



工程指示 / 要求簡箋 ENGINEER INSTRUCTIONS(E.I.)

工程指示編號:	EI- 4666	修改版本:	-
	HK- 0761		
工程編號:	J 858	工程名稱:	將軍澳日出康城11
收件人:	生統	發件人:	Bernard Lau
工程項目:	後裝窗 大貨(T1-T3) 到貨期及分層表	日期:	20/05/2022

<input checked="" type="checkbox"/> 原合約工程包	<input type="checkbox"/> 原合約工程加 / 減賬 QT-	<input type="checkbox"/> 新工程報價 QT-
--	--	------------------------------------

信件批核號碼/圖紙參考編號:	批核模具圖紙編號:
客戶指示附件:	管理內部批簽署:

<input type="checkbox"/> 初步鋁料 B.M.	<input checked="" type="checkbox"/> 加工拆圖, 然後生產	<input type="checkbox"/> 尺寸表
<input type="checkbox"/> 正式鋁料 B.M.	<input type="checkbox"/> 技術上資料/指示	<input type="checkbox"/> 報價
<input type="checkbox"/> 配件 B.M.	<input type="checkbox"/> 樣辦或貨品說明書	<input type="checkbox"/> 分判合約
<input type="checkbox"/> 其他:		

內容: 請按附頁內的生產圖加工 另附到貨期及分層表出貨 (T1-T3)  請留意先做試版窗, T1A-B/K1及 T1B-B/K-1 各做一幅 睇效果 ✓ 配件: 請參考 EI4675A ✓ 不銹鋼加力巴請用EI4601 ✓
完成上列要求日期: 07/04/2022

國內

<input type="checkbox"/> 生產技術總監	<input type="checkbox"/> 連附件	<input type="checkbox"/> 技術部	<input type="checkbox"/> 連附件	<input type="checkbox"/> 生產部	<input type="checkbox"/> 連附件
<input type="checkbox"/> 採購部	<input type="checkbox"/> 連附件	<input checked="" type="checkbox"/> 生產統籌部	<input checked="" type="checkbox"/> 連附件	<input type="checkbox"/> 報關組	<input type="checkbox"/> 連附件
<input checked="" type="checkbox"/> 質檢部	<input checked="" type="checkbox"/> 連附件	<input checked="" type="checkbox"/> 會計部	<input type="checkbox"/> 連附件	<input type="checkbox"/> 機械設計部	<input type="checkbox"/> 連附件
<input checked="" type="checkbox"/> 其他: 水澆 / 木小器					


香港

<input type="checkbox"/> 行政部	<input type="checkbox"/> 連附件	<input type="checkbox"/> 會計部	<input type="checkbox"/> 連附件	<input type="checkbox"/> 統籌部	<input type="checkbox"/> 連附件	<input type="checkbox"/> 工程部	<input type="checkbox"/> 連附件
<input type="checkbox"/> 採購部	<input type="checkbox"/> 連附件	<input type="checkbox"/> QS部	<input type="checkbox"/> 連附件	<input type="checkbox"/> 地盤管理	<input type="checkbox"/> 連附件	<input type="checkbox"/> 維修部	<input type="checkbox"/> 連附件

*發件人簽署:	*組別成員批核簽署:
傳遞編號:	項目經理簽署:



 美特铝质有限公司 MIDI Aluminium Fabricator Ltd.	工程號	J858	拆圖	SHAW	2022.02.15
	地盤	康城1期	復核		
名稱	50地盤安裝窗	顏色	批准		

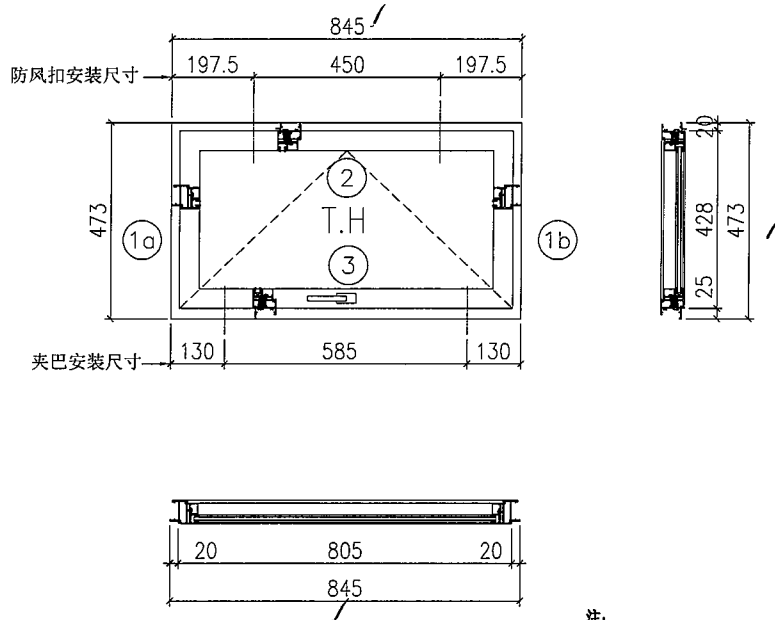

- 注:
- 1) 生窗底料需開15mm去水缺口2处;
  - 2) 窗玉搭位6mm;
  - 3) 滴水線比窗玉每頭長1mm;
  - 4) TH窗需裝2組TC903扣碼;
  - 5) 用東城產2021-A12°扇撐;
  - 6) 安裝201-10多点鎖夾巴2个;
  - 7) 框橫料兩端需切1x2mm切口打膠;
  - 8) 出地盤摩爾10个;
  - 9) 边企料安裝50-LC-04A窗粘各1只;

序号	料号	名称	出荷	长度(mm)	支/幅	加工说明
1a	X862510	边企料		473	1	X86251-01L
1b	X862510	边企料		473	1	X86251-01R
2	X862520	生顶横	避位	807	1	X86252-02
3	X862530	生底横	避位	799	1	X86253-02

窗玉用料


序号	料号	名称	出荷	长度(mm)	支/幅	加工说明
1a	X86163	窗玉企	45° 斜口	428	1	X86163-04LB
1b	X86163	窗玉企	45° 斜口	428	1	X86163-04RB
2a	X86163	窗玉横	45° 斜口	805	1	X86163-05A
2b	X86163	窗玉横	45° 斜口	805	1	X86163-06A
3	X86164	窗玉玻璃线企	直口	364	2	X86164-06C
4a	X86164	窗玉玻璃线横	直口	709	1	X86164-06B
4b	X86164	窗玉玻璃线横	直口	709	1	X86164-03A
5a	X86153	撞角码	直口	45	1	J858-LM01L
5b	X86153	撞角码	直口	45	1	J858-LM01R
5c	X86153	撞角码	直口	45	2	J858-LM01
6	L065	15x13x3铝角	直口	50	10	J858-LM04
7	X86154	拉巴用压板1	直口	80	2	J858-LM05
8	X86155	拉巴用压板2	直口	15	4	J858-LM06
9a	X86237	14x3拉巴	直口	292.5	1	X86237-01A
9b	X86237	14x3拉巴	直口	279.5	1	X86237-01B
10		12"框不锈钢扇撑加力巴		181.5	2	J858-LM08

加工细则

顶留	-	mm		
底留	-	mm		
企料底部开避位		mm		
底横料防水巴锯去		mm		
水线孔在企料	顶	底		
按装扣码	-			
多点锁夹巴型号:	-			
手柄型号:	-			
限位撑型号:				
T窗最大的开度:				
窗玉搭位数:	-			
窗款	宽度	高度	隻/幅	撑长
TH	805	428	1	12"

大图版次	宽度	本图版	Rev. 3	
		日期	05/19	
窗号	宽度(W)	高度(H)	幅数	楼层数
T1B-B/K-1	845	473	1	
T2B-B/K-1	845	473	1	
T3B-B/K-1	845	473	1	
图号				

 美特鋁質有限公司 MIDI Aluminium Fabricator Ltd.	工程號	J858	拆圖	SHAW	2022.02.15
	地盤	康城1期	復核		
名稱	50地盤安裝窗	顏色	批准		

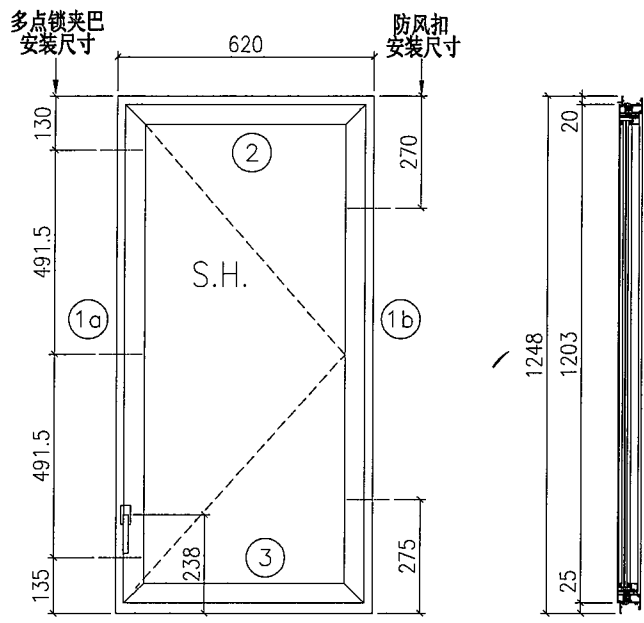

- 注:
- 1) 生窗底料需開15mm去水缺口2處;
  - 2) 窗玉搭位6mm;
  - 3) 滴水線比窗玉每頭長1mm;
  - 4) SH窗需裝2組TC903扣碼;
  - 5) 用東城產2021-A16°扇撐;
  - 6) 安裝201-10多点鎖夾巴3個;
  - 7) 框橫料兩端需切1x2mm切口打膠;
  - 8) 出貨摩爾16個;
  - 9) 底料安裝50-LC-04A窗拑1只;

序号	料号	名称	出荷	长度(mm)	支/幅	加工说明
1a	X862510	边企料		1248	1	X86251-03
1b	X862510	边企料		1248	1	X86251-02
2	X862520	生顶横	避位	582	1	X86252-01B
3	X862530	生底横	避位	574	1	X86253-01B

加工细则				
顶留	-			mm
底留	-			mm
企料底部开避位				mm
底横料防水巴锯去				mm
水线孔在企料	顶	底		
按装扣码				
多点锁夹巴型号:				
手柄型号:				
限位撑型号:				
T窗最大的开度:				
窗玉搭位数:				


窗玉用料

序号	料号	名称	出荷	长度(mm)	支/幅	加工说明
1a	X86163	窗玉企	45°斜口	1203	1	X86163-05B
1b	X86163	窗玉企	45°斜口	1203	1	X86163-07A
2a	X86163	窗玉横	45°斜口	580	1	X86163-04LA
2b	X86163	窗玉横	45°斜口	580	1	X86163-04RA
3a	X86171	窗玉玻璃线企	直口	1139	1	X86171-06A
3b	X86171	窗玉玻璃线企	直口	1139	1	X86171-03A
4a	X86171	窗玉玻璃线横	直口	484	1	X86171-06B
4b	X86171	窗玉玻璃线横	直口	484	1	X86171-04A
5a	X86153	撞角码	直口	45	1	J858-LM01L
5b	X86153	撞角码	直口	45	1	J858-LM01R
5c	X86153	撞角码	直口	45	2	J858-LM01
6	L065	15x13x3铝角	直口	50	10	J858-LM04
7	X86154	拉巴用压板1	直口	80	3	J858-LM05
8	X86155	拉巴用压板2	直口	15	6	J858-LM06
9	X86237	14x3拉巴	直口	103	1	X86237-01C
10	X86237	14x3拉巴	直口	867	1	X86237-01E

窗款	宽度	高度	隻/幅	撑长
SRH	580	1203	1	16"

大图版次	宽度	本图版	Rev. 3	
		日期	05/19	
窗号	宽度(W)	高度(H)	幅数	楼层数
T3B-C/B-1	620	1248	49	
T2B-1/B-1	620	1248	1	
图号				

 美特鋁質有限公司 MIDI Aluminium Fabricator Ltd.	工程號	J858	拆圖	SHAW	2022.02.15
	地盤	康城1期	復核		
名稱	50地盤安裝窗	顏色	批准		

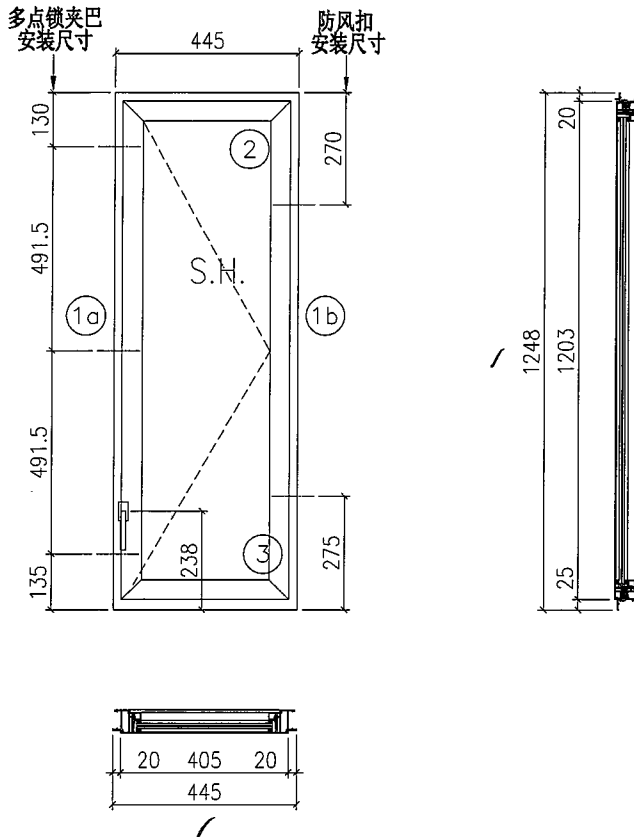

- 注:
- 1) 生窗底料需開15mm去水缺口2處;
  - 2) 窗玉搭位6mm;
  - 3) 滴水線比窗玉每頭長1mm;
  - 4) SH窗需裝2組TC903扣碼;
  - 5) 用東城產2021-A12°扇漆;
  - 6) 安裝201-10多点鎖夾巴3個;
  - 7) 框橫料兩端需切1x2mm切口打膠;
  - 8) 出貨摩爾14個;
  - 9) 底料安裝50-LC-04A窗沾1只;

序号	料号	名称	出荷	长度(mm)	支/幅	加工说明
1a	X862510	边企料		1248	1	X86251-03
1b	X862510	边企料		1248	1	X86251-02
2	X862520	生顶横	避位	407	1	X86252-01A
3	X862530	生底横	避位	399	1	X86253-01A

窗玉用料


序号	料号	名称	出荷	长度(mm)	支/幅	加工说明
1a	X86163	窗玉企	45° 斜口	1203	1	X86163-05B
1b	X86163	窗玉企	45° 斜口	1203	1	X86163-07A
2a	X86163	窗玉横	45° 斜口	405	1	X86163-04LC
2b	X86163	窗玉横	45° 斜口	405	1	X86163-04RC
3a	X86171	窗玉玻璃线企	直口	1139	1	X86171-06A
3b	X86171	窗玉玻璃线企	直口	1139	1	X86171-03A
4a	X86171	窗玉玻璃线横	直口	309	1	X86171-06C
4b	X86171	窗玉玻璃线横	直口	309	1	X86171-04B
5a	X86153	撞角码	直口	45	1	J858-LM01L
5b	X86153	撞角码	直口	45	1	J858-LM01R
5c	X86153	撞角码	直口	45	2	J858-LM01
6	L065	15x13x3铝角	直口	50	10	J858-LM04
7	X86154	拉巴用压板1	直口	80	3	J858-LM05
8	X86155	拉巴用压板2	直口	15	6	J858-LM06
9	X86237	14x3拉巴	直口	103	1	X86237-01C
10	X86237	14x3拉巴	直口	867	1	X86237-01E

加工细则

顶留	-	mm		
底留	-	mm		
企料底部开避位		mm		
底横料防水巴锯去		mm		
水线孔在企料---	顶	底		
按装扣码	-			
多点锁夹巴型号:	-			
手柄型号:	-			
限位撑型号:				
T窗最大的开度:				
窗玉搭位数:	-			
窗款	宽度	高度	隻/幅	撑长
SRH	405	1203	1	12"

大图版次	宽度	本图版	Rev. 3	
		日期	05/19	
窗号	宽度(W)	高度(H)	幅数	楼层数
T2B-C/B-1	445	1248	49	
图号				

 美特铝质有限公司 MIDI Aluminium Fabricator Ltd.	工程號	J858	拆圖	SHAW	2022.02.15
	地盤	康城1期	復核		
名稱	50地盤安裝窗	顏色	批准		

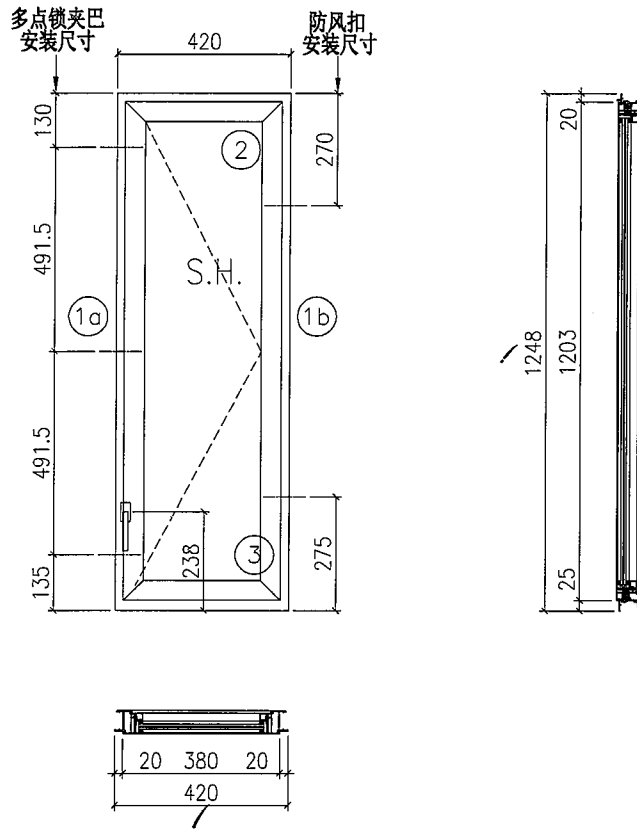

- 注:
- 1) 生窗底料需開15mm去水缺口2處;
  - 2) 窗玉搭位6mm;
  - 3) 滴水線比窗玉每頭長1mm;
  - 4) SH窗需裝2組TC903扣碼;
  - 5) 用東城產2021-A12"扇撐;
  - 6) 安裝201-10多點鎖夾巴3個;
  - 7) 框橫料兩端需切1x2mm切口打膠;
  - 8) 出貨摩爾14個;
  - 9) 底料安裝50-LC-04A窗抬1只;

序号	料号	名称	出荷	长度(mm)	支/幅	加工说明
1a	X862510	边企料		1248	1	X86251-03
1b	X862510	边企料		1248	1	X86251-02
2	X862520	生顶横	避位	382	1	X86252-01C
3	X862530	生底横	避位	374	1	X86253-01C

窗玉用料


序号	料号	名称	出荷	长度(mm)	支/幅	加工说明
1a	X86163	窗玉企	45° 斜口	1203	1	X86163-05B
1b	X86163	窗玉企	45° 斜口	1203	1	X86163-07A
2a	X86163	窗玉横	45° 斜口	380	1	X86163-04LD
2b	X86163	窗玉横	45° 斜口	380	1	X86163-04RD
3a	X86171	窗玉玻璃线企	直口	1139	1	X86171-06A
3b	X86171	窗玉玻璃线企	直口	1139	1	X86171-03A
4a	X86171	窗玉玻璃线横	直口	284	1	X86171-06D
4b	X86171	窗玉玻璃线横	直口	284	1	X86171-04C
5a	X86153	撞角码	直口	45	1	J858-LM01L
5b	X86153	撞角码	直口	45	1	J858-LM01R
5c	X86153	撞角码	直口	45	2	J858-LM01
6	L065	15x13x3铝角	直口	50	10	J858-LM04
7	X86154	拉巴用压板1	直口	80	3	J858-LM05
8	X86155	拉巴用压板2	直口	15	6	J858-LM06
9	X86237	14x3拉巴	直口	103	1	X86237-01C
10	X86237	14x3拉巴	直口	867	1	X86237-01E

加工细则

顶留	-	mm		
底留	-	mm		
企料底部开避位		mm		
底横料防水巴锯去		mm		
水线孔在企料	顶	底		
按装扣码	-			
多点锁夹巴型号:	-			
手柄型号:	-			
限位撑型号:				
T窗最大的开度:				
窗玉搭位数:	-			
窗款	宽度	高度	隻/幅	撑长
SRH	380	1203	1	12"

大图版次	宽度	本图版	Rev. 3	
		日期	05/19	
窗号	宽度(W)	高度(H)	幅数	楼层数
T3B-A/B-1	420	1248	1	
图号				

 美特鋁質有限公司 MIDI Aluminium Fabricator Ltd.	工程號	J858	拆圖	SHAW	2022.02.15
	地盤	康城1期	復核		
名稱	50地盤安裝窗	顏色	批准		

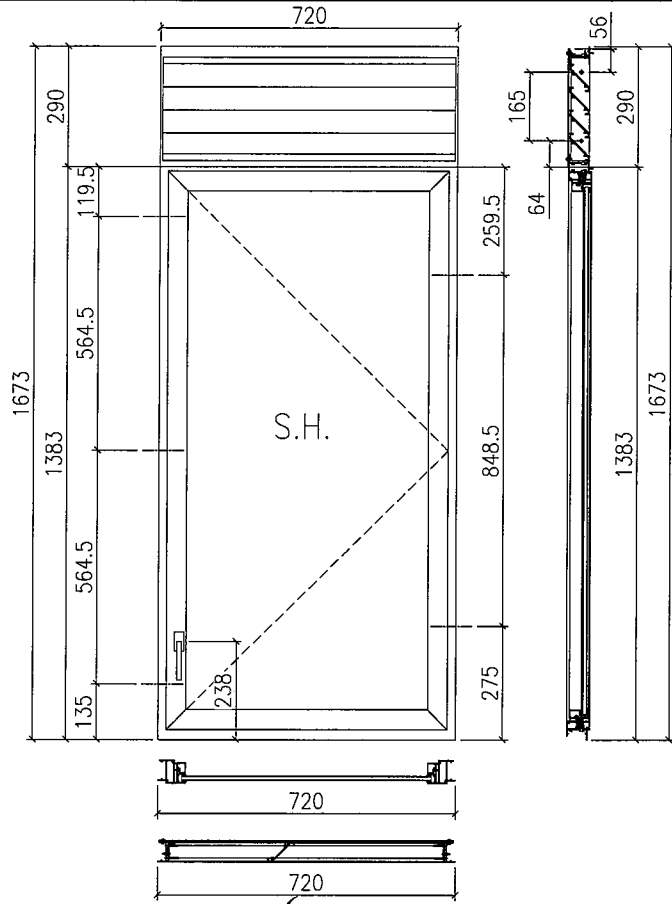

- 注:
- 1) 生窗底料需開15mm去水缺口2處;
  - 2) 窗玉搭位6mm;
  - 3) 滴水線比窗玉每頭長1mm;
  - 4) SH窗需裝2組TC903扣碼;
  - 5) 用東城產2021-A16°扇撐;
  - 6) 安裝201-10多點鎖夾巴3個;
  - 7) 框橫料兩端需切1x2mm切口打磨;
  - 8) 出貨摩爾18個;
  - 9) 底料安裝50-LC-04A窗沾1只;

序号	料号	名称	出荷	长度(mm)	支/幅	加工说明
1a	X862510	边企料		1673	1	X86251-05
1b	X862510	边企料		1673	1	X86251-04
2	X862520	生顶横	避位	682	1	X86252-03
3	X862530	生底横	避位	674	1	X86253-01D
4	X862490	滴水线		668	1	X86249-01
5	X862500	生中横	避位	682	1	X86250-01
6	X862480	百叶片		661	4	X86248-01

序号	料号	名称	出荷	长度(mm)	支/幅	加工说明
7	-	-		-	-	-
8	-	百叶巴		248	1	J858-LM10L
9	-	百叶巴		248	1	J858-LM10R



窗玉用料

序号	料号	名称	出荷	长度(mm)	支/幅	加工说明
1a	X86163	窗玉企	45° 斜口	1348.5	1	X86163-05C
1b	X86163	窗玉企	45° 斜口	1348.5	1	X86163-07B
2a	X86163	窗玉横	45° 斜口	680	1	X86163-04LE
2b	X86163	窗玉横	45° 斜口	680	1	X86163-04RE
3a	X86164	窗玉玻璃线企	直口	1284.5	1	X86164-06A
3b	X86164	窗玉玻璃线企	直口	1284.5	1	X86164-02B
4a	X86164	窗玉玻璃线横	直口	584	1	X86164-06D
4b	X86164	窗玉玻璃线横	直口	584	1	X86164-04A
5a	X86153	撞角码	直口	45	1	J858-LM01L
5b	X86153	撞角码	直口	45	1	J858-LM01R
5c	X86153	撞角码	直口	45	2	J858-LM01
6	L065	15x13x3铝角	直口	50	10	J858-LM04
7	X86154	拉巴用压板1	直口	80	3	J858-LM05
8	X86155	拉巴用压板2	直口	15	6	J858-LM06
9	X86237	14x3拉巴	直口	103	1	X86237-01C
10	X86237	14x3拉巴	直口	1012.5	1	X86237-01F

窗款	宽度	高度	隻/幅	撑长
SRH	680	1348.5	1	16"


大图版次	宽度	本图版	Rev. 3	
		日期	05/19	
窗号	宽度(W)	高度(H)	幅数	楼层数
T1A-B/K-1	720	1673	45	
T2A-B/K-1	720	1673	49	
T3A-B/K-1	720	1673	49	
T1A-A/K-1	720	1673	1	
T2A-A/K-1	720	1673	1	
T3A-A/K-1	720	1673	1	

图号	
----	--

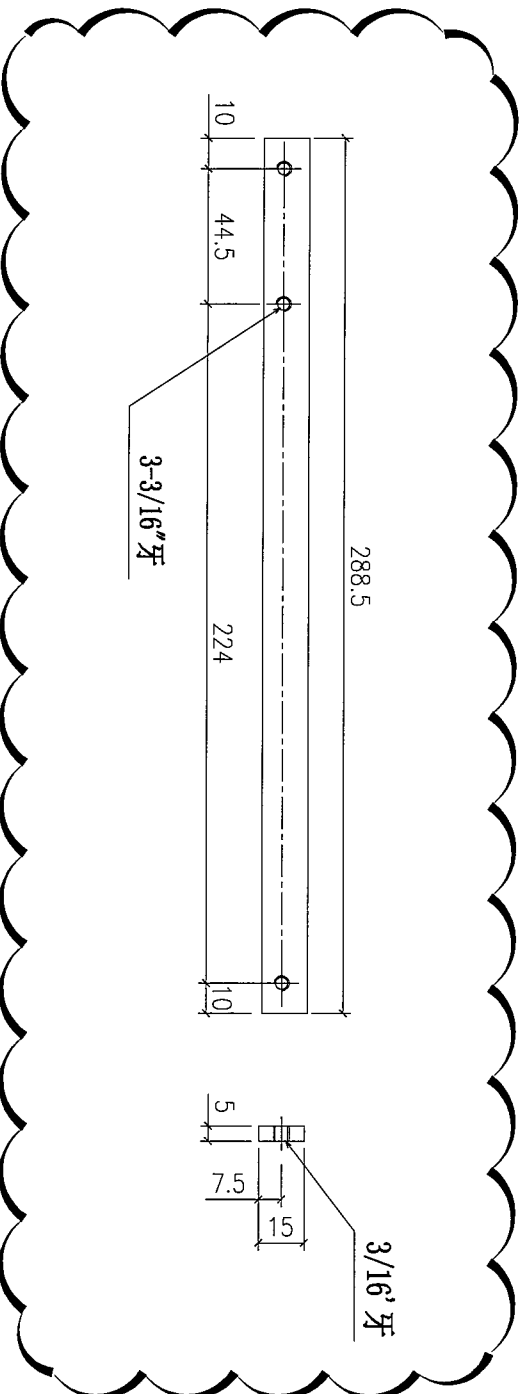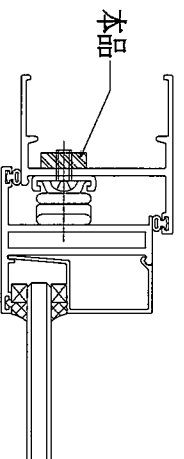


FOR: 2021-A12" TH窗用




Remarks:		Checked: -		Description:		QTY: 6		Delivery to:		Date		Amendments	
Project Name: 康城11期		Project No. J858		Date: 22-12-2014		Material: 15x5mm 不锈钢		Tolerance: ±0.5		Factory			
Shop Drawing No. PRE-CAST ALUM. WINDOW & LOUVRE		Rev. -		Date: 17-02-2020		Finish: 304# 不锈钢		Projection:		Site		Assembly No. J858-LM08	
												Rev. 1	

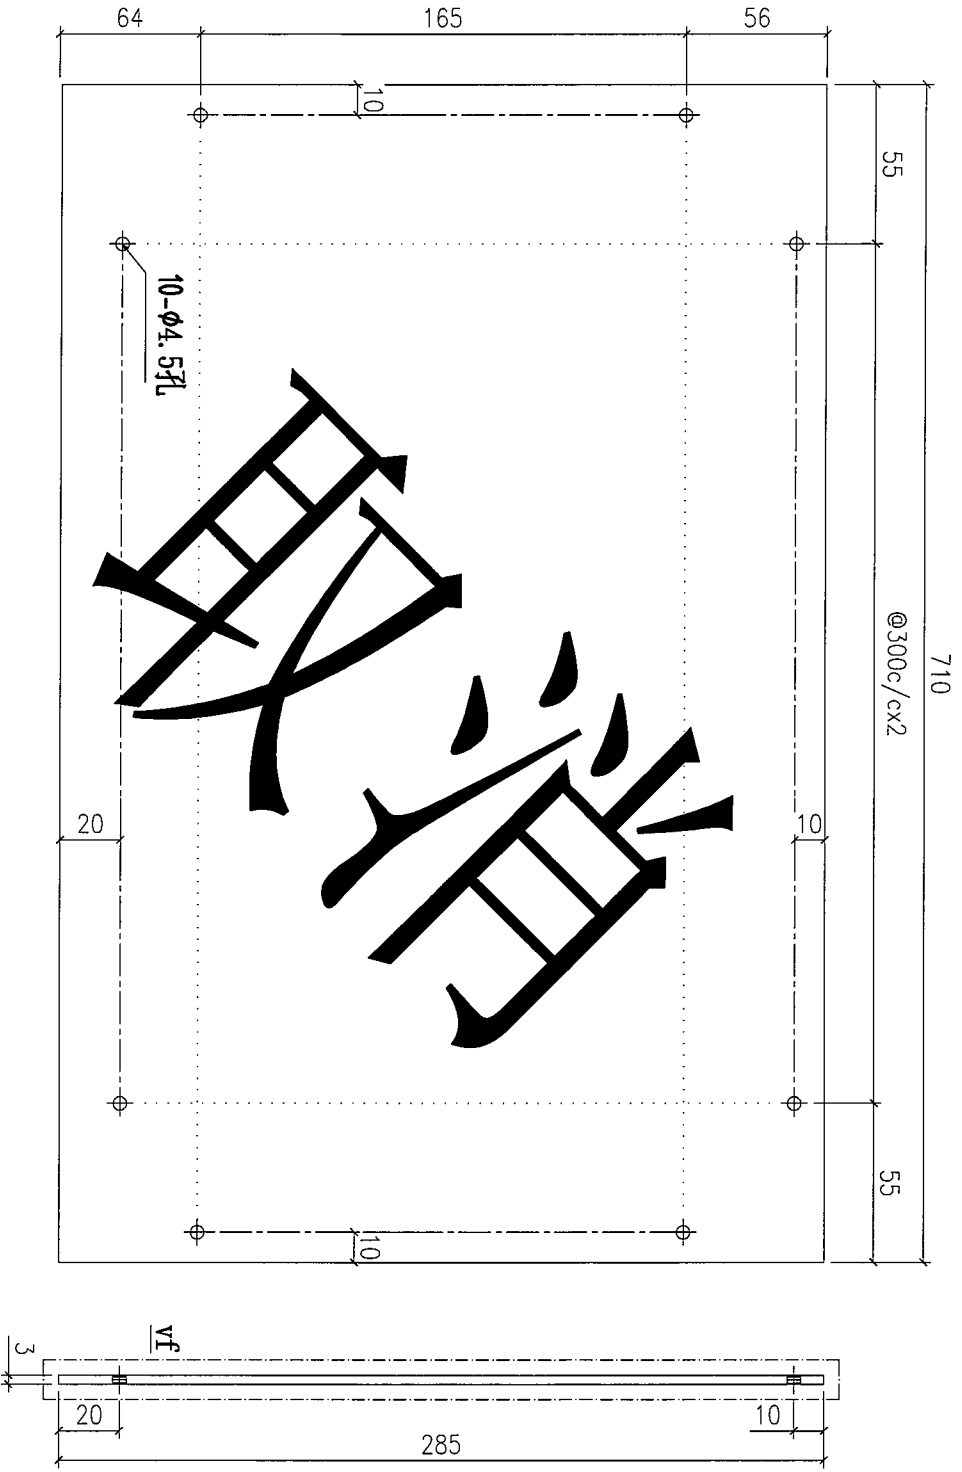

Remarks:		Checked: -		Description:		QTY: 146		Delivery to Rev.		Date		Amendments	
Project Name: 康城11期		Project No. J858		Material: 3mm厚铝板		Tolerance: ±0.5		Factory					
Shop Drawing No. PRE-CAST ALUM. WINDOW & LOUVRE		Rev. -		Date: 22-12-2014		Projection:		Site		Assembly No. J858-LM09		Rev. -	
		Date: 17-02-2020		Drawn: W.E.X		Finish: PPR2							


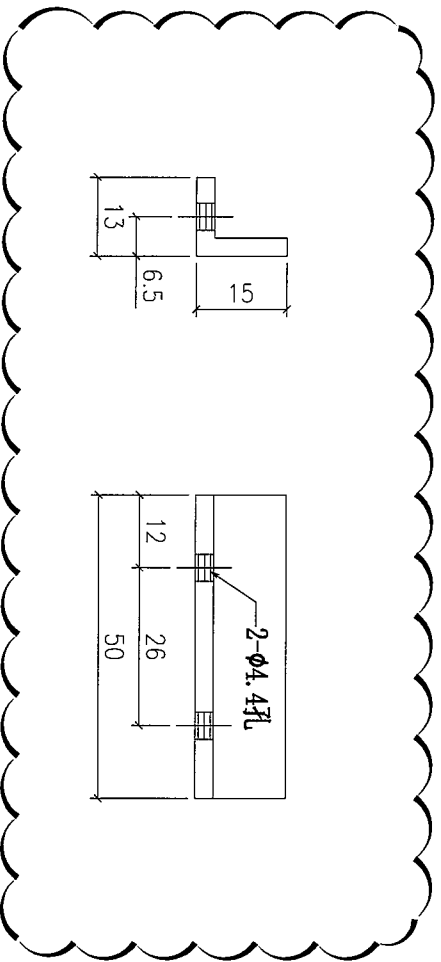


Remarks:		Checked: -		Description:		QTY:		Delivery to		Date		Amendments	
Project Name:		Project No.		Material:		Tolerance:		Factory					
康城11期		J858		13x15x2铝角		±0.5		Site					
Shop Drawing No.		Rev.		Finish:		Projection:		Assembly No.		Date		Rev.	
PRE-CAST ALUM. WINDOW & LOUVRE		-		MILL				J858-LM04				1	
		Date:											
		22-12-2014											
		Drawn:											
		W.E.X											
		Date:											
		17-02-2020											

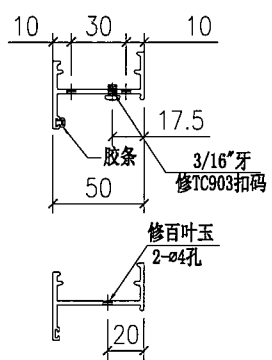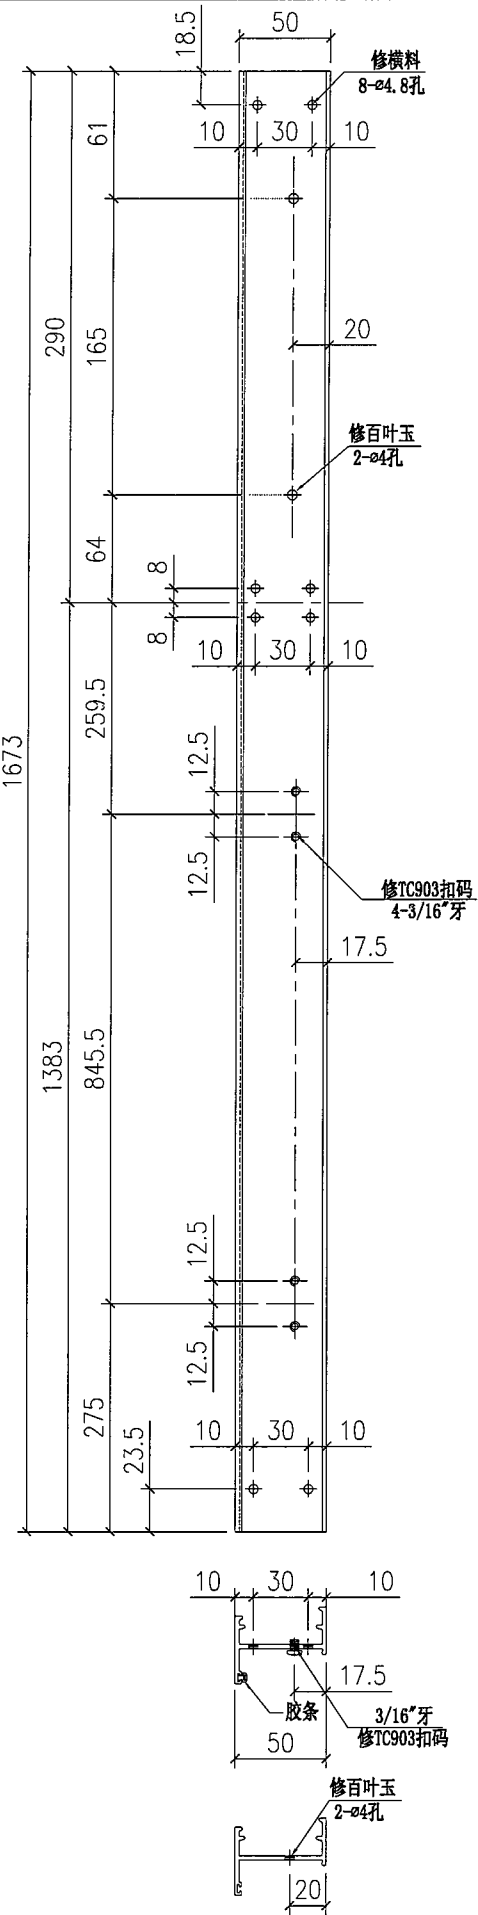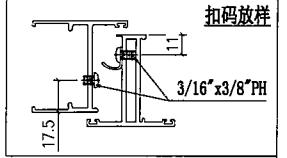


Remarks:		Checked: KEN		Description: 生边企		QTY: 146		Delivery to: Factory		Date:		Amendments:	
Project Name: 康城11期		Date: 22-12-2014		Material: 6061-T5		Tolerance: ±0.5		Site:		Date:			
Shop Drawing No.: PRE-CAST ALUM. WINDOW & LOUVRE		Drawn: W.E.X		Finish: PVF2		Projection:		Assembly No.: X86251-04		Date:			
Project No.: J858		Date: 22-12-2014						Rev.:		Date:			
Rev.:		Date: 22-12-2014						Rev.:		Date:			




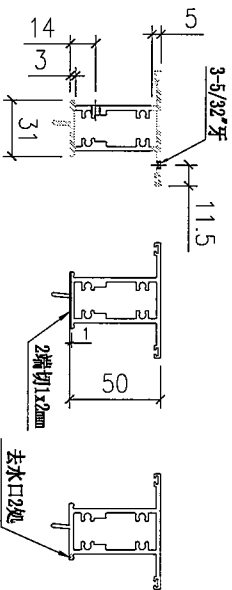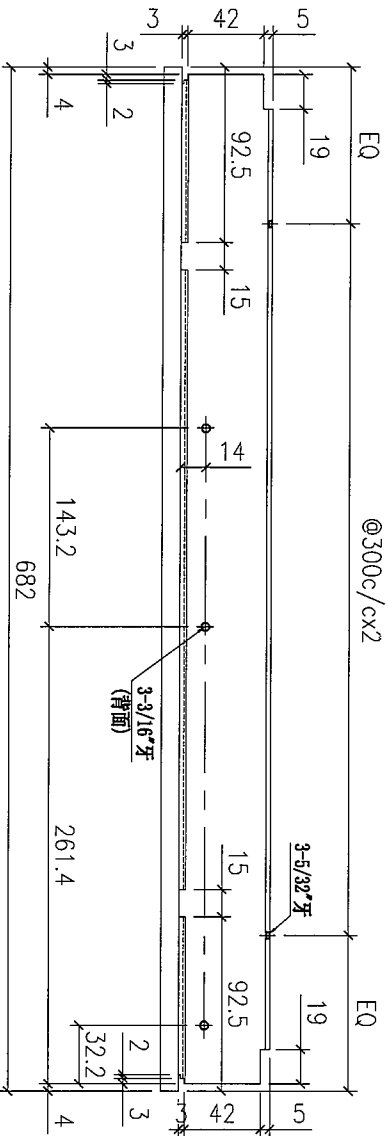

Remarks:		Checked: -		Description: 生中横		QTY: 146		Delivery to		Date		Remarks	
Project Name: 康城11期		Date: -		Material: 6061-T5		Tolerance: ±0.5		Factory					
Project No. J858		Drawn: W.E.X		Finish: PVF2		Projection:		Site		Assembly No. X86250-01		Rev. 1	
Shop Drawing No. PRE-CAST ALUM. WINDOW & LOUVRE		Rev: -		Date: 15-02-2020									

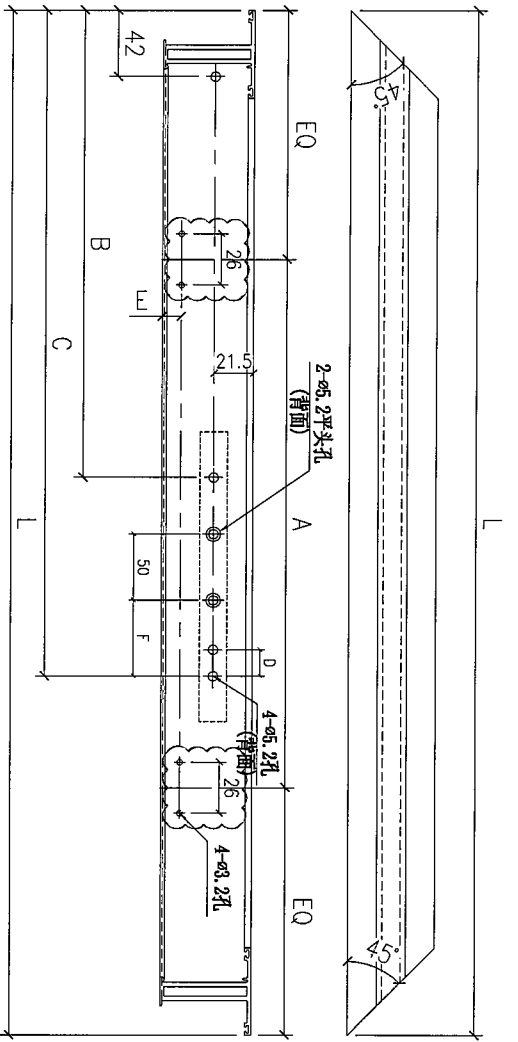

序号	部件编号	L	A	B	C	D	E	F	扇撑	数量
5	X86163-04LE	680	340	112	248.5	13.5	20	55	16"	146
4	X86163-04LD	380	140	-	203.5	13.5	12.5	35	12"	1
3	X86163-04LC	405	150	-	203.5	13.5	12.5	35	12"	49
2	X86163-04LB	428	210	-	203.5	13.5	20	35	12"	3
1	X86163-04LA	580	290	112	248.5	13.5	12.5	55	16"	50

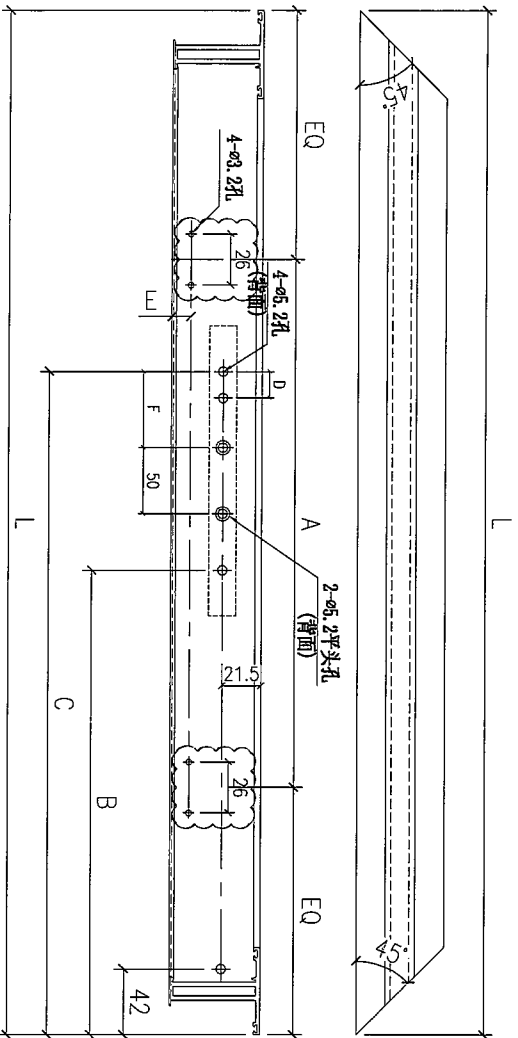

序号	部件编号	L	A	B	C	D	E	F	扇撑	数量
5	X86163-04RE	680	340	112	248.5	13.5	20	55	16"	146
4	X86163-04RD	380	140	-	203.5	13.5	12.5	35	12"	1
3	X86163-04RC	405	150	-	203.5	13.5	12.5	35	12"	49
2	X86163-04RB	428	210	-	203.5	13.5	20	35	12"	3
1	X86163-04RA	580	290	112	248.5	13.5	12.5	55	16"	50

Remarks:



Project Name: 康城11期  
 Project No: J858  
 Shop Drawing No: PRE-CAST ALUM. WINDOW & LOUVRE  
 Rev: -

Check: -  
 Date: -  
 Drawn: W.E.X  
 Date: 15-02-2020

Description: 窗玉料  
 Material: 6061-T5  
 Finish: PVF2





QTY: -  
 Tolerance: ±0.5  
 Projection:

Delivery to Rev. Date  
 Site:   
 Assembly No: X86163-04  
 Rev: 1

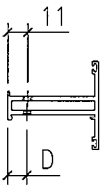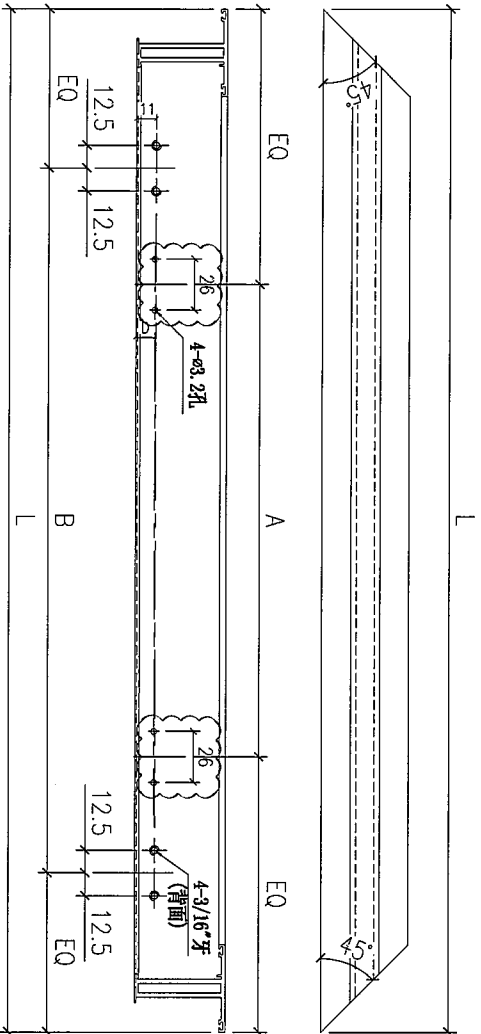





序号	部件编号	L	A	B	D	数量
2	X86163-05C	1348.5	2x325/c/c	848.5	20	146
2	X86163-05B	1203	2x300/c/c	703	12.5	100
1	X86163-05A	805	2x200/c/c	450	20	3

Remarks:		Checked: -		Description: 窗玉料		QTY: -		Delivery to Rev.		Date		Amendments	
Project Name: 康城11期		Project No: J858		Material: 6061-T5		Tolerance: ±0.5		Factory		Site		Assembly No. X86163-05	
Shop Drawing No. PRE-CAST ALUM. WINDOW & LOUVRE		Rev: -		Date: 15-02-2020		Finish: PVF2		Projection:		Rev. 1			

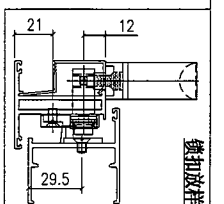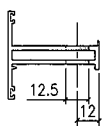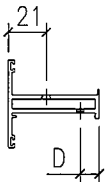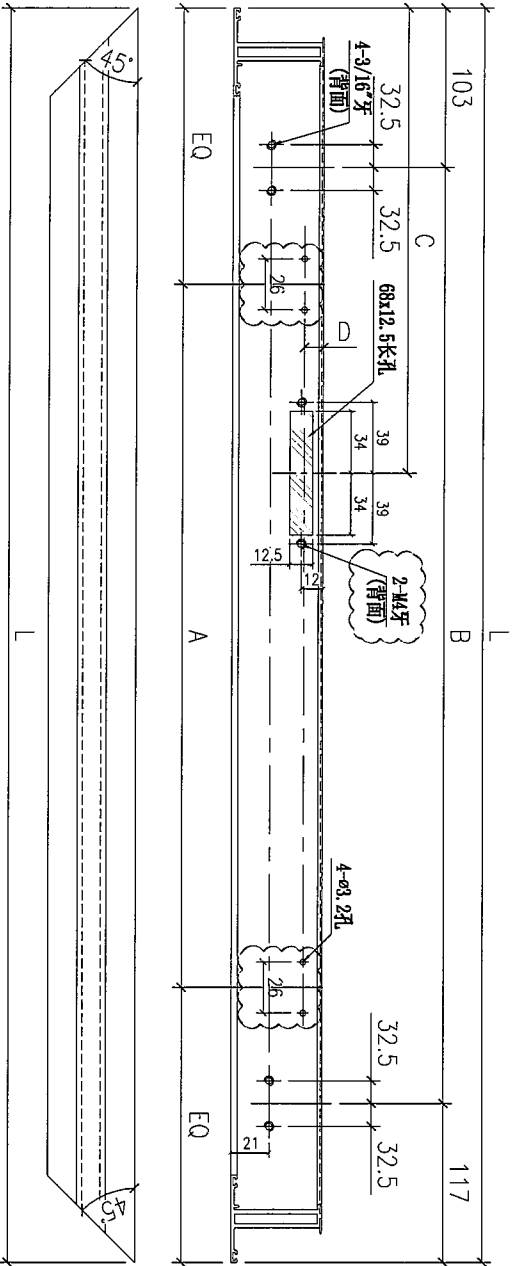

序号	1	X86163-06A	805	2-2000/c	585	402.5	20	3
部件编号			L	A	B	C	D	数量

Remarks:		Checked:		Description:	
Project Name: 康城11期		Date: -		窗玉料	
Project No: J858		Drawn: W.E.X		Material: 6061-T5	
Shop Drawing No: PRE-CAST ALUM. WINDOW & LOUVRE		Date: 15-02-2020		Finish: PVF2	

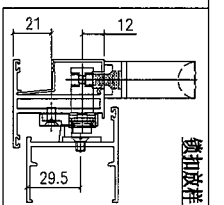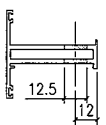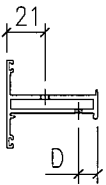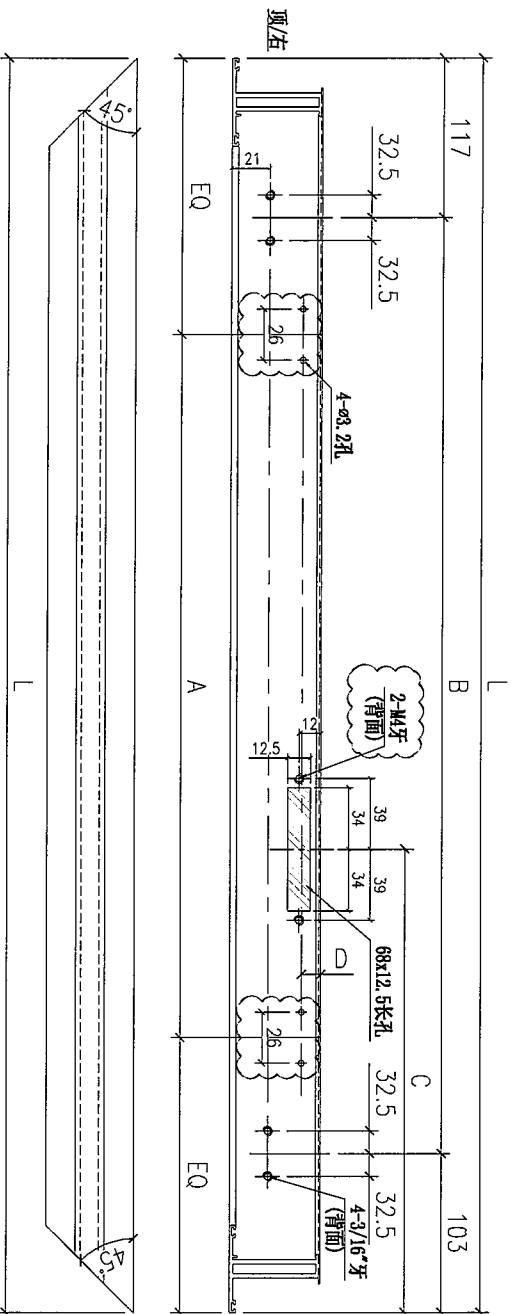

1	X86163-07B	1348.5	2x325dc	@564.25dcx2	213	20	146
1	X86163-07A	1203	2x300dc	@491.5dcx2	213	12.5	100
序号	部件编号	QTY	Delivery to		Rev.	Date	数量
			L	A	B	C	D

Remarks:

Project Name: 康城II期  
Project No: J858  
Shop Drawing No: PRE-CAST ALUM. WINDOW & LOUVRE



Checked: -  
Date: -  
Drawn: W.E.X  
Date: 15-02-2020

Description: 窗玉料  
Material: 6061-T5  
Finish: PVF2

Tolerance: ±0.5  
Projection:

Site:



Assembly No: X86163-07  
Rev: 1

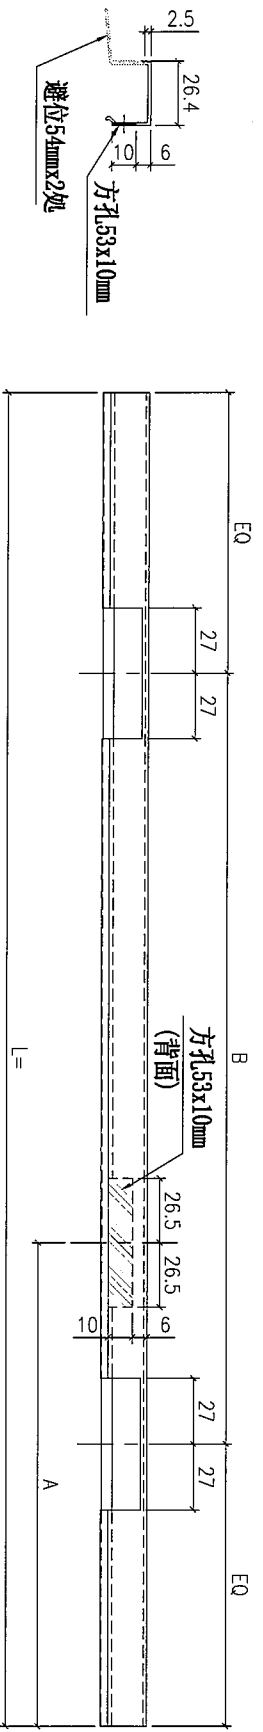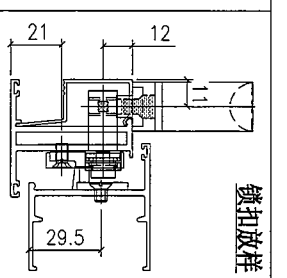

2	X86171-02B	1284.5	181	2x3256c	146
1	X86171-02A	-	-	-	-
序号	部件编号	L	A	B	数量



Remarks:

Project Name:	康城11期	Project No.:	J858	Checked:	KEN	Description:	6mm玻璃线	QTY:	-	Delivery to:	Factory	Rev.:		Date:		Amendments:	
Shop Drawing No.:	PRE-CAST ALUM. WINDOW & LOUVRE	Rev.:	-	Date:	22-12-2014	Material:	6061-T5	Tolerance:	±0.5	Site:		Assembly No.:	X86164-02	Rev.:	2		
				Drawn:	W.E.X	Finish:	PVF2	Projection:									

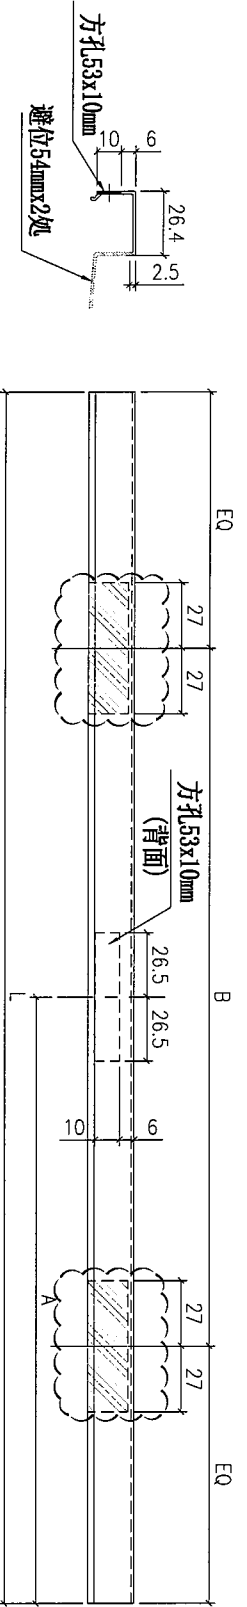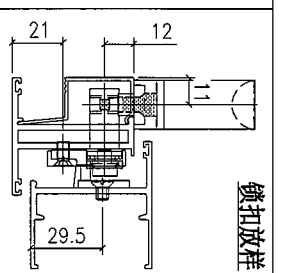


序号	1	X86171-03A	709	354.5	2x200cc	3
部件编号	L	A	B			数量

Remarks:		Checked: KEN		Description: 6mm玻璃线		QTY: -		Delivery to Rev. Date		Amendments	
Project Name: 康城11期		Date: 22-12-2014		Material: 6061-T5		Tolerance: ±0.5		Factory			
Project No. J858		Drawn: W.L.X		Finish: PVF2		Projection:		Site		Assembly No. X86164-03	
Ship Drawing No. PRE-CAST ALUM. WINDOW & LOUVRE		Rev: -		Date: 22-12-2014						Rev. 1	

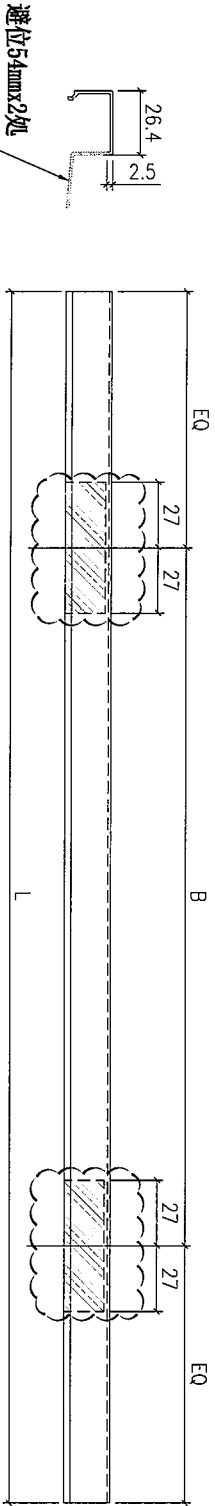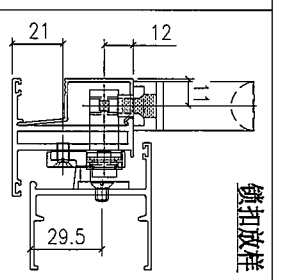

序号	部件编号	L	B	数量
1	X86171-04A	584	340	146



Remarks:		Checked: KEN		Description: 6mm玻璃线		QTY: -		Delivery to Rev		Date		Assemblies No.		Revisions	
Project Name: 康城11期		Project No: J858		Material: 6061-T5		Tolerance: ±0.5		Factory				X86164-04		1	
Shop Drawing No: PRE-CAST ALUM. WINDOW & LOUVRE		Rev: -		Date: 22-12-2014		Date: 22-12-2014		Site							
				Drawn: W.L.X		Finish: PVF2		Projection:							

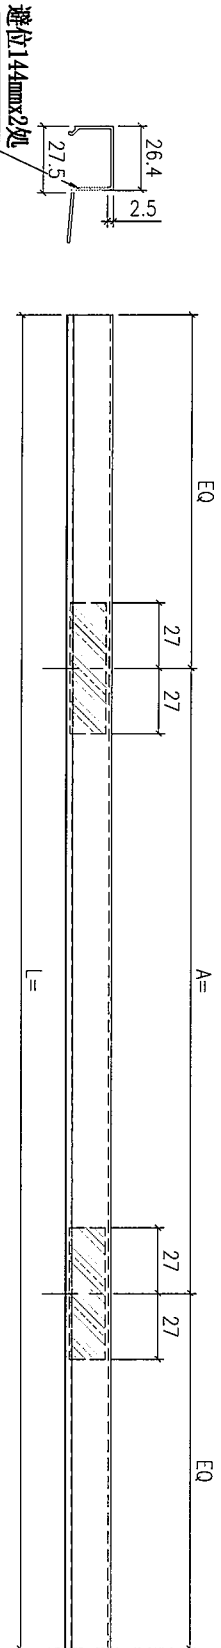


新图

序号	部件编号	L	A	数量
4	X86164-06D	584	340	146
3	X86164-06C	364	210	6
2	X86164-06B	709	400	3
1	X86164-06A	1284.5	2x3256/c	146

Remarks:		Checked: KEN		Description: 6mm玻璃线		QTY: -		Delivery to: (Factory)		Date: 22-12-2014		Assembly No. X86164-06		Rev: -	
Project Name: 康城11期		Project No. J858		Material: 6061-T5		Tolerance: ±0.5		Site		Date: 22-12-2014		Rev: -			
Shop Drawing No. PRE-CAST ALUM. WINDOW & LOUVRE		Drawn: W.E.X		Finish: PVF2		Projection:				Date: 22-12-2014		Rev: -			

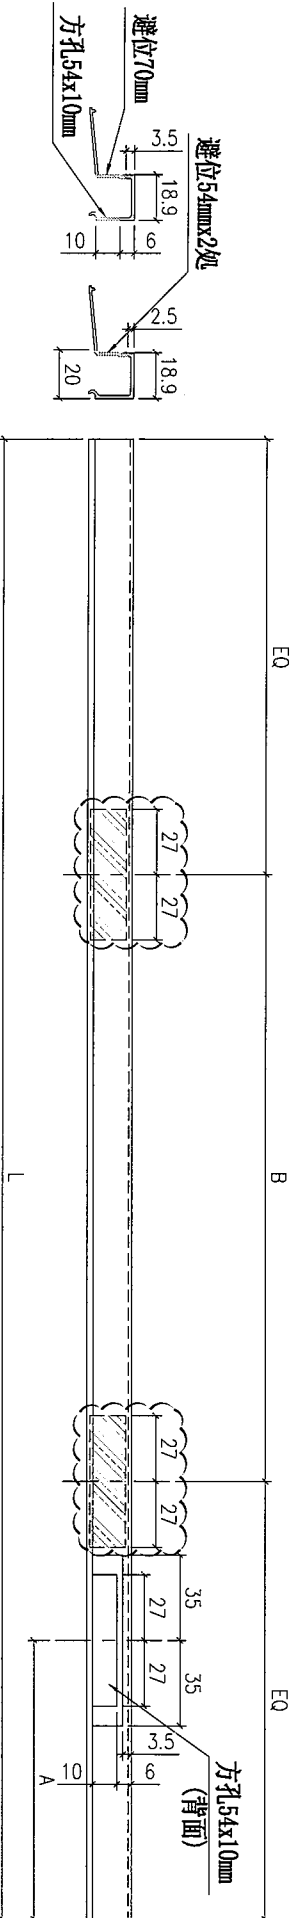
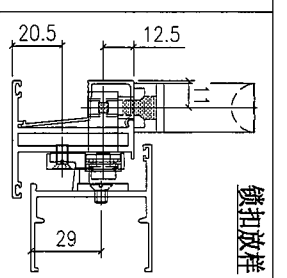


Remarks:		Checked: KEN		Description: 13.52mm玻璃线		QTY: -		Delivery to Rev. Date		Assembly No. X86171-03		Rev. 1	
Project Name: 康城11期		Project No. J858		Material: 6061-T5		Tolerance: ±0.5		Factory		Site		Rev.	
Shop Drawing No. PRE-CAST ALUM. WINDOW & LOUVRE		Date: 22-12-2014		Drawn: W.E.X		Projection:		Date		Date		Quantity	
Rev. -		Date: 22-12-2014		Finish: PVF2		Projection:		Date		Date		Quantity	

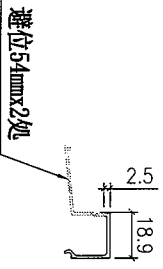

序号	部件编号	L	A	数量
3	X86171-04C	284	140	1
2	X86171-04B	309	150	49
1	X86171-04A	484	290	50

Remarks:		Checked: KEN		Description: 13. 52mm玻璃线		QTY: -		Delivery to Rev.	
Project Name: 康城11期		Date: 22-12-2014		Material: 6061-T5		Tolerance: ±0.5		Date	
Project No: J858		Drawn: W.E.X		Finish: PVF2		Projection:		Date	
Ship Drawing No: PRE-CAST ALUM. WINDOW & LOUVERE		Rev: -		Date: 22-12-2014		Site		Date	
						Assembly No. X86171-04		Rev. 1	

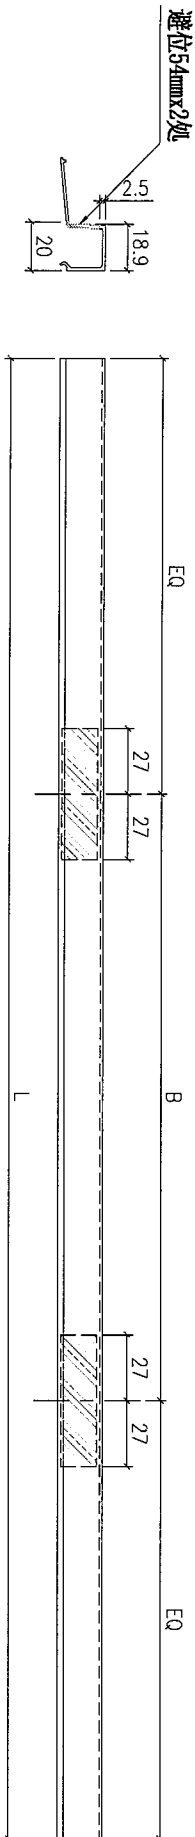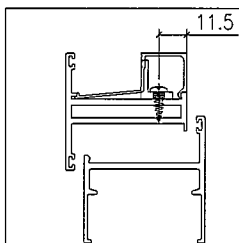

新图

Remarks:

Project Name:

康城11期

Project No.:

J858

Checked:

KEN

Description:

13.52mm玻璃线

QTY:

-

Delivery to:

Factory

Assembly No.:

X86171-06

Amendments:

Rev.:

-

Shop Drawing No.:

PRE-CAST ALUM. WINDOW & LOUVRE

Rev.:

1

Date:

22-12-2014

Drawn:

W.E.X

Finish:

PV/F2

Projection:





Site:


序号	部件编号	L	B	数量
4	X86171-06D	284	140	1
3	X86171-06C	309	150	49
2	X86171-06B	484	290	50
1	X86171-06A	1139	2x3000c/c	100




ADD. REF. : \_\_\_\_\_

CLIENT :  信和置业有限公司  
Sino Land Company Limited



ARCHITECT :  Ronald Lu  
Ronald Lu & Partners (HK) Ltd.  
呂宗誠建築師事務所 (香港) 建築公司

MAIN CONTRACTOR :  Gammon

STRUCTURAL ENGINEER :  AECOM

FAÇADE CONSULTANT :  AECOM

NOTE :  
1. ALL DIMENSIONS ARE IN mm.  
2. ALL ELEVATIONS ARE VIEWED FROM OUTSIDE.  
3. ALL DIMENSIONS TO BE VERIFIED ON SITE BEFORE FABRICATION.

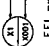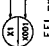LEGEND :  
 --DETAIL MARK NO.  
 --REVISION SHEET NO.

1. F.F.L. --- FINISHED FLOOR LEVEL.  
2. S.F.L. --- STRUCTURAL FLOOR LEVEL.  
3. (⊖) --- REVERSED DETAIL.

NO.	DATE	REVISION	BY	CHK.
1	15-02-2022	REVISED AS PER ARCHITECT COMMENTS	LS	BP


JOB NO. : J-856

PROJECT : PROPOSED RESIDENTIAL DEVELOPMENT AT TKOTIL 709P, PHASE 11, LOHAS PARK TSEUNG KWAN O, N.T.

FILE : IN-SITU ALUM. WINDOW SCHEDULE




DATE : 04-OCT-21 SCALE : 1:30

DRAWN BY : \_\_\_\_\_ CHECKED BY : \_\_\_\_\_




UNITED 6-8, Sunray Industrial Centre, 1/F  
 MTDI  
16125499211-4 Fax: (852) 7272566

REV. : A

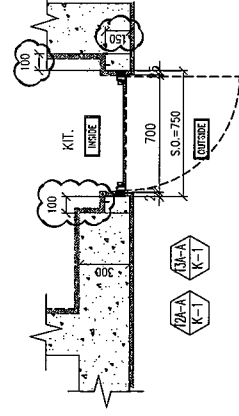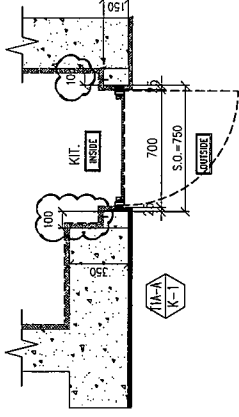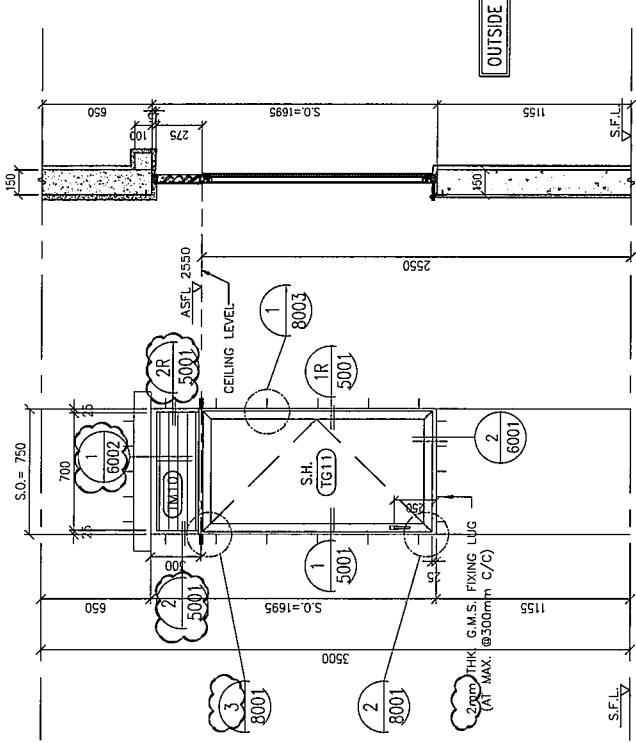ELEVATION



GLAZING AREA	Required = 0.542	Provided = 0.7318
OPENABLE AREA	Required = 0.339	Provided = 0.8293
GLAZING AREA	Required = 1.403	Provided = 0.7318
OPENABLE AREA	Required = 1.403	Provided = 0.8293

WINDOW MARK	SECTION	QTY.	LOCATION	GLAZING	REMARK
	50mm ALUM. SECTION WITH PVF2 COATING(SILVER CHAMPAGNE COLOUR)	1 NOS.	TOWER 1(1A) FLAT A KITCHEN(62/F)	10mm THK CRYSTAL GREY TEMPERED GLASS	FREE AREA (%) : 17/35 = 0.486%
	50mm ALUM. SECTION WITH PVF2 COATING(SILVER CHAMPAGNE COLOUR)	1 NOS.	TOWER 2(2A) FLAT A KITCHEN(67/F)	10mm THK CRYSTAL GREY TEMPERED GLASS	
	50mm ALUM. SECTION WITH PVF2 COATING(SILVER CHAMPAGNE COLOUR)	1 NOS.	TOWER 3(3A) FLAT A KITCHEN(67/F)	10mm THK CRYSTAL GREY TEMPERED GLASS	

B.D. REF :

CLIENT : 怡和置業有限公司  
Sino Land Company Limited

ARCHITECT : Ronald Lu & Partners  
Ronald Lu & Partners (HK) Ltd.  
呂元璋建築師事務所 (香港) 有限公司

MAIN CONTRACTOR : Gammon

STRUCTURAL ENGINEER : AECOM

FACADE CONSULTANT: AECOM

NOTE :

1. ALL DIMENSIONS ARE IN mm.
2. ALL ELEVATIONS ARE VIEWED FROM OUTSIDE.
3. ALL DIMENSIONS TO BE VERIFIED ON SITE BEFORE FABRICATION.

LEGEND :

— DETAIL MARK NO.  
 — REFER SHEET NO.

1. F.F.L. — FINISHED FLOOR LEVEL.
2. S.F.L. — STRUCTURAL FLOOR LEVEL.
3. — REVERSED DETAIL.

1	18-09-2024	ISSUED AS PER ARCHITECT COMMENTS	LS
2	11-11-2024	ISSUED AS PER ARCHITECT COMMENTS	LS
3	12-10-2024	ISSUED AS PER ARCHITECT COMMENTS	LS
4	DATE	ISSUED AS PER ARCHITECT COMMENTS	LS
5	DATE	ISSUED AS PER ARCHITECT COMMENTS	LS

JOB NO. : J-828

PROJECT : PROPOSED RESIDENTIAL DEVELOPMENT AT TKTOTL 70RP, PHASE 11, LOHAS PARK TSECUNG KWAN O. N.T.




TITLE : IN-SITU ALUM. WINDOW SCHEDULE

DATE : 04-OCT-21 SCALE : 1:30

DRAWN BY : CHECKED BY :

美特 特 特 有限公司  
MIDI Architectural Services  
Unit 6-8, Sunny Industrial Centre, 1/F  
810 Che Kwo Ling Road, Kowloon  
Tel: 248211-4 Fax: (852) 2727746

DWG NO. : J059-W-2102 REV. : C

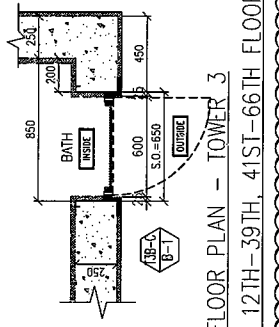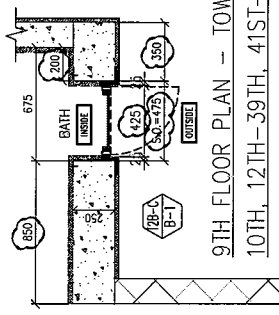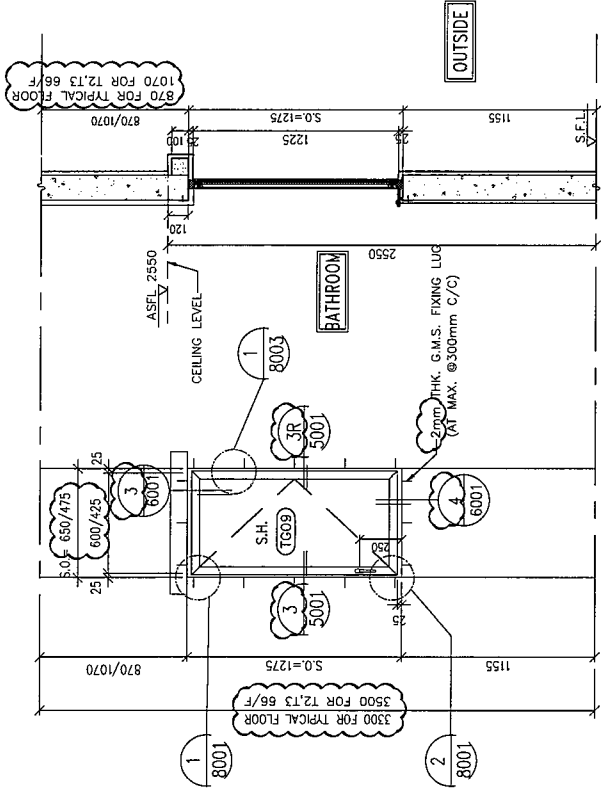

9TH FLOOR PLAN - TOWER 2  
10TH, 12TH-39TH, 41ST-66TH FLOOR PLAN - TOWER 2

9TH FLOOR PLAN - TOWER 3  
10TH, 12TH-39TH, 41ST-66TH FLOOR PLAN - TOWER 3

WINDOW MARK	SECTION	GLAZING AREA	OPENABLE AREA	GLAZING AREA	OPENABLE AREA	Required	Provided
	50mm ALUM. SECTION WITH PVF2 COATING(SILVER CHAMPAGNE COLOUR) 49 NOS. (TYPICAL)					0.305	0.3421
	TOWER 2(2B) FLAT C BATHROOM(9/F,10/F, 12/F-39/F, 41/F-66/F) 6mm THK HEAT STRENGTHENED CLEAR GLASS + 1.52mm MILKY WHITE PVB + 6mm THK HEAT STRENGTHENED CLEAR GLASS					0.305	0.4184
	50mm ALUM. SECTION WITH PVF2 COATING(SILVER CHAMPAGNE COLOUR) 49 NOS. (TYPICAL)					0.305	0.5358
	TOWER 3(3B) FLAT C BATHROOM(9/F,10/F, 12/F-39/F, 41/F-66/F)					0.305	0.6212

ELEVATION

