

工程指示 / 要求簡箋(E.I.)

工程指示編號：EI / 4723 / 23

修改版次：E

工程編號：J - 858

工程名稱：將軍澳日出康城 11

工程項目：幕牆單元件、趟門 生產次序 附上趟門

收件人：生統

發件人：Ant Yeung

日期：21/02/2023

要求提供 / 確認 事項：

- | | | |
|------------------------------------|-------------------------------------|-------------------------------|
| <input type="checkbox"/> 初步鋁料 B.M. | <input type="checkbox"/> 加工拆圖，然後生產 | <input type="checkbox"/> 尺寸表 |
| <input type="checkbox"/> 正式鋁料 B.M. | <input type="checkbox"/> 技術上資料 / 指示 | <input type="checkbox"/> 報價 |
| <input type="checkbox"/> 配件 B.M. | <input type="checkbox"/> 樣辦或貨品說明書 | <input type="checkbox"/> 分判合約 |

內容：

E 版本：請附件的生產次序排產、出貨。 附上拆棚次序方向。 (T1 T2 T3 的改倉位置延後)E 版本：Low Zone 底區 T1 9-16/F T2 9-19/F T3 9-19/FD 版本：附上趟門通、框、玉生產進度。C 版本：請按附件的生產次序排產、出貨。2.排架表 11/F 底的 1270 高單元，與 11/F 頂 583 高單元分開排架。B 版 請附件的生產次序排產、出貨。 / 加附上拆棚次序方向地盆：請也留意更新了拆棚次序方向附件為幕牆單元件生產次序。樣板層 T1 (12,15,16/F) --->準確出貨指示排車由地盆發出。水洪，請再評估 廠內存貨空間 和 平放架用量是否足夠應付工程所需。謝謝請在 2023.02.22 前完成上列要求。

附： 頁

 原合約工程包 原合約工程加 / 減賬 新工程報價

分發東莞各部門：

- | | | | |
|--|---|--|---|
| <input type="checkbox"/> 生產技術總監 <input type="checkbox"/> 連附件 | <input checked="" type="checkbox"/> 技術部 <input checked="" type="checkbox"/> 連附件 | <input type="checkbox"/> 生產部 <input type="checkbox"/> 連附件 | <input type="checkbox"/> 機械設計部 <input type="checkbox"/> 連附件 |
| <input type="checkbox"/> 採購部 <input type="checkbox"/> 連附件 | <input checked="" type="checkbox"/> 生產統籌部 <input checked="" type="checkbox"/> 連附件 | <input checked="" type="checkbox"/> 小羅&清 <input checked="" type="checkbox"/> 連附件 | |
| <input type="checkbox"/> 質檢部 <input type="checkbox"/> 連附件 | <input type="checkbox"/> 會計部 <input type="checkbox"/> 連附件 | <input type="checkbox"/> 報關組 <input type="checkbox"/> 連附件 | <input checked="" type="checkbox"/> 其他 水洪 <input checked="" type="checkbox"/> 連附件 |

分發香港各部門：


- | | | | |
|---|--|---|--|
| <input type="checkbox"/> 行政部 <input type="checkbox"/> 連附件 | <input type="checkbox"/> 會計部 <input type="checkbox"/> 連附件 | <input type="checkbox"/> 統籌部 <input type="checkbox"/> 連附件 | <input checked="" type="checkbox"/> 工程部地盤科文 <input checked="" type="checkbox"/> 連附件 積哥 |
| <input type="checkbox"/> 採購部 <input type="checkbox"/> 連附件 | <input type="checkbox"/> QS 部 <input type="checkbox"/> 連附件 | <input type="checkbox"/> 維修部 <input type="checkbox"/> 連附件 | <input type="checkbox"/> 其他 _____ <input type="checkbox"/> 連附件 |

傳遞編號：

HK 286 / 23

發件人簽署：

項目經理簽署：

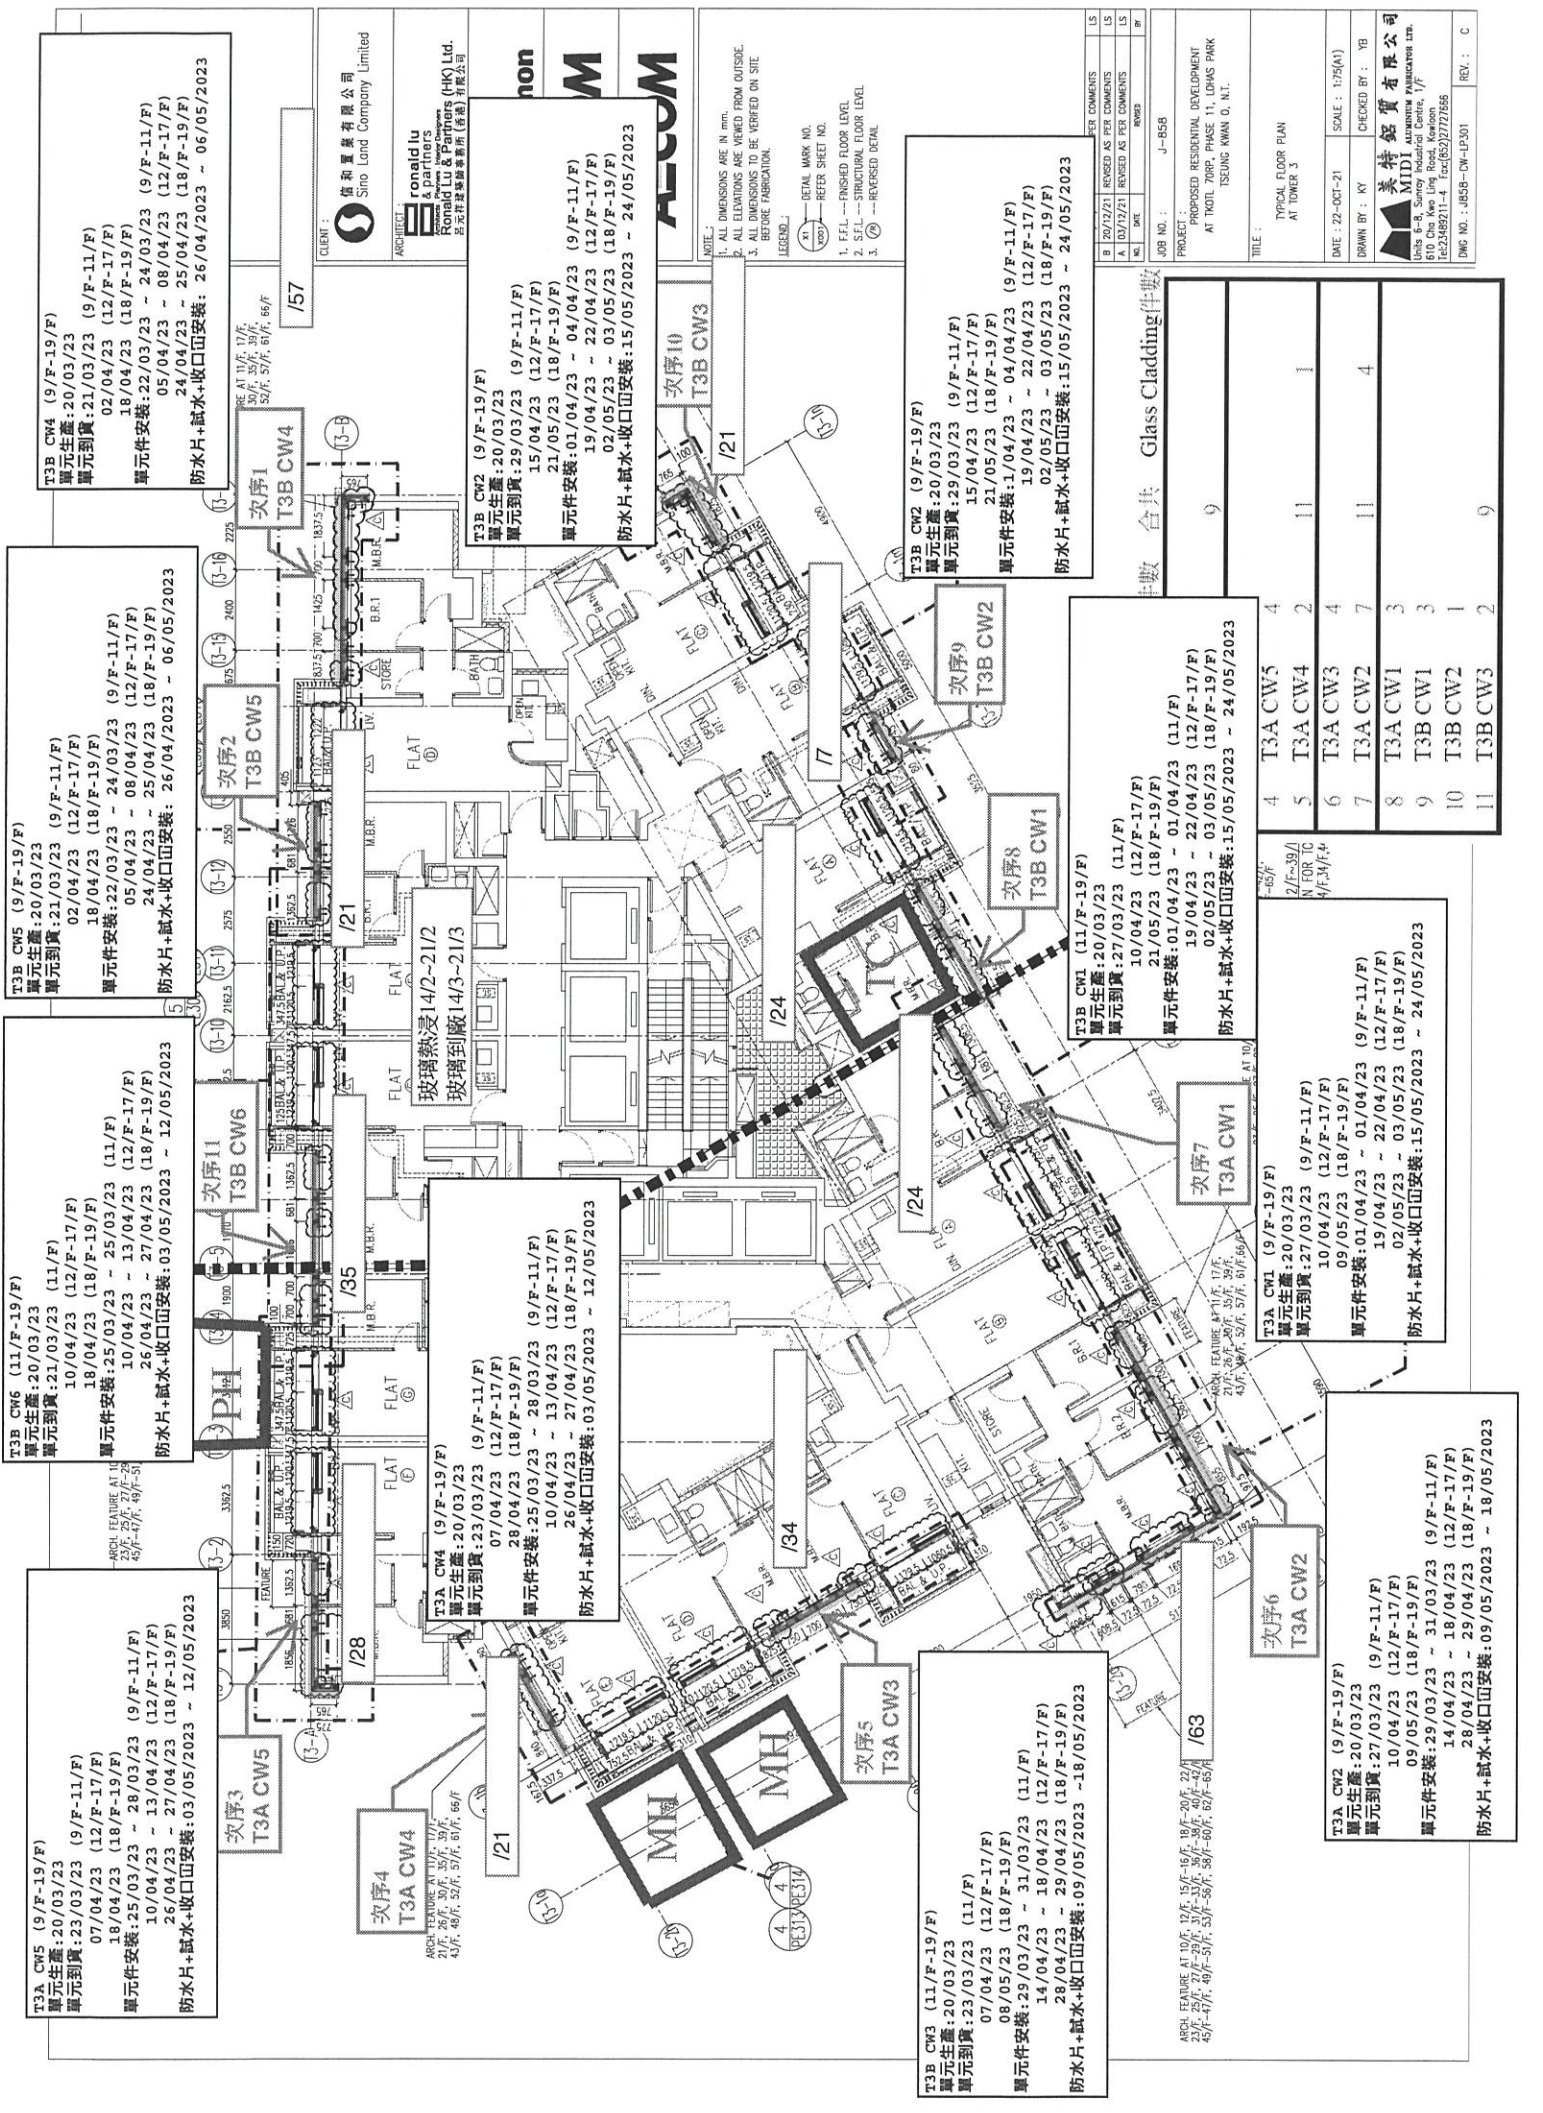

T3B CW4 (9/F-19/F)
 單元生產: 20/03/23
 單元到貨: 21/03/23 (9/F-11/F)
 02/04/23 (12/F-17/F)
 18/04/23 (18/F-19/F)
 單元件安裝: 22/03/23 - 24/03/23 (9/F-11/F)
 05/04/23 - 08/04/23 (12/F-17/F)
 24/04/23 - 25/04/23 (18/F-19/F)
 防水片+試水+收口安裝: 26/04/2023 - 06/05/2023

T3B CW5 (9/F-19/F)
 單元生產: 20/03/23
 單元到貨: 21/03/23 (9/F-11/F)
 02/04/23 (12/F-17/F)
 18/04/23 (18/F-19/F)
 單元件安裝: 22/03/23 - 24/03/23 (9/F-11/F)
 05/04/23 - 08/04/23 (12/F-17/F)
 24/04/23 - 25/04/23 (18/F-19/F)
 防水片+試水+收口安裝: 26/04/2023 - 06/05/2023

T3B CW6 (11/F-19/F)
 單元生產: 20/03/23
 單元到貨: 21/03/23 (11/F)
 10/04/23 (12/F-17/F)
 18/04/23 (18/F-19/F)
 單元件安裝: 25/03/23 - 25/03/23 (11/F)
 10/04/23 - 13/04/23 (12/F-17/F)
 26/04/23 - 27/04/23 (18/F-19/F)
 防水片+試水+收口安裝: 03/05/2023 - 12/05/2023

T3A CW5 (9/F-19/F)
 單元生產: 20/03/23
 單元到貨: 23/03/23 (9/F-11/F)
 07/04/23 (12/F-17/F)
 18/04/23 (18/F-19/F)
 單元件安裝: 25/03/23 - 28/03/23 (9/F-11/F)
 10/04/23 - 13/04/23 (12/F-17/F)
 26/04/23 - 27/04/23 (18/F-19/F)
 防水片+試水+收口安裝: 03/05/2023 - 12/05/2023

T3B CW2 (9/F-19/F)
 單元生產: 20/03/23 (9/F-11/F)
 單元到貨: 29/03/23 (9/F-11/F)
 15/04/23 (12/F-17/F)
 21/05/23 (18/F-19/F)
 單元件安裝: 01/04/23 - 04/04/23 (9/F-11/F)
 19/04/23 - 22/04/23 (12/F-17/F)
 02/05/23 - 03/05/23 (18/F-19/F)
 防水片+試水+收口安裝: 15/05/2023 - 24/05/2023

T3B CW1 (11/F-19/F)
 單元生產: 20/03/23 (11/F)
 單元到貨: 27/03/23 (11/F)
 10/04/23 (12/F-17/F)
 21/05/23 (18/F-19/F)
 單元件安裝: 01/04/23 - 01/04/23 (11/F)
 19/04/23 - 22/04/23 (12/F-17/F)
 02/05/23 - 03/05/23 (18/F-19/F)
 防水片+試水+收口安裝: 15/05/2023 - 24/05/2023

T3A CW4 (9/F-19/F)
 單元生產: 20/03/23 (9/F-11/F)
 單元到貨: 07/04/23 (12/F-17/F)
 28/04/23 (18/F-19/F)
 單元件安裝: 25/03/23 - 28/03/23 (9/F-11/F)
 10/04/23 - 13/04/23 (12/F-17/F)
 26/04/23 - 27/04/23 (18/F-19/F)
 防水片+試水+收口安裝: 03/05/2023 - 12/05/2023

T3A CW3 (11/F-19/F)
 單元生產: 20/03/23 (11/F)
 單元到貨: 23/03/23 (11/F)
 07/04/23 (12/F-17/F)
 08/05/23 (18/F-19/F)
 單元件安裝: 29/03/23 - 31/03/23 (11/F)
 14/04/23 - 18/04/23 (12/F-17/F)
 28/04/23 - 29/04/23 (18/F-19/F)
 防水片+試水+收口安裝: 09/05/2023 - 18/05/2023

T3A CW2 (9/F-19/F)
 單元生產: 20/03/23 (9/F-11/F)
 單元到貨: 27/03/23 (9/F-11/F)
 10/04/23 (12/F-17/F)
 21/05/23 (18/F-19/F)
 單元件安裝: 01/04/23 - 01/04/23 (9/F-11/F)
 19/04/23 - 22/04/23 (12/F-17/F)
 02/05/23 - 03/05/23 (18/F-19/F)
 防水片+試水+收口安裝: 15/05/2023 - 24/05/2023

T3A CW1 (11/F-19/F)
 單元生產: 20/03/23 (11/F)
 單元到貨: 27/03/23 (11/F)
 10/04/23 (12/F-17/F)
 21/05/23 (18/F-19/F)
 單元件安裝: 01/04/23 - 01/04/23 (11/F)
 19/04/23 - 22/04/23 (12/F-17/F)
 02/05/23 - 03/05/23 (18/F-19/F)
 防水片+試水+收口安裝: 15/05/2023 - 24/05/2023

T3A CW2 (9/F-19/F)
 單元生產: 20/03/23 (9/F-11/F)
 單元到貨: 27/03/23 (9/F-11/F)
 10/04/23 (12/F-17/F)
 21/05/23 (18/F-19/F)
 單元件安裝: 01/04/23 - 01/04/23 (9/F-11/F)
 19/04/23 - 22/04/23 (12/F-17/F)
 02/05/23 - 03/05/23 (18/F-19/F)
 防水片+試水+收口安裝: 15/05/2023 - 24/05/2023

T3A CW1 (9/F-19/F)
 單元生產: 20/03/23 (9/F-11/F)
 單元到貨: 27/03/23 (9/F-11/F)
 10/04/23 (12/F-17/F)
 21/05/23 (18/F-19/F)
 單元件安裝: 01/04/23 - 01/04/23 (9/F-11/F)
 19/04/23 - 22/04/23 (12/F-17/F)
 02/05/23 - 03/05/23 (18/F-19/F)
 防水片+試水+收口安裝: 15/05/2023 - 24/05/2023

T3B CW1 (9/F-19/F)
 單元生產: 20/03/23 (9/F-11/F)
 單元到貨: 29/03/23 (9/F-11/F)
 15/04/23 (12/F-17/F)
 21/05/23 (18/F-19/F)
 單元件安裝: 1/04/23 - 04/04/23 (9/F-11/F)
 19/04/23 - 22/04/23 (12/F-17/F)
 02/05/23 - 03/05/23 (18/F-19/F)
 防水片+試水+收口安裝: 15/05/2023 - 24/05/2023

T3A CW1 (11/F-19/F)
 單元生產: 20/03/23 (11/F)
 單元到貨: 27/03/23 (11/F)
 10/04/23 (12/F-17/F)
 21/05/23 (18/F-19/F)
 單元件安裝: 01/04/23 - 01/04/23 (11/F)
 19/04/23 - 22/04/23 (12/F-17/F)
 02/05/23 - 03/05/23 (18/F-19/F)
 防水片+試水+收口安裝: 15/05/2023 - 24/05/2023

T3A CW1 (9/F-19/F)
 單元生產: 20/03/23 (9/F-11/F)
 單元到貨: 27/03/23 (9/F-11/F)
 10/04/23 (12/F-17/F)
 21/05/23 (18/F-19/F)
 單元件安裝: 01/04/23 - 01/04/23 (9/F-11/F)
 19/04/23 - 22/04/23 (12/F-17/F)
 02/05/23 - 03/05/23 (18/F-19/F)
 防水片+試水+收口安裝: 15/05/2023 - 24/05/2023

T3A CW2 (9/F-19/F)
 單元生產: 20/03/23 (9/F-11/F)
 單元到貨: 27/03/23 (9/F-11/F)
 10/04/23 (12/F-17/F)
 21/05/23 (18/F-19/F)
 單元件安裝: 29/03/23 - 31/03/23 (9/F-11/F)
 14/04/23 - 18/04/23 (12/F-17/F)
 28/04/23 - 29/04/23 (18/F-19/F)
 防水片+試水+收口安裝: 09/05/2023 - 18/05/2023

T3B CW2 (9/F-19/F)
 單元生產: 20/03/23 (9/F-11/F)
 單元到貨: 29/03/23 (9/F-11/F)
 15/04/23 (12/F-17/F)
 21/05/23 (18/F-19/F)
 單元件安裝: 1/04/23 - 04/04/23 (9/F-11/F)
 19/04/23 - 22/04/23 (12/F-17/F)
 02/05/23 - 03/05/23 (18/F-19/F)
 防水片+試水+收口安裝: 15/05/2023 - 24/05/2023

T3A CW1 (11/F-19/F)
 單元生產: 20/03/23 (11/F)
 單元到貨: 27/03/23 (11/F)
 10/04/23 (12/F-17/F)
 21/05/23 (18/F-19/F)
 單元件安裝: 01/04/23 - 01/04/23 (11/F)
 19/04/23 - 22/04/23 (12/F-17/F)
 02/05/23 - 03/05/23 (18/F-19/F)
 防水片+試水+收口安裝: 15/05/2023 - 24/05/2023

T3A CW1 (9/F-19/F)
 單元生產: 20/03/23 (9/F-11/F)
 單元到貨: 27/03/23 (9/F-11/F)
 10/04/23 (12/F-17/F)
 21/05/23 (18/F-19/F)
 單元件安裝: 01/04/23 - 01/04/23 (9/F-11/F)
 19/04/23 - 22/04/23 (12/F-17/F)
 02/05/23 - 03/05/23 (18/F-19/F)
 防水片+試水+收口安裝: 15/05/2023 - 24/05/2023

T3A CW2 (9/F-19/F)
 單元生產: 20/03/23 (9/F-11/F)
 單元到貨: 27/03/23 (9/F-11/F)
 10/04/23 (12/F-17/F)
 21/05/23 (18/F-19/F)
 單元件安裝: 29/03/23 - 31/03/23 (9/F-11/F)
 14/04/23 - 18/04/23 (12/F-17/F)
 28/04/23 - 29/04/23 (18/F-19/F)
 防水片+試水+收口安裝: 09/05/2023 - 18/05/2023

數 查 共 合 Glass Cladding 件數

| | | | | | | | | | | |
|---------|---------|---------|---------|---------|---------|---------|---------|---------|---------|---------|
| 1 | 2 | 3 | 4 | 5 | 6 | 7 | 8 | 9 | 10 | 11 |
| T3A CW1 | T3A CW2 | T3A CW3 | T3A CW4 | T3A CW5 | T3A CW6 | T3B CW1 | T3B CW2 | T3B CW3 | T3B CW4 | T3B CW5 |
| 1 | 1 | 1 | 1 | 1 | 1 | 1 | 1 | 1 | 1 | 1 |

NOTE:
 1. ALL DIMENSIONS ARE IN METERS.
 2. ALL ELEVATIONS ARE WORKED FROM OUTSIDE.
 3. ALL DIMENSIONS TO BE VERIFIED ON SITE BEFORE FABRICATION.
LEGEND:
 (A) DETAIL MARK NO.
 (B) REFER SHEET NO.
 1. F.F.L. --- FINISHED FLOOR LEVEL
 2. S.F.L. --- STRUCTURAL FLOOR LEVEL
 3. --- REVERSED DETAIL

CLIENT: 信和置業有限公司
 Sino Land Company Limited

ARCHITECT: Ronald Lu & Partners
 Ronald Lu & Partners (HK) Ltd.
 呂宗賢建築師事務所 (香港) 有限公司

PROJECT: PROPOSED RESIDENTIAL DEVELOPMENT
 AT TKOOL 709P, PHASE 11, LOKAS PARK
 TSUNG KWAN O. N.T.

JOB NO.: J-858

DATE: 22-OCT-21
SCALE: 1:75(A1)

DRAWN BY: YB
CHECKED BY: YB

TITLE: TYPICAL FLOOR PLAN
 AT TOWER 3

REV.: C

PER COMMENTS

| | | |
|----|----------|-------------------------|
| IS | 20/03/23 | REVISED AS PER COMMENTS |
| LS | 10/04/23 | REVISED AS PER COMMENTS |
| LS | 18/04/23 | REVISED AS PER COMMENTS |
| IS | 26/04/23 | REVISED AS PER COMMENTS |

次序 1
T3A CW1
 單元生產: 20/03/23 (9/F-11/F)
 單元到貨: 27/03/23 (9/F-11/F)
 10/04/23 (12/F-17/F)
 21/05/23 (18/F-19/F)
 單元件安裝: 01/04/23 - 01/04/23 (9/F-11/F)
 19/04/23 - 22/04/23 (12/F-17/F)
 02/05/23 - 03/05/23 (18/F-19/F)
 防水片+試水+收口安裝: 15/05/2023 - 24/05/2023

次序 2
T3A CW2
 單元生產: 20/03/23 (9/F-11/F)
 單元到貨: 27/03/23 (9/F-11/F)
 10/04/23 (12/F-17/F)
 21/05/23 (18/F-19/F)
 單元件安裝: 01/04/23 - 01/04/23 (9/F-11/F)
 19/04/23 - 22/04/23 (12/F-17/F)
 02/05/23 - 03/05/23 (18/F-19/F)
 防水片+試水+收口安裝: 15/05/2023 - 24/05/2023

次序 3
T3A CW3
 單元生產: 20/03/23 (9/F-11/F)
 單元到貨: 27/03/23 (9/F-11/F)
 10/04/23 (12/F-17/F)
 21/05/23 (18/F-19/F)
 單元件安裝: 01/04/23 - 01/04/23 (9/F-11/F)
 19/04/23 - 22/04/23 (12/F-17/F)
 02/05/23 - 03/05/23 (18/F-19/F)
 防水片+試水+收口安裝: 15/05/2023 - 24/05/2023

次序 4
T3A CW4
 單元生產: 20/03/23 (9/F-11/F)
 單元到貨: 27/03/23 (9/F-11/F)
 10/04/23 (12/F-17/F)
 21/05/23 (18/F-19/F)
 單元件安裝: 01/04/23 - 01/04/23 (9/F-11/F)
 19/04/23 - 22/04/23 (12/F-17/F)
 02/05/23 - 03/05/23 (18/F-19/F)
 防水片+試水+收口安裝: 15/05/2023 - 24/05/2023

次序 5
T3A CW5
 單元生產: 20/03/23 (9/F-11/F)
 單元到貨: 27/03/23 (9/F-11/F)
 10/04/23 (12/F-17/F)
 21/05/23 (18/F-19/F)
 單元件安裝: 01/04/23 - 01/04/23 (9/F-11/F)
 19/04/23 - 22/04/23 (12/F-17/F)
 02/05/23 - 03/05/23 (18/F-19/F)
 防水片+試水+收口安裝: 15/05/2023 - 24/05/2023

次序 6
T3A CW6
 單元生產: 20/03/23 (11/F)
 單元到貨: 27/03/23 (11/F)
 10/04/23 (12/F-17/F)
 21/05/23 (18/F-19/F)
 單元件安裝: 01/04/23 - 01/04/23 (11/F)
 19/04/23 - 22/04/23 (12/F-17/F)
 02/05/23 - 03/05/23 (18/F-19/F)
 防水片+試水+收口安裝: 15/05/2023 - 24/05/2023

次序 7
T3B CW1
 單元生產: 20/03/23 (9/F-11/F)
 單元到貨: 29/03/23 (9/F-11/F)
 15/04/23 (12/F-17/F)
 21/05/23 (18/F-19/F)
 單元件安裝: 1/04/23 - 04/04/23 (9/F-11/F)
 19/04/23 - 22/04/23 (12/F-17/F)
 02/05/23 - 03/05/23 (18/F-19/F)
 防水片+試水+收口安裝: 15/05/2023 - 24/05/2023

次序 8
T3B CW2
 單元生產: 20/03/23 (9/F-11/F)
 單元到貨: 29/03/23 (9/F-11/F)
 15/04/23 (12/F-17/F)
 21/05/23 (18/F-19/F)
 單元件安裝: 1/04/23 - 04/04/23 (9/F-11/F)
 19/04/23 - 22/04/23 (12/F-17/F)
 02/05/23 - 03/05/23 (18/F-19/F)
 防水片+試水+收口安裝: 15/05/2023 - 24/05/2023

次序 9
T3B CW3
 單元生產: 20/03/23 (9/F-11/F)
 單元到貨: 29/03/23 (9/F-11/F)
 15/04/23 (12/F-17/F)
 21/05/23 (18/F-19/F)
 單元件安裝: 1/04/23 - 04/04/23 (9/F-11/F)
 19/04/23 - 22/04/23 (12/F-17/F)
 02/05/23 - 03/05/23 (18/F-19/F)
 防水片+試水+收口安裝: 15/05/2023 - 24/05/2023

次序 10
T3B CW4
 單元生產: 20/03/23 (9/F-11/F)
 單元到貨: 29/03/23 (9/F-11/F)
 15/04/23 (12/F-17/F)
 21/05/23 (18/F-19/F)
 單元件安裝: 1/04/23 - 04/04/23 (9/F-11/F)
 19/04/23 - 22/04/23 (12/F-17/F)
 02/05/23 - 03/05/23 (18/F-19/F)
 防水片+試水+收口安裝: 15/05/2023 - 24/05/2023

次序 11
T3B CW5
 單元生產: 20/03/23 (9/F-11/F)
 單元到貨: 29/03/23 (9/F-11/F)
 15/04/23 (12/F-17/F)
 21/05/23 (18/F-19/F)
 單元件安裝: 1/04/23 - 04/04/23 (9/F-11/F)
 19/04/23 - 22/04/23 (12/F-17/F)
 02/05/23 - 03/05/23 (18/F-19/F)
 防水片+試水+收口安裝: 15/05/2023 - 24/05/2023