

工程指示 / 要求簡箋(E.I.)

工程指示編號：EI / 4867 / 22

修改版次：-

工程編號：J - 858

工程名稱：將軍澳日出康城

工程項目：T1 幕牆單元件 廠用玻璃 BM

收件人：生統 / Maggie

發件人：Ant Yeung

日期：08/07/2022

要求提供 /  確認 事項：

- |                                    |                                     |                               |
|------------------------------------|-------------------------------------|-------------------------------|
| <input type="checkbox"/> 初步鋁料 B.M. | <input type="checkbox"/> 加工拆圖，然後生產  | <input type="checkbox"/> 尺寸表  |
| <input type="checkbox"/> 正式鋁料 B.M. | <input type="checkbox"/> 技術上資料 / 指示 | <input type="checkbox"/> 報價   |
| <input type="checkbox"/> 配件 B.M.   | <input type="checkbox"/> 樣辦或貨品說明書   | <input type="checkbox"/> 分判合約 |

內容：

請按玻璃 BM 生產玻璃送廠。

T1, 接板層+M01用

1. 附上玻璃出貨表，請按出貨表排期生產、熱浸、和包箱 首批出貨到廠 2022.09.01

見玻璃出貨表 Excel

預計熱浸約 2022.08.10

2. 不要印上熱浸標纖。只給"可移除"的標纖

3. 單片：標籤在室外面 (注明尺寸)、IGU: 標籤在室內面 (注明尺寸)

GL01a

4. 11/F 和 40/F 隔火層 請獨立包箱，廠留收貨 11/F, 40/F 的玻璃有不同，是反光片的 IGU

5. 首次出貨時：請提供各款玻璃的參照樣板 300x300 供王良收貨。

6. T1A- E 暫停，暫停了 4 款尺寸的玻璃。

謝謝

請在 2022. 09. 01 前完成上列要求。

附：

以上項目為：

- 原合約工程包                       原合約工程加 / 減賬                       新工程報價

原因：-

分發東莞各部門：

- |  |   |   |   |
|--|---|---|---|
| <input type="checkbox"/> 生產技術總監 <input type="checkbox"/> 連附件 | <input type="checkbox"/> 技術部 <input type="checkbox"/> 連附件                         | <input type="checkbox"/> 生產部 <input type="checkbox"/> 連附件               | <input type="checkbox"/> 機械設計部 <input type="checkbox"/> 連附件                   |
| <input type="checkbox"/> 採購部 <input type="checkbox"/> 連附件    | <input checked="" type="checkbox"/> 生產統籌部 <input checked="" type="checkbox"/> 連附件 | <input checked="" type="checkbox"/> 小羅 & 清 <input type="checkbox"/> 連附件 |   |
| <input type="checkbox"/> 質檢部 <input type="checkbox"/> 連附件    | <input type="checkbox"/> 會計部 <input type="checkbox"/> 連附件                         | <input type="checkbox"/> 報關組 <input type="checkbox"/> 連附件               | <input checked="" type="checkbox"/> 其他 <u>水洪</u> <input type="checkbox"/> 連附件 |

分發其他分判：

連附件 (檯)

分發香港各部門：

- |   |  |   |  |
|---|--|---|--|
| <input type="checkbox"/> 行政部 <input type="checkbox"/> 連附件                       | <input type="checkbox"/> 會計部 <input type="checkbox"/> 連附件  | <input type="checkbox"/> 統籌部 <input type="checkbox"/> 連附件 | <input type="checkbox"/> 工程部地盤科文 <input type="checkbox"/> 連附件  |
| <input checked="" type="checkbox"/> 採購部 <input checked="" type="checkbox"/> 連附件 | <input type="checkbox"/> QS 部 <input type="checkbox"/> 連附件 | <input type="checkbox"/> 維修部 <input type="checkbox"/> 連附件 | <input type="checkbox"/> 其他 _____ <input type="checkbox"/> 連附件 |




傳遞編號：

發件人簽署：R

HK 1124 / 22

項目經理簽署：[Signature]

 美特鋁質有限公司 MIDI Aluminium Fabricator Ltd.				工程號 J858 地盘 康城11期	類別 制圖 W. E. X	物料號 - 2022-05-12	圖號 J858-GL01
修改 - 日期 -	採用工廠 ✓ 材料颜色 -	地盤 - 图纸名称 玻璃加工图	材料 -	復核 - 批准 -	數量 - 單件重量 - (KG)		

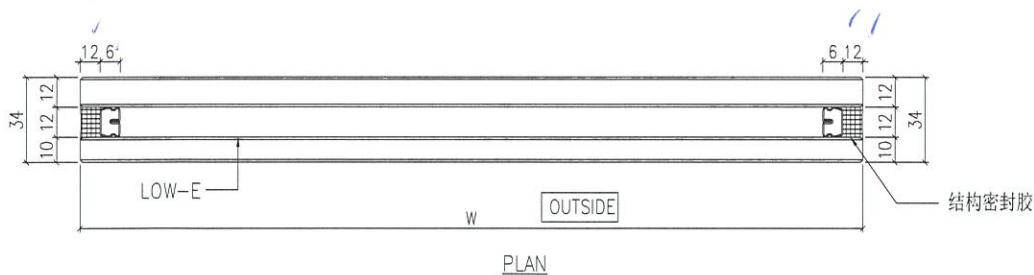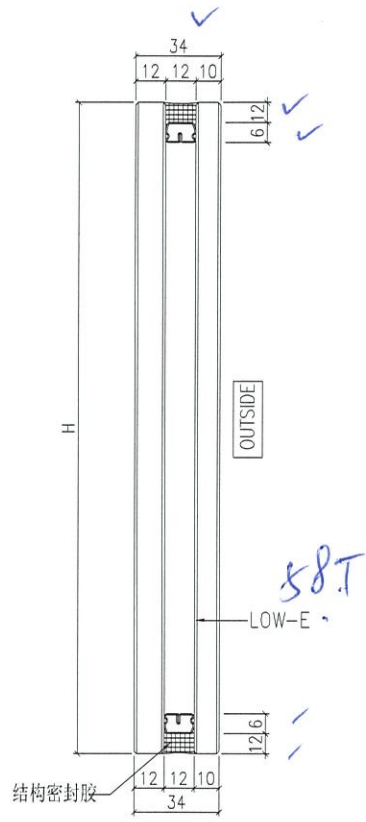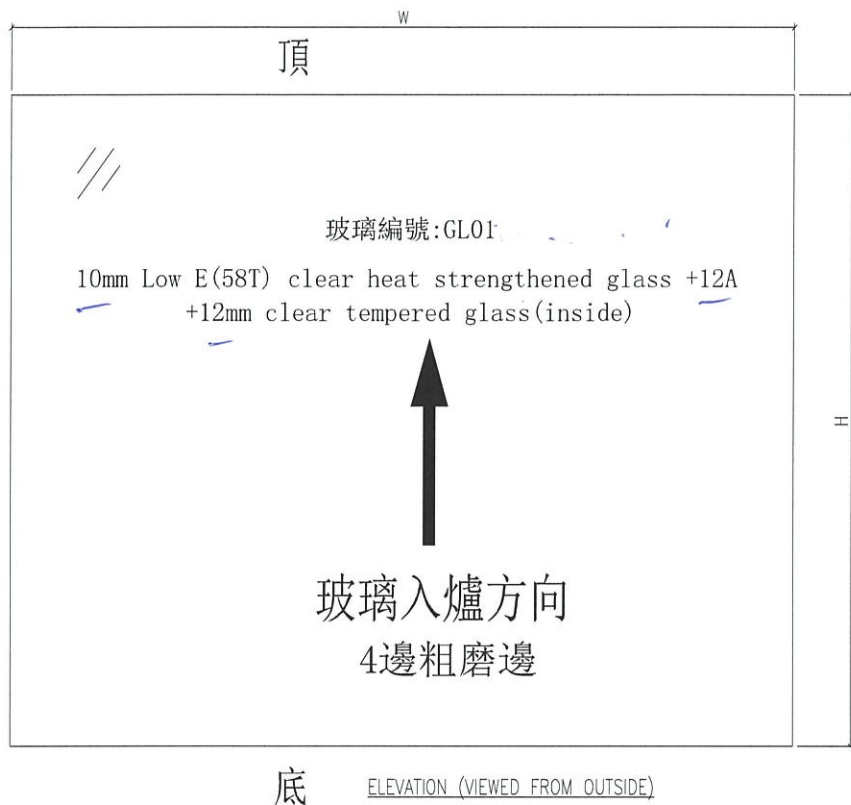




檢

生产厂编号: R20220114001

- NOTES
- ALL DIMENSION IN mm
  - ALL EDGE CHAMFER 1x1x45°

G1

 美特鋁質有限公司 MIDI Aluminium Fabricator Ltd.			工程號 J858	類別 W. E. X	物料號 -	
修改 - - - 採用工廠 <input checked="" type="checkbox"/> 地盤 -			地盘 康城11期	制圖 W. E. X	2022-05-12	圖號 J858-GL02
日期 - - - 材料颜色 -			图纸名称 玻璃加工图	復核 -	-	數量 -
			材料 -	批准 -	-	單件重量 - (KG)

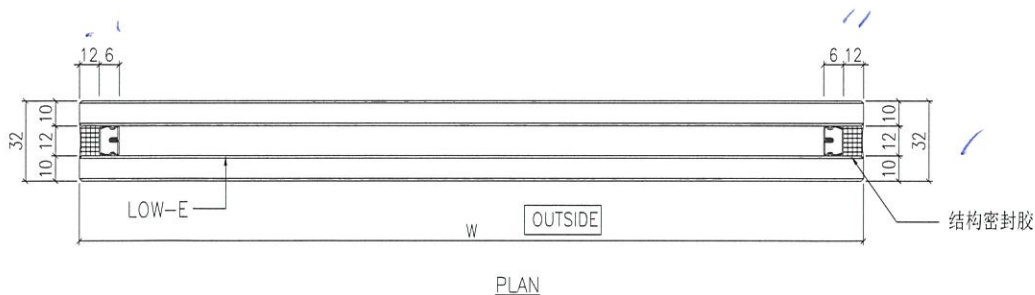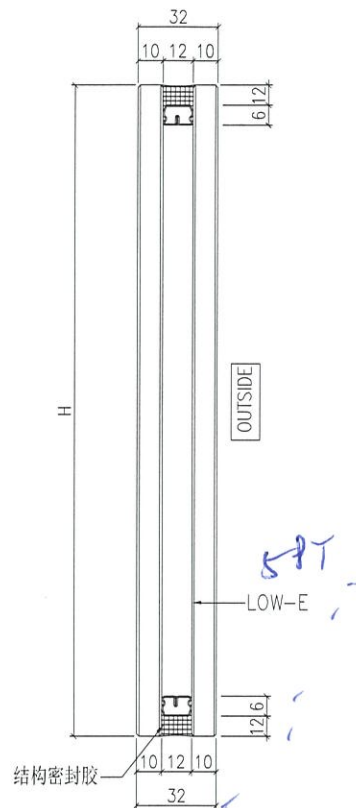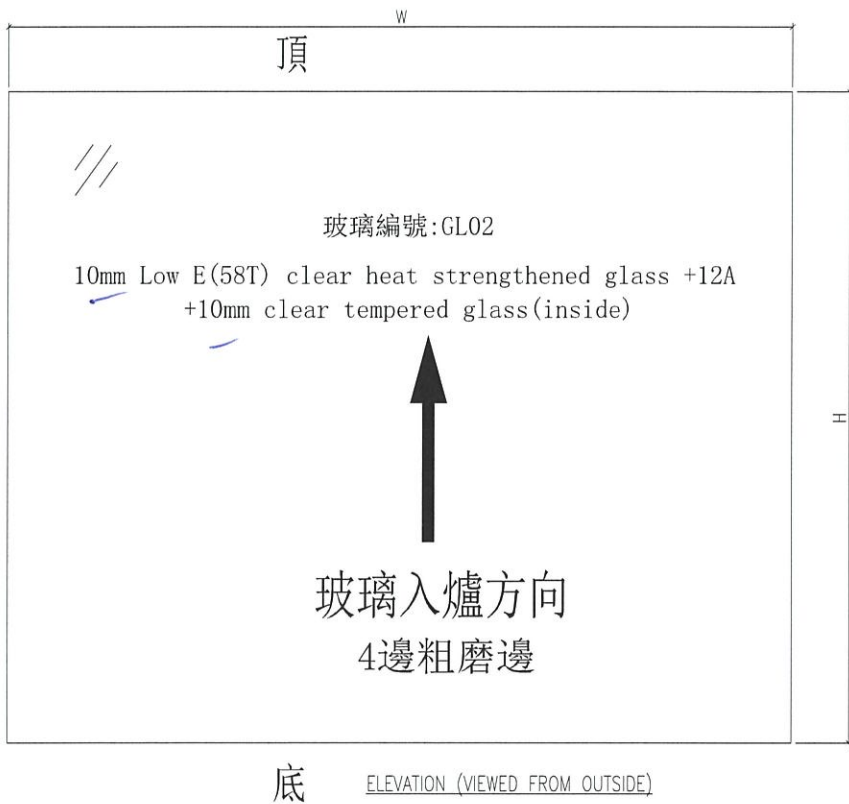


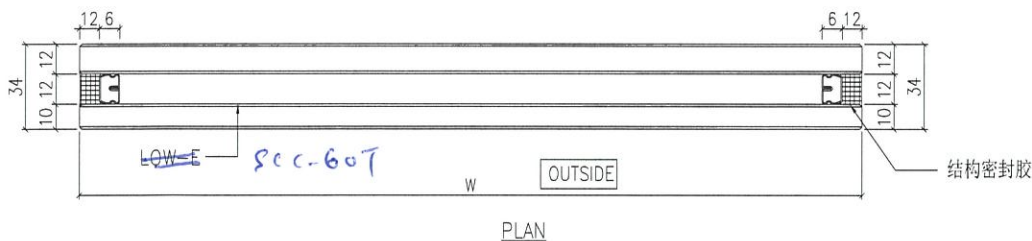
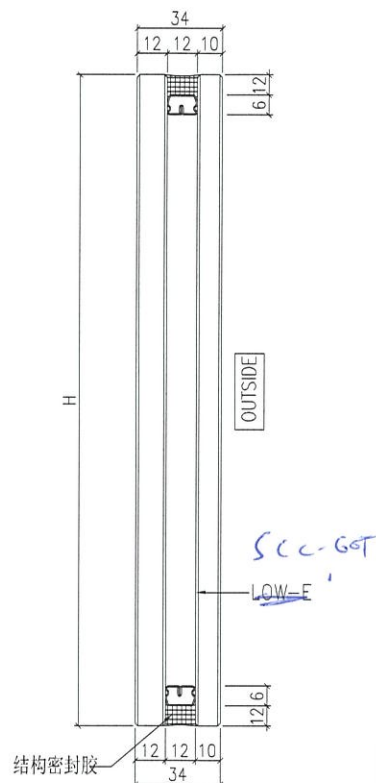
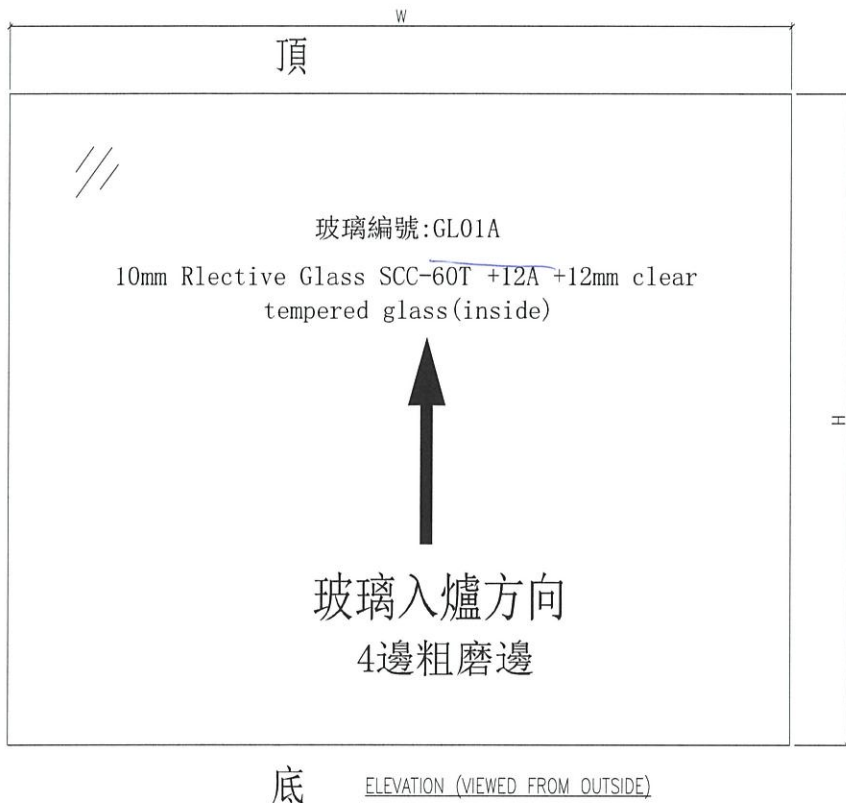
生产厂编号: R20220114003

NOTES

1. ALL DIMENSION IN mm
2. ALL EDGE CHAMFER 1x1x45°

G2

 美特鋁質有限公司 MIDI Aluminium Fabricator Ltd.			工程號 J858 地盘 康城11期	類別 制圖 W. E. X	物料號 - 2022-05-12	圖號 J858-GL01A
修改 - 日期 -	採用工廠 ✓ 材料颜色 -	地盤 - 图纸名称 玻璃加工图	復核 - 批准 -	數量 - 單件重量 - (KG)		



*1/2 200*


*1/2 40/F 用*



生产厂编号: R20220517050

NOTES

1. ALL DIMENSION IN mm
2. ALL EDGE CHAMFER 1x1x45°

GL01A. 

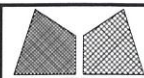 美特鋁質有限公司 MIDI Aluminium Fabricator Ltd.				工程號 J858	類別 制圖 W. E. X	物料號 - 2022-05-12	圖號 J858-GL03
修改 - 日期 -	採用工廠 ✓	地盤 -	圖紙名稱 玻璃加工圖	復核 -	數量 -	單件重量 -	(KG)

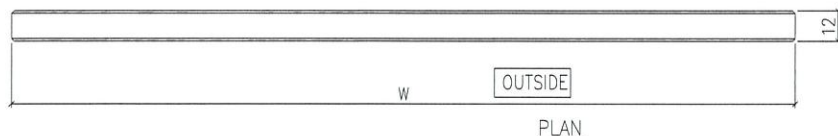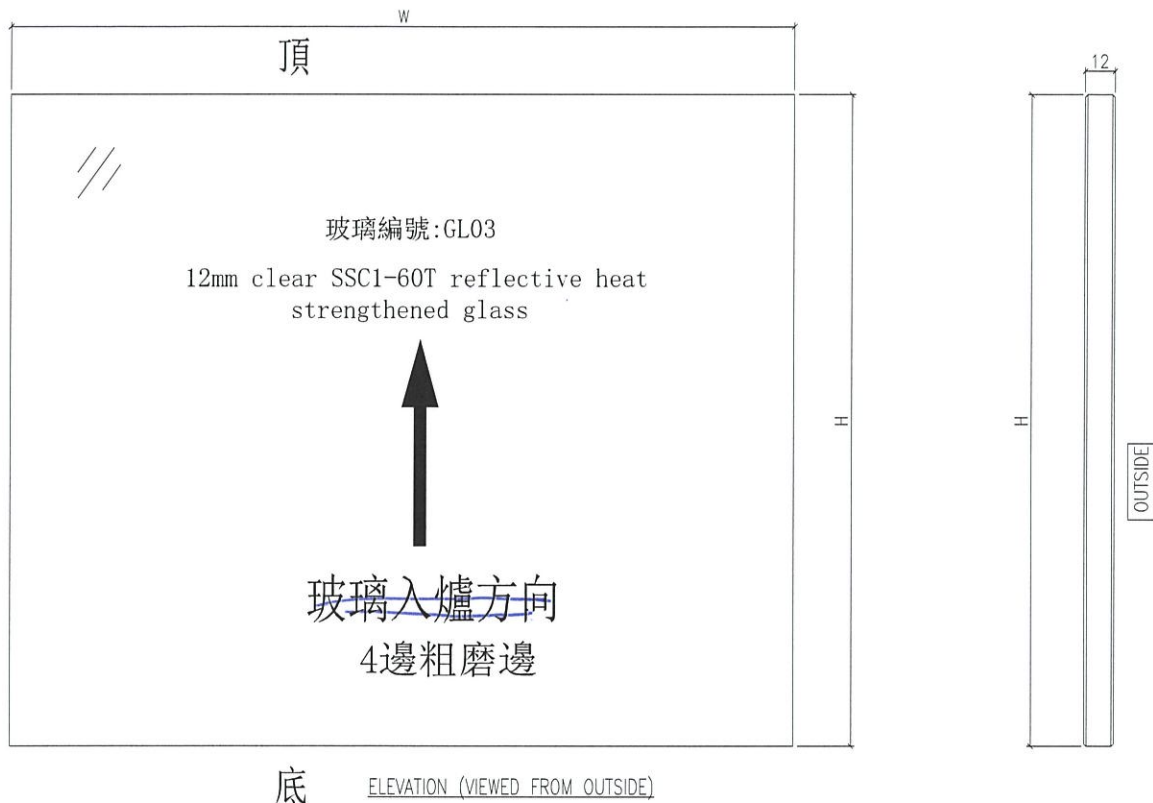


承詳

生产厂编号: R20220324054

NOTES



1. ALL DIMENSION IN mm
2. ALL EDGE CHAMFER 1x1x45°

G3

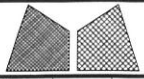


美特鋁質有限公司  
MIDI Aluminium Fabricator Ltd.

工程號	J858	類別		物料號	-							
地盘	康城11期	制圖	W. E. X	2022-05-12	圖號	J858-GL04						
修改	-	採用工廠	✓	地盤	-	圖紙名稱	玻璃加工圖	復核	-	-	數量	-
日期	-	材料顏色	-	材料	-	批准	-	-	-	單件重量	-	(KG)

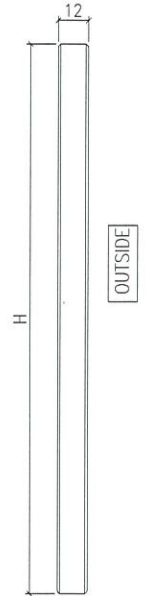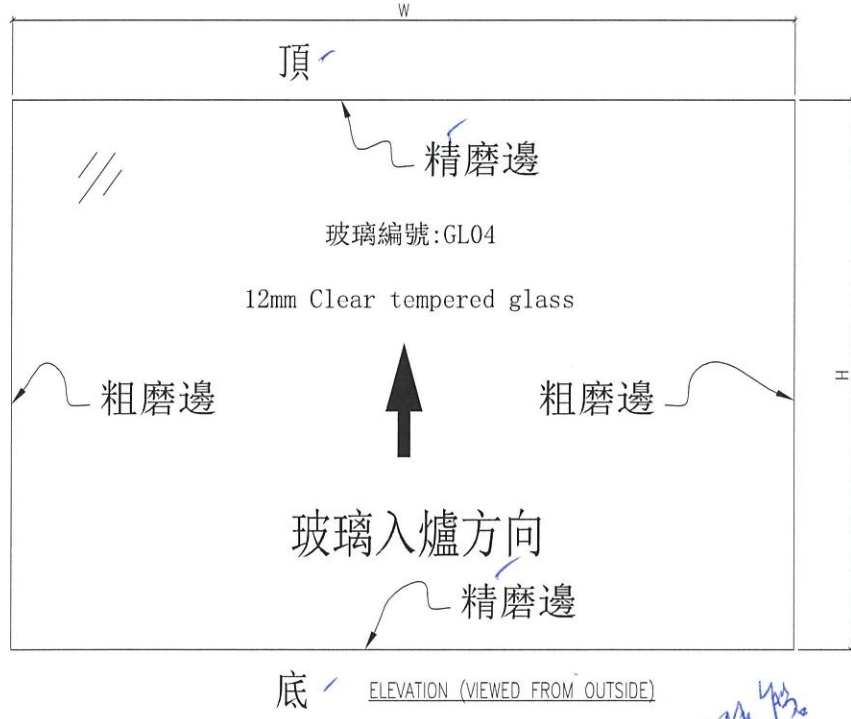

*頂視圖*

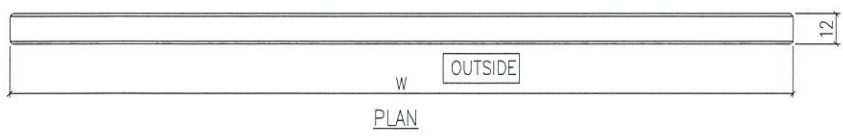

*縮相圖*

生产厂编号: R20220114008

NOTES

1. ALL DIMENSION IN mm
2. ALL EDGE CHAMFER 1x1x45°

G4.

J858康城11期单元幕墙玻璃分层统计表 (T1 单元幕墙)

訂

工程: J858康城 11期 (T1)

日期: 10-Jun-22

序号	玻璃编号	玻璃类型	玻璃尺寸			单面积 (m2)	分层数量				总数量	总面积	备注	
			W(mm)	x	H(mm)		9F(10.12~16.18~20.22~25.27~29.31~33.36~38.41~42.45~47.49~51.53~56.58~60F相同, 共34层)		11F	40F				17F(21.26.30.35.39.43.48.52.57F相同, 共10层)
1	GL01-01	GL01	628	x	832	0.52	34				10	44	23.0	送工厂
2	GL01-02	GL01	663	x	832	0.55	306				90	396	218.4	送工厂
3	GL01-03	GL01	644	x	832	0.54	476				140	616	330.1	送工厂
4	GL01-04	GL01	585.5	x	832	0.49	68				20	88	42.9	送工厂
5	GL01-05	GL01	678.5	x	832	0.56	136				40	176	99.4	送工厂
6	GL01-06	GL01	903	x	2332	2.11	34				10	44	92.7	送工厂
7	GL01-07	GL01A	903	x	2282	2.06			1	1		2	4.1	送工厂
8	GL01-08	GL01	1793	x	2332	4.18	34				10	44	184.0	送工厂
9	GL01-09	GL01A	1793	x	2282	4.09			1	1		2	8.2	送工厂
10	GL01-10	GL01	1525.5	x	2332	3.56	34				10	44	156.5	送工厂
11	GL01-11	GL01A	1525.5	x	2282	3.48			1	1		2	7.0	送工厂
12	GL01-12	GL01	663	x	2332	1.55	102				30	132	204.1	送工厂
13	GL01-13	GL01A	663	x	2282	1.51			8	8		16	24.2	送工厂
14	GL01-14	GL01	644	x	2332	1.50	238				70	308	462.6	送工厂
15	GL01-15	GL01	1272	x	2332	2.97	34				10	44	130.5	送工厂
16	GL01-16	GL01	1662	x	2332	3.88	34				10	44	170.5	送工厂
17	GL01-17	GL01	585.5	x	2332	1.37	68				20	88	120.2	送工厂
18	GL01-18	GL01A	644	x	2282	1.47			9	9		18	26.5	送工厂
19	GL01-19	GL01	1770	x	2332	4.13	68				20	88	363.2	送工厂
20	GL01-20	GL01A	1770	x	2282	4.04			2	2		4	16.2	送工厂
21	GL01-21	GL01	1594	x	2332	3.72	34				10	44	163.6	送工厂
22	GL01-23	GL01	1388	x	2332	3.24	34				10	44	142.4	送工厂
23	GL01-24	GL01	1751	x	2332	4.08	34				10	44	179.7	送工厂
24	GL01-25	GL01A	1388	x	2282	3.17			1	1		2	6.3	送工厂
25	GL01-26	GL01A	1751	x	2282	4.00			1	1		2	8.0	送工厂
26	GL01-27	GL01	1660	x	2332	3.87	34				10	44	170.3	送工厂
27	GL01-28	GL01A	1660	x	2282	3.79			1	1		2	7.6	送工厂
28	GL01-29	GL01	1544	x	2332	3.60	34				10	44	158.4	送工厂
29	GL01-49	GL01A	628	x	2282	1.43			1	1		2	2.9	送工厂
30	GL01-51	GL01A	678.5	x	2282	1.55			4	4		8	12.4	送工厂
31	GL01-52	GL01A	513	x	2282	1.17			1	1		2	2.3	送工厂
32	GL01-53	GL01	513	x	832	0.43	34				10	44	18.8	送工厂
暫停 33	GL01-54	GL01	798	x	2332	1.86	34				10	44	81.9	送工厂
暫停 34	GL01-55	GL01A	798	x	2282	1.82			1	1		2	3.6	送工厂
35	GL01-56	GL01A	976	x	2132	2.08			3	3		6	12.5	送工厂

2534 3654.72

1	GL02-01	GL02	628	x	1443	0.91	34				10	44	39.9	送工厂
2	GL02-03	GL02	663	x	1443	0.96	170				50	220	210.5	送工厂
3	GL02-05	GL02	636.5	x	1443	0.92	476				140	616	565.8	送工厂
4	GL02-07	GL02	585.5	x	1443	0.84	68				20	88	74.3	送工厂
5	GL02-08	GL02	660.5	x	1443	0.95	136				40	176	167.7	送工厂
6	GL02-12	GL02	655.5	x	1443	0.95	136				40	176	166.5	送工厂
7	GL02-15	GL02	513	x	1443	0.74	34				10	44	32.6	送工厂

1364 1257.269

1	GL03-01	GL03	628	x	578	0.36	34		1	1		10	46	16.7	送工厂
2	GL03-02	GL03	1603	x	843	1.35	34			1			35	47.3	送工厂
3	GL03-03	GL03	1603	x	578	0.93			1			10	11	10.2	送工厂
4	GL03-04	GL03	1793	x	843	1.51	34			1			35	52.9	送工厂
5	GL03-05	GL03	1793	x	578	1.04			1			10	11	11.4	送工厂
6	GL03-06	GL03	1525.5	x	843	1.29	34			1			35	45.0	送工厂
7	GL03-07	GL03	1525.5	x	578	0.88			1			10	11	9.7	送工厂
8	GL03-08	GL03	663	x	843	0.56	306		4	9		40	359	200.6	送工厂
9	GL03-09	GL03	663	x	578	0.38			2			20	22	8.4	送工厂
10	GL03-10	GL03	1363	x	578	0.79	34		1	1		10	46	36.2	送工厂
11	GL03-11	GL03	1325.5	x	843	1.12	204		4	6			254	283.8	送工厂
12	GL03-12	GL03	644	x	843	0.54	238		4	7		40	289	156.9	送工厂
13	GL03-13	GL03	1272	x	843	1.07	34		1	1		10	46	49.3	送工厂
14	GL03-14	GL03	1662	x	843	1.40	34		1	1		10	46	64.4	送工厂
15	GL03-15	GL03	1208	x	843	1.02	68		2	2		20	92	93.7	送工厂
16	GL03-17	GL03	1325.5	x	313	0.41			2			20	22	9.1	送工厂
17	GL03-18	GL03	644	x	313	0.20			2			20	22	4.4	送工厂
18	GL03-19	GL03	1770	x	843	1.49	68			2			70	104.4	送工厂
19	GL03-20	GL03	1770	x	313	0.55			1			10	11	6.1	送工厂
20	GL03-21	GL03	678.5	x	843	0.57	136			4			140	80.1	送工厂

J858康城11期单元幕墙玻璃分层统计表 (T1 单元幕墙)

工程: J858康城11期 (T1)														
日期: 10-Jun-22														
序号	玻璃编号	玻璃类型	玻璃尺寸			单面积 (m <sup>2</sup> )	分层数量				总数量	总面积	备注	
			W(mm)	x	H(mm)		9F(10,12~16,18~20,22~25,27~29,31~33,36~38,41~42,45~47,49~51,53~56,58~60F相同, 共34层)	11F	40F	17F(21,26,30,35,39,43,48,52,57F相同, 共10层)				
21	GL03-22	GL03	678.5	x	313	0.21			3		30	33	7.0	送工厂
22	GL03-23	GL03	678.5	x	578	0.39			1		10	11	4.3	送工厂
23	GL03-24	GL03	1770	x	578	1.02			1		10	11	11.3	送工厂
24	GL03-25	GL03	644	x	578	0.37			1		10	11	4.1	送工厂
25	GL03-27	GL03	1325.5	x	578	0.77	34		1	1	10	46	35.2	送工厂
26	GL03-28	GL03	1594	x	843	1.34	34		1	1	10	46	61.8	送工厂
27	GL03-29	GL03	663	x	313	0.21			3		30	33	6.8	送工厂
28	GL03-32	GL03	1388	x	843	1.17	34			1		35	41.0	送工厂
29	GL03-33	GL03	1751	x	843	1.48	34			1		35	51.7	送工厂
30	GL03-34	GL03	1388	x	313	0.43			1		10	11	4.8	送工厂
31	GL03-35	GL03	1751	x	313	0.55			1		10	11	6.0	送工厂
暂停	32	GL03-36	GL03	1348	x	843	1.14	34		1		35	39.8	送工厂
暂停	33	GL03-37	GL03	1348	x	313	0.42		1		10	11	4.6	送工厂
34	GL03-38	GL03	1660	x	843	1.40	34			1		35	49.0	送工厂
35	GL03-39	GL03	1660	x	313	0.52			1		10	11	5.7	送工厂
36	GL03-40	GL03	1544	x	843	1.30	34		1	1	10	46	59.9	送工厂
37	GL03-89	GL03	1325.5	x	519.5	0.69			4	4		8	5.5	送工厂
38	GL03-90	GL03	644	x	519.5	0.33			4	4		8	2.7	送工厂
39	GL03-91	GL03	1272	x	519.5	0.66			1	1		2	1.3	送工厂
40	GL03-92	GL03	1662	x	519.5	0.86			1	1		2	1.7	送工厂
41	GL03-93	GL03	1208	x	519.5	0.63			2	2		4	2.5	送工厂
42	GL03-94	GL03	1594	x	519.5	0.83			1	1		2	1.7	送工厂
43	GL03-95	GL03	663	x	519.5	0.34			4	4		8	2.8	送工厂
44	GL03-96	GL03	1544	x	519.5	0.80			1	1		2	1.6	送工厂
45	GL03-101	GL03	970	x	519.5	0.50			3	3		6	3.0	送工厂
46	GL03-102	GL03	986	x	519.5	0.51			3	3		6	3.1	送工厂
47	GL03-103	GL03	975	x	519.5	0.51			18	18		36	18.2	送工厂
48	GL03-104	GL03	948	x	519.5	0.49			6	6		12	5.9	送工厂
49	GL03-105	GL03	966	x	519.5	0.50			6	6		12	6.0	送工厂
50	GL03-106	GL03	1325.5	x	308	0.41			4	4		8	3.3	送工厂
51	GL03-107	GL03	644	x	308	0.20			4	4		8	1.6	送工厂
52	GL03-108	GL03	1272	x	308	0.39			1	1		2	0.8	送工厂
53	GL03-109	GL03	1662	x	308	0.51			1	1		2	1.0	送工厂
54	GL03-110	GL03	1208	x	308	0.37			2	2		4	1.5	送工厂
55	GL03-111	GL03	663	x	308	0.20			4	4		8	1.6	送工厂
56	GL03-112	GL03	1594	x	308	0.49			1	1		2	1.0	送工厂
57	GL03-113	GL03	1544	x	308	0.48			1	1		2	1.0	送工厂
											2168	1751.588		

1	GL04-01	GL04	545	x	145	0.08	34				10	44	3.5	送工厂
2	GL04-02	GL04	580	x	145	0.08	306				90	396	33.3	送工厂
3	GL04-03	GL04	561	x	145	0.08	476				140	616	50.1	送工厂
4	GL04-04	GL04	502.5	x	145	0.07	68				20	88	6.4	送工厂
5	GL04-05	GL04	474	x	145	0.07	136				40	176	12.1	送工厂
6	GL04-08	GL04	430	x	145	0.06	34				10	44	2.7	送工厂
											1364	108.1		
						总数量	5508		151	151	1620	7430	6771.7	

注: 玻璃类型

7430 6771.718

1	GL01	10mm THK. HEAT STRENGTHEN GLASS (OUTSIDE) W/ LOW-E COATING ON SURFACE 58T #2 + 12 mm AIR SPACE + 12mm THK. CLEAR TEMPERED GLASS(INSIDE) R20220114001											
2	GL02	10mm THK. HEAT STRENGTHEN GLASS (OUTSIDE) W/ LOW-E COATING ON SURFACE 58T #2 + 12 mm AIR SPACE + 10mm THK. CLEAR TEMPERED GLASS(INSIDE) R20220114003											
3	GL03	12mm THK. HEAT STRENGTHEN GLASS .Reflective Glass SSC1-60T (R20220324054)											
4	GL04	12mm THK.CLEAR TEMPERED GLASS (R20220114008)											
5	GL01A	10mm THK.Reflective Glass SSC1-60T HEAT STRENGTHEN GLASS (OUTSIDE) + 12 mm AIR SPACE + 12mm THK. CLEAR TEMPERED GLASS(INSIDE) IGU R20220517050											

J858康城1	MO 1							MO 2				MO 3				MO 4				MO 5			
10-Jun-22	1	2	3	4	5	6	7	1	2	3	4	1	2	3	4	1	2	3	4	1	2	3	4
玻璃编号	9	10	11	12	15	16	17	18	19	20	21	22	23	25	26	27	28	29	30	31	32	33	35
GL01-01	1	1	0	1	1	1	1	1	1	1	1	1	1	1	1	1	1	1	1	1	1	1	1
GL01-02	9	9	0	9	9	9	9	9	9	9	9	9	9	9	9	9	9	9	9	9	9	9	9
GL01-03	14	14	0	14	14	14	14	14	14	14	14	14	14	14	14	14	14	14	14	14	14	14	14
GL01-04	2	2	0	2	2	2	2	2	2	2	2	2	2	2	2	2	2	2	2	2	2	2	2
GL01-05	4	4	0	4	4	4	4	4	4	4	4	4	4	4	4	4	4	4	4	4	4	4	4
GL01-06	1	1	0	1	1	1	1	1	1	1	1	1	1	1	1	1	1	1	1	1	1	1	1
GL01-07	0	0	1	0	0	0	0	0	0	0	0	0	0	0	0	0	0	0	0	0	0	0	0
GL01-08	1	1	0	1	1	1	1	1	1	1	1	1	1	1	1	1	1	1	1	1	1	1	1
GL01-09	0	0	1	0	0	0	0	0	0	0	0	0	0	0	0	0	0	0	0	0	0	0	0
GL01-10	1	1	0	1	1	1	1	1	1	1	1	1	1	1	1	1	1	1	1	1	1	1	1
GL01-11	0	0	1	0	0	0	0	0	0	0	0	0	0	0	0	0	0	0	0	0	0	0	0
GL01-12	3	3	0	3	3	3	3	3	3	3	3	3	3	3	3	3	3	3	3	3	3	3	3
GL01-13	0	0	8	0	0	0	0	0	0	0	0	0	0	0	0	0	0	0	0	0	0	0	0
GL01-14	7	7	0	7	7	7	7	7	7	7	7	7	7	7	7	7	7	7	7	7	7	7	7
GL01-15	1	1	0	1	1	1	1	1	1	1	1	1	1	1	1	1	1	1	1	1	1	1	1
GL01-16	1	1	0	1	1	1	1	1	1	1	1	1	1	1	1	1	1	1	1	1	1	1	1
GL01-17	2	2	0	2	2	2	2	2	2	2	2	2	2	2	2	2	2	2	2	2	2	2	2
GL01-18	0	0	9	0	0	0	0	0	0	0	0	0	0	0	0	0	0	0	0	0	0	0	0
GL01-19	2	2	0	2	2	2	2	2	2	2	2	2	2	2	2	2	2	2	2	2	2	2	2
GL01-20	0	0	2	0	0	0	0	0	0	0	0	0	0	0	0	0	0	0	0	0	0	0	0
GL01-21	1	1	0	1	1	1	1	1	1	1	1	1	1	1	1	1	1	1	1	1	1	1	1
GL03-10	1	1	1	1	1	1	1	1	1	1	1	1	1	1	1	1	1	1	1	1	1	1	1
GL03-11	6	6	4	6	6	6	4	6	6	6	4	6	6	6	4	6	6	6	4	6	6	6	4
GL03-12	7	7	4	7	7	7	4	7	7	7	4	7	7	7	4	7	7	7	4	7	7	7	4
GL03-13	1	1	1	1	1	1	1	1	1	1	1	1	1	1	1	1	1	1	1	1	1	1	1
GL03-14	1	1	1	1	1	1	1	1	1	1	1	1	1	1	1	1	1	1	1	1	1	1	1
GL03-15	2	2	2	2	2	2	2	2	2	2	2	2	2	2	2	2	2	2	2	2	2	2	2
GL03-17	0	0	2	0	0	0	2	0	0	0	2	0	0	0	2	0	0	0	2	0	0	0	2
GL03-18	0	0	2	0	0	0	2	0	0	0	2	0	0	0	2	0	0	0	2	0	0	0	2
GL03-19	2	2	0	2	2	2	0	2	2	2	0	2	2	2	0	2	2	2	0	2	2	2	0
GL03-20	0	0	1	0	0	0	1	0	0	0	1	0	0	0	1	0	0	0	1	0	0	0	1
GL03-21	4	4	0	4	4	4	0	4	4	4	0	4	4	4	0	4	4	4	0	4	4	4	0

出有期方属表  
 是月是excel  
 4页





J858康城11		MO6				M07 +40/f				MO 8				MO 9				MO 10				MO 11					
10-Jun-22		1	2	3	4	1	2	3	4	1	2	3	4	1	2	3	4	1	2	3	4	1	2	3	4	1	2
玻璃编号		36	37	38	39	40	41	42	43	45	46	47	48	49	50	51	52	53	55	56	57	58	59	60			
GL03-22		0	0	0	3	0	0	0	3	0	0	0	3	0	0	0	3	0	0	0	3	0	0	0	0		
GL03-23		0	0	0	1	0	0	0	1	0	0	0	1	0	0	0	1	0	0	0	1	0	0	0	0		
GL03-24		0	0	0	1	0	0	0	1	0	0	0	1	0	0	0	1	0	0	0	1	0	0	0	0		
GL03-25		0	0	0	1	0	0	0	1	0	0	0	1	0	0	0	1	0	0	0	1	0	0	0	0		
GL03-27		1	1	1	1	1	1	1	1	1	1	1	1	1	1	1	1	1	1	1	1	1	1	1	1		
GL03-28		1	1	1	1	1	1	1	1	1	1	1	1	1	1	1	1	1	1	1	1	1	1	1	1		
GL03-29		0	0	0	3	0	0	0	3	0	0	0	3	0	0	0	3	0	0	0	3	0	0	0	0		
GL03-32		1	1	1	0	1	1	1	0	1	1	1	0	1	1	1	0	1	1	1	0	1	1	1	1		
GL03-33		1	1	1	0	1	1	1	0	1	1	1	0	1	1	1	0	1	1	1	0	1	1	1	1		
GL03-34		0	0	0	1	0	0	0	1	0	0	0	1	0	0	0	1	0	0	0	1	0	0	0	0		
GL03-35		0	0	0	1	0	0	0	1	0	0	0	1	0	0	0	1	0	0	0	1	0	0	0	0		
GL03-36		1	1	1	0	1	1	1	0	1	1	1	0	1	1	1	0	1	1	1	0	1	1	1	1		
GL03-37		0	0	0	1	0	0	0	1	0	0	0	1	0	0	0	1	0	0	0	1	0	0	0	0		
GL03-38		1	1	1	0	1	1	1	0	1	1	1	0	1	1	1	0	1	1	1	0	1	1	1	1		
GL04-08		1	1	1	1	0	1	1	1	1	1	1	1	1	1	1	1	1	1	1	1	1	1	1	1		
		162	162	162	162	151	162	162	162	162	162	162	162	162	162	162	162	162	162	162	162	162	162	162	162		
		1	2	3	4		1	2	3	4	1	2	3	4	1	2	3	4	1	2	3	4	1	2			
					648	151			648				648				648				648				324		
					01/04				15/04				29/04				13/05				27/05				10/06		

J858康城11期单元幕墙玻璃分层统计表 (T1 单元幕墙)

工程: J858

日期:

大程 隔墙工程

序号	玻璃编号	玻璃类型	中线尺寸			玻璃尺寸			单面积 (m2)	分层数量				总数量	备注
			W(mm)	x	H(mm)	W(mm)	x	H(mm)		9F(10.12~16.18~20.22~25.27~29.31~33.36~38.41~42.45~47.49~51.53~56.58~60F相同, 共54层)	11F	40F	17F(21.26.30.35.39.43.48.52.57F相同, 共10层)		
1	GL01-01	GL01	665	x	895	628	x	833	0.52	34			10	44	送工厂
2	GL01-02	GL01	700	x	895	663	x	833	0.55	306			90	396	送工厂
3	GL01-03	GL01	681	x	895	644	x	833	0.54	476			140	616	送工厂
4	GL01-04	GL01	622.5	x	895	585.5	x	833	0.49	68			20	88	送工厂
5	GL01-05	GL01	765	x	895	678.5	x	833	0.57	136			40	176	送工厂
6	GL01-06	GL01	940	x	2395	903	x	2333	2.11	34			10	44	送工厂
7	GL01-07	GL01	940	x	2345	903	x	2283	2.06					2	送工厂
8	GL01-08	GL01	1830	x	2395	1793	x	2333	4.18	34			10	44	送工厂
9	GL01-09	GL01	1830	x	2345	1793	x	2283	4.09		1			2	送工厂
10	GL01-10	GL01	1562.5	x	2395	1525.5	x	2333	3.56	34			10	44	送工厂
11	GL01-11	GL01	1562.5	x	2345	1525.5	x	2283	3.48		1			2	送工厂
12	GL01-12	GL01	700	x	2395	663	x	2333	1.55	102			50	132	送工厂
13	GL01-13	GL01	700	x	2345	663	x	2283	1.51		8			16	送工厂
14	GL01-14	GL01	681	x	2395	644	x	2333	1.50	238			70	308	送工厂
15	GL01-15	GL01	1309	x	2395	1272	x	2333	2.97	34			10	44	送工厂
16	GL01-16	GL01	1699	x	2395	1662	x	2333	3.88	34			10	44	送工厂
17	GL01-17	GL01	622.5	x	2395	585.5	x	2333	1.37	68			20	88	送工厂
18	GL01-18	GL01	681	x	2345	644	x	2283	1.47		9			18	送工厂
19	GL01-19	GL01	1856.5	x	2395	1770	x	2333	4.13	68			20	88	送工厂
20	GL01-20	GL01	1856.5	x	2345	1770	x	2283	4.04		2			4	送工厂
21	GL01-21	GL01	1631	x	2395	1594	x	2333	3.72	34			10	44	送工厂
22	GL01-23	GL01	1425	x	2395	1388	x	2333	3.24	34			10	44	送工厂
23	GL01-24	GL01	1837.5	x	2395	1751	x	2333	4.09	34			10	44	送工厂
24	GL01-25	GL01	1425	x	2345	1388	x	2283	3.17		1	1		2	送工厂
25	GL01-26	GL01	1837.5	x	2345	1751	x	2283	4.00		1	1		2	送工厂
26	GL01-27	GL01	1746.5	x	2395	1660	x	2333	3.87	34			10	44	送工厂
27	GL01-28	GL01	1746.5	x	2345	1660	x	2283	3.79		1			2	送工厂
28	GL01-29	GL01	1581	x	2395	1544	x	2333	3.60	34			10	44	送工厂
29	GL01-50	GL01	665	x	2345	628	x	2283	1.43		1			2	送工厂
30	GL01-51	GL01	765	x	2345	678.5	x	2283	1.55		4	4		8	送工厂
31	GL01-52	GL01	550	x	2345	513	x	2283	1.17		1			2	送工厂
32	GL01-53	GL01	550	x	895	513	x	833	0.43	34			10	44	送工厂
33	GL01-54	GL01	835	x	2395	798	x	2333	1.86	34			10	44	送工厂
34	GL01-55	GL01	835	x	2345	798	x	2283	1.82		1			2	送工厂
35	GL01-56	GL01	1013	x	2195	976	x	2133	2.08		3	3		6	送工厂

Handwritten notes in red ink: "Check it", "24号", "32号", "PE113", "PE107", "水工".

1	GL02-01	GL02	665	x	1500	628	x	1443	0.91	34			10	44	送工厂
2	GL02-03	GL02	700	x	1500	663	x	1443	0.96	170			50	220	送工厂
3	GL02-05	GL02	681	x	1500	636.5	x	1443	0.92	476			140	616	送工厂
4	GL02-07	GL02	622.5	x	1500	585.5	x	1443	0.84	68			20	88	送工厂
5	GL02-08	GL02	765	x	1500	660.5	x	1443	0.95	136			40	176	送工厂
6	GL02-12	GL02	700	x	1500	655.5	x	1443	0.95	136			40	176	送工厂
7	GL02-15	GL02	550	x	1500	513	x	1443	0.74	34			10	44	送工厂

1	GL03-01	GL03	665	x	905	628	x	578	0.36	34	1	1	10	46	送工厂
2	GL03-02	GL03	1640	x	905	1603	x	843	1.35	34		1		35	送工厂
3	GL03-03	GL03	1640	x	905	1603	x	578	0.93			1		11	送工厂
4	GL03-04	GL03	1830	x	905	1793	x	843	1.51	34		1		35	送工厂
5	GL03-05	GL03	1830	x	905	1793	x	578	1.04		1		10	11	送工厂
6	GL03-06	GL03	1562.5	x	905	1525.5	x	843	1.29	34		1		35	送工厂
7	GL03-07	GL03	1562.5	x	905	1525.5	x	578	0.88				10	11	送工厂
8	GL03-08	GL03	700	x	905	663	x	843	0.56	306	4	9	40	359	送工厂
9	GL03-09	GL03	700	x	905	663	x	578	0.38		2		20	22	送工厂
10	GL03-10	GL03	1400	x	905	1363	x	578	0.79	34	1	1	10	46	送工厂
11	GL03-11	GL03	1362.5	x	905	1325.5	x	843	1.12	204	4	6	40	254	送工厂
12	GL03-12	GL03	681	x	905	644	x	843	0.54	238	4	7	40	289	送工厂
13	GL03-13	GL03	1309	x	905	1272	x	843	1.07	34	1	1	10	46	送工厂
14	GL03-14	GL03	1699	x	905	1662	x	843	1.40	34	1	1	10	46	送工厂
15	GL03-15	GL03	1245	x	905	1208	x	843	1.02	68	2	2	20	92	送工厂
16	GL03-17	GL03	1362.5	x	905	1325.5	x	843	0.41		2		20	22	送工厂
17	GL03-18	GL03	681	x	905	644	x	843	0.20		2		20	22	送工厂
18	GL03-19	GL03	1856.5	x	905	1770	x	843	1.49	1/268		2		70	送工厂
19	GL03-20	GL03	1856.5	x	905	1770	x	843	0.55		1		10	11	送工厂

Handwritten notes in blue ink: "843 feature", "578 = feature", "343 72 feature", "1364".





J858康城11期单元幕墙玻璃分层统计表 (T1 单元幕墙)



工程: J858康城11期 (T1)

日期: 10-Jun-22

序号	玻璃编号	玻璃类型	中线尺寸				玻璃尺寸				单面积 (m2)	分层数量				总数量	备注						
			W(mm)	x	H(mm)		W(mm)	x	H(mm)			9F(10,12,16,18,20,22,25,27,29,31,33,36,38,41,42,45,47,49,51,53,56,58,60F相同,共34层)	11F	40F	17F(21,26,30,35,39,43,48,52,57F相同,共10层)								
24	GL03-25	GL03	681	x	905	18.5	18.5	33.5	293.5	644	x	578	0.37			1		10	11	送工厂			
25	<del>GL03-26</del>	GL03	1362.5	x	905	18.5	18.5	<del>298.5</del>	<del>28.5</del>	1325.5	x	578	0.77						0	送工厂			
26	GL03-27	GL03	1362.5	x	905	18.5	18.5	33.5	293.5	1325.5	x	578	0.77	34		1	1	10	46	送工厂			
27	GL03-28	GL03	1631	x	905	18.5	18.5	33.5	28.5	1594	x	843	1.34	34		1	1	10	46	送工厂			
28	GL03-29	GL03	700	x	905	18.5	18.5	298.5	293.5	663	x	313	0.21			3		30	33	送工厂			
29	<del>GL03-30</del>	GL03	<del>837.5</del>	x	905	18.5	18.5	33.5	28.5	800.5	x	843	0.67						0	送工厂			
30	<del>GL03-31</del>	GL03	<del>837.5</del>	x	905	18.5	18.5	298.5	293.5	800.5	x	313	0.25						0	送工厂			
31	GL03-32	GL03	1425	x	905	18.5	18.5	33.5	28.5	1388	x	843	1.17	34			1		35	送工厂			
32	GL03-33	GL03	1837.5	x	905	68	18.5	33.5	28.5	1751	x	843	1.48	34			1		35	送工厂			
33	GL03-34	GL03	1425	x	905	18.5	18.5	298.5	293.5	1388	x	313	0.43			1		10	11	送工厂			
34	GL03-35	GL03	1837.5	x	905	68	18.5	298.5	293.5	1751	x	313	0.55			1		10	11	送工厂			
35	GL03-36	GL03	1385	x	905	18.5	18.5	33.5	28.5	1348	x	843	1.14	34			1		35	送工厂			
36	GL03-37	GL03	1385	x	905	18.5	18.5	298.5	293.5	1348	x	313	0.42			1		10	11	送工厂			
37	GL03-38	GL03	1746	x	905	68	18.5	33.5	28.5	1659.5	x	843	1.40	34			1		35	送工厂			
38	GL03-39	GL03	1746	x	905	68	18.5	298.5	293.5	1659.5	x	313	0.52			1		10	11	送工厂			
39	GL03-40	GL03	1581	x	905	18.5	18.5	33.5	28.5	1544	x	843	1.30	34			1	1	10	46	送工厂		
40	GL03-89	GL03	1362.5	x	582.5	18.5	18.5	33.5	28.5	1325.5	x	520.5	0.69			4	4		8	送工厂			
41	GL03-90	GL03	681	x	582.5	18.5	18.5	33.5	28.5	644	x	520.5	0.34			4	4		8	送工厂			
42	GL03-91	GL03	1309	x	582.5	18.5	18.5	33.5	28.5	1272	x	520.5	0.66			1	1		2	送工厂			
43	GL03-92	GL03	1699	x	582.5	18.5	18.5	33.5	28.5	1662	x	520.5	0.87			1	1		2	送工厂			
44	GL03-93	GL03	1245	x	582.5	18.5	18.5	33.5	28.5	1208	x	520.5	0.63			2	2		4	送工厂			
45	GL03-94	GL03	1631	x	582.5	18.5	18.5	33.5	28.5	1594	x	520.5	0.83			1	1		2	送工厂			
46	GL03-95	GL03	700	x	582.5	18.5	18.5	33.5	28.5	663	x	520.5	0.35			4	4		8	送工厂			
47	GL03-96	GL03	1581	x	582.5	18.5	18.5	33.5	28.5	1544	x	520.5	0.80			1	1		2	送工厂			
48	GL03-101	GL03	1007	x	582.5	18.5	18.5	28.5	33.5	970	x	520.5	0.50			3	3		6	送工厂			
49	GL03-102	GL03	1023	x	582.5	18.5	18.5	28.5	33.5	986	x	520.5	0.51			3	3		6	送工厂			
50	GL03-103	GL03	1012	x	582.5	18.5	18.5	28.5	33.5	975	x	520.5	0.51			18	18		36	送工厂			
51	GL03-104	GL03	985	x	582.5	18.5	18.5	28.5	33.5	948	x	520.5	0.49			6	6		12	送工厂			
52	GL03-105	GL03	1003	x	582.5	18.5	18.5	28.5	33.5	966	x	520.5	0.50			6	6		12	送工厂			
53	GL03-106	GL03	1362.5	x	365	18.5	18.5	28.5	28.5	1325.5	x	308	0.41			4	4		8	送工厂			
54	GL03-107	GL03	681	x	365	18.5	18.5	28.5	28.5	644	x	308	0.20			4	4		8	送工厂			
55	GL03-108	GL03	1309	x	365	18.5	18.5	28.5	28.5	1272	x	308	0.39			1	1		2	送工厂			
56	GL03-109	GL03	1699	x	365	18.5	18.5	28.5	28.5	1662	x	308	0.51			1	1		2	送工厂			
57	GL03-110	GL03	1245	x	365	18.5	18.5	28.5	28.5	1208	x	308	0.37			2	2		4	送工厂			
58	GL03-111	GL03	700	x	365	18.5	18.5	28.5	28.5	663	x	308	0.20			4	4		8	送工厂			
59	GL03-112	GL03	1631	x	365	18.5	18.5	28.5	28.5	1594	x	308	0.49			1	1		2	送工厂			
60	GL03-113	GL03	1581	x	365	18.5	18.5	28.5	28.5	1544	x	308	0.48			1	1		2	送工厂			
1	GL04-01	GL04	665	x	135	60	60	0	0	545	x	135	0.07	34				10	44	送工厂			
2	GL04-02	GL04	700	x	135	60	60	0	0	580	x	135	0.08	306				90	396	送工厂			
3	GL04-03	GL04	681	x	135	60	60	0	0	561	x	135	0.08	476				140	616	送工厂			
4	GL04-04	GL04	622.5	x	135	60	60	0	0	502.5	x	135	0.07	68				20	88	送工厂			
5	GL04-05	GL04	765	x	135	231	60	0	0	474	x	135	0.06	136				40	176	送工厂			
6	<del>GL04-06</del>	GL04	<del>837.5</del>	x	135	60	60	0	0	717.5	x	135	0.10						0				
7	GL04-08	GL04	550	x	135	60	60	0	0	430	x	135	0.06	34				10	44	送工厂			
													总数量					5508	151	151	1620	0	7430


注:

1	GL01	10mm THK. HEAT STRENGTHEN GLASS (OUTSIDE) W/ LOW-E COATING ON SURFACE #2 + 12 mm AIR SPACE + 12mm THK. CLEAR TEMPERED GLASS(INSIDE) IGU
2	GL02	10mm THK. HEAT STRENGTHEN GLASS (OUTSIDE) W/ LOW-E COATING ON SURFACE #2 + 12 mm AIR SPACE + 10mm THK. CLEAR TEMPERED GLASS(INSIDE) IGU
3	GL03	12mm THK. HEAT STRENGTHEN GLASS
4	GL04	12mm THK. CLEAR TEMPERED GLASS
5		

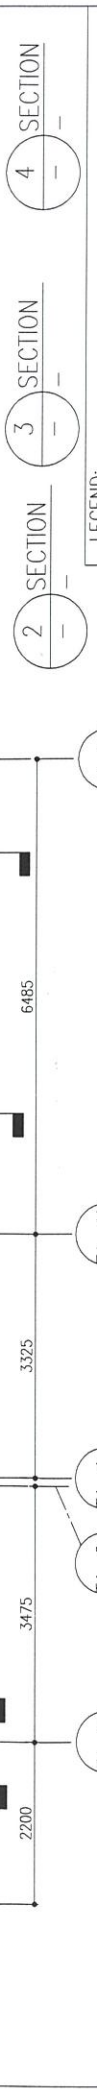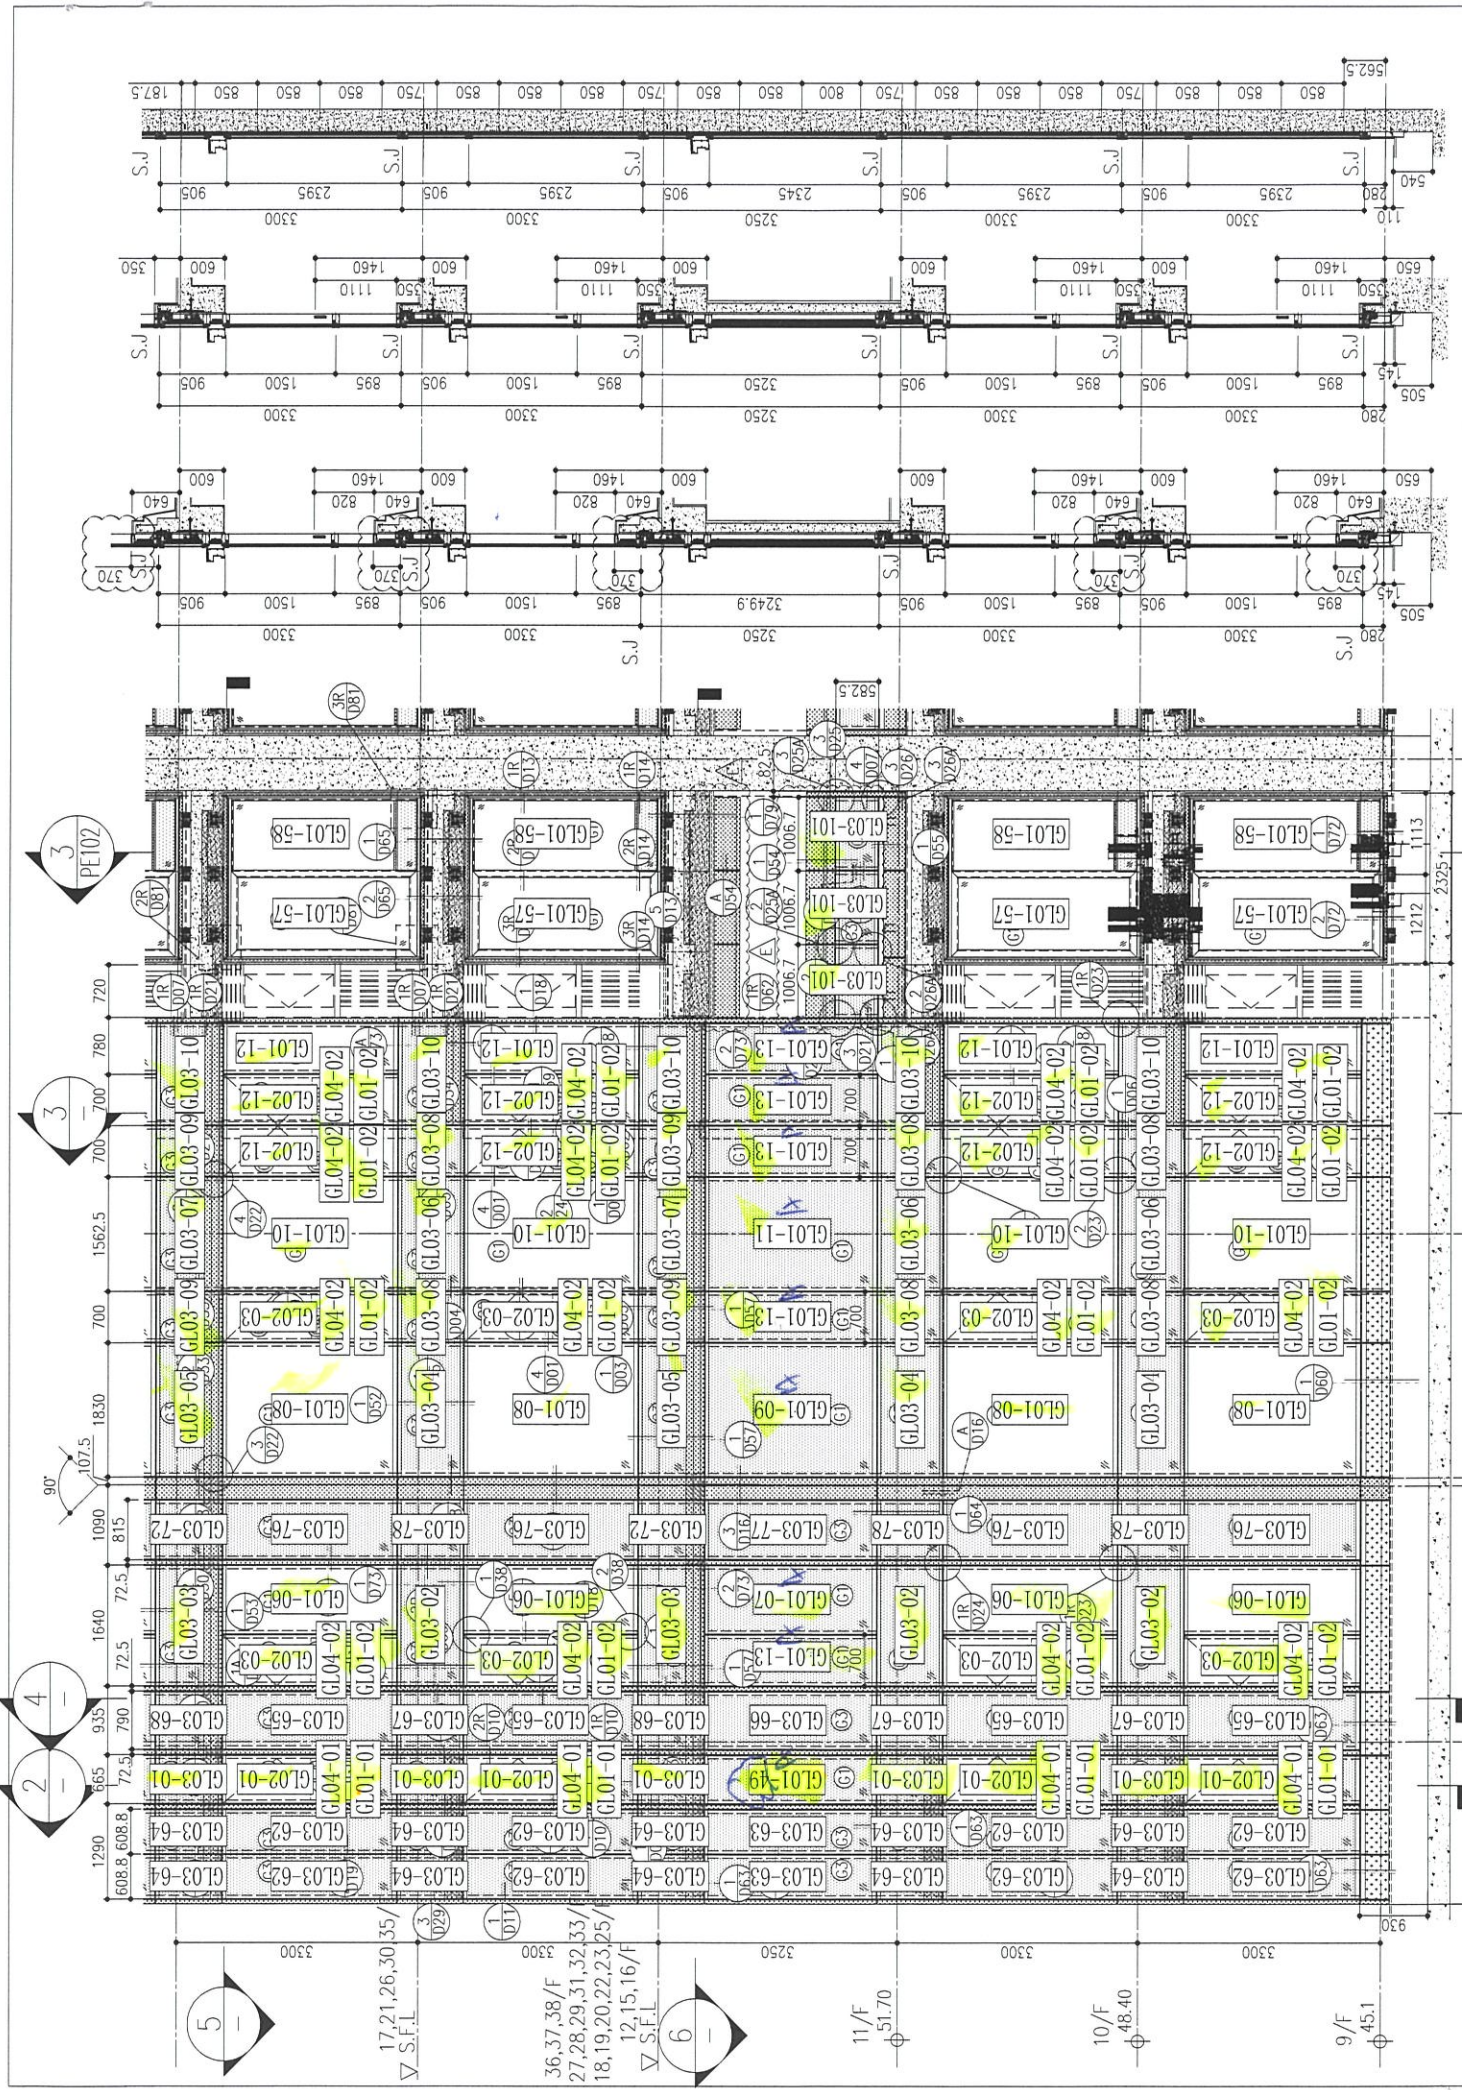



LEGEND:

- (G1) 10mm THK. HEAT STRENGTHENED GLASS (OUTSIDE) + 12mm AIR SPACE + 12mm THK. TEMPERED GLASS
- (G2) 10mm THK. HEAT STRENGTHENED GLASS (OUTSIDE) + 12mm AIR SPACE + 10mm THK. TEMPERED GLASS
- (G3) 12mm THK. HEAT STRENGTHENED GLASS
- (G4) 12mm THK. CLEAR TEMPERED GLASS ( INTERNAL PROTECTIVE BARRIER )
- (G5) 12mm CLEAR HEAT STRENGTHENED GLASS
- (G6) 10mm THK. CLEAR TEMPERED GLASS
- (G7) 8mm THK. CLEAR STRENGTHENED GLASS + 1.52mm ALUM. CLADDING + 3 mm THK. ALUM. CLADDING
- (S.J.) 3 mm THK. ALUM. BACKPAN

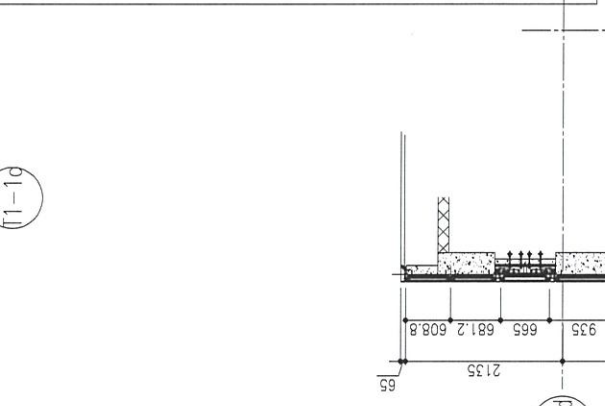

1 PART ELEVATION FOR CURTAIN WALL

26/F	+91.25	39/F	+130.85	52/F	+170.40
25/F	+87.95	38/F	+127.55	51/F	+167.10
23/F	+84.65	37/F	+124.25	50/F	+163.80
22/F	+81.35	36/F	+120.95	49/F	+160.50
21/F	+78.05	35/F	+117.65	48/F	+157.20
20/F	+74.75	33/F	+114.35	47/F	+153.90
19/F	+71.45	32/F	+111.05	46/F	+150.60
18/F	+68.15	31/F	+107.75	45/F	+147.30
17/F	+64.85	30/F	+104.45	43/F	+144.00
16/F	+61.55	29/F	+101.15	42/F	+140.70
15/F	+58.25	28/F	+97.85	41/F	+137.40
12/F	+54.95	27/F	+94.55	40/F	+134.15

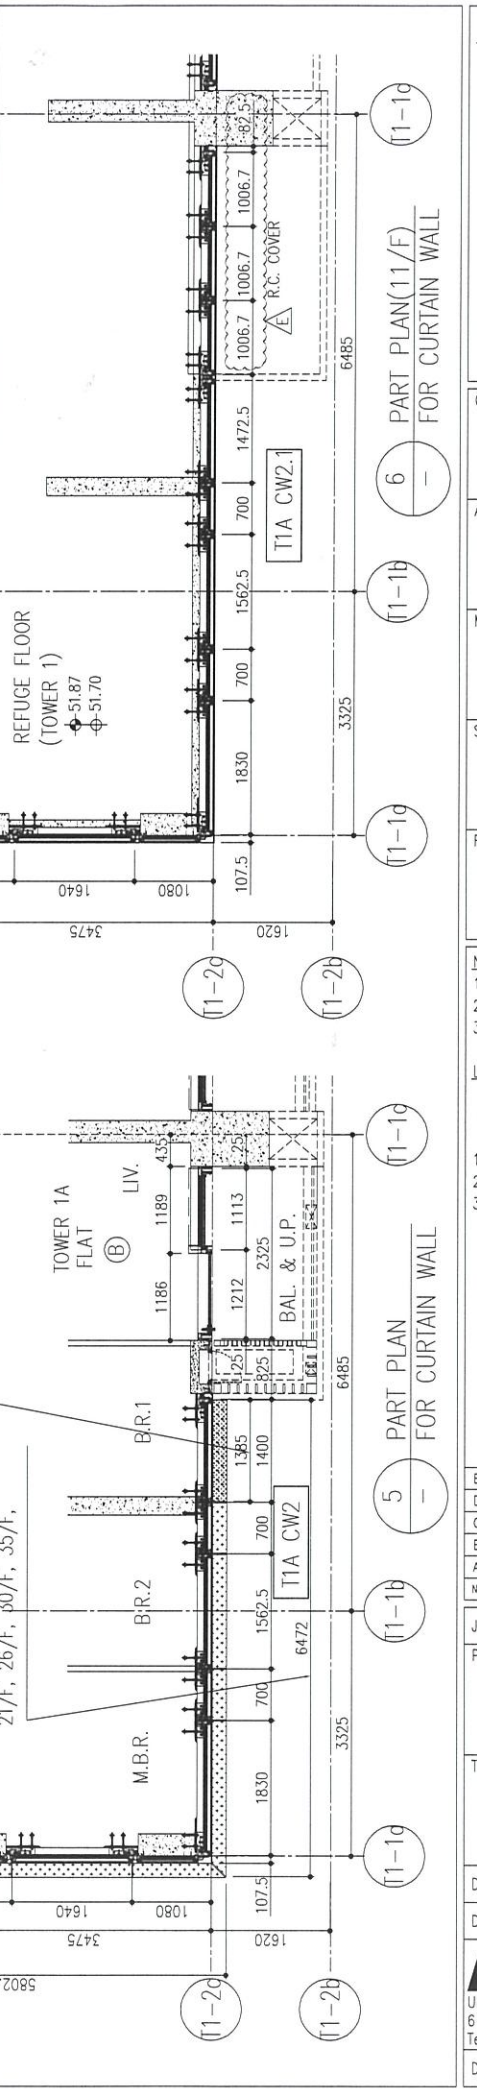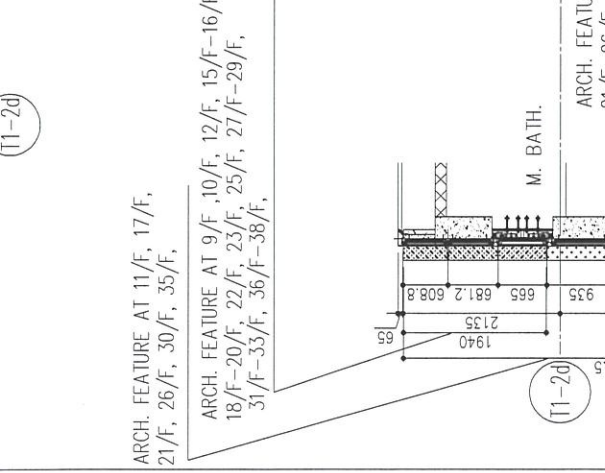

B.D. REF :

CLIENT : 信和置業有限公司 Sino Land Company Limited

ARCHITECT : ronald lu & partners Architects, Planners, Interior Designers Ronald Lu & Partners (HK) Ltd. 呂元祥建築師事務所 (香港) 有限公司

MAIN CONTRACTOR : Gammon

STRUCTURAL ENGINEER : AECOM

FAÇADE CONSULTANT: AECOM

NOTE :

- ALL DIMENSIONS ARE IN mm.
- ALL ELEVATIONS ARE VIEWED FROM OUTSIDE.
- ALL DIMENSIONS TO BE VERIFIED ON SITE BEFORE FABRICATION.

LEGEND :

- X1 --- DETAIL MARK NO.
- X001 --- REFER SHEET NO.
- F.F.L. --- FINISHED FLOOR LEVEL
- S.F.L. --- STRUCTURAL FLOOR LEVEL
- ⊖ --- REVERSED DETAIL

E	23/05/22	REVISED AS PER COMMENTS	LS
D	06/04/22	REVISED AS PER COMMENTS	LS
C	24/01/22	REVISED AS PER COMMENTS	LS
B	20/12/21	REVISED AS PER COMMENTS	LS
A	03/12/21	REVISED AS PER COMMENTS	LS
NO.	DATE	REVISED	BY

JOB NO. : J-858

PROJECT : PROPOSED RESIDENTIAL DEVELOPMENT AT TKOTL 70RP, PHASE 11, LOHAS PARK TSEUNG KWAN O, N.T.

TITLE : TYPICAL FLOOR PARTIAL ELEVATION & SECTION, PLAN FOR CURTAIN WALL (TOWER 1)


DATE : 22-OCT-21 SCALE : 1:50(A1)

DRAWN BY : CHECKED BY :

美特鋁質有限公司 MIDI ALUMINIUM FABRICATOR LTD. Units 6-8, Sunroy Industrial Centre, 1/F 610 Cha Kwo Ling Road, Kowloon Tel:23489211-4 Fax:(852)27727666

DWG NO. : J858-CW-PE101 REV. : E



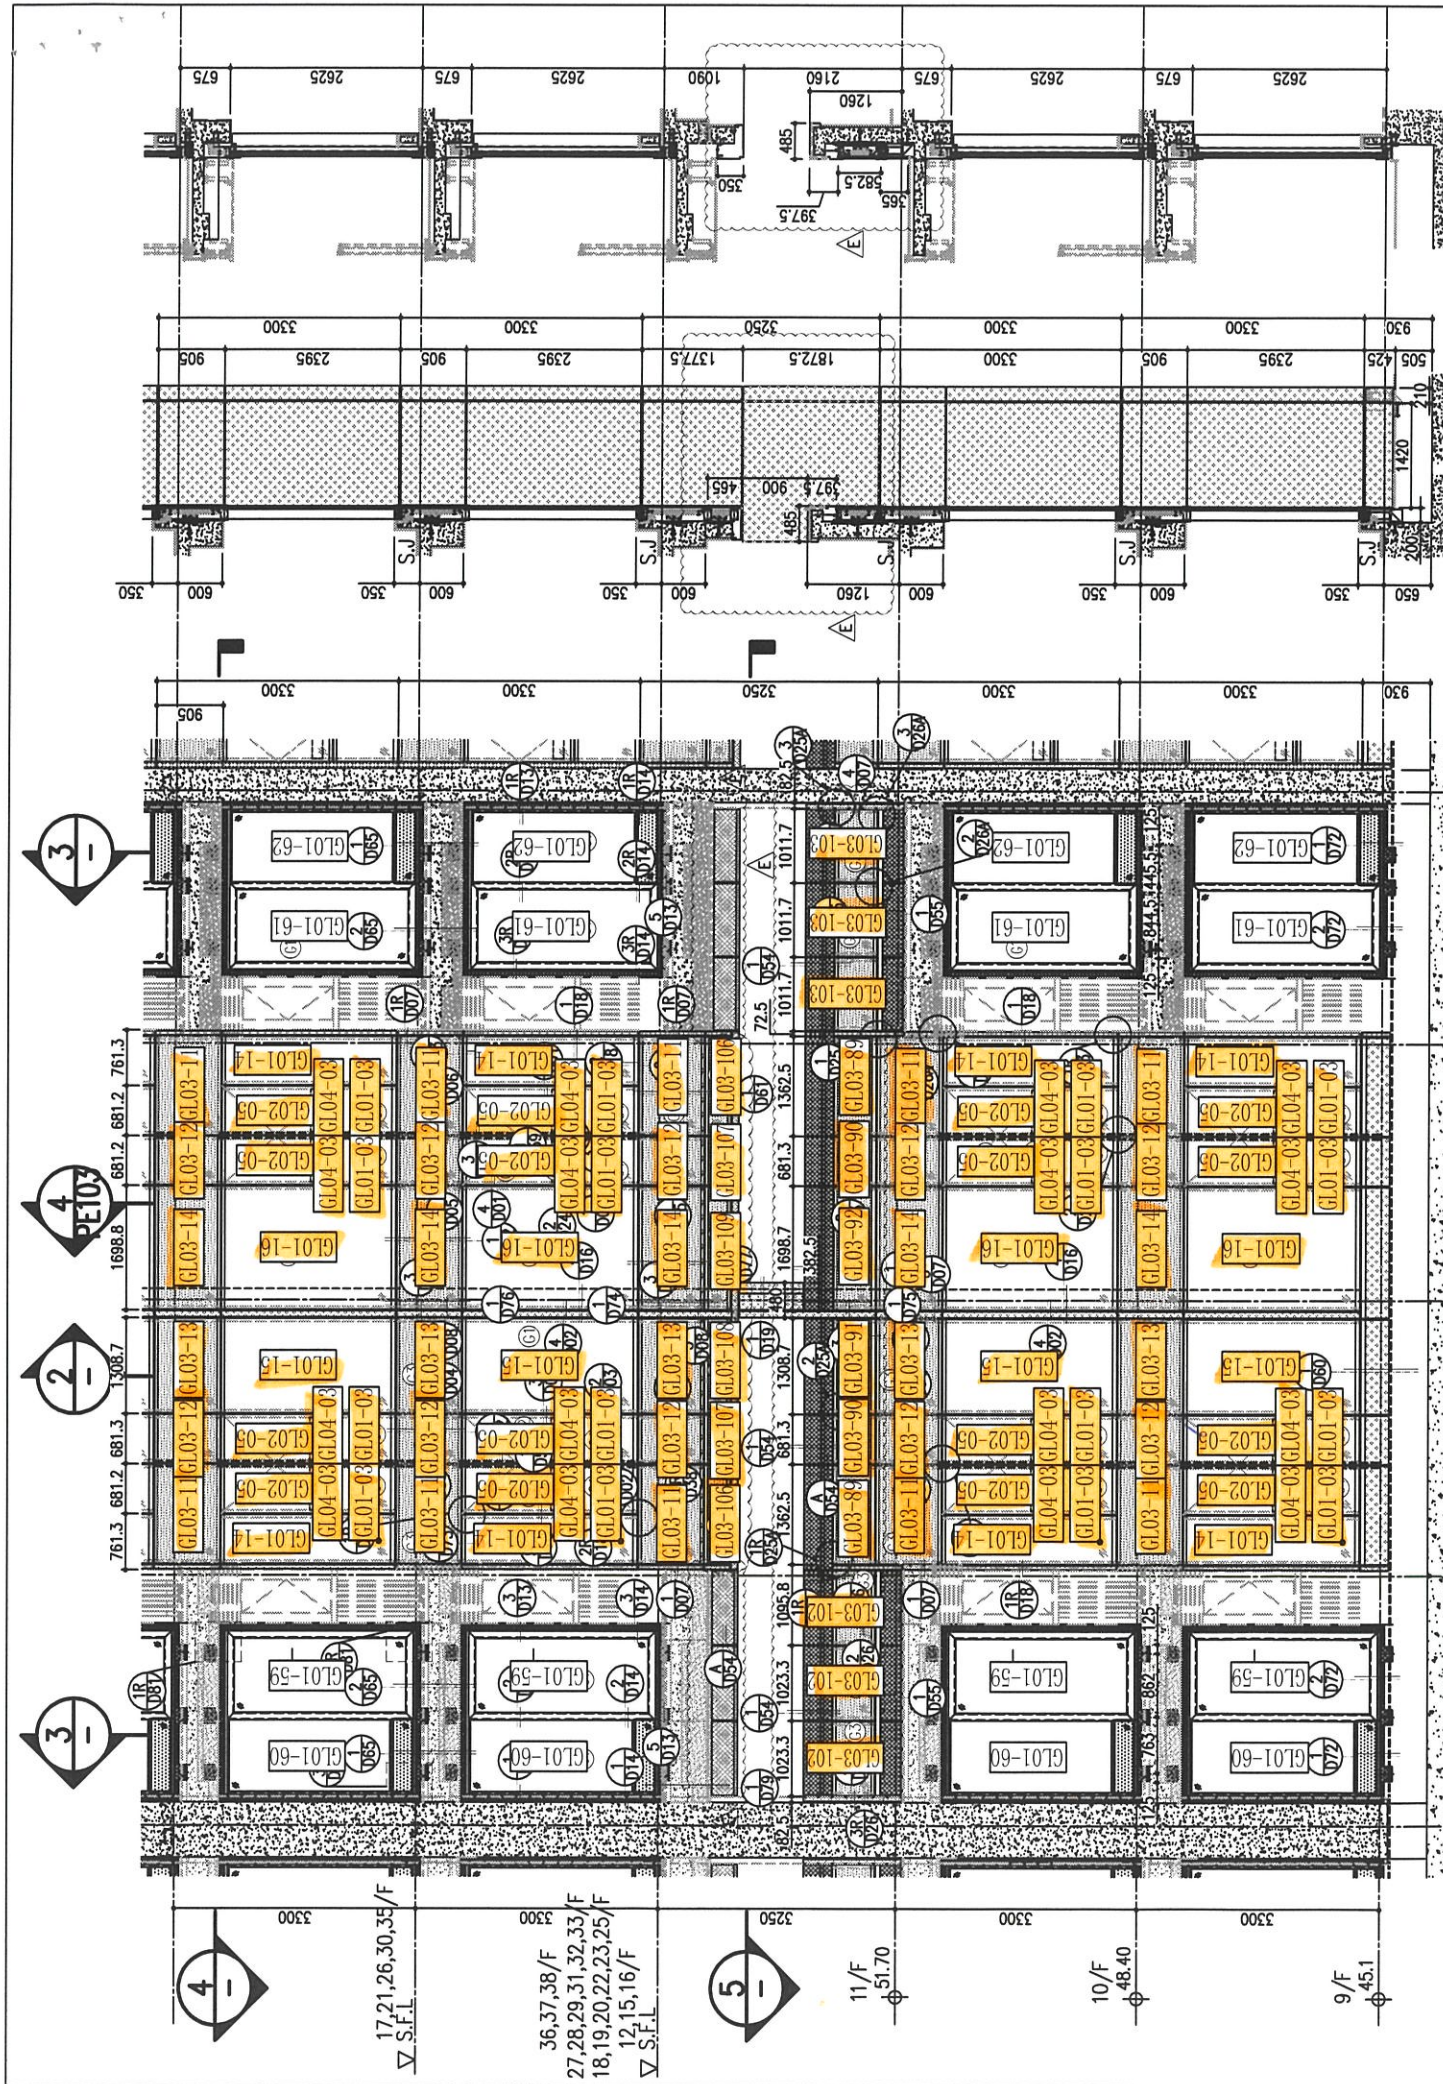

26/F	+91.25	52/F	+170.40	R/F	+203.80
25/F	+87.95	38/F	+127.55	51/F	+167.10
23/F	+84.65	37/F	+124.25	50/F	+163.80
22/F	+81.35	36/F	+120.95	49/F	+160.50
21/F	+78.05	35/F	+117.65	48/F	+157.20
20/F	+74.75	33/F	+114.35	47/F	+153.90
19/F	+71.45	32/F	+111.05	46/F	+150.60
18/F	+68.15	31/F	+107.75	45/F	+147.30
17/F	+64.85	30/F	+104.45	43/F	+144.00
16/F	+61.55	29/F	+101.15	42/F	+140.70
15/F	+58.25	28/F	+97.85	41/F	+137.40
12/F	+54.95	27/F	+94.55	40/F	+134.15

**LEGEND:**

① 10mm THK. HEAT STRENGTHENED GLASS (OUTSIDE) + 12mm AIR SPACE + 12mm THK. TEMPERED GLASS

② 10mm THK. HEAT STRENGTHENED GLASS (OUTSIDE) + 12mm AIR SPACE + 10mm THK. TEMPERED GLASS

③ 12mm THK. HEAT STRENGTHENED GLASS

④ 12mm THK. CLEAR TEMPERED GLASS (INTERNAL PROTECTIVE BARRIER)

⑤ 12mm CLEAR HEAT STRENGTHENED GLASS



⑥ 10mm THK. CLEAR TEMPERED GLASS

⑦ 8mm THK. CLEAR HEAT STRENGTHENED GLASS + 1.52mm CLEAR HEAT-STRENGTHENED GLASS

⑧ 3 mm THK. ALUM. CLADDING

⑨ 3 mm THK. ALUM. BACKPAN

S.J. - STACK JOINT

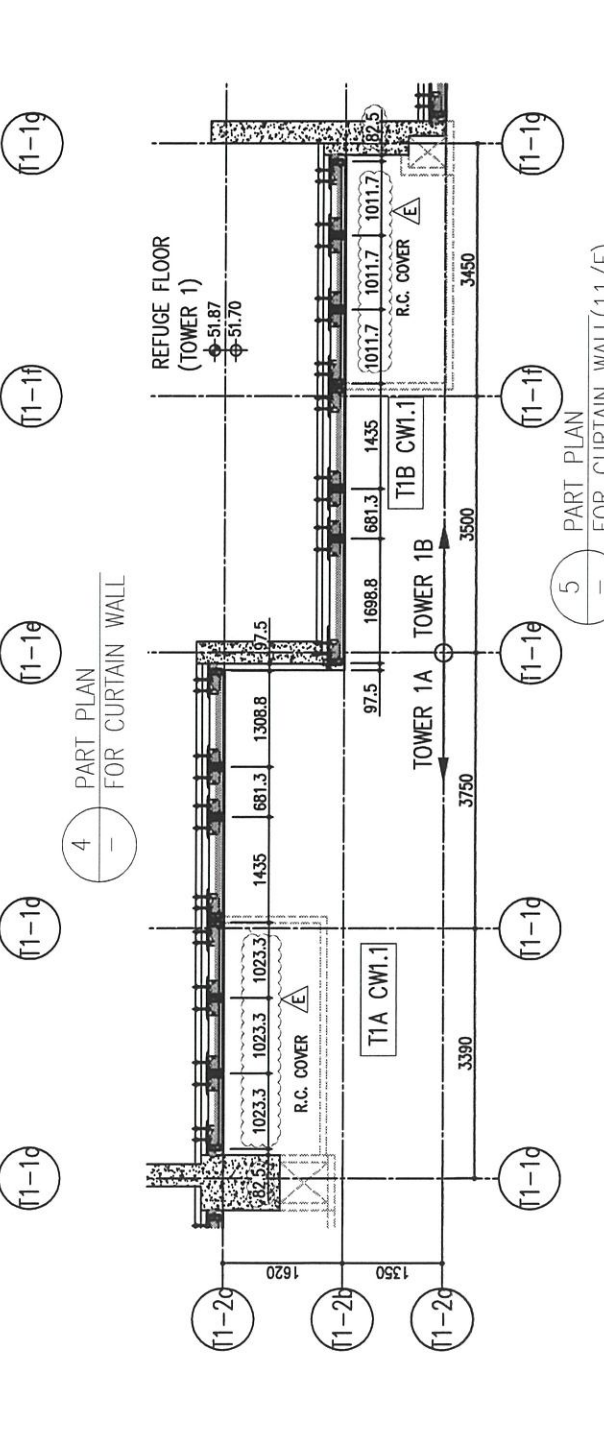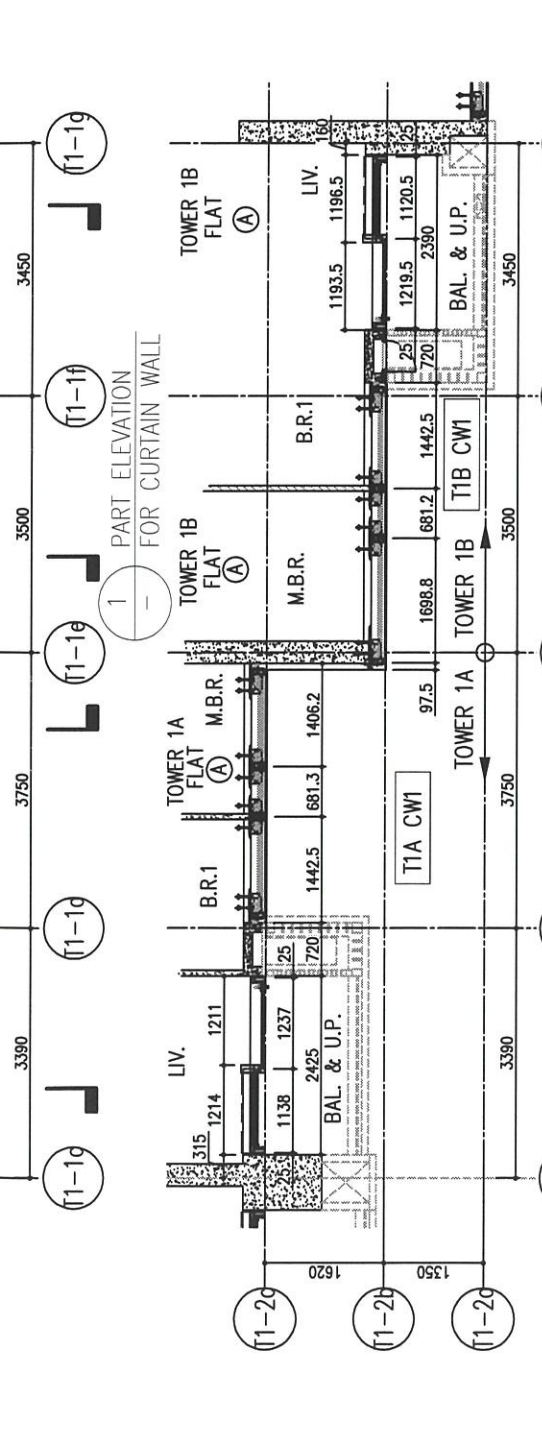

B.D. REF :

CLIENT :  
 信和置業有限公司  
 Sino Land Company Limited

ARCHITECT :  
 ronald lu & partners  
 Architects Planners Interior Designers  
 Ronald Lu & Partners (HK) Ltd.  
 呂元祥建築師事務所 (香港) 有限公司

MAIN CONTRACTOR :  
 Gammon

STRUCTURAL ENGINEER :  
 AECOM

FAÇADE CONSULTANT:  
 AECOM

NOTE :  
 1. ALL DIMENSIONS ARE IN mm.  
 2. ALL ELEVATIONS ARE VIEWED FROM OUTSIDE.  
 3. ALL DIMENSIONS TO BE VERIFIED ON SITE BEFORE FABRICATION.

LEGEND :  
 X1 - DETAIL MARK NO.  
 X001 - REFER SHEET NO.

1. F.F.L. --- FINISHED FLOOR LEVEL  
 2. S.F.L. --- STRUCTURAL FLOOR LEVEL  
 3. (R) --- REVERSED DETAIL

NO.	DATE	REVISED	BY
E	23/05/22	REVISED AS PER COMMENTS	LS
D	06/04/22	REVISED AS PER COMMENTS	LS
C	24/01/22	REVISED AS PER COMMENTS	LS
B	20/12/21	REVISED AS PER COMMENTS	LS
A	03/12/21	REVISED AS PER COMMENTS	LS

JOB NO. : J-858

PROJECT :  
 PROPOSED RESIDENTIAL DEVELOPMENT  
 AT TKOTL 70RP, PHASE 11, LOHAS PARK  
 TSEUNG KWAN O, N.T.

TITLE :  
 TYPICAL FLOOR PARTIAL  
 ELEVATION & SECTION, PLAN  
 FOR CURTAIN WALL (TOWER 1)


DATE : 22-OCT-21      SCALE : 1:50(A1)

DRAWN BY :      CHECKED BY :

美特鋁質有限公司  
 MIDI ALUMINUM FABRICATOR LTD.  
 Units 6-8, Sunroy Industrial Centre, 1/F  
 610 Cha Kwo Ling Road, Kowloon  
 Tel:23489211-4 Fax:(852)27727666

DWG NO. : J858-CW-PE102      REV. : E



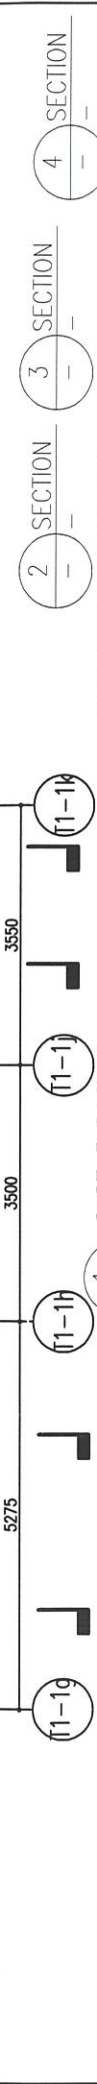


ARCH. FEATURE AT 11/F, 17/F, 21/F, 26/F, 30/F, 35/F

26/F	+91.25	39/F	+130.85	52/F	+170.40
25/F	+87.95	38/F	+127.55	51/F	+167.10
23/F	+84.65	37/F	+124.25	50/F	+163.80
22/F	+81.35	36/F	+120.95	49/F	+160.50
21/F	+78.05	35/F	+117.65	48/F	+157.20
20/F	+74.75	33/F	+114.35	47/F	+153.90
19/F	+71.45	32/F	+111.05	46/F	+150.60
18/F	+68.15	31/F	+107.75	45/F	+147.30
17/F	+64.85	30/F	+104.45	43/F	+144.00
16/F	+61.55	29/F	+101.15	42/F	+140.70
15/F	+58.25	28/F	+97.85	41/F	+137.40
12/F	+54.95	27/F	+94.55	40/F	+134.15

LEGEND:

(G1)	10mm THK. HEAT STRENGTHENED GLASS (OUTSIDE) +12mm AIR SPACE + 12mm THK. TEMPERED GLASS
(G2)	10mm THK. HEAT STRENGTHENED GLASS (OUTSIDE) +12mm AIR SPACE + 10mm THK. TEMPERED GLASS
(G3)	12mm THK. HEAT STRENGTHENED GLASS
(G4)	12mm THK. CLEAR TEMPERED GLASS (INTERNAL PROTECTIVE BARRIER)
(G5)	12mm CLEAR HEAT STRENGTHENED GLASS
(G6)	10mm THK. CLEAR TEMPERED GLASS
(G7)	8mm THK. CLEAR HEAT STRENGTHENED GLASS +1.52mm CLEAR HEAT-STRENGTHENED GLASS + 8mm THK. CLEAR HEAT-STRENGTHENED GLASS
(G8)	3 mm THK. ALUM. CLADDING
(S.J.)	3 mm THK. ALUM. BACKPAN
(S.J.)	STACK JOINT

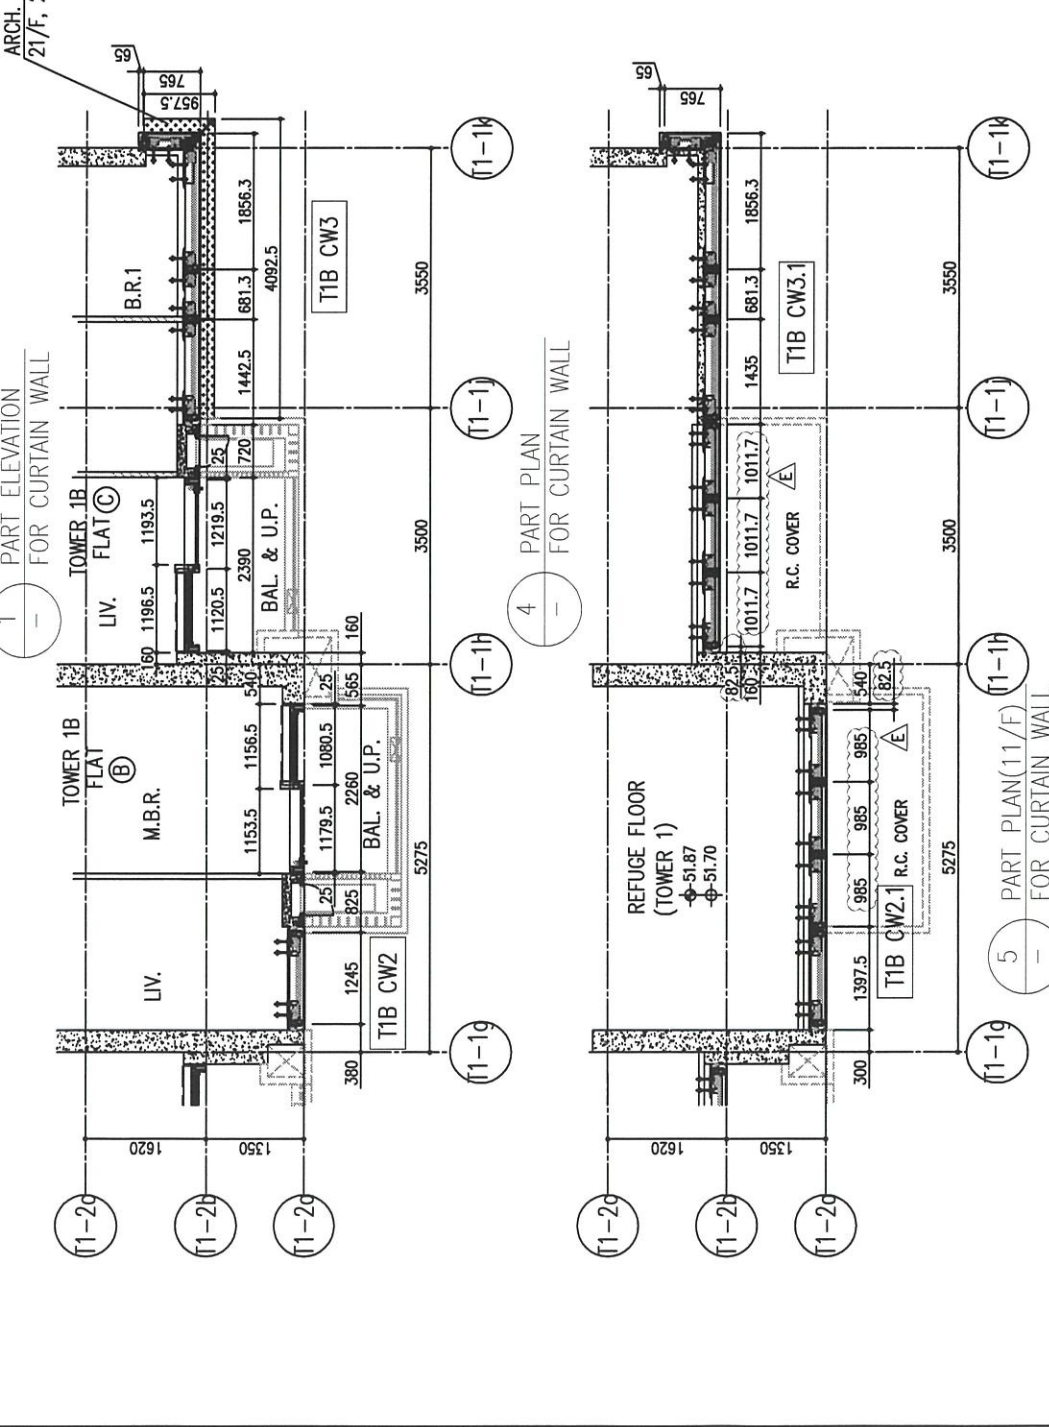

B.D. REF :

CLIENT : 信和置業有限公司 Sino Land Company Limited

ARCHITECT : ronald lu & partners Architects - Partners - Interior Designers Ronald Lu & Partners (HK) Ltd. 呂元祥建築師事務所 (香港) 有限公司

MAIN CONTRACTOR : Gammon

STRUCTURAL ENGINEER : AECOM

FAÇADE CONSULTANT : AECOM

NOTE :  
 1. ALL DIMENSIONS ARE IN mm.  
 2. ALL ELEVATIONS ARE VIEWED FROM OUTSIDE.  
 3. ALL DIMENSIONS TO BE VERIFIED ON SITE BEFORE FABRICATION.

LEGEND :  
 (X1) -- DETAIL MARK NO.  
 (X001) -- REFER SHEET NO.  
 1. F.F.L. -- FINISHED FLOOR LEVEL  
 2. S.F.L. -- STRUCTURAL FLOOR LEVEL  
 3. (R) -- REVERSED DETAIL

E	23/05/22	REVISED AS PER COMMENTS	LS
D	06/04/22	REVISED AS PER COMMENTS	LS
C	24/01/22	REVISED AS PER COMMENTS	LS
B	20/12/21	REVISED AS PER COMMENTS	LS
A	03/12/21	REVISED AS PER COMMENTS	LS

JOB NO. : J-858

PROJECT : PROPOSED RESIDENTIAL DEVELOPMENT AT TKOTL 70RP, PHASE 11, LOHAS PARK TSEUNG KWAN O, N.T.

TITLE : TYPICAL FLOOR PARTIAL ELEVATION & SECTION, PLAN FOR CURTAIN WALL (TOWER 1)


DATE : 22-OCT-21 SCALE : 1:50(A1)

DRAWN BY : CHECKED BY :

美特鋁質有限公司 MIDI ALUMINIUM FABRICATOR LTD. Units 6-8, Sunray Industrial Centre, 1/F 610 Cha Kwo Ling Road, Kowloon Tel:23489211-4 Fax:(852)27727666

DWG NO. : J858-CW-PE103 REV. : E



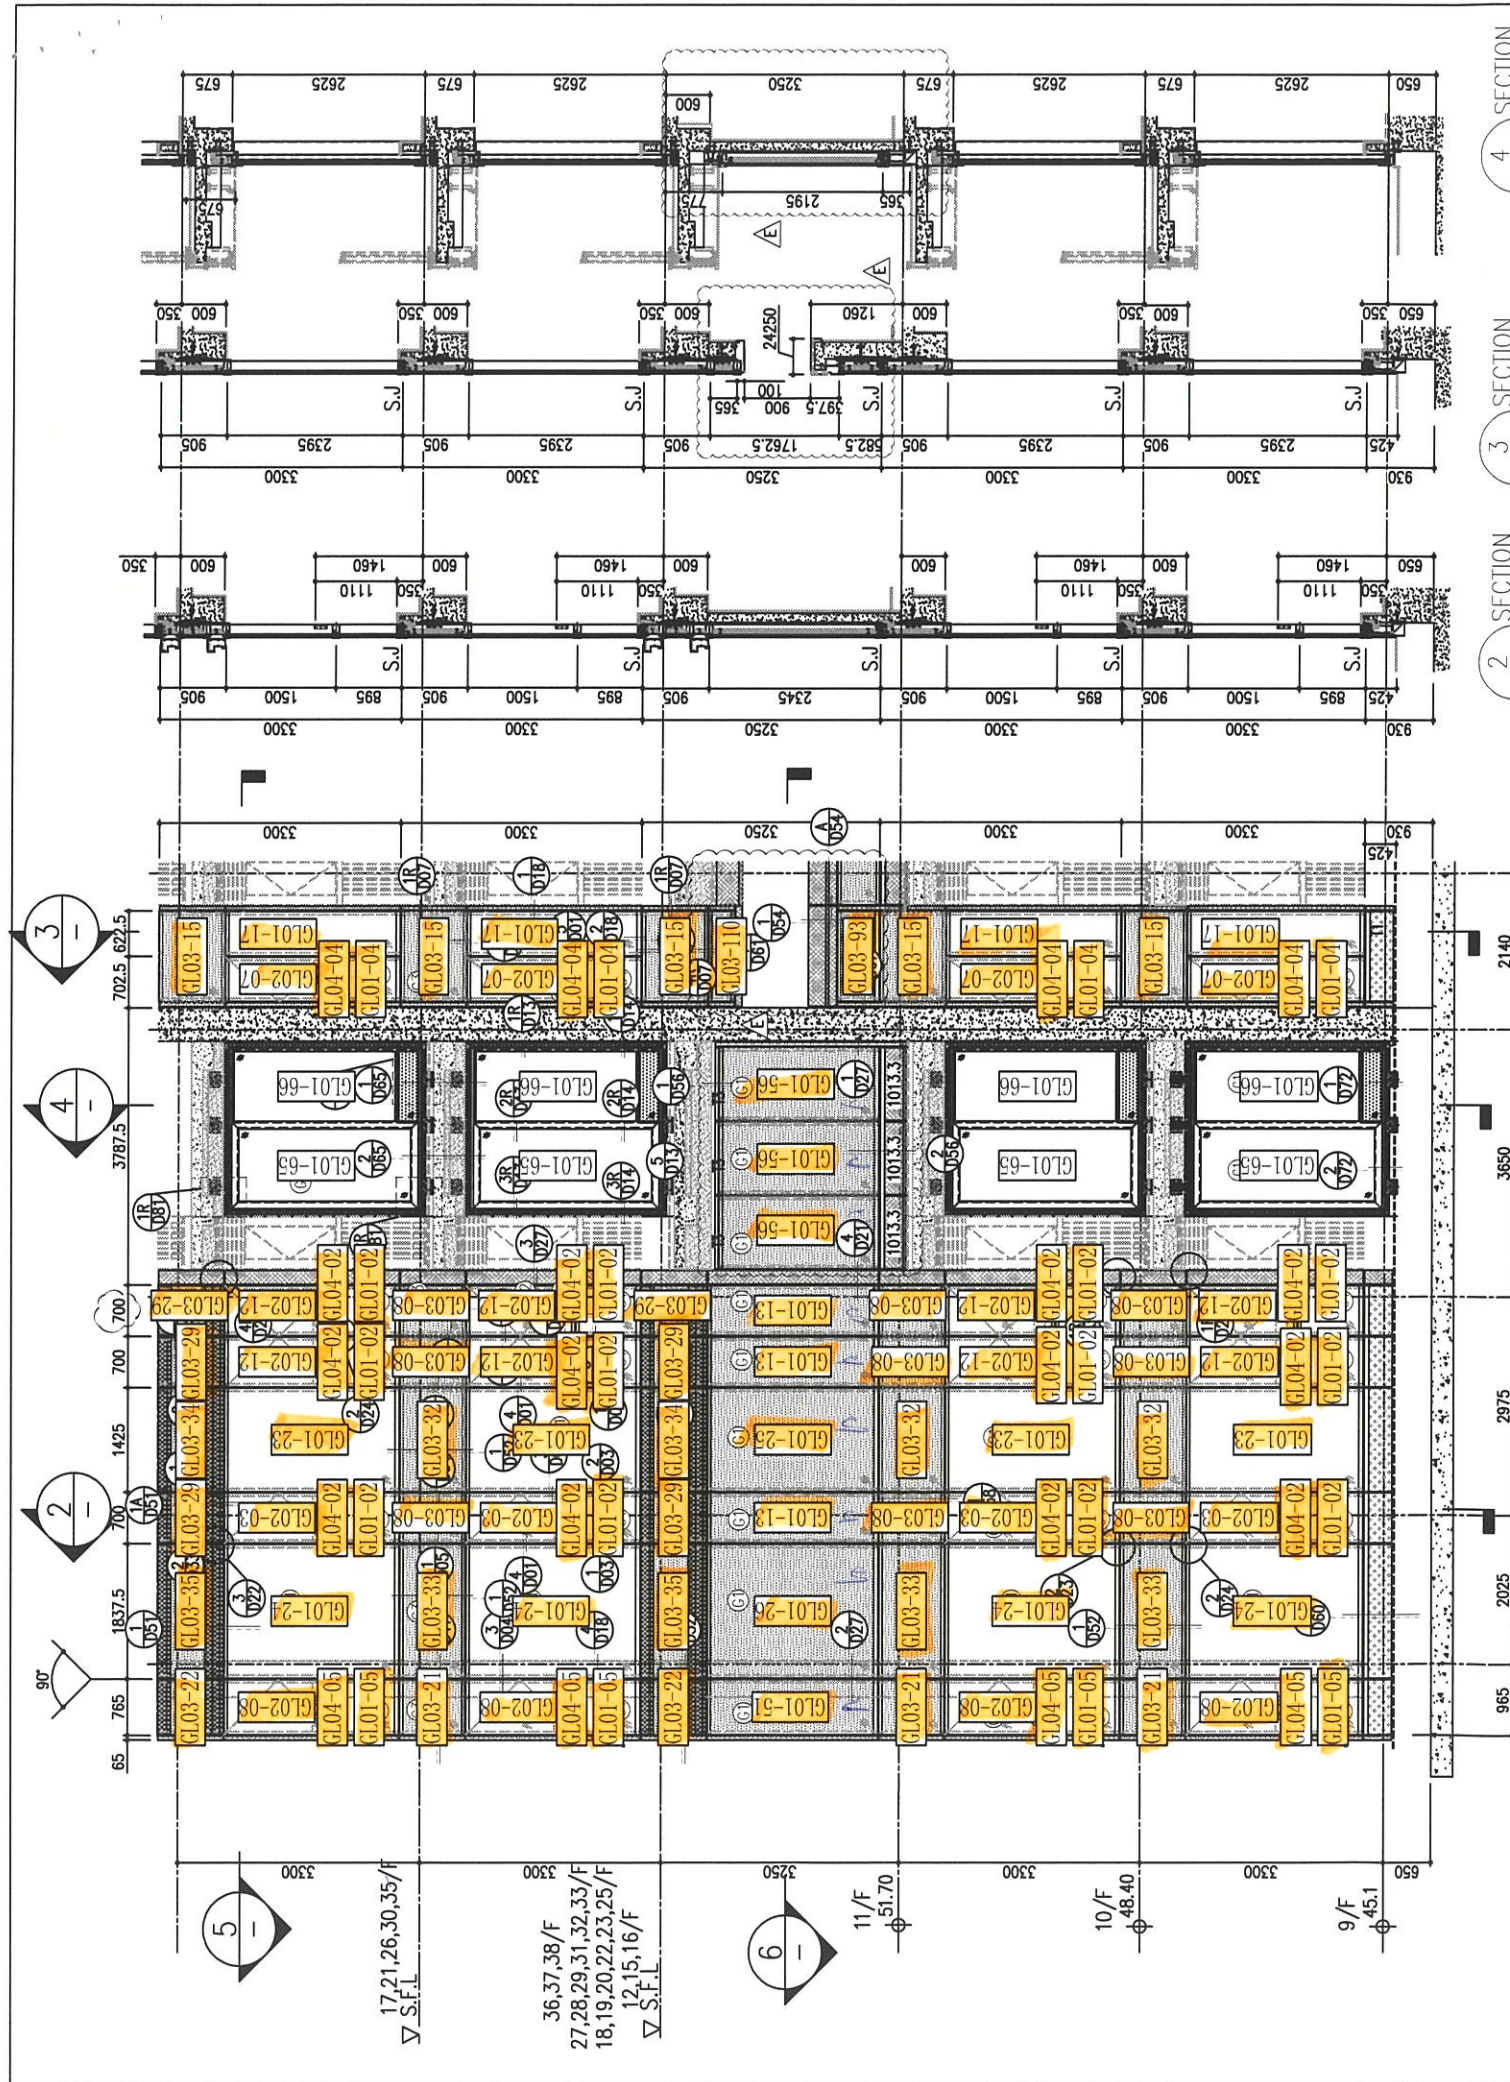

ARCH. FEATURE AT 11/F, 17/F, 21/F, 26/F, 30/F, 35/F


26/F	+91.25	39/F	+130.85	52/F	+170.40	R/F	+203.80
25/F	+87.95	38/F	+127.55	51/F	+167.10	62/F	+200.30
23/F	+84.65	37/F	+124.25	50/F	+163.80	61/F	+196.80
22/F	+81.35	36/F	+120.95	49/F	+160.50	60/F	+193.50
21/F	+78.05	35/F	+117.65	48/F	+157.20	59/F	+190.20
20/F	+74.75	33/F	+114.35	47/F	+153.90	58/F	+186.90
19/F	+71.45	32/F	+111.05	46/F	+150.60	57/F	+183.60
18/F	+68.15	31/F	+107.75	45/F	+147.30	56/F	+180.30
17/F	+64.85	30/F	+104.45	43/F	+144.00	55/F	+177.00
16/F	+61.55	29/F	+101.15	42/F	+140.70	53/F	+173.70
15/F	+58.25	28/F	+97.85	41/F	+137.40		
12/F	+54.95	27/F	+94.55	40/F	+134.15		

**LEGEND:**

- (C1) 10mm THK. HEAT STRENGTHENED GLASS (OUTSIDE) + 12mm AIR SPACE + 12mm THK. TEMPERED GLASS
- (C2) 10mm THK. HEAT STRENGTHENED GLASS (OUTSIDE) + 12mm AIR SPACE + 10mm THK. TEMPERED GLASS
- (C3) 12mm THK. HEAT STRENGTHENED GLASS (INTERNAL PROTECTIVE BARRIER)
- (C4) 12mm CLEAR HEAT STRENGTHENED GLASS
- (C5) 10mm THK. CLEAR TEMPERED GLASS
- (C6) 8mm THK. CLEAR HEAT-STRENGTHENED GLASS + 1.52mm ALUM. CLADDING + 3mm THK. ALUM. CLADDING
- (S.J.) 3mm THK. ALUM. BACKPAN

**DELETED**

- (C7) 10mm THK. HEAT STRENGTHENED GLASS (OUTSIDE) + 12mm AIR SPACE + 12mm THK. TEMPERED GLASS
- (C8) 10mm THK. HEAT STRENGTHENED GLASS (OUTSIDE) + 12mm AIR SPACE + 10mm THK. TEMPERED GLASS
- (C9) 12mm THK. HEAT STRENGTHENED GLASS (INTERNAL PROTECTIVE BARRIER)
- (C10) 12mm CLEAR HEAT STRENGTHENED GLASS
- (C11) 10mm THK. CLEAR TEMPERED GLASS
- (C12) 8mm THK. CLEAR HEAT-STRENGTHENED GLASS + 1.52mm ALUM. CLADDING + 3mm THK. ALUM. CLADDING
- (S.J.) 3mm THK. ALUM. BACKPAN

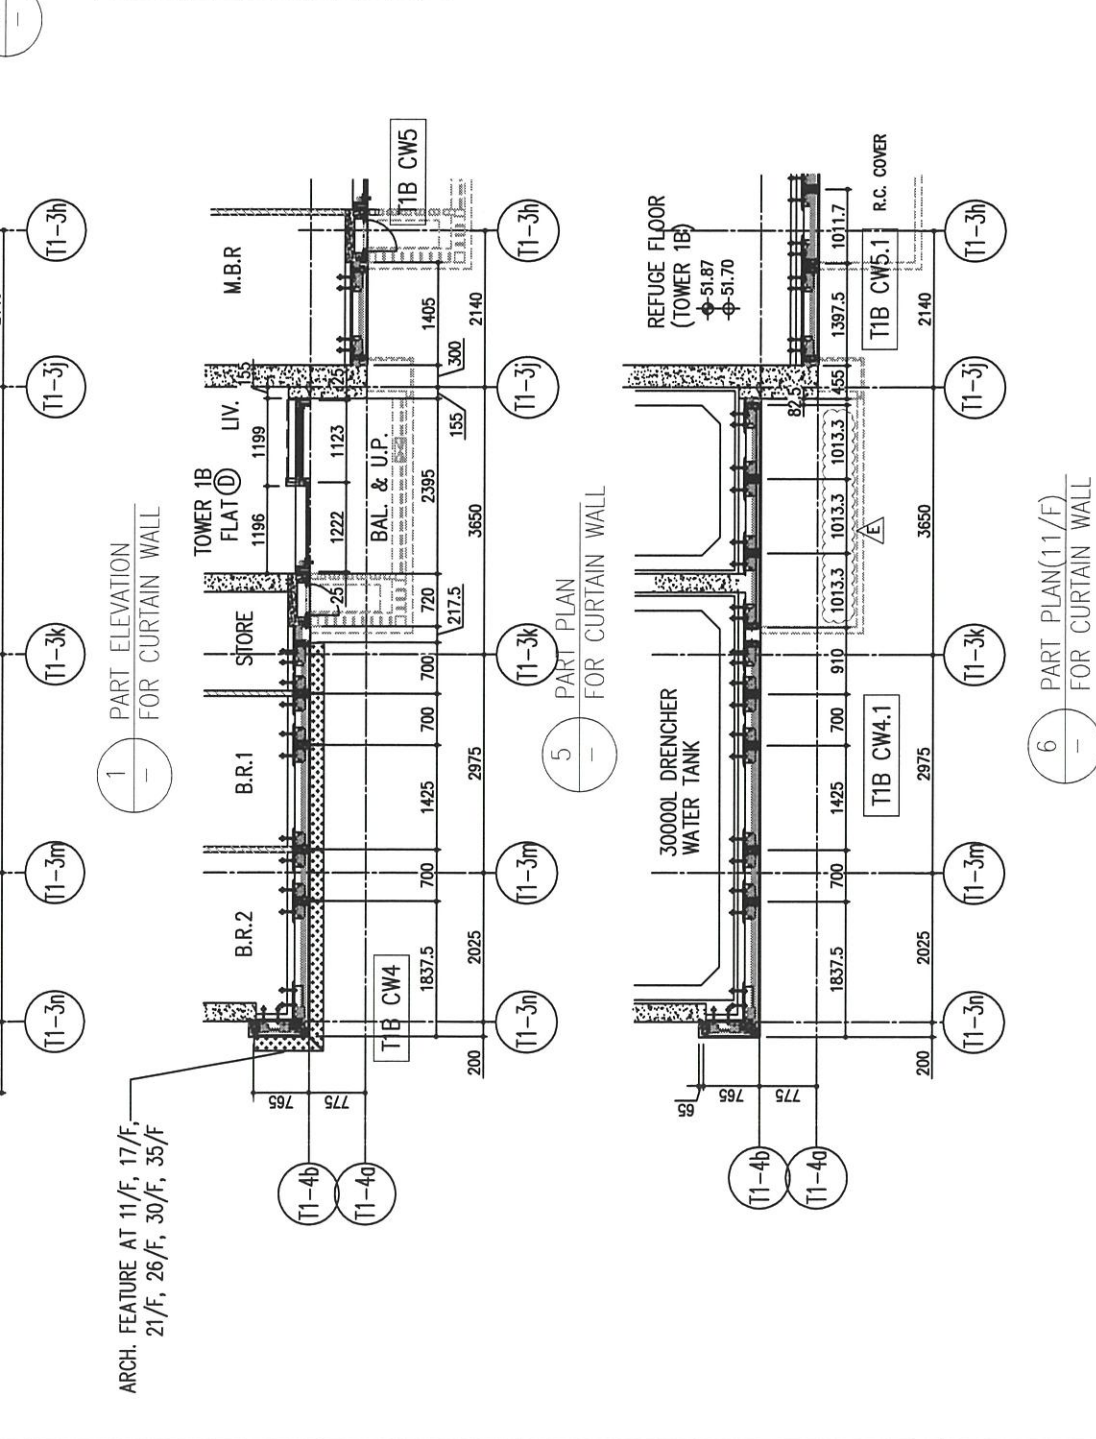

**B.D. REF :**

**CLIENT :**  
 信和置業有限公司  
 Sino Land Company Limited

**ARCHITECT :**  
 ronald lu & partners  
 Architects Planners Interior Designers  
 Ronald Lu & Partners (HK) Ltd.  
 呂元祥建築師事務所 (香港) 有限公司

**MAIN CONTRACTOR :**  
 Gammon

**STRUCTURAL ENGINEER :**  
 AECOM

**FAÇADE CONSULTANT:**  
 AECOM

**NOTE :**

- ALL DIMENSIONS ARE IN mm.
- ALL ELEVATIONS ARE VIEWED FROM OUTSIDE.
- ALL DIMENSIONS TO BE VERIFIED ON SITE BEFORE FABRICATION.

**LEGEND :**

- (X1) DETAIL MARK NO.
- (X001) REFER SHEET NO.
- 1. F.F.L. --- FINISHED FLOOR LEVEL
- 2. S.F.L. --- STRUCTURAL FLOOR LEVEL
- 3. (R) --- REVERSED DETAIL

NO.	DATE	REVISION	BY
E	23/05/22	REVISED AS PER COMMENTS	LS
D	06/04/22	REVISED AS PER COMMENTS	LS
C	24/01/22	REVISED AS PER COMMENTS	LS
B	20/12/21	REVISED AS PER COMMENTS	LS
A	03/12/21	REVISED AS PER COMMENTS	LS

**JOB NO. :** J-858

**PROJECT :**  
 PROPOSED RESIDENTIAL DEVELOPMENT  
 AT TKOTL 70RP, PHASE 11, LOHAS PARK  
 TSEUNG KWAN O, N.T.


**TITLE :**  
 TYPICAL FLOOR PARTIAL  
 ELEVATION & SECTION, PLAN  
 FOR CURTAIN WALL (TOWER 1)

**DATE :** 22-OCT-21 **SCALE :** 1:50(A1)


**DRAWN BY :** **CHECKED BY :**

**美特鋁質有限公司**  
 MIDI ALUMINIUM FABRICATOR LTD.  
 Units 6-8, Sunray Industrial Centre, 1/F  
 610 Cha Kwo Ling Road, Kowloon  
 Tel:23489211-4 Fax:(852)2727666


**DWG NO. :** J858-CW-PE107 **REV. :** E

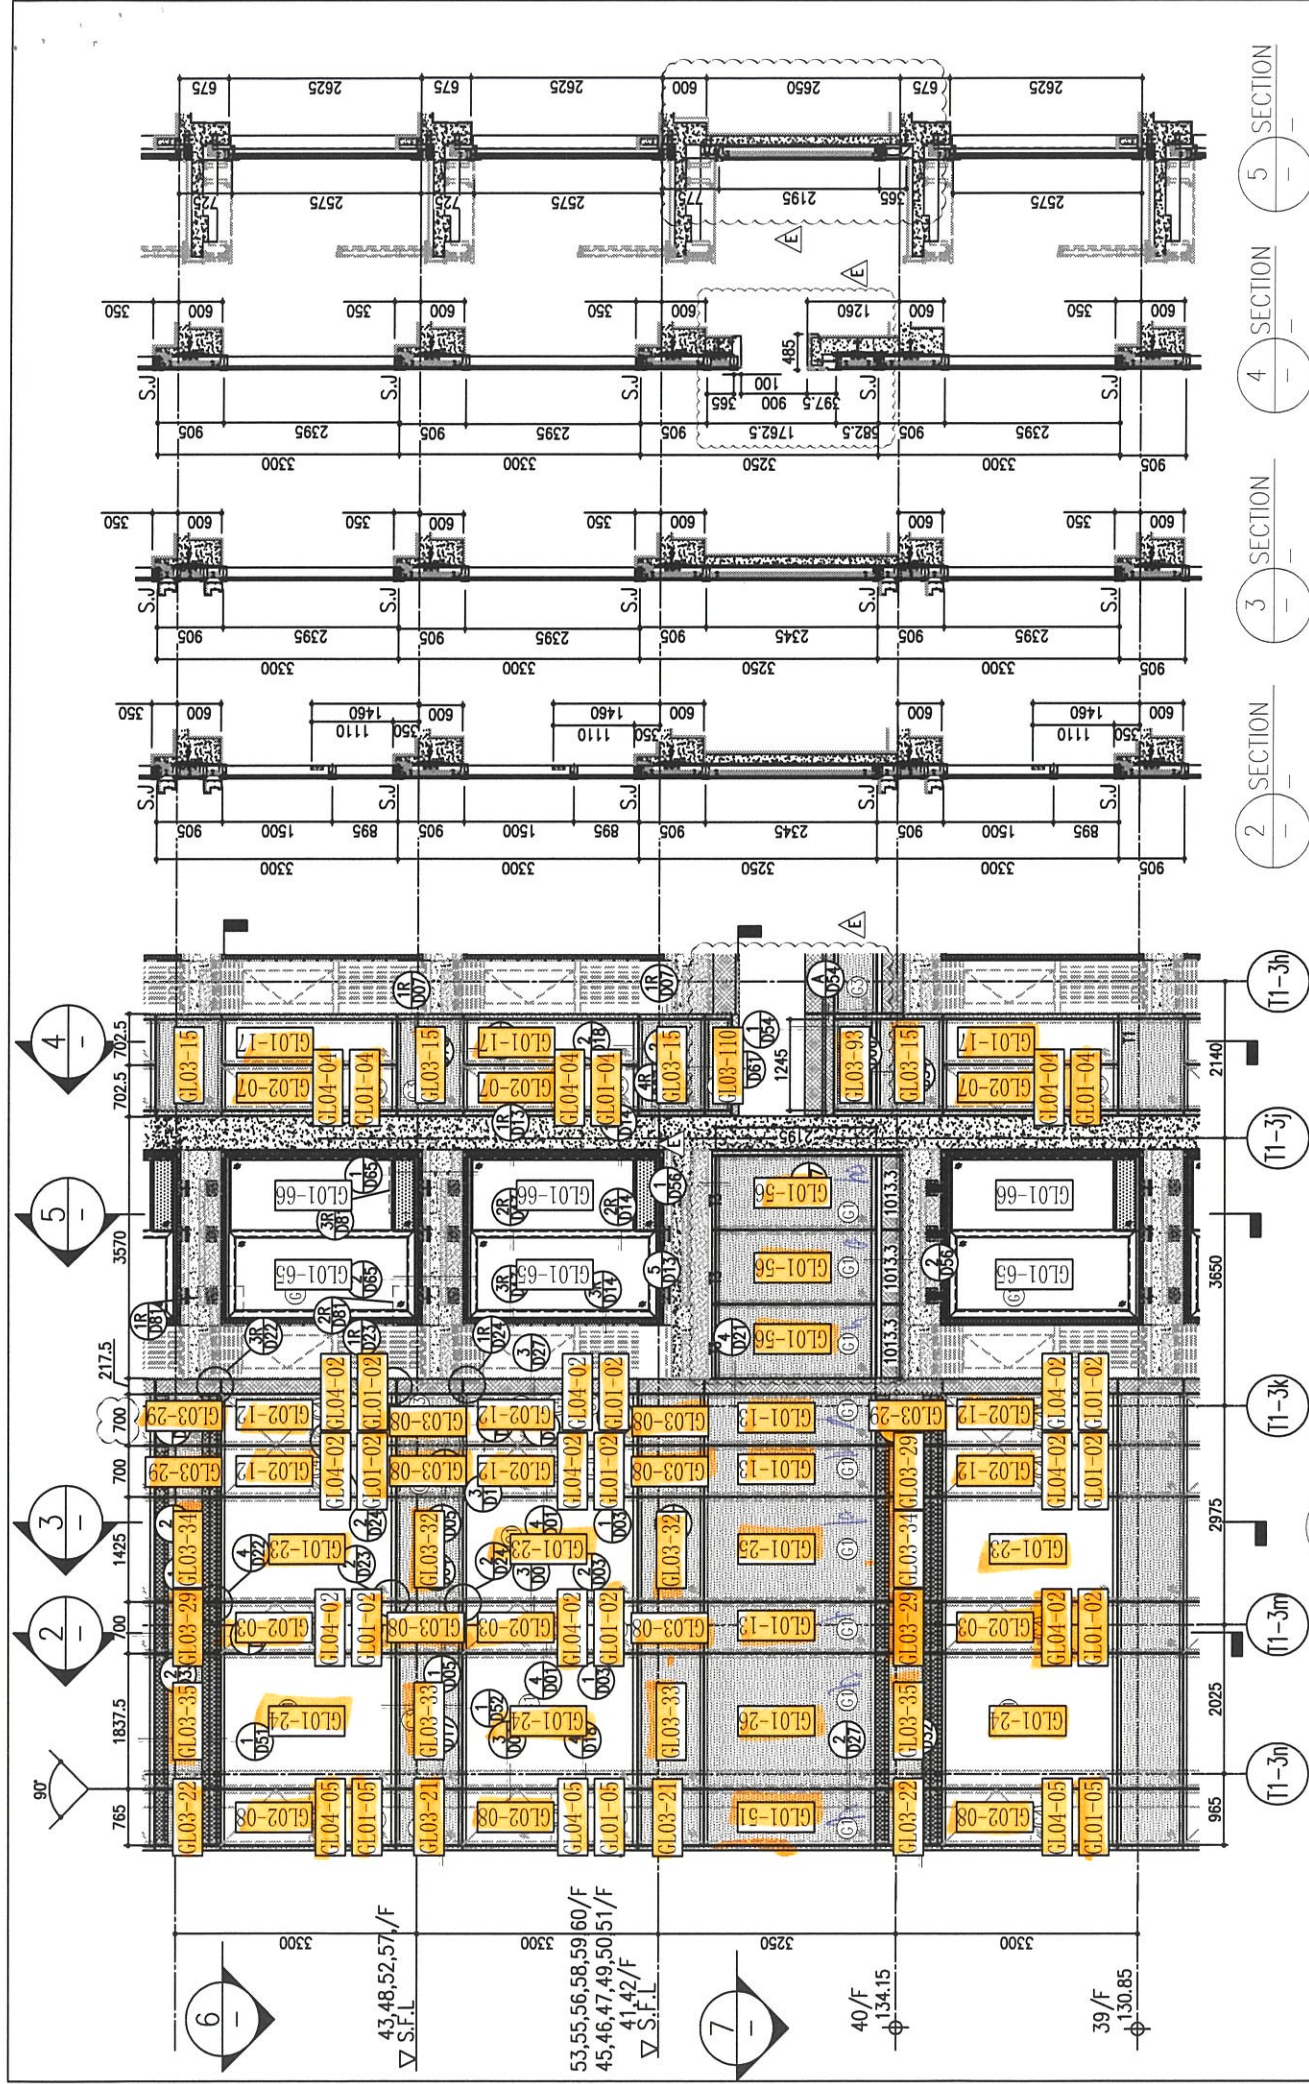

1 PART ELEVATION FOR CURTAIN WALL

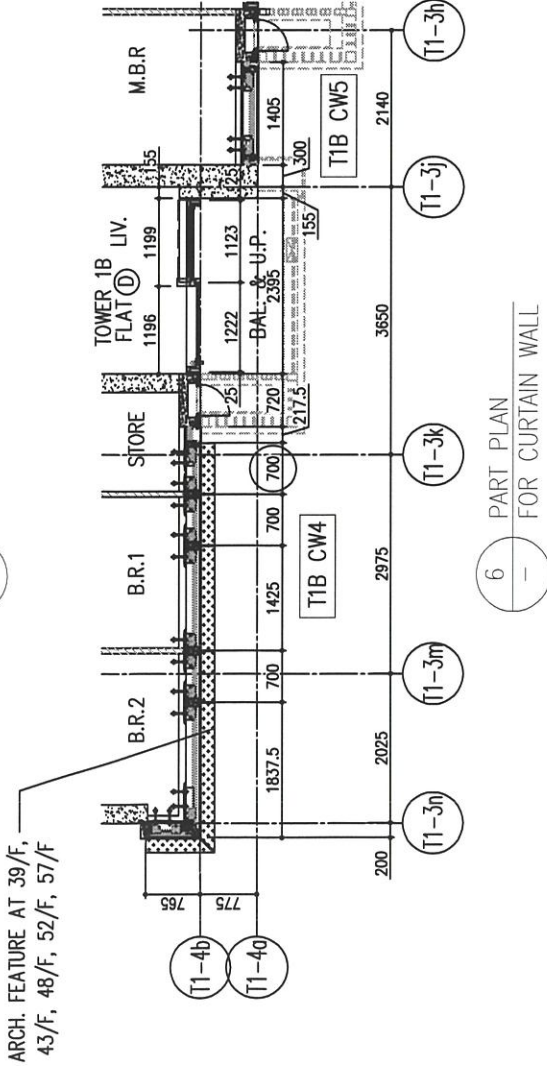

6 PART PLAN FOR CURTAIN WALL

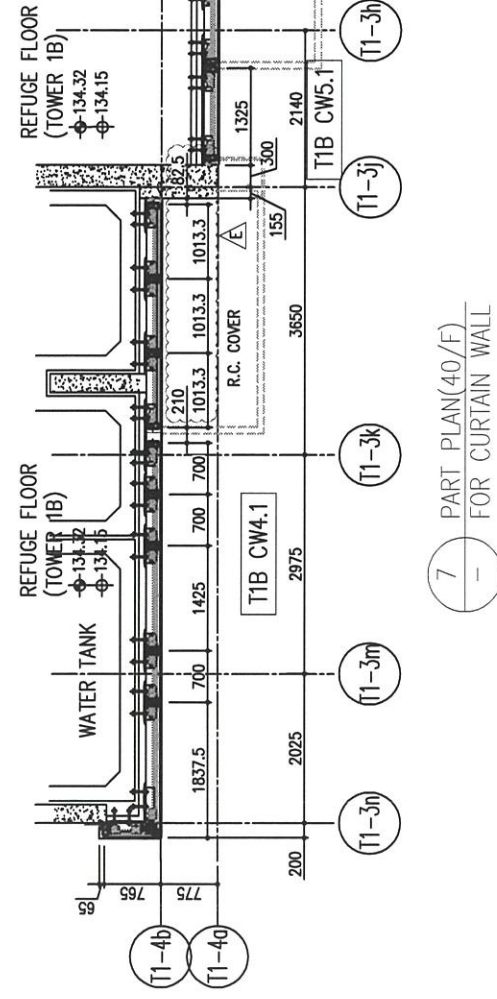

7 PART PLAN(40/F) FOR CURTAIN WALL

26/F	+91.25	39/F	+130.85	52/F	+170.40	R/F	+203.80
25/F	+87.95	38/F	+127.55	51/F	+167.10	62/F	+200.30
23/F	+84.65	37/F	+124.25	50/F	+163.80	61/F	+196.80
22/F	+81.35	36/F	+120.95	49/F	+160.50	60/F	+193.50
21/F	+78.05	35/F	+117.65	48/F	+157.20	59/F	+190.20
20/F	+74.75	33/F	+114.35	47/F	+153.90	58/F	+188.90
19/F	+71.45	32/F	+111.05	46/F	+150.60	57/F	+183.60
18/F	+68.15	31/F	+107.75	45/F	+147.30	56/F	+180.30
17/F	+64.85	30/F	+104.45	43/F	+144.00	55/F	+177.00
16/F	+61.55	29/F	+101.15	42/F	+140.70	53/F	+173.70
15/F	+58.25	28/F	+97.85	41/F	+137.40		
12/F	+54.95	27/F	+94.55	40/F	+134.15		

**LEGEND:**

- (C1) 10mm THK. HEAT STRENGTHENED GLASS (OUTSIDE) + 12mm AIR SPACE + 12mm THK. TEMPERED GLASS
- (C2) 10mm THK. HEAT STRENGTHENED GLASS (OUTSIDE) + 12mm AIR SPACE + 10mm THK. TEMPERED GLASS
- (C3) 12mm THK. HEAT STRENGTHENED GLASS
- (C4) 12mm THK. CLEAR TEMPERED GLASS (INTERNAL PROTECTIVE BARRIER)
- (C5) 12mm CLEAR HEAT STRENGTHENED GLASS
- (C6) 10mm THK. CLEAR TEMPERED GLASS
- (C7) 8mm THK. CLEAR HEAT-STRENGTHENED GLASS + 1.52mm ALUM. GLASS + 8mm THK. CLEAR HEAT-STRENGTHENED GLASS
- (C8) 3mm THK. ALUM. GLASSING
- S.J. 3mm THK. ALUM. BACKPAN

DELETED

B.D. REF :

CLIENT :  
 信和置業有限公司  
 Sino Land Company Limited

ARCHITECT :  
 ronald lu & partners  
 Architects Partners Interior Designers  
 Ronald Lu & Partners (HK) Ltd.  
 呂元祥建築師事務所 (香港) 有限公司

MAIN CONTRACTOR :  
 Gammon

STRUCTURAL ENGINEER :  
 AECOM

FAÇADE CONSULTANT:  
 AECOM

**NOTE :**

1. ALL DIMENSIONS ARE IN mm.
2. ALL ELEVATIONS ARE VIEWED FROM OUTSIDE.
3. ALL DIMENSIONS TO BE VERIFIED ON SITE BEFORE FABRICATION.

**LEGEND :**

- (X1) — DETAIL MARK NO.
- (X001) — REFER SHEET NO.

1. F.F.L. — FINISHED FLOOR LEVEL
2. S.F.L. — STRUCTURAL FLOOR LEVEL
3. (R) — REVERSED DETAIL

NO.	DATE	REVISED	BY
E	23/05/22	REVISED AS PER COMMENTS	LS
D	06/04/22	REVISED AS PER COMMENTS	LS
C	16/02/22	REVISED AS PER COMMENTS	LS
B	20/12/21	REVISED AS PER COMMENTS	LS
A	03/12/21	REVISED AS PER COMMENTS	LS

JOB NO. : J-858  
 PROJECT : PROPOSED RESIDENTIAL DEVELOPMENT AT TKOTL 70RP, PHASE 11, LOHAS PARK TSEUNG KWAN O, N.T.

TITLE : TYPICAL FLOOR PARTIAL ELEVATION & SECTION, PLAN FOR CURTAIN WALL (TOWER 1)

DATE : 22-OCT-21 SCALE : 1:50(A1)

DRAWN BY : CHECKED BY :

美特鋁質有限公司  
 MIDI ALUMINIUM FABRICATOR LTD.  
 Units 6-8, Sunray Industrial Centre, 1/F  
 610 Cha Kwo Ling Road, Kowloon  
 Tel:23489211-4 Fax:(852)27727666


DWG NO. : J858-CW-PE110 REV. : E



26/F	+91.25	39/F	+130.85	52/F	+170.40	R/F	+203.80
25/F	+87.95	38/F	+127.55	51/F	+167.10	62/F	+200.30
23/F	+84.65	37/F	+124.25	50/F	+163.80	61/F	+196.80
22/F	+81.35	36/F	+120.95	49/F	+160.50	60/F	+193.50
21/F	+78.05	35/F	+117.65	48/F	+157.20	59/F	+190.20
20/F	+74.75	33/F	+114.35	47/F	+153.90	58/F	+186.90
19/F	+71.45	32/F	+111.05	46/F	+150.60	57/F	+183.60
18/F	+68.15	31/F	+107.75	45/F	+147.30	56/F	+180.30
17/F	+64.85	30/F	+104.45	43/F	+144.00	55/F	+177.00
16/F	+61.55	29/F	+101.15	42/F	+140.70	54/F	+173.70
15/F	+58.25	28/F	+97.85	41/F	+137.40		
12/F	+54.95	27/F	+94.55	40/F	+134.15		

**LEGEND:**

- (G1) 10mm THK. HEAT STRENGTHENED GLASS (OUTSIDE) + 12mm AIR SPACE + 12mm THK. TEMPERED GLASS
- (G2) 10mm THK. HEAT STRENGTHENED GLASS (OUTSIDE) + 12mm AIR SPACE + 10mm THK. TEMPERED GLASS
- (G3) 12mm THK. HEAT STRENGTHENED GLASS (INTERNAL PROTECTIVE BARRIER)
- (G4) 12mm THK. CLEAR TEMPERED GLASS
- (G5) 12mm CLEAR HEAT STRENGTHENED GLASS
- (G6) 10mm THK. CLEAR TEMPERED GLASS
- (G7) 8mm THK. CLEAR HEAT-STRENGTHENED GLASS + 1.52mm PVB + 8mm THK. CLEAR HEAT-STRENGTHENED GLASS
- (G8) 3 mm THK. ALUM. CLADDING
- (S.J.) 3 mm THK. ALUM. BACKPAN - STACK JOINT

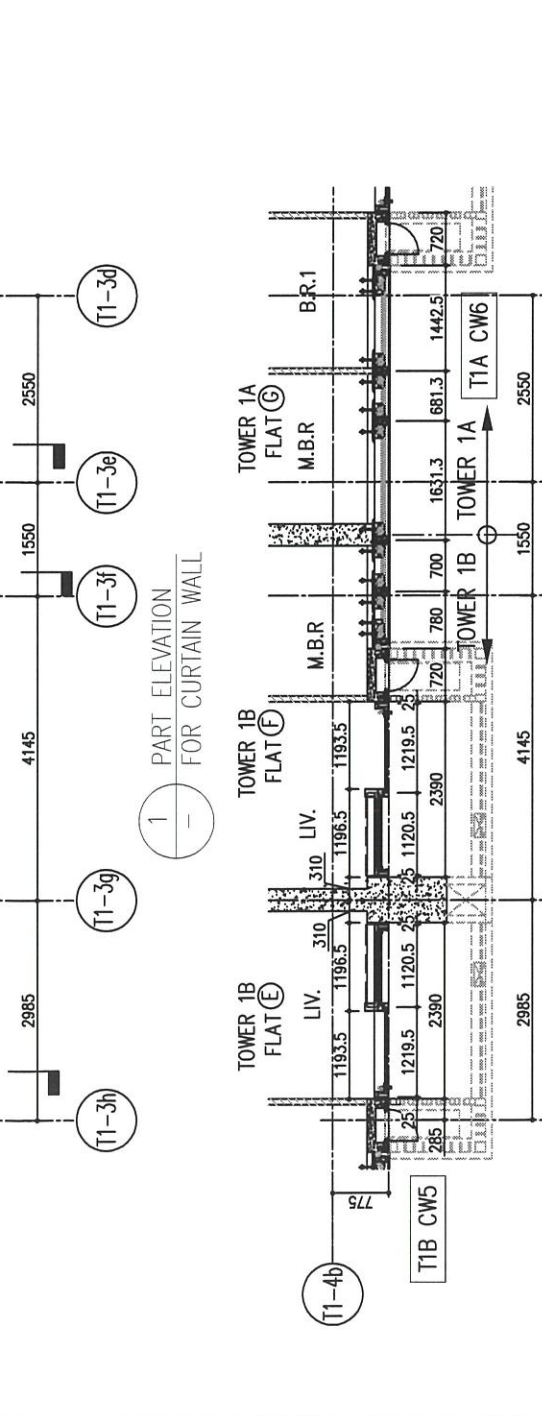

**LEGEND:**

- (X1) DETAIL MARK NO.
- (X001) REFER SHEET NO.

1. F.F.L. --- FINISHED FLOOR LEVEL  
 2. S.F.L. --- STRUCTURAL FLOOR LEVEL  
 3. (R) --- REVERSED DETAIL

**B.D. REF :**

**CLIENT :**  
 信和置業有限公司  
 Sino Land Company Limited

**ARCHITECT :**  
 ronald lu & partners  
 Architects, Planners, Interior Designers  
 Ronald Lu & Partners (HK) Ltd.  
 呂元祥建築師事務所 (香港) 有限公司

**MAIN CONTRACTOR :**  
 Gammon

**STRUCTURAL ENGINEER :**  
 AECOM

**FAÇADE CONSULTANT:**  
 AECOM

**NOTE :**  
 1. ALL DIMENSIONS ARE IN mm.  
 2. ALL ELEVATIONS ARE VIEWED FROM OUTSIDE.  
 3. ALL DIMENSIONS TO BE VERIFIED ON SITE BEFORE FABRICATION.

**REVISIONS:**

NO.	DATE	REVISION	BY
E	23/05/22	REVISED AS PER COMMENTS	LS
D	06/04/22	REVISED AS PER COMMENTS	LS
C	16/02/22	REVISED AS PER COMMENTS	LS
B	20/12/21	REVISED AS PER COMMENTS	LS
A	03/12/21	REVISED AS PER COMMENTS	LS

**JOB NO. :** J-858

**PROJECT :** PROPOSED RESIDENTIAL DEVELOPMENT AT TKOTL 70RP, PHASE 11, LOHAS PARK TSEUNG KWAN O, N.T.


**TITLE :** TYPICAL FLOOR PARTIAL ELEVATION & SECTION, PLAN FOR CURTAIN WALL (TOWER 1)

**DATE :** 22-OCT-21 **SCALE :** 1:50(A1)

**DRAWN BY :** **CHECKED BY :**

**美特鋁質有限公司**  
 MIDI ALUMINIUM FABRICATOR LTD.  
 Units 6-8, Sunray Industrial Centre, 1/F  
 610 Cha Kwo Ling Road, Kowloon  
 Tel:23489211-4 Fax:(852)2727666

**DWG NO. :** J858-CW-PE108 **REV. :** E


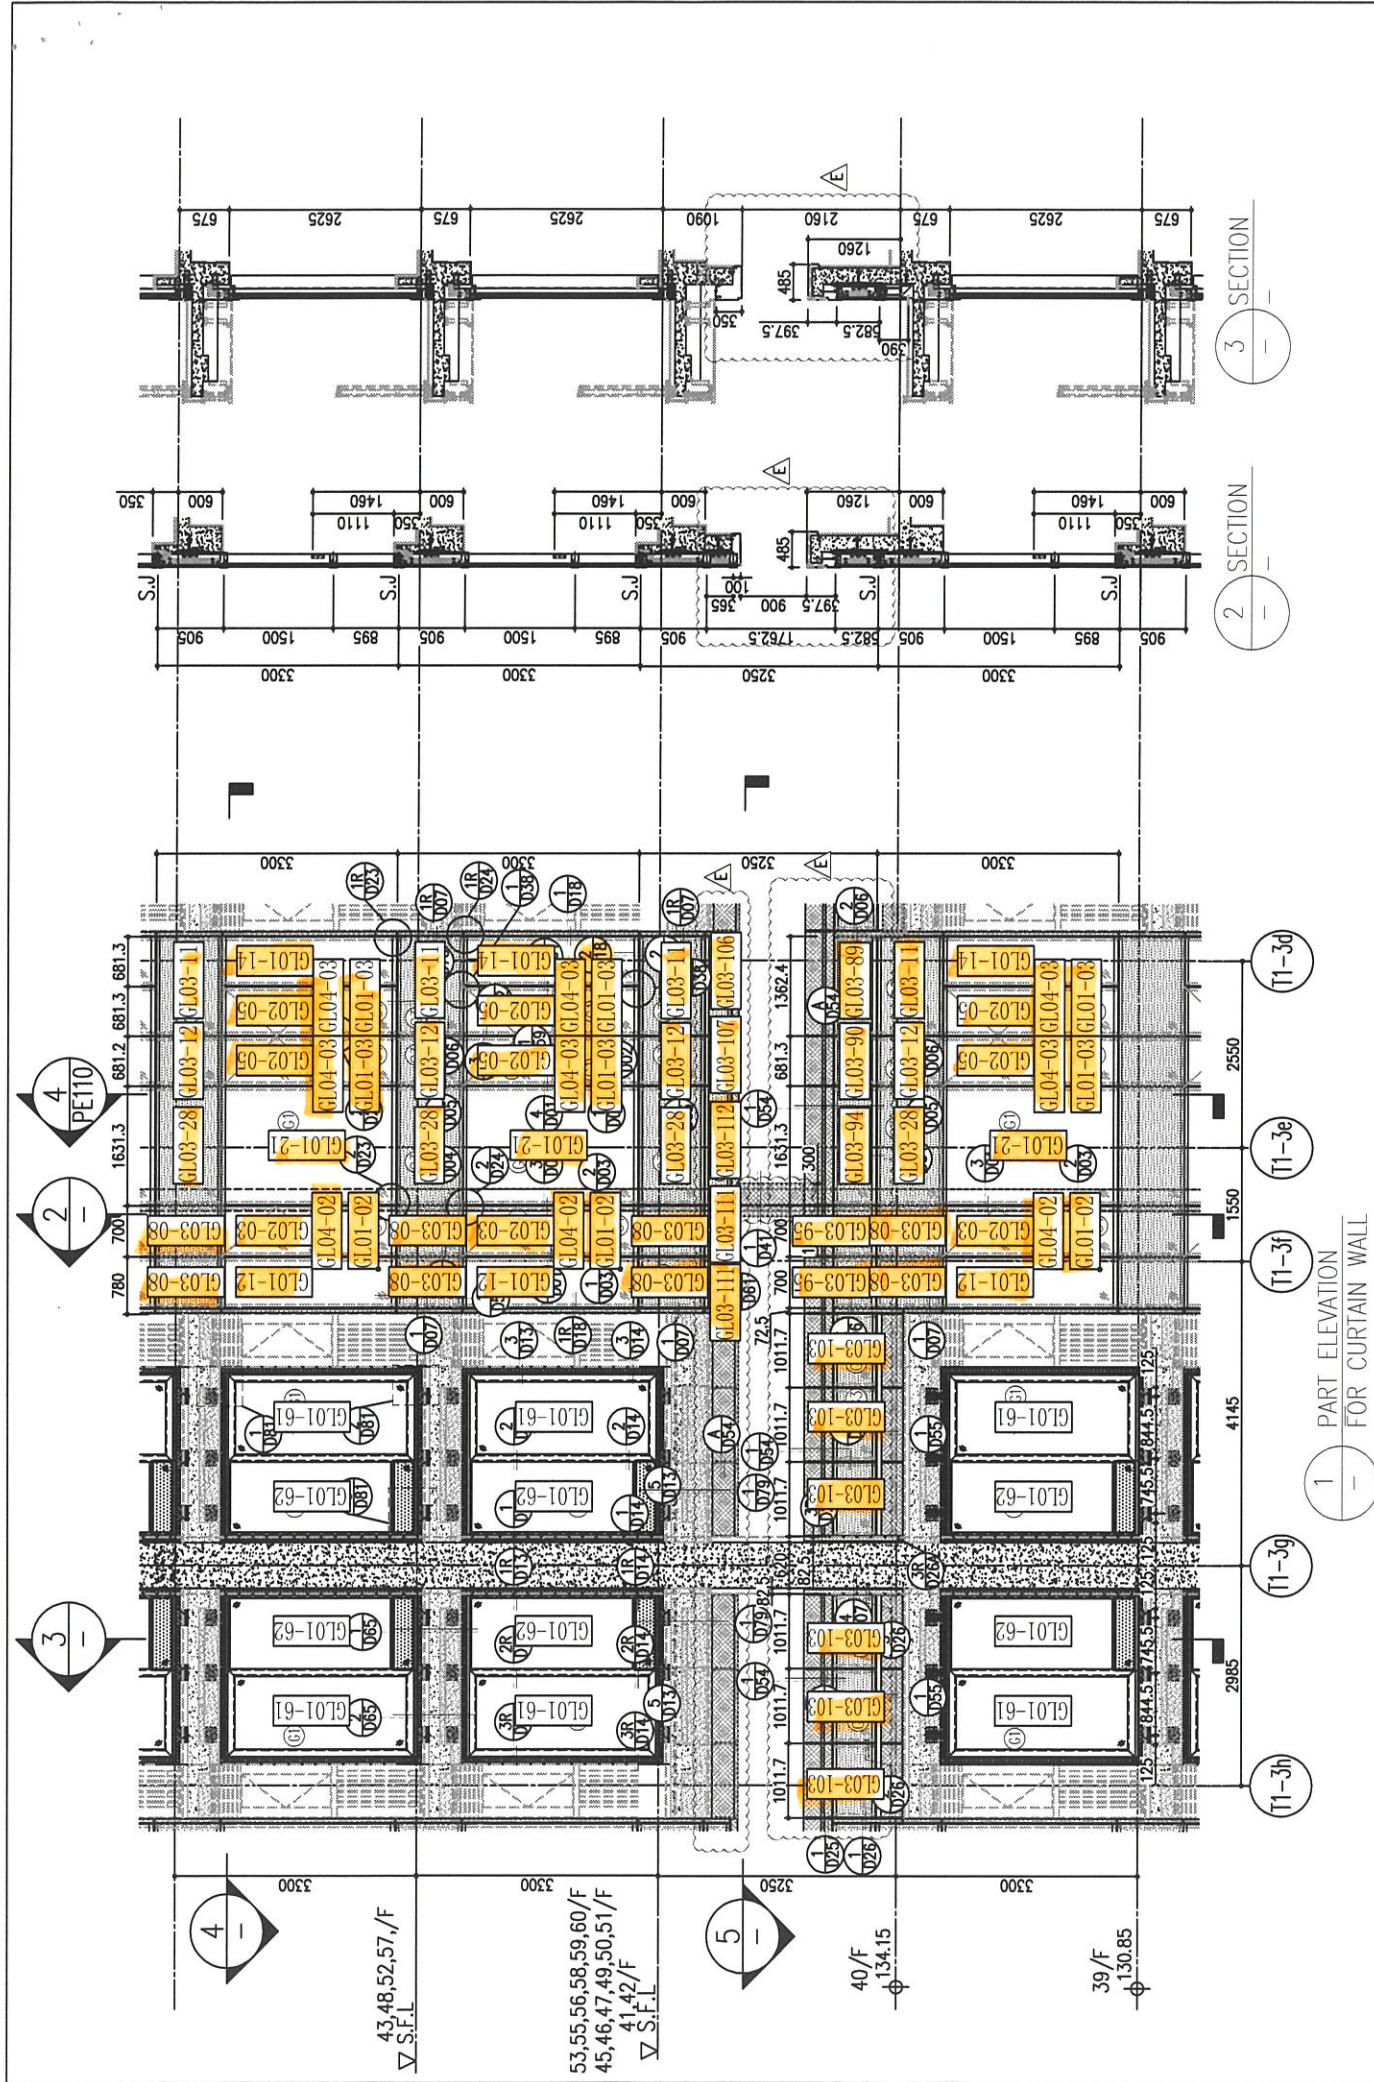


26/F	+91.25	39/F	+130.85	52/F	+170.40	R/F	+203.80
25/F	+87.95	38/F	+127.55	51/F	+167.10	62/F	+200.30
23/F	+84.65	37/F	+124.25	50/F	+163.80	61/F	+196.80
22/F	+81.35	36/F	+120.95	49/F	+160.50	60/F	+193.50
21/F	+78.05	35/F	+117.65	48/F	+157.20	59/F	+190.20
20/F	+74.75	33/F	+114.35	47/F	+153.90	58/F	+186.90
19/F	+71.45	32/F	+111.05	46/F	+150.60	57/F	+183.60
18/F	+68.15	31/F	+107.75	45/F	+147.30	56/F	+180.30
17/F	+64.85	30/F	+104.45	44/F	+144.00	55/F	+177.00
16/F	+61.55	29/F	+101.15	42/F	+140.70	54/F	+173.70
15/F	+58.25	28/F	+97.85	41/F	+137.40		
12/F	+54.95	27/F	+94.55	40/F	+134.15		

**LEGEND:**

- (G1) 10mm THK. HEAT STRENGTHENED GLASS (OUTSIDE) + 12mm AIR SPACE + 12mm THK. TEMPERED GLASS
- (G2) 10mm THK. HEAT STRENGTHENED GLASS (OUTSIDE) + 12mm AIR SPACE + 10mm THK. TEMPERED GLASS
- (G3) 12mm THK. HEAT STRENGTHENED GLASS
- (G4) 12mm THK. CLEAR TEMPERED GLASS (INTERNAL PROTECTIVE BARRIER)
- (G5) 12mm CLEAR HEAT STRENGTHENED GLASS
- (G6) 10mm THK. CLEAR TEMPERED GLASS
- (G7) 8mm THK. CLEAR HEAT STRENGTHENED GLASS + 1.52mm ALUM. CLADDING + 8mm THK. CLEAR HEAT-STRENGTHENED GLASS
- (G8) 3mm THK. ALUM. CLADDING
- S.J. 3mm THK. ALUM. BACKPAN

**DELETED**

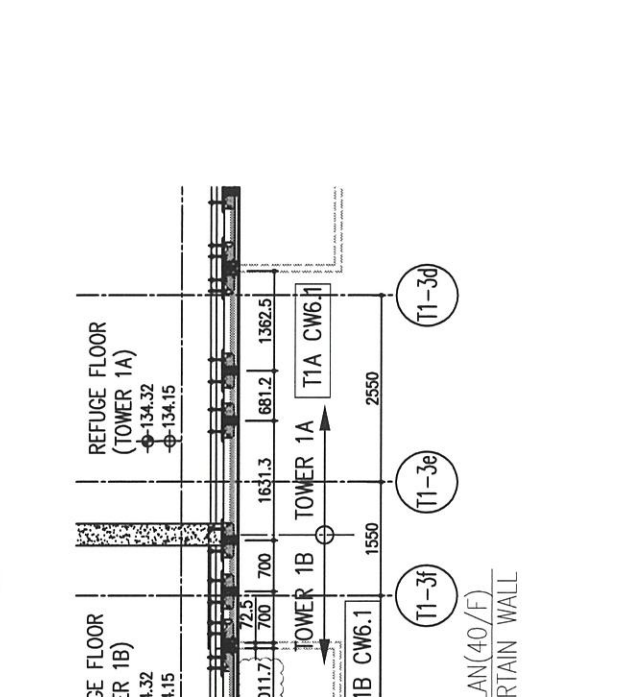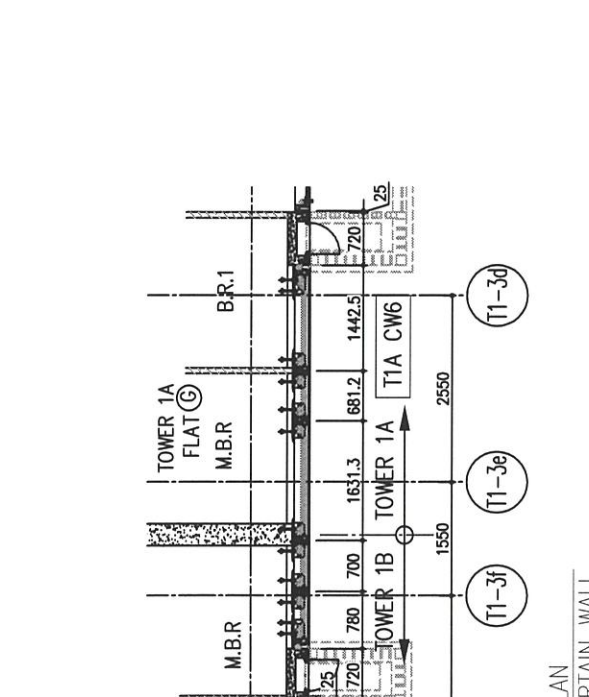

B.D. REF :

CLIENT :  
 信和置業有限公司  
 Sino Land Company Limited

ARCHITECT :  
 ronald lu & partners  
 Architects, Planners, Interior Designers  
 Ronald Lu & Partners (HK) Ltd.  
 呂元祥建築師事務所 (香港) 有限公司

MAIN CONTRACTOR :  
 Gammon

STRUCTURAL ENGINEER :  
 AECOM

FAÇADE CONSULTANT:  
 AECOM

**NOTE :**

- ALL DIMENSIONS ARE IN mm.
- ALL ELEVATIONS ARE VIEWED FROM OUTSIDE.
- ALL DIMENSIONS TO BE VERIFIED ON SITE BEFORE FABRICATION.

**LEGEND :**

- (X1) — DETAIL MARK NO.
- (X001) — REFER SHEET NO.

- F.F.L. — FINISHED FLOOR LEVEL
- S.F.L. — STRUCTURAL FLOOR LEVEL
- (R) — REVERSED DETAIL

NO.	DATE	REVISED	BY
E	23/05/22	REVISED AS PER COMMENTS	LS
D	06/04/22	REVISED AS PER COMMENTS	LS
C	16/02/22	REVISED AS PER COMMENTS	LS
B	20/12/21	REVISED AS PER COMMENTS	LS
A	03/12/21	REVISED AS PER COMMENTS	LS

JOB NO. : J-858  
 PROJECT : PROPOSED RESIDENTIAL DEVELOPMENT AT TKOTL 70RP, PHASE 11, LOHAS PARK TSEUNG KWAN O, N.T.

TITLE : TYPICAL FLOOR PARTIAL ELEVATION & SECTION, PLAN FOR CURTAIN WALL (TOWER 1)

DATE : 22-OCT-21 SCALE : 1:50(A1)

DRAWN BY : CHECKED BY :

美特鋁質有限公司  
 MIDI ALUMINIUM FABRICATOR LTD.  
 Units 6-8, Sunray Industrial Centre, 1/F  
 610 Cha Kwo Ling Road, Kowloon  
 Tel:23489211-4 Fax:(852)27727666

DWG NO. : J858-CW-PE111 REV. : E



26/F	+91.25	39/F	+130.85	52/F	+170.40	R/F	+203.80
25/F	+87.95	38/F	+127.55	51/F	+167.10	62/F	+200.30
23/F	+84.65	37/F	+124.25	50/F	+163.80	61/F	+196.80
22/F	+81.35	36/F	+120.95	49/F	+160.50	60/F	+193.50
21/F	+78.05	35/F	+117.65	48/F	+157.20	59/F	+190.20
20/F	+74.75	33/F	+114.35	47/F	+153.90	58/F	+186.90
19/F	+71.45	32/F	+111.05	46/F	+150.60	57/F	+183.60
18/F	+68.15	31/F	+107.75	45/F	+147.30	56/F	+180.30
17/F	+64.85	30/F	+104.45	44/F	+144.00	55/F	+177.00
16/F	+61.55	29/F	+101.15	43/F	+140.70	54/F	+173.70
15/F	+58.25	28/F	+97.85	42/F	+137.40		
12/F	+54.95	27/F	+94.55	40/F	+134.15		


**LEGEND:**

- 10mm THK. HEAT STRENGTHENED GLASS (OUTSIDE) + 12mm AIR SPACE + 12mm THK. TEMPERED GLASS
- 10mm THK. HEAT STRENGTHENED GLASS (OUTSIDE) + 12mm AIR SPACE + 10mm THK. TEMPERED GLASS
- 12mm THK. HEAT STRENGTHENED GLASS
- 12mm THK. CLEAR TEMPERED GLASS (INTERNAL PROTECTIVE BARRIER)
- 12mm CLEAR HEAT STRENGTHENED GLASS
- 10mm THK. CLEAR TEMPERED GLASS
- 8mm THK. CLEAR HEAT-STRENGTHENED GLASS + 1.52mm PVB + 8mm THK. CLEAR HEAT-STRENGTHENED GLASS
- 3 mm THK. ALUM. GLASSING
- 3 mm THK. ALUM. BACKPAN
- S.J. - STACK JOINT

**DELETED**

ARCH. FEATURE AT 11/F, 17/F, 21/F, 26/F, 30/F, 35/F,

ARCH. FEATURE AT 9/F, 10/F, 12/F, 15/F-16/F, 18/F-20/F, 22/F, 23/F, 25/F, 27/F-29/F, 31/F-33/F, 36/F-38/F,

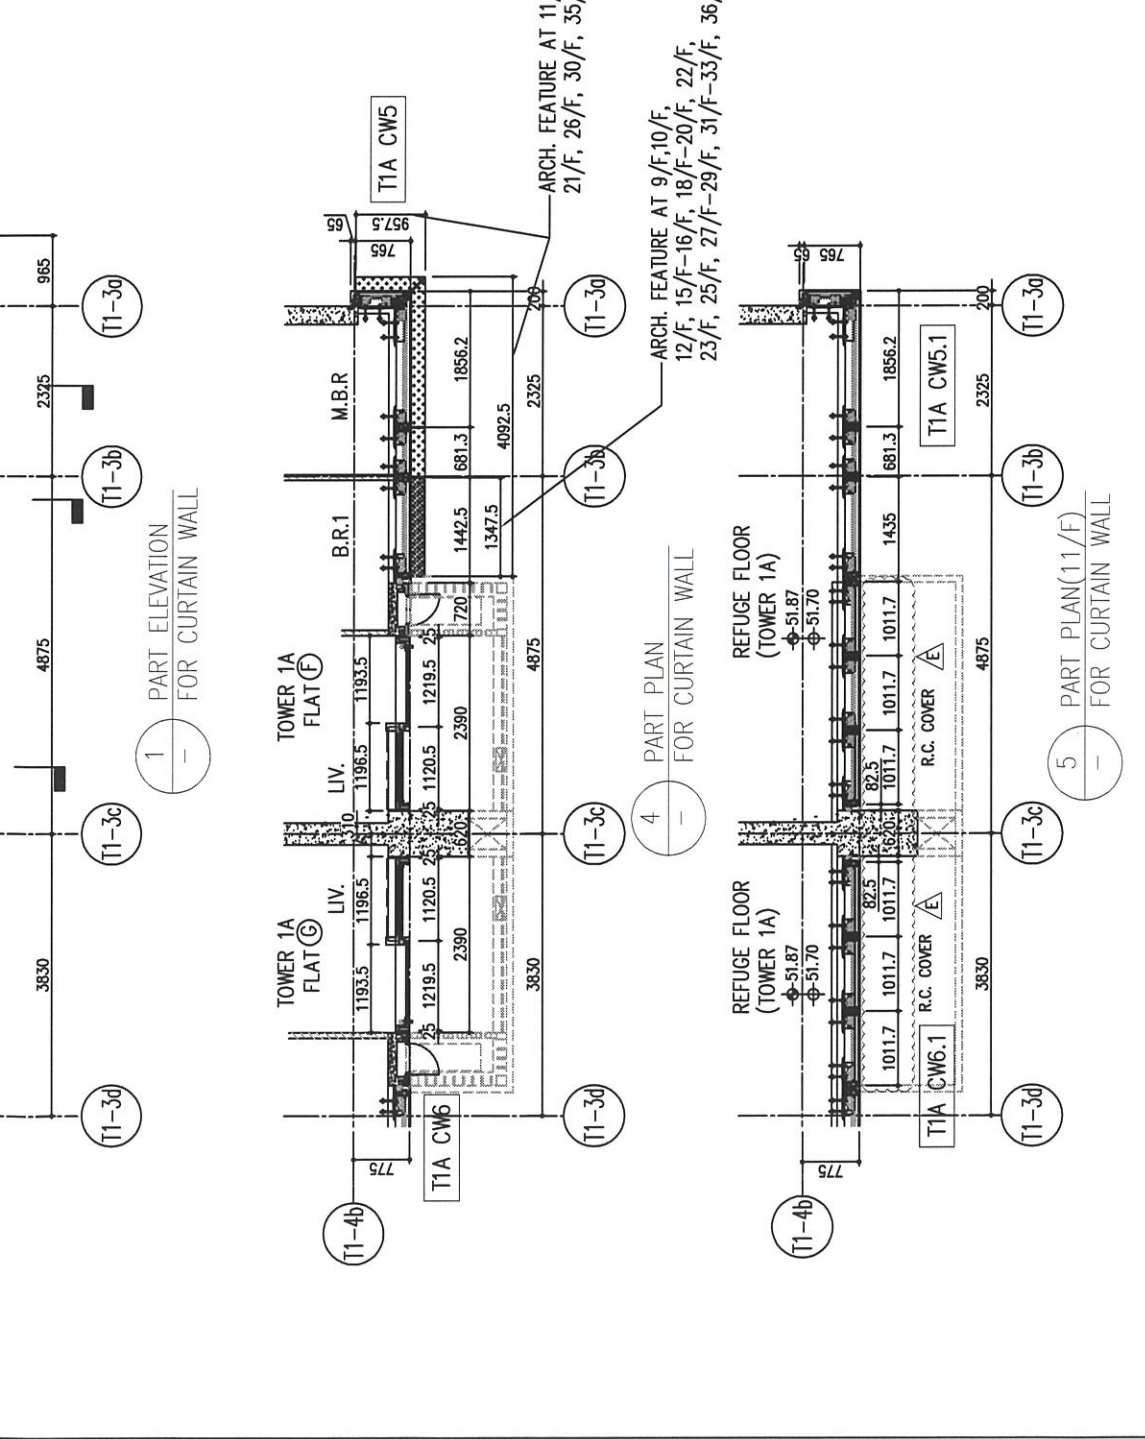

B.D. REF :

CLIENT : 信和置業有限公司 Sino Land Company Limited

ARCHITECT : Ronald Lu & Partners Architects, Planners, Interior Designers Ronald Lu & Partners (HK) Ltd. 呂元祥建築師事務所 (香港) 有限公司

MAIN CONTRACTOR : Gammon

STRUCTURAL ENGINEER : AECOM

FAÇADE CONSULTANT : AECOM

**NOTE :**

- ALL DIMENSIONS ARE IN mm.
- ALL ELEVATIONS ARE VIEWED FROM OUTSIDE.
- ALL DIMENSIONS TO BE VERIFIED ON SITE BEFORE FABRICATION.

**LEGEND :**

- X1 - DETAIL MARK NO.
- X001 - REFER SHEET NO.
- F.F.L. - FINISHED FLOOR LEVEL
- S.F.L. - STRUCTURAL FLOOR LEVEL
- ⊕ - REVERSED DETAIL

NO.	DATE	REVISED	BY
E	23/05/22	REVISED AS PER COMMENTS	LS
D	06/04/22	REVISED AS PER COMMENTS	LS
C	16/02/22	REVISED AS PER COMMENTS	LS
B	20/12/21	REVISED AS PER COMMENTS	LS
A	03/12/21	REVISED AS PER COMMENTS	LS

JOB NO. : J-858

PROJECT : PROPOSED RESIDENTIAL DEVELOPMENT AT TKOTL 70RP, PHASE 11, LOHAS PARK TSEUNG KWAN O, N.T.


TITLE : TYPICAL FLOOR PARTIAL ELEVATION & SECTION, PLAN FOR CURTAIN WALL (TOWER 1)

DATE : 22-OCT-21 SCALE : 1:50(A1)

DRAWN BY : CHECKED BY :

美特鋁質有限公司 MIDI ALUMINIUM FABRICATOR LTD. Units 6-8, Sunray Industrial Centre, 1/F 610 Cha Kwo Ling Road, Kowloon Tel:23489211-4 Fax:(852)27727666

DWG NO. : J858-CW-PE109 REV. : E

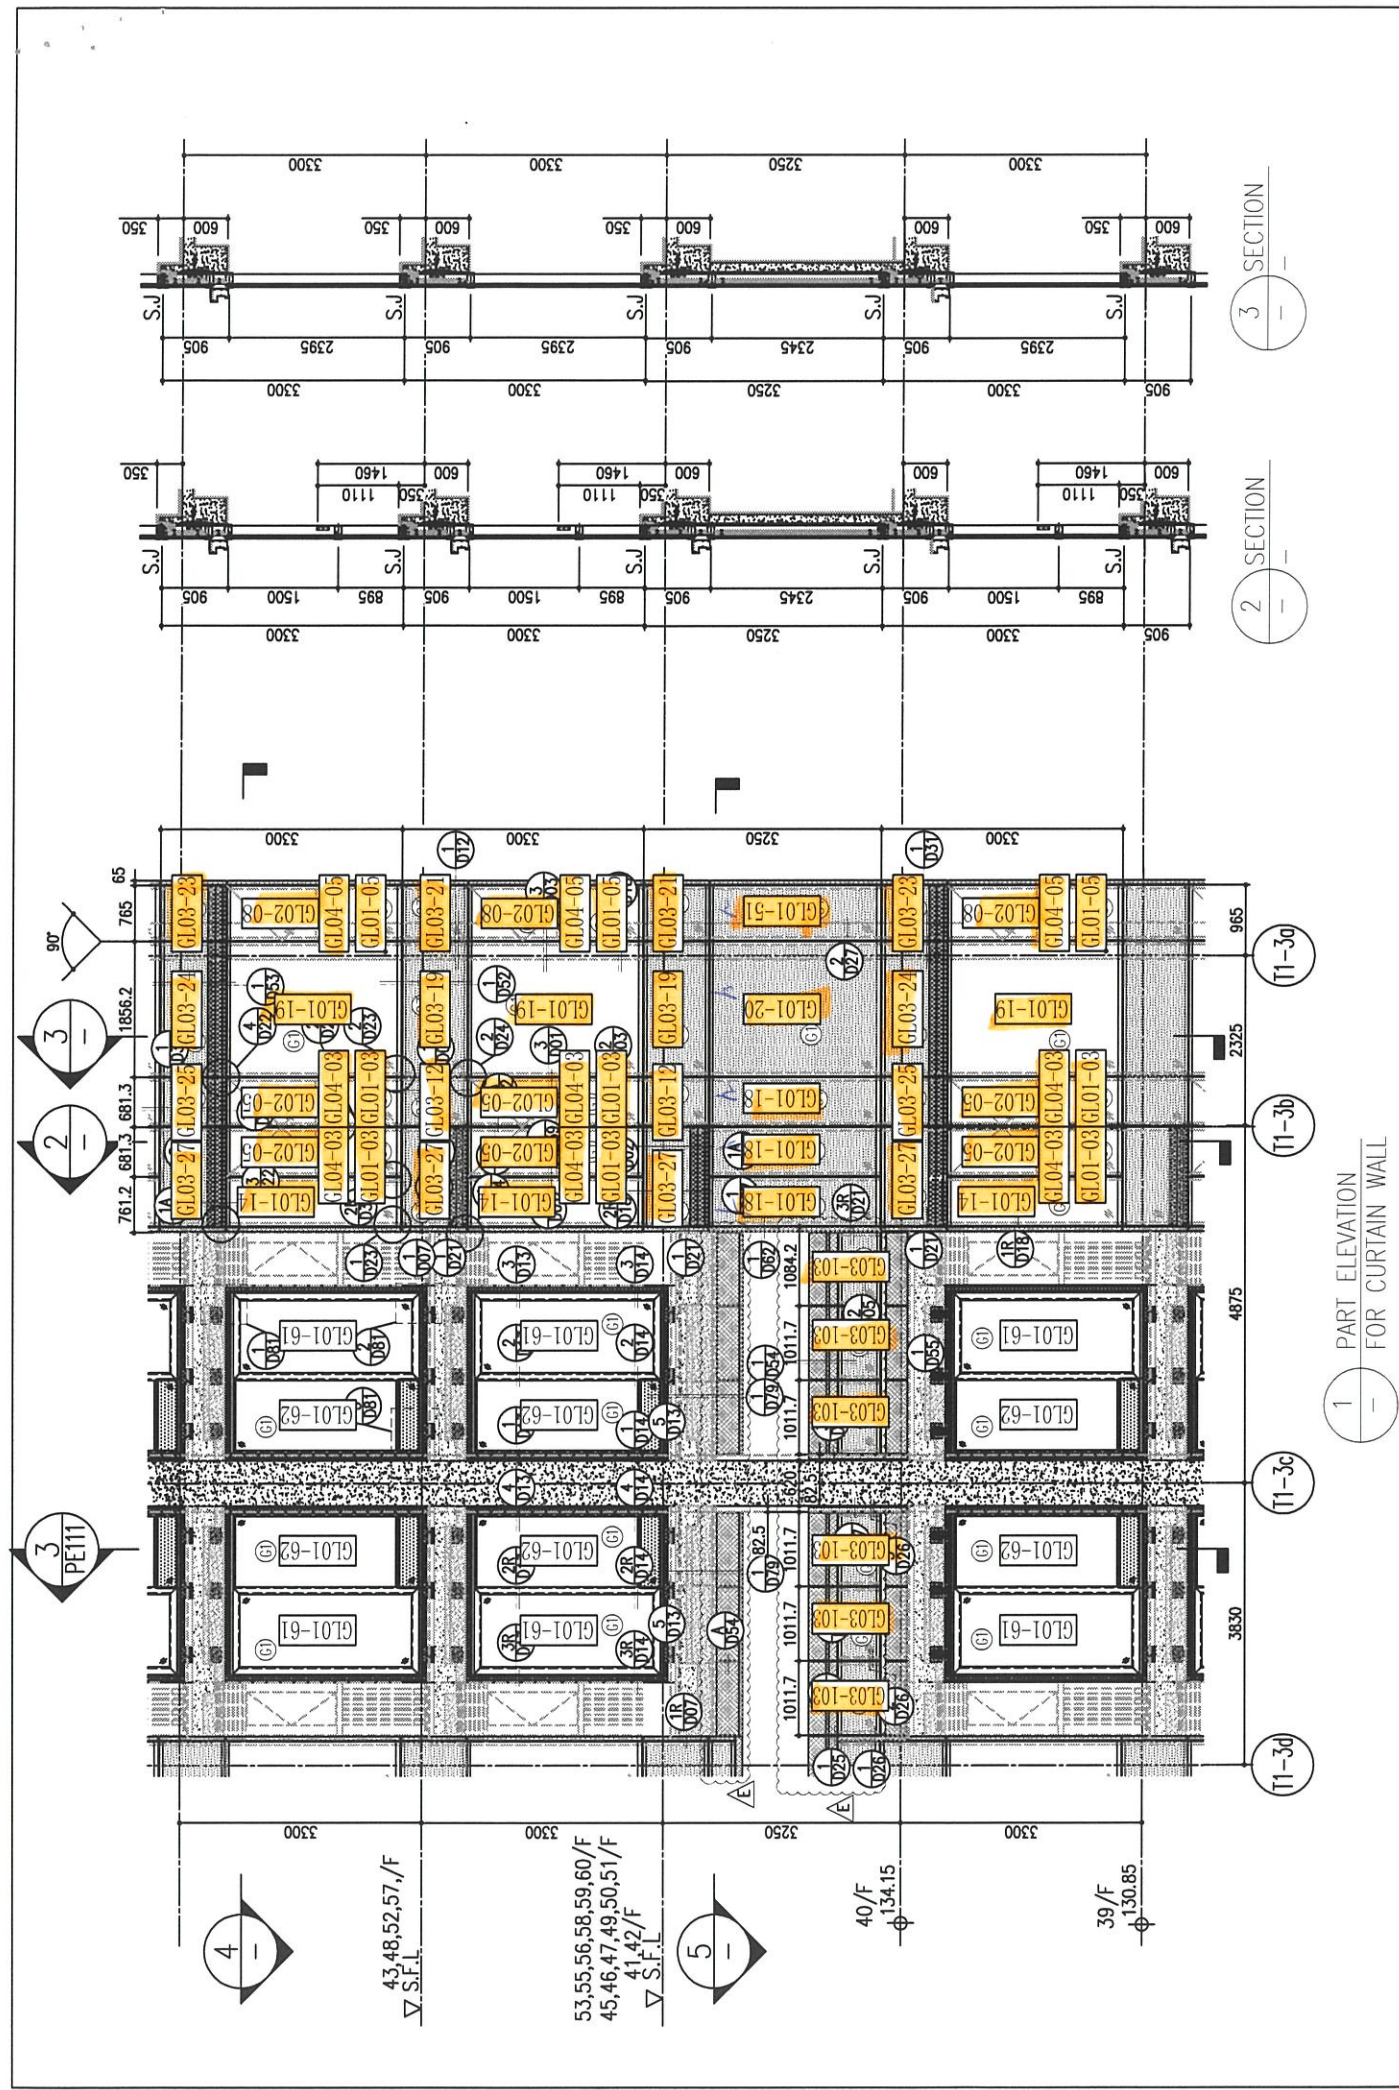


1 PART ELEVATION FOR CURTAIN WALL

2 SECTION

3 SECTION

4 PART PLAN FOR CURTAIN WALL

5 PART PLAN FOR CURTAIN WALL

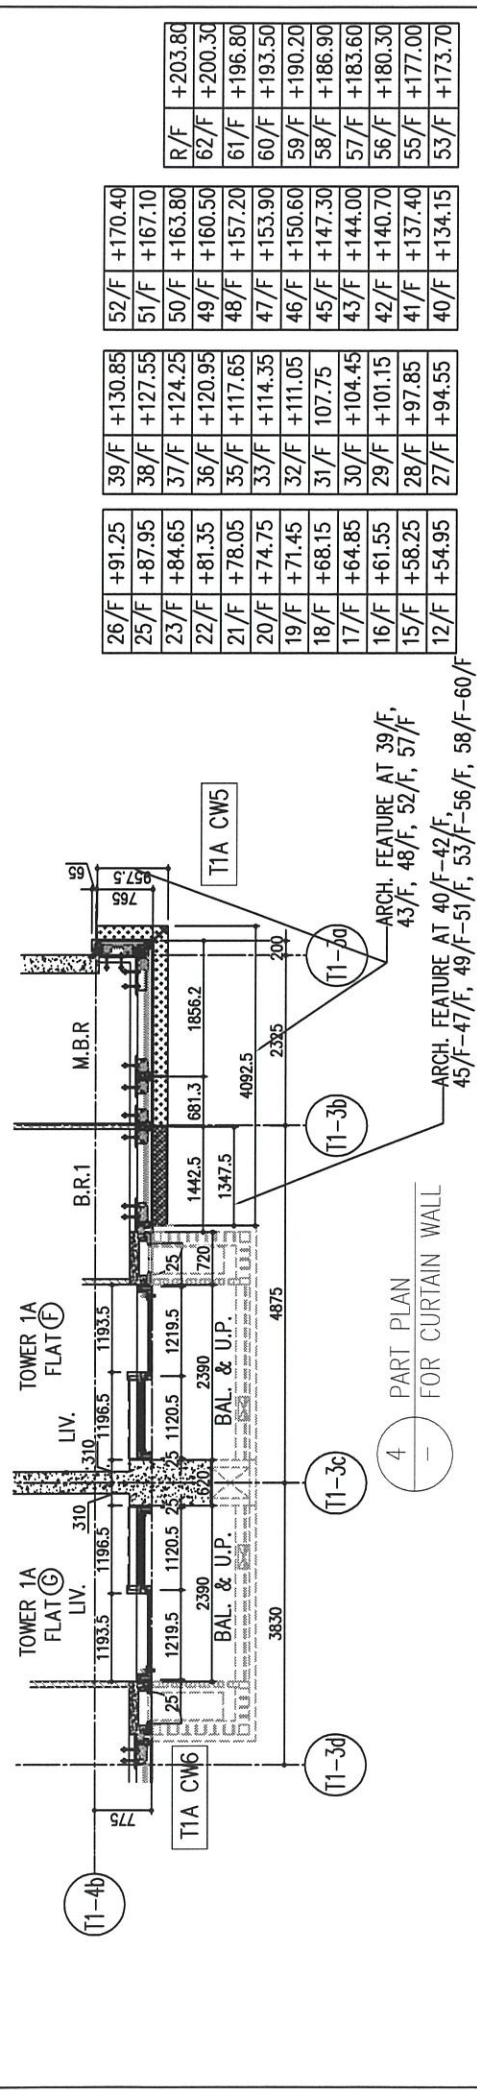

4 PART PLAN FOR CURTAIN WALL

3 SECTION

2 SECTION

4 PART PLAN FOR CURTAIN WALL

5 PART PLAN FOR CURTAIN WALL

26/F	+91.25	39/F	+130.85	52/F	+170.40	R/F	+203.80
25/F	+87.95	38/F	+127.55	51/F	+167.10	62/F	+200.30
23/F	+84.65	37/F	+124.25	50/F	+163.80	61/F	+196.80
22/F	+81.35	36/F	+120.95	49/F	+160.50	60/F	+193.50
21/F	+78.05	35/F	+117.65	48/F	+157.20	59/F	+190.20
20/F	+74.75	33/F	+114.35	47/F	+153.90	58/F	+186.90
19/F	+71.45	32/F	+111.05	46/F	+150.60	57/F	+183.60
18/F	+68.15	31/F	+107.75	45/F	+147.30	56/F	+180.30
17/F	+64.85	30/F	+104.45	43/F	+144.00	55/F	+177.00
16/F	+61.55	29/F	+101.15	42/F	+140.70	53/F	+173.70
15/F	+58.25	28/F	+97.85	41/F	+137.40		
12/F	+54.95	27/F	+94.55	40/F	+134.15		

LEGEND:

- 10mm THK. HEAT STRENGTHENED GLASS (OUTSIDE) + 12mm AIR SPACE + 12mm THK. TEMPERED GLASS
- 10mm THK. HEAT STRENGTHENED GLASS (OUTSIDE) + 12mm AIR SPACE + 10mm THK. TEMPERED GLASS
- 12mm THK. HEAT STRENGTHENED GLASS
- 12mm THK. CLEAR TEMPERED GLASS (INTERNAL PROTECTIVE BARRIER)
- 12mm CLEAR HEAT STRENGTHENED GLASS
- 10mm THK. CLEAR TEMPERED GLASS
- 8mm THK. CLEAR STRENGTHENED GLASS + 1.52mm ALUM. CLADDING + 3mm THK. ALUM. CLADDING
- 3mm THK. ALUM. BACKPAN
- S.J. - STACK JOINT

B.D. REF :

CLIENT : 信和置業有限公司 Sino Land Company Limited

ARCHITECT : ronald lu & partners Architects Planners Interior Designers Ronald Lu & Partners (HK) Ltd. 呂元祥建築師事務所 (香港) 有限公司

MAIN CONTRACTOR : Gammon

STRUCTURAL ENGINEER : AECOM

FAÇADE CONSULTANT : AECOM

NOTE :

- ALL DIMENSIONS ARE IN mm.
- ALL ELEVATIONS ARE VIEWED FROM OUTSIDE.
- ALL DIMENSIONS TO BE VERIFIED ON SITE BEFORE FABRICATION.

LEGEND :

- X1 - DETAIL MARK NO.
- X001 - REFER SHEET NO.
- F.F.L. - FINISHED FLOOR LEVEL
- S.F.L. - STRUCTURAL FLOOR LEVEL
- ⊕ - REVERSED DETAIL

E	23/05/22	REVISED AS PER COMMENTS	LS
D	06/04/22	REVISED AS PER COMMENTS	LS
C	16/02/22	REVISED AS PER COMMENTS	LS
B	20/12/21	REVISED AS PER COMMENTS	LS
A	03/12/21	REVISED AS PER COMMENTS	LS

NO. DATE REVISION BY

JOB NO. : J-858

PROJECT : PROPOSED RESIDENTIAL DEVELOPMENT AT TKOTL 70RP, PHASE 11, LOHAS PARK TSEUNG KWAN O, N.T.


TITLE : TYPICAL FLOOR PARTIAL ELEVATION & SECTION, PLAN FOR CURTAIN WALL (TOWER 1)

DATE : 22-OCT-21 SCALE : 1:50(A1)

DRAWN BY : CHECKED BY :

美特鋁質有限公司 MIDALUMINIUM FABRICATOR LTD. Units 6-8, Sunray Industrial Centre, 1/F 610 Cho Kwo Ling Road, Kowloon Tel:23489211-4 Fax:(852)27727666

DWG NO. : J858-CW-PE112 REV. : E

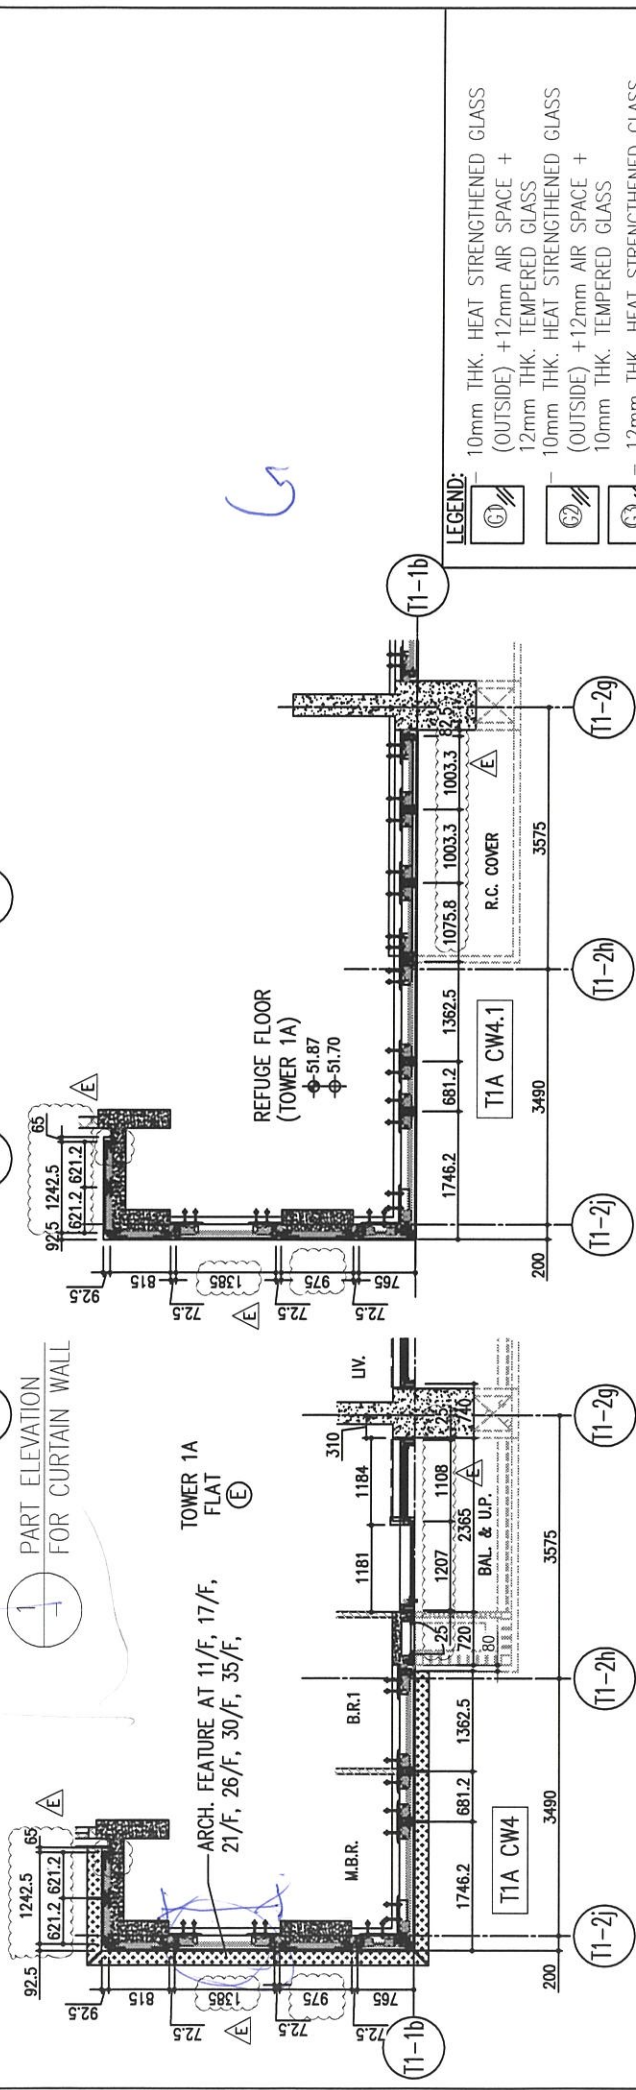

**LEGEND:**

- (G1) 10mm THK. HEAT STRENGTHENED GLASS (OUTSIDE) + 12mm AIR SPACE + 12mm THK. TEMPERED GLASS
- (G2) 10mm THK. HEAT STRENGTHENED GLASS (OUTSIDE) + 12mm AIR SPACE + 10mm THK. TEMPERED GLASS
- (G3) 10mm THK. HEAT STRENGTHENED GLASS (OUTSIDE) + 12mm AIR SPACE + 10mm THK. TEMPERED GLASS
- (G4) 12mm THK. CLEAR TEMPERED GLASS (INTERNAL PROTECTIVE BARRIER)
- (G5) 10mm THK. BLUE TINTED HEAT STRENGTHENED GLASS
- (G6) 10mm THK. CLEAR TEMPERED GLASS
- (G7) 8mm THK. CLEAR HEAT STRENGTHENED GLASS + 1.52mm THK. CLEAR HEAT-STRENGTHENED GLASS + 3mm THK. ALUM. CLADDING
- (G8) 3mm THK. ALUM. BACKPAN
- (S.J.) STACK JOINT

**LEGEND:**

- (X1) DETAIL MARK NO.
- (X001) REFER SHEET NO.

**NOTE:**

- ALL DIMENSIONS ARE IN mm.
- ALL ELEVATIONS ARE VIEWED FROM OUTSIDE.
- ALL DIMENSIONS TO BE VERIFIED ON SITE BEFORE FABRICATION.

**LEGEND:**

- 1. F.F.L. --- FINISHED FLOOR LEVEL
- 2. S.F.L. --- STRUCTURAL FLOOR LEVEL
- 3. (R) --- REVERSED DETAIL

26/F	+91.25	39/F	+130.85	52/F	+170.40	R/F	+203.80
25/F	+87.95	38/F	+127.55	51/F	+167.10	62/F	+200.30
23/F	+84.65	37/F	+124.25	50/F	+163.80	61/F	+196.80
22/F	+81.35	36/F	+120.95	49/F	+160.50	60/F	+193.50
21/F	+78.05	35/F	+117.65	48/F	+157.20	59/F	+190.20
20/F	+74.75	33/F	+114.35	47/F	+153.90	58/F	+186.90
19/F	+71.45	32/F	+111.05	46/F	+150.60	57/F	+183.60
18/F	+68.15	31/F	+107.75	45/F	+147.30	56/F	+180.30
17/F	+64.85	30/F	+104.45	44/F	+144.00	55/F	+177.00
16/F	+61.55	29/F	+101.15	43/F	+140.70	53/F	+173.70
15/F	+58.25	28/F	+97.85	42/F	+137.40		
12/F	+54.95	27/F	+94.55	40/F	+134.15		

**B.D. REF :**

**CLIENT :**  
 信和置業有限公司  
 Sino Land Company Limited

**ARCHITECT :**  
 ronald lu & partners  
 Architects / Interior Designers  
 Ronald Lu & Partners (HK) Ltd.  
 呂元祥建築師事務所 (香港) 有限公司

**MAIN CONTRACTOR :**  
 Gammon

**STRUCTURAL ENGINEER :**  
 AECOM

**FAÇADE CONSULTANT:**  
 AECOM

**NOTE :**

- ALL DIMENSIONS ARE IN mm.
- ALL ELEVATIONS ARE VIEWED FROM OUTSIDE.
- ALL DIMENSIONS TO BE VERIFIED ON SITE BEFORE FABRICATION.

**LEGEND :**

- (X1) DETAIL MARK NO.
- (X001) REFER SHEET NO.

E	23/05/22	REVISED AS PER COMMENTS	LS
D	06/04/22	REVISED AS PER COMMENTS	LS
C	17/02/22	REVISED AS PER COMMENTS	LS
B	20/12/21	REVISED AS PER COMMENTS	LS
A	03/12/21	REVISED AS PER COMMENTS	LS

**JOB NO. :** J-858

**PROJECT :**  
 PROPOSED RESIDENTIAL DEVELOPMENT  
 AT TKOTL 70RP, PHASE 11, LOHAS PARK  
 TSEUNG KWAN O, N.T.




**TITLE :**  
 TYPICAL FLOOR PARTIAL  
 ELEVATION & SECTION, PLAN  
 FOR CURTAIN WALL (TOWER 1)

**DATE :** 22-OCT-21      **SCALE :** 1:50(A1)

**DRAWN BY :**      **CHECKED BY :**

**美特鋁質有限公司**  
 MIDI ALUMINIUM FABRICATOR LTD.  
 Units 6-8, Sunray Industrial Centre, 1/F  
 610 Cha Kwo Ling Road, Kowloon  
 Tel:23489211-4 Fax:(852)2772666

**DWG NO. :** J858-CW-PE113      **REV. :** E

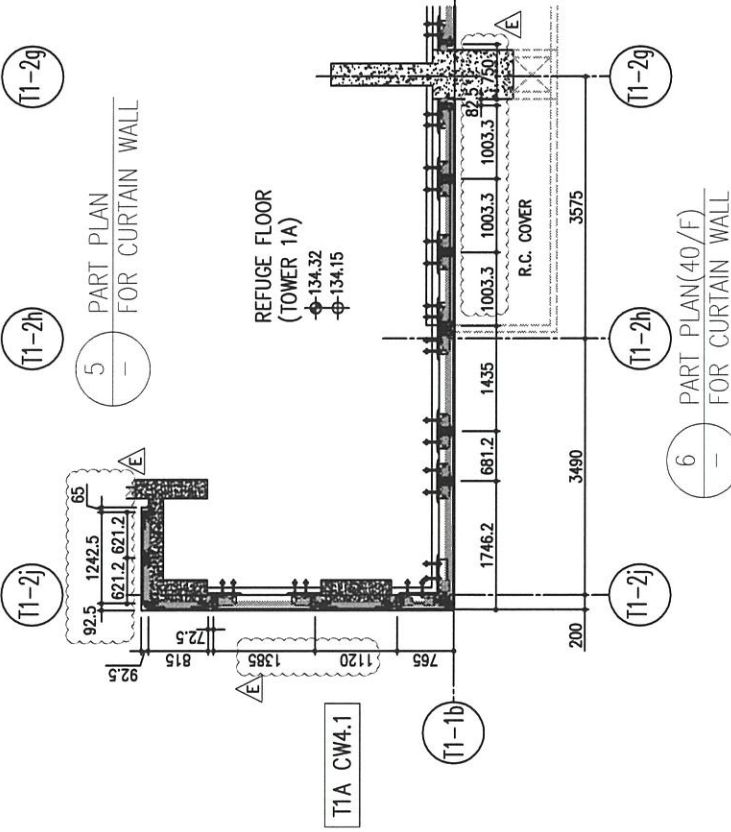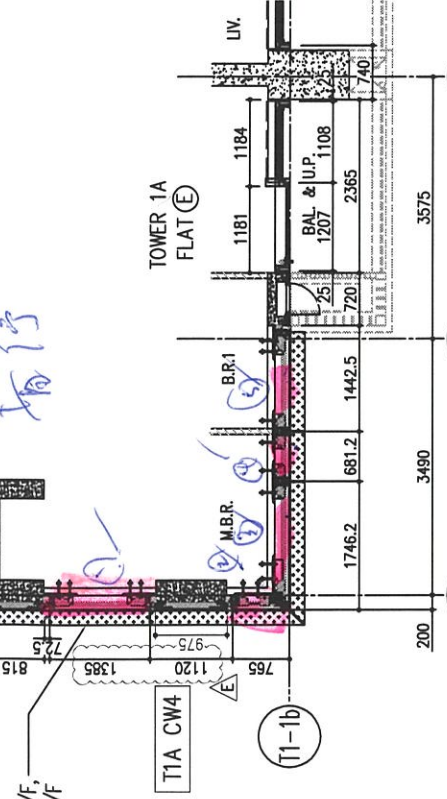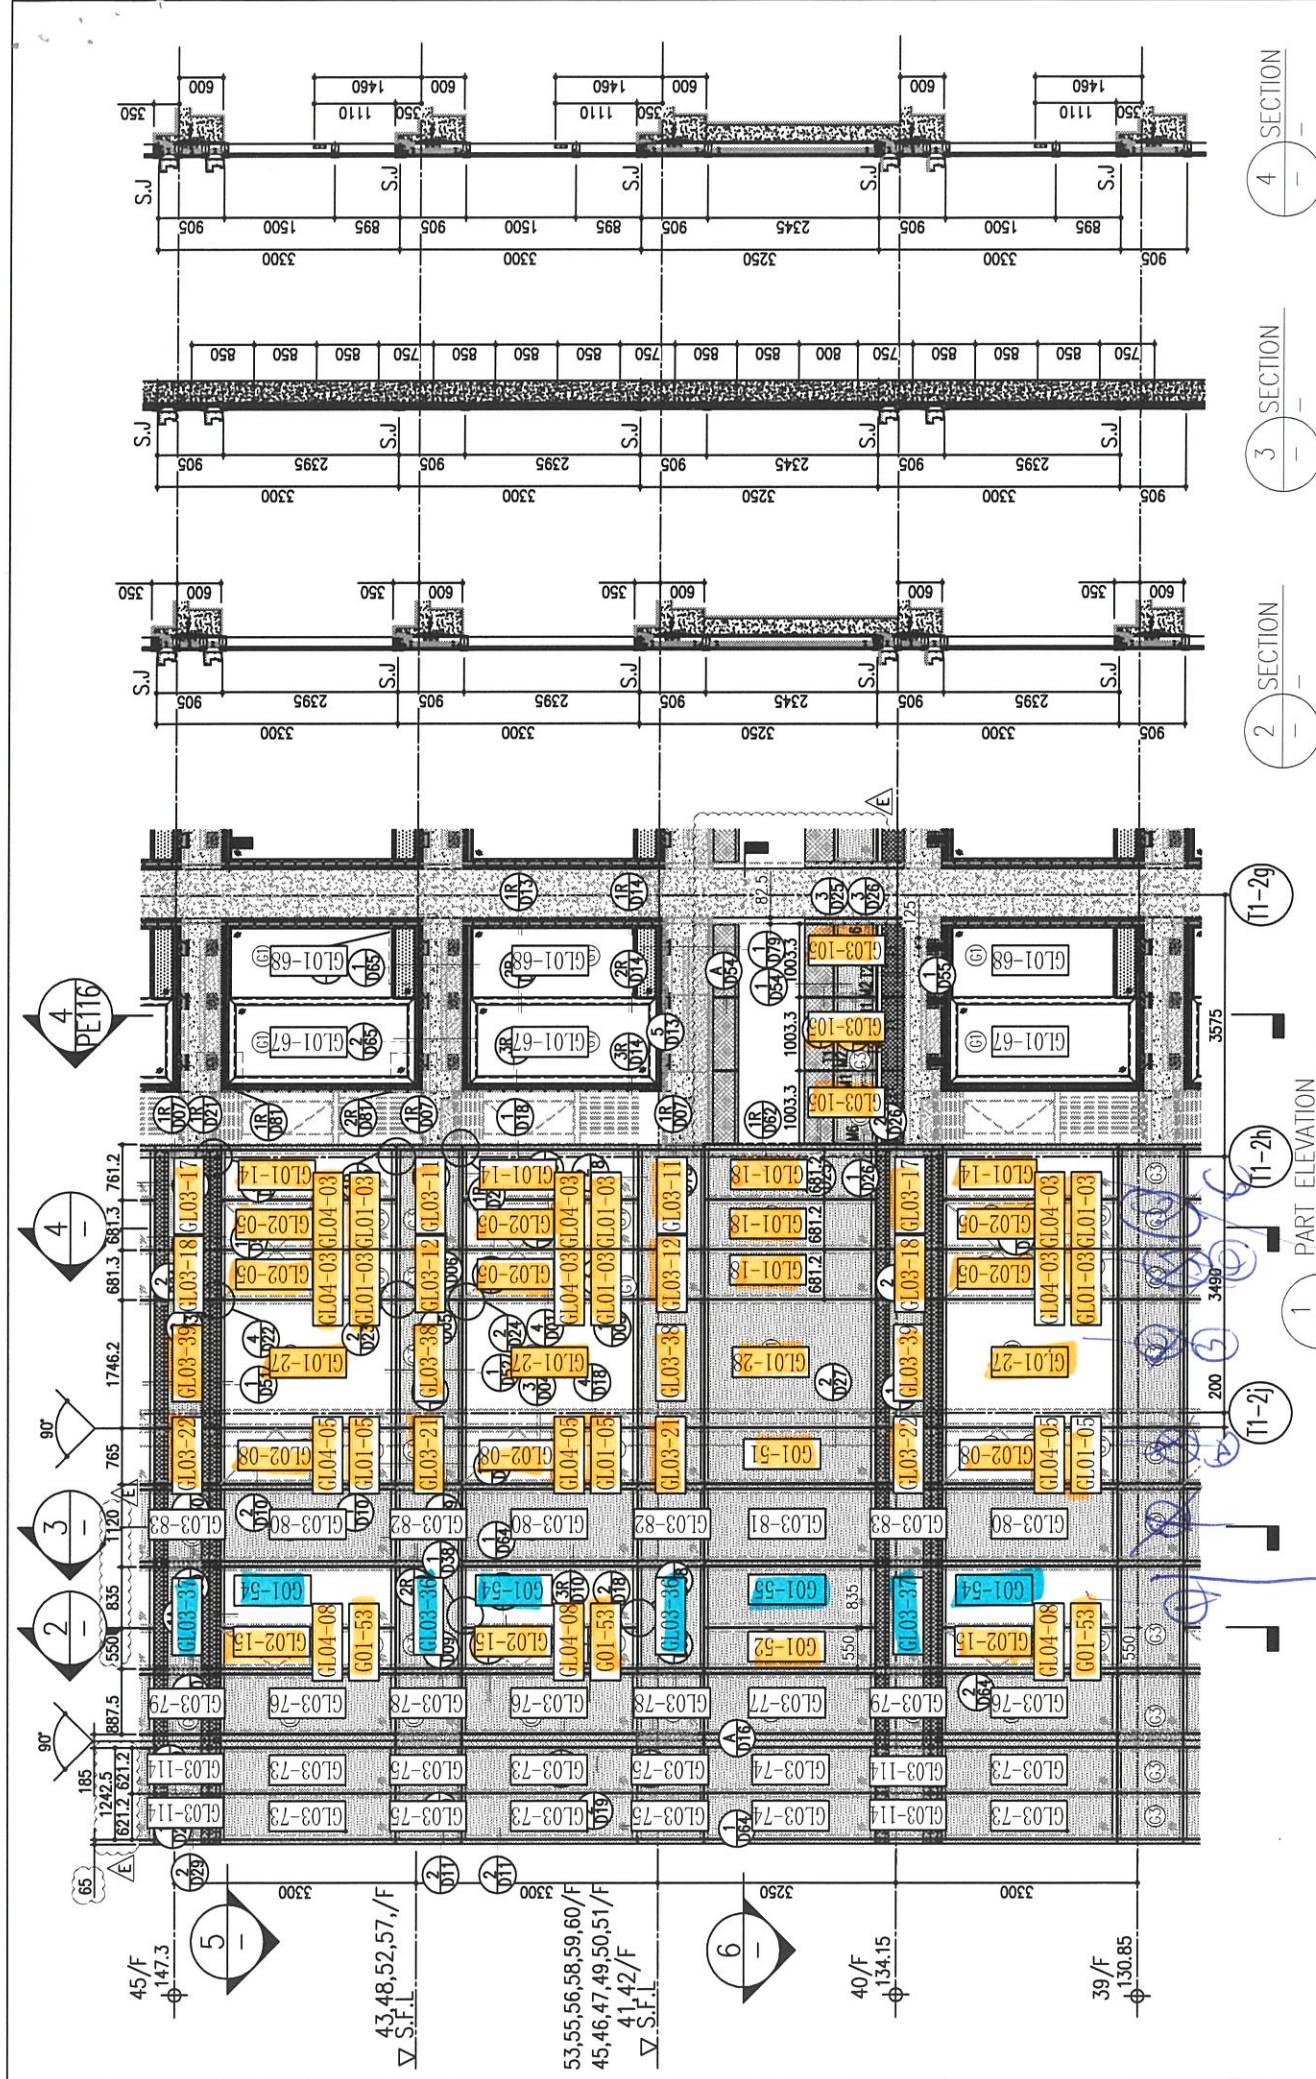

26/F	+91.25	39/F	+130.85	52/F	+170.40	R/F	+203.80
25/F	+87.95	38/F	+127.55	51/F	+167.10	62/F	+200.30
23/F	+84.65	37/F	+124.25	50/F	+163.80	61/F	+196.80
22/F	+81.35	36/F	+120.95	49/F	+160.50	60/F	+193.50
21/F	+78.05	35/F	+117.65	48/F	+157.20	59/F	+190.20
20/F	+74.75	33/F	+114.35	47/F	+153.90	58/F	+186.90
19/F	+71.45	32/F	+111.05	46/F	+150.60	57/F	+183.60
18/F	+68.15	31/F	+107.75	45/F	+147.30	56/F	+180.30
17/F	+64.85	30/F	+104.45	43/F	+144.00	55/F	+177.00
16/F	+61.55	29/F	+101.15	42/F	+140.70	53/F	+173.70
15/F	+58.25	28/F	+97.85	41/F	+137.40		
12/F	+54.95	27/F	+94.55	40/F	+134.15		

**LEGEND:**

- (G1) 10mm THK. HEAT STRENGTHENED GLASS (OUTSIDE) + 12mm AIR SPACE + 12mm THK. TEMPERED GLASS
- (G2) 10mm THK. HEAT STRENGTHENED GLASS (OUTSIDE) + 12mm AIR SPACE + 10mm THK. TEMPERED GLASS
- (G3) 12mm THK. HEAT STRENGTHENED GLASS
- (G4) 12mm THK. CLEAR TEMPERED GLASS (INTERNAL PROTECTIVE BARRIER)
- (G5) 10mm BLUE TINTED HEAT STRENGTHENED GLASS
- (G6) 10mm THK. CLEAR TEMPERED GLASS
- (G7) 8mm THK. CLEAR HEAT-STRENGTHENED GLASS + 1.52mm PVB + 8mm THK. CLEAR HEAT-STRENGTHENED GLASS
- (G8) 3mm THK. ALUM. CLADDING
- (S.J.) 3mm THK. ALUM. BACKPAN - STACK JOINT

B.D. REF :

CLIENT :  
 信和置業有限公司  
 Sino Land Company Limited

ARCHITECT :  
 ronald lu & partners  
 Technical Partners Interior Designers  
 Ronald Lu & Partners (HK) Ltd.  
 呂元祥建築師事務所 (香港) 有限公司

MAIN CONTRACTOR :  
 Gammon

STRUCTURAL ENGINEER :  
 AECOM

FAÇADE CONSULTANT:  
 AECOM

**NOTE :**  
 1. ALL DIMENSIONS ARE IN mm.  
 2. ALL ELEVATIONS ARE VIEWED FROM OUTSIDE.  
 3. ALL DIMENSIONS TO BE VERIFIED ON SITE BEFORE FABRICATION.

**LEGEND :**  
 (X1) --- DETAIL MARK NO.  
 (X001) --- REFER SHEET NO.  
 1. F.F.L --- FINISHED FLOOR LEVEL  
 2. S.F.L --- STRUCTURAL FLOOR LEVEL  
 3. (R) --- REVERSED DETAIL

NO.	DATE	REVISED	BY
E	23/05/22	REVISED AS PER COMMENTS	LS
D	06/04/22	REVISED AS PER COMMENTS	LS
C	17/02/22	REVISED AS PER COMMENTS	LS
B	20/12/21	REVISED AS PER COMMENTS	LS
A	03/12/21	REVISED AS PER COMMENTS	LS

JOB NO. : J-858  
 PROJECT : PROPOSED RESIDENTIAL DEVELOPMENT AT TKOTL 70RP, PHASE 11, LOHAS PARK TSEUNG KWAN O, N.T.

TITLE : TYPICAL FLOOR PARTIAL ELEVATION & SECTION, PLAN FOR CURTAIN WALL (TOWER 1)

DATE : 22-OCT-21 SCALE : 1:50(A1)  
 DRAWN BY : CHECKED BY :

美特鋁質有限公司  
 MIDI ALUMINUM FABRICATOR LTD.  
 Units 6-8, Sunray Industrial Centre, 1/F  
 610 Cha Kwo Ling Road, Kowloon  
 Tel:23489211-4 Fax:(852)27727666

DWG NO. : J858-CW-PE115 REV. : E







10TH, 12TH-39TH, 41ST-52ND FLOOR PLAN - TOWER 1  
(36 STOREYS)

NOTE: 1. MECHANICAL VENTILATION AND ARTIFICIAL LIGHTING WILL BE PROVIDED AT THE BATHROOM/ LAVATORY MARKED WITH " \* " FOR OMISSION OF NATURAL LIGHTING AND VENTILATION.  
2. THERE WILL BE NO 13/F, 14/F, 24/F, 34/F & 44/E IN THE NOMENCLATURE SYSTEM FOR NUMBERING OF FLOORS.

	OPEN KITCHEN		SUNKEN SLAB
	NON-STRUCTURAL PREFABRICATED EXTERNAL WALL		