

工程指示 / 要求簡箋(E.I.)

工程指示編號：EI/4919/22

修改版次：-

工程編號：J-858

工程名稱：將軍澳日出康城 LP-11

工程項目：趟門 地盆用鐵件 9/F 起腳

收件人：Maggie

發件人：Ant Yeung

日期：23/07/2022

□要求提供 / □確認 事項：

- | | | |
|------------------------------------|-------------------------------------|-------------------------------|
| <input type="checkbox"/> 初步鋁料 B.M. | <input type="checkbox"/> 加工拆圖，然後生產 | <input type="checkbox"/> 尺寸表 |
| <input type="checkbox"/> 正式鋁料 B.M. | <input type="checkbox"/> 技術上資料 / 指示 | <input type="checkbox"/> 報價 |
| <input type="checkbox"/> 配件 B.M. | <input type="checkbox"/> 樣辦或貨品說明書 | <input type="checkbox"/> 分判合約 |

內容：

請按加工圖生產鐵件送地盆使用使用。165x100x15

分座包裝不用驗焊：出貨前，請給 Mill cert 和熱浸 Cert請在 2022.08.15 前完成上列要求。

附：

以上項目為：

- | | | |
|---------------------------------|--------------------------------------|--------------------------------|
| <input type="checkbox"/> 原合約工程包 | <input type="checkbox"/> 原合約工程加 / 減賬 | <input type="checkbox"/> 新工程報價 |
|---------------------------------|--------------------------------------|--------------------------------|

原因：-

分發東莞各部門：

- | | | | |
|--------------------------------------|-------------------------------------|------------------------------------|--|
| <input type="checkbox"/> 生產技術總監 □連附件 | <input type="checkbox"/> 技術部 □連附件 | <input type="checkbox"/> 生產部 □連附件 | <input type="checkbox"/> 機械設計部 □連附件 |
| <input type="checkbox"/> 採購部 □連附件 | <input type="checkbox"/> 生產統籌部 □連附件 | <input type="checkbox"/> 小羅&清 □連附件 | |
| <input type="checkbox"/> 質檢部 □連附件 | <input type="checkbox"/> 會計部 □連附件 | <input type="checkbox"/> 報關組 □連附件 | <input type="checkbox"/> 其他 _____ □連附件 |

分發其他分判：

□連附件 Bun

分發香港各部門：

- | | | | |
|-----------------------------------|------------------------------------|-----------------------------------|---|
| <input type="checkbox"/> 行政部 □連附件 | <input type="checkbox"/> 會計部 □連附件 | <input type="checkbox"/> 統籌部 □連附件 | <input type="checkbox"/> 工程部地盤科文 □連附件 <u>積哥</u> |
| <input type="checkbox"/> 採購部 □連附件 | <input type="checkbox"/> QS 部 □連附件 | <input type="checkbox"/> 維修部 □連附件 | <input type="checkbox"/> 其他 _____ □連附件 |

傳遞編號：

發件人簽署：Ant Yeung

HK / 22

項目經理簽署：[Signature]

S.D. REF :

CLIENT :
Sino Land Company Limited
怡和置業有限公司

ARCHITECT :
ronald lu & partners
Ronald Lu & Partners (HK) Ltd.
呂元輝建築師事務所 (香港) 有限公司

MAIN CONTRACTOR :
Gammon

STRUCTURAL ENGINEER :
AECOM

FAÇADE CONSULTANT :
AECOM

NOTE :
1. ALL DIMENSIONS ARE IN mm.
2. ALL ELEVATIONS ARE VIEWED FROM OUTSIDE.
3. ALL DIMENSIONS TO BE VERIFIED ON SITE BEFORE FABRICATION.

LEGEND:
X1 DETAIL MARK NO.
X2 REFER SHEET NO.
1. F.F.L. -- FINISHED FLOOR LEVEL
2. S.F.L. -- STRUCTURAL FLOOR LEVEL
3. -- REVERSED DETAIL

NO.	DATE	REVISED	BY

JOB NO. : J-858


PROJECT :
PROPOSED RESIDENTIAL DEVELOPMENT
AT TOWER 709P, PHASE 11, LOHAS PARK
TSEUNG KWAN O, N.T.

TITLE :
TYPICAL FLOOR PLAN
AT TOWER 1

DATE : 14-Jun-22 SCALE : 1:80(A1)

DRAWN BY : KY CHECKED BY : YB

UNITA 8-A Sunny Industrial Centre, 7/F
610 Che Awo Ling Road, Kowloon
Tel: 23489211-4 Fax: (852) 27272665
DWC NO. : J858-CW-WZ-S101 REV. : -

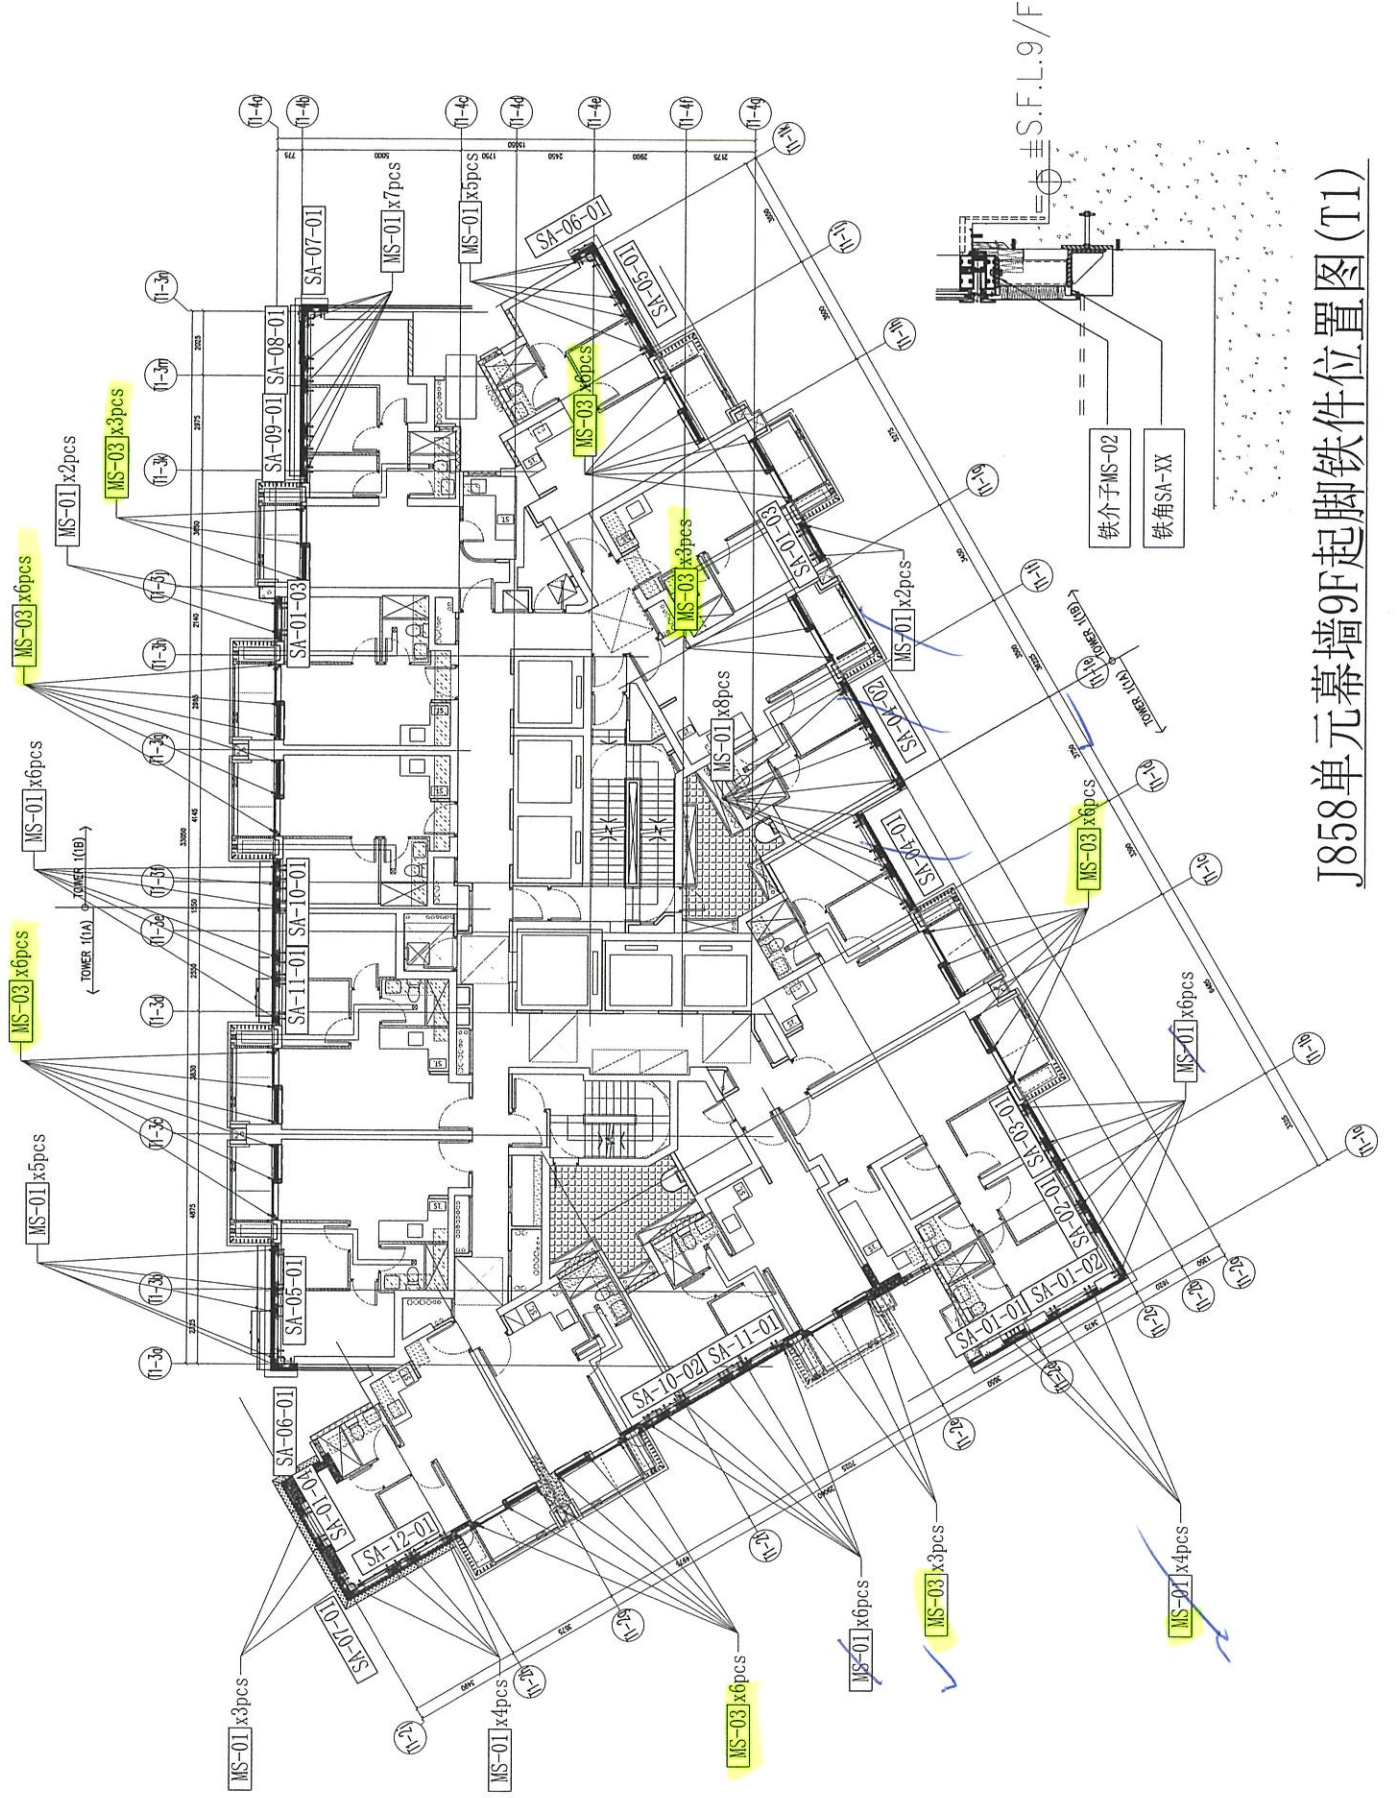

J858单元幕墙9F起脚铁件位置图(T1)

B.O. REF.:

CLIENT : 怡和置業有限公司
Sino Land Company Limited

ARCHITECT : Ronald Lu & Partners
Ronald Lu & Partners (HK) Ltd.
呂志祥建築師事務所 (香港) 有限公司

MAIN CONTRACTOR : Gammon

STRUCTURAL ENGINEER : AECOM
FACADE CONSULTANT: AECOM

NOTE:
1. ALL DIMENSIONS ARE IN mm.
2. ALL DIMENSIONS ARE VERIFIED FROM OUTSIDE.
3. TO BE VERIFIED ON SITE BEFORE FABRICATION.

LEGEND:
X1 DETAIL MARK NO.
X2 REFER SHEET NO.
1. F.F.L. -- FINISHED FLOOR LEVEL
2. S.F.L. -- STRUCTURAL FLOOR LEVEL
3. (R) -- REVERSED DETAIL


NO.	DATE	REVISION	BY

JOB NO. : J-858
PROJECT : PROPOSED RESIDENTIAL DEVELOPMENT
AT 'TOWER 700P, PHASE 11, LOMAS PARK
TISUNG KWAN O. N.T.

TITLE : TYPICAL FLOOR PLAN
AT TOWER 2

DATE : 14-Jun-22
SCALE : 1:80(A1)
DRAWN BY : KY
CHECKED BY : YB

美特銘有限公司
MIDI Architecture Associates Ltd.
Units 6-8, Sunny Industrial Centre, 1/F
610 Ona Mee Ung Road, Kowloon
Tel: 23489211-4 Fax: (852) 27272868
DWG NO. : J858-CW-WZ-S201 REV. : -

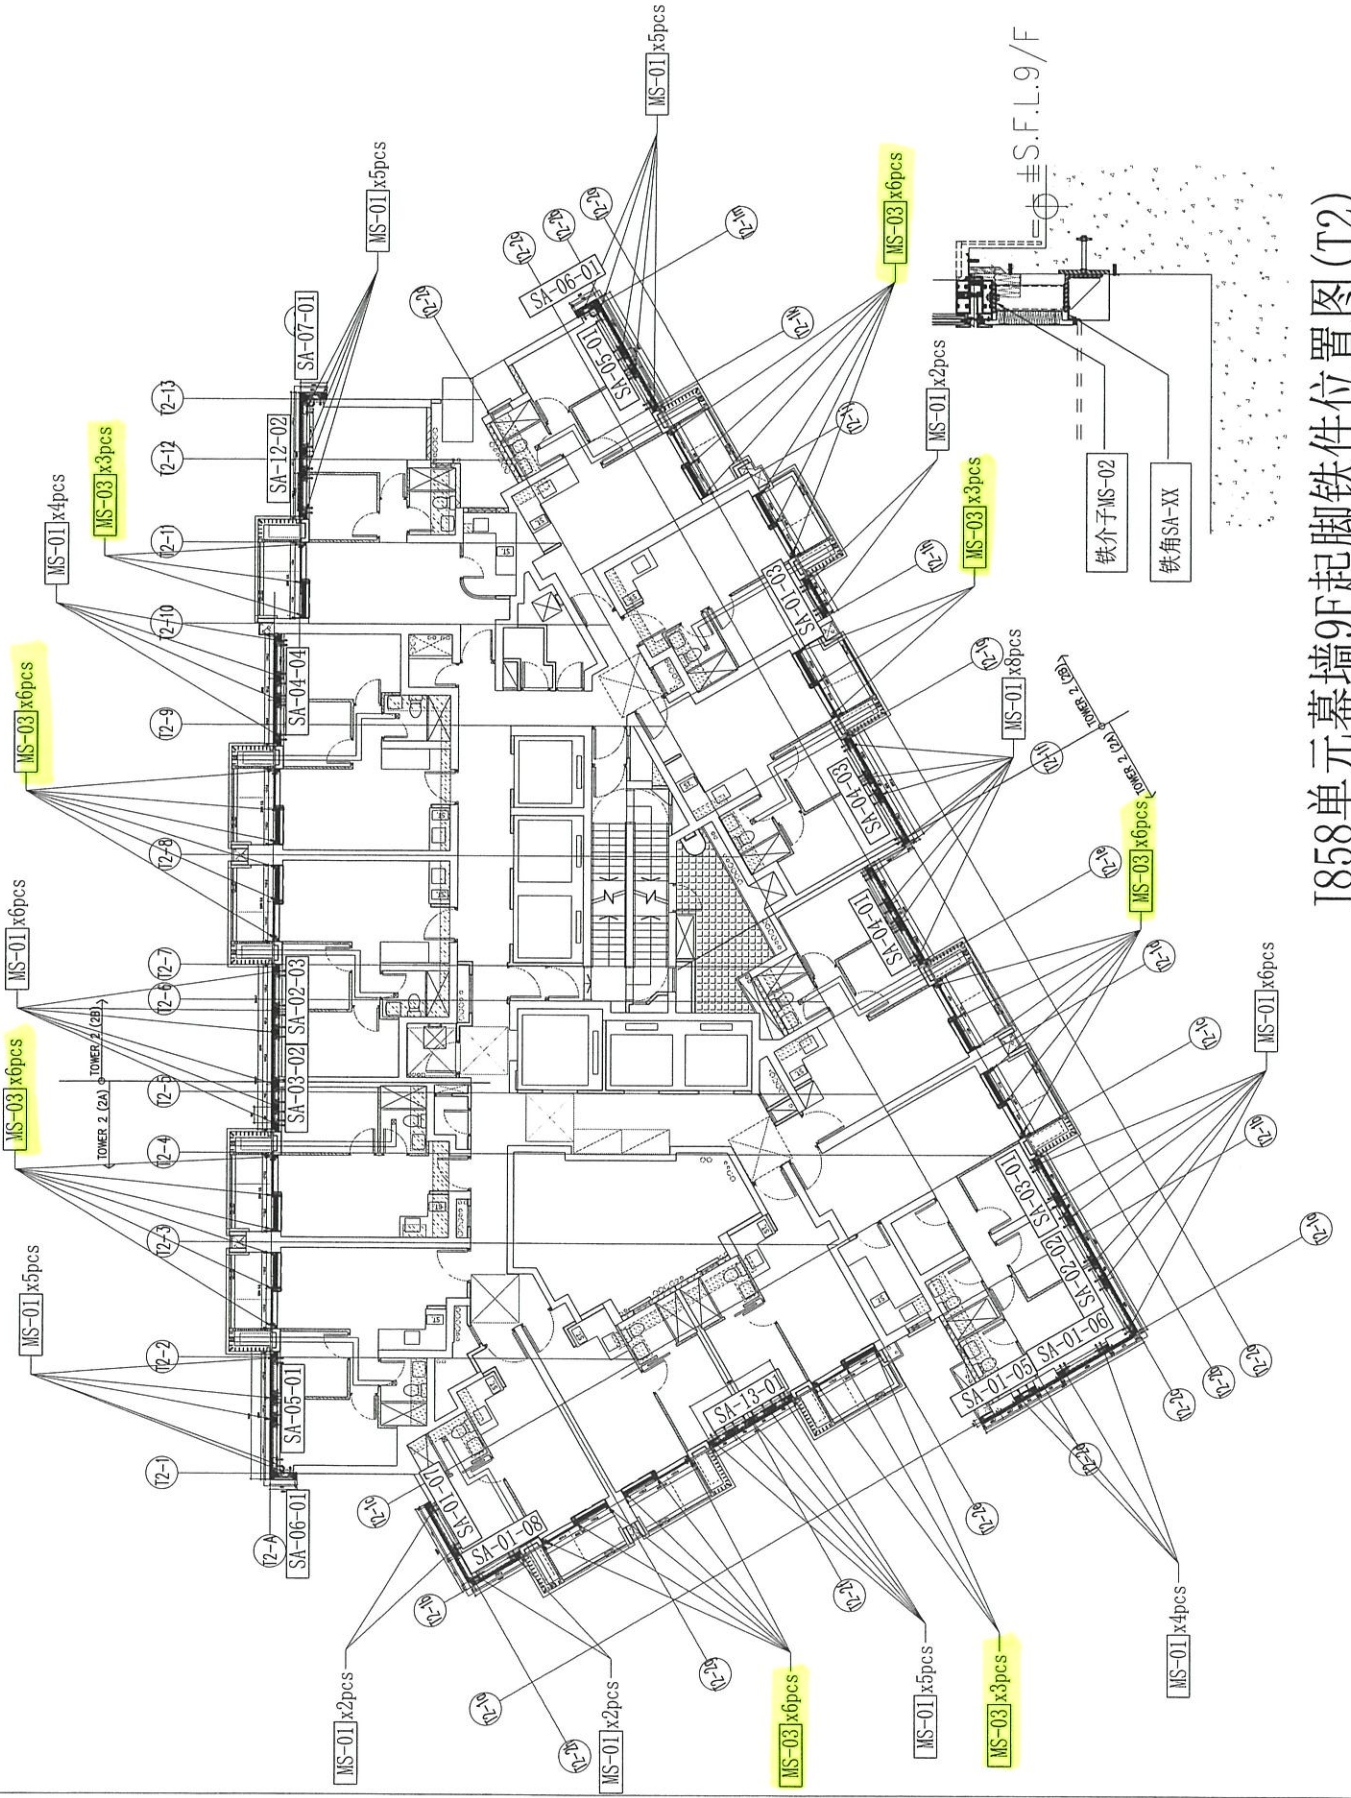

J858单元幕墙9F起脚铁件位置图(T2)

B.D. REF :

CLIENT : 信和置業有限公司
Sino Land Company Limited

ARCHITECT : Ronald Lu & Partners
Ronald Lu & Partners (HK) Ltd.
呂元輝建築師事務所(香港)有限公司

MAIN CONTRACTOR : Gammon

STRUCTURAL ENGINEER : AECOM

FAÇADE CONSULTANT : AECOM

NOTE :
1. ALL DIMENSIONS ARE IN mm.
2. ALL ELEVATIONS ARE VIEWED FROM OUTSIDE.
3. ALL DIMENSIONS TO BE VERIFIED ON SITE BEFORE FABRICATION.


LEGEND :
① DETAIL MARK NO.
② REFER SHEET NO.
1. F.F.L. → FINISHED FLOOR LEVEL.
2. S.F.L. → STRUCTURAL FLOOR LEVEL.
3. Ⓜ → REVERSED DETAIL.

J-858
PROPOSED RESIDENTIAL DEVELOPMENT
AT TROTIL 700P, PHASE 11, LOMAS PARK
TSEUNG KWAN O, N.T.

TYPICAL FLOOR PLAN
AT TOWER 3

DATE : 14-Jun-22 SCALE : 1:80(A1)
DRAWN BY : KY CHECKED BY : YB

美特銘有限公司
M.T.M. (SINO) ENGINEERING LTD.
Units 6-8, Sunny Industrial Centre, 1/F
610 Che Kwo Ling Road, Kowloon
Tel: 2468211-4, Fax: (852) 2727866
DWG NO. : J858-CW-WZ-5301 REV. : -

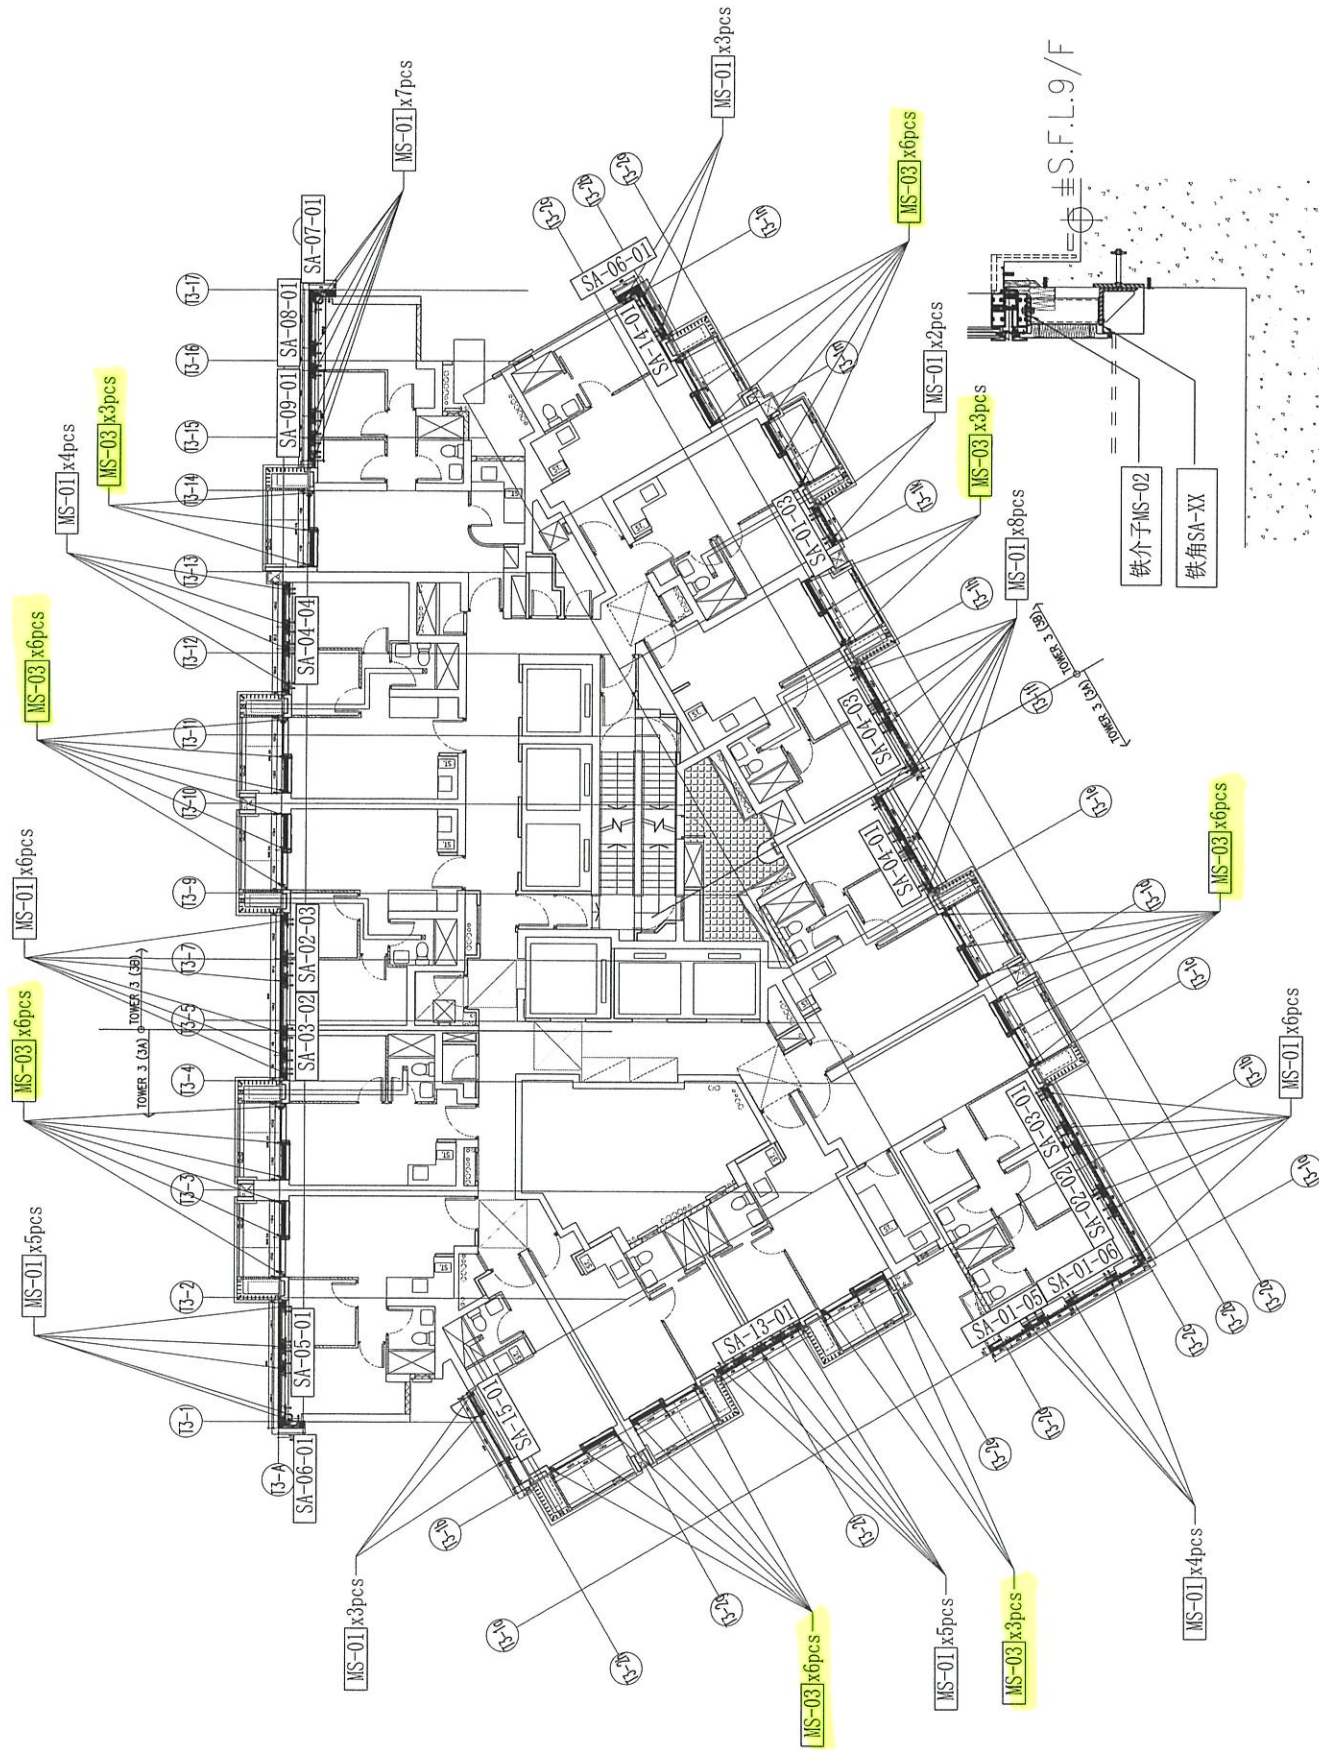

J858单元幕墙9F起脚铁件位置图(T3)