

工程指示 / 要求簡箋(E.I.)

工程指示編號：EI / 4951 / 22

修改版次：-

工程編號：J - 858

工程名稱：將軍澳日出康城 LP-11

工程項目：趟門 地盆用鐵件 頂底鐵件

收件人：Maggie

發件人：Ant Yeung

日期：2/8 / 2022

□要求提供 / □確認 事項：

- | | | |
|------------------------------------|-------------------------------------|-------------------------------|
| <input type="checkbox"/> 初步鋁料 B.M. | <input type="checkbox"/> 加工拆圖，然後生產 | <input type="checkbox"/> 尺寸表 |
| <input type="checkbox"/> 正式鋁料 B.M. | <input type="checkbox"/> 技術上資料 / 指示 | <input type="checkbox"/> 報價 |
| <input type="checkbox"/> 配件 B.M. | <input type="checkbox"/> 樣辦或貨品說明書 | <input type="checkbox"/> 分判合約 |

內容：

請按加工圖生產鐵件送地盆使用。 G502, G504

1. 分 5 批出貨，請按 MO 次序生產。MO4 和 MO5 為年後出貨。請於 12 月時才生產
2. 因各座判頭不同，必須分座包裝
3. 驗焊: Fillet Weld 100% Visual, 10% MPI / Name: (For Curtain Wall)
4. 出貨前，請給 Mill cert 和熱浸 Cert
5. 有油瀝青油
6. 附分層統計 excel 表

請在 2022.08.30 前完成上列要求。

附：

以上項目為：

- | | | |
|---------------------------------|--------------------------------------|--------------------------------|
| <input type="checkbox"/> 原合約工程包 | <input type="checkbox"/> 原合約工程加 / 減賬 | <input type="checkbox"/> 新工程報價 |
|---------------------------------|--------------------------------------|--------------------------------|

原因：-

分發東莞各部門：

- | | | | | | | | |
|---------------------------------|------------------------------|--------------------------------|------------------------------|-------------------------------|------------------------------|--------------------------------|------------------------------|
| <input type="checkbox"/> 生產技術總監 | <input type="checkbox"/> 連附件 | <input type="checkbox"/> 技術部 | <input type="checkbox"/> 連附件 | <input type="checkbox"/> 生產部 | <input type="checkbox"/> 連附件 | <input type="checkbox"/> 機械設計部 | <input type="checkbox"/> 連附件 |
| <input type="checkbox"/> 採購部 | <input type="checkbox"/> 連附件 | <input type="checkbox"/> 生產統籌部 | <input type="checkbox"/> 連附件 | <input type="checkbox"/> 小羅&清 | <input type="checkbox"/> 連附件 | | |
| <input type="checkbox"/> 質檢部 | <input type="checkbox"/> 連附件 | <input type="checkbox"/> 會計部 | <input type="checkbox"/> 連附件 | <input type="checkbox"/> 報關組 | <input type="checkbox"/> 連附件 | <input type="checkbox"/> 其他 | <input type="checkbox"/> 連附件 |

分發其他分判：

 連附件

分發香港各部門：

- | | | | | | | | | |
|------------------------------|---|-------------------------------|------------------------------|------------------------------|------------------------------|----------------------------------|------------------------------|----|
| <input type="checkbox"/> 行政部 | <input type="checkbox"/> 連附件 | <input type="checkbox"/> 會計部 | <input type="checkbox"/> 連附件 | <input type="checkbox"/> 統籌部 | <input type="checkbox"/> 連附件 | <input type="checkbox"/> 工程部地盤科文 | <input type="checkbox"/> 連附件 | 積哥 |
| <input type="checkbox"/> 採購部 | <input checked="" type="checkbox"/> 連附件 | <input type="checkbox"/> QS 部 | <input type="checkbox"/> 連附件 | <input type="checkbox"/> 維修部 | <input type="checkbox"/> 連附件 | <input type="checkbox"/> 其他 | <input type="checkbox"/> 連附件 | |

傳遞編號：

發件人簽署：Ant Yeung

HK / 22

項目經理簽署：

趟門鐵件預算完成生產日子 (10層1批)

EI			T1			T2 / T3		
					2	67/F	Mo6	2023/04/22
					1	66/F		
			Mo5	2023/03/23	10	65/F	Mo5	2023/04/07
					9	63/F		
8	48	62/F			8	62/F		
7	47	61/F			7	61/F		
6	46	60/F			6	60/F		
5	45	59/F			5	59/F		
4	44	58/F			4	58/F		
3	43	57/F			3	57/F		
2	42	56/F			2	56/F		
1	41	55/F			1	55/F		
10	40	53/F	Mo4	2023/02/06	10	53/F	Mo4	2023/02/21
9	39	52/F			9	52/F		
8	38	51/F			8	51/F		
7	37	50/F			7	50/F		
6	36	49/F			6	49/F		
5	35	48/F			5	48/F		
4	34	47/F			4	47/F		
3	33	46/F			3	46/F		
2	32	45/F			2	45/F		
1	31	43/F			1	43/F		
10	30	42/F	Mo3	2022/11/13	10	42/F	Mo3	2022/11/28
9	29	41/F			9	41/F		
8	28	40/F			8	40/F		
7	27	39/F			7	39/F		
6	26	38/F			6	38/F		
5	25	37/F			5	37/F		
4	24	36/F			4	36/F		
3	23	35/F			3	35/F		
2	22	33/F			2	33/F		
1	21	32/F			1	32/F		
10	20	31/F	Mo2	2022/09/29	10	31/F	Mo2	2022/10/14
9	19	30/F			9	30/F		
8	18	29/F			8	29/F		
7	17	28/F			7	28/F		
6	16	27/F			6	27/F		
5	15	26/F			5	26/F		
4	14	25/F			4	25/F		
3	13	23/F			3	23/F		
2	12	22/F			2	22/F		
1	11	21/F			1	21/F		
10	10	20/F	Mo1	2022/08/30	10	20/F	Mo1	2022/09/14
9	9	19/F			9	19/F		
8	8	18/F			8	18/F		
7	7	17/F			7	17/F		
6	6	16/F			6	16/F		
5	5	15/F			5	15/F		
4	4	12/F			4	12/F		
3	3	11/F			3	11/F		
2	2	10/F			2	10/F		
1	1	09/F			1	09/F		

10/F
 9/F

10/F, 9/F



美特鋁質有限公司
MIDI Aluminum Fabricator Ltd.

工程號: J-858	計算: WCM	日期: 2022/07/27	送呈: Jason 哥
地盤名稱: 康城11期	核對:	日期:	副本:
項目類別: 鐵碼	批准:	日期:	
BM編號: 858-CW-M01-S-HP02 類別: 地盤用趟門頂底鐵件, T1 (10-61/F), T2, T3 (10-66/F), 不含T1 62/F, T2, 3 67/F 總重量 (kg): 88731.36			




序號	修改標示	配件圖號	物料編號	配件名稱	顏色	實用	後備	總數	單位 件	單件重量 Kg	總重量	備注
2			SD-GS02	6mm厚鐵板	熱浸鋅	5694	36	5730	件	1.44	8251.2	
3			SD-GS03	4mm厚鐵介子	熱浸鋅	22776	72	22848	件	0.02	456.96	
4			SD-GS04	185x100x15mm鐵角	熱浸鋅	5694	36	5730	件	4.81	27561.3	
5		改送廠	SD-GS05	60x15mm厚鐵板	熱浸鋅	1820	180	2000	件	17.55	35100	
											88731.36	

 美特鋁質有限公司 MIDI Aluminium Fabricator Ltd.		工程號 J858 地盘 康城11期	類別 制圖 W. E. X	物料號 - 2022-07-25	圖號 SD-GS02 數量 5523
修改 日期	採用工廠 材料颜色 热浸锌	图纸名称 铁料加工图 材料 S-275	復核 - 批准 -	-	單件重量 1.44 (KG)

	位置	QTY
1794	T1	1716
1950	T2	1872
1950	T3	1872
= 5696	合计:	5460

+36个/每

廠
 3升
 此孔 (埋端開)

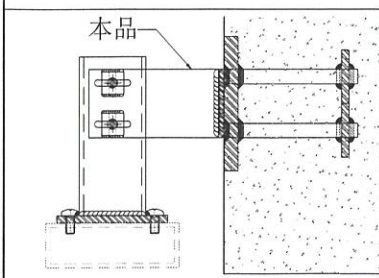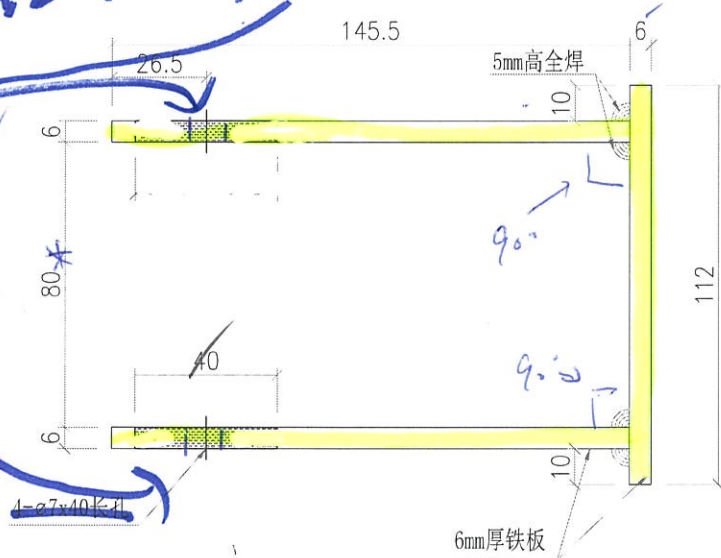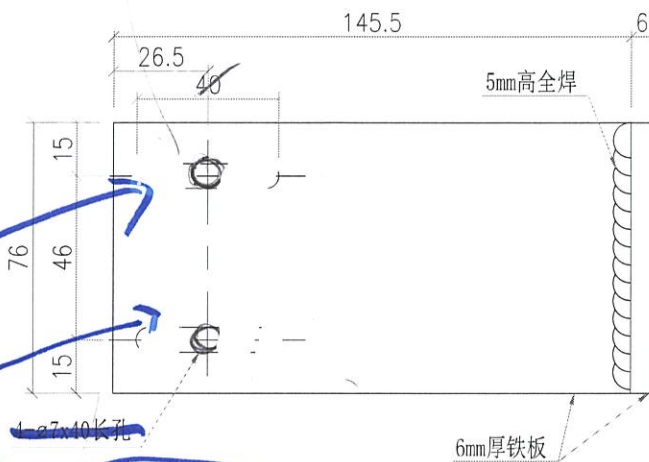

明頂夾磚



專人安裝

BB

每幅門3只

 美特鋁質有限公司 MIDI Aluminium Fabricator Ltd.			工程號	J858	類別		物料號	-			
修改		採用工廠	地盤	✓	圖紙名稱	鐵料加工圖	制圖	W. E. X	2022-07-25	圖號	SD-GS04
日期		材料顏色	熱浸鋅		材料	S-275	復核	-	-	數量	-
							批准	-	-	單件重量	4.81 (KG)


	位置	QTY
1794	T1	1716
1950	T2	1872
1950	T3	1872
= 5694	合計:	5460

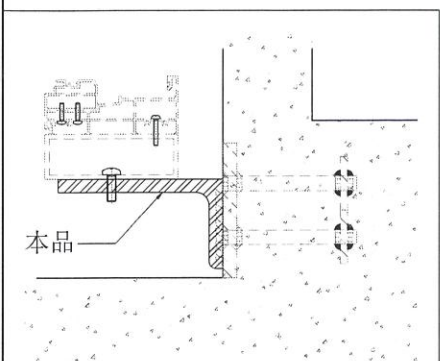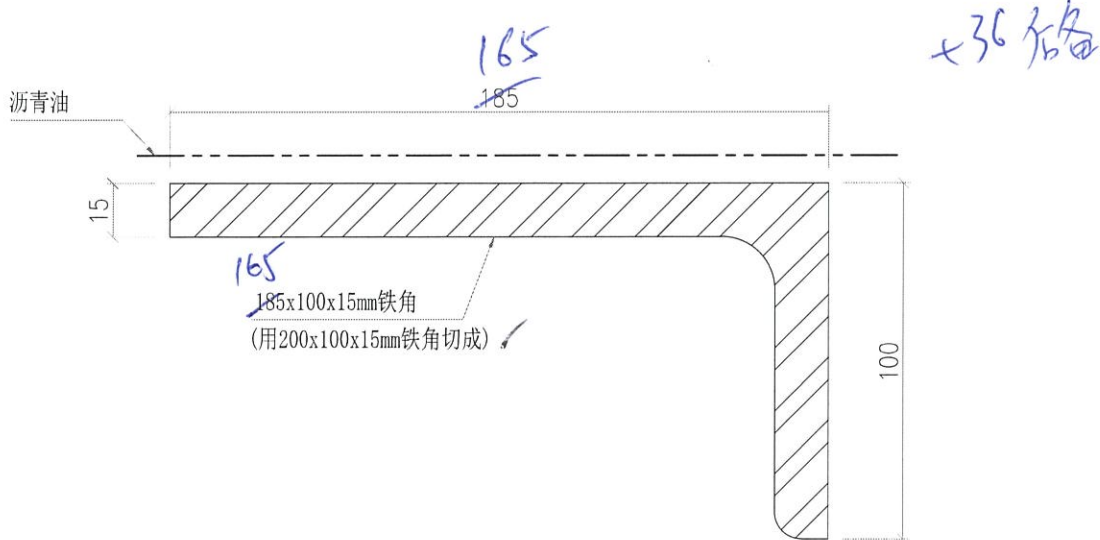

門底

每幅門3只

SL

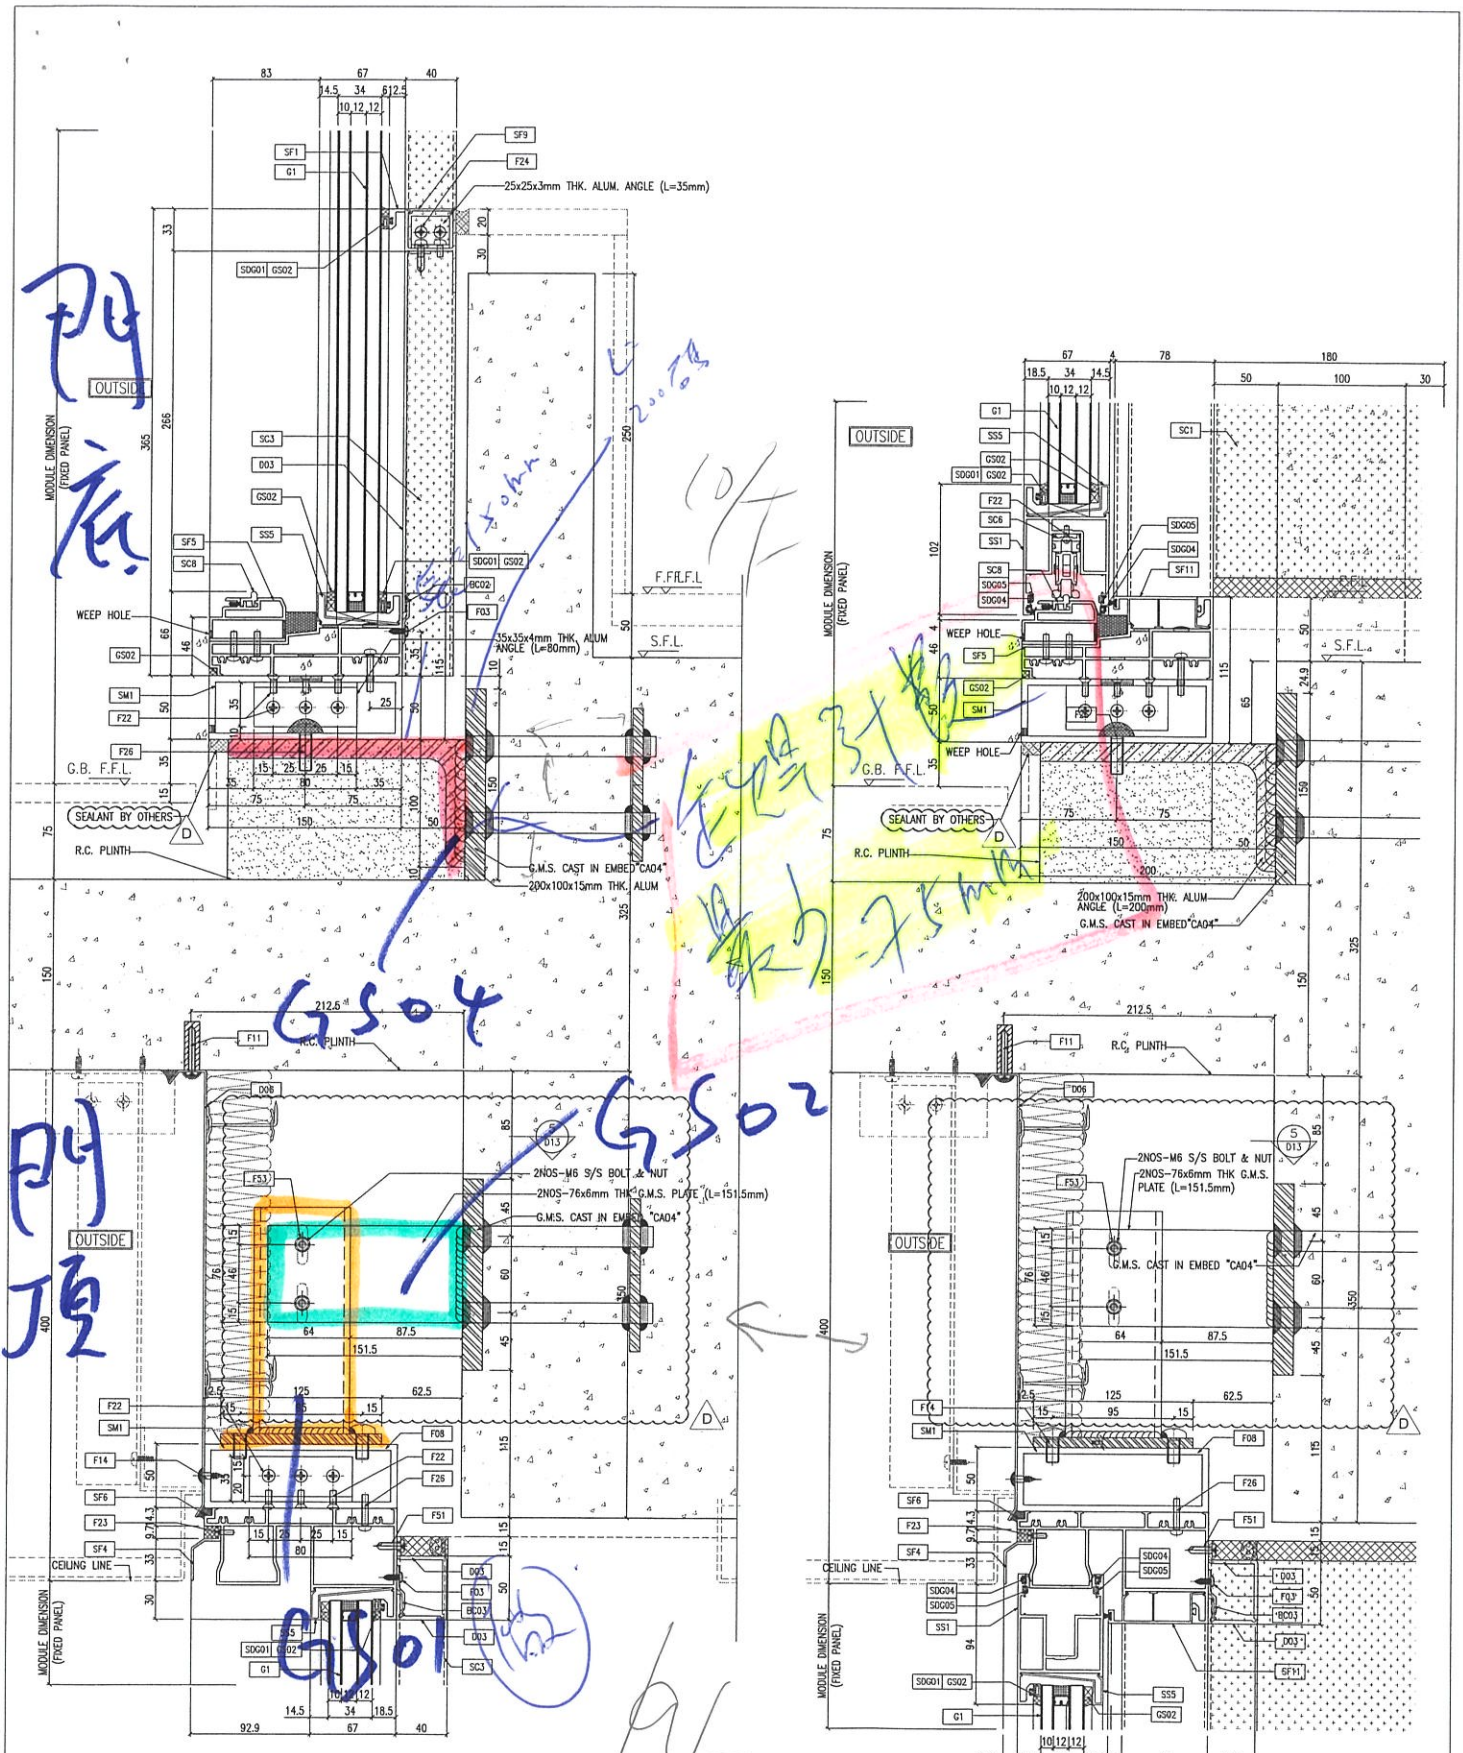

1 TYPICAL TRANSOM DETAIL
D65 SLIDING DOOR

2 TYPICAL TRANSOM DETAIL
D65 SLIDING DOOR

DMC NO.: J-658 PROJECT: PROPOSED RESIDENTIAL DEVELOPMENT AT TAOLOI PARK, PHASE 11, LOKAS PARK (TSUNG KWAH O, N.T.) JOB NO.: J-658 DATE: 22-OCT-21 SCALE: 1:2(A1) DRAWN BY: [Signature] CHECKED BY: [Signature]	DATE: 22-OCT-21 SCALE: 1:2(A1) DRAWN BY: [Signature] CHECKED BY: [Signature]	TITLE: TYPICAL MULLION DETAIL FOR CURTAIN WALL	ARCHITECT: ronalliu & Partners Ronald Lu & Partners (HK) Ltd. 香港建築師事務所 (香港) 有限公司 MAIN CONTRACTOR: 佳和置業有限公司 Sino Land Company Limited	B.O. REF.:
NOTE: DIMENSIONS ARE IN mm. 1. ALL DIMENSIONS ARE VIEWED FROM OUTSIDE. 2. ALL DIMENSIONS TO BE VIEWED ON SITE BEFORE FABRICATION. LEGEND: [Symbol] DETAIL MARK NO. [Symbol] REFER SHEET NO. [Symbol] F.F.L. = FINISHED FLOOR LEVEL. [Symbol] S.F.L. = STRUCTURAL FLOOR LEVEL. [Symbol] = REVERSED DETAIL.				

B.D. REF :
 CLIENT : 信和置業有限公司
 Sino Land Company Limited

ARCHITECT : Ronald Lu & Partners
 羅納路建築師事務所
 ROLAND LU ARCHITECTS (HK) LTD.
 羅納路建築師事務所 (香港) 有限公司
 MAIN CONTRACTOR : Gammon


STRUCTURAL ENGINEER : AECOM
 FACADE CONSULTANT: AECOM

NOTE :
 1. ALL DIMENSIONS ARE IN mm.
 2. ALL ELEVATIONS ARE VIEWED FROM OUTSIDE.
 3. ALL DIMENSIONS TO BE VERIFIED ON SITE BEFORE FABRICATION.
 LEGEND :
 (S1) DETAIL MARK NO.
 (S2) REFER SHEET NO.
 1. F.F.L. -- FINISHED FLOOR LEVEL
 2. S.F.L. -- STRUCTURAL FLOOR LEVEL
 3. (R) -- REVERSED DETAIL

NO.	DATE	REVISION	BY

JOB NO. : J-858
 PROJECT : PROPOSED RESIDENTIAL DEVELOPMENT
 AT TKOIL 70RP, PHASE 11, LOHAS PARK
 TSEUNG KWAN O, N.T.

TITLE : TYPICAL FLOOR PLAN
 AT TOWER 1
 DATE : 14-Jun-22
 SCALE : 1:80(A1)
 DRAWN BY : KY
 CHECKED BY : YB
 業特銘實有限公司
 MTD Engineering Ltd.
 Units 6-8, Sunny Industrial Centre, 1/F
 510 Cha Kwo Ling Road, Kowloon
 Tel: 2348211-4 Fax: (852) 7272666
 DWG NO. : JB58-CW-SD-101 REV. : -

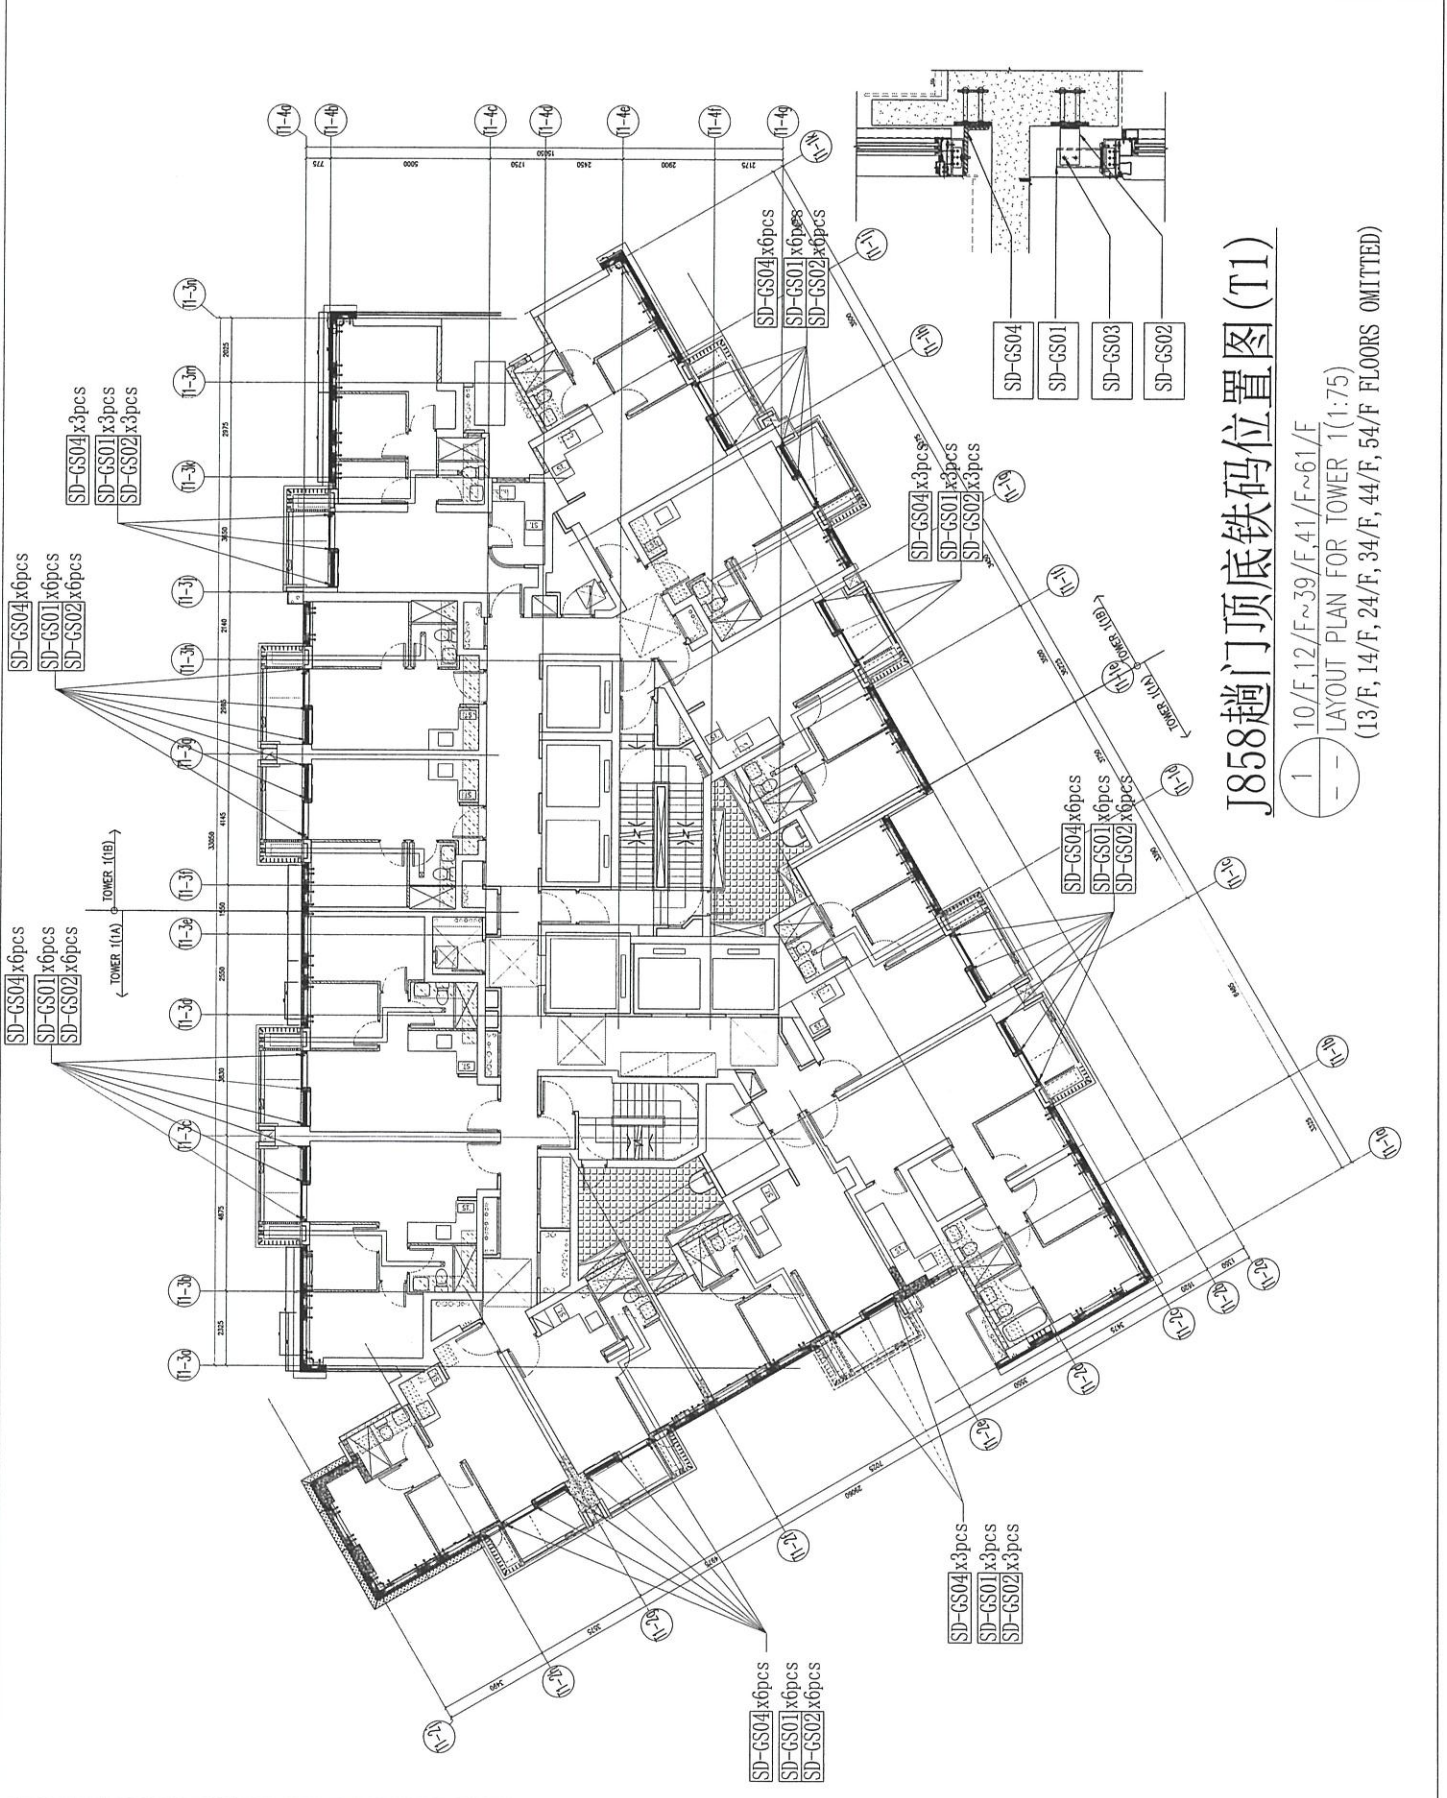

J858趟門頂底鐵碼位置圖 (T1)

10/F, 12/F, 39/F, 41/F, 61/F
 LAYOUT PLAN FOR TOWER 1(1:75)
 (13/F, 14/F, 24/F, 34/F, 44/F, 54/F FLOORS OMITTED)

B.D. REF.:

CLIENT:
德和置業有限公司
Sino Land Company Limited

ARCHITECT:
Ronald Lu & Partners
Ronald Lu & Partners (HK) Ltd.
羅國強建築師 (香港) 有限公司
MAIN CONTRACTOR:

STRUCTURAL ENGINEER:
Gammon
AECOM
FACADE CONSULTANT:
AECOM

NOTE:
1. ALL DIMENSIONS ARE IN mm.
2. ALL ELEVATIONS ARE VIEWED FROM OUTSIDE.
3. ALL DIMENSIONS TO BE VERIFIED ON SITE BEFORE FABRICATION.

LEGEND:

- ① - DETAIL MARK NO.
- ② - REFER SHEET NO.
- 1. F.F.L. -- FINISHED FLOOR LEVEL.
- 2. S.F.L. -- STRUCTURAL FLOOR LEVEL.
- 3. Ⓞ -- REVERSED DETAIL.

JOB NO.: J-858

PROJECT:
PROPOSED RESIDENTIAL DEVELOPMENT
AT TKOIL 70RP, PHASE 11, LOHAS PARK
TSEUNG KWAN O, N.T.


TITLE:
TYPICAL FLOOR PLAN
AT TOWER 1

DATE: 14-Jun-22

DRAWN BY: KY

CHECKED BY: YB

SCALE: 1:80(A1)
UNIT: 8-8, Sunny Industrial Centre, 1/F
510 Che Kwo Ling Road, Kowloon
Tel: 23489211-4 Fax: (852) 2727866
REV.: -

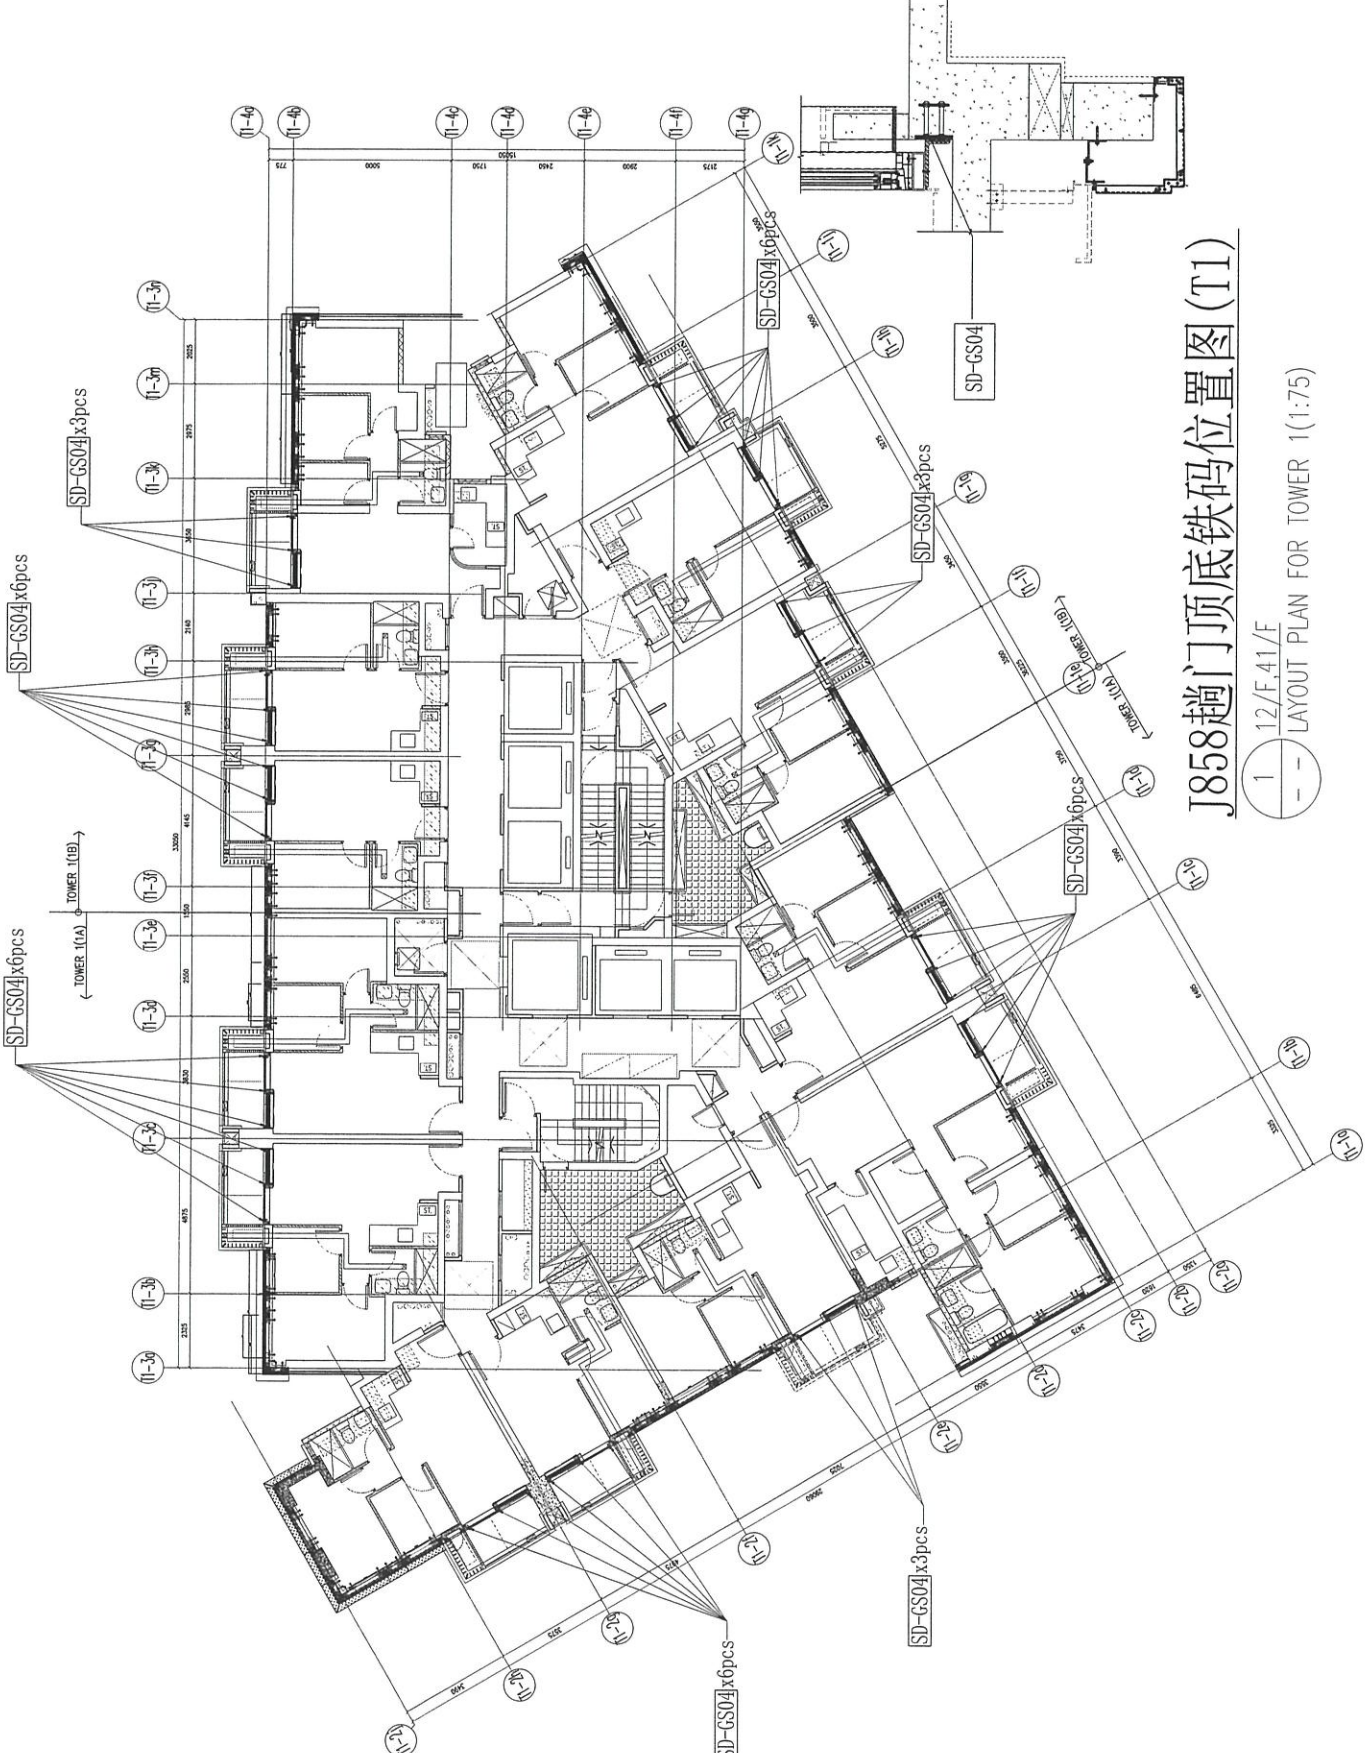


J858趟门顶底铁码位置图 (T1)


1/12/F, 41/F
LAYOUT PLAN FOR TOWER 1(1:75)

B.D. REF : _____

CLIENT :  信和置業有限公司
Sino Land Company Limited

ARCHITECT :  Ronald Lu & Partners
Ronald Lu, Principal Architect
羅國強, 建築師
羅國強建築師事務所 (HK) Ltd.
羅國強建築師事務所 (香港) 有限公司
MAIN CONTRACTOR : _____

STRUCTURAL ENGINEER :  Gammon

FAÇADE CONSULTANT :  AECOM

FAÇADE CONSULTANT :  AECOM


NOTE :
1. ALL DIMENSIONS ARE IN mm.
2. ALL ELEVATIONS ARE VIEWED FROM OUTSIDE.
3. ALL DIMENSIONS TO BE VERIFIED ON SITE BEFORE FABRICATION.

LEGEND:
 -- DETAIL MARK NO.
 -- REFER SHEET NO.
1. F.F.L. -- FINISHED FLOOR LEVEL
2. S.F.L. -- STRUCTURAL FLOOR LEVEL
3.  -- REVERSED DETAIL

JOB NO. : J-858
PROJECT : PROPOSED RESIDENTIAL DEVELOPMENT AT T201, 70RP, PHASE 11, LOHAS PARK, TSEUNG KWAN O, N.T.

TITLE : TYPICAL FLOOR PLAN AT TOWER 2

DATE : 14-Jun-22 SCALE : 1:80(A1)
DRAWN BY : KY CHECKED BY : YB
 嘉特鋁質有限公司
MTR
Unit 6-8, Sunny Industrial Centre, Yuen Long
610 Che Kwo Ling Road, Kowloon
Tel: 2489211-4, Fax: (852) 2727666
DWG NO. : JB58-CW-SJ-L202 REV. : -

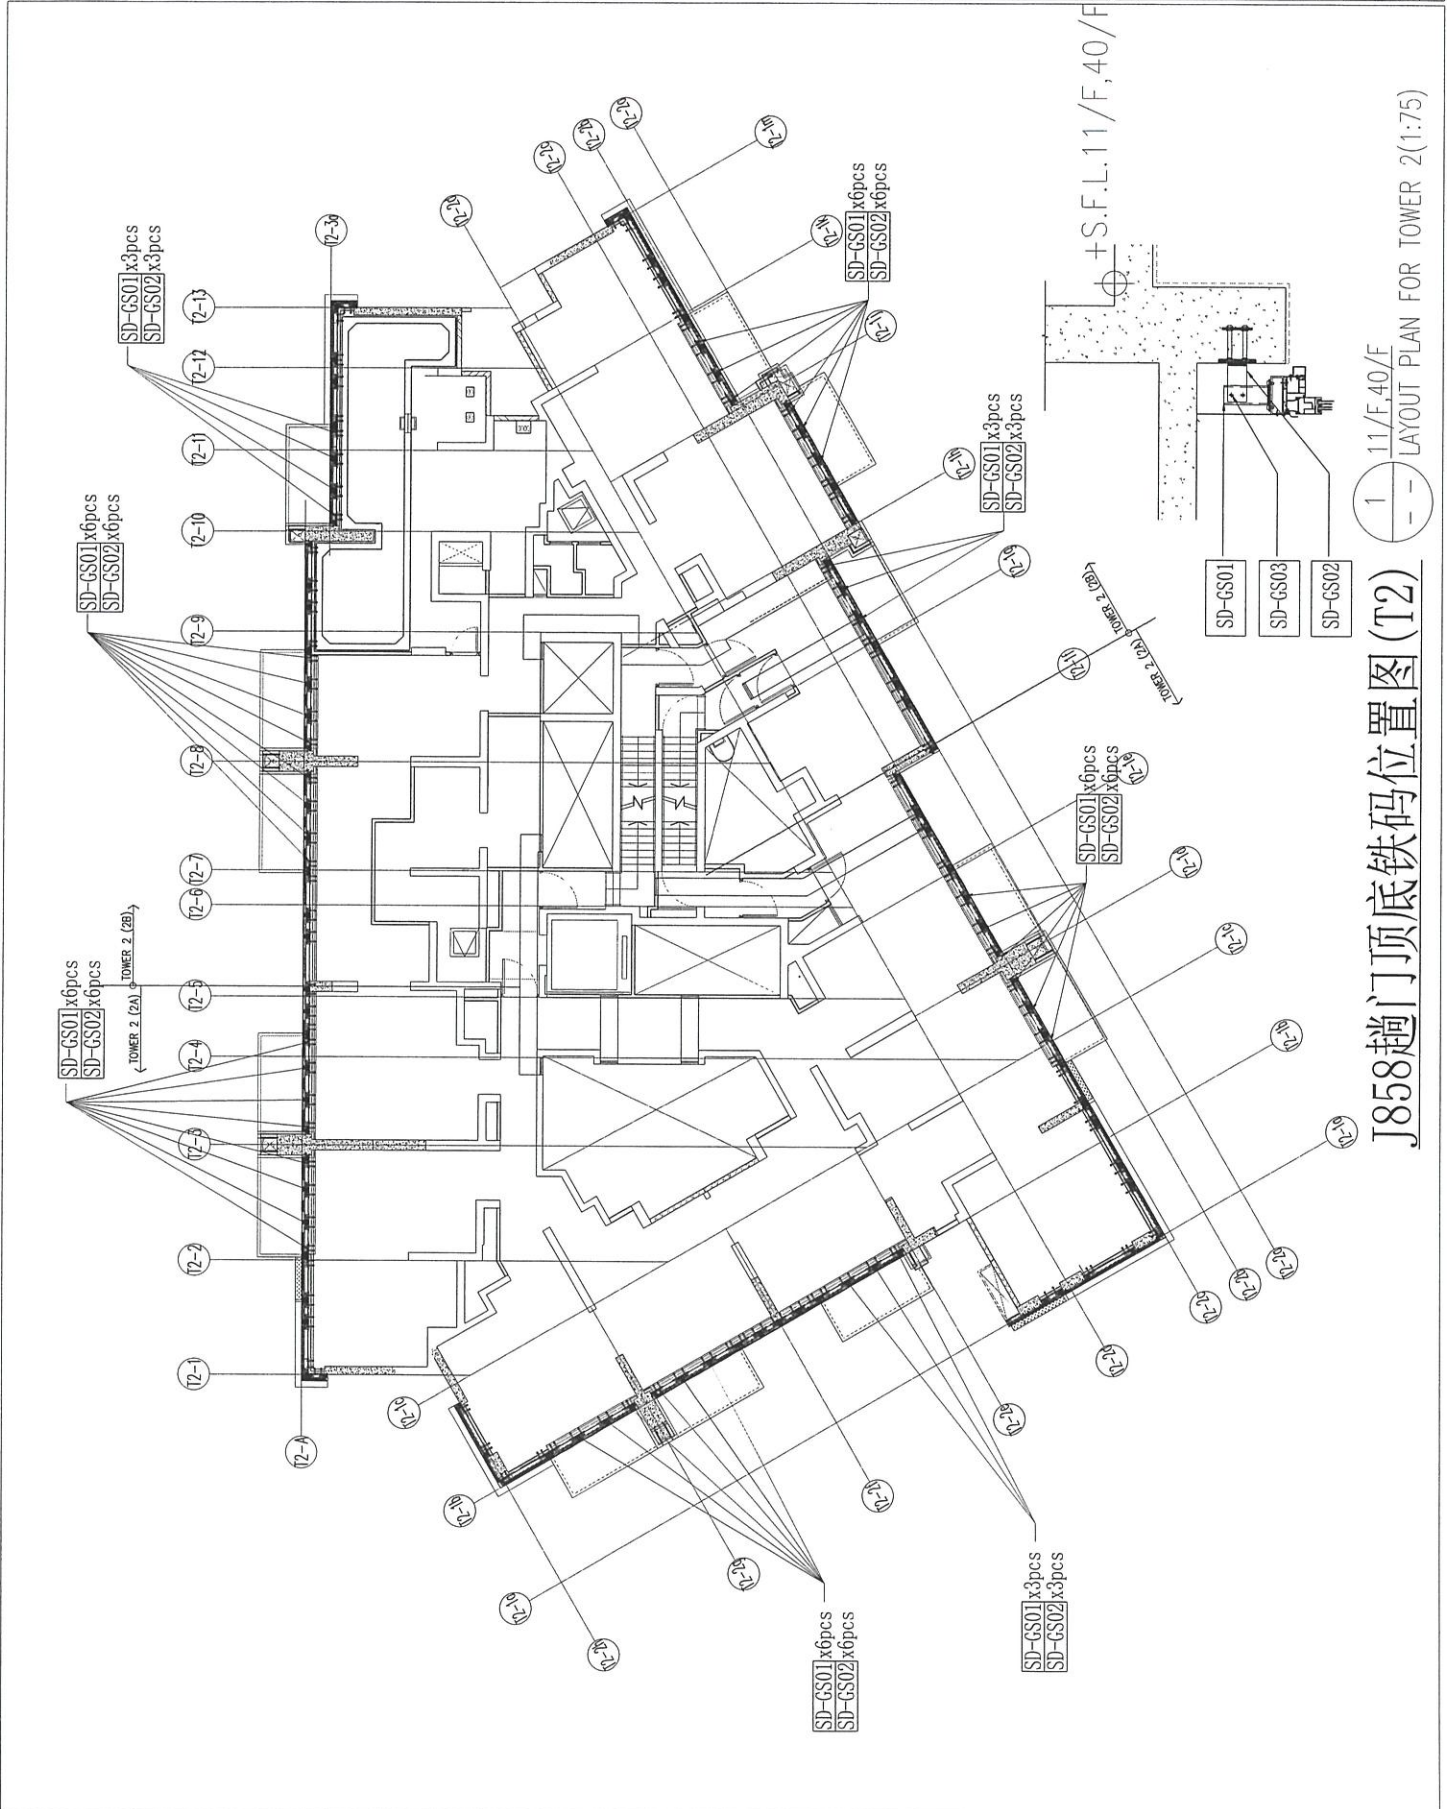

11/F, 40/F
LAYOUT PLAN FOR TOWER 2 (1:75)
J858趟門頂底鐵碼位置圖 (T2)

BD. REF :
 CLIENT :
 Sino Land Company Limited

ARCHITECT :
Ronald Lu & Partners
 Ronald Lu & Partners (HK) Ltd.
 羅敏申建築師 (香港) 有限公司

STRUCTURAL ENGINEER :
Gammon AECOM

FAÇADE CONSULTANT:
AECOM

NOTE:
 1. ALL DIMENSIONS ARE IN mm.
 2. ALL ELEVATIONS ARE VIEWED FROM OUTSIDE.
 3. ALL DIMENSIONS TO BE VERIFIED ON SITE BEFORE FABRICATION.


LEGEND:
 (1) DETAIL MARK NO.
 (2) REFER SHEET NO.

1. F.F.L. -- FINISHED FLOOR LEVEL.
 2. S.F.L. -- STRUCTURAL FLOOR LEVEL.
 3. -- -- REVERSED DETAIL.

JOB NO. : J-858
 PROJECT :
 PROPOSED RESIDENTIAL DEVELOPMENT
 AT TKOIL 709P, PHASE 11, LOHAS PARK
 TSEUNG KWAN O, N.T.

TITLE :
 TYPICAL FLOOR PLAN
 AT TOWER 2


DATE : 14-Jun-22 SCALE : 1:80(A1)
 DRAWN BY : KY CHECKED BY : YB
 MIDT Aluminium Fabrication Ltd.
 610 Cho Kwo Ling Road, Kowloon
 Tel:23489211-4, Fax:8527272668
 DWG NO. : J858-CW-S0-L203 REV. : -

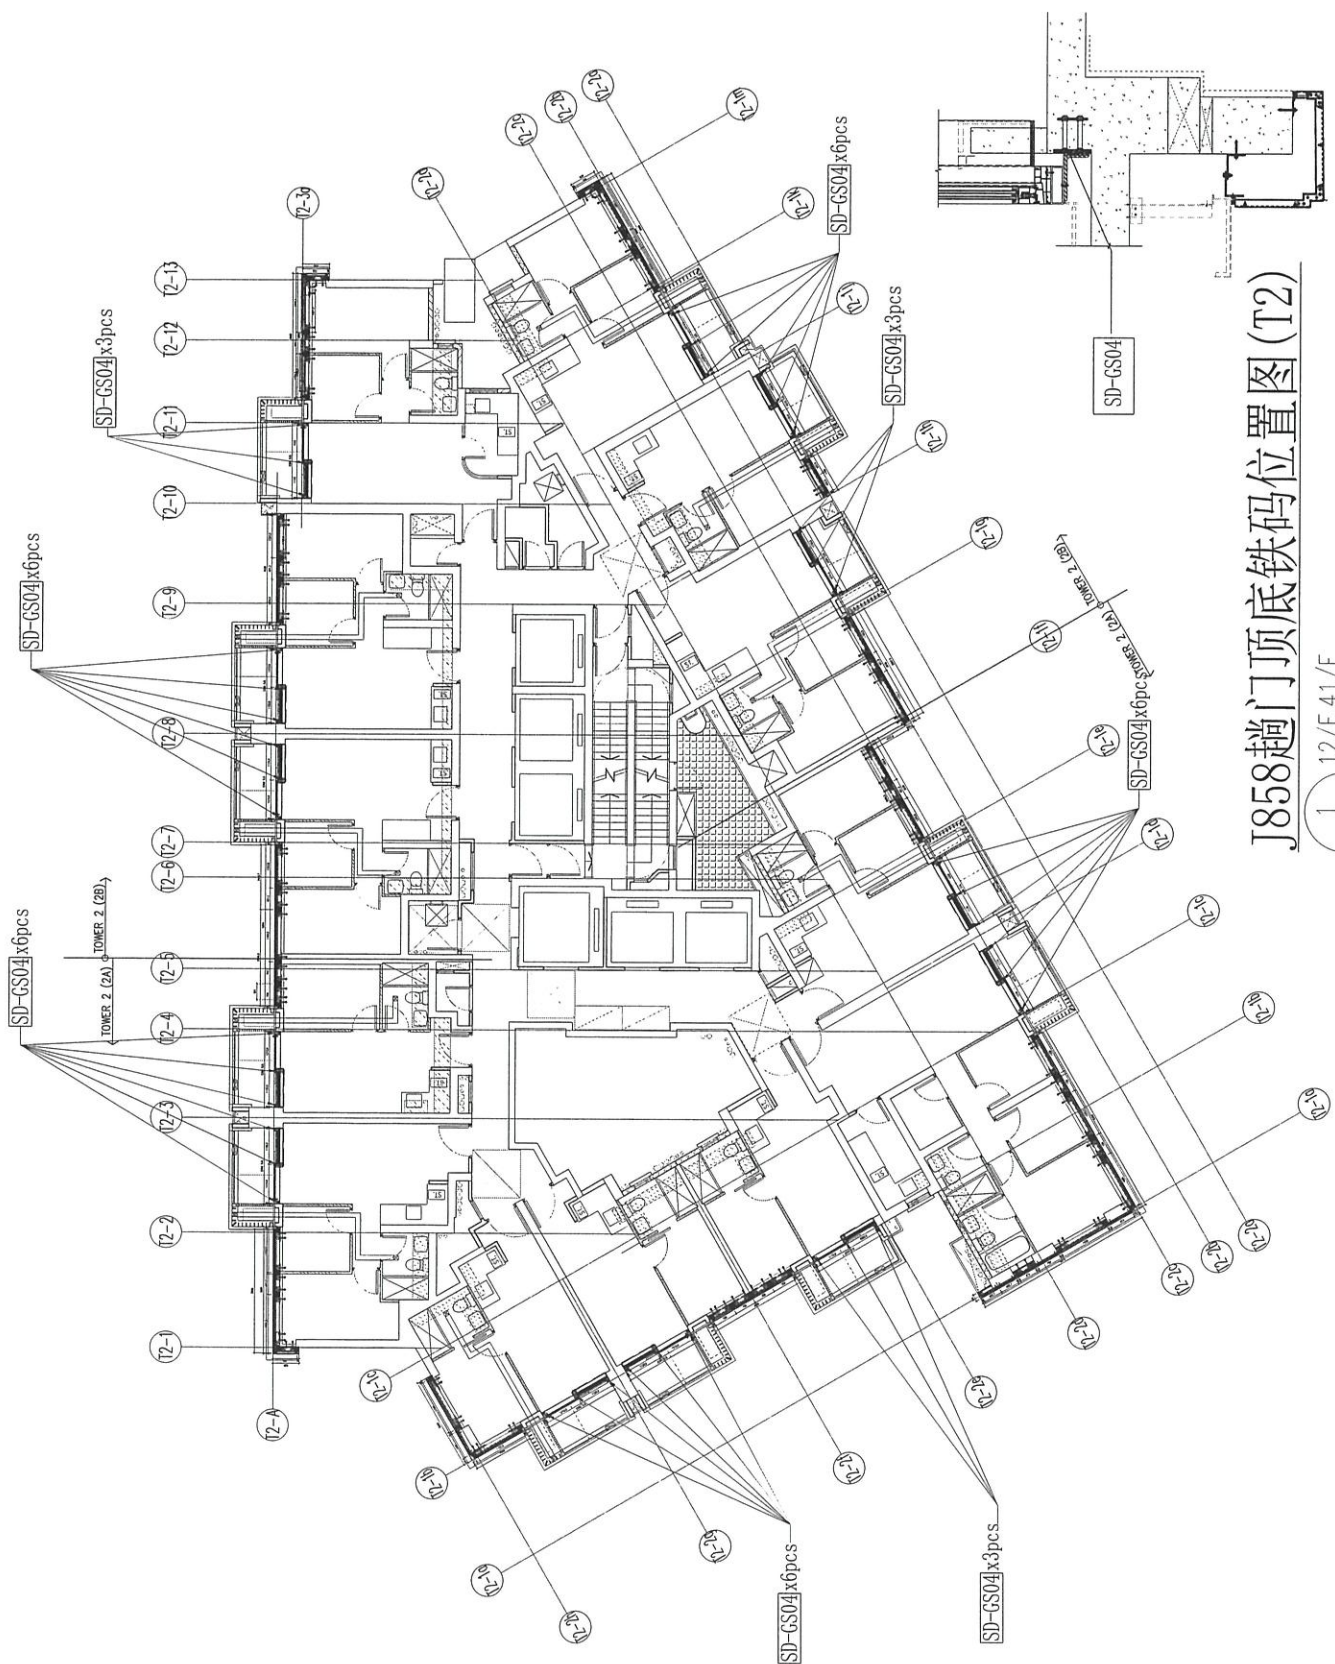

J858趟门顶底铁码位置图 (T2)

1 12/F, 41/F
 LAYOUT PLAN FOR TOWER 2 (1:75)

B.O. REF : 	CLIENT : Sino Land Company Limited 	ARCHITECT : Ronald Lu Ronald Lu & Partners (HK) Ltd. 羅國龍建築師事務所 (香港) 有限公司 MAIN CONTRACTOR :	STRUCTURAL ENGINEER : Gammon 	FACADE CONSULTANT: AECOM 	NOTE: 1. ALL DIMENSIONS ARE IN MM. 2. ALL ELEVATIONS ARE VIEWED FROM OUTSIDE. 3. ALL DIMENSIONS TO BE VERIFIED ON SITE BEFORE FABRICATING. LEGEND: DETAIL MARK NO. REFER SHEET NO. 1. F.F.L. — FINISHED FLOOR LEVEL. 2. S.F.L. — STRUCTURAL FLOOR LEVEL. 3. — REVERSED DETAIL.	<table border="1" style="width:100%; border-collapse: collapse;"> <tr> <td style="width:50%;">JOB NO. : J-858</td> <td style="width:50%;">REV. : —</td> </tr> <tr> <td>PROJECT : PROPOSED RESIDENTIAL DEVELOPMENT AT TKOIL 70RP, PHASE 11, LHAS PARK, TSEUNG KWAN O, N.T.</td> <td>DATE : 14-Jun-22</td> </tr> <tr> <td>TITLE : TYPICAL FLOOR PLAN AT TOWER 3</td> <td>SCALE : 1:50(0/1)</td> </tr> <tr> <td>DRAWN BY : KY</td> <td>CHECKED BY : YB</td> </tr> </table>	JOB NO. : J-858	REV. : —	PROJECT : PROPOSED RESIDENTIAL DEVELOPMENT AT TKOIL 70RP, PHASE 11, LHAS PARK, TSEUNG KWAN O, N.T.	DATE : 14-Jun-22	TITLE : TYPICAL FLOOR PLAN AT TOWER 3	SCALE : 1:50(0/1)	DRAWN BY : KY	CHECKED BY : YB
JOB NO. : J-858	REV. : —													
PROJECT : PROPOSED RESIDENTIAL DEVELOPMENT AT TKOIL 70RP, PHASE 11, LHAS PARK, TSEUNG KWAN O, N.T.	DATE : 14-Jun-22													
TITLE : TYPICAL FLOOR PLAN AT TOWER 3	SCALE : 1:50(0/1)													
DRAWN BY : KY	CHECKED BY : YB													

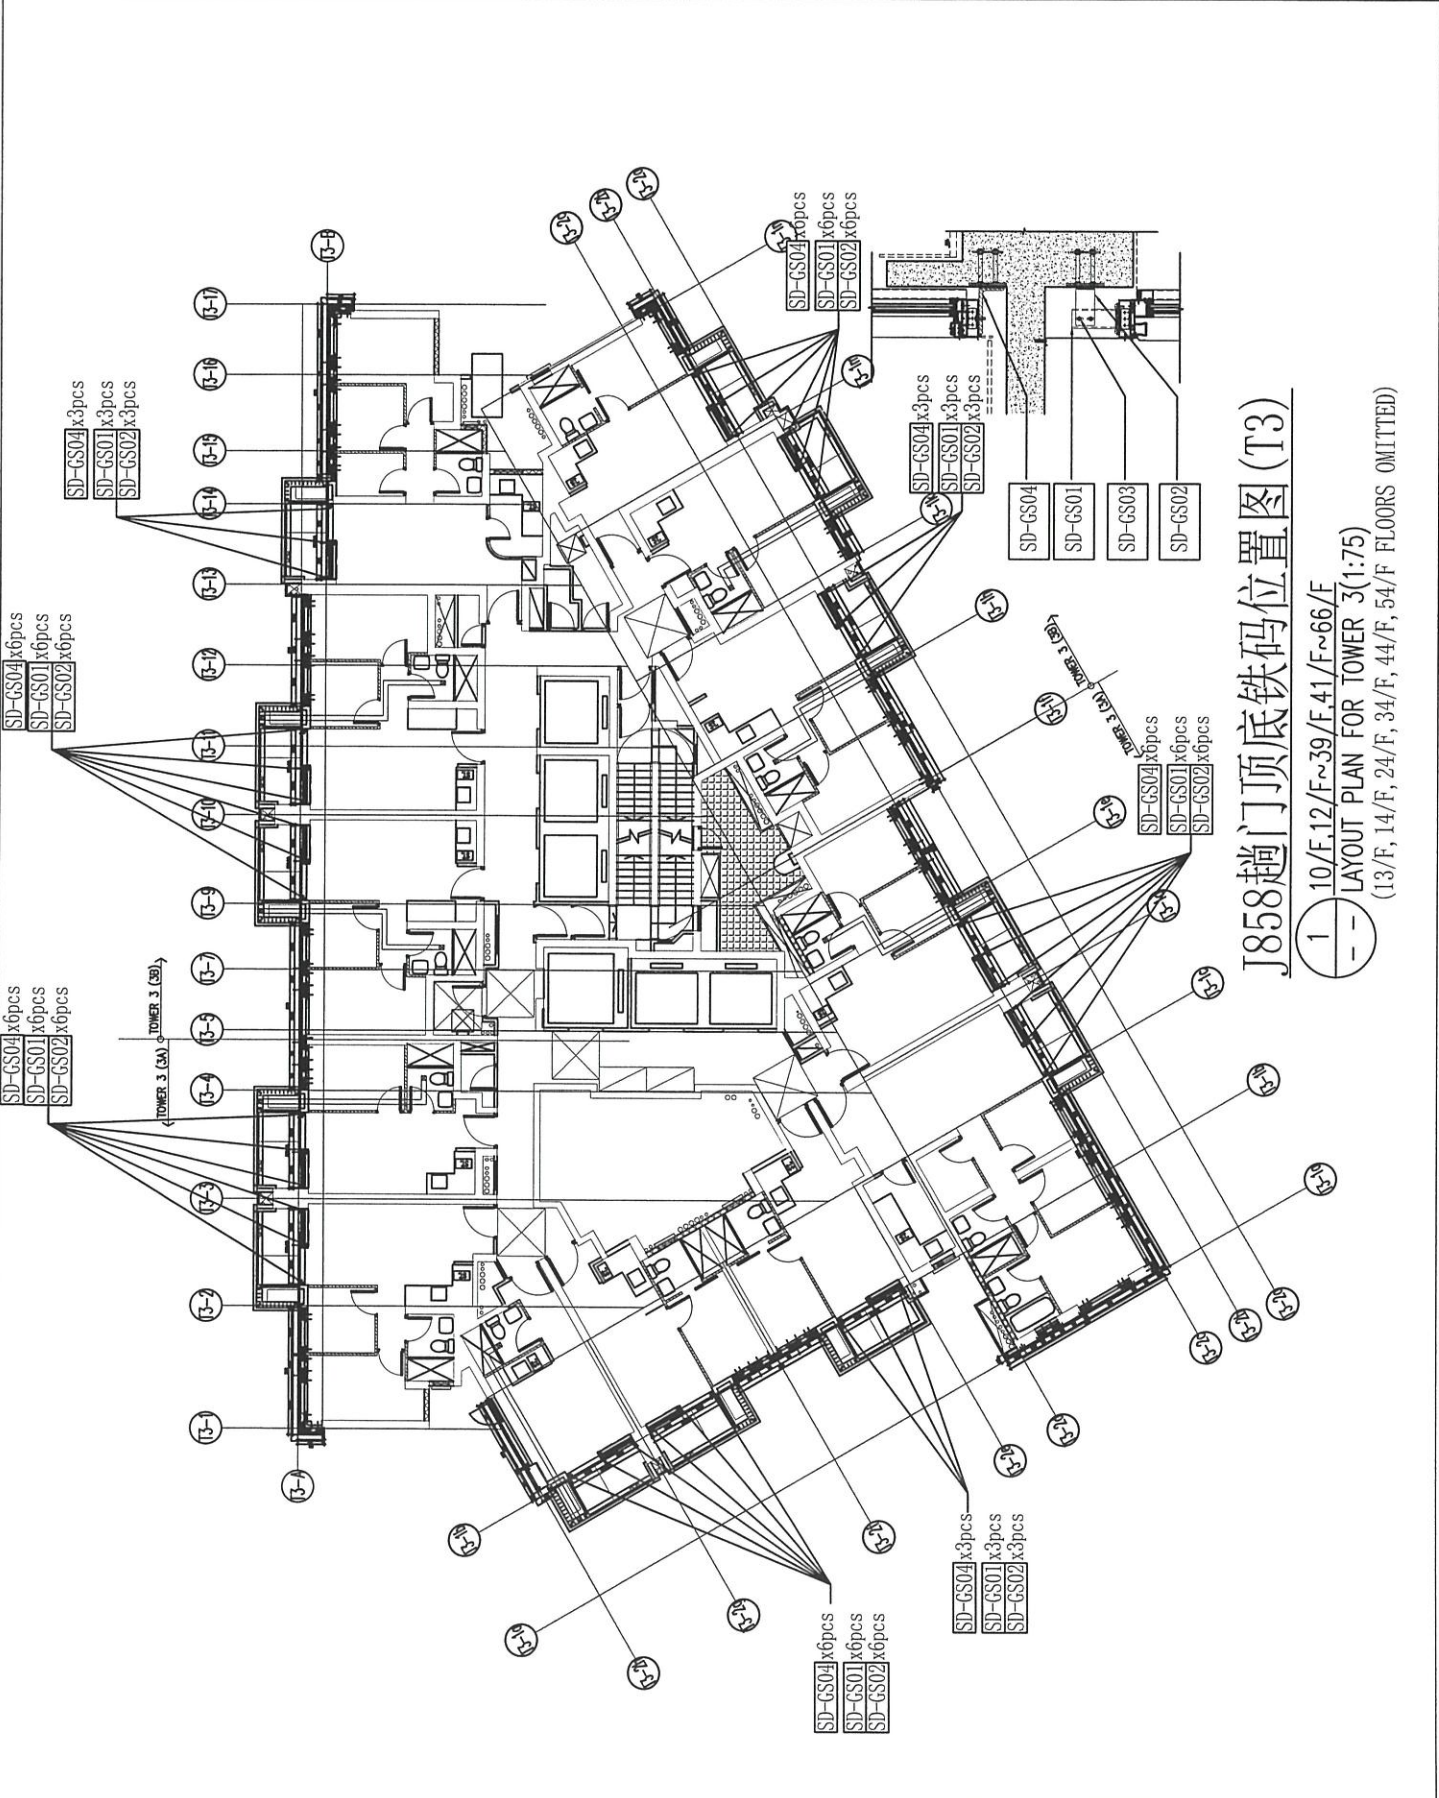

J858趟门顶底铁码位置图 (T3)

1 — 10/F, 12/F, 39/F, 41/F, 66/F
 LAYOUT PLAN FOR TOWER 3(1:75)
 (13/F, 14/F, 24/F, 34/F, 44/F, 54/F FLOORS OMITTED)

E.O. REF.:

CLIENT: 佳和置業有限公司
Sino Land Company Limited

ARCHITECT: Ronald Lu
Ronald Lu & Partners (HK) Ltd.
羅國強建築師事務所 (香港) 有限公司

MAIN CONTRACTOR: Gammon

STRUCTURAL ENGINEER: AECOM
FAÇADE CONSULTANT: AECOM

NOTE:
1. ALL DIMENSIONS ARE IN MM.
2. ALL ELEVATIONS ARE VIEWED FROM OUTSIDE.
3. ALL DIMENSIONS TO BE VERIFIED ON SITE BEFORE FABRICATION.

LEGEND:
① - DETAIL MARK NO.
② - REFER SHEET NO.
1. F.F.L. - FINISHED FLOOR LEVEL.
2. S.F.L. - STRUCTURAL FLOOR LEVEL.
3. Ⓜ - REVERSED DETAIL.


JOB NO.: J-858

PROJECT: PROPOSED RESIDENTIAL DEVELOPMENT
AT TKOIL 70RP, PHASE 11, LOHAS PARK
TSEUNG KWAN O, N.T.

TITLE: TYPICAL FLOOR PLAN
AT TOWER 3

DATE: 14-Jun-22 SCALE: 1:80(41)
DRAWN BY: KY CHECKED BY: YB

英特置業有限公司
MTDI
810 Cheong Chee Road, #07-117
Tel: 6527272008 Fax: 6527272009
DWG NO.: J858-CW-SP-L302 REV.:

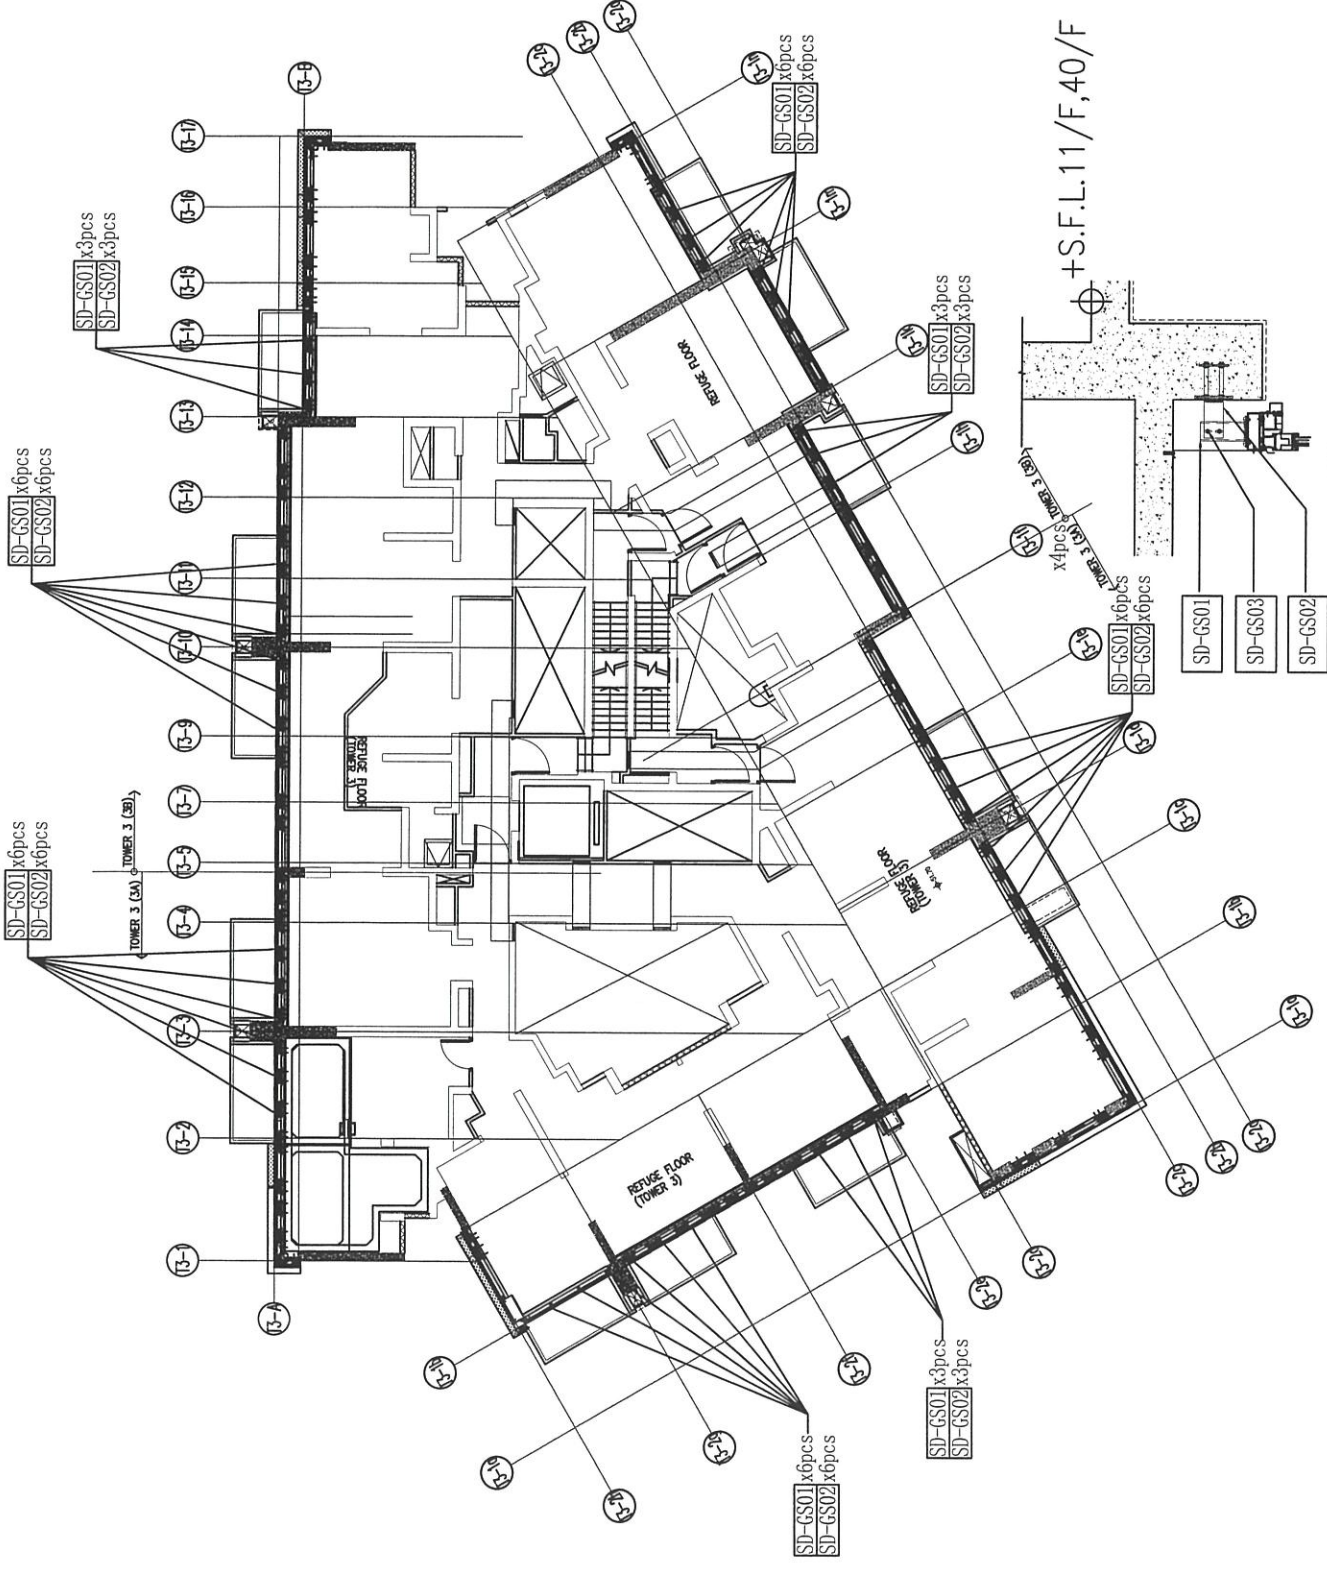

J858趟门顶底铁码位置图 (T3) $\frac{1}{80}$ 11/F,40/F LAYOUT PLAN FOR TOWER 3(1:75)

B.O. REF :

CLIENT : 佳和置業有限公司
Sino Land Company Limited

ARCHITECT : Ronald Lu
Ronald Lu & Partners (HK) Ltd.
羅朗強建築師事務所 (香港) 有限公司

STRUCTURAL ENGINEER : Gammon
AECOM
FRAME CONSULTANT: **AECOM**

NOTE :
1. ALL DIMENSIONS ARE IN MM.
2. ALL ELEVATIONS ARE VIEWED FROM OUTSIDE.
3. ALL DIMENSIONS TO BE VERIFIED ON SITE BEFORE FABRICATION.

LEGEND :
① - DETAIL MARK NO.
② - REFER SHEET NO.
③ - F.F.L. - FINISHED FLOOR LEVEL.
④ - S.F.L. - STRUCTURAL FLOOR LEVEL.
⑤ - REVERSED DETAIL.

JOB NO. : J-858

PROJECT : PROPOSED RESIDENTIAL DEVELOPMENT
AT TROT. 70RP, PHASE 11, LOHAS PARK
ISELING KWAN O, N.T.


TITLE : TYPICAL FLOOR PLAN
AT TOWER 3

DATE : 14-Jun-22 SCALE : 1/80(A1)

DRAWN BY : KY CHECKED BY : YB

UNITED STRUCTURAL ENGINEERS LTD.
810 Chee Koo Ling Road, Kowloon
Tel: 25248821-3 Fax: (852) 27278868

DWG NO. : J858-CP-SD-3303 REV. : -

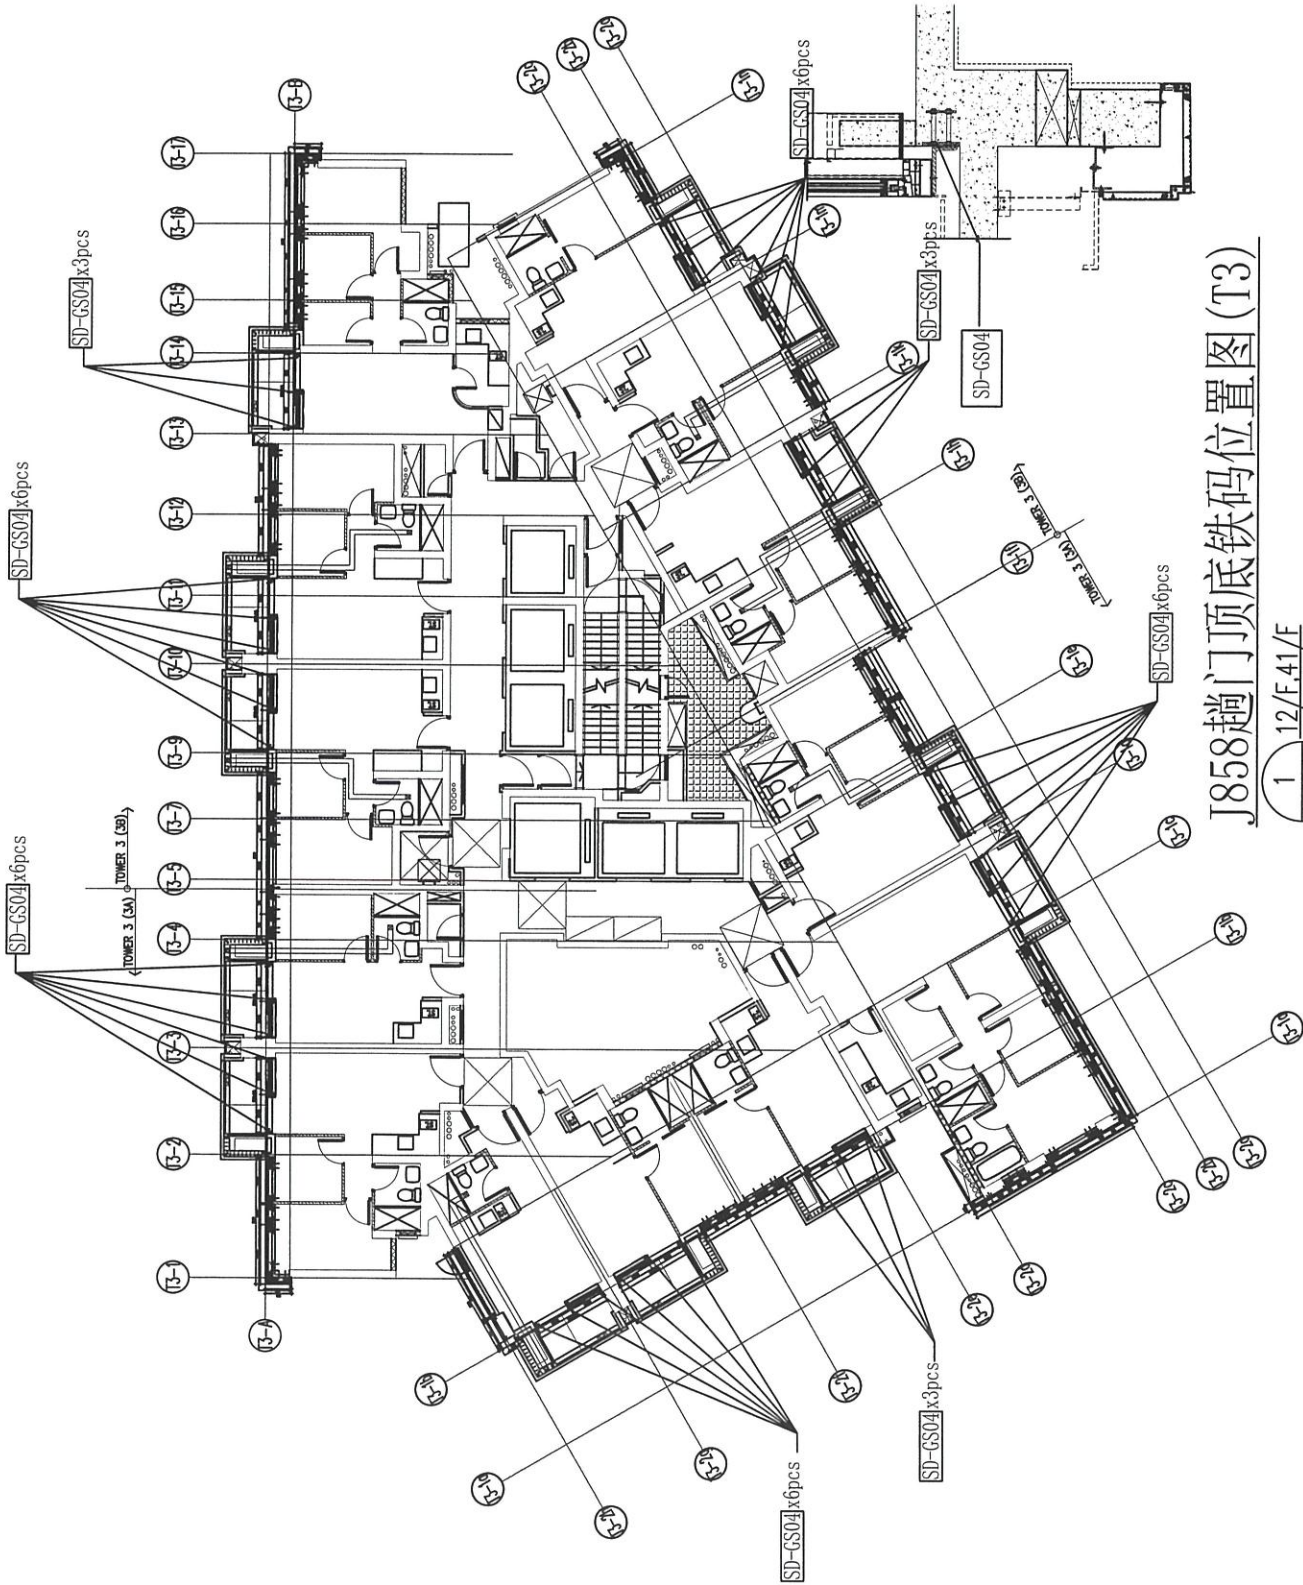

J858趟门顶底铁码位置图(T3)

1/12 F, 41/F
LAYOUT PLAN FOR TOWER 3(1:75)

工程: J858康城11期(T1)

日期: 27-Jul-22

Handwritten signature

序号	部件图编号															
		9F	10	11	12F	15F	16F	17F	18F	19F	20F	21F	22F	23F	25F	26F
1	SD-GS01	39	39	39		39	39	39	39	39	39	39	39	39	39	39
2	SD-GS02	39	39	39		39	39	39	39	39	39	39	39	39	39	39
3	SD-GS03	156	156	156		156	156	156	156	156	156	156	156	156	156	156
4	SD-GS04	39	39		39	39	39	39	39	39	39	39	39	39	39	39
5	SD-GS05	13	13		13	13	13	13	13	13	13	13	13	13	13	13
	分层数量	286	286	234	52	286	286	286	286	286	286	286	286	286	286	286

J858康城11期趟门顶底铁码数量分层统计表(T1)

楼层

27F	28F	29F	30F	31F	32F	33F	35F	36F	37F	38F	39F	40F	41F	42F	43F	45F	46F	47F	48F
39	39	39	39	39	39	39	39	39	39	39	39	39		39	39	39	39	39	39
39	39	39	39	39	39	39	39	39	39	39	39	39		39	39	39	39	39	39
156	156	156	156	156	156	156	156	156	156	156	156	156		156	156	156	156	156	156
39	39	39	39	39	39	39	39	39	39	39	39		39	39	39	39	39	39	39
13	13	13	13	13	13	13	13	13	13	13	13		13	13	13	13	13	13	13
286	286	286	286	286	286	286	286	286	286	286	286	234	52	286	286	286	286	286	286

														总数量	备注
49F	50F	51F	52F	53F	55F	56F	57F	58F	59F	60F	61F	62/F			
39	39	39	39	39	39	39	39	39	39	39	39	39		1794	送地盘
39	39	39	39	39	39	39	39	39	39	39	39	39		1794	送地盘
156	156	156	156	156	156	156	156	156	156	156	156	156		7176	送地盘
39	39	39	39	39	39	39	39	39	39	39	39	39		1794	送地盘
13	13	13	13	13	13	13	13	13	13	13	13	13		598	送工厂
286	286	286	286	286	286	286	286	286	286	286	286	286	0	13156	

工程: J858康城11期(T2)

日期: 27-Jul-22

序号	部件图编号															
		9F	10F	11F	12F	15F	16F	17F	18F	19F	20F	21F	22F	23F	25F	26F
1	SD-GS01	39	39	39		39	39	39	39	39	39	39	39	39	39	39
2	SD-GS02	39	39	39		39	39	39	39	39	39	39	39	39	39	39
3	SD-GS03	156	156	156		156	156	156	156	156	156	156	156	156	156	156
4	SD-GS04	39	39		39	39	39	39	39	39	39	39	39	39	39	39
5	SD-GS05	13	13		13	13	13	13	13	13	13	13	13	13	13	13
	分层数量	286	286	234	52	286	286	286	286	286	286	286	286	286	286	286

J858康城11期趟门顶底铁码数量分层统计表(T2)

楼层

27F	28F	29F	30F	31F	32F	33F	35F	36F	37F	38F	39F	40F	41F	42F	43F	45F	46F	47F	48F
39	39	39	39	39	39	39	39	39	39	39	39	39		39	39	39	39	39	39
39	39	39	39	39	39	39	39	39	39	39	39	39		39	39	39	39	39	39
156	156	156	156	156	156	156	156	156	156	156	156	156		156	156	156	156	156	156
39	39	39	39	39	39	39	39	39	39	39	39		39	39	39	39	39	39	39
13	13	13	13	13	13	13	13	13	13	13	13		13	13	13	13	13	13	13
286	286	286	286	286	286	286	286	286	286	286	286	234	52	286	286	286	286	286	286

																		总数量	备注
49F	50F	51F	52F	53F	55F	56F	57F	58F	59F	60F	61F	62/F	63F	65F	66F	67/F			
39	39	39	39	39	39	39	39	39	39	39	39	39	39	39	39	39		1950	送地盘
39	39	39	39	39	39	39	39	39	39	39	39	39	39	39	39	39		1950	送地盘
156	156	156	156	156	156	156	156	156	156	156	156	156	156	156	156	156		7800	送地盘
39	39	39	39	39	39	39	39	39	39	39	39	39	39	39	39	39		1950	送地盘
13	13	13	13	13	13	13	13	13	13	13	13	13	13	13	13	13		650	送地盘
																		0	送地盘
																		0	送地盘
																		0	送地盘
																		0	送地盘
286	286	286	286	286	286	286	286	286	286	286	286	286	286	286	286	286	0	14300	

工程: J858康城11期(T3)

日期: 27-Jul-22

序号	部件图编号															
		9F	10F	11F	12F	15F	16F	17F	18F	19F	20F	21F	22F	23F	25F	26F
1	SD-GS01	39	39	39		39	39	39	39	39	39	39	39	39	39	39
2	SD-GS02	39	39	39		39	39	39	39	39	39	39	39	39	39	39
3	SD-GS03	156	156	156		156	156	156	156	156	156	156	156	156	156	156
4	SD-GS04	39	39		39	39	39	39	39	39	39	39	39	39	39	39
5	SD-GS05	13	13		13	13	13	13	13	13	13	13	13	13	13	13
	分层数量	286	286	234	52	286	286	286	286	286	286	286	286	286	286	286

J858康城11期趟门顶底铁码数量分层统计表(T3)

楼层																			
27F	28F	29F	30F	31F	32F	33F	35F	36F	37F	38F	39F	40F	41F	42F	43F	45F	46F	47F	48F
39	39	39	39	39	39	39	39	39	39	39	39	39		39	39	39	39	39	39
39	39	39	39	39	39	39	39	39	39	39	39	39		39	39	39	39	39	39
156	156	156	156	156	156	156	156	156	156	156	156	156		156	156	156	156	156	156
39	39	39	39	39	39	39	39	39	39	39	39		39	39	39	39	39	39	39
13	13	13	13	13	13	13	13	13	13	13	13		13	13	13	13	13	13	13
286	286	286	286	286	286	286	286	286	286	286	286	234	52	286	286	286	286	286	286

																		总数量	备注
49F	50F	51F	52F	53F	55F	56F	57F	58F	59F	60F	61F	62/F	63F	65F	66F	67/F			
39	39	39	39	39	39	39	39	39	39	39	39	39	39	39	39	39		1950	送地盘 <i>敬</i>
39	39	39	39	39	39	39	39	39	39	39	39	39	39	39	39	39		1950	送地盘
156	156	156	156	156	156	156	156	156	156	156	156	156	156	156	156	156		7800	送地盘
39	39	39	39	39	39	39	39	39	39	39	39	39	39	39	39	39		1950	送地盘
13	13	13	13	13	13	13	13	13	13	13	13	13	13	13	13	13		650	送地盘 <i>敬</i>
																		0	送地盘
																		0	送地盘
																		0	送地盘
																		0	送地盘
286	286	286	286	286	286	286	286	286	286	286	286	286	286	286	286	286	0	14300	