



工程指示 / 要求簡箋(E.I.)

工程指示編號：EI / 5104 / 23

修改版次： D

工程編號： J - 858

工程名稱：將軍澳日出康城 11

工程項目：Glass Cladding 地盆用 特色層 鐵件加工圖修改

收件人：Maggie

發件人：Ant Yeung

日期：15/09/2023

要求提供 / 確認 事項：

內容：

D 版: 從 EI5104 A 版抽取圖紙。請按加工圖生產特色層用鐵件送地盆。

GS-(18,18a,19,20) , GS(31-35) , GS (42-43)

特色層修改的加工圖，改短和加孔生產。

附位置圖

C 版:因應凹坑公差，修改 FS-01 的數量。

C 版:增加 FS-01-150, FS-X-150 圖紙生產。

B: (1)放行全數; (2)取消 M6 牙孔; (3)其餘尺寸沒有修改; (4)FS03 增加 52 件後備; (5)按 EI5136 鉛水厚度指示。

B: (6) 原 EI 已附 BM, (7) 加訂碼仔 FS-01A-80 (300 隻), FS01A-90 (200 隻) 作石矢公差用。

A: 補回圖紙 GS-(18,19,20) , GS(31-35) , GS (42-43)。

A: 此部份為特色層圖紙，先給圖紙作方便記錄。現在未需生產。跟最後一個 MO 執行。

謝謝

請在 2023.10.06 前完成上列要求。

附： 頁

原合約工程包

原合約工程加 / 減賬

新工程報價

分發東莞各部門：

- () 生產技術總監口連附件 () 技術部 口連附件 () 生產部 口連附件 () 機械設計部口連附件
 () 採購部 口連附件 () 生產統籌部 口連附件 () 小羅&清 口連附件
 () 質檢部 口連附件 () 會計部 口連附件 () 報關組 口連附件 () 其他 _____口連附件

分發香港各部門：

- () 行政部口連附件 () 會計部口連附件 () 統籌部口連附件 (✓) 工程部地盤科文_積哥 口連附件
 (✓) 採購部口連附件 () QS 部 口連附件 () 維修部口連附件 () 其他 _____口連附件

傳遞編號：

HK / 23





發件人簽署：

項目經理簽署：

 美特鋁質有限公司 MIDI Aluminium Fabricator Ltd.		工程號 J858 地盘 康城11期	類別 制圖 WCM	物料號 - 2022-08-15	圖號 GS-18
修改 1 日期 15/09	採用工廠 材料颜色 热浸锌	图纸名称 铁料加工图 材料 S-275	復核 - 批准 -	數量 - 單件重量 - (KG)	

位置	QTY
T1 (61/F)	3
T2 (66/F)	3
T3 (66/F)	3

cut from
50x50x6 鐵角

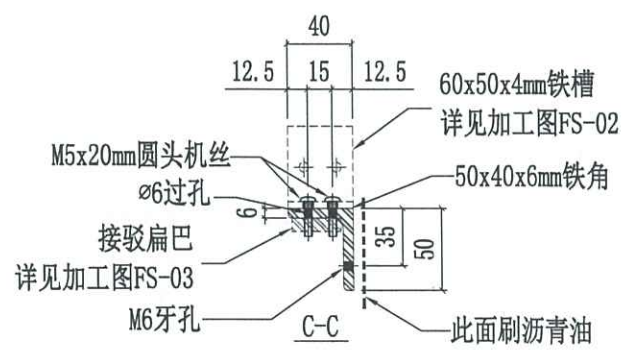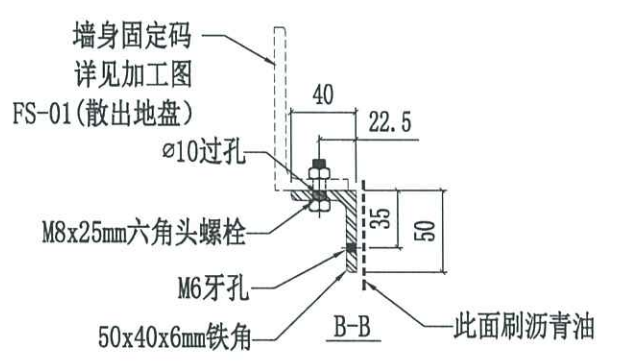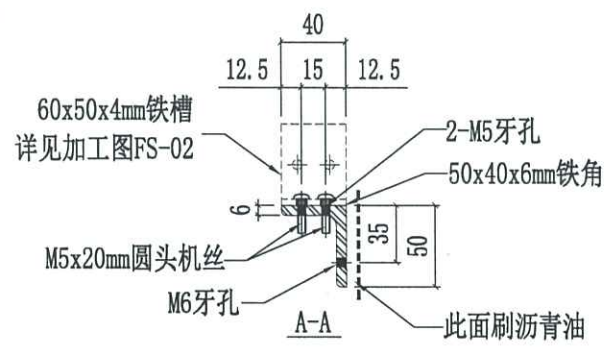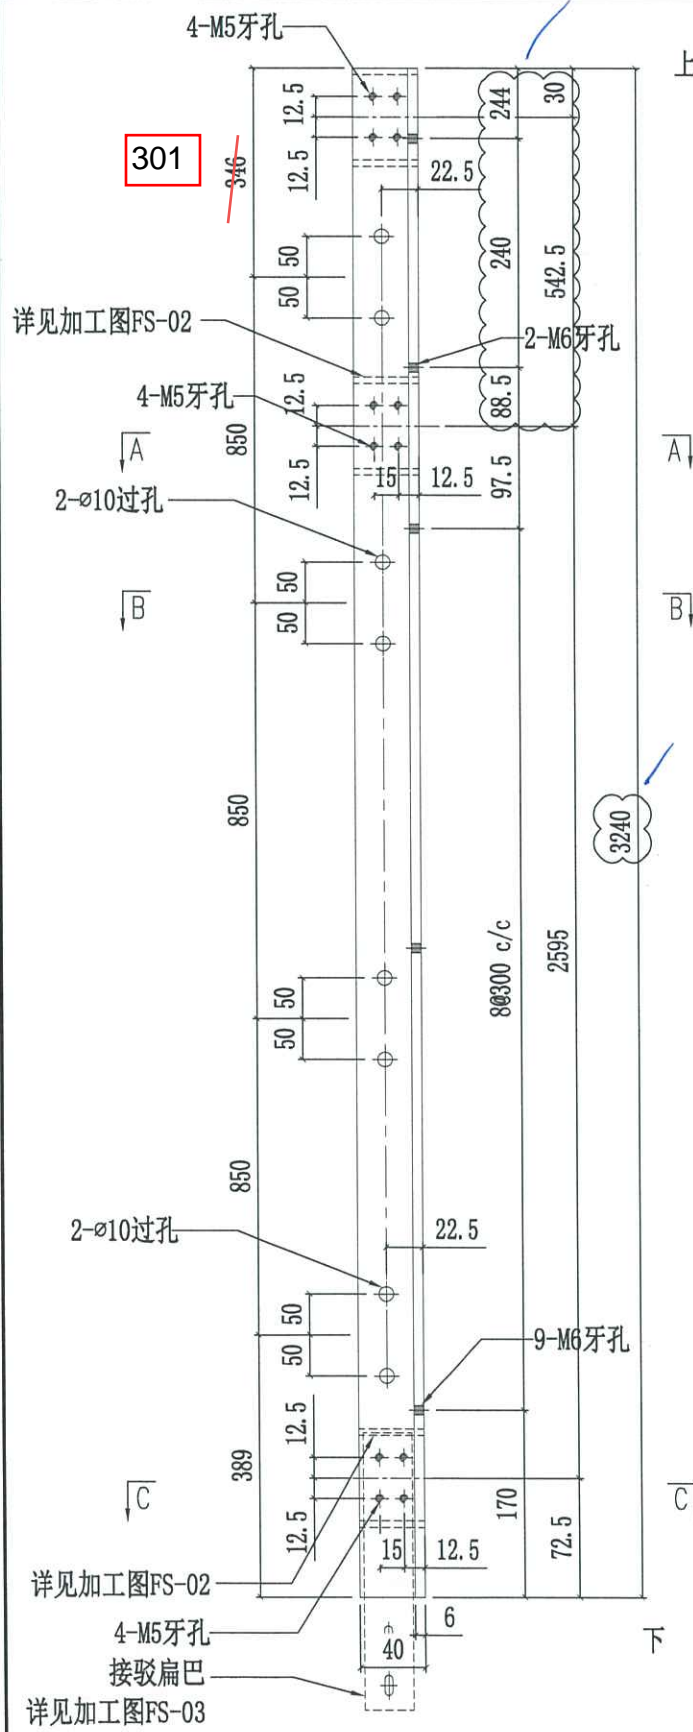


(改短.改孔)






美特鋁質有限公司
MIDI Aluminium Fabricator Ltd.

工程號	J858	類別		物料號	- 修 95-18改
地盘	康城11期	制圖	WCM	2022-08-15	圖號 GS-18a
修改		採用工廠	地盤	✓	图纸名称 铁料加工图
日期		材料颜色 热浸锌	材料	S-275	復核 -
					批准 -
					數量 -
					單件重量 - (KG)

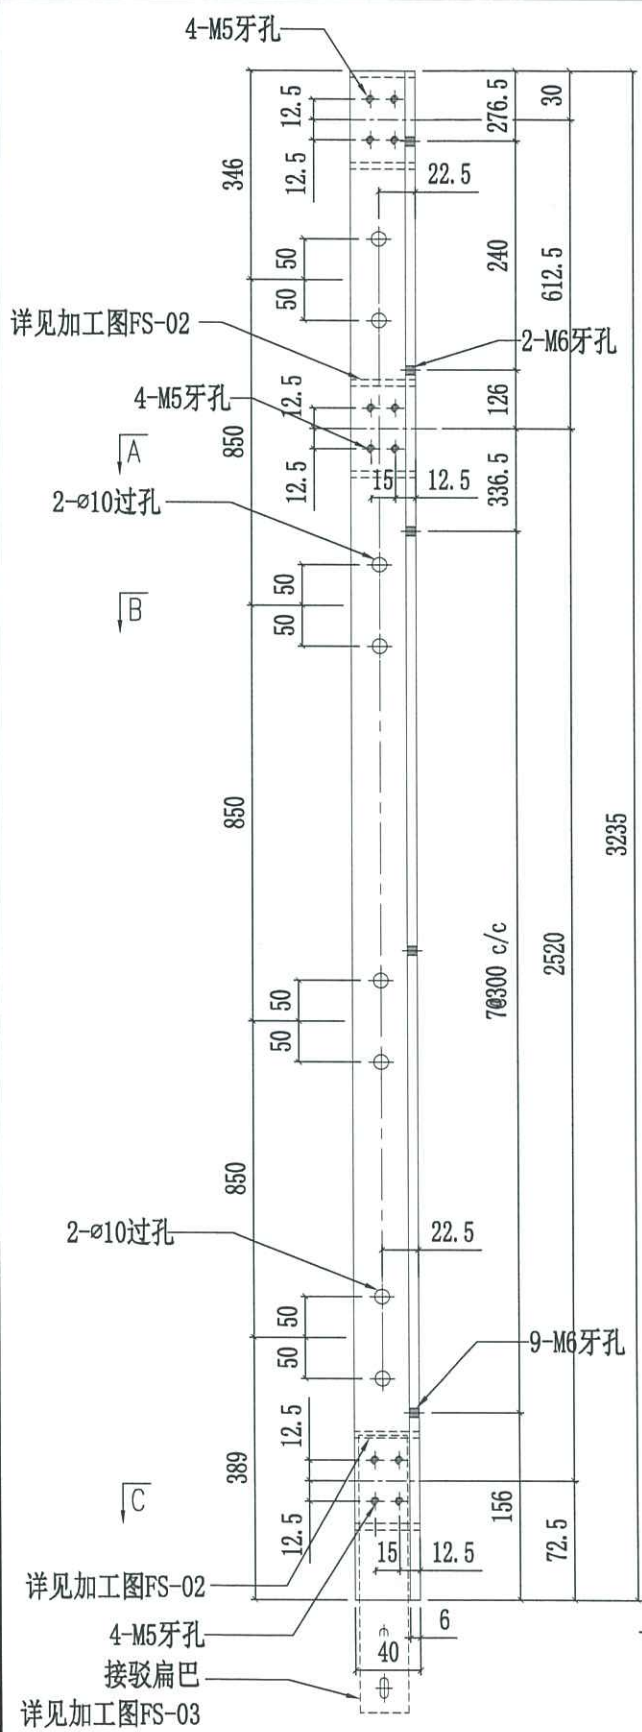

位置	QTY
T1 62/F	3
T2 67/F	1
T3 67/F	1


上
cut from
50x50x6 鐵角

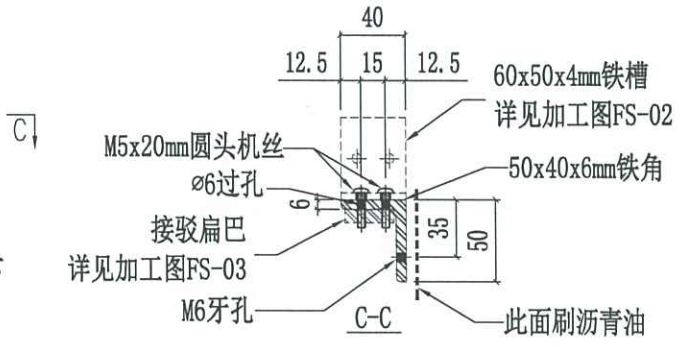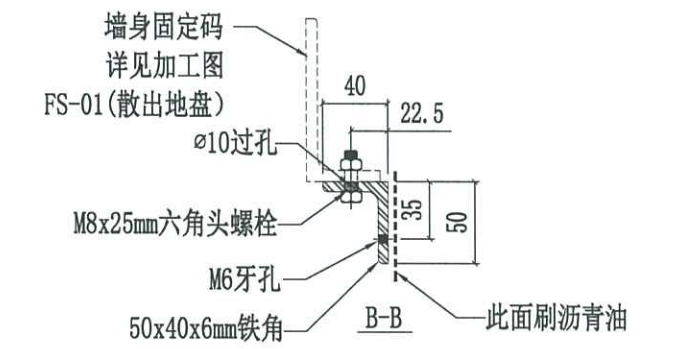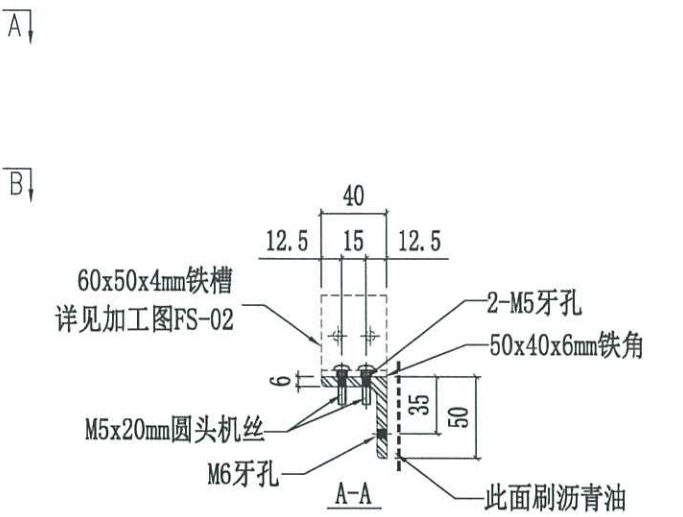


下

 美特铝质有限公司 MIDI Aluminium Fabricator Ltd.			工程號	J858	類別		物料號	-	
修改	1	採用工廠	地盤	康城11期	制圖	WCM	2022-08-15	圖號	GS-20
日期	15/09	材料颜色	热浸锌	图纸名称	铁料加工图	復核	-	數量	-
				材料	S-275	批准	-	單件重量	- (KG)

位置	QTY
T1 61/F	3
T2 66/F	3
T3 66/F	3

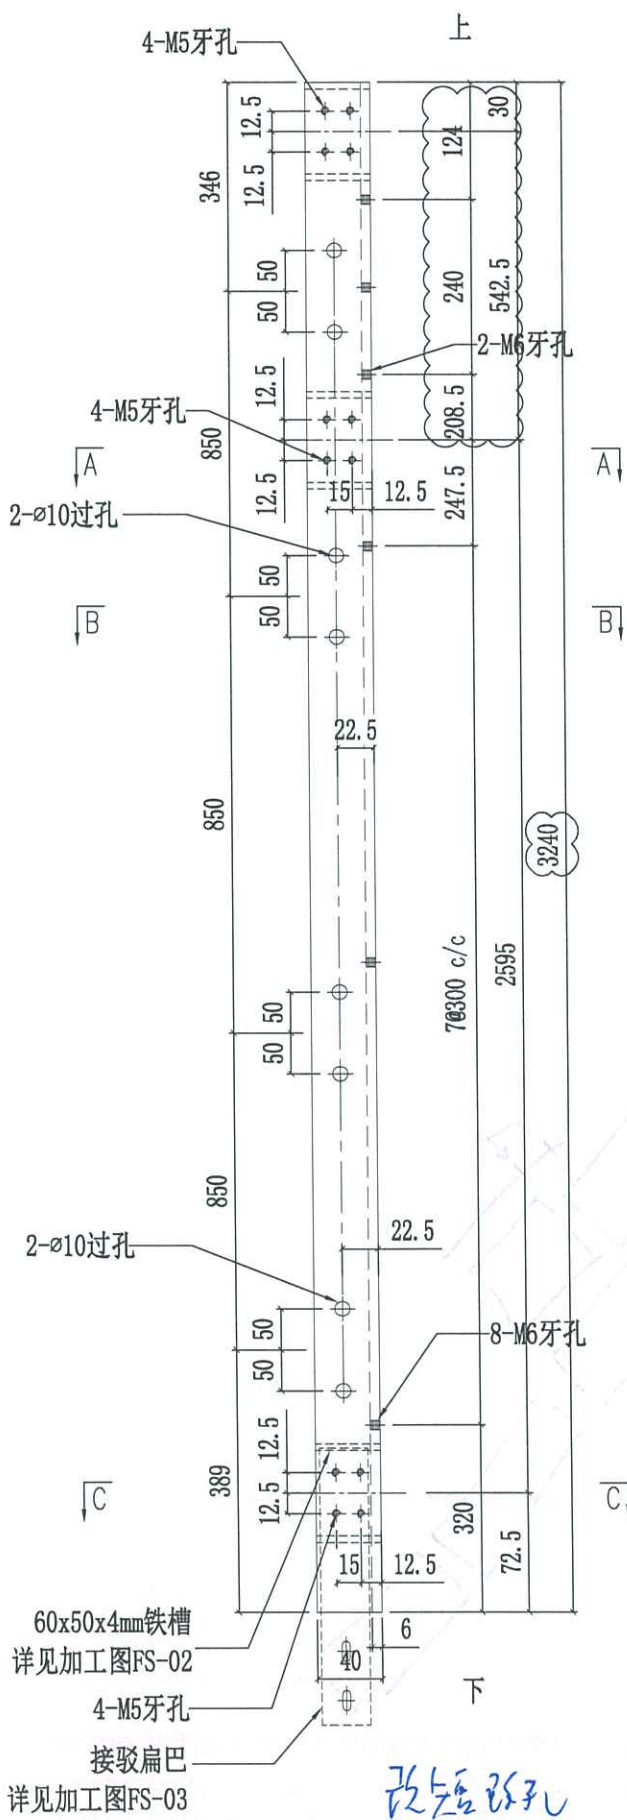


cut from
50x50x6 鐵角

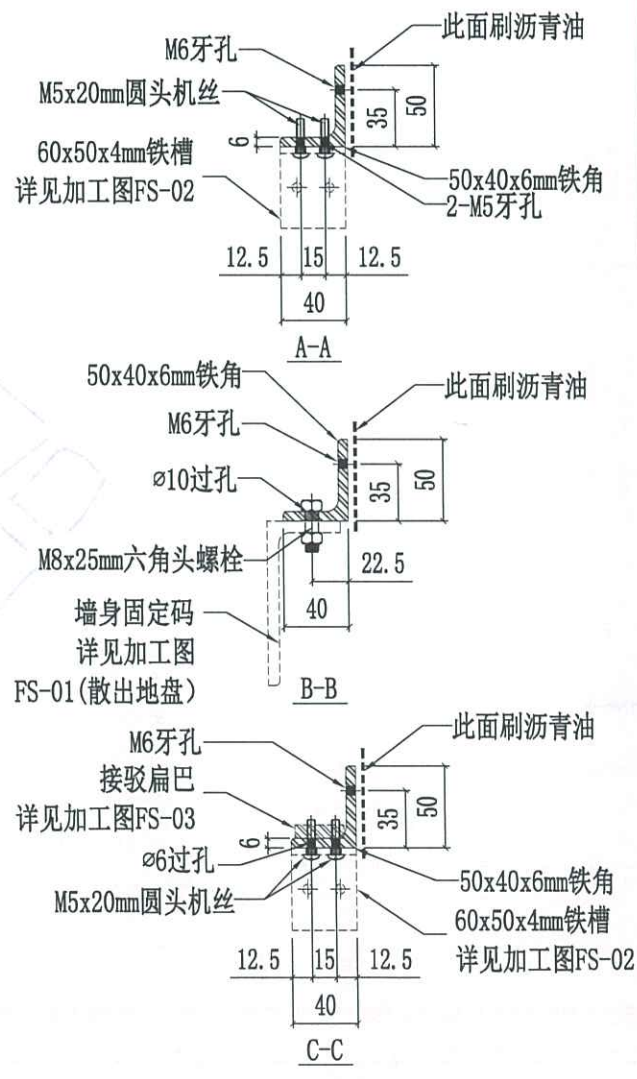


改短孔

 美特铝质有限公司 MIDI Aluminium Fabricator Ltd.		工程號 J858 地盘 康城11期	類別 制圖 WCM	物料號 - 2022-08-15	圖號 GS-31
修改 1 日期 15/09	採用工廠 材料颜色 熟镀锌	图纸名称 铁料加工图 材料 S-275	復核 - 批准 -	數量 - 單件重量 - (KG)	

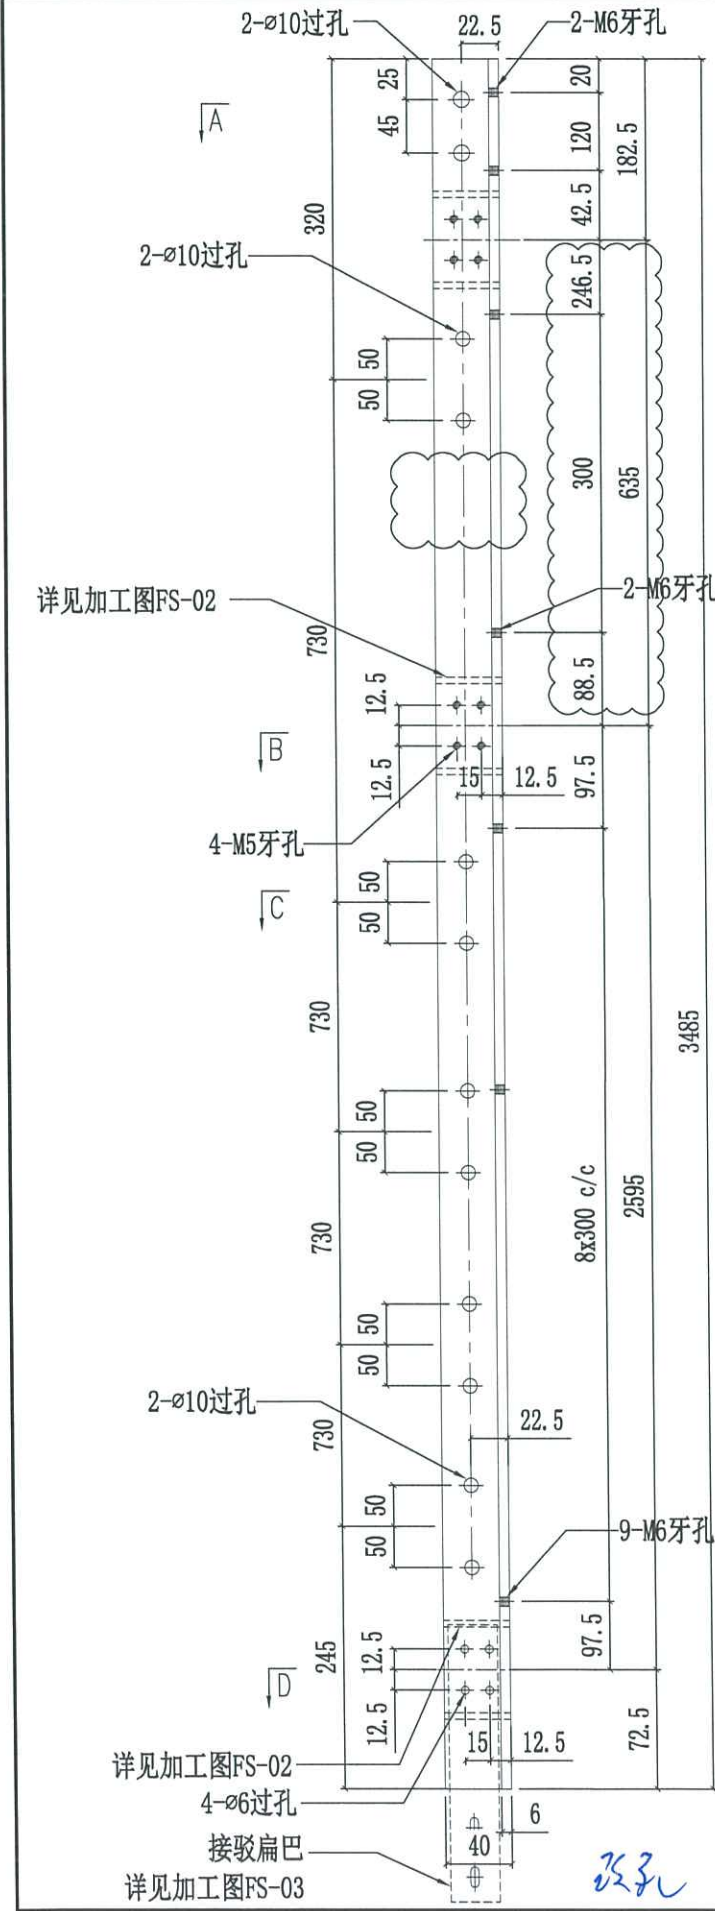

位置	QTY
T1 61/F	3
T2 66/F	1
T3 66/F	1


cut from
50x50x6 鐵角

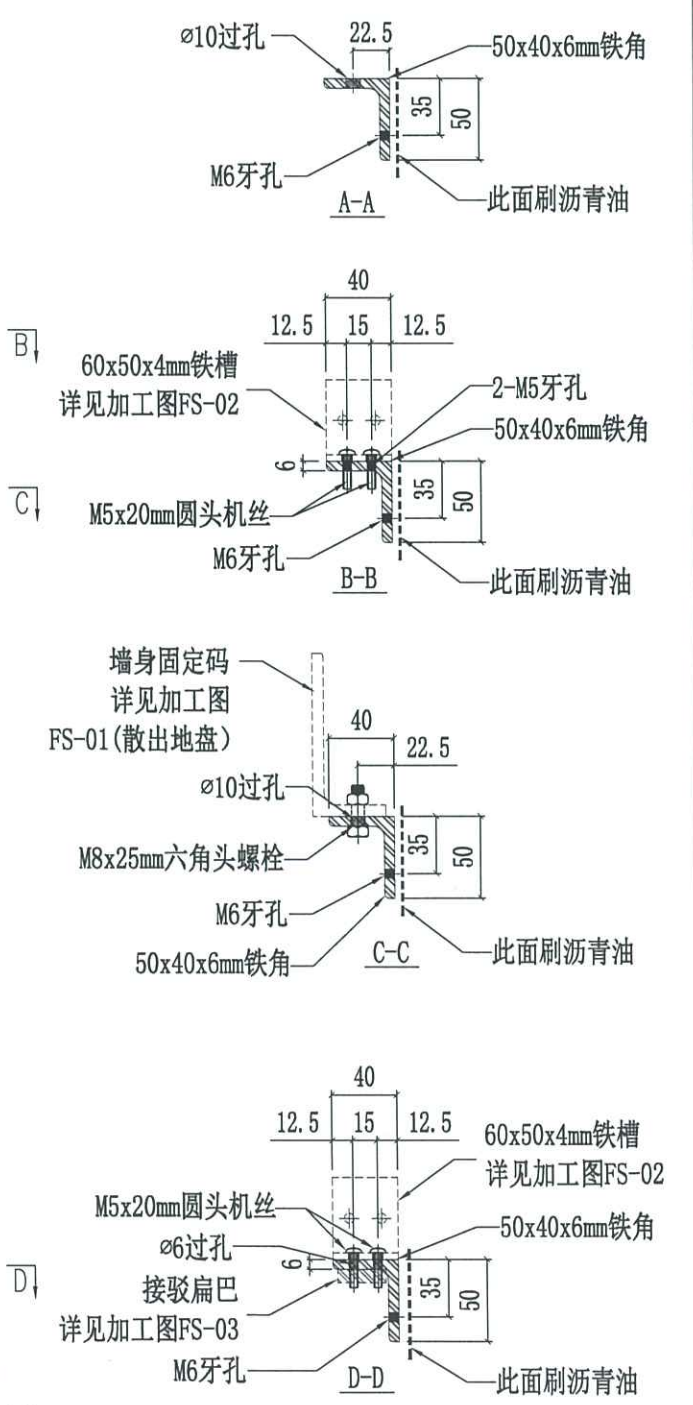


改孔

 美特铝质有限公司 MIDI Aluminium Fabricator Ltd.			工程號 J858 地盘 康城11期	類別 制圖 WCM	物料號 - 2022-08-15	圖號 GS-35
修改 1 日期 15/09	採用工廠 材料颜色 熟镀锌	地盤 <input checked="" type="checkbox"/>	图纸名称 铁料加工图 材料 S-275	復核 - 批准 -	數量 - 單件重量 - (KG)	

位置	QTY
T1 62/F	3
T2 67/F	1

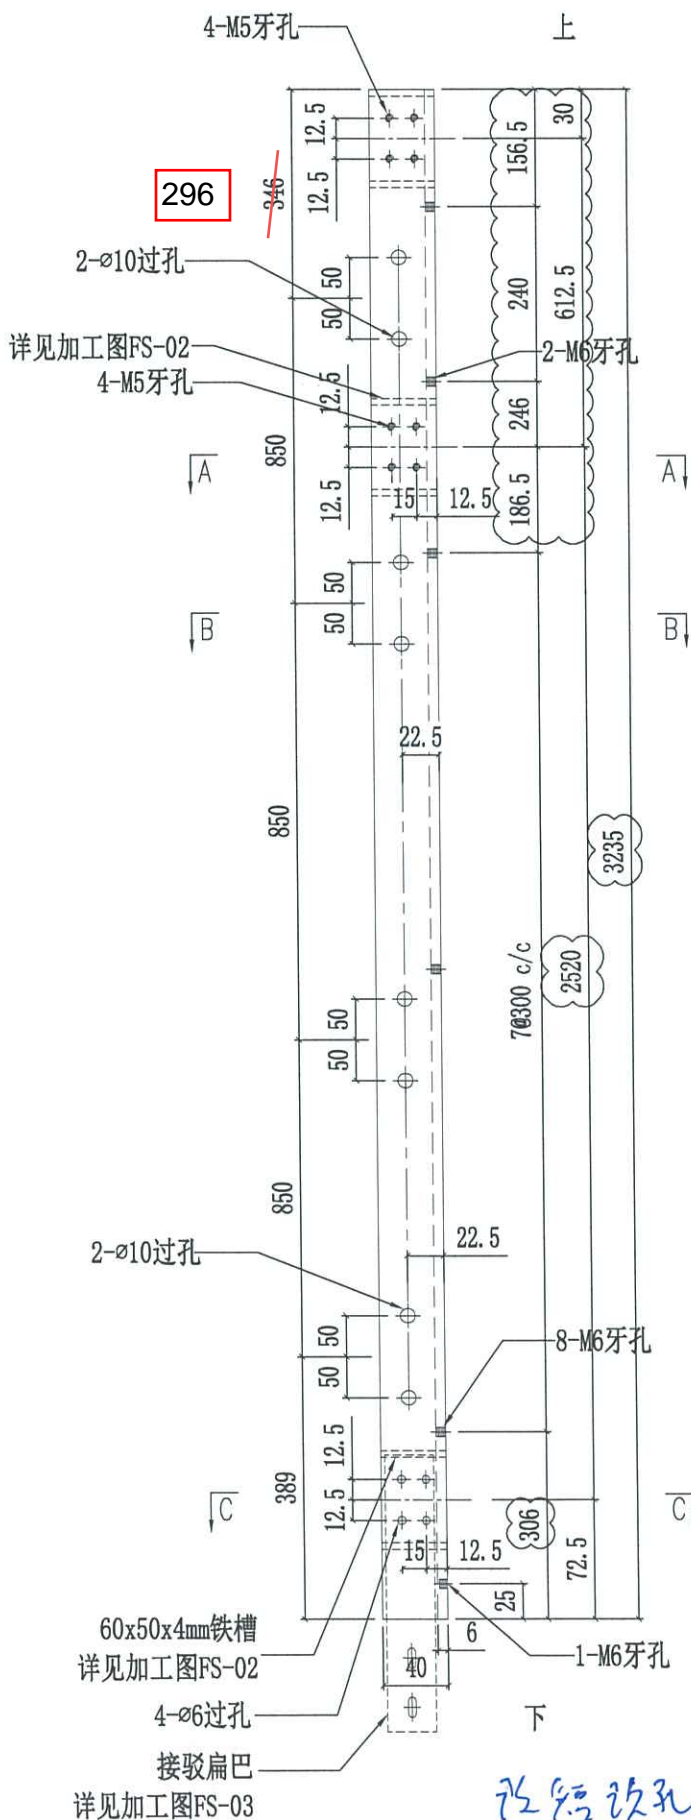



cut from
50x50x6 鐵角

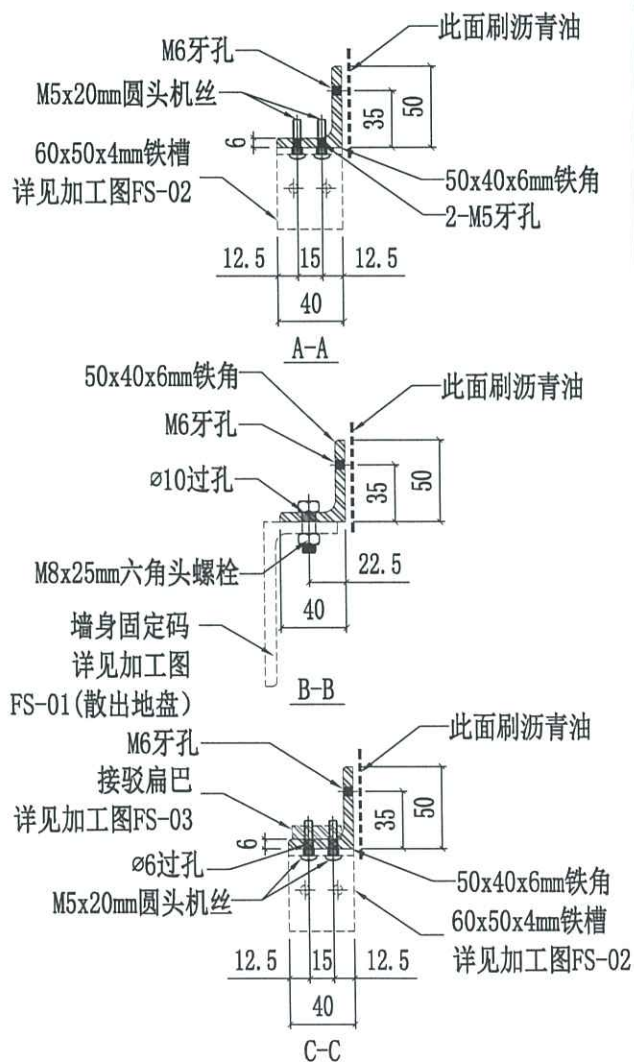




改行改孔

 美特铝质有限公司 MIDI Aluminium Fabricator Ltd.		工程號 J858 地盘 康城11期	類別 制圖 WCM	物料號 - 2022-08-15	圖號 GS-42
修改 1 日期 15/09	採用工廠 材料颜色 熟镀锌	图纸名称 铁料加工图 材料 S-275	復核 - 批准 -	數量 - 單件重量 - (KG)	

位置	QTY
T3 66/F	1

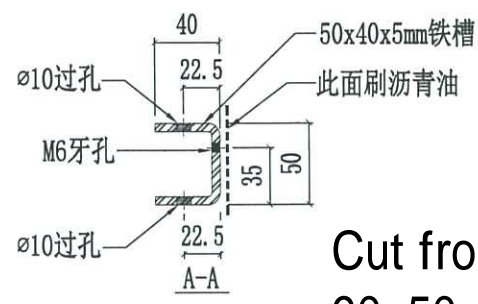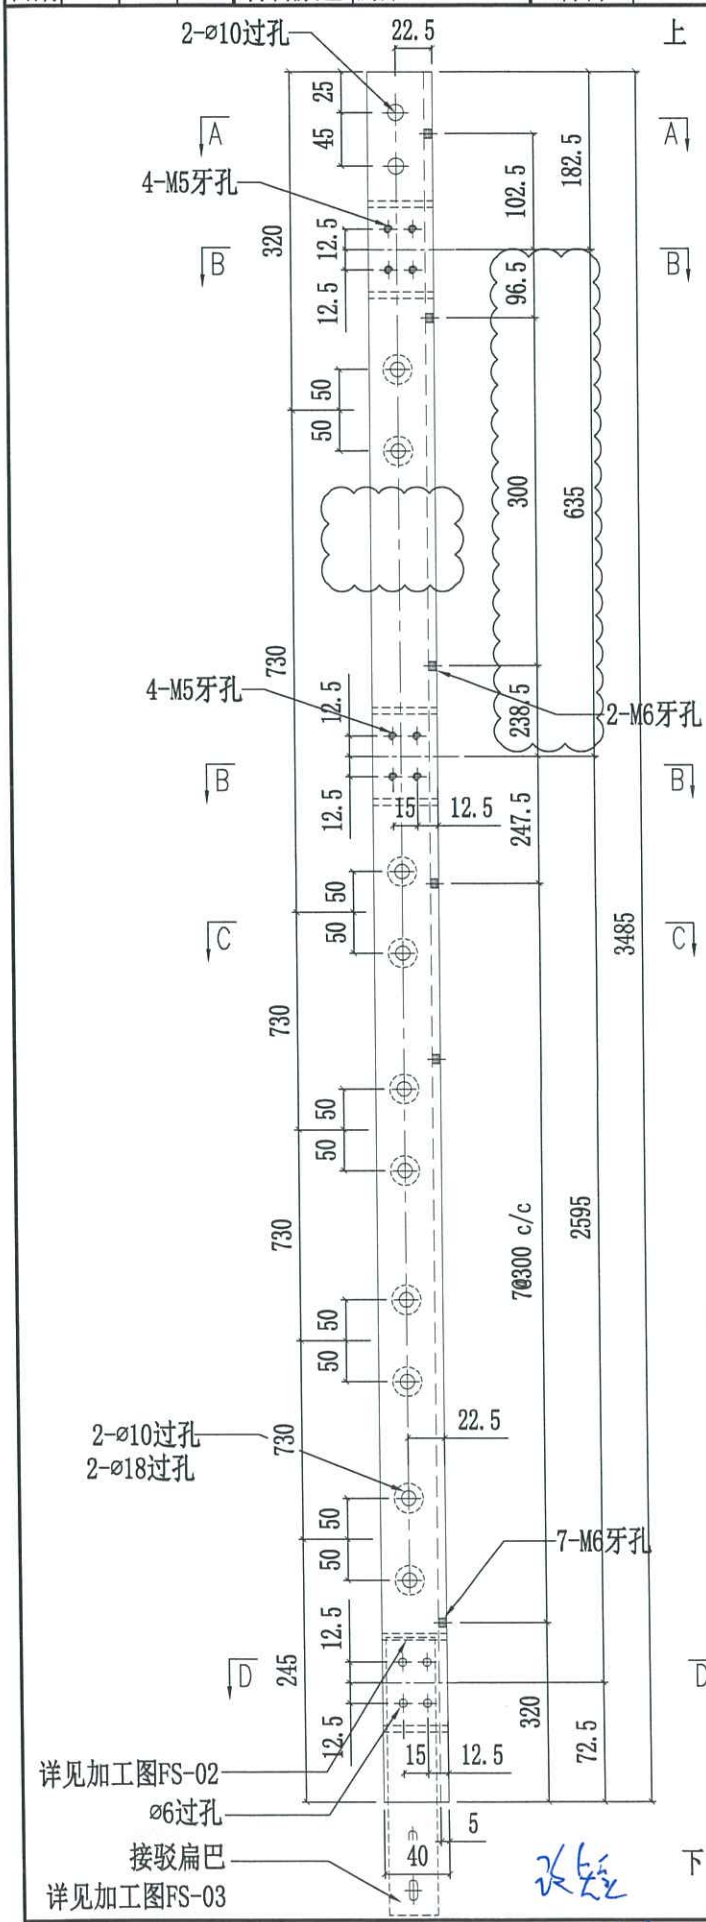


Cut from
90x50x5 鐵通

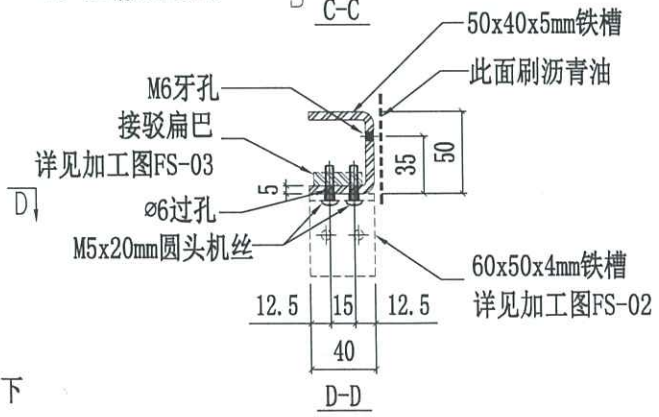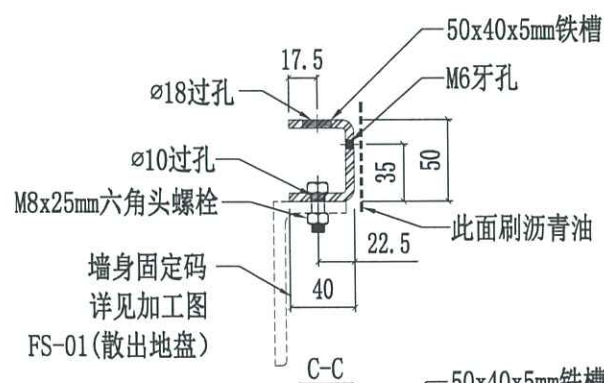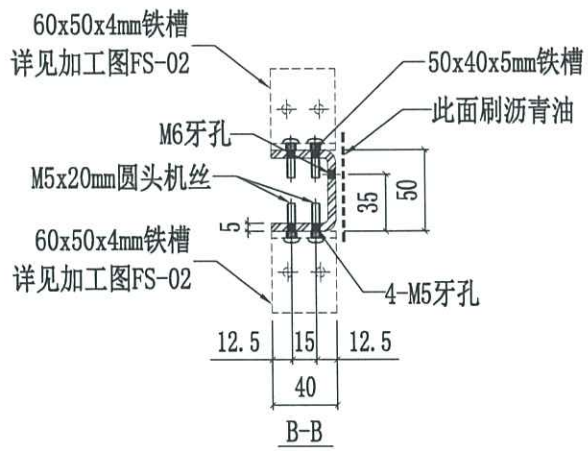




下
改孔

 美特铝质有限公司 MIDI Aluminium Fabricator Ltd.		工程號 J858 地盘 康城11期	類別 制圖 WCM	物料號 - 2022-08-15	圖號 GS-43
修改 1 日期 15/09	採用工廠 材料颜色 熟浸锌	图纸名称 铁料加工图 材料 S-275	復核 - 批准 -	數量 - 單件重量 - (KG)	


位置	QTY
T3 67/F	1

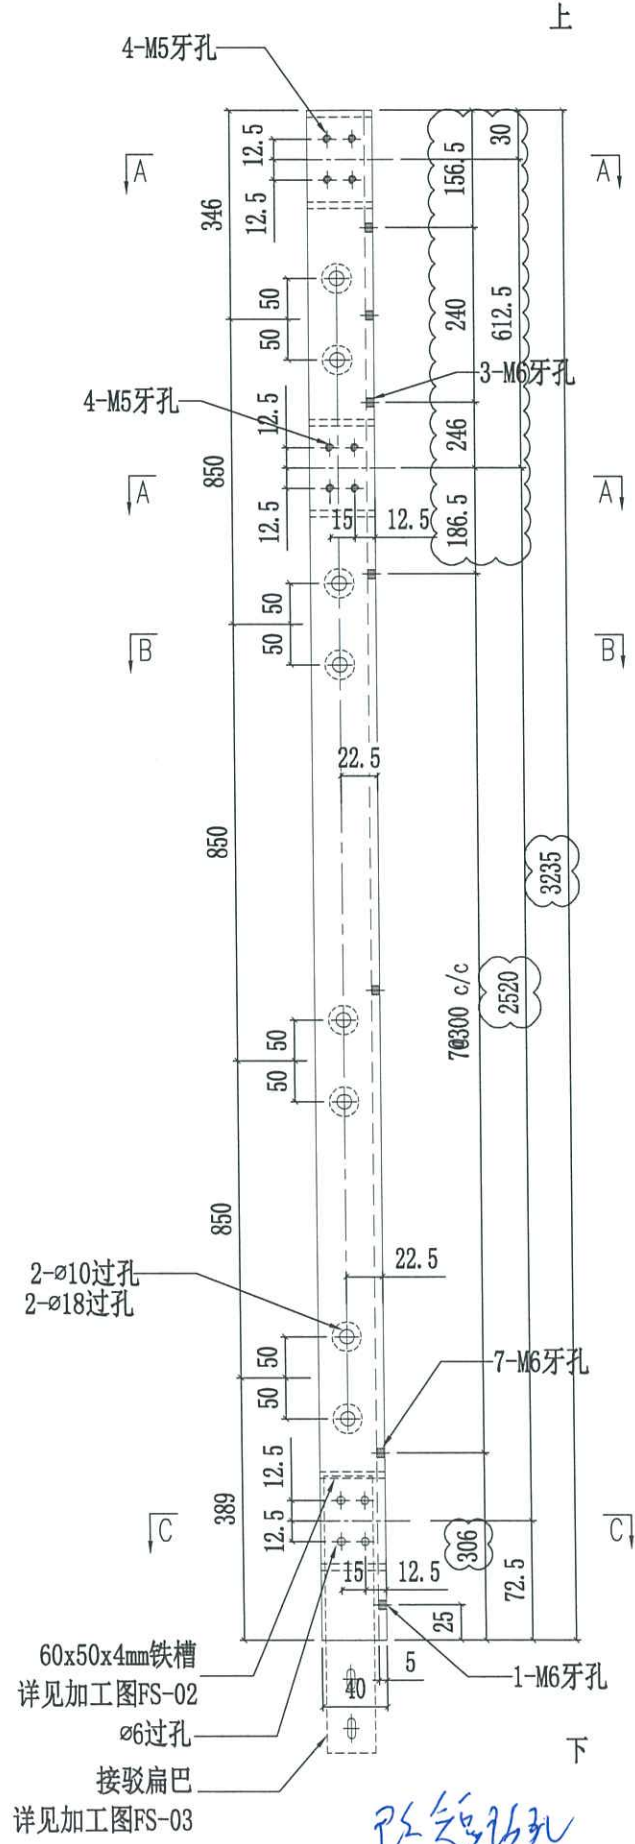

Cut from
90x50x5 鐵通

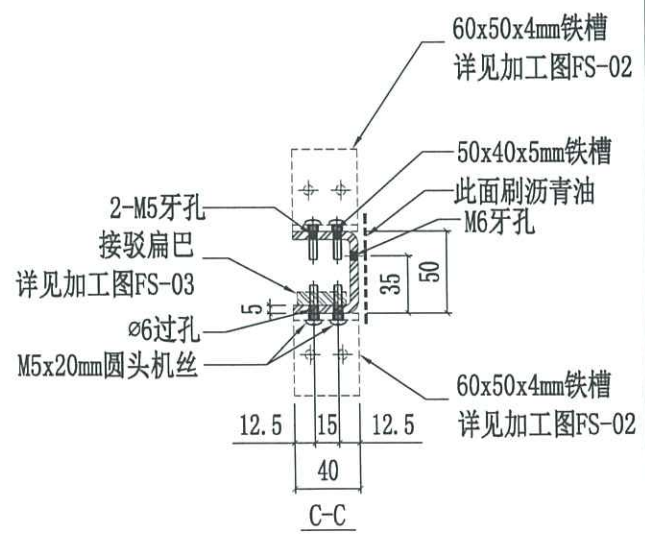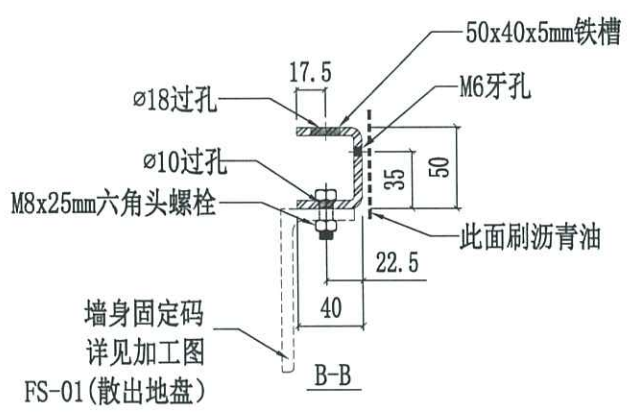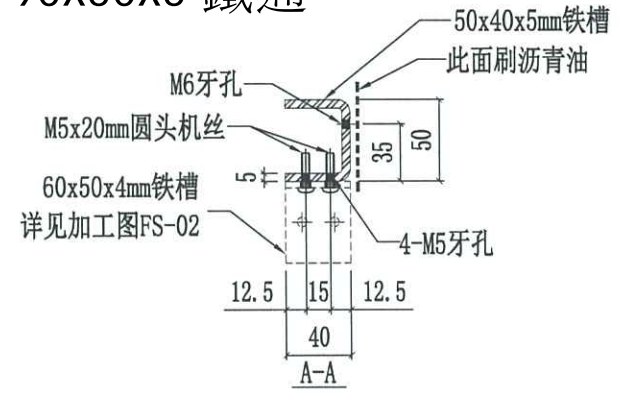

改定孔

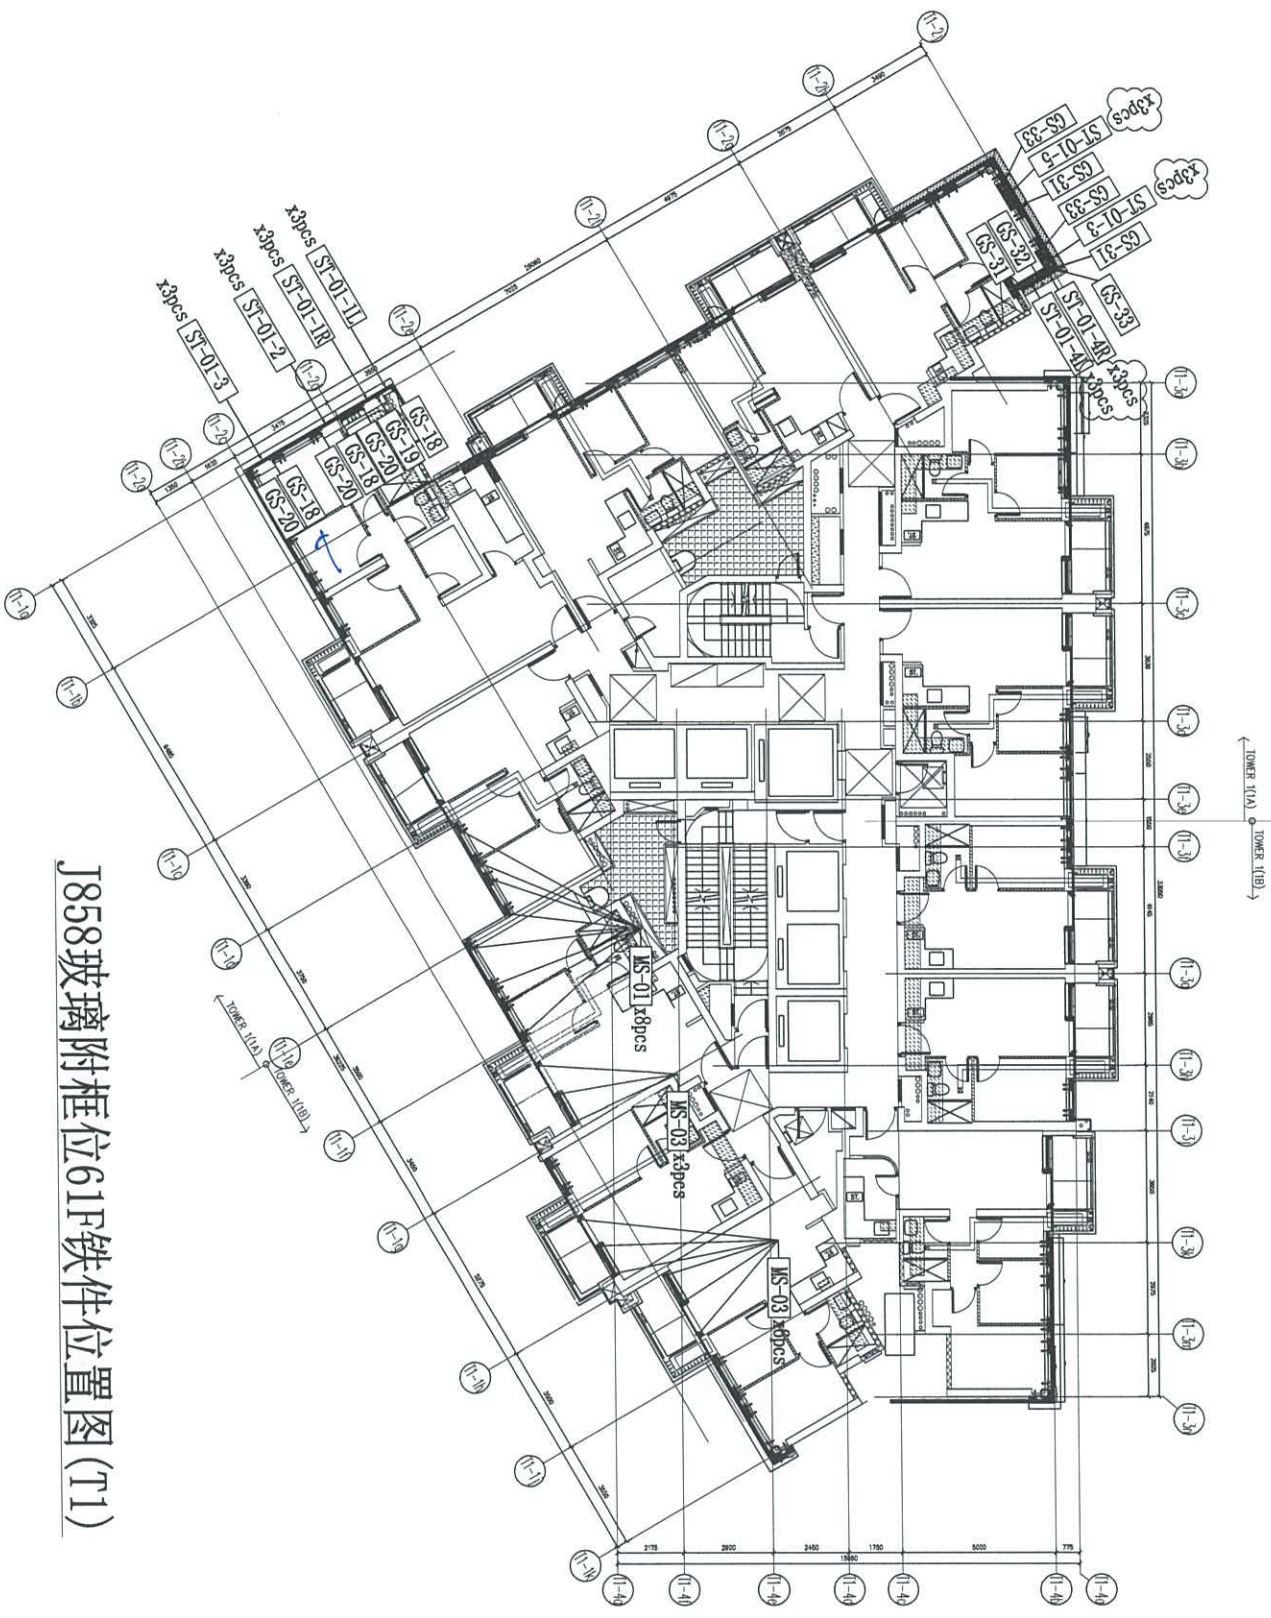

J858玻璃附框位61F铁件位置图 (T1)

JOB NO. : J-858		DATE : 22-OCT-21	SCALE : 1:80(A)
PROJECT : PROPOSED RESIDENTIAL DEVELOPMENT AT TOWER 708F, PHASE 11, LOKAS PARK TSINGI KWAN Q. N.T.		DRAWN BY : KY	CHECKED BY : YB
TITLE : TYPICAL FLOOR PLAN AT TOWER 1			
<p>ARCHITECT : ronald lu & partners Ronald Lu & Partners (HK) Ltd. 呂文行建築師事務所 (註冊) 有限公司 MAIN CONTRACTOR :</p>			
<p>CLIENT : 世和置業有限公司 Sino Land Company Limited</p>			
<p>STRUCTURAL ENGINEER : Gammorn AECOM AECOM</p>			
<p>FAÇADE CONSULTANT : AECOM</p>			
<p>NOTE : 1. ALL DIMENSIONS ARE IN mm. 2. ALL ELEVATIONS ARE VIEWED FROM OUTSIDE. 3. ALL DIMENSIONS TO BE VERIFIED ON SITE BEFORE PROVISION. LEGEND: (○) DETAIL MARK NO. (○) REFER SHEET NO. 1. F.F.L. -- FINISHED FLOOR LEVEL. 2. S.F.L. -- STRUCTURAL FLOOR LEVEL. 3. (◐) -- REVERSED DETAIL.</p>			
NO.	REV.	REASON	BY
<p>DRW. NO. : J858-1P107</p>			

美特堅有限公司
 MTDI Aluminium Fabrication Ltd.
 Unit 6-B, Sunny Industrial Centre, 1/F
 182-2882211-4 Fax: (853) 27272555

BD, REF :

CLIENT : **新加坡置地有限公司**
Sino Land Company Limited

ARCHITECT : **ronald lu**
Ronald Lu & Partners (HK) Ltd.
呂志文建築師事務所 (香港) 有限公司

STRUCTURAL ENGINEER : **Gammon**
AECOM

FAÇADE CONSULTANT : **AECOM**

NOTE :
1. ALL DIMENSIONS ARE IN mm.
2. ALL ELEVATIONS ARE VIEWED FROM OUTSIDE.
3. ALL DIMENSIONS TO BE CHECKED ON SITE BEFORE FABRICATION.


LEGEND :
① - DETAIL MARK NO.
② - REFER SHEET NO.
1. F.F.L. -- FINISHED FLOOR LEVEL.
2. S.F.L. -- STRUCTURAL FLOOR LEVEL.
3. (R) -- REVERSED DETAIL.

JOB NO. : J-055
PROJECT : PROPOSED RESIDENTIAL DEVELOPMENT
AT TOWER 1, PHASE T1, LUNAS PARK
TSUNG KWAN O, N.T.

TITLE : TYPICAL FLOOR PLAN
AT TOWER 1

DATE : 22-OCT-21
SCALE : 1:80(A1)
DRAWN BY : KY
CHECKED BY : YB

美特銘質有限公司
MIDI Aluminium Fabrication Ltd.
香港新界沙田沙田圍沙田圍路610號
Tel: 2489711-4 Fax: (852) 2727666
DWG NO. : J055-1P108
REV. :

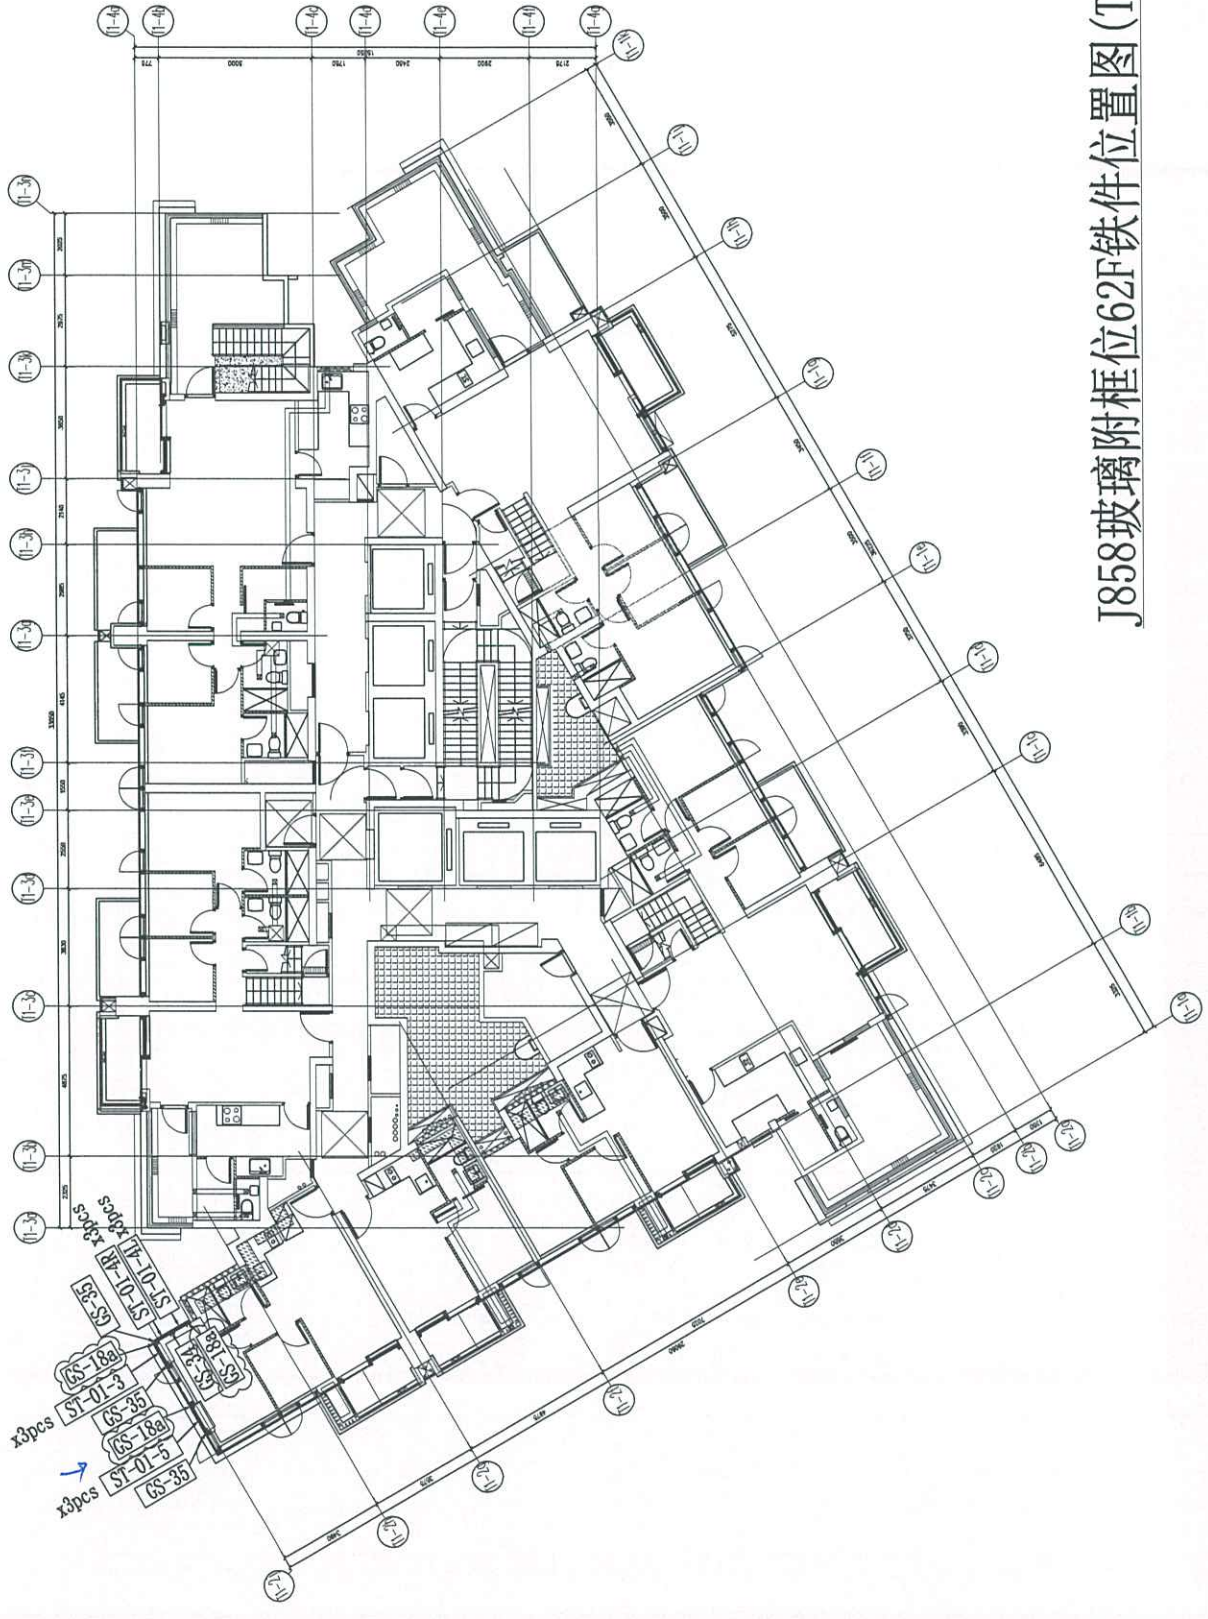

J858玻璃附框位62F铁件位置图(T1)

BD. REF :

CLIENT : **新和置業有限公司**
Sino Land Company Limited

ARCHITECT : **ronald lu**
Ronald Lu & Partners (HK) Ltd.
羅國強建築師事務所 (香港) 有限公司

STRUCTURAL ENGINEER : **Gammon**
AECOM

FAÇADE CONSULTANT : **AECOM**

NOTE :
1. ALL DIMENSIONS ARE IN mm.
2. ALL ELEVATIONS ARE VIEWED FROM OUTSIDE.
3. ALL DIMENSIONS TO BE CHECKED ON SITE BEFORE FABRICATION.


LEGEND:
① - DETAIL MARK NO.
② - REFER SHEET NO.
1. F.F.L. -- FINISHED FLOOR LEVEL.
2. S.F.L. -- STRUCTURAL FLOOR LEVEL.
3. Ⓜ -- REVERSED DETAIL.

JOB NO. : J-858
PROJECT : PROPOSED RESIDENTIAL DEVELOPMENT
AT TOWER 209P, PHASE 11, LUNAS PARK
TSEUNG KWAN O, N.T.

TITLE : TYPICAL FLOOR PLAN
AT TOWER 1

DATE : 22-OCT-21 SCALE : 1:80(A1)
DRAWN BY : KY CHECKED BY : YB

美特銘質有限公司
MTDI INTERNATIONAL MANUFACTURING LTD.
香港沙田, 新圍街 11 號
810 Che Kwo Ling Road, Kwai Tsong
Tel: 2488211-4, Fax: (852) 2727866
DWG NO. : J858-1P207 REV. :

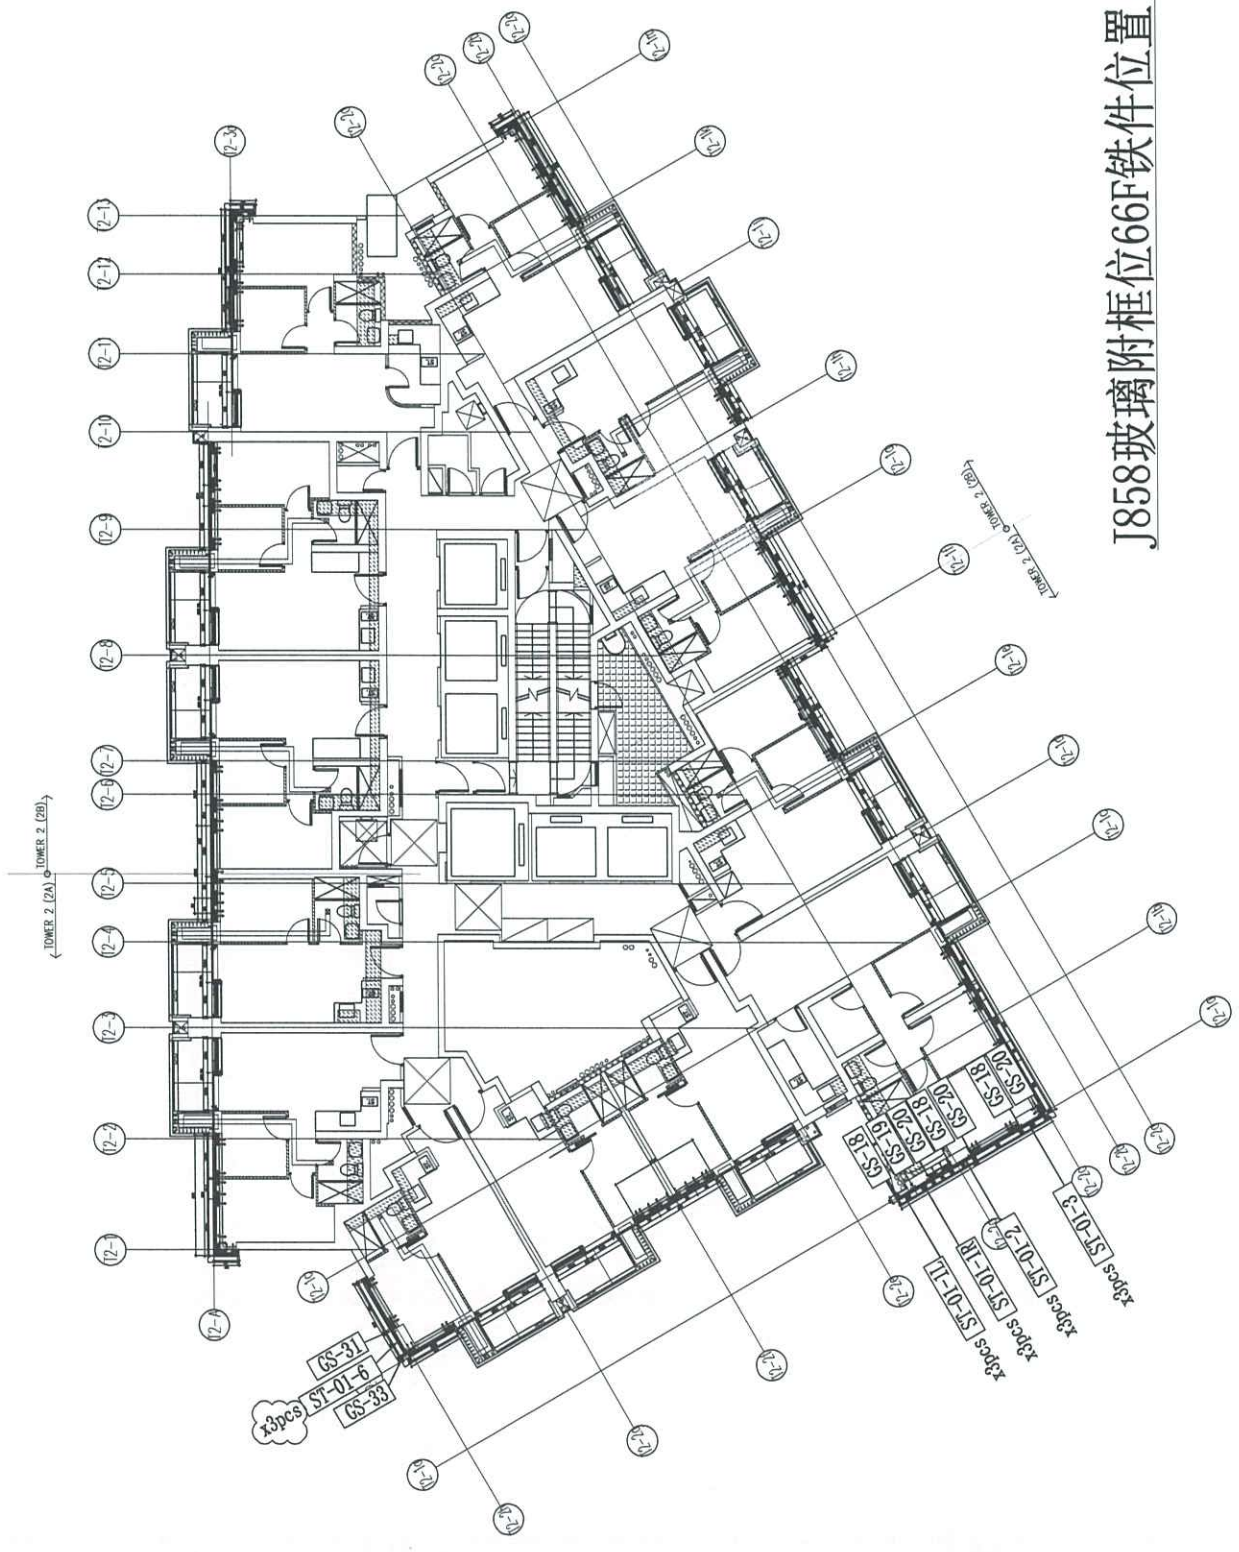

J858玻璃附框位66F铁件位置图(T2)

B.O. REF. :

CLIENT :

榮特銳有限公司
Sino Land Company Limited

ARCHITECT :

ronald lu
Ronald Lu & Partners (HK) Ltd.
呂宗利建築師事務所 (香港) 有限公司

MAIN CONTRACTOR :



STRUCTURAL ENGINEER :



NOTE :

1. ALL DIMENSIONS ARE IN MM.
2. ALL ELEVATIONS ARE VIEWED FROM OUTSIDE.
3. ALL DIMENSIONS TO BE VERIFIED ON SITE BEFORE FABRICATION.

LEGEND :

- DETAIL MARK NO.
 1. F.F.L. -- FINISHED FLOOR LEVEL
 2. S.F.L. -- STRUCTURAL FLOOR LEVEL
 3. (R) -- REVERSED DETAIL

JOB NO. :

J-659

PROJECT :

PROPOSED RESIDENTIAL DEVELOPMENT
AT TOWER 201P, PHASE 11, LUNAS PARK
TSEUNG KWAN O, N.T.

TITLE :

TYPICAL FLOOR PLAN
AT TOWER 1

DATE :

22-OCT-21

SCALE :

1:80(A1)

DRAWN BY :

KY

CHECKED BY :


YB



榮特銳有限公司
MEI TEI ENGINEERING CO., LTD.
MEI TEI ENGINEERING CO., LTD.
110, Cheung Kuo Road, Kowloon
Tel: 2348821-4, Fax: 8522727666


DWG NO. : J858-1P208

REV. :

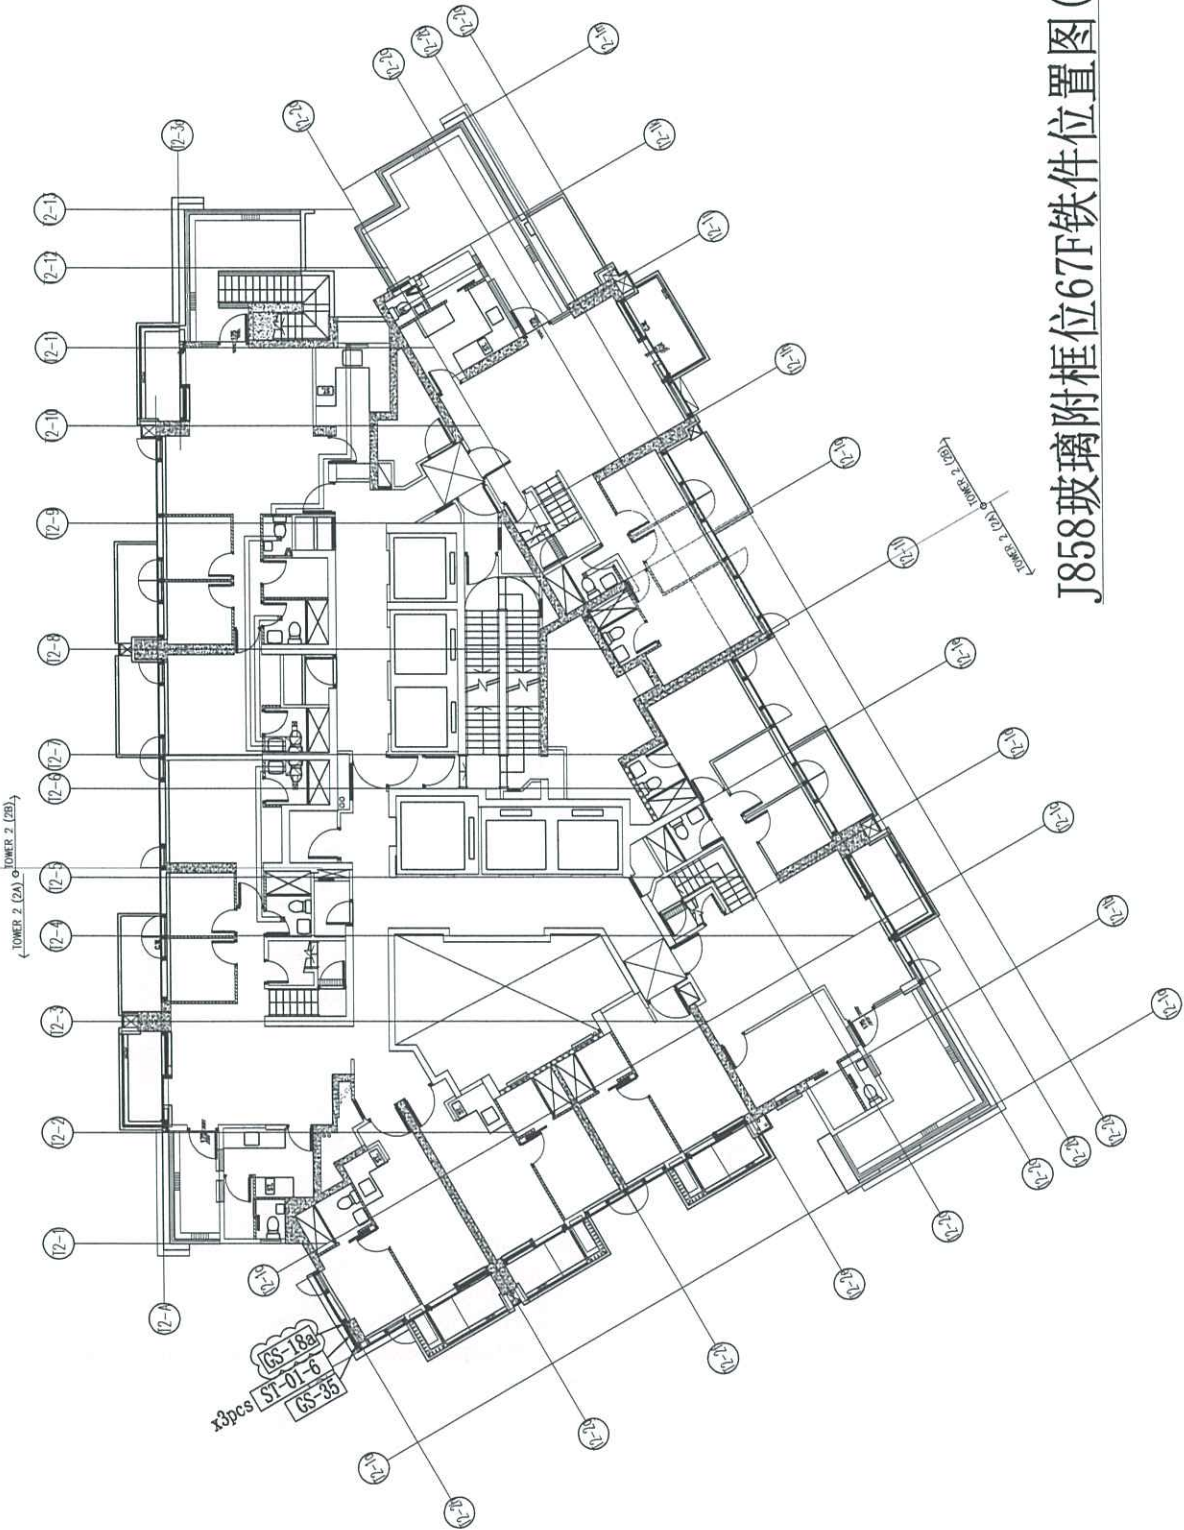

J858玻璃附框位67F铁件位置图(T2)

J858玻璃附框位66F铁件位置图 (T3)

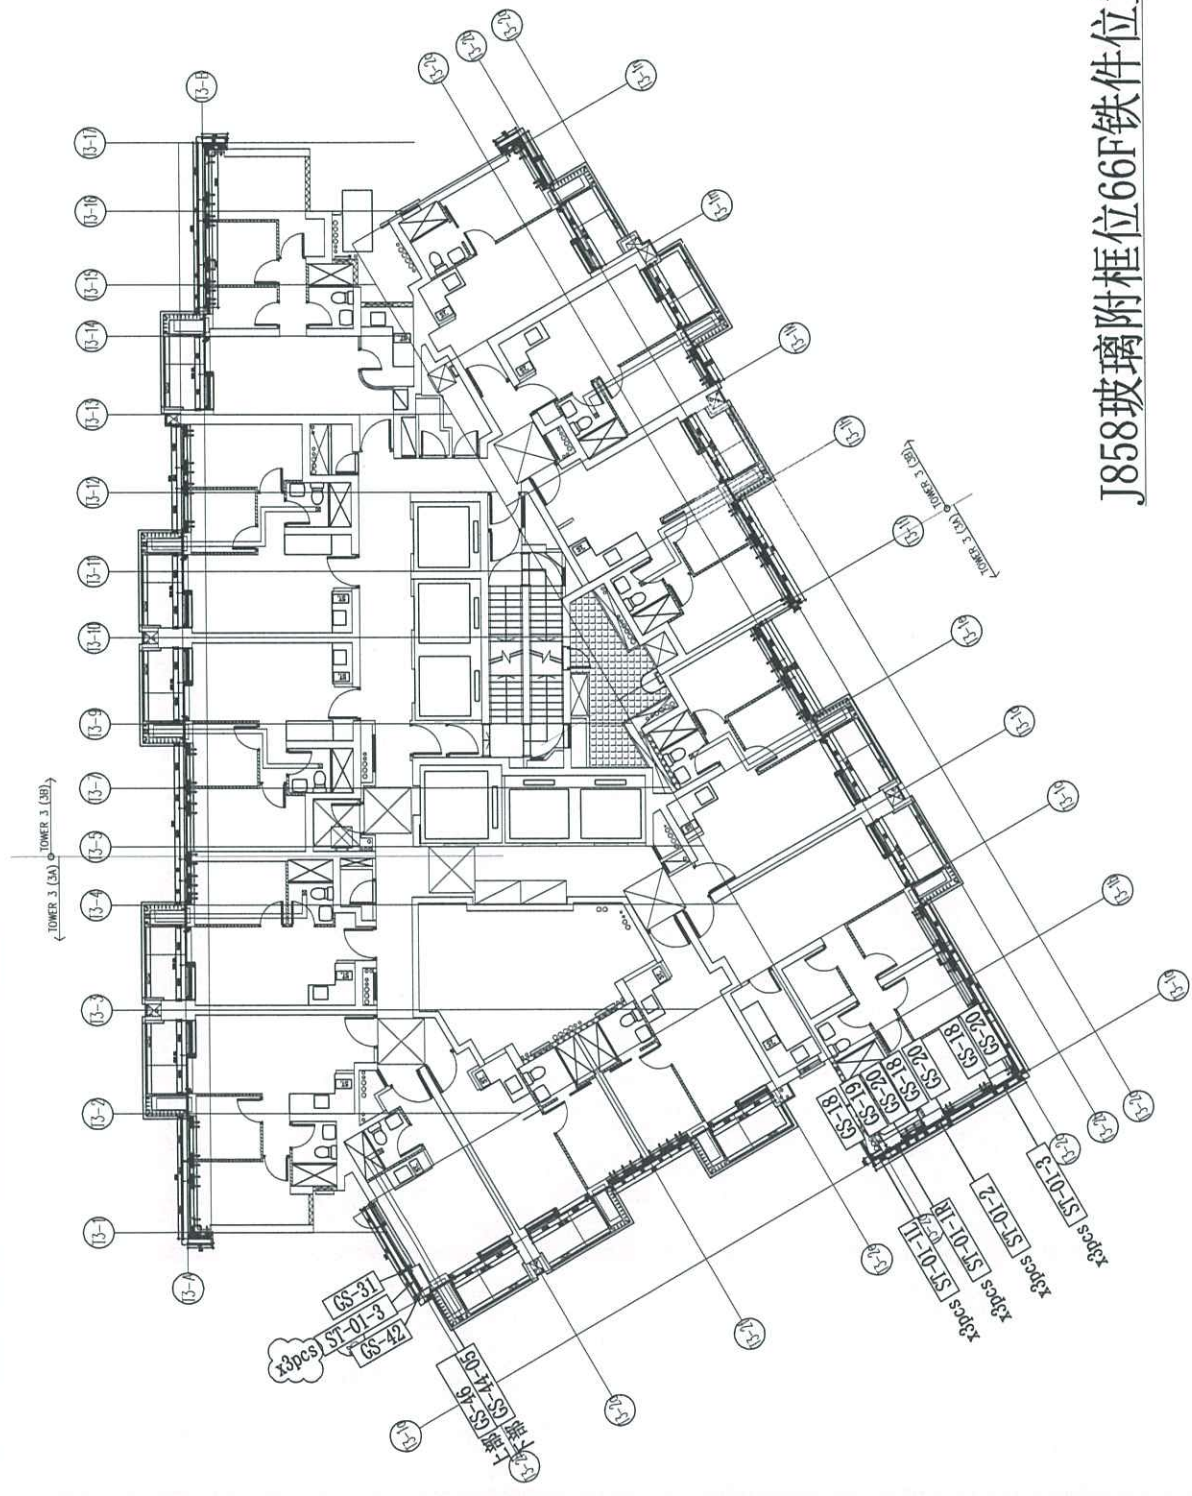

B.D. REF :	CLIENT : 德和置業有限公司 Sino Land Company Limited	ARCHITECT : ronald lu Ronald Lu & Partners (HK) Ltd. 呂克仕建築師事務所 (香港) 有限公司	MAIN CONTRACTOR : Gammon STRUCTURAL ENGINEER : AECOM FAÇADE CONSULTANT : AECOM	NOTE : 1. ALL DIMENSIONS ARE IN MM. 2. ALL ELEVATIONS ARE VIEWED FROM OUTSIDE. 3. ALL DIMENSIONS TO BE VERIFIED ON SITE BEFORE FABRICATION. LEGEND: 1. () DETAIL MARK NO. 2. () REFER SHEET NO. 1. F.F.L. --- FINISHED FLOOR LEVEL. 2. S.F.L. --- STRUCTURAL FLOOR LEVEL. 3. () --- REVERSED DETAIL.	JOB NO. : J-858 PROJECT : PROPOSED RESIDENTIAL DEVELOPMENT AT TOWER 70MP, PHASE 11, LUNGS PARK TSEUNG KWAN O, N.T. TITLE : TYPICAL FLOOR PLAN AT TOWER 1
DATE : 22-OCT-21		SCALE : 1:80(A1)	DRAWN BY : KY		CHECKED BY : YB
業特製質有限公司 MIDDI ARCHITECTURE MANAGER LTD. 10/F, 100, Queen's Road, Tseung Kwan O, N.T. Tel: 23489211-4, Fax: (852) 27278666		DWG NO. : J858-1P308 REV. :			

B.D. REF :

CLIENT :



華新地產有限公司
Sino Land Company Limited

ARCHITECT :



羅國強建築師事務所 (HK) Ltd.
羅國強建築師事務所 (香港) 有限公司

MAIN CONTRACTOR :



STRUCTURAL ENGINEER :



FAÇADE CONSULTANT :



NOTE :
1. ALL DIMENSIONS ARE IN mm.
2. ALL DIMENSIONS TO BE VERIFIED ON SITE.
3. BEFORE FABRICATION.

LEGEND :

- ① DETAIL MARK NO.
- ② REFER SHEET NO.
- 1. F.F.L. -- FINISHED FLOOR LEVEL.
- 2. S.F.L. -- STRUCTURAL FLOOR LEVEL.
- 3. Ⓜ -- REVERSED DETAIL.

JOB NO. : J-558

PROJECT : PROPOSED RESIDENTIAL DEVELOPMENT AT TOWER 1, URBAN PARK, TSEUNG KWAN O, N.T.

TITLE : TYPICAL FLOOR PLAN AT TOWER 1

DATE : 22-OCT-21

SCALE : 1/80(A1)

DOWN BY : KY

CHECKED BY : YB

DATE : 22-OCT-21

SCALE : 1/80(A1)


CHECKED BY : YB



美特鋸質有限公司
Mei Tin Tin & Partners
Mei Tin Tin & Partners (HK) Limited
Mei Tin Tin & Partners (香港) 有限公司
510 Che Kwo Ling Road, Kowloon
Tel: 2488711-4, Fax: (852) 7727666

DWG NO. : J858-UP308

REV. :

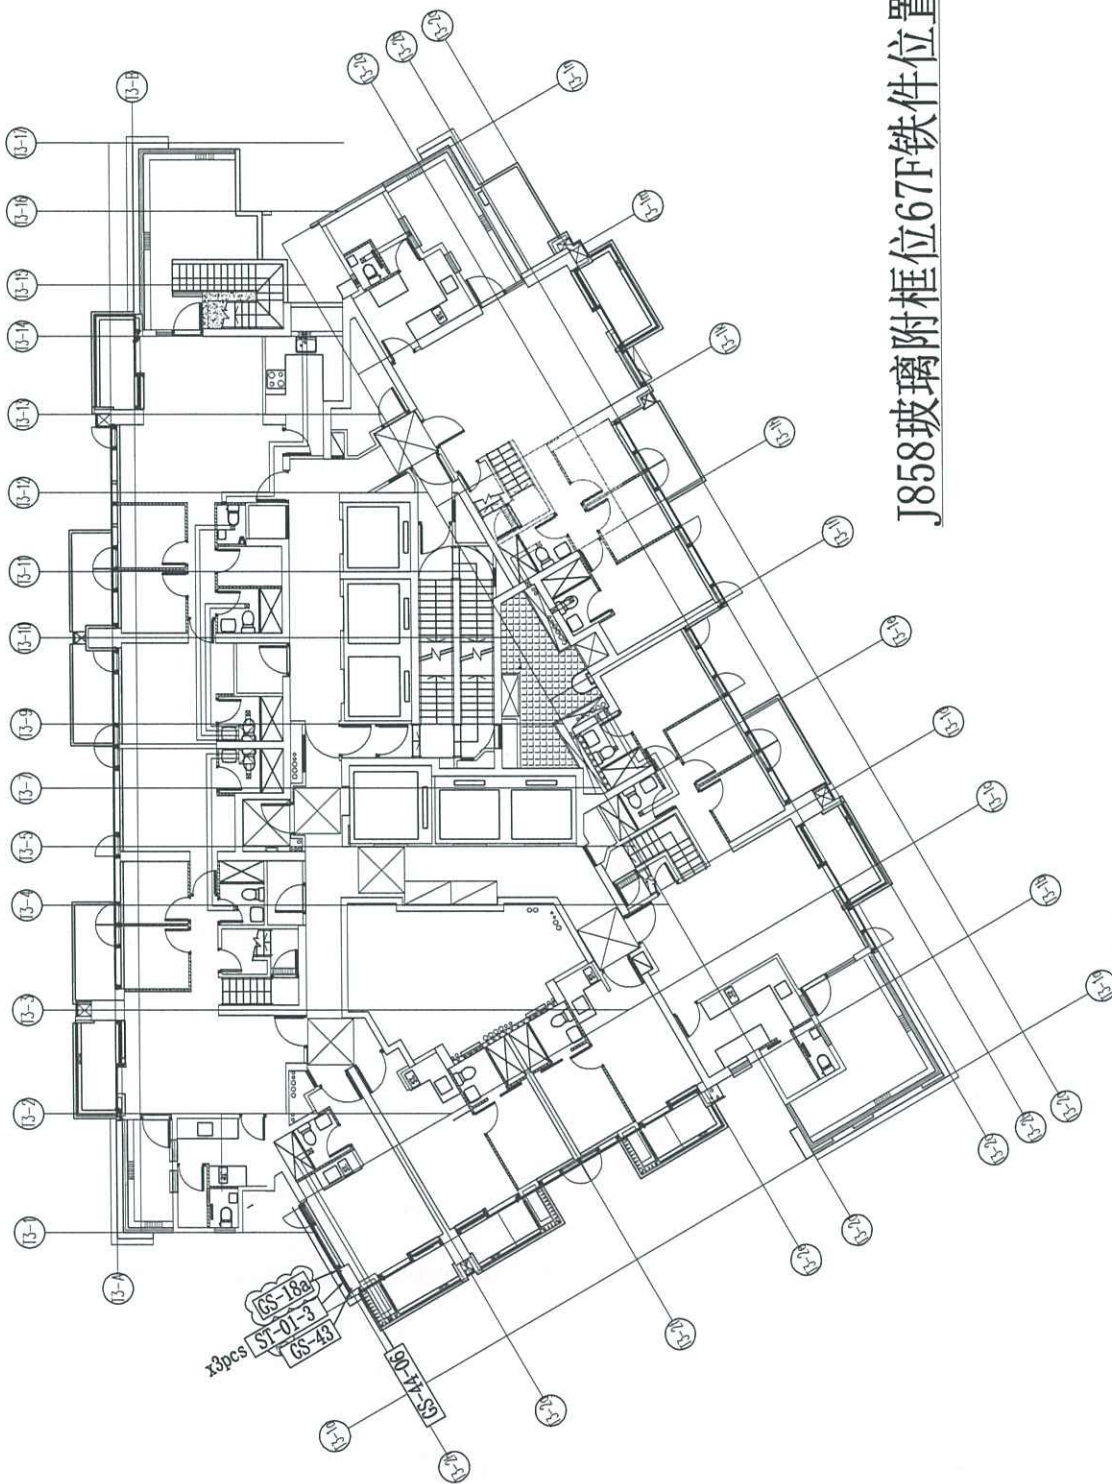

J858玻璃附框位67F铁件位置图(T3)

Handwritten signature or initials.