



工程指示 / 要求簡箋(E.I.)

工程指示編號：EI/5307/22

修改版次：-

工程編號：J - 858

工程名稱：將軍澳日出康城

工程項目：後裝窗 地盆用玻璃 BM (只放行生產 T1 9-19/F)

收件人：Maggie

發件人：Helen Chak

日期：09/11/2022

要求提供 / 確認 事項：

- |                                    |                                     |                               |
|------------------------------------|-------------------------------------|-------------------------------|
| <input type="checkbox"/> 初步鋁料 B.M. | <input type="checkbox"/> 加工拆圖，然後生產  | <input type="checkbox"/> 尺寸表  |
| <input type="checkbox"/> 正式鋁料 B.M. | <input type="checkbox"/> 技術上資料 / 指示 | <input type="checkbox"/> 報價   |
| <input type="checkbox"/> 配件 B.M.   | <input type="checkbox"/> 樣辦或貨品說明書   | <input type="checkbox"/> 分判合約 |

內容：

請按玻璃 BM 生產玻璃送地盆。 需熱浸 (跟 EI5299 出貨)

1. 只放行生產 T1 9-19/F (9,10,12,15,16,17,18,19/F 共 8 層樓,包樣板層) 後裝窗用玻璃，共 8 件

2. 因應拆棚期分隔太遠，餘下的大貨，年後才放行

3. 附上玻璃出貨表 EXCEL，請按出貨表排期生產、熱浸、和包箱

出貨到地盆 2022.12.20

預計熱浸約 2022.12.08

4. 不要印上熱浸標纖。只給"可移除"的標纖

5. 單片/Lam 片：標籤在室內面 (注明尺寸)，方便移除

6. 此單包括 6mm 單片 / 6+1.52+6 mm Lam 片

7. 按 EI-4999 的熱浸追蹤標籤

8. 批核信件：MC41231

地盆留意：玻璃不能反轉內外安裝，特別留意 Lam 片，內外顏色有大相差。(內是超白玻璃) 謝謝  
謝謝

請在 2022. 12.20 前完成上列要求。

附：

原合約工程包

原合約工程加 / 減賬

新工程報價

原因：-

分發東莞各部門：

- |  |   |  |  |
|--|---|--|--|
| <input type="checkbox"/> 生產技術總監 <input type="checkbox"/> 連附件 | <input type="checkbox"/> 技術部 <input type="checkbox"/> 連附件   | <input type="checkbox"/> 生產部 <input type="checkbox"/> 連附件  | <input type="checkbox"/> 機械設計部 <input type="checkbox"/> 連附件                              |
| <input type="checkbox"/> 採購部 <input type="checkbox"/> 連附件    | <input type="checkbox"/> 生產統籌部 <input type="checkbox"/> 連附件 | <input type="checkbox"/> 小羅&清 <input type="checkbox"/> 連附件 |  |
| <input type="checkbox"/> 質檢部 <input type="checkbox"/> 連附件    | <input type="checkbox"/> 會計部 <input type="checkbox"/> 連附件   | <input type="checkbox"/> 報關組 <input type="checkbox"/> 連附件  | <input checked="" type="checkbox"/> 其他 <u>水洪</u> <input checked="" type="checkbox"/> 連附件 |

分發其他分判：

連附件 檳

分發香港各部門：


- |   |  |   |   |
|---|--|---|---|
| <input type="checkbox"/> 行政部 <input type="checkbox"/> 連附件                       | <input type="checkbox"/> 會計部 <input type="checkbox"/> 連附件  | <input type="checkbox"/> 統籌部 <input type="checkbox"/> 連附件 | <input checked="" type="checkbox"/> 工程部地盤科文 <u>積哥</u> <input checked="" type="checkbox"/> 連附件 |
| <input checked="" type="checkbox"/> 採購部 <input checked="" type="checkbox"/> 連附件 | <input type="checkbox"/> QS 部 <input type="checkbox"/> 連附件 | <input type="checkbox"/> 維修部 <input type="checkbox"/> 連附件 | <input type="checkbox"/> 其他 _____ <input type="checkbox"/> 連附件                                |

傳遞編號：

HK / 22

發件人簽署：

項目經理簽署：

 <b>美特鋁質</b> 有限公司 MIDI Aluminium Fabricator Ltd.		<b>工程號:</b> J-858 <b>地盤名稱:</b> 康城11期 <b>項目類別:</b> 后裝窗 <b>修改版次:</b>	<b>計算:</b> WCM <b>核對:</b> <b>批准:</b> 總計玻璃面積 (平方米): 159.08	<b>日期:</b> 11/09/2022 <b>日期:</b> <b>日期:</b>	<b>送呈:</b> 施哥 <b>副本:</b> <b>A/C Code:</b> 生產用 此BM依據			
序號	修改內容	玻璃編號	顏色與類型	玻璃尺寸		數量 (塊)	總面積 (平方米)	備注
				寬度W (mm)	高度H (mm)			
1	TG09: 6mm THK HEAT STRENGTHENED CLEAR GLASS +1.52mm MILKY WHITE PVB +6mm THK LOW IRON HEAT STRENGTHENED CLEAR GLASS (R20220414034)	HG09-01		329	1127	49	18.17	暫停/待放行
2	TG09: 6mm THK HEAT STRENGTHENED CLEAR GLASS +1.52mm MILKY WHITE PVB +6mm THK LOW IRON HEAT STRENGTHENED CLEAR GLASS (R20220414034)	HG09-02		504	1127	50	28.40	暫停/待放行
3	TG09: 6mm THK HEAT STRENGTHENED CLEAR GLASS +1.52mm MILKY WHITE PVB +6mm THK LOW IRON HEAT STRENGTHENED CLEAR GLASS (R20220414034)	HG09-03		304	1127	1	0.34	暫停/待放行
5	TG11: 6mm THK TEMPERED GLASS <b>R202204101057</b>	HG11-01		604	1272	146	112.17	只生產8件
6	TG11: 6mm THK TEMPERED GLASS (R20220401057)	HG11-02		729	352	3	0.77	暫停/待放行
				合計:		249	159	
<b>加工注意事項:</b> 1). 本表中所有玻璃對角線尺寸偏差要求不超過正負2mm。 2). 本表中所有玻璃要求粗磨邊及精磨邊處理並倒棱角。 3). 本表中不同種類玻璃參照玻璃加工圖加工。 4). 本表中所有強化玻璃均需HEAT SOAK TEST。 5). 本表中所有強化玻璃之入爐方向均以寬度方向進入。 6). 本表中所有玻璃成品均需注明室內外面及其玻璃編號，以便識別。								

	第一區	第二區	第三區
貨期	20/12.2022	7/2023	11/2023
T1	9-19/F	20-39/F	41-61/F
	次序1	次序3	次序5

T2	9-22/f	23-45/f	46-67/f
T3	9-22/f	23-45/f	46-67/f
貨期	3/2023	10/2023	2/2024
	次序2	次序4	次序6

伊江留  
跟 E I 5299 次序

共 8 件  
 7/1 9-19/F

J858

		9/F	10/F	12/F	15/F	16/F	17/F	18/F	19/F	20/F	21/F	22/F	23/F	25/F	26/F	27/F	28/F	29/F	30/F	31/F
	佛沙窗																			
1	HG11-01	T1	T1A-A/K-1																	
2	HG11-01	T1	T1A-B/K-1	1	1	1	1	1	1	1	1	1	1	1	1	1	1	1	1	1
3	HG11-02	T1	T1B-B/K-1																	
1	HG09-01	T2	T2B-C/B-1	1	1	1	1	1	1	1	1	1	1	1	1	1	1	1	1	1
2	HG09-02	T2	T2B-A/B-1																	
3	HG11-01	T2	T2A-A/K-1																	
4	HG11-01	T2	T2A-B/K-1	1	1	1	1	1	1	1	1	1	1	1	1	1	1	1	1	1
5	HG11-02	T2	T2B-B/K-1																	
1	HG09-02	T3	T3B-C/B-1	1	1	1	1	1	1	1	1	1	1	1	1	1	1	1	1	1
2	HG09-03	T3	T3B-A/B-1																	
3	HG11-01	T3	T3A-A/K-1																	
4	HG11-01	T3	T3A-B/K-1	1	1	1	1	1	1	1	1	1	1	1	1	1	1	1	1	1
5	HG11-02	T3	T3B-B/K-1																	

(沒有11,13,14,24,34,40,44,54,64,F)

J858

			32/F	33/F	35/F	36/F	37/F	38/F	39/F	41/F	42/F	43/F	45/F	46/F	47/F	48/F	49/F	50/F	51/F	52/F	53/F
	佛沙窗																				
1	HG11-01	T1																			
2	HG11-01	T1	1	1	1	1	1	1	1	1	1	1	1	1	1	1	1	1	1	1	1
3	HG11-02	T1																			
			32/F	33/F	35/F	36/F	37/F	38/F	39/F	41/F	42/F	43/F	45/F	46/F	47/F	48/F	49/F	50/F	51/F	52/F	53/F
1	HG09-01	T2	1	1	1	1	1	1	1	1	1	1	1	1	1	1	1	1	1	1	1
2	HG09-02	T2																			
3	HG11-01	T2																			
4	HG11-01	T2	1	1	1	1	1	1	1	1	1	1	1	1	1	1	1	1	1	1	1
5	HG11-02	T2																			
			32/F	33/F	35/F	36/F	37/F	38/F	39/F	41/F	42/F	43/F	45/F	46/F	47/F	48/F	49/F	50/F	51/F	52/F	53/F
1	HG09-02	T3	1	1	1	1	1	1	1	1	1	1	1	1	1	1	1	1	1	1	1
2	HG09-03	T3																			
3	HG11-01	T3																			
4	HG11-01	T3	1	1	1	1	1	1	1	1	1	1	1	1	1	1	1	1	1	1	1
5	HG11-02	T3																			

(沒有11,13,14,24,34,40,44,54,64,/F)

J858


				55/F	56/F	57/F	58/F	59/F	60/F	61/F	62/F	63/F	65/F	66/F	67/F
	佛沙窗														
1	HG11-01	T1	T1A-A/K-1								1				
2	HG11-01	T1	T1A-B/K-1	1	1	1	1	1	1	1					
3	HG11-02	T1	T1B-B/K-1								1				
				55/F	56/F	57/F	58/F	59/F	60/F	61/F	62/F	63/F	65/F	66/F	67/F
1	HG09-01	T2	T2B-C/B-1	1	1	1	1	1	1	1	1	1	1	1	1
2	HG09-02	T2	T2B-A/B-1												1
3	HG11-01	T2	T2A-A/K-1												1
4	HG11-01	T2	T2A-B/K-1	1	1	1	1	1	1	1	1	1	1	1	1
5	HG11-02	T2	T2B-B/K-1												1
				55/F	56/F	57/F	58/F	59/F	60/F	61/F	62/F	63/F	65/F	66/F	67/F
1	HG09-02	T3	T3B-C/B-1	1	1	1	1	1	1	1	1	1	1	1	1
2	HG09-03	T3	T3B-A/B-1												1
3	HG11-01	T3	T3A-A/K-1												1
4	HG11-01	T3	T3A-B/K-1	1	1	1	1	1	1	1	1	1	1	1	1
5	HG11-02	T3	T3B-B/K-1												1



1  
45  
1

49  
1  
1  
49  
1

49  
1  
1  
49  
1  
249

(沒有11,13,14,24,34,40,44,54,64,F)


 <b>美特鋁質有限公司</b> MIDI Aluminium Fabricator Ltd.			工程號 J858 地盘 康城11期 图纸名称 佛砂窗玻璃加工图 材料 -	類別 制圖 W. E. X 復核 - 批准 -	物料號 - 2022-05-12 - -	圖號 J858-YG09 數量 - 單件重量 - (KG)
修改	-	-	採用工廠 <input checked="" type="checkbox"/> 地盘 -			
日期	-	-	材料颜色 -			

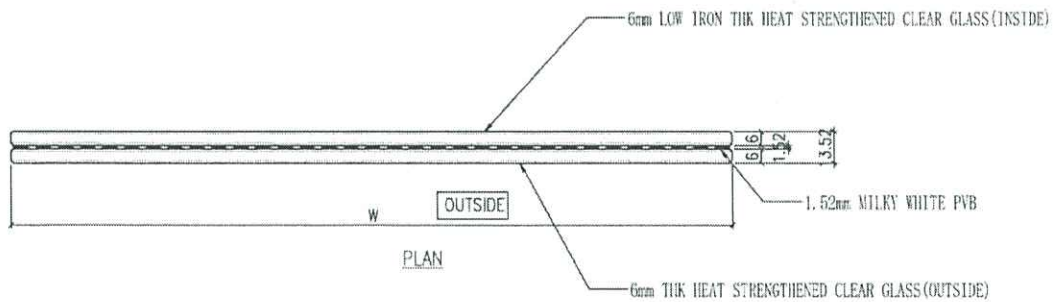
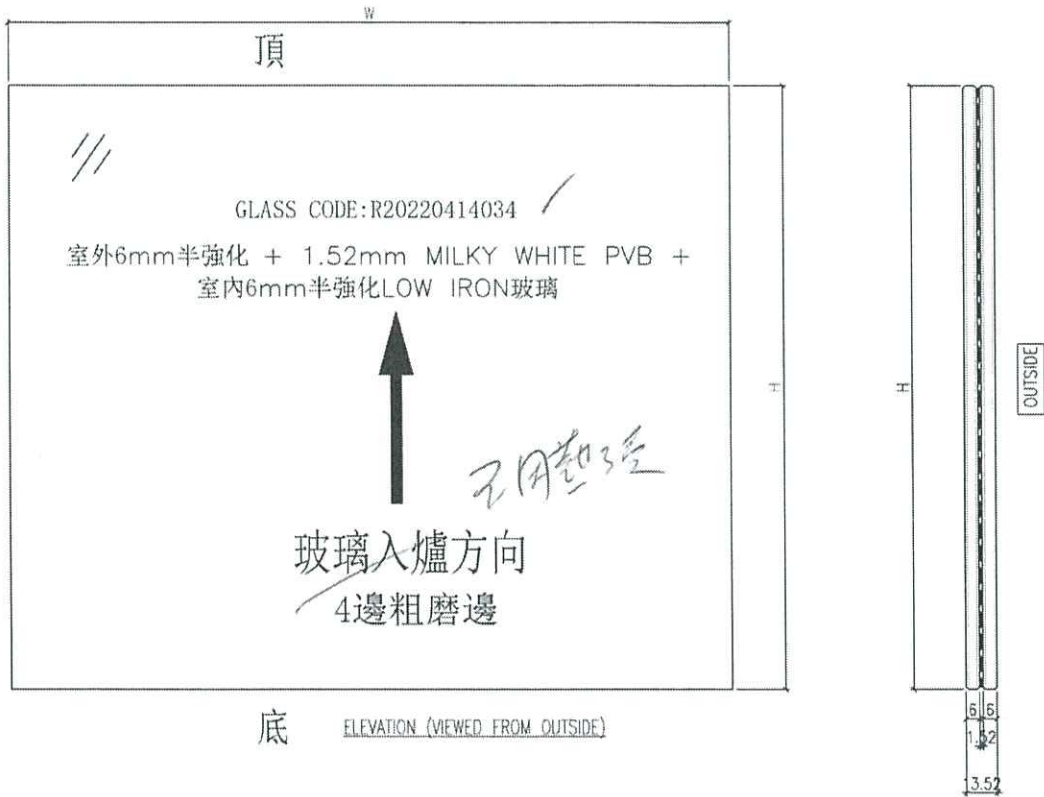


NOTES

- ALL DIMENSION IN mm
- ALL EDGE CHAMFER 1x1x45°

4	YG09-04	359	1129	98
3	YG09-03	454	766.5	200
2	YG09-02	454	1109.5	200
1	YG09-01	309	1129	185
序號	玻璃編號	W	H	數量

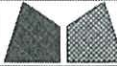 美特鋁質有限公司 MIDI Aluminium Fabricator Ltd.				工程號	J858	類別		物料號	-	
				地盘	康城11期	制圖	W. E. X	2022-05-12	圖號	J858-YG11
修改	-	-	採用工廠	✓	地盘	-	圖紙名稱	佛砂窗玻璃加工圖	復核	-
日期	-	-	材料顏色	-	材料	-	批准	-	單件重量	- (KG)

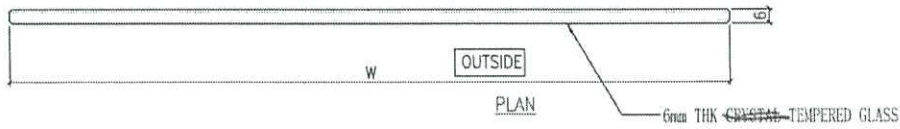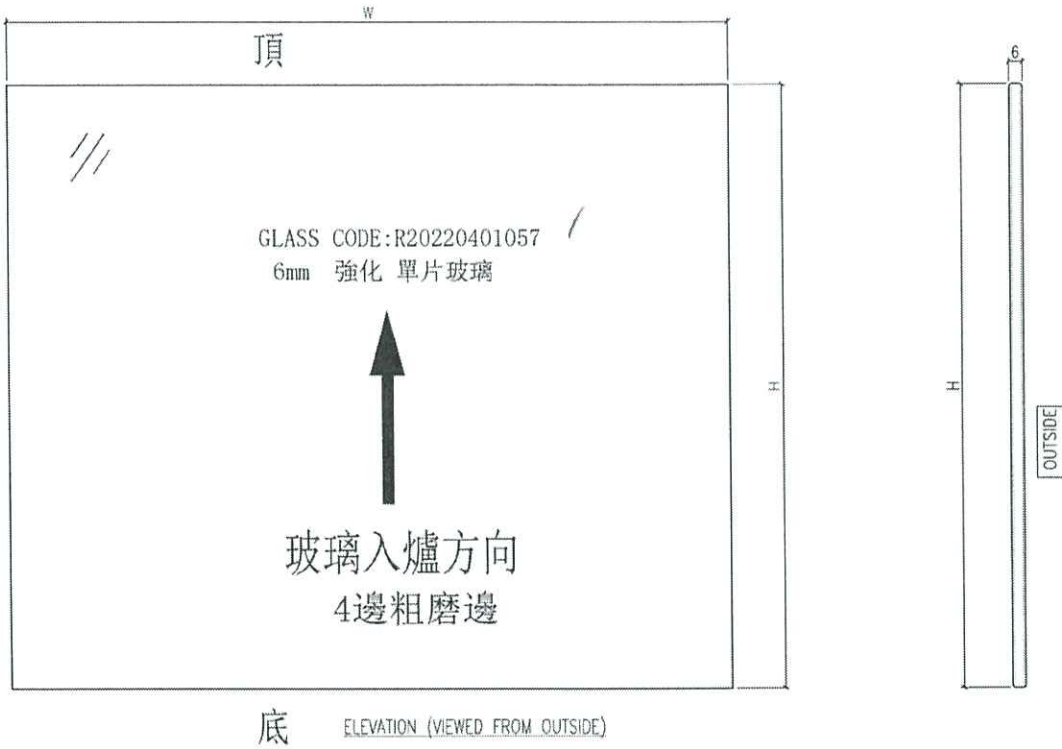


NOTES

1. ALL DIMENSION IN mm
2. ALL EDGE CHAMFER 1x1x45°

1	YG11-01	759	384	143
序號	玻璃編號	W	H	數量

 <b>美特鋁質</b> 有限公司 MIDI Aluminium Fabricator Ltd.		工程號:	J-858	計算:	WCM	日期:	01/06/2022	送呈:	施哥
地盤名稱:		康城11期		核對:		日期:		副本:	
項目類別:		后裝窗		批准:		日期:		A/C Code:	
BM編號:		修改版次:		總計玻璃面積 (平方米):	159.13	此BM依據			

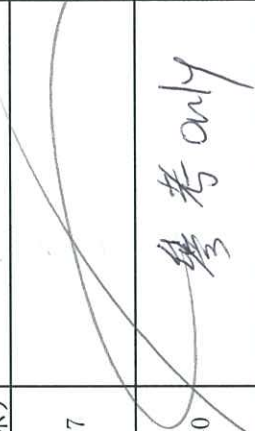序號	修改內容	玻璃編號	顏色與類型	玻璃尺寸		數量 (塊)	總面積 (平方米)	備注
				寬度W (mm)	高度H (mm)			
1		HG09-01	TG09: 6mm THK HEAT STRENGTHENED CLEAR GLASS +1.52mm MILKY WHITE PVB +6mm THK LOW IRON HEAT STRENGTHENED CLEAR GLASS	329	1127	49	18.17	
2		HG09-02	TG09: 6mm THK HEAT STRENGTHENED CLEAR GLASS +1.52mm MILKY WHITE PVB +6mm THK LOW IRON HEAT STRENGTHENED CLEAR GLASS	504	1127	50	28.40	
3		HG09-03	TG09: 6mm THK HEAT STRENGTHENED CLEAR GLASS +1.52mm MILKY WHITE PVB +6mm THK LOW IRON HEAT STRENGTHENED CLEAR GLASS	304	1127	1	0.34	
5		HC11-01	TG11: 6mm THK CRYSTAL TEMPERED GLASS	604	1272.5	146	112.21	
6		HC11-02	TG11: 6mm THK CRYSTAL TEMPERED GLASS	729	352	3	0.77	
					合計:	249	159	

- 1). 本表中所有玻璃對角線尺寸偏差要求不超過正負2mm。
- 2). 本表中所有玻璃要求粗磨邊及精磨邊處理並倒棱角。
- 3). 本表中不同種類玻璃參照玻璃加工圖加工。
- 4). 本表中所有強化玻璃均需HEAT SOAK TEST。
- 5). 本表中所有強化玻璃之入爐方向均以寬度方向進入。
- 6). 本表中所有玻璃成品均需注明室內外面及其玻璃編號，以便識別。敬

### 加工注意事項:



B.D. REF :

CLIENT : 信和置業有限公司  
Sino Land Company Limited

ARCHITECT : Ronald Liu & Partners  
Ronald Liu & Partners (HK) Ltd.  
呂文樂建築師事務所 (香港) 有限公司

MAIN CONTRACTOR : [Logo]

STRUCTURAL ENGINEER : AECOM

FAÇADE CONSULTANT : AECOM

NOTE:  
1. ALL DIMENSIONS ARE IN mm.  
2. ALL ELEVATIONS ARE VIEWED FROM OUTSIDE.  
3. ALL DIMENSIONS TO BE VERIFIED ON SITE BEFORE FABRICATION.



LEGEND:  
[Symbol] DETAIL MARK NO.  
[Symbol] REFER SHEET NO.  
1. F.F.L. — FINISHED FLOOR LEVEL  
2. S.F.L. — STRUCTURAL FLOOR LEVEL  
3. [Symbol] — REVERSED DETAIL

C 25-02-2024	REVISED AS PER ARCHITECT COMMENTS	LS
B 11-11-2024	REVISED AS PER ARCHITECT COMMENT	LS
A 27-10-2024	REVISED AS PER ARCHITECT COMMENTS	LS
NO.	DATE	REVISION
BY		

JOB NO. : J-858  
PROJECT : PROPOSED RESIDENTIAL DEVELOPMENT AT TKOIL 70RP, PHASE 11, LOMAS PARK TSCUNG KWAN O, N.T.

TITLE : IN-SITU ALUM. WINDOW SCHEDULE

DATE : 04-OCT-21  
SCALE : 1:30  
DRAWN BY :  
CHECKED BY :  
MIDI Architectural & Interiors Ltd.  
Unit E-8, Sunny Industrial Centre, 1/F  
142,448B711-1, Tel: (852) 2727266  
DWG NO. : J858-W-2102  
REV. : C

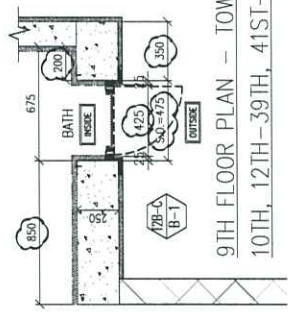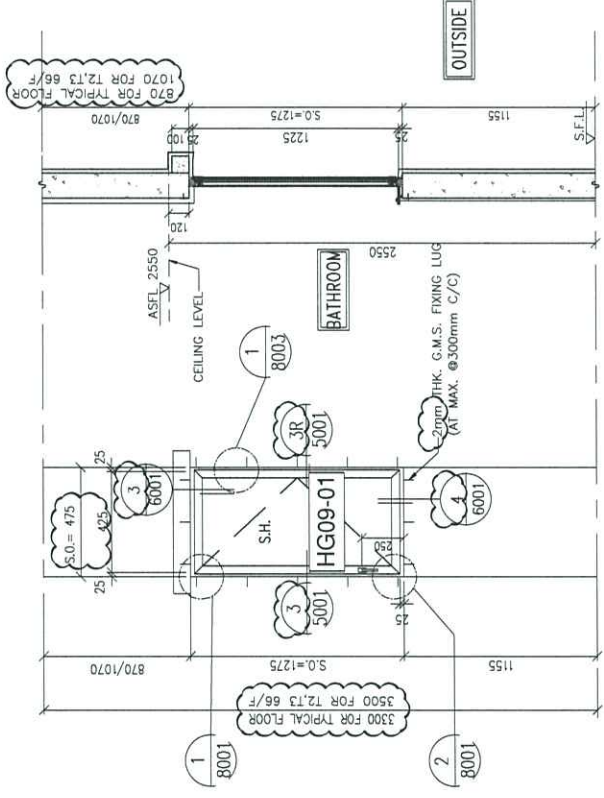

[Window Mark]	GLAZING AREA	Required = 0.305 Provided = 0.3421
	OPENABLE AREA	Required = 0.305 Provided = 0.4184

ELEVATION

WINDOW MARK : [Symbol]

SECTION : 50mm ALUM. SECTION WITH PW2 COATING (SILVER) (CHAMPAGNE) COLOUR

QTY. : 49 NOS. (TYPICAL)

LOCATION : TOWER 2 (2B) FLAT C BATHROOM (9/F, 10/F, 12/F-39/F, 41/F-66/F)

GLAZING : 6mm THK HEAT STRENGTHENED CLEAR GLASS + 1.52mm MILKY WHITE PVB + 6mm THK LOW IRON HEAT STRENGTHENED CLEAR GLASS

REMARK :







B.D. REF :

CLIENT :  
 信和置業有限公司  
 Sino Land Company Limited

ARCHITECT :  
 Transolid & Partners  
 信和置業有限公司  
 信和置業有限公司 (香港) 有限公司  
 信和置業有限公司 (香港) 有限公司  
 MAIN CONTRACTOR :



STRUCTURAL ENGINEER :  
**AECOM**

FAÇADE CONSULTANT:  
**AECOM**

NOTE:  
 1. ALL DIMENSIONS ARE IN mm.  
 2. ALL ELEVATIONS ARE VIEWED FROM OUTSIDE.  
 3. ALL DIMENSIONS TO BE VERIFIED ON SITE BEFORE FABRICATION.

LEGEND:

- 1. F.F.L. --- FINISHED FLOOR LEVEL
- 2. S.F.L. --- STRUCTURAL FLOOR LEVEL
- 3. --- REINFORCED DETAIL



NO.	DATE	REVISION	BY
A	25-07-2022	REVISION AS FOR ARCHITECT COMMENTS	LS

JOB NO. : J-658  
 PROJECT : PROPOSED RESIDENTIAL DEVELOPMENT AT TKOIL 70RP, PHASE 1T, LOKAS PARK TSEUNG KWAN O, N.T.

TITLE : IN-SITU ALUM. WINDOW SCHEDULE


DATE : 04-OCT-21 SCALE : 1:30  
 DRAWN BY : CHECKED BY :

美特鋁質有限公司  
 MIDT Aluminium Fabrication Ltd.  
 Units E-8, Sunny Industrial Centre, 1/F  
 810 Chee Yee Ling Road, Kowloon  
 TEL: 2685111-4 Fax: (852) 2777666  
 DWG NO. : J658-IW-2102a REV. : A

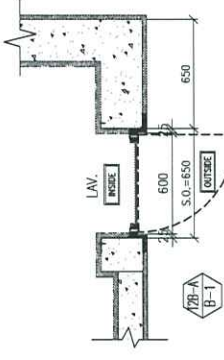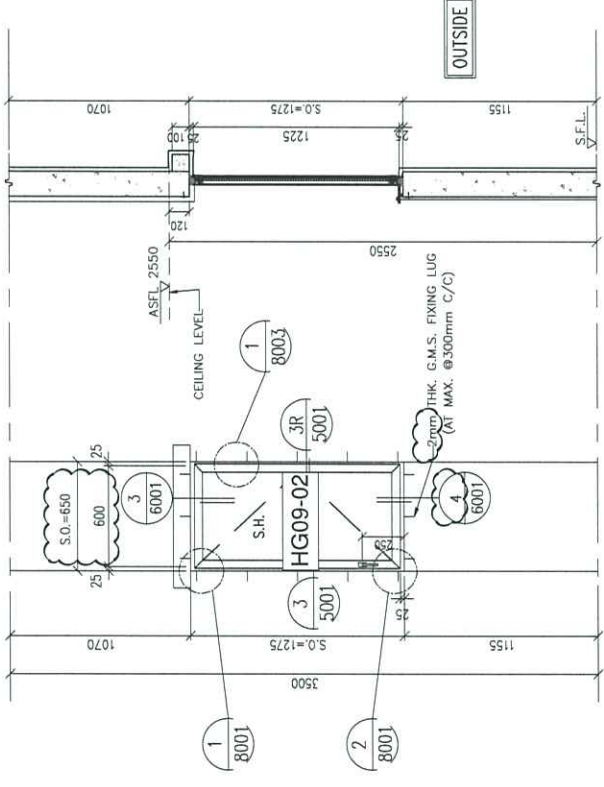

GLAZING AREA	Required = 0.205
	Provided = 0.5358
OPENABLE AREA	Required = 0.205
	Provided = 0.6212

ELEVATION

WINDOW MARK	
SECTION :	50mm ALUM. SECTION WITH PVF2 COATING(SILVER/CHAMPAGNE COLOUR)
QTY.	1 NOS.
LOCATION :	TOWER 2(2B) FLAT A LAV.(67/F)
GLAZING	6mm THK HEAT STRENGTHENED CLEAR GLASS + 1.52mm MILKY WHITE PVB + 6mm THK LOW IRON HEAT STRENGTHENED CLEAR GLASS
REMARK :	



19084NT

Form RLP/TSF

Project Proposed Residential Development at TKOTL 70RP, Phase 11, Lohas Park, Tseung Kwan O, New Territories  
Works Main Contract  
Contract No. J3931  
Ref. No. P19084NT/MS/MD/440 (Rev.1)  
GECCL Ref. J3931/304/D03870  
Date 25 Apr 2022  
To / Attn RLP / Mr. Kenneth Wong / Ms. Florence Cheung  
Subject **Material Submission – Midi – Glass Sample Precast & Insitu Alum. Window**

27 APR 2022  
Received by RLP  
RECEIVED

We write to request this submission replied by:  RLP /  AECOM /  WSP /  Others  
Anticipated date of response 09 May 2022

We certify that the submission has been checked and is in full compliance with the Specification & Contract Documents, unless otherwise stated in the remarks.

REC 4/23/21

Matthew Wong  
For and on behalf of  
Gammon Engineering & Construction Company Limited

- MTRC (Site)  Mr. K.S. Lee / Mr. Teddy Wui / Mr. HF Au / Mr. Si. Kwai / Mr. Jacky Cheung
- MTRC (STR)  Mr. Tony Fung
- MTRC (E&M)  Mr. Ricky Tang
- MTRC (Cost & Prog)  Mr. Anthony Tam
- SKY CASTLE  Mr. Simon Tsang / Mr. Francis Lee / Mr. Simon Tsang / Mr. Andy Chan
- AECOM  Mr. Henry Lee / Mr. Cole Li
- AECOM (Facade)  Mr. Monica Lee / Mr. Phoenix Chung / Mr. Ryan Ng
- WSP  Mr. Simon Tsang / Mr. Tommy Leung
- ADI (LANDSCAPE)  Mr. Victor So / Mr. Kenf Ho
- MDL  Mr. Mandy Law
- Bera  Mr. Keith Yim / Mr. Randolph Chan
- RE (AECOM)  Mr. Simon Tsang / Mr. Ken So
- COW  Mr. Marcus Koo
- BSI  BSI
- WSP (Safety & Risk)  Mr. Chris Tong / Mr. Louis Siu
- Ramboll  Mr. David Yeung
- Tin Lee  Mr. Eddie Kwan
- AEC  Mr. Andy Liu

Material / Work Description *	Glass Sample for Precast & Insitu Alum. Window
Location	Precast & Insitu Alum. Window
Brand Name	Guangdong Haikong Special Glass Technology Co. Ltd.
Model / Reference No. *	Glass Sample 1: 6mm Tempered Glass Glass code: R20220401057 Use of Location: Precast & Insitu Alum. Window (for Kitchen)
	Glass Sample 2: 6mm Heat Strengthened Clear Glass (Outside) + 1.52mm milky white PVB + 6mm Low-iron Heat Strengthened Clear Glass (Inside) Glass code: R20220414034 Use of Location: Precast & Insitu Alum. Window (for Bathroom)
Country of Origin	China
Supplier Name	Guangdong Haikong Special Glass Technology Co. Ltd.
Others (Color / Pattern, etc.) *	N/A
Material / Work Reference *	N/A
Specification Reference	N/A
Related Dwg. / A.I. Ref. *	N/A
Related BQ Reference	N/A
Submission Attachment	1 set of glass sample
Sample	<input checked="" type="checkbox"/> N/A
Catalogue / Technical Data *	<input type="checkbox"/> Attached
Test Report / Certificate *	<input type="checkbox"/> N/A
Equipment Schedule	<input type="checkbox"/> N/A
Method Statement	<input type="checkbox"/> N/A
Installation Details	<input type="checkbox"/> N/A
Job Reference	<input type="checkbox"/> N/A
Remarks (To list deviations, if any)	* Delete as appropriate

Review Status / Comment

RESPONSE TO TECHNICAL SUBMISSION REVIEW STATUS: B.  
Date 30/5-2022  
Comments 1/ NO ADVERSE COMMENT ON YOUR MATERIAL SUBMISSION  
2/ REFER TO COMMENTS FROM SIND, FACADE CONSULTANT AND OTHER RELEVANT PARTIES.

Replied by SE / Date

Replied by BS / Date

Replied by RLP / Date 30/5-2022




For and on behalf of  
Ronald Lu & Partners (Hong Kong) Ltd.

SKH/ NYFI TTC  
Man

No review is made of detail dimensions/quantities.  
The submission is reviewed for general compliance with the design intent only.  
Any comments or amendments required shall not be deemed to be variation.  
The review does not release the Contractor from his responsibilities to comply with contract requirements.  
For resubmission, the Contractor has to highlight or cloud those revision areas in the shop drawing for review.  
Legend: A (No objection) B (No objection, subject to comments as noted) C (Amendment & resubmission required) D (Rejected & resubmission required)

- MTRC (Site)  Mr. K.S. Lee / Mr. Teddy Wui / Mr. HF Au / Mr. Si. Kwai / Mr. Jacky Cheung
- MTRC (STR)  Mr. Tony Fung
- MTRC (E&M)  Mr. Ricky Tang
- MTRC (Cost & Prog)  Mr. Anthony Tam
- SKY CASTLE  Mr. Simon Tsang / Mr. Francis Lee / Mr. Simon Tsang / Mr. Andy Chan
- AECOM  Mr. Henry Lee / Mr. Cole Li
- AECOM (Facade)  Mr. Monica Lee / Mr. Phoenix Chung / Mr. Ryan Ng
- WSP  Mr. Simon Tsang / Mr. Tommy Leung
- ADI (LANDSCAPE)  Mr. Victor So / Mr. Kenf Ho
- MDL  Mr. Mandy Law
- Bera  Mr. Keith Yim / Mr. Randolph Chan
- RE (AECOM)  Mr. Simon Tsang / Mr. Ken So
- COW  Mr. Marcus Koo
- BSI  BSI
- WSP (Safety & Risk)  Mr. Chris Tong / Mr. Louis Siu
- Ramboll  Mr. David Yeung
- Tin Lee  Mr. Eddie Kwan
- AEC  Mr. Andy Liu

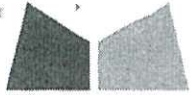

美特鋁質有限公司  
MIDI ALUMINIUM FABRICATOR LTD.

Our ref. MC/41231/858

22<sup>nd</sup> April, 2022

Gammon Construction Company Limited  
22/F Tower 1, The Quayside,  
77 Hoi Bun Road,  
Kwun Tong, Kowloon.

By Email & Hand

Attn.: Mr. Matthew Wong

Dear Sir,

**Re: Design, Supply and Installation of Curtain Wall, Glass Wall, Aluminium Window, Aluminium Cladding, Aluminium Louvres and Glass Balustrade Nominated Sub-Contract at T.K.O.T.L. 70 RP, Phase 11, LOHAS Park, Tseung Kwan O, N.T.**  
**Submission of Glass Sample for Precast & Insitu Alum. Window (MS029)**

Regarding the captioned project, we would like to submit glass sample for Precast & Insitu Alum. Window for your review and comment.

Brand : Guangdong Haikong Special Glass Technology Co. Ltd.

Glass Sample 1 : 6mm Tempered Glass

Glass code : R20220401057

Use of Location: Precast & Insitu Alum. Window (for Kitchen)

Glass Sample 2 : 6mm Heat Strengthened Clear Glass (Outside) + 1.52mm milky white PVB  
+ 6mm Low-iron Heat Strengthened Clear Glass (Inside)

Glass code : R20220414034

Use of Location: Precast & Insitu Alum. Window (for Bathroom)


Remarks:

- 1.) 1 set of glass sample will be delivered to Gammon site office.
- 2.) Glass data was attached.

If you have any query, please feel free to contact us.

Thank you for your kind attention.

Yours faithfully,  
MIDI ALUMINIUM FABRICATOR LTD.

  
Francis Mau  
Managing Director

Encl - 5 page(s)

cc. Gammon	- Mr. Jun Tsui / Mr. Brian Ng	(w/e)
Sino	- Mr. Terry Wan / Mr. Andy Chan	(w/e) (Email Only)
RLP	- Ms. Marina Tong / Ms. Ginny Chau	(w/e) (Email Only)
Aecom	- Mr. Ryan Ko / Mr. Cole Li	(w/e) (Email Only)
	- Ms. Daisy Lau / Ms. Crystal Wong	

EM/MT/DW/JL/AY/EL/KL/yl  
九龍葵涌道610號生利工業中心1樓6-8號  
Units 6-8, 1<sup>st</sup> Floor, Sunray Industrial Centre, 610 Cha Kwo Ling Road, Kln.  
TEL. (電話): 2348 9211 FAX. (傳真): 2772 7666 E-mail Address (電郵): midi@midiltd.com.hk.



ISO 9001 : 2015  
Certificate No: CC 1795



**MIDI ALUMINIUM FABRICATOR LTD.**

Units 6, 7, 8 Sunray Industrial Centre, 1st Floor, 610 Cha Kwo Ling Road Kowloon.

Project : T.K.O.T.L. 70 RP, Phase 11, LOHAS Park, Tseung Kwan O, N.T.

Subject : 6mm Tempered Glass (Sample 1) (MS029)


Brand : Guangdong Haikong Special Glass Technology Co. Ltd.

Glass Code : R20220401057

Location : Precast & Insitu Alum. Window (for Kitchen)

Letter ref. : MC/41231/858

Date : 22<sup>nd</sup> April 2022

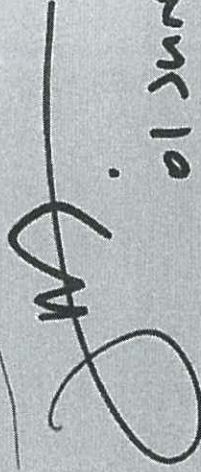  
01 JUN 22.



## MIDI ALUMINIUM FABRICATOR LTD.

Units 6, 7, 8 Sunray Industrial Centre, 1st Floor, 610 Cha Kwo Ling Road Kowloon.

Project : T.K.O.T.L. 70 RP, Phase 11, LOHAS Park, Tseung Kwan O, N.T.  
Subject : 6mm Heat Strengthened Clear Glass (Outside) + 1.52mm milky white PVB  
+ 6mm Low-iron Heat Strengthened Clear Glass (Inside) (Sample 2) (MS029)  
Brand : Guangdong Haikong Special Glass Technology Co. Ltd.  
Glass Code : R20220414034  
Location : Precast & Insitu Alum. Window (for Bathroom)  
Letter ref. : MC/41231/858  
Date : 22<sup>nd</sup> April 2022

01 JUN 22