

工程指示 / 要求簡箋(E.I.)

工程指示編號：EI / 5466 / 22

修改版次：C

工程編號：J - 858

工程名稱：將軍澳日出康城 11

工程項目：幕牆 單元件修改方案

收件人：生統 / 王良

發件人：Helen Chak

日期：16/12/2022

□要求提供 / □確認 事項：

- | | | |
|------------------------------------|-------------------------------------|-------------------------------|
| <input type="checkbox"/> 初步鋁料 B.M. | <input type="checkbox"/> 加工拆圖，然後生產 | <input type="checkbox"/> 尺寸表 |
| <input type="checkbox"/> 正式鋁料 B.M. | <input type="checkbox"/> 技術上資料 / 指示 | <input type="checkbox"/> 報價 |
| <input type="checkbox"/> 配件 B.M. | <input type="checkbox"/> 樣辦或貨品說明書 | <input type="checkbox"/> 分判合約 |

內容：

C 版:1.經胡哥及王良建議，需修改排氣孔做法，詳情請見後頁;2.未生產的單元，請按後頁修改唧膠背板方法。B 版: 現確認氣孔做法，詳情請查閱後頁。**A 版:**1.因單元幕牆雙裝飾條那款，主企(X86273-12 等)與玻璃骨(X86305-02 等)的安裝孔尺寸有偏差，導致需要安裝人員自行配孔才能完成安裝，請廠的拆圖部幫忙檢查此類加工圖並修正過來，以便後續的生產能順暢，詳情請見後頁2.夾巴位置由 18.5 改為 20.5;3.轉角窗玉不能開關，需重新拆圖;請在單元件做出以下修改，方便單元件排水:1.扣蓋避位取消(橫向)2.加開避位(企向)3.加開氣孔詳情請見後頁，謝謝!請在 2022.12.15 前完成上列要求。

附： 頁

 原合約工程包 原合約工程加 / 減賬 新工程報價

分發東莞各部門：

- | | | | | | | | |
|-----------------------------------------|-----------------------------------------|-------------------------------------------|-----------------------------------------|------------------------------------------|-----------------------------------------|-------------------------------------------|-----------------------------------------|
| <input type="checkbox"/> 生產技術總監 | <input type="checkbox"/> 連附件 | <input checked="" type="checkbox"/> 技術部 | <input checked="" type="checkbox"/> 連附件 | <input type="checkbox"/> 生產部 | <input type="checkbox"/> 連附件 | <input type="checkbox"/> 機械設計部 | <input type="checkbox"/> 連附件 |
| <input type="checkbox"/> 採購部 | <input type="checkbox"/> 連附件 | <input checked="" type="checkbox"/> 生產統籌部 | <input checked="" type="checkbox"/> 連附件 | <input checked="" type="checkbox"/> 小羅&清 | <input checked="" type="checkbox"/> 連附件 | | |
| <input checked="" type="checkbox"/> 質檢部 | <input checked="" type="checkbox"/> 連附件 | <input type="checkbox"/> 會計部 | <input type="checkbox"/> 連附件 | <input type="checkbox"/> 報關組 | <input type="checkbox"/> 連附件 | <input checked="" type="checkbox"/> 其他 水洪 | <input checked="" type="checkbox"/> 連附件 |
| <input type="checkbox"/> Bun | <input type="checkbox"/> 連附件 | | | | | | |

分發香港各部門：

- | | | | | | | | |
|------------------------------|------------------------------|-------------------------------|------------------------------|------------------------------|------------------------------|------------------------------------------------|-----------------------------------------|
| <input type="checkbox"/> 行政部 | <input type="checkbox"/> 連附件 | <input type="checkbox"/> 會計部 | <input type="checkbox"/> 連附件 | <input type="checkbox"/> 統籌部 | <input type="checkbox"/> 連附件 | <input checked="" type="checkbox"/> 工程部地盤科文 積哥 | <input checked="" type="checkbox"/> 連附件 |
| <input type="checkbox"/> 採購部 | <input type="checkbox"/> 連附件 | <input type="checkbox"/> QS 部 | <input type="checkbox"/> 連附件 | <input type="checkbox"/> 維修部 | <input type="checkbox"/> 連附件 | <input type="checkbox"/> 其他 _____ | <input type="checkbox"/> 連附件 |


傳遞編號：

發件人簽署：

HK 2300 / 22

項目經理簽署：


生母企 梗墙位去水孔+氣孔

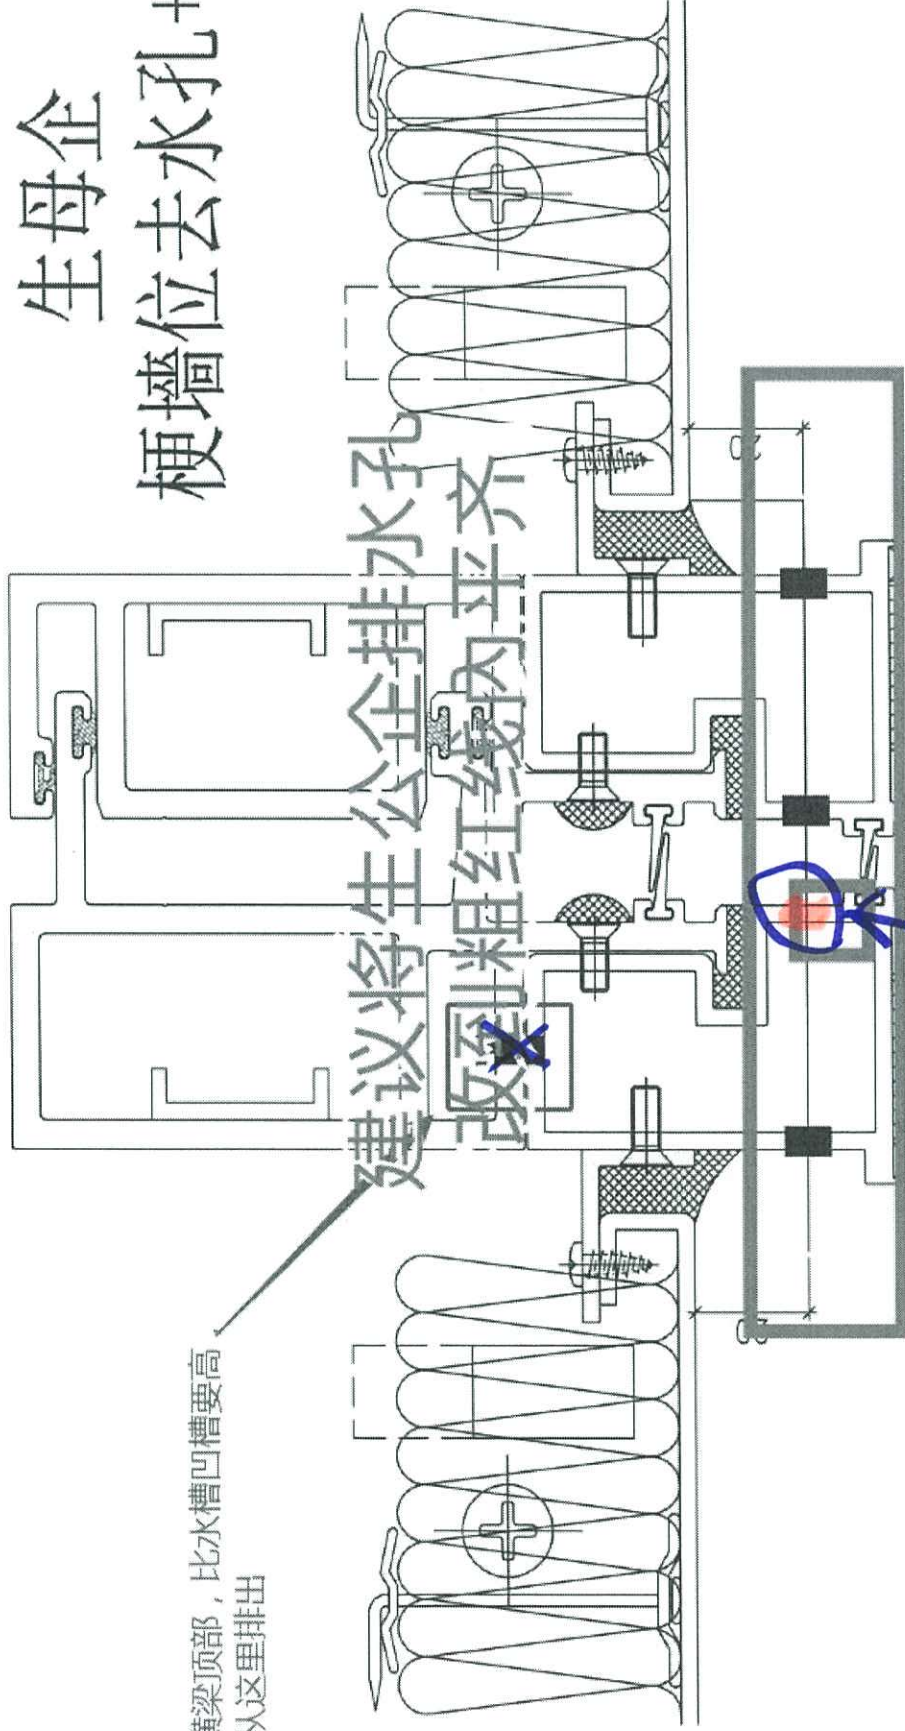

A孔在橫梁頂部，比水槽凹槽要高
水無法從這裡排出

建議將生公企排水孔
改到粗紅線內平齊


經胡哥及琅建議，請按此修改排水孔。

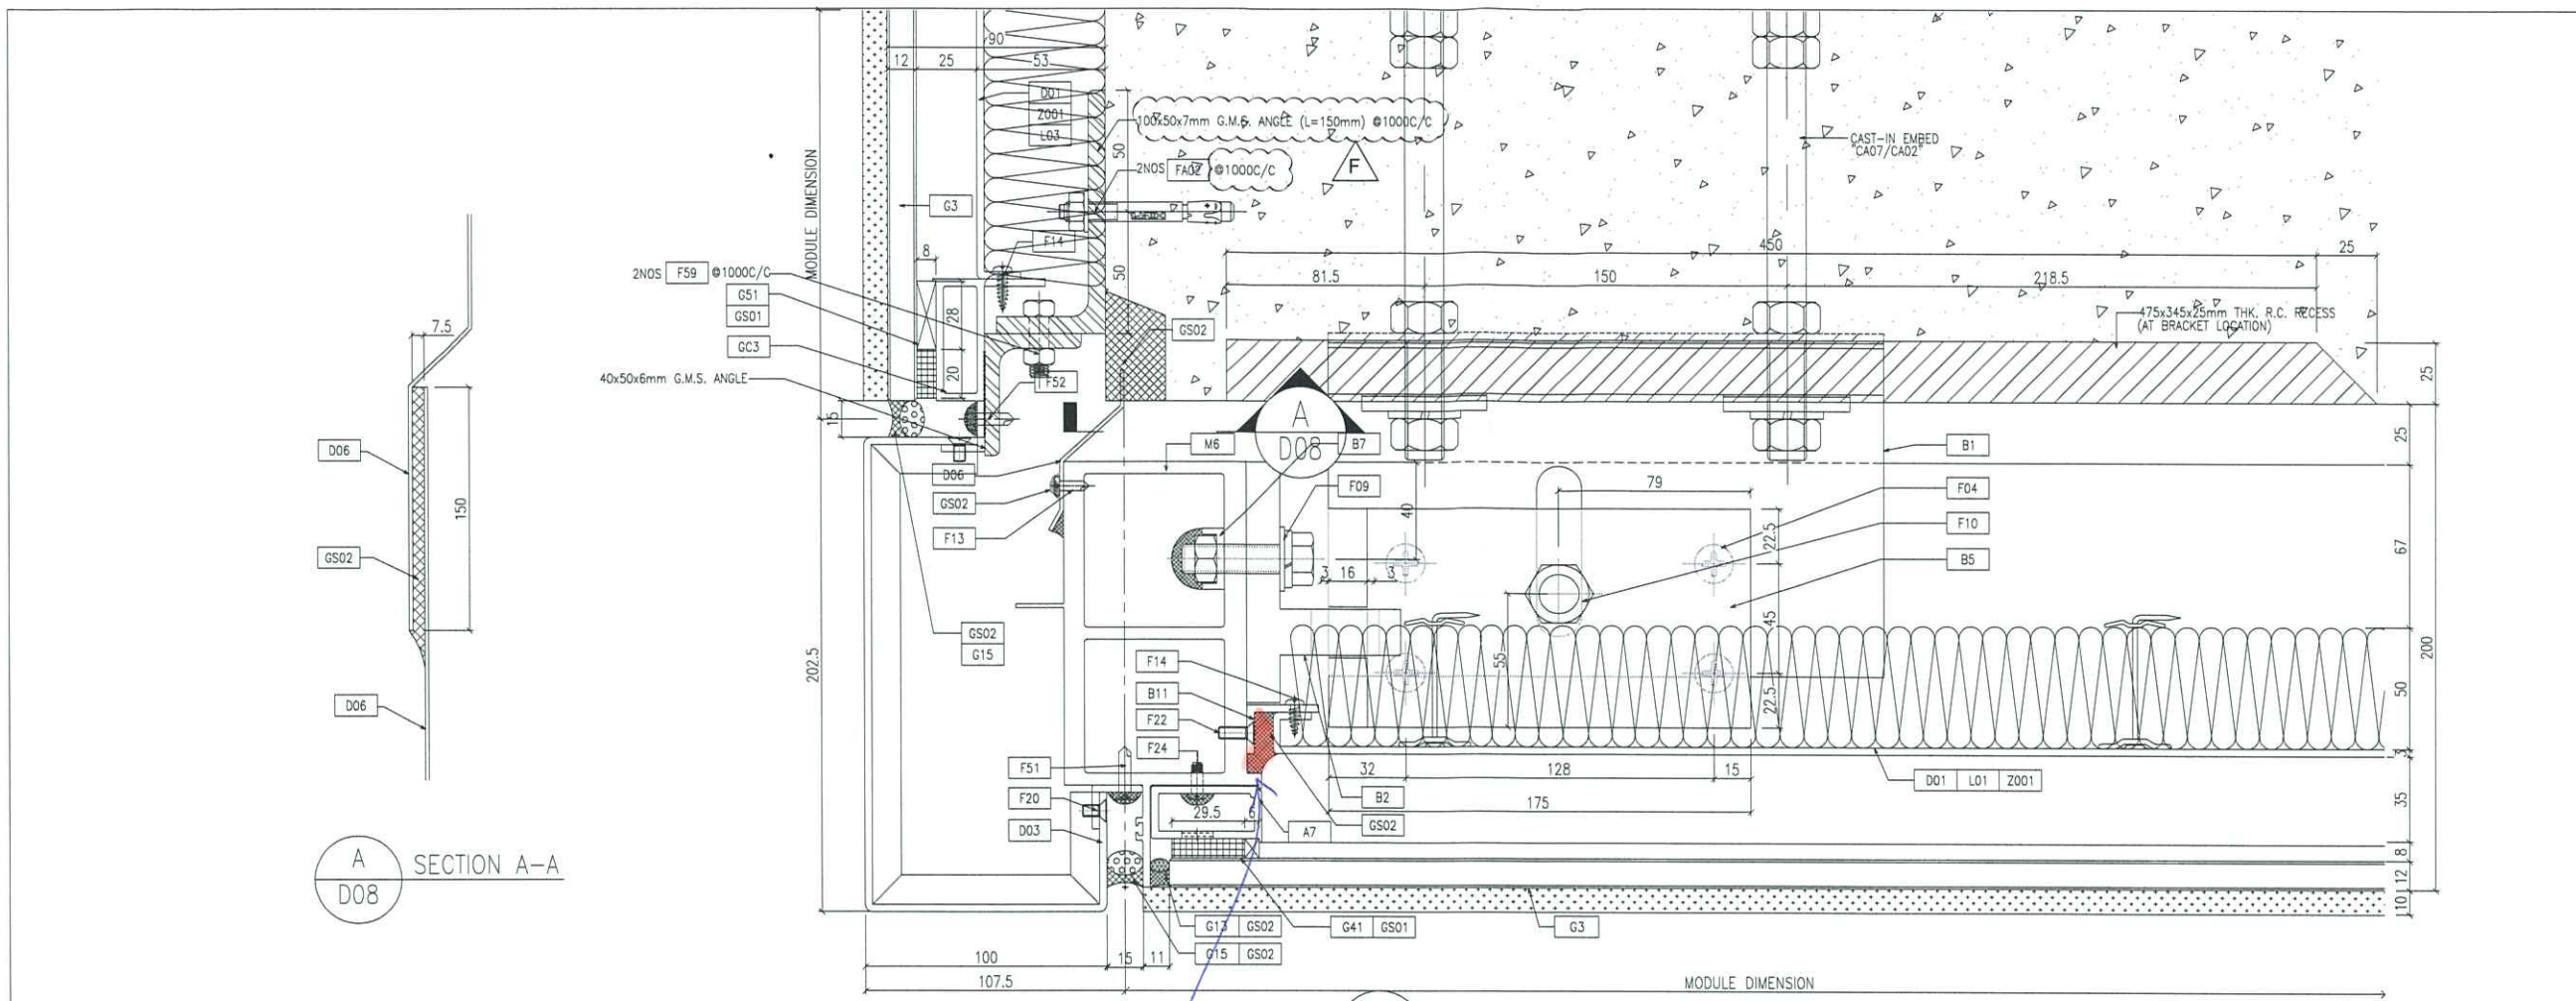


A SECTION A-A
D08

1 TYPICAL MULLION DETAIL
D08 CURTAIN WALL OUTSIDE

未生產的單元
招此修改膠膠背板方法

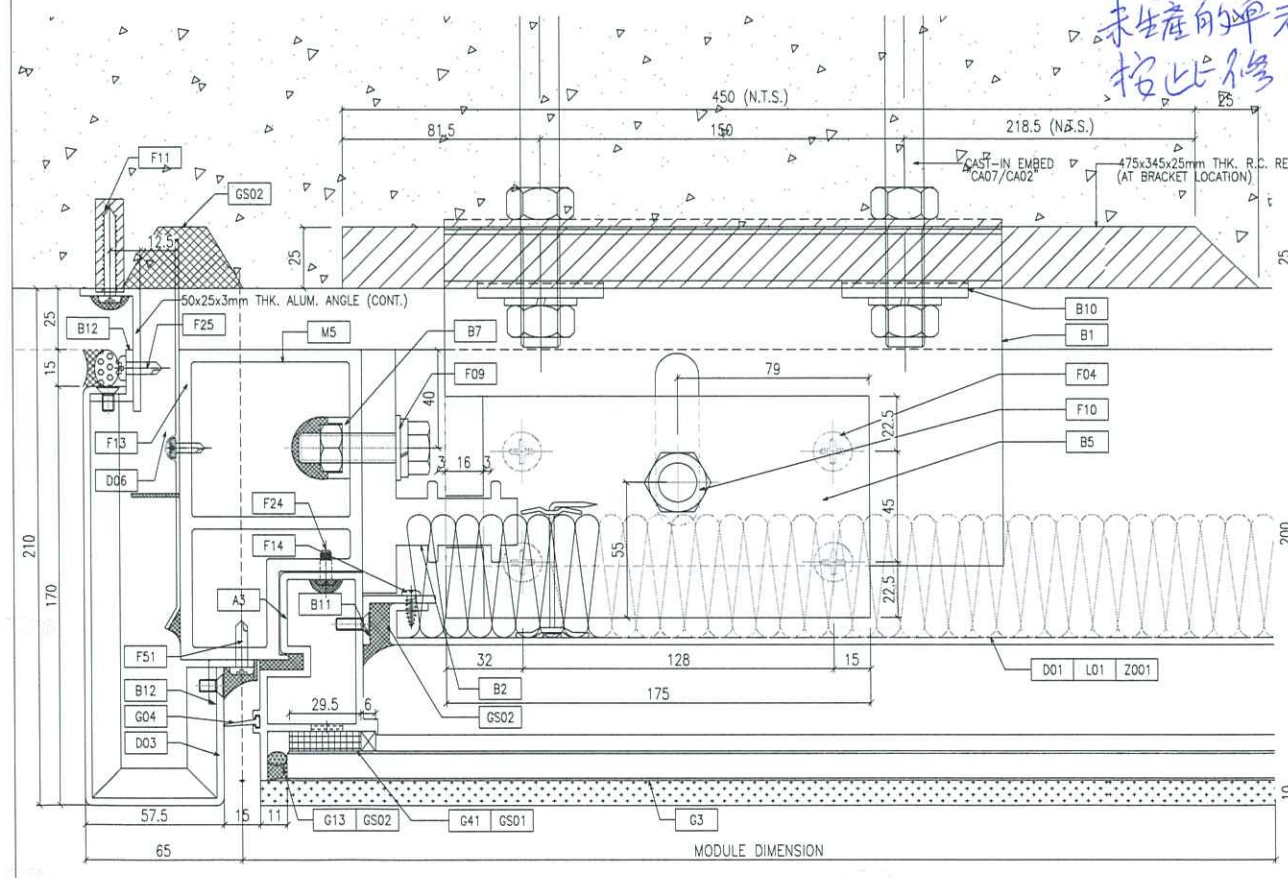

2 TYPICAL MULLION DETAIL
D08 CURTAIN WALL OUTSIDE

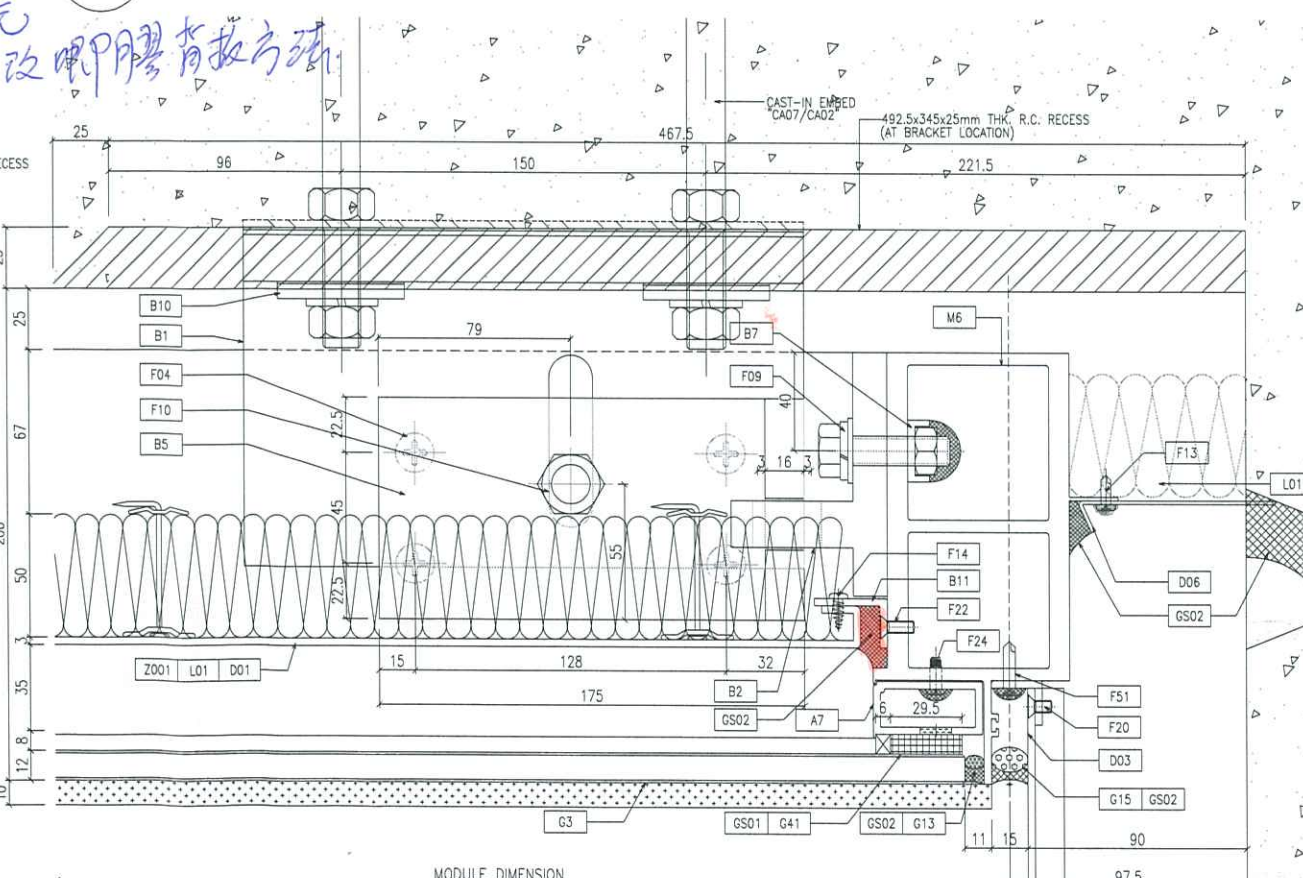

3 TYPICAL MULLION DETAIL
D08 CURTAIN WALL OUTSIDE

B.D. REF :

CLIENT :
信和置業有限公司
Sino Land Company Limited

ARCHITECT :
ronald lu & partners
Ronald Lu & Partners (HK) Ltd.
呂元祥建築師事務所 (香港) 有限公司

MAIN CONTRACTOR :
Gammon

STRUCTURAL ENGINEER :
AECOM

FAÇADE CONSULTANT :
AECOM

NOTE :
1. ALL DIMENSIONS ARE IN mm.
2. ALL ELEVATIONS ARE VIEWED FROM OUTSIDE.
3. ALL DIMENSIONS TO BE VERIFIED ON SITE BEFORE FABRICATION.

LEGEND :
X1 --- DETAIL MARK NO.
X001 --- REFER SHEET NO.
1. F.F.L. --- FINISHED FLOOR LEVEL
2. S.F.L. --- STRUCTURAL FLOOR LEVEL
3. (R) --- REVERSED DETAIL

NO.	DATE	REVISED	BY
F	28/09/22	REVISED AS PER COMMENTS	LS
E	22/07/22	REVISED AS PER COMMENTS	LS
D	24/05/22	REVISED AS PER COMMENTS	LS
C	07/04/22	REVISED AS PER COMMENTS	LS
B	25/01/22	REVISED AS PER COMMENTS	LS
A	23/12/21	REVISED AS PER COMMENTS	LS

JOB NO. : J-858
PROJECT : PROPOSED RESIDENTIAL DEVELOPMENT AT TKOTL 70RP, PHASE 11, LOHAS PARK TSEUNG KWAN O, N.T.

TITLE : TYPICAL MULLION DETAIL FOR CURTAIN WALL

DATE : 22-OCT-21 SCALE : 1:1.5(A1)
DRAWN BY : CHECKED BY :

美特鋁質有限公司
MIDI ALUMINIUM FABRICATOR LTD.
Units 6-8, Sunray Industrial Centre, 1/F
610 Cha Kwo Ling Road, Kowloon
Tel:23489211-4 Fax:(852)2727666
DWG NO. : J858-CW-D08 REV. : F