

工程指示 / 要求簡箋(E.I.)

工程指示編號：EI / 5527 / 23 (原 EI 5272) 修改版次：M

工程編號：J - 858

工程名稱：將軍澳日出康城 LP 11

工程項目：幕牆 大貨單元件加工圖

收件人：生統 / 王良 / 水洪

發件人：Ant Yeung

日期：21/02/2023

要求提供 / 確認 事項：

→ M 版：因應業主要求飾線收封口片後圍邊啣黑膠 DC791。注意：膠不要太粗 (已附電郵確認)

L 版：因應地盆安裝時，原本在地盆安裝的防火棉托，會阻礙安裝有飾線的單元件。

所以凡有飾線的單元件此防火棉需改由廠安裝。顧問已同意。(附報告)

L *請留意 防火棉需貼上錫紙，錫紙包好完整，不露出防火棉。

參考相片，該個飾線背空間全裝密，單元背凸出 30MM 便可以，唔夠地盤後補。

L *單元件落架：因防火棉墊高，請留意高低。

L *拆圖，請計算防火棉用量

L: 防火棉廠未有貨，暫時地盆墊棉，完成的單元保持

(原 EI 5272)

請在 2023.02.22 前完成上列要求。w

附：頁

原合約工程包

原合約工程加 / 減賬

新工程報價

分發 拆圖 ()BUN 連附件

分發東莞各部門：

()生產技術總監 連附件

(✓)技術部 連附件

()生產部 連附件

()機械設計部 連附件

()採購部 連附件

(✓)生產統籌部 連附件

(✓)小羅&清 連附件

(✓)質檢部 連附件

()會計部 連附件

()報關組 連附件

(✓)其他 水洪 連附件

分發香港各部門：

()行政部 連附件 ()會計部 連附件 ()統籌部 連附件 (✓)工程部地盤科文 積哥、二寶 連附件

()採購部 連附件 ()QS 部 連附件 ()維修部 連附件 ()其他 _____ 連附件


傳遞編號：

發件人簽署：


HK 275 / 23

項目經理簽署：

此為等
補回通知
記錄
無防棉出隻

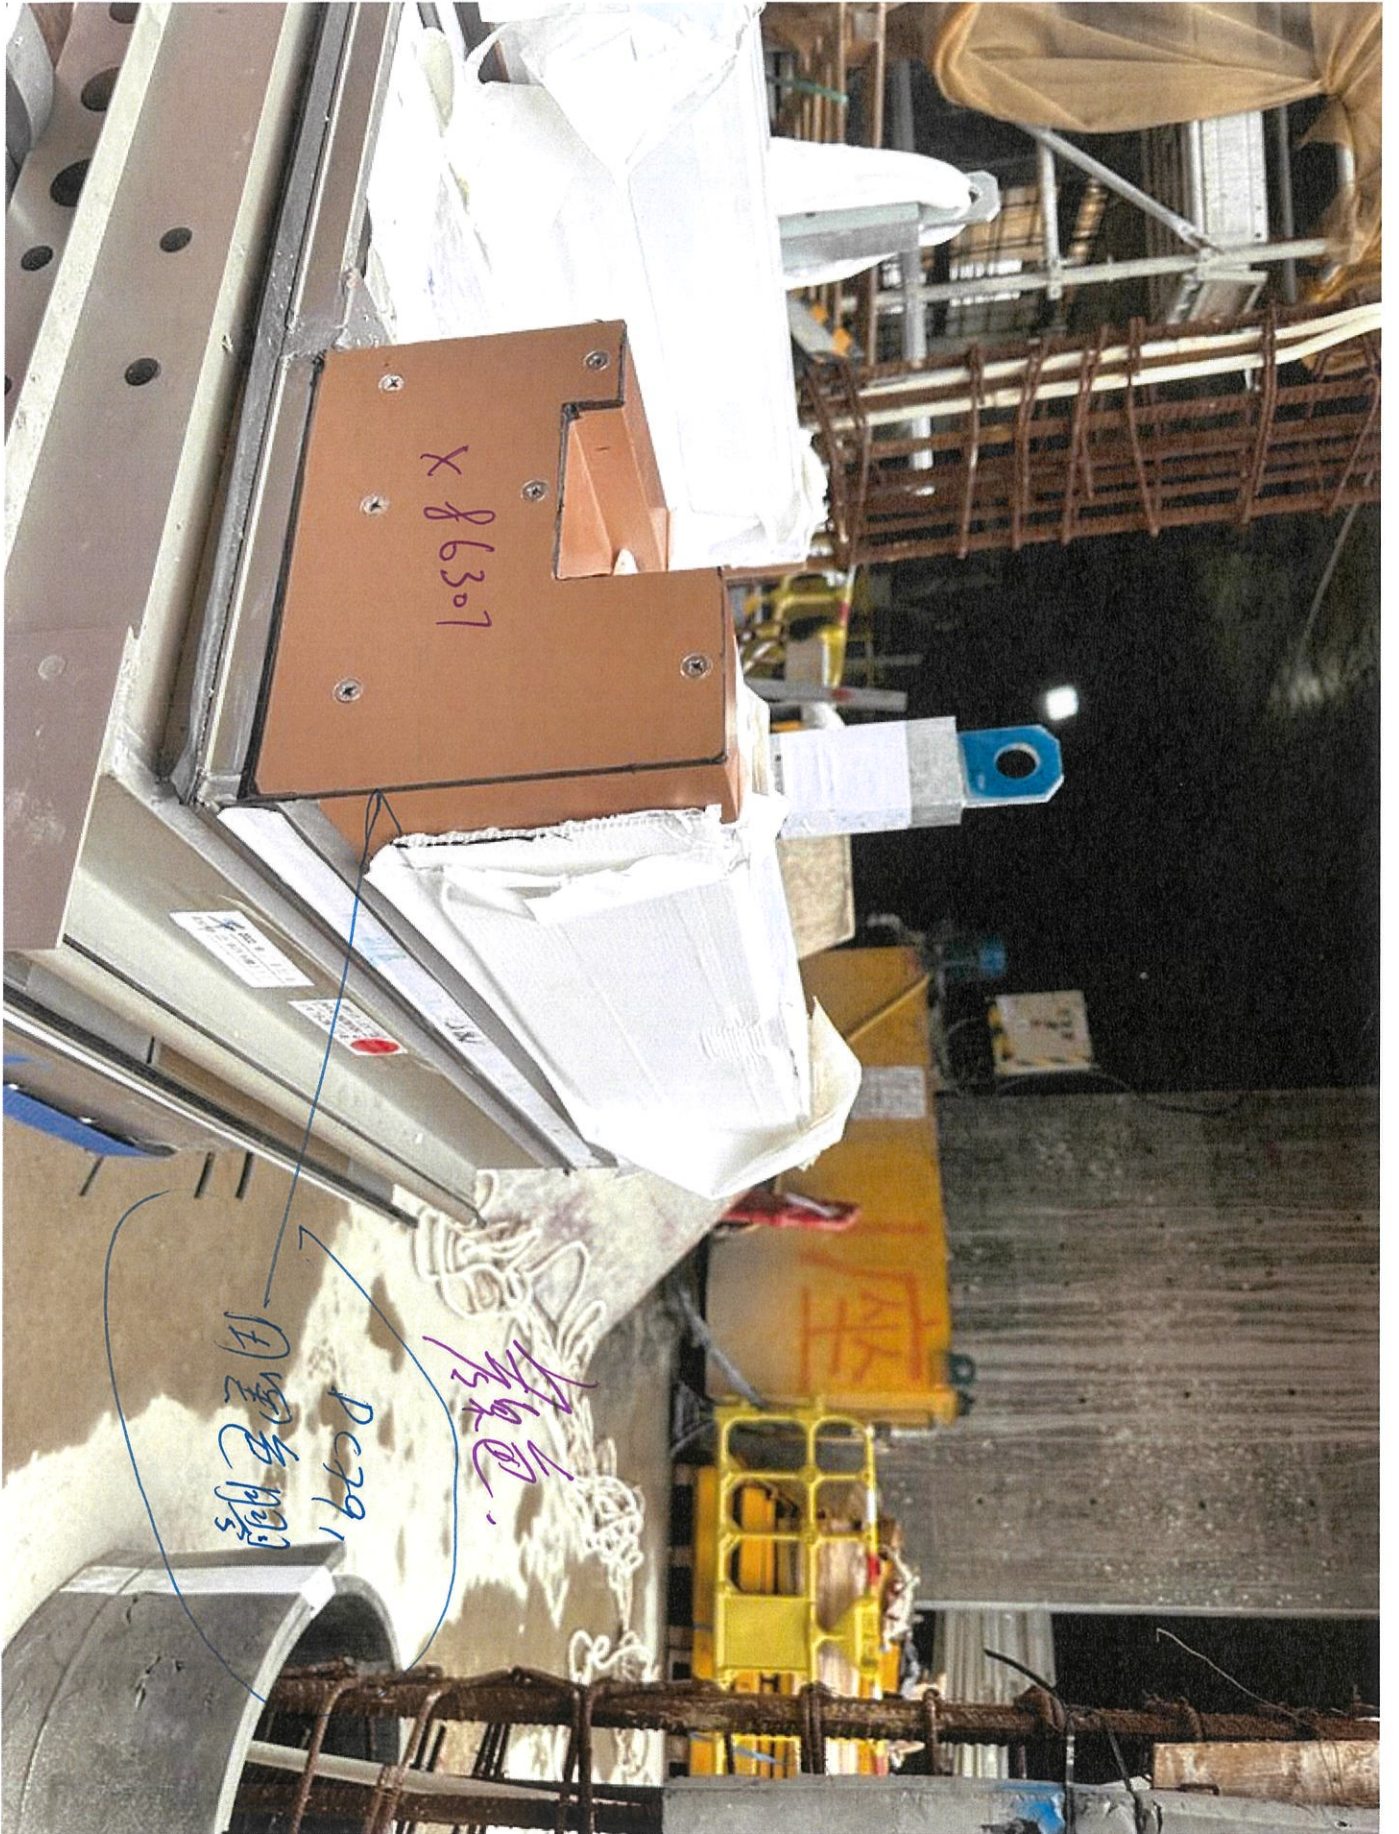

203.2.20

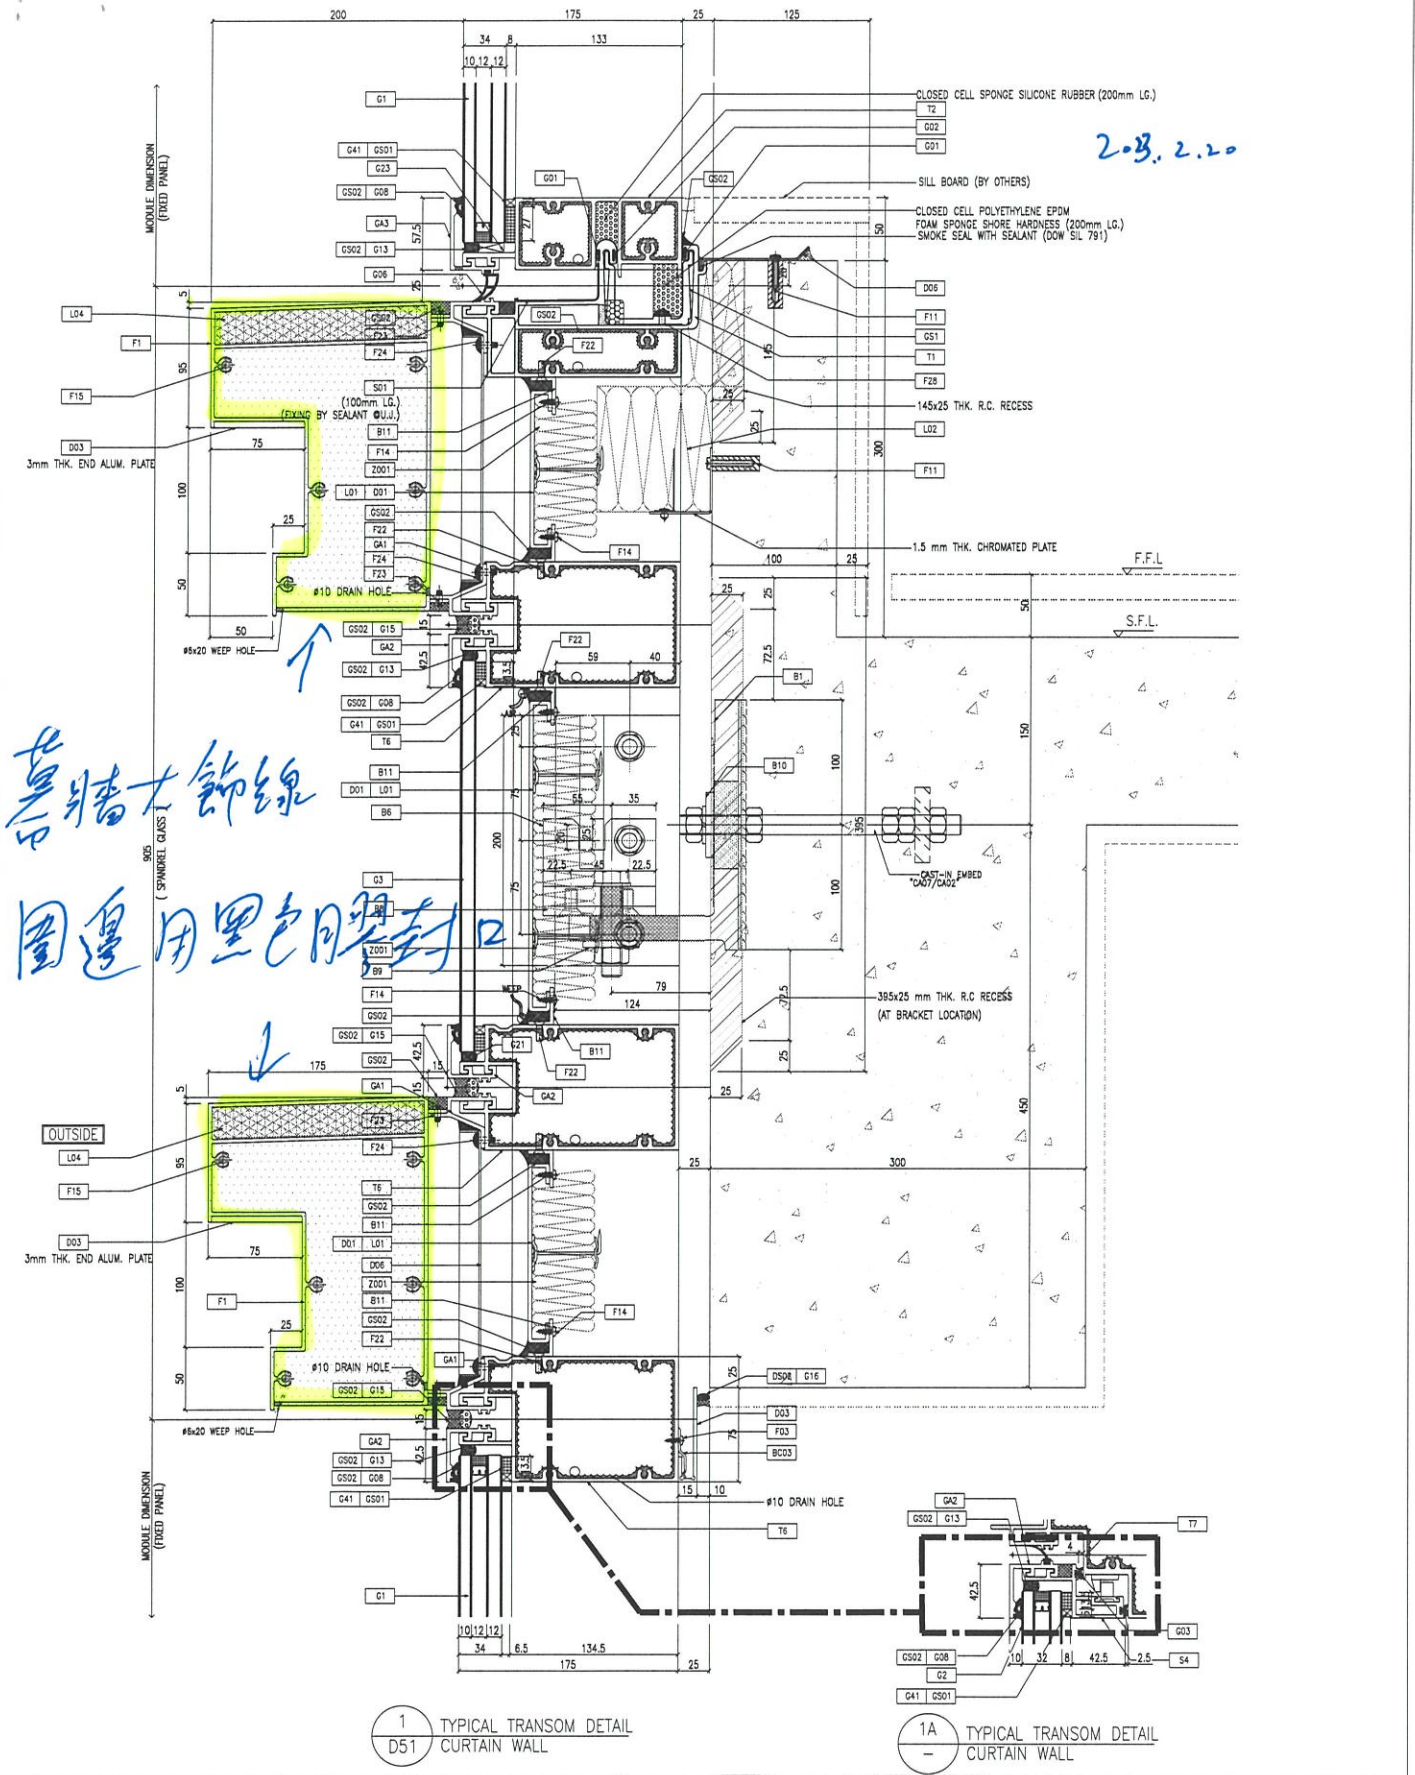

幕墙大節線
 圈邊用黑色膠密封

1 TYPICAL TRANSOM DETAIL
 D51 CURTAIN WALL

1A TYPICAL TRANSOM DETAIL
 CURTAIN WALL

CLIENT : 佳利置業有限公司 Sino Land Company Limited		ARCHITECT : ronaldi Ronald Li & Partners (HK) Ltd. 呂志文建築師事務所 (香港) 有限公司		MAIN CONTRACTOR : Gammon																					
DATE : 22-OCT-21 SCALE : 1:2(A1)		STRUCTURAL ENGINEER : AECOM		FAÇADE CONSULTANT : AECOM																					
PROJECT : PROPOSED RESIDENTIAL DEVELOPMENT AT TKOIL 788P, PHASE 11, LOMA PARK TSEUNG KWAN O, N.T.		REVISIONS: <table border="1"> <tr><th>NO.</th><th>DATE</th><th>REASON</th></tr> <tr><td>1</td><td>22/07/22</td><td>REVISION AS PER COMMENTS</td></tr> <tr><td>2</td><td>25/07/22</td><td>REVISION AS PER COMMENTS</td></tr> <tr><td>3</td><td>07/08/22</td><td>REVISION AS PER COMMENTS</td></tr> <tr><td>4</td><td>29/07/22</td><td>REVISION AS PER COMMENTS</td></tr> <tr><td>5</td><td>29/12/21</td><td>REVISION AS PER COMMENTS</td></tr> </table>		NO.	DATE	REASON	1	22/07/22	REVISION AS PER COMMENTS	2	25/07/22	REVISION AS PER COMMENTS	3	07/08/22	REVISION AS PER COMMENTS	4	29/07/22	REVISION AS PER COMMENTS	5	29/12/21	REVISION AS PER COMMENTS	LEGEND: (A1) DETAIL MARK NO. (D51) REFER SHEET NO. 1. F.F.L. --- FINISHED FLOOR LEVEL 2. S.F.L. --- STRUCTURAL FLOOR LEVEL 3. (R) --- REVERSED DETAIL		NOTE: 1. ALL DIMENSIONS ARE IN mm. 2. ALL DIMENSIONS ARE MEASD FROM OUTSIDE. 3. ALL DIMENSIONS TO BE VERIFIED ON SITE BEFORE FABRICATION.	
NO.	DATE	REASON																							
1	22/07/22	REVISION AS PER COMMENTS																							
2	25/07/22	REVISION AS PER COMMENTS																							
3	07/08/22	REVISION AS PER COMMENTS																							
4	29/07/22	REVISION AS PER COMMENTS																							
5	29/12/21	REVISION AS PER COMMENTS																							
APP NO. : J-858 PROJECT : PROPOSED RESIDENTIAL DEVELOPMENT AT TKOIL 788P, PHASE 11, LOMA PARK TSEUNG KWAN O, N.T. TITLE : TYPICAL MULLION DETAIL FOR CURTAIN WALL		DRAWN BY : [Name] CHECKED BY : [Name]		REVISIONS: [Table]																					
COMPANY : 美特經貿有限公司 MDI International Development 610 Chee Kwo Ling Road, Kowloon (42349871-4) Tel:(852)27777688 (W)W. NO. : JB58-CW-051		COMPANY : AECOM 11th Floor, One Prince of Wales Drive, Kowloon, Hong Kong Tel: (852) 2438 8888		COMPANY : Gammon 11/F, One Prince of Wales Drive, Kowloon, Hong Kong Tel: (852) 2438 8888																					

From: j858@midiltd.com.hk <j858@midiltd.com.hk>
To: Jun.Tsui@gammonconstruction.com, Brian.Ng@gammonconstruction.com,
j3931@gammonconstruction.com, KaHei.Wong@gammonconstruction.com,
Woody.Wong@gammonconstruction.com, Donny.Lo@gammonconstruction.com,
Terry.KT.Leung@gammonconstruction.com, Edward.Chiang@gammonconstruction.com,
Eunice.Tang@gammonconstruction.com, rss19084mw@rlphk.com,
P19084@rlp.asia, marinatong@rlp.asia,
ginnychau@rlp.asia, wallaceng@rlp.asia,
andywchan@sino.com, terrywan@sino.com,
simonspleung@sino.com, kennethleung@sino.com,
stephenchchow@sino.com, mckay.zhang@aecom.com
Subject: LP11-CW -確認 幕牆飾線圍邊封口黑色膠
Copies to: ant.ysy.midi@gmail.com, jason.lcs.midi@gmail.com
Date sent: Mon, 20 Feb 2023 18:11:22 +0800

Dear Andy Sir

附上現場修改幕牆飾線圍邊封口黑色膠相片和圖紙

按今日會議確認，使用黑色膠作為圍邊封口。

謝謝

源

Attachments: \\midinas0\job\Jobs\J-858\7 Email & Letter\Email\to Gammon\20230220 飾線圍邊封口黑色膠\20230220 confirm 飾線圍邊封口黑色膠.pdf

琳已經電郵石睿親傳知
如主

如蒙電到地盤，現場改色。