

工程指示 / 要求簡箋(E.I.)

工程指示編號：EI / 5566123

修改版次：-

工程編號：J - 858

工程名稱：將軍澳日出康城 LP 11

工程項目：大樓 趟門鋁窗 安裝玻璃分判

收件人：Maggie

發件人：Ant Yeung

日期：31/12/2022

要求提供 / 確認 事項：

- |                                    |                                     |                               |
|------------------------------------|-------------------------------------|-------------------------------|
| <input type="checkbox"/> 初步鋁料 B.M. | <input type="checkbox"/> 加工拆圖，然後生產  | <input type="checkbox"/> 尺寸表  |
| <input type="checkbox"/> 正式鋁料 B.M. | <input type="checkbox"/> 技術上資料 / 指示 | <input type="checkbox"/> 報價   |
| <input type="checkbox"/> 配件 B.M.   | <input type="checkbox"/> 樣辦或貨品說明書   | <input type="checkbox"/> 分判合約 |

內容：

請按附件分判玻璃安裝。本地盆為信和業主、金門大判。須附合業主大判要求

1. 鋁窗玻璃 (包佛沙窗和後裝窗)，兩款玻璃 6mm 單片 和 6+1.52+6 夾片 總數 1075 件/ 475m<sup>2</sup>

2. 趟門玻璃 包梗和玉 玻璃，一款玻璃 10mm +12A +12mm IGU 總數 3720 件/ 9082m<sup>2</sup>

附上計算表 summary 和 BM。特色層門窗各座最高 1 層未出設計、稍後補回追加米數

首批和樣板層先做：

1. 鋁窗 T1 9-19/F (EI 5307+EI 5299) (拆棚位) 共 40 件，預 2 月 24 日 安裝

2. 趟門 T1 12,15,16/F (EI 5404) (樣板層) 共 78 件，預 3 月 3 日 安裝

鋁窗玻璃線：玻璃線向室內，玻璃線內有加力角需要現場安裝。

趟門玻璃線：門梗玻璃線向室外(室內有基仔)，門玉玻璃線向室內。

請在 2023.01.31 前完成上列要求。

附：

原合約工程包

原合約工程加 / 減賬

新工程報價

原因：-

分發東莞各部門：

- |  |   |  |  |
|--|---|--|--|
| <input type="checkbox"/> 生產技術總監 <input type="checkbox"/> 連附件 | <input type="checkbox"/> 技術部 <input type="checkbox"/> 連附件   | <input type="checkbox"/> 生產部 <input type="checkbox"/> 連附件  | <input type="checkbox"/> 機械設計部 <input type="checkbox"/> 連附件        |
| <input type="checkbox"/> 採購部 <input type="checkbox"/> 連附件    | <input type="checkbox"/> 生產統籌部 <input type="checkbox"/> 連附件 | <input type="checkbox"/> 小羅&清 <input type="checkbox"/> 連附件 |  |
| <input type="checkbox"/> 質檢部 <input type="checkbox"/> 連附件    | <input type="checkbox"/> 會計部 <input type="checkbox"/> 連附件   | <input type="checkbox"/> 報關組 <input type="checkbox"/> 連附件  | <input type="checkbox"/> 其他 <u>水洪</u> <input type="checkbox"/> 連附件 |

分發其他分判：

連附件 檳

分發香港各部門：

- |   |  |   |   |
|---|--|---|---|
| <input type="checkbox"/> 行政部 <input type="checkbox"/> 連附件                       | <input type="checkbox"/> 會計部 <input type="checkbox"/> 連附件  | <input type="checkbox"/> 統籌部 <input type="checkbox"/> 連附件 | <input checked="" type="checkbox"/> 工程部地盤科文 <u>積哥</u> <input checked="" type="checkbox"/> 連附件 |
| <input checked="" type="checkbox"/> 採購部 <input checked="" type="checkbox"/> 連附件 | <input type="checkbox"/> QS 部 <input type="checkbox"/> 連附件 | <input type="checkbox"/> 維修部 <input type="checkbox"/> 連附件 | <input type="checkbox"/> 其他 _____ <input type="checkbox"/> 連附件                                |

傳遞編號：

HK / 22

發件人簽署：

項目經理簽署：

J858 -- LP 11--- 日出康城11期 ---門窗玻璃安裝分判

窗仔玻璃 (包佛沙窗和後裝窗)


款式	單片	件	m2
6mm temper glass	單片	292	154
6 + 1.52 pvb+ 6 low iron mm lam 片	Lam片	783	321
	Total	1075	475
		件	m2

佛沙窗	件	m2
佛沙窗	826	316
後裝窗	249	159
	1075	475
	特色層未出設計、稍後補回	

趟門玻璃 (包梗門和門玉)

款式	IGU : 10mm Low E(58T) + 12A + 12mm	件	m2
趟門	IGU	3720	9082.3
	Total	3720	9082.3
		件	m2

T1	件	m2	62/F未計
T1	1170	2853.5	9-61/F
T2	1274	3112.8	9-66/F
T3	1276	3116	9-66/F
	3720	9082.3	67/F未計
	特色層未出設計、稍後補回		

 <b>美特鋁質</b> 有限公司 MIDI Aluminium Fabricator Ltd.		工程號: J-858	計算: WCM	日期: 2022/05/31	送呈: 施哥			
地盤名稱: 康城11期		核對:	副本:					
項目類別: 預制窗		批准:	A/C Code:					
修改版次:		總計玻璃面積 (平方米): 316.28						
BM編號:		此BM依據						
序號	修改內容	玻璃編號	顏色與類型	玻璃尺寸		數量 (塊)	總面積 (平方米)	備注
				寬度W (mm)	高度H (mm)			
1		YG09-01	TG09: 6mm THK HEAT STRENGTHENED CLEAR GLASS +1.52mm MILKY WHITE PVB +6mm LOW IRON THK HEAT STRENGTHENED CLEAR GLASS	309	1129	185	64.54	
2		YG09-02	TG09: 6mm THK HEAT STRENGTHENED CLEAR GLASS +1.52mm MILKY WHITE PVB +6mm LOW IRON THK HEAT STRENGTHENED CLEAR GLASS	454	1109.5	200	100.74	← 夾片
3		YG09-03	TG09: 6mm THK HEAT STRENGTHENED CLEAR GLASS +1.52mm MILKY WHITE PVB +6mm LOW IRON THK HEAT STRENGTHENED CLEAR GLASS	454	766.5	200	69.60	
4		YG09-04	TG09: 6mm THK HEAT STRENGTHENED CLEAR GLASS +1.52mm MILKY WHITE PVB +6mm LOW IRON THK HEAT STRENGTHENED CLEAR GLASS	359	1129	98	39.72	
5		YG11-01	TG11: 6mm THK CRYSTAL TEMPERED GLASS	759	384	143	41.68	← 夾片
				合計:		826	316	
<b>加工注意事項:</b> 1) 本表中所有玻璃對角線尺寸偏差要求不超過正負2mm。 2) 本表中所有玻璃要求粗磨邊及精磨邊處理並倒棱角。 3) 本表中不同種類玻璃參照玻璃加工圖加工。 4) 本表中所有強化玻璃均需HEAT SOAK TEST。 5) 本表中所有強化玻璃之入爐方向均以寬度方向進入。 6) 本表中所有玻璃成品均需注明室內外面及其玻璃編號，以便識別。								

T1-73 傅少倫

美特鋁質 MDI Aluminium Fabricator Ltd.	工程號:	J-858	計算:	WCM	日期:	2022/09/11	送呈:	施哥
	地盤名稱:	康城11期	核對:		日期:		副本:	
地盤用玻璃B.M.表	項目類別:	后裝窗	批准:		日期:		A/C Code:	
	BM編號:	修改版次:	總計玻璃面積 (平方米):		159.08	此BM依據		

序號	修改內容	玻璃編號	顏色與類型	玻璃尺寸		數量 (塊)	總面積 (平方米)	備注
				寬度W (mm)	高度H (mm)			
1		HG09-01	TG09: 6mm THK HEAT STRENGTHENED CLEAR GLASS +1.52mm MILKY WHITE PVB +6mm THK LOW IRON HEAT STRENGTHENED CLEAR GLASS (R20220414034)	329	1127	49	18.17	
2		HG09-02	TG09: 6mm THK HEAT STRENGTHENED CLEAR GLASS +1.52mm MILKY WHITE PVB +6mm THK LOW IRON HEAT STRENGTHENED CLEAR GLASS (R20220414034)	504	1127	50	28.40	一片
3		HG09-03	TG09: 6mm THK HEAT STRENGTHENED CLEAR GLASS +1.52mm MILKY WHITE PVB +6mm THK LOW IRON HEAT STRENGTHENED CLEAR GLASS (R20220414034)	304	1127	1	0.34	
5		HG11-01	TG11: 6mm THK TEMPERED GLASS (R20220414034)	604	1272	146	112.17	一片
6		HG11-02	TG11: 6mm THK TEMPERED GLASS (R20220401057)	729	352	3	0.77	
					合計:	249	159	

1).本表中所有玻璃對角線尺寸偏差要求不超過正負2mm。  
2).本表中所有玻璃要求粗磨邊及精磨邊處理並倒棱角。  
3).本表中不同種類玻璃參照玻璃加工圖加工。  
4).本表中所有強化玻璃均需HEAT SOAK TEST。  
5).本表中所有強化玻璃之入爐方向均以寬度方向進入。  
6).本表中所有玻璃成品均需注明室內外面及其玻璃編號，以便識別。敬

**加工注意事項：**

T-73  
何維毅



J858康城11期单元幕墙玻璃分层统计表 (T2趟门)

工程: J858康城11期 (T2)

日期: 14-Jun-22

序号	玻璃编号	玻璃类型	玻璃尺寸			单面积 (m2)	分层数量			总数量	备注	
			W (mm)	x	H (mm)		9F (10, 12~16, 18~20, 22~25, 27~29, 31~33, 36~38, 41~42, 45~47, 49~51, 53~56, 58~60, 62~65F相同, 共37层)	17F (21, 26, 30, 35, 39, 43, 48, 52, 57, 61F相同, 共11层)	66F			
1	GL01-57	GL01	1010	x	2374	2.40	37	11		48	送地盘	115.1
2	GL01-58	GL01	978	x	2525	2.47	37	11		48	送地盘	118.5
3	GL01-72	GL01	1010	x	2574	2.60				1	1 送地盘	2.6
4	GL01-73	GL01	978	x	2725	2.67				1	1 送地盘	2.7
5	GL01-59	GL01	1035	x	2374	2.46	37	11		48	送地盘	117.9
6	GL01-60	GL01	1003	x	2525	2.53	37	11		48	送地盘	121.6
7	GL01-70	GL01	1035	x	2574	2.66				1	1 送地盘	2.7
8	GL01-71	GL01	1003	x	2725	2.73				1	1 送地盘	2.7
9	GL01-61	GL01	1017.5	x	2374	2.42	296	88		384	送地盘	927.6
10	GL01-62	GL01	985.5	x	2525	2.49	296	88		384	送地盘	955.5
11	GL01-78	GL01	1017.5	x	2574	2.62				8	8 送地盘	21.0
12	GL01-79	GL01	985.5	x	2725	2.69				8	8 送地盘	21.5
13	GL01-63	GL01	977.5	x	2374	2.32	74	22		96	送地盘	222.8
14	GL01-64	GL01	945.5	x	2525	2.39	74	22		96	送地盘	229.2
15	GL01-74	GL01	977.5	x	2574	2.52				2	2 送地盘	5.0
16	GL01-75	GL01	945.5	x	2725	2.58				2	2 送地盘	5.2
17	GL01-65	GL01	1020	x	2374	2.42	37	11		48	送地盘	116.2
18	GL01-66	GL01	988	x	2525	2.49	37	11		48	送地盘	119.7
19	GL01-80	GL01	1020	x	2574	2.63				1	1 送地盘	2.6
20	GL01-81	GL01	988	x	2725	2.69				1	1 送地盘	2.7
总数量						962	286			1274		3112.8

注:

1	GL01	10mm Low E(58T) clear heat strengthened glass +12A +12mm clear tempered glass(inside)										

Handwritten notes and signatures: 14, T2, 3112.8 m<sup>2</sup>, and a signature.

J858康城11期单元幕墙玻璃分层统计表 (T3趟门)

工程: J858康城11期 (T3)  
日期: 01-Aug-22

序号	玻璃编号	玻璃类型	玻璃尺寸			单面积 (m2)	分层数量				总数量	备注	面积 (m2)
			W (mm)	x	H (mm)		9F	10F (12~16, 18~20, 22~25, 27~29, 31~33, 36~38, 41~42, 45~47, 49~51, 53~56, 58~60, 62~65F相同, 共36层)	17F (21, 26, 30, 35, 39, 43, 48, 52, 57, 61F相同, 共11层)	66F			
1	GL01-57	GL01	1010	x	2374	2.40	1	36	11		48	送地盘	115.09
2	GL01-58	GL01	978	x	2525	2.47	1	36	11		48	送地盘	118.53
3	GL01-72	GL01	1010	x	2574	2.60					1	1 送地盘	2.5997
4	GL01-73	GL01	978	x	2725	2.67					1	1 送地盘	2.6651
5	GL01-59	GL01	1035	x	2374	2.46	1	36	11		48	送地盘	117.94
6	GL01-60	GL01	1003	x	2525	2.53	1	36	11		48	送地盘	121.56
7	GL01-70	GL01	1035	x	2574	2.66					1	1 送地盘	2.6641
8	GL01-71	GL01	1003	x	2725	2.73					1	1 送地盘	2.7332
9	GL01-61	GL01	1017.5	x	2374	2.42	8	288	88		384	送地盘	927.57
10	GL01-62	GL01	985.5	x	2525	2.49	8	288	88		384	送地盘	955.54
11	GL01-78	GL01	1017.5	x	2574	2.62					8	8 送地盘	20.952
12	GL01-79	GL01	985.5	x	2725	2.69					8	8 送地盘	21.484
13	GL01-63	GL01	977.5	x	2374	2.32	2	72	22		96	送地盘	222.78
14	GL01-64	GL01	945.5	x	2525	2.39	2	72	22		96	送地盘	229.19
15	GL01-74	GL01	977.5	x	2574	2.52					2	2 送地盘	5.0322
16	GL01-75	GL01	945.5	x	2725	2.58					2	2 送地盘	5.153
17	GL01-65	GL01	1020	x	2374	2.42	1	36	11		48	送地盘	116.23
18	GL01-66	GL01	988	x	2525	2.49	1	36	11		48	送地盘	119.75
19	GL01-80	GL01	1020	x	2574	2.63					1	1 送地盘	2.6255
20	GL01-81	GL01	988	x	2725	2.69					1	1 送地盘	2.6923
21	GL01-82	GL01	747.5	x	2317	1.73	1				1	送地盘	1.732
22	GL01-83	GL01	715.5	x	2468	1.77	1				1	送地盘	1.7659
总数量								936	286	26	1276		3116

注:

1	GL01	10mm Low E(58T) clear heat strengthened glass +12A +12mm clear tempered glass(inside)											

Handwritten notes: T3, 11F, m<sup>2</sup>, and a signature.

BD. REF.:

CLIENT: 德和置业有限公司 Sino Land Company Limited

ARCHITECT: Ronald Lu & Partners  
 羅敏申建築師事務所 (香港) 有限公司

MAIN CONTRACTOR: Gammon AECOM AECOM

STRUCTURAL ENGINEER: AECOM

FAÇADE CONSULTANT: AECOM

NOTE:  
 1. ALL DIMENSIONS ARE IN mm.  
 2. ALL ELEVATIONS ARE VIEWED FROM OUTSIDE.  
 3. ALL DIMENSIONS TO BE VERIFIED ON SITE BEFORE FABRICATION.

LEGEND:  
 1. DETAIL MARK NO.  
 2. REFER SHEET NO.  
 3. F.F.L. — FINISHED FLOOR LEVEL  
 4. S.F.L. — STRUCTURAL FLOOR LEVEL  
 5. R — REVERSED DETAIL

D	16-04-2022	REVISED AS PER COMMENT
C	14-03-2022	REVISED AS PER COMMENT
B	23-11-2021	REVISED AS PER ARCHITECT COMMENT
A	28-10-2021	REVISED AS PER ARCHITECT COMMENT
NO.	DATE	REVISION

JOB NO.: J-858

PROJECT: PROPOSED RESIDENTIAL DEVELOPMENT AT 'NO.11 TOWER', PHASE 11, LOMAS PARK, TSEUNG KWAN O, N.T.

TITLE: TYPICAL DETAIL FOR PRECAST ALUM. WINDOW


DATE: 04-OCT-21 SCALE: 1:2

DRAWN BY: CHECKED BY:


美特鋁質有限公司  
 MIDTI ALUMINIUM FABRICATOR LTD.  
 110, Cheung Yee Road, Tseung Kwan O, N.T.  
 TEL: 23288271-4 Fax: (853) 2727666

DWG. NO.: J858-PW-5001 REV.: D


玻璃 (綠) 出外 (出外)

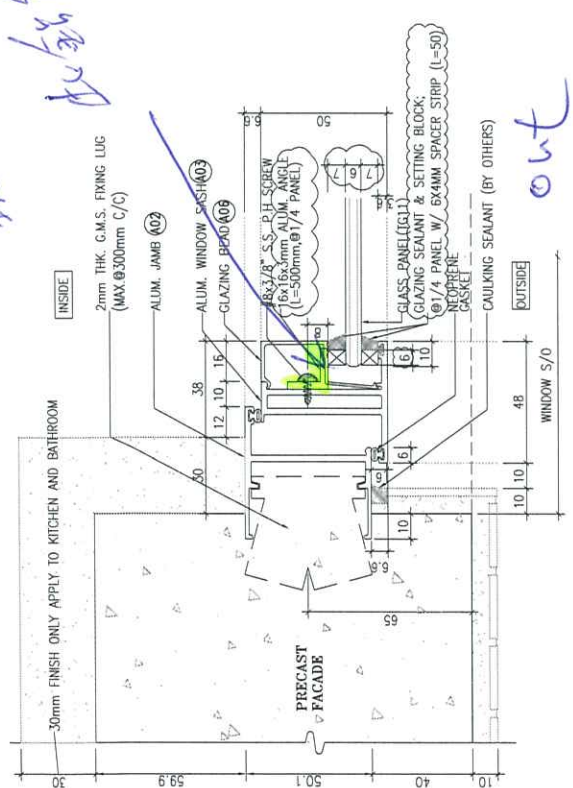

1 HORIZONTAL DETAIL  
5001 Operable Window

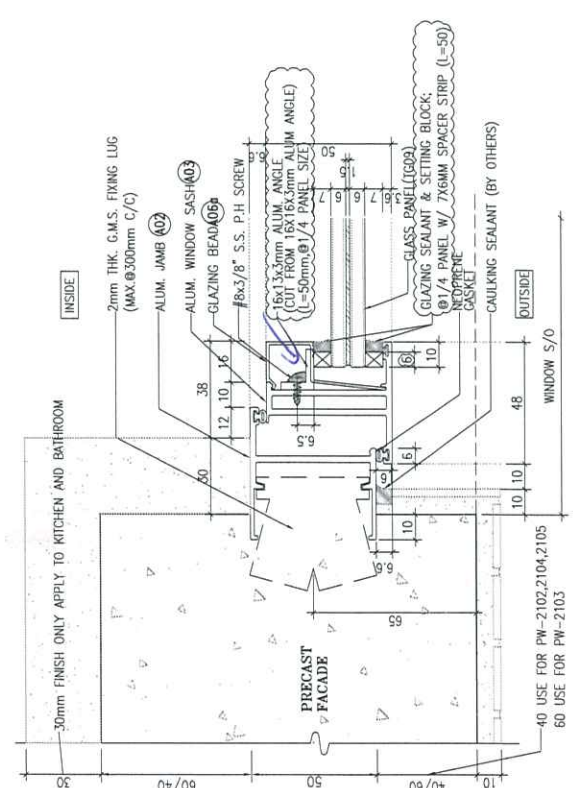

3 HORIZONTAL DETAIL  
5003 Operable Window

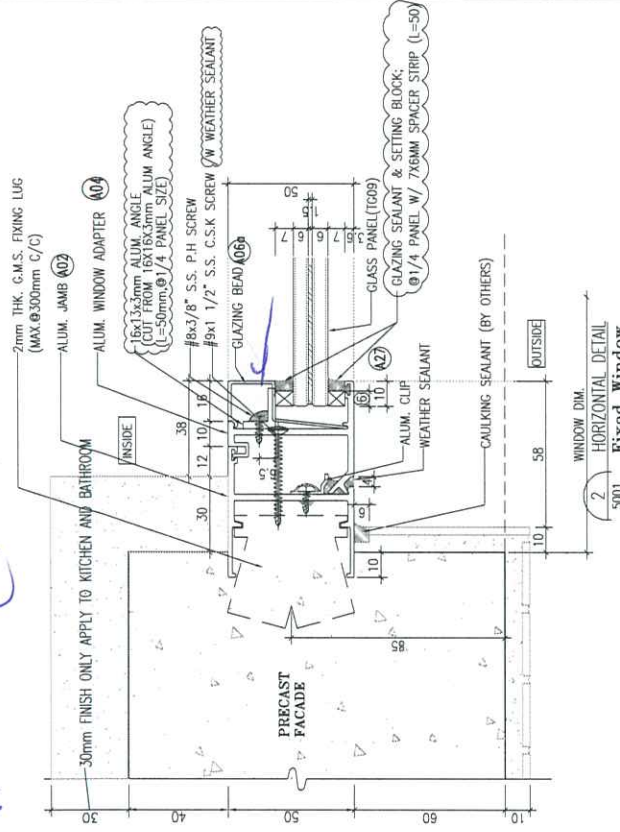

2 HORIZONTAL DETAIL  
5002 Fixed Window

5001





B.D. REF :

CLIENT: 怡和置業有限公司  
Sinc Land Company Limited

ARCHITECT: Ronald Lu & Partners  
Ronald Lu & Partners (HK) Ltd.  
呂志輝建築師事務所 (香港) 有限公司

MAIN CONTRACTOR: Gammon

STRUCTURAL ENGINEER: AECOM

FAÇADE CONSULTANT: AECOM

NOTE:

1. ALL DIMENSIONS ARE IN MM
2. ALL ELEVATIONS ARE VIEWED FROM OUTSIDE.
3. ALL DIMENSIONS TO BE VERIFIED ON SITE BEFORE FABRICATION.

LEGEND:

- DETAIL MARK NO.
- REFER SHEET NO.
- 1. EFFL — FINISHED FLOOR LEVEL
- 2. SFL — STRUCTURAL FLOOR LEVEL
- 3. ○ — REVERSED DETAIL

NO.	REV.	DATE	BY	CHK	APP.
C	04-04-2022	REVISED AS PER COMMENT			DF
B	11-03-2022	REVISED PER COMMENT			
A	19-10-2021	REVISED AS PER ARCHITECT COMMENT			

JOB NO.: J-858

PROJECT: PROPOSED RESIDENTIAL DEVELOPMENT AT TROTTEL TOWER, PHASE 11, LOHAS PARK, TSEUNG KWAN O, N.T.



TITLE: ALUM. WINDOW SECTION FIXING DETAIL

DATE: 04-OCT-21 SCALE: 1:2

DRAWN BY: CHECKED BY:

美特鋁質有限公司  
MIDI ALUMINUM FABRICATOR LTD.  
610 Che Kwo Lin Road, Kowloon  
Tel: 2428211-4 Fax: (852) 2727666

DWG NO.: J858-PW-8001 REV.: C

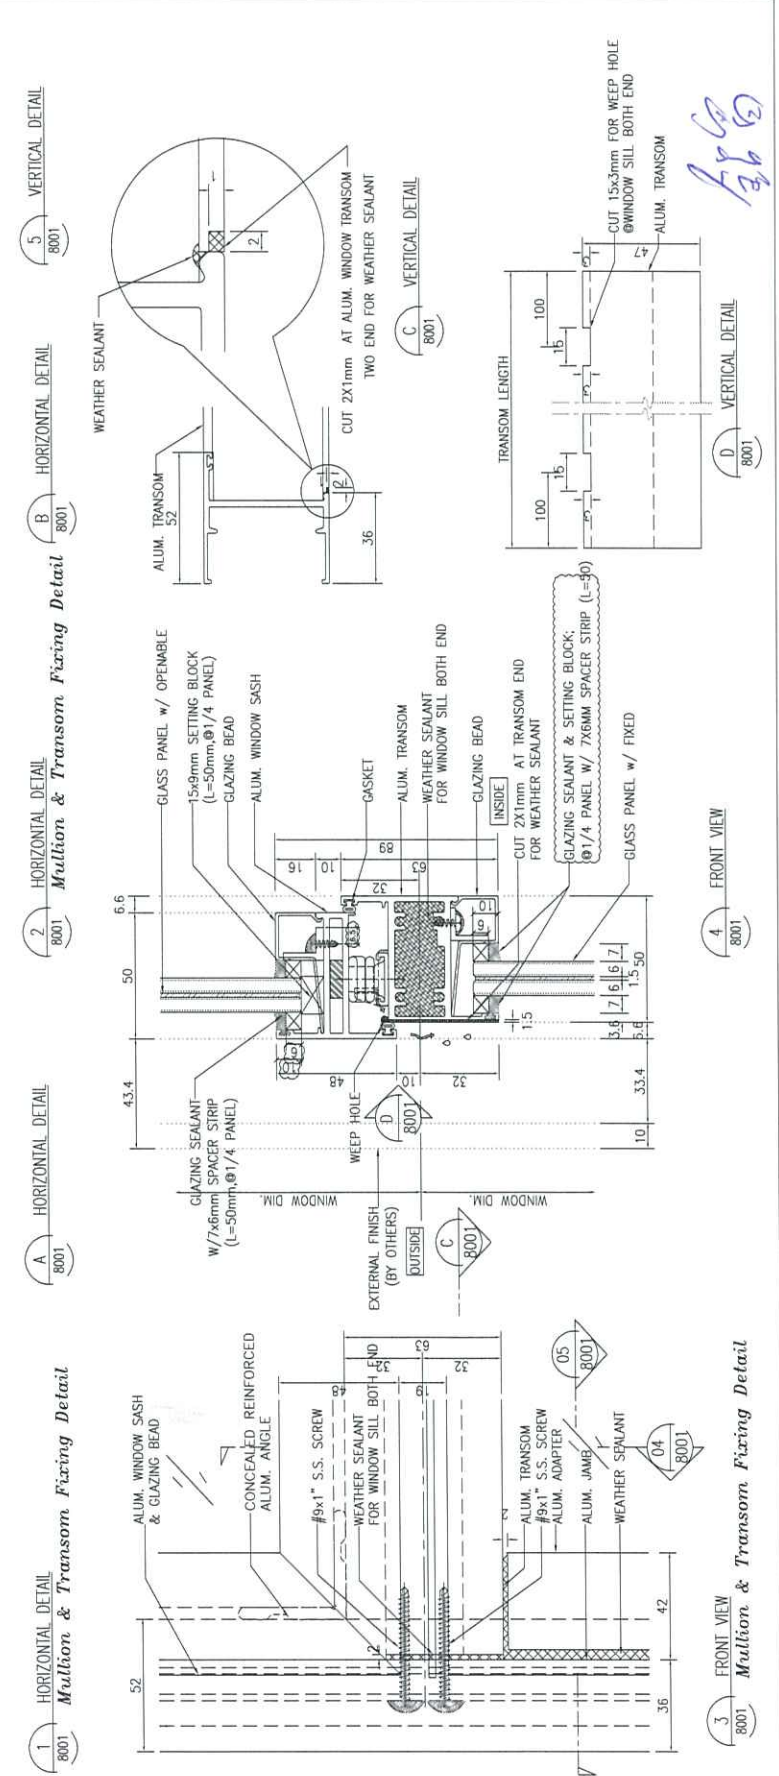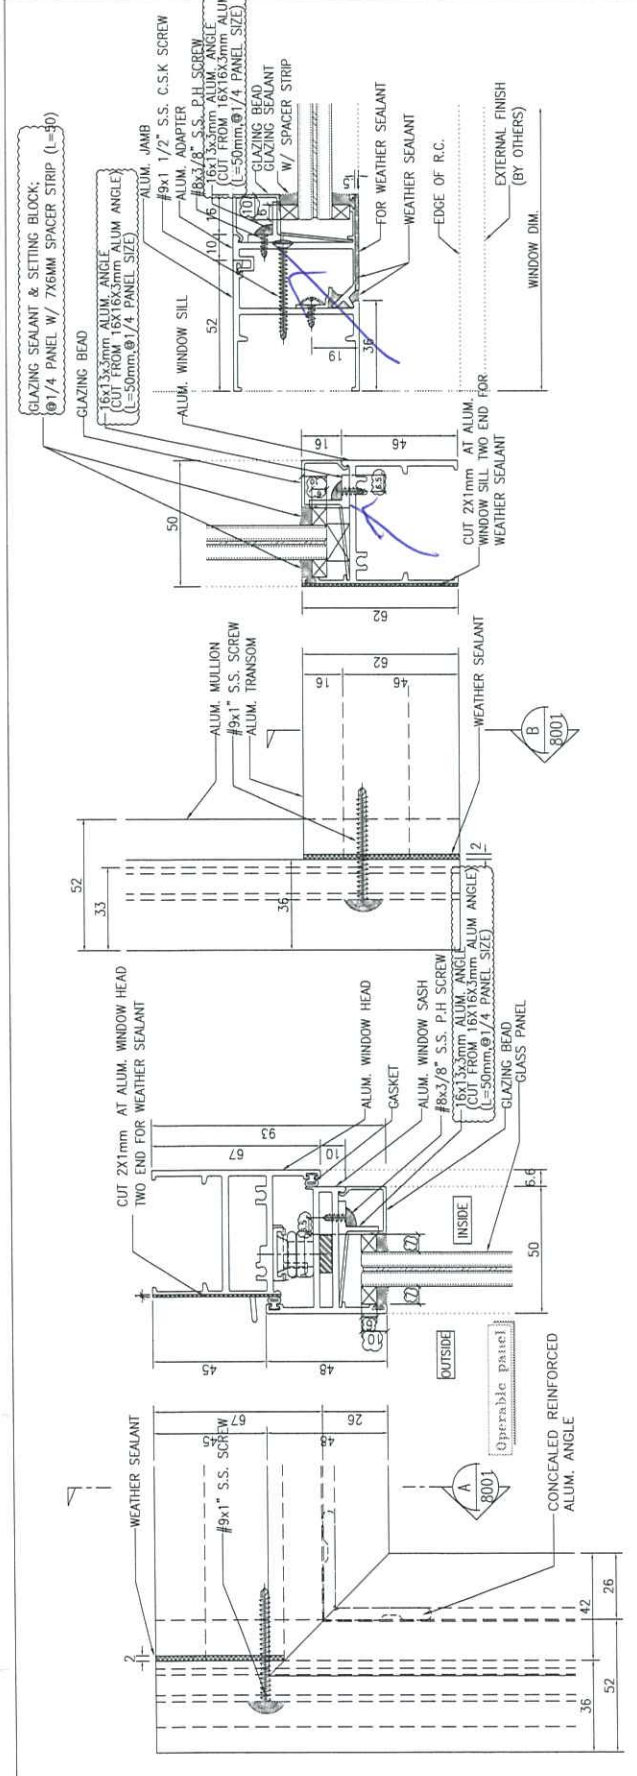

Handwritten signature and initials.

4 FRONT VIEW 8001

3 FRONT VIEW Mullion & Transom Fixing Detail 8001

1 HORIZONTAL DETAIL Mullion & Transom Fixing Detail 8001

A HORIZONTAL DETAIL 8001

2 HORIZONTAL DETAIL Mullion & Transom Fixing Detail 8001

B HORIZONTAL DETAIL 8001

5 VERTICAL DETAIL 8001

B.D. REF :

CLIENT : 怡和置業有限公司  
Sino Land Company Limited

ARCHITECT : Ronald Lu & Partners  
Ronald Lu & Partners (HK) Ltd.  
呂元祥建築師事務所 (香港) 有限公司

MAIN CONTRACTOR : Gammon

STRUCTURAL ENGINEER : AECOM

FAÇADE CONSULTANT: AECOM

NOTE:

1. ALL DIMENSIONS ARE IN mm.
2. ALL ELEVATIONS ARE VIEWED FROM OUTSIDE.
3. ALL DIMENSIONS TO BE VERIFIED ON SITE BEFORE FABRICATION.

LEGEND:

① -- DETAIL MARK NO.  
② -- REFER SHEET NO.  
③ -- FINISHED FLOOR LEVEL  
④ -- STRUCTURAL FLOOR LEVEL  
⑤ -- REVERSED DETAIL

NO.	DATE	REVISION	BY
E	25/07/21	REVISED AS PER COMMENTS	LS
D	25/05/21	REVISED AS PER COMMENTS	LS
C	07/04/21	REVISED AS PER COMMENTS	LS
B	25/01/21	REVISED AS PER COMMENTS	LS
A	23/12/21	REVISED AS PER COMMENTS	LS

JOB NO. : J-858

PROJECT : PROPOSED RESIDENTIAL DEVELOPMENT  
AT TOTTU 709P, PHASE 11, LOHAS PARK  
TSUNG KWAN O, N.T.


TITLE : TYPICAL MULLION DETAIL FOR CURTAIN WALL

DATE : 22-OCT-21 SCALE : 1:1 (A1)

DRAWN BY : CHECKED BY :

美特鋁質有限公司  
MIDI ALUMINUM MANUFACTURE LTD.  
Units 6-8, Sunny Industrial Centre, 1/F  
610 Chee Kwo Ling Road, Kowloon  
Tel: 2469211-4 Fax: (852) 277866

DWG NO. : J858-CW-013 REV. : E

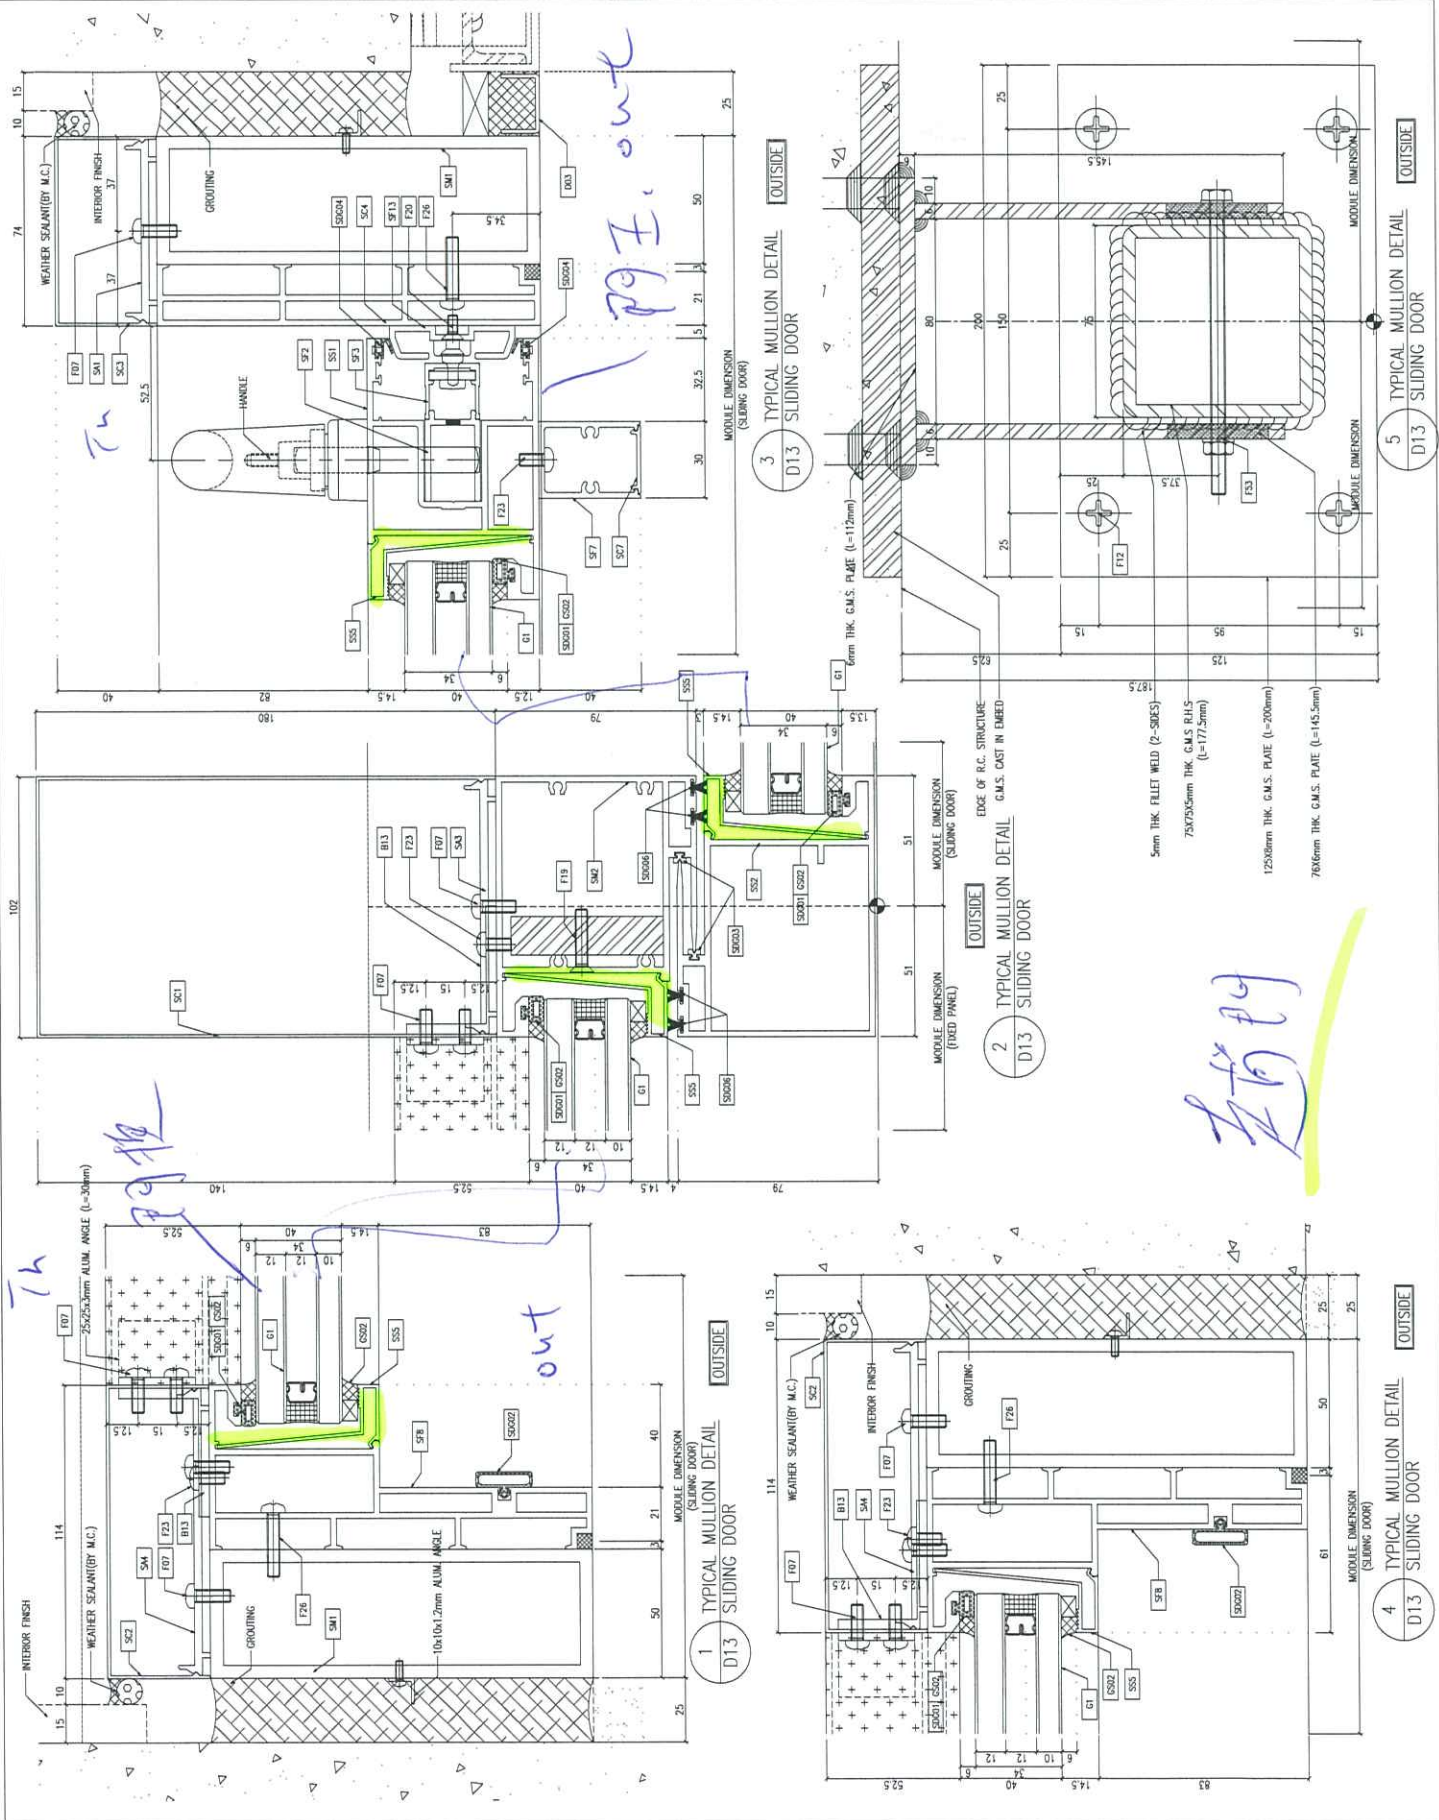

1 TYPICAL MULLION DETAIL D13 SLIDING DOOR

2 TYPICAL MULLION DETAIL D13 SLIDING DOOR

3 TYPICAL MULLION DETAIL D13 SLIDING DOOR

4 TYPICAL MULLION DETAIL D13 SLIDING DOOR

5 TYPICAL MULLION DETAIL D13 SLIDING DOOR

