



工程指示 / 要求簡箋(E.I.)

工程指示編號：EI / 5594 / 23

修改版次：

工程編號：J - 858

工程名稱：將軍澳日出康城 LP 11

工程項目：單元架安全標示

收件人：生統

發件人：Helen Chak

日期：06/01/2023

□要求提供 / □確認 事項：

1.請在吊耳噴季節顏色:1月至3月 藍色;4月至6月待通知;

2. T-7 架 S.W.L 單元總重:2 T 及 4 支企柱都要白膠紙注明架號，安全負重 S.W.L(與證書吻合)及實際單元總重量。

請在 2023.01.10 前完成上列要求。

附：頁

 原合約工程包 原合約工程加 / 減賬 新工程報價

分發 拆圖 ()BUN □連附件

分發東莞各部門：

()生產技術總監 □連附件 ()技術部 □連附件 ()生產部 □連附件 ()機械設計部 □連附件

()採購部 □連附件 (✓)生產統籌部 ☑連附件 (✓)小羅&清 ☑連附件

()質檢部 □連附件 ()會計部 □連附件 ()報關組 □連附件 (✓)其他 水洪 ☑連附件

分發香港各部門：

()行政部□連附件 ()會計部□連附件 ()統籌部□連附件 (✓)工程部地盤科文 積哥 ☑連附件

()採購部□連附件 ()QS 部 □連附件 ()維修部□連附件 ()其他 _____ □連附件

傳遞編號：

發件人簽署：

HK 0027 / 23

項目經理簽署：

Interface in vivo
CP
危險
DANGER
2728 8333



← 吊耳噴
季節顏色
1月~3月藍色
4月~6月待通知

858

T-7 架

S.W.L

2T

(單元總重)

← 4支企柱
都要白膠紙
注明架號, 空鎮
重 S.W.L (與證書
吻合)
及實際單元總重量

CERT. NO. MID-220927-01

FORM 6

[reg. 18(1)(d)]

[規例第 18(1)(d)條]

FACTORIES AND INDUSTRIAL UNDERTAKINGS (LIFTING APPLIANCES AND LIFTING GEAR) REGULATIONS

**CERTIFICATE OF TEST AND THOROUGH EXAMINATION OF
CHAINS, ROPES AND LIFTING GEAR**

*Form approved by the Commissioner for Labour for the purposes of regulation 18(1)&(d) of the Factories and
Industrial Undertakings (Lifting Appliances and Lifting Gear) Regulations*

工廠及工業經營 (起重機械及起重裝置) 規例

鏈條、纜索及起重裝置的測試及徹底檢驗結果證明書 ORIGINAL

本表格乃由勞工處處長就工廠及工業經營 (起重機械及起重裝置) 規例第 18 (1) (d) 條的需要而認可

Name of owner and address of installation of the chain, rope or lifting gear tested and examined. 接受測試及檢驗的鏈條、纜索或起重裝置的擁有人姓名及安裝地址		MIDI Aluminum Fabricator Ltd.	
Description of chain, rope or lifting gear tested and distinguishing mark 接受測試的鏈條、纜索或起重裝置的說明及識別標誌	Test load applied (tonnes) 測試時所使用的負荷 (以公噸為單位)	Safe working load (tonnes) 安全操作負荷 (以公噸為單位)	Defects noted If none, enter "None" and state whether in safe working order. 註明所發現的毛病，如無不妥，則填「無」字並註明是否處於安全操作狀態。
<p>" Lifting Frame "</p> <p>Lifting rectangular frame constructed of 100mm x 48mm U-channel at bottom and four (4) 100mm x 58mm U-channel vertical member with 40mm dia. hole on top for lifting. Side member adjustable from 1320mm to 1680mm and fixed by four (4) pairs of bolt and nut.</p> <p>Length : 2,500mm Height : 1,370mm Width : 1,320mm to 1,680mm Owner's No. : T-1, T-2, T-3, T-4, T-5, T-6, T-7, T-8, T-9, T-10. Quantity : 10 sets</p>	4 T (per set)	2 T (per set)	None In Safe Working Order

I hereby certify that on September 27, 2022 the gear described in this certificate was tested and
茲證明本人曾於 年 月 日 依照附表 1 的規定測試及徹底檢驗本證書所指的
thoroughly examined by me in accordance with the First Schedule and that the above particulars are correct.
起重裝置，且上述各項均屬確實無訛。

Signature of Registered Professional Engineer

註冊專業工程師簽署


Ng Shu Man (RP0744470)

Qualification

R.P.E.

註冊資格

Discipline

MNA

註冊界別

Person or firm by whom person conducting the test
and examination is employed

僱用執行此項測試及檢驗的人士或商號

泰豐 (11) 顧問有限公司
Time Pacific (11) Consultants Ltd.
P.O. Box No. 183,
Tsuen Wan Post Office,
Tsuen Wan, N.T.
Tel : 2498 6130 Fax : 2498 6160




Date of certificate

September 27, 2022

簽發日期

Any competent examiner or competent person who delivers to an owner a certificate or makes a report which is to his knowledge false as to a material particular shall be guilty of an offence and shall be liable on conviction to a fine of \$200,000 and to imprisonment for 12 months.

任何合資格檢驗員或合資格的人，如向擁有人交付他明知有任何要項屬虛假的證明書或作出他明知有任何要項屬虛假的報告，即屬犯罪：一經定罪，可處罰款二十萬元及監禁十二個月。

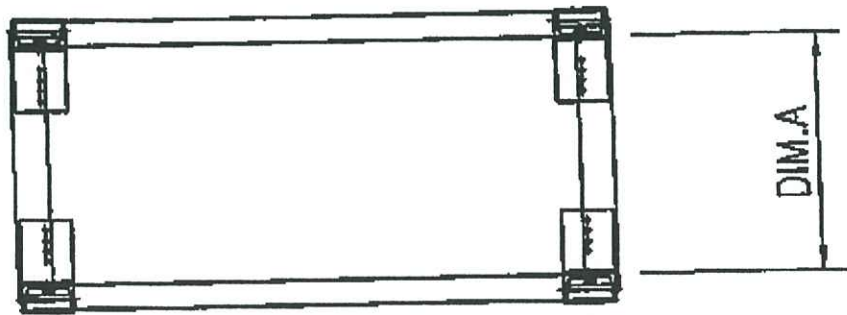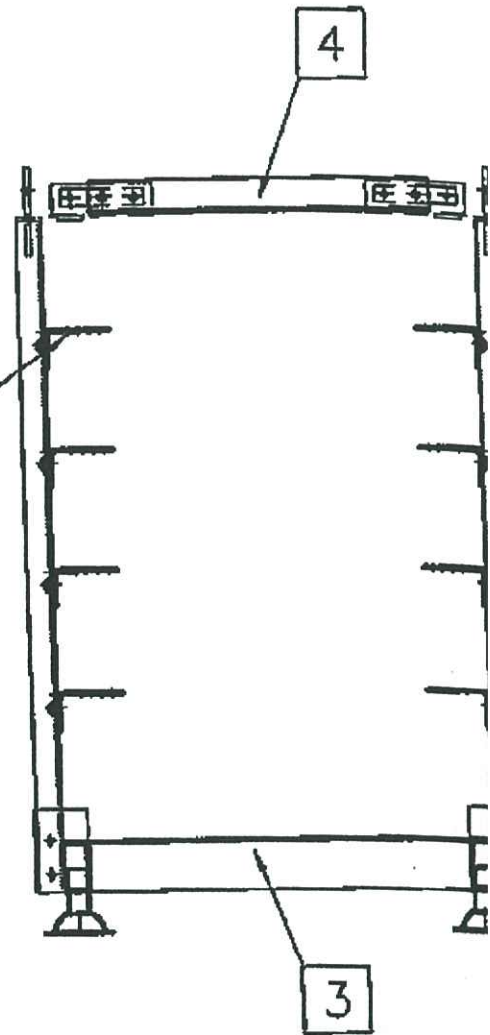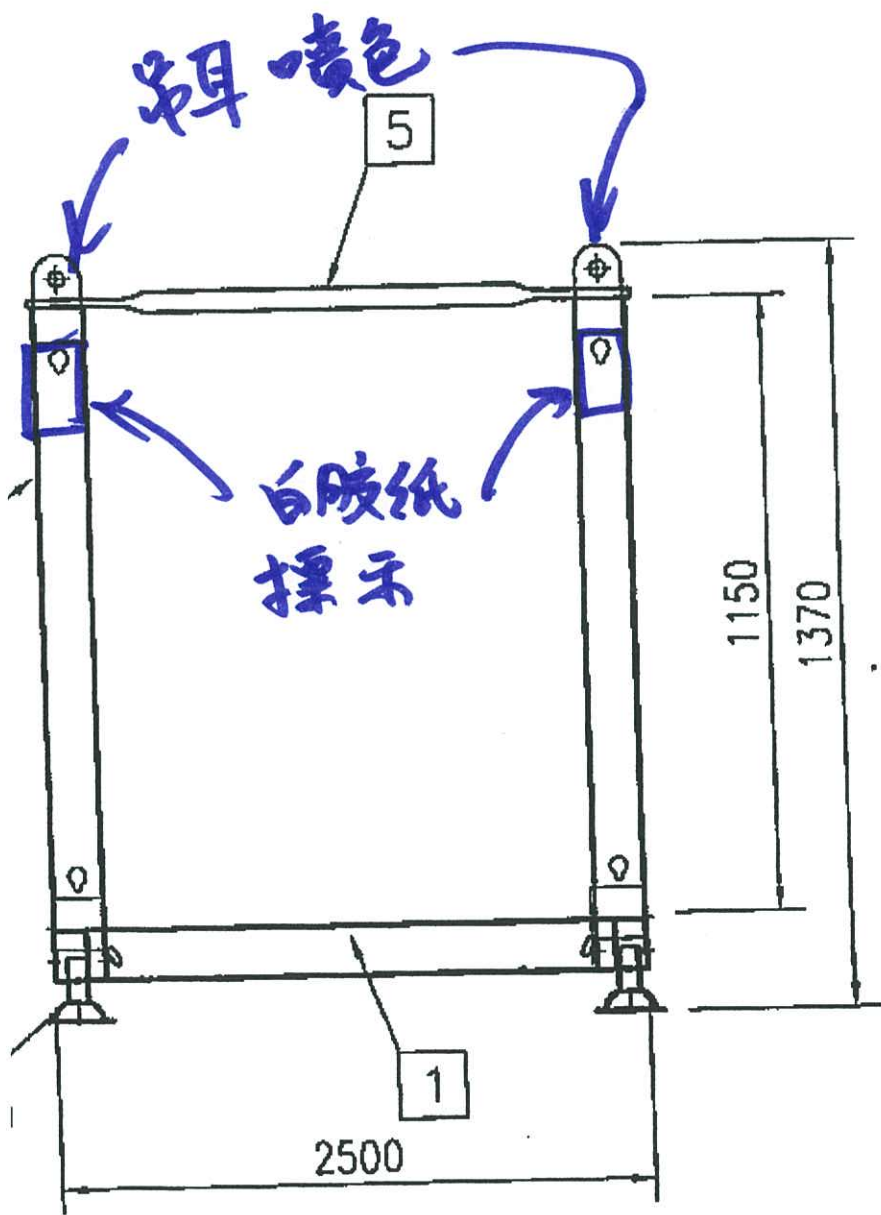

DIM.A	NOTE
1320	ROR 722 (1270)
1440	
1560	FOR 728 (1494)
1680	FOR 728 (1584)

新增.