



工程指示 / 要求簡箋(E.I.)

工程指示編號：EI / 5614 / 23

修改版次：A

工程編號：J - 858

工程名稱：將軍澳日出康城 11

工程項目：偏林箱 拆圖和生產 (加雀網)

收件人：生統 / 鈹金

發件人：Helen Chak

日期：16/02/2023

要求提供 /  確認 事項：

- |                                    |                                     |                               |
|------------------------------------|-------------------------------------|-------------------------------|
| <input type="checkbox"/> 初步鋁料 B.M. | <input type="checkbox"/> 加工拆圖，然後生產  | <input type="checkbox"/> 尺寸表  |
| <input type="checkbox"/> 正式鋁料 B.M. | <input type="checkbox"/> 技術上資料 / 指示 | <input type="checkbox"/> 報價   |
| <input type="checkbox"/> 配件 B.M.   | <input type="checkbox"/> 樣辦或貨品說明書   | <input type="checkbox"/> 分判合約 |
- 內容：

**A: 按顧問要求，需要加雀網。請按附件修改 拆圖  
請鈹金廠拆圖。**

**EI4866 已報價確認，鈹金拆圖和生產。**

**所有偏林箱，需要鉻化。3mm 厚**

請在 2023.01.13 前完成上列要求。

附： 頁

原合約工程包

原合約工程加 / 減賬

新工程報價

Bun

分發東莞各部門：

- |  |   |  |  |
|--|---|--|--|
| <input type="checkbox"/> 生產技術總監 <input type="checkbox"/> 連附件 | <input checked="" type="checkbox"/> 技術部 <input checked="" type="checkbox"/> 連附件   | <input type="checkbox"/> 生產部 <input type="checkbox"/> 連附件                          | <input type="checkbox"/> 機械設計部 <input type="checkbox"/> 連附件                        |
| <input type="checkbox"/> 採購部 <input type="checkbox"/> 連附件    | <input checked="" type="checkbox"/> 生產統籌部 <input checked="" type="checkbox"/> 連附件 | <input checked="" type="checkbox"/> 小羅 & 清 <input checked="" type="checkbox"/> 連附件 |  |
| <input type="checkbox"/> 質檢部 <input type="checkbox"/> 連附件    | <input type="checkbox"/> 會計部 <input type="checkbox"/> 連附件                         | <input type="checkbox"/> 報關組 <input type="checkbox"/> 連附件                          | <input checked="" type="checkbox"/> 其他 楊榮輝 <input checked="" type="checkbox"/> 連附件 |

分發香港各部門：

- |   |  |   |  |
|---|--|---|--|
| <input type="checkbox"/> 行政部 <input type="checkbox"/> 連附件 | <input type="checkbox"/> 會計部 <input type="checkbox"/> 連附件  | <input type="checkbox"/> 統籌部 <input type="checkbox"/> 連附件 | <input checked="" type="checkbox"/> 工程部地盤科文 積哥 <input checked="" type="checkbox"/> 連附件 |
| <input type="checkbox"/> 採購部 <input type="checkbox"/> 連附件 | <input type="checkbox"/> QS 部 <input type="checkbox"/> 連附件 | <input type="checkbox"/> 維修部 <input type="checkbox"/> 連附件 | <input type="checkbox"/> 其他 _____ <input type="checkbox"/> 連附件                         |

傳遞編號：

HK 249 / 23


發件人簽署：

項目經理簽署：




美特鋁質有限公司  
MIDI Aluminium Fabricator Ltd.

類別		物料號	
制圖	胡冬雲	2023.1.10	圖號 858-PL-BOX01
修改	-	-	數量 146+4(後備)=150
日期	-	-	位置
復核	-	-	
批准			

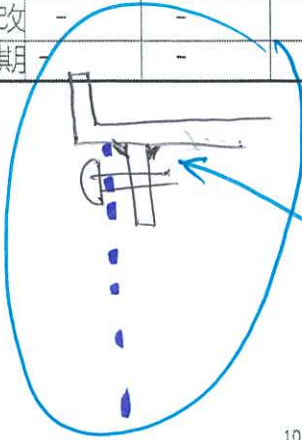


可用此圖

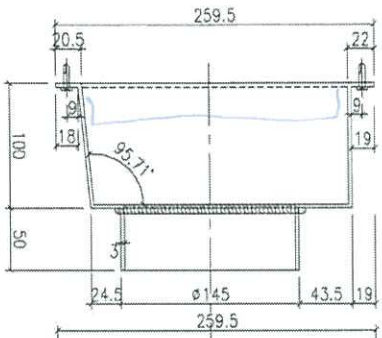


先打

145/16

145/16

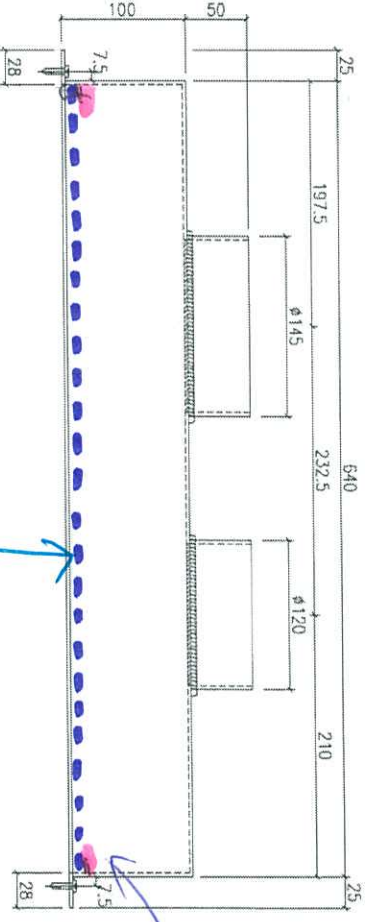

加多條

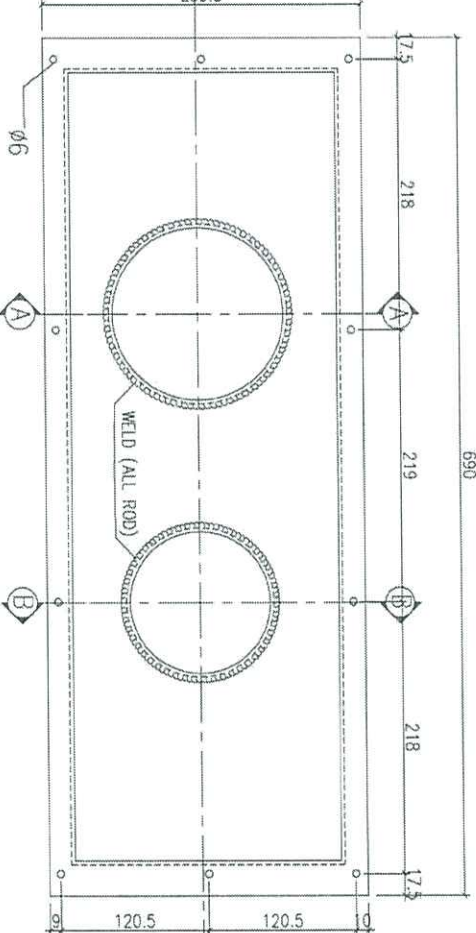


WELD (ALL ROD)

網眼 10x

線粗 2mm

加多條  
P.H.H  
145/16

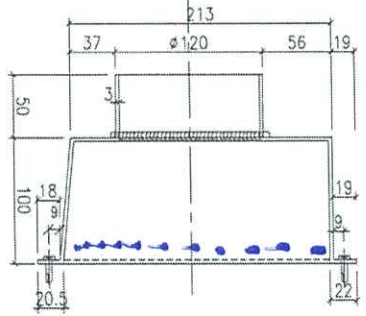

工程號	J-858	地盤	將軍澳日出康城11
名稱	偏林箱加工圖	採用	
材料	3mm厚鋁板	地盤	
顏	鉻化	工廠	

附件

E. Electrical Continuity

1. The Facade System shall be designed and constructed to achieve electrical continuity, with electrical bonding locations tied to main electrical system.
2. The Electrical Contractor shall provide a main earth grounding terminal at the highest and lowest floor for each face of the curtain wall. The Façade Contractor shall make electrical connection between these terminals and the Facade System and insure that the metallic structural framework of the curtain wall is electrically continuous by itself
3. The equipotential bonding conductor shall have a cross-sectional area of not less than 25mm<sup>2</sup> copper equivalent.

F. Operable Doors and Hinges

1. Door hinges shall be Hahn VL – Band AL concealed hinges or Architect approved equivalent.
2. Door should be fitted with multi-point locks or at least 3-point locks. Door locks and handles shall be Dorma or Architect approved equivalent. Locking mechanisms shall be Chubb or Architect approved equivalent and shall be based on a Master-Keying System.
3. All hardware shall be Grade 304 or 316 Stainless Steel of Architect specified finish.
4. All doors shall have a Grade 316 Stainless Steel kicker plate of at least 150mm height unless otherwise specified.
5. Doors with panic bolt requirement shall be 3 point lock.
6. Doors with access control requirement shall be provided.

G. Louvres

1. Louvres:
  - a) Shall be proprietary product and consist of proprietary extruded aluminium blades.
  - b) Blade ends shall be welded or fastened to the framing members with concealed stainless steel fasteners. Pop rivets are not acceptable.
  - c) Provide concealed aluminium or stainless steel stiffeners for blades so that the blade deflection perpendicular to blade principle axis does not exceed  $l/180$  of the span at design pressures. Assume that pressure acts perpendicular to the plane formed by the corners of the perimeter frame and that the tributary area for one blade equals its projected area on the same plane. Stiffeners and other supporting items which may be viewed from below must be finished to match the louvre blades.
  - d) All louvres are considered as inactive unless indicated otherwise. As such, all louvres shall be provided with 3mm minimum thickness (nominal, thickness dependent upon loading) painted aluminium blank off panels in black colour or as chosen by the Architect.
  - e) Unless otherwise approved, external louvres or louvres subject to wind and weather shall incorporate two stage blade design to ensure weatherproofing.
  - f) Louvre assemblies shall be self-draining with internal drainage channels and outlets as required.
  - g) Where louvres are made active, by either removal of blank-off panels, or cutting holes in same, the Facade Contractor shall provide and attach to the blank off panel and/or louvre frame with stainless steel or aluminium bird screen mesh in all active areas of the louvres.
    - i) Provide approved concealed 1.4401-grade stainless steel insect wire mesh to the interior of all functional active louver assemblies (architectural and performance louvers). Aluminium wire mesh with black PVDF coating is required for decorative louvre in active areas.
    - ii) Mesh wire shall have a minimum diameter of 2mm.
    - iii) The openings within the mesh shall be 10mm square.

Handwritten notes in Chinese: 加蓋鋼網 (Add stainless steel mesh), 不銹鋼 1.4401 網 (Stainless steel 1.4401 mesh), 10mm 網 (10mm mesh), 鳥籠 (Bird cage), 噴塗 (Spray coating).