

工程指示 / 要求簡箋(E.I.)

工程指示編號：EI / 5635 / 24

修改版次：K

工程編號：J - 858

工程名稱：將軍澳日出康城 11

工程項目：幕牆 特色層室外收口鋁板 放行 AQ51-55, AQ56-57 修改 地盤用

收件人：生統

發件人：Paul Wong

日期：15/01/2024

內容

K 版: 放行 AQ51-55, 不用加力骨, 不用棉, 請按最新版本圖紙生產。
AQ56, 57 不用加力骨, 不用棉, 在廠未出貨的, 先修改好才出貨。

J 版: 因應鋁板底下有通長鐵角。加力骨阻安裝

1. EI5635 AQ78, AQ80 不用加力骨
2. AQ79 的加力骨加, 加開避位 70x14 mm, 平耳仔鋁角邊
3. AQ-81 為隔火層用, 是加開避位的
4. AQ 75,76,77 已出貨, 不修改
5. 現時送貨目前 T1 送貨 16F, T2 送貨 20F, T3 送貨 20F
6. 現時加力骨生產開料到 40/F
7. 未出貨的在廠改

I 版: 由於先前的 F 版: 因應業主 Comment, 轉角位置的暫停噴色,
現改噴色 AQ-14,15,19,20,37。用深銅色。

T2,T3: 請用深銅色出貨 (優先噴 T2, 急要)。

T1 的已出貨: 要重做。

EI5901 已批色板用色油 ECD3W04976S-JF2

附 2023.06.24 Email

拆圖: 請也留意

請在 2024.01.22 前完成上列要求。

附： 頁
分發東莞各部門：

- | | | | | | | | |
|------------|------------------------------|-----------|-----------------------------------------|----------|-----------------------------------------|-----------|------------------------------------|
| () 生產技術總監 | <input type="checkbox"/> 連附件 | (✓) 技術部 | <input checked="" type="checkbox"/> 連附件 | () 生產部 | <input type="checkbox"/> 連附件 | () 機械設計部 | <input type="checkbox"/> 連附件 |
| () 採購部 | <input type="checkbox"/> 連附件 | (✓) 生產統籌部 | <input checked="" type="checkbox"/> 連附件 | (✓) 小羅&清 | <input checked="" type="checkbox"/> 連附件 | | |
| () 質檢部 | <input type="checkbox"/> 連附件 | () 會計部 | <input type="checkbox"/> 連附件 | () 報關組 | <input type="checkbox"/> 連附件 | () 其他 | _____ <input type="checkbox"/> 連附件 |

分發香港各部門：


- | | | | | | | | | |
|---------|------------------------------|----------|------------------------------|---------|------------------------------|-------------|-------|-----------------------------------------|
| () 行政部 | <input type="checkbox"/> 連附件 | () 會計部 | <input type="checkbox"/> 連附件 | () 統籌部 | <input type="checkbox"/> 連附件 | (✓) 工程部地盤科文 | 積哥 | <input checked="" type="checkbox"/> 連附件 |
| () 採購部 | <input type="checkbox"/> 連附件 | () QS 部 | <input type="checkbox"/> 連附件 | () 維修部 | <input type="checkbox"/> 連附件 | () 其他 | _____ | <input type="checkbox"/> 連附件 |

傳遞編號：

HK 0077 / 24




發件人簽署：

項目經理簽署：

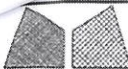

美特鋁質有限公司
MIDI Aluminium Fabricator Ltd.

工程號	J858	類別		物料號	-		
地盤	康城11期	制圖	W. E. X	2022-11-11	圖號	AQ-51	
修改	-	採用工廠	地盤	✓	圖紙名稱	鋁板加工圖	
日期	-	材料顏色	PVF2 (香檳金)	材料	3.0mm 鋁板	數量	-
						單件重量	- (KG)

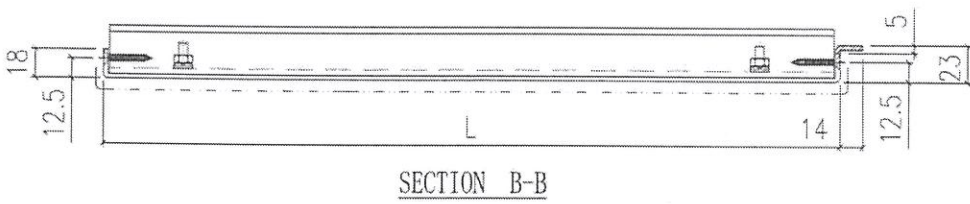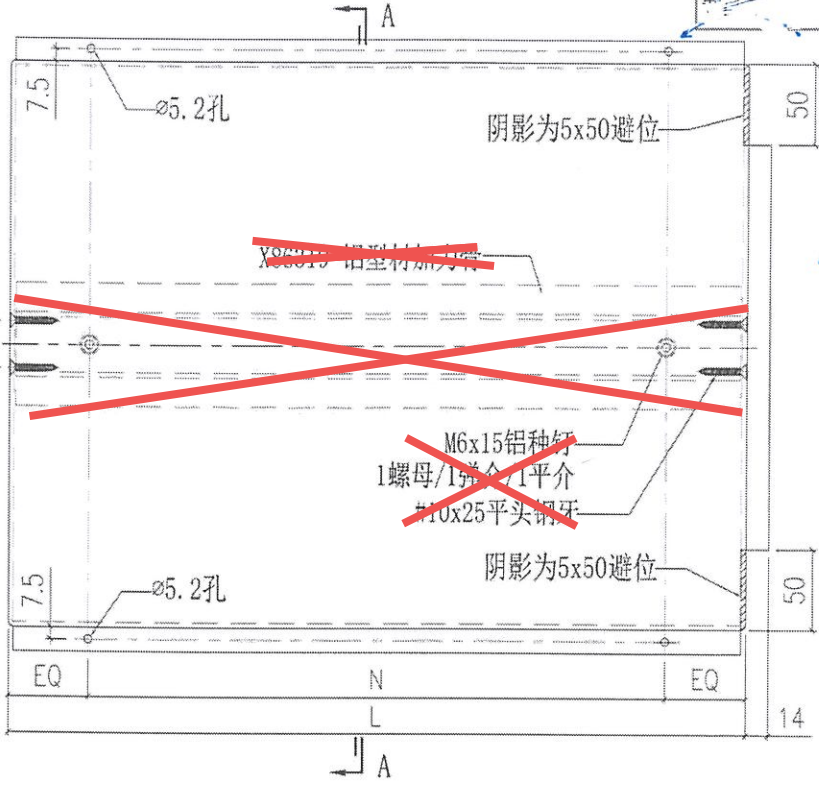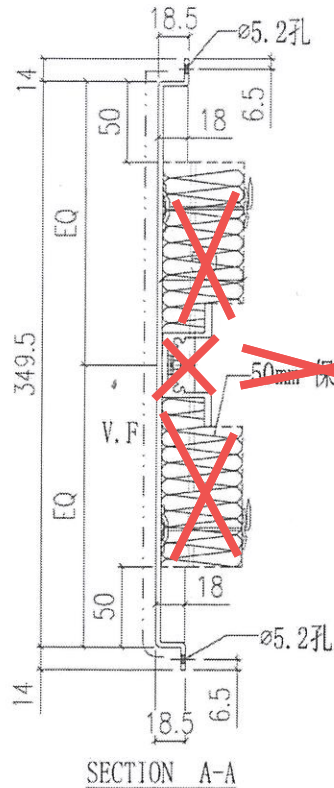


放行

AQ-51-23	800	@300c/cx2	1	
AQ-51-22	-	-	-	
AQ-51-21	599	@250c/cx2	1	暫停
AQ-51-20	1575	@300c/cx5	1	
AQ-51-19	735	@300c/cx2	2	
AQ-51-18	897.5	@300c/cx2	1	
AQ-51-17	1641	@300c/cx5	2	
AQ-51-16	1747.5	@300c/cx5	1	
AQ-51-15	745	@300c/cx2	2	
AQ-51-14	1566	@300c/cx5	1	
AQ-51-13	1616	@300c/cx5	1	
AQ-51-12	1410	@300c/cx4	2	
AQ-51-11	1294	@300c/cx4	3	
AQ-51-10	666	@300c/cx2	19	
AQ-51-09	1347.5	@300c/cx4	9	
AQ-51-08	1385	@300c/cx4	3	
AQ-51-07	1547.5	@280c/cx5	3	
AQ-51-06	685	@300c/cx2	20	
AQ-51-05	872.5	@300c/cx2	3	
AQ-51-04	1697.5	@300c/cx5	1	
AQ-51-03	775	@300c/cx2	3	
AQ-51-02	795	@300c/cx2	1	
AQ-51-01	594	@250c/cx2	3	
編號	L	N	合計數量	


不用加力骨，
不用棉

9/11

 美特鋁質有限公司 MIDI Aluminium Fabricator Ltd.			工程號 J858 地盘 康城11期	類別 制圖 W. E. X	物料號 - 2022-11-11	圖號 AQ-52
修改 - - - 日期 - - -	採用工廠 <input checked="" type="checkbox"/> 地盤 <input checked="" type="checkbox"/> 材料颜色 PVF2 (香槟金)	图纸名称 铝板加工图 材料 3.0mm 铝板	復核 - - 批准 - -	數量 - 單件重量 - (KG)		

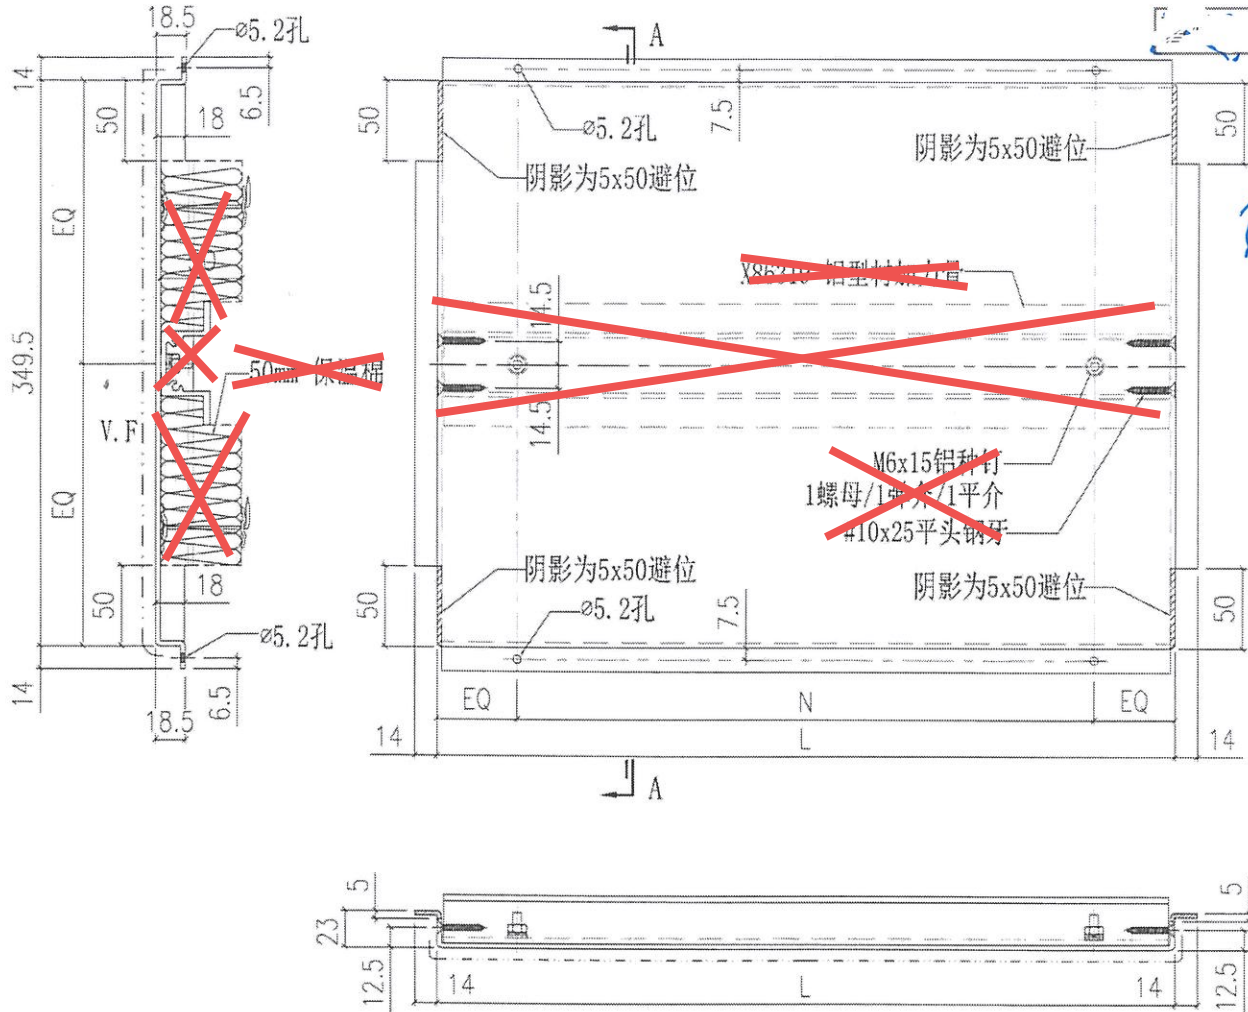


放行

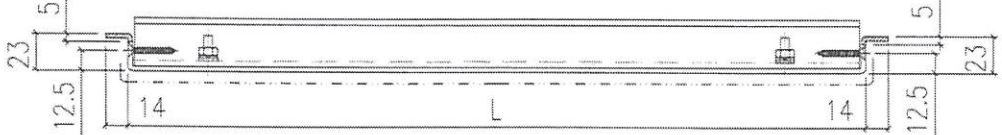

SECTION B-B




不用加力骨，
不用棉

AQ-52-15	1435	@300c/cx4	1
AQ-52-14	1430	@300c/cx4	1
AQ-52-13	599	@250c/cx2	1
AQ-52-12	1709	@300c/cx5	2
AQ-52-11	735	@300c/cx2	1
AQ-52-10	1712.5	@300c/cx5	1
AQ-52-09	1765	@300c/cx5	1
AQ-52-08	1311	@300c/cx4	2
AQ-52-07	1840	@280c/cx6	2
AQ-52-06	685	@300c/cx2	3
AQ-52-05	1230	@280c/cx4	4
AQ-52-04	1684	@300c/cx5	1
AQ-52-03	1347.5	@300c/cx4	10
AQ-52-02	1815	@280c/cx6	1
AQ-52-01	594	@250c/cx2	3
编号	L	N	合计数量

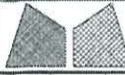

美特鋁質有限公司
MIDI Aluminium Fabricator Ltd.

工程號	J858	類別		物料號	-
地盘	康城11期	制圖	W. E. X	2022-11-11	圖號 AQ-53
修改	-	採用工廠	✓	地盤	✓
日期	-	材料颜色	PVF2 (香槟金)	图纸名称	铝板加工图
				復核	-
				批准	-
				數量	-
				單件重量	- (KG)

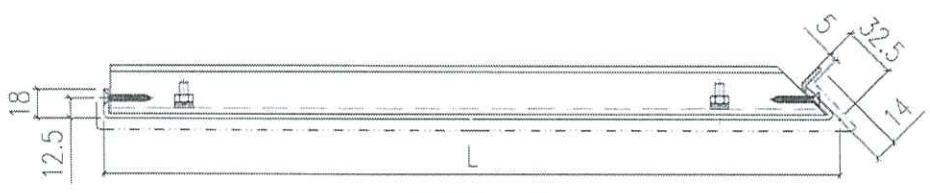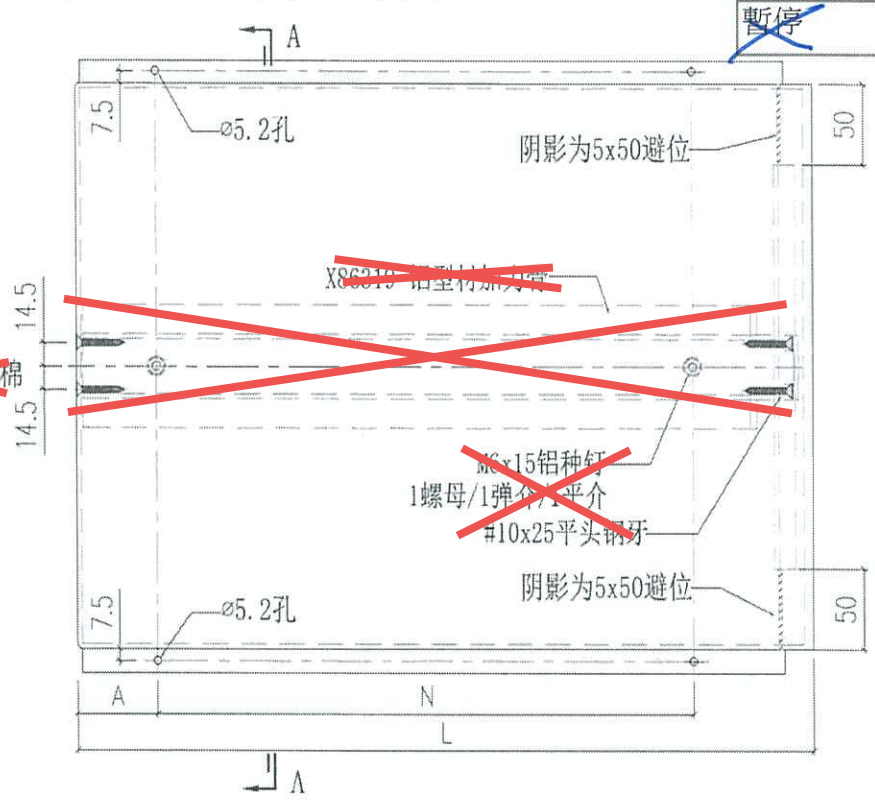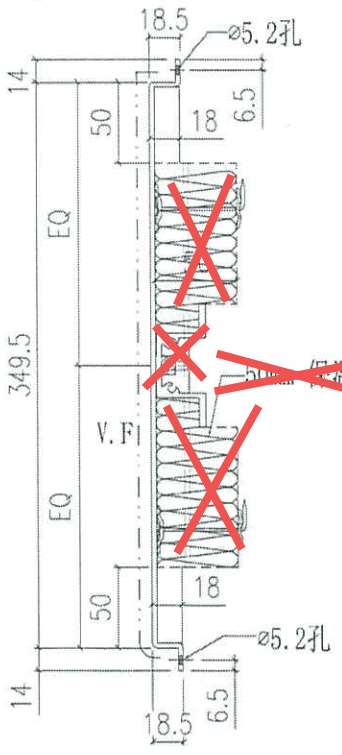


SECTION B-B

放行




不用加力骨，
不用棉

AQ-53-01	1838	@280c/cx6	75	5
编号	L	N	A	合计数量

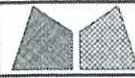

美特鋁質有限公司
MIDI Aluminium Fabricator Ltd.

工程號	J858	類別		物料號	-						
地盤	康城11期	制圖	W. E. X	2022-11-11	圖號	AQ-54					
修改	-	採用工廠	✓	地盤	✓	圖紙名稱	铝板加工图	復核	-	數量	-
日期	-	材料顏色	PVF2 (香槟金)	材料	3.0mm 铝板	批准	-	單件重量	-	(KG)	

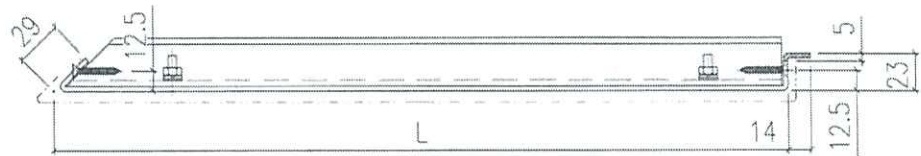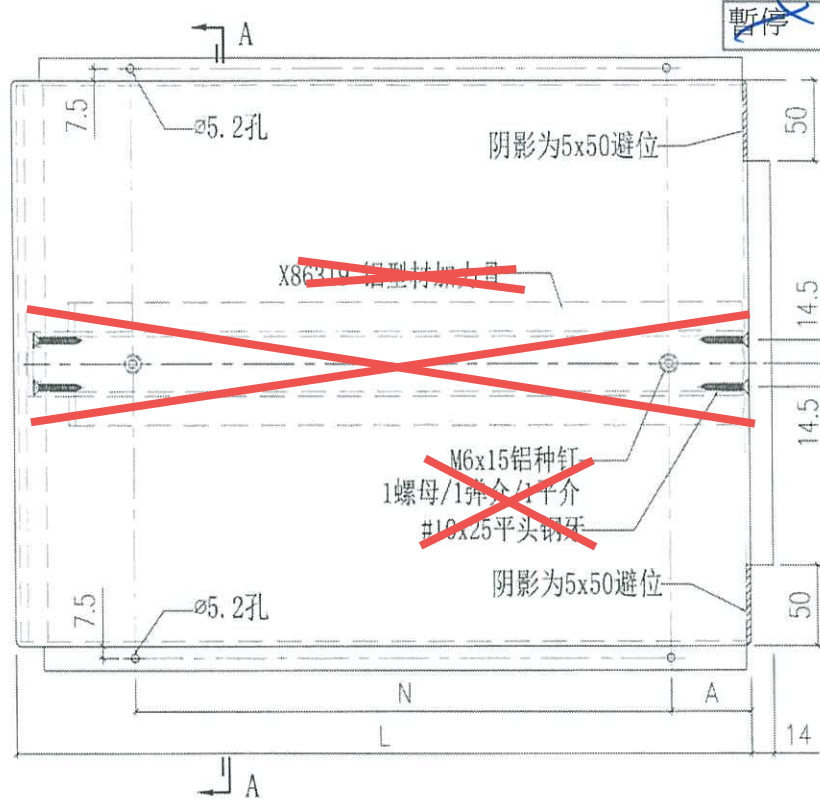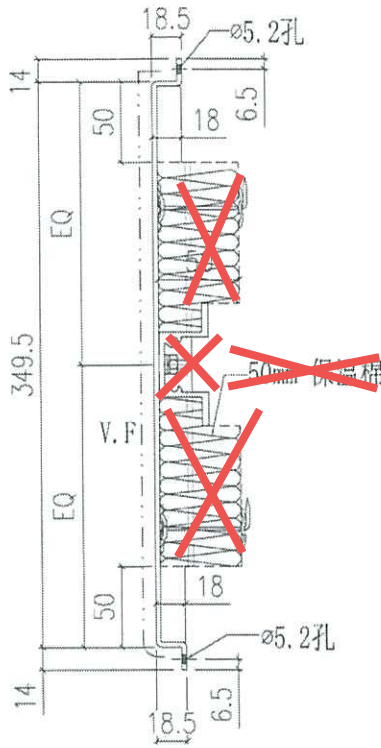


SECTION B-B

不用加力骨，
不用棉


放行

AQ-54-04	1828	@280c/cx6	75	1
AQ-54-03	1819	@280c/cx6	75	2
AQ-54-02	747	@300c/cx2	75	6
AQ-54-01	1838	@280c/cx6	75	1
编号	L	N	A	楼层

 美特铝质有限公司 MIDI Aluminium Fabricator Ltd			工程號 J858 地盘 康城11期	類別 制圖 W. E. X	物料號 - 2022-11-11	圖號 AQ-55
修改 - - - 日期 - - -	採用工廠  地盤 	图纸名称 铝板加工图	復核 - - 批准 - -	數量 - 單件重量 - (KG)		
材料颜色 PVF2 (香槟金)		材料 3.0mm 铝板				

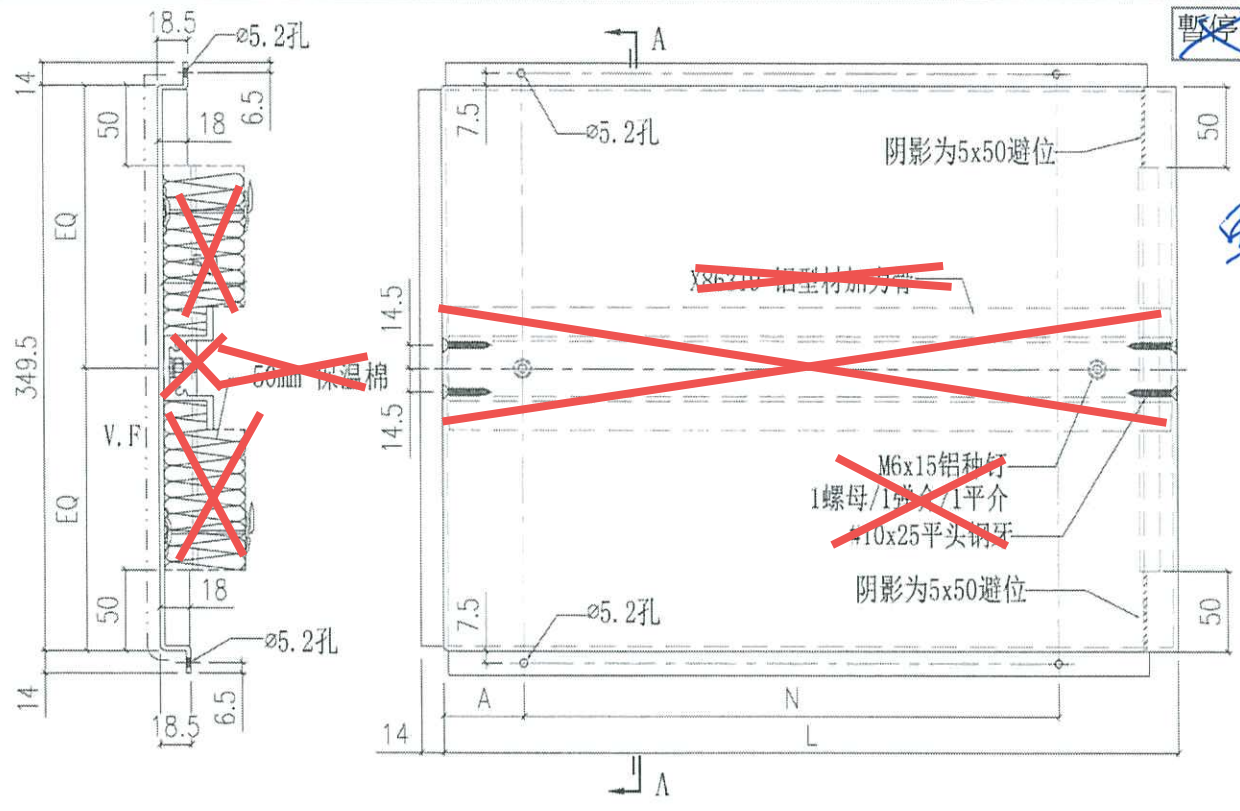

放行

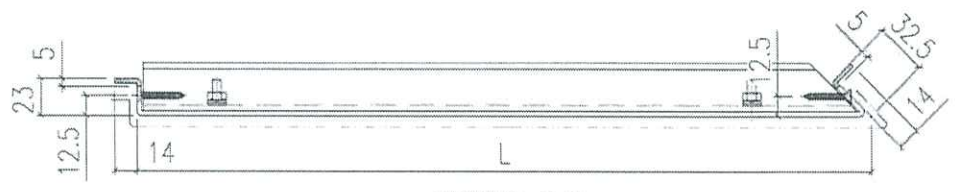

SECTION B-B




不用加力骨，
不用棉

AQ-55-03	819.5	@300c/cx2	75	1	暂停
AQ-55-02	1807	@280c/cx6	75	1	
AQ-55-01	747	@300c/cx2	75	3	
编号	L	N	A	楼层	

 美特铝质有限公司 MIDI Aluminium Fabricator Ltd.				工程號	J858	類別		物料號	-				
				地盘	康城11期	制圖	W. E. X	2022-11-11	圖號	AQ-56			
修改	-	-	-	採用工廠	<input checked="" type="checkbox"/>	地盤	<input checked="" type="checkbox"/>	图纸名称	铝板加工图	復核	-	數量	-
日期	-	-	-	材料颜色	PW2 (香槟金)	材料	3.0mm 铝板	批准	-	-	單件重量	-	(KG)

暫停


放行

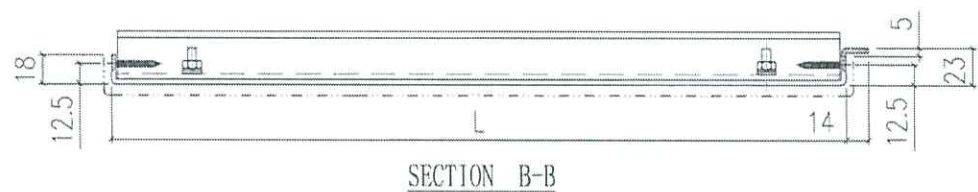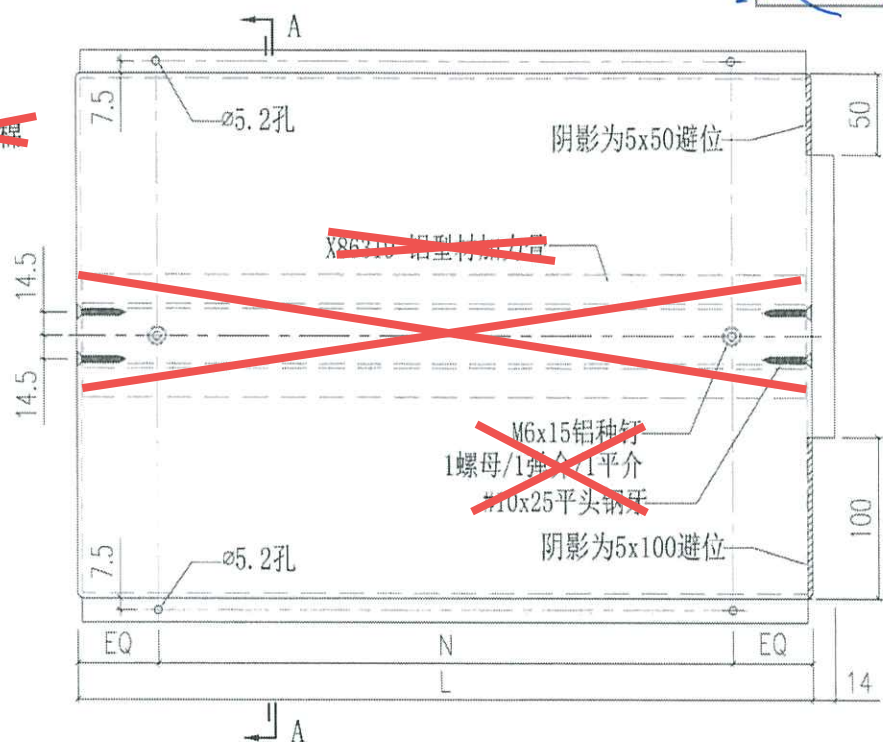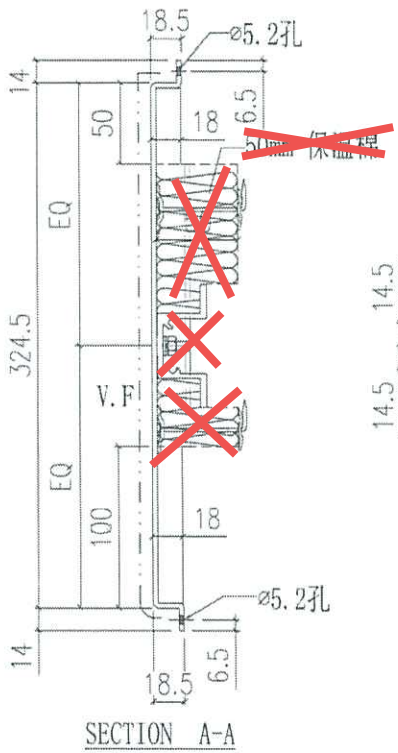

不用加力骨，
不用棉

AQ-56-09	1098	@300c/cx3	2
AQ-56-08	-	-	-
AQ-56-07	792.5	@300c/cx2	2
AQ-56-06	998	@300c/cx3	12
AQ-56-05	988	@300c/cx3	8
AQ-56-04	970	@300c/cx3	24
AQ-56-03	997	@300c/cx3	84
AQ-56-02	1008	@300c/cx3	12
AQ-56-01	992	@300c/cx3	12
编号	L	N1	数量

 美特鋁質有限公司 MIDI Aluminium Fabricator Ltd.		工程號 J858 地盘 康城11期 图纸名称 铝板加工图 材料 3.0mm 铝板	類別 制圖 W. E. X 復核 - 批准 -	物料號 - 2022-11-11 - -	圖號 AQ-57 數量 - 單件重量 - (KG)
修改	-	採用工廠 <input checked="" type="checkbox"/> 地盘 <input checked="" type="checkbox"/>	日期	-	材料颜色 PV2 (香槟金)

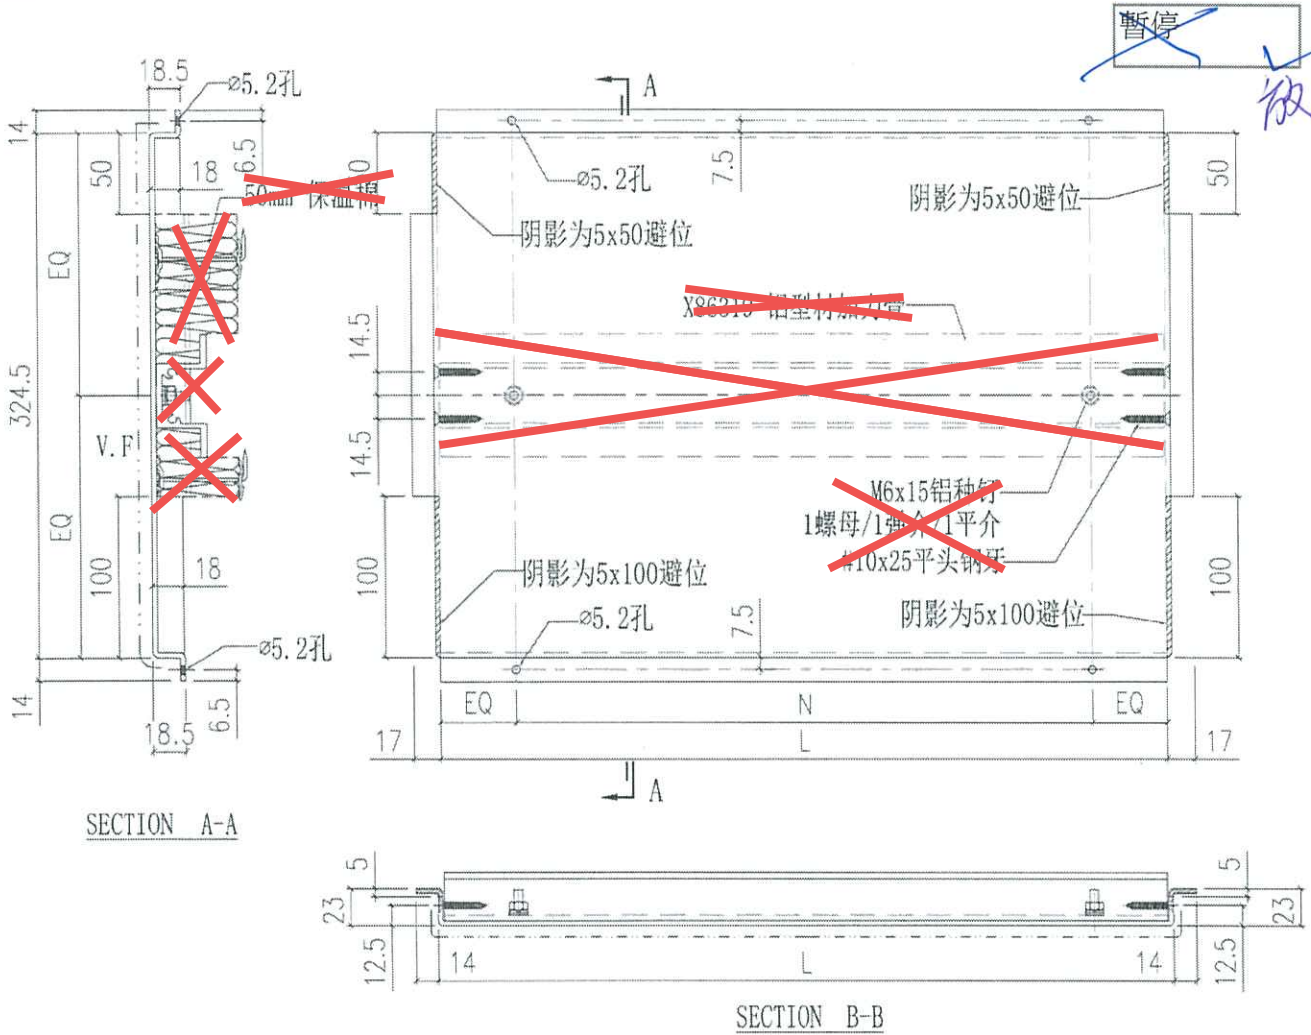

不用加力骨，
不用棉


AQ-57-09	1098	@300c/cx3	2
AQ-57-08	968	@300c/cx3	4
AQ-57-07	-	-	-
AQ-57-06	998	@300c/cx3	4
AQ-57-05	988	@300c/cx3	4
AQ-57-04	970	@300c/cx3	12
AQ-57-03	997	@300c/cx3	42
AQ-57-02	1008	@300c/cx3	6
AQ-57-01	992	@300c/cx3	6
编号	L	N1	数量

T3B-CW3 (a)

AG-57-03

T3B-CW6 (b)

AG-57-03

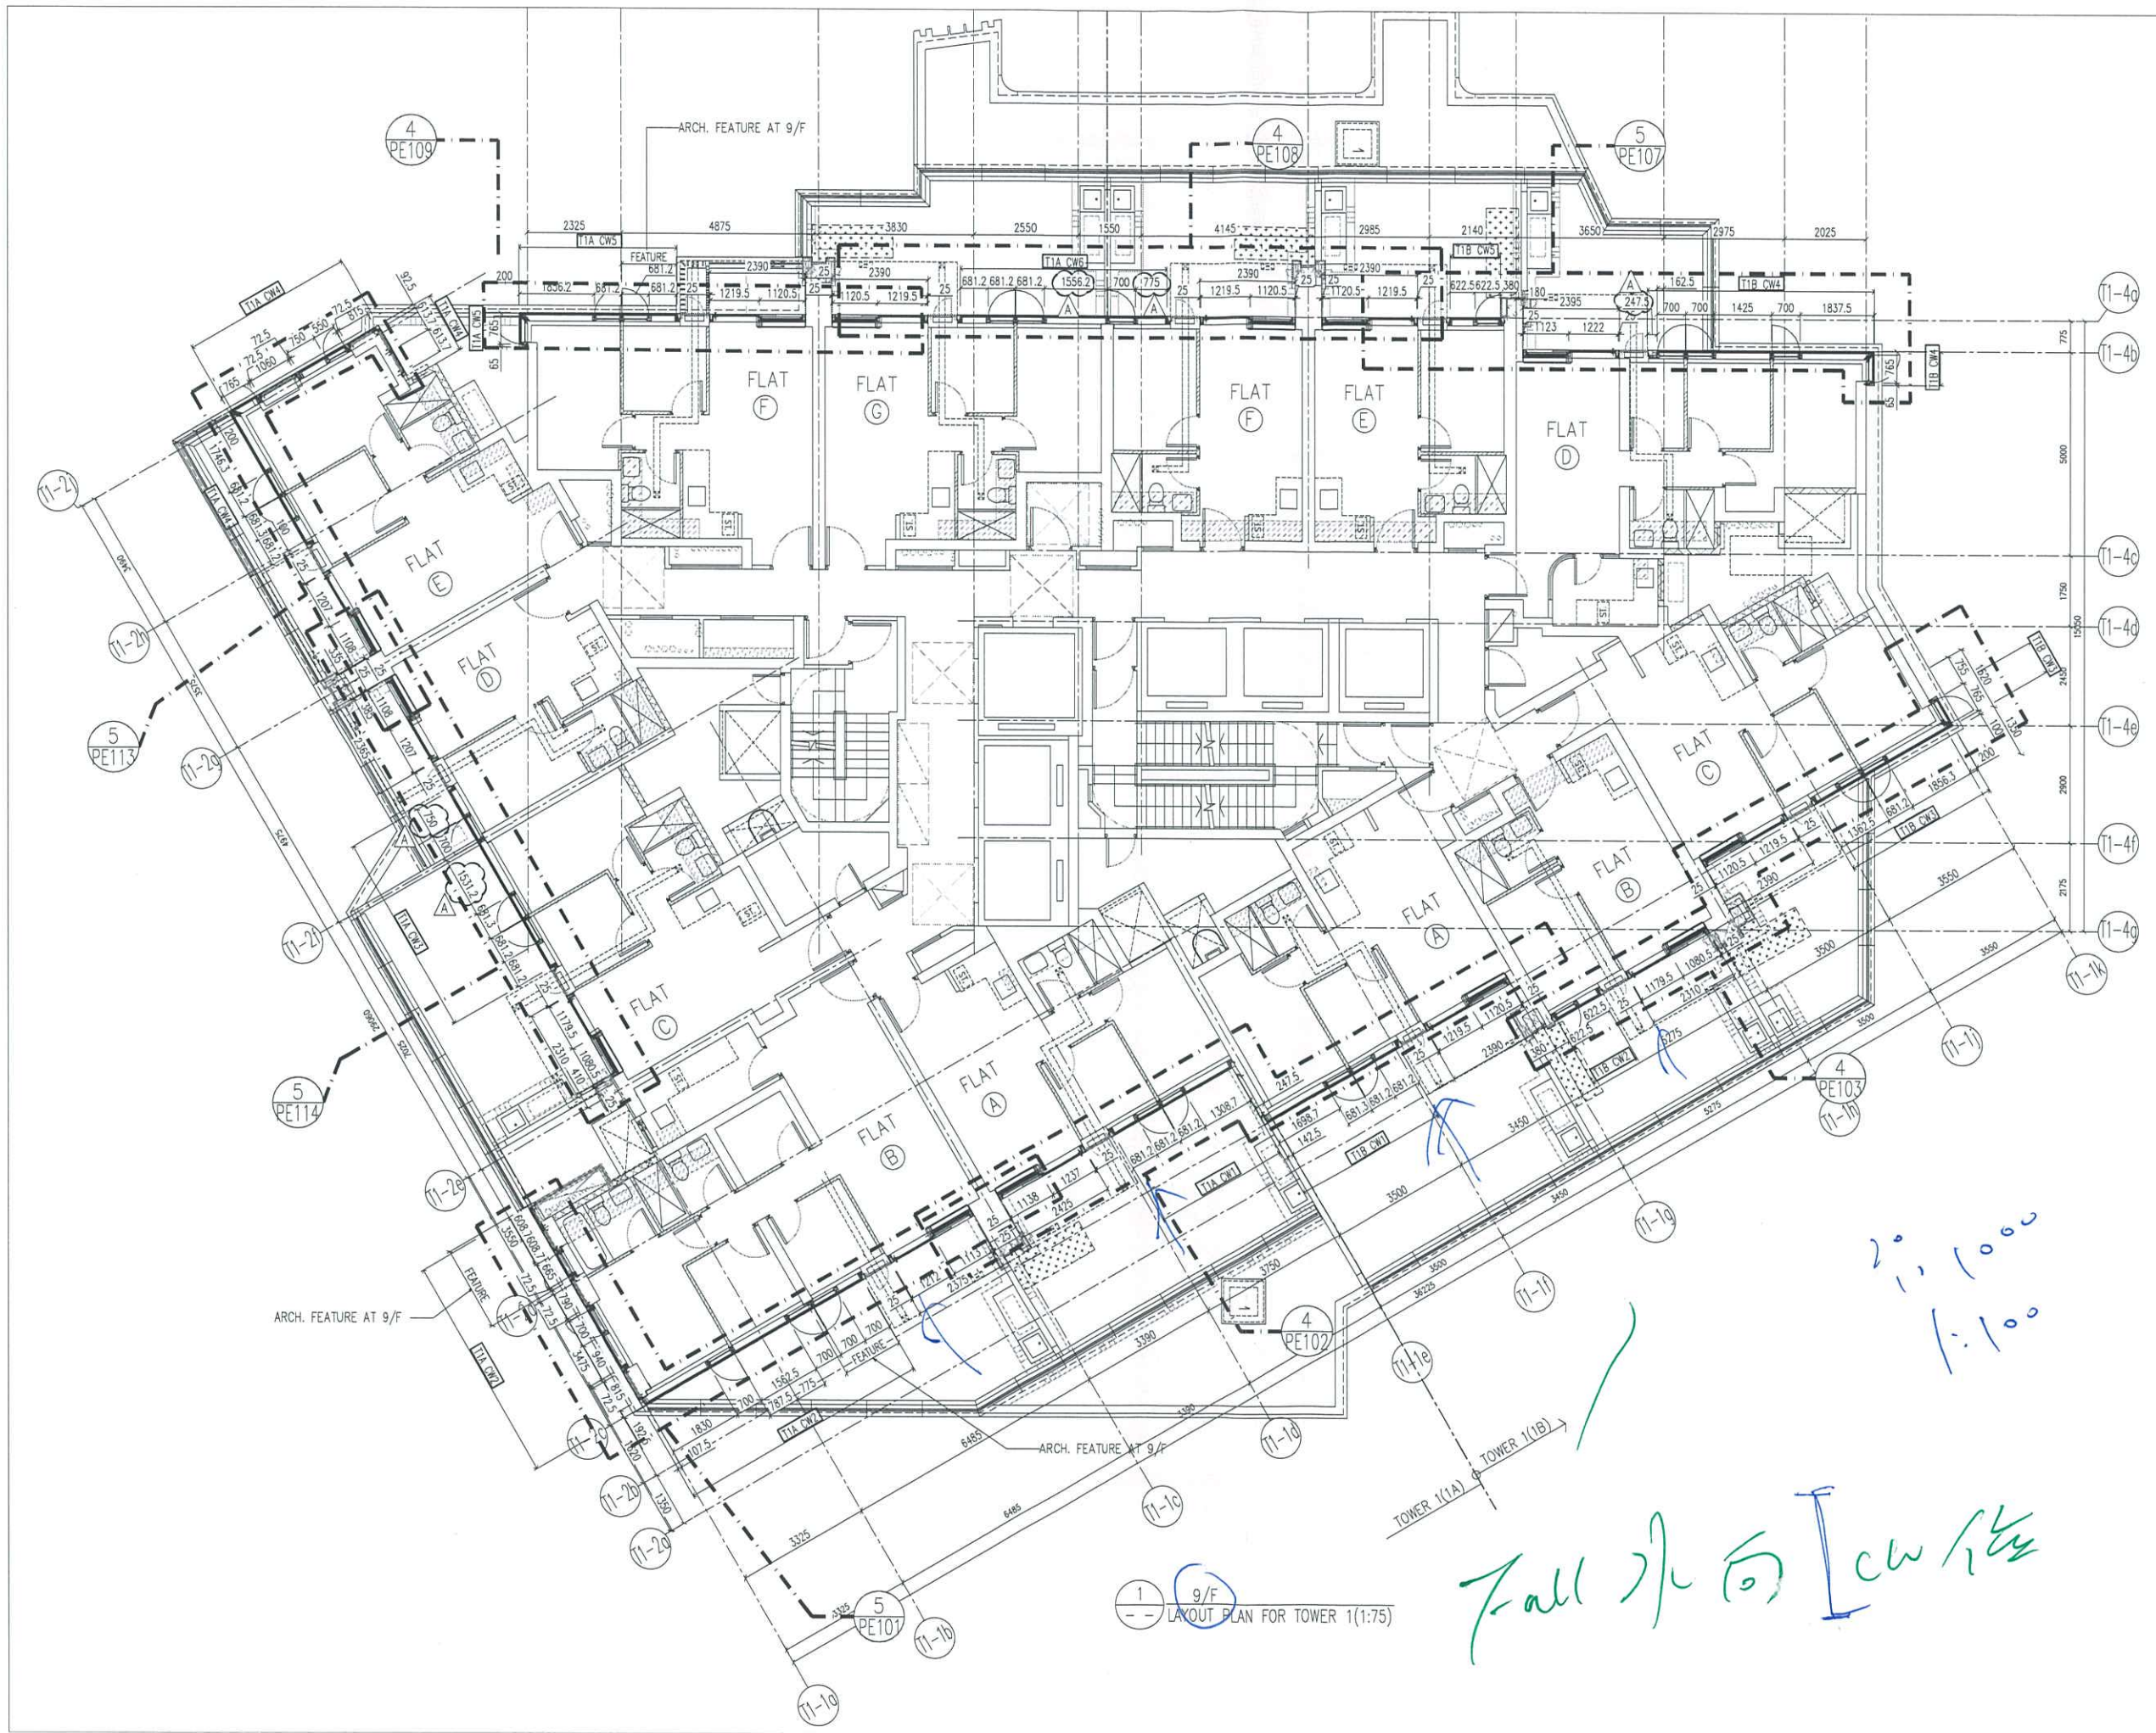

1 9/F LAYOUT PLAN FOR TOWER 1(1:75)

B.D. REF :

CLIENT :
 信和置業有限公司
 Sino Land Company Limited

ARCHITECT :
 ronald lu & partners
 Architects, Planners, Interior Designers
 Ronald Lu & Partners (HK) Ltd.
 呂元祥建築師事務所 (香港) 有限公司

MAIN CONTRACTOR :
 Gammon

STRUCTURAL ENGINEER :
 AECOM

FACADE CONSULTANT:
 AECOM

NOTE :
 1. ALL DIMENSIONS ARE IN mm.
 2. ALL ELEVATIONS ARE VIEWED FROM OUTSIDE.
 3. ALL DIMENSIONS TO BE VERIFIED ON SITE BEFORE FABRICATION.

LEGEND :
 (X1) --- DETAIL MARK NO.
 (X001) --- REFER SHEET NO.
 1. F.F.L. --- FINISHED FLOOR LEVEL
 2. S.F.L. --- STRUCTURAL FLOOR LEVEL
 3. (R) --- REVERSED DETAIL

NO.	DATE	REVISED AS PER COMMENTS	LS
A	25/12/22	REVISED AS PER COMMENTS	LS

JOB NO. : J-858

PROJECT :
 PROPOSED RESIDENTIAL DEVELOPMENT
 AT TKOTL 70RP, PHASE 11, LOHAS PARK
 TSEUNG KWAN O, N.T.

TITLE :
 TYPICAL FLOOR PLAN
 AT TOWER 1

DATE : 22-OCT-21 SCALE : 1:75(A1)

DRAWN BY : KY CHECKED BY : YB

美特鋁質有限公司
 MIDI ALUMINIUM FABRICATOR LTD.
 Units 6-8, Sunray Industrial Centre, 1/F
 610 Cha Kwo Ling Road, Kowloon
 Tel:23489211-4 Fax:(852)27727666

DWG NO. : J858-CW-LP101A REV. : A