

工程指示 / 要求簡箋(E.I.)

工程指示編號 : EI / 5733 / 23

修改版次 :

工程編號 : J - 858

工程名稱 : 將軍澳日出康城 11

工程項目 : 幕牆 拆圖修改 大飾線 X86307 加 6 x 20 去水孔

收件人 : 生統 / 水洪

發件人 : Ant Yeung

日期 : 16/02/2023

□要求提供 / □確認 事項 :

- | | | |
|------------------------------------|-------------------------------------|-------------------------------|
| <input type="checkbox"/> 初步鋁料 B.M. | <input type="checkbox"/> 加工拆圖, 然後生產 | <input type="checkbox"/> 尺寸表 |
| <input type="checkbox"/> 正式鋁料 B.M. | <input type="checkbox"/> 技術上資料 / 指示 | <input type="checkbox"/> 報價 |
| <input type="checkbox"/> 配件 B.M. | <input type="checkbox"/> 樣辦或貨品說明書 | <input type="checkbox"/> 分判合約 |

內容 :

業主 comment 飾線去水孔, 飾線要按圖加做 6x20 長孔。離邊 100mm
 注明: 開孔後廠點油

請在 2023.02.11 前完成上列要求。

附: 頁

 原合約工程包 原合約工程加 / 減賬 新工程報價

分發東莞各部門 :

- | | | | | | | | |
|---------------------------------|------------------------------|---|---|--|---|--|---|
| <input type="checkbox"/> 生產技術總監 | <input type="checkbox"/> 連附件 | <input checked="" type="checkbox"/> 技術部 | <input checked="" type="checkbox"/> 連附件 | <input type="checkbox"/> 生產部 | <input type="checkbox"/> 連附件 | <input type="checkbox"/> 機械設計部 | <input type="checkbox"/> 連附件 |
| <input type="checkbox"/> 採購部 | <input type="checkbox"/> 連附件 | <input checked="" type="checkbox"/> 生產統籌部 | <input checked="" type="checkbox"/> 連附件 | <input checked="" type="checkbox"/> 小羅&清 | <input checked="" type="checkbox"/> 連附件 | | |
| <input type="checkbox"/> 質檢部 | <input type="checkbox"/> 連附件 | <input type="checkbox"/> 會計部 | <input type="checkbox"/> 連附件 | <input type="checkbox"/> 報關組 | <input type="checkbox"/> 連附件 | <input checked="" type="checkbox"/> 其他 | <u>水洪</u> <input checked="" type="checkbox"/> 連附件 |

分發香港各部門 :


- | | | | | | | | | |
|------------------------------|------------------------------|-------------------------------|------------------------------|------------------------------|------------------------------|----------------------------------|-----------|------------------------------|
| <input type="checkbox"/> 行政部 | <input type="checkbox"/> 連附件 | <input type="checkbox"/> 會計部 | <input type="checkbox"/> 連附件 | <input type="checkbox"/> 統籌部 | <input type="checkbox"/> 連附件 | <input type="checkbox"/> 工程部地盤科文 | <u>積哥</u> | <input type="checkbox"/> 連附件 |
| <input type="checkbox"/> 採購部 | <input type="checkbox"/> 連附件 | <input type="checkbox"/> QS 部 | <input type="checkbox"/> 連附件 | <input type="checkbox"/> 維修部 | <input type="checkbox"/> 連附件 | <input type="checkbox"/> 其他 | | <input type="checkbox"/> 連附件 |

傳遞編號 :

HK 254 / 23

發件人簽署 :

項目經理簽署 :

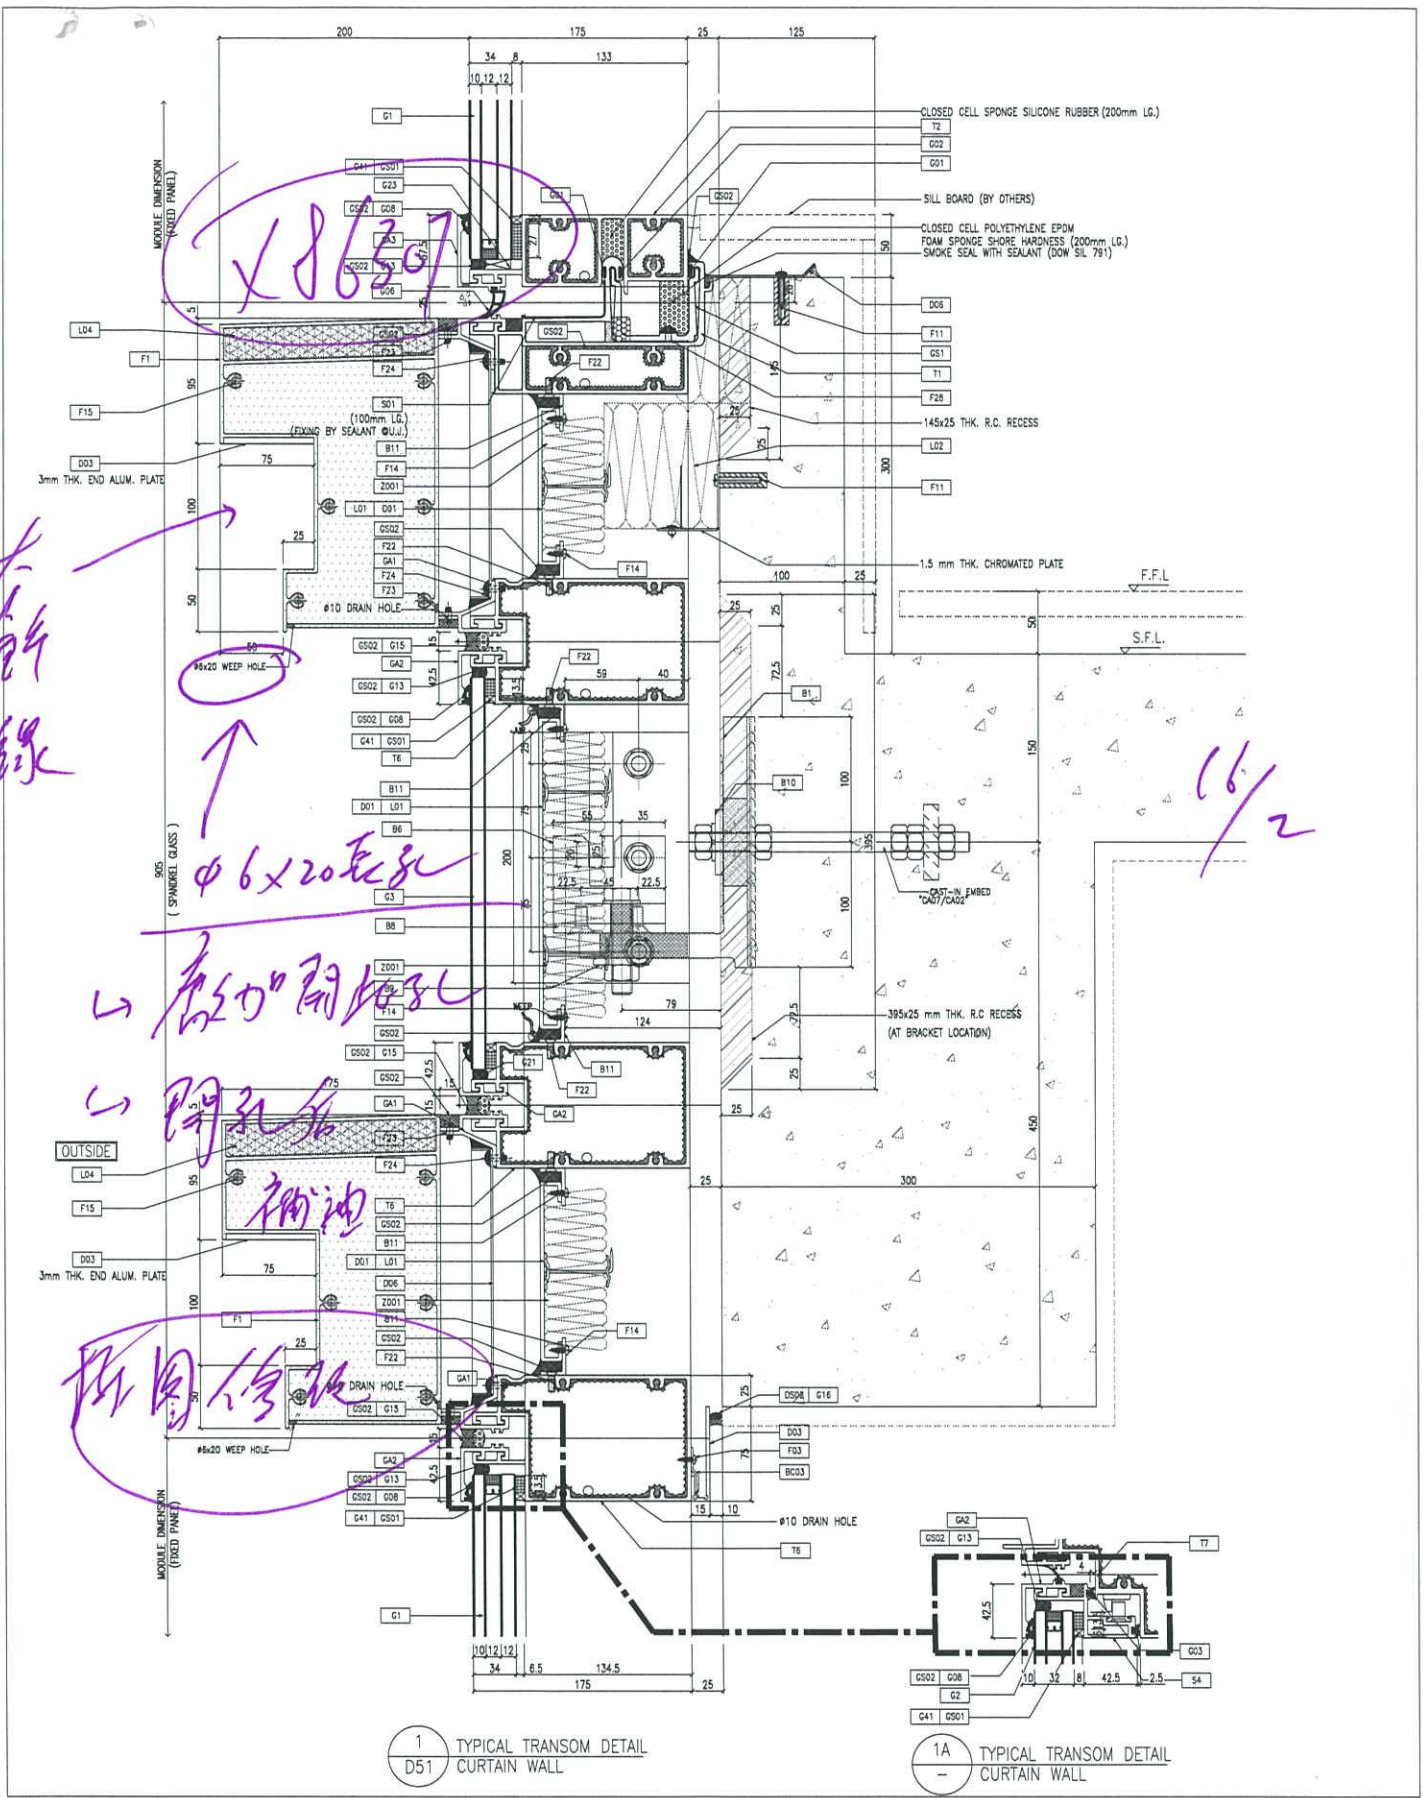

1 TYPICAL TRANSOM DETAIL CURTAIN WALL D51

1A TYPICAL TRANSOM DETAIL CURTAIN WALL

<p>DATE: 22-OCT-21 SCALE: 1:2(A1)</p> <p>DRAWN BY: CHECKED BY:</p> <p>DATE: 22-OCT-21</p>		<p>TITLE: TYPICAL MULLION DETAIL FOR CURTAIN WALL</p>		<p>JOB NO.: J-R558</p> <p>PROJECT: PROPOSED RESIDENTIAL DEVELOPMENT AT KOTU 7089, PHASE 11, LOHAS PARK, TSEUNG KWAN O, N.T.</p>		<p>REVISIONS:</p> <table border="1"> <tr> <th>NO.</th> <th>DATE</th> <th>DESCRIPTION</th> <th>BY</th> <th>CHKD.</th> </tr> <tr> <td>1</td> <td>22/07/21</td> <td>REVISION AS PER COMMENTS</td> <td>LS</td> <td>LS</td> </tr> <tr> <td>2</td> <td>22/09/21</td> <td>REVISION AS PER COMMENTS</td> <td>LS</td> <td>LS</td> </tr> <tr> <td>3</td> <td>07/09/21</td> <td>REVISION AS PER COMMENTS</td> <td>LS</td> <td>LS</td> </tr> <tr> <td>4</td> <td>23/07/21</td> <td>REVISION AS PER COMMENTS</td> <td>LS</td> <td>LS</td> </tr> </table>		NO.	DATE	DESCRIPTION	BY	CHKD.	1	22/07/21	REVISION AS PER COMMENTS	LS	LS	2	22/09/21	REVISION AS PER COMMENTS	LS	LS	3	07/09/21	REVISION AS PER COMMENTS	LS	LS	4	23/07/21	REVISION AS PER COMMENTS	LS	LS
NO.	DATE	DESCRIPTION	BY	CHKD.																												
1	22/07/21	REVISION AS PER COMMENTS	LS	LS																												
2	22/09/21	REVISION AS PER COMMENTS	LS	LS																												
3	07/09/21	REVISION AS PER COMMENTS	LS	LS																												
4	23/07/21	REVISION AS PER COMMENTS	LS	LS																												
<p>CLIENT: 德和置業有限公司 Sino Land Company Limited</p>		<p>ARCHITECT: Ronald Lu & Partners (HK) Ltd. Ronald Lu & Partners (HK) Ltd. 吳文輝建築師事務所 (香港) 有限公司</p>		<p>STRUCTURAL ENGINEER: Gammon</p>		<p>FAÇADE CONSULTANT: AECOM</p>																										
<p>REVISIONS:</p> <p>1. ALL DIMENSIONS ARE IN mm.</p> <p>2. ALL DIMENSIONS ARE VERIFIED FROM OUTSIDE.</p> <p>3. ALL DIMENSIONS TO BE VERIFIED ON SITE BEFORE FABRICATION.</p>		<p>LEGEND:</p> <p>(X) DETAIL MARK NO.</p> <p>(O) REFER SHEET NO.</p> <p>1. F.F.L. -- FINISHED FLOOR LEVEL</p> <p>2. S.F.L. -- STRUCTURAL FLOOR LEVEL</p> <p>3. (R) -- REVERSED DETAIL</p>		<p>NOTE:</p> <p>1. ALL DIMENSIONS ARE IN mm.</p> <p>2. ALL DIMENSIONS ARE VERIFIED FROM OUTSIDE.</p> <p>3. ALL DIMENSIONS TO BE VERIFIED ON SITE BEFORE FABRICATION.</p>		<p>MAIN CONTRACTOR: AECOM</p>																										
<p>REVISIONS:</p> <p>DATE: 22-OCT-21</p> <p>SCALE: 1:2(A1)</p> <p>DRAWN BY: CHECKED BY:</p>		<p>DATE: 22-OCT-21</p> <p>SCALE: 1:2(A1)</p> <p>DRAWN BY: CHECKED BY:</p>		<p>DATE: 22-OCT-21</p> <p>SCALE: 1:2(A1)</p> <p>DRAWN BY: CHECKED BY:</p>		<p>DATE: 22-OCT-21</p> <p>SCALE: 1:2(A1)</p> <p>DRAWN BY: CHECKED BY:</p>																										