



工程指示 / 要求簡箋(E.I.)

工程指示編號：EI / 593<sup>9</sup> / 23 修改版次：-  
 工程編號：J - 858 工程名稱：將軍澳日出康城  
 工程項目：T2 趟門 地盆用玻璃 BM (只放行生產 12,15,16/F) 樣板層  
 收件人：Maggie 發件人：Ant Yeung 日期：30/03/2023

要求提供 / 確認 事項：

- |                                    |                                     |                               |
|------------------------------------|-------------------------------------|-------------------------------|
| <input type="checkbox"/> 初步鋁料 B.M. | <input type="checkbox"/> 加工拆圖，然後生產  | <input type="checkbox"/> 尺寸表  |
| <input type="checkbox"/> 正式鋁料 B.M. | <input type="checkbox"/> 技術上資料 / 指示 | <input type="checkbox"/> 報價   |
| <input type="checkbox"/> 配件 B.M.   | <input type="checkbox"/> 樣辦或貨品說明書   | <input type="checkbox"/> 分判合約 |
- 內容：

請按玻璃 BM 生產 趟門 梗和玉 玻璃送地盆。IGU 片需熱浸 26x3 層 = 78 件 玻璃

1. 只放行生產 T2 12,15,16/F)

2. 附上玻璃出貨表 EXCEL，請按出貨表排期生產、熱浸、和包箱

預出貨到地盆 2023.5.08 預計熱浸約 2022.04.27

\*3. 按層包箱。 2374 mm 高為門玉玻璃 / 2525mm 高為梗門玻璃。(每層包 26 件)

4. 不要印上熱浸標纖。只給"可移除"的標纖

5. 此為 IGU 片：標籤在室外面 (注明尺寸)，方便移除

6. 沙基尺寸：斜角 2800mm x 垂直高度 2500mm / 玻璃最大尺寸沒有超過 2800mm OK

7. 按 EI-4999 的熱浸追蹤標籤

8. 10mm Low E(58T)#2 clear HS glass +12A +12mm clear tempered glass (inside)

(R20220114001) 已批

\*9. 按地盆要求加上箱腳和帆布帶，符合地盆落貨要求

請在 2023.05.08 前完成上列要求。

附：

- 原合約工程包  原合約工程加 / 減賬  新工程報價

原因：-

分發東莞各部門：

- |  |   |  |  |
|--|---|--|--|
| <input type="checkbox"/> 生產技術總監 <input type="checkbox"/> 連附件 | <input type="checkbox"/> 技術部 <input type="checkbox"/> 連附件   | <input type="checkbox"/> 生產部 <input type="checkbox"/> 連附件    | <input type="checkbox"/> 機械設計部 <input type="checkbox"/> 連附件        |
| <input type="checkbox"/> 採購部 <input type="checkbox"/> 連附件    | <input type="checkbox"/> 生產統籌部 <input type="checkbox"/> 連附件 | <input type="checkbox"/> 小羅 & 清 <input type="checkbox"/> 連附件 |  |
| <input type="checkbox"/> 質檢部 <input type="checkbox"/> 連附件    | <input type="checkbox"/> 會計部 <input type="checkbox"/> 連附件   | <input type="checkbox"/> 報關組 <input type="checkbox"/> 連附件    | <input type="checkbox"/> 其他 <u>水洪</u> <input type="checkbox"/> 連附件 |

分發香港各部門：

- |   |  |   |   |
|---|--|---|---|
| <input type="checkbox"/> 行政部 <input type="checkbox"/> 連附件                       | <input type="checkbox"/> 會計部 <input type="checkbox"/> 連附件  | <input type="checkbox"/> 統籌部 <input type="checkbox"/> 連附件 | <input checked="" type="checkbox"/> 工程部地盤科文 <u>積哥</u> <input checked="" type="checkbox"/> 連附件 |
| <input checked="" type="checkbox"/> 採購部 <input checked="" type="checkbox"/> 連附件 | <input type="checkbox"/> QS 部 <input type="checkbox"/> 連附件 | <input type="checkbox"/> 維修部 <input type="checkbox"/> 連附件 | <input type="checkbox"/> 其他 _____ <input type="checkbox"/> 連附件                                |

傳遞編號：

HK / 23

發件人簽署：

項目經理簽署：

J858康城11期 玻璃分层统计表 (T2趟门)

工程: J858康城11期 (T2)

日期: 29-Mar-2023

訂製用

序号	玻璃编号	玻璃类型	玻璃尺寸			单面积 (m2)	標準層幾多件	3層12,15,16/F	本次訂購數量	备注	面積
			W(mm)	x	H(mm)						
1	GL01-57	GL01	1010	x	2374	2.40	1	3	3	送地盤	7.19322
2	GL01-58	GL01	978	x	2525	2.47	1	3	3	送地盤	7.40835
3	GL01-72	GL01	1010	x	2574	2.60	0	0	0	送地盤	0
4	GL01-73	GL01	978	x	2725	2.67	0	0	0	送地盤	0
5	GL01-59	GL01	1035	x	2374	2.46	1	3	3	送地盤	7.37127
6	GL01-60	GL01	1003	x	2525	2.53	1	3	3	送地盤	7.597725
7	GL01-70	GL01	1035	x	2574	2.66	0	0	0	送地盤	0
8	GL01-71	GL01	1003	x	2725	2.73	0	0	0	送地盤	0
9	GL01-61	GL01	1017	x	2374	2.41	8	24	24	送地盤	57.944592
10	GL01-62	GL01	985	x	2525	2.49	8	24	24	送地盤	59.691
11	GL01-78	GL01	1017	x	2574	2.62	0	0	0	送地盤	0
12	GL01-79	GL01	985	x	2725	2.68	0	0	0	送地盤	0
13	GL01-63	GL01	977	x	2374	2.32	2	6	6	送地盤	13.916388
14	GL01-64	GL01	945	x	2525	2.39	2	6	6	送地盤	14.31675
15	GL01-74	GL01	977	x	2574	2.51	0	0	0	送地盤	0
16	GL01-75	GL01	945	x	2725	2.58	0	0	0	送地盤	0
17	GL01-65	GL01	1020	x	2374	2.42	1	3	3	送地盤	7.26444
18	GL01-66	GL01	988	x	2525	2.49	1	3	3	送地盤	7.4841
19	GL01-80	GL01	1020	x	2574	2.63	0	0	0	送地盤	0
20	GL01-81	GL01	988	x	2725	2.69	0	0	0	送地盤	0
注:						总数量	261		78		190
1	GL01	10mm Low E(58T) clear heat strengthened glass +12A +12mm clear tempered glass(inside)									

按層自相

一層261件

J858康城11期单元幕墙玻璃分层统计表 (T2趟门)

工程: J858康城11期 (T2)

日期: 14-Jun-22


序号	玻璃编号	玻璃类型	玻璃尺寸			单面积 (m2)	分层数量			总数量	备注
			W(mm)	x	H(mm)		9F(10, 12~16, 18~20, 22~25, 27~29, 31~33, 36~38, 41~42, 45~47, 49~51, 53~56, 58~60, 62~65F相同, 共37层)	17F(21, 26, 30, 35, 39, 43, 48, 52, 57, 61F相同, 共11层)	66F		
1	GL01-57	GL01	1010	x	2374	2.40	37	11		48	送地盘
2	GL01-58	GL01	978	x	2525	2.47	37	11		48	送地盘
3	GL01-72	GL01	1010	x	2574	2.60			1	1	送地盘
4	GL01-73	GL01	978	x	2725	2.67			1	1	送地盘
5	GL01-59	GL01	1035	x	2374	2.46	37	11		48	送地盘
6	GL01-60	GL01	1003	x	2525	2.53	37	11		48	送地盘
7	GL01-70	GL01	1035	x	2574	2.66			1	1	送地盘
8	GL01-71	GL01	1003	x	2725	2.73			1	1	送地盘
9	GL01-61	GL01	1017.5	x	2374	2.42	296	88		384	送地盘
10	GL01-62	GL01	985.5	x	2525	2.49	296	88		384	送地盘
11	GL01-78	GL01	1017.5	x	2574	2.62			8	8	送地盘
12	GL01-79	GL01	985.5	x	2725	2.69			8	8	送地盘
13	GL01-63	GL01	977.5	x	2374	2.32	74	22		96	送地盘
14	GL01-64	GL01	945.5	x	2525	2.39	74	22		96	送地盘
15	GL01-74	GL01	977.5	x	2574	2.52			2	2	送地盘
16	GL01-75	GL01	945.5	x	2725	2.58			2	2	送地盘
17	GL01-65	GL01	1020	x	2374	2.42	37	11		48	送地盘
18	GL01-66	GL01	988	x	2525	2.49	37	11		48	送地盘
19	GL01-80	GL01	1020	x	2574	2.63			1	1	送地盘
20	GL01-81	GL01	988	x	2725	2.69			1	1	送地盘
总数量						962	286		1274		

注:

1	GL01	10mm Low E(58T) clear heat strengthened glass +12A +12mm clear tempered glass(inside)									
---	------	---	--	--	--	--	--	--	--	--	--

第二份  
备注  
纪念集团



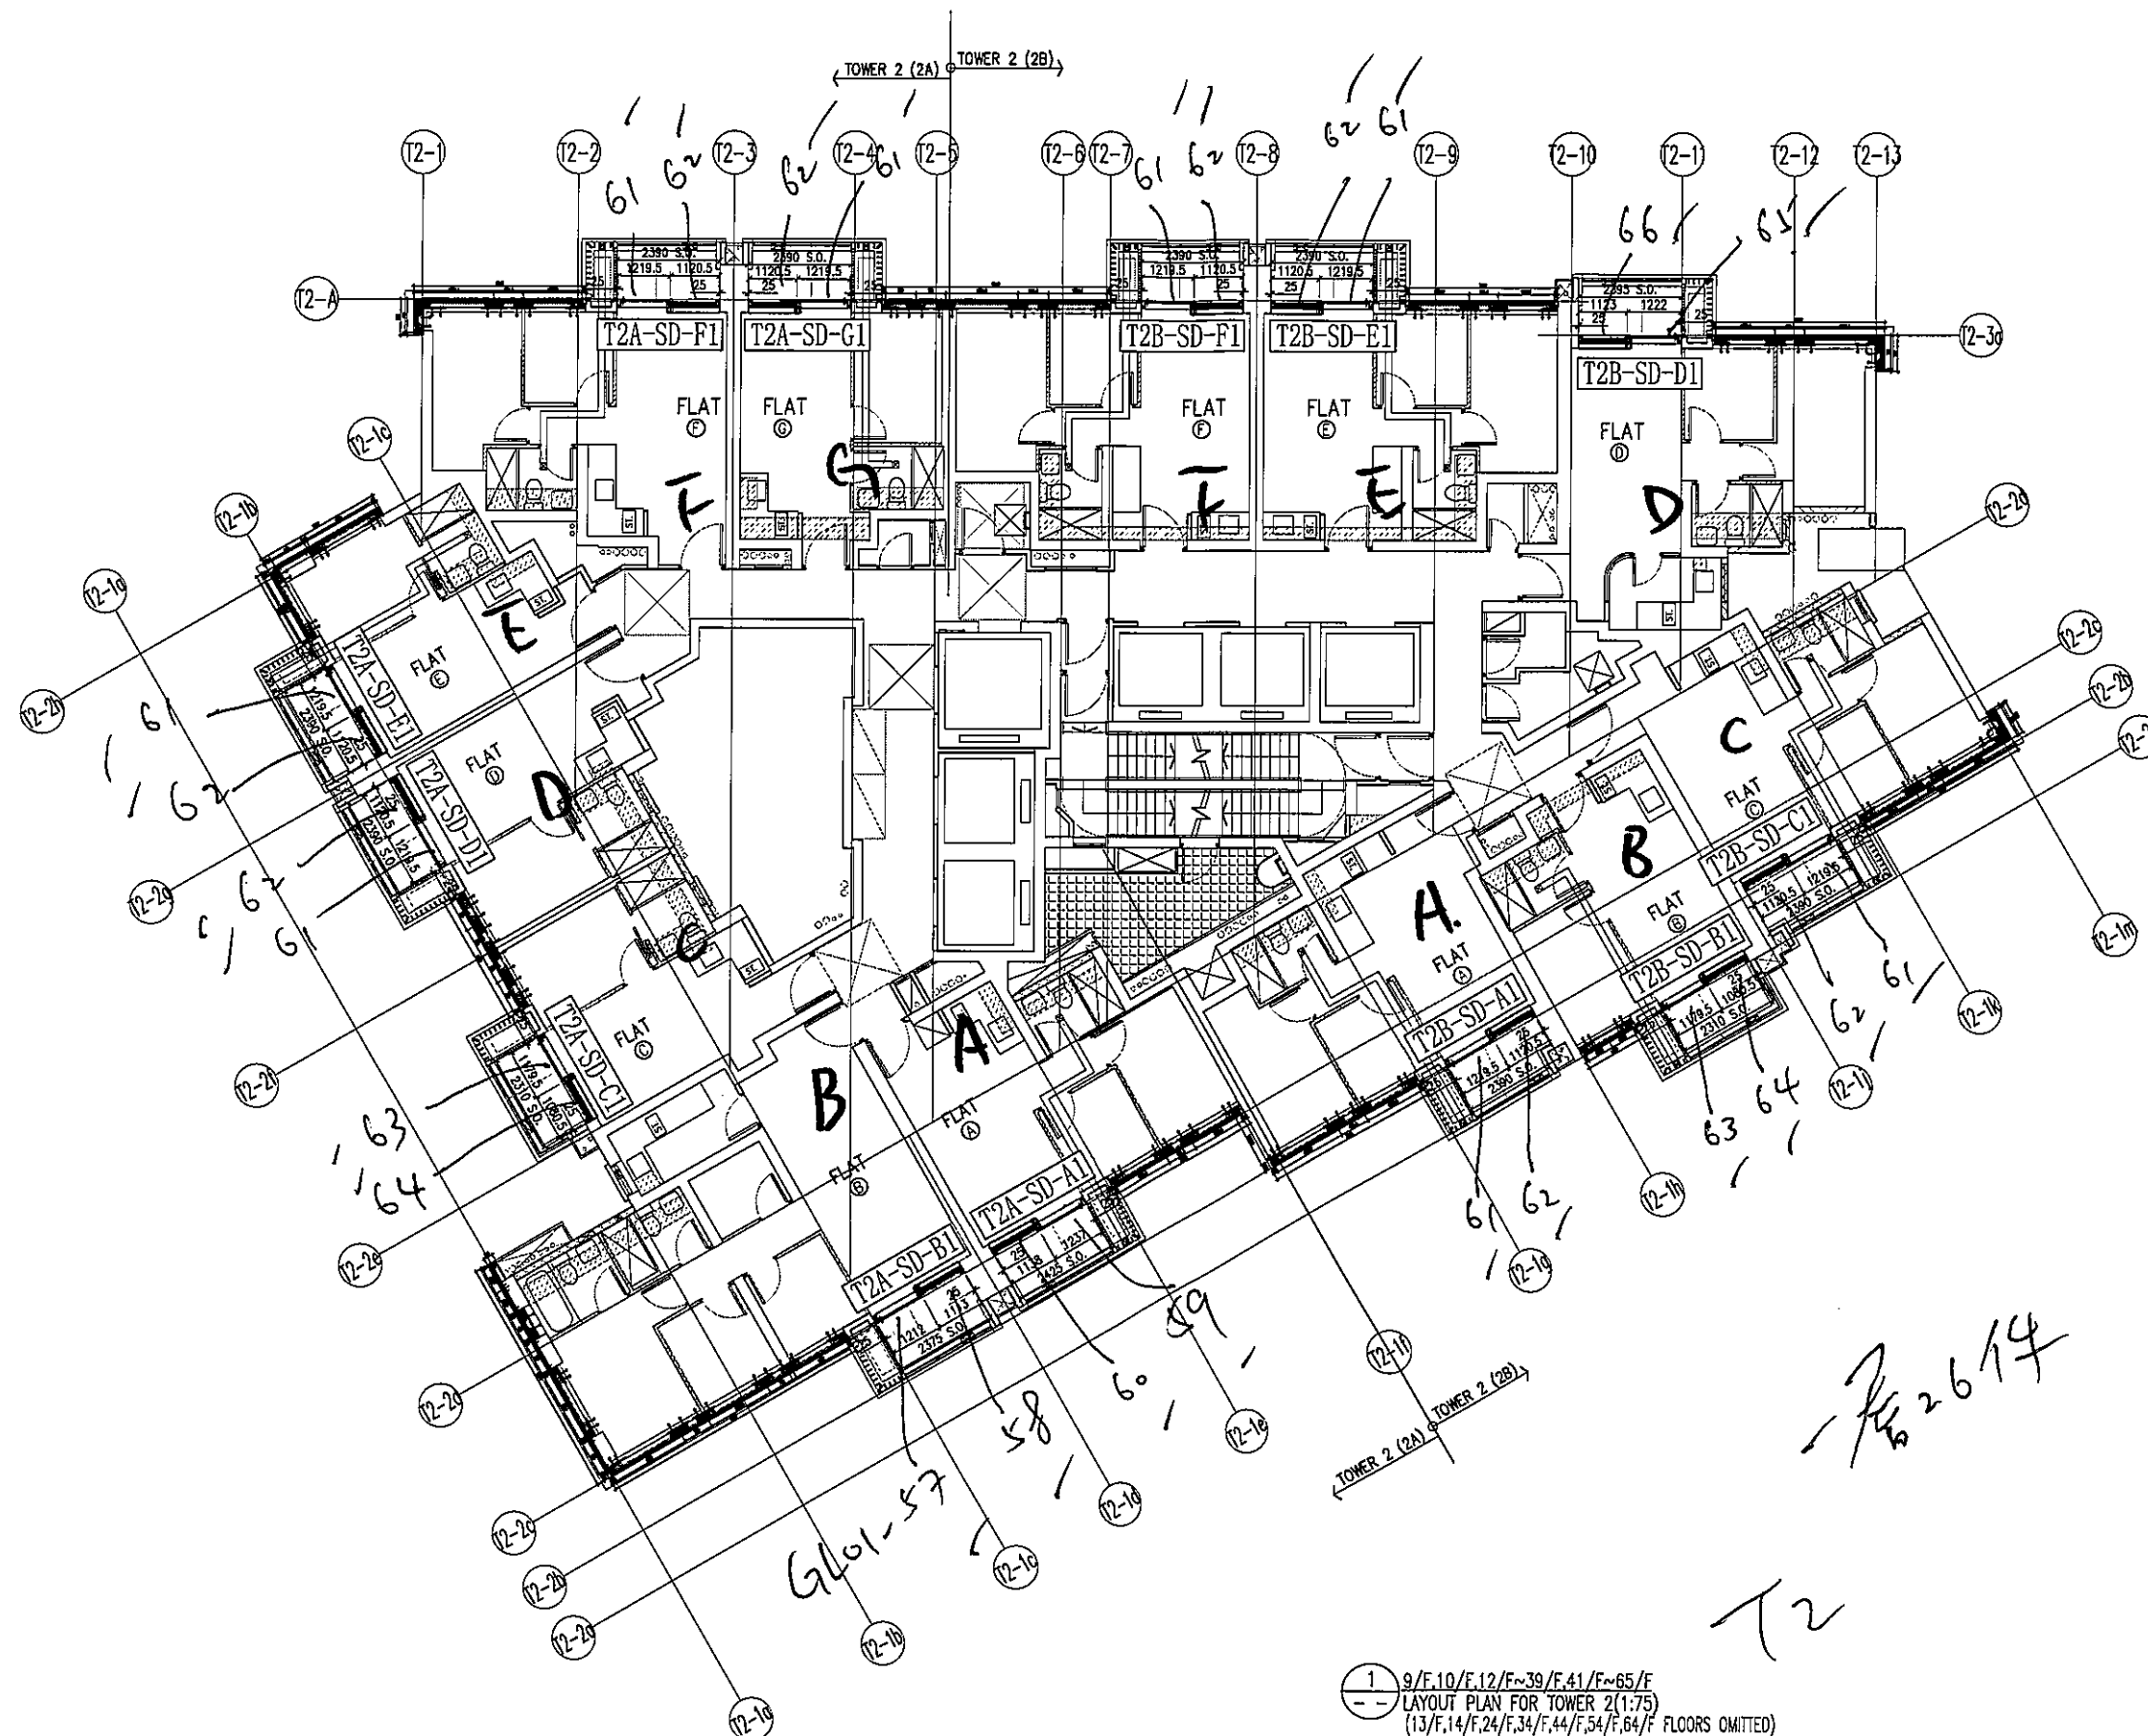

1 9/F, 10/F, 12/F, 39/F, 41/F, 65/F  
 LAYOUT PLAN FOR TOWER 2 (1:75)  
 (13/F, 14/F, 24/F, 34/F, 44/F, 54/F, 64/F FLOORS OMITTED)

B.O. REF :

---

CLIENT :  
 信和置業有限公司  
 Sino Land Company Limited

ARCHITECT :  
 ronald lu & partners  
 Architects, Planners, Interior Designers  
 Ronald Lu & Partners (HK) Ltd.  
 呂元祥建築師事務所 (香港) 有限公司

MAIN CONTRACTOR :  
 Gammon

STRUCTURAL ENGINEER :  
 AECOM

FACADE CONSULTANT :  
 AECOM

NOTE :  
 1. ALL DIMENSIONS ARE IN mm.  
 2. ALL ELEVATIONS ARE VIEWED FROM OUTSIDE.  
 3. ALL DIMENSIONS TO BE VERIFIED ON SITE BEFORE FABRICATION.

LEGEND :  
 X1 --- DETAIL MARK NO.  
 XDC1 --- REFER SHEET NO.

1. F.F.L. --- FINISHED FLOOR LEVEL  
 2. S.F.L. --- STRUCTURAL FLOOR LEVEL  
 3. (F) --- REVERSED DETAIL

NO.	DATE	REVISED	BY

JOB NO. : J-858  
 PROJECT : PROPOSED RESIDENTIAL DEVELOPMENT AT TKOTL 70RP, PHASE 11, LOHAS PARK TSEUNG KWAN O, N.T.  
 TITLE : TYPICAL SLIDING DOOR PLAN AT TOWER 2  
 DATE : 14-Jun-22 SCALE : 1:80(A1)  
 DRAWN BY : KY CHECKED BY : YB

美特鋁質有限公司  
 MIDI ALUMINIUM FABRICATOR LTD.  
 Units 6-8, Sunray Industrial Centre, 1/F  
 610 Cha Kwo Ling Road, Kowloon  
 Tel: 23489211-4 Fax: (852) 2727666

DWG NO. : JB58-CW-SD-P201 REV. : -