

零件图号: FS-END40

优先出 72 100件  
 73 100件  
 復

71 1500 件  
 72 1500 件  
 73 1500 件

共 4500 件


基于子烟 Smoke Seal 封集 左右也全位

金板 (1.5mm 箔板)

190 mm

规格: FS-END190

图 2

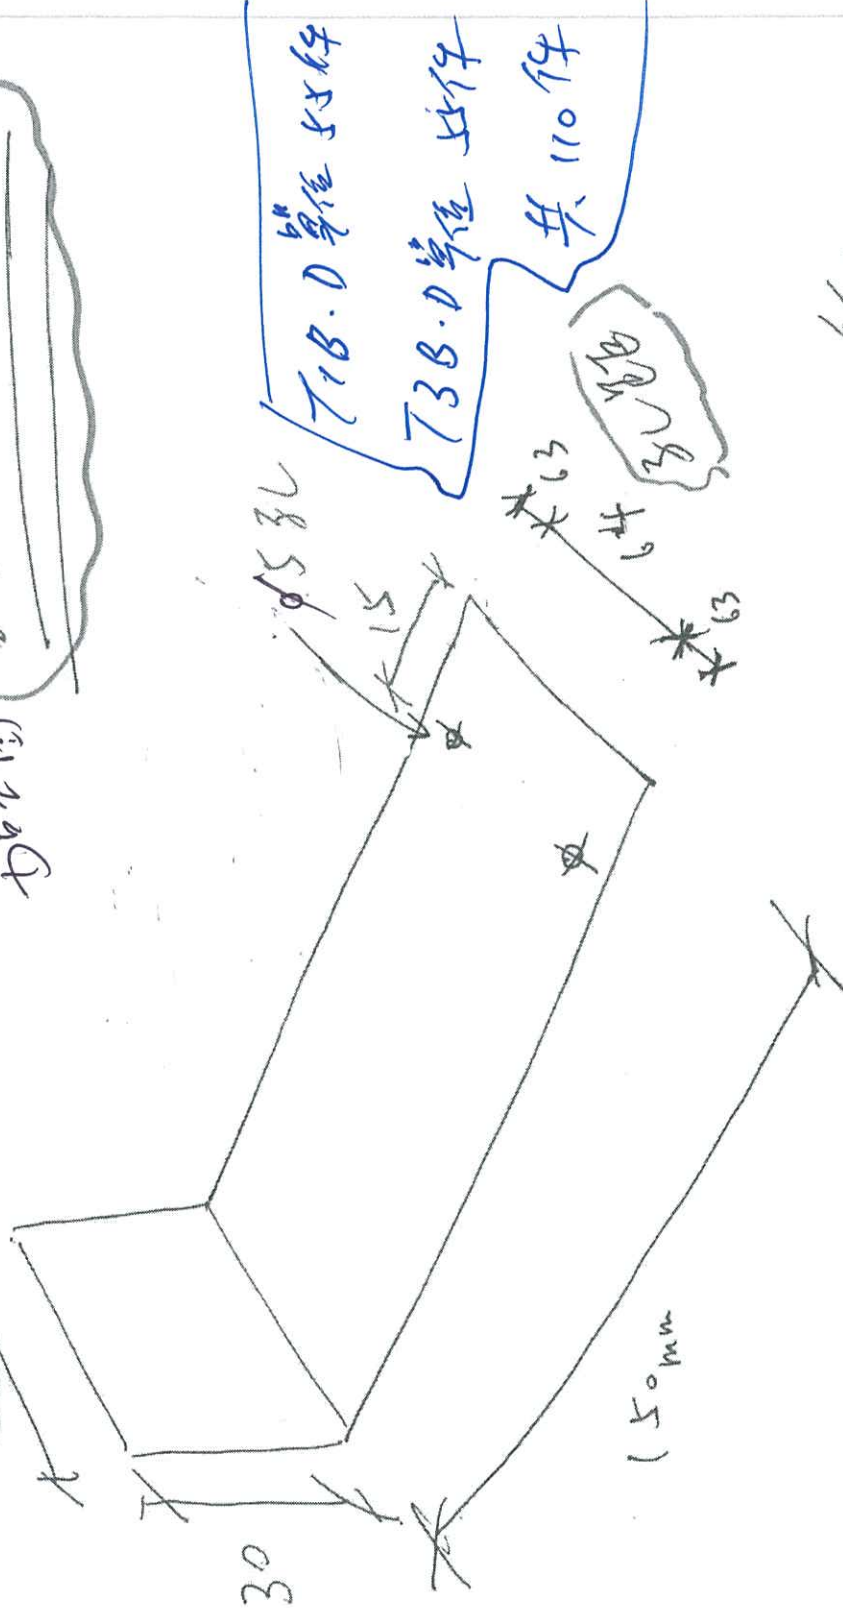


T1B-D 单位 55件  
 T3B-D 单位 55件  
 共 110件


T1B座D单位

T3B座D单位 基子图 Smoke Seal 封条 左右也在位

铝板 1.5mm 铝板

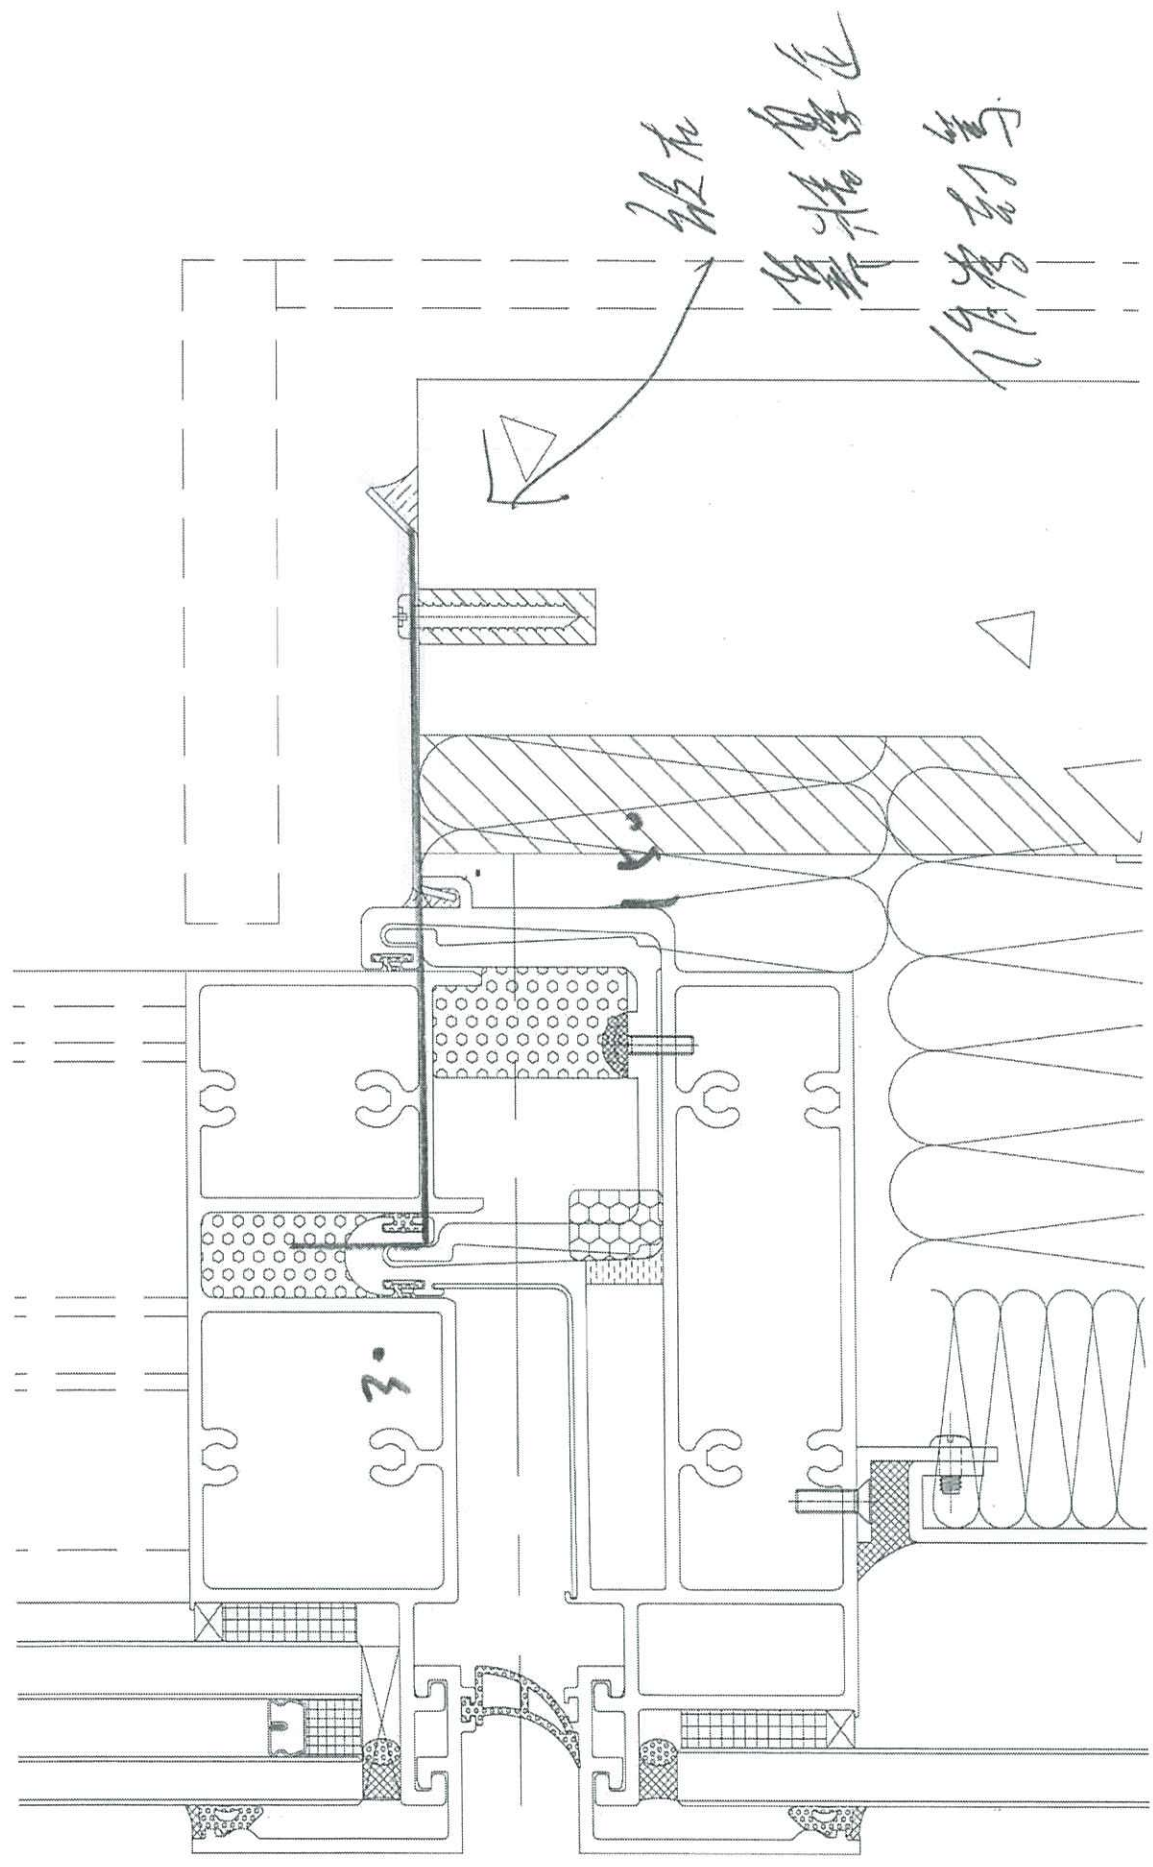

out

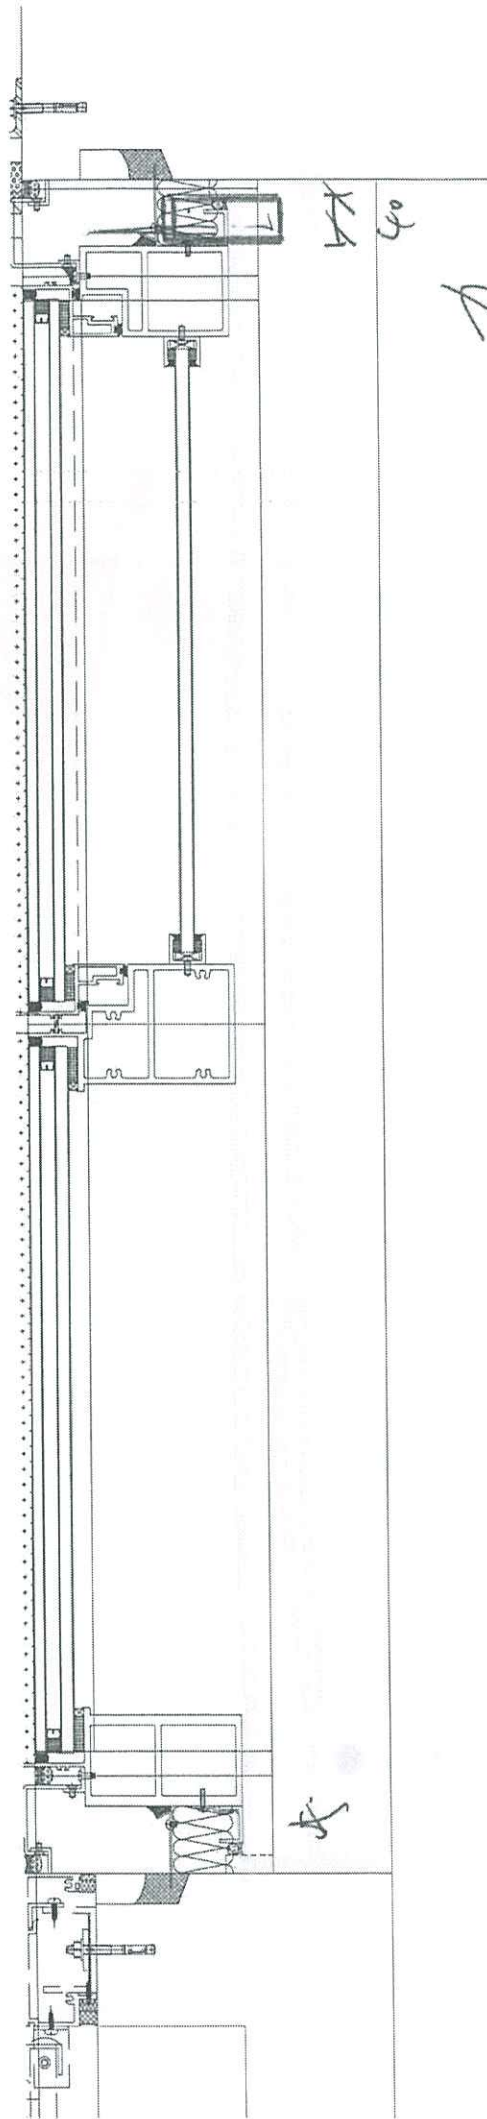


徑向位置

FS-END 40

板大角

轴

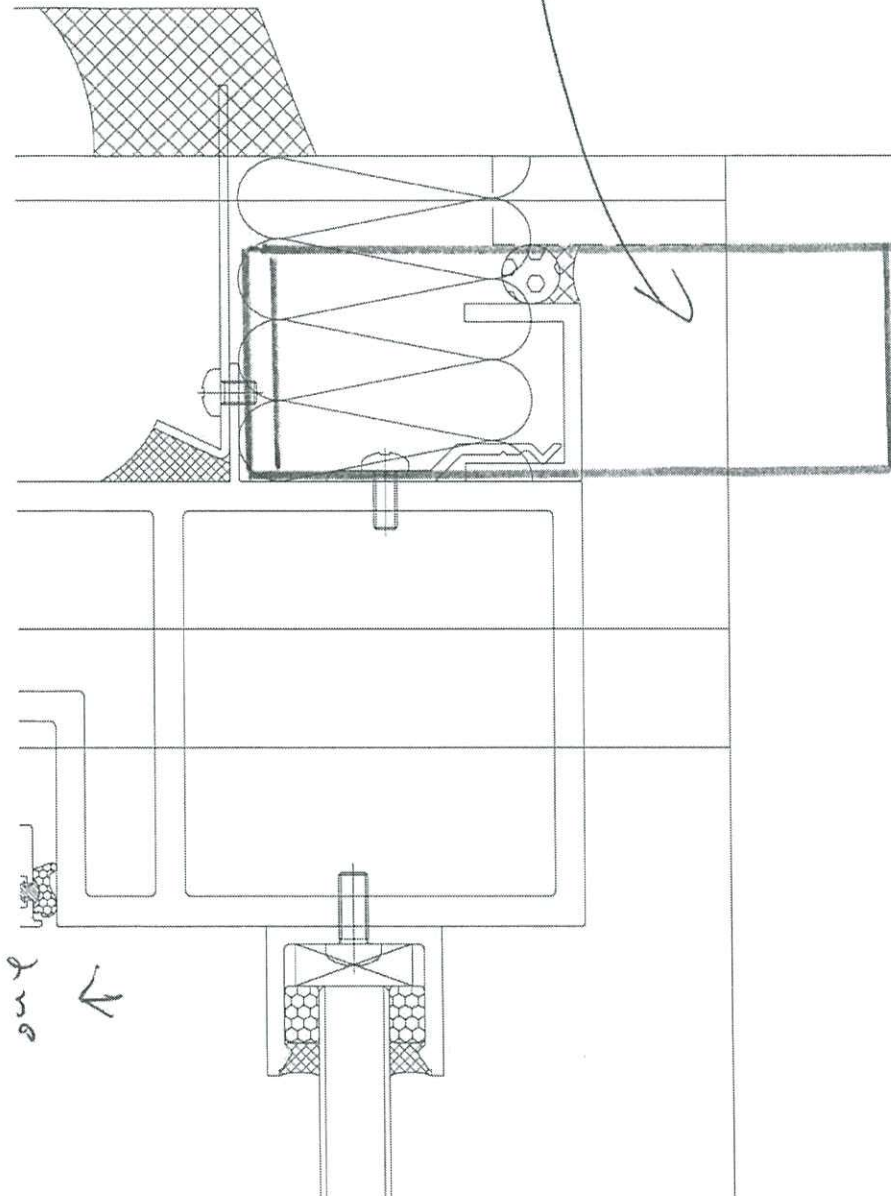

ans

FS-EN 190


T3 B-D

T1 B-D

190

247.5

700

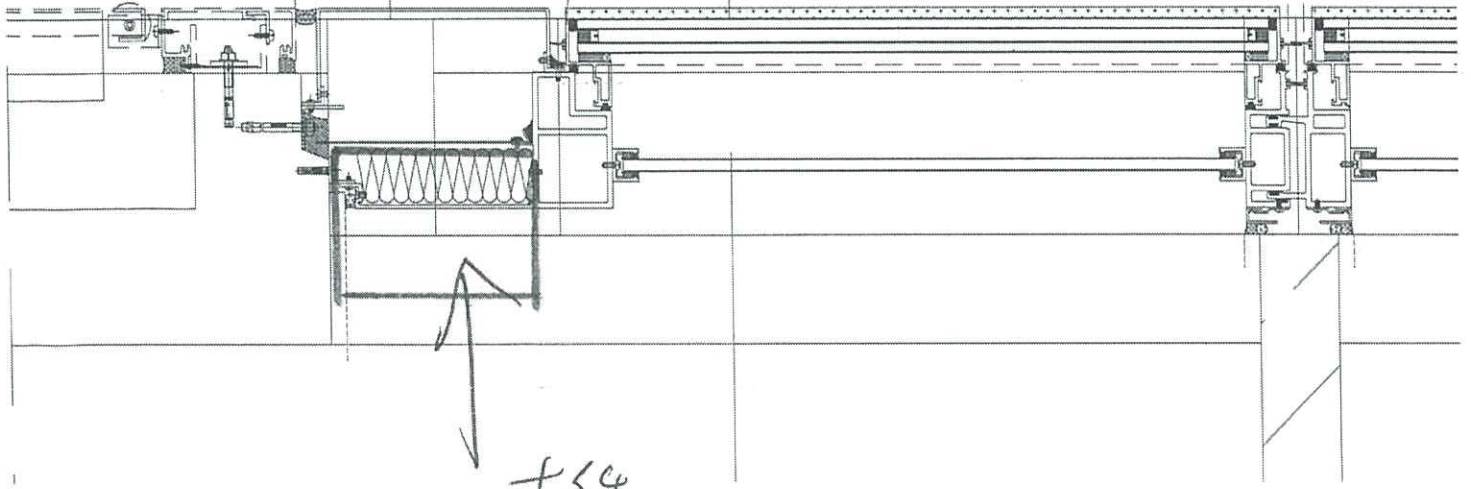


190


1.B-D FS-END 190

(A)

(28)


11

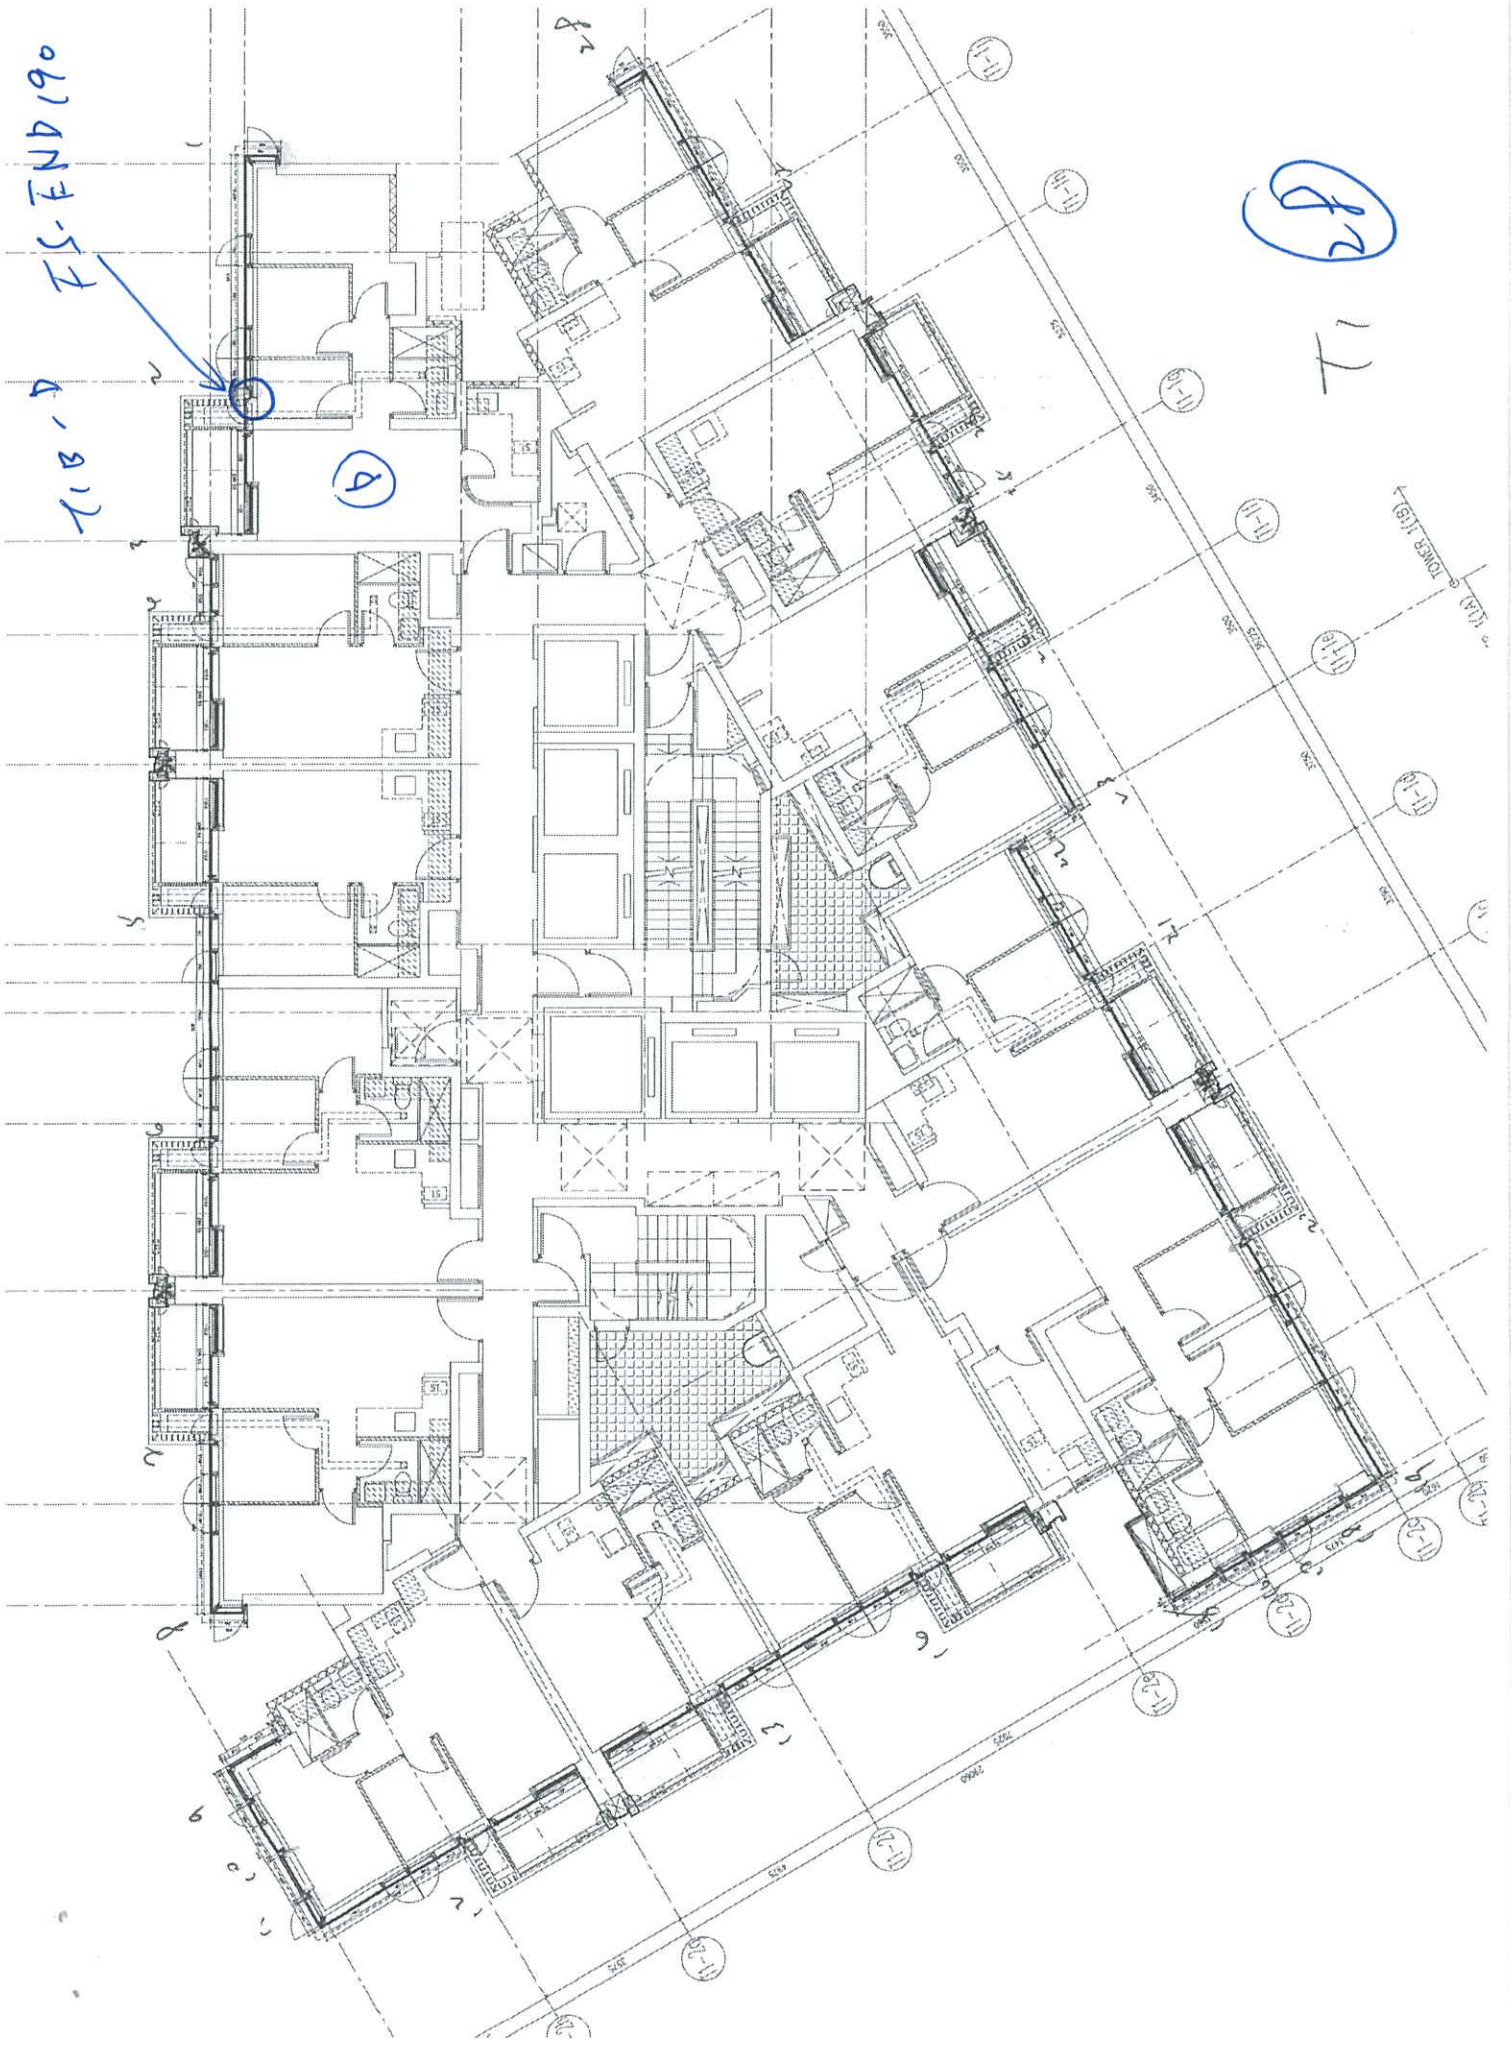

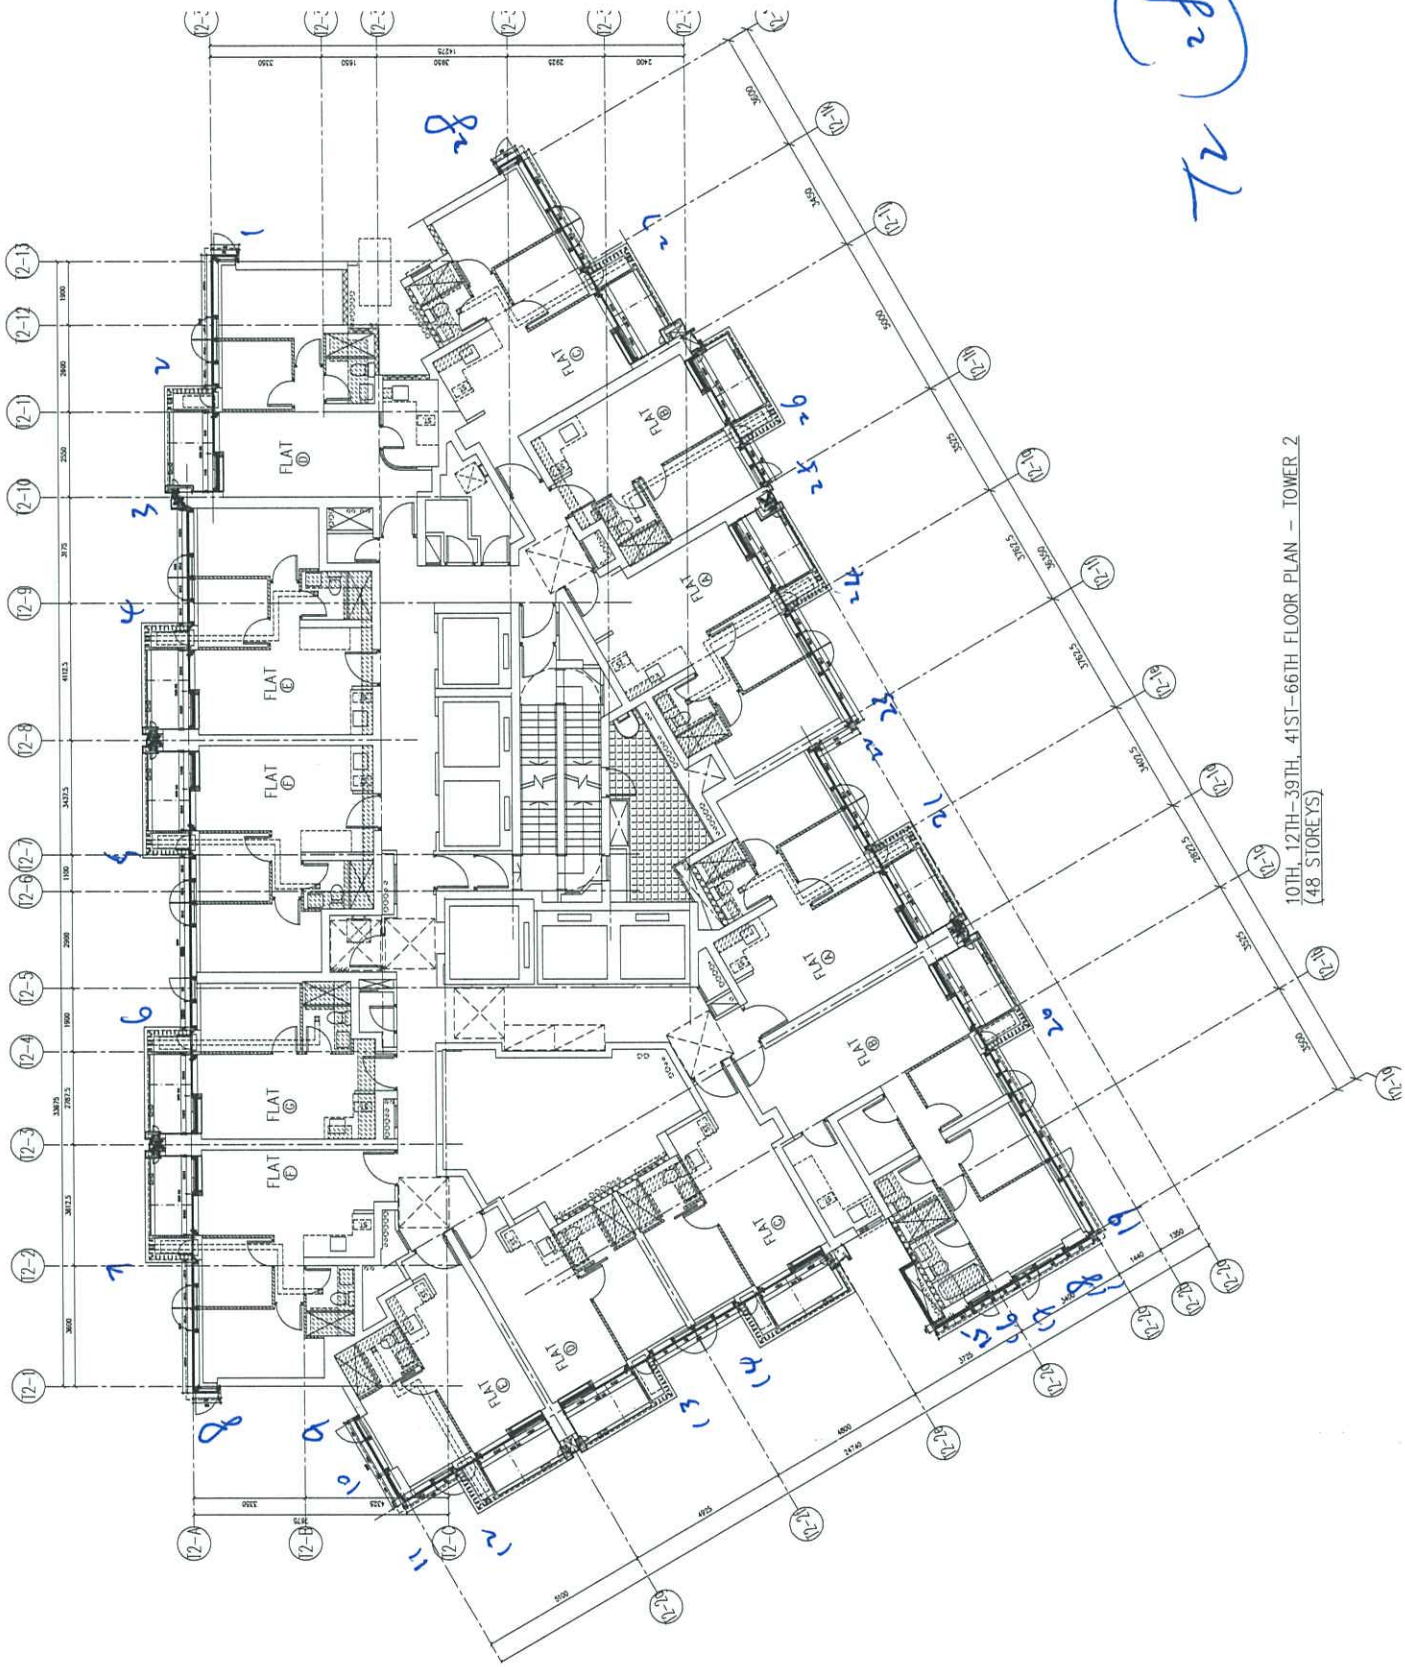

10TH, 12TH-39TH, 41ST-66TH FLOOR PLAN - TOWER 2  
(48 STOREYS)

FS-END196

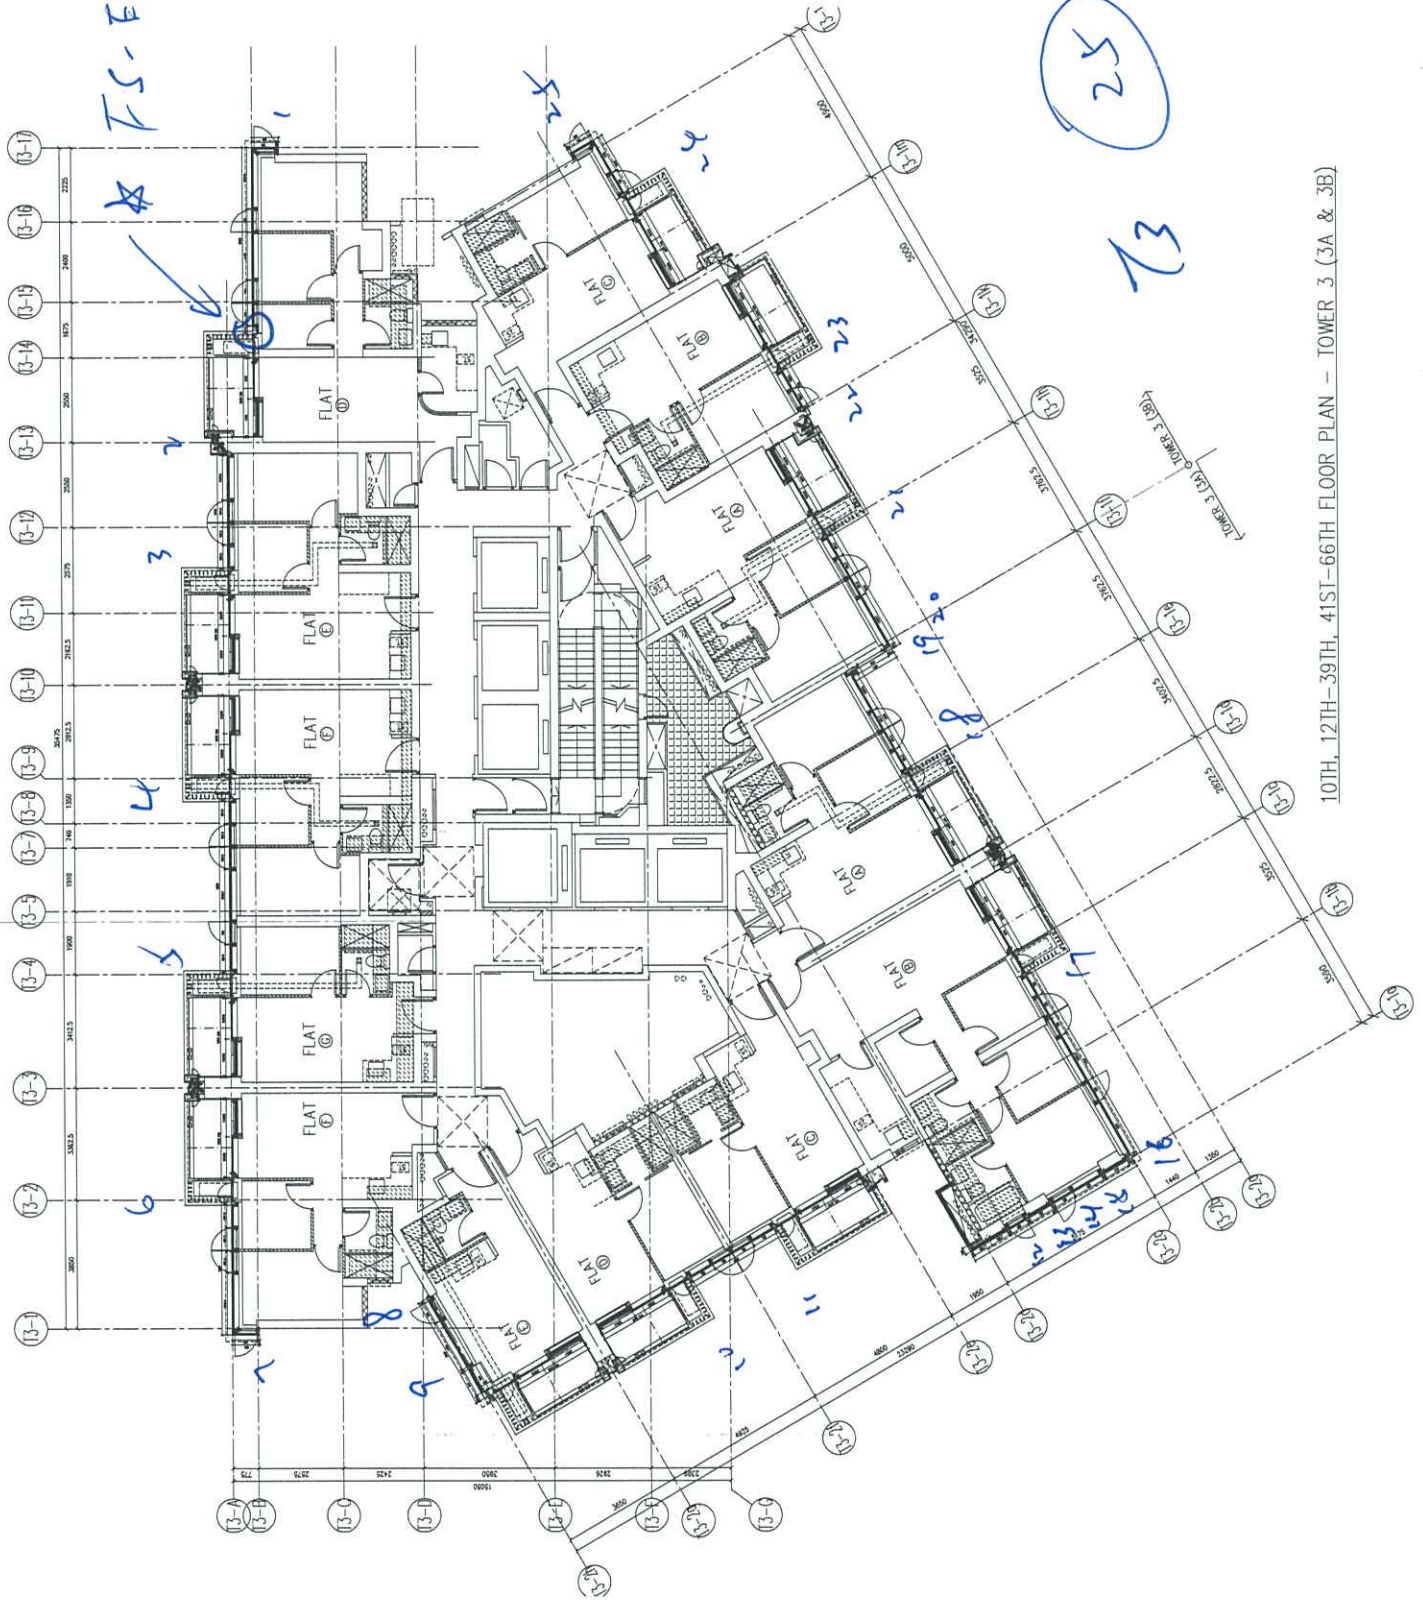

10TH, 12TH-39TH, 41ST-66TH FLOOR PLAN - TOWER 3 (3A & 3B)

25

23

17

16

19, 20

11

9

8

6

5

4

3

2

1

