



工程指示 / 要求簡箋(E.I.)

工程指示編號：EI / 6327 / 23

修改版次： -

工程編號：J - 858

工程名稱：將軍澳日出康城 11

工程項目：幕牆 地盆用防水片(11, 40 / F 隔火層單元底) #81件

收件人：生統

發件人：Ant Yeung

日期：09/06/2023

□要求提供 / □確認 事項：

- | | | |
|---------------|----------------|----------|
| () 初步鋁料 B.M. | () 加工拆圖，然後生產 | () 尺寸表 |
| () 正式鋁料 B.M. | () 技術上資料 / 指示 | () 報價 |
| () 配件 B.M. | () 樣辦或貨品說明書 | () 分判合約 |

內容：

按 2023.06.08 地盆現場商討，

請按加工圖生產防水片送地盆 11/F, 40/F 用， 所有防水片需銹化

分座打扎 和 11/F,40/F 分開打扎 #81件

此防水片為 幕牆 地盆用防水片(11, 40 / F 隔火層單元底)

露台有基仔

請在 2023.06.20 前完成上列要求。

附： 頁

□ 原合約工程包

□ 原合約工程加 / 減賬

□ 新工程報價

分發東莞各部門：

- | | | | |
|-----------------|----------------|---------------|-----------------|
| () 生產技術總監 □連附件 | () 技術部 □連附件 | () 生產部 □連附件 | () 機械設計部 □連附件 |
| () 採購部 □連附件 | (✓) 生產統籌部 □連附件 | (✓) 小羅&清 □連附件 | |
| () 質檢部 □連附件 | () 會計部 □連附件 | () 報關組 □連附件 | (✓) 其他 楊榮輝 □連附件 |

分發香港各部門：

- | | | | |
|--------------|---------------|--------------|---------------------|
| () 行政部 □連附件 | () 會計部 □連附件 | () 統籌部 □連附件 | (✓) 工程部地盤科文 積哥 □連附件 |
| () 採購部 □連附件 | () QS 部 □連附件 | () 維修部 □連附件 | () 其他 _____ □連附件 |


傳遞編號：

HK 1312 / 23

發件人簽署：

項目經理簽署：

編號 FS-CANOPY 11F40F

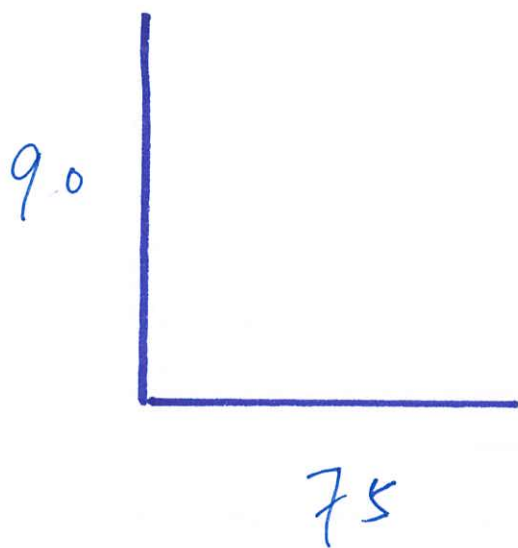

(已預長, 包仔)

L = 400mm

1.5 厚 mm

全包化

78 + 3

= 81 件

11, 40/F 露台 4 單位 54

底部加防水片 5 條

(露台有包仔)

	11/F	40/F	合共包
T1	13	13	13 件
T2	13	13	— 件
T3	13	13	
			46

From: j858@midiltd.com.hk <j858@midiltd.com.hk>
To: Billy.Kan@gammonconstruction.com, Rick.Chung@gammonconstruction.com,
j3931@gammonconstruction.com, KaHei.Wong@gammonconstruction.com,
Woody.Wong@gammonconstruction.com, Donny.Lo@gammonconstruction.com,
Terry.KT.Leung@gammonconstruction.com, Edward.Chiang@gammonconstruction.com,
Eunice.Tang@gammonconstruction.com, rss19084mw@rlphk.com,
P19084@rlp.asia, marinatong@rlp.asia,
ginnychau@rlp.asia, wallaceng@rlp.asia,
andywchan@sino.com, terrywan@sino.com,
simonspleung@sino.com, kennethleung@sino.com,
stephenchow@sino.com
Subject: LP11- CW - 露台單元件 底部加防水片方案
Copies to: jason.lcs.midi@gmail.com, ant.ysy.midi@gmail.com,
paul.wpc.midi@gmail.com
Date sent: Fri, 09 Jun 2023 10:38:32 +0800

Dear Stephen Sir


有關昨日地盆現場商討，
附上11F,40F 露台單元件 底部加防水片方案(見粉紅色Highlight)。


請查看。

謝謝

源

Attachments: T:\Jobs\J-858\7 Email & Letter\Email\to Gammon\20230609 露台單元件11F
40F 底部加防水片方案\20230609 露台單元件11F 40F 底部加防水片方案.pdf

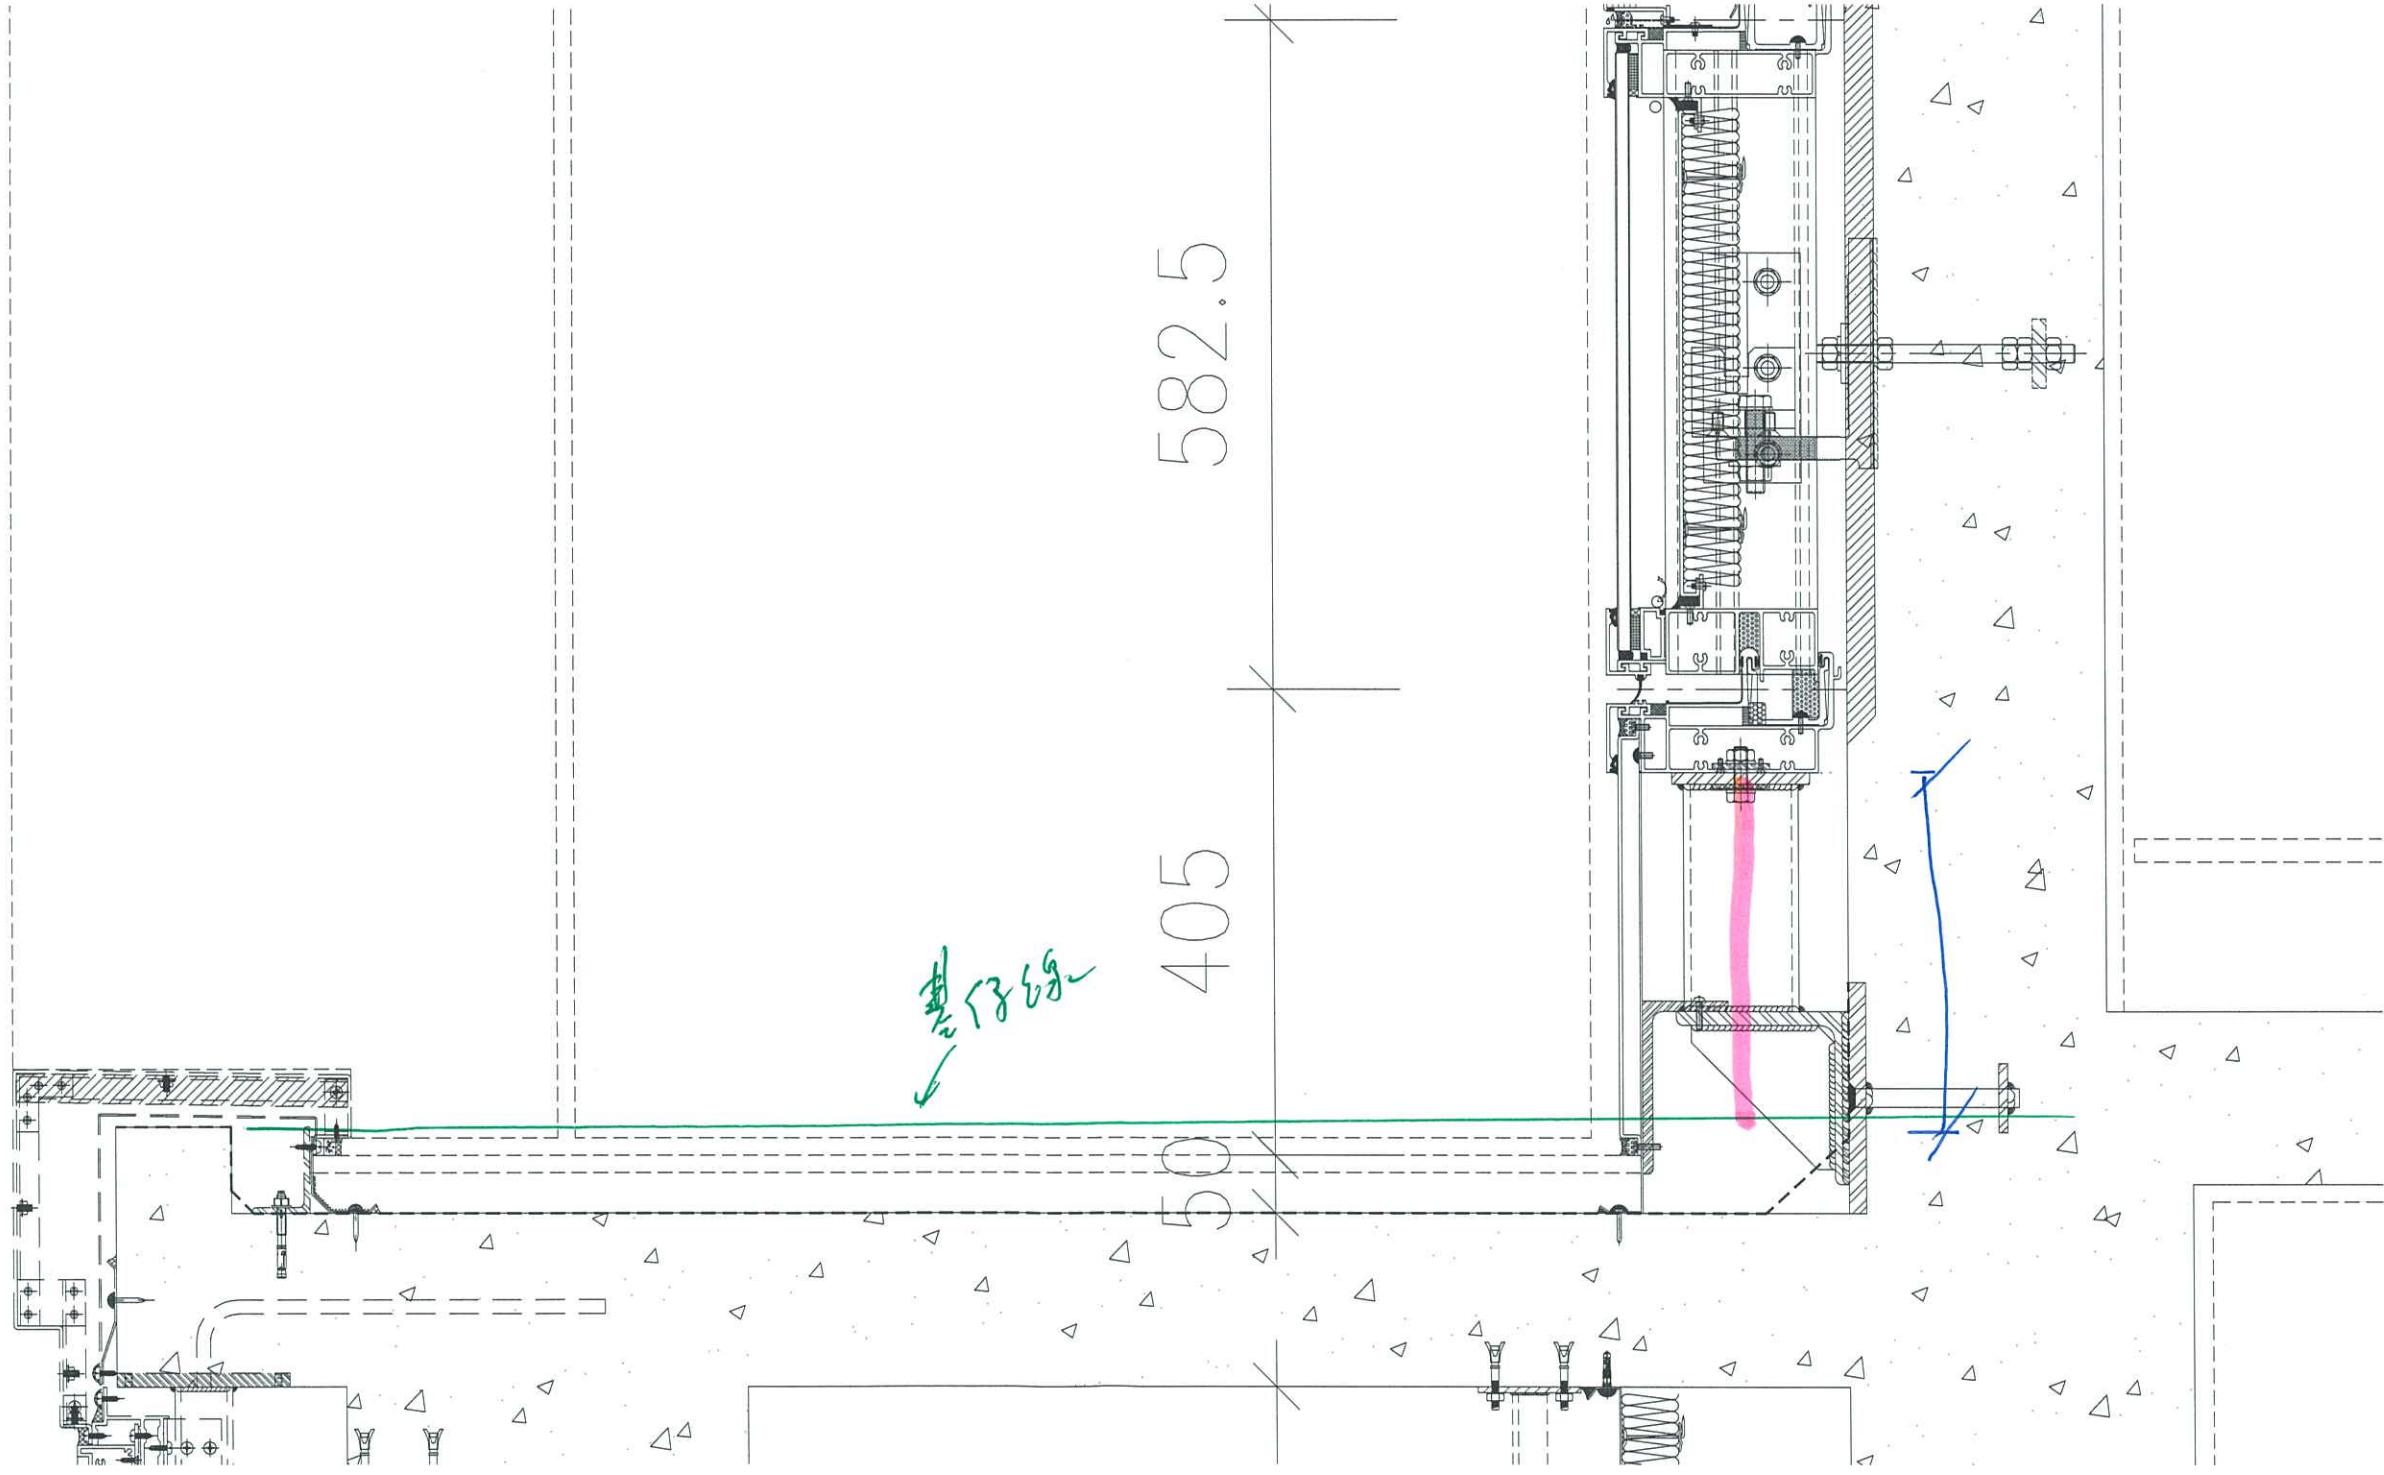

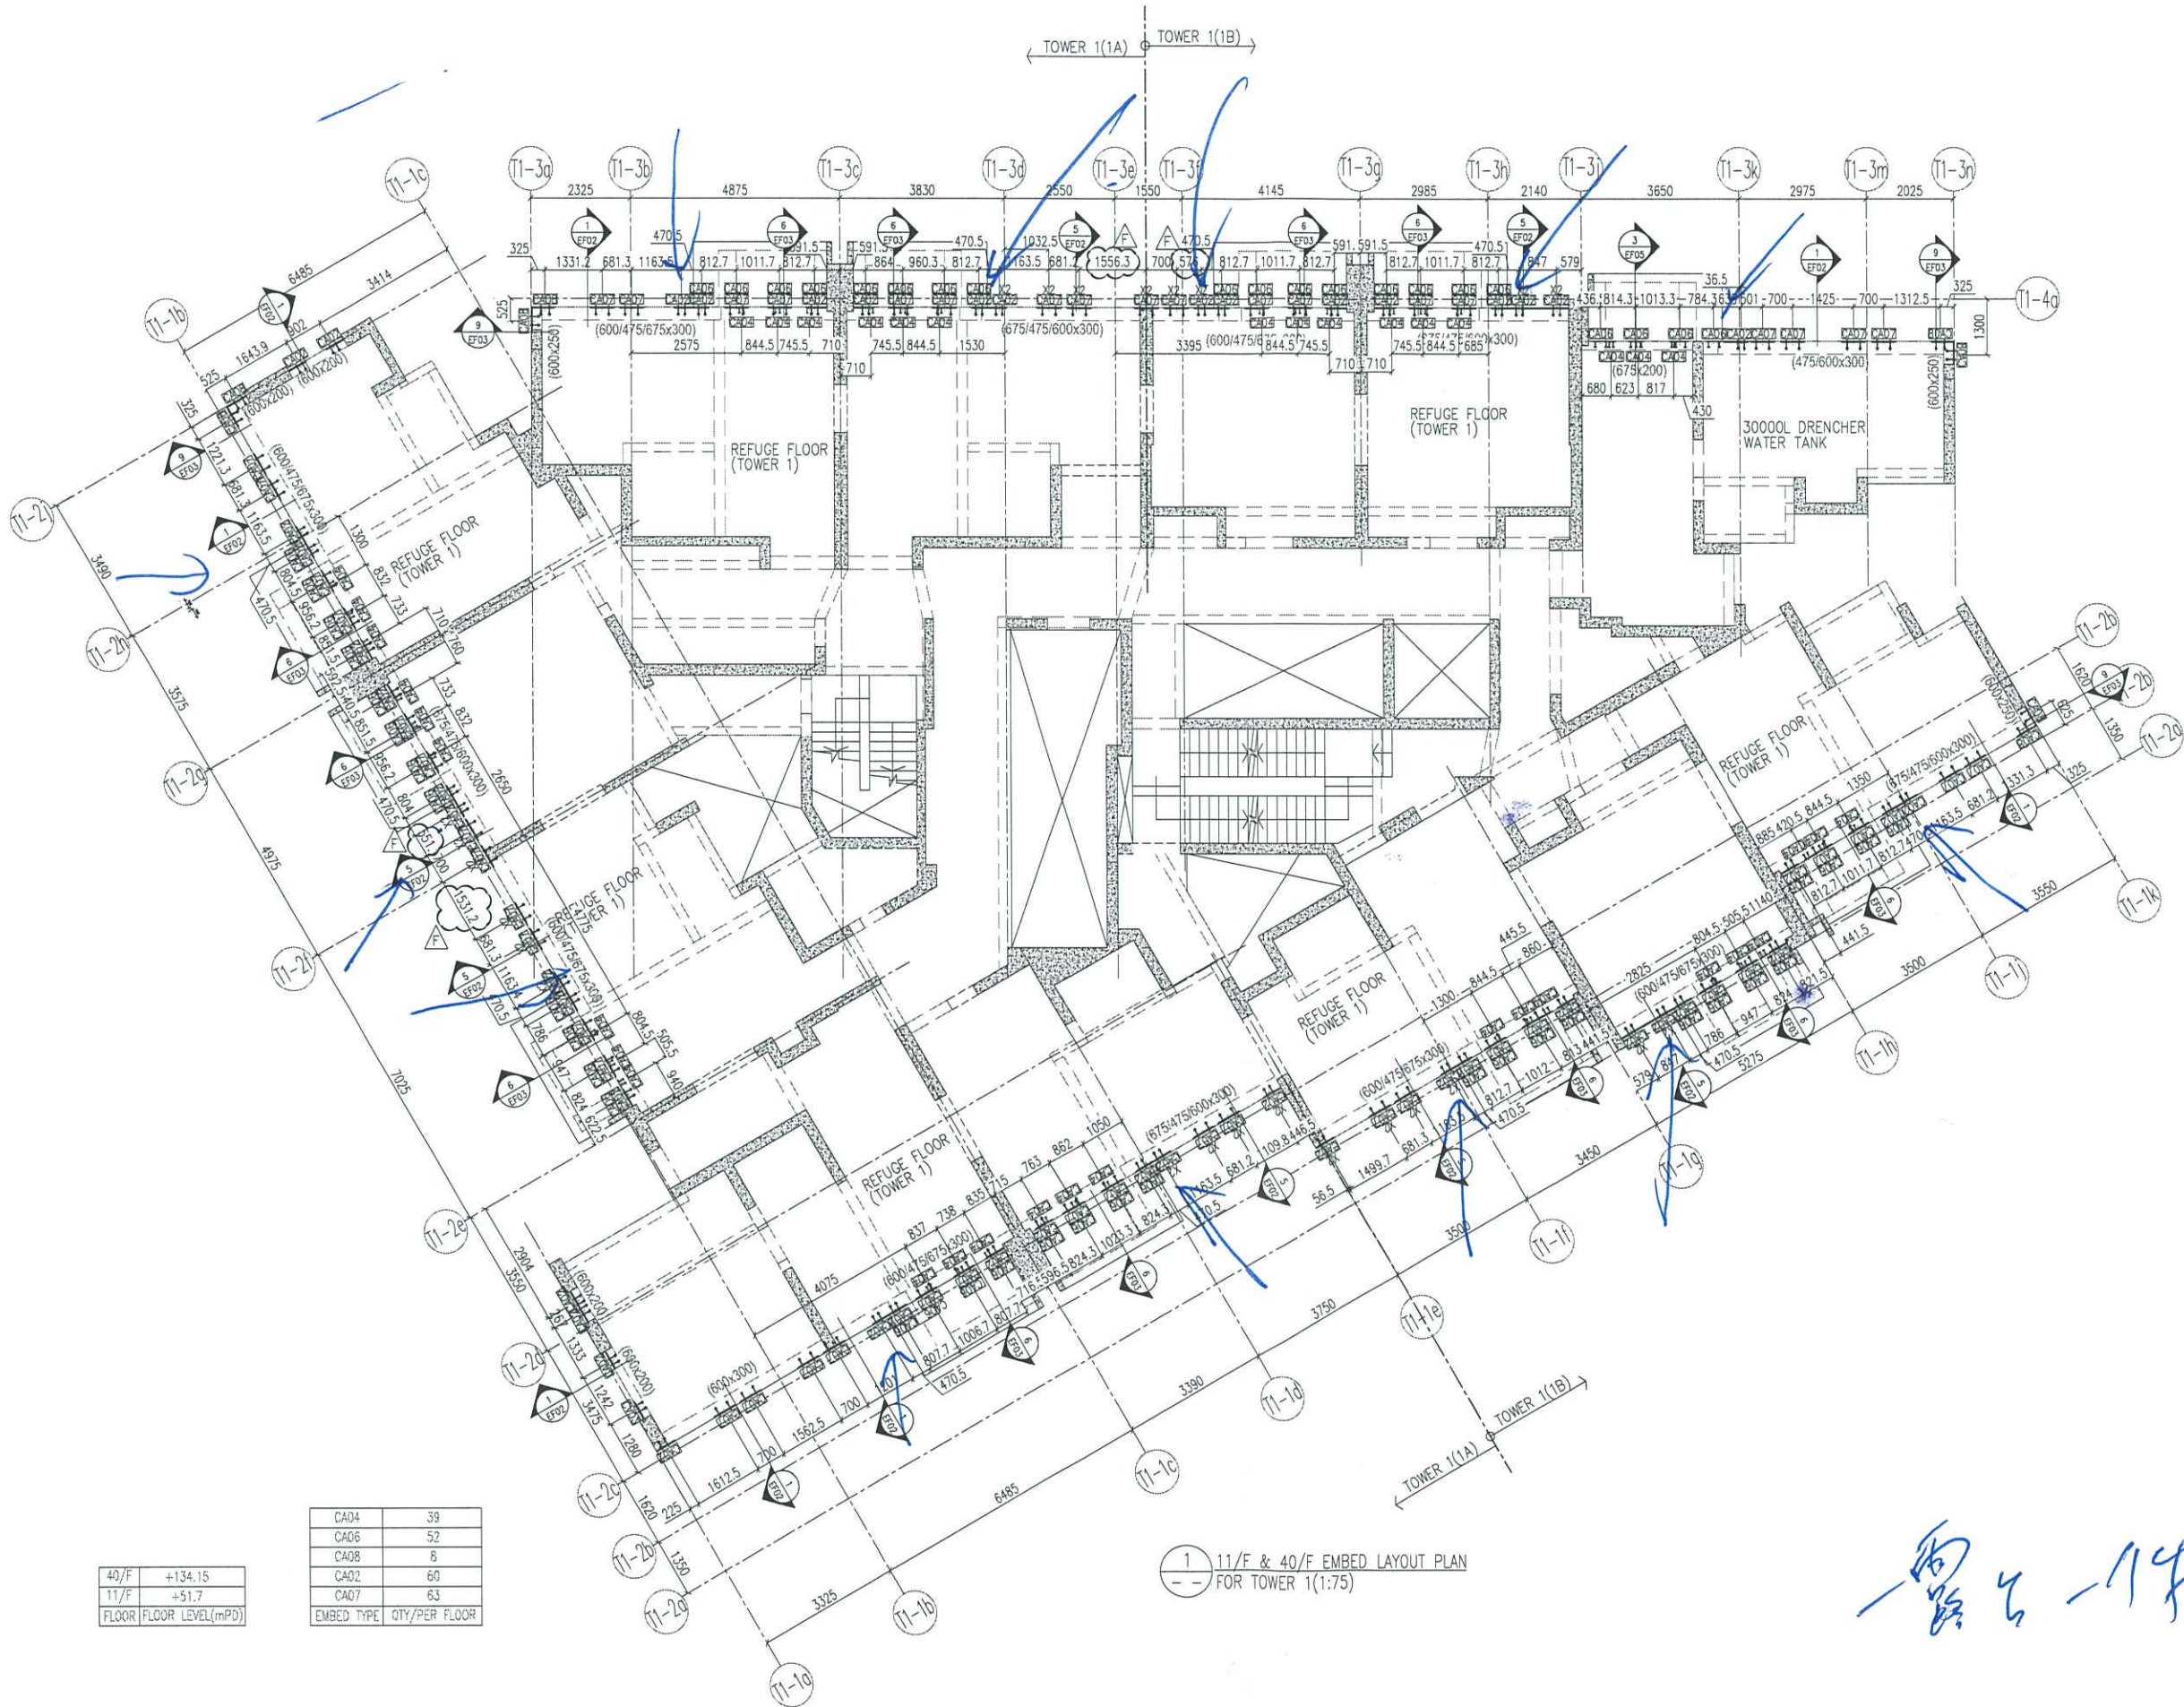

40/F	+134.15
11/F	+51.7
FLOOR	FLOOR LEVEL (mPD)

CA04	39
CA06	52
CA08	8
CA02	60
CA07	63
EMBED TYPE	QTY/PER FLOOR

1 11/F & 40/F EMBED LAYOUT PLAN FOR TOWER 1(1:75)

Handwritten signature and date: 2022-10-21

B.D. REF :

CLIENT :
 信和置業有限公司
 Sino Land Company Limited

ARCHITECT :
ronald lu & partners
 Architects, Planners, Interior Designers
 Ronald Lu & Partners (HK) Ltd.
 呂元祥建築師事務所 (香港) 有限公司

MAIN CONTRACTOR :
Gammon

STRUCTURAL ENGINEER :
AECOM

FACADE CONSULTANT:
AECOM

NOTE :
 1. ALL DIMENSIONS ARE IN mm.
 2. ALL ELEVATIONS ARE VIEWED FROM OUTSIDE.
 3. ALL DIMENSIONS TO BE VERIFIED ON SITE BEFORE FABRICATION.

LEGEND :
 (X1) --- DETAIL MARK NO.
 (X00) --- REFER SHEET NO.
 1. F.F.L. --- FINISHED FLOOR LEVEL
 2. S.F.L. --- STRUCTURAL FLOOR LEVEL
 3. (R) --- REVERSED DETAIL

F	25/12/22	REVISED AS PER COMMENTS	LS
E	28/09/22	REVISED AS PER COMMENTS	LS
D	26/07/22	REVISED AS PER COMMENTS	LS
C	26/05/22	REVISED AS PER COMMENTS	LS
B	06/04/22	REVISED AS PER COMMENTS	LS
A	16/02/22	REVISED AS PER COMMENTS	LS
NO.	DATE	REVISION	BY

JOB NO. : J-858

PROJECT :
 PROPOSED RESIDENTIAL DEVELOPMENT
 AT TKOTL 70RP, PHASE 11, LOHAS PARK
 TSEUNG KWAN O, N.T.

TITLE :
 11/F & 40/F EMBED LAYOUT PLAN
 AT TOWER 1

DATE : 22-OCT-21 SCALE : 1:75(A1)

DRAWN BY : KY CHECKED BY : YB

美特鋁質有限公司
 MIDI ALUMINIUM FABRICATOR LTD.
 Units 6-8, Sunray Industrial Centre, 1/F
 610 Cha Kwo Ling Road, Kowloon
 Tel:23489211-4 Fax:(852)27727666

DWG NO. : J858-CW-EP103 REV. : F