



工程指示 / 要求簡箋(E.I.)

工程指示編號：EI / 6546 / 23

修改版次：-

工程編號：J - 858

工程名稱：將軍澳日出康城 11

工程項目：幕牆單元件(上料台使用) 用 2 米平架出貨 40/F 以上 和 17/F 以上

收件人：生統

發件人：Paul Wong

日期：26/07/2023

內容：

因應使用上料台，請使用 2 米細平架作為出貨，因大於 2000mm，無法吊到上料台落貨。

1. 見附件後頁位置，共 3 柱 (17/F) 及以上的單元件 (只有 T1)，未出貨廠要改架。

2. 見附件後頁位置，共 16 柱 (40/F) 及以上的單元件以上 (T1,2,3)

3. 附上料台覆尺

謝謝

請在 2023.07.31 前完成上列要求。

分發東莞各部門：

- () 生產技術總監 連附件 () 技術部 連附件 () 生產部 連附件 () 機械設計部 連附件
 () 採購部 連附件 (✓) 生產統籌部 連附件 () 小羅&清 連附件
 () 質檢部 連附件 () 會計部 連附件 () 報關組 連附件 () 其他 _____ 連附件

分發香港各部門：

- () 行政部 連附件 () 會計部 連附件 () 統籌部 連附件 (✓) 工程部地盤科文 二寶，積哥 連附件
 () 採購部 連附件 () QS 部 連附件 () 維修部 連附件 () 其他 _____ 連附件

傳遞編號：

HK 1673 / 23

發件人簽署：

項目經理簽署：

有關17/F 上單元件：上料台和上料台旁用2000平架

最寬單元 邊至邊 mm

1	上料台	T1	BA	T1B	CW1	1773
2	上料台旁邊	T1	AA	T1A	CW1	1182
3	上料台旁邊	T1	BB	T1B	CW2	1335

有關40/F 上單元件：上料台和上料台旁用2000平架

最寬單元 邊至邊 mm

1	上料台	T1	AGBF	T1A	CW6	1578
2	上料台旁邊	T1	BE	T1B	CW5	1335
3	上料台	T1	ACAD	T1A	CW3	1552
4	上料台	T1	BA	T1B	CW1	1773
5	上料台旁邊	T1	AA	T1A	CW1	1182
6	上料台旁邊	T1	BB	T1B	CW2	1335
7	上料台	T2	AGBF	T2A	CW6	1590
8	上料台旁邊	T2	BE	T2B	CW5	1400
9	上料台	T2	BA	T2B	CW1	1798
10	上料台旁邊	T2	AA	T2A	CW1	1346
11	上料台旁邊	T2	BB	T2B	CW2	1335
12	上料台旁邊	T3	AGBF	T3A	CW6	1590
13	上料台	T3	BE	T3B	CW5	1400
14	上料台	T3	BA	T3B	CW1	1798
15	上料台旁邊	T3	AA	T3A	CW1	1346
16	上料台旁邊	T3	BB	T3B	CW2	1335

上料台餘下空間

寬度 $2670-300-300=2070\text{mm}$

高度 1900mm

平架

寬度 2000mm 邊至邊, 內籠1870mm

高度 約1500mm

T1A CW5 (17/F-36/F)
 單元生產: 22/07/23 52/72
 單元到貨: 15/08/23 (17-36/F)
 單元件安裝: 16/07-06/09/23 (17-36/F)
 防水片+試水+收口口安裝: 7/09/2023 ~06/10/2023

T1A CW6 (17/F-36/F)
 單元生產: 29/07/23 64/90
 單元到貨: 30/07/23 (17-36/F)
 單元件安裝: 31/07-22/08/23 (17-36/F)
 防水片+試水+收口口安裝: 23/08/2023 ~22/09/2023

T1B CW5 (17/F-36/F)
 單元生產: 29/07/23 13/18
 單元到貨: 30/07/23 (17-36/F)
 單元件安裝: 31/07-22/08/23 (17-36/F)
 防水片+試水+收口口安裝: 23/08/2023 ~22/09/2023

T1B CW4 (17/F-36/F)
 單元生產: 22/07/23 77/108
 單元到貨: 15/08/23 (17-36/F)
 單元件安裝: 16/07-06/09/23 (17-36/F)
 防水片+試水+收口口安裝: 7/09/2023 ~06/10/2023

8.14.2
 7..

次序6
 T1AE CW4

次序5
 T1AF CW5

次序2
 T1AGBF CW6

次序1
 T1BE CW5

次序3
 T1BD CW4

已裝完monorail
 7/19 改棚 (打風改期)
 7/24 驗機
 拆棚7/25
 拆挑棚工字7/28
 Set 船

65/90

已裝完monorail
 改棚 7/21
 驗機7/25
 拆棚7/26
 拆挑棚工字7/29
 Set 船

已裝完monorail
 改棚 7/21
 驗機7/25
 拆棚7/26
 拆挑棚工字7/29
 Set 船

驗機7/19 (打風改期)
 拆棚7/20
 拆挑棚工字7/23
 Set 船

驗機7/19 (打風改期)
 拆棚7/20
 拆挑棚工字7/23
 Set 船

次序11
 T1BC CW3

17/F-36/F floor



T1A CW4 (17/F-36/F)
 單元生產: 22/07/23
 單元到貨: 22/08/23 (17-36/F)
 單元件安裝: 23/07-13/09/23 (17-36/F)
 防水片+試水+收口口安裝: 14/09/2023 ~13/10/2023
 Glass Cladding 24/09-13/10/23

已裝完monorail
 改棚 7/21
 驗機7/25
 拆棚7/26
 拆挑棚工字7/29
 Set 船

已裝完monorail
 改棚 7/24
 驗機7/28
 拆棚7/31
 拆挑棚工字8/3
 Set 船

裝monorail 7/24
 改棚 7/25
 驗機7/28
 拆棚7/31
 拆挑棚工字8/3
 Set 船

已到monorail
 7/27 裝完monorail
 7/28 改棚
 8/1 驗機
 拆棚8/2
 拆挑棚工字8/5
 Set 船

次序11
 T1BC CW3

T1B CW3 (17/F-36/F)
 單元生產: 22/07/23 52/72
 單元到貨: 22/08/23 (17-36/F)
 單元件安裝: 23/07-13/09/23 (17-36/F)
 防水片+試水+收口口安裝: 14/09/2023 ~13/10/2023

ACAD
 次序4
 T1ACAD CW3

已裝完monorail
 7/19 改棚 (打風改期)
 7/24 驗機
 拆棚7/25
 拆挑棚工字7/28
 Set 船

已裝完monorail
 7/24 改棚
 7/31 驗機
 拆棚8/1
 拆挑棚工字8/5
 Set 船

裝monorail 7/24
 改棚 7/25
 驗機7/28
 拆棚7/31
 拆挑棚工字8/3
 Set 船

已到monorail
 7/27 裝完monorail
 7/28 改棚
 8/1 驗機
 拆棚8/2
 拆挑棚工字8/5
 Set 船

已到monorail
 7/27 裝完monorail
 7/28 改棚
 8/1 驗機
 拆棚8/2
 拆挑棚工字8/5
 Set 船

T1A CW3 (17/F-36/F)
 單元生產: 29/07/23 65/90
 單元到貨: 30/07/23 (17-36/F)
 單元件安裝: 31/07-22/08/23 (17-36/F)
 防水片+試水+收口口安裝: 23/08/2023 ~22/09/2023

已裝完monorail
 7/24 改棚
 7/31 驗機
 拆棚8/1
 拆挑棚工字8/5
 Set 船

次序8
 T1AA CW1

次序9
 T1BA CW1

次序10
 T1BB CW2

T1B CW1 (17/F-36/F)
 單元生產: 29/07/23 39/54
 單元到貨: 03/08/23 (17-36/F)
 單元件安裝: 04/08-26/08/23 (17-36/F)
 防水片+試水+收口口安裝: 27/08/2023 ~26/09/2023

ARCH. FEATURE AT 10/F, 12/F, 15/F-16/F, 18/F-20/F, 22/F, 23/F, 25/F, 27/F-29/F, 31/F-33/F, 36/F-38/F, 40/F-42/F, 45/F-47/F, 49/F-51/F, 53/F-56/F, 58/F-60/F

已裝完monorail
 7/24 改棚
 7/31 驗機
 拆棚8/1
 拆挑棚工字8/5
 Set 船

T1A CW1 (17/F-36/F)
 單元生產: 29/07/23 39/54
 單元到貨: 03/08/23 (17-36/F)
 單元件安裝: 04/08-26/08/23 (17-36/F)
 防水片+試水+收口口安裝: 27/08/2023 ~26/09/2023

次序7
 T1AB CW2

已裝完monorail
 7/24 改棚
 7/31 驗機
 拆棚8/1
 拆挑棚工字8/5
 Set 船

T1A CW2 (17/F-36/F)
 單元生產: 22/07/23 90/126
 單元到貨: 22/08/23 (17-36/F)
 單元件安裝: 23/07-13/09/23 (17-36/F)
 防水片+試水+收口口安裝: 14/09/2023 ~13/10/2023
 Glass Cladding 24/09-13/10/23

1	T1B CW4	6	
2	T1B CW5	1	
	T1A CW6	5	12
	T1A CW5	4	
	T1A CW4	5	9 4
	T1A CW3	5	
	T1A CW2	7	12 4
8	T1A CW1	3	
9	T1B CW1	3	
10	T1B CW2	1	
11	T1B CW3	4	11

Cladding 件數

A	NO.	DATE	REVISED AS PER COMMENTS	LS	BY
		03/12/21			

JOB NO.: J-858

PROJECT: PROPOSED RESIDENTIAL DEVELOPMENT AT TKOIL 70RP, PHASE 11, LOKAS PARK TSEUNG KWAN O, N.T.


TITLE: TYPICAL FLOOR PLAN AT TOWER 1

DATE: 22-OCT-21 SCALE: 1:75(A1)

DRAWN BY: KY CHECKED BY: YB

美特鋁質有限公司
 MIDI ALUMINIUM FABRICATOR LTD.
 Units 6-8, Sunray Industrial Centre, 1/F
 810 Che Kwo Ling Road, Kowloon
 Tel: 23489211-4 Fax: (852) 27272666

DWG NO.: J858-CW-LP101 REV.: C

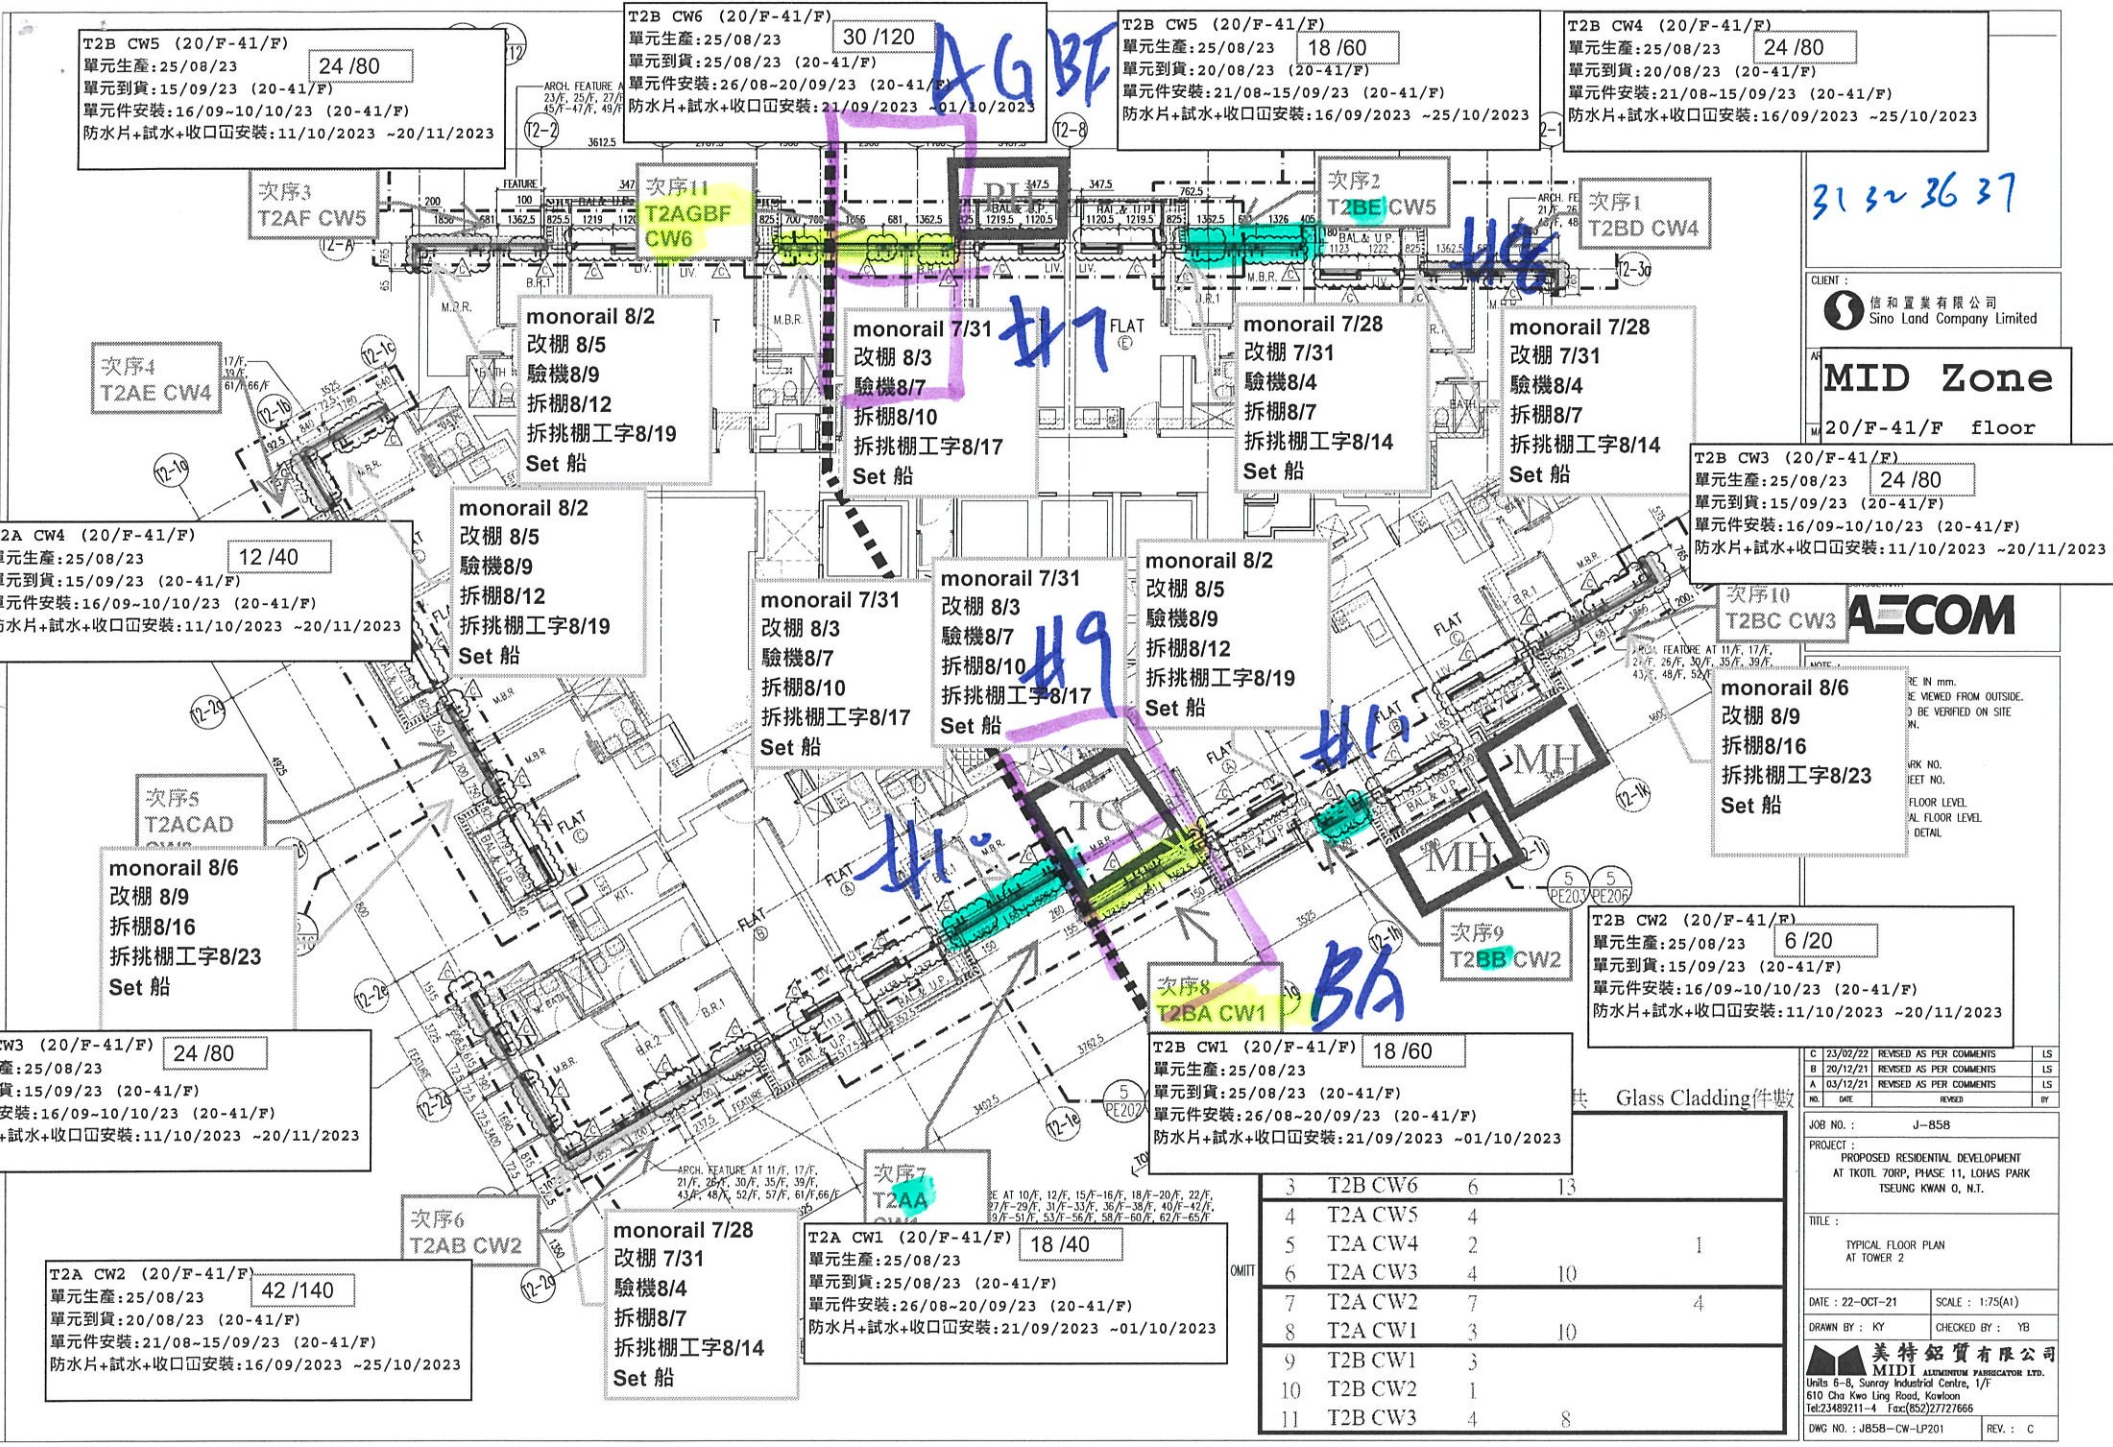

31 32 36 37

信和置業有限公司
Sino Land Company Limited

MID Zone
20/F-41/F floor

AECOM

RE IN mm.
BE VIEWED FROM OUTSIDE.
BE VERIFIED ON SITE
PL.

WRK NO.
HEET NO.

FLOOR LEVEL
AL FLOOR LEVEL
DETAIL

T2B CW2 (20/F-41/F)
單元生產: 25/08/23
單元到貨: 15/09/23 (20-41/F)
單元件安裝: 16/09-10/10/23 (20-41/F)
防水片+試水+收口安裝: 11/10/2023 ~20/11/2023

共 Glass Cladding 件數

3	T2B CW6	6	13
4	T2A CW5	4	
5	T2A CW4	2	1
6	T2A CW3	4	10
7	T2A CW2	7	4
8	T2A CW1	3	10
9	T2B CW1	3	
10	T2B CW2	1	
11	T2B CW3	4	8

C	23/02/22	REVISED AS PER COMMENTS	LS
B	20/12/21	REVISED AS PER COMMENTS	LS
A	03/12/21	REVISED AS PER COMMENTS	LS
NO.	DATE	REVISED	BY

JOB NO.: J-858

PROJECT:
PROPOSED RESIDENTIAL DEVELOPMENT
AT TKOIL 70RP, PHASE 11, LOHAS PARK
TSEUNG KWAN O, N.T.

TITLE:
TYPICAL FLOOR PLAN
AT TOWER 2

DATE: 22-OCT-21 SCALE: 1:75(A1)

DRAWN BY: KY CHECKED BY: YB

美特鋁質有限公司
MIDI ALUMINIUM FABRICATOR LTD.
Units 6-8, Sunray Industrial Centre, 1/F
610 Cha Kwo Ling Road, Kowloon
Tel: 23489211-4 Fax: (852) 27272666

DWG NO.: JBSB-CW-LP201 REV.: C

T2B CW5 (20/F-41/F)
單元生產: 25/08/23
單元到貨: 15/09/23 (20-41/F)
單元件安裝: 16/09-10/10/23 (20-41/F)
防水片+試水+收口安裝: 11/10/2023 ~20/11/2023

T2B CW6 (20/F-41/F)
單元生產: 25/08/23
單元到貨: 25/08/23 (20-41/F)
單元件安裝: 26/08-20/09/23 (20-41/F)
防水片+試水+收口安裝: 21/09/2023 ~01/10/2023

T2B CW5 (20/F-41/F)
單元生產: 25/08/23
單元到貨: 20/08/23 (20-41/F)
單元件安裝: 21/08-15/09/23 (20-41/F)
防水片+試水+收口安裝: 16/09/2023 ~25/10/2023

T2B CW4 (20/F-41/F)
單元生產: 25/08/23
單元到貨: 20/08/23 (20-41/F)
單元件安裝: 21/08-15/09/23 (20-41/F)
防水片+試水+收口安裝: 16/09/2023 ~25/10/2023

次序3
T2AF CW5

次序11
T2AGBF
CW6

次序2
T2BE CW5

次序1
T2BD CW4

次序4
T2AE CW4

monorail 8/2
改棚 8/5
驗機 8/9
拆棚 8/12
拆挑棚工字 8/19
Set 船

monorail 7/31
改棚 8/3
驗機 8/7
拆棚 8/10
拆挑棚工字 8/17
Set 船

monorail 7/28
改棚 7/31
驗機 8/4
拆棚 8/7
拆挑棚工字 8/14
Set 船

monorail 7/28
改棚 7/31
驗機 8/4
拆棚 8/7
拆挑棚工字 8/14
Set 船

T2B CW3 (20/F-41/F)
單元生產: 25/08/23
單元到貨: 15/09/23 (20-41/F)
單元件安裝: 16/09-10/10/23 (20-41/F)
防水片+試水+收口安裝: 11/10/2023 ~20/11/2023

T2A CW4 (20/F-41/F)
單元生產: 25/08/23
單元到貨: 15/09/23 (20-41/F)
單元件安裝: 16/09-10/10/23 (20-41/F)
防水片+試水+收口安裝: 11/10/2023 ~20/11/2023

monorail 8/2
改棚 8/5
驗機 8/9
拆棚 8/12
拆挑棚工字 8/19
Set 船

monorail 7/31
改棚 8/3
驗機 8/7
拆棚 8/10
拆挑棚工字 8/17
Set 船

monorail 7/31
改棚 8/3
驗機 8/9
拆棚 8/12
拆挑棚工字 8/19
Set 船

monorail 8/2
改棚 8/5
驗機 8/9
拆棚 8/12
拆挑棚工字 8/19
Set 船

次序10
T2BC CW3
monorail 8/6
改棚 8/9
拆棚 8/16
拆挑棚工字 8/23
Set 船

次序5
T2ACAD
CW5

monorail 8/6
改棚 8/9
拆棚 8/16
拆挑棚工字 8/23
Set 船

T2A CW3 (20/F-41/F)
單元生產: 25/08/23
單元到貨: 15/09/23 (20-41/F)
單元件安裝: 16/09-10/10/23 (20-41/F)
防水片+試水+收口安裝: 11/10/2023 ~20/11/2023

次序6
T2AB CW2


T2A CW2 (20/F-41/F)
單元生產: 25/08/23
單元到貨: 20/08/23 (20-41/F)
單元件安裝: 21/08-15/09/23 (20-41/F)
防水片+試水+收口安裝: 16/09/2023 ~25/10/2023

monorail 7/28
改棚 7/31
驗機 8/4
拆棚 8/7
拆挑棚工字 8/14
Set 船

T2A CW1 (20/F-41/F)
單元生產: 25/08/23
單元到貨: 25/08/23 (20-41/F)
單元件安裝: 26/08-20/09/23 (20-41/F)
防水片+試水+收口安裝: 21/09/2023 ~01/10/2023

次序8
T2BA CW1
T2B CW1 (20/F-41/F)
單元生產: 25/08/23
單元到貨: 25/08/23 (20-41/F)
單元件安裝: 26/08-20/09/23 (20-41/F)
防水片+試水+收口安裝: 21/09/2023 ~01/10/2023

次序7
T2AA

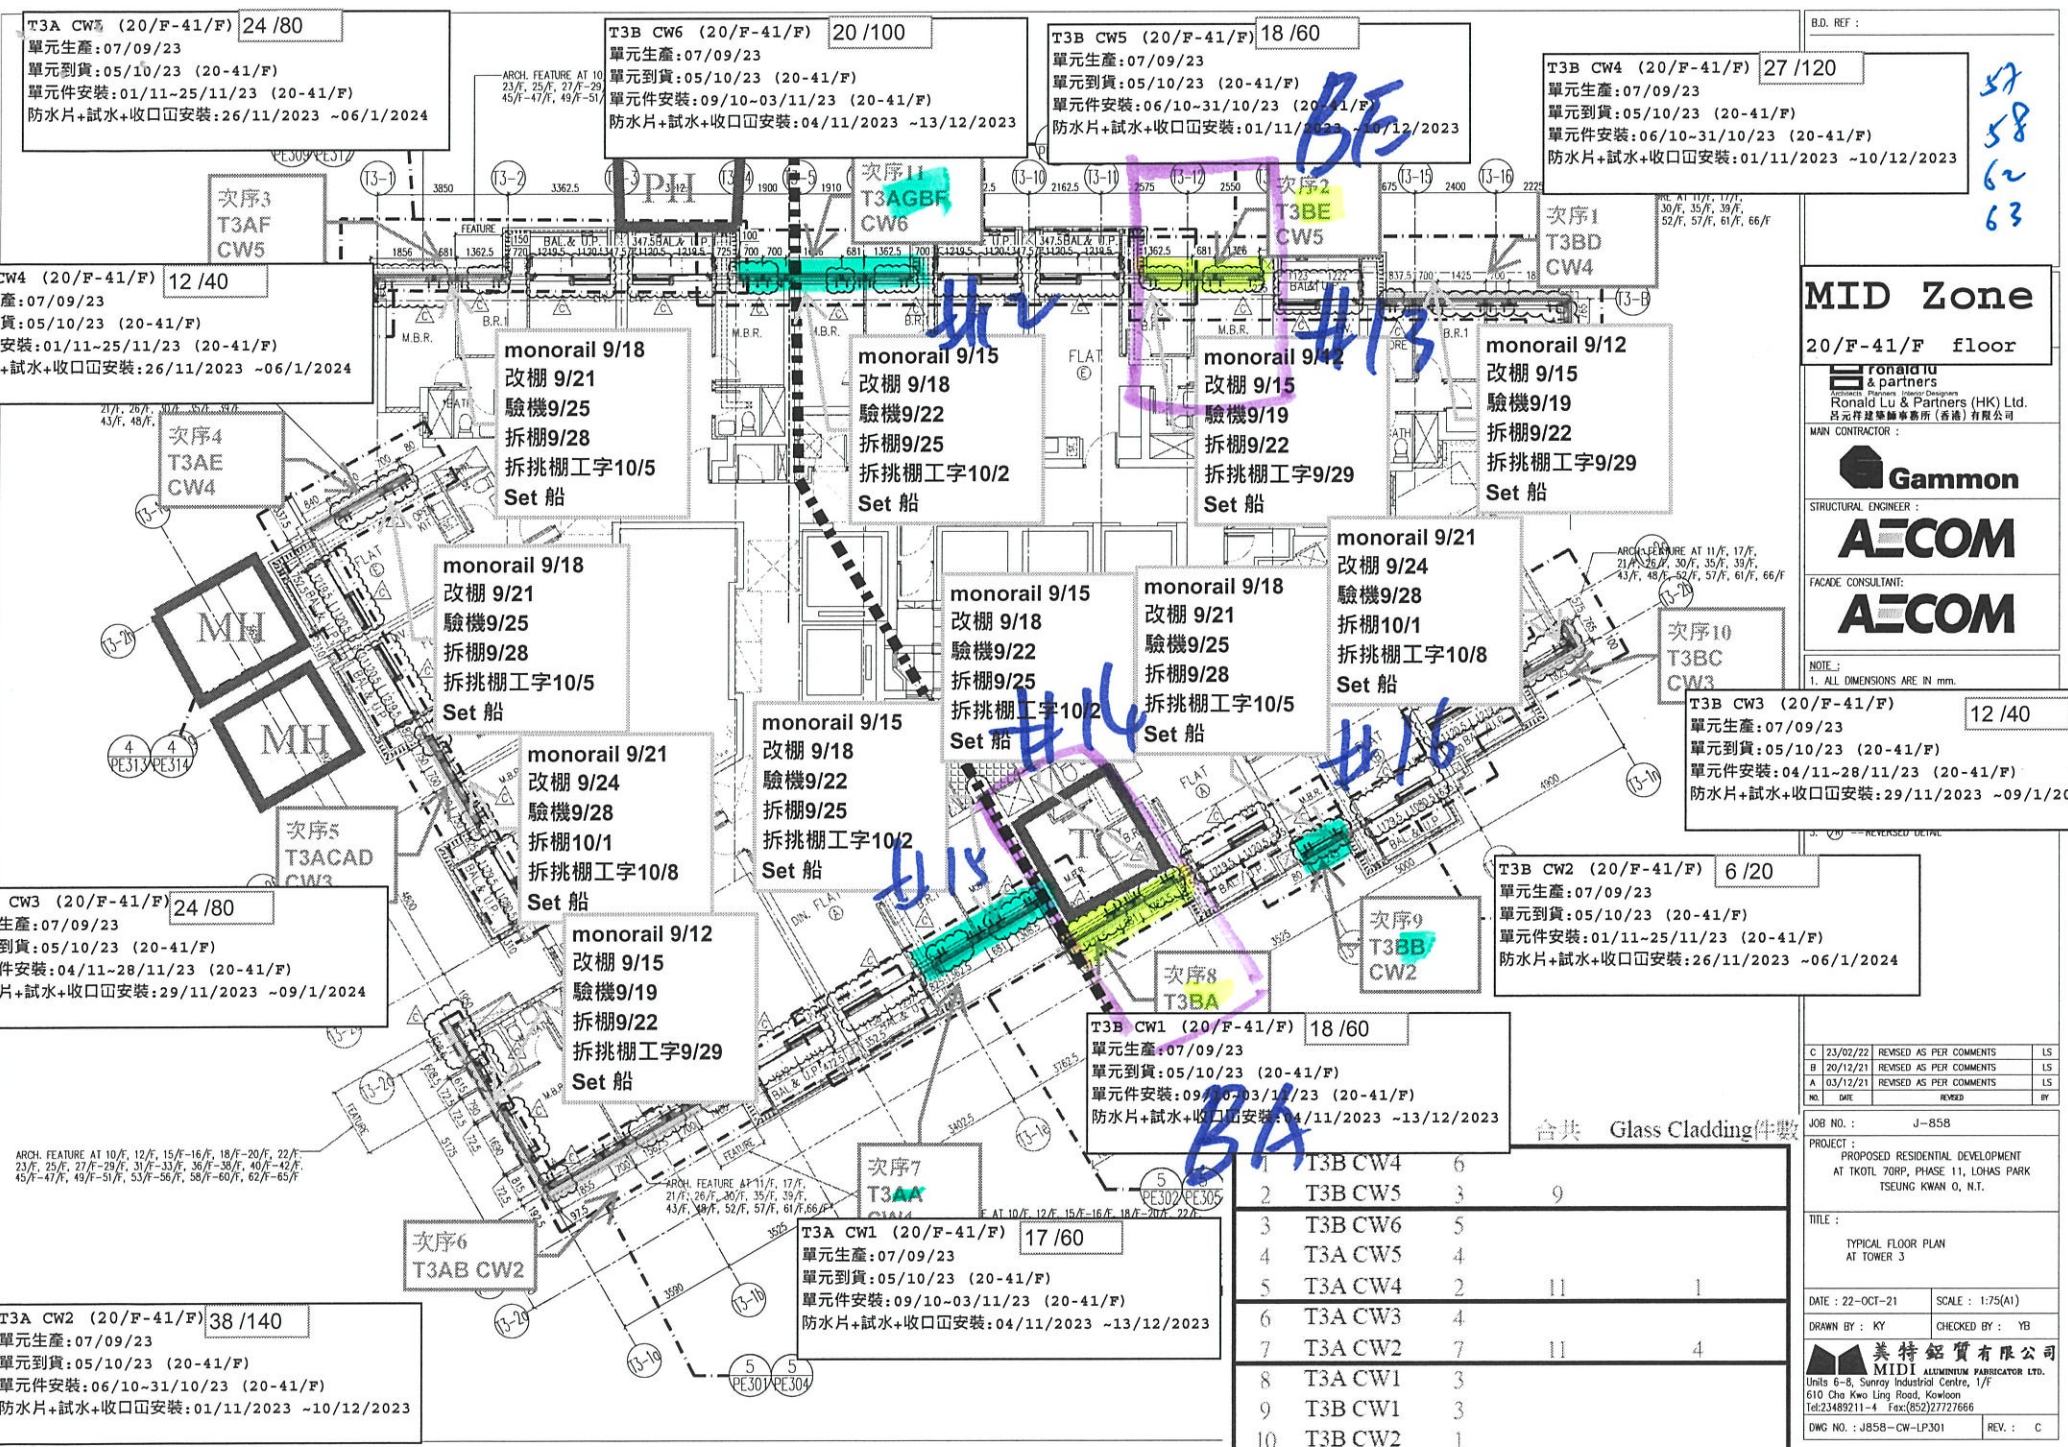

B.D. REF :

57
58
62
63

MID Zone

20/F-41/F floor

Ronald Lu & Partners
Ronald Lu & Partners (HK) Ltd.
呂元祥建築師事務所 (香港) 有限公司

MAIN CONTRACTOR :
Gammon

STRUCTURAL ENGINEER :
AECOM

FACADE CONSULTANT :
AECOM

NOTE :
1. ALL DIMENSIONS ARE IN mm.

T3B CW3 (20/F-41/F) 12 /40
單元生產: 07/09/23
單元到貨: 05/10/23 (20-41/F)
單元件安裝: 04/11-28/11/23 (20-41/F)
防水片+試水+收口凸安裝: 29/11/2023 ~09/1/2024

T3B CW2 (20/F-41/F) 6 /20
單元生產: 07/09/23
單元到貨: 05/10/23 (20-41/F)
單元件安裝: 01/11-25/11/23 (20-41/F)
防水片+試水+收口凸安裝: 26/11/2023 ~06/1/2024

NO.	DATE	REVISION	BY
C	23/02/22	REVISED AS PER COMMENTS	LS
B	20/12/21	REVISED AS PER COMMENTS	LS
A	03/12/21	REVISED AS PER COMMENTS	LS

JOB NO. : J-858

PROJECT :
PROPOSED RESIDENTIAL DEVELOPMENT
AT TKOIL 709P, PHASE 11, LOHAS PARK
TSEUNG KWAN O, N.T.

TITLE :
TYPICAL FLOOR PLAN
AT TOWER 3

DATE : 22-OCT-21 SCALE : 1:75(A1)
DRAWN BY : KY CHECKED BY : YB

美特鋁質有限公司
MIDI ALUMINIUM FABRICATOR LTD.
Units 6-8, Sunray Industrial Centre, 1/F
610 Che Kwo Ling Road, Kowloon
Tel: 23489211-4 Fax: (852) 27727666

DWG NO. : J858-CW-LP301 REV. : C

合共 Glass Cladding 件數

1	T3B CW4	6		
2	T3B CW5	3	9	
3	T3B CW6	5		
4	T3A CW5	4		
5	T3A CW4	2	11	1
6	T3A CW3	4		
7	T3A CW2	7	11	4
8	T3A CW1	3		
9	T3B CW1	3		
10	T3B CW2	1		
11	T3B CW3	2	9	

1900

1070

2670



