



## 工程指示 / 要求簡箋(E.I.)

工程指示編號：EI / 6570 / 23

修改版次： -

工程編號：J - 858

工程名稱：將軍澳日出康城 11

工程項目：幕牆 配件 大梗頂 訂黑膠 BM

收件人：生統 / 楊榮輝

發件人：Paul Wong 日期：01/08/2023

□要求提供 / □確認 事項：

- |                                    |                                     |                               |
|------------------------------------|-------------------------------------|-------------------------------|
| <input type="checkbox"/> 初步鋁料 B.M. | <input type="checkbox"/> 加工拆圖，然後生產  | <input type="checkbox"/> 尺寸表  |
| <input type="checkbox"/> 正式鋁料 B.M. | <input type="checkbox"/> 技術上資料 / 指示 | <input type="checkbox"/> 報價   |
| <input type="checkbox"/> 配件 B.M.   | <input type="checkbox"/> 樣辦或貨品說明書   | <input type="checkbox"/> 分判合約 |

內容：

由於業主要求，幕牆 大梗頂改用黑色。請按廠用配件 BM 訂購黑膠供廠使用。

謝謝

請在 2023.08.15 前完成上列要求。

分發東莞各部門：

- |                                 |                              |   |   |  |   |  |  |
|---------------------------------|------------------------------|---|---|--|---|--|--|
| <input type="checkbox"/> 生產技術總監 | <input type="checkbox"/> 連附件 | <input type="checkbox"/> 技術部              | <input type="checkbox"/> 連附件            | <input type="checkbox"/> 生產部             | <input type="checkbox"/> 連附件            | <input type="checkbox"/> 機械設計部         | <input type="checkbox"/> 連附件                       |
| <input type="checkbox"/> 採購部    | <input type="checkbox"/> 連附件 | <input checked="" type="checkbox"/> 生產統籌部 | <input checked="" type="checkbox"/> 連附件 | <input checked="" type="checkbox"/> 小羅&清 | <input checked="" type="checkbox"/> 連附件 |  |  |
| <input type="checkbox"/> 質檢部    | <input type="checkbox"/> 連附件 | <input type="checkbox"/> 會計部              | <input type="checkbox"/> 連附件            | <input type="checkbox"/> 報關組             | <input type="checkbox"/> 連附件            | <input checked="" type="checkbox"/> 其他 | <u>楊榮輝</u> <input checked="" type="checkbox"/> 連附件 |

分發香港各部門：

- |                              |                              |                               |                              |                              |                              |                                  |                                    |
|------------------------------|------------------------------|-------------------------------|------------------------------|------------------------------|------------------------------|----------------------------------|------------------------------------|
| <input type="checkbox"/> 行政部 | <input type="checkbox"/> 連附件 | <input type="checkbox"/> 會計部  | <input type="checkbox"/> 連附件 | <input type="checkbox"/> 統籌部 | <input type="checkbox"/> 連附件 | <input type="checkbox"/> 工程部地盤科文 | <input type="checkbox"/> 連附件       |
| <input type="checkbox"/> 採購部 | <input type="checkbox"/> 連附件 | <input type="checkbox"/> QS 部 | <input type="checkbox"/> 連附件 | <input type="checkbox"/> 維修部 | <input type="checkbox"/> 連附件 | <input type="checkbox"/> 其他      | _____ <input type="checkbox"/> 連附件 |

傳遞編號：

HK1712/23

發件人簽署：

項目經理簽署：

美特鋁質有限公司 MIDI Aluminium Fabricator Ltd.	工程號:	J-858	計算:	shaw	日期:	1/8/2023	送呈:	
	地盤名稱:	康城11期	核對:		日期:		副本:	
廠用配件B.M.表(特色層總表)	項目類別:	单元幕墙	批准:		日期:			
BM編號:	A/C Code : EI 6570 2023/8/1							

序號	修改標示	配件圖號	物料編號	配件名稱	顏色	實用	後備	總數	單位	備注
1				DOWSIL 791	黑色	4500		4500	米	大梗訂轉黑膠用


单元板部分			
部件编号	数量	长度	总长度
X86306-01A	24	1840	44.16
X86306-01B	232	685	158.92
X86306-01E	46	650	29.9
X86306-01F	11	1625	17.875
X86306-01G	35	1547.5	54.1625
X86306-01H	146	1385	202.21
X86306-01J	238	1347.5	320.705
X86306-01K	127	666	84.582
X86306-01L	46	1410	64.86
X86306-01M	22	1285	28.27
X86306-01N	11	1815	19.965
X86306-01P	100	600	60
X86306-01Q	25	1675	41.875
X86306-01R	24	1765	42.36
X86306-01S	24	1712.5	41.1
X86306-01T	24	1575	37.8
X86306-02A	81	1789	144.909
X86306-02B	92	697.5	64.17
X86306-02E	24	1757.5	42.18
X86306-03A	24	1789	42.936
X86306-03B	105	697.5	73.2375
X86306-03C	46	1770	81.42
X86306-03D	22	1679	36.938
X86306-04A	24	1840	44.16
X86306-04B	232	685	158.92
x86306-04E	46	650	29.9
x86306-04F	11	1625	17.875
X86306-04G	35	1547.5	54.1625
x86306-04H	146	1385	202.21
x86306-04J	238	1347.5	320.705
X86306-04K	127	666	84.582
x86306-04L	46	1410	64.86
x86306-04M	22	1285	28.27
X86306-04N	11	1815	19.965
X86306-04P	100	600	60
x86306-04Q	24	1675	40.2
X86306-04R	24	1765	42.36
X86306-04S	24	1712.5	41.1
x86306-04T	24	1575	37.8
X86306-05A	24	1789	42.936
X86306-05B	105	697.5	73.2375
X86306-05C	46	1770	81.42
X86306-05D	22	1679	36.938
X86306-06A	81	1789	144.909
x86306-06B	92	697.5	64.17
x86306-06E	24	1757.5	42.18
			3467.395

Glass Cladding部分			
部件编号	数量	长度	总长度
X86306-GC01-01	292	592	172.864
X86306-GC01-02	35	773	27.055
X86306-GC01-03	83	798	66.234
X86306-GC01-04	46	596.5	27.439
X86306-GC01-05	23	1043	23.989
X86306-GC01-06	25	823	20.575
X86306-GC02-01	24	265	6.36
X86306-GC03-02	24	210	5.04
X86306-GC04-01	292	592	172.864
X86306-GC04-02	35	773	27.055
X86306-GC04-03	83	798	66.234
X86306-GC04-04	46	596.5	27.439
X86306-GC04-05	23	1043	23.989
X86306-GC04-06	25	823	20.575
X86306-GC05-01	24	210	5.04
X86306-GC06-01	24	265	6.36
			699.112

計算加損耗=4166+333

總數:4500米

紀錄用

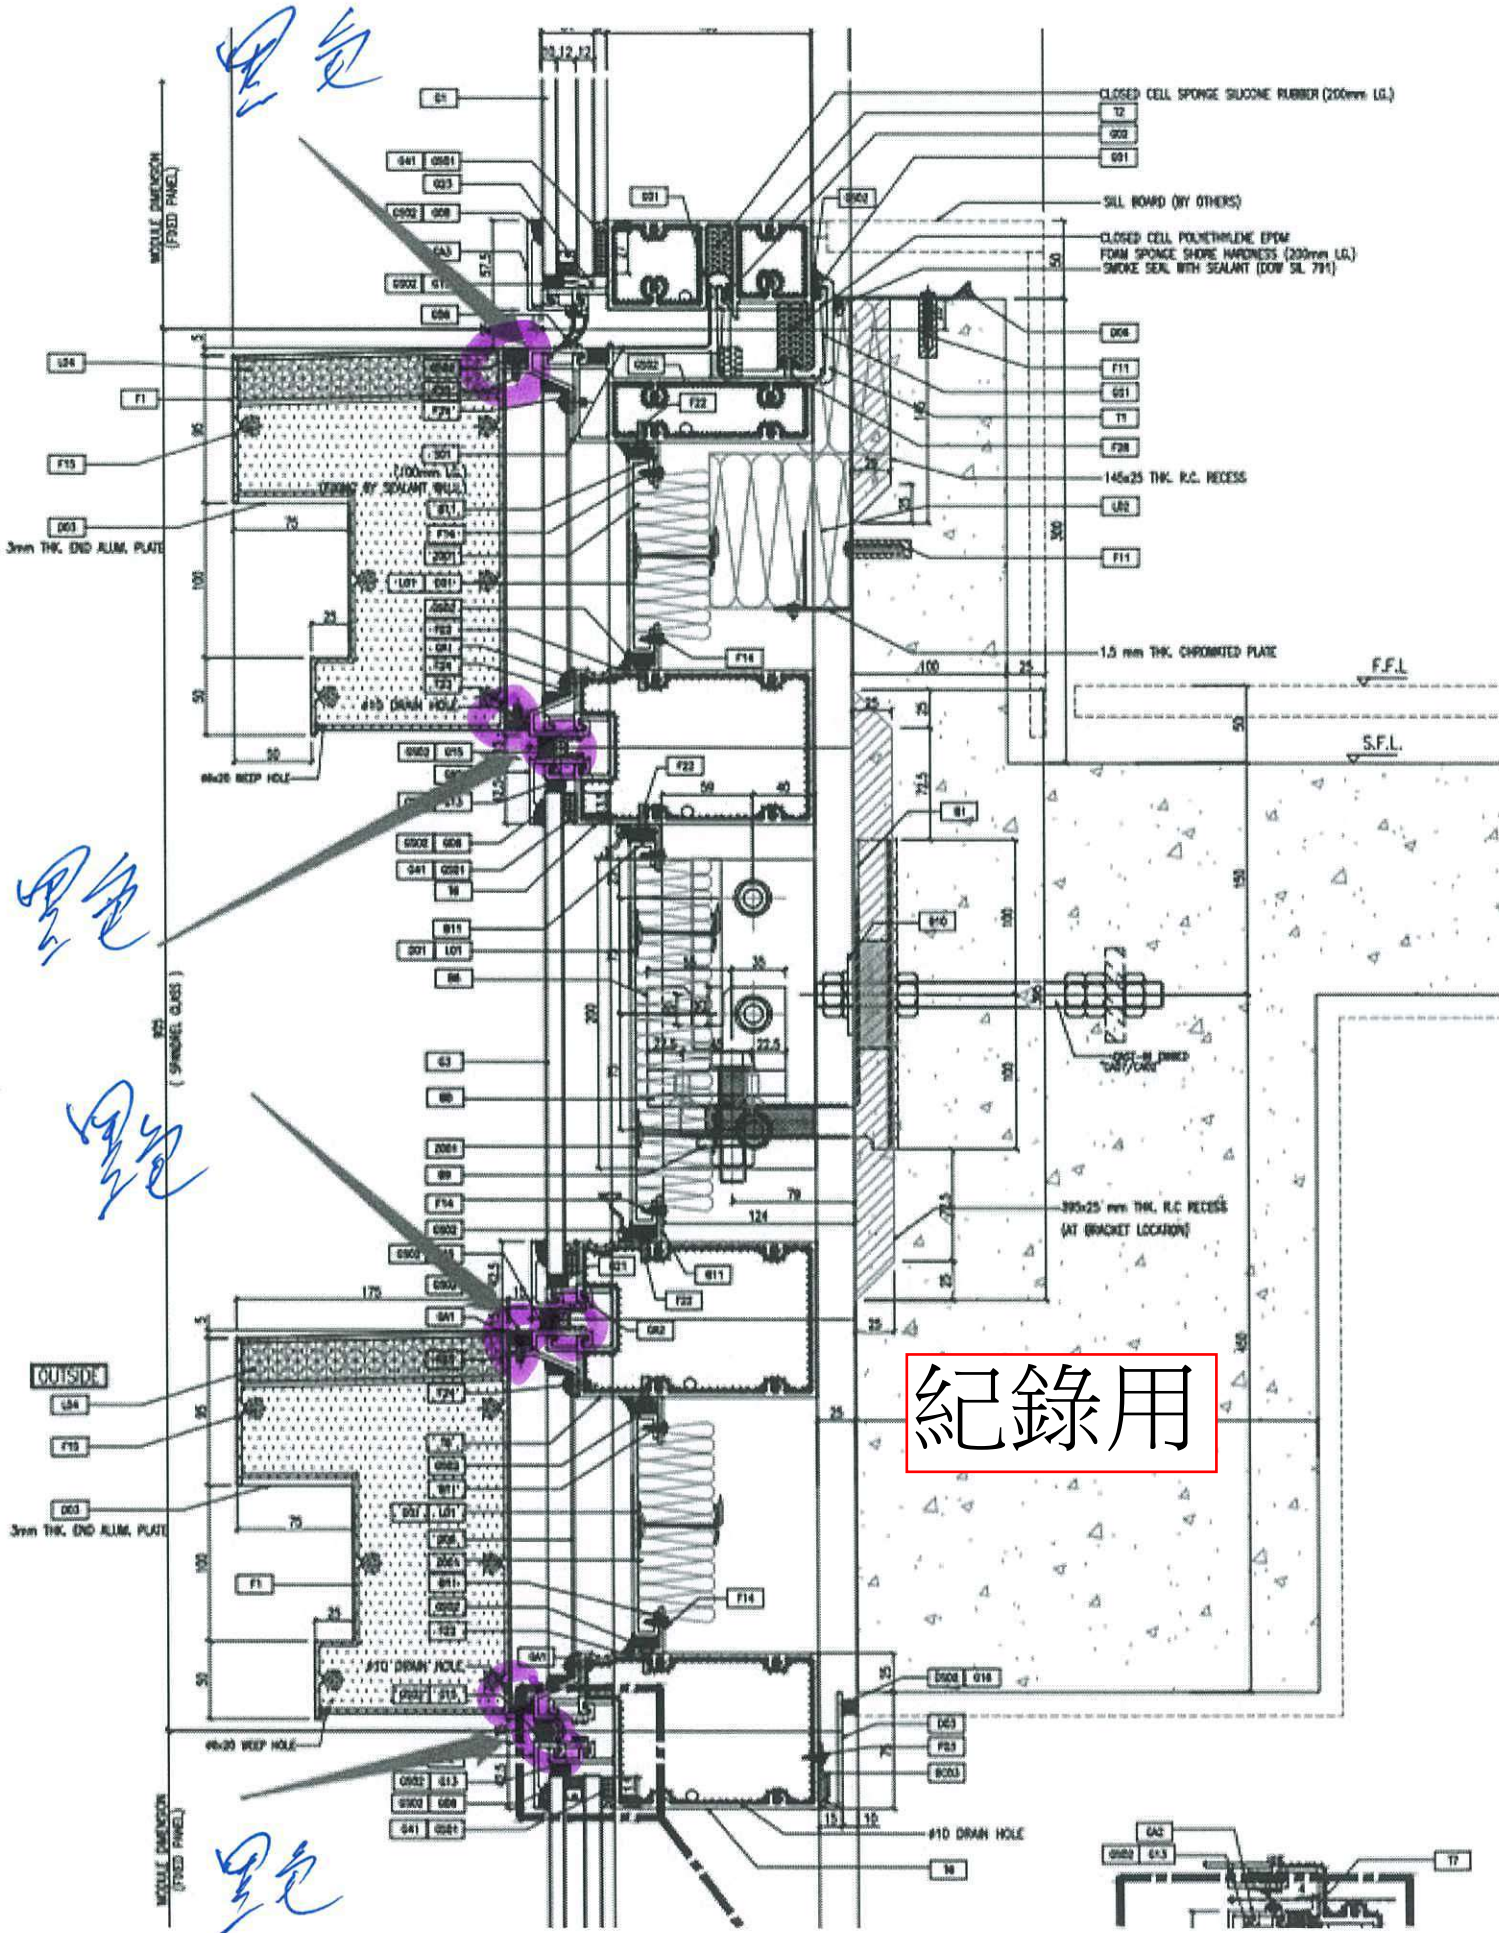

黑色


黑色

黑色

黑色

紀錄用



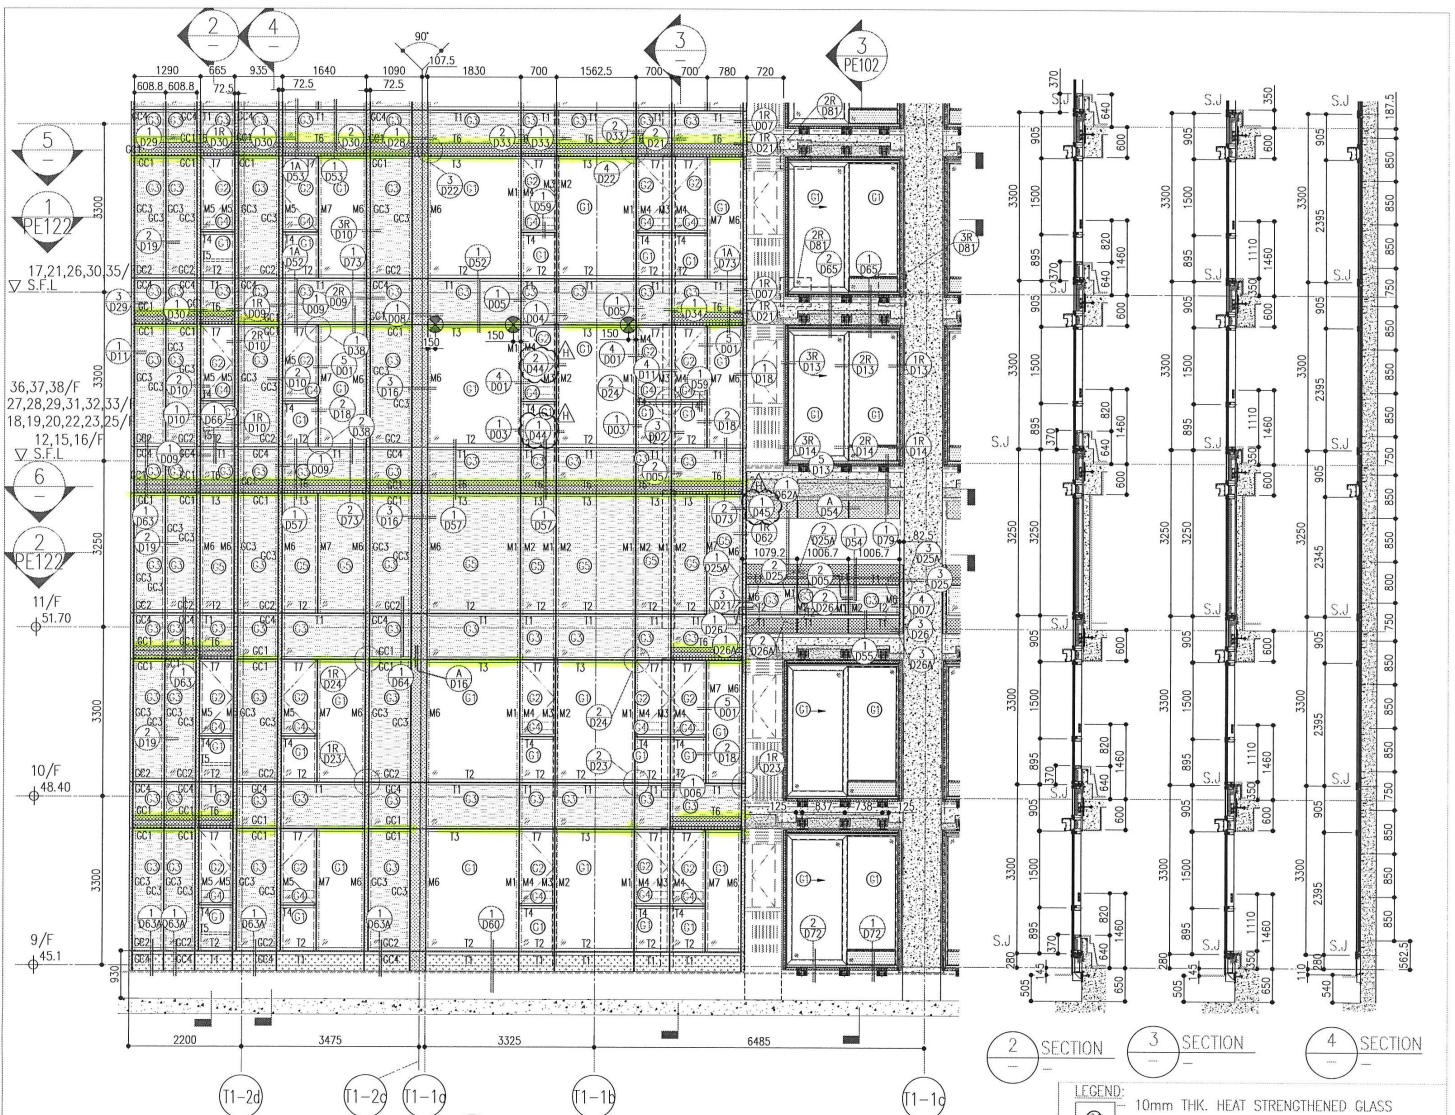


1 PART ELEVATION FOR CURTAIN WALL


ARCH. FEATURE AT 11/F, 17/F, 21/F, 26/F, 30/F, 35/F.  
 ARCH. FEATURE AT 9/F, 10/F, 12/F, 15/F-16/F, 18/F-20/F, 22/F, 23/F, 25/F, 27/F-29/F, 31/F-33/F, 36/F-38/F.

26/F	+91.25	39/F	+130.85	52/F	+170.40
25/F	+87.95	38/F	+127.55	51/F	+167.10
23/F	+84.65	37/F	+124.25	50/F	+163.80
22/F	+81.35	36/F	+120.95	49/F	+160.50
21/F	+78.05	35/F	+117.65	48/F	+157.20
20/F	+74.75	33/F	+114.35	47/F	+153.90
19/F	+71.45	32/F	+111.05	46/F	+150.60
18/F	+68.15	31/F	+107.75	45/F	+147.30
17/F	+64.85	30/F	+104.45	43/F	+144.00
16/F	+61.55	29/F	+101.15	42/F	+140.70
15/F	+58.25	28/F	+97.85	41/F	+137.40
12/F	+54.95	27/F	+94.55	40/F	+134.15
				R/F	+203.80
				62/F	+200.30
				61/F	+196.80
				60/F	+193.30
				59/F	+190.20
				58/F	+186.90
				57/F	+183.60
				56/F	+180.30
				55/F	+177.00
				53/F	+173.70

紀錄用

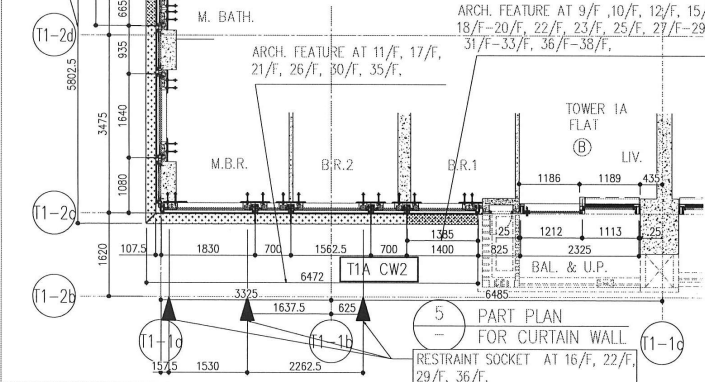


5 PART PLAN FOR CURTAIN WALL

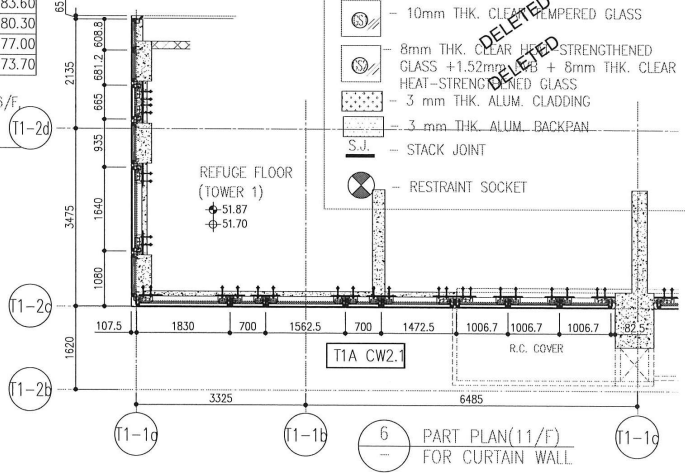

6 PART PLAN (11/F) FOR CURTAIN WALL

<p>MIDI Aluminium Fabricator Ltd.        601, 6-8, Sunny Industrial Centre 1/F        60, Tai Seng Street, Singapore        Tel: 63498211-4 Fax: 6327277666</p>	<p>DATE: 22-OCT-21        SCALE: 1:50(A4)        DRAWN BY: [Name]        CHECKED BY: [Name]</p>	<p>TITLE: TYPICAL FLOOR PARTIAL ELEVATION &amp; SECTION, PLAN FOR CURTAIN WALL (TOWER 1)</p>	<p>PROJECT: PROPOSED RESIDENTIAL DEVELOPMENT AT TOWER 709P, PHASE 11, LONSH PARK, TELUK KEMAN 0, N.T.</p>	<p>JOB NO.: J-858</p>	<p>1. FEEL - FINISHED FLOOR LEVEL          2. S.F.L. - STRUCTURAL FLOOR LEVEL          3. S.F.L. - REVERSED DEM'L.</p>	<p>NOTE:          1. ALL DIMENSIONS ARE IN mm.          2. ALL ELEVATIONS ARE VIEWED FROM OUTSIDE.          3. ALL DIMENSIONS TO BE VERIFIED ON SITE BEFORE FABRICATION.</p>	<p>LEGEND:          (X) - REF'L MARK NO.          (S.J.) - STACK JOINT</p>	<p>CLIENT: 信和置業有限公司          Sino Land Company Limited</p>	<p>ARCHITECT: Ronald Liu &amp; Partners          Ronald Liu &amp; Partners (HK) Ltd.          皇后大道中 100 號 10 樓 (香港) 有限公司</p>	<p>STRUCTURAL ENGINEER: Gammon</p>	<p>FRACSE CONSULTANT: AECOM</p>	<p>MAIN CONTRACTOR: [Name]</p>	<p>B.D. REF: [Number]</p>



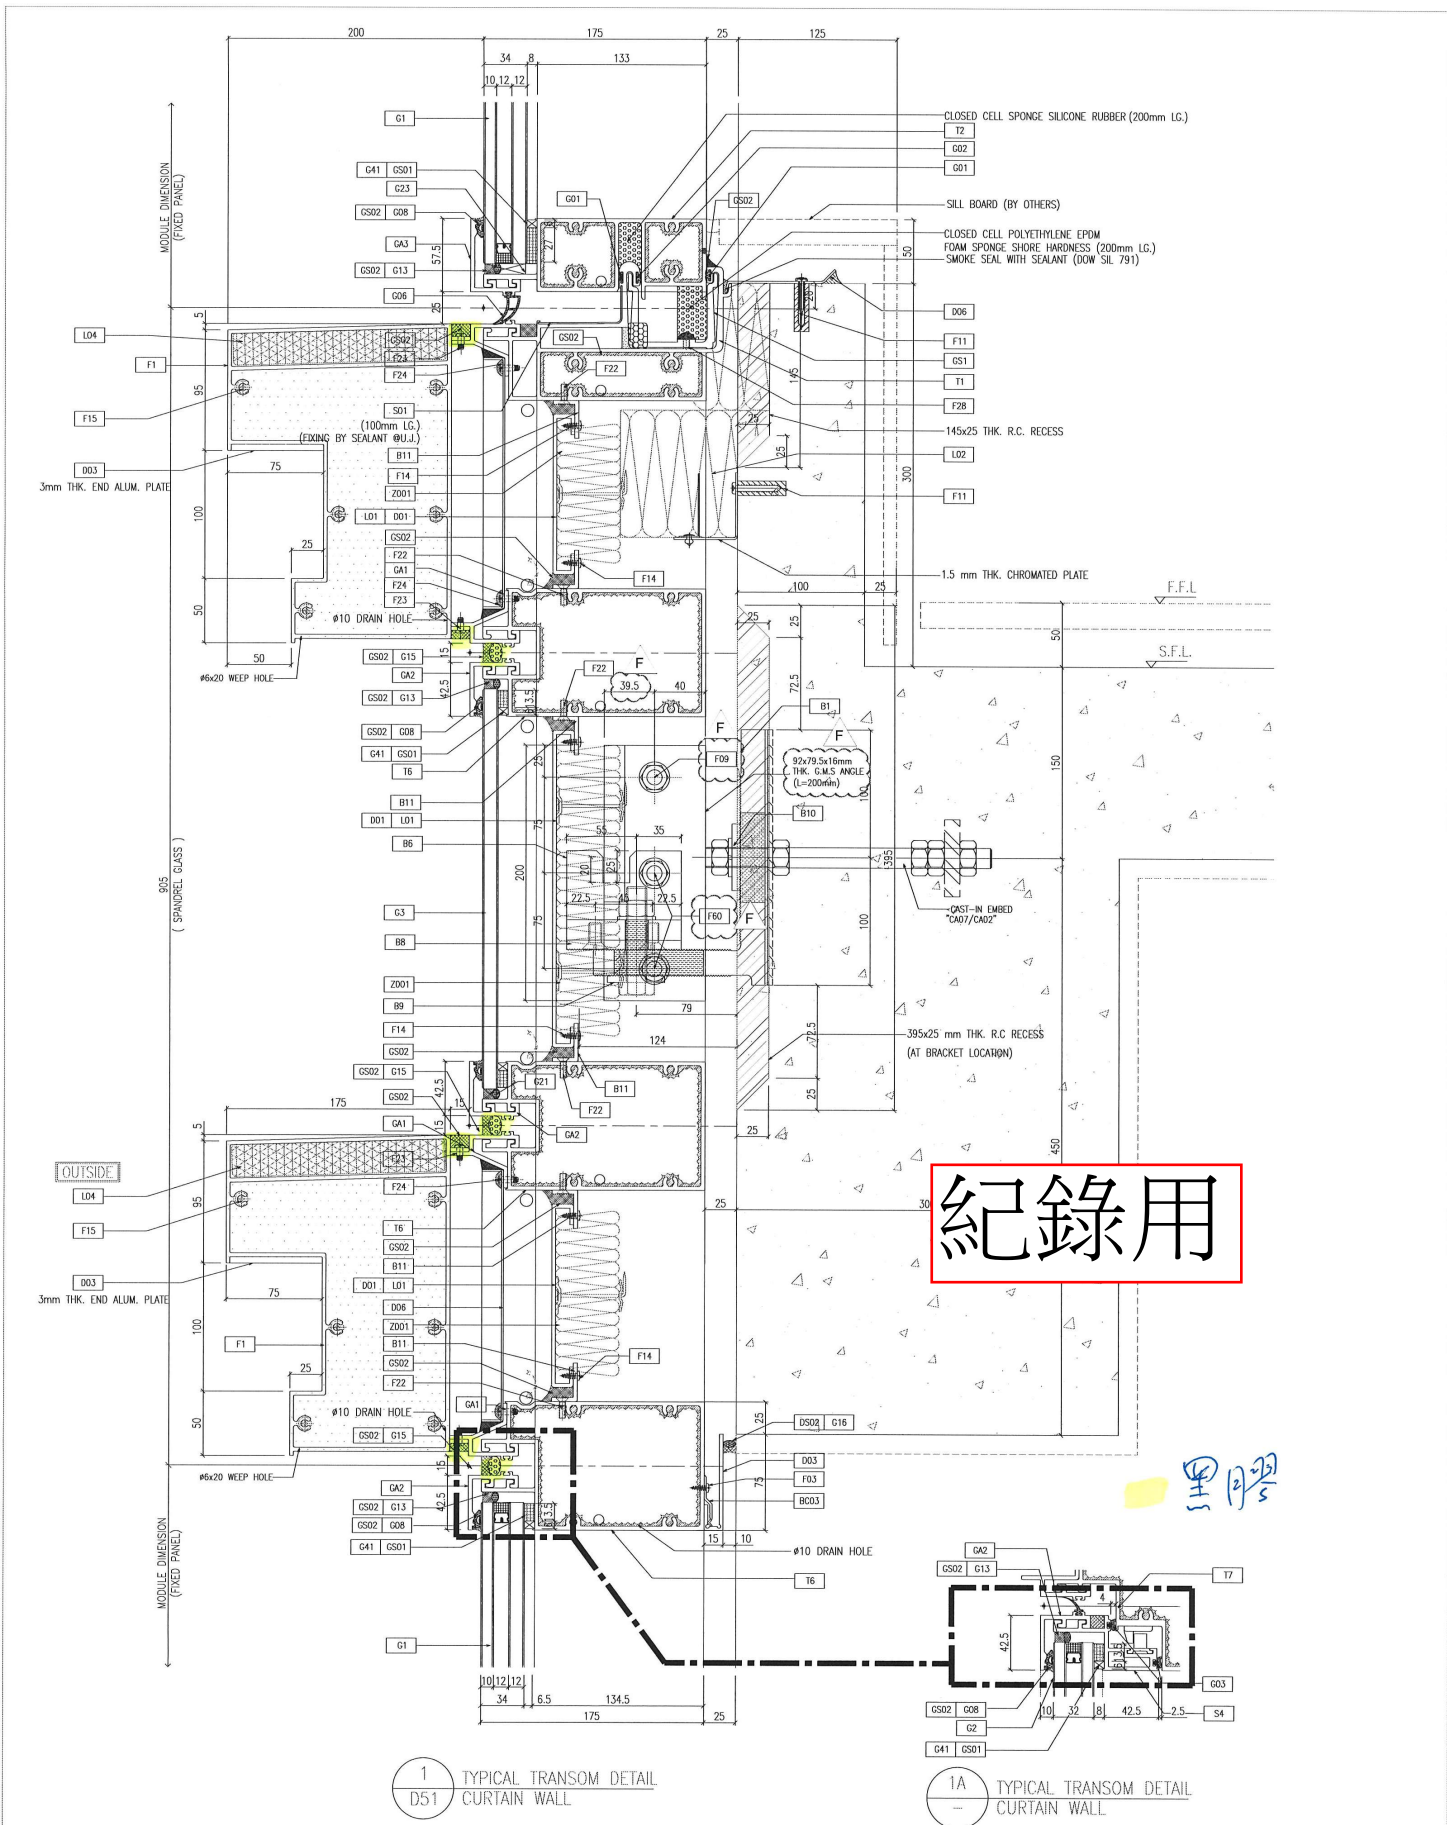


紀錄用

黑明

<p><b>PROJECT:</b> PROPOSED RESIDENTIAL DEVELOPMENT AT TQHL 709P PHASE 11, LIONS PARK TSEUNG KWAN O, N.T.</p> <p><b>TITLE:</b> TYPICAL MULLION DETAIL FOR CURTAIN WALL</p> <p><b>DATE:</b> 22-03-21 <b>SCALE:</b> 1:2(A1)</p> <p><b>DRAWN BY:</b> <b>CHECKED BY:</b></p>	<p><b>REVISIONS:</b></p> <table border="1"> <tr> <th>NO.</th> <th>DATE</th> <th>REVISION</th> <th>BY</th> </tr> <tr> <td>F</td> <td>23/12/22</td> <td>REVISED AS PER COMMENTS</td> <td>US</td> </tr> <tr> <td>E</td> <td>22/07/22</td> <td>REVISED AS PER COMMENTS</td> <td>US</td> </tr> <tr> <td>D</td> <td>23/05/22</td> <td>REVISED AS PER COMMENTS</td> <td>US</td> </tr> <tr> <td>C</td> <td>07/04/22</td> <td>REVISED AS PER COMMENTS</td> <td>US</td> </tr> <tr> <td>B</td> <td>25/07/22</td> <td>REVISED AS PER COMMENTS</td> <td>US</td> </tr> <tr> <td>A</td> <td>23/12/21</td> <td>REVISED AS PER COMMENTS</td> <td>US</td> </tr> </table>	NO.	DATE	REVISION	BY	F	23/12/22	REVISED AS PER COMMENTS	US	E	22/07/22	REVISED AS PER COMMENTS	US	D	23/05/22	REVISED AS PER COMMENTS	US	C	07/04/22	REVISED AS PER COMMENTS	US	B	25/07/22	REVISED AS PER COMMENTS	US	A	23/12/21	REVISED AS PER COMMENTS	US	<p><b>LEGEND:</b></p> <p>(---) DETAIL MARK NO. (---) REFER SHEET NO.</p> <p>1. F.F.L. -- FINISHED FLOOR LEVEL 2. S.F.L. -- STRUCTURAL FLOOR LEVEL 3. --- REVERSED DETAIL</p>	<p><b>NOTE:</b></p> <p>1. ALL DIMENSIONS ARE IN mm. 2. ALL DIMENSIONS ARE VIEWED FROM OUTSIDE. 3. ALL DIMENSIONS TO BE CHECKED ON SITE BEFORE FABRICATION.</p>	<p><b>PACKAGE CONSULTANT:</b> <b>AECOM</b></p>	<p><b>STRUCTURAL ENGINEER:</b> <b>Gammon</b></p>	<p><b>ARCHITECT:</b> <b>Donald lu &amp; Partners</b> Donald Lu &amp; Partners (HK) Ltd. 羅道立建築師事務所 (香港) 有限公司</p>	<p><b>CLIENT:</b> <b>信和置業有限公司</b> Sino Land Company Limited</p>	<p><b>B.D. REF.:</b></p>
		NO.	DATE	REVISION	BY																															
F	23/12/22	REVISED AS PER COMMENTS	US																																	
E	22/07/22	REVISED AS PER COMMENTS	US																																	
D	23/05/22	REVISED AS PER COMMENTS	US																																	
C	07/04/22	REVISED AS PER COMMENTS	US																																	
B	25/07/22	REVISED AS PER COMMENTS	US																																	
A	23/12/21	REVISED AS PER COMMENTS	US																																	
<p><b>OWNER:</b> MIDI Aluminium Fabricator tm. 610 Chee Yee Ling Road, Kwunshan Kwai Tsang Industrial Centre, 1/F Tel: 23255211-1, 1564(05)/2727886 DWA NO.: 0858-CW-051</p>																																				

紀錄用

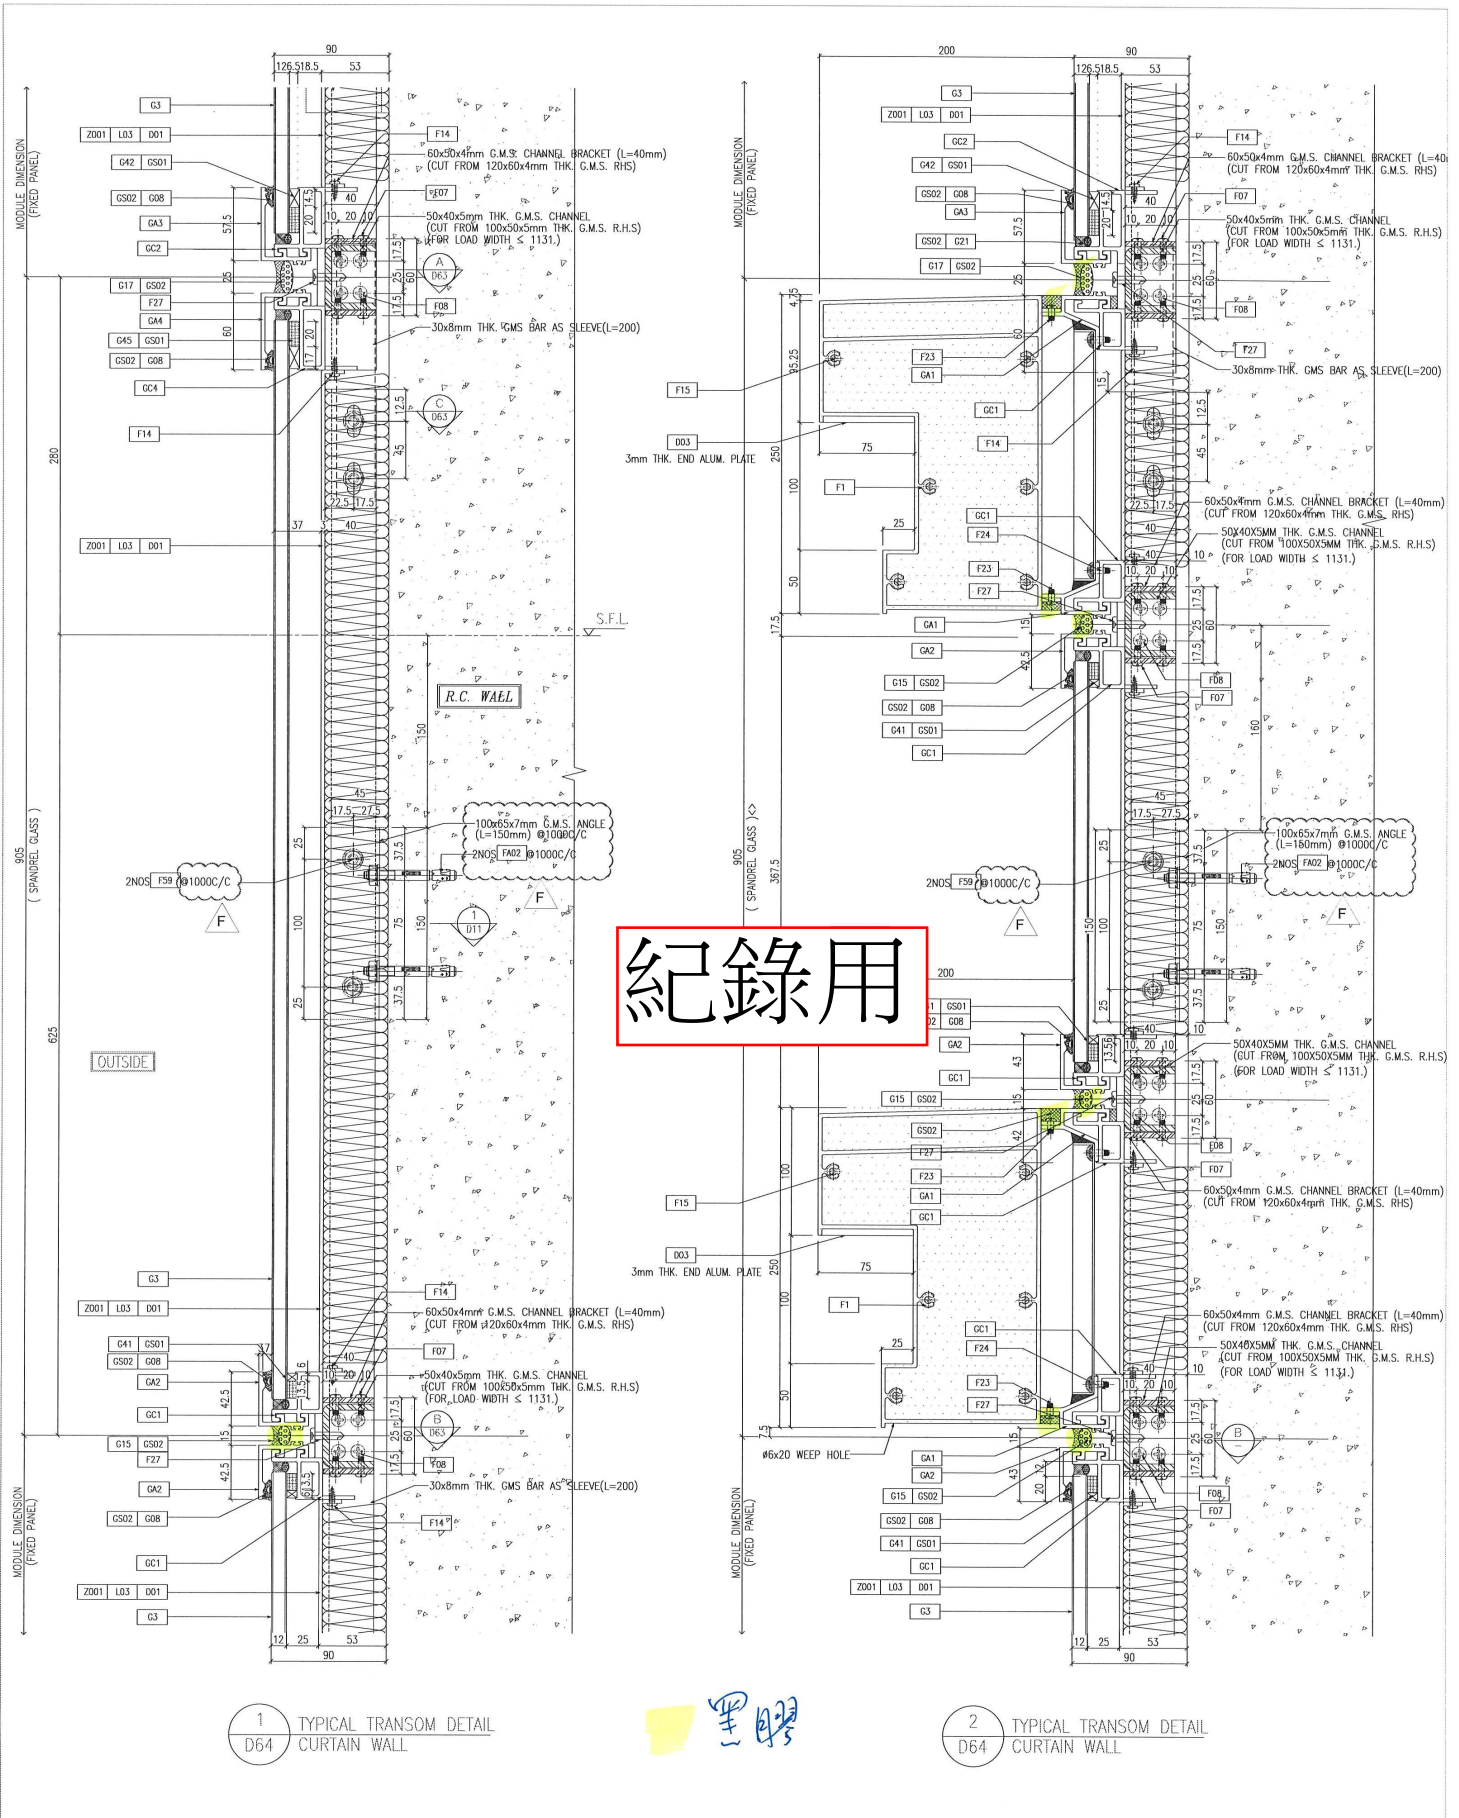

<p>DATE: 22-OCT-21</p> <p>SCALE: 1:2(A1)</p> <p>DRAWN BY: [Signature]</p> <p>CHECKED BY: [Signature]</p>	<p>PROJECT: PROPOSED RESIDENTIAL DEVELOPMENT AT TROPIC TOWER PHASE 1, LOMA PARK, TSEUNG KWAN O, N.T.</p> <p>CLIENT: 信和置業有限公司 Sino Land Company Limited</p>	<p>ARCHITECT: Ronald Lu Ronald Lu &amp; Partners 信和置業有限公司 (香港) 有限公司</p> <p>MAIN CONSULTANT: Gammon</p> <p>STRUCTURAL ENGINEER: AECOM</p> <p>FAÇADE CONSULTANT: AECOM</p>	<p>REVISIONS:</p> <table border="1"> <tr><th>NO.</th><th>DATE</th><th>REVISION</th></tr> <tr><td>1</td><td>20/09/22</td><td>REVISION AS PER COMMENTS</td></tr> <tr><td>2</td><td>12/07/22</td><td>REVISION AS PER COMMENTS</td></tr> <tr><td>3</td><td>23/05/22</td><td>REVISION AS PER COMMENTS</td></tr> <tr><td>4</td><td>07/04/22</td><td>REVISION AS PER COMMENTS</td></tr> <tr><td>5</td><td>23/07/21</td><td>REVISION AS PER COMMENTS</td></tr> <tr><td>6</td><td>03/12/21</td><td>REVISION AS PER COMMENTS</td></tr> </table>	NO.	DATE	REVISION	1	20/09/22	REVISION AS PER COMMENTS	2	12/07/22	REVISION AS PER COMMENTS	3	23/05/22	REVISION AS PER COMMENTS	4	07/04/22	REVISION AS PER COMMENTS	5	23/07/21	REVISION AS PER COMMENTS	6	03/12/21	REVISION AS PER COMMENTS	<p>NOTES:</p> <ol style="list-style-type: none"> <li>ALL DIMENSIONS ARE IN mm.</li> <li>ALL ELEVATIONS ARE VIEWED FROM OUTSIDE.</li> <li>ALL DIMENSIONS TO BE VIEWED ON SITE BEFORE FABRICATION.</li> </ol> <p>LEGEND:</p> <ul style="list-style-type: none"> <li>(X) - DETAIL MARK NO.</li> <li>(A) - REFER SHEET NO.</li> <li>1. F.F.L. - FINISHED FLOOR LEVEL</li> <li>2. S.F.L. - STRUCTURAL FLOOR LEVEL</li> <li>3. (R) - REVERSED DETAIL</li> </ul>
NO.	DATE	REVISION																							
1	20/09/22	REVISION AS PER COMMENTS																							
2	12/07/22	REVISION AS PER COMMENTS																							
3	23/05/22	REVISION AS PER COMMENTS																							
4	07/04/22	REVISION AS PER COMMENTS																							
5	23/07/21	REVISION AS PER COMMENTS																							
6	03/12/21	REVISION AS PER COMMENTS																							