



工程指示 / 要求簡箋(E.I.)

工程指示編號：EI / 661 / 23

修改版次：

工程編號：J - 858

工程名稱：將軍澳日出康城 11

工程項目：趟門 外鋁通 白膠紙包裝指示

收件人：生統 / 王良

發件人：Paul Wong

日期：21/08/2023

內容：

按地盆要求，見附件。

門頂鋁通向上塊白膠紙和

門底鋁通向下塊白膠紙。

上述提及位置，白膠紙不需包上出貨

未入箱的請改

請在 2023.08.24 前完成上列要求。

分發東莞各部門：

() 生產技術總監 連附件 (✓) 技術部 連附件 () 生產部 連附件 () 機械設計部 連附件
 () 採購部 連附件 (✓) 生產統籌部 連附件 (✓) 小羅&清 連附件
 (✓) 質檢部 連附件 () 會計部 連附件 () 報關組 連附件 () 其他 _____ 連附件

分發香港各部門：

() 行政部 連附件 () 會計部 連附件 () 統籌部 連附件 (✓) 工程部地盤科文 連附件
 () 採購部 連附件 () QS 部 連附件 () 維修部 連附件 () 其他 _____ 連附件

傳遞編號：

HK 661 / 23

發件人簽署：

項目經理簽署：



有關窗門通櫃工廠


To Jason

包保護白膠紙最新

指示/要求, 請工廠知悉!

17-8-2023

指示/要求, 請工廠知悉!

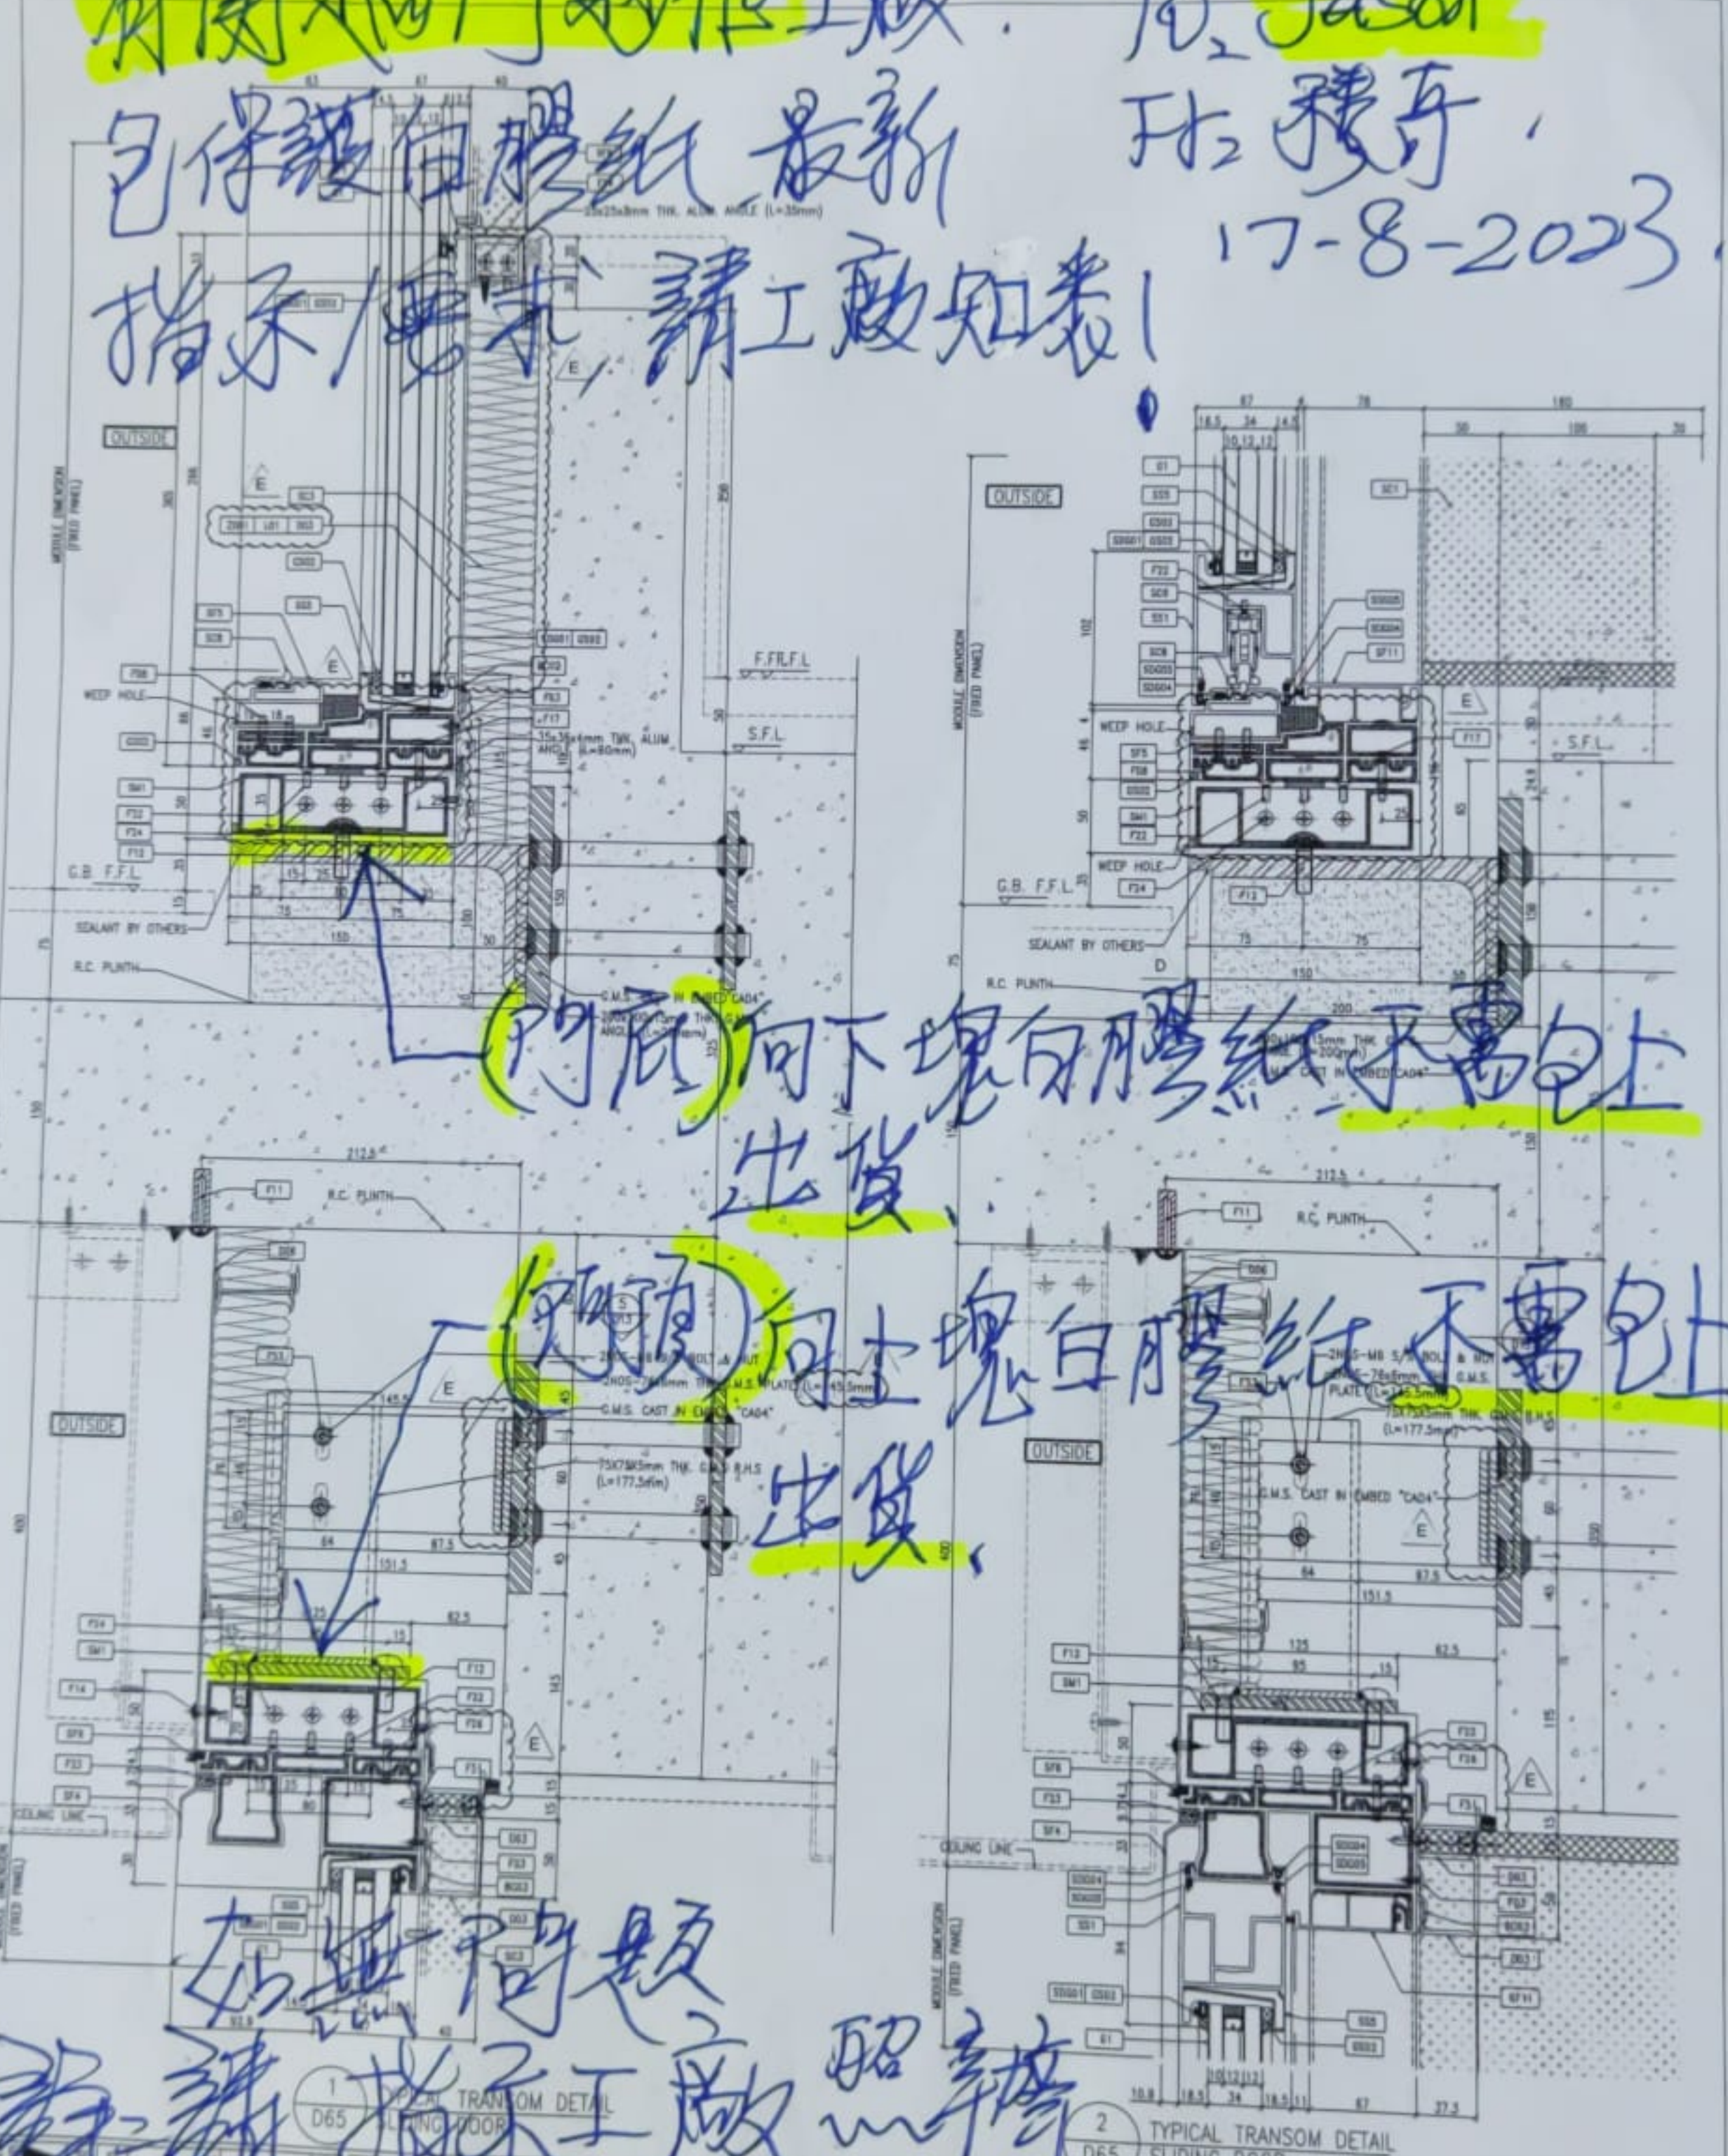

門底向下塊白膠紙不需包上
出貨

窗頂向上塊白膠紙不需包上
出貨

如無問題

請指示工廠照辦

<p>PROJECT: TYPICAL TRANSOM DETAIL SLIDING DOOR</p> <p>DATE: 22-OCT-21</p> <p>SCALE: 1:20(A1)</p> <p>CHECKED BY: [Signature]</p> <p>PROJECTED BY: [Signature]</p> <p>DESIGNED BY: [Signature]</p> <p>DATE: 22-OCT-21</p>	<p>1. ALL DIMENSIONS ARE IN mm.</p> <p>2. ALL DIMENSIONS ARE TAKEN FROM OUTLINE UNLESS SPECIFIED OTHERWISE.</p> <p>3. ALL DIMENSIONS TO BE VERIFIED ON SITE.</p> <p>4. REVERSE SIDE OF SHEET.</p> <p>5. F.F.L. - FINISHED FLOOR LEVEL.</p> <p>6. S.F.L. - STRUCTURE FLOOR LEVEL.</p> <p>7. G.B. F.F.L. - GROUND BENCH FINISHED FLOOR LEVEL.</p> <p>8. R.C. PLINTH - REINFORCED CONCRETE PLINTH.</p>	<p>ARCHITECT: Ronald Lu & Partners (HK) Ltd.</p> <p>STRUCTURAL ENGINEER: Gammon</p> <p>FACE CONSULTANT: AECOM</p> <p>CLIENT: Sino Land Company Limited</p>
--	---	--