



工程指示 / 要求簡箋(E.I.)

工程指示編號：EI / 6972 / 23

修改版次：B

工程編號：J - 858

工程名稱：將軍澳日出康城 11

工程項目：(特色層) 後裝窗 廠用鐵件 孖窗用 ST-52 修改

收件人：Maggie / 生統

發件人：Ant Yeung

日期：27/11/2023

要求提供 / 確認 事項：

- | | | |
|------------------------------------|-------------------------------------|-------------------------------|
| <input type="checkbox"/> 初步鋁料 B.M. | <input type="checkbox"/> 加工拆圖，然後生產 | <input type="checkbox"/> 尺寸表 |
| <input type="checkbox"/> 正式鋁料 B.M. | <input type="checkbox"/> 技術上資料 / 指示 | <input type="checkbox"/> 報價 |
| <input type="checkbox"/> 配件 B.M. | <input type="checkbox"/> 樣辦或貨品說明書 | <input type="checkbox"/> 分判合約 |

內容：

B 版: 請按加工圖生產。

A 版: 按生產和拆圖覆核，由於增加鎖座孔，ST-52 圖紙增加孔位。

請按加工圖生產，送廠組裝。

附上 BM 單。

供組裝孖窗用 (3 隻)

1. 有油瀝青油

2. 沿水油厚度 符合 EI5136 指示 100um

請在 2023.11.30 前完成上列要求。

附： 頁

以上項目為:

- 原合約工程包 原合約工程加 / 減賬 新工程報價

原因：-

分發東莞各部門：

- | | | | |
|--|---|--|--|
| <input type="checkbox"/> 生產技術總監 <input type="checkbox"/> 連附件 | <input checked="" type="checkbox"/> 技術部 <input type="checkbox"/> 連附件 | <input type="checkbox"/> 生產部 <input type="checkbox"/> 連附件 | <input type="checkbox"/> 機械設計部 <input type="checkbox"/> 連附件 |
| <input type="checkbox"/> 採購部 <input type="checkbox"/> 連附件 | <input checked="" type="checkbox"/> 生產統籌部 <input checked="" type="checkbox"/> 連附件 | <input checked="" type="checkbox"/> 小羅 & 清 <input checked="" type="checkbox"/> 連附件 | |
| <input type="checkbox"/> 質檢部 <input type="checkbox"/> 連附件 | <input type="checkbox"/> 會計部 <input type="checkbox"/> 連附件 | <input type="checkbox"/> 報關組 <input type="checkbox"/> 連附件 | <input type="checkbox"/> 其他 _____ <input type="checkbox"/> 連附件 |

分發香港各部門：

- | | | | |
|--|--|---|--|
| <input type="checkbox"/> 行政部 <input type="checkbox"/> 連附件 | <input type="checkbox"/> 會計部 <input type="checkbox"/> 連附件 | <input type="checkbox"/> 統籌部 <input type="checkbox"/> 連附件 | <input type="checkbox"/> 工程部地盤科文 <input type="checkbox"/> 連附件 |
| <input checked="" type="checkbox"/> 採購部 <input type="checkbox"/> 連附件 | <input type="checkbox"/> QS 部 <input type="checkbox"/> 連附件 | <input type="checkbox"/> 維修部 <input type="checkbox"/> 連附件 | <input type="checkbox"/> 其他 _____ <input type="checkbox"/> 連附件 |

傳遞編號：

HK 2151 / 23

發件人簽署：

項目經理簽署：

圖則登記表
DRAWING REGISTER

| | |
|---------------------|-------|
| 工程名稱 Project Title: | 康城11期 |
| | 后装窗 |
| 工程編號 Project No: | J858 |

分發予 Distributed To

| |
|--|
| |
| |
| |

| 圖則編號 Drg. No. | 圖則名稱 Drawing Title |
|------------------|-----------------------|
| X86250-51 | 后装窗加工图 |
| X86250-52 | 后装窗加工图 |
| X86250-53 | 后装窗加工图 |
| X86250-54 | 后装窗加工图 |
| X86251-51 | 后装窗加工图 |
| X86251-52 | 后装窗加工图 |
| X86251-53 | 后装窗加工图 |
| X86251-54 | 后装窗加工图 |
| X86251-55 | 后装窗加工图 |
| X86251-56 | 后装窗加工图 |
| X86251-57 | 后装窗加工图 |
| X86251-58 | 后装窗加工图 |
| X86251-59 | 后装窗加工图 |
| X86251-60 | 后装窗加工图 |
| X86251-61 | 后装窗加工图 |
| X86251-62 | 后装窗加工图 |
| X86251-63 | 后装窗加工图 |
| X86252-51 | 后装窗加工图 |
| X86252-52 | 后装窗加工图 |
| X86252-53 | 后装窗加工图 |
| X86252-54 | 后装窗加工图 |
| X86253-51 | 后装窗加工图 |
| X86253-52 | 后装窗加工图 |
| X86253-53 | 后装窗加工图 |
| X86253-54 | 后装窗加工图 |
| X86253-55 | 后装窗加工图 |
| J858-DA51 | 后装窗加工图 |
| J858-ST51 | 后装窗加工图 |
| J858-ST52 | 后装窗加工图 |
| J858-SS51 | 后装窗加工图 |
| | |
| | |

接收日期 Receiving Date (適用於客戶圖則)

| | | | | | | | |
|---|--|--|--|--|--|--|--|
| 年 | | | | | | | |
| 月 | | | | | | | |
| 日 | | | | | | | |


發出日期 Issued Date

| | | | | | | | |
|---|----|----|----|----|----|----|--|
| 年 | 23 | 23 | 23 | 23 | 23 | | |
| 月 | 11 | 11 | 11 | 11 | 11 | | |
| 日 | 08 | 10 | 16 | 17 | 20 | 24 | |

修訂編號
Revision No.

| | | | | | | | |
|----|---|---|--|---|--|---|--|
| 33 | - | A | | | | | |
| 34 | - | A | | | | | |
| 35 | - | A | | | | | |
| 36 | - | A | | | | | |
| 37 | - | | | | | | |
| 38 | - | | | | | | |
| 61 | - | | | A | | B | |
| 62 | - | | | | | | |
| | | | | | | | |
| | | | | | | | |



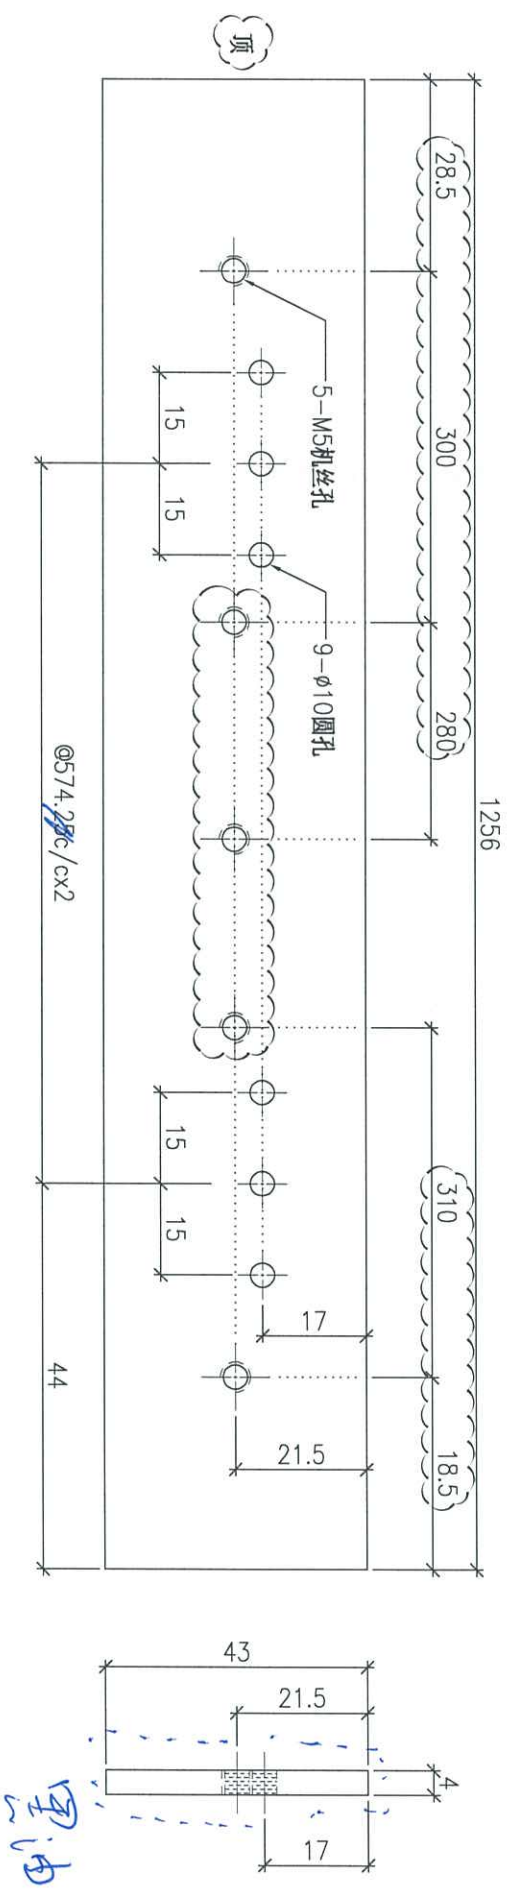

314

| | | | | | | | | | | | |
|---|--|------------------|--|-----------------------|--|-----------------|--|----------------------|--|--------------------------------|--|
| Remarks: | | Checked: J.L. | | Description: 43x4mm铁板 | | QTY: 3 | | Delivery to: Factory | | Rev. B | |
| Project Name: 康城11期 | | Date: 02-11-2023 | | Material: S275 | | Tolerance: ±0.5 | | Site | | Assembly No. J858-ST52 | |
| Project No. J858 | | Drawn: I.H. | | Finish: 热浸锌 | | Projection: | | Date | | MIDI Aluminium Fabricator Ltd. | |
| Shop Drawing No. PRE-CAST ALUM. WINDOW & LOUVRE | | Rev. - | | Date: 02-11-2023 | | Projection: | | Date | | MIDI Aluminium Fabricator Ltd. | |