



工程指示 / 要求簡箋(E.I.)

工程指示編號：EI / 7481 / 24

修改版次：D

工程編號：J - 858

工程名稱：將軍澳日出康城 LP 11

工程項目：後加百葉 加工圖 (第三批) 大貨 11/F, 40/F 只出 11 隻百葉

收件人：生統

發件人：Paul Wong

日期：25/04/2024

附上：

D 版本: 按大判 24/4 通知，取消露台位出外的 Louver, 原本 C 版已生產 36 隻, D 版只出貨 11 隻，25 隻備用。附 EMAIL，位置圖。

C 版本: 按大判要求，放行 11/F C1，40/F C2 百葉。

B 版本: X86248-AL-51 和 X86248-AL-52 需開避位，現附上最新版本加工圖。另外 B09056-AL-71 加圓孔。

A 版本: 因拆圖有誤，拆料圖的編號修改，現附上最新版本的加工明細表，組裝圖及加工圖生產。

大貨放行 包括 9/F, 11/F, 40/F, 53,62,67, R/F, LMR, Upper roof, top roof)
(只暫停 11/F C1, 40/F C2)

1. 因各座的 11/F C1 百葉, 40/F C2 百葉覆尺未有孔，暫停
(只暫停 11/F C1, 40/F C2) 全是 600Wx250H 共 36 隻暫停。 為免浪費鋁料，此 36 隻不開料
2. 其餘位置全部放行
3. 必須分座 分層打扎
- *4. 附次序 LMR, Upper roof, top roof) 為最急*
5. 附圖則登記表，加工明細表，工序明細表，百頁開料單，百頁組裝圖及鋁料加工圖 (第三批)
6. 地盆：請覆核各座的 11/F C1 百葉, 40/F C2
7. 20 x 3mm 鋁巴 壓雀網用。 如此料未及回廠，請用鋁板代替生產。
8. 按 2 號圖拆圖。
9. 附 2024.03.15 的覆尺

請在 2024.04.03 前完成上列要求。

分發東莞

() 生產技術總監 連附件 () 技術部 連附件 () 生產部 連附件 () 機械設計部 連附件
 () 採購部 連附件 () 生產統籌部 連附件 () 小羅&清 連附件
 () 質檢部 連附件 () 會計部 連附件 () 報關組 連附件 () 其他 連附件

分發香港各部門：

() 行政部 連附件 () 會計部 連附件 () 統籌部 連附件 () 工程部地盤科文 積哥 連附件
 () 採購部 連附件 () QS 部 連附件 () 維修部 連附件 () 其他 連附件

傳遞編號：

HK 0751 / 24

發件人簽署：

項目經理簽署：

記號

midi@midiltd.com.hk

Date forwarded: Wed, 24 Apr 2024 17:53:34 +0800
Forwarded by: <projects@midiltd.com.hk>
From: Peter Nip Chun Ma <Peter.Manc@gammonconstruction.com>
To: "Ginny CHAU [RLPHK]" <ginnychau@rlp.asia>, "jason.lcs.midi@gmail.com" <jason.lcs.midi@gmail.com>
Copies to: Andy Chan Yan Wai <andywchan@sino.com>, Ka Hei Wong <KaHei.Wong@gammonconstruction.com>, Paco Kwan Pang Ma <Paco.Ma@gammonconstruction.com>, Eric Ka Shun Hao <Eric.Hao@gammonconstruction.com>
Subject: J3931(LP11)-modified louver for T1-3 11/F & 40/F
Date sent: Wed, 24 Apr 2024 09:52:25 +0000

Dear Jason and Ginny,

As spoken at yesterday's meeting, here are the louver that need to be deleted for T1-3 11/F & 40/F. Also, as spoken in today morning's meeting, the dog house at T3 9/F has showed as attached file. Please note that MIDI only have 250mm space for louver installation.

Best regards,
Peter Ma
Gammon Construction
Tel: (+852) 93436563

Legal Disclaimer

This email (and any attachments) is confidential and subject to copyright. It may be subject to legal or other professional privilege. It is intended for use by the addressee(s) only and if you have received it in error, please notify the sender immediately by return email and delete it from your system. Any personal data in this email must be handled in accordance with applicable privacy laws.

B.D. REF : _____

CLIENT : **Sino Land Company Limited**
 信和置業有限公司

ARCHITECT : **ronald lu & partners**
 Ronald Lu & Partners (HK) Ltd.
 呂元祥建築師事務所 (香港) 有限公司

STRUCTURAL ENGINEER : **Gammon AECOM**

FACE CONSULTANT: **AECOM**

NOTE:
 1. ALL DIMENSIONS ARE IN mm.
 2. ALL ELEVATIONS ARE VIEWED FROM OUTSIDE.
 3. ALL DIMENSIONS TO BE VERIFIED ON SITE BEFORE FABRICATION.


LEGEND:
 (X) DETAIL MARK NO.
 (R) REFER SHEET NO.
 1. EFL — FINISHED FLOOR LEVEL
 2. SFL — STRUCTURAL FLOOR LEVEL
 3. (Z) — REVERSED DETAIL

JOB NO. : J-658
 PROJECT : PROPOSED RESIDENTIAL DEVELOPMENT AT TKOIL 7ORP, PHASE 11, LOHAS PARK TSEUNG KWAN O, N.T.

TITLE : IN-SITU ALUM. LOUVER LAYOUT PLAN TOWER 1 - 11/F





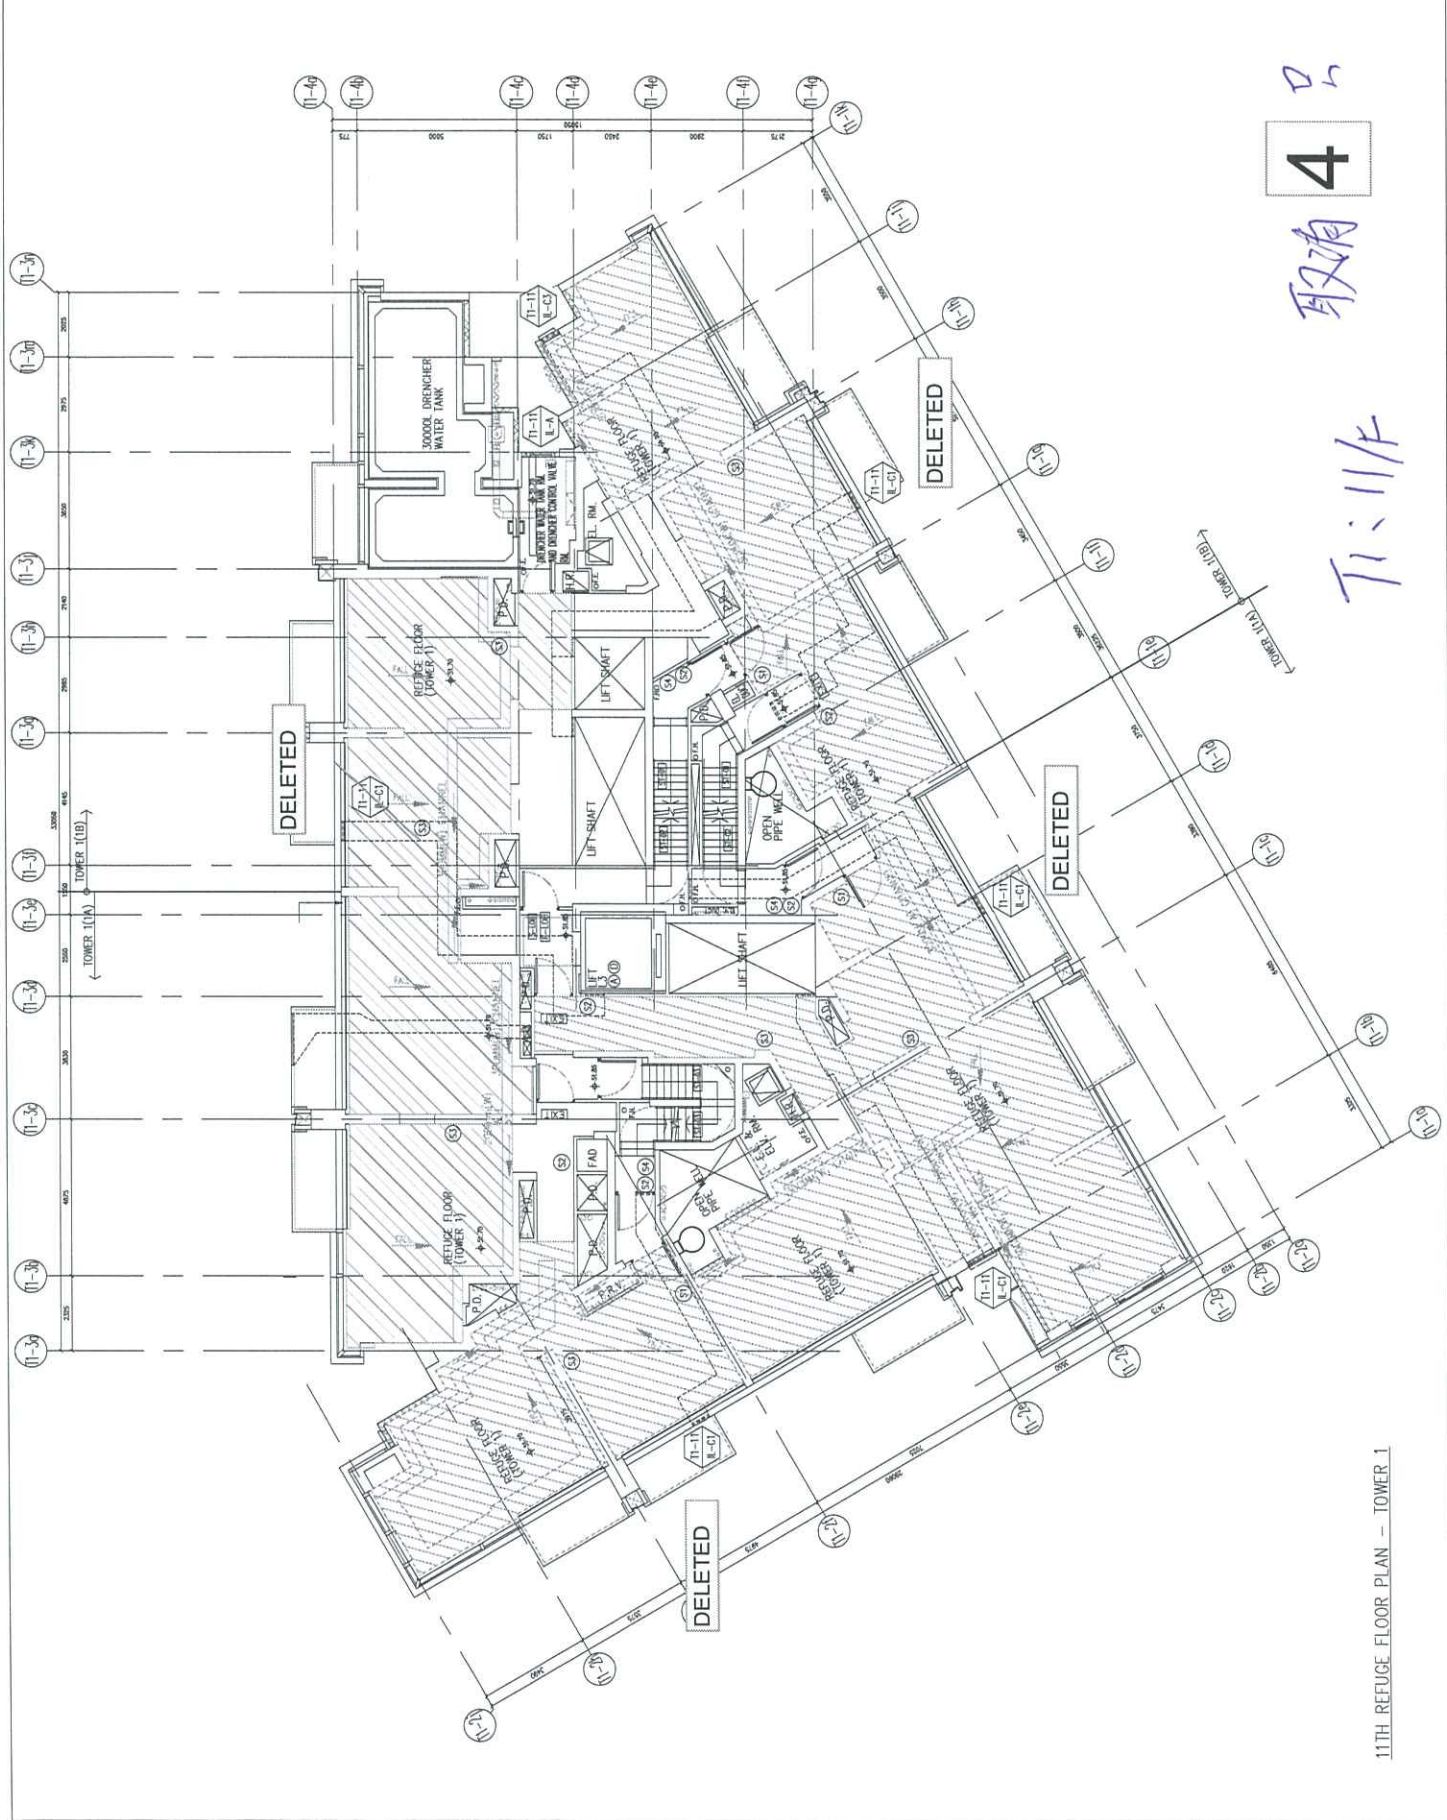

DATE : 04-OCT-21 SCALE : 1:160
 DRAWN BY : _____ CHECKED BY : _____


DESIGNED BY : **美特銘質有限公司**
 MIDT International Corporation Ltd.
 110 Cho Yee Ling Road, Kowloon
 Tel: (852) 2727656
 DWG NO. : JB58-11-3102 REV. : -



取消 4 只
 T1:11/F

11TH REFUGE FLOOR PLAN — TOWER 1

B.D. REF.:			
CLIENT:	 信和置業有限公司 Sino Land Company Limited		
ARCHITECT:	 Ronald Lu & Partners (HK) Ltd. 呂志祥建築師事務所 (香港) 有限公司		
MAIN CONTRACTOR:	 Gammon		
STRUCTURAL ENGINEER:	 AECOM		
FAÇADE CONSULTANT:	 AECOM		
NOTE:	1. ALL DIMENSIONS ARE IN mm. 2. ALL ELEVATIONS ARE VIEWED FROM OUTSIDE. 3. ALL DIMENSIONS TO BE VERIFIED ON SITE. BEFORE FABRICATION.		
LEGEND:	(X) DETAIL MARK NO. (R) REFER SHEET NO. 1. F.F.L. -- FINISHED FLOOR LEVEL. 2. S.F.L. -- STRUCTURAL FLOOR LEVEL. 3. (R) -- REVERSED DETAIL.		
NO.	DATE	ISSUE	BY
		J-658	
PROJECT: PROPOSED RESIDENTIAL DEVELOPMENT AT TKOIL 70RP, PHASE 11, LOHAS PARK TSELUNG KWAN O, N.T.			
TITLE: IN-SITU ALUM. LOUVER LAYOUT PLAN TOWER 1 - 40/F			
DATE:	04-OCT-21	SCALE:	1:160
DRAWN BY:		CHECKED BY:	
 MIDI Architecture Associates Ltd. 美特銘質有限公司 11/F, 610, Cho Kwo Ling Road, Kwun Tong, Kowloon, H.K. Tel: 23489211-4 Fax: (852) 27276656 DWG NO.: JBS58-11-3103 REV.: -			

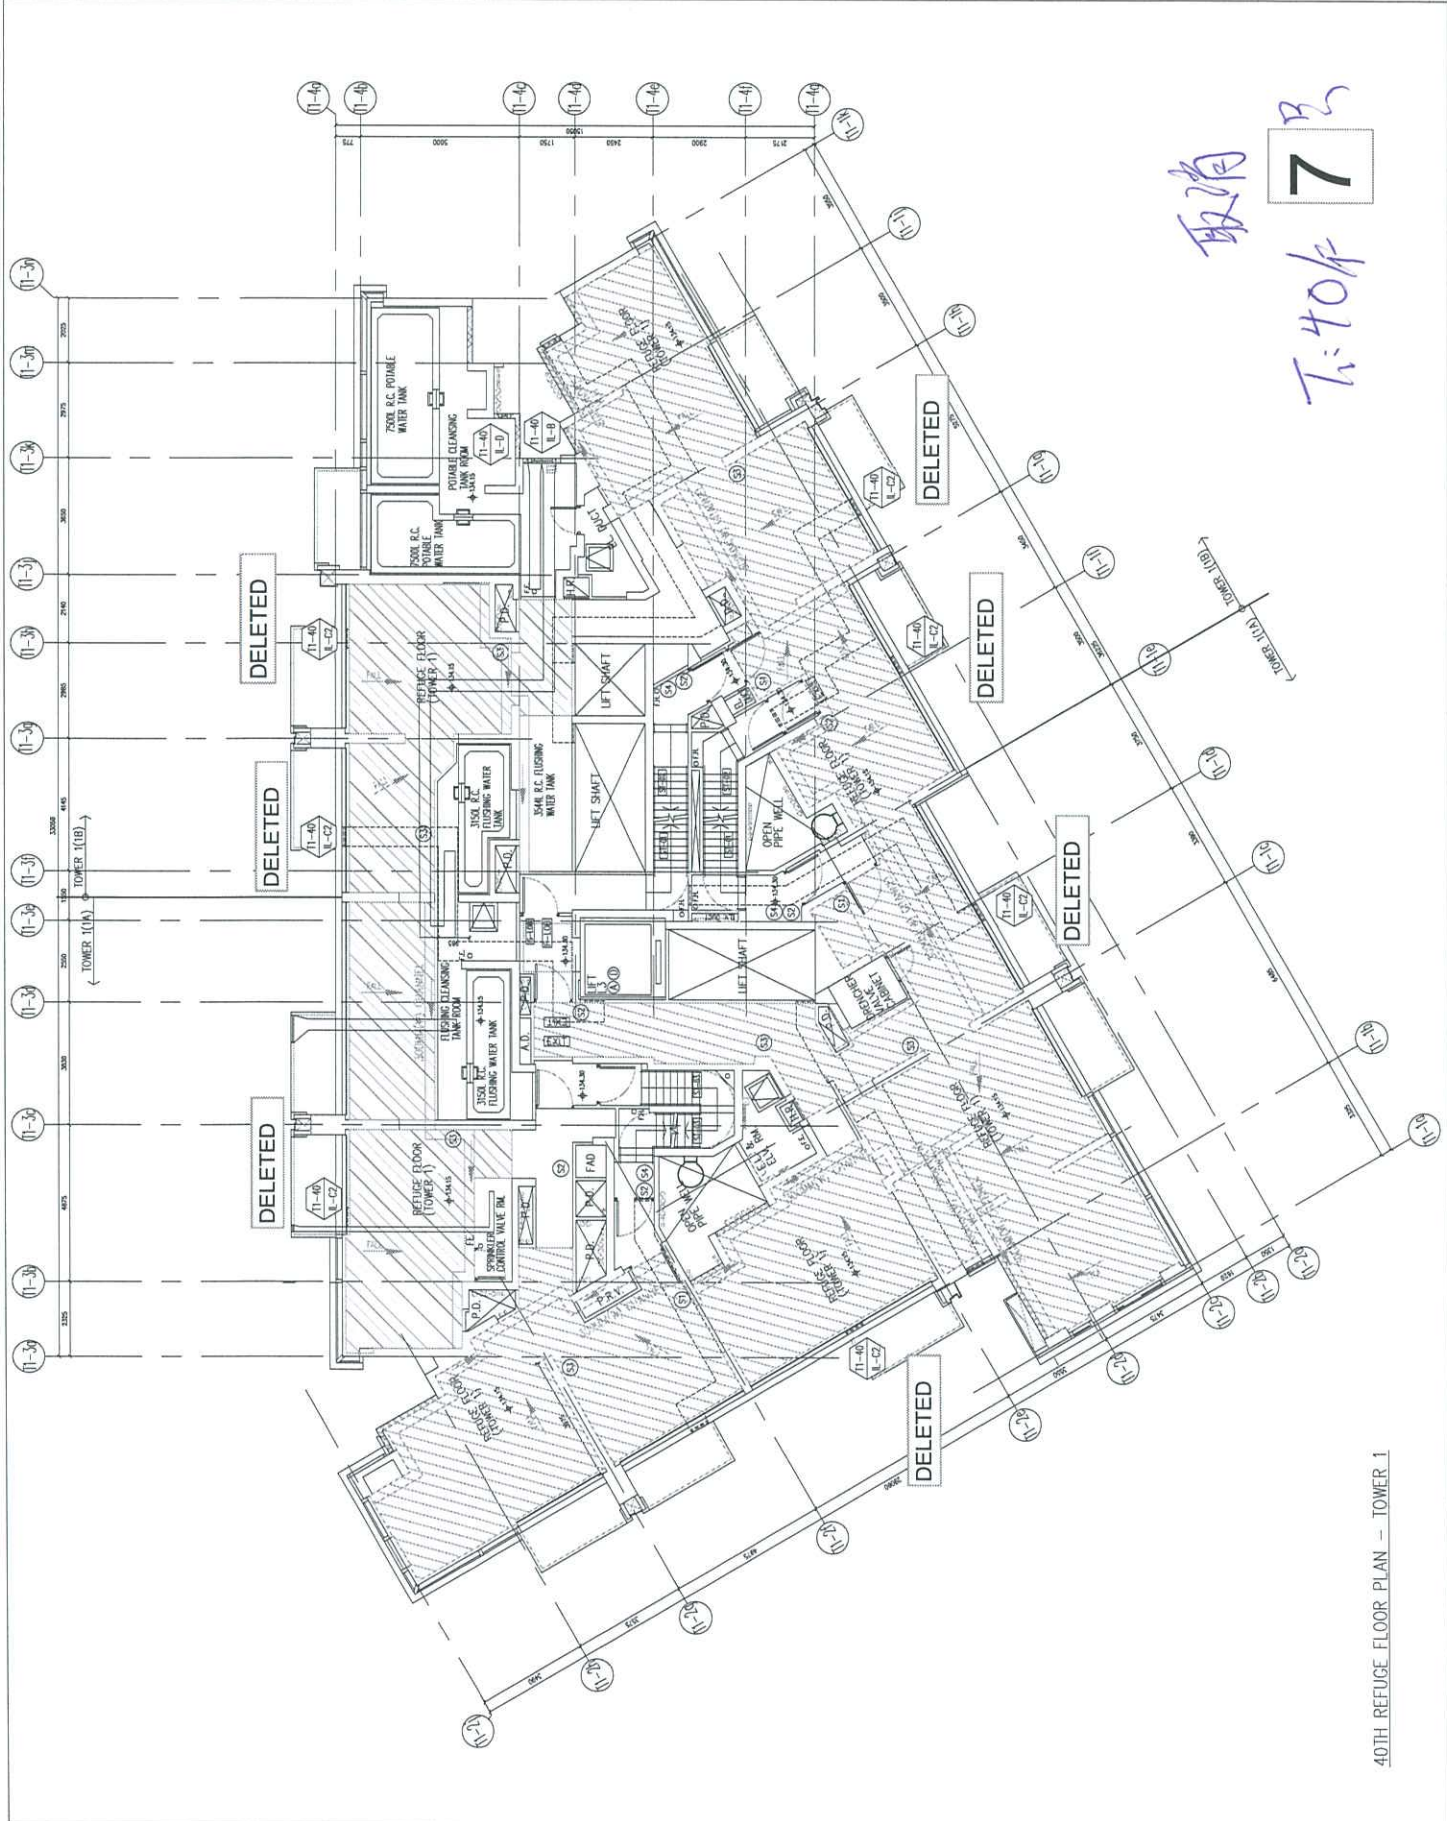

40TH REFUGEE FLOOR PLAN - TOWER 1

B.D. REF :

CLIENT :
Sino Land Company Limited
怡和置業有限公司

ARCHITECT :
Ronald Lu & Partners
Ronald Lu & Partners (HK) Ltd.
呂志祥建築師事務所 (香港) 有限公司

STRUCTURAL ENGINEER :
Gammon AECOM
FACE CONSULTANT :
AECOM

NOTE :
1. ALL DIMENSIONS ARE IN mm.
2. ALL ELEVATIONS ARE VIEWED FROM OUTSIDE.
3. BE BEFORE FABRICATION.

LEGEND :
① - DETAIL MARK NO.
② - REFER SHEET NO.
1. F.F.L. - FINISHED FLOOR LEVEL
2. S.F.L. - STRUCTURAL FLOOR LEVEL
3. Ⓜ - REVERSED DETAIL

JOB NO. : J-E58


PROJECT :
PROPOSED RESIDENTIAL DEVELOPMENT
AT TKOYL 70RP, PHASE 11, LOHAS PARK
TSEUNG KWAN O, N.T.

TITLE :
IN-SITU ALUM. LOOWER
LAYOUT PLAN
TOWER 2 - 11/F

DATE : 04-OCT-21 SCALE : 1:160

DRAWN BY : CHECKED BY :

美特鋁質有限公司
MIDI Aluminium Extrusion Ltd.
Units 5-8, Sunny Industrial Centre, 1/F
810 Cho Kwo Ling Road, Kowloon
Tel: 23489711-4 Fax: (852) 2777665
DWG NO. : JES58-11-3202 REV. : -

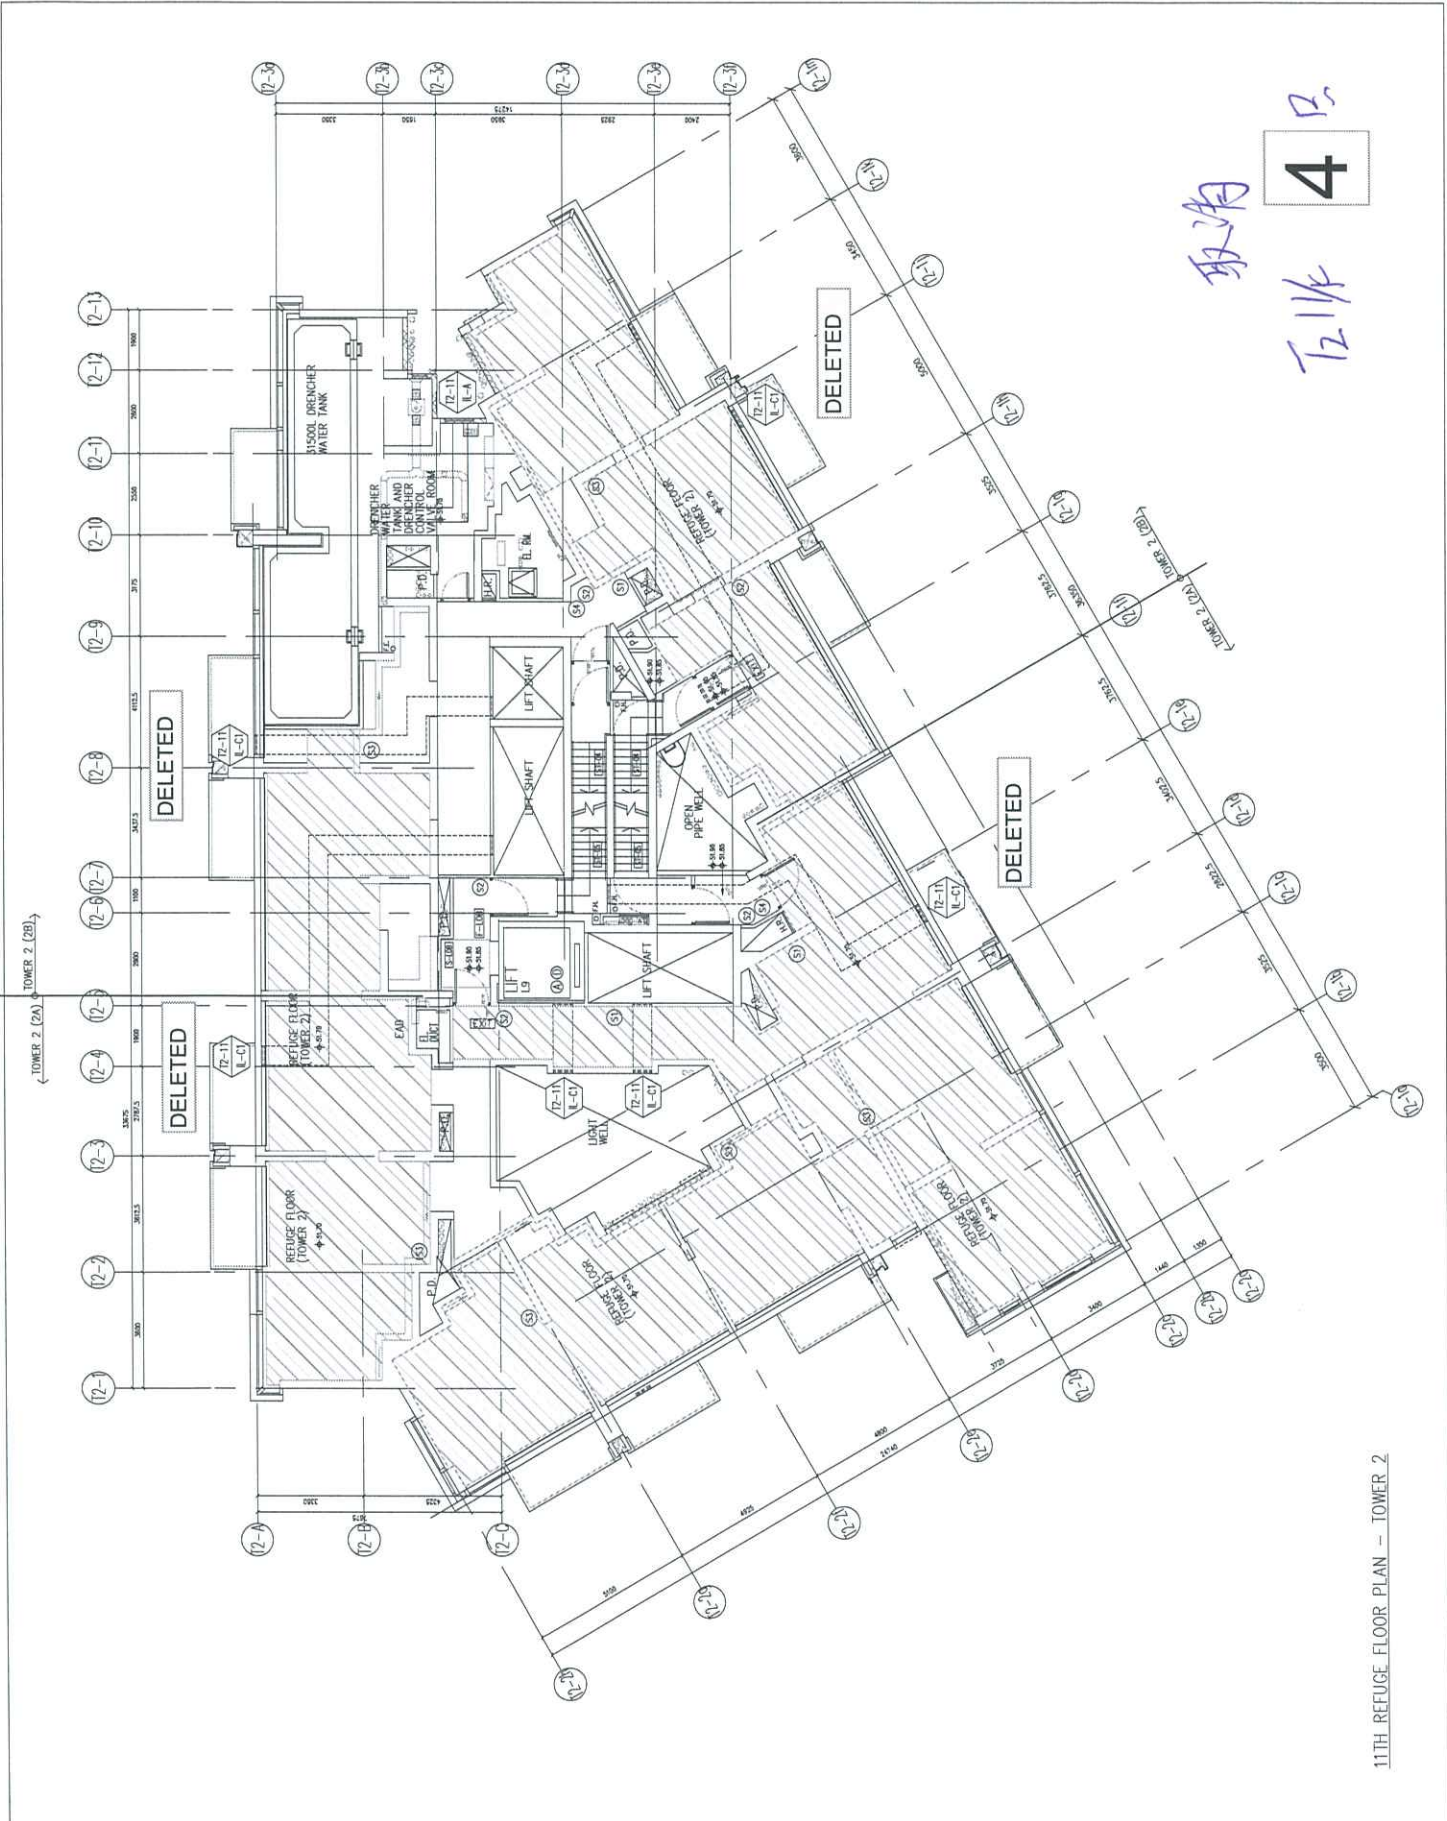

取消
1211K
4 B

11TH REFUGE FLOOR PLAN - TOWER 2

8.D. REF :

CLIENT : 德和置業有限公司
Sino Land Company Limited

ARCHITECT : ronald lu & partners
Ronald Lu & Partners (HK) Ltd.
呂志輝建築師事務所 (香港) 有限公司

MAIN CONTRACTOR :

STRUCTURAL ENGINEER : **Gammon**

FACE CONSULTANT: **AECOM**

AECOM

NOTE :
1. ALL DIMENSIONS ARE IN mm.
2. ALL ELEVATIONS ARE VIEWED FROM OUTSIDE UNLESS OTHERWISE SPECIFIED.
3. BEFORE FABRICATING.

LEGEND :
① DETAIL MARK NO.
② REFER SHEET NO.
③ F.F.L. -- FINISHED FLOOR LEVEL
④ S.F.L. -- STRUCTURAL FLOOR LEVEL
⑤ -- REVERSED DETAIL

JOB NO. : J-858


PROJECT : PROPOSED RESIDENTIAL DEVELOPMENT AT TKOIL 70RP, PHASE 11, LOHAS PARK TSEUNG KWAN O, N.T.

TITLE : IN-SITU ALUM. LOUVER LAYOUT PLAN TOWER 2 - 40/F

DATE : 04-OCT-21 SCALE : 1:160

DRAWN BY : CHECKED BY :

美特銘有限公司
MIDI ARCHITECTURAL PRACTICE LTD.
Unit 6-8, Sunny Industrial Centre, 1/F
610 Cho Kwo Ling Road, Kowloon
Tel: 23489211-4 Fax: (852) 2727666
DWG NO. : JRS58-IL-3203 REV. : -

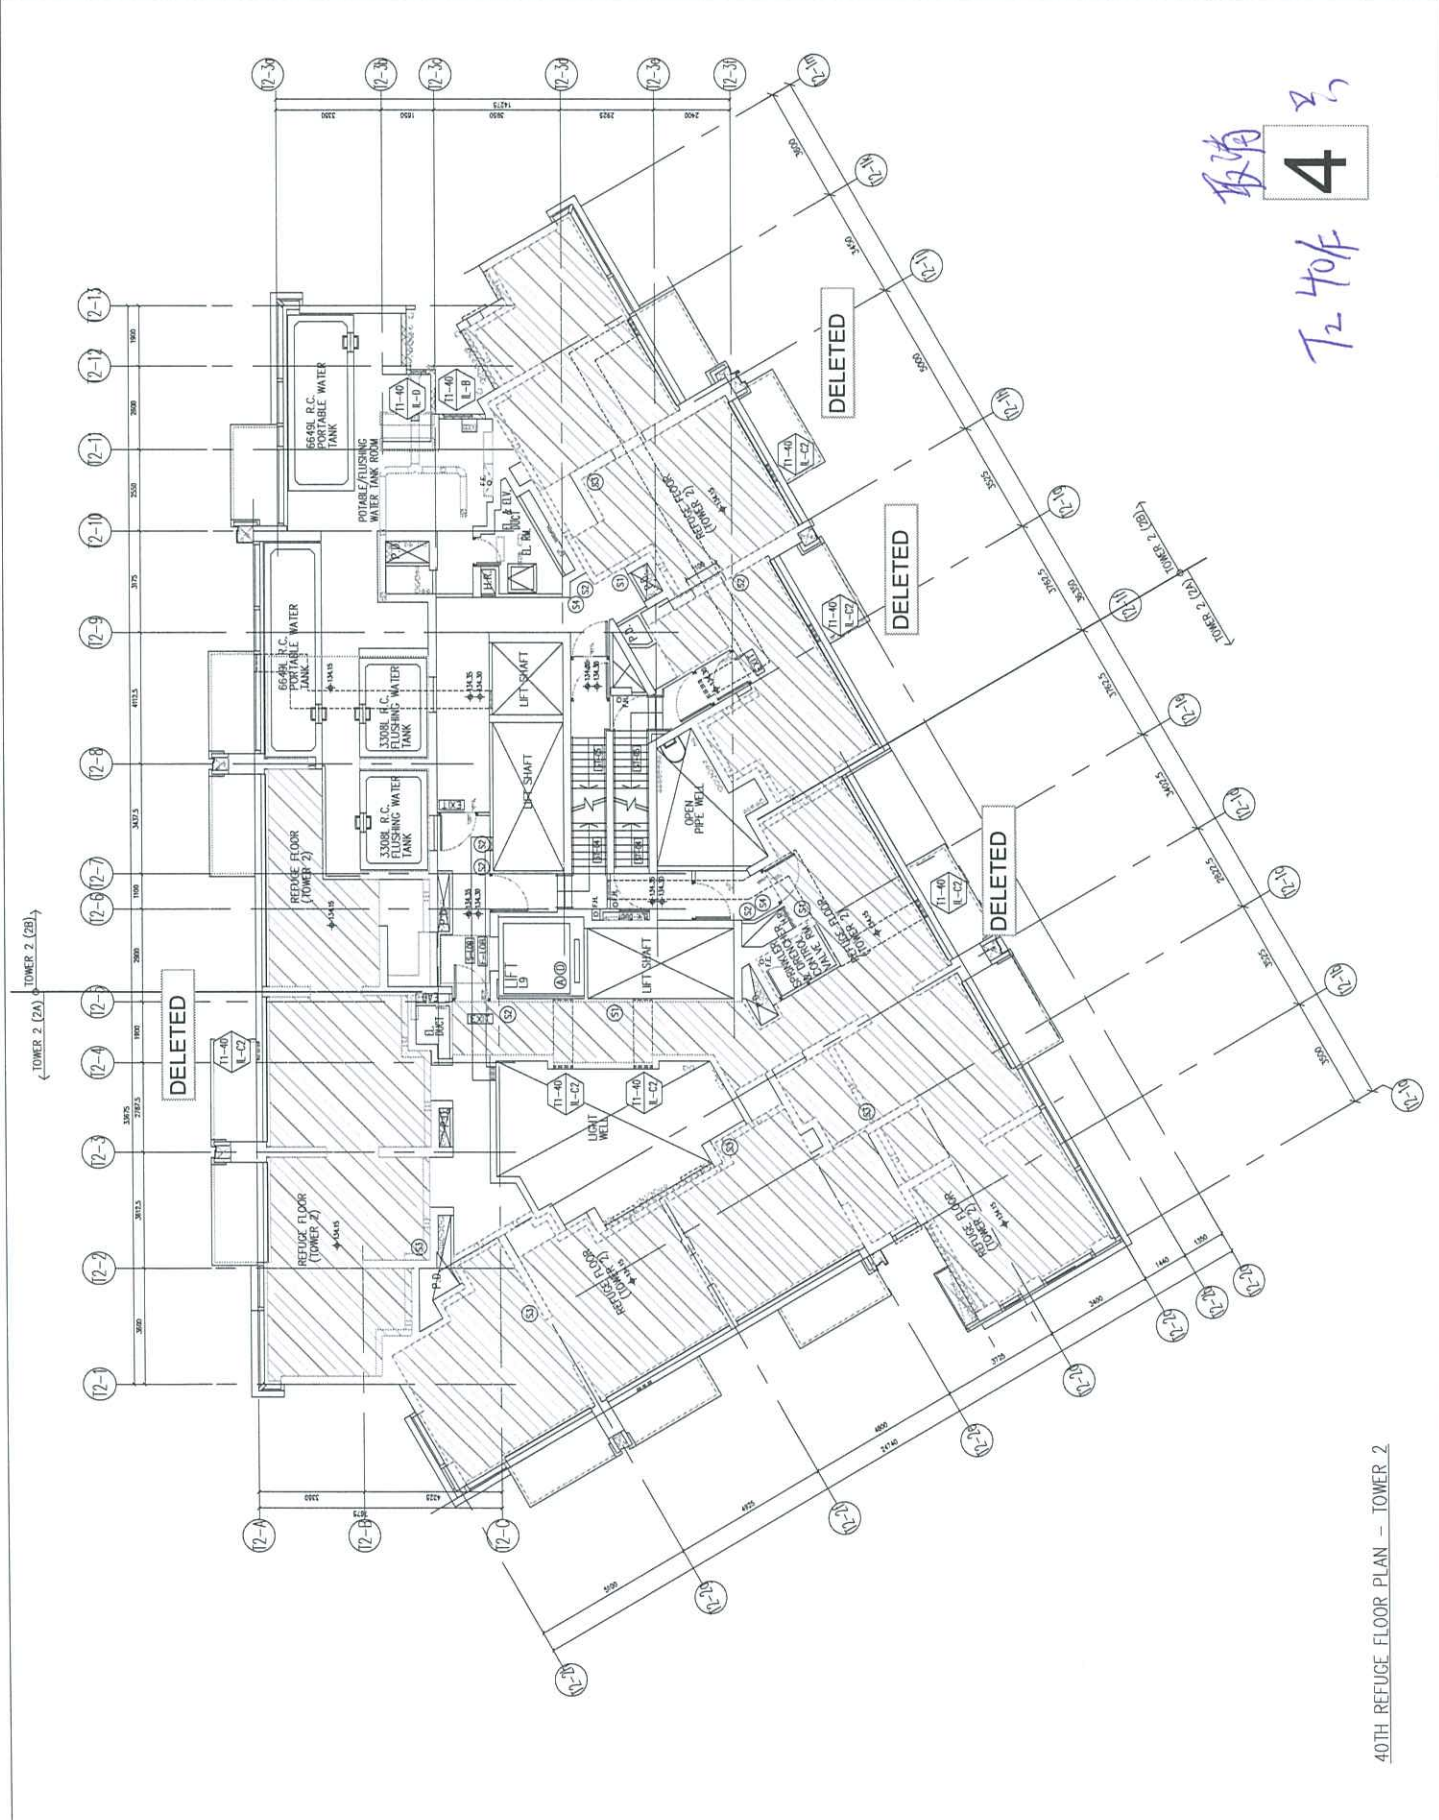

40TH REFUGE FLOOR PLAN - TOWER 2

