




ARCH. FEATURE AT 11/F, 17/F,  
21/F, 26/F, 30/F, 35/F, 39/F,  
43/F, 48/F, 52/F, 57/F, 61/F

**T1AE**

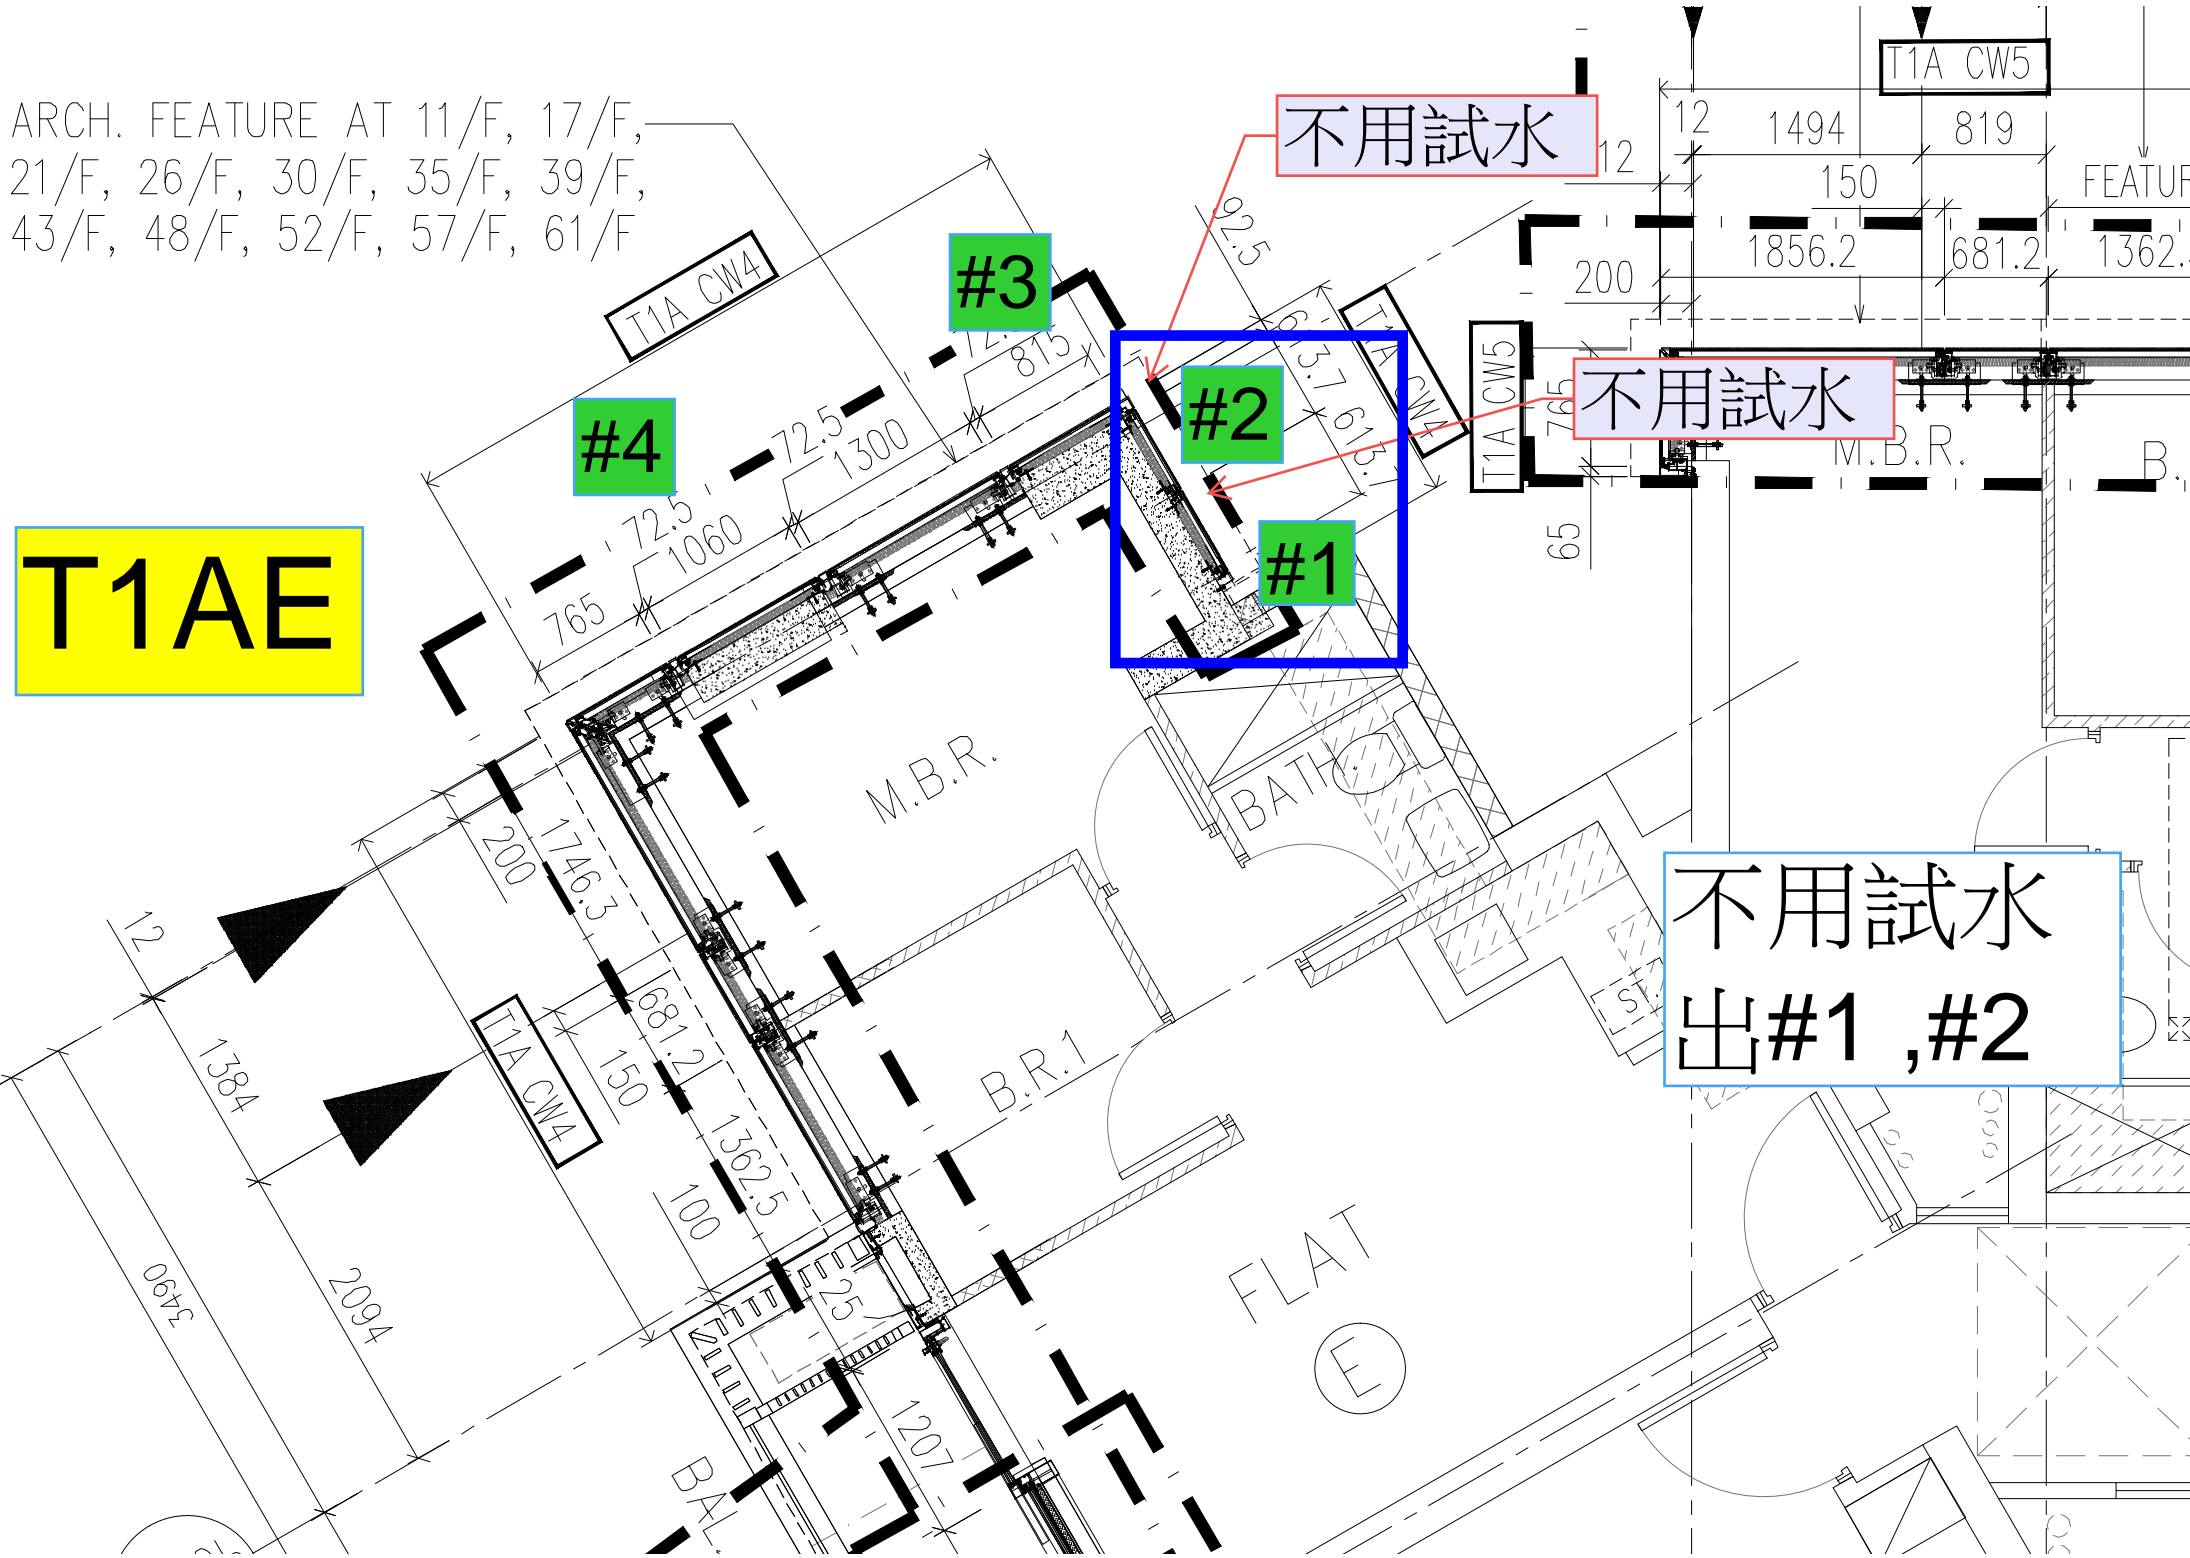

不用試水

不用試水

不用試水  
出#1, #2

#3

#4

#2

#1

T1A CW5

T1A CW4

T1A CW4

T1A CW5

T1A CW4

M.B.R.

BATH

B.R.1

FLAT  
(E)

BAL

FEATUR

B.

T1AB

不用試水

不用試水  
出#5

#5

#6

#7

#8

T1-2e

T1-40


T1A CW2

M BATH.

M.B.R.

B.R.2

/F, 22/F,  
/F-42/F,  
/F, 58/F-60/F

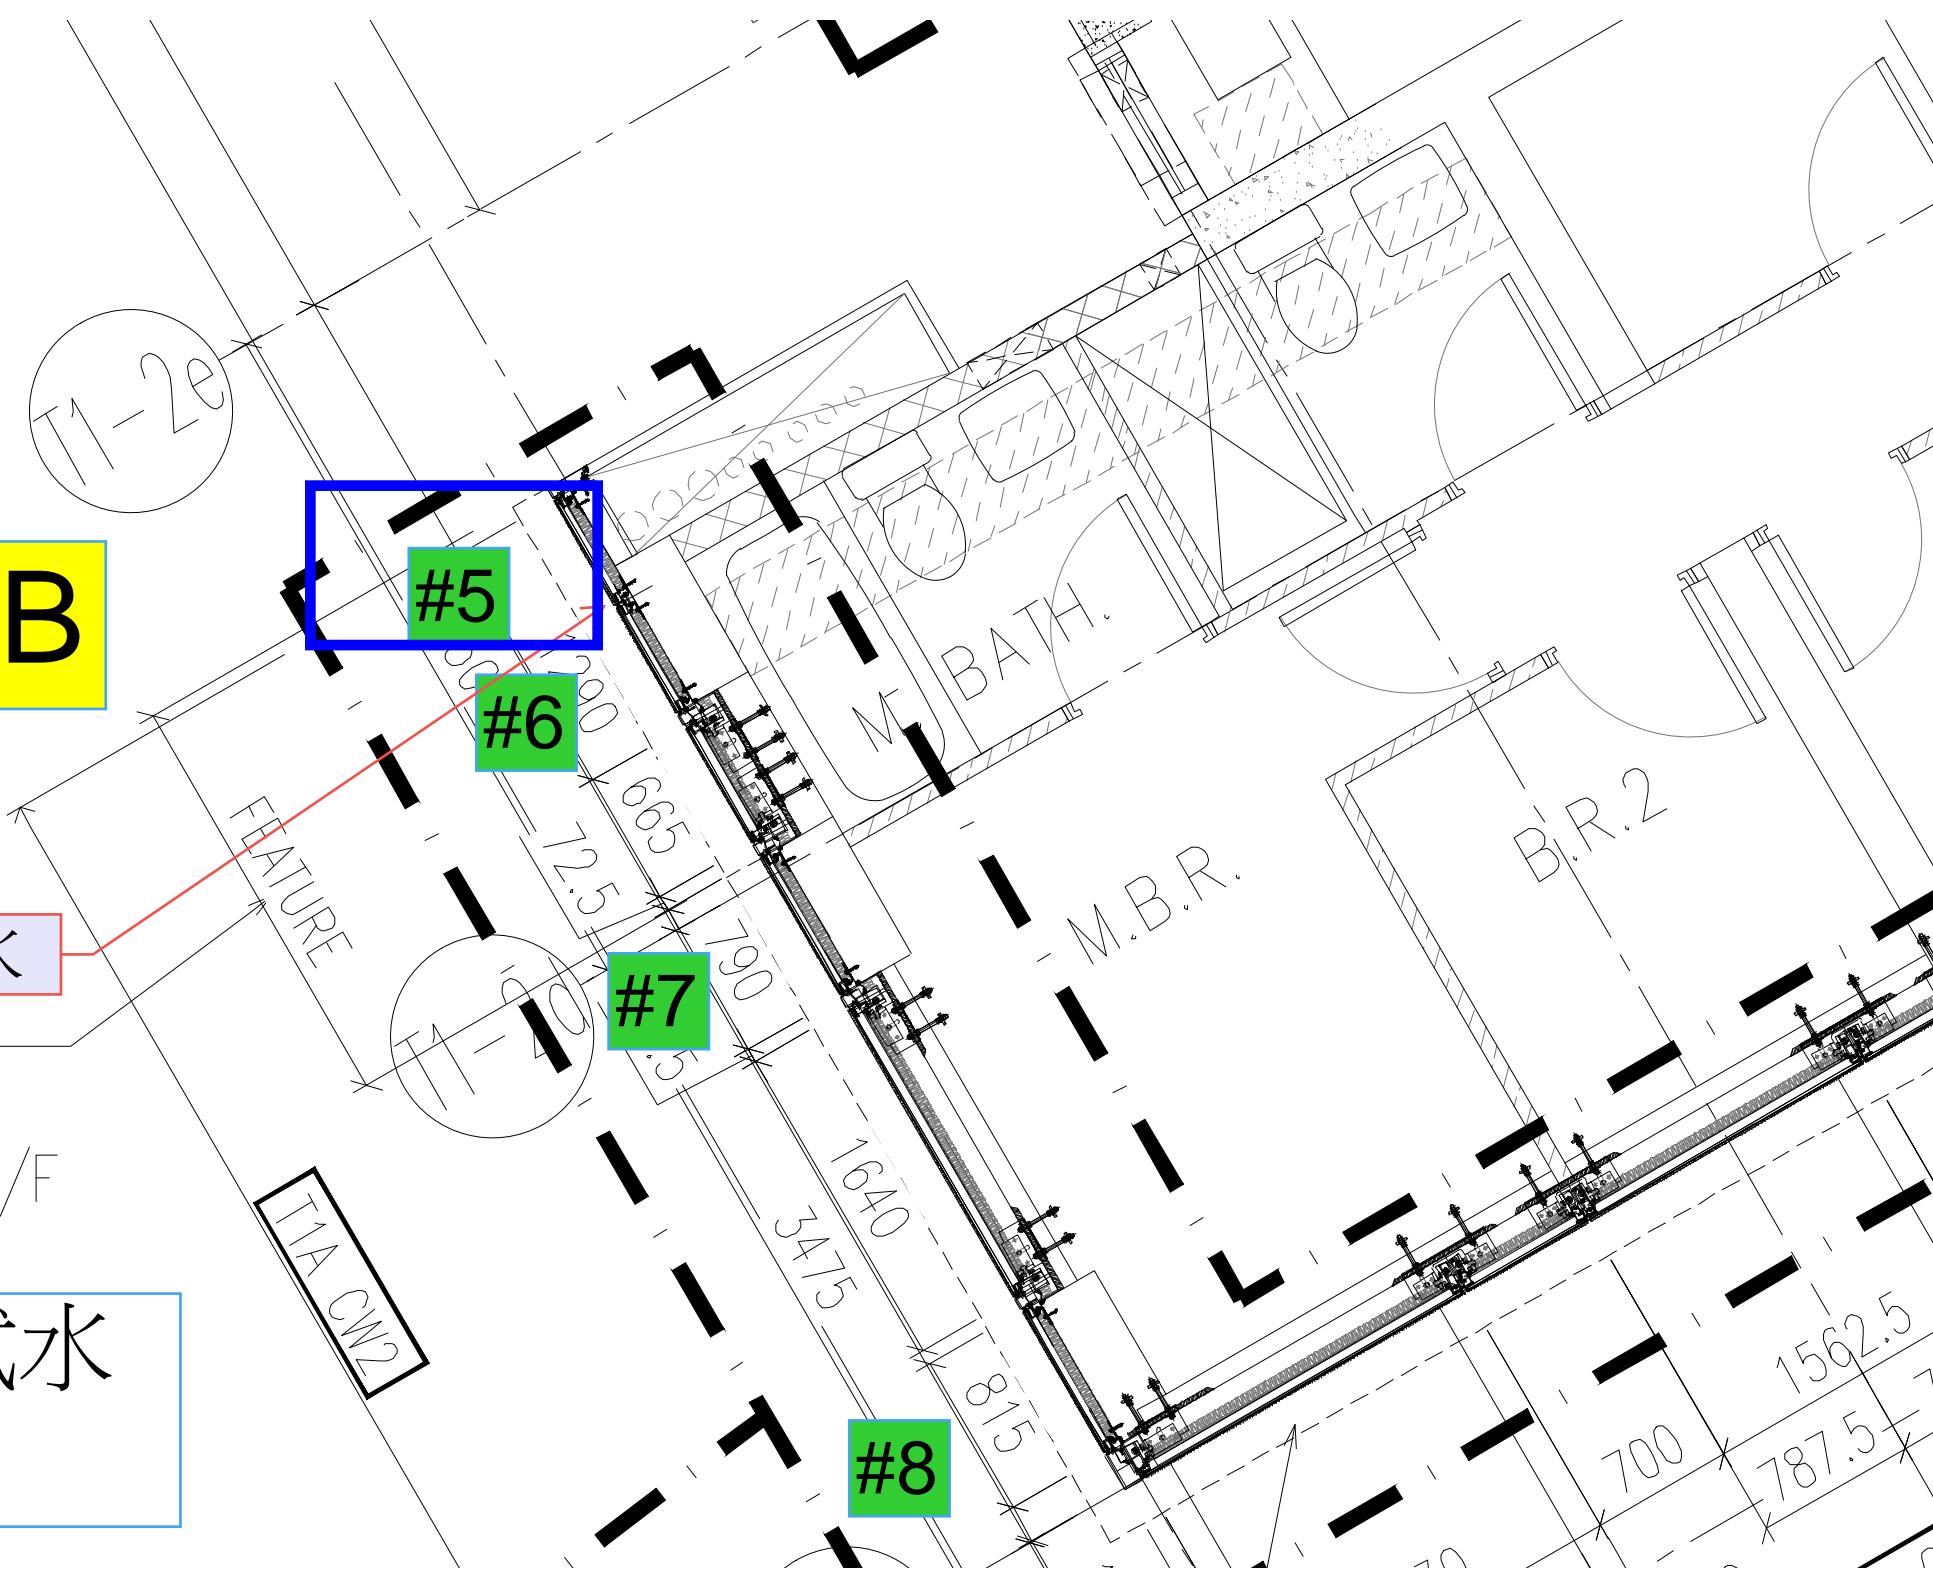

61/F, 66/F

T2A

T210

#1

T2AE

3525

640

72.5 780

2950 1780

840

192.5

192.5

M.B.R.

\*BATH


197.5

1727.5

1727.5

T2A  
CWA

FLAT

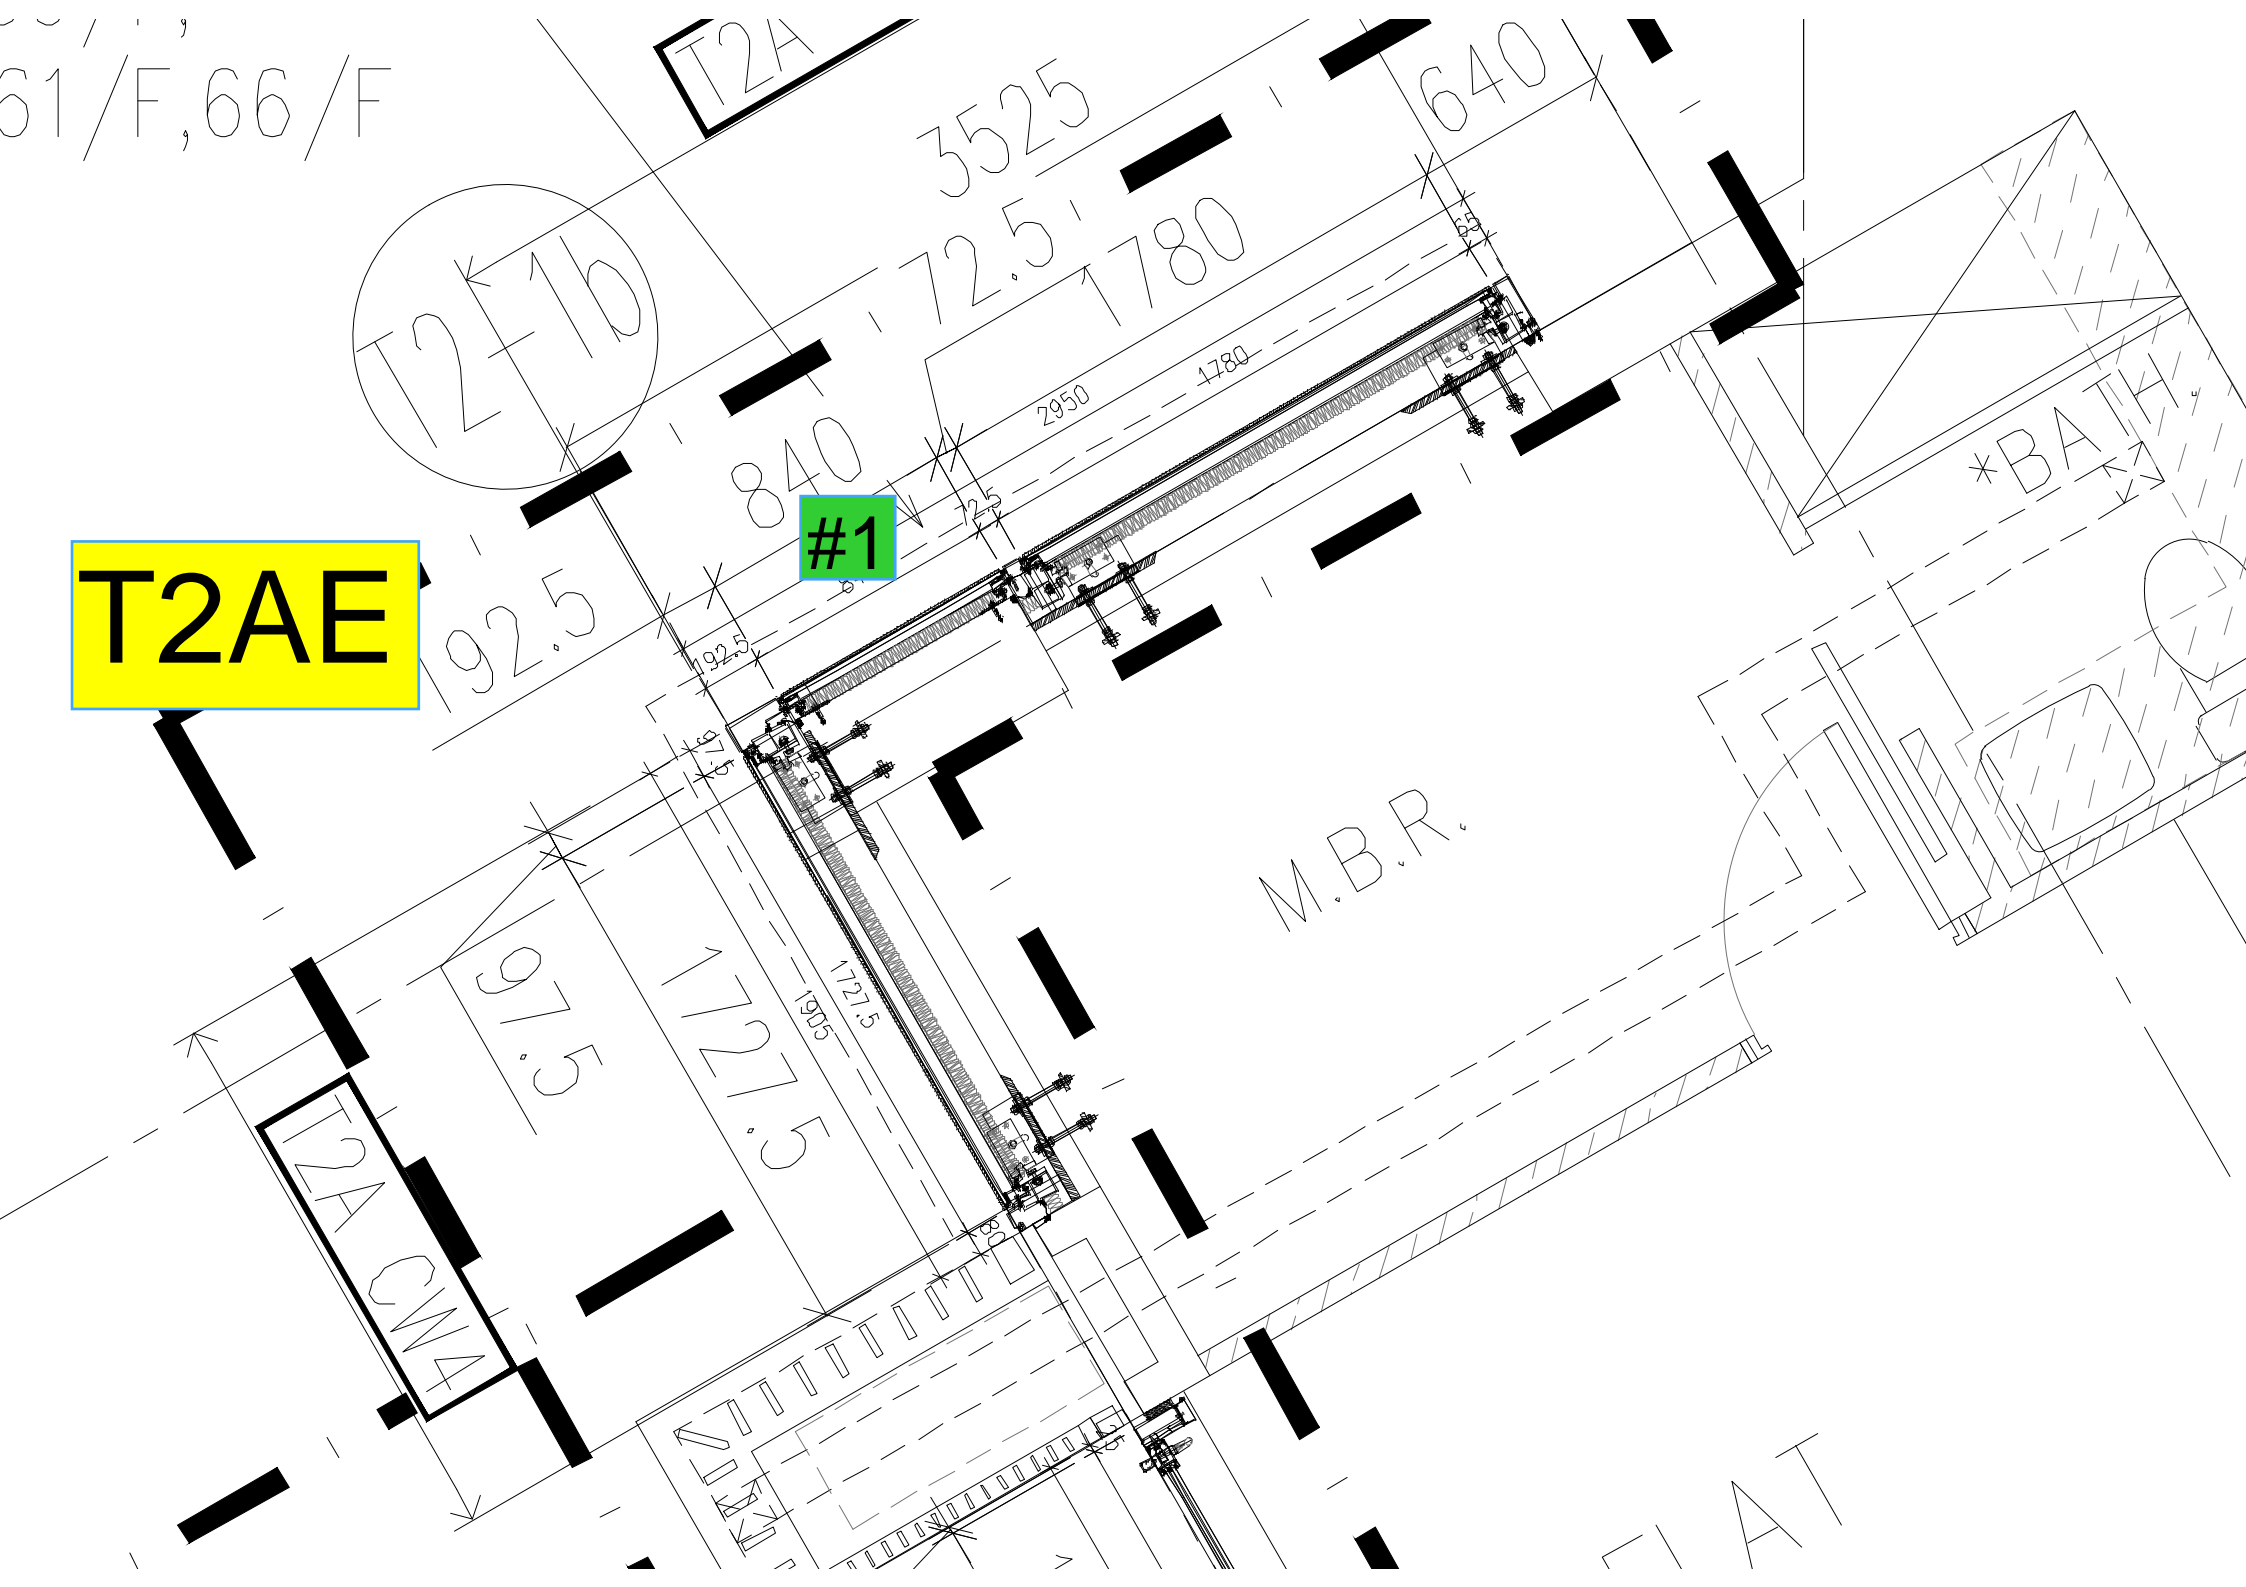





T3-20

T3-20

#2

#3

不用試水

#4

#5

T3AB

T3A CW2

T3A CW2

