

工程指示 / 要求簡箋(E.I.)

工程指示編號：EI / 8052 / 24

修改版次：A

工程編號：J - 858

工程名稱：將軍澳日出康城 LP 11

工程項目：後加百葉 T1 (11/F) 補 1 隻 (T1 AB Kit 位)

收件人：生統

發件人：Paul Wong

日期：17/07/2024

附上：

A 版本：因現場的 SO 孔和批圖生產的 SO 不對；

現場為 SO: 750(W) x 1650(H)

而大判表示現場已無法再落石矢修改 SO，

現趕驗樓，請生產一隻 SO 750(W)x1650(H)的百頁配合現場。

附圖則登記表，加工明細表，工序明細表，百頁開料單，百頁組裝圖及鋁料加工圖 (第四批)

請標新此存 T1-11 IL-C1

1. 請生產 1 隻百葉送地盤安裝。 T1 11/F / IL-C3。

2. 請查鋁料是否足夠??

如 B1502 鋁巴無料，用鋁板代替

X86251 無料。用 X86157 改料代替

3. 按地盤要求: T1 用 11/F T1 AB Kit ，請加做一隻 ~~SO: 425 W X 1250 H~~

請在 2024.07.22 前完成上列要求。

分發東莞

( ) 生產技術總監	<input type="checkbox"/> 連附件	(✓) 技術部	<input checked="" type="checkbox"/> 連附件	( ) 生產部	<input type="checkbox"/> 連附件	( ) 機械設計部	<input type="checkbox"/> 連附件
( ) 採購部	<input type="checkbox"/> 連附件	(✓) 生產統籌部	<input checked="" type="checkbox"/> 連附件	(✓) 小羅&清	<input checked="" type="checkbox"/> 連附件		
( ) 質檢部	<input type="checkbox"/> 連附件	( ) 會計部	<input type="checkbox"/> 連附件	( ) 報關組	<input type="checkbox"/> 連附件	( ) 其他	<input type="checkbox"/> 連附件

分發香港各部門：

( ) 行政部	<input type="checkbox"/> 連附件	( ) 會計部	<input type="checkbox"/> 連附件	( ) 統籌部	<input type="checkbox"/> 連附件	(✓) 工程部地盤科文 積哥	<input checked="" type="checkbox"/> 連附件
( ) 採購部	<input type="checkbox"/> 連附件	( ) QS 部	<input type="checkbox"/> 連附件	( ) 維修部	<input type="checkbox"/> 連附件	( ) 其他	<input type="checkbox"/> 連附件

傳遞編號：

HK 1339/24

發件人簽署：

項目經理簽署：




### 加工明细表

工程名称		J-858(康城11期)				施工分區(批次) :			VO Louver 铝料
采购原因		正常采购	工序号			材料发送地:		工厂	
序列号	型材模号	物料描述	图号	部件编号	长度 (mm)	数量	单位	颜色	备注
1	B09056	45X3mm铝巴	B09056-AL-75	B09056-AL-75L	1549	1	件	ECD3X1009 9S-XF1	
2	B09056	45X3mm铝巴	B09056-AL-75	B09056-AL-75R	1549	1	件	ECD3X1009 9S-XF1	
3	B1502	20X3mm铝巴	B1502-AL-59	B1502-AL-59B	669	2	件	ECD3X1009 9S-XF1	
4	B1502	20X3mm铝巴	B1502-AL-59	B1502-AL-59C	1608	2	件	ECD3X1009 9S-XF1	
5	X86248	百叶片	X86248-AL-54	X86248-AL-54A	661	26	件	ECD3X1009 9S-XF1	
6	X86249	滴水线	X86249-AL-57	X86249-AL-57A	667.5	1	件	ECD3X1009 9S-XF1	
7	X86251	边企料	X86251-AL-75	X86251-AL-75L	1623	1	件	ECD3X1009 9S-XF1	
8	X86251	边企料	X86251-AL-75	X86251-AL-75R	1623	1	件	ECD3X1009 9S-XF1	
9	X86252	生顶模	X86252-AL-57	X86252-AL-57A	684	1	件	ECD3X1009 9S-XF1	
10	X86253	生底模	X86253-AL-57	X86253-AL-57A	674	1	件	ECD3X1009 9S-XF1	
11									
12									
以下空白

说明: 1:注意保护成品, 严禁刻痕、划伤;

设计: 校对: 审核:

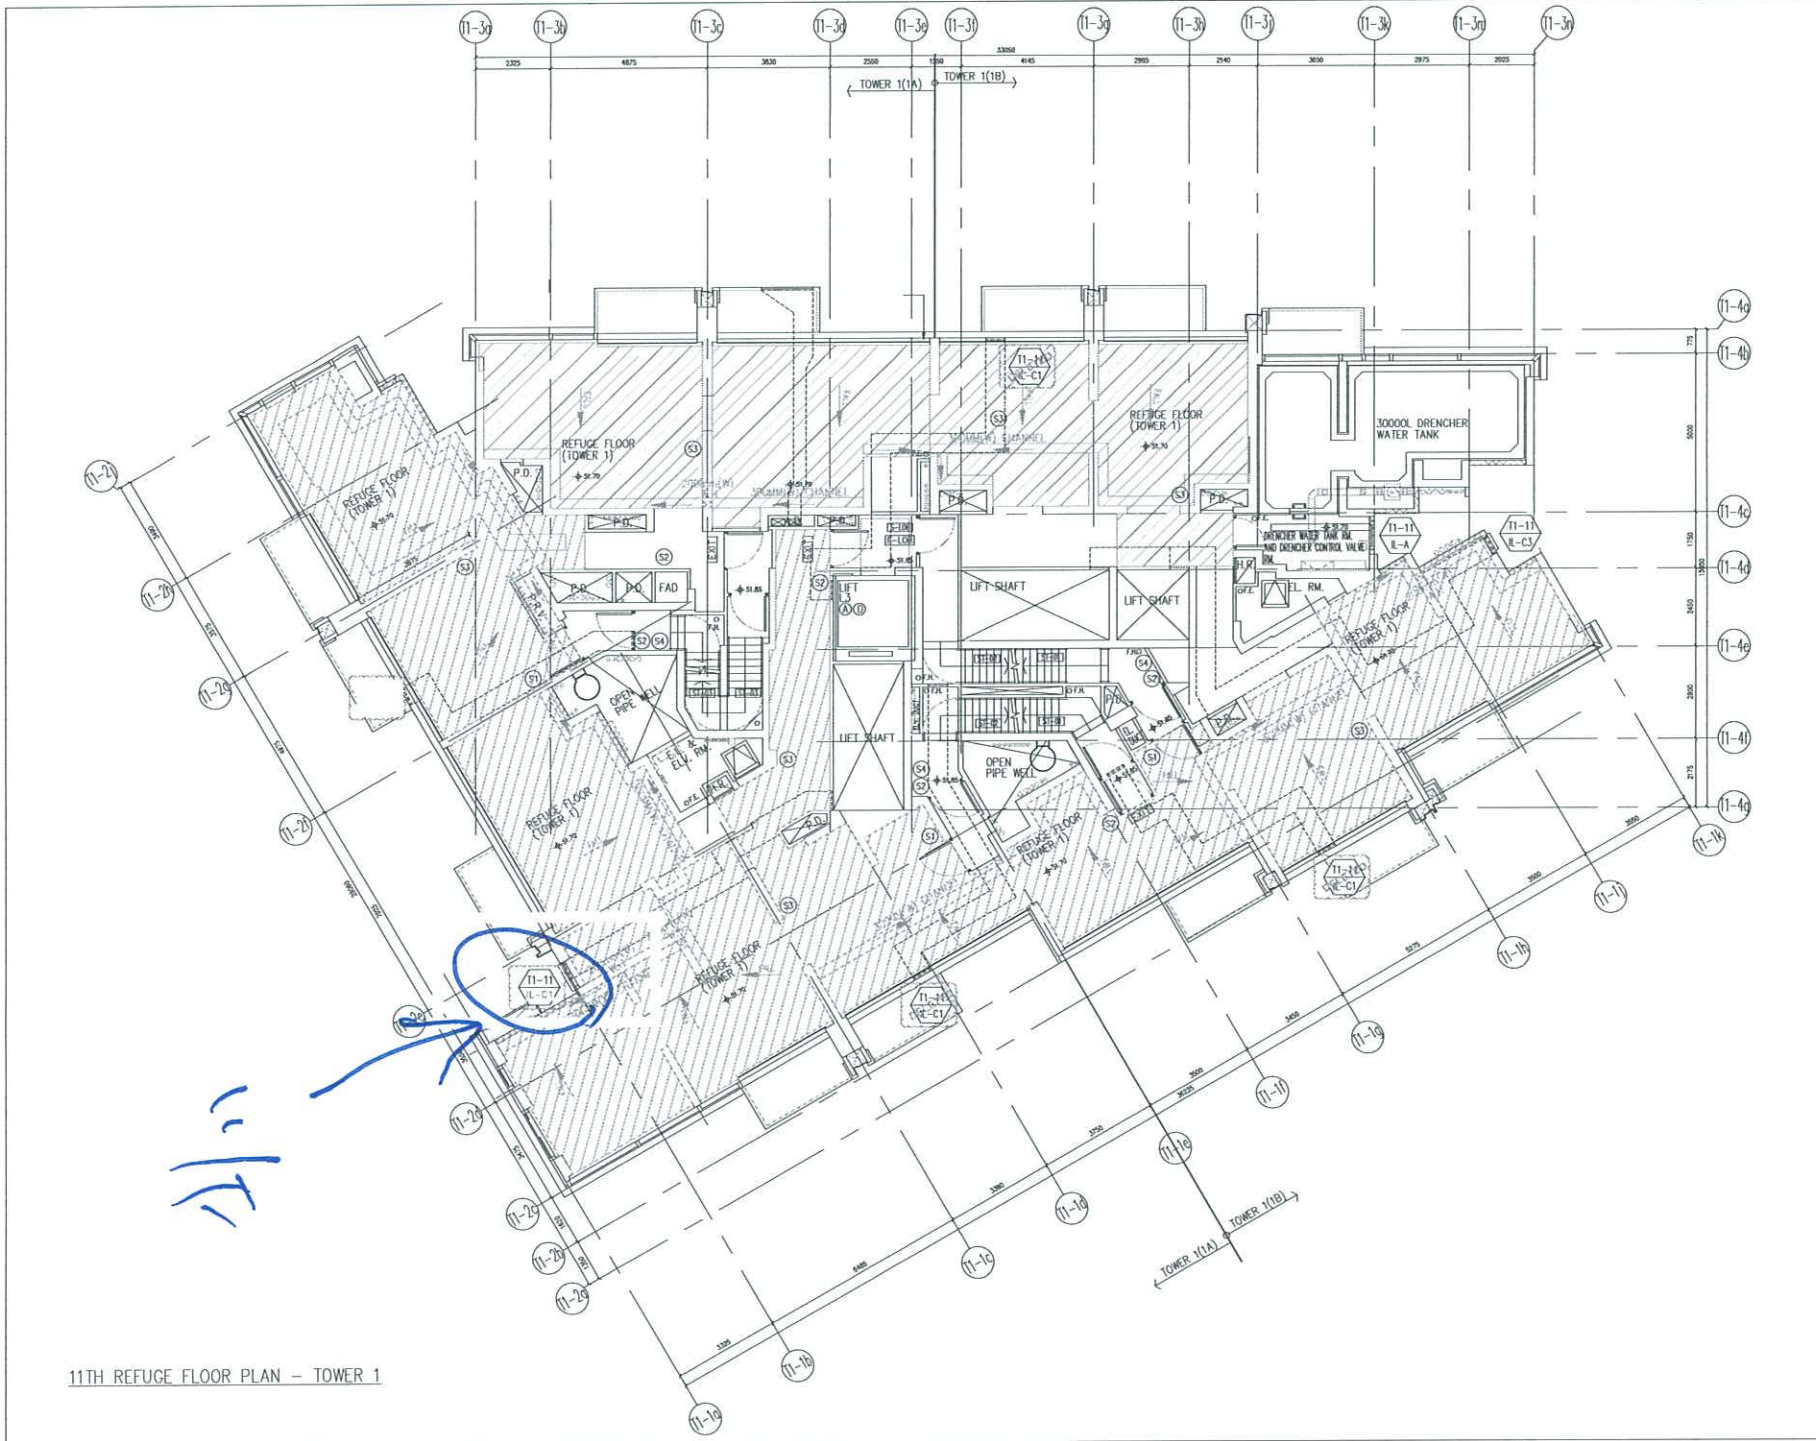

11TH REFUGE FLOOR PLAN - TOWER 1

B.D. REF :

CLIENT :  
 信和置業有限公司  
 Sino Land Company Limited

ARCHITECT :  
 Ronald Lu & Partners  
 Ronald Lu & Partners (HK) Ltd.  
 呂元祥建築師事務所 (香港) 有限公司

MAIN CONTRACTOR :  
 Gammon

STRUCTURAL ENGINEER :  
 AECOM

FAÇADE CONSULTANT :  
 AECOM

NOTE :  
 1. ALL DIMENSIONS ARE IN mm.  
 2. ALL ELEVATIONS ARE VIEWED FROM OUTSIDE.  
 3. ALL DIMENSIONS TO BE VERIFIED ON SITE BEFORE FABRICATION.

LEGEND :  
 X1 - DETAIL MARK NO.  
 X001 - REFER SHEET NO.  
 1. F.F.L. --- FINISHED FLOOR LEVEL  
 2. S.F.L. --- STRUCTURAL FLOOR LEVEL  
 3. (R) --- REVERSED DETAIL

A	02-05-2024	REVISED AS PER ARCHITECT COMMENTS	MM
NO.	DATE	REVISED	BY


JOB NO. : J-858  
 PROJECT : PROPOSED RESIDENTIAL DEVELOPMENT AT TROTIL 70RP, PHASE 11, LOHAS PARK TSEUNG KWAN O, N.T.

TITLE : IN-SITU ALUM. LOUVER LAYOUT PLAN TOWER 1 - 11/F

DATE : 04-OCT-21 SCALE : 1:160  
 DRAWN BY : CHECKED BY :

 美特鋁質有限公司  
 MIDI ALUMINIUM FABRICATOR LTD.  
 Units 6-8, Sunray Industrial Centre, 1/F  
 610 Cha Kwo Ling Road, Kowloon  
 Tel: 23489211-4 Fax: (852) 27276666


DWG NO. : J858-IL-3102 REV. : A

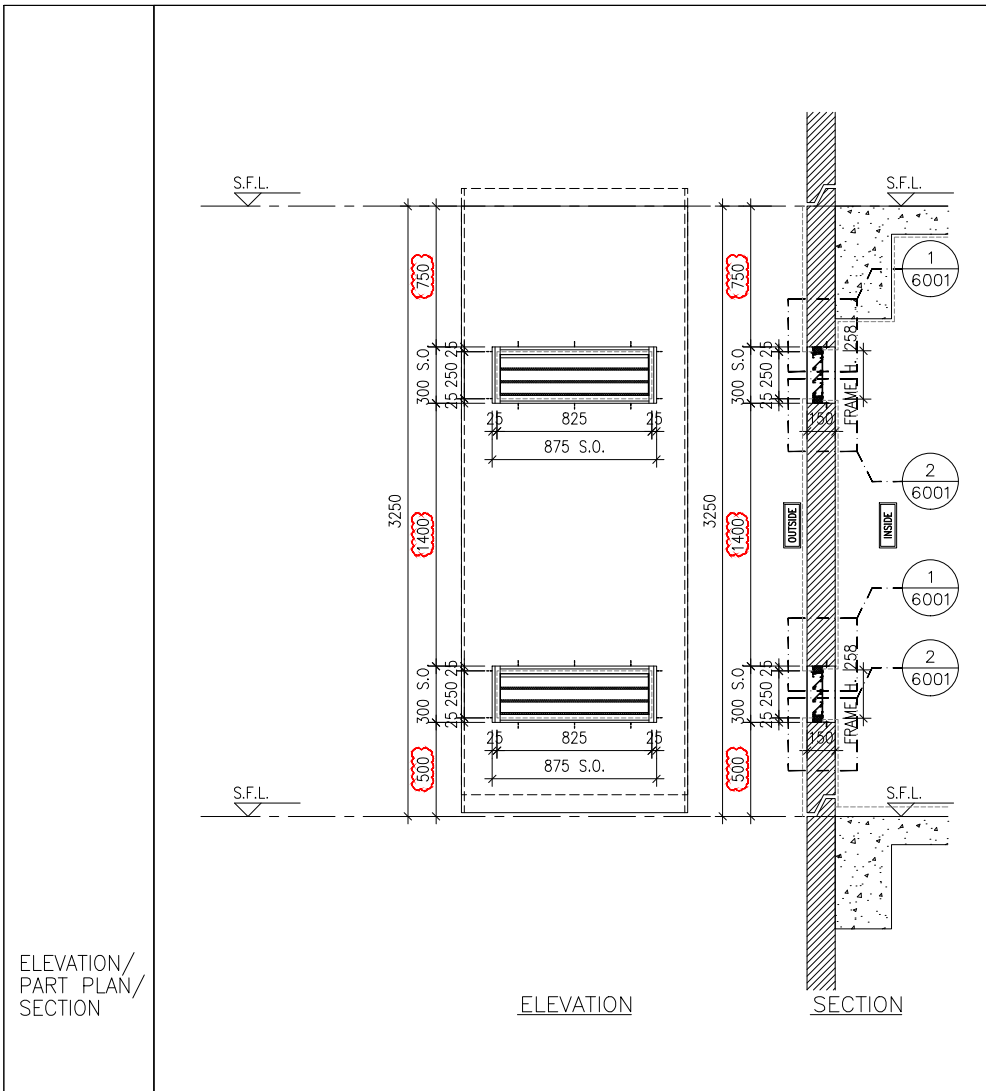

ELEVATION/  
PART PLAN/  
SECTION


ELEVATION

SECTION

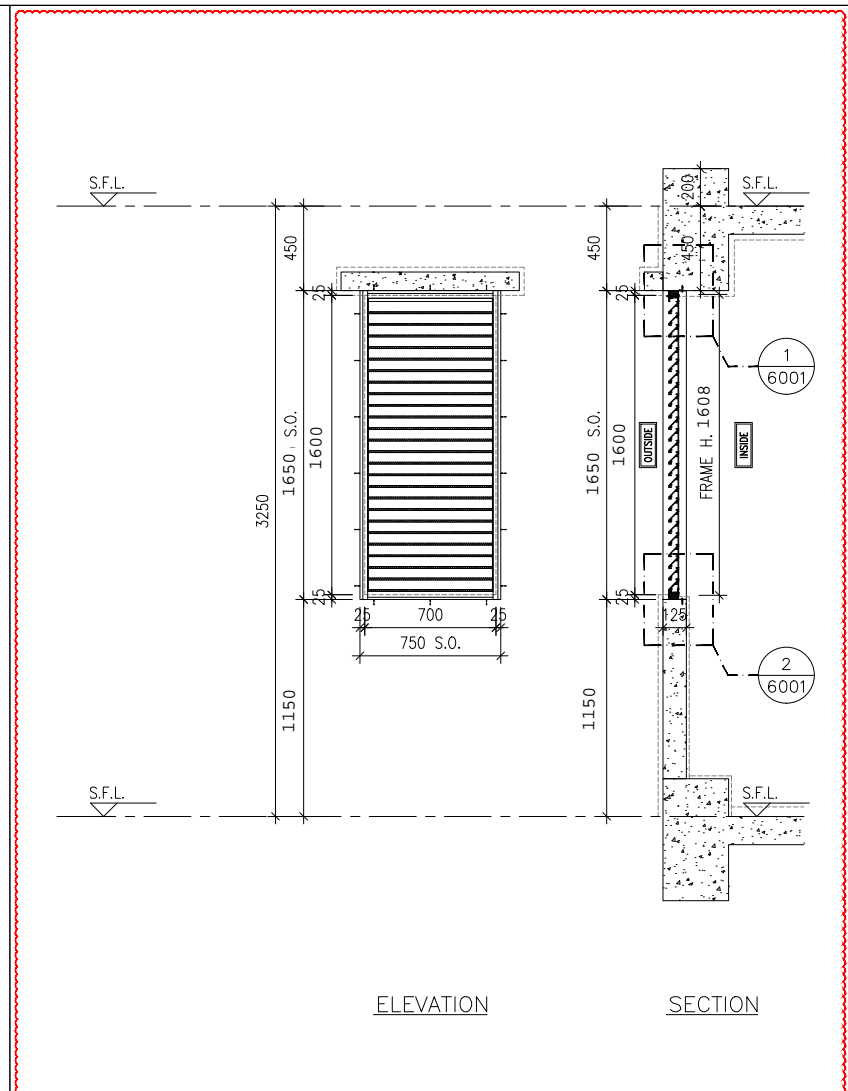


ELEVATION

SECTION

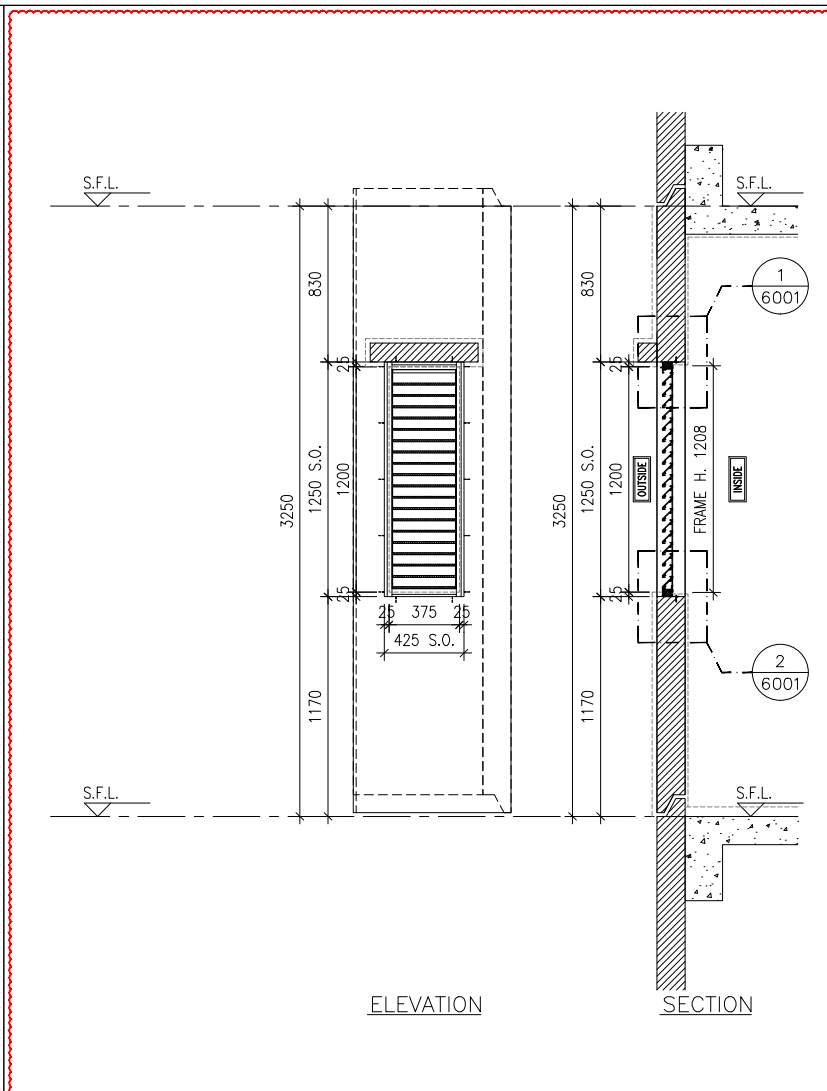


ELEVATION


SECTION

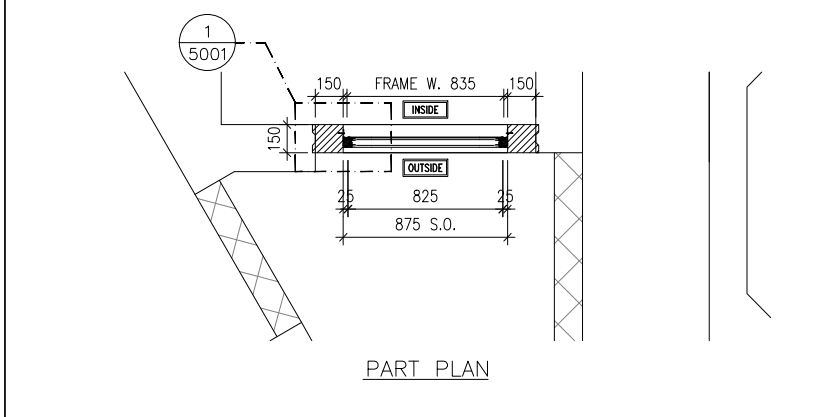

PART PLAN

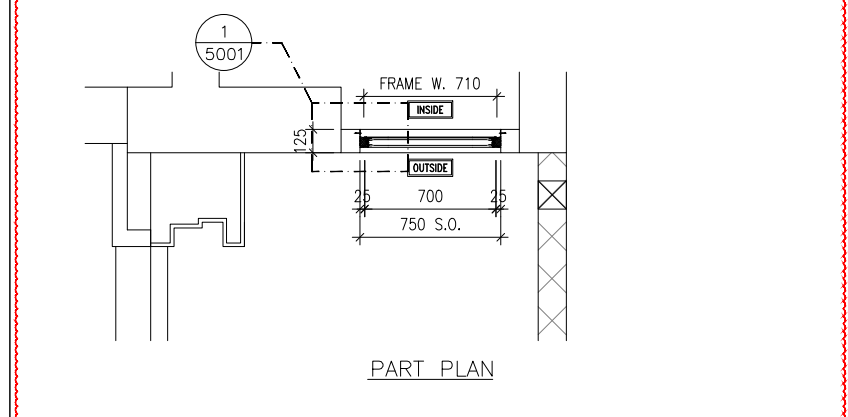

PART PLAN

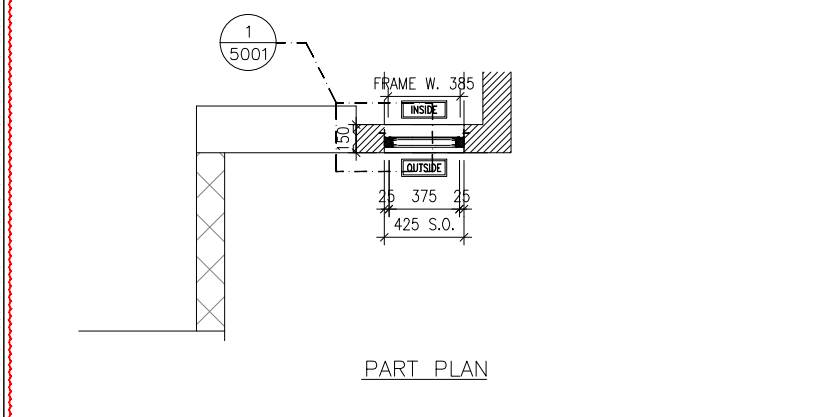

PART PLAN

B.D. REF :

CLIENT :  
 信和置業有限公司  
 Sino Land Company Limited

ARCHITECT :  
**ronald lu & partners**  
 Architects, Planners, Interior Designers  
 Ronald Lu & Partners (HK) Ltd.  
 呂元祥建築師事務所 (香港) 有限公司

MAIN CONTRACTOR :  
**Gammon**

STRUCTURAL ENGINEER :  
**AECOM**

FACADE CONSULTANT:  
**AECOM**

- NOTE :
1. ALL DIMENSIONS ARE IN mm.
  2. ALL ELEVATIONS ARE VIEWED FROM OUTSIDE.
  3. ALL DIMENSIONS TO BE VERIFIED ON SITE BEFORE FABRICATION.

- LEGEND :
- ① --- DETAIL MARK NO.
  - ⊗ --- REFER SHEET NO.
1. F.F.L. --- FINISHED FLOOR LEVEL
  2. S.F.L. --- STRUCTURAL FLOOR LEVEL
  3. (R) --- REVERSED DETAIL

NO.	DATE	REVISED	BY
B	02-05-2024	REVISED AS PER ARCHITECT COMMENTS	MN
A	22-01-2024	REVISED AS PER ARCHITECT COMMENTS	MN

JOB NO. : J-858

PROJECT :  
 PROPOSED RESIDENTIAL DEVELOPMENT  
 AT TKOTL 70RP, PHASE 11, LOHAS PARK  
 TSEUNG KWAN O, N.T.

TITLE :  
 IN-SITU ALUM. LOUVER  
 ALUM. LOUVER SCHEDULE  
 FOR TOWER 1

DATE : 04-OCT-21      SCALE : 1:40

DRAWN BY :              CHECKED BY :

**美特鋁質有限公司**  
**MIDI ALUMINIUM FABRICATOR LTD.**  
 Units 6-8, Sunray Industrial Centre, 1/F  
 610 Cha Kwo Ling Road, Kowloon  
 Tel:23489211-4 Fax:(852)2727666

DWG NO. : J858-IL-2101      REV. : B

GLAZING AREA:	Required = N/A	Provided = N/A
OPENABLE AREA:	Required = N/A	Provided = N/A

GLAZING AREA:	Required = N/A	Provided = N/A
OPENABLE AREA:	Required = N/A	Provided = N/A

GLAZING AREA:	Required = N/A	Provided = N/A
OPENABLE AREA:	Required = N/A	Provided = N/A

WINDOW MARK	
LOCATION	TOWER 1 11/F(REFUGE FLOOR)
SECTION	50mm ALUM. SECTION WITH PVF2 COATING(SLIVER CHAMPAGNE COLOUR)
GLAZING	N/A
QUANTITY	2 NOS.(1 SET)
REMARKS	FREE AREA (%) : 24.21/39.12 = 0.6189 = 61.89%


WINDOW MARK	
LOCATION	TOWER 1 11/F(REFUGE FLOOR)
SECTION	50mm ALUM. SECTION WITH PVF2 COATING(SLIVER CHAMPAGNE COLOUR)
GLAZING	N/A
QUANTITY	1 NO.
REMARKS	FREE AREA (%) : 21.97/35.93 = 0.6115 = 61.15%

WINDOW MARK	
LOCATION	TOWER 1 11/F(REFUGE FLOOR)
SECTION	50mm ALUM. SECTION WITH PVF2 COATING(SLIVER CHAMPAGNE COLOUR)
GLAZING	N/A
QUANTITY	2 NOS.
REMARKS	FREE AREA (%) : 35.01/49.10 = 0.7130 = 71.30%



美特铝质有限公司  
MIDI Aluminium Fabricator Ltd.

工程號	J858	類別		物料號	-	
地盘	康城11期	制圖	I. H.	2024-07-16	圖號	J858-AL-47SU
修改		採用工廠	地盤	✓	图纸名称	百叶窗组装图
日期		材料颜色	-		材料	-
					復核	-
					批准	-
					數量	-
					單件重量	- (KG)

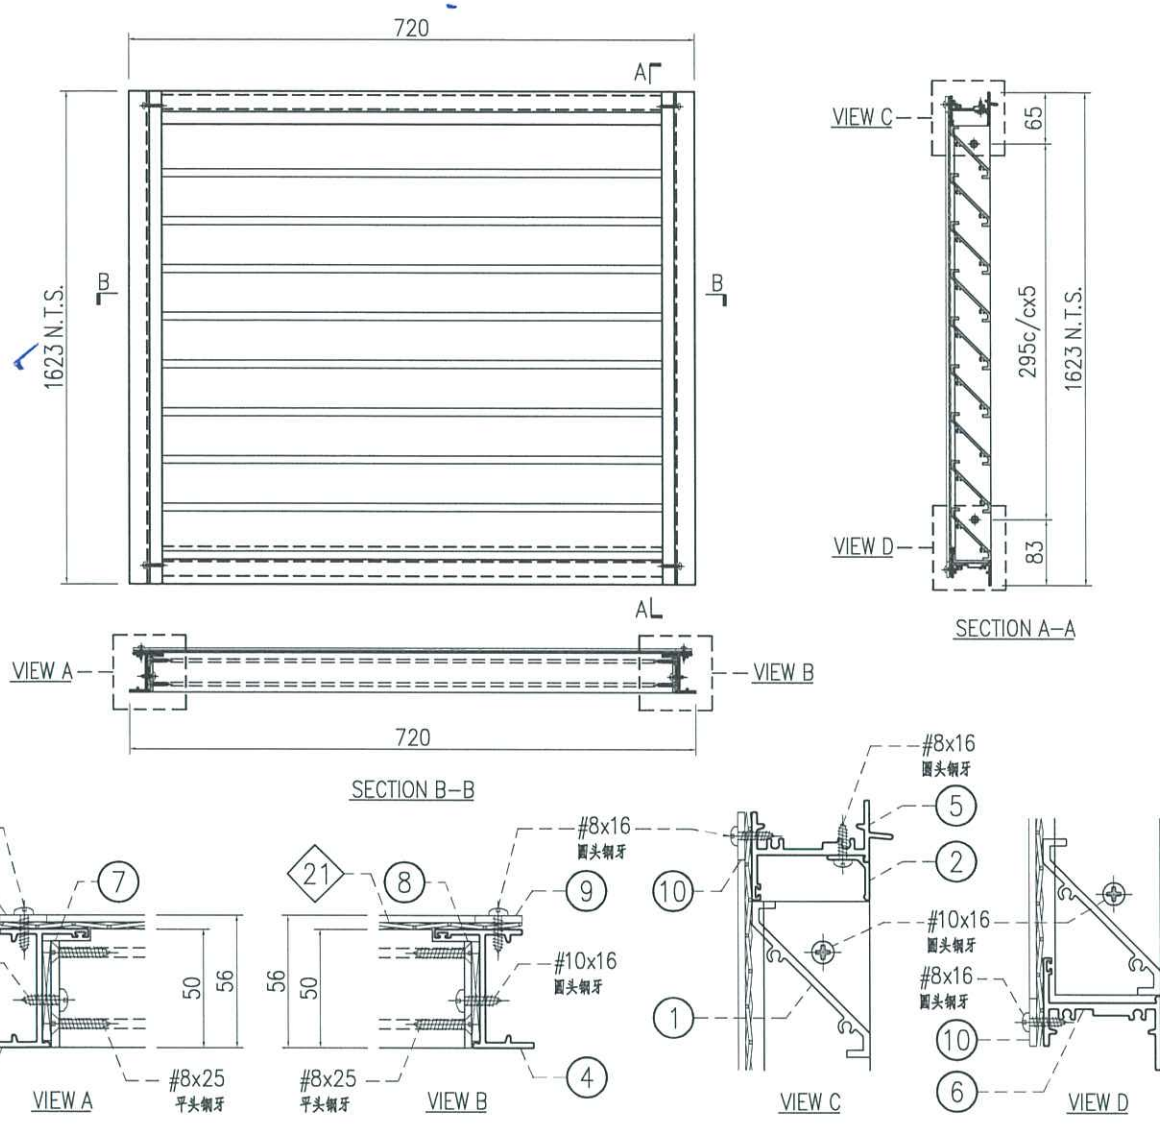

○ ALUM. EXTRUSION			
ITEM	FAB. DWG NO.	LENGTH (mm)	QTY
1	X86248-AL-54A	661	26
2	X86249-AL-57A	667.5	1
3	X86251-AL-75L	1623	1
4	X86251-AL-75R	1623	1
5	X86252-AL-57A	684	1
6	X86253-AL-57A	674	1
7	B09056-AL-75L	1549	1
8	B09056-AL-75R	1549	1
9	B1502-AL-59C	1608	2
10	B1502-AL-59B	669	2

◇ ALUM. BIRD MESH				
ITEM	FAB. DWG NO.	L (mm)	H (mm)	件/幅
21	BM-AL-55A	710	1608	1

窗号	宽度(W)	高度(H)	数量	楼层
T1-11/IL-C3	720	1623	1	11/F



内门框配件	颜色	数量	备注
#8x16圆头钢牙	A4-70	18	鸟网压巴
#8x25平头钢牙	A4-70	104	百叶片
#8x25圆头钢牙	A4-70	8	组框
#10x16圆头钢牙	A4-70	12	百叶框



美特鋁質有限公司  
MIDI Aluminium Fabricator Ltd.

工程號	J858	類別		物料號	-							
地盘	康城11期	制圖	I. H.	2024-06-04	圖號	X86248-AL-54						
修改		採用工廠	✓	地盤		圖紙名稱	百叶片加工图	復核	-	-	數量	-
日期		材料颜色	香槟金 (ECC03X1009 9S-XF1)	材料	X86248	批准	-	-	單件重量	-	(KG)	

序号	产品编号	L(mm)	数量
1	X86248-AL-54A	661	-

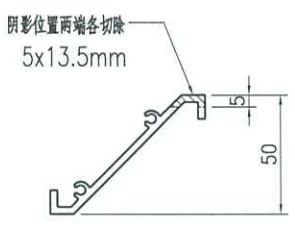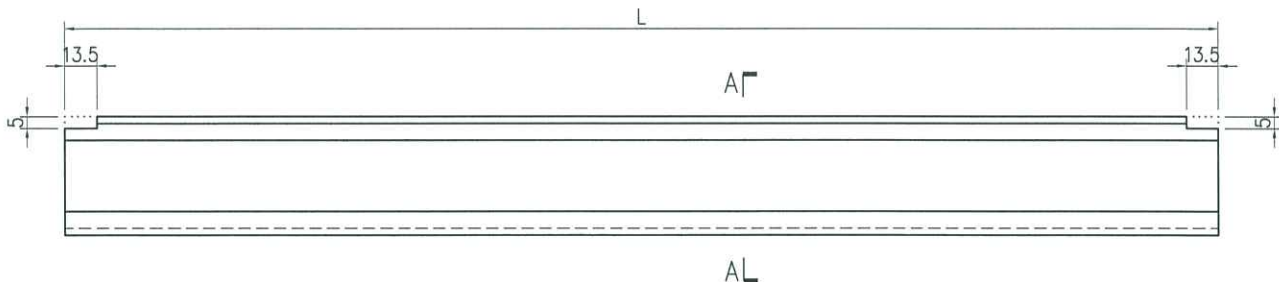



SECTION A-A



美特鋁質有限公司  
MIDI Aluminium Fabricator Ltd.

工程號	J858	類別		物料號	-							
地盘	康城11期	制圖	I. H.	2024-06-04	圖號	X86249-AL-57						
修改		採用工廠	✓	地盤		圖紙名稱	百叶滴水线加工图	復核	-	-	數量	-
日期		材料颜色	香槟金 (EC33X1009 9S-TF1)	材料	X86249	批准	-	-	單件重量	-	(KG)	

序号	产品编号	L(mm)	C	数量
1	X86249-AL-57A	667.5	300c/cx2	-

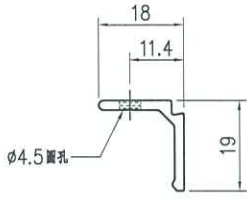
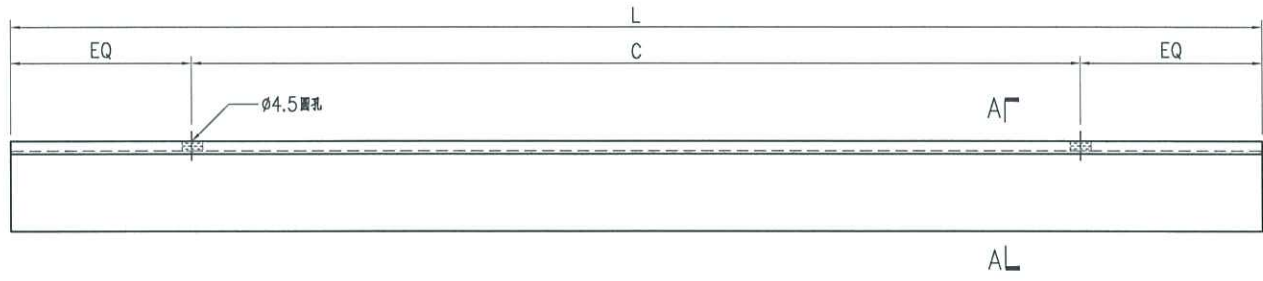


SECTION A-A




美特铝质有限公司  
MIDI Aluminium Fabricator Ltd.



工程號	J858	類別		物料號	-		
地盘	康城11期	制圖	I. H.	2024-07-16	圖號	X86251-AL-75	
修改		採用工廠	✓	地盤		數量	-
日期		材料颜色	香槟金 (EC03X1009 9S-1F1)	材料	X86251	批准	-
						單件重量	- (KG)

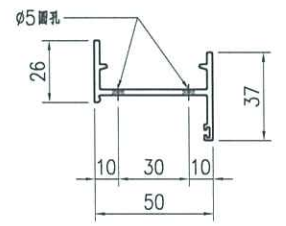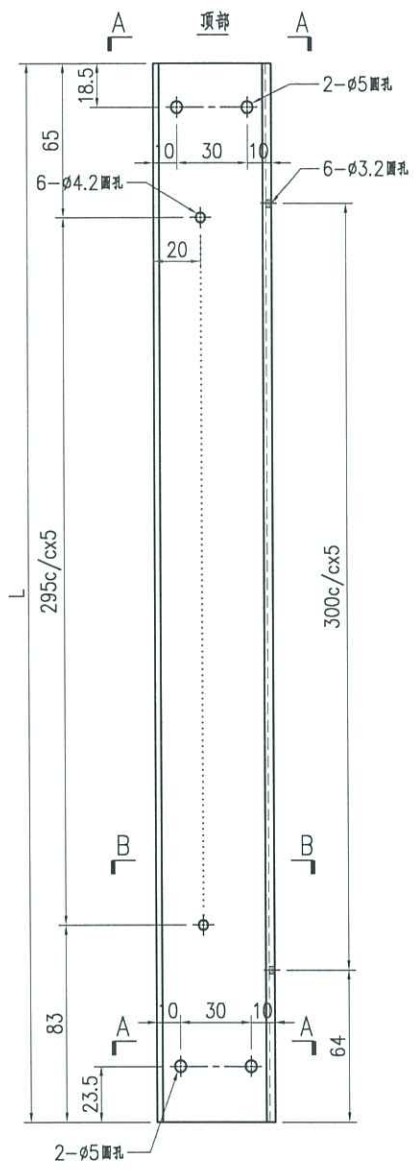


SECTION A-A

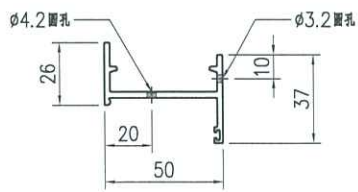

SECTION B-B

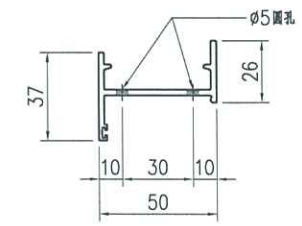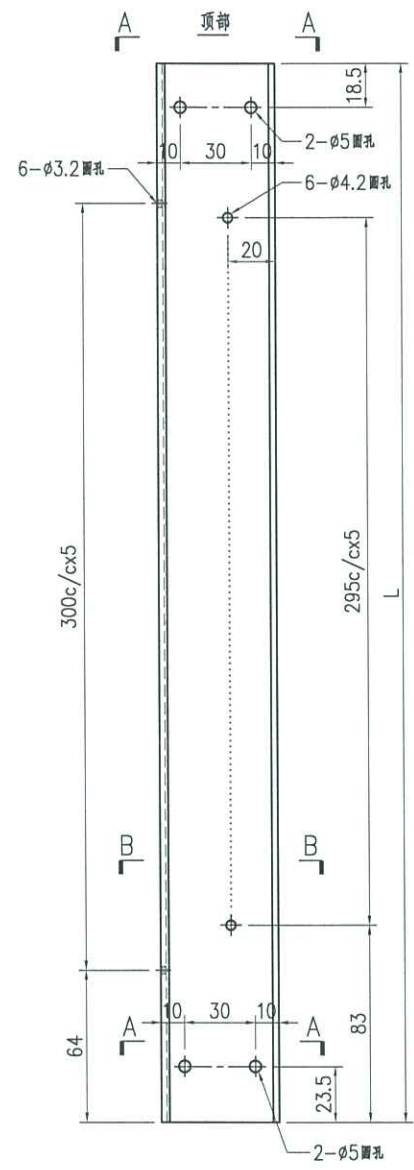

SECTION A-A

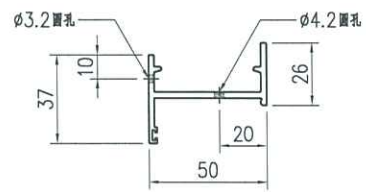

SECTION B-B

序号	产品编号	L(mm)	数量
1	X86251-AL-75L	1623	-



序号	产品编号	L(mm)	数量
1	X86251-AL-75R	1623	-



美特鋁質有限公司  
MIDI Aluminium Fabricator Ltd.

工程號	J858	類別		物料號	-							
地盘	康城11期	制圖	I. H.	2024-06-04	圖號	X86252-AL-57						
修改		採用工廠	✓	地盤		图纸名称	生顶横加工图	復核	-	-	數量	-
日期		材料颜色	香槟金 (ECC03X1009 9S-FF1)	材料	X86252	批准	-	-	單件重量	-	(KG)	

序号	产品编号	L(mm)	C	数量
1	X86252-AL-57A	684	300c/cx2	-

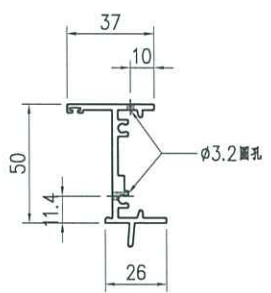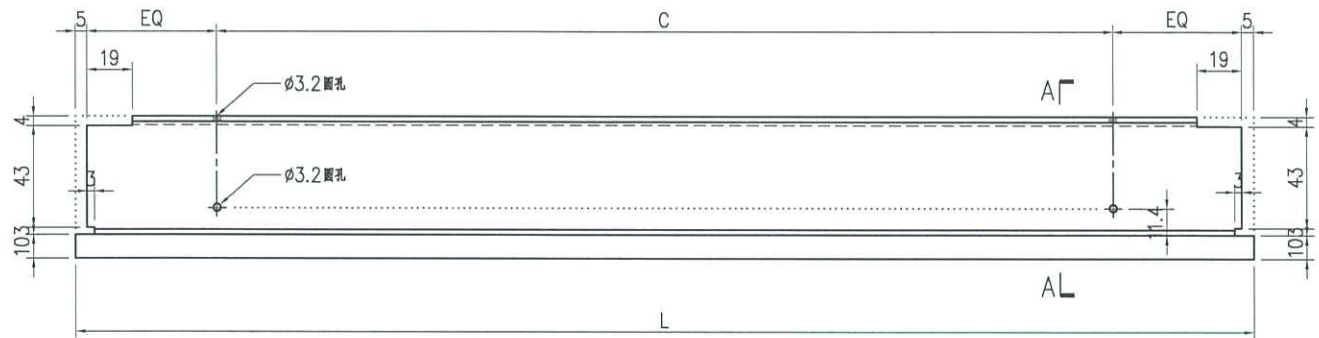



SECTION A-A





美特鋁質有限公司  
MIDI Aluminium Fabricator Ltd.

工程號	J858	類別		物料號	-		
地盘	康城11期	制圖	I. H.	2024-07-16	圖號	B09056-AL-75	
修改		採用工廠	✓	地盘	图纸名称	百叶框铝巴加工图	
日期		材料颜色	香槟金 (ECD3X1009 9S-XP1)	材料	B09056	復核	-
						批准	-
						數量	-
						單件重量	- (KG)

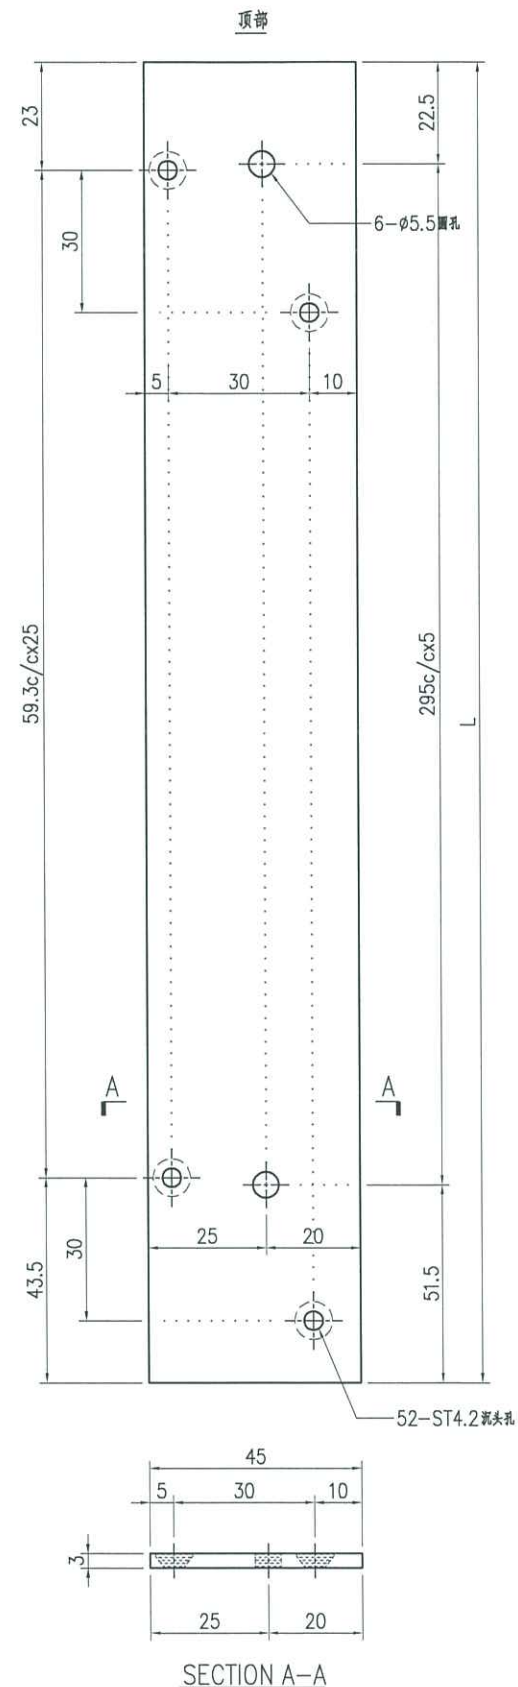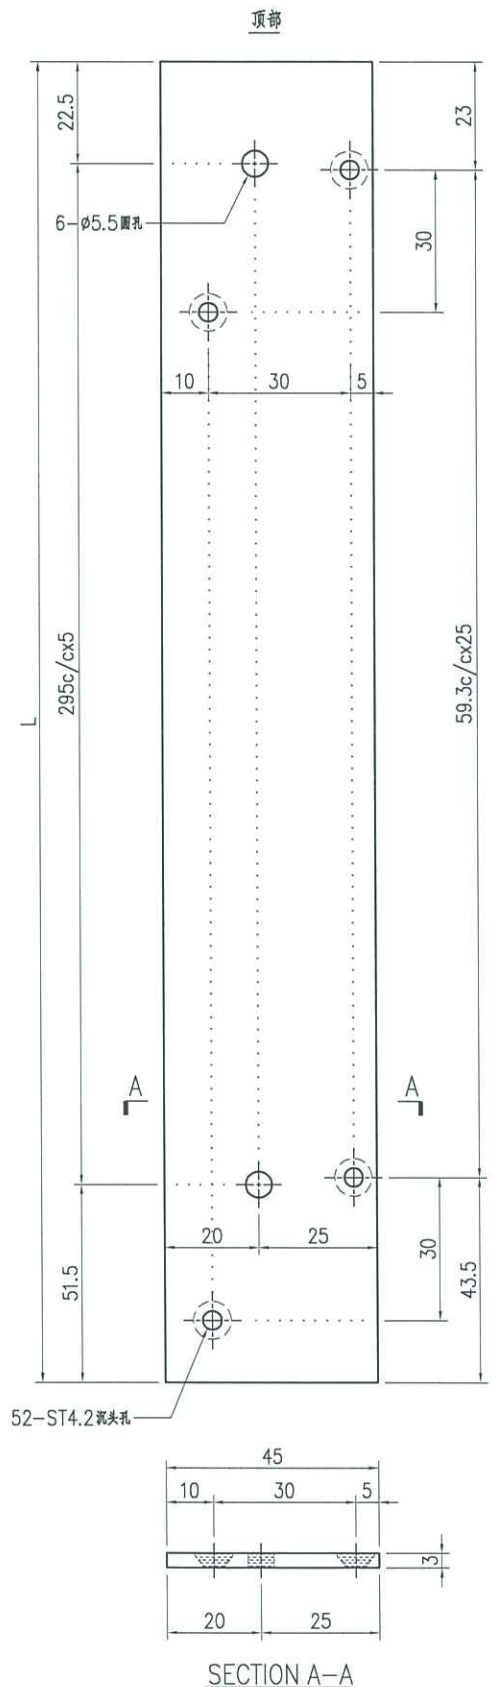

序号	产品编号	L(mm)	数量
1	B09056-AL-75L	1549	-



序号	产品编号	L(mm)	数量
1	B09056-AL-75R	1549	-



美特鋁質有限公司  
MIDI Aluminium Fabricator Ltd.

工程號	J858	類別		物料號	-	
地盘	康城11期	制圖	I. H.	2024-06-04	圖號	B1502-AL-59
修改	A	採用工廠	✓	地盘	圖紙名稱	鸟网竖压巴加工图
日期	20240716	材料颜色	香槟金 (EC03X1009 9S-1P1)	材料	B1502	批准
						復核
						數量
						單件重量
						(KG)

序号	产品编号	L(mm)	C	数量
1	B1502-AL-59A	1458	300c/cx4	-
2	B1502-AL-59B	669	300c/cx2	-
3	B1502-AL-59C	1608	300c/cx5	-

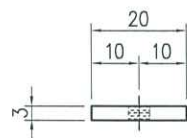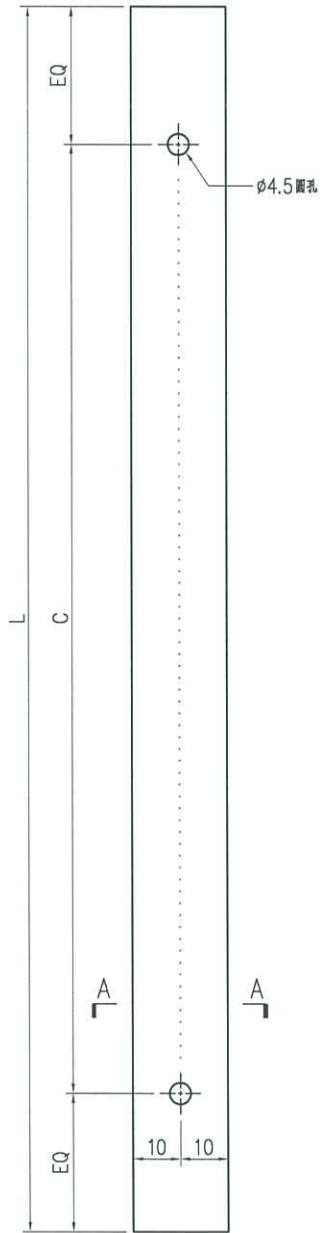

SECTION A-A



### 鋁材開料總表

工程號碼: J858 工程名稱: 康城11期(V0 Louver\_第六批)

序號	鋁料編號	名稱	表面處理		開料長度	實用長料總數量		浪費率(%)
			顏色	層厚		支數	長度	
1	B09056	45X3mm鋁巴	ECD3X10 09 9S-		6000	1	6000	47.33
2	B1502	20x3mm鋁巴	ECD3X10 09 9S-		6000	1	6000	22.87
3	X86248	百叶片	ECD3X10 09 9S-		6100	3	18300	4.42
4	X86249	百叶滴水线	ECD3X10 09 9S-		5500	1	5500	86.85
5	X86251	窗框企料	ECD3X10 09 9S-		5150	1	5150	35.77
6	X86252	窗框頂橫料	ECD3X10 09 9S-		6000	1	6000	87.67
7	X86253	窗框底橫料	ECD3X10 09 9S-		6000	1	6000	87.83

送至: \_\_\_\_\_

由: \_\_\_\_\_

日期: \_\_\_\_\_

簡短說明: \_\_\_\_\_

共8頁 第1頁

打印日期: 2024/7/17 打印時間: 10:17

工程號碼:J858, 工程名稱:康城11期(VO Louver\_第六批)  
開料長度:6000, 總長料支數:1, 總開料支數:1  
鋸片厚度(mm):6, 料頭尾總切除(mm):50, 浪費率(%):87.83

鋁材開料清單 X86253

窗號	編號(用料狀況)	實用長度(長料開數)	需要 支數	開料 支數	長料 支數	餘料 支數	編號(剩餘長度)
X86253-AL-57A	1	674.0	1	1	1	0	1@(5270)x1

工程號碼:J858, 工程名稱:康城11期(VO Louver\_第六批)  
開料長度:6000, 總長料支數:1, 總開料支數:1  
鋸片厚度(mm):6, 料頭尾總切除(mm):50, 浪費率(%):87.67

鋁材開料清單 X86252

窗號	編號(用料狀況)	實用長度(長料開數)	需要支數	開料支數	長料支數	餘料支數	編號(剩餘長度)
X86252-AL-57A	1	684.0	1	1	1	0	1@(5260)x1

工程號碼: J858, 工程名稱: 康城11期(VO Louver\_第六批)  
 開料長度: 5150, 總長料支數: 1, 總開料支數: 2  
 鋸片厚度(mm): 6, 料頭尾總切除(mm): 50, 浪費率(%): 35.77

鋁材開料清單 X86251

窗號	編號(用料狀況)	實用長度(長料開數)	需要支數	開料支數	長料支數	餘料支數	編號(剩餘長度)
X86251-AL-75R, X86251-AL-75L	(餘料)1, 1	1623.0	2	2	1	1	1@(1842)x1 1@(3471)x1

工程號碼:J858, 工程名稱:康城11期(VO Louver\_第六批)  
開料長度:5500, 總長料支數:1, 總開料支數:1  
鋸片厚度(mm):6, 料頭尾總切除(mm):50, 浪費率(%):86.85

鋁材開料清單 X86249

窗號	編號(用料狀況)	實用長度(長料開數)	需要 支數	開料 支數	長料 支數	餘料 支數	編號(剩餘長度)
X86249-AL-57A	1	667.5	1	1	1	0	1@(4776.5)x1

工程號碼:J858, 工程名稱:康城11期(VO Louver\_第六批)  
開料長度:6100, 總長料支數:3, 總開料支數:26  
鋸片厚度(mm):6, 料頭尾總切除(mm):50, 浪費率(%):4.42

鋁材開料清單 X86248

窗號	編號(用料狀況)	實用長度(長料開數)	需要支數	開料支數	長料支數	餘料支數	編號(剩餘長度)
X86248-AL-54A	1-3	661.0	26	26	3	0	1-2@(47)x2 3@(714)x1

工程號碼:J858, 工程名稱:康城11期(VO Louver\_第六批)

開料長度:6000, 總長料支數:1, 總開料支數:4

鋸片厚度(mm):6, 料頭尾總切除(mm):50, 浪費率(%):22.87

鋁材開料清單 B1502

窗號	編號(用料狀況)	實用長度(長料開數)	需要 支數	開料 支數	長料 支數	餘料 支數	編號(剩餘長度)
B1502-AL-59C	1	1608.0	2	2	1	0	1@(2722)x1
B1502-AL-59B	(餘料)1	669.0	2	2	0	1	1@(1372)x1

工程號碼:J858, 工程名稱:康城11期(VO Louver\_第六批)

開料長度:6000, 總長料支數:1, 總開料支數:2

鋸片厚度(mm):6, 料頭尾總切除(mm):50, 浪費率(%):47.33

鋁材開料清單 B09056

窗號	編號(用料狀況)	實用長度(長料開數)	需要 支數	開料 支數	長料 支數	餘料 支數	編號(剩餘長度)
B09056-AL-75R, B09056-AL-75L	(餘料)1, 1	1549.0	2	2	1	1	1@(2840)x1 1@(4395)x1



25 26 27 28 29  
3 4 5 6 7 8 9 10 11 12 13 14 15



4  
5  
6  
7  
8  
9  
**61**  
62  
63  
**60**  
1  
2  
3  
4  
5  
6  
7  
8  
9  
**64**  
65  
66  
67  
**70**  
1



