

## 工程指示 / 要求簡箋(E.I.)

工程指示編號：EI / 8437 / 24

修改版次：-

工程編號：J - 858

工程名稱：將軍澳日出康城

工程項目：趟門 補 1 件玻璃 T2 (29F) BC 梗門 地盤用 (第 3 批)

收件人：Maggie

發件人：Ant Yeung

日期：14/10/2024

□要求提供 / □確認 事項：

- |                                    |                                     |                               |
|------------------------------------|-------------------------------------|-------------------------------|
| <input type="checkbox"/> 初步鋁料 B.M. | <input type="checkbox"/> 加工拆圖，然後生產  | <input type="checkbox"/> 尺寸表  |
| <input type="checkbox"/> 正式鋁料 B.M. | <input type="checkbox"/> 技術上資料 / 指示 | <input type="checkbox"/> 報價   |
| <input type="checkbox"/> 配件 B.M.   | <input type="checkbox"/> 樣辦或貨品說明書   | <input type="checkbox"/> 分判合約 |

內容：

由於玻璃，地盆損壞，需要更換玻璃，請按玻璃 BM 生產玻璃，共 1 件 送地盤。

1. 請安排熱浸
  2. 不要印上熱浸標籤。只給”可移除”的標籤。
  3. 玻璃標籤請註明樓層，座。
  4. 分座打扎
  5. T3 未有回覆有爛玻璃。
  6. 第一批為 PR47254 RFC23697 (18 件)，EI8303 為第二批 (5 件)，本 EI 為第三批 (1 件)
- 謝謝

請在 2024. 10. 30 前完成上列要求。

分發東莞各部門：

- |                                 |                              |                                |                              |                               |                              |                                |                              |
|---------------------------------|------------------------------|--------------------------------|------------------------------|-------------------------------|------------------------------|--------------------------------|------------------------------|
| <input type="checkbox"/> 生產技術總監 | <input type="checkbox"/> 連附件 | <input type="checkbox"/> 技術部   | <input type="checkbox"/> 連附件 | <input type="checkbox"/> 生產部  | <input type="checkbox"/> 連附件 | <input type="checkbox"/> 機械設計部 | <input type="checkbox"/> 連附件 |
| <input type="checkbox"/> 採購部    | <input type="checkbox"/> 連附件 | <input type="checkbox"/> 生產統籌部 | <input type="checkbox"/> 連附件 | <input type="checkbox"/> 小羅&清 | <input type="checkbox"/> 連附件 |                                |                              |
| <input type="checkbox"/> 質檢部    | <input type="checkbox"/> 連附件 | <input type="checkbox"/> 會計部   | <input type="checkbox"/> 連附件 | <input type="checkbox"/> 報關組  | <input type="checkbox"/> 連附件 | <input type="checkbox"/> 其他    | <input type="checkbox"/> 連附件 |

分發香港各部門：

- |   |   |                               |                              |                              |                              |  |   |
|---|---|-------------------------------|------------------------------|------------------------------|------------------------------|--|---|
| <input type="checkbox"/> 行政部            | <input type="checkbox"/> 連附件            | <input type="checkbox"/> 會計部  | <input type="checkbox"/> 連附件 | <input type="checkbox"/> 統籌部 | <input type="checkbox"/> 連附件 | <input checked="" type="checkbox"/> 工程部地盤科文 積哥 | <input checked="" type="checkbox"/> 連附件 |
| <input checked="" type="checkbox"/> 採購部 | <input checked="" type="checkbox"/> 連附件 | <input type="checkbox"/> QS 部 | <input type="checkbox"/> 連附件 | <input type="checkbox"/> 維修部 | <input type="checkbox"/> 連附件 | <input type="checkbox"/> 其他                    | <input type="checkbox"/> 連附件            |

傳遞編號：

HK / 24

發件人簽署：

項目經理簽署：

# J858康城11期 玻璃分层统计表 (T2趟门)

工程: J858康城11期 (T2)

日期: 2024-10-14

## T2 標準層 (29F) BC 梗門 (補)

序号	玻璃编号	玻璃类型	玻璃尺寸			单面积 (m2)	分层数量		备注
			W(mm)	x	H(mm)		本次訂購數量	66F	
10	GL01-62	GL01	985	x	2525	2.49	1		送地盘
1	GL01	10mm Low E(58T) clear heat strengthened glass +12A +12mm clear tempered glass(inside							

本次訂購面積

2.5



194.

T2 29/F BC 門

 美特鋁質有限公司 MIDI Aluminium Fabricator Ltd.				工程號	J858	類別		物料號	-	
修改	-	-	-	地盤	康城11期	制圖	W. E. X	2022-05-12	圖號	J858-GL01
日期	-	-	-	採用工廠	✓	地盤	-		數量	-
				材料顏色	-	圖紙名稱	玻璃加工圖		單件重量	- (KG)
				材料	-	復核	-			
						批准	-			




ELEVATION (VIEWED FROM OUTSIDE)

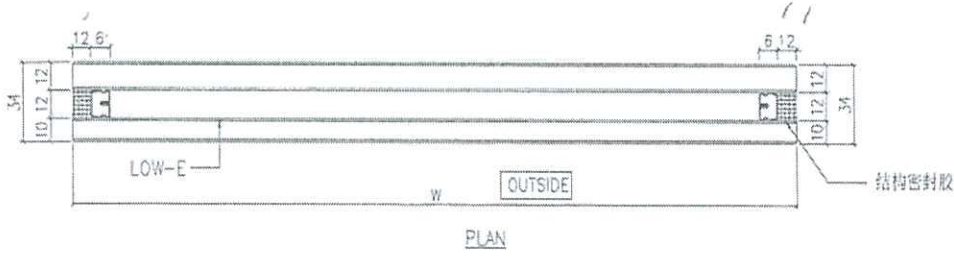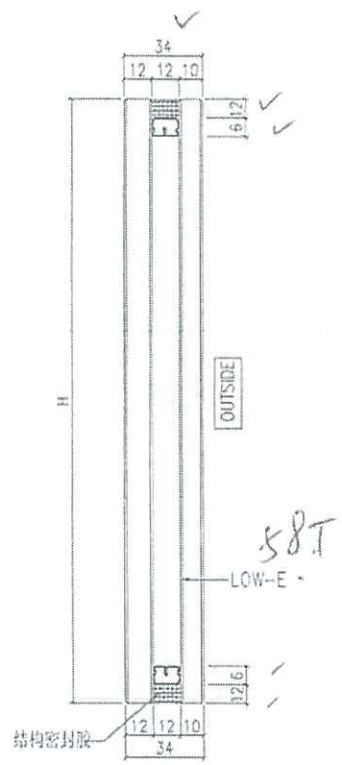

生产厂编号: R20220114001

- NOTES
1. ALL DIMENSION IN mm
  2. ALL EDGE CHAMFER 1x1x45°

G1

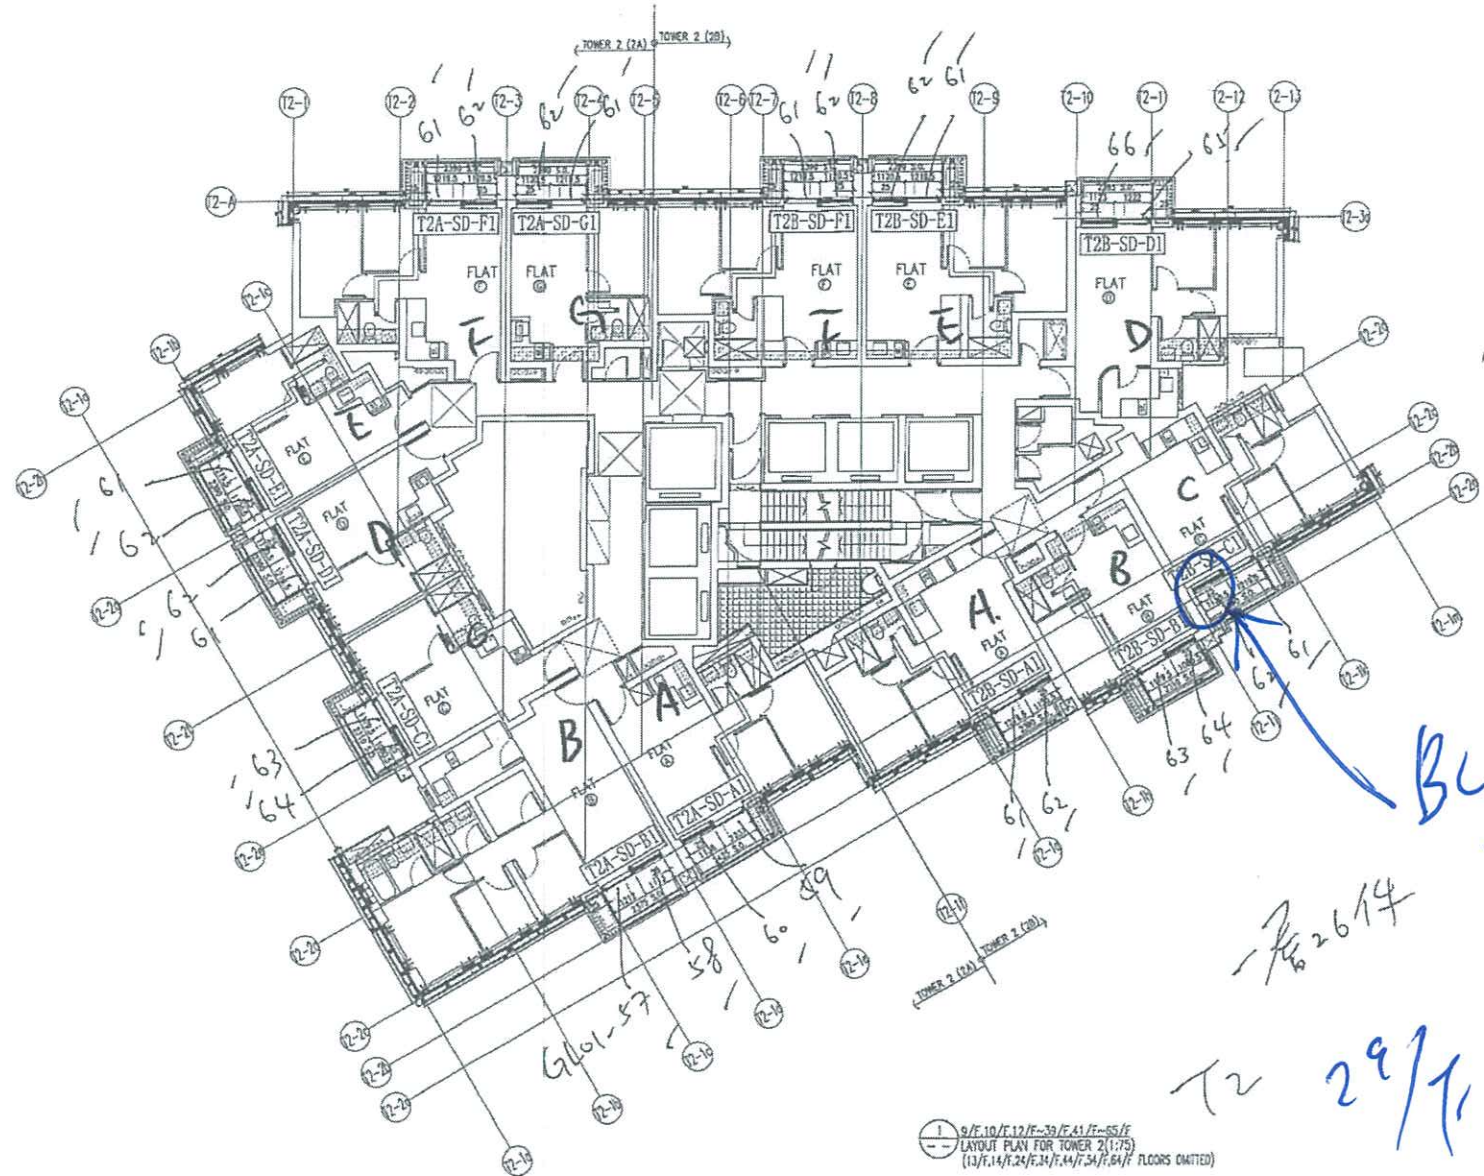

1/9/F, 10/F, 12/F, 13/F, 14/F, 65/F, 66/F FLOORS OMITTED

BU 樓門  
 26/4  
 T2 29/1


B.D. REF :			
CLIENT : Sino Land Company Limited			
ARCHITECT : Ronald Lu & Partners Ronald Lu & Partners (HK) Ltd. 呂元祥建築師事務所 (香港) 有限公司			
MAIN CONTRACTOR : Gammon			
STRUCTURAL ENGINEER : AECOM			
FACADE CONSULTANT: AECOM			
NOTE : 1. ALL DIMENSIONS ARE IN mm. 2. ALL ELEVATIONS ARE VIEWED FROM OUTSIDE. 3. ALL DIMENSIONS TO BE VERIFIED ON SITE BEFORE FABRICATION.			
LEGEND : (A) DETAIL MARK NO. (REF) REFER SHEET NO. 1. F.F.L. --- FINISHED FLOOR LEVEL 2. S.F.L. --- STRUCTURAL FLOOR LEVEL 3. (R) --- REVERSED DETAIL			
NO	DATE	REVISED	BY
JOB NO : J-858			
PROJECT : PROPOSED RESIDENTIAL DEVELOPMENT AT TROT, 70RD, PHASE 11, LOHAS PARK TSEUNG KWAN O, N.T.			
TITLE : TYPICAL SLIDING DOOR PLAN AT TOWER 2			
DATE : 14-Jun-22	SCALE : 1:80(A1)		
DRAWN BY : KY	CHECKED BY : YB		
MIDI ALLIUM GROUP PAPERBOND LTD. Units 6-8, Sunny Industrial Centre, 1/F 110 Che Kwo Ling Road, Tseung Kwan O Tel: 23488211-4 Fax: (852) 27772866			
DWG NO. : J858-CN-S2-P201		REV. : -	

控制

T2

29/F

BC

玻璃厂名称:	 广东海控特种玻璃技术有限公司
工程名称:	日出康城11期
规格:	985*2525
玻璃编号:	GL01-62
玻璃款式:	10mmSTB1-58T半钢化#2+12A+12mm白钢化
位置:	M03/EI6343/T2越门/31F, 投诉单
生产单号:	R20231220048 1
室内/外表标示:	室内面及钢化


W 985 x 2525 H

EI6343

GL01-62

引爆炉号: FY-JZ-195  
 入炉日期: 2023年12月28日



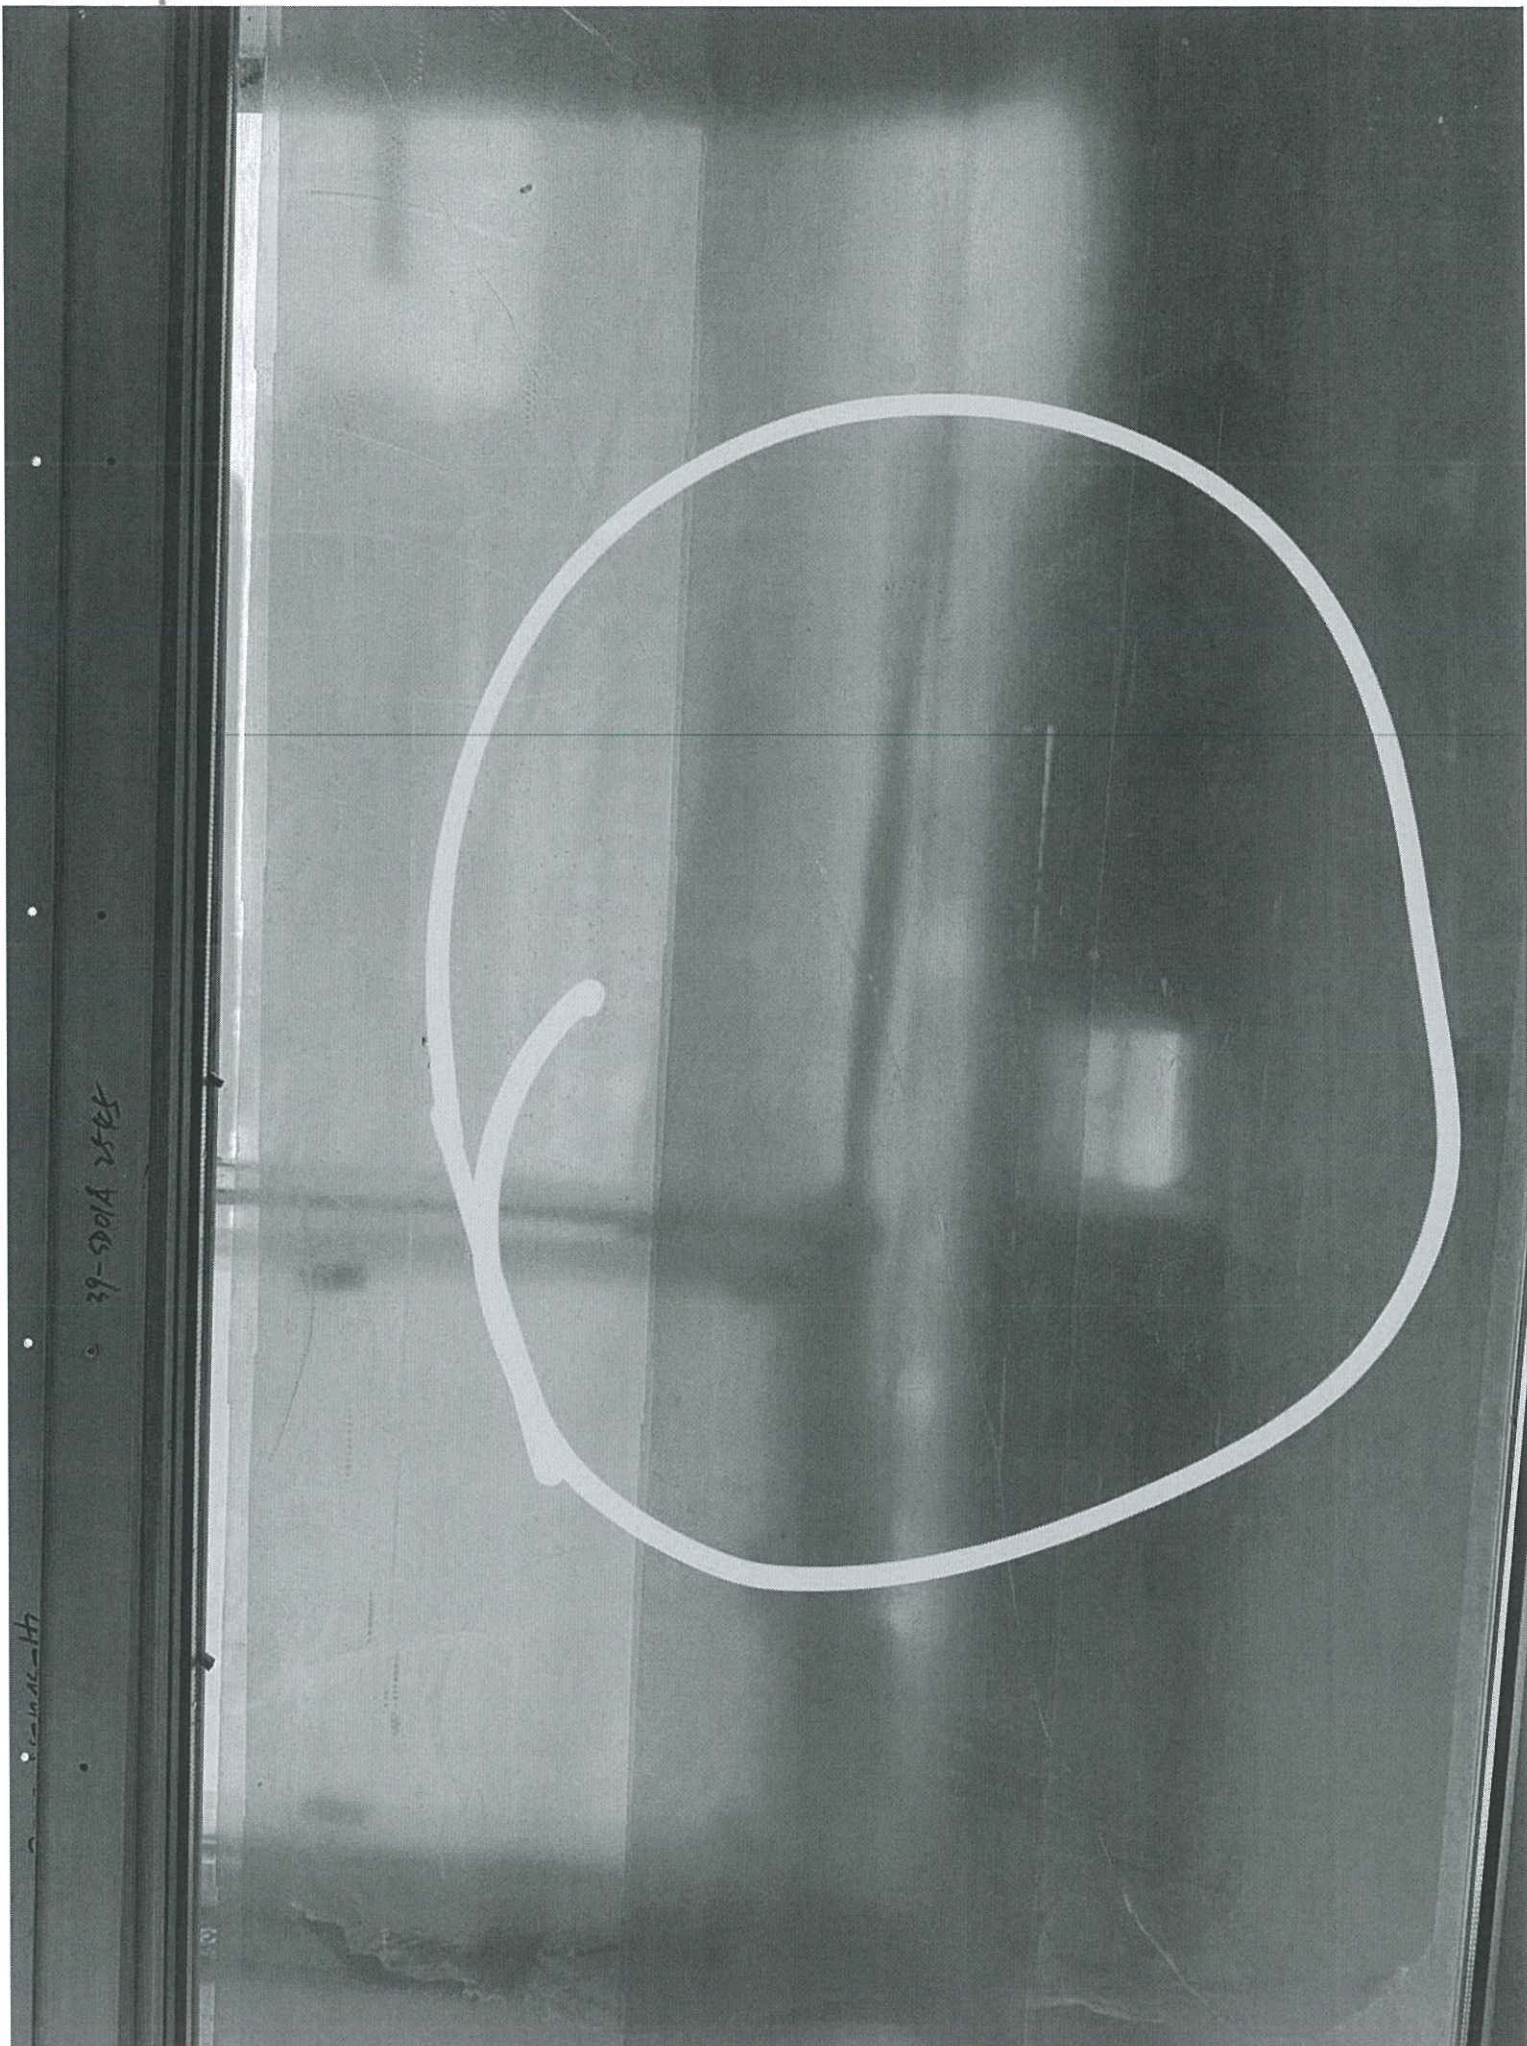

39-501A 2545

47-11-11

39-501A-17

39-501A 25-26



39-501A 2548



44-2101-117

39-501A 2548

41-2101-11



玻璃厂名称:



广东海控特种玻璃技术有限公司

工程名称:

日出康城11期

规格:

985\*2525

玻璃编号:

GL01-62

玻璃款式:

10mm STB1-58T 半钢化H2+12A+12mm 白玻钢化

位置:

M03/EI6343/T2趟门/31F, 投诉单

生产单号:

R20231220048

室内/外表标示:

室内面及钢化

引爆炉号: FY-JZ-195

入炉日期: 2023年12月28日

HEAT SOAK  
TESTED

