

工程指示 / 要求簡箋(E.I.)

工程指示編號：EI / 8760 / 25      修改版次：-  
 工程編號      : J - 858                      工程名稱      : 將軍澳日出康城  
 工程項目      : 趙門 補 3 件玻璃 T3 地盤執修用 (第 5 批)  
 收件人         : Maggie                      發件人         : Ant Yeung                      日期 : 12/02/2025

要求提供 /  確認 事項 :

- |                                    |                                     |                               |
|------------------------------------|-------------------------------------|-------------------------------|
| <input type="checkbox"/> 初步鋁料 B.M. | <input type="checkbox"/> 加工拆圖，然後生產  | <input type="checkbox"/> 尺寸表  |
| <input type="checkbox"/> 正式鋁料 B.M. | <input type="checkbox"/> 技術上資料 / 指示 | <input type="checkbox"/> 報價   |
| <input type="checkbox"/> 配件 B.M.   | <input type="checkbox"/> 樣辦或貨品說明書   | <input type="checkbox"/> 分判合約 |

內容 :

由於玻璃，地盆損壞，需要更換玻璃，請按玻璃 BM 生產玻璃，共 3 件 送地盤。

1. 請安排熱浸
2. 不要印上熱浸標籤。只給”可移除”的標籤。
3. 玻璃標籤請註明樓層，座。
4. 分座打扎
5. T3 有爛玻璃。
6. 第一批為 PR47254 RFC23697 (18 件)，第二批為 EI8303 (5 件)，  
第三批為 EI8437 (1 件)，第四批為 EI 8571 A (4+1 件)，第五批為 本 EI (3 件)

謝謝

請在 2025. 03. 21 前完成上列要求。

分發東莞各部門 :

- |                                 |                              |                                |                              |                               |                              |                                   |                              |
|---------------------------------|------------------------------|--------------------------------|------------------------------|-------------------------------|------------------------------|-----------------------------------|------------------------------|
| <input type="checkbox"/> 生產技術總監 | <input type="checkbox"/> 連附件 | <input type="checkbox"/> 技術部   | <input type="checkbox"/> 連附件 | <input type="checkbox"/> 生產部  | <input type="checkbox"/> 連附件 | <input type="checkbox"/> 機械設計部    | <input type="checkbox"/> 連附件 |
| <input type="checkbox"/> 採購部    | <input type="checkbox"/> 連附件 | <input type="checkbox"/> 生產統籌部 | <input type="checkbox"/> 連附件 | <input type="checkbox"/> 小羅&清 | <input type="checkbox"/> 連附件 |                                   |                              |
| <input type="checkbox"/> 質檢部    | <input type="checkbox"/> 連附件 | <input type="checkbox"/> 會計部   | <input type="checkbox"/> 連附件 | <input type="checkbox"/> 報關組  | <input type="checkbox"/> 連附件 | <input type="checkbox"/> 其他 _____ | <input type="checkbox"/> 連附件 |

分發香港各部門 :

- |   |   |                               |                              |                              |                              |   |   |
|---|---|-------------------------------|------------------------------|------------------------------|------------------------------|---|---|
| <input type="checkbox"/> 行政部            | <input type="checkbox"/> 連附件            | <input type="checkbox"/> 會計部  | <input type="checkbox"/> 連附件 | <input type="checkbox"/> 統籌部 | <input type="checkbox"/> 連附件 | <input checked="" type="checkbox"/> 工程部地盤科文 <u>二寶</u> | <input checked="" type="checkbox"/> 連附件 |
| <input checked="" type="checkbox"/> 採購部 | <input checked="" type="checkbox"/> 連附件 | <input type="checkbox"/> QS 部 | <input type="checkbox"/> 連附件 | <input type="checkbox"/> 維修部 | <input type="checkbox"/> 連附件 | <input type="checkbox"/> 其他 _____                     | <input type="checkbox"/> 連附件            |

傳遞編號 :

HK / 25

發件人簽署 : 


項目經理簽署 : 

序號	EI	項目	座	樓層	單位	件數	玻璃編號	W (mm)	H (mm)	厚度(mm)	Letter
		趟門 / 窗	PR47254_RFC23697	18件已更換							
11	本訂單補	趟門	T3	48/F	AA	1	GL01-59	1035	x 2374	10mm Low E(58T) clear heat strengthened glass +12A +12mm clear tempered glass(inside) (R20220114001)	
12	本訂單補	趟門	T3	26/F	AE	1	GL01-61	1017	x 2374	10mm Low E(58T) clear heat strengthened glass +12A +12mm clear tempered glass(inside) (R20220114001)	
13	本訂單補	趟門	T3	26/F	AF	1	GL01-61	1017	x 2374	10mm Low E(58T) clear heat strengthened glass +12A +12mm clear tempered glass(inside) (R20220114001)	
	GL01	=	10mm THK. HEAT STRENGTHEN GLASS (OUTSIDE) W/ LOW-E COATING ON SURFACE 58T #2 + 12 mm AIR SPACE + 12mm THK. CLEAR TEMPERED GLASS(INSIDE) 1GU (R20220114001)								

共3件

26/F RE  
#12

26/F AT  
#13

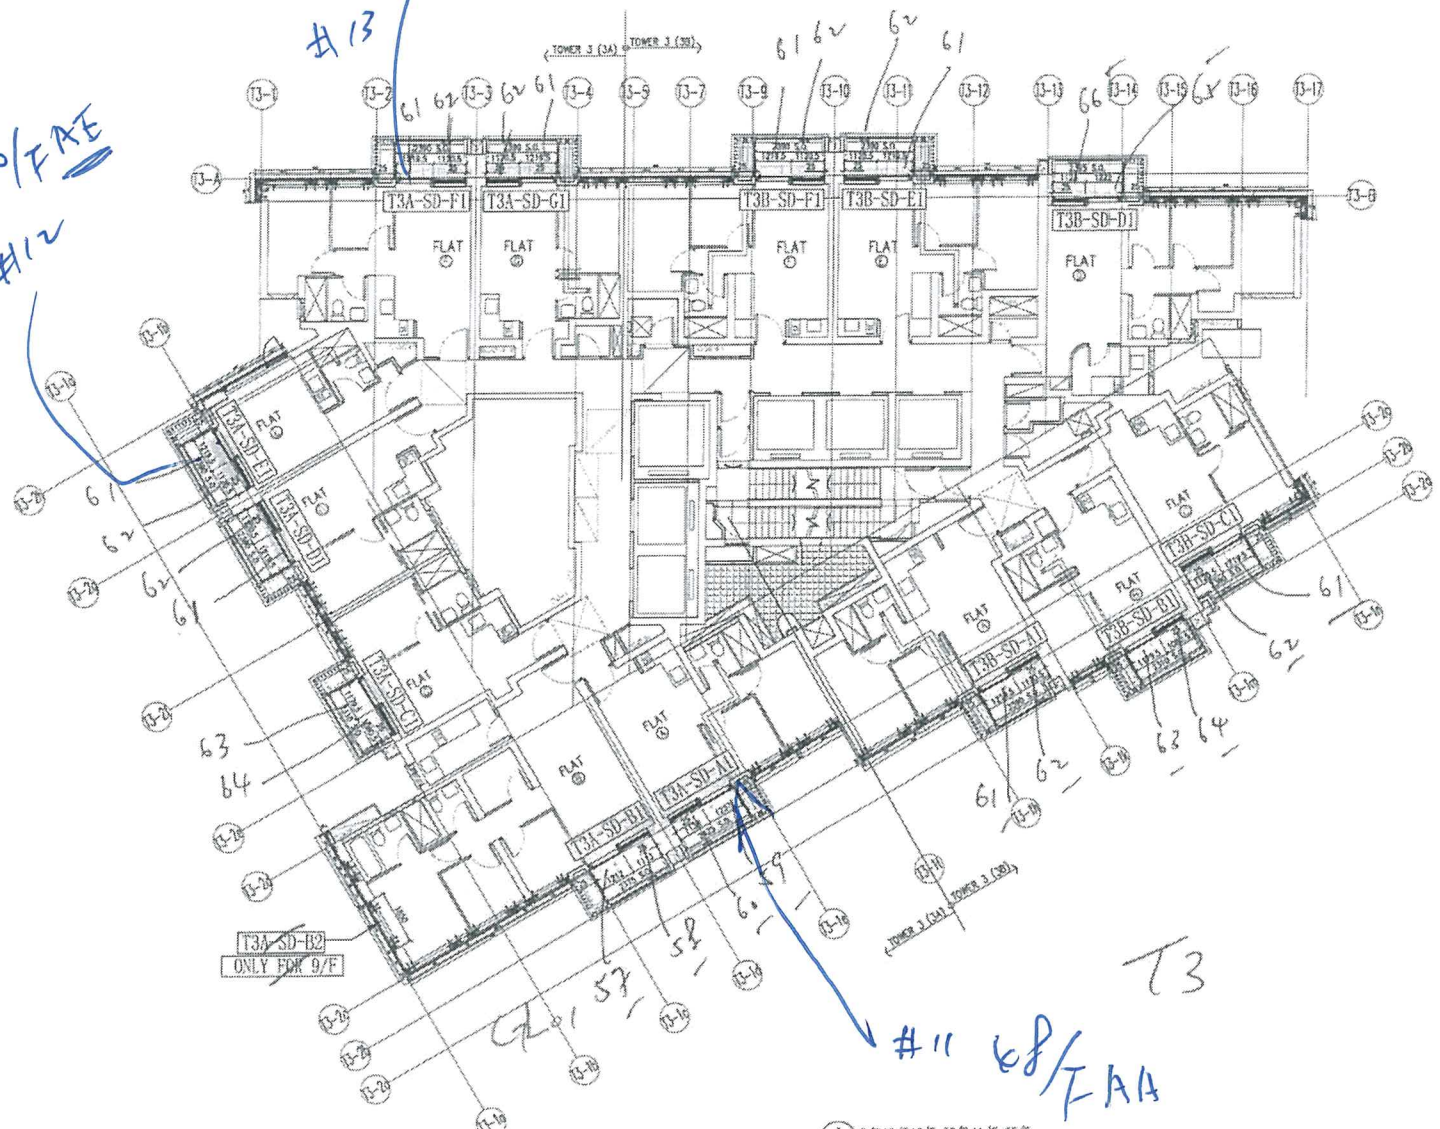

① 9/F, 10/F, 12/F, 13/F, 14/F, 44/F, 45/F FLOORS OMITTED

B.D. REF.:	
CLIENT Sino Land Company Limited	
ARCHITECT ronald lu & partners Ronald Lu & Partners (HK) Ltd.	
STRUCTURAL ENGINEER Gammon	
STRUCTURAL CONSULTANT AECOM	
MECHANICAL CONSULTANT AECOM	
NOTES: 1. ALL DIMENSIONS ARE IN MM. 2. ALL ELEVATIONS ARE VERIFIED FROM OUTSIDE. 3. ALL DIMENSIONS TO BE VERIFIED ON SITE BEFORE FABRICATION.	
LEGEND: ① - DETAIL MARK NO. ② - REFER SHEET NO.	
1. P.F.L. - FINISHED FLOOR LEVEL 2. S.F.L. - STRUCTURAL FLOOR LEVEL 3. Ⓞ - REVERSED DETAIL	
NO.	NOV 22
JOB NO.	J-858
PROJECT PROPOSED RESIDENTIAL DEVELOPMENT AT TKOHL ZONE, PHASE 11, LOHAS PARK TSEUNG KWAN O, N.T.	
TITLE TYPICAL SLIDING DOOR PLAN AT TOWER 3	
DATE	14-JUN-22
SCALE	1:80(4)
DRAWN BY	KY
CHECKED BY	YS
MIDI 美特鋁質有限公司 MEMBERSHIP CORPORATION LTD. Units 6-8, Sunny Industrial Centre, 1/F 610 Che Kwo Ling Road, Kowloon Tel: 23489217-4 Fax: (852) 27272666	
DWG NO.	J058-CN-SD-P351
REV.	