

工程指示 / 要求簡箋(E.I.)

工程指示編號：EI / 8784/25

修改版次： -

工程編號： J - 858

工程名稱：將軍澳日出康城 11

工程項目：幕牆 室內收口鋁料 地盤用 (補 T3) T3AF, BD

收件人：生統

發件人：Ant Yeung

日期：20/02/2025

要求提供 / 確認 事項：

內容：

因地盆表示：T3 需補收口料(標準層)，因安裝工差 T3AF, BD

轉向位。

原 EI 6389：X86457。

請工廠查有無餘料????

請工廠生產供地盆使用

1. 生統，請按此最後版本圖紙生產。
2. 阿二寶收貨。
3. 註明 T3 用
4. 地盆：留意廠內餘料，倉存已不多。
5. 如有多，請保留用作執更換料。。

請在 2025.2.28 前完成上列要求。

分發東莞各部門：

()生產技術總監 連附件 (✓)技術部 連附件 ()生產部 連附件 ()機械設計部 連附件
 ()採購部 連附件 (✓)生產統籌部 連附件 (✓)小羅&清 連附件
 ()質檢部 連附件 ()會計部 連附件 ()報關組 連附件 ()其他 _____ 連附件

分發香港各部門：

()行政部 連附件 ()會計部 連附件 ()統籌部 連附件 (✓)工程部地盤科文 連附件 二寶
 ()採購部 連附件 ()QS 部 連附件 ()維修部 連附件 ()其他 _____ 連附件

傳遞編號：

HK 0150 / 25


發件人簽署：

項目經理簽署：



美特鋁質有限公司
MIDI Aluminium Fabricator Ltd.

修改		採用工廠	地盤	✓	工程號	J858	類別		物料號	-	
日期		材料顏色	ECD3X1009 9S-XF1		地盤	康城11期	制圖	J.L.	2023-16-17	圖號	X86457-03
					圖紙名稱	幕牆陣底收口	復核	-	-	數量	-
					材料	X86457	批准	-	-	單件重量	- (KG)

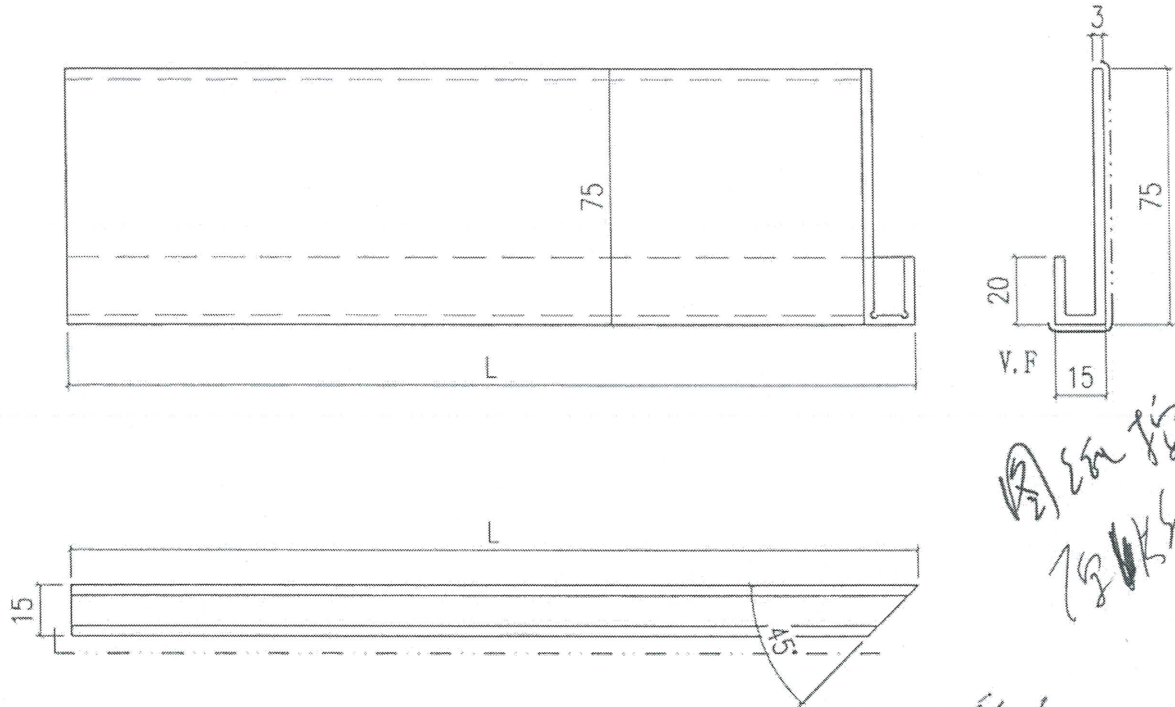

圖紙指
改尺寸

幕牆轉台

物料編號

T3BD
x 86457-03-03



X86457-03-04	1568.5	44
X86457-03-03	1660	22
X86457-03-02	537.5	280
X86457-03-01	1679	48
編號	L	合計數量

L = 1665mm

20支

降底 8.5

 美特鋁質有限公司 MIDI Aluminium Fabricator Ltd.				工程號	J858	類別		物料號	-
修改		採用工廠	地盤	✓	地盤	康城11期	制圖	J.L.	2023-16-17
日期		材料顏色	ECD3X1009 9S-XF1		圖紙名稱	幕牆陣底收口	復核	-	-
					材料	X86457	批准	-	-
								圖號	X86457-02
								數量	-
								單件重量	- (KG)

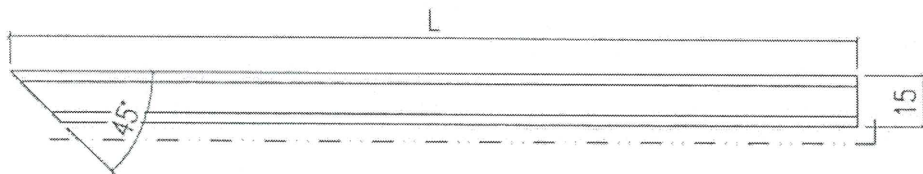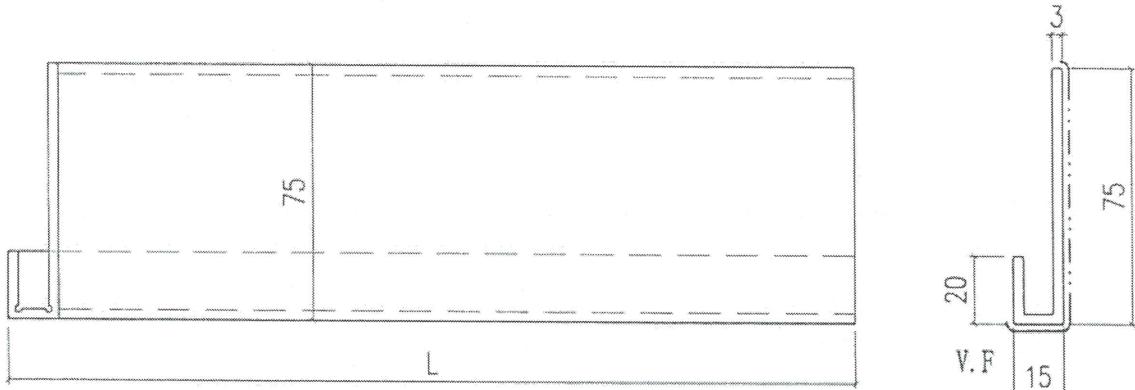

圖紙指
厚板

轉角位

幕牆陣底

物料編號

73AF.

x ~~86457~~ 86457-02-01


X86457-02-04	1703.5	48
X86457-02-03	643.5	44
X86457-02-02	537.5	140
X86457-02-01	1679	232
編號	L	合計數量

20支

L = 1684 mm

陣底

p.4

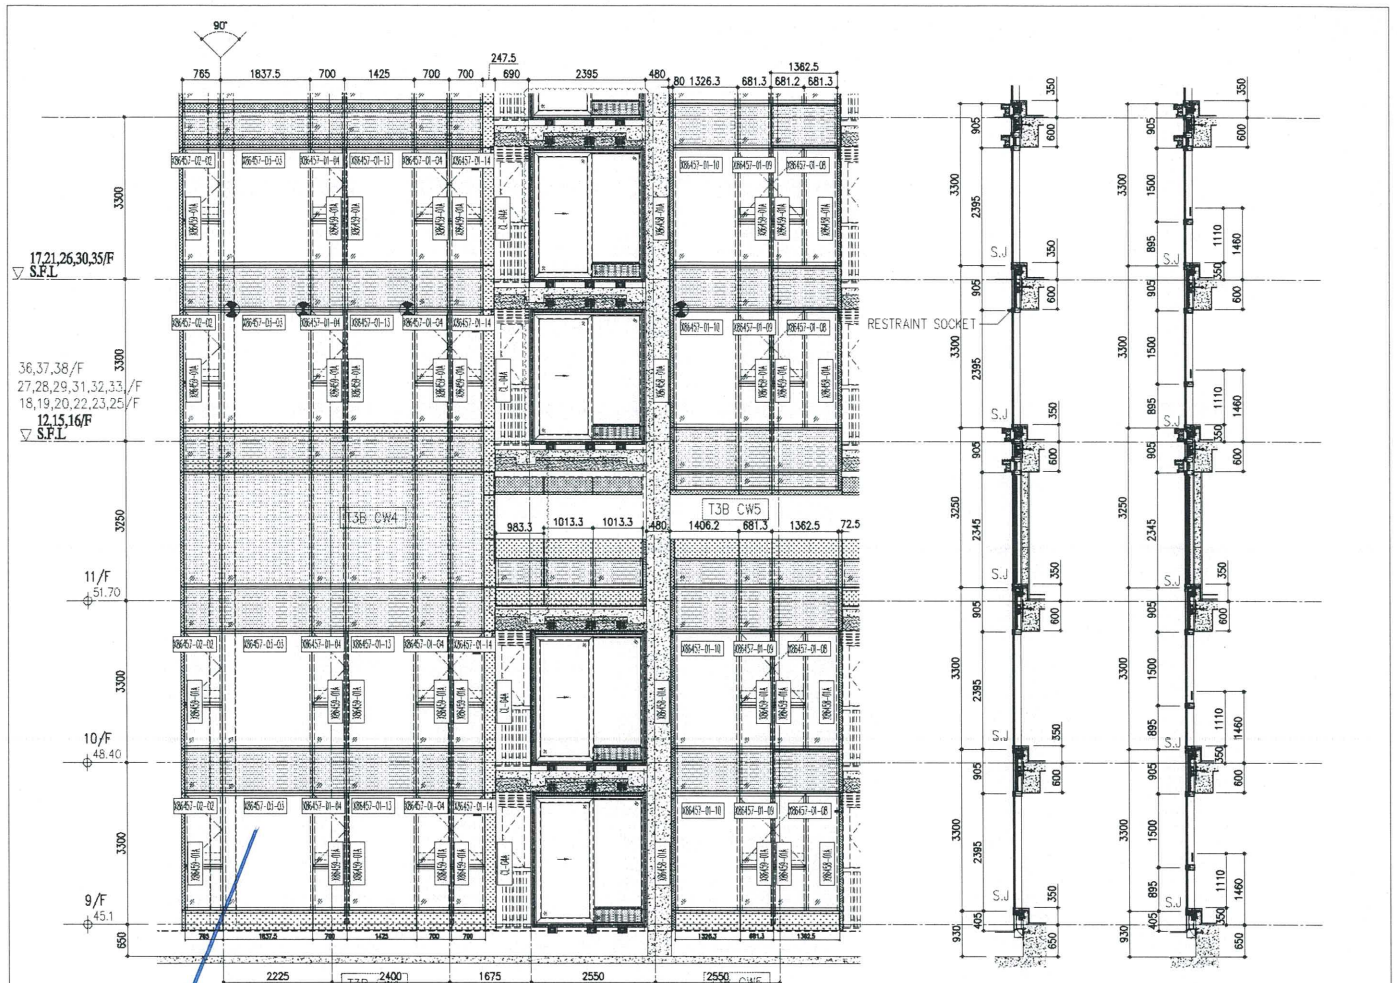

x86457-03-03


1 PART ELEVATION FOR CURTAIN WALL

2 SECTION


3 SECTION

R/F	+217.00
67/F	+213.50
66/F	+210.00
65/F	+206.70
63/F	+203.40
62/F	+200.10
61/F	+196.80
60/F	+193.50
59/F	+190.20
58/F	+186.90
57/F	+183.60
56/F	+180.30
55/F	+177.00
53/F	+173.70
52/F	+170.40
51/F	+167.10
50/F	+163.80
49/F	+160.50
48/F	+157.20
47/F	+153.90
46/F	+150.60
45/F	+147.30
44/F	+144.00
43/F	+140.70
42/F	+137.40
41/F	+134.10
40/F	+130.80
39/F	+127.50
38/F	+124.20
37/F	+120.90
36/F	+117.60
35/F	+114.30
34/F	+111.00
32/F	+107.70
31/F	+104.40
30/F	+101.10
29/F	+97.80
28/F	+94.50
27/F	+91.20
26/F	+87.90
25/F	+84.60
23/F	+81.30
22/F	+78.00
21/F	+74.70
20/F	+71.40
19/F	+68.10
18/F	+64.80
17/F	+61.50
16/F	+58.20
15/F	+54.90

- LEGEND:
- 10mm THK. HEAT STRENGTHENED GLASS (OUTSIDE) +12mm AIR SPACE + 12mm THK. TEMPERED GLASS
 - 10mm THK. HEAT STRENGTHENED GLASS (OUTSIDE) +12mm AIR SPACE + 10mm THK. TEMPERED GLASS
 - 12mm THK. HEAT STRENGTHENED GLASS
 - 12mm THK. CLEAR TEMPERED GLASS (INTERNAL PROTECTIVE BARRIER)
 - 10mm THK. HEAT STRENGTHENED GLASS (OUTSIDE) +12mm AIR SPACE + 12mm THK. TEMPERED GLASS WITH REFLECTIVE COATING
 - 10mm THK. CLEAR TEMPERED GLASS
 - 8mm THK. CLEAR HEAT-STRENGTHENED GLASS + 52mm PVB + 8mm THK. CLEAR HEAT-STRENGTHENED GLASS
 - 3 mm THK. ALUM. CLADDING
 - 3 mm THK. ALUM. BACKPAN
 - STACK JOINT
 - RESTRAINT SOCKET

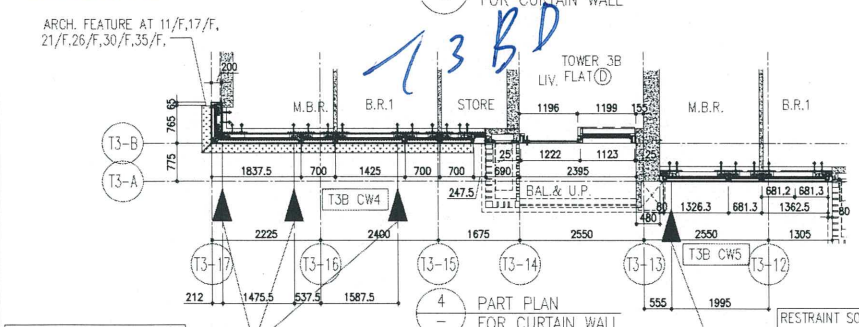

4 PART PLAN FOR CURTAIN WALL

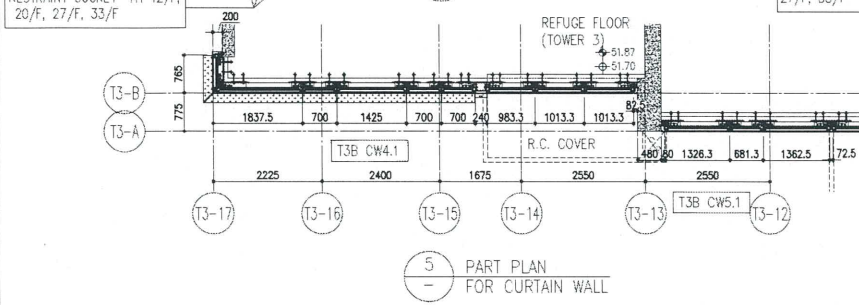

5 PART PLAN FOR CURTAIN WALL

PROJECT: PROPOSED RESIDENTIAL DEVELOPMENT AT TOWER 30PH, PHASE 11, LOMA'S PARK, TSEUNG KWAN O, N.T.

DATE: 22-OCT-21 **SCALE:** 1:50(A1)

DRAWN BY: [Signature]

CHECKED BY: [Signature]

PROJECT ENGINEER: [Signature]

STRUCTURAL ENGINEER: [Signature]

ARCHITECT: [Signature]

CLIENT: [Signature]

REVISIONS:

NO.	DESCRIPTION
1	REVISION AS PER COMMENTS
2	REVISION AS PER COMMENTS
3	REVISION AS PER COMMENTS
NOTES:

- ALL DIMENSIONS ARE IN MM.
- ALL ELEVATIONS ARE DIMED FROM OUTSIDE.
- ALL DIMENSIONS TO BE CHECKED ON SITE BEFORE FABRICATION.


LEGEND:

- DETAIL MARK NO.
- REVISION SHEET NO.
- FINISHED FLOOR LEVEL
- STRUCTURAL FLOOR LEVEL
- REVISION DETAIL

COMPANIES:

- AECOM** (Facade Consultant)
- Gammou** (Structural Engineer)
- coroplast** (Architect)
- SHO LOMA COMPANY LIMITED** (Client)

DRG NO.: JB59-CW-PC507 **REV.:** G

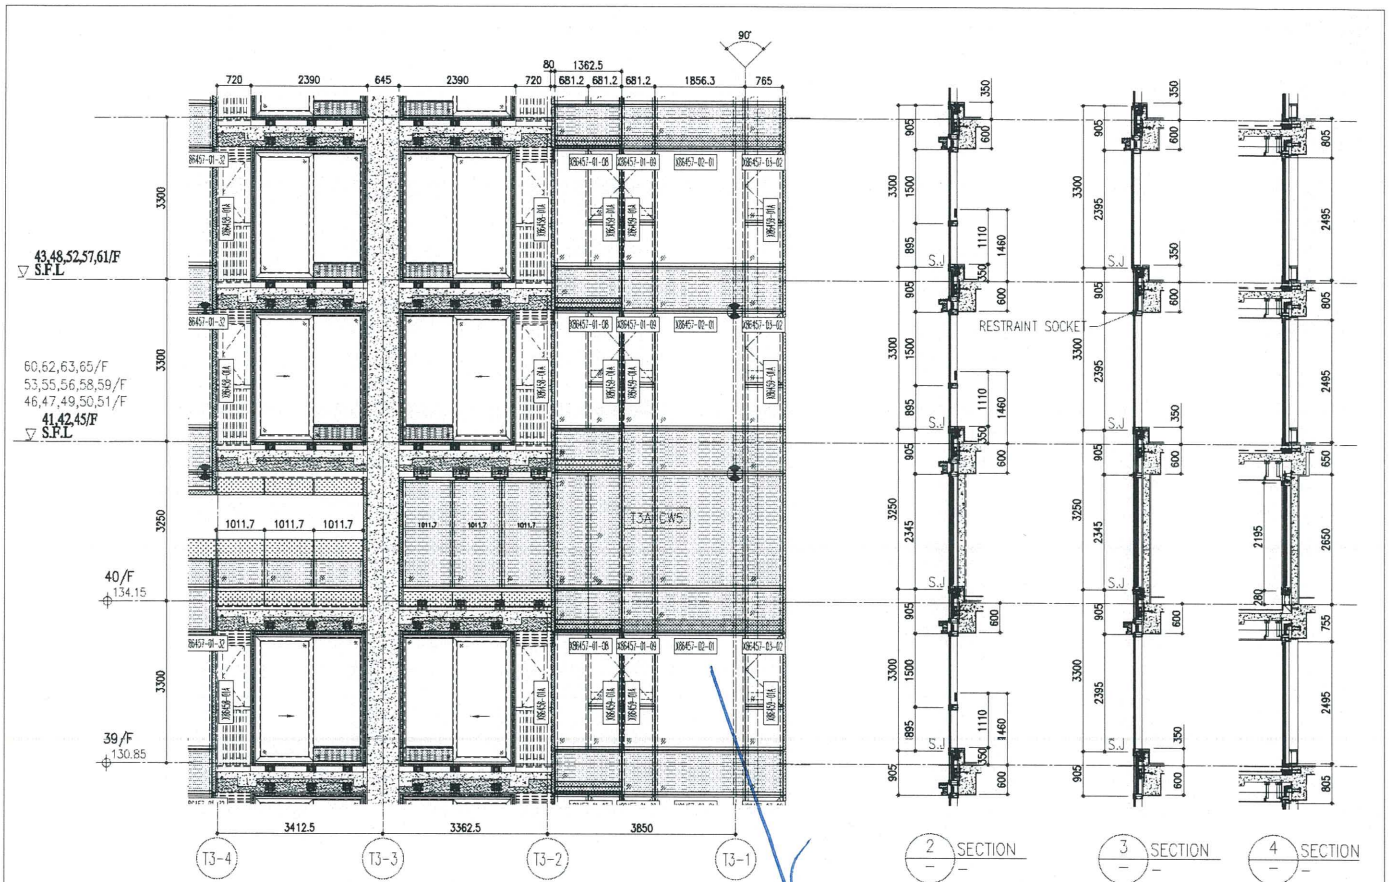


1 PART ELEVATION FOR CURTAIN WALL


2 SECTION
3 SECTION
4 SECTION

x 86457-02-01

T3 AF

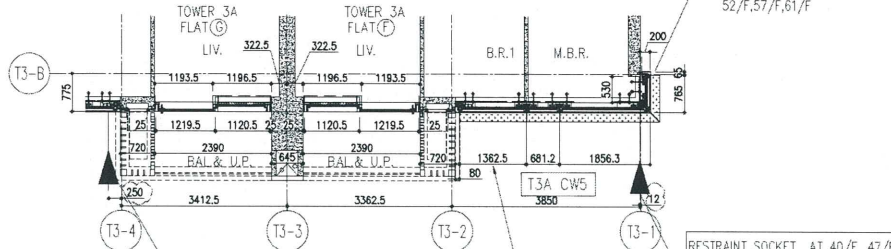

5 PART PLAN FOR CURTAIN WALL

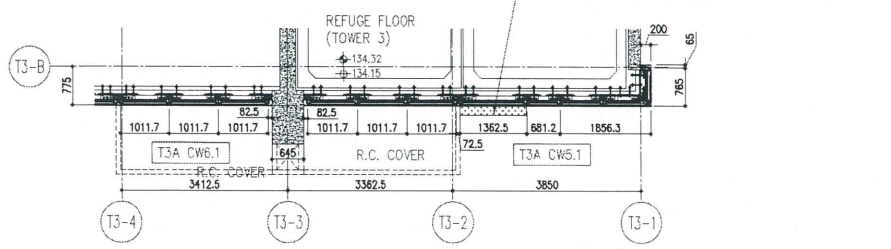

6 PART PLAN FOR CURTAIN WALL

R/F	+217.00	R/F	+213.50
26/F	+91.25	39/F	+130.85
25/F	+87.95	38/F	+127.55
23/F	+84.65	37/F	+124.25
22/F	+81.35	36/F	+120.95
21/F	+78.05	35/F	+117.65
20/F	+74.75	33/F	+114.35
19/F	+71.45	32/F	+111.05
18/F	+68.15	31/F	+107.75
17/F	+64.85	30/F	+104.45
16/F	+61.55	29/F	+101.15
15/F	+58.25	28/F	+97.85
12/F	+54.95	27/F	+94.55
		40/F	+134.15
		52/F	+170.40
		51/F	+167.10
		63/F	+203.40
		49/F	+160.50
		62/F	+200.10
		48/F	+157.20
		61/F	+196.80
		60/F	+193.50
		59/F	+190.20
		58/F	+186.90
		57/F	+183.60
		56/F	+180.30
		55/F	+177.00
		53/F	+173.70

- LEGEND:
- ① 10mm THK. HEAT STRENGTHENED GLASS (OUTSIDE) +12mm AIR SPACE + 12mm THK. TEMPERED GLASS
 - ② 10mm THK. HEAT STRENGTHENED GLASS (OUTSIDE) +12mm AIR SPACE + 10mm THK. TEMPERED GLASS
 - ③ 12mm THK. HEAT STRENGTHENED GLASS
 - ④ 12mm THK. CLEAR TEMPERED GLASS (INTERNAL PROTECTIVE BARRIER)
 - ⑤ 10mm THK. HEAT STRENGTHENED GLASS (OUTSIDE) +12mm AIR SPACE + 12mm THK. TEMPERED GLASS WITH REFLECTIVE COATING
 - ⑥ 10mm THK. CLEAR TEMPERED GLASS
 - ⑦ 8mm THK. CLEAR HEAT-STRENGTHENED GLASS + 52mm PVB + 8mm THK. CLEAR HEAT-STRENGTHENED GLASS
 - ⑧ 3 mm THK. ALUM. CLADDING
 - ⑨ 3 mm THK. ALUM. BACKPAN
 - S.J. - STACK JOINT
 - RS - RESTRAINT SOCKET

<p>DATE: 22-07-21 SCALE: 1:50(A1)</p> <p>DRAWN BY: [Signature]</p> <p>CHECKED BY: [Signature]</p> <p>PROJECT: PROPOSED RESIDENTIAL DEVELOPMENT AT HONG KONG TRADE TOWER PARK (23/000 KWAN YU, N.Y.)</p> <p>TITLE: TYPICAL FLOOR PARTIAL ELEVATION & SECTION, PLAN FOR CURTAIN WALL (TOWER 3)</p>	<p>JOB NO.: J-858</p> <p>PROJECT: PROPOSED RESIDENTIAL DEVELOPMENT AT HONG KONG TRADE TOWER PARK (23/000 KWAN YU, N.Y.)</p>	<p>NO. 1. ALL DIMENSIONS ARE IN MM.</p> <p>2. ALL ELEVATIONS ARE SHOWN FROM OUTSIDE.</p> <p>3. BEFORE FABRICATION.</p> <p>LEGEND:</p> <p>(X1) - DETAIL WORK NO.</p> <p>(X2) - REFER SHEET NO.</p> <p>1. F.F.L. - FINISHED FLOOR LEVEL</p> <p>2. S.F.L. - STRUCTURAL FLOOR LEVEL</p> <p>3. (79) - REVERSED DETAIL</p>	<p>ARCHITECT: Ronald Lu & Partners (HK) Ltd. 羅國龍建築師事務所 (香港) 有限公司</p> <p>STRUCTURAL ENGINEER: Gammon</p> <p>FACEBOOK CONSULTANT: AECOM</p> <p>CLIENT: 怡和置業有限公司 Sino Land Company Limited</p>	<p>BLD. REF: [Blank]</p>
--	---	--	---	--------------------------