

工程指示 / 要求簡箋(E.I.)

工程指示編號：EI / 8952 / 25 修改版次： B  
 工程編號： J - 858 工程名稱：將軍澳日出康城  
 工程項目：幕牆 第 2 次 補玻璃 35 件 (小業主單)  
 收件人：Maggie 發件人：Jason 日期：29/05/2025

要求提供 / 確認 事項：

- |                                    |                                     |                               |
|------------------------------------|-------------------------------------|-------------------------------|
| <input type="checkbox"/> 初步鋁料 B.M. | <input type="checkbox"/> 加工拆圖，然後生產  | <input type="checkbox"/> 尺寸表  |
| <input type="checkbox"/> 正式鋁料 B.M. | <input type="checkbox"/> 技術上資料 / 指示 | <input type="checkbox"/> 報價   |
| <input type="checkbox"/> 配件 B.M.   | <input type="checkbox"/> 樣辦或貨品說明書   | <input type="checkbox"/> 分判合約 |

內容：

**B 版: 增加至 35 件**  
**序號 114 & 119 修改玻璃厚度**

**A 版: 增加至 31 件**

由於地盤需要更換玻璃，請按玻璃 BM 生產玻璃，共 35 件 送地盤。  
請安排熱浸

1. 不要印上熱浸標籤。只給”可移除”的標籤。
2. 依原 EI 4867, EI 4943, EI 4942 尺寸補，
3. \*\*\*\*\*分座包箱，玻璃標籤請註明樓層、單位。\*\*\*\*\* 請留意。
4. 第一次補 25 件 EI8938; 第 2 次補 35 件本次;
5. 地盆：更換幕牆玻璃，需用吊船。
6. 按芳姐 二寶 資料

**謝謝**

請在 **2025. 06. 30** 前完成上列要求。

分發東莞各部門：

- |                                 |                              |                                |                              |                               |                              |                                |                              |
|---------------------------------|------------------------------|--------------------------------|------------------------------|-------------------------------|------------------------------|--------------------------------|------------------------------|
| <input type="checkbox"/> 生產技術總監 | <input type="checkbox"/> 連附件 | <input type="checkbox"/> 技術部   | <input type="checkbox"/> 連附件 | <input type="checkbox"/> 生產部  | <input type="checkbox"/> 連附件 | <input type="checkbox"/> 機械設計部 | <input type="checkbox"/> 連附件 |
| <input type="checkbox"/> 採購部    | <input type="checkbox"/> 連附件 | <input type="checkbox"/> 生產統籌部 | <input type="checkbox"/> 連附件 | <input type="checkbox"/> 小羅&清 | <input type="checkbox"/> 連附件 |                                |                              |
| <input type="checkbox"/> 質檢部    | <input type="checkbox"/> 連附件 | <input type="checkbox"/> 會計部   | <input type="checkbox"/> 連附件 | <input type="checkbox"/> 報關組  | <input type="checkbox"/> 連附件 | <input type="checkbox"/> 其他    | <input type="checkbox"/> 連附件 |

分發香港各部門：

- |   |   |                               |                              |                              |                              |  |   |
|---|---|-------------------------------|------------------------------|------------------------------|------------------------------|--|---|
| <input type="checkbox"/> 行政部            | <input type="checkbox"/> 連附件            | <input type="checkbox"/> 會計部  | <input type="checkbox"/> 連附件 | <input type="checkbox"/> 統籌部 | <input type="checkbox"/> 連附件 | <input checked="" type="checkbox"/> 工程部地盤科文 二寶 | <input checked="" type="checkbox"/> 連附件 |
| <input checked="" type="checkbox"/> 採購部 | <input checked="" type="checkbox"/> 連附件 | <input type="checkbox"/> QS 部 | <input type="checkbox"/> 連附件 | <input type="checkbox"/> 維修部 | <input type="checkbox"/> 連附件 | <input type="checkbox"/> 其他                    | <input type="checkbox"/> 連附件            |

傳遞編號：

HK / 25

發件人簽署：

項目經理簽署：

序號	EI	項目	樓層	單位	柱數	玻璃編號	W (mm)	H (mm)	厚度 (mm)	Letter
90	本次E	CW	T3	37/F	AF	GL01-14	644	2332	Shows THE BEAT STRENGTHENERS GLASS (FRESHEN W/ LOBE COATING ON SURFACE CLEAR TEMPERED GLASS) (ET-1000) (TEMPERED GLASS) (ET-1000) (1000)	
91	本次E	CW	T1	41/F	AE	GL01-54	713	2332	Shows THE BEAT STRENGTHENERS GLASS (FRESHEN W/ LOBE COATING ON SURFACE CLEAR TEMPERED GLASS) (ET-1000) (TEMPERED GLASS) (ET-1000) (1000)	
92	本次E	CW	T1	35/F	AB	GL01-06	903	2332	Shows THE BEAT STRENGTHENERS GLASS (FRESHEN W/ LOBE COATING ON SURFACE CLEAR TEMPERED GLASS) (ET-1000) (TEMPERED GLASS) (ET-1000) (1000)	
93	本次E	CW	T1	16/F	AB	GL02-03	663	1443	Shows THE BEAT STRENGTHENERS GLASS (FRESHEN W/ LOBE COATING ON SURFACE CLEAR TEMPERED GLASS) (ET-1000) (TEMPERED GLASS) (ET-1000) (1000)	
94	本次E	CW	T1	41/F	BD	GL01-23	1388	2332	Shows THE BEAT STRENGTHENERS GLASS (FRESHEN W/ LOBE COATING ON SURFACE CLEAR TEMPERED GLASS) (ET-1000) (TEMPERED GLASS) (ET-1000) (1000)	
95	本次E		T1	27/F	BB	GL02-07	585	1443	Shows THE BEAT STRENGTHENERS GLASS (FRESHEN W/ LOBE COATING ON SURFACE CLEAR TEMPERED GLASS) (ET-1000) (TEMPERED GLASS) (ET-1000) (1000)	
96	本次E	CW	T1	36/F	BB	GL02-07	585	1443	Shows THE BEAT STRENGTHENERS GLASS (FRESHEN W/ LOBE COATING ON SURFACE CLEAR TEMPERED GLASS) (ET-1000) (TEMPERED GLASS) (ET-1000) (1000)	
97	本次E	CW	T1	43/F	BD	GL01-24	1751	2332	Shows THE BEAT STRENGTHENERS GLASS (FRESHEN W/ LOBE COATING ON SURFACE CLEAR TEMPERED GLASS) (ET-1000) (TEMPERED GLASS) (ET-1000) (1000)	
98	本次E	CW	T1	43/F	BD	GL02-08	655.5	1443	Shows THE BEAT STRENGTHENERS GLASS (FRESHEN W/ LOBE COATING ON SURFACE CLEAR TEMPERED GLASS) (ET-1000) (TEMPERED GLASS) (ET-1000) (1000)	
99	本次E	CW	T1	35/F	AD	GL01-02	663	832	Shows THE BEAT STRENGTHENERS GLASS (FRESHEN W/ LOBE COATING ON SURFACE CLEAR TEMPERED GLASS) (ET-1000) (TEMPERED GLASS) (ET-1000) (1000)	
100	本次E	CW	T1	33/F	AD	GL02-03	663	1443	Shows THE BEAT STRENGTHENERS GLASS (FRESHEN W/ LOBE COATING ON SURFACE CLEAR TEMPERED GLASS) (ET-1000) (TEMPERED GLASS) (ET-1000) (1000)	
101	本次E	CW	T1	32/F	BD	GL01-02	663	832	Shows THE BEAT STRENGTHENERS GLASS (FRESHEN W/ LOBE COATING ON SURFACE CLEAR TEMPERED GLASS) (ET-1000) (TEMPERED GLASS) (ET-1000) (1000)	
102	氣泡	CW	T1	22/F	BC	GL01-03	644	832	Shows THE BEAT STRENGTHENERS GLASS (FRESHEN W/ LOBE COATING ON SURFACE CLEAR TEMPERED GLASS) (ET-1000) (TEMPERED GLASS) (ET-1000) (1000)	
103	本次E	CW	T1	20/F	AE	GL02-05	636	1443	Shows THE BEAT STRENGTHENERS GLASS (FRESHEN W/ LOBE COATING ON SURFACE CLEAR TEMPERED GLASS) (ET-1000) (TEMPERED GLASS) (ET-1000) (1000)	
104	本次E	CW	T1	39/F	AG	GL02-05	636	1443	Shows THE BEAT STRENGTHENERS GLASS (FRESHEN W/ LOBE COATING ON SURFACE CLEAR TEMPERED GLASS) (ET-1000) (TEMPERED GLASS) (ET-1000) (1000)	
105	本次E	CW	T1	17/F	AF	GL02-05	636	1443	Shows THE BEAT STRENGTHENERS GLASS (FRESHEN W/ LOBE COATING ON SURFACE CLEAR TEMPERED GLASS) (ET-1000) (TEMPERED GLASS) (ET-1000) (1000)	
106	本次E	CW	T1	20/F	AC	GL01-14	644	2332	Shows THE BEAT STRENGTHENERS GLASS (FRESHEN W/ LOBE COATING ON SURFACE CLEAR TEMPERED GLASS) (ET-1000) (TEMPERED GLASS) (ET-1000) (1000)	
107	本次E	CW	T1	20/F	AC	GL02-05	636	1443	Shows THE BEAT STRENGTHENERS GLASS (FRESHEN W/ LOBE COATING ON SURFACE CLEAR TEMPERED GLASS) (ET-1000) (TEMPERED GLASS) (ET-1000) (1000)	
108	本次E	CW	T1	18/F	AG	GL01-03	644	832	Shows THE BEAT STRENGTHENERS GLASS (FRESHEN W/ LOBE COATING ON SURFACE CLEAR TEMPERED GLASS) (ET-1000) (TEMPERED GLASS) (ET-1000) (1000)	
109	本次E	CW	T1	16/F	AE	GL01-03	644	832	Shows THE BEAT STRENGTHENERS GLASS (FRESHEN W/ LOBE COATING ON SURFACE CLEAR TEMPERED GLASS) (ET-1000) (TEMPERED GLASS) (ET-1000) (1000)	
110	本次E	CW	T1	12/F	BA	GL02-05	636	1443	Shows THE BEAT STRENGTHENERS GLASS (FRESHEN W/ LOBE COATING ON SURFACE CLEAR TEMPERED GLASS) (ET-1000) (TEMPERED GLASS) (ET-1000) (1000)	
111	本次E	CW	T1	30/F	BE	GL02-07	585	1443	Shows THE BEAT STRENGTHENERS GLASS (FRESHEN W/ LOBE COATING ON SURFACE CLEAR TEMPERED GLASS) (ET-1000) (TEMPERED GLASS) (ET-1000) (1000)	
112	本次E	CW	T1	29/F	BE	GL02-07	585	1443	Shows THE BEAT STRENGTHENERS GLASS (FRESHEN W/ LOBE COATING ON SURFACE CLEAR TEMPERED GLASS) (ET-1000) (TEMPERED GLASS) (ET-1000) (1000)	
113	本次E	CW	T1	29/F	BE	GL01-04	585	832	Shows THE BEAT STRENGTHENERS GLASS (FRESHEN W/ LOBE COATING ON SURFACE CLEAR TEMPERED GLASS) (ET-1000) (TEMPERED GLASS) (ET-1000) (1000)	
114	B層次	CW	T1	51/F	AA	GL01-03	644	832	Shows THE BEAT STRENGTHENERS GLASS (FRESHEN W/ LOBE COATING ON SURFACE CLEAR TEMPERED GLASS) (ET-1000) (TEMPERED GLASS) (ET-1000) (1000)	
115	氣泡	CW	T1	32/F	AE	GL02-05	636	1443	Shows THE BEAT STRENGTHENERS GLASS (FRESHEN W/ LOBE COATING ON SURFACE CLEAR TEMPERED GLASS) (ET-1000) (TEMPERED GLASS) (ET-1000) (1000)	
116	本次E	CW	T1	33/F	AB	GL01-08	1793	2332	Shows THE BEAT STRENGTHENERS GLASS (FRESHEN W/ LOBE COATING ON SURFACE CLEAR TEMPERED GLASS) (ET-1000) (TEMPERED GLASS) (ET-1000) (1000)	
117	本次E	CW	T1	33/F	AB	GL02-01	628	1443	Shows THE BEAT STRENGTHENERS GLASS (FRESHEN W/ LOBE COATING ON SURFACE CLEAR TEMPERED GLASS) (ET-1000) (TEMPERED GLASS) (ET-1000) (1000)	
118	本次E	CW	T1	36/F	BD	GL02-08	655.5	1443	Shows THE BEAT STRENGTHENERS GLASS (FRESHEN W/ LOBE COATING ON SURFACE CLEAR TEMPERED GLASS) (ET-1000) (TEMPERED GLASS) (ET-1000) (1000)	
119	B層次	CW	T1	57/F	AD	GL01-03	644	832	Shows THE BEAT STRENGTHENERS GLASS (FRESHEN W/ LOBE COATING ON SURFACE CLEAR TEMPERED GLASS) (ET-1000) (TEMPERED GLASS) (ET-1000) (1000)	

序號	E1	項目	座	樓層	單位	作數	玻璃編號	W (mm)	H (mm)	厚度 (mm)	Letter
B版次	E18952B	CW	T1	10/F	AA	1	GL01-14	644	2332	10mm THK. HEAT STRENGTHEN GLASS (OUTSIDE) W/ LOW-E COATING ON SURFACE #2 + 12mm THK. CLEAR TEMPERED GLASS (INSIDE) IGU (R2020114001)	
B版次	E18952B	CW	T1	39/F	BB	1	GL02-07	585	1443	10mm THK. HEAT STRENGTHEN GLASS (OUTSIDE) W/ LOW-E COATING ON SURFACE #2 + 12mm THK. CLEAR TEMPERED GLASS (INSIDE) IGU (R2020114003)	
B版次	E18952B	CW	T1	56/F	AD	1	GL01-02	663	832	10mm THK. HEAT STRENGTHEN GLASS (OUTSIDE) W/ LOW-E COATING ON SURFACE #2 + 12mm THK. CLEAR TEMPERED GLASS (INSIDE) IGU (R2020114003)	
B版次	E18952B	CW	T1	42/F	BC	1	GL01-05	678.5	832	10mm THK. HEAT STRENGTHEN GLASS (OUTSIDE) W/ LOW-E COATING ON SURFACE #2 + 12mm THK. CLEAR TEMPERED GLASS (INSIDE) IGU (R2020114003)	
					補玻璃總數		35				
	GL01	=								10mm THK. HEAT STRENGTHEN GLASS (OUTSIDE) W/ LOW-E COATING ON SURFACE #2 + 12mm THK. CLEAR TEMPERED GLASS (INSIDE) IGU (R2020114001)	
	GL02	=								10mm THK. HEAT STRENGTHEN GLASS (OUTSIDE) W/ LOW-E COATING ON SURFACE #2 + 12mm THK. CLEAR TEMPERED GLASS (INSIDE) IGU (R2020114003)	
	GL03	=								12mm THK. HEAT STRENGTHEN GLASS (REFLECTIVE GLASS SSC1-60T) (R202020324054)	




PROJECT: 康城11期凱柏峰

項目: 鋁窗, 鋁門及幕牆玻璃的驗收表格

TOWER: 1A

樓層: 10 VIP 單位: A

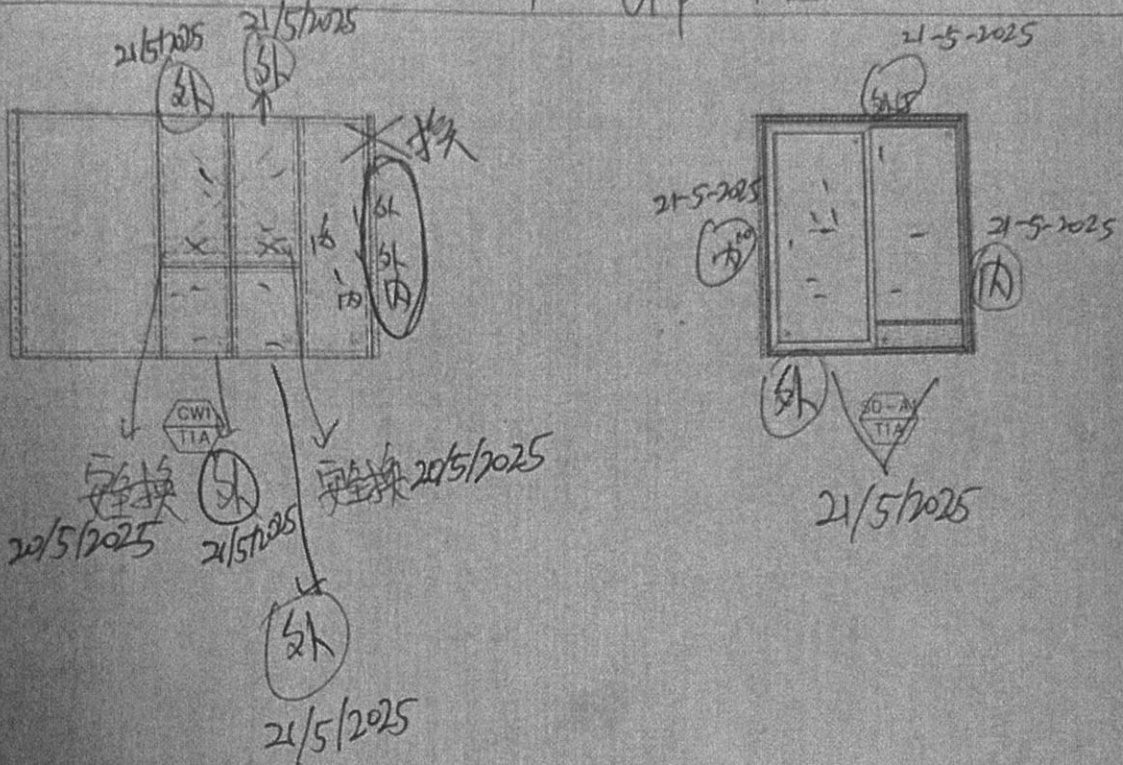

聯檢代表	公司	姓名	簽名	日期
	MIDI	盧國深	✓	16-5-2025
	OSR			




PROJECT: 康城11期凱柏峰

項目: 鋁窗, 鋁門及幕牆玻璃的驗收表格

TOWER: 1B

樓層: 42

單位: C

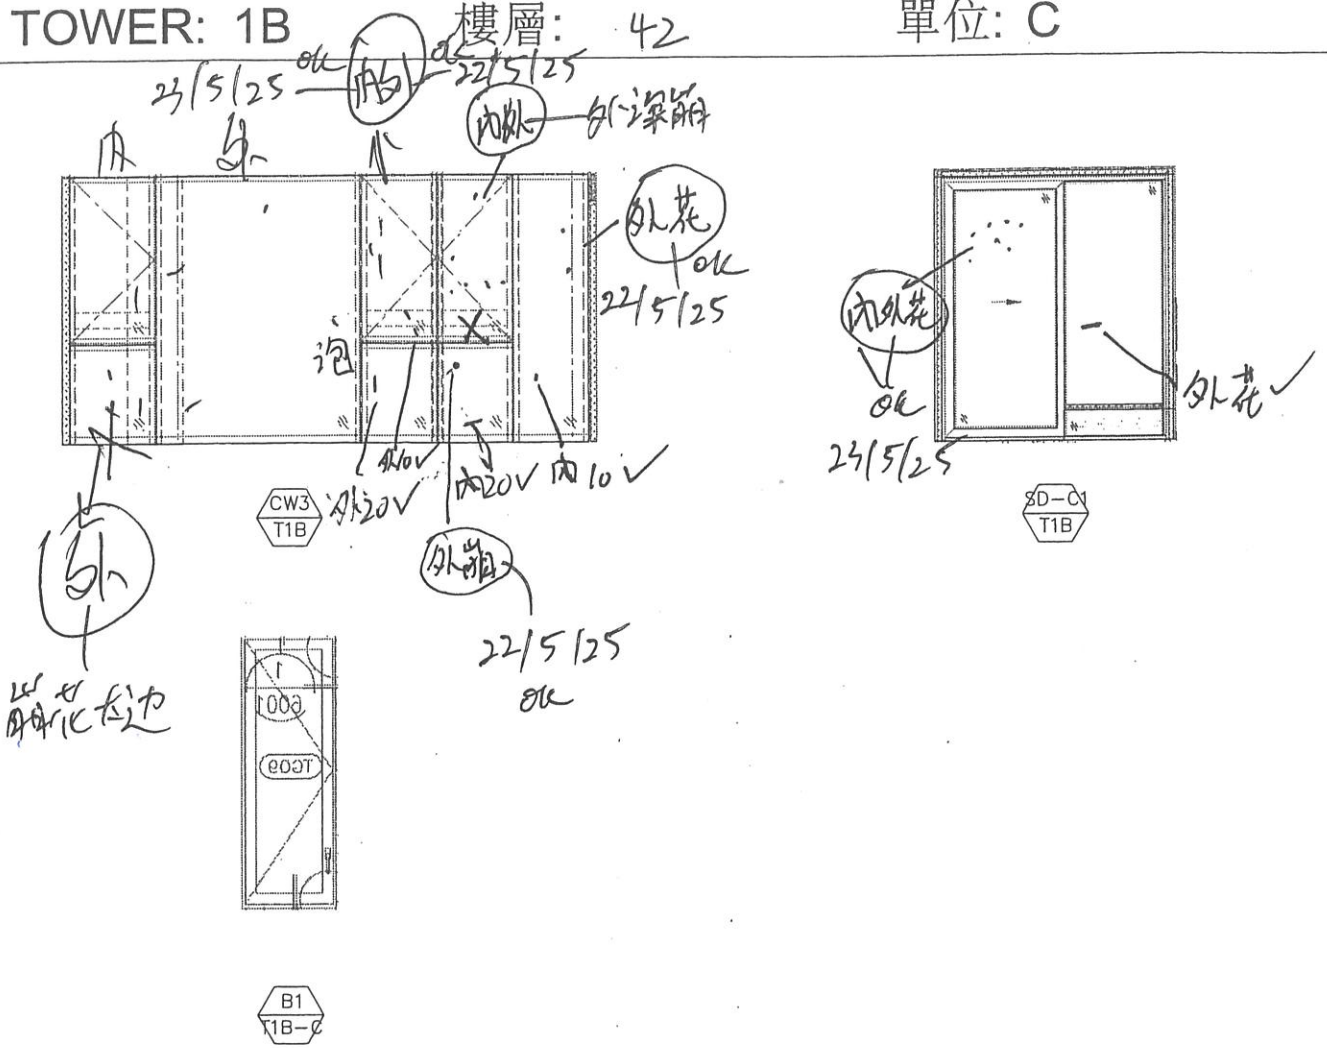

聯檢代表	公司	姓名	簽名	日期
	MIDI	盧國深	⚡	2025-5-20
	OSR			



PROJECT: 康城11期凱柏峰

項目: 鋁窗, 鋁門及幕牆玻璃的驗收表格

TOWER: 1B

樓層: 39

單位: B

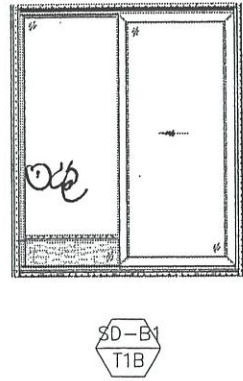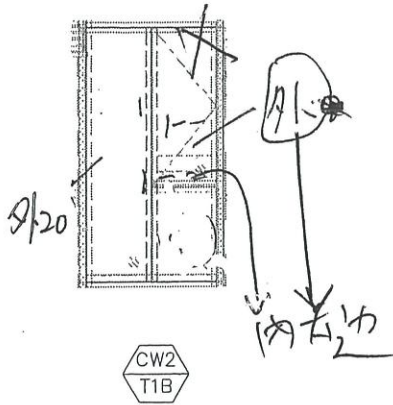

聯檢代表	公司	姓名	簽名	日期
	MIDI	盧國深	☞	22-5-2025
	OSR			





PROJECT: 康城11期凱柏峰

項目: 鋁窗, 鋁門及幕牆玻璃的驗收表格

TOWER: 1A 樓層: 56 VIP. 單位: D

23/5/25 <sup>ok</sup>  23-5-25

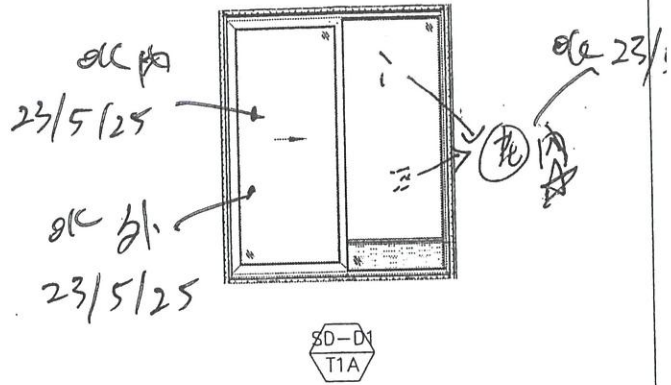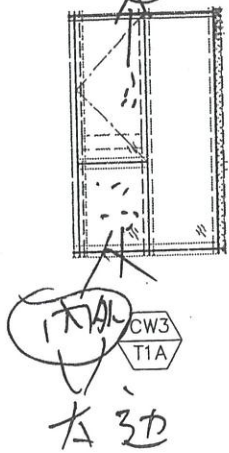

聯檢代表	公司	姓名	簽名	日期
	MIDI	盧國深	↳	2025-5-21
	OSR			