工程指示 / 要求簡箋(E.I.)

工程指示編號：EI / 9150 / 25

修改版次：A

工程編號：J - 858

工程名稱：將軍澳日出康城 11

工程項目：T1 62AA BA T3 67AA 鋁板牆收口後加鋁板 2 件

收件人：生統

發件人：Jason Leung

日期：21/10/2025

□要求提供 / □確認 事項：

- | | | |
|---------------|----------------|----------|
| () 初步鋁料 B.M. | () 加工拆圖，然後生產 | () 尺寸表 |
| () 正式鋁料 B.M. | () 技術上資料 / 指示 | () 報價 |
| () 配件 B.M. | () 樣辦或貨品說明書 | () 分判合約 |
- 內容：

A 版次：T3 67AA BA 鋁板牆收口後加鋁板 1 件 (AQ-107.1)

請按 T1 62AA BA 鋁板牆收口後加鋁板 1 件 (AQ-107.1)由於加快送地盤，鋁板廠不用噴塗，由地盤現場噴，需打磨後出貨請在 2025.11.13 前完成上列要求。

附：頁

□ 原合約工程包

□ 原合約工程加 / 減賬

□ 新工程報價

分發東莞各部門：

- | | | | | | |
|--------------------|-----------|---|---|--------------|---|
| () 生產技術總監 □ 連附件 | (✓) 技術部 | <input checked="" type="checkbox"/> 連附件 | () 生產部 | □ 連附件 | () 機械設計部 □ 連附件 |
| () 採購部 | □ 連附件 | (✓) 生產統籌部 | <input checked="" type="checkbox"/> 連附件 | (✓) 小羅 & 清 | <input checked="" type="checkbox"/> 連附件 |
| () 質檢部 | □ 連附件 | () 會計部 | □ 連附件 | () 報關組 | □ 連附件 |
| () 其他 _____ □ 連附件 | | | | | |

分發香港各部門：


- | | | | | |
|---------------|---------------|---------------|---------------|--------------------|
| () 行政部 □ 連附件 | () 會計部 □ 連附件 | () 統籌部 □ 連附件 | () 工程部地盤科文 | □ 連附件 |
| () 採購部 □ 連附件 | () QS 部 | □ 連附件 | () 維修部 □ 連附件 | () 其他 _____ □ 連附件 |

傳遞編號：

HK 0815 / 25

發件人簽署：

項目經理簽署：

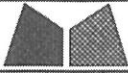



美特鋁質有限公司
MIDI Aluminium Fabricator Ltd.

工程號	J858	類別		物料號	-		
地盘	康城11期	制圖	J.L.	2023-08-01	圖號	AQ-107.1	
修改 A	採用工廠	图纸名称	铝板加工图	復核	-	數量	-
日期 05/10	材料颜色 香槟金 (E03X10099S-JF2)	材料	3.0mm 铝板	批准	-	單件重量	- (KG)


數量:2
T1 62/F 1件
T3 67/F 1件

编号	L	N
AQ-107.1A	597.5	250

762.5

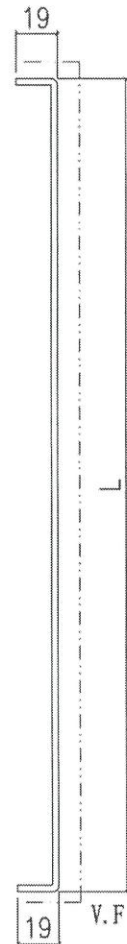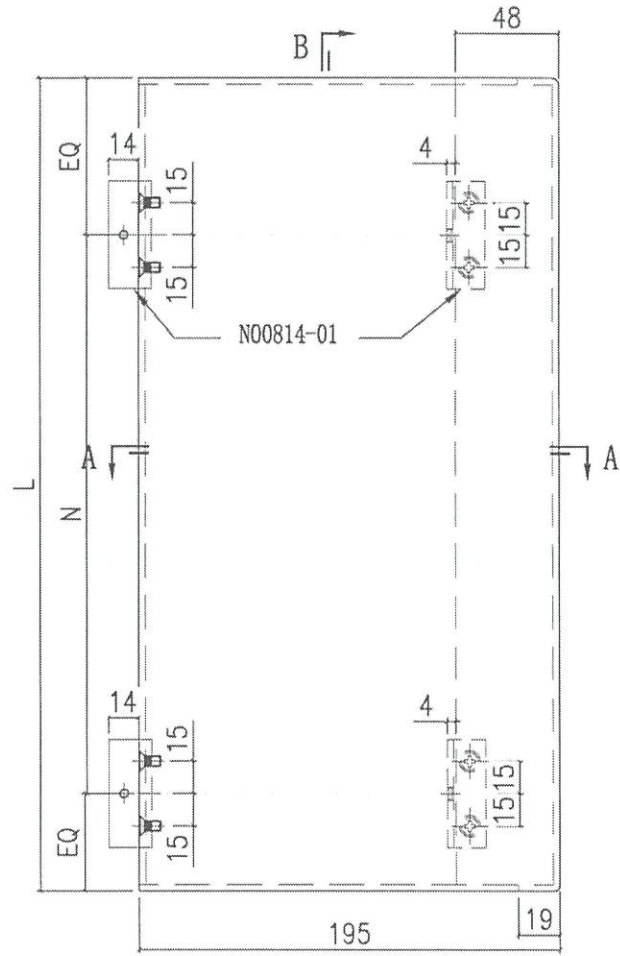


SECTION B-B

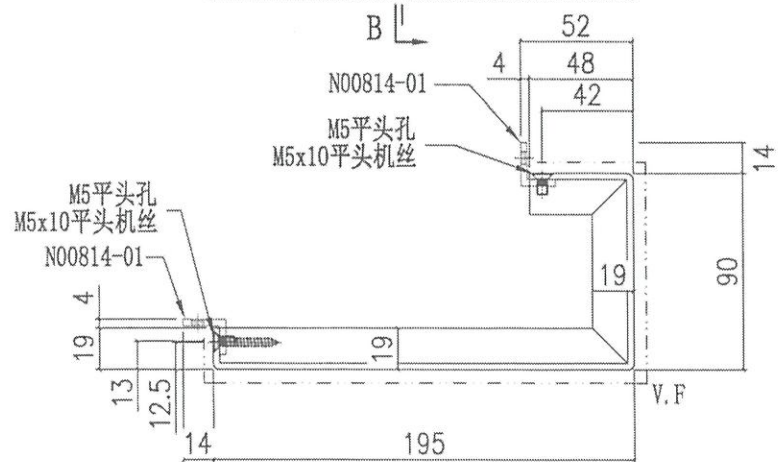


SECTION A-A

AB姓

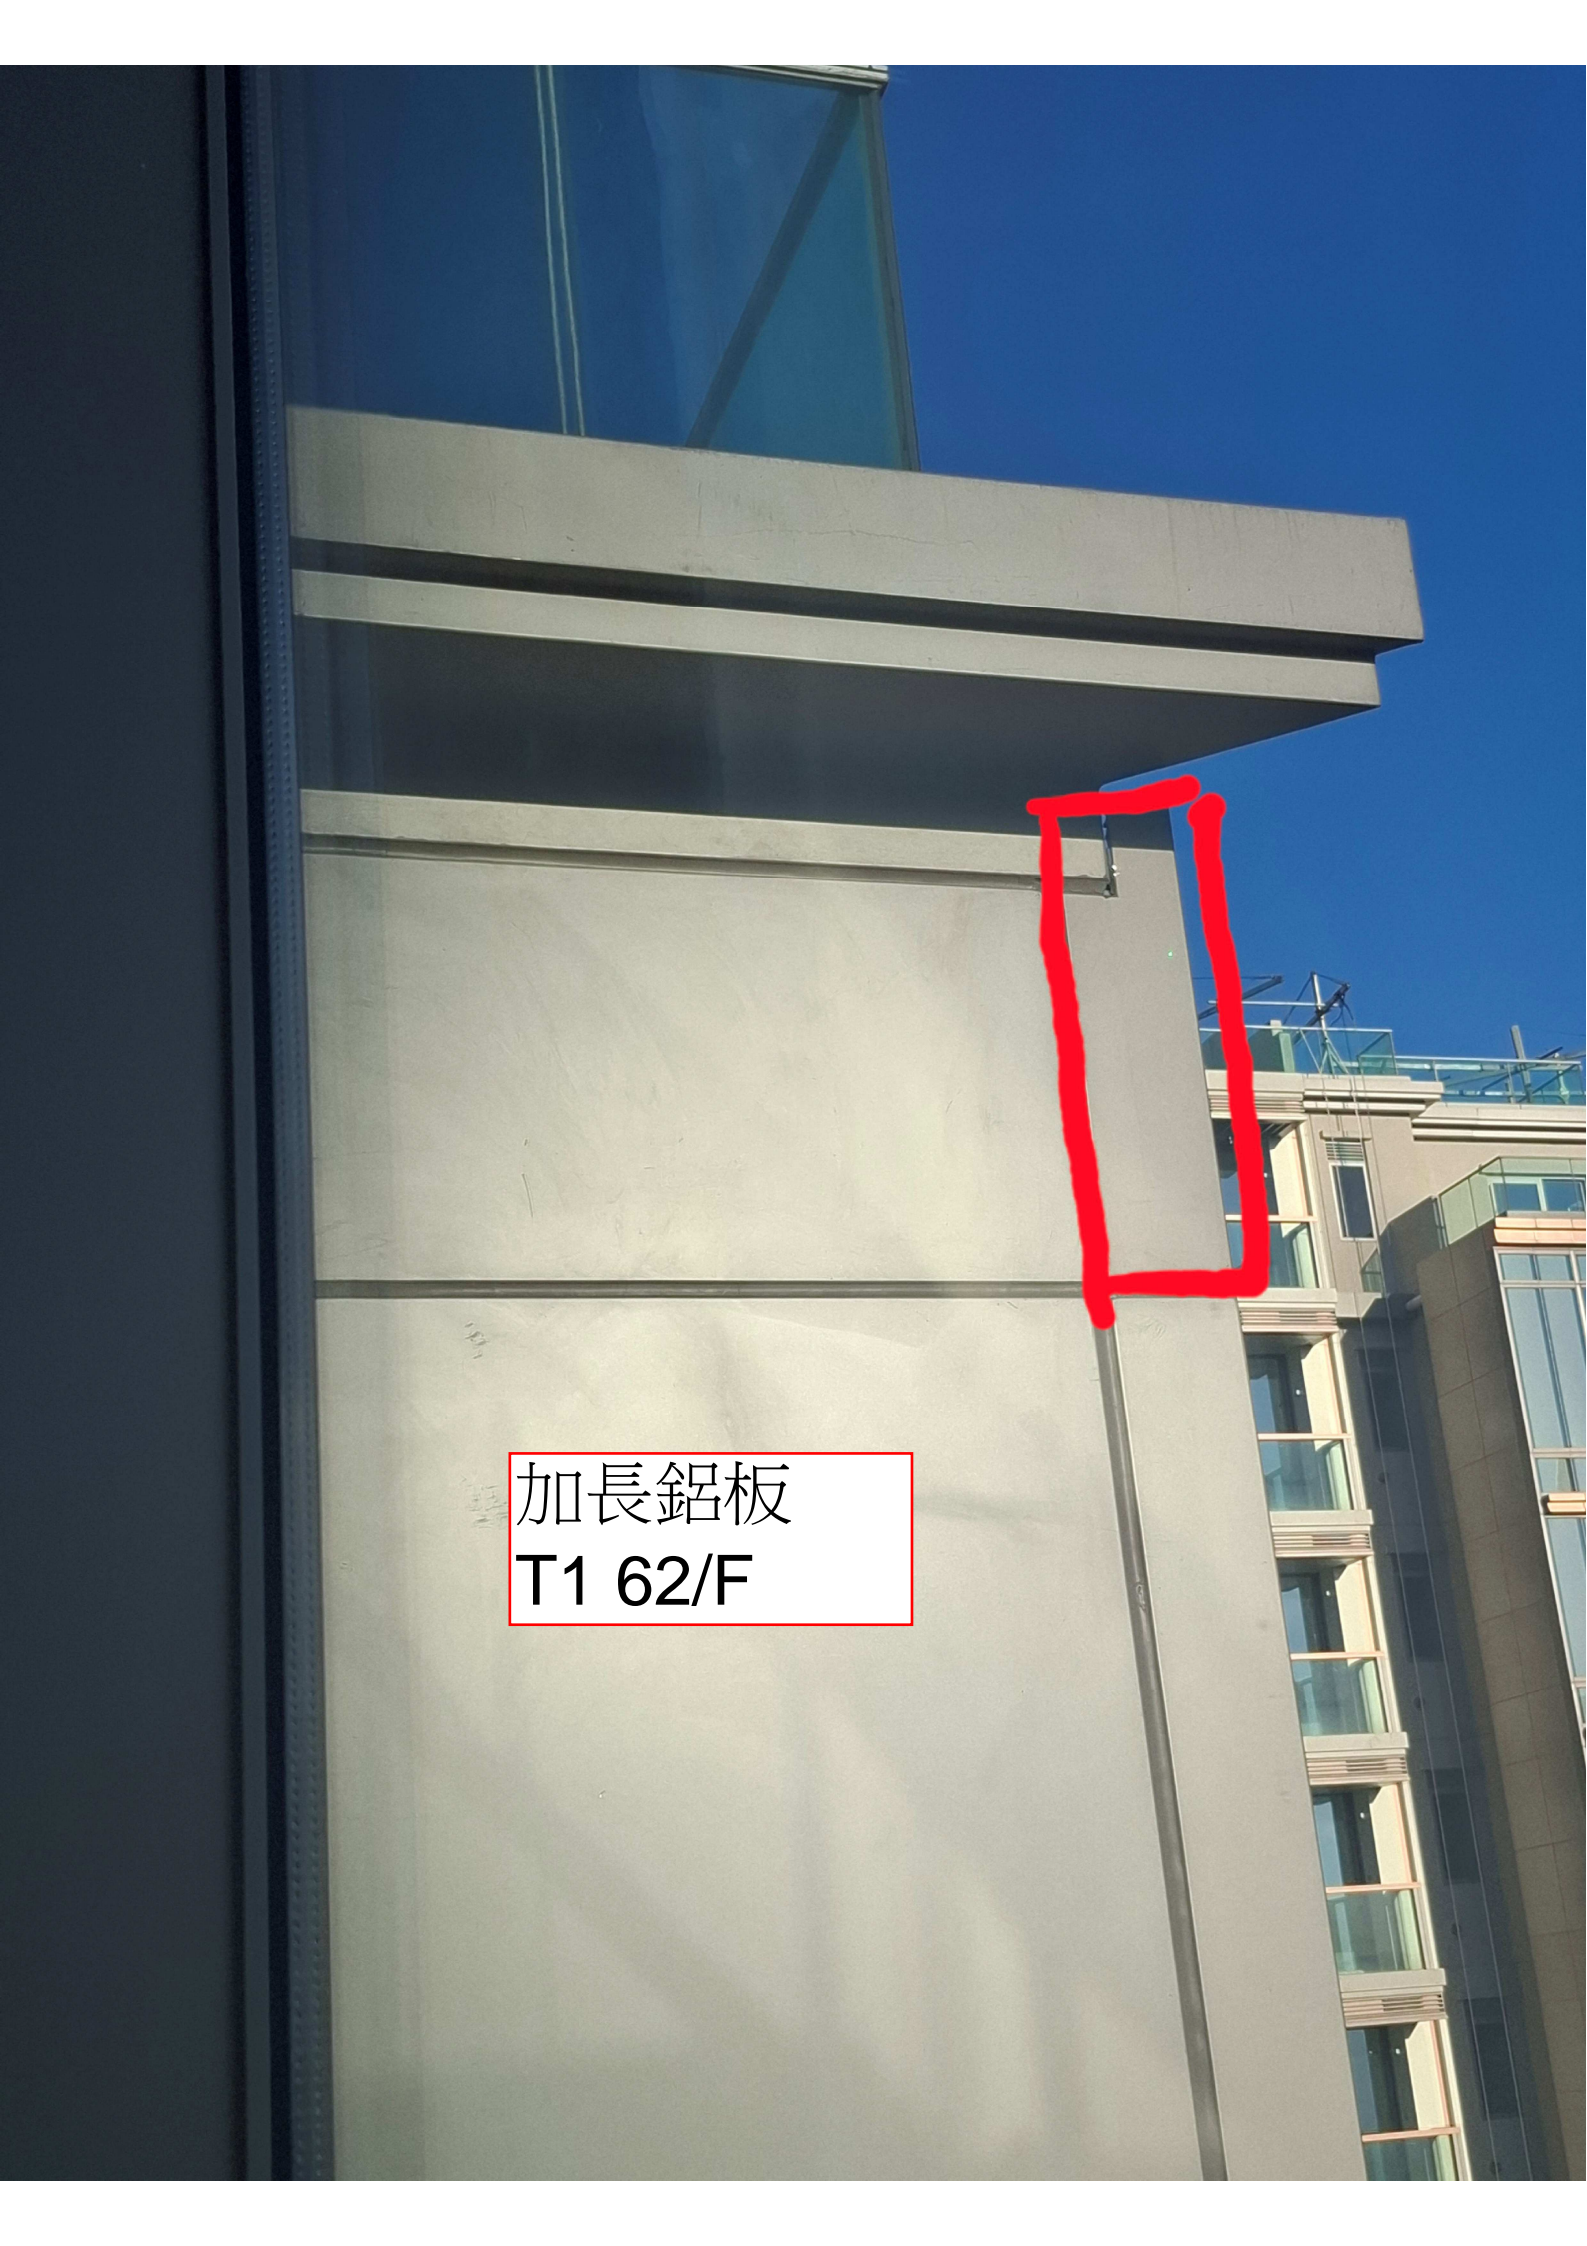

加長鋁板
T1 62/F



鋁板
T1 62/F





@jason leung T3 67BA 欠位，25/10交單
位



← 回覆

鋁板
T3 67/F

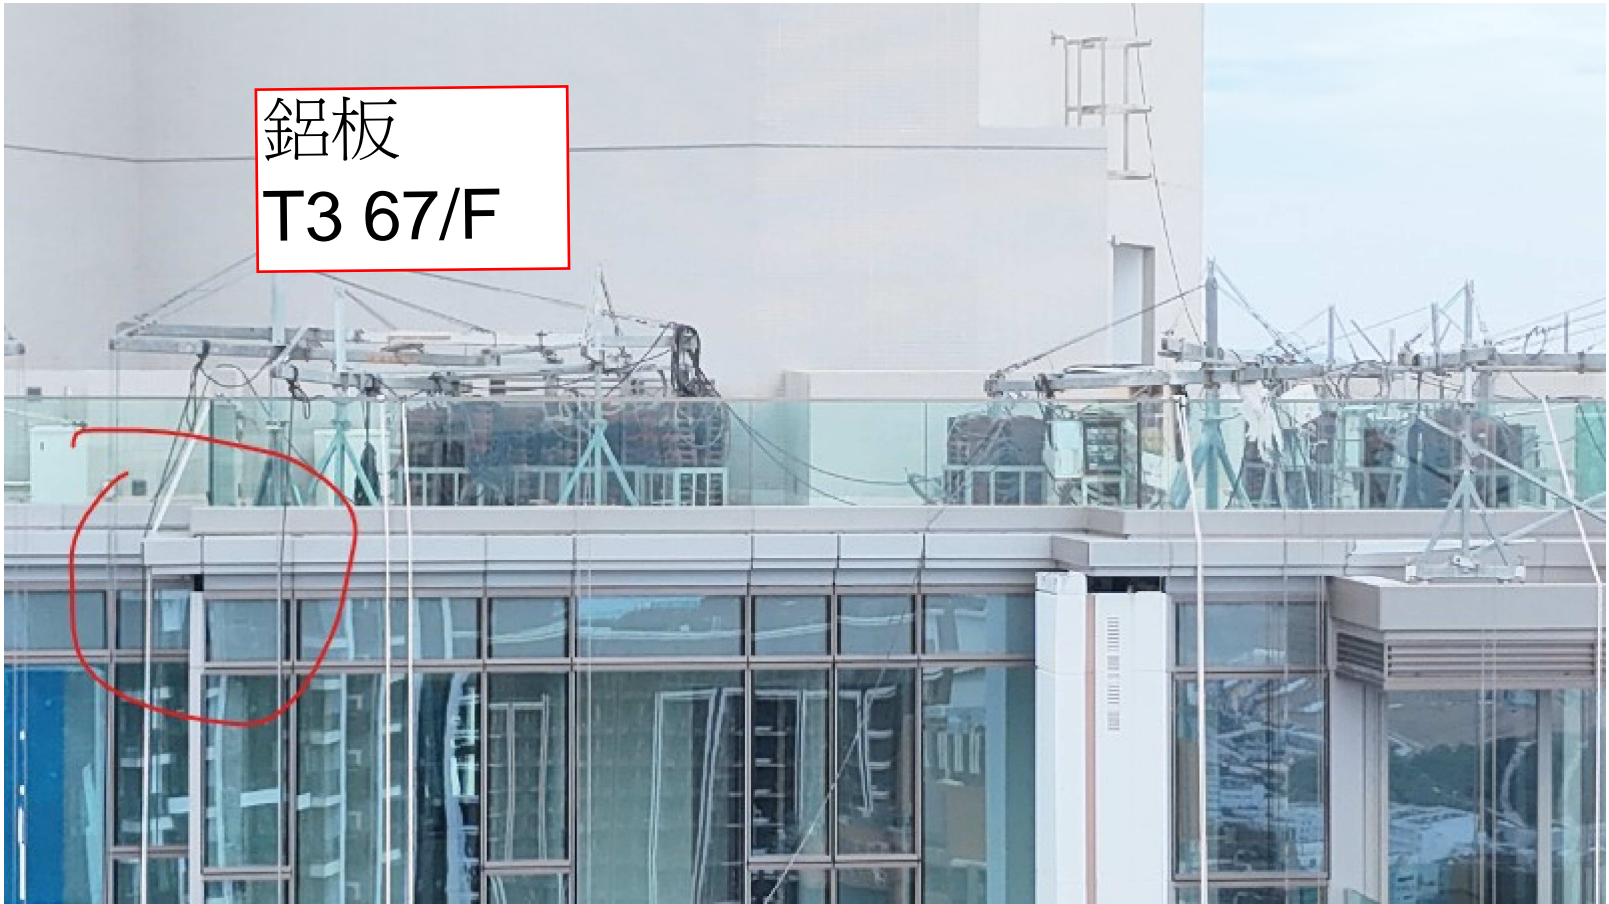

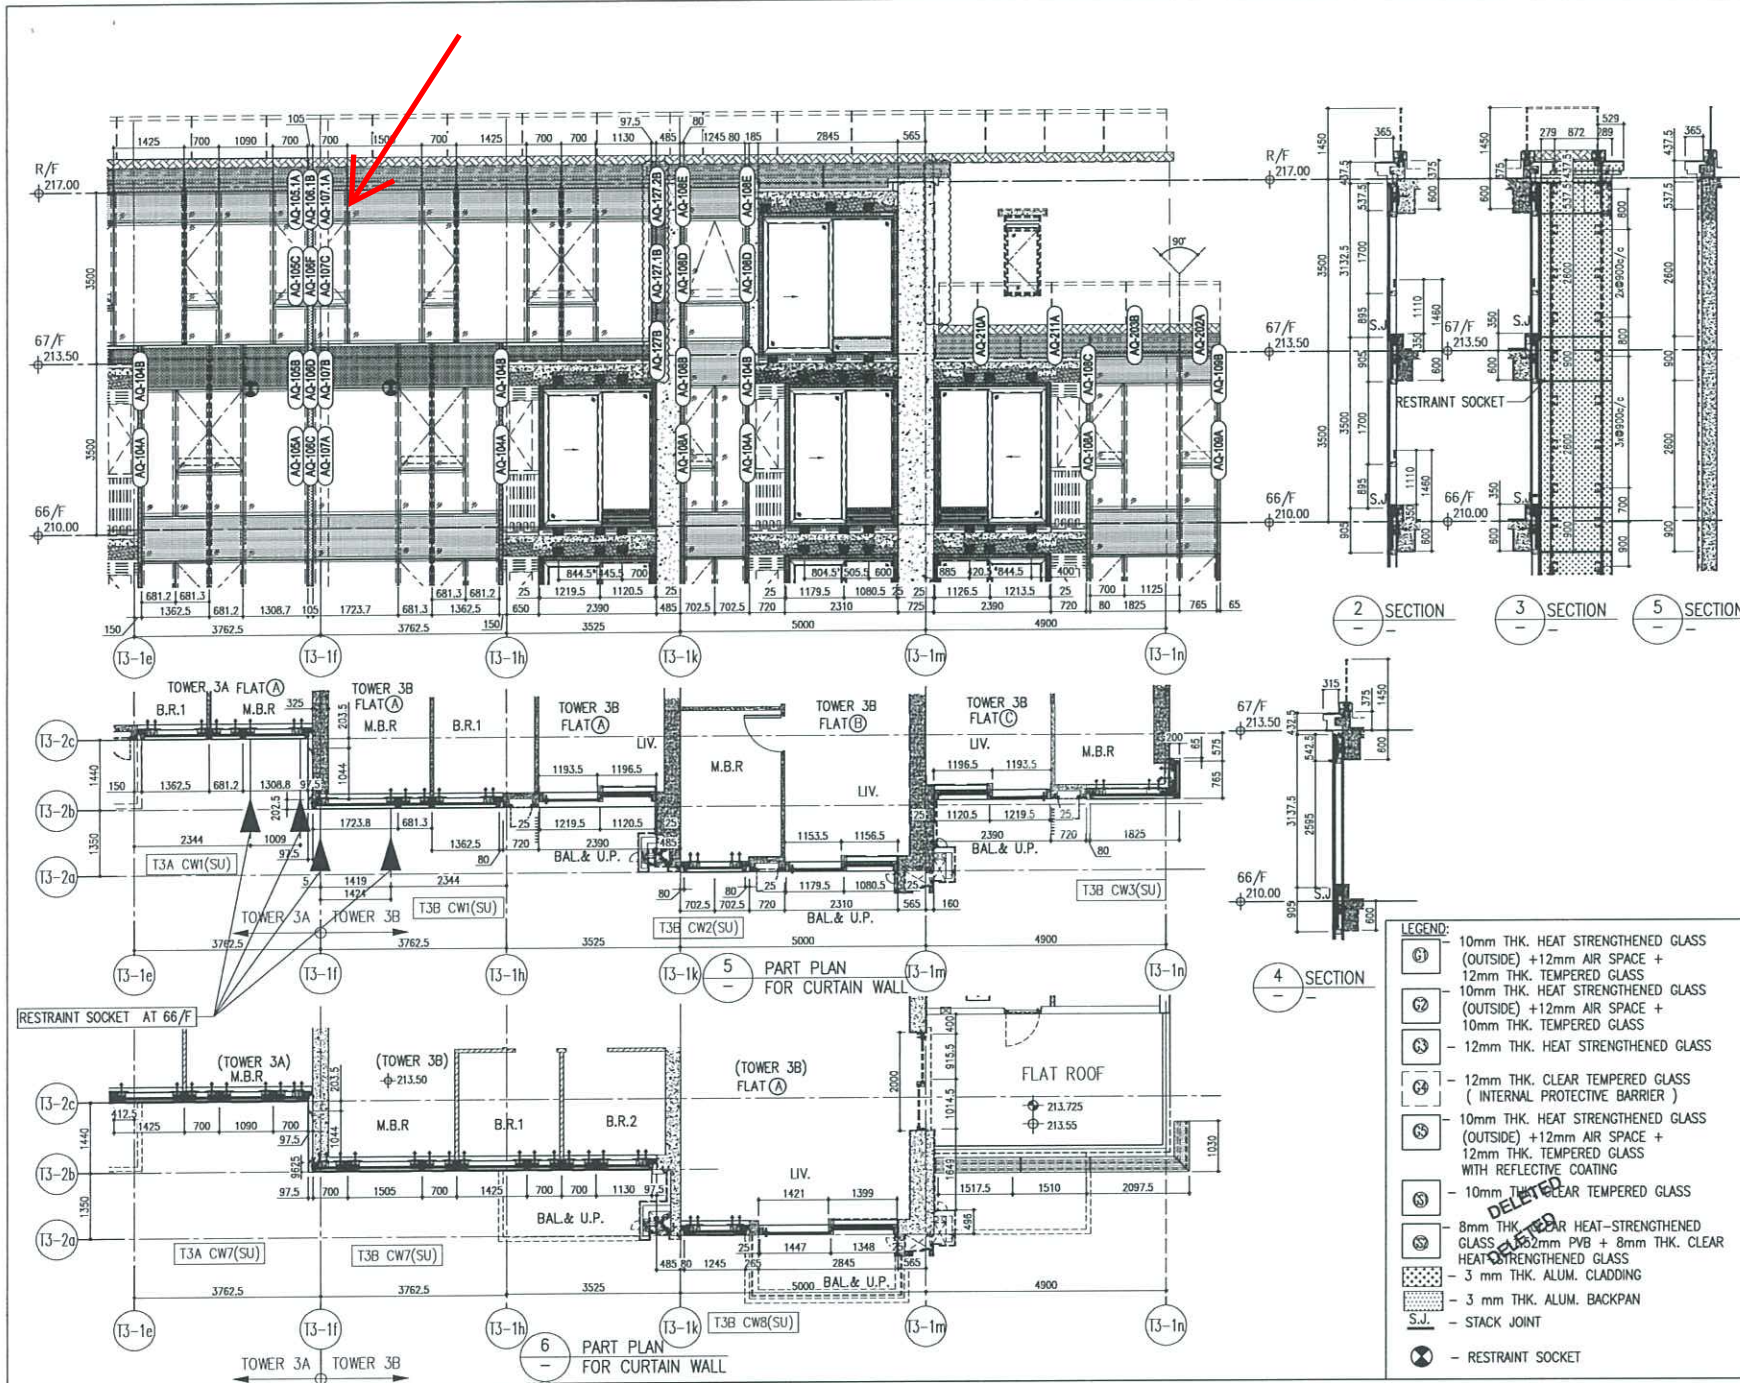

B.D. REF :

CLIENT : **信和置業有限公司**
Sino Land Company Limited

ARCHITECT : **ronald lu & partners**
Principal Architect
Ronald Lu & Partners (HK) Ltd.
呂元祥建築師事務所 (香港) 有限公司

MAIN CONTRACTOR : **Gammon**

STRUCTURAL ENGINEER : **AECOM**

FACADE CONSULTANT : **AECOM**

NOTE :

1. ALL DIMENSIONS ARE IN mm.
2. ALL ELEVATIONS ARE VIEWED FROM OUTSIDE.
3. ALL DIMENSIONS TO BE VERIFIED ON SITE BEFORE FABRICATION.

LEGEND :

(X1) DETAIL MARK NO.
(X000) REFER SHEET NO.

1. F.F.L -- FINISHED FLOOR LEVEL
2. S.F.L -- STRUCTURAL FLOOR LEVEL
3. (Z) -- REVERSED DETAIL

NO.	DATE	REVISED	BY
E	26/04/23	REVISED AS PER COMMENTS	LS
D	18/09/22	REVISED AS PER COMMENTS	LS
C	26/07/22	REVISED AS PER COMMENTS	LS
B	25/05/22	REVISED AS PER COMMENTS	LS
A	12/03/22	REVISED AS PER COMMENTS	LS

JOB NO. : J-858

PROJECT : PROPOSED RESIDENTIAL DEVELOPMENT AT TKOIL 70R, PHASE 11, LOHAS PARK TSEUNG KWAN O, N.T.

TITLE : PENTHOUSE FLOOR PARTIAL ELEVATION & SECTION, PLAN FOR CURTAIN WALL (TOWER 3)

DATE	SCALE
DATE : 22-OCT-21	SCALE : 1:50(A1)

DRAWN BY : CHECKED BY :

美特銘質有限公司
MIDI ALUMINIUM FABRICATOR LTD.
Units E-8, Sunny Industrial Centre, 1/F
610 Cho Kwo Ling Road, Kowloon
Tel:23489211-4 Fax:(852)2727666

DWG NO. : J858-CW-PE318 REV. : E