

工程指示 / 要求簡箋(E.I.)

工程指示編號：EI / 4263 / 22 修改版次：A

工程編號：J - 859 工程名稱：啟德 6551

工程項目：佛沙窗鋁料模圖 (7 個修改)

收件人：Maggie 發件人：Eric Liu 日期：07/02/2022

要求提供 / 確認 事項：

- () 初步鋁料 B.M. () 加工拆圖，然後生產 () 尺寸表
- () 正式鋁料 B.M. () 技術上資料 / 指示 () 報價
- () 配件 B.M. () 樣辦或貨品說明書 () 分判合約

內容：

現需要修改 7 個模圖，請根據附件資料盡快修改。

謝謝

請在 2022/02/23 前完成上列要求。

附：

1+7

以上項目為：

- 原合約工程包 原合約工程加 / 減賬 新工程報價

原因：-

分發東莞各部門：

- () 生產技術總監 連附件 () 技術部 連附件 () 生產部 連附件 () 機械設計部 連附件
- () 採購部 連附件 () 生產統籌部 連附件 () 小羅&清 連附件
- () 質檢部 連附件 () 會計部 連附件 () 報關組 連附件 () 其他 _____ 連附件

分發其他分判：

- (v) 水洪 連附件

分發香港各部門：

- () 行政部 連附件 () 會計部 連附件 () 統籌部 連附件 () 工程部地盤科文 連附件
- () 採購部 連附件 () QS 部 連附件 () 維修部 連附件 () 其他 _____ 連附件

傳遞編號：

HK / 22

發件人簽署：





項目經理簽署：

CHKR16841

CUSTOMER	CUSTOMER APPROVAL	CUST PART NO.	AW-36
		SECTION NO.	X86213

- a=0.1r
- b=0.2r
- c=0.3r
- d=0.4r
- e=0.5r
- f=0.8r
- g=1.0r
- h=1.5r
- j=2r

50 窗 頂 封 條

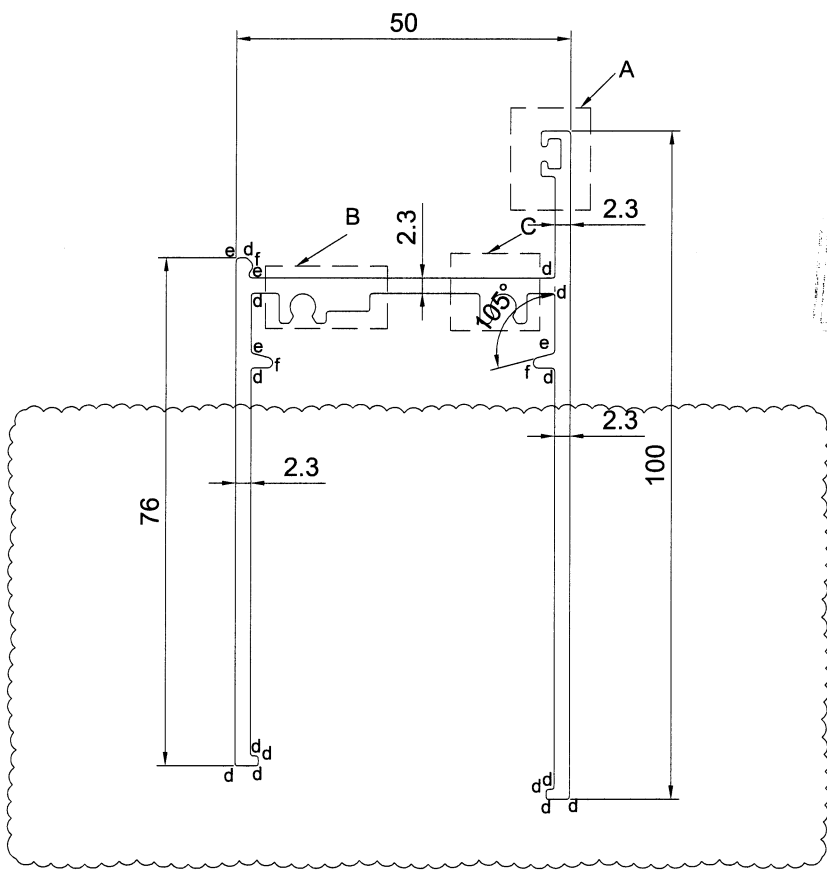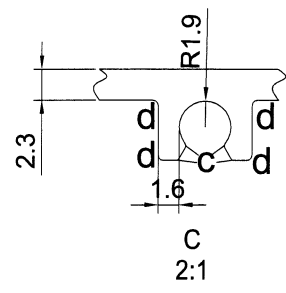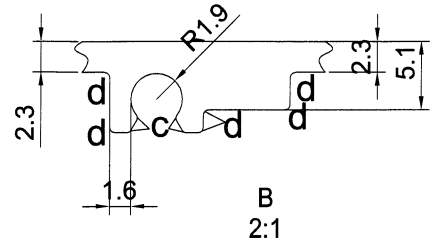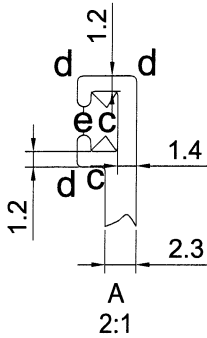

美特鋁質有限公司
 圖面
 日期 26/01/2022

SCALE 1:2

V.F





SIGNATURE GRADEING	HIGH SIGNATURE GRADEING	C.C.DIA(MM)							
AREA (SQ MM)	578.8	UNSPECIFIED THICKNESS	2.3	PERIMETER (MM)	503.7	STANDARD		SCALE	1:1
MASS (KG/M)	1.562	UNSPECIFIED CORNERS	-	SURFACE AREA	263.95	ALLOY	6063-T6	VERSION	
COMPANY ISSUE			DRAWN	L	DATE	2022-01-06	APPELLATION	PAGE OF	
			STANDARDIZATION		DATE				
			TO SIGN		DATE				
			AUDITING		DATE				
MARKER	MODIFY	FILE NO	SIGNATURE	DATE	APPROV				

美特鋁質有限公司
 MIDI Aluminium Fabricator Ltd.

CHKR 16844

CUSTOMER	CUSTOMER APPROVAL	CUST PART NO.	AW-16
		SECTION NO.	X86207

$a=0.1r$
 $b=0.2r$
 $c=0.3r$
 $d=0.4r$
 $e=0.5r$
 $f=0.8r$
 $g=1.0r$
 $h=1.5r$
 $j=2r$

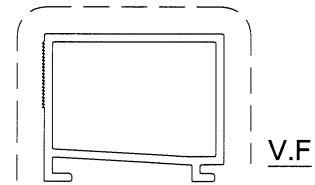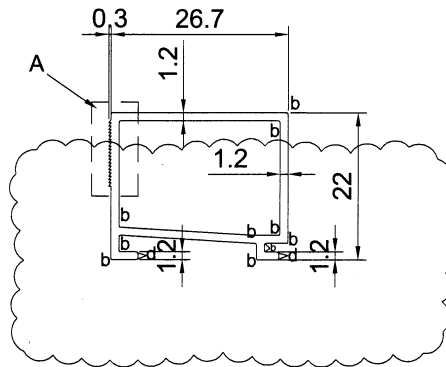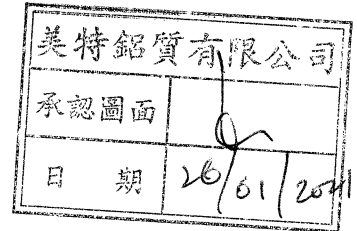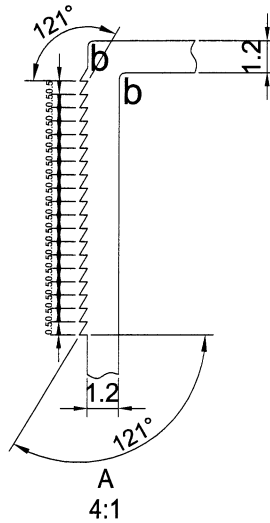

SCALE 1:1

SIGNATURE GRADEING	HIGH SIGNATURE GRADEING	C.C.DIA(MM)							
AREA (SQ MM)	93.6	UNSPECIFIED THICKNESS	1.2	PERIMETER (MM)	120.11	STANDARD		SCALE	1:1
MASS (KG/M)	0.253	UNSPECIFIED CORNERS	-	SURFACE AREA	86.34	ALLOY	6063-T5	VERSION	
COMPANY ISSUE			DRAWN	L	DATE	2021-06-22	APELLATION	PAGE OF	
			STANDARDIZATION		DATE				
			TO SIGN		DATE				
			AUDITING		DATE				
MARKER	MODIFY	FILE NO	SIGNATURE	DATE	APPROV				




美特鋁質有限公司
 MIDI Aluminium Fabricator Ltd.

CK012 16842


CUSTOMER	CUSTOMER APPROVAL	CUST PART NO.	AW-26
		SECTION NO.	X86205

中模 2020

- a=0.1r
- b=0.2r
- c=0.3r
- d=0.4r
- e=0.5r
- f=0.8r
- g=1.0r
- h=1.5r
- j=2r

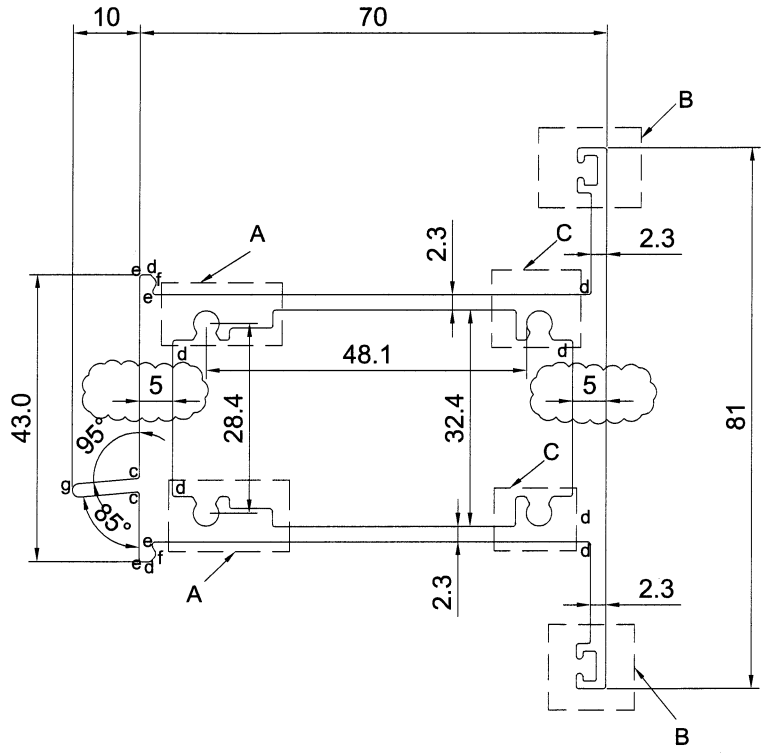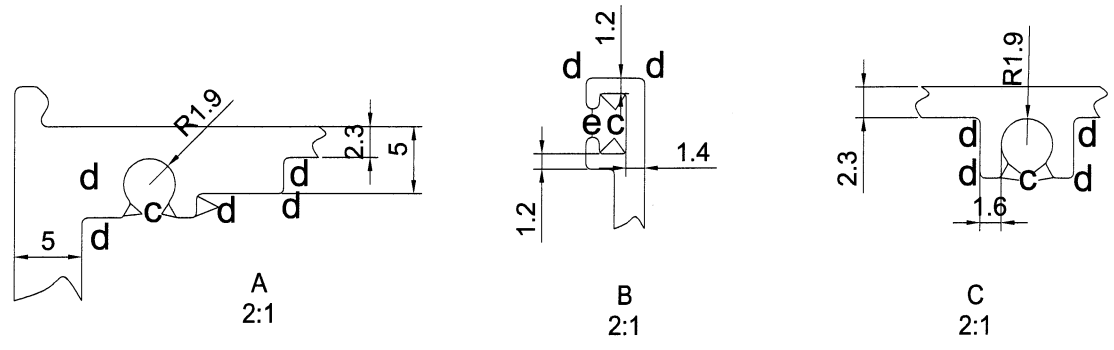

美特鋁質有限公司	
承認圖面	
日期	2020/1/20

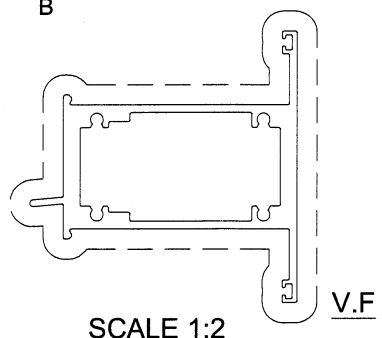



SIGNATURE GRADEING	HIGH SIGNATURE GRADEING	C.C.DIA(MM)							
AREA (SQ MM)	916.4	UNSPECIFIED THICKNESS	2.3	PERIMETER (MM)	615.2	STANDARD		SCALE	1:1
MASS (KG/M)	2.474	UNSPECIFIED CORNERS	-	SURFACE AREA	357.95	ALLOY	6063-T6	VERSION	A
COMPANY ISSUE			DRAWN	L	DATE	2022-01-06	APPELLATION	PAGE OF	
			STANDARDIZATION		DATE		美特鋁質有限公司 MIDI Aluminium Fabricator Ltd.		
			TO SIGN		DATE				
			AUDITING		DATE				
MARKER	MODIFY	FILE NO	SIGNATURE	DATE	APPROV		DATE		

CKAK 16843


CUSTOMER	CUSTOMER APPROVAL	CUST PART NO.	AW-27
		SECTION NO.	X86206

飞窗中企

- a=0.1r
- b=0.2r
- c=0.3r
- d=0.4r
- e=0.5r
- f=0.8r
- g=1.0r
- h=1.5r
- j=2r

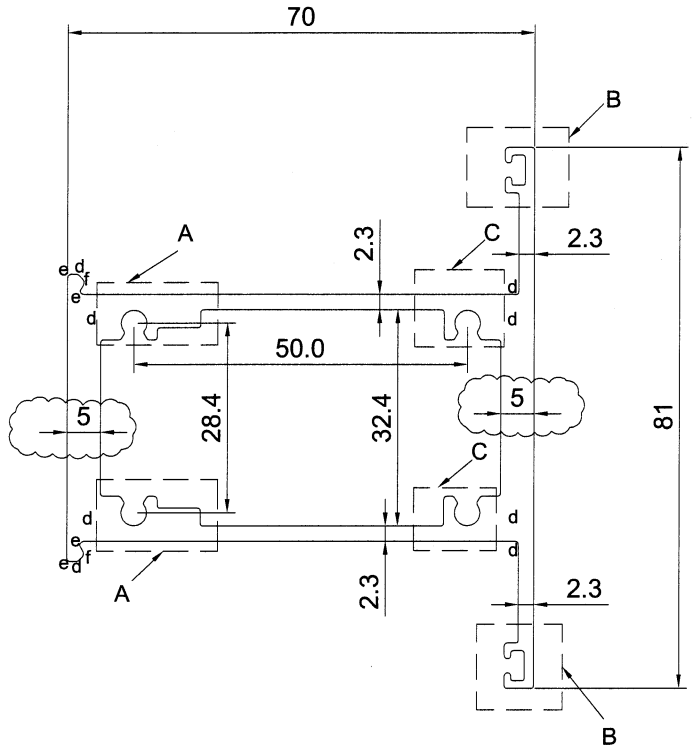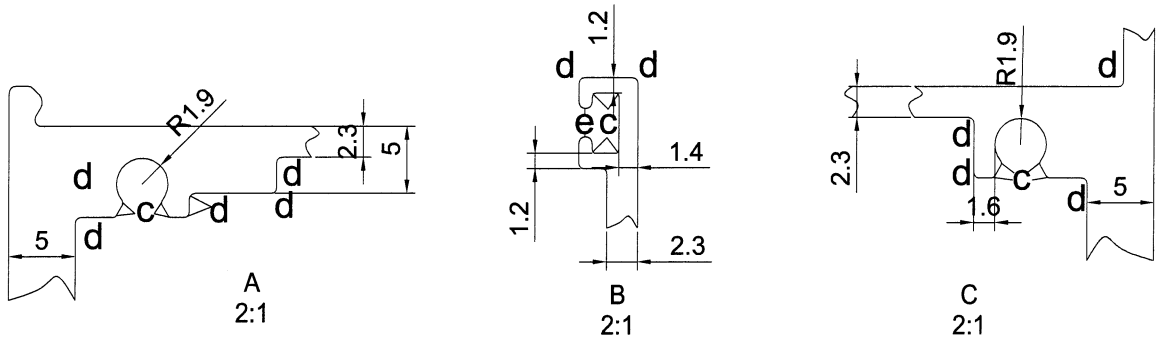

美特鋁質有限公司
承認圖面
日期 26/01/2021

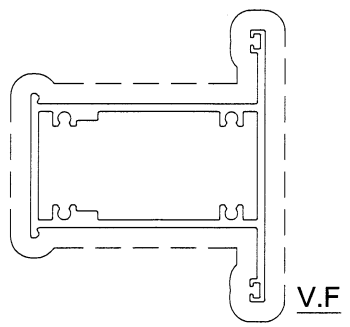

SCALE 1:2

SIGNATURE GRADEING	HIGH SIGNATURE GRADEING	C.C.DIA(MM)							
AREA (SQ MM)	896.5	UNSPECIFIED THICKNESS	2.3	PERIMETER (MM)	339.00	STANDARD		SCALE	1:1
MASS (KG/M)	2.421	UNSPECIFIED CORNERS	-	SURFACE AREA	339.00	ALLOY	6063-T6	VERSION	
COMPANY ISSUE			DRAWN	L	DATE	2022-01-06	APPELLATION	PAGE OF	
			STANDARDIZATION		DATE				
			TO SIGN		DATE				
			AUDITING		DATE				
MARKER	MODIFY	FILE NO	SIGNATURE	DATE	APPROV				



美特鋁質有限公司
MIDI Aluminium Fabricator Ltd.

CHK16838


CUSTOMER	CUSTOMER APPROVAL	CUST PART NO.	AW-33
		SECTION NO.	X86210

- a=0.1r
- b=0.2r
- c=0.3r
- d=0.4r
- e=0.5r
- f=0.8r
- g=1.0r
- h=1.5r
- j=2r

70 窗 窗框

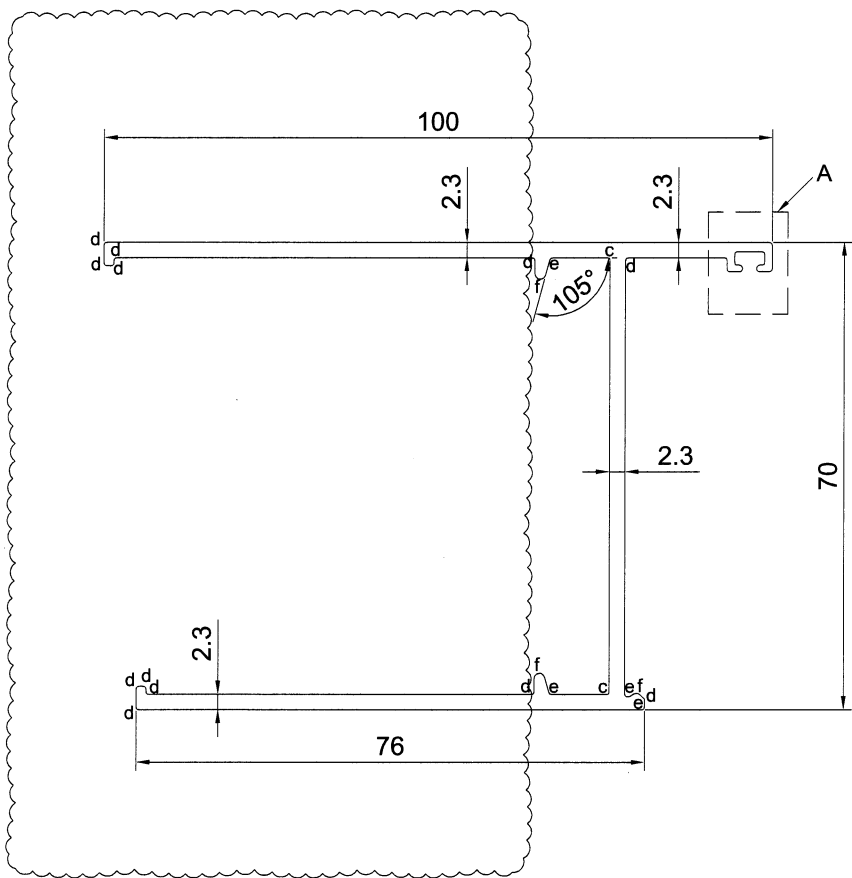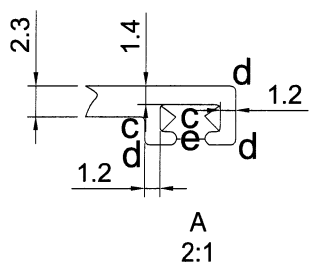

美特鋁質有限公司	
承認圖面	
日期	26/01/2022

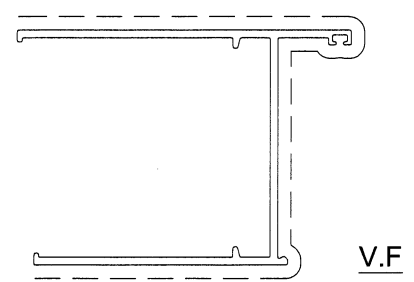

SCALE 1:2



SIGNATURE GRADEING	HIGH SIGNATURE GRADEING	C.C.DIA(MM)							
AREA (SQ MM)	572.8	UNSPECIFIED THICKNESS	2.3	PERIMETER (MM)	512.8	STANDARD		SCALE	1:1
MASS (KG/M)	1.547	UNSPECIFIED CORNERS	-	SURFACE AREA	283.96	ALLOY	6063-T6	VERSION	
COMPANY ISSUE			DRAWA	L	DATE	2022-01-06	APELLATION	PAGE OF	
			STANDA-RDIZATION		DATE		美特鋁質有限公司 MIDI Aluminium Fabricator Ltd.		
			TO SIGN		DATE				
			AUDITING		DATE				
MARKER	MODIFY	FILE NO	SIGNATURE	DATE	APPROV		DATE		

CKHR16839


CUSTOMER	CUSTOMER APPROVAL	CUST PART NO.	AW-34
		SECTION NO.	X86211

- a=0.1r
- b=0.2r
- c=0.3r
- d=0.4r
- e=0.5r
- f=0.8r
- g=1.0r
- h=1.5r
- j=2r

的零
透框

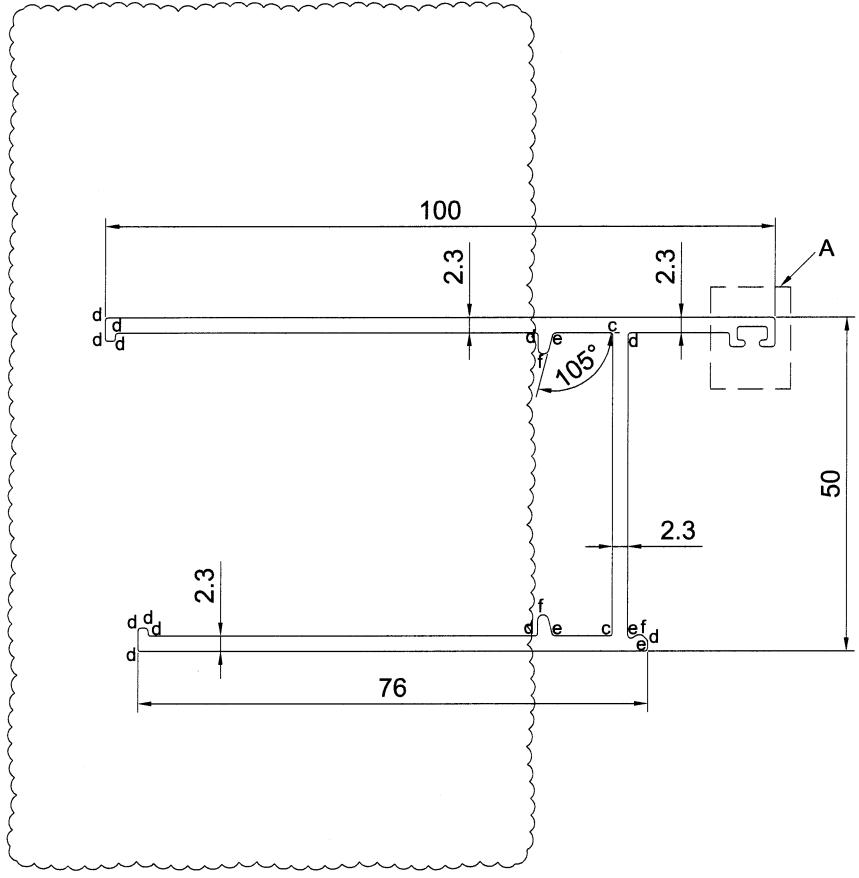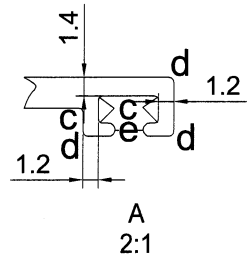

美特鋁質有限公司	
承認圖面	
日期	26/01/2022

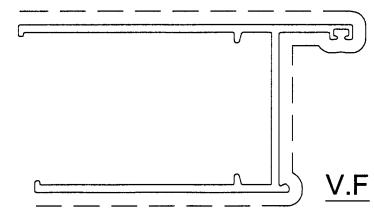

SCALE 1:2



SIGNATURE GRADEING	HIGH SIGNATURE GRADEING	C.C.DIA(MM)							
AREA (SQ MM)	526.8	UNSPECIFIED THICKNESS	2.3	PERIMETER (MM)	472.8	STANDARD		SCALE	1:1
MASS (KG/M)	1.422	UNSPECIFIED CORNERS	-	SURFACE AREA	263.96	ALLOY	6063-T6	VERSION	
COMPANY ISSUE		DRAWN	L	DATE	2022-01-06	APELLATION		PAGE OF	
		STANDARDIZATION		DATE		美特鋁質有限公司 MIDI Aluminium Fabricator Ltd.			
		TO SIGN		DATE					
		AUDITING		DATE					
MARKER	MODIFY	FILE NO	SIGNATURE	DATE	APPROV				

CKHK16840

CUSTOMER	CUSTOMER APPROVAL	CUST PART NO.	AW-35
		SECTION NO.	X86212


- a=0.1r
- b=0.2r
- c=0.3r
- d=0.4r
- e=0.5r
- f=0.8r
- g=1.0r
- h=1.5r
- j=2r

70mm 頂底框

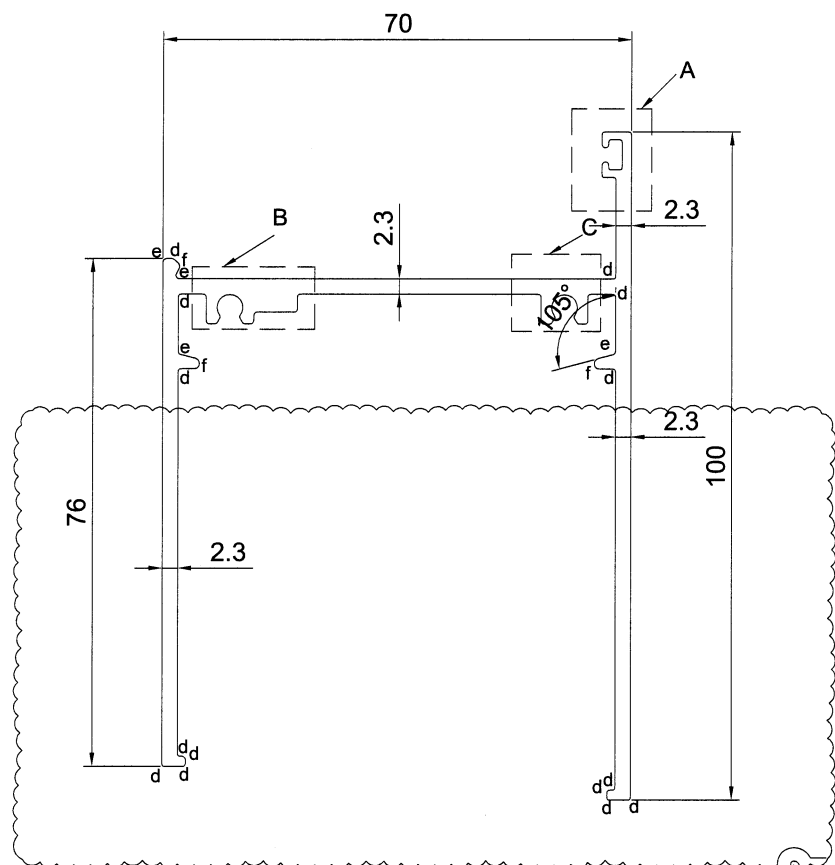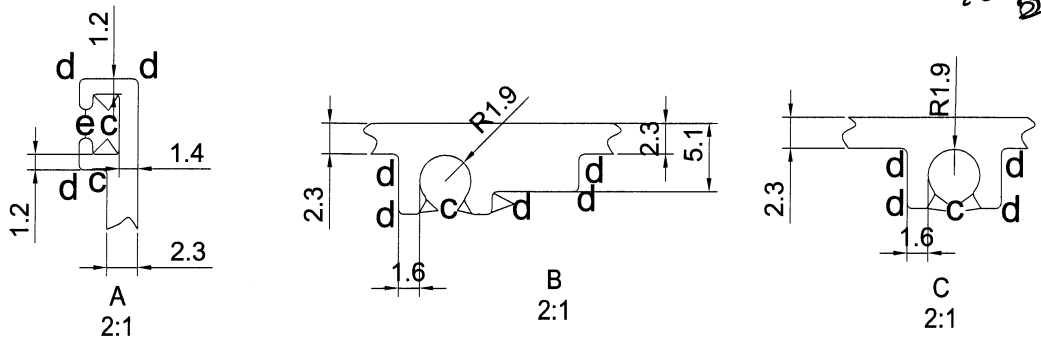

美特鋁質有限公司	
承認圖面	<i>[Signature]</i>
日期	26/01/2022

SCALE 1:2

SIGNATURE GRADEING	HIGH SIGNATURE GRADEING	C.C.DIA(MM)							
AREA (SQ MM)	624.8	UNSPECIFIED THICKNESS	2.3	PERIMETER (MM)	543.7	STANDARD		SCALE	1:1
MASS (KG/M)	1.687	UNSPECIFIED CORNERS	-	SURFACE AREA	283.95	ALLOY	6063-T6	VERSION	
COMPANY ISSUE		DRAWN	L	DATE	2022-01-06	APELLATION		PAGE OF	
		STANDARDIZATION		DATE		 美特鋁質有限公司 MIDI Aluminium Fabricator Ltd.			
		TO SIGN		DATE					
		AUDITING		DATE					
MARKER	MODIFY	FILE NO	SIGNATURE	DATE	APPROV				