



工程指示 / 要求簡箋 ENGINEER INSTRUCTIONS(E.I.)

工程指示編號:	EI- 8555	修改版本:	G
	HK- 2197		
工程編號:	J 861	工程名稱:	己連拿利
收件人:	生統	發件人:	細佬
工程項目:	幕牆 - 計算隔音用的棉在Feature位	日期:	11/12/2024

<input type="checkbox"/> 原合約工程包	<input type="checkbox"/> 原合約工程加 / 減賬 QT-	<input type="checkbox"/> 新工程報價 QT-
---------------------------------	--	------------------------------------

信件批核號碼/圖紙參考編號:	批核模具圖紙編號:
客戶指示附件:	管理內部批簽署:

<input type="checkbox"/> 初步鋁料 B.M.	<input type="checkbox"/> 加工拆圖, 然後生產	<input type="checkbox"/> 尺寸表
<input type="checkbox"/> 正式鋁料 B.M.	<input type="checkbox"/> 技術上資料/指示	<input type="checkbox"/> 報價
<input type="checkbox"/> 配件 B.M.	<input type="checkbox"/> 樣辦或貨品說明書	<input type="checkbox"/> 分判合約
<input type="checkbox"/> 其他:		


內容: 給技術部: 請計算隔音用的棉在Feature位, 看附頁資料
完成上列要求日期: 19/12/2024


國內

<input type="checkbox"/> 生產技術總監	<input type="checkbox"/> 連附件	<input checked="" type="checkbox"/> 技術部	<input checked="" type="checkbox"/> 連附件	<input type="checkbox"/> 生產部	<input type="checkbox"/> 連附件
<input type="checkbox"/> 採購部	<input type="checkbox"/> 連附件	<input checked="" type="checkbox"/> 生產統籌部	<input checked="" type="checkbox"/> 連附件	<input type="checkbox"/> 報關組	<input type="checkbox"/> 連附件
<input type="checkbox"/> 質檢部	<input type="checkbox"/> 連附件	<input type="checkbox"/> 會計部	<input type="checkbox"/> 連附件	<input type="checkbox"/> 機械設計部	<input type="checkbox"/> 連附件
<input type="checkbox"/> 香港辦	<input type="checkbox"/> 連附件	<input type="checkbox"/> 其他:			

香港

<input type="checkbox"/> 行政部	<input type="checkbox"/> 連附件	<input type="checkbox"/> 會計部	<input type="checkbox"/> 連附件	<input type="checkbox"/> 統籌部	<input type="checkbox"/> 連附件	<input type="checkbox"/> 工程部	<input type="checkbox"/> 連附件
<input type="checkbox"/> 採購部	<input type="checkbox"/> 連附件	<input type="checkbox"/> QS部	<input type="checkbox"/> 連附件	<input type="checkbox"/> 地盤管理	<input type="checkbox"/> 連附件	<input type="checkbox"/> 維修部	<input type="checkbox"/> 連附件

*發件人簽署:	*組別成員批核簽署:
傳遞編號: HK-2197	項目經理簽署: 

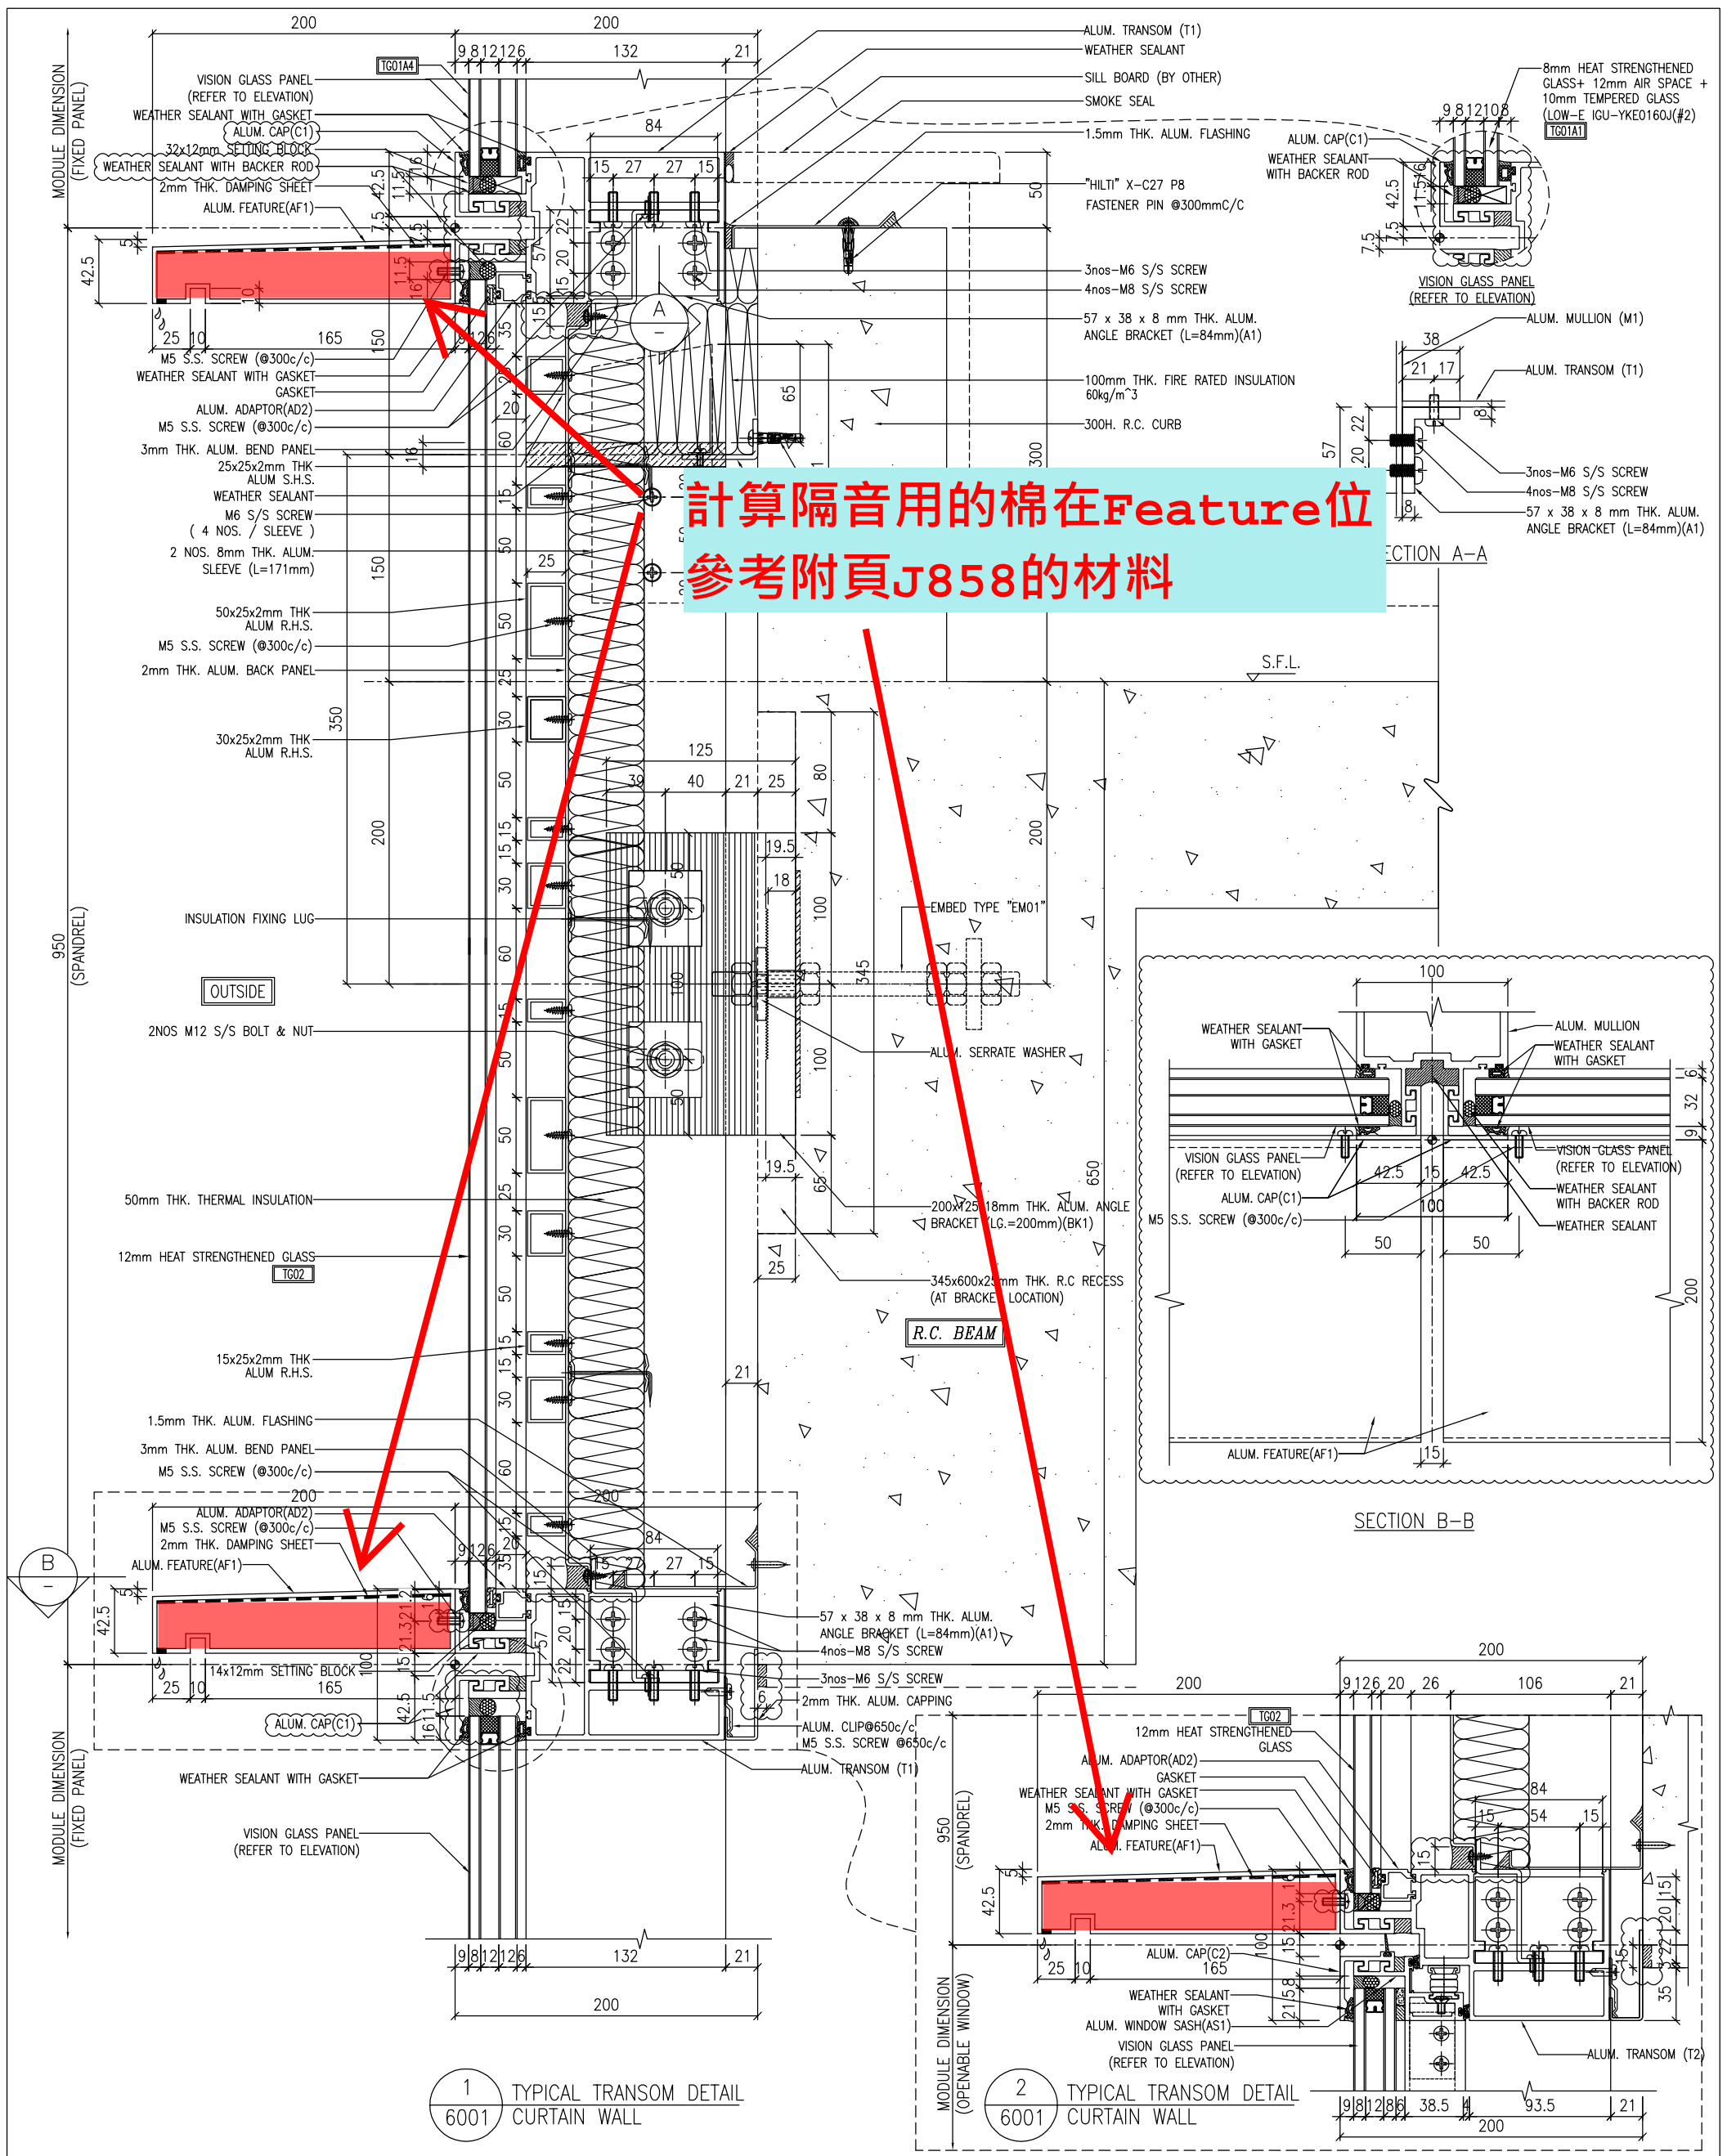

WONG TUNG & PARTNERS LTD. APPROVED AS NOTED APPROVED AS NOTED & REQUIRING RESUBMIT NO COMMENT REFER OTHER CONSULTANTS COMMENTS Note: This drawing is for information only and does not constitute a contract. The contractor shall verify all dimensions and conditions on site before fabrication. The contractor shall be responsible for any errors or omissions in this drawing.		DATE: 18-Jun-24 SCALE: 1:2 (A1) DRAWN BY: asing CHECKED BY: DWG NO.: J861-SD-CW-6001 REV.: B	TITLE: TYPICAL TRANSOM DETAIL FOR CURTAIN WALL	PROJECT: PROPOSED RESIDENTIAL DEVELOPMENT AT NOS. 3-6 GLEANEALY, CENTRAL, HONG KONG	JOB NO.: J-861	CLIENT: MILLION BASE PROPERTIES LIMITED	ARCHITECT: WONG TUNG & PARTNERS LIMITED ARCHITECTS & PLANNERS	STRUCTURAL ENGINEER: SYW & ASSOCIATES LTD. 邵賢偉建築工程師	MAIN CONTRACTOR: 顯利工程有限公司 HIEN LEE ENGINEERING CO., LTD.	REVISIONS: B 18/10/2024 GENERAL REVISED A 20/9/2024 GENERAL REVISED	NOTE: 1. ALL DIMENSIONS ARE IN mm. 2. ALL ELEVATIONS ARE VIEWED FROM OUTSIDE. 3. ALL DIMENSIONS TO BE VERIFIED ON SITE BEFORE FABRICATION. LEGEND: (X1) -- DETAIL MARK NO. (R) -- REFER SHEET NO. 1. F.F.L. -- FINISHED FLOOR LEVEL 2. S.F.L. -- STRUCTURAL FLOOR LEVEL 3. (R) -- REVERSED DETAIL
---	--	---	--	--	-------------------	--	--	--	--	---	--

美特鋁質有限公司 MIDI Aluminium Fabricator Ltd.	工程號: J-858	計算: shaw	日期: 2023-02-21	送呈:
	地盤名稱: 康城11期	核對:	日期:	副本:
廠用配件B.M.表(标准层总表)	項目類別: 单元幕墙(标准层)	批准:	日期:	
BM編號:	A/C Code : EI4847 K 2023/2/21			此BM依據20220530收施工圖大樣計算

序號	修改標示	配件圖號	物料編號	配件名稱	顏色	實用	後備	總數	單位	備注
71		材質: EPDM	20x7mm厚墊塊 (L=50mm)		黑色	4004	96	4100	塊	护栏玻璃1側用, 硬度65°~75°
72		參考J858工程用隔熱棉(隔音用)放在Feature位						100000	米	玻璃四周, 背板四周打膠用
73								5000	米	中橫室外打膠用
74			DC983	DC983結構膠	黑色	15000		15000	升	雙組份
75	J再訂5184支	EI4847 A已訂 5184支	每件单元4支	DC791 防水膠	香槟金	26000	0	26000	支	窗組裝碰口, 螺絲頭用, 300ml/支
76	F增加			DC791 防水膠	深灰色	50000	0	50000	支	室外防水, 背板300ml/支
76a	F新增	EI4915的倉存已經過期, 要加訂		DC791 防水膠	岩灰色	9500	0	9500	支	橫碰企等等
76b	F新增			DC791 防水膠	黑色	13000	0	13000	支	棉叉 / 掛碼
77		ROCKWOOL THERMALLROCK S110	CSR 1200x600x50隔熱棉			7820	180	8000	件	单面锡纸
78	跟J833	EI 4847已附加工圖		隔熱棉棉插		67500	2500	70000	只	1平方米配12只
79	C增加	ROCKWOOL THERMALLROCK S110	CSR 1200x600x25隔熱棉(隔音用) 25厚			437	23	460	件	Feature 位 隔音用
80	D增加	ROCKWOOL THERMALLROCK S110	CSR 1200x600x25隔熱棉(隔音用) 25厚			462	8	470	件	避难层及顶层鹅头铝板 单面锡纸
81	D增加	ROCKWOOL THERMALLROCK S110	CSR 1200x600x50隔熱棉			236	14	250	件	边企料铝板加浴室位, 单面锡纸
82	D增加	EI 4847已附加工圖		隔熱棉棉插		2036	114	2150	只	鋁板用 1平方米配12只
83	D增加		M16螺母/平介	A4-70		484	16	500	套	修吊船扣用, 配1平1彈墊
84	E修改		批檔網(80mm寬) smoke seal 防煙片用	鋅鐵拉展網		6835	165	7000	米	橫線窗臺完成面
85	F新增		Φ32mm过大小孔胶	黑		38950	850	39800	個	鋁掛勾碼的大小孔封孔
86	F新增		Φ14mm过大小孔胶	黑		116850	850	117700	個	主企开大小孔修螺丝位
87	F新增	M12x45內六角平头螺栓配1平1彈1螺帽		A4-70		636	34	670	套	修雙挂碼 11/F 40/F 用