



工程指示 / 要求簡箋 ENGINEER INSTRUCTIONS(E.I.)

工程指示編號:	EI- 8555	修改版本:	J
	HK- 0085		
工程編號:	J 861	工程名稱:	己連拿利
收件人:	生統/技術部	發件人:	細佬
工程項目:	幕牆 加鋁摺件	日期:	06/02/2025

<input type="checkbox"/> 原合約工程包	<input type="checkbox"/> 原合約工程加 / 減脹 QT-	<input type="checkbox"/> 新工程報價 QT-
---------------------------------	--	------------------------------------

信件批核號碼/圖紙參考編號:	批核模具圖紙編號:
客戶指示附件:	管理內部批簽署:

<input type="checkbox"/> 初步鋁料 B.M.	<input type="checkbox"/> 加工拆圖, 然後生產	<input type="checkbox"/> 尺寸表
<input type="checkbox"/> 正式鋁料 B.M.	<input type="checkbox"/> 技術上資料/指示	<input type="checkbox"/> 報價
<input type="checkbox"/> 配件 B.M.	<input type="checkbox"/> 樣辦或貨品說明書	<input type="checkbox"/> 分判合約
<input type="checkbox"/> 其他:		


內容: 增加紅圈位置的鋁摺件和鋁角
完成上列要求日期: 27/02/2025


國內

<input type="checkbox"/> 生產技術總監	<input type="checkbox"/> 連附件	<input checked="" type="checkbox"/> 技術部	<input checked="" type="checkbox"/> 連附件	<input type="checkbox"/> 生產部	<input type="checkbox"/> 連附件
<input type="checkbox"/> 採購部	<input type="checkbox"/> 連附件	<input checked="" type="checkbox"/> 生產統籌部	<input checked="" type="checkbox"/> 連附件	<input type="checkbox"/> 報關組	<input type="checkbox"/> 連附件
<input checked="" type="checkbox"/> 質檢部	<input checked="" type="checkbox"/> 連附件	<input type="checkbox"/> 會計部	<input type="checkbox"/> 連附件	<input type="checkbox"/> 機械設計部	<input type="checkbox"/> 連附件
<input type="checkbox"/> 香港辦	<input type="checkbox"/> 連附件	<input type="checkbox"/> 其他:			

香港

<input type="checkbox"/> 行政部	<input type="checkbox"/> 連附件	<input type="checkbox"/> 會計部	<input type="checkbox"/> 連附件	<input type="checkbox"/> 統籌部	<input type="checkbox"/> 連附件	<input type="checkbox"/> 工程部	<input type="checkbox"/> 連附件
<input type="checkbox"/> 採購部	<input type="checkbox"/> 連附件	<input type="checkbox"/> QS部	<input type="checkbox"/> 連附件	<input type="checkbox"/> 地盤管理	<input type="checkbox"/> 連附件	<input type="checkbox"/> 維修部	<input type="checkbox"/> 連附件

*發件人簽署:	*組別成員批核簽署:
傳遞編號: HK-0085	項目經理簽署: 

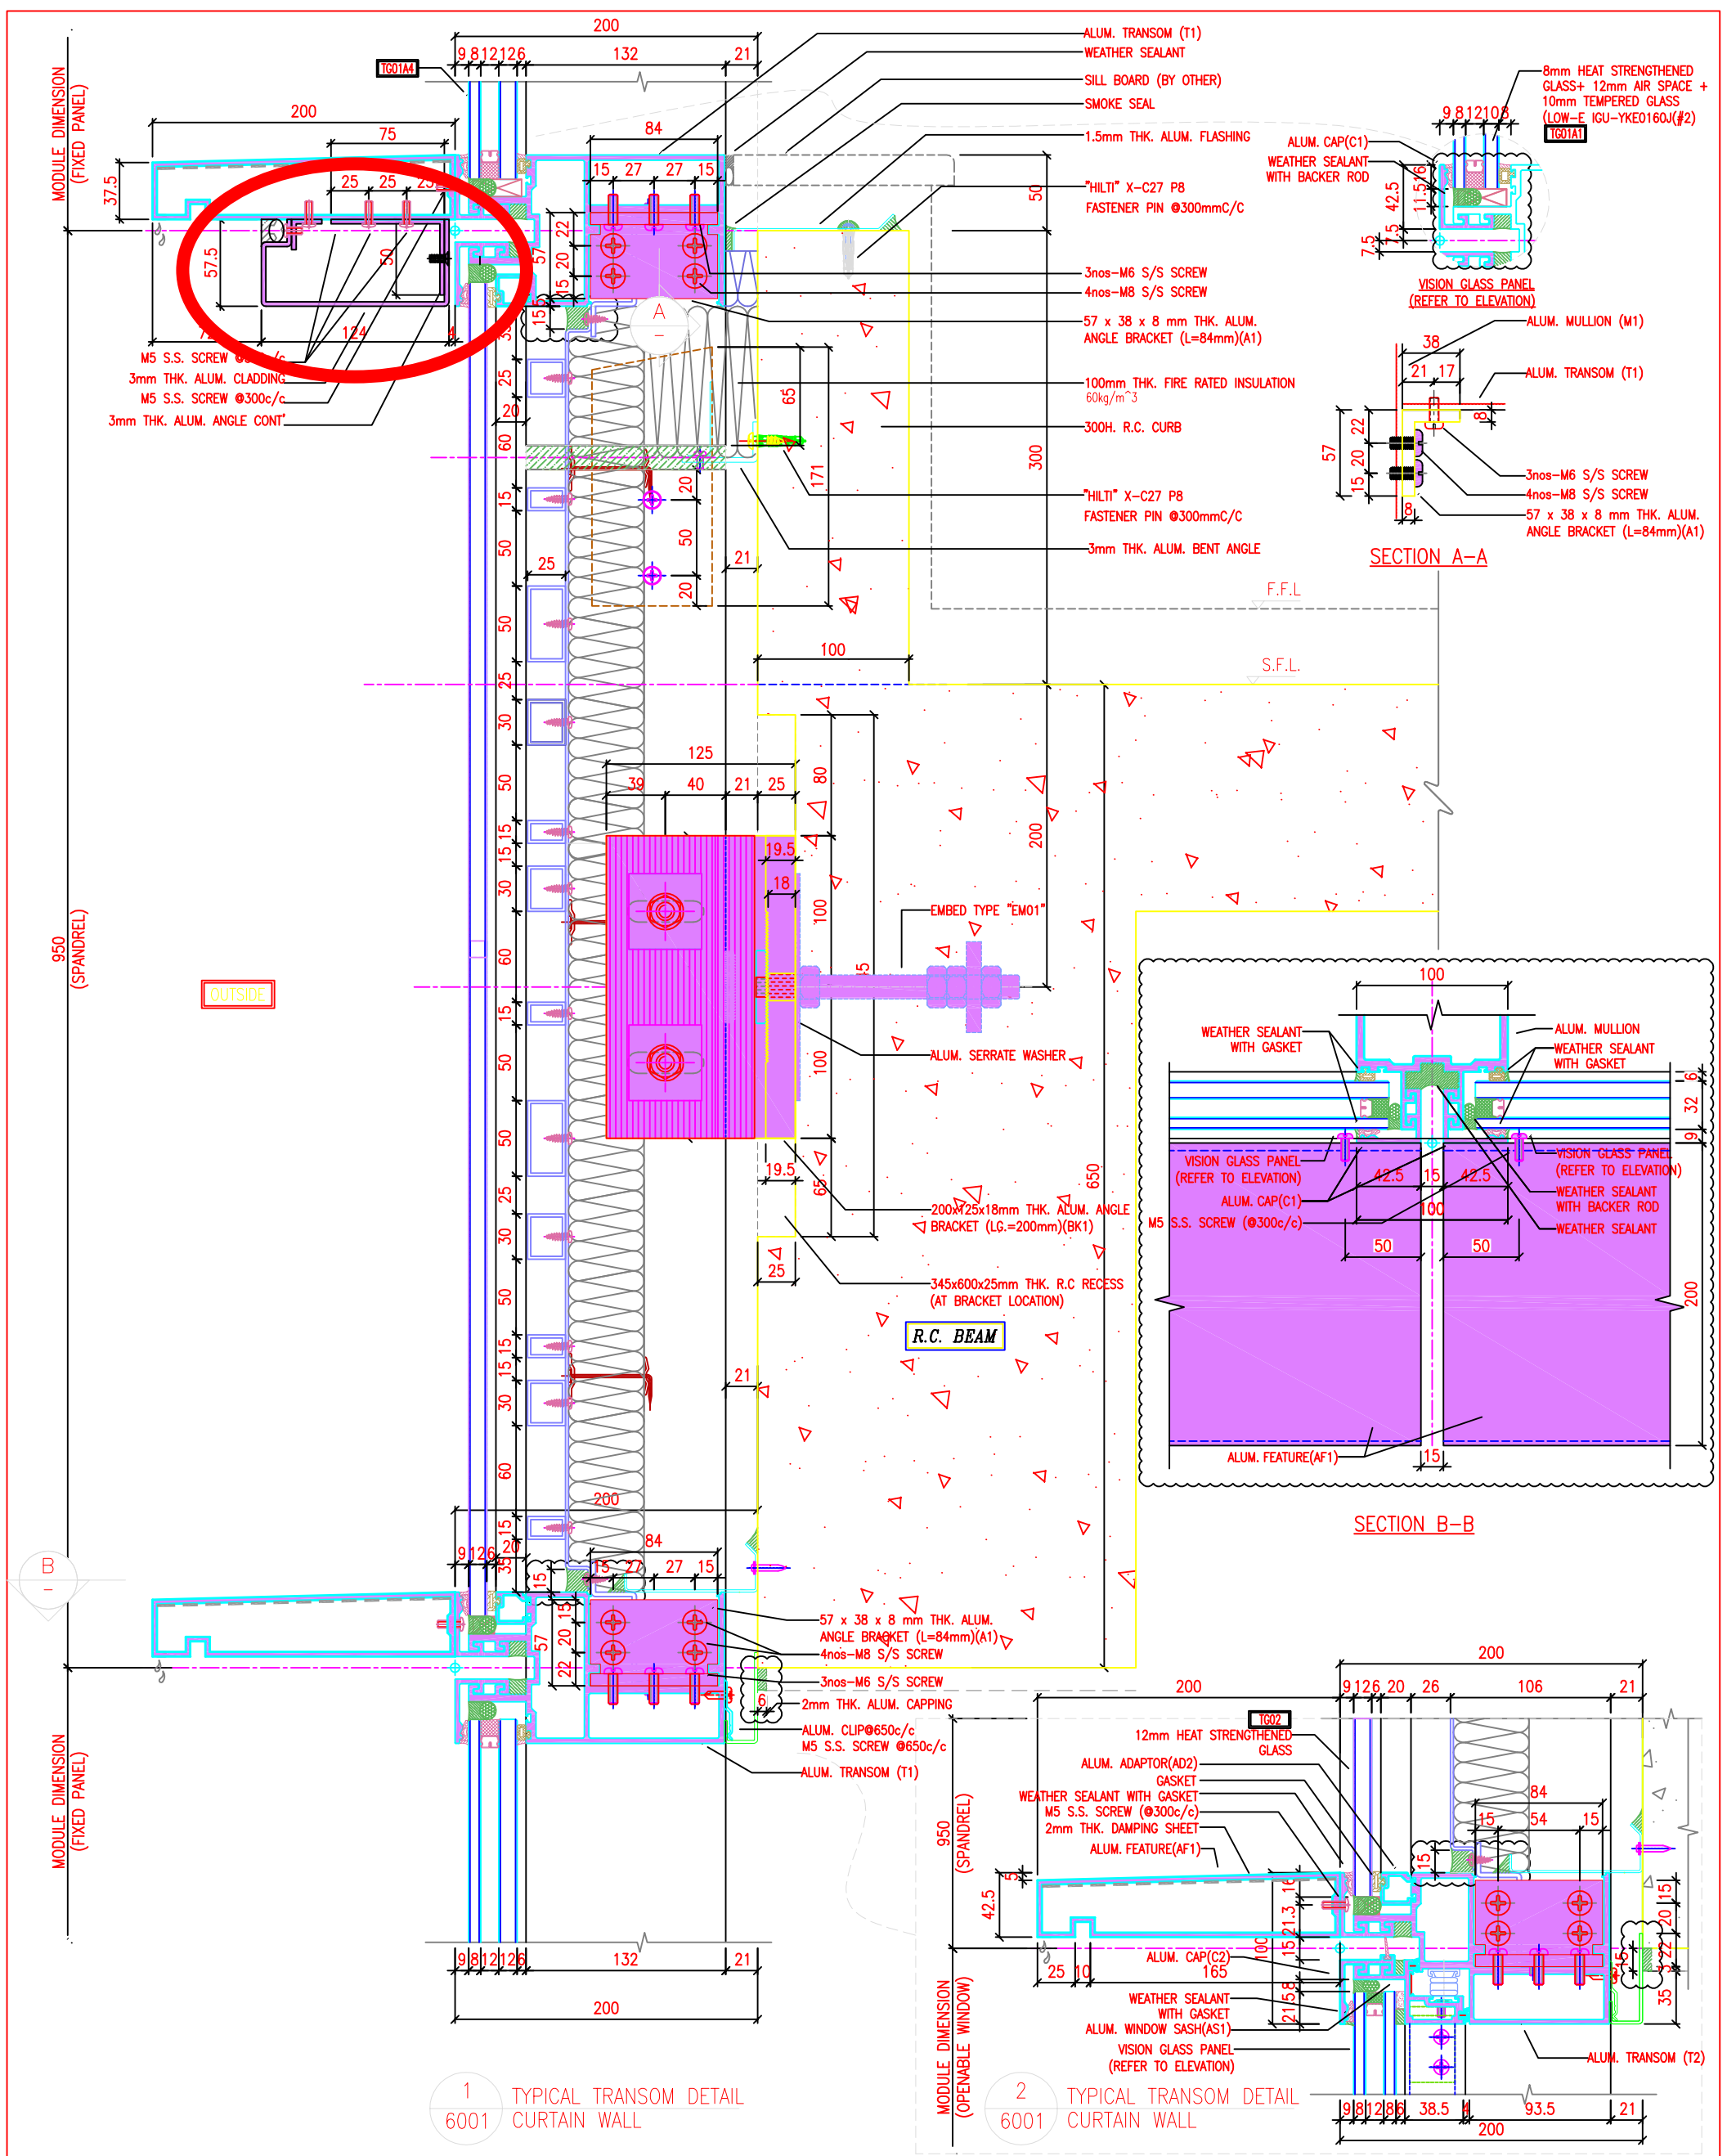

1 TYPICAL TRANSOM DETAIL  
6001 CURTAIN WALL

2 TYPICAL TRANSOM DETAIL  
6001 CURTAIN WALL

- NOTE:
1. ALL DIMENSIONS ARE IN mm.
  2. ALL ELEVATIONS ARE VIEWED FROM OUTSIDE.
  3. ALL DIMENSIONS TO BE VERIFIED ON SITE BEFORE FABRICATION.
- LEGEND:
- (X1) --- DETAIL MARK NO.
  - (X00) --- REFER SHEET NO.
  - 1. F.F.L. --- FINISHED FLOOR LEVEL
  - 2. S.F.L. --- STRUCTURAL FLOOR LEVEL
  - 3. (R) --- REVERSED DETAIL

NO.	DATE	REVISION
B	18/10/2024	GENERAL REVISED
A	20/9/2024	GENERAL REVISED

MILLION BASE PROPERTIES LIMITED

CLIENT:

ARCHITECT:  
WONG TUNG & PARTNERS LIMITED  
ARCHITECTS & ENGINEERS

STRUCTURAL ENGINEER:  
SWW

MAIN CONTRACTOR:  
顯利工程有限公司  
HIEN LEE ENGINEERING CO., LTD.

UNITED ALUMINIUM FABRICATOR LTD.  
MIDI ALUMINIUM FABRICATOR LTD.  
Unit 6-8, Sunray Industrial Centre, V/F  
610 Cho Kwo Ling Road, Kowloon  
Tel: 23469211-4 Fax: (852) 27272666

JOB NO.: J-961

PROJECT:  
PROPOSED RESIDENTIAL  
DEVELOPMENT AT NOS. 3-6  
GENEALY, CENTRAL, HONG KONG

TITLE:  
TYPICAL TRANSOM DETAIL  
FOR CURTAIN WALL

DATE: 18-Jun-24 SCALE: 1:2 (A1)

DRAWN BY: Ailing CHECKED BY:

DWG NO.: J861-SD-CW-6001 REV.: B

APPROVED	DATE
WONG TUNG & PARTNERS LTD.	
APPROVED AS NOTED	
APPROVED AS NOTED & RESUBMIT	
RESUBMIT	
NO COMMENT	
REFER OTHER CONSULTANTS' COMMENTS	
REVIEWER'S COMMENTS	
REVISIONS	
REVIEWED BY	