



工程指示 / 要求簡箋 ENGINEER INSTRUCTIONS(E.I.)

| | | | |
|---------|------------------|-------|------------|
| 工程指示編號: | EI- 8777 | 修改版本: | A |
| | HK- 0141 | | |
| 工程編號: | J 861 | 工程名稱: | 己連拿利 |
| 收件人: | 生統/技術部 | 發件人: | 細佬 |
| 工程項目: | 後裝窗 Shop Drawing | 日期: | 18/02/2025 |

| | | |
|---------------------------------|--|------------------------------------|
| <input type="checkbox"/> 原合約工程包 | <input type="checkbox"/> 原合約工程加 / 減賬 QT- | <input type="checkbox"/> 新工程報價 QT- |
|---------------------------------|--|------------------------------------|

| | |
|----------------|-----------|
| 信件批核號碼/圖紙參考編號: | 批核模具圖紙編號: |
| 客戶指示附件: | 管理內部批簽署: |

| | | |
|------------------------------------|-------------------------------------|-------------------------------|
| <input type="checkbox"/> 初步鋁料 B.M. | <input type="checkbox"/> 加工拆圖, 然後生產 | <input type="checkbox"/> 尺寸表 |
| <input type="checkbox"/> 正式鋁料 B.M. | <input type="checkbox"/> 技術上資料/指示 | <input type="checkbox"/> 報價 |
| <input type="checkbox"/> 配件 B.M. | <input type="checkbox"/> 樣辦或貨品說明書 | <input type="checkbox"/> 分判合約 |
| <input type="checkbox"/> 其他: | | |

| |
|--|
| 內容: 給技術部: 請收附頁後裝窗ShopDrawing 請制作2F至7F(頭5層)的加工圖 CAD文件在以下位置 J:\midi_sharepoint\Public\to_china\謝永林\J861\EI8777A_HK0141_CAD |
| 完成上列要求日期: 18/03/2025 |


國內

| | | | | | |
|---------------------------------|------------------------------|---|---|--------------------------------|------------------------------|
| <input type="checkbox"/> 生產技術總監 | <input type="checkbox"/> 連附件 | <input checked="" type="checkbox"/> 技術部 | <input checked="" type="checkbox"/> 連附件 | <input type="checkbox"/> 生產部 | <input type="checkbox"/> 連附件 |
| <input type="checkbox"/> 採購部 | <input type="checkbox"/> 連附件 | <input checked="" type="checkbox"/> 生產統籌部 | <input checked="" type="checkbox"/> 連附件 | <input type="checkbox"/> 報關組 | <input type="checkbox"/> 連附件 |
| <input type="checkbox"/> 質檢部 | <input type="checkbox"/> 連附件 | <input type="checkbox"/> 會計部 | <input type="checkbox"/> 連附件 | <input type="checkbox"/> 機械設計部 | <input type="checkbox"/> 連附件 |
| <input type="checkbox"/> 香港辦 | <input type="checkbox"/> 連附件 | <input type="checkbox"/> 其他: | | | |

香港

| | | | | | | | |
|------------------------------|------------------------------|------------------------------|------------------------------|-------------------------------|------------------------------|------------------------------|------------------------------|
| <input type="checkbox"/> 行政部 | <input type="checkbox"/> 連附件 | <input type="checkbox"/> 會計部 | <input type="checkbox"/> 連附件 | <input type="checkbox"/> 統籌部 | <input type="checkbox"/> 連附件 | <input type="checkbox"/> 工程部 | <input type="checkbox"/> 連附件 |
| <input type="checkbox"/> 採購部 | <input type="checkbox"/> 連附件 | <input type="checkbox"/> QS部 | <input type="checkbox"/> 連附件 | <input type="checkbox"/> 地盤管理 | <input type="checkbox"/> 連附件 | <input type="checkbox"/> 維修部 | <input type="checkbox"/> 連附件 |

| | |
|--------------------------|-----------------------|
| *發件人簽署: 傳遞編號: HK-0141 | *組別成員批核簽署: 項目經理簽署: |
|--------------------------|-----------------------|

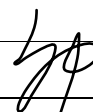

PROJECT :

PROPOSED RESIDENTIAL
DEVELOPMENT AT
NOS. 3-6 GLENEALY, CENTRAL, HONG KONG

5

SHOPDRAWING SUBMISSION
IN-SITU ALUM. WINDOW , LOUVRE & BI-FOLDING DOOR

DATE: 18-FEB-2025

 美特鋁質有限公司
MIDI ALUMINIUM FABRICATOR LTD.

Units 6-8, Sunray Industrial Centre, 1/F
610 Cha Kwo Ling Road, Kowloon
Tel:23489211-4 Fax:(852)27727666


DWG NO. : J861-SD-IW-0000

REV. : E

DRAWING SUBMISSION REGISTER

| PROJECT: PROPOSED RESIDENTIAL DEVELOPMENT AT NOS. 3-6 GLENEALY, CENTRAL, HONG KONG TITLE: SHOPDRAWING SUBMISSION FOR IN-SITU ALUM. WINDOW, LOUVRE, BI-FOLDING DOOR & SLIDING DOOR | DATE OF ISSUE | | | | | | | | | | SUBMISSION STATE (FOR B.D / A.S.D) | | | SUBMISSION STATE (FOR CLIENT / CONSULTANT) | | | SUBMISSION STATE (FOR ARCHITECT) | | | FABRICATION / CONSTRUCTION STATE | | | | | | |
|--|-----------------|-----------|----|----|----|----|----|--|--|--|------------------------------------|---------------------------------|-------|--|---------------------------------|-------|----------------------------------|---------------------------------|-------|----------------------------------|-----------------------|------|---------------|------|-------------------------|--|
| | ISSUE | 1 | 2 | 3 | 4 | 4a | 5 | | | | | AP - APPROVED | | | AP - APPROVED | | | AP - APPROVED | | | ISSUE TO CHINA OFFICE | | ISSUE TO SITE | | ISSUE TO SUB-CONTRACTOR | |
| | DAY | 29 | 16 | 10 | 11 | 2 | 17 | | | | | AC - APPROVED SUB. TO CONDITION | | | AC - APPROVED SUB. TO CONDITION | | | AC - APPROVED SUB. TO CONDITION | | | | | | | | |
| | MONTH | 7 | 8 | 10 | 11 | 12 | 2 | | | | | NA - NOT APPROVED | | | NA - NOT APPROVED | | | NA - NOT APPROVED | | | | | | | | |
| | YEAR | 24 | 24 | 24 | 24 | 24 | 25 | | | | | | | | | | | | | | | | | | | |
| DRAWING TITLE | DWG. NO. | REVISIONS | | | | | | | | | COMMENT DATE | REV. | STATE | COMMENT DATE | REV. | STATE | COMMENT DATE | REV. | STATE | REV. | DATE | REV. | DATE | REV. | DATE | |
| COVER PAGE | J861-SD-IW-0000 | - | A | B | C | D | E | | | | | | | | | | | | | | | | | | | |
| DRAWING REGISTER | J861-SD-IW-0001 | - | A | B | C | D | E | | | | | | | | | | | | | | | | | | | |
| DRAWING REGISTER | J861-SD-IW-0002 | - | A | B | C | D | E | | | | | | | | | | | | | | | | | | | |
| GENERAL NOTES FOR IN-SITU WINDOW | J861-SD-IW-0011 | | - | A | A | A | / | | | | | | | | | | | | | | | | | | | |
| DIE LIST FOR IN-SITU WINDOW | J861-SD-IW-0021 | - | - | - | - | - | / | | | | | | | | | | | | | | | | | | | |
| DIE LIST FOR IN-SITU WINDOW | J861-SD-IW-0022 | - | - | - | - | - | / | | | | | | | | | | | | | | | | | | | |
| DIE LIST FOR IN-SITU WINDOW | J861-SD-IW-0023 | - | - | - | - | - | / | | | | | | | | | | | | | | | | | | | |
| DIE LIST FOR IN-SITU WINDOW | J861-SD-IW-0024 | - | A | B | B | / | | | | | | | | | | | | | | | | | | | | |
| DIE LIST FOR IN-SITU WINDOW | J861-SD-IW-0025 | - | A | B | B | / | | | | | | | | | | | | | | | | | | | | |
| WINDOW LOCATION PLAN FOR IN-SITU WINDOW AT TOWER (1F) | J861-SD-IW-0100 | | - | - | - | / | | | | | | | | | | | | | | | | | | | | |
| WINDOW LOCATION PLAN FOR IN-SITU WINDOW AT TOWER (2F) | J861-SD-IW-0101 | - | A | B | B | C | / | | | | | | | | | | | | | | | | | | | |
| WINDOW LOCATION PLAN FOR IN-SITU WINDOW AT TOWER (3F-12F) | J861-SD-IW-0102 | - | A | A | A | A | / | | | | | | | | | | | | | | | | | | | |
| WINDOW LOCATION PLAN FOR IN-SITU WINDOW AT TOWER (15F-21F) | J861-SD-IW-0103 | - | - | A | A | B | / | | | | | | | | | | | | | | | | | | | |
| WINDOW LOCATION PLAN FOR IN-SITU WINDOW AT TOWER (22F-23F) | J861-SD-IW-0104 | - | - | A | A | B | / | | | | | | | | | | | | | | | | | | | |
| WINDOW LOCATION PLAN FOR IN-SITU WINDOW AT TOWER (25F) | J861-SD-IW-0105 | - | - | A | A | B | / | | | | | | | | | | | | | | | | | | | |
| WINDOW LOCATION PLAN FOR IN-SITU WINDOW AT TOWER (26F-30F) | J861-SD-IW-0106 | - | - | A | A | B | / | | | | | | | | | | | | | | | | | | | |
| WINDOW LOCATION PLAN FOR IN-SITU WINDOW AT TOWER (31F) | J861-SD-IW-0107 | - | - | A | A | B | / | | | | | | | | | | | | | | | | | | | |
| WINDOW LOCATION PLAN FOR IN-SITU WINDOW AT TOWER (32F) | J861-SD-IW-0108 | - | - | A | A | B | / | | | | | | | | | | | | | | | | | | | |
| WINDOW LOCATION PLAN FOR IN-SITU WINDOW AT TOWER (TMR) | J861-SD-IW-0109 | - | - | - | - | - | / | | | | | | | | | | | | | | | | | | | |
| WINDOW LOCATION PLAN FOR IN-SITU WINDOW AT TOWER (LRF & IRF) | J861-SD-IW-0110 | - | - | - | - | - | / | | | | | | | | | | | | | | | | | | | |
| WINDOW SCHEDULE FOR IN-SITU WINDOW | J861-SD-IW-1001 | - | - | A | B | B | / | | | | | | | | | | | | | | | | | | | |
| WINDOW SCHEDULE FOR IN-SITU WINDOW | J861-SD-IW-1002 | - | - | A | B | C | D | | | | | | | | | | | | | | | | | | | |
| WINDOW SCHEDULE FOR IN-SITU WINDOW | J861-SD-IW-1003 | - | - | A | B | C | D | | | | | | | | | | | | | | | | | | | |
| WINDOW SCHEDULE FOR IN-SITU WINDOW | J861-SD-IW-1004 | - | - | A | B | B | / | | | | | | | | | | | | | | | | | | | |
| WINDOW SCHEDULE FOR IN-SITU WINDOW | J861-SD-IW-1005 | - | - | A | A | A | / | | | | | | | | | | | | | | | | | | | |
| WINDOW SCHEDULE FOR IN-SITU WINDOW | J861-SD-IW-1006 | - | - | A | A | A | / | | | | | | | | | | | | | | | | | | | |
| WINDOW SCHEDULE FOR IN-SITU WINDOW | J861-SD-IW-1007 | - | - | - | - | - | / | | | | | | | | | | | | | | | | | | | |
| WINDOW SCHEDULE FOR IN-SITU WINDOW | J861-SD-IW-1008 | - | - | - | - | - | / | | | | | | | | | | | | | | | | | | | |
| WINDOW SCHEDULE FOR IN-SITU WINDOW | J861-SD-IW-1009 | - | - | - | - | - | / | | | | | | | | | | | | | | | | | | | |
| WINDOW SCHEDULE FOR IN-SITU WINDOW | J861-SD-IW-1010 | - | - | - | - | - | / | | | | | | | | | | | | | | | | | | | |
| WINDOW SCHEDULE FOR IN-SITU WINDOW | J861-SD-IW-1011 | - | - | - | - | - | / | | | | | | | | | | | | | | | | | | | |
| WINDOW SCHEDULE FOR IN-SITU WINDOW | J861-SD-IW-1012 | - | - | A | A | A | / | | | | | | | | | | | | | | | | | | | |
| WINDOW SCHEDULE FOR IN-SITU WINDOW | J861-SD-IW-1013 | - | - | A | A | A | / | | | | | | | | | | | | | | | | | | | |
| WINDOW SCHEDULE FOR IN-SITU WINDOW | J861-SD-IW-1014 | - | - | A | A | A | / | | | | | | | | | | | | | | | | | | | |
| WINDOW SCHEDULE FOR IN-SITU WINDOW | J861-SD-IW-1015 | | - | - | - | / | | | | | | | | | | | | | | | | | | | | |
| WINDOW SCHEDULE FOR IN-SITU WINDOW | J861-SD-IW-1016 | | - | - | - | / | | | | | | | | | | | | | | | | | | | | |
| WINDOW SCHEDULE FOR IN-SITU WINDOW | J861-SD-IW-1101 | - | - | A | A | / | | | | | | | | | | | | | | | | | | | | |
| WINDOW SCHEDULE FOR IN-SITU WINDOW | J861-SD-IW-1102 | - | - | A | A | / | | | | | | | | | | | | | | | | | | | | |
| WINDOW SCHEDULE FOR IN-SITU WINDOW | J861-SD-IW-1103 | - | - | A | A | / | | | | | | | | | | | | | | | | | | | | |
| WINDOW SCHEDULE FOR IN-SITU WINDOW | J861-SD-IW-1104 | - | - | A | A | / | | | | | | | | | | | | | | | | | | | | |
| TYPICAL DETAILS FOR IN-SITU WINDOW | J861-SD-IW-2001 | - | - | A | B | B | / | | | | | | | | | | | | | | | | | | | |
| TYPICAL DETAILS FOR IN-SITU WINDOW | J861-SD-IW-2002 | - | - | A | B | B | / | | | | | | | | | | | | | | | | | | | |
| TYPICAL DETAILS FOR IN-SITU WINDOW | J861-SD-IW-2003 | - | - | A | B | B | / | | | | | | | | | | | | | | | | | | | |
| TYPICAL DETAILS FOR IN-SITU WINDOW | J861-SD-IW-2004 | - | - | A | A | A | / | | | | | | | | | | | | | | | | | | | |

IN-HOUSE DESIGN CHECKER



Units 6-8, Sunray Industrial Centre, 1/F
 610 Cha Kwo Ling Road, Kowloon
 Tel:23489211-4 Fax:(852)27727666

DWG NO. : J861-SD-IW-0001 REV. : E

DRAWING SUBMISSION REGISTER





| PROJECT: PROPOSED RESIDENTIAL DEVELOPMENT AT NOS. 3-6 GLENEALY, CENTRAL, HONG KONG TITLE: SHOPDRAWING SUBMISSION FOR IN-SITU ALUM. WINDOW , LOUVRE & BI-FOLDING DOOR | DATE OF ISSUE | | | | | | | SUBMISSION STATE (FOR B.D / A.S.D) | | | SUBMISSION STATE (FOR CLIENT / CONSULTANT) | | | SUBMISSION STATE (FOR ARCHITECT) | | | FABRICATION / CONSTRUCTION STATE | | | | | | |
|--|------------------|-----------|----|----|----|----|----|---------------------------------------|--------------|------|---|--------------|------|-------------------------------------|--------------|------|----------------------------------|------|------------------|------|----------------------------|------|------|
| | ISSUE | 1 | 2 | 3 | 4 | 4a | 5 | AP - APPROVED | | | AP - APPROVED | | | AP - APPROVED | | | ISSUE TO CHINA OFFICE | | ISSUE TO SITE | | ISSUE TO SUB-CONTRACTOR | | |
| | DAY | 29 | 16 | 10 | 11 | 2 | 17 | AC - APPROVED SUB. TO CONDITION | | | AC - APPROVED SUB. TO CONDITION | | | AC - APPROVED SUB. TO CONDITION | | | | | | | | | |
| | MONTH | 7 | 8 | 10 | 11 | 12 | 2 | NA - NOT APPROVED | | | NA - NOT APPROVED | | | NA - NOT APPROVED | | | | | | | | | |
| | YEAR | 24 | 24 | 24 | 24 | 24 | 25 | | | | | | | | | | | | | | | | |
| DRAWING TITLE | DWG. NO. | REVISIONS | | | | | | | COMMENT DATE | REV. | STATE | COMMENT DATE | REV. | STATE | COMMENT DATE | REV. | STATE | REV. | DATE | REV. | DATE | REV. | DATE |
| TYPICAL DETAILS FOR IN-SITU WINDOW | J861-SD-IW-2005 | - | - | A | A | A | / | | | | | | | | | | | | | | | | |
| TYPICAL DETAILS FOR IN-SITU WINDOW | J861-SD-IW-2006 | - | - | A | A | A | / | | | | | | | | | | | | | | | | |
| TYPICAL DETAILS FOR IN-SITU WINDOW | J861-SD-IW-2007 | - | - | - | - | - | / | | | | | | | | | | | | | | | | |
| TYPICAL DETAILS FOR IN-SITU WINDOW | J861-SD-IW-2008 | - | - | - | - | - | / | | | | | | | | | | | | | | | | |
| TYPICAL DETAILS FOR IN-SITU WINDOW | J861-SD-IW-2009 | - | - | A | A | A | / | | | | | | | | | | | | | | | | |
| TYPICAL DETAILS FOR IN-SITU WINDOW | J861-SD-IW-2010 | - | - | A | A | A | / | | | | | | | | | | | | | | | | |
| TYPICAL DETAILS FOR IN-SITU WINDOW | J861-SD-IW-2011 | | | - | - | - | / | | | | | | | | | | | | | | | | |
| TYPICAL DETAILS FOR IN-SITU WINDOW | J861-SD-IW-2012 | | | - | - | - | / | | | | | | | | | | | | | | | | |
| TYPICAL DETAILS FOR IN-SITU WINDOW | J861-SD-IW-2101 | | - | A | B | B | / | | | | | | | | | | | | | | | | |
| TYPICAL DETAILS FOR IN-SITU WINDOW | J861-SD-IW-2101A | | - | A | B | B | / | | | | | | | | | | | | | | | | |
| TYPICAL DETAILS FOR IN-SITU WINDOW | J861-SD-IW-2102 | | - | A | B | B | / | | | | | | | | | | | | | | | | |
| TYPICAL DETAILS FOR IN-SITU WINDOW | J861-SD-IW-3001 | - | - | - | A | A | / | | | | | | | | | | | | | | | | |
| TYPICAL DETAILS FOR IN-SITU WINDOW | J861-SD-IW-3010 | | | - | - | - | / | | | | | | | | | | | | | | | | |
| TYPICAL DETAILS FOR IN-SITU WINDOW | J861-SD-IW-3011 | | | - | - | - | / | | | | | | | | | | | | | | | | |
| TYPICAL DETAILS FOR IN-SITU WINDOW | J861-SD-IW-3101 | | - | - | A | A | / | | | | | | | | | | | | | | | | |
| TYPICAL DETAILS FOR IN-SITU WINDOW | J861-SD-IW-3102 | | - | - | A | A | / | | | | | | | | | | | | | | | | |
| TYPICAL DETAILS FOR IN-SITU WINDOW | J861-SD-IW-3103 | | - | - | A | A | / | | | | | | | | | | | | | | | | |
| TYPICAL DETAILS FOR IN-SITU WINDOW | J861-SD-IW-4001 | - | - | - | - | - | / | | | | | | | | | | | | | | | | |

IN-HOUSE DESIGN CHECKER

美特鋁質有限公司
 MIDI ALUMINIUM FABRICATOR LTD.
 Units 6-8, Sunray Industrial Centre, 1/F
 610 Cha Kwo Ling Road, Kowloon
 Tel:23489211-4 Fax:(852)27727666

DWG NO. : J861-SD-IW-0002 REV. : E

| REQUIRE | | PROVIDED | |
|---------------|--------------|---------------|--------------|
| OPENABLE AREA | GLAZING AREA | OPENABLE AREA | GLAZING AREA |
| 0.388 | — | 0.712 | 0.602 |

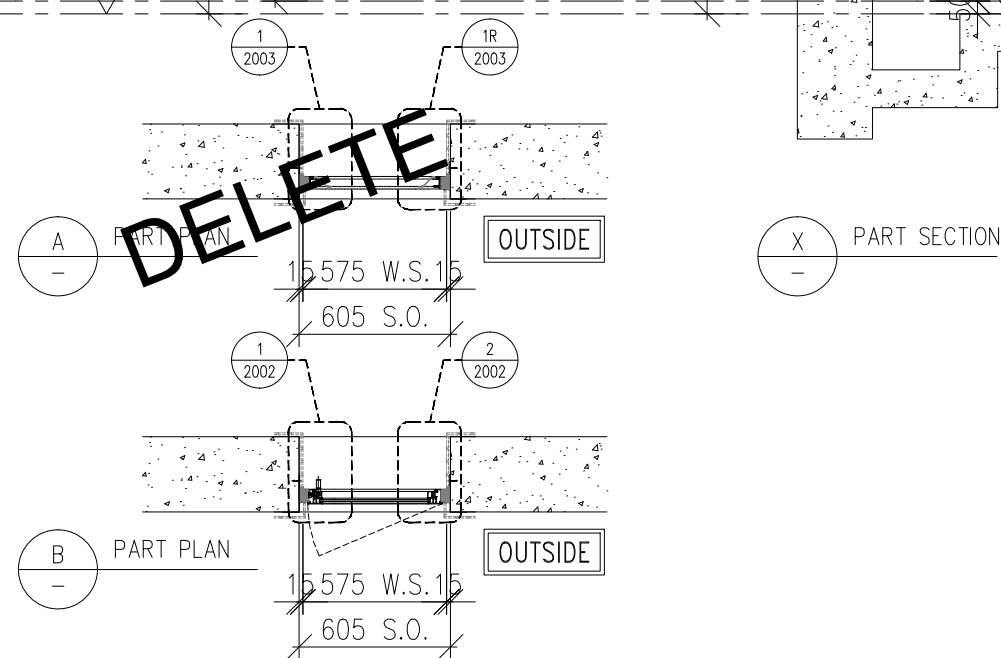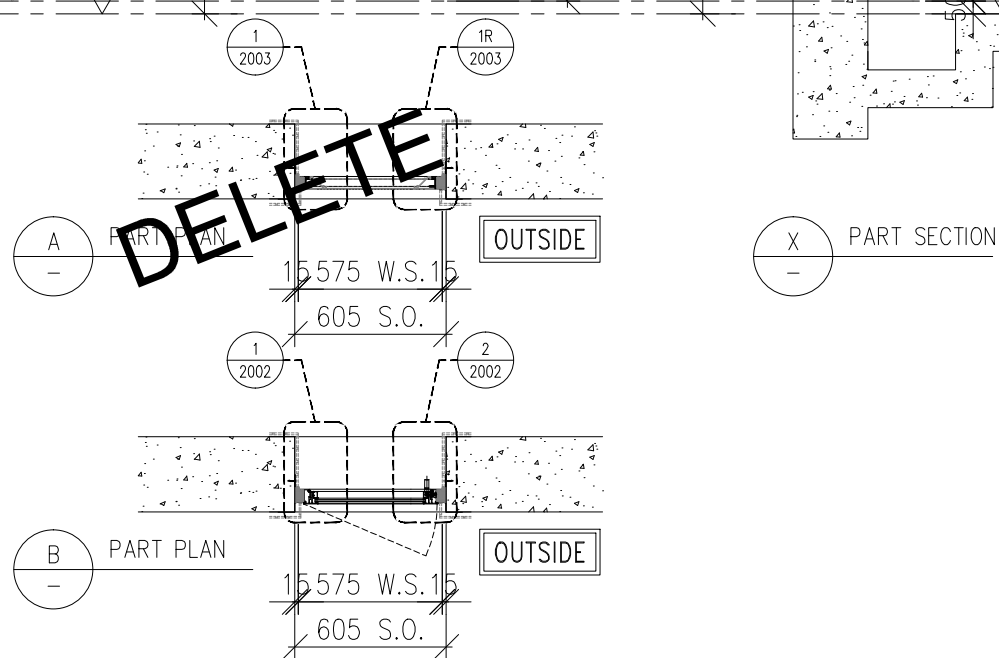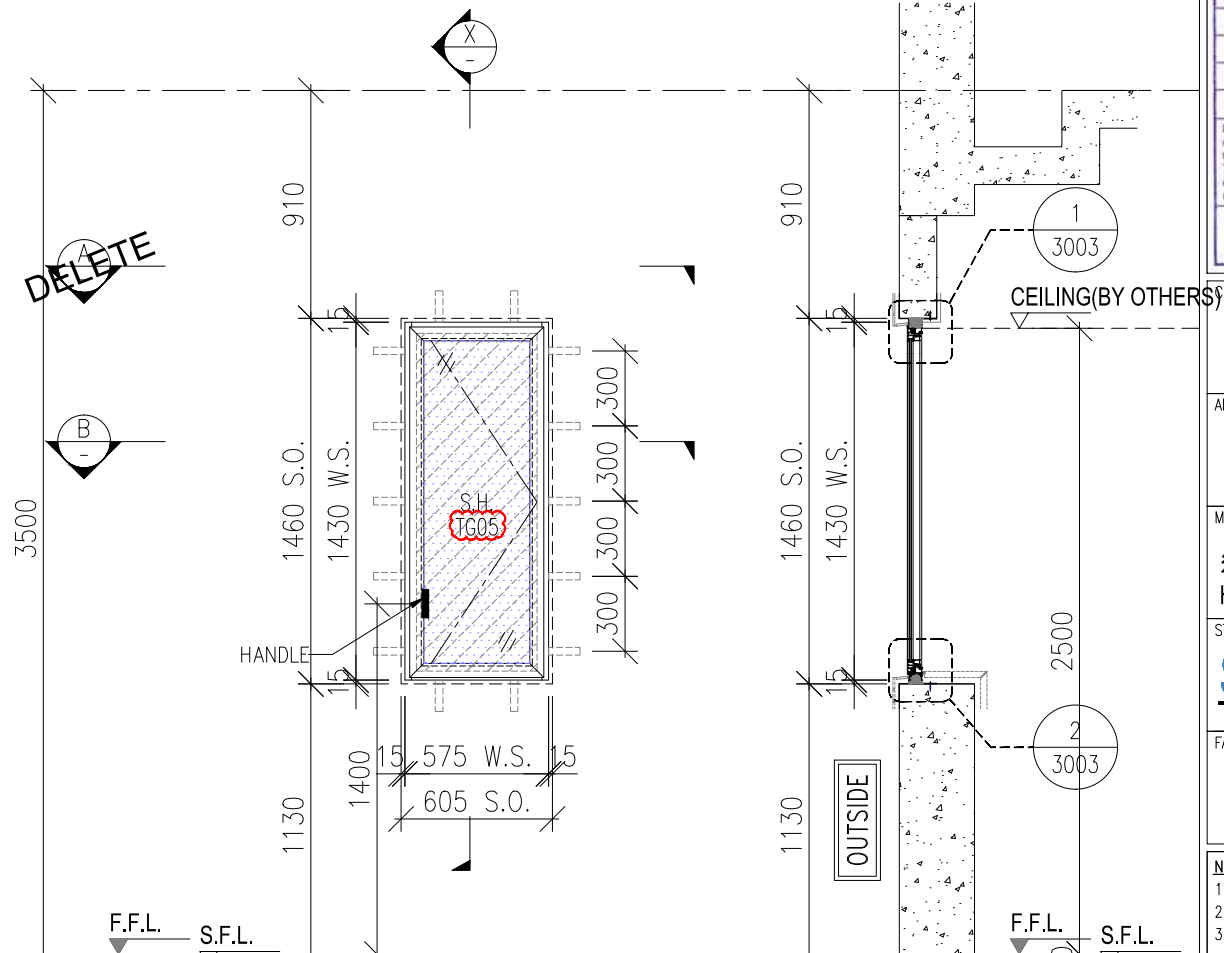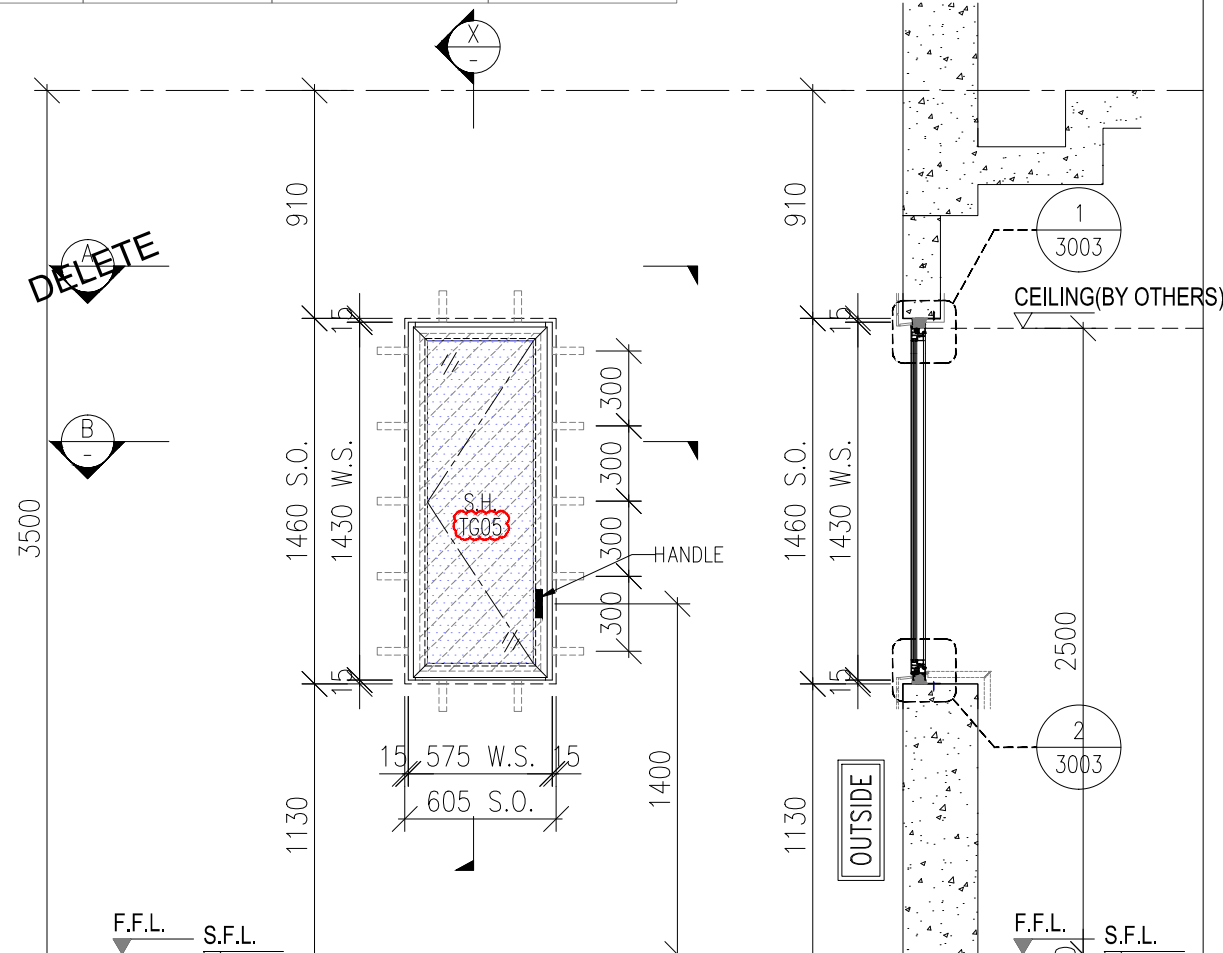

| | |
|--------------|---|
| WINDOW MARK | 8 nos. |
| LOCATION | (FLAT A J.S. BATH AT 25/F-30/F) |
| GLAZING | TG05 |
| WINDOW FRAME | 50mm ALUM. WINDOW SECTION , 4 BAR HINGE |

| | |
|--------------|--|
| WINDOW MARK | 8 nos. |
| LOCATION | (FLAT B J.S. BATH AT 25/F-30/F) (FLAT A J.S. BATH AT 31/F-32/F) |
| GLAZING | TG05 |
| WINDOW FRAME | 50mm ALUM. WINDOW SECTION , 4 BAR HINGE |

| | |
|---|------|
| B.D. REF : | |
| WONG TUNG & PARTNERS LTD. | |
| APPROVED | |
| APPROVED AS NOTED | |
| APPROVED AS NOTED & RESUBMIT | |
| RESUBMIT | |
| NO COMMENT | |
| REFER OTHER CONSULTANT'S COMMENTS | |
| Reviewed for compliance with the design intent. Comments made shall apply to all similar conditions & details, not just the ones cited. | |
| The approval shall not be construed as relieving the contractor for compliance with the contract documents & requirements. | |
| Reviewed By | Date |

| | |
|-----------------------|---|
| CLIENT : | Pacific Century Premium Developments 盈科大衍地產發展 |
| ARCHITECT : | WONG TUNG & PARTNERS LIMITED ARCHITECTS & PLANNERS |
| MAIN CONTRACTOR : | 顯利工程有限公司 HIEN LEE ENGINEERING CO., LTD. |
| STRUCTURAL ENGINEER : | SYW & ASSOCIATES LTD. SYW & ASSOCIATES LTD. |
| FACADE CONSULTANT : | |

- NOTE :
1. ALL DIMENSIONS ARE IN mm.
 2. ALL ELEVATIONS ARE VIEWED FROM OUTSIDE.
 3. ALL DIMENSIONS TO BE VERIFIED ON SITE BEFORE FABRICATION.
- LEGEND :
- x1 - DETAIL MARK NO.
 - x001 - REFER SHEET NO.
 - 1. F.F.L. -- FINISHED FLOOR LEVEL
 - 2. S.F.L. -- STRUCTURAL FLOOR LEVEL
 - 3. (R) -- REVERSED DETAIL
 - 4. F. -- FIXED WINDOW
 - 5. SH. -- TOP HUNG WINDOW
 - 6. (H) -- LOUVER
 - 7. GLASS LEGEND
 - TG01A2--SOUTH-EAST FACADE: LOW-E IGU-YKED160J (#2)
8mmHS CLEAR GLASS+12A+8mmT CLEAR GLASS
 - TG03--10mmT LIGHT GREY TINTED GLASS
 - TG04--8mmHS LIGHT GREY TINTED GLASS
 - TG05--8mmHS LIGHT GREY TINTED FROSTED GLASS
- GLAZING AREA (stippled pattern)
- OPENABLE AREA (hatched pattern)

| | | | |
|---|------------------|------------------|----|
| A | 19/09/2024 | GENERAL REVISION | MN |
| NO. | DATE | REVISED | BY |
| JOB NO. : J-861 | | | |
| PROJECT : PROPOSED RESIDENTIAL DEVELOPMENT AT NOS. 3-6 GLENEALY, CENTRAL, HONG KONG | | | |
| TITLE : WINDOW SCHEDULE FOR IN-SITU WINDOW | | | |
| DATE : 26-06-24 | SCALE : 1:30 @A3 | | |
| DRAWN BY : IVAN | CHECKED BY : | | |
| MIDI ALUMINIUM FABRICATOR LTD. Units 6-8, Sunray Industrial Centre, 1/F 610 Cha Kwo Ling Road, Kowloon Tel:23489211-4 Fax:(852)2727666 | | | |
| DWG NO. : J861-SD-IW-1003 | REV. : D | | |