



工程指示 / 要求簡箋 ENGINEER INSTRUCTIONS(E.I.)

工程指示編號:	EI- 8864	修改版本:	F
	HK- 0302		
工程編號:	J 861	工程名稱:	己連拿利
收件人:	生統/技術部	發件人:	細佬
工程項目:	幕牆	日期:	10/04/2025

<input type="checkbox"/> 原合約工程包	<input type="checkbox"/> 原合約工程加 / 減賬 QT-	<input type="checkbox"/> 新工程報價 QT-
---------------------------------	------------------------------------------	------------------------------------

信件批核號碼/圖紙參考編號:	批核模具圖紙編號:
客戶指示附件:	管理內部批簽署:

<input type="checkbox"/> 初步鋁料 B.M.	<input type="checkbox"/> 加工拆圖, 然後生產	<input type="checkbox"/> 尺寸表
<input type="checkbox"/> 正式鋁料 B.M.	<input type="checkbox"/> 技術上資料/指示	<input type="checkbox"/> 報價
<input type="checkbox"/> 配件 B.M.	<input type="checkbox"/> 樣辦或貨品說明書	<input type="checkbox"/> 分判合約
<input type="checkbox"/> 其他:		


內容: 給技術部: 看附頁回覆技術部顏色分布的資料 顏色編號: TM01 : Thunder Cloud(Grey) 興發色號:UCT554575XL-3(看EI8643),鋁板色號:UCT550041XLB-3(看EI8644) TM03 : 木紋色 編號LX01963MH(看EI8754) TM05 : Dark Grey 興發色號:UCT207124XL-3(看EI8295),鋁板色號:UCT206165XLA-3(看EI8644) TM06 : Brown 興發色號:UCT207123SC-3(看EI8643),鋁板色號:UCT814824SC-3(看EI8644)
完成上列要求日期: 23/04/2025

國內

<input type="checkbox"/> 生產技術總監	<input type="checkbox"/> 連附件	<input checked="" type="checkbox"/> 技術部	<input checked="" type="checkbox"/> 連附件	<input type="checkbox"/> 生產部	<input type="checkbox"/> 連附件
<input type="checkbox"/> 採購部	<input type="checkbox"/> 連附件	<input type="checkbox"/> 生產統籌部	<input type="checkbox"/> 連附件	<input type="checkbox"/> 報關組	<input type="checkbox"/> 連附件
<input type="checkbox"/> 質檢部	<input type="checkbox"/> 連附件	<input type="checkbox"/> 會計部	<input type="checkbox"/> 連附件	<input type="checkbox"/> 機械設計部	<input type="checkbox"/> 連附件
<input type="checkbox"/> 香港辦	<input type="checkbox"/> 連附件	<input type="checkbox"/> 其他:			


香港

<input type="checkbox"/> 行政部	<input type="checkbox"/> 連附件	<input type="checkbox"/> 會計部	<input type="checkbox"/> 連附件	<input type="checkbox"/> 統籌部	<input type="checkbox"/> 連附件	<input type="checkbox"/> 工程部	<input type="checkbox"/> 連附件
<input type="checkbox"/> 採購部	<input type="checkbox"/> 連附件	<input type="checkbox"/> QS部	<input type="checkbox"/> 連附件	<input type="checkbox"/> 地盤管理	<input type="checkbox"/> 連附件	<input type="checkbox"/> 維修部	<input type="checkbox"/> 連附件

*發件人簽署:	*組別成員批核簽署:
傳遞編號: HK-0302	項目經理簽署: 

# 大圖3001

铝板色号:UCT550041XLB-3 正确:TM01

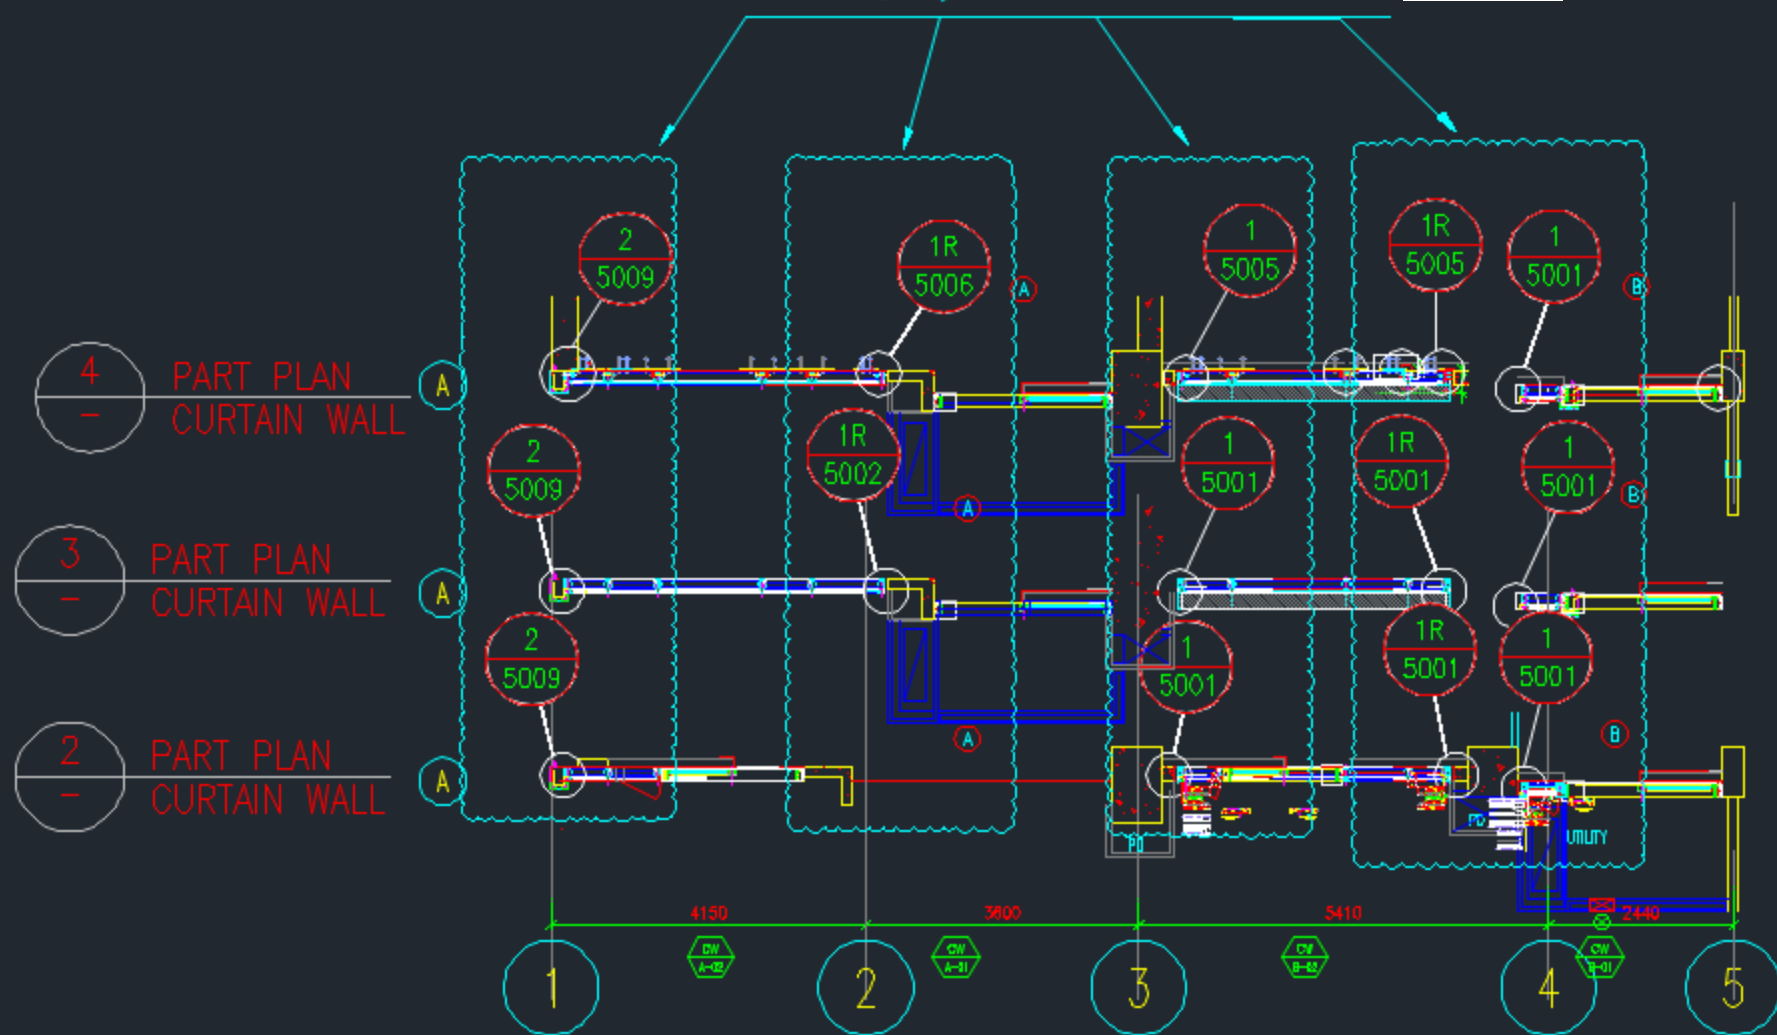


# 大圖3002

木紋色 正確: TM03


铝板色号  
UCT550041XLB-3

正確: TM01

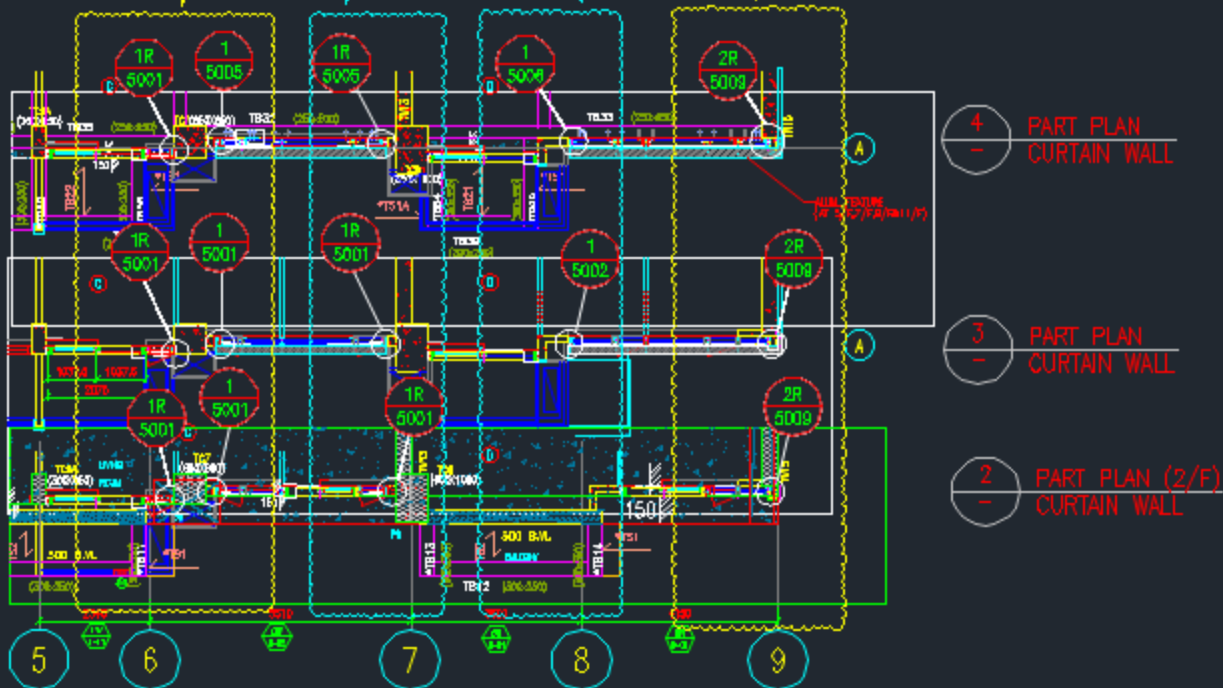

# 大圖3006

铝板色号:UCT206165XLA-3 正确:TM05

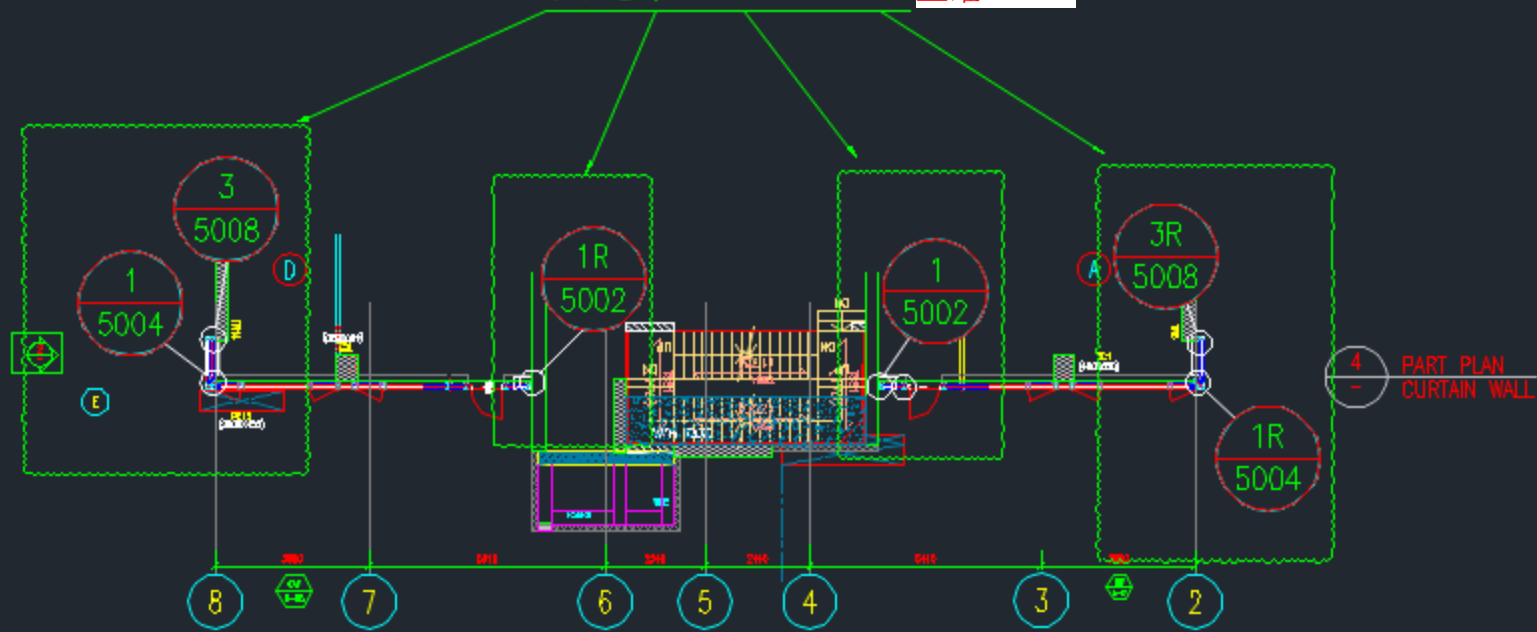


# 大圖3007

铝板色号:UCT206165XLA-3 正确:TM05

木纹色


正确:TM03

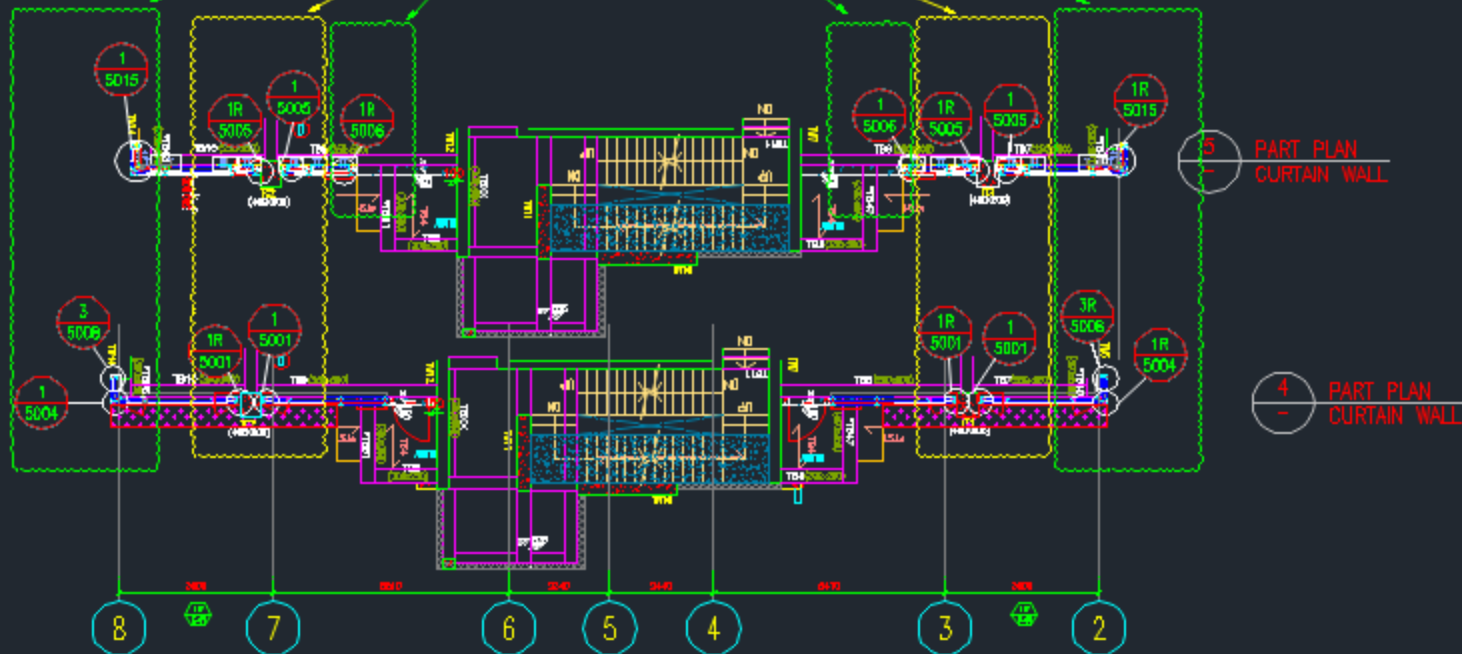

鋁板色號UCT206165XLA-3

正確:TM05

3/F

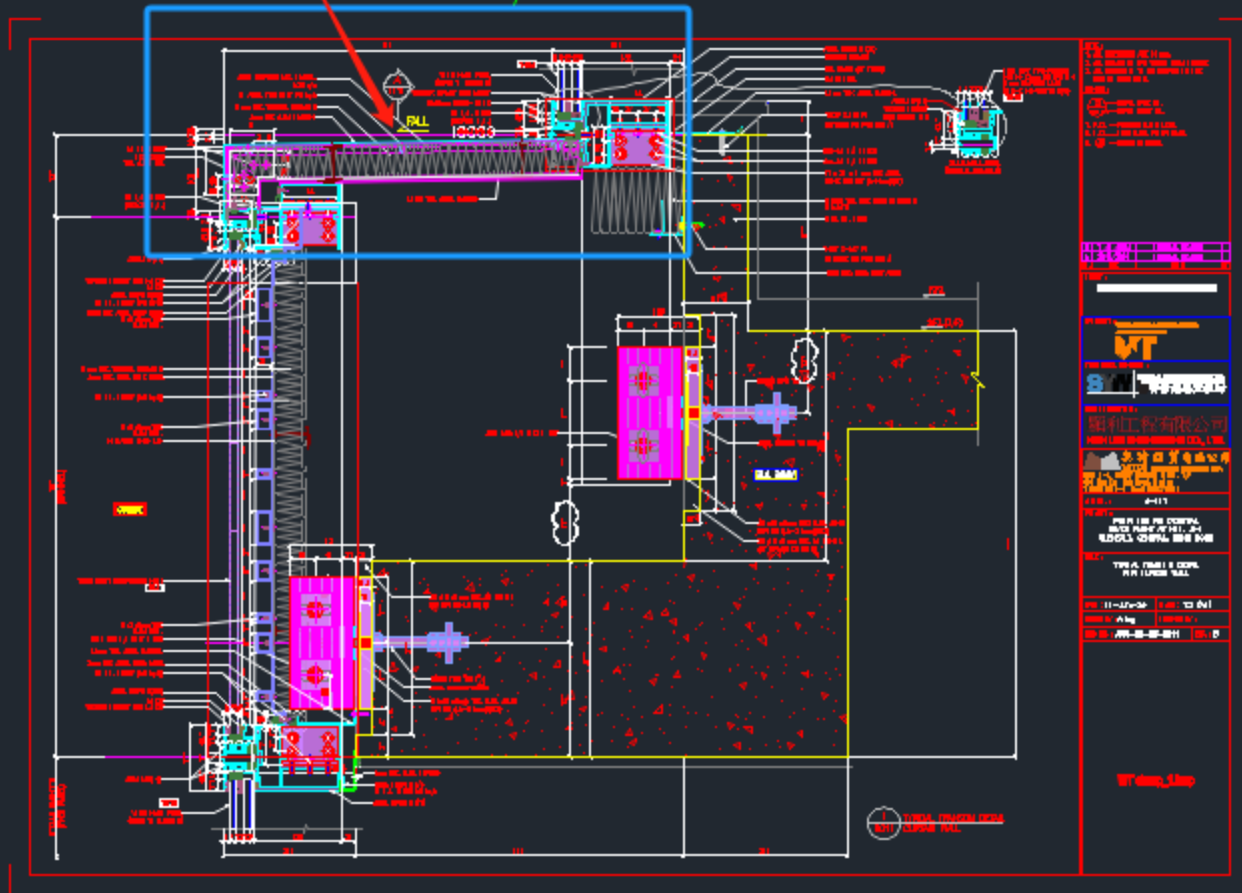

- 1. 請參閱本圖之說明書及零件目錄。
- 2. 本圖之說明書及零件目錄請向本公司索取。
- 3. 本圖之說明書及零件目錄請向本公司索取。
- 4. 本圖之說明書及零件目錄請向本公司索取。

1	2	3	4	5	6	7	8	9	10
1	2	3	4	5	6	7	8	9	10




陽和科技股份有限公司  
SUN HONG TECHNOLOGY CO., LTD.  
4-11

TYPE A, TYPE B, TYPE C, TYPE D, TYPE E, TYPE F, TYPE G, TYPE H, TYPE I, TYPE J, TYPE K, TYPE L, TYPE M, TYPE N, TYPE O, TYPE P, TYPE Q, TYPE R, TYPE S, TYPE T, TYPE U, TYPE V, TYPE W, TYPE X, TYPE Y, TYPE Z, TYPE AA, TYPE AB, TYPE AC, TYPE AD, TYPE AE, TYPE AF, TYPE AG, TYPE AH, TYPE AI, TYPE AJ, TYPE AK, TYPE AL, TYPE AM, TYPE AN, TYPE AO, TYPE AP, TYPE AQ, TYPE AR, TYPE AS, TYPE AT, TYPE AU, TYPE AV, TYPE AW, TYPE AX, TYPE AY, TYPE AZ, TYPE BA, TYPE BB, TYPE BC, TYPE BD, TYPE BE, TYPE BF, TYPE BG, TYPE BH, TYPE BI, TYPE BJ, TYPE BK, TYPE BL, TYPE BM, TYPE BN, TYPE BO, TYPE BP, TYPE BQ, TYPE BR, TYPE BS, TYPE BT, TYPE BU, TYPE BV, TYPE BW, TYPE BX, TYPE BY, TYPE BZ, TYPE CA, TYPE CB, TYPE CC, TYPE CD, TYPE CE, TYPE CF, TYPE CG, TYPE CH, TYPE CI, TYPE CJ, TYPE CK, TYPE CL, TYPE CM, TYPE CN, TYPE CO, TYPE CP, TYPE CQ, TYPE CR, TYPE CS, TYPE CT, TYPE CU, TYPE CV, TYPE CW, TYPE CX, TYPE CY, TYPE CZ, TYPE DA, TYPE DB, TYPE DC, TYPE DD, TYPE DE, TYPE DF, TYPE DG, TYPE DH, TYPE DI, TYPE DJ, TYPE DK, TYPE DL, TYPE DM, TYPE DN, TYPE DO, TYPE DP, TYPE DQ, TYPE DR, TYPE DS, TYPE DT, TYPE DU, TYPE DV, TYPE DW, TYPE DX, TYPE DY, TYPE DZ, TYPE EA, TYPE EB, TYPE EC, TYPE ED, TYPE EE, TYPE EF, TYPE EG, TYPE EH, TYPE EI, TYPE EJ, TYPE EK, TYPE EL, TYPE EM, TYPE EN, TYPE EO, TYPE EP, TYPE EQ, TYPE ER, TYPE ES, TYPE ET, TYPE EU, TYPE EV, TYPE EW, TYPE EX, TYPE EY, TYPE EZ, TYPE FA, TYPE FB, TYPE FC, TYPE FD, TYPE FE, TYPE FF, TYPE FG, TYPE FH, TYPE FI, TYPE FJ, TYPE FK, TYPE FL, TYPE FM, TYPE FN, TYPE FO, TYPE FP, TYPE FQ, TYPE FR, TYPE FS, TYPE XB, TYPE XC, TYPE XD, TYPE XE, TYPE XF, TYPE XG, TYPE XH, TYPE XI, TYPE XJ, TYPE XK, TYPE XL, TYPE XM, TYPE XN, TYPE XO, TYPE XP, TYPE XQ, TYPE XR, TYPE XS, TYPE XT, TYPE XU, TYPE XV, TYPE XW, TYPE XX, TYPE XY, TYPE XZ, TYPE YA, TYPE YB, TYPE YC, TYPE YD, TYPE YE, TYPE YF, TYPE YG, TYPE YH, TYPE YI, TYPE YJ, TYPE YK, TYPE YL, TYPE YM, TYPE YN, TYPE YO, TYPE YP, TYPE YQ, TYPE YR, TYPE YS, TYPE YT, TYPE YU, TYPE YV, TYPE YW, TYPE YX, TYPE YY, TYPE YZ, TYPE ZA, TYPE ZB, TYPE ZC, TYPE ZD, TYPE ZE, TYPE ZF, TYPE ZG, TYPE ZH, TYPE ZI, TYPE ZJ, TYPE ZK, TYPE ZL, TYPE ZM, TYPE ZN, TYPE ZO, TYPE ZP, TYPE ZQ, TYPE ZR, TYPE ZS, TYPE ZT, TYPE ZU, TYPE ZV, TYPE ZW, TYPE ZX, TYPE ZY, TYPE ZZ


WT class\_1.jpg

6011

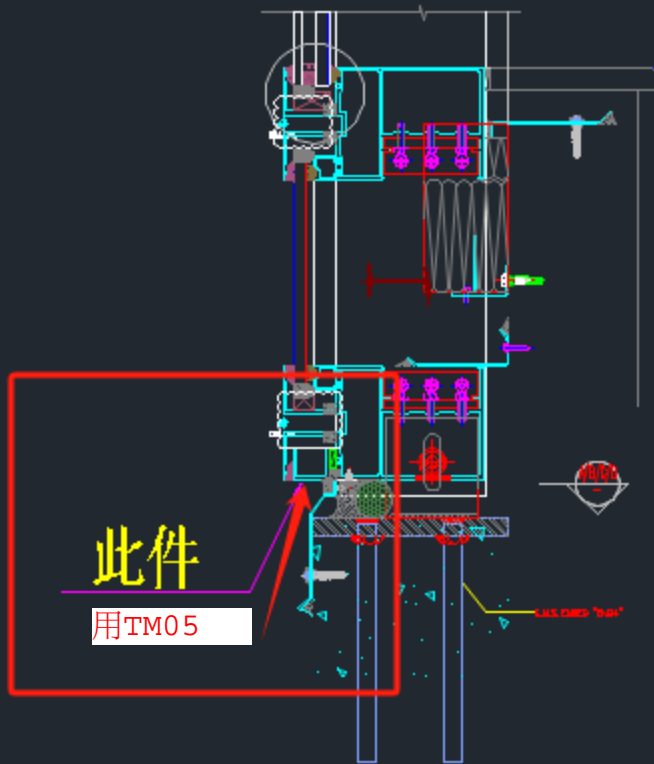

1  
6006

TYPICAL TRANSOM DETAIL  
CURTAIN WALL

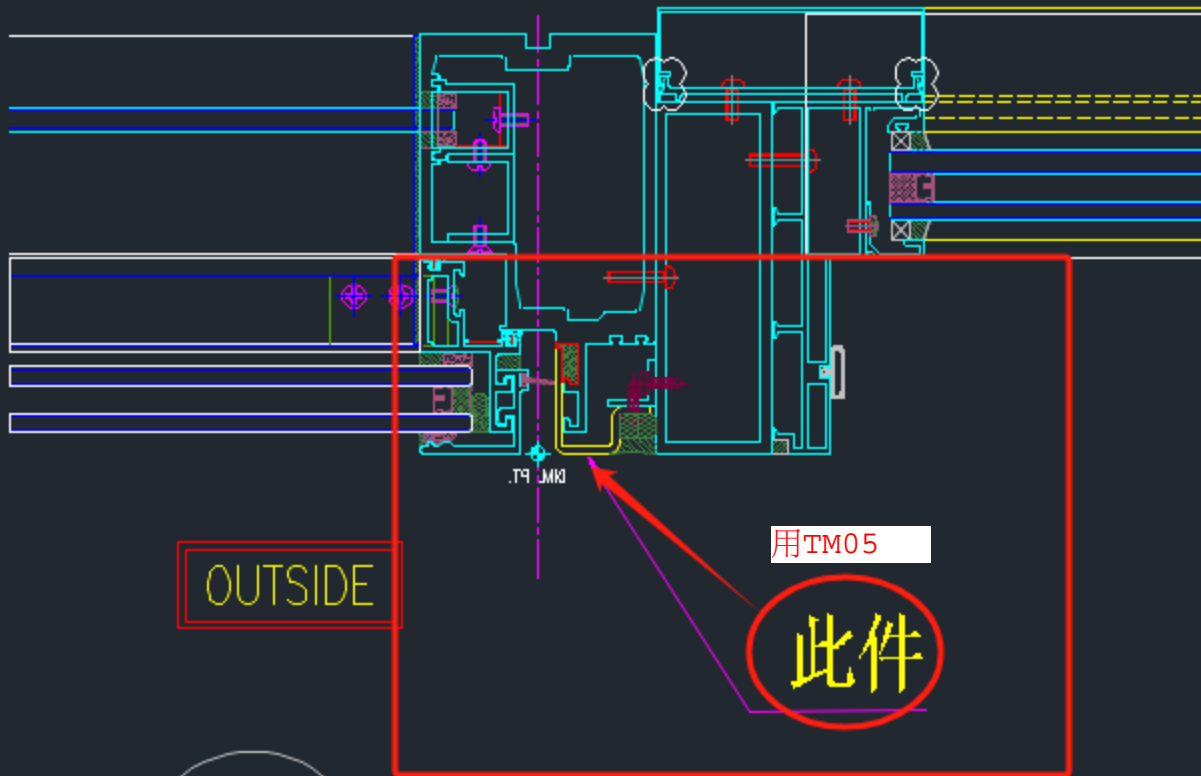

2  
5010

TYPICAL MULLION DETAIL  
CURTAIN WALL