



工程指示 / 要求簡箋 ENGINEER INSTRUCTIONS(E.I.)

| | | | |
|---------|----------|-------|------------|
| 工程指示編號: | EI- 8934 | 修改版本: | 1 |
| | HK- 0558 | | |
| 工程編號: | J 861 | 工程名稱: | 己連拿利 |
| 收件人: | 生統/技術部 | 發件人: | 細佬 |
| 工程項目: | 後裝窗趟門 | 日期: | 07/07/2025 |

| | | |
|---------------------------------|------------------------------------------|------------------------------------|
| <input type="checkbox"/> 原合約工程包 | <input type="checkbox"/> 原合約工程加 / 減賬 QT- | <input type="checkbox"/> 新工程報價 QT- |
|---------------------------------|------------------------------------------|------------------------------------|

| | |
|----------------|-----------|
| 信件批核號碼/圖紙參考編號: | 批核模具圖紙編號: |
| 客戶指示附件: | 管理內部批簽署: |

| | | |
|------------------------------------|-------------------------------------|-------------------------------|
| <input type="checkbox"/> 初步鋁料 B.M. | <input type="checkbox"/> 加工拆圖, 然後生產 | <input type="checkbox"/> 尺寸表 |
| <input type="checkbox"/> 正式鋁料 B.M. | <input type="checkbox"/> 技術上資料/指示 | <input type="checkbox"/> 報價 |
| <input type="checkbox"/> 配件 B.M. | <input type="checkbox"/> 樣辦或貨品說明書 | <input type="checkbox"/> 分判合約 |
| <input type="checkbox"/> 其他: | | |

| | |
|-----------|------------------------------------------------------------------------------|
| 內容: | 給技術部: 看附頁後裝窗趟門修改闊度(圖號: J861-SD-IW-1103), 請修改有關的加工圖 |
| | CAD文件在以下位置 J:\midi_sharepoint\Public\to_china\謝永林\J861\EI8934I_HK0558_CAD |
| 完成上列要求日期: | 16/07/2025 |

國內





| | | | | | |
|---------------------------------|------------------------------|-----------------------------------------|-----------------------------------------|--------------------------------|------------------------------|
| <input type="checkbox"/> 生產技術總監 | <input type="checkbox"/> 連附件 | <input checked="" type="checkbox"/> 技術部 | <input checked="" type="checkbox"/> 連附件 | <input type="checkbox"/> 生產部 | <input type="checkbox"/> 連附件 |
| <input type="checkbox"/> 採購部 | <input type="checkbox"/> 連附件 | <input type="checkbox"/> 生產統籌部 | <input type="checkbox"/> 連附件 | <input type="checkbox"/> 報關組 | <input type="checkbox"/> 連附件 |
| <input type="checkbox"/> 質檢部 | <input type="checkbox"/> 連附件 | <input type="checkbox"/> 會計部 | <input type="checkbox"/> 連附件 | <input type="checkbox"/> 機械設計部 | <input type="checkbox"/> 連附件 |
| <input type="checkbox"/> 香港辦 | <input type="checkbox"/> 連附件 | <input type="checkbox"/> 其他: | | | |

香港

| | | | | | | | |
|------------------------------|------------------------------|------------------------------|------------------------------|-------------------------------|------------------------------|------------------------------|------------------------------|
| <input type="checkbox"/> 行政部 | <input type="checkbox"/> 連附件 | <input type="checkbox"/> 會計部 | <input type="checkbox"/> 連附件 | <input type="checkbox"/> 統籌部 | <input type="checkbox"/> 連附件 | <input type="checkbox"/> 工程部 | <input type="checkbox"/> 連附件 |
| <input type="checkbox"/> 採購部 | <input type="checkbox"/> 連附件 | <input type="checkbox"/> QS部 | <input type="checkbox"/> 連附件 | <input type="checkbox"/> 地盤管理 | <input type="checkbox"/> 連附件 | <input type="checkbox"/> 維修部 | <input type="checkbox"/> 連附件 |

| | |
|---------|-----------------------------------------------------------------------------------------------|
| *發件人簽署: | *組別成員批核簽署: |
| 傳遞編號: | 項目經理簽署:  |

| REQUIRE | | PROVIDED | |
|---------------|--------------|---------------|--------------|
| OPENABLE AREA | GLAZING AREA | OPENABLE AREA | GLAZING AREA |
| - | - | (1.953) | (3.660) |

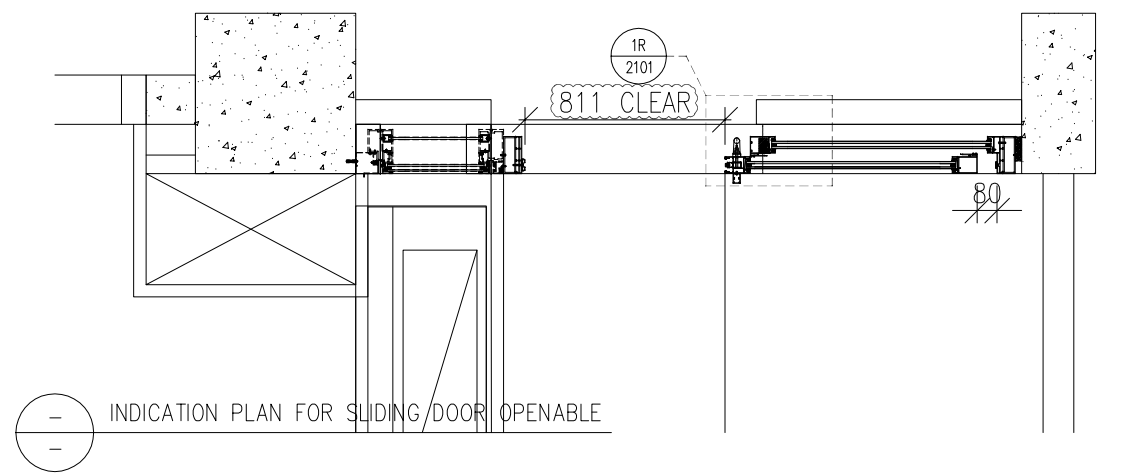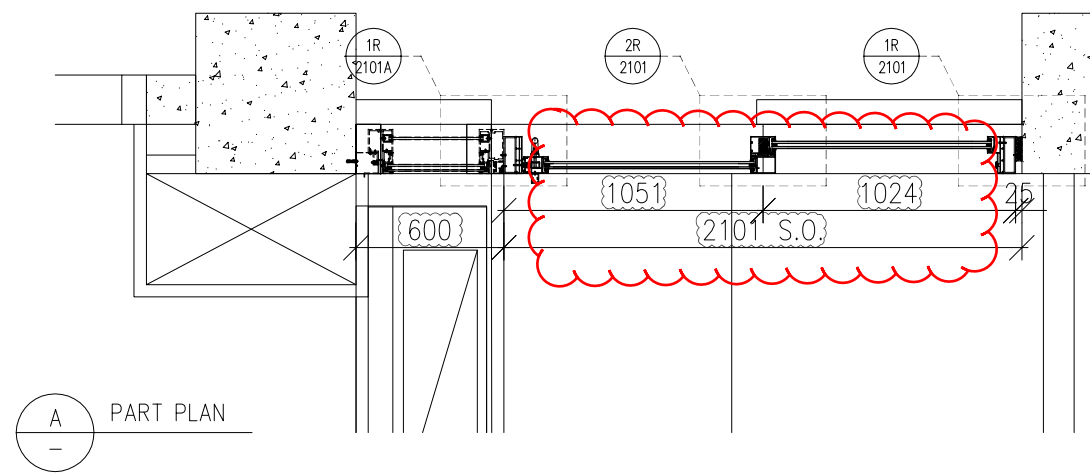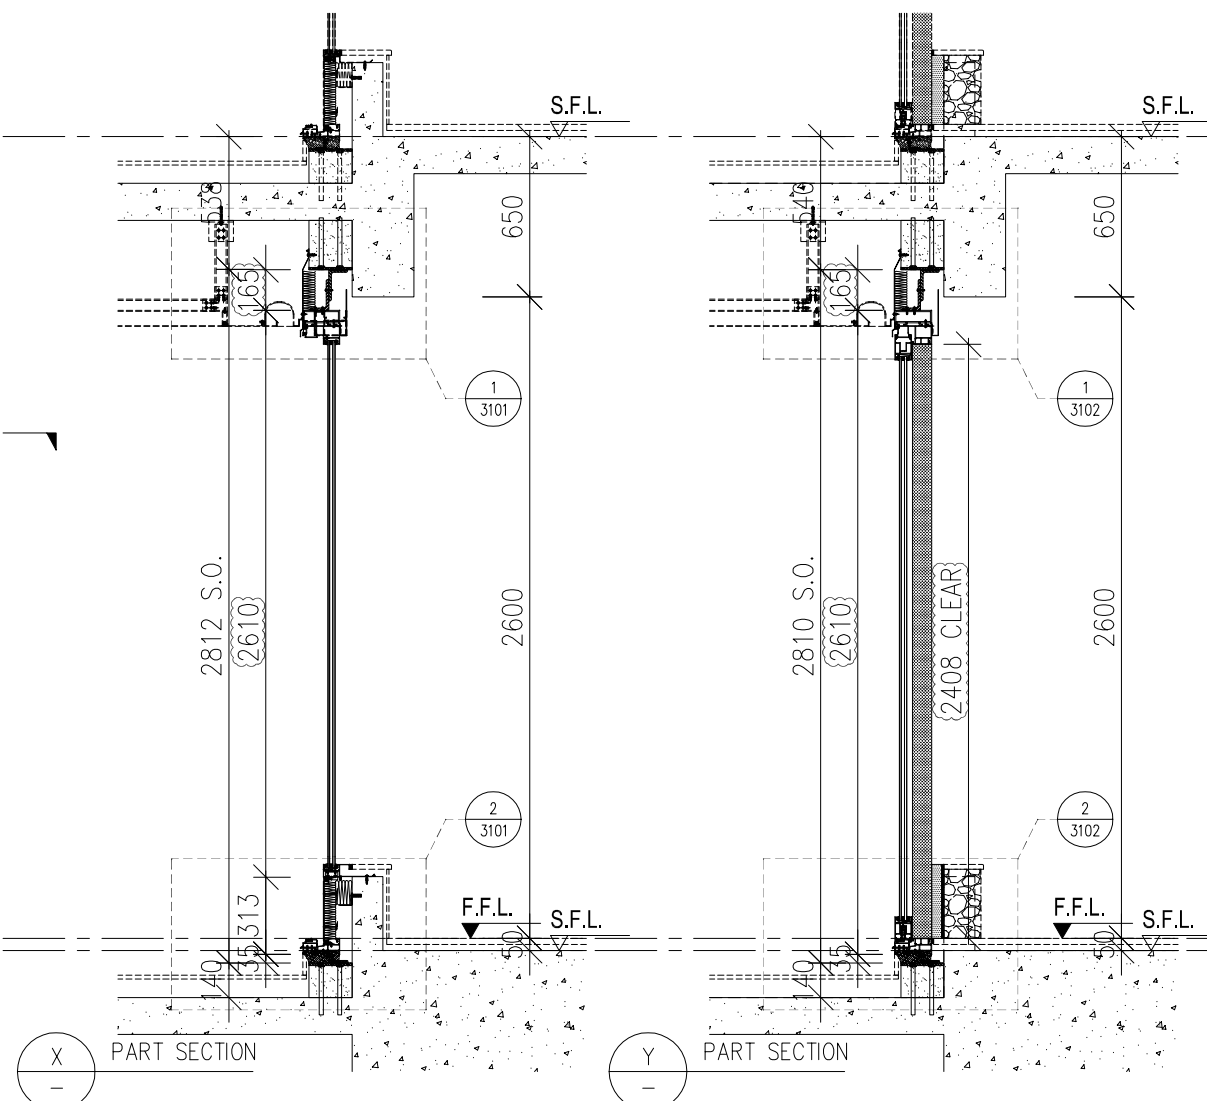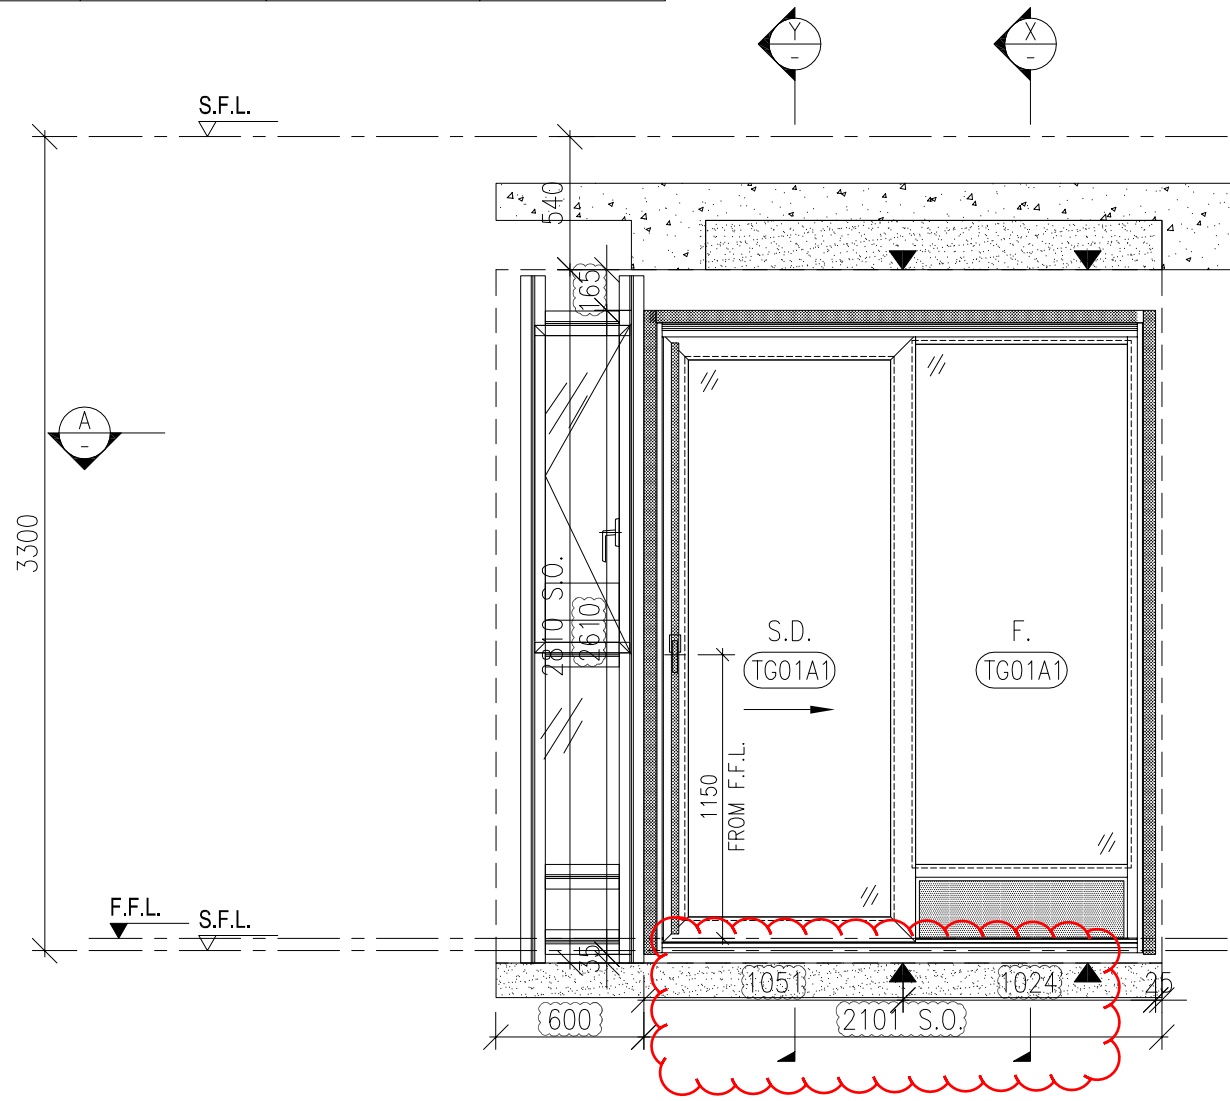

B.D. REF :

| | |
|--------------------------------------------------------------------------------------------------------------------------------------------------------------------------------------------------------------------------------------------------------------------|------|
| WONG TUNG & PARTNERS LTD. | |
| APPROVED | |
| APPROVED AS NOTED | |
| APPROVED AS NOTED & RESUBMIT | |
| RESUBMIT | |
| NO COMMENT | |
| REFER OTHER CONSULTANT'S COMMENTS | |
| Reviewed for compliance with the design intent. Comments made shall apply to all similar conditions & details, not just the ones cited. The approval shall not be construed as relieving the contractor for compliance with the contract documents & requirements. | |
| Reviewed By | Date |

CLIENT : Pacific Century Premium Developments 盈科大衍地產發展

ARCHITECT : WONG TUNG & PARTNERS LIMITED ARCHITECTS & PLANNERS

MAIN CONTRACTOR : 顯利工程有限公司 HIEN LEE ENGINEERING CO., LTD.

STRUCTURAL ENGINEER : SYW & ASSOCIATES LTD. 新豐信建築工程師

FAÇADE CONSULTANT:

NOTE :

- ALL DIMENSIONS ARE IN mm.
- ALL ELEVATIONS ARE VIEWED FROM OUTSIDE.
- ALL DIMENSIONS TO BE VERIFIED ON SITE BEFORE FABRICATION.

LEGEND :

X1 -- DETAIL MARK NO.
X001 -- REFER SHEET NO.

- F.F.L. -- FINISHED FLOOR LEVEL
- S.F.L. -- STRUCTURAL FLOOR LEVEL
- (R) -- REVERSED DETAIL
- F. -- FIXED WINDOW
- S. -- SLIDING DOOR
- GLASS LEGEND

TG01A1 -- SOUTH-EAST FAÇADE: LOW-E IGU-YKE0160J (#2)
8mmHS CLEAR GLASS+12A+10mmT CLEAR GLASS

| NO. | DATE | REVISION | BY |
|-----|------------|---------------------------|----|
| C | 26-02-2025 | REVISION TO ARCH. COMMENT | MN |
| B | 07-01-2025 | REVISION TO ARCH. COMMENT | MN |
| A | 29-10-2024 | DESIGN REVISED | MN |

JOB NO. : J-861

PROJECT : PROPOSED RESIDENTIAL DEVELOPMENT AT NOS. 3-6 GLENEALY, CENTRAL, HONG KONG

TITLE : WINDOW SCHEDULE FOR IN-SITU WINDOW

DATE : 26-06-24 SCALE : 1:30 @A3

DRAWN BY : IVAN CHECKED BY :

美特鋁質有限公司
MIDI ALUMINIUM FABRICATOR LTD.
Units 6-8, Sunray Industrial Centre, 1/F
610 Cha Kwo Ling Road, Kowloon
Tel:23489211-4 Fax:(852)2727666

DWG NO. : J861-SD-IW-1103 REV. : C

| | | |
|--------------|-------------------------------------|-------------------------------------|
| WINDOW MARK | 10 nos. | REVERSE SLIDING DOOR 10 nos. |
| LOCATION | (FLAT B LIVING ROOM AT 2/F TO 12/F) | (FLAT C LIVING ROOM AT 2/F TO 12/F) |
| GLAZING | TG01A1 | |
| WINDOW FRAME | 150mm ALUM. SLIDING DOOR SECTION | |