



工程指示 / 要求簡箋 ENGINEER INSTRUCTIONS(E.I.)

工程指示編號:	EI- 9013	修改版本:	D
	HK- 0920		
工程編號:	J 861	工程名稱:	己連拿利
收件人:	生統	發件人:	細佬
工程項目:	趟摺門	日期:	24/11/2025

<input type="checkbox"/> 原合約工程包	<input type="checkbox"/> 原合約工程加 / 減賬 QT-	<input type="checkbox"/> 新工程報價 QT-
---------------------------------	--	------------------------------------

信件批核號碼/圖紙參考編號:	批核模具圖紙編號:
客戶指示附件:	管理內部批簽署:

<input type="checkbox"/> 初步鋁料 B.M.	<input type="checkbox"/> 加工拆圖, 然後生產	<input type="checkbox"/> 尺寸表
<input type="checkbox"/> 正式鋁料 B.M.	<input type="checkbox"/> 技術上資料/指示	<input type="checkbox"/> 報價
<input type="checkbox"/> 配件 B.M.	<input type="checkbox"/> 樣辦或貨品說明書	<input type="checkbox"/> 分判合約
<input type="checkbox"/> 其他:		

內容: 附件的趟摺門尺寸地盤已經確定 可以按此尺寸去生產 備注: 11月24日地盤覆尺
完成上列要求日期: 29/12/2025

國內

<input type="checkbox"/> 生產技術總監	<input type="checkbox"/> 連附件	<input type="checkbox"/> 技術部	<input type="checkbox"/> 連附件	<input type="checkbox"/> 生產部	<input type="checkbox"/> 連附件
<input type="checkbox"/> 採購部	<input type="checkbox"/> 連附件	<input checked="" type="checkbox"/> 生產統籌部	<input checked="" type="checkbox"/> 連附件	<input type="checkbox"/> 報關組	<input type="checkbox"/> 連附件
<input type="checkbox"/> 質檢部	<input type="checkbox"/> 連附件	<input type="checkbox"/> 會計部	<input type="checkbox"/> 連附件	<input type="checkbox"/> 機械設計部	<input type="checkbox"/> 連附件
<input type="checkbox"/> 香港辦	<input type="checkbox"/> 連附件	<input type="checkbox"/> 其他:			


香港

<input type="checkbox"/> 行政部	<input type="checkbox"/> 連附件	<input type="checkbox"/> 會計部	<input type="checkbox"/> 連附件	<input type="checkbox"/> 統籌部	<input type="checkbox"/> 連附件	<input type="checkbox"/> 工程部	<input type="checkbox"/> 連附件
<input type="checkbox"/> 採購部	<input type="checkbox"/> 連附件	<input type="checkbox"/> QS部	<input type="checkbox"/> 連附件	<input type="checkbox"/> 地盤管理	<input type="checkbox"/> 連附件	<input type="checkbox"/> 維修部	<input type="checkbox"/> 連附件

*發件人簽署:	*組別成員批核簽署:
傳遞編號:	項目經理簽署: 

REQUIRE	PROVIDED
OPENABLE AREA	GLAZING AREA
13.01	11.7428

TRANSFER PLATE
1238
1960

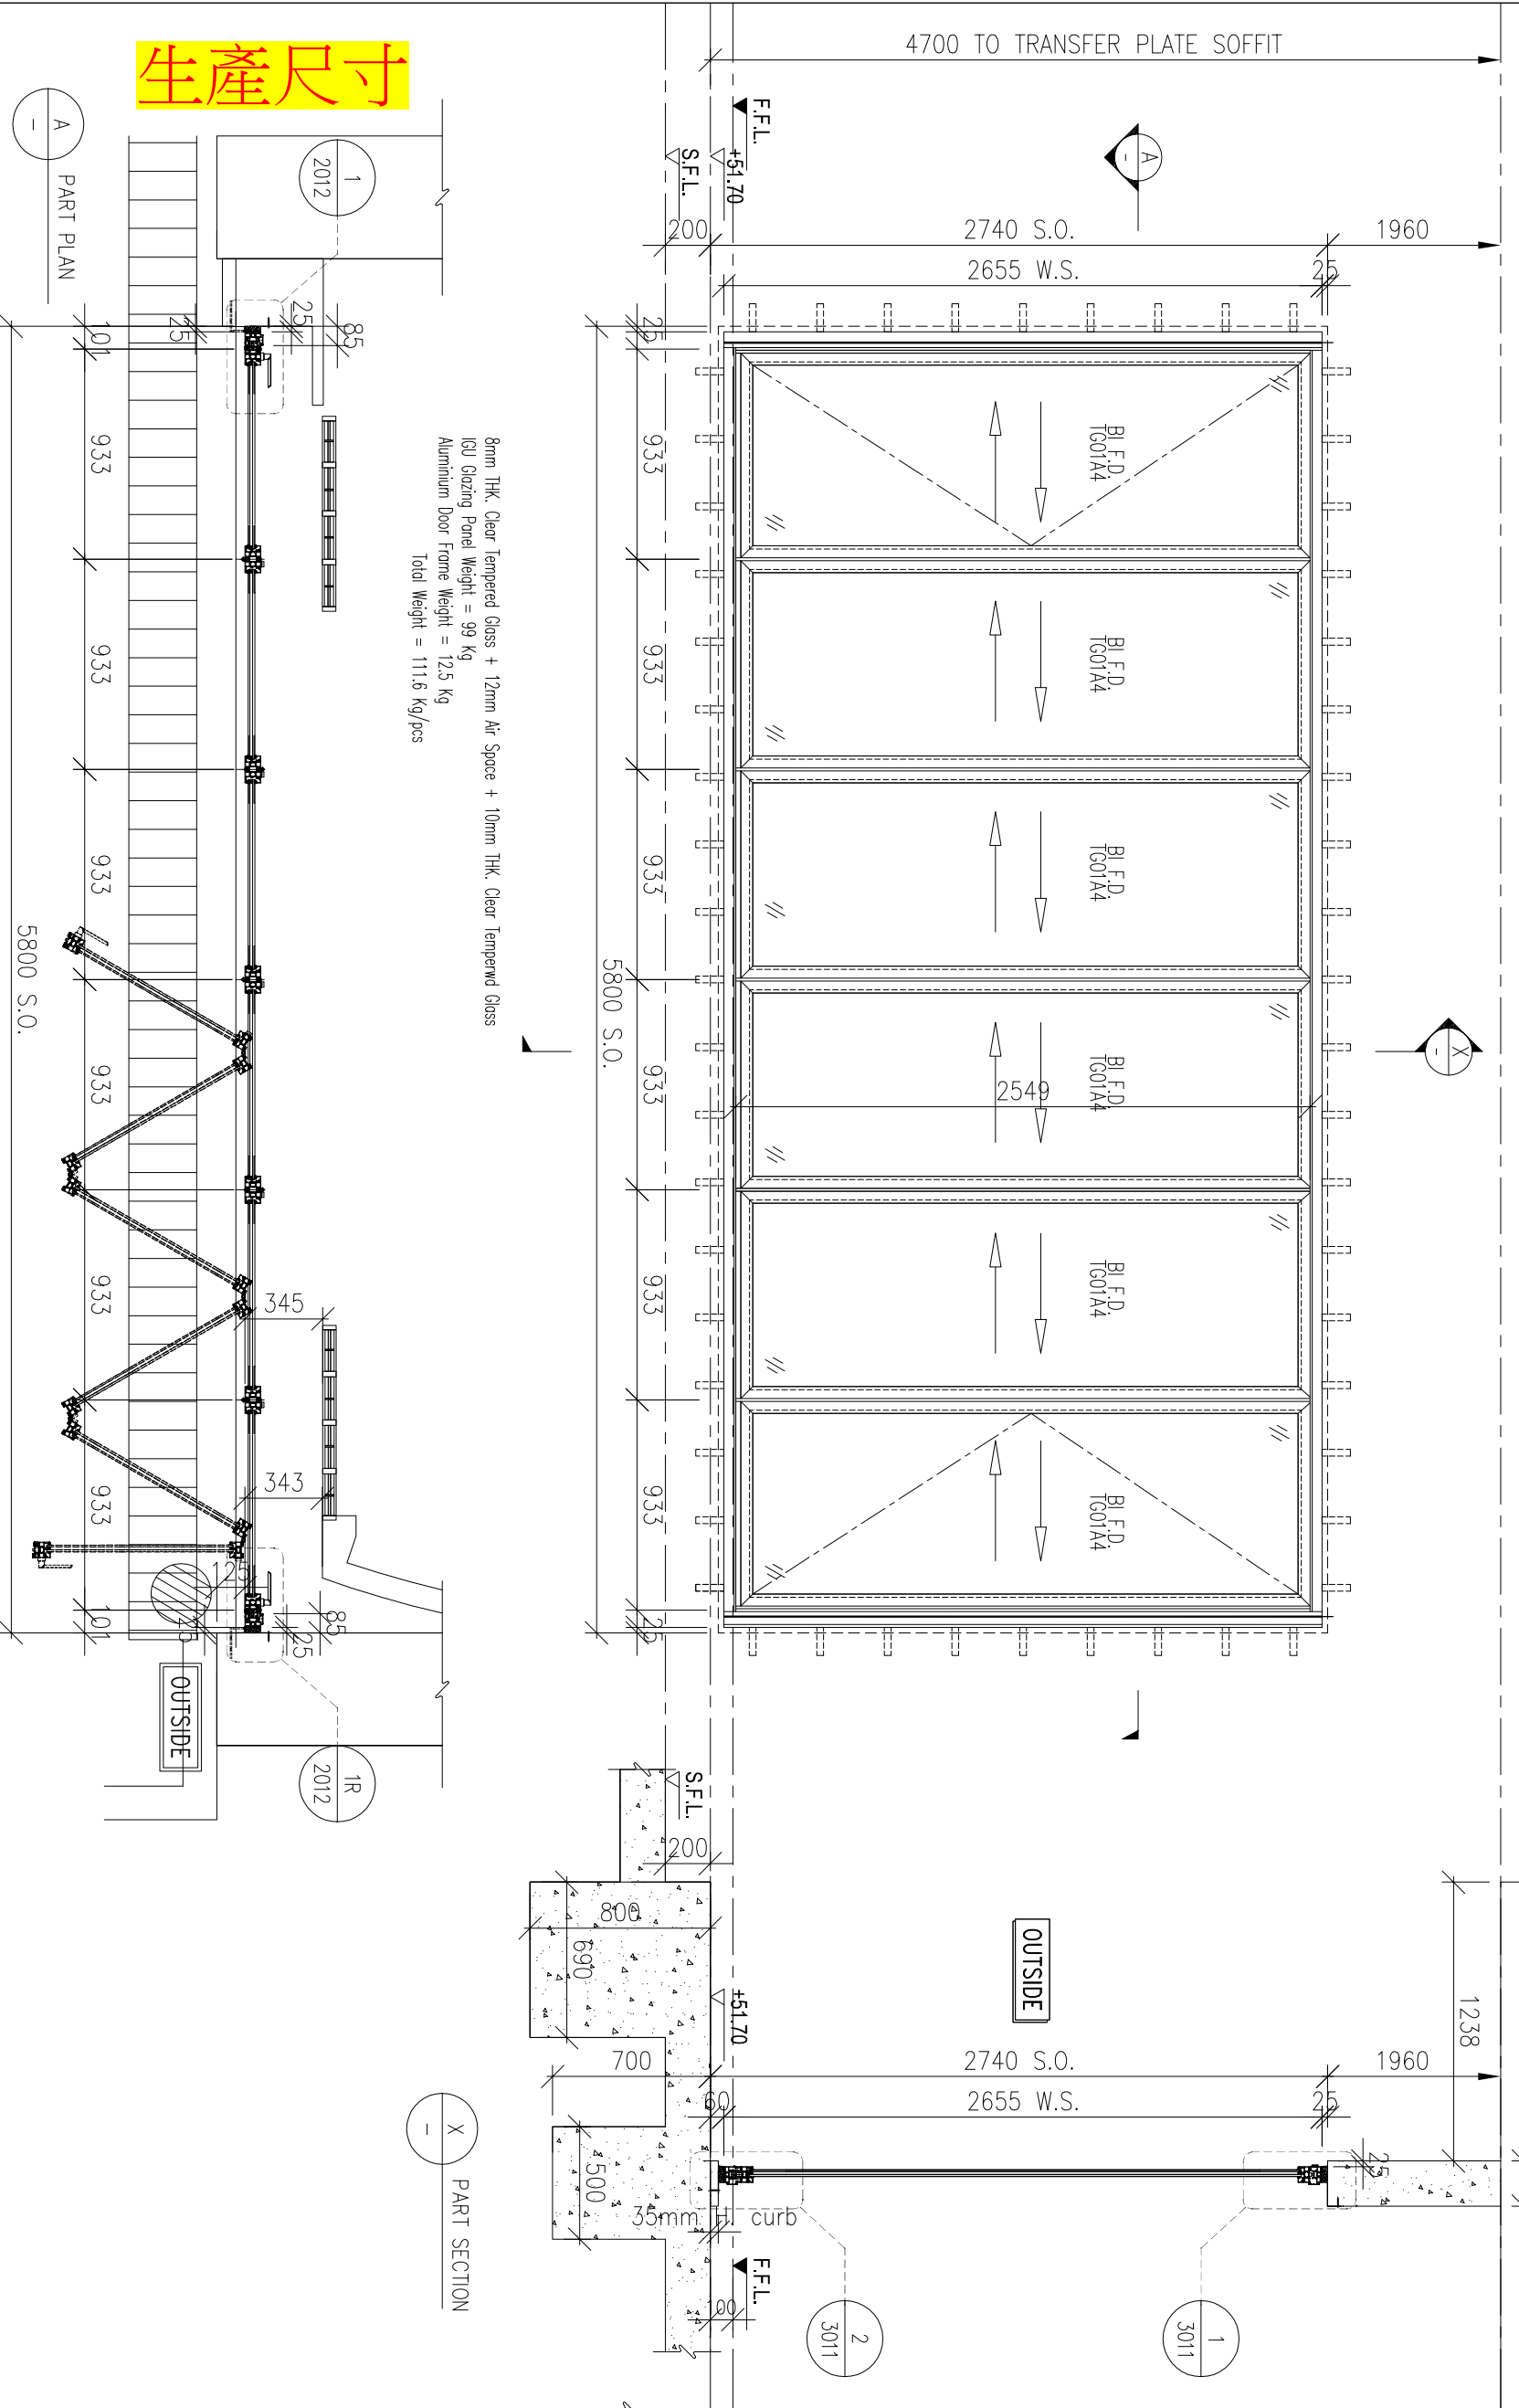

8mm THK. Clear Tempered Glass + 12mm Air Space + 10mm THK. Clear Tempered Glass
 IGU Glazing Panel Weight = 99 Kg
 Aluminium Door Frame Weight = 12.5 Kg
 Total Weight = 111.6 Kg/pcs

8mm THK. Clear Tempered Glass + 12mm Air Space + 10mm THK. Clear Tempered Glass
 IGU Glazing Panel Weight = 99 Kg
 Aluminium Door Frame Weight = 12.5 Kg
 Total Weight = 111.6 Kg/pcs

WINDOW MARK	W-17	1 no.
LOCATION	(FUNCTION ROOM 1 AT 1/F)	
GLAZING	TG01A4	
WINDOW FRAME	"SCHUCCO" ASS70 FD BI-FOLDING DOOR	

B.O. REF :	
WONG TUNG & PARTNERS LTD.	
APPROVED	
APPROVED AS NOTED & RESUBMIT	
NO COMMENT	
REFER OTHER CONSULTANT'S COMMENTS	
Reviewed By	Date

CLIENT :
Pacific Century
 Premium Developments
 盈科大樹地產發展

ARCHITECT :
WONG TUNG & PARTNERS LIMITED
 ARCHITECTS & PLANNERS

MAIN CONTRACTOR :
顯利工程有限公司
 HIEN LEE ENGINEERING CO., LTD.

STRUCTURAL ENGINEER :
SYW & ASSOCIATES LTD.
 STRUCTURAL ENGINEERS
SYW 邵賢偉建築工程師

FAÇADE CONSULTANT:

NOTE:
 1. ALL DIMENSIONS ARE IN mm.
 2. ALL ELEVATIONS ARE VIEWED FROM OUTSIDE.
 3. ALL DIMENSIONS TO BE VERIFIED ON SITE BEFORE FABRICATION.

LEGEND:
 (X1) DETAIL MARK NO.
 (X001) REFER SHEET NO.

1. F.F.L. -- FINISHED FLOOR LEVEL
 2. S.F.L. -- STRUCTURAL FLOOR LEVEL
 3. (R) -- REVERSED DETAIL
 4. F. -- FIXED WINDOW
 5. SH. -- TOP HING WINDOW
 6. -- LOUVER
 7. GLASS LEGEND

TO04--8mmHS CLEAR GLASS+12mm AIR SPACE+8mm FROSTED GLASS
 TO03--10mmHS CLEAR GLASS+12mm AIR SPACE+8mm FROSTED GLASS
 TO04--8mmHS LIGHT GREY TINTED GLASS
 TO05--8mmHS LIGHT GREY TINTED FROSTED GLASS

GLAZING AREA
 OPENABLE AREA

JOB NO. : J-861

PROJECT : PROPOSED RESIDENTIAL DEVELOPMENT AT NOS. 3-6 GLENVALE, CENTRAL, HONG KONG

TITLE : WINDOW SCHEDULE FOR IN-SITU WINDOW

DATE : 26-06-24 SCALE : 1:30 @A3
 DRAWN BY : IVAN CHECKED BY :

UNITED METAL FABRICATOR LTD.
 610 Ona Kwong Road, Kowloon
 Tel: 23489211-4 Fax: (852) 27277866
 DWG NO. : J861-SD-IW-1016 REV. :

11月24日地盤覆尺記錄作參考

FFIT


2750
2740 S.O.



1960

2655 W.S.

24/11/2025

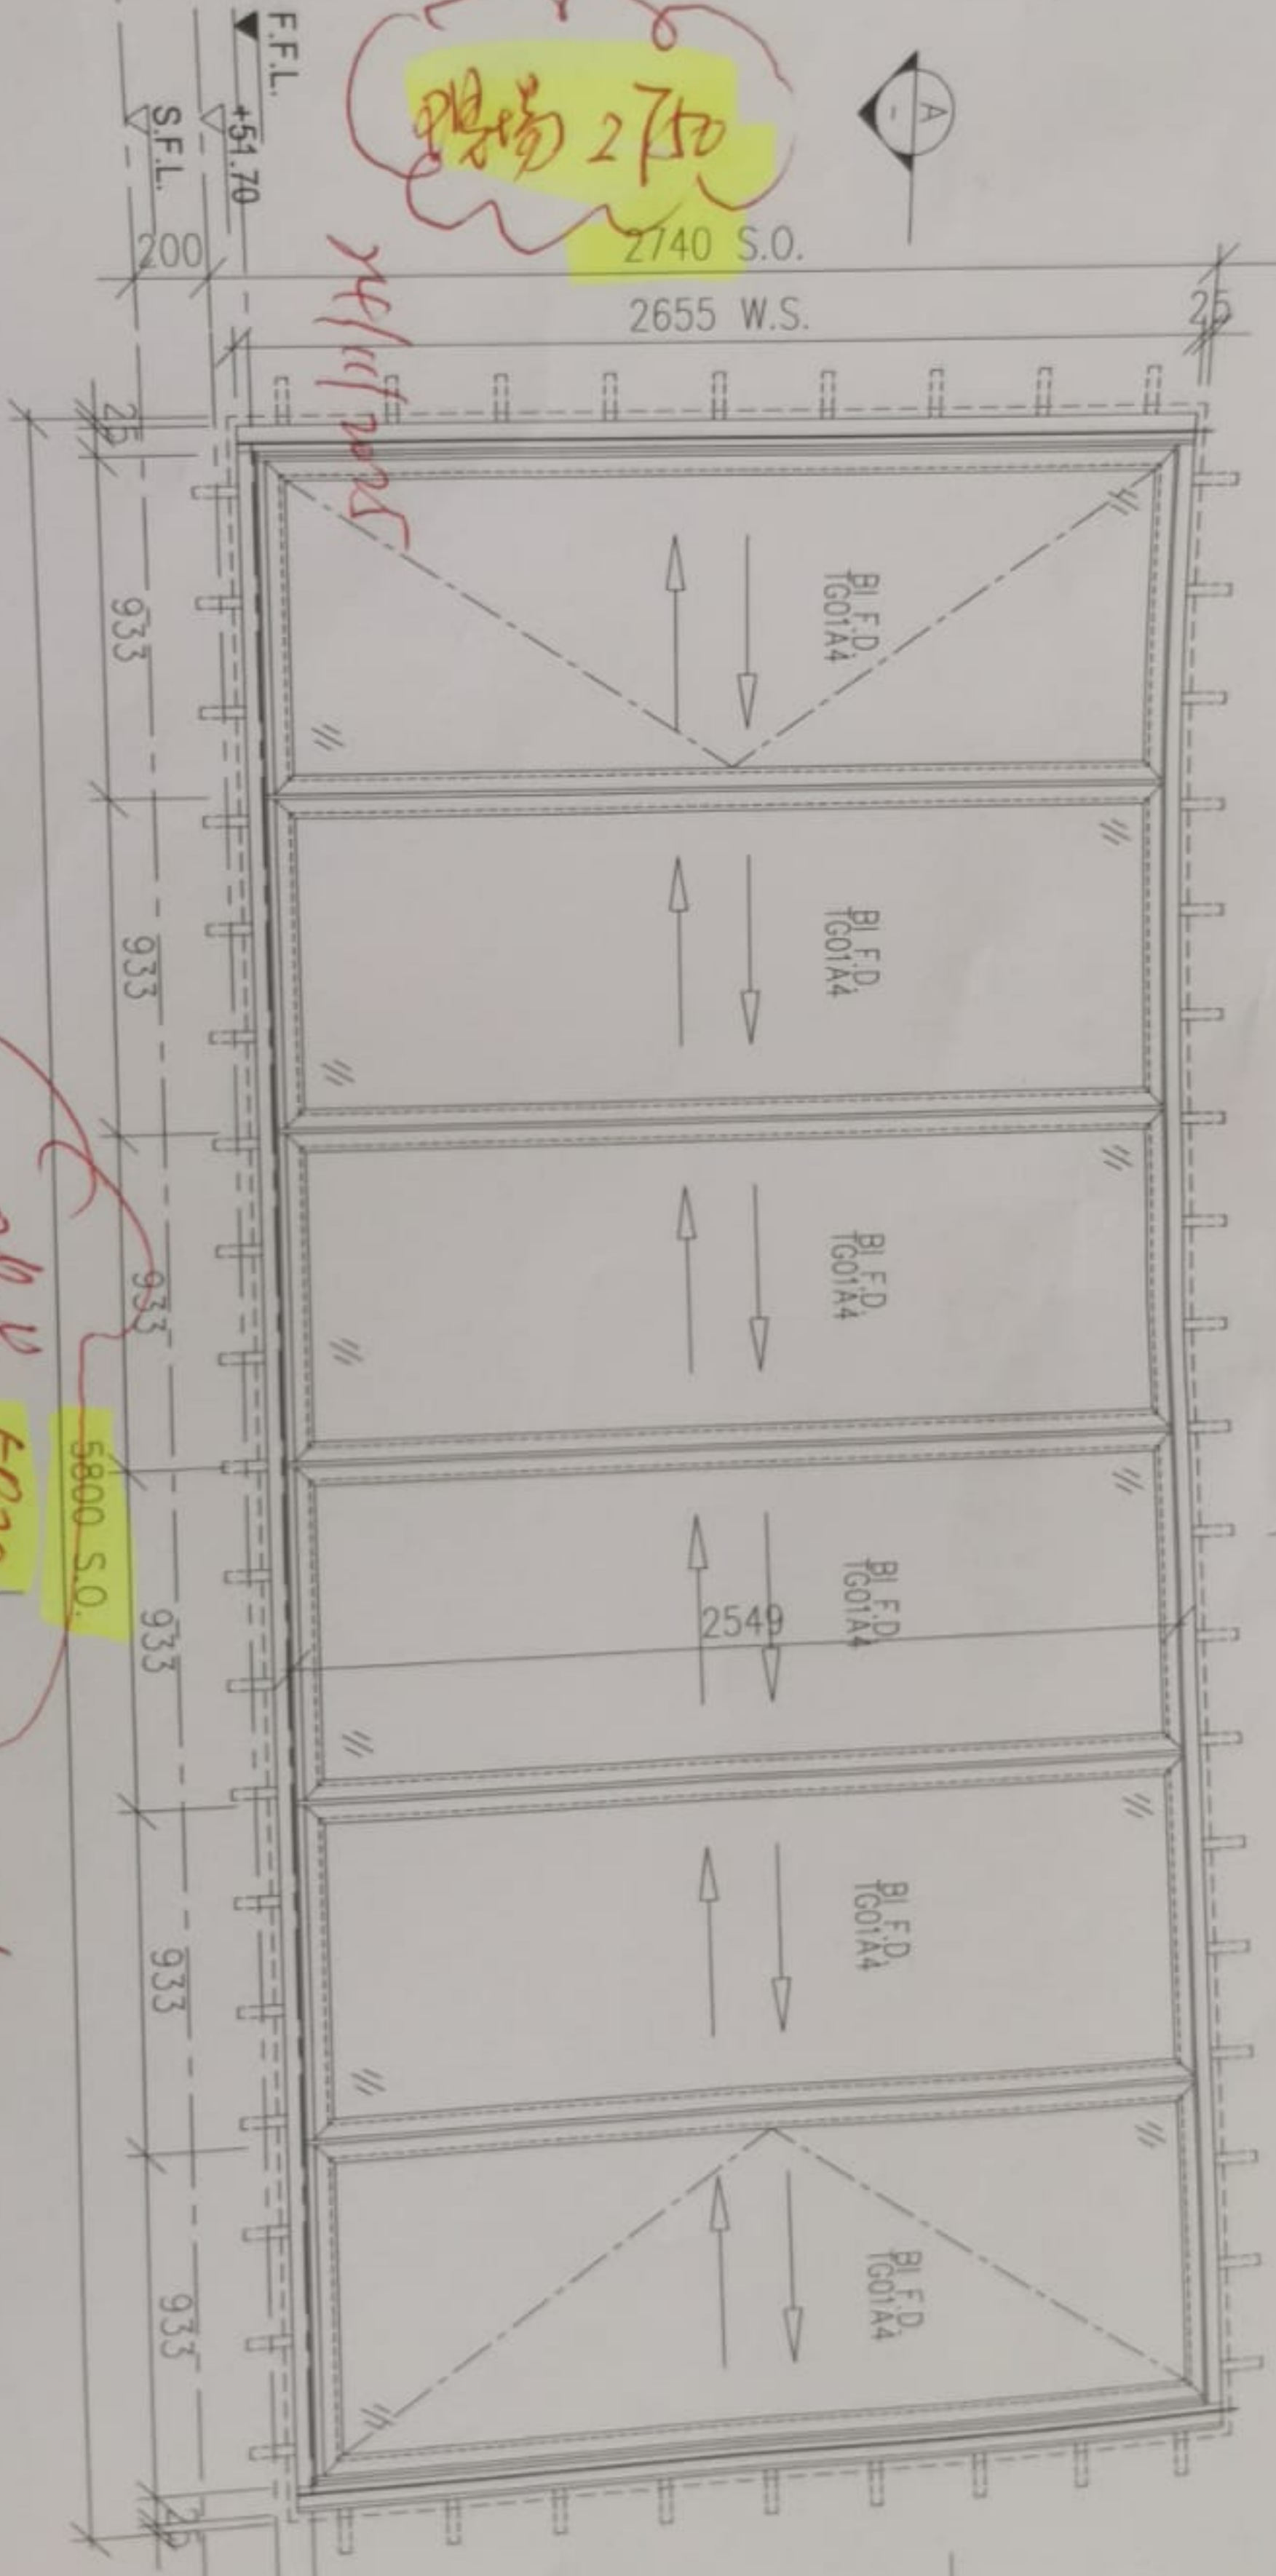

8mm THK. Clear Tempered Glass + 12mm Air Space + 10mm THK. Clear Tempered Glass
 IGU Glazing Panel Weight = 99 Kg
 Aluminum Door Frame Weight = 12.5 Kg
 Total Weight = 111.6 Kg/pcs

5820

5800 S.O.

24/11/2025

85