



工程指示 / 要求簡箋 ENGINEER INSTRUCTIONS(E.I.)

|         |          |       |            |
|---------|----------|-------|------------|
| 工程指示編號: | EI- 9030 | 修改版本: | -          |
|         | HK- 0590 |       |            |
| 工程編號:   | J 861    | 工程名稱: | 己連拿利       |
| 收件人:    | 生統/技術部   | 發件人:  | 細佬         |
| 工程項目:   | 幕牆       | 日期:   | 14/07/2025 |

|                                 |  |                                    |
|---------------------------------|--|------------------------------------|
| <input type="checkbox"/> 原合約工程包 | <input type="checkbox"/> 原合約工程加 / 減脹 QT- | <input type="checkbox"/> 新工程報價 QT- |
|---------------------------------|--|------------------------------------|

|                |           |
|----------------|-----------|
| 信件批核號碼/圖紙參考編號: | 批核模具圖紙編號: |
| 客戶指示附件:        | 管理內部批簽署:  |

|                                    |                                     |                               |
|------------------------------------|-------------------------------------|-------------------------------|
| <input type="checkbox"/> 初步鋁料 B.M. | <input type="checkbox"/> 加工拆圖, 然後生產 | <input type="checkbox"/> 尺寸表  |
| <input type="checkbox"/> 正式鋁料 B.M. | <input type="checkbox"/> 技術上資料/指示   | <input type="checkbox"/> 報價   |
| <input type="checkbox"/> 配件 B.M.   | <input type="checkbox"/> 樣辦或貨品說明書   | <input type="checkbox"/> 分判合約 |
| <input type="checkbox"/> 其他:       |                                     |                               |

|  |
|--|
| 內容:<br>給技術部: 看附頁回覆技術部顏色的問題<br>在26至30樓近軸線4, 加橫料和背板, 看[修改表示1]<br><br>CAD文件在以下位置<br>J:\midi_sharepoint\Public\to_china\謝永林\J861\EI9030_HK0590_CAD |
| 完成上列要求日期: 12/08/2025   |

國內

|                                 |                              |   |   |                                |                              |
|---------------------------------|------------------------------|---|---|--------------------------------|------------------------------|
| <input type="checkbox"/> 生產技術總監 | <input type="checkbox"/> 連附件 | <input checked="" type="checkbox"/> 技術部 | <input checked="" type="checkbox"/> 連附件 | <input type="checkbox"/> 生產部   | <input type="checkbox"/> 連附件 |
| <input type="checkbox"/> 採購部    | <input type="checkbox"/> 連附件 | <input type="checkbox"/> 生產統籌部          | <input type="checkbox"/> 連附件            | <input type="checkbox"/> 報關組   | <input type="checkbox"/> 連附件 |
| <input type="checkbox"/> 質檢部    | <input type="checkbox"/> 連附件 | <input type="checkbox"/> 會計部            | <input type="checkbox"/> 連附件            | <input type="checkbox"/> 機械設計部 | <input type="checkbox"/> 連附件 |
| <input type="checkbox"/> 香港辦    | <input type="checkbox"/> 連附件 | <input type="checkbox"/> 其他:            |   |                                |                              |

香港

|                              |                              |                              |                              |                               |                              |                              |                              |
|------------------------------|------------------------------|------------------------------|------------------------------|-------------------------------|------------------------------|------------------------------|------------------------------|
| <input type="checkbox"/> 行政部 | <input type="checkbox"/> 連附件 | <input type="checkbox"/> 會計部 | <input type="checkbox"/> 連附件 | <input type="checkbox"/> 統籌部  | <input type="checkbox"/> 連附件 | <input type="checkbox"/> 工程部 | <input type="checkbox"/> 連附件 |
| <input type="checkbox"/> 採購部 | <input type="checkbox"/> 連附件 | <input type="checkbox"/> QS部 | <input type="checkbox"/> 連附件 | <input type="checkbox"/> 地盤管理 | <input type="checkbox"/> 連附件 | <input type="checkbox"/> 維修部 | <input type="checkbox"/> 連附件 |

|         |   |
|---------|---|
| *發件人簽署: | *組別成員批核簽署:  |
| 傳遞編號:   | 項目經理簽署:  |

◆ = RESTRAINT SOCKET

TM03

木紋色方向

TM05

TM05

大圖3008

木紋色方向

TM05

TM03

TM05

TM03

木紋色方向

木紋色方向

TM05

TM05

大圖3008

TM05

TM05

2 PART ELEVATION CURTAIN WALL

REFER DRAWING 481-20-CV-1/3007



1 PART ELEVATION CURTAIN WALL


3 PART ELEVATION CURTAIN WALL

RESTRAINT SOCKET AT 21/F

RESTRAINT SOCKET AT 15/F (18/F & 21/F ONLY)

RESTRAINT SOCKET AT 15/F (18/F & 21/F ONLY)

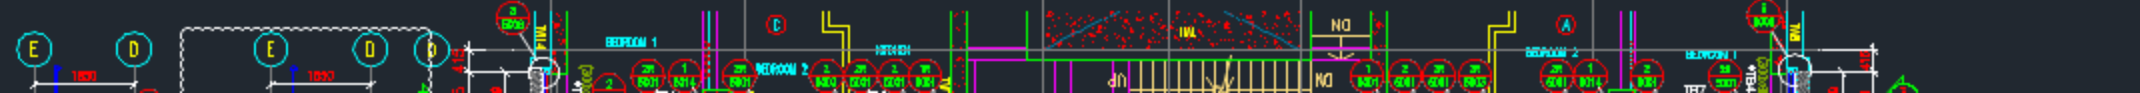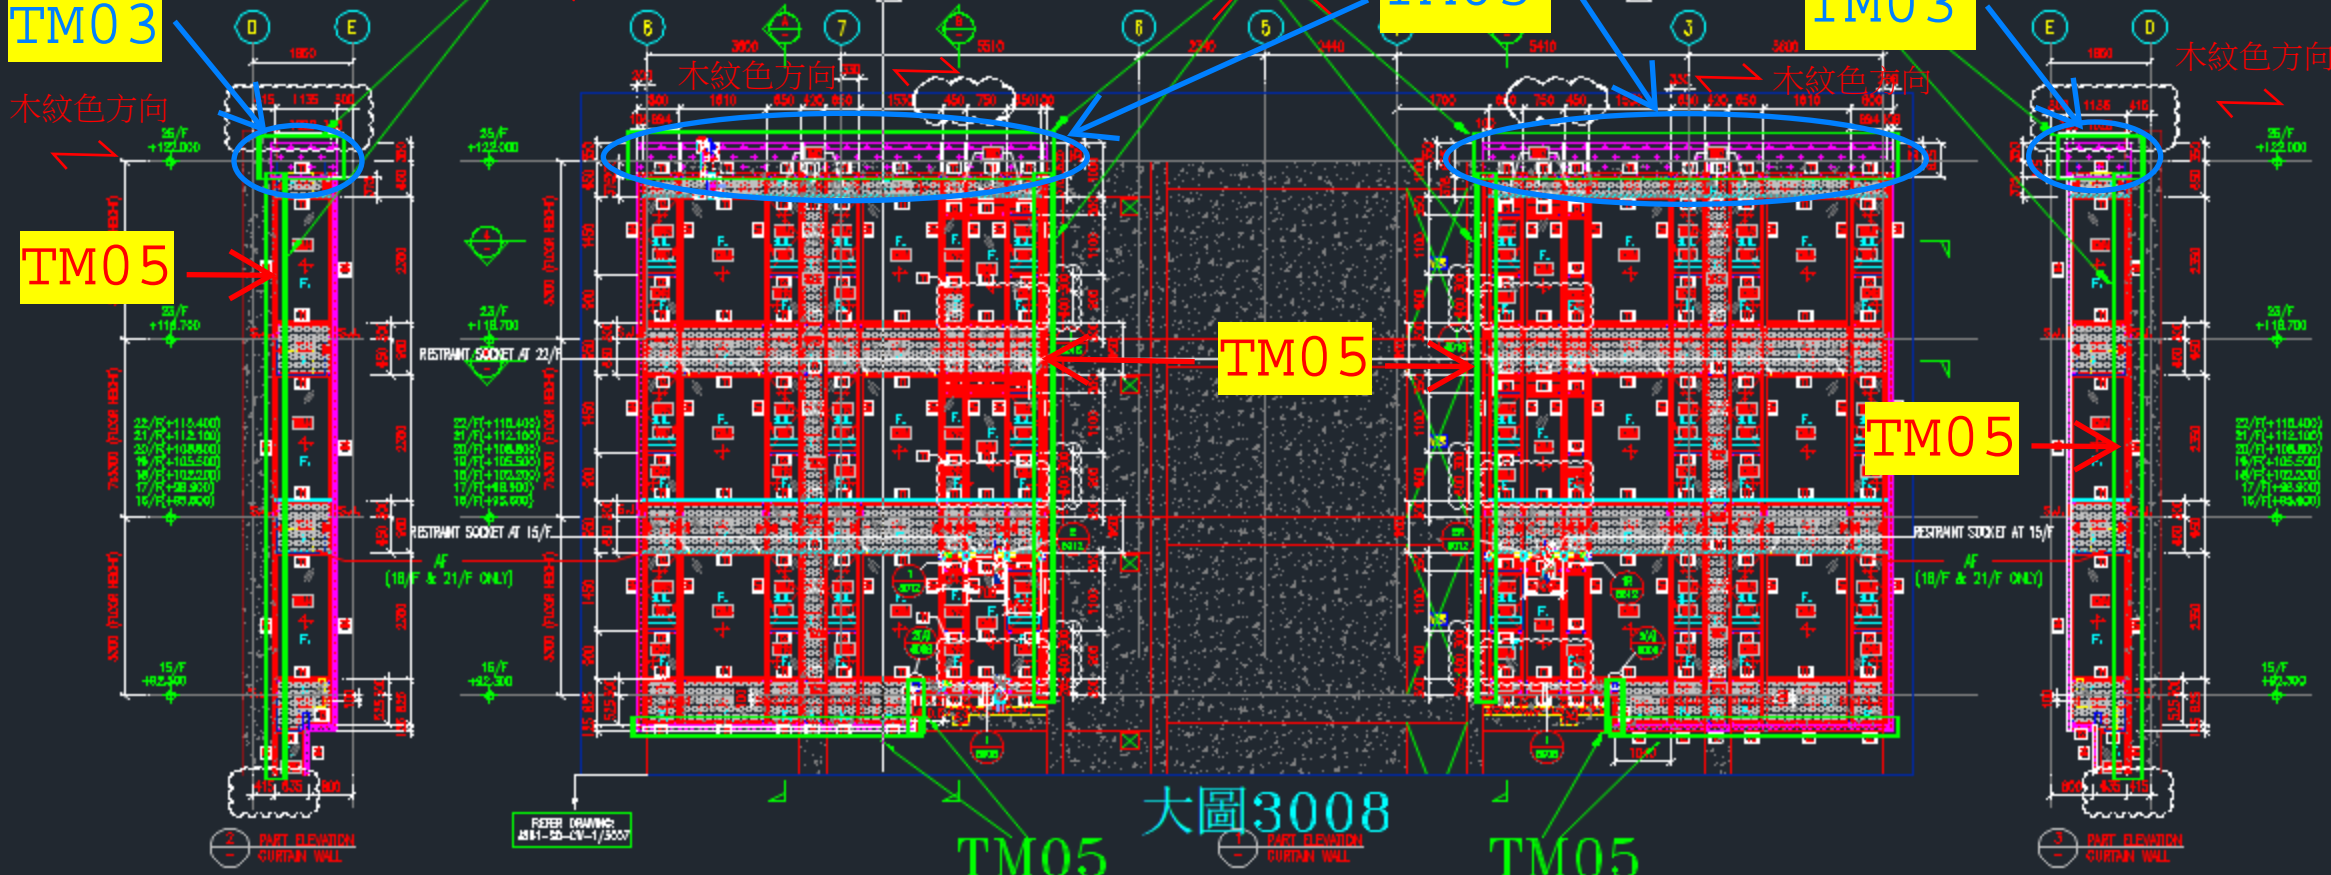

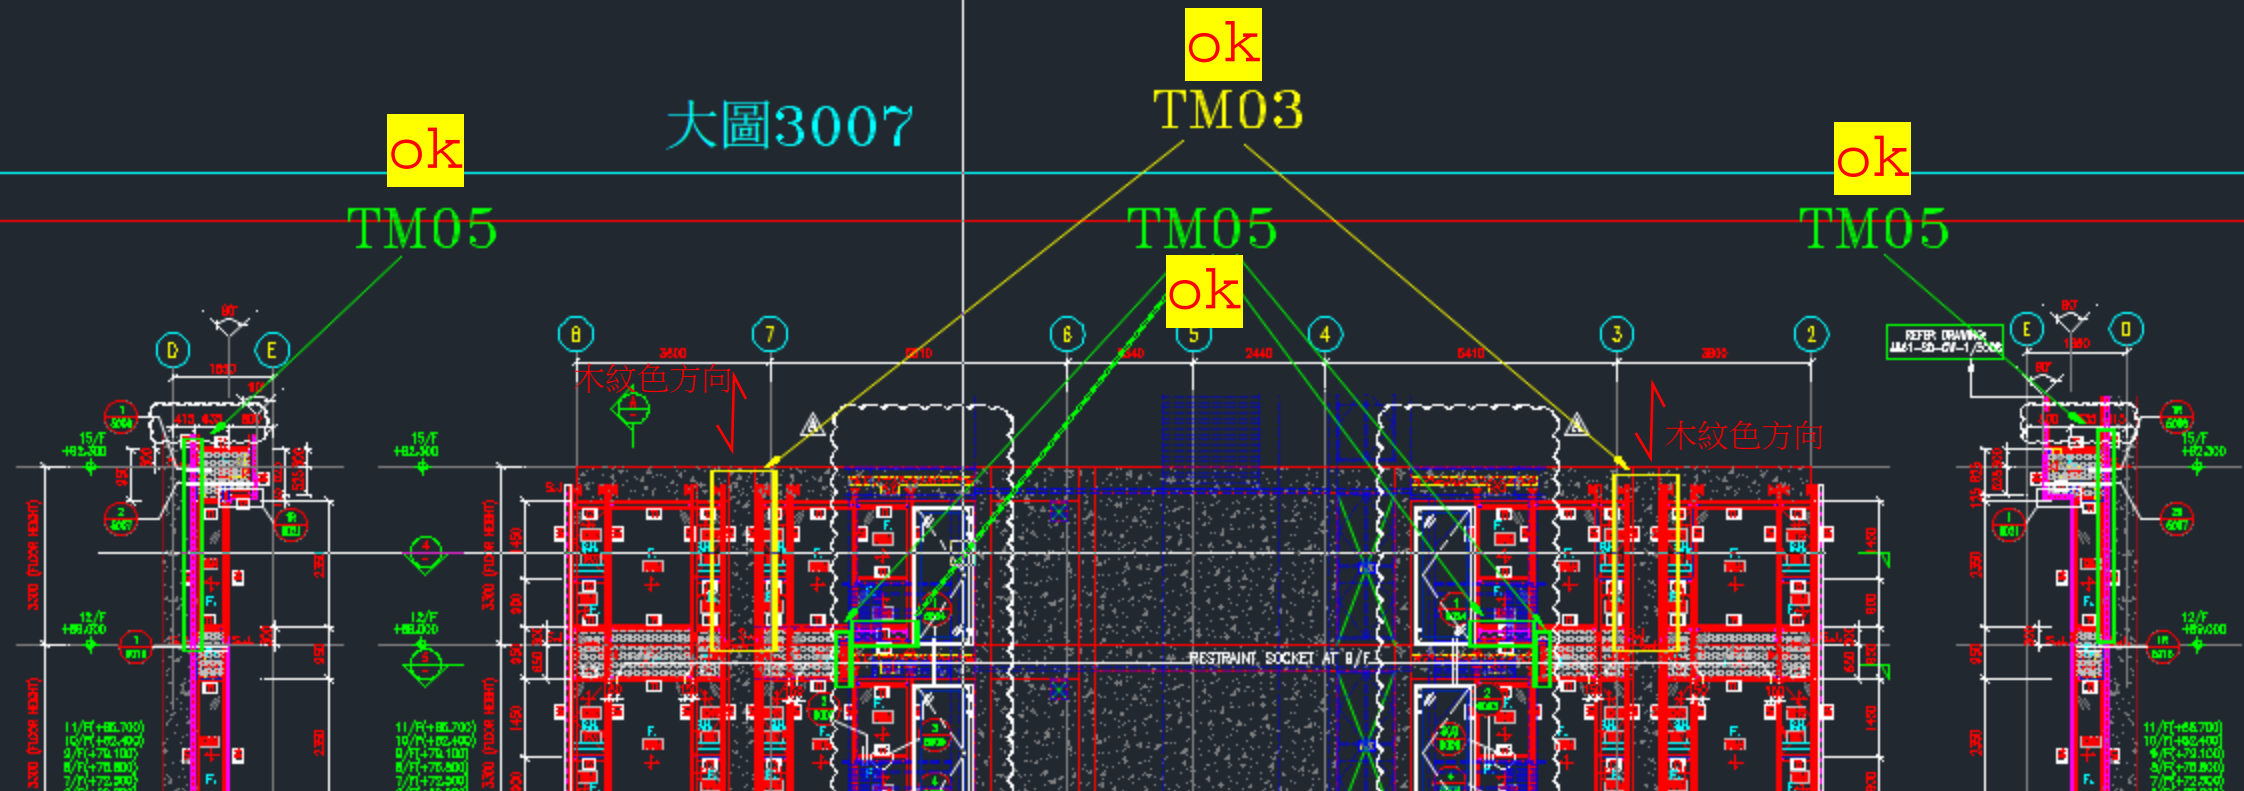

- NOTE:
1. ALL DIMENSIONS ARE IN METERS.
  2. ALL ELEVATIONS ARE VERIFIED.
  3. ALL DIMENSIONS TO BE CHECKED BEFORE FABRICATION.

- LEGEND:
- (M) DETAIL WORK
  - (R) REFER SHEET

1. F.F.L. -- FINISHED FLOOR
2. S.F.L. -- STRUCTURAL FLOOR
3. (R) -- REVERSED SIDE

|    |           |
|----|-----------|
| B  | 8/11/2024 |
| A  | 18/9/2024 |
| DR | DR        |

CLIENT: MILLION BARE

