



工程指示 / 要求簡箋 ENGINEER INSTRUCTIONS(E.I.)

工程指示編號:	EI- 9168	修改版本:	D
	HK- 0859		
工程編號:	J 861	工程名稱:	己連拿利
收件人:	生統/技術部	發件人:	細佬
工程項目:	後裝窗施工圖更新	日期:	03/11/2025

<input type="checkbox"/> 原合約工程包	<input type="checkbox"/> 原合約工程加 / 減賬 QT-	<input type="checkbox"/> 新工程報價 QT-
---------------------------------	--	------------------------------------

信件批核號碼/圖紙參考編號:	批核模具圖紙編號:
客戶指示附件:	管理內部批簽署:

<input type="checkbox"/> 初步鋁料 B.M.	<input type="checkbox"/> 加工拆圖, 然後生產	<input type="checkbox"/> 尺寸表
<input type="checkbox"/> 正式鋁料 B.M.	<input type="checkbox"/> 技術上資料/指示	<input type="checkbox"/> 報價
<input type="checkbox"/> 配件 B.M.	<input type="checkbox"/> 樣辦或貨品說明書	<input type="checkbox"/> 分判合約
<input type="checkbox"/> 其他:		

內容:	<p>給技術部: 後裝窗施工圖更新, 請製作相關的加工圖。 提醒: 如之前未有出加工圖的窗, 請繼續製作(請在11月中之前提交未出的加工圖)。</p> <p>CAD文件在以下位置 J:\midi_sharepoint\Public\to_china\謝永林\J861\EI9168D_HK0859_CAD</p>
完成上列要求日期:	26/11/2025

國內

<input type="checkbox"/> 生產技術總監	<input type="checkbox"/> 連附件	<input checked="" type="checkbox"/> 技術部	<input checked="" type="checkbox"/> 連附件	<input type="checkbox"/> 生產部	<input type="checkbox"/> 連附件
<input type="checkbox"/> 採購部	<input type="checkbox"/> 連附件	<input type="checkbox"/> 生產統籌部	<input type="checkbox"/> 連附件	<input type="checkbox"/> 報關組	<input type="checkbox"/> 連附件
<input type="checkbox"/> 質檢部	<input type="checkbox"/> 連附件	<input type="checkbox"/> 會計部	<input type="checkbox"/> 連附件	<input type="checkbox"/> 機械設計部	<input type="checkbox"/> 連附件
<input type="checkbox"/> 香港辦	<input type="checkbox"/> 連附件	<input type="checkbox"/> 其他:			

香港

<input type="checkbox"/> 行政部	<input type="checkbox"/> 連附件	<input type="checkbox"/> 會計部	<input type="checkbox"/> 連附件	<input type="checkbox"/> 統籌部	<input type="checkbox"/> 連附件	<input type="checkbox"/> 工程部	<input type="checkbox"/> 連附件
<input type="checkbox"/> 採購部	<input type="checkbox"/> 連附件	<input type="checkbox"/> QS部	<input type="checkbox"/> 連附件	<input type="checkbox"/> 地盤管理	<input type="checkbox"/> 連附件	<input type="checkbox"/> 維修部	<input type="checkbox"/> 連附件

*發件人簽署:	*組別成員批核簽署:
傳遞編號:	項目經理簽署: 

WONG TUNG & PARTNERS LTD.

APPROVED AS NOTED

APPROVED AS NOTED & RESUBMIT

REUBMIT

NO COMMENT

REFER OTHER CONSULTANT'S COMMENTS

Reviewed by: _____ Date: _____

CLIENT:

Pacific Century
 Premium Developments
 新洲大新地發展

ADDRESS: WONG TUNG & PARTNERS LTD.

WT

MAIN CONTRACTOR:

順利工程有限公司
 HEEN LEE ENGINEERING CO., LTD.

STRUCTURAL DESIGNER:

S.W. CYL & ASSOCIATES LTD.
 香港建築師學會

FAHGE CONSULTANT

- NOTES:
1. ALL DIMENSIONS ARE IN mm
 2. ALL DIMENSIONS ARE VERIFIED FROM SURFACE
 3. ALL DIMENSIONS TO BE VERIFIED ON SITE BEFORE CONSTRUCTION

- LEGEND:
- 1. FFL -- FINISHED FLOOR LEVEL
 - 2. SFL -- STRUCTURAL FLOOR LEVEL
 - 3. ⓧ -- REINFORCED BEAM
 - 4. P -- FLOOR FINISH
 - 5. SL -- TOP FINISH WINDOW
 - 6. L -- LINDER
 - 7. GLASS LINDING

1. FFL -- FINISHED FLOOR LEVEL
2. SFL -- STRUCTURAL FLOOR LEVEL
3. ⓧ -- REINFORCED BEAM
4. P -- FLOOR FINISH
5. SL -- TOP FINISH WINDOW
6. L -- LINDER
7. GLASS LINDING
- 1000 -- 1000mm x 1000mm (1000mm x 1000mm) (1000mm x 1000mm)
- 1000 -- 1000mm x 1000mm (1000mm x 1000mm) (1000mm x 1000mm)
- 1000 -- 1000mm x 1000mm (1000mm x 1000mm) (1000mm x 1000mm)
- 1000 -- 1000mm x 1000mm (1000mm x 1000mm) (1000mm x 1000mm)

- GLAZING AREA
- OPENABLE AREA

1	1/10/2008	DESIGN REVIEW	HW
2	01/11/2008	DESIGN REVIEW	HW

JOB NO.: J-241

PROJECT:

PROPOSED RESIDENTIAL DEVELOPMENT AT NOS. 3-5 GLADENLY, CENTRAL, HONG KONG

TITLE:

WINDOW SCHEDULE FOR IN-SITU WINDOW


DATE: 20-08-04 SCALE: 1:20 @A3

DRAWN BY: MAM DESIGNED BY:

英特地產有限公司
 MTDI DEVELOPMENT MANAGEMENT CO.
 Unit 1-6, Shary Building, Centre 1/F
 881 On Yee Street, Kowloon
 HONGKONG Tel: 36790122/22099

DWG NO.: JBN-80-M-1007 REV.: B

高度尺寸更新

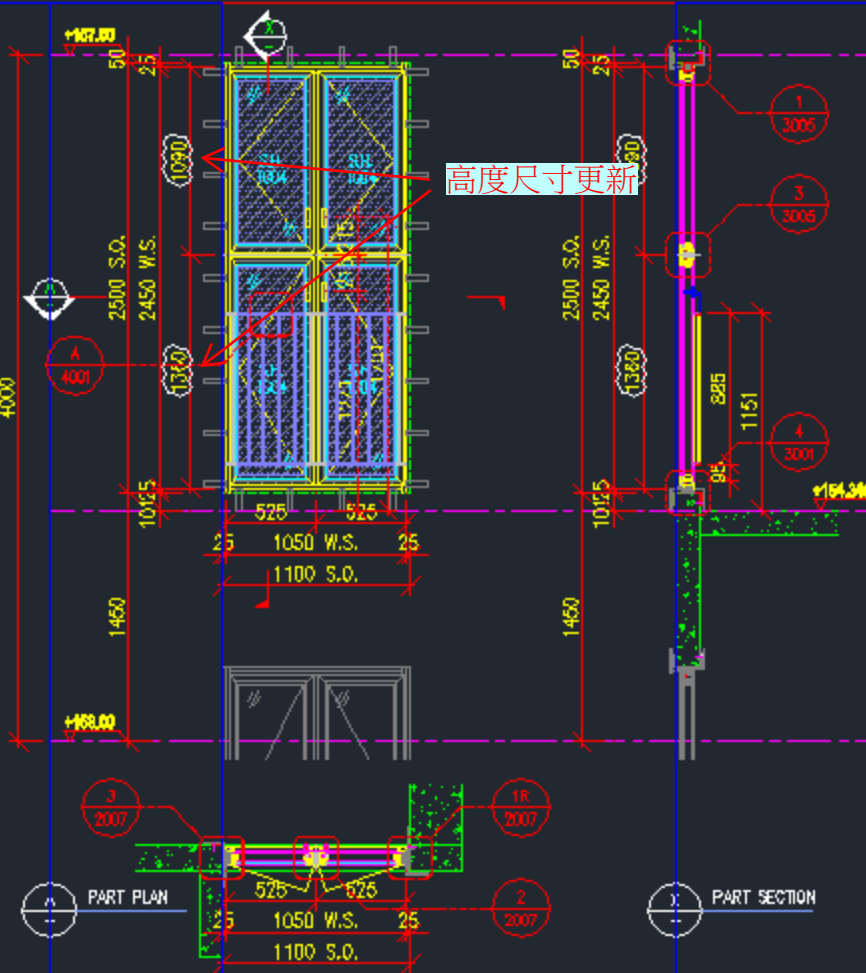

REQUIRE		PROVIDED	
OPENABLE AREA	GLAZING AREA	OPENABLE AREA	GLAZING AREA
-	-	2,003	1,534

1 no.
 (VENTILATING STAIRCASE AT LR/F)

3320 W.S.

1660

1660

S.H.
TG04

S.H.
TG04

S.H.
TG04

S.H.
TG04

215

215

統一做215

2000

