美 特 鋁 質 有 限 公 司
MIDI ALUMINIUM FABRICATOR LTD.

工程指示 / 要求簡箋(E.I.)

工程指示編號：EI / 0506/19　　修改版次：

工程編號　：J835　　工程名稱　：TKO66D2 A&A Works

工程項目　：鋁料加工, 鋁板摺件及玻璃組裝 廠報價

收件人　：生統　　發件人　：Timmy　　日　期　：29/04/2019

□要求提供 / ■確認 事項 ：

( ) 初步鋁料 B.M.　( ) 加工拆圖，然後生產　( ) 尺寸表

( ) 正式鋁料 B.M.　(X) 技術上資料 / 指示　(X) 報價

( ) 玻璃 B.M.　( ) 樣辦或貨品說明書　( ) 分判合約

( ) 其他 ：_____

內容 ：

附頁為是次工程鋁料加工, 鋁板摺件及玻璃組裝報價資料

請在 _____ 前完成上列要求。

附有關圖紙 / 文件 ：

1+26 頁

以上項目為:

□ 原合約工程包　□ 原合約工程加 / 減賬　□ 新工程報價

原因 ：-_____

分發東莞各部門 ：

(X)生產技術總監■連附件 ( )技術部 □連附件 ( )生產部 □連附件 ( )機械設計部□連附件

( )採購部 □連附件 (X)生產統籌部 ■連附件

( )質檢部 □連附件 ( )會計部 □連附件 ( )報關組 □連附件 ( )其他 _____□連附件

分發香港各部門 ：

( )行政部□連附件 ( )會計部□連附件 ( )統籌部□連附件 ( )工程部地盤科文 □連附件

(X)採購部■連附件 ( )QS 部 □連附件 ( )維修部□連附件 ( )其他 _____ □連附件

傳遞編號：HK – 0996/19 (FTP)　　發件人簽署：Timmy

項目經理簽署：P.P.

PROJECT :

3

PROPOSED RESIDENTIAL DEVELOPMENT AT TSEUNG KWAN O, AREA 66D2, T.K.O.T.L. 118

J835

SHOP DRAWING FOR

A & A WORKS AT PODIUM

DATE: 15 - APR - 2019

美特鋁質有限公司
MIDI ALUMINIUM FABRICATOR LTD.
Units 6-8, Sunray Industrial Centre, 1/F
610 Cha Kwo Ling Road, Kowloon
Tel:23489211-4 Fax:(852)27727666

DWG NO. : J835-AA-AA01 | REV. : C

加工範圍

W1 P1 P2 P3 TC-3

1880 6150 5900

2000

1 PE06

1 PE05

**NEW DOUBLE SWING DOOR & ADDITION AUTOMATIC SWING DOOR OPERATOR

**NEW SWING DOOR & ADDITION AUTOMATIC SWING DOOR OPERATOR

**NEW GLASS WALL

MATCH LINE (REFER DRAWING AA-PL04)

RAMP UP 1 : 21

RAMP UP

RETAIL ENTRANCE LOBBY

ESCALATOR TO & FROM U/G

ESCALATOR NO. 1

ESCALATOR NO. 2

4.90 F.L.
4.70 S.L.

NEW 150 H. R.C. CURB

NEW STORE RM.

NEW 1250 H. R.C. PARAPET WALL

GW03a GW03 GW02 GW01

GREEN WALL

ADVERTISEMENT BOARD

**NEW ALUM. LOUVRE

NEW P.D.

SHOP 1
5.05 F.L.
5.00 S.L.

CHAIN LINK FENCE W/ 7.20 T.L. ON 1200 H. R.C. PARAPET WALL

MN - 22.867 M

**NEW ALUM. LOUVRE

**ADVERTISEMENT BOARD REDUCE SIZE

ADVERTISEMENT BOARD

NEW ACC. LAV.

NEW H.R.

NEW P. LAV.

R.C. A.F.

H.R.

TRANSFORMER RM

B.D. Ref.

F.P.B. Ref.

Legend :

1. F.F.L.-- Finished Floor Level
2. S.F.L.-- Structural Floor Level
3. /R -- Reversed Detail

X1 — DETAIL MARK NO.
X001 — REFER SHEET NO.

** -- FOR THIS SUBMISSION
GBP ref. no.: 4800-LA02

DATE/REVISION/AMENDMENTS		
11/02/19	A	REVISED ARCHITECT'S COMMENTS
04/04/19	B	GENERAL REVISION

SUN HUNG KAI ARCHITECTS AND ENGINEERS LTD.
SUN HUNG KAI CENTRE, WANCHAI, HONGKONG
TEL. 28278111 FAX. 28272884

YEE FAI CONTRACTORS CO. LTD.
44/F SUN HUNG KAI CENTRE, WANCHAI, HONGKONG
TEL. 28278111 FAX. 28270717

美特鋁質有限公司
MIDI ALUMINIUM FABRICATOR LTD.
Units 6-8, Sunray Industrial Centre, 1/F
610 Cha Kwo Ling Road, Kowloon
Tel: 23489211-4 Fax: (852)27727666

This drawing and design are copyright of the authorized person. No portion may be reproduced without his written permission. Use written dimensions. Measurements to existing works to be verified on site. This drawing shall be read in conjunction with specification and condition of contract.

PROJECT

PROPOSED RESIDENTIAL DEVELOPMENT AT TSEUNG KWAN O AREA 66D2, T.K.O.T.L. 118

TITLE


G/F PARTIAL PLAN OF A & A WORKS AT PODIUM

FILE NAME	
DRAWN BY	
CHECKED BY	
PRINTED DATE	
SCALE	1:100

JOB No.	DRAWING No.	REV.
J-835	J835-AA-PL03	B

R.S.E.

FOR B.D. APPROVAL

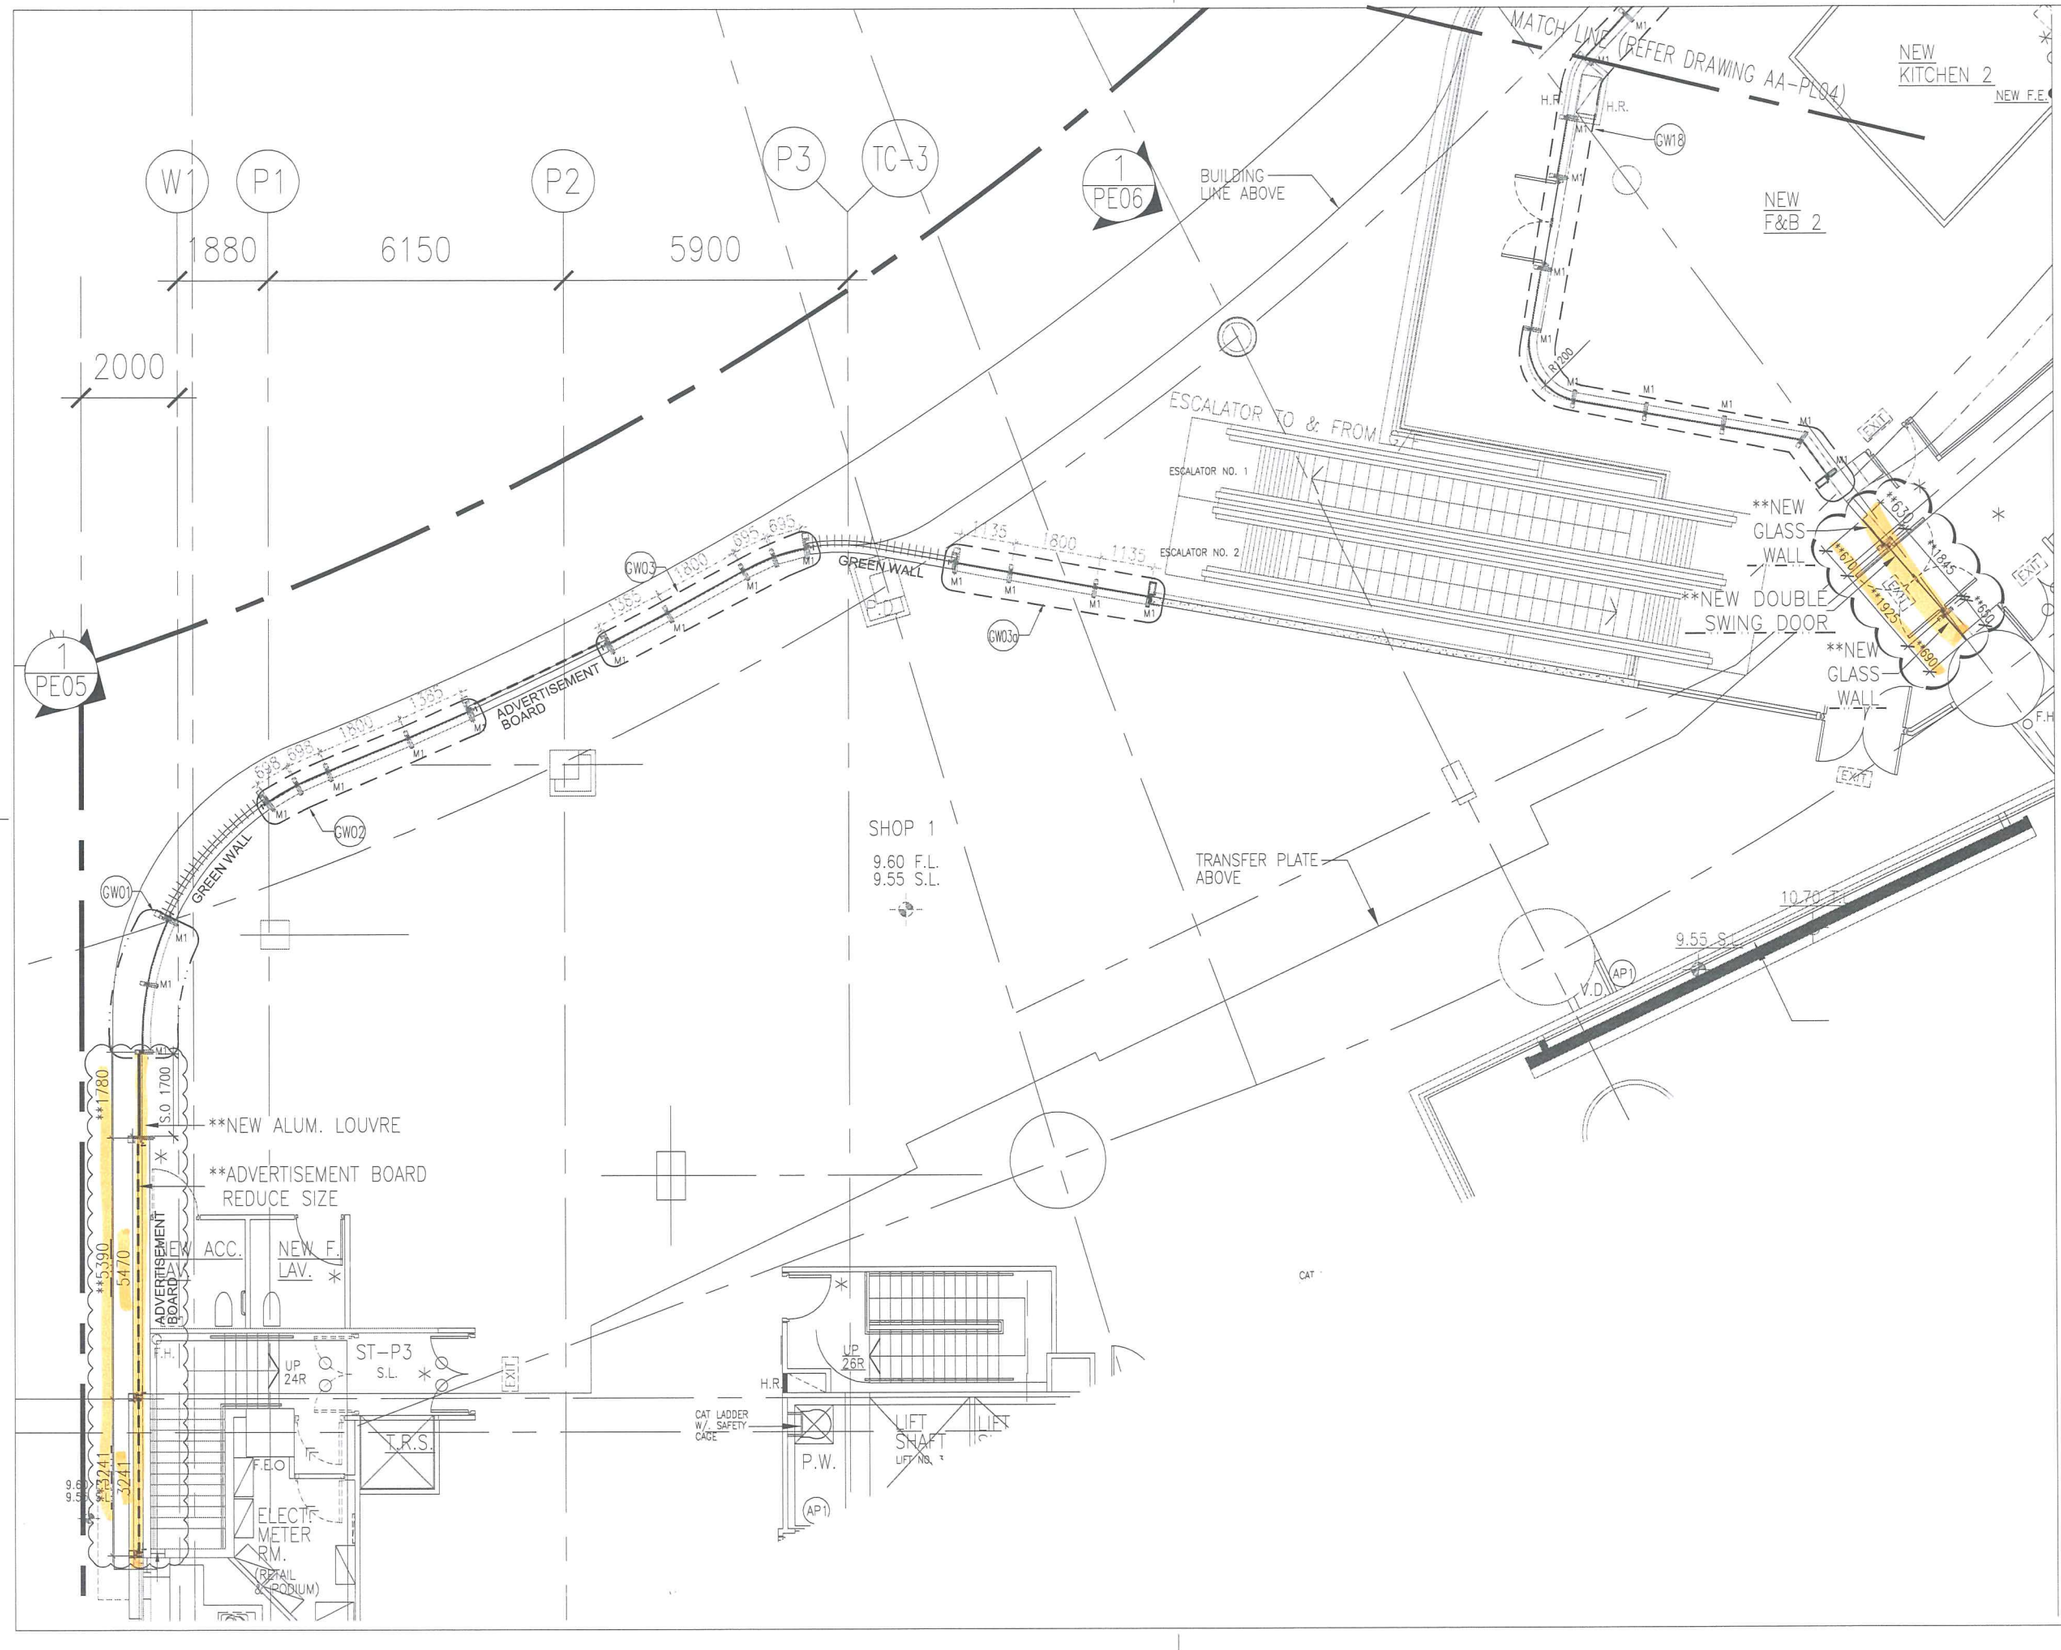

B.D. Ref.

F.P.B. Ref.

Legend :

1. F.F.L.-- Finished Floor Level
2. S.F.L.-- Structural Floor Level
3. (/R) -- Reversed Detail

X1 ---- DETAIL MARK NO.
X001 ---- REFER SHEET NO.

**-- FOR THIS SUBMISSION

GBP ref. no.: 4800-LA02

11/02/19	A	REVISED ARCHITECT'S COMMENTS
04/04/19	B	ADDITIONAL WORKS AT 1/F AREA

DATE/REVISION/AMENDMENTS

SUN HUNG KAI ARCHITECTS AND ENGINEERS LTD.
SUN HUNG KAI CENTRE, WANCHAI, HONGKONG
TEL. 28278111 FAX. 28272884

YEE FAI CONTRACTORS CO. LTD.
44/F SUN HUNG KAI CENTRE, WANCHAI, HONGKONG
TEL. 28278111 FAX. 28270717

美特鋁質有限公司
MIDI ALUMINIUM FABRICATOR LTD.
Units 6-8, Sunray Industrial Centre, 1/F
610 Cha Kwo Ling Road, Kowloon
Tel: 23489211-4 Fax: (852)27727666

This drawing and design are copyright of the authorized person. No portion may be reproduced without his written permission. Use written dimensions. Measurements to existing works to be verified on site. This drawing shall be read in conjunction with specification and condition of contract.

PROJECT

PROPOSED RESIDENTIAL DEVELOPMENT AT TSEUNG KWAN O AREA 66D2, T.K.O.T.L. 118

TITLE

1/F PARTIAL PLAN OF A & A WORKS AT PODIUM

FILE NAME

DRAWN BY

CHECKED BY


PRINTED DATE

SCALE 1:100

JOB No.	DRAWING No.	REV.
J-835	J835-AA-PL03a	B

R.S.E.

FOR B.D. APPROVAL

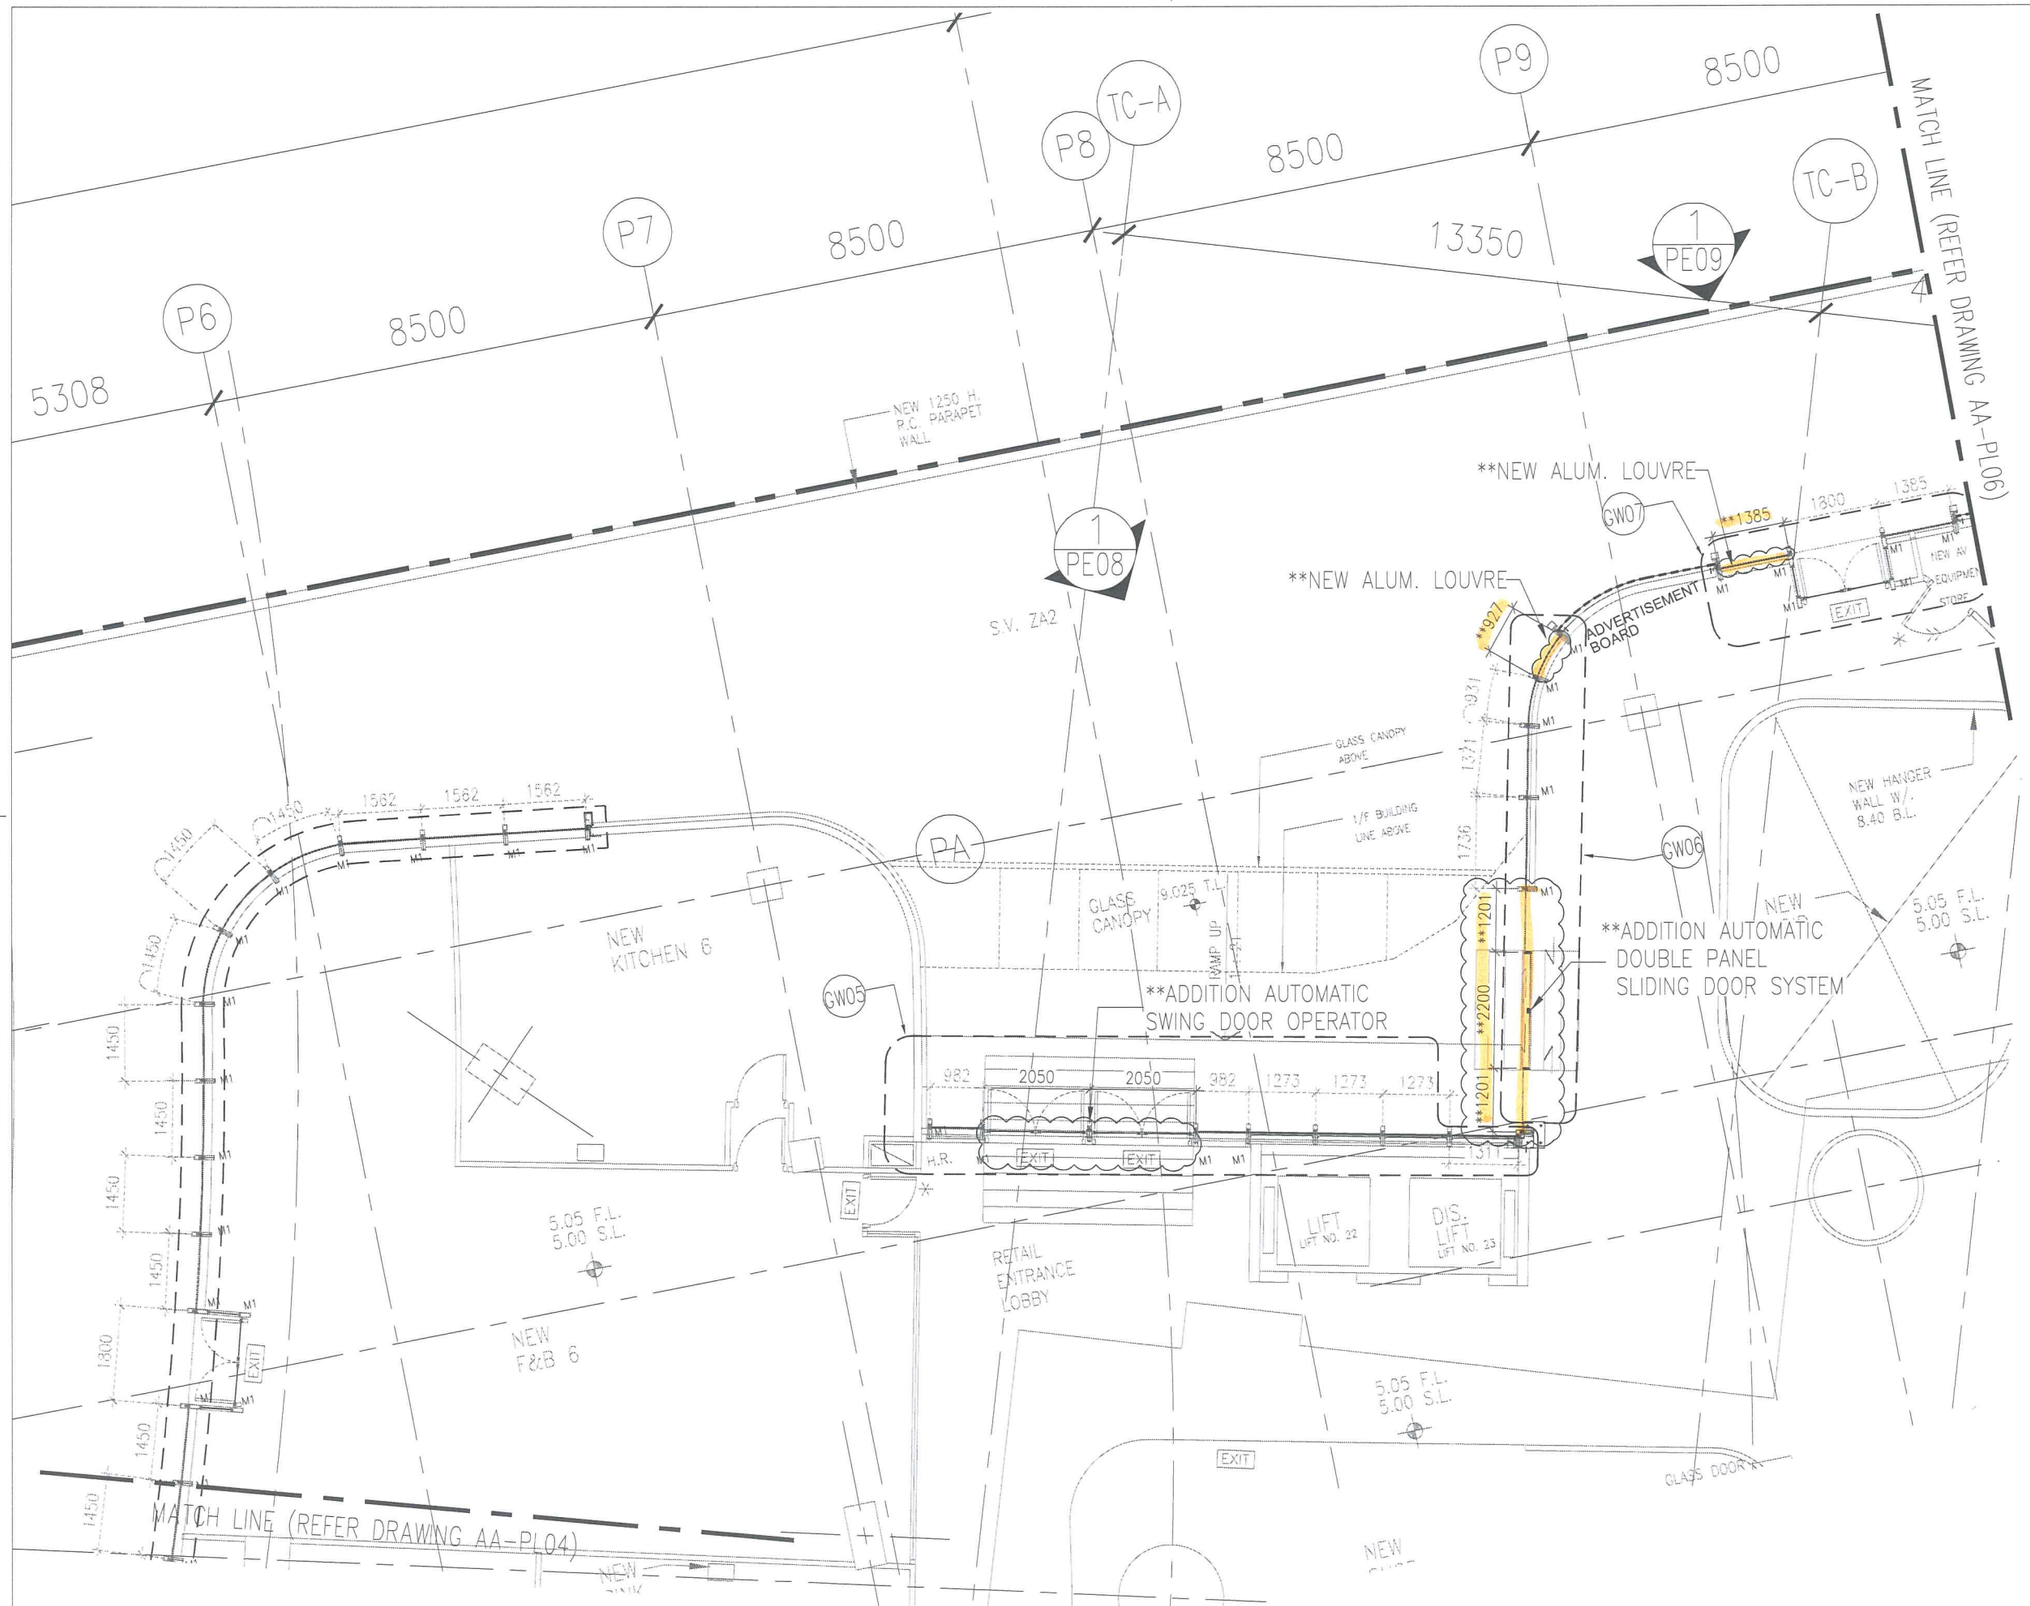

B.D. Ref.

F.P.B. Ref.

Legend :

1. F.F.L.-- Finished Floor Level
2. S.F.L.-- Structural Floor Level
3. /R -- Reversed Detail

X1 — DETAIL MARK NO.
X001 — REFER SHEET NO.

** -- FOR THIS SUBMISSION

GBP ref. no.: 4800-LA02

21/01/19 A MODIFY SETTING OUT

DATE/REVISION/AMENDMENTS

SUN HUNG KAI ARCHITECTS AND ENGINEERS LTD.
SUN HUNG KAI CENTRE, WANCHAI, HONGKONG
TEL. 28278111 FAX. 28272884

YEE FAI CONTRACTORS CO. LTD.
44/F SUN HUNG KAI CENTRE, WANCHAI, HONGKONG
TEL. 28278111 FAX. 28270717

美特鋁質有限公司
MIDI ALUMINIUM FABRICATOR LTD.
Units 6-8, Sunray Industrial Centre, 1/F
610 Cha Kwo Ling Road, Kowloon
Tel: 23489211-4 Fax: (852)27727666

This drawing and design are copyright of the authorized person. No portion may be reproduced without his written permission. Use written dimensions. Measurements to existing works to be verified on site. This drawing shall be read in conjunction with specification and condition of contract.

PROJECT

PROPOSED RESIDENTIAL DEVELOPMENT AT TSEUNG KWAN O AREA 66D2, T.K.O.T.L. 118

TITLE

G/F PARTIAL PLAN OF A & A WORKS AT PODIUM

FILE NAME

DRAWN BY

CHECKED BY

PRINTED DATE

SCALE 1:100

JOB No.	DRAWING No.	REV.
J-835	J835-AA-PL05	A

R.S.E.

FOR B.D. APPROVAL

P6 P7 P8 P9 TC-A TC-B

8500 8500 8500 13350 8500

1 PE08

1 PE09

MATCH LINE (REFER DRAWING AA-PL06a)

**REMOVE 1/F EXISTING GLASS WALL"GW07" (NEW EXTERNAL RC WALL BY CONTRACTOR)

**4570

ADVERTISEMENT BOARD

ADVERTISEMENT BOARD

NEW TV

M1

GW18

PA

OPEN TERRACE 9.60 F.L. 9.45 S.L.

GLASS CANOPY 9.025 T.L.

BUILDING LINE ABOVE

H.R.

P.D.

NEW F&B 6

NEW GLASS DOOR & WALL

EXIT

NEW V.P.

NEW S.L.

NEW EXHAUST DUCT ABOVE

NEW F.E.

NEW KITCHEN 6

LIFT LIFT NO. 22

DIS. LIFT LIFT NO. 23

NEW H.R.

9.60 F.L. 9.55 S.L.

NEW VOID

MIN. 1100 H. GLASS BALUSTRADE

NEW GLASS DOOR & WALL

EXIT

MATCH LINE (REFER DRAWING AA-PL04a)

NEW

B.D. Ref.

F.P.B. Ref.

Legend :

1. F.F.L.-- Finished Floor Level
2. S.F.L.-- Structural Floor Level
3. /R -- Reversed Detail

X1 -- DETAIL MARK NO.
X001 -- REFER SHEET NO.

** -- FOR THIS SUBMISSION

GBP ref. no.: 4800-LA02

20/03/19 A GENERAL REVISION

DATE/REVISION/AMENDMENTS

SUN HUNG KAI ARCHITECTS AND ENGINEERS LTD.
SUN HUNG KAI CENTRE, WANCHAI, HONGKONG
TEL. 28278111 FAX. 28272884

YEE FAI CONTRACTORS CO. LTD.
44/F SUN HUNG KAI CENTRE, WANCHAI, HONGKONG
TEL. 28278111 FAX. 28270717

美特鋁質有限公司
MIDI ALUMINIUM FABRICATOR LTD.
Units 6-8, Sunray Industrial Centre, 1/F
610 Cha Kwo Ling Road, Kowloon
Tel: 23489211-4 Fax: (852)27727666

This drawing and design are copyright of the authorized person. No portion may be reproduced without his written permission. Use written dimensions. Measurements to existing works to be verified on site. This drawing shall be read in conjunction with specification and condition of contract.

PROJECT

PROPOSED RESIDENTIAL DEVELOPMENT AT TSEUNG KWAN O AREA 66D2, T.K.O.T.L. 118

TITLE

1/F PARTIAL PLAN OF A & A WORKS AT PODIUM

FILE NAME

DRAWN BY

CHECKED BY


PRINTED DATE

SCALE 1:100

JOB No.	DRAWING No.	REV.
J-835	J835-AA-PL05a	A

R.S.E.

FOR B.D. APPROVAL

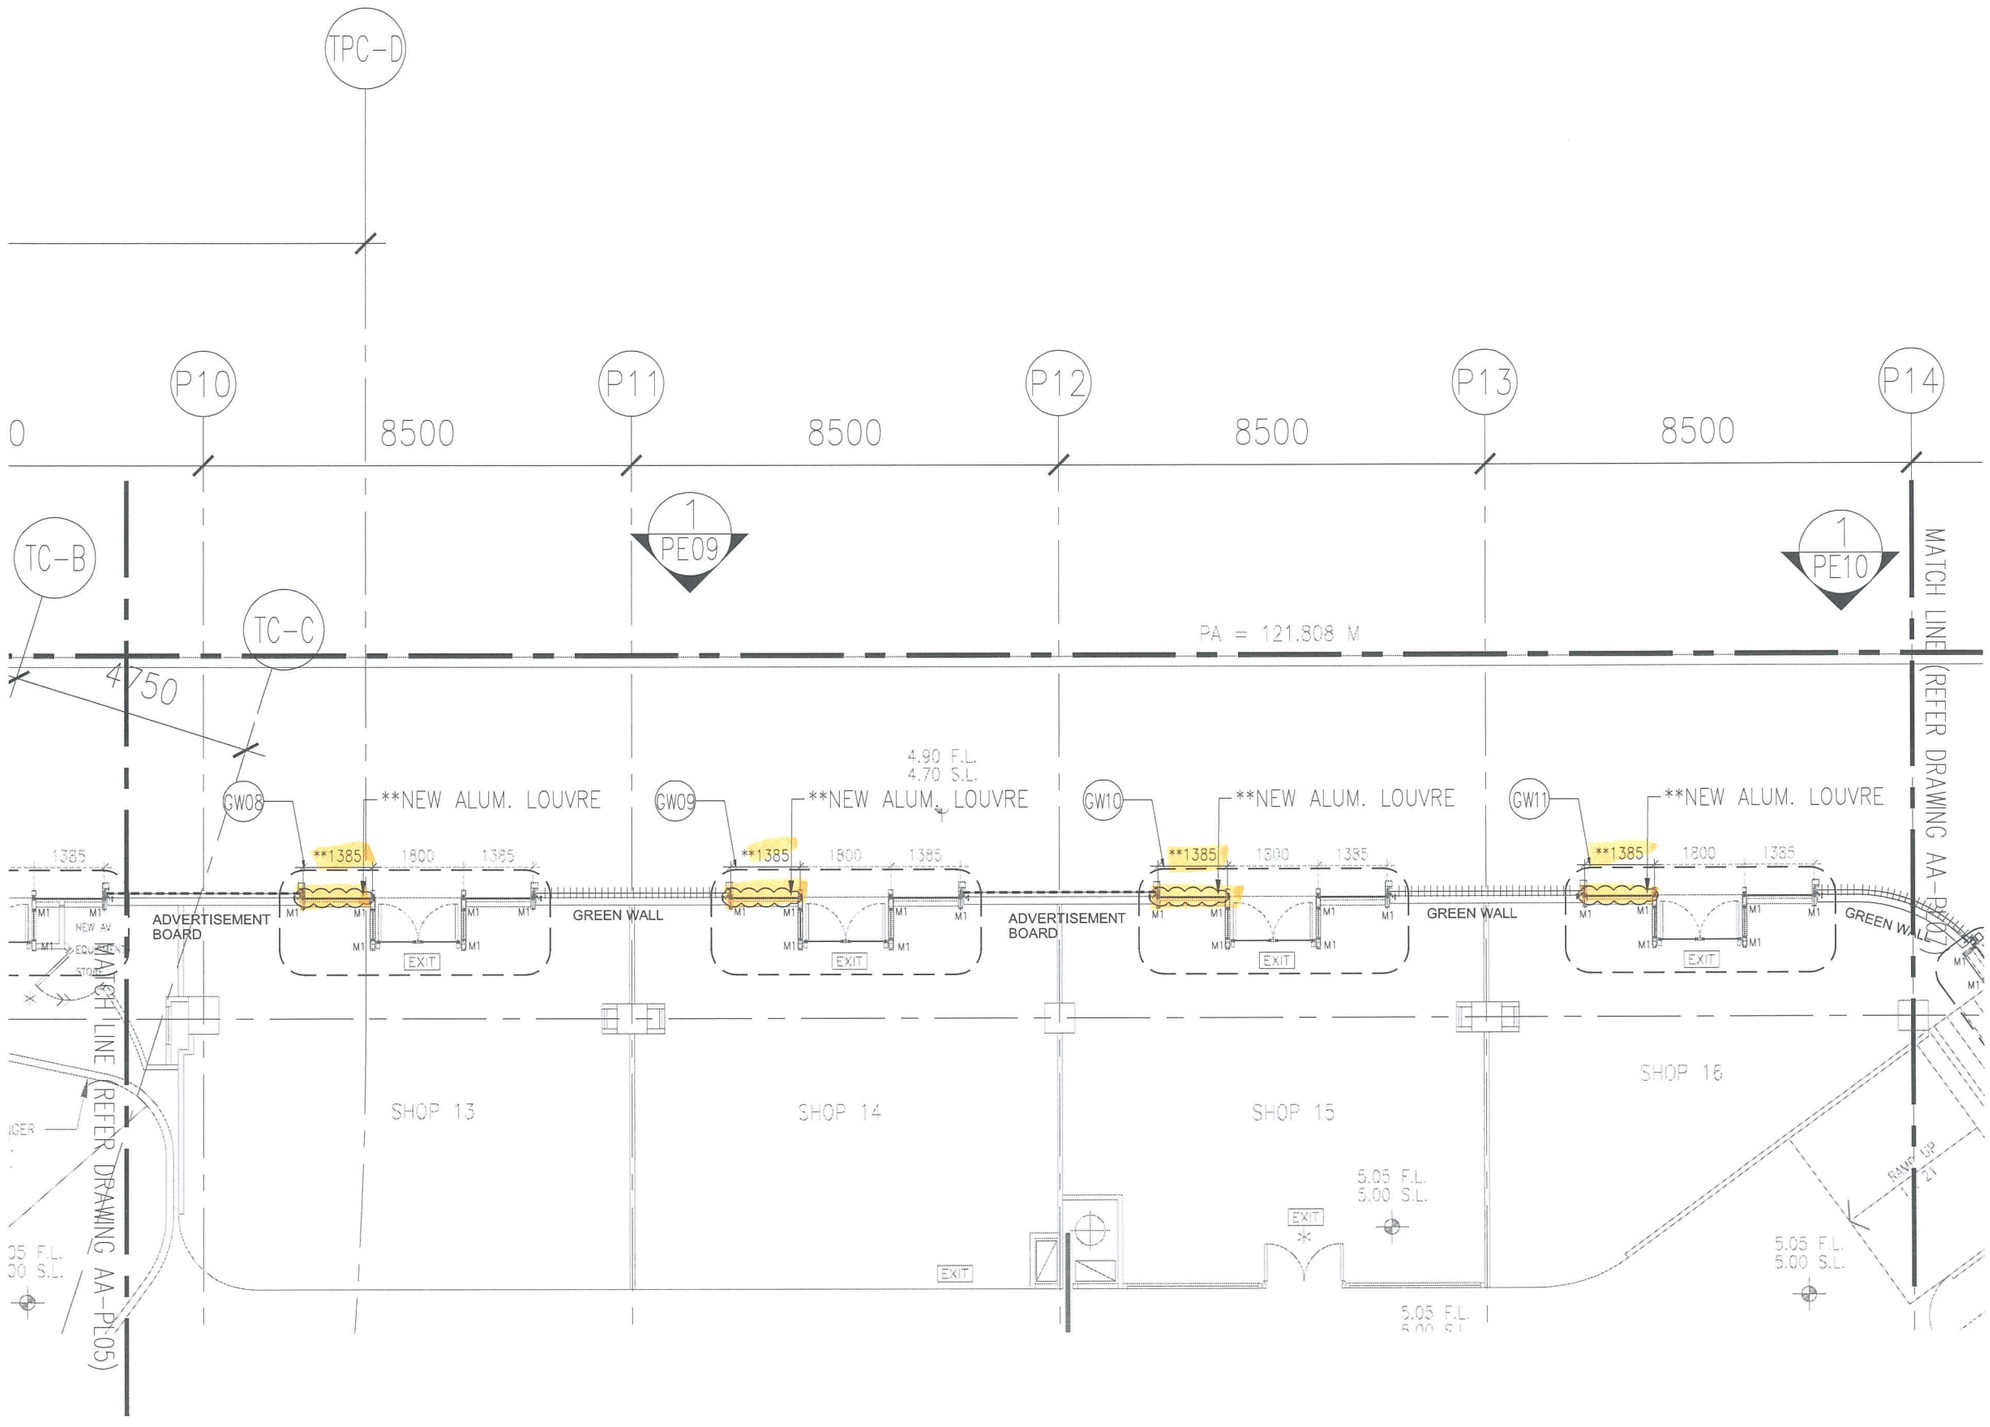

B.D. Ref.

F.P.B. Ref.

Legend :

1. F.F.L.-- Finished Floor Level
2. S.F.L.-- Structural Floor Level
3. (/R) -- Reversed Detail

X1 — DETAIL MARK NO.
X001 — REFER SHEET NO.

** -- FOR THIS SUBMISSION

GBP ref. no.: 4800-LA02

DATE/REVISION/AMENDMENTS

SUN HUNG KAI ARCHITECTS AND ENGINEERS LTD.
SUN HUNG KAI CENTRE, WANCHAI, HONGKONG
TEL. 28278111 FAX. 28272884

YEE FAI CONTRACTORS CO. LTD.
44/F SUN HUNG KAI CENTRE, WANCHAI, HONGKONG
TEL. 28278111 FAX. 28270717

美特鋁質有限公司
MIDI ALUMINIUM FABRICATOR LTD.
Units 6-8, Sunray Industrial Centre, 1/F
610 Cha Kwo Ling Road, Kowloon
Tel: 23489211-4 Fax:(852)27727666

This drawing and design are copyright of the authorized person. No portion may be reproduced without his written permission. Use written dimensions. Measurements to existing works to be verified on site. This drawing shall be read in conjunction with specification and condition of contract.

PROJECT

PROPOSED RESIDENTIAL DEVELOPMENT AT TSEUNG KWAN O AREA 66D2, T.K.O.T.L. 118

TITLE

G/F PARTIAL PLAN OF A & A WORKS AT PODIUM

FILE NAME

DRAWN BY

CHECKED BY

PRINTED DATE

SCALE 1:100

JOB No.	DRAWING No.	REV.
J-835	J835-AA-PL06	-

R.S.E.

FOR B.D. APPROVAL

P14 P15 P16 P17 P18

8500 8500 11700 6100

MATCH LINE (REFER DRAWING AA-PL06)

MATCH LINE (REFER DRAWING AA-PL08)

1 PE10

1 PE11

NEW 1250 H. R.C. PARAPET WALL

4500 WIDE PEDESTRIAN WAY

**NEW DOUBLE SWING DOOR w/ ALUM. SIGNAGE BOX & ALUM. LOUVRE

**NEW GLASS WALL

**GREEN WALL REDUCE SIZE

**ADDITION AUTOMATIC SWING DOOR OPERATOR & NEW ALUM. LOUVRE & GLASS PLANEL

GW12 GW13 GW14 GW15

GREEN WALL

RETAIL ENTRANCE LOBBY

2/F BUILDING LINE ABOVE

4.90 F.L. 4.70 S.L.

FALL 1:80

**2030 **2039

**2147 **1800 926 2111

**1720

1386 1800 1385

ADVERTISEMENT BOARD

EXIT

ESCALATOR NO. 4

ESCALATOR NO. 3

ESCALATOR NO. 2 (UP ONLY)

RAMP UP 1:12

SHOP 22

SHOP 23

NEW SHOP 24

NEW SHOP 1

5.05 F.L. 5.00 S.L.

NEW GLASS DOOR & WALL

TRAVEL DISTANCE 15.169 + 14.929 = 31.1

AP1 P.D. O.F.H.

B.D. Ref.

F.P.B. Ref.

Legend :

1. F.F.L.-- Finished Floor Level
2. S.F.L.-- Structural Floor Level
3. /R -- Reversed Detail

X1- DETAIL MARK NO.
X001- REFER SHEET NO.

** -- FOR THIS SUBMISSION

GBP ref. no.: 4800-LA02

21/01/19	A	MODIFY SETTING OUT
11/02/19	B	REVISED ARCHITECT'S COMMENTS
04/04/19	C	GENERAL REVISION

DATE/REVISION/AMENDMENTS

SUN HUNG KAI ARCHITECTS AND ENGINEERS LTD.
SUN HUNG KAI CENTRE, WANCHAI, HONGKONG
TEL. 28278111 FAX. 28272884

YEE FAI CONTRACTORS CO. LTD.
44/F SUN HUNG KAI CENTRE, WANCHAI, HONGKONG
TEL. 28278111 FAX. 28270717

美特鋁質有限公司
MIDI ALUMINIUM FABRICATOR LTD.
Units 6-8, Sunray Industrial Centre, 1/F
610 Cha Kwo Ling Road, Kowloon
Tel: 23489211-4 Fax:(852)27727666

This drawing and design are copyright of the authorized person. No portion may be reproduced without his written permission. Use written dimensions. Measurements to existing works to be verified on site. This drawing shall be read in conjunction with specification and condition of contract.

PROJECT

PROPOSED RESIDENTIAL DEVELOPMENT AT TSEUNG KWAN O AREA 66D2, T.K.O.T.L. 118

TITLE

G/F PARTIAL PLAN OF A & A WORKS AT PODIUM

FILE NAME

DRAWN BY

CHECKED BY

PRINTED DATE

SCALE 1:100

JOB No.	DRAWING No.	REV.
J-835	J835-AA-PL07	C

R.S.E.

FOR B.D. APPROVAL

P14 P15 P16 P17 P18

8500 8500 11700 6100

MATCH LINE (REFER DRAWING AA-PL06a)

MATCH LINE (REFER DRAWING AA-PL08a)

1 PE10

1 PE11

**NEW ALUM. LOUVRE

**NEW GLASS WALL

**NEW ALUM. LOUVRE

**GREEN WALL REDUCE SIZE

GW13 GW12 GW15

**926 **1800 **926 **2147

2111 1386 1800 1385 385 1800 1385

M1

GREEN WALL

BUILDING LINE ABOVE

ADVERTISEMENT BOARD

ADVERTISE BOARD

ESCALATOR NO. 4

ESCALATOR NO. 3

ESCALATOR TO & FROM G/F

** REMOVE EXISTING GLASS BALUSTRADE AND INSTALL NEW GLASS WALL

**13124

SHOP 20

9.60 F.L.
9.55 S.L.

SHOP 18

9.60 F.L.
9.55 S.L.

9.60 F.L.
9.55 S.L.

PB

DEDICATED PASSAGE

EXIT

RAMP UP 1 : 12

9.90 F.L.
9.80 S.L.

9.90 F.L.
9.80 S.L.

ARD

P.D.

H.R.

F.E.

ELECT. RM. (RETAIL)

9.55 S.L.

EMERG GENER

GLASS BALUSTRADE (BY OTHERS)

B.D. Ref.

F.P.B. Ref.

Legend :

1. F.F.L.-- Finished Floor Level
2. S.F.L.-- Structural Floor Level
3. /R -- Reversed Detail

X1 -- DETAIL MARK NO.
X001 -- REFER SHEET NO.

** -- FOR THIS SUBMISSION

GBP ref. no.: 4800-LA02

DATE/REVISION/AMENDMENTS		
21/01/19	A	MODIFY SETTING OUT
11/02/19	B	REVISED ARCHITECT'S COMMENTS
04/04/19	C	ADDITIONAL WORKS AT 1/F AREA

SUN HUNG KAI ARCHITECTS AND ENGINEERS LTD.
SUN HUNG KAI CENTRE, WANCHAI, HONGKONG
TEL. 28278111 FAX. 28272884

YEE FAI CONTRACTORS CO. LTD.
44/F SUN HUNG KAI CENTRE, WANCHAI, HONGKONG
TEL. 28278111 FAX. 28270717

美特鋁質有限公司
MIDI ALUMINIUM FABRICATOR LTD.
Units 6-8, Sunray Industrial Centre, 1/F
610 Cha Kwo Ling Road, Kowloon
Tel: 23489211-4 Fax: (852)27727666

This drawing and design are copyright of the authorized person. No portion may be reproduced without his written permission. Use written dimensions. Measurements to existing works to be verified on site. This drawing shall be read in conjunction with specification and condition of contract.

PROJECT

PROPOSED RESIDENTIAL DEVELOPMENT AT TSEUNG KWAN O AREA 66D2, T.K.O.T.L. 118

TITLE


1/F PARTIAL PLAN OF A & A WORKS AT PODIUM

FILE NAME	
DRAWN BY	
CHECKED BY	
PRINTED DATE	
SCALE	1:100

JOB No.	DRAWING No.	REV.
J-835	J835-AA-PL07a	C

R.S.E.

FOR B.D. APPROVAL

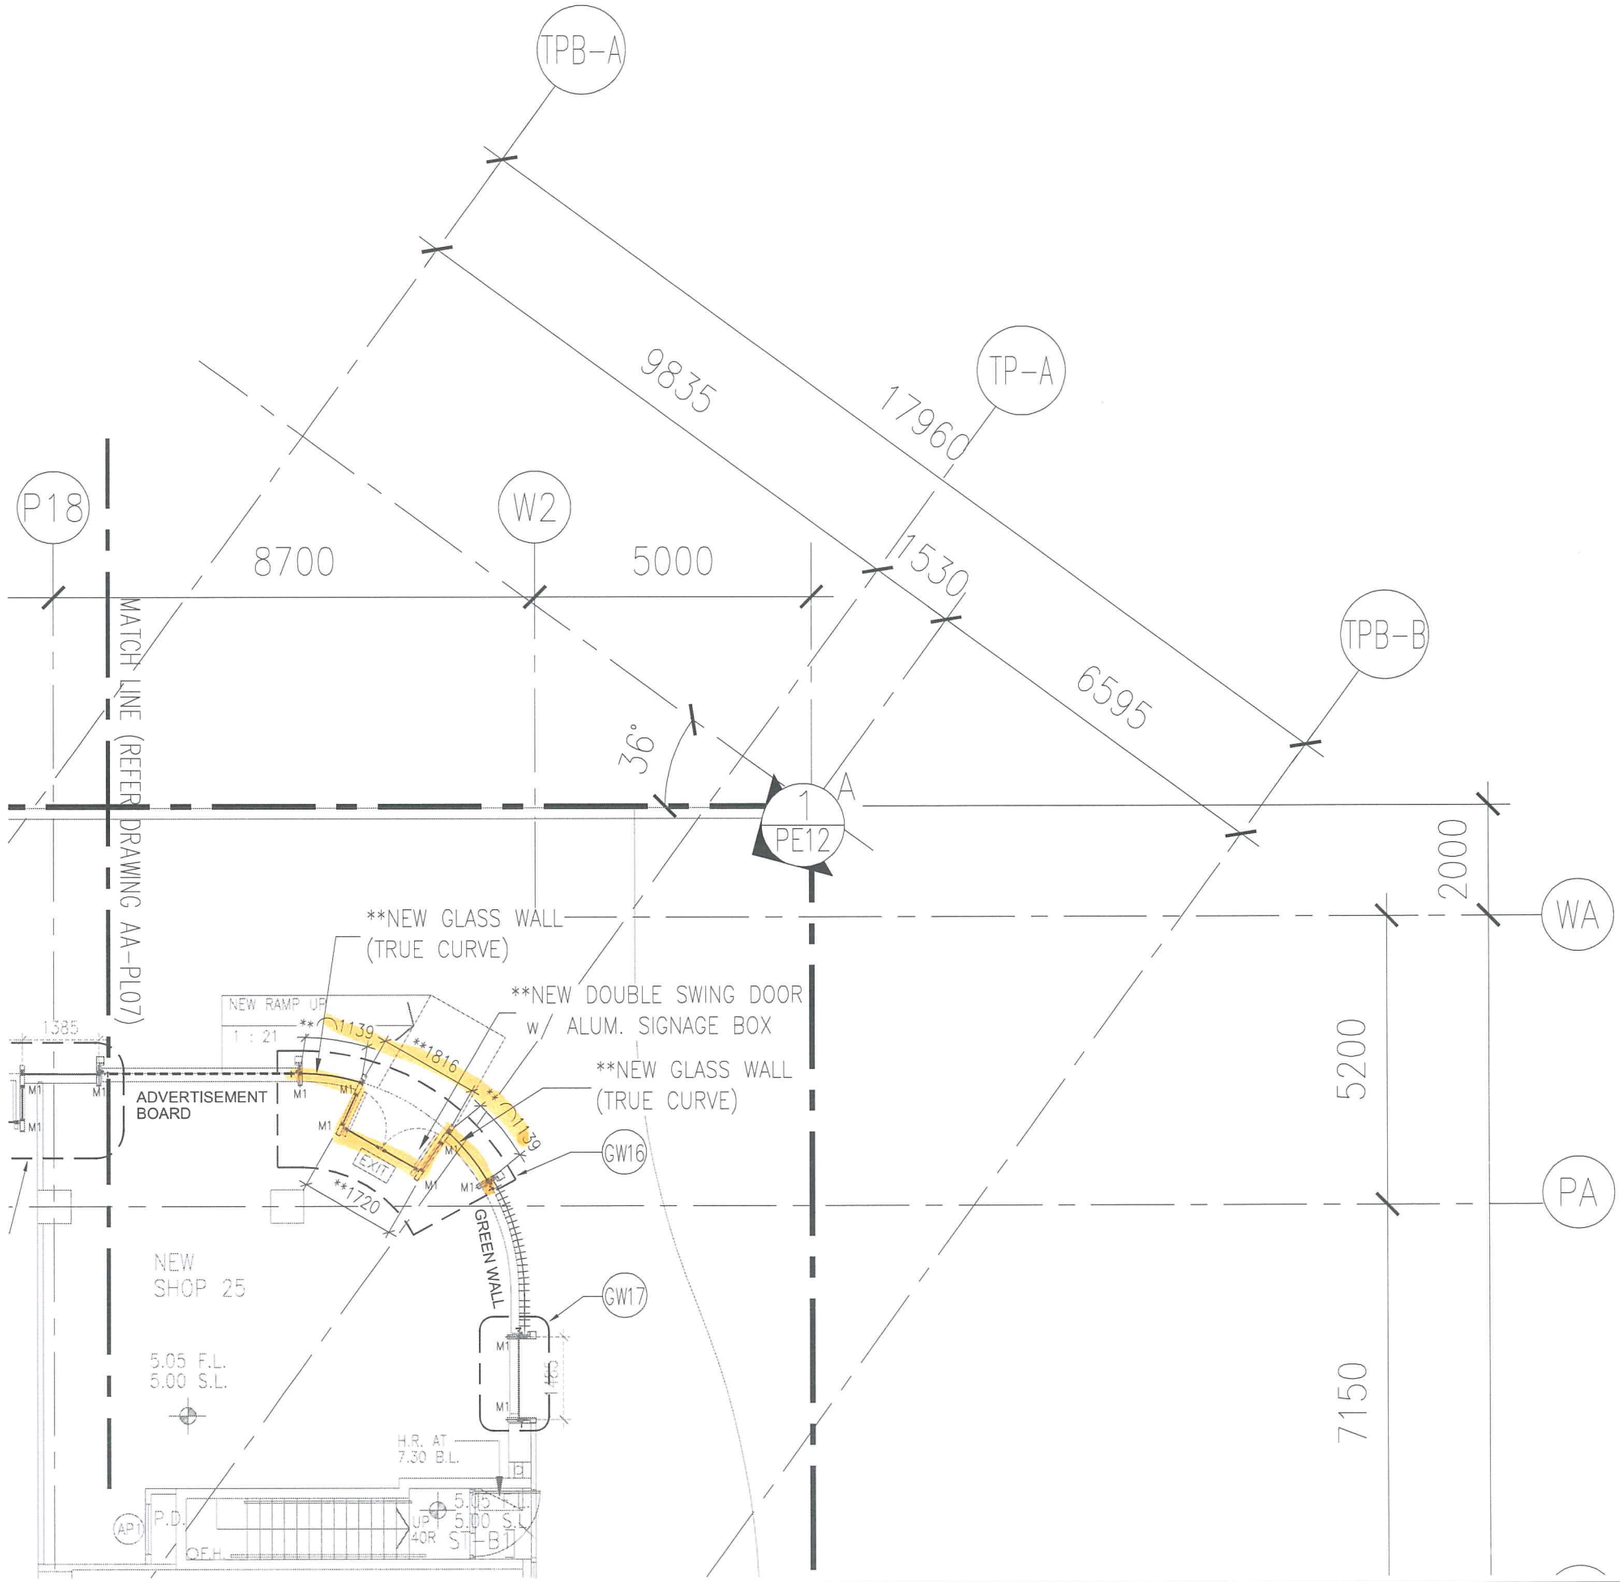

B.D. Ref.

F.P.B. Ref.

Legend :

1. F.F.L.-- Finished Floor Level
2. S.F.L.-- Structural Floor Level
3. (/R) -- Reversed Detail

X1 — DETAIL MARK NO.
X001 — REFER SHEET NO.

** -- FOR THIS SUBMISSION

GBP ref. no.: 4800-LA02

11/02/19 A REVISED ARCHITECT'S COMMENTS

DATE/REVISION/AMENDMENTS

SUN HUNG KAI
ARCHITECTS AND ENGINEERS LTD.

SUN HUNG KAI CENTRE, WANCHAI, HONGKONG
TEL. 28278111 FAX. 28272884

YEE FAI CONTRACTORS CO. LTD.

44/F SUN HUNG KAI CENTRE, WANCHAI, HONGKONG
TEL. 28278111 FAX. 28270717

美特鋁質有限公司
MIDI ALUMINIUM FABRICATOR LTD.
Units 6-8, Sunray Industrial Centre, 1/F
610 Cha Kwo Ling Road, Kowloon
Tel: 23489211-4 Fax:(852)27727666

This drawing and design are copyright of the authorized person. No portion may be reproduced without his written permission. Use written dimensions. Measurements to existing works to be verified on site. This drawing shall be read in conjunction with specification and condition of contract.

PROJECT

PROPOSED RESIDENTIAL
DEVELOPMENT AT
TSEUNG KWAN O
AREA 66D2, T.K.O.T.L. 118

TITLE

G/F PARTIAL PLAN OF
A & A WORKS AT PODIUM

FILE NAME

DRAWN BY

CHECKED BY

PRINTED DATE


SCALE 1:100

JOB No.	DRAWING No.	REV.
J-835	J835-AA-PL08	A

R.S.E.

FOR B.D. APPROVAL

加工範圍

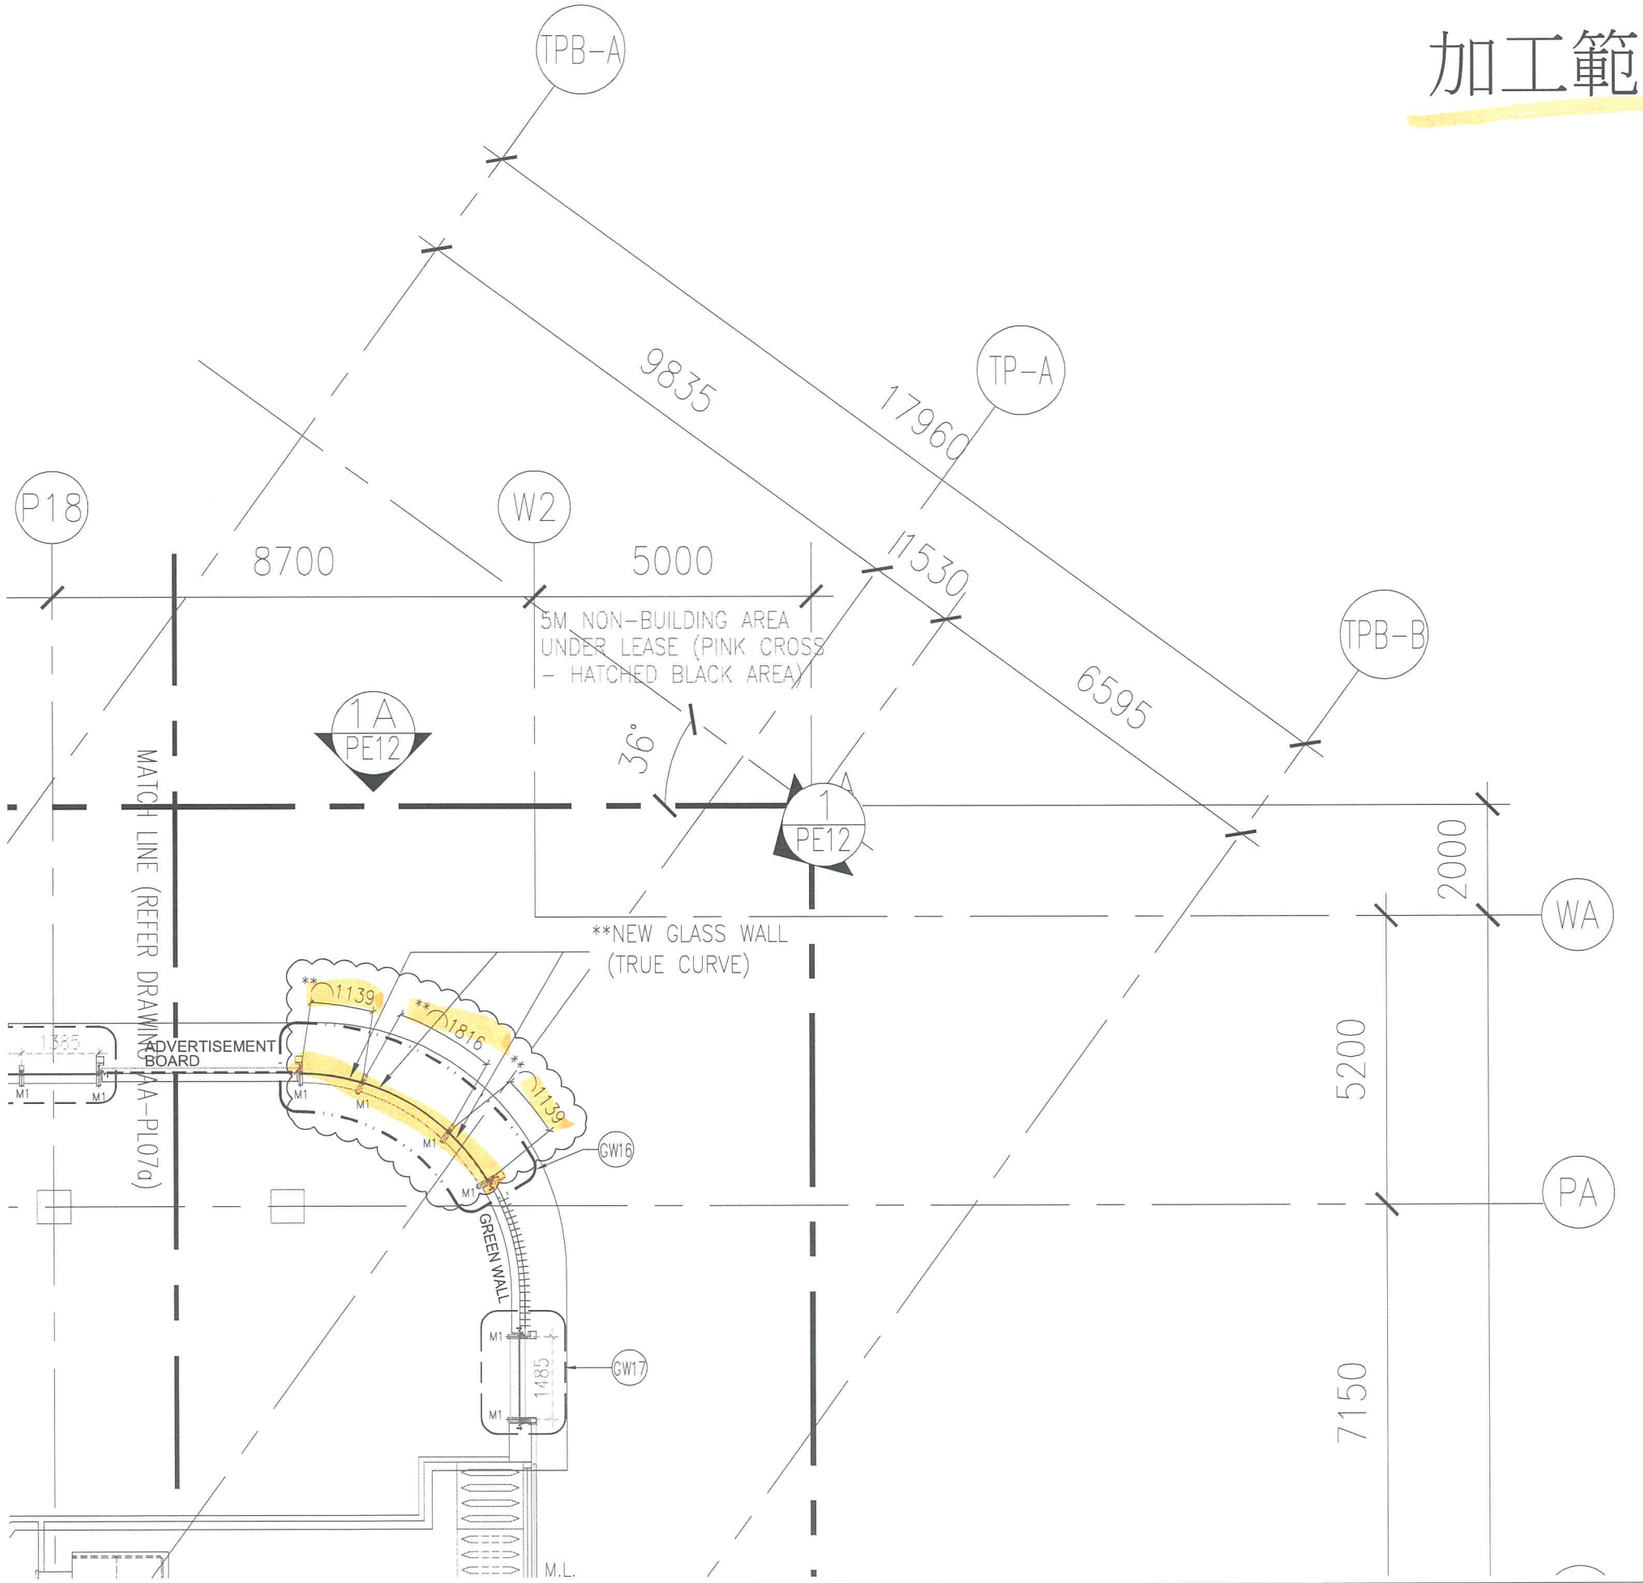

B.D. Ref.

F.P.B. Ref.

Legend :

1. F.F.L.-- Finished Floor Level
2. S.F.L.-- Structural Floor Level
3. /R -- Reversed Detail

X1 — DETAIL MARK NO.
X001 — REFER SHEET NO.

** -- FOR THIS SUBMISSION

GBP ref. no.: 4800-LA02

11/02/19 A REVISED ARCHITECT'S COMMENTS

DATE/REVISION/AMENDMENTS

SUN HUNG KAI ARCHITECTS AND ENGINEERS LTD.
SUN HUNG KAI CENTRE, WANCHAI, HONGKONG
TEL. 28278111 FAX. 28272884

YEE FAI CONTRACTORS CO. LTD.
44/F SUN HUNG KAI CENTRE, WANCHAI, HONGKONG
TEL. 28278111 FAX. 28270717

美特鋁質有限公司
MIDI ALUMINIUM FABRICATOR LTD.
Units 6-8, Sunray Industrial Centre, 1/F
610 Cha Kwo Ling Road, Kowloon
Tel: 23489211-4 Fax: (852)27727666

This drawing and design are copyright of the authorized person. No portion may be reproduced without his written permission. Use written dimensions. Measurements to existing works to be verified on site. This drawing shall be read in conjunction with specification and condition of contract.

PROJECT

PROPOSED RESIDENTIAL
DEVELOPMENT AT
TSEUNG KWAN O
AREA 66D2, T.K.O.T.L. 118

TITLE

1/F PARTIAL PLAN OF
A & A WORKS AT PODIUM

FILE NAME

DRAWN BY

CHECKED BY

PRINTED DATE


SCALE 1:100

JOB No.	DRAWING No.	REV.
J-835	J835-GW-PL08a	A


R.S.E.

FOR B.D. APPROVAL

A1H

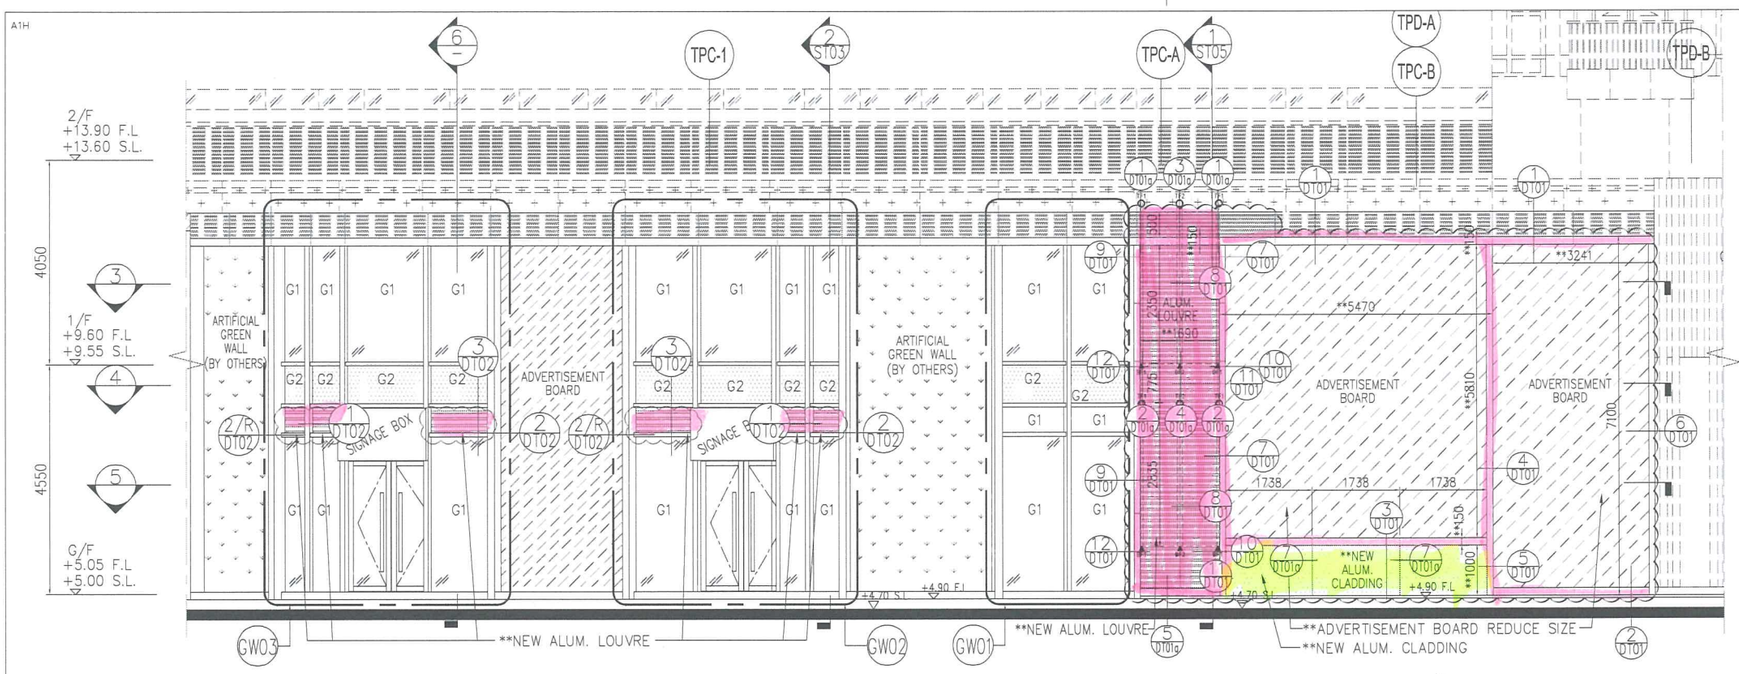

1 PARTIAL ELEVATION

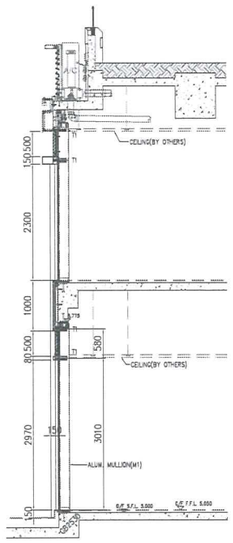


6 SECTION

加工範圍

鋁料加工

摺件

玻璃組裝

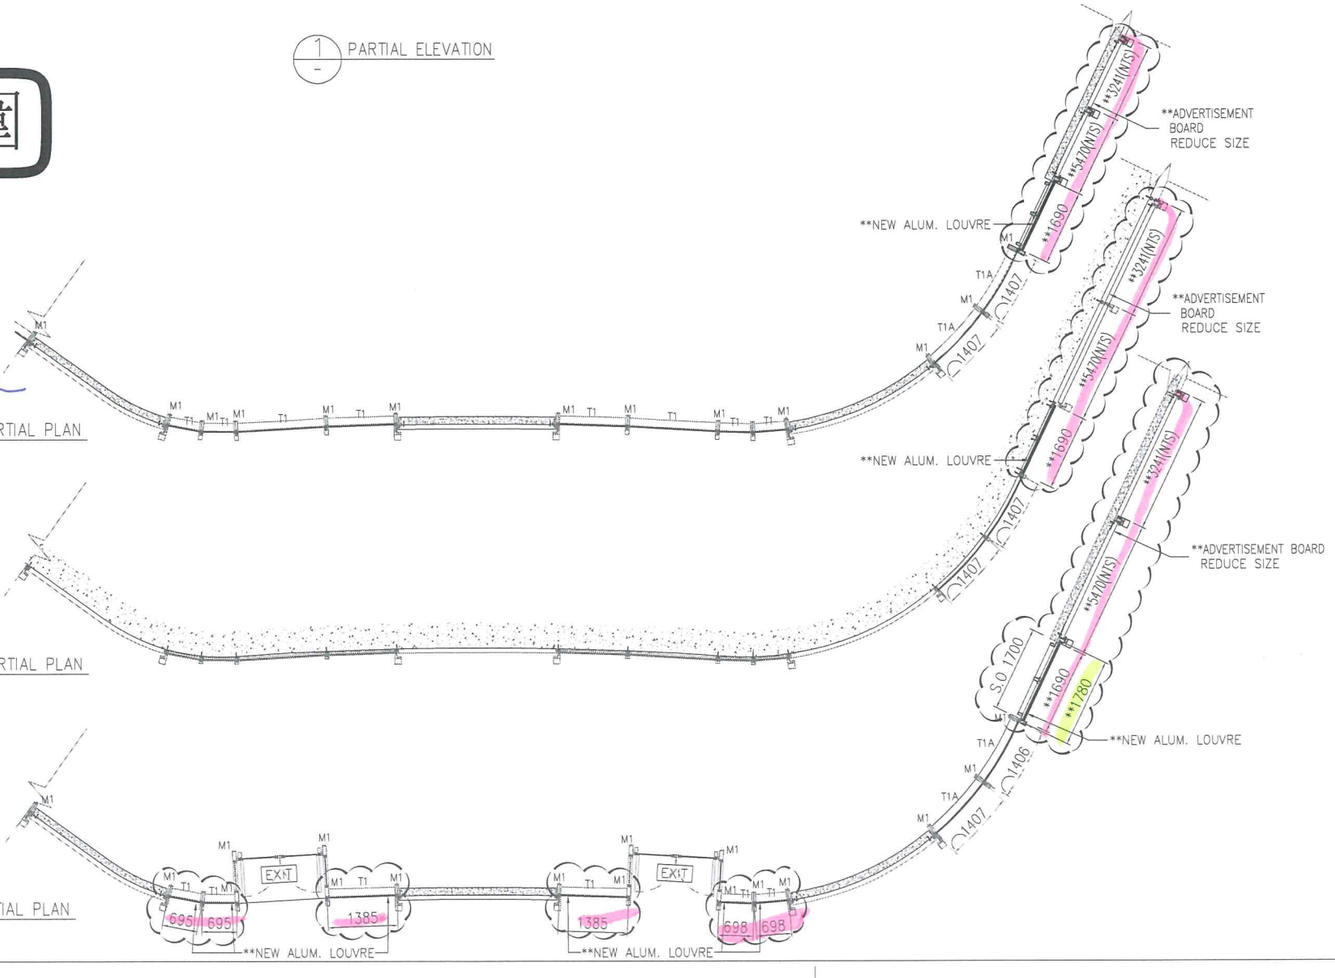

3 PARTIAL PLAN

4 PARTIAL PLAN

5 PARTIAL PLAN

LEGEND:

- G1 — 12mm THK. CLEAR TEMPERED GLASS
- G2 — 12mm THK. CLEAR TEMPERED GLASS + ALUM. BACK PANEL
- ALUM. LOUVER

M1: ALUM. MULLION (REF. TO J835-GW-GN02)
T1: ALUM. TRANSOM (REF. TO J835-GW-GN02)
NTS: NOT TO SCALE

B.D. Ref.

F.P.B. Ref.

Legend :

1. F.F.L.-- Finished Floor Level
2. S.F.L.-- Structural Floor Level
3. /R -- Reversed Detail

X1 — DETAIL MARK NO.
X001 — REFER SHEET NO.

** -- FOR THIS SUBMISSION

DATE/REVISION/AMENDMENTS		
21/01/19	A	MODIFY SETTING OUT
11/02/19	B	REVISED ARCHITECT'S COMMENTS
04/04/19	C	REVISED ARCHITECT'S COMMENTS

SUN HUNG KAI ARCHITECTS AND ENGINEERS LTD.
SUN HUNG KAI CENTRE, WANCHAI, HONGKONG
TEL. 28278111 FAX. 28272884

YEE FAI CONTRACTORS CO. LTD.
44/F SUN HUNG KAI CENTRE, WANCHAI, HONGKONG
TEL. 28278111 FAX. 28270717

美特鋁製有限公司
MIDI ALUMINIUM FABRICATOR LTD.
Units 6-8, Sunray Industrial Centre, 1/F
610 Cha Kwo Ling Road, Kowloon
Tel: 23489211-4 Fax: (852)27727666

This drawing and design are copyright of the authorized person. No portion may be reproduced without his written permission. Use written dimensions. Measurements to existing works to be verified on site. This drawing shall be read in conjunction with specification and condition of contract.

PROJECT
PROPOSED RESIDENTIAL DEVELOPMENT AT TSEUNG KWAN O AREA 66D2, T.K.O.T.L. 118

TITLE
PARTIAL ELEVATION & PLAN FOR A & A WORKS AT PODIUM


FILE NAME	
DRAWN BY	
CHECKED BY	
PRINTED DATE	
SCALE	1:110

JOB No.	DRAWING No.	REV.
J-835	J835-AA-PE05	C

R.S.E.


FOR B.D. APPROVAL

A1H

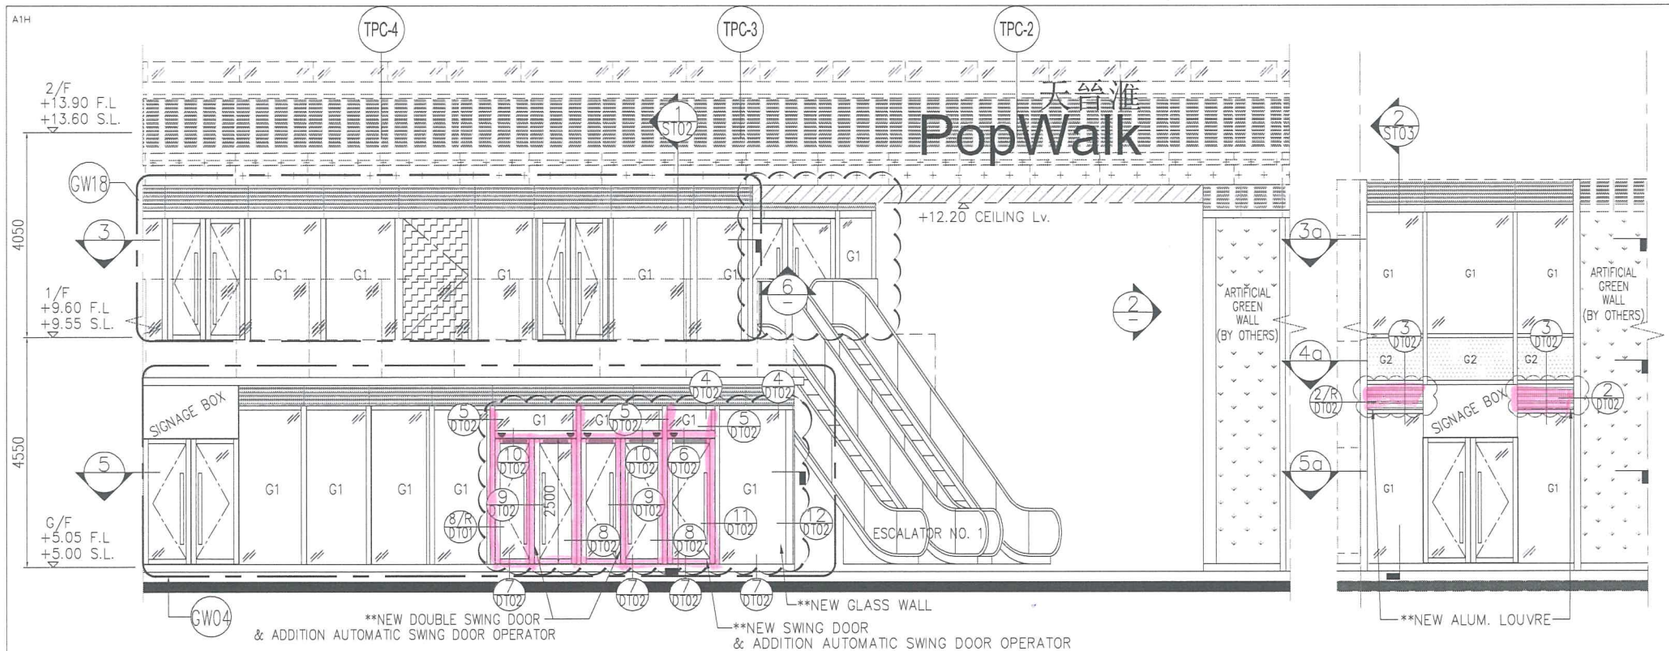

1 PARTIAL ELEVATION

2 PARTIAL ELEVATION

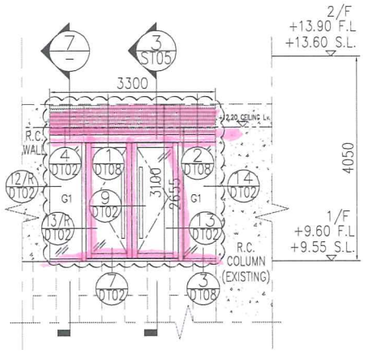



6 PARTIAL ELEVATION
1/F (G.L TPC-4,TPC-C)

LEGEND:

- G1 — 12mm THK. CLEAR TEMPERED GLASS
- G2 — 12mm THK. CLEAR TEMPERED GLASS + ALUM. BACK PANEL
- ALUM. LOUVER


M1: ALUM. MULLION (REF. TO J835-GW-GN02)
T1: ALUM. TRANSOM (REF. TO J835-GW-GN02)
NTS: NOT TO SCALE

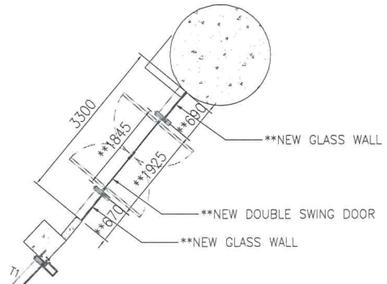


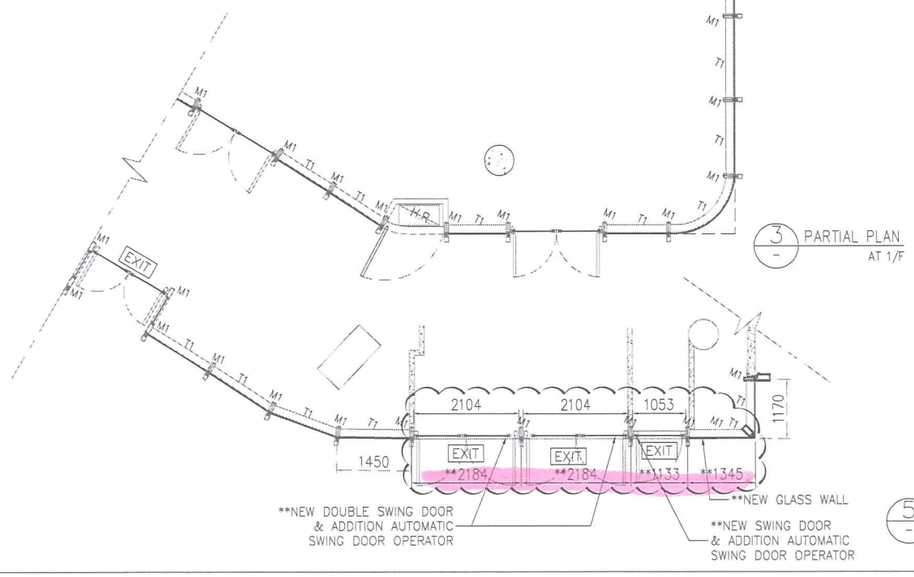

3 PARTIAL PLAN
AT 1/F

5 PARTIAL PLAN
AT G/F

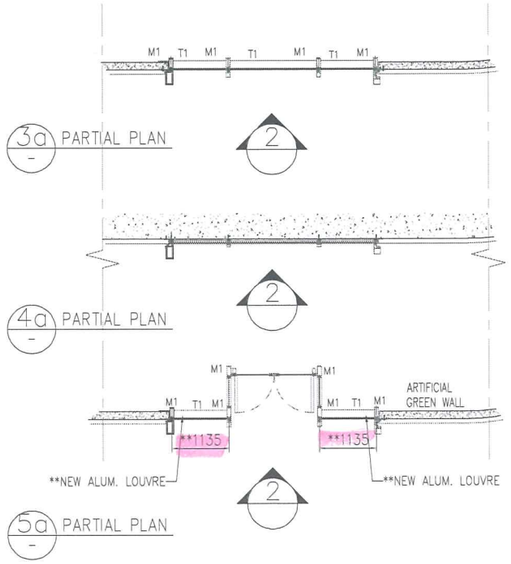

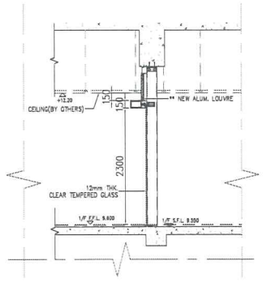

7 PARTIAL SECTION
1/F (G.L TPC-4,TPC-C)

B.D. Ref.

F.P.B. Ref.

Legend :

1. F.F.L.-- Finished Floor Level
2. S.F.L.-- Structural Floor Level
3. /R -- Reversed Detail

X1 — DETAIL MARK NO.
X001 — REFER SHEET NO.

** -- FOR THIS SUBMISSION

21/01/19	A	MODIFY SETTING OUT
11/02/19	B	REVISED ARCHITECT'S COMMENTS
04/04/19	C	ADDITIONAL WORKS AT 1/F AREA

DATE/REVISION/AMENDMENTS

SUN HUNG KAI
ARCHITECTS AND ENGINEERS LTD.
SUN HUNG KAI CENTRE, WANCHAI, HONGKONG
TEL. 28278111 FAX. 28272884

YEE FAI CONTRACTORS CO. LTD.
44/F SUN HUNG KAI CENTRE, WANCHAI, HONGKONG
TEL. 28278111 FAX. 28270717

美特鋁貿有限公司
MIDI ALUMINIUM FABRICATOR LTD.
Units 6-8, Sunray Industrial Centre, 1/F
610 Cha Kwo Ling Road, Kowloon
Tel: 23489211-4 Fax:(852)27727666

This drawing and design are copyright of the authorized person. No portion may be reproduced without his written permission. Use written dimensions. Measurements to existing works to be verified on site. This drawing shall be read in conjunction with specification and condition of contract.

PROJECT

PROPOSED RESIDENTIAL
DEVELOPMENT AT
TSEUNG KWAN O
AREA 66D2, T.K.O.T.L. 118

TITLE

PARTIAL ELEVATION & PLAN
FOR A & A WORKS AT PODIUM

FILE NAME

DRAWN BY

CHECKED BY

PRINTED DATE


SCALE 1:110

JOB No.	DRAWING No.	REV.
J-835	J835-AA-PE06	C


R.S.E.

FOR B.D. APPROVAL


A1H

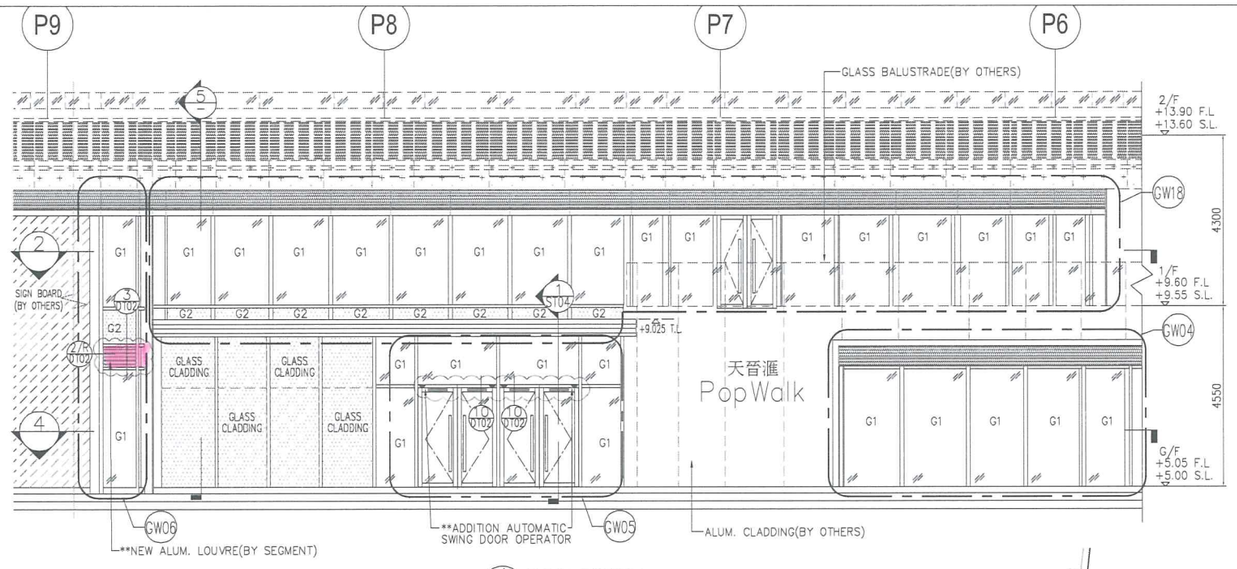


1 PARTIAL ELEVATION

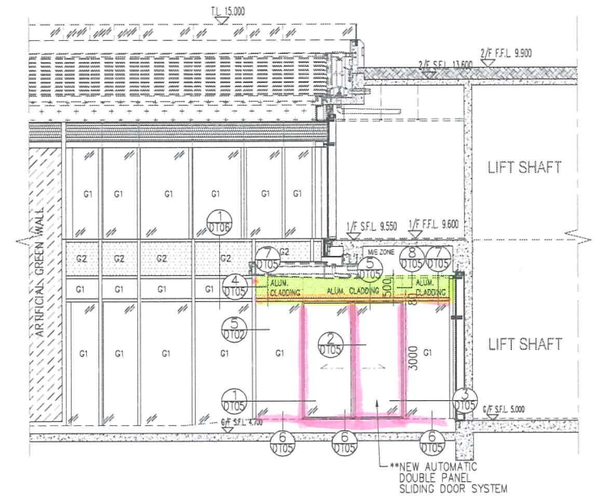

5 PARTIAL ELEVATION

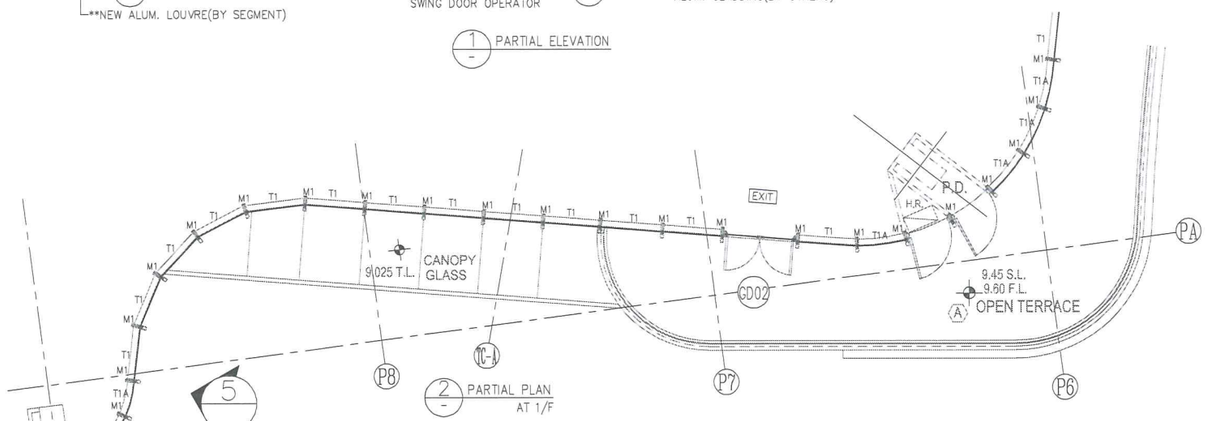

2 PARTIAL PLAN AT 1/F

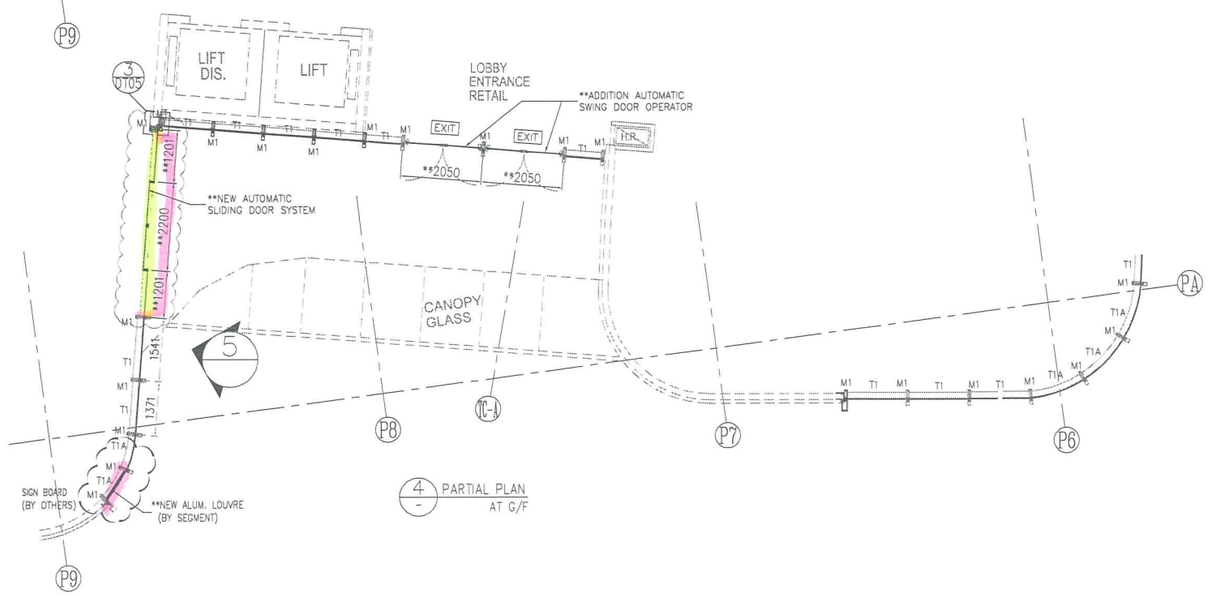

4 PARTIAL PLAN AT G/F

LEGEND:

- G1 — 12mm THK. CLEAR TEMPERED GLASS
- G2 — 12mm THK. CLEAR TEMPERED GLASS + ALUM. BACK PANE
- ALUM. LOUVER
- ALUM. CLADDING

M1: ALUM. MULLION (REF. TO J835-AA-GN02)
T1: ALUM. TRANSOM (REF. TO J835-AA-GN02)

B.D. Ref.

F.P.B. Ref.

Legend :

1. F.F.L.-- Finished Floor Level
2. S.F.L.-- Structural Floor Level
3. /R -- Reversed Detail

X1 ---------- DETAIL MARK NO.
X001 ---------- REFER SHEET NO.

** -- FOR THIS SUBMISSION

21/01/19	A	MODIFY SETTING OUT
04/04/19	B	GENERAL REVISION

DATE/REVISION/AMENDMENTS

SUN HUNG KAI ARCHITECTS AND ENGINEERS LTD.
SUN HUNG KAI CENTRE, WANCHAI, HONGKONG
TEL. 28278111 FAX. 28272884

YEE FAI CONTRACTORS CO. LTD.
44/F SUN HUNG KAI CENTRE, WANCHAI, HONGKONG
TEL. 28278111 FAX. 28270717

美特鋁質有限公司
MIDI ALUMINIUM FABRICATOR LTD.
Units 6-8, Sunray Industrial Centre, 1/F
610 Cha Kwo Ling Road, Kowloon
Tel: 23489211-4 Fax: (852)27727666

This drawing and design are copyright of the authorized person. No portion may be reproduced without his written permission. Use written dimensions. Measurements to existing works to be verified on site. This drawing shall be read in conjunction with specification and condition of contract.

PROJECT

PROPOSED RESIDENTIAL DEVELOPMENT AT TSEUNG KWAN O AREA 66D2, T.K.O.T.L. 118

TITLE

PARTIAL ELEVATION & PLAN FOR A & A WORKS AT PODIUM

FILE NAME

DRAWN BY

CHECKED BY

PRINTED DATE

SCALE 1:100

JOB No.	DRAWING No.	REV.
J-835	J835-AA-PE08	B

R.S.E.

FOR B.D. APPROVAL

A1H

LEGEND:


G1 — 12mm THK. CLEAR TEMPERED GLASS


G2 — 12mm THK. CLEAR TEMPERED GLASS + ALUM. BACK PANEL

ALUM. LOUVER


M1: ALUM. MULLION (REF. TO J835-AA-GN02)

T1: ALUM. TRANSOM (REF. TO J835-AA-GN02)

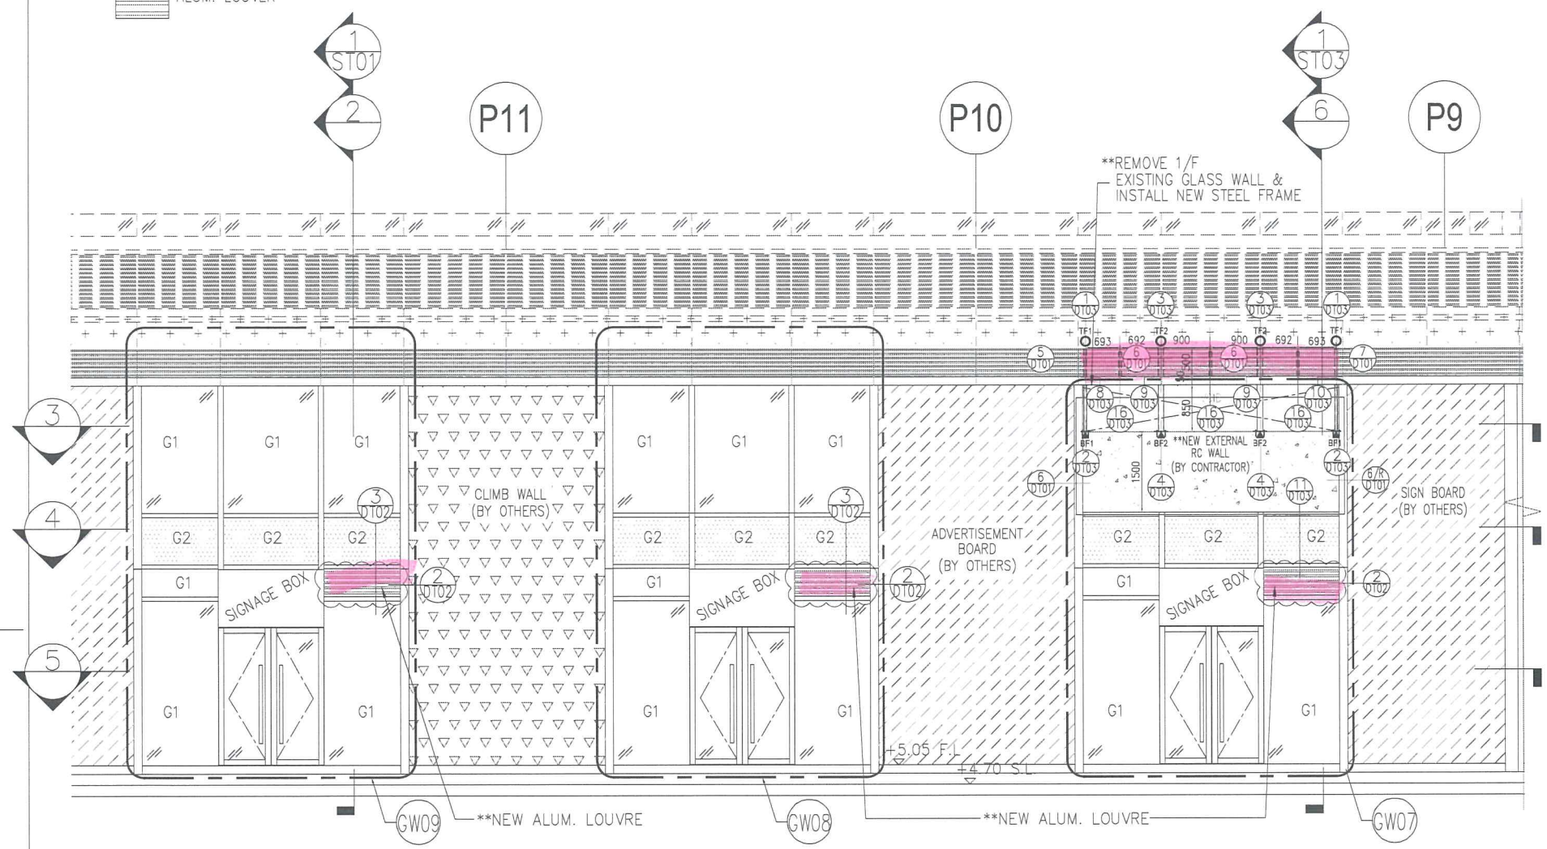

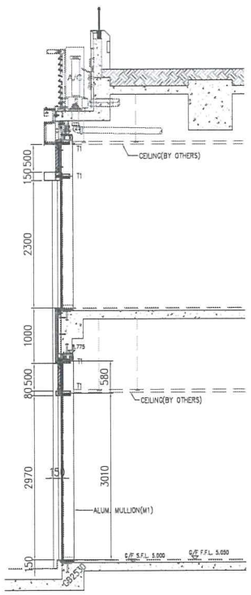


2 SECTION

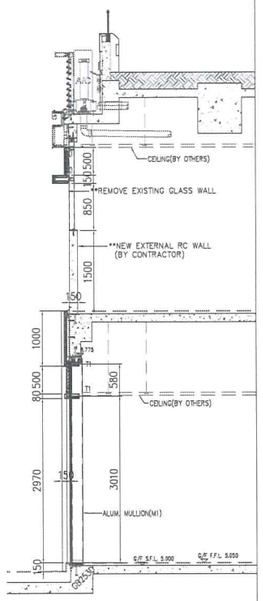

6 SECTION

1 PARTIAL ELEVATION

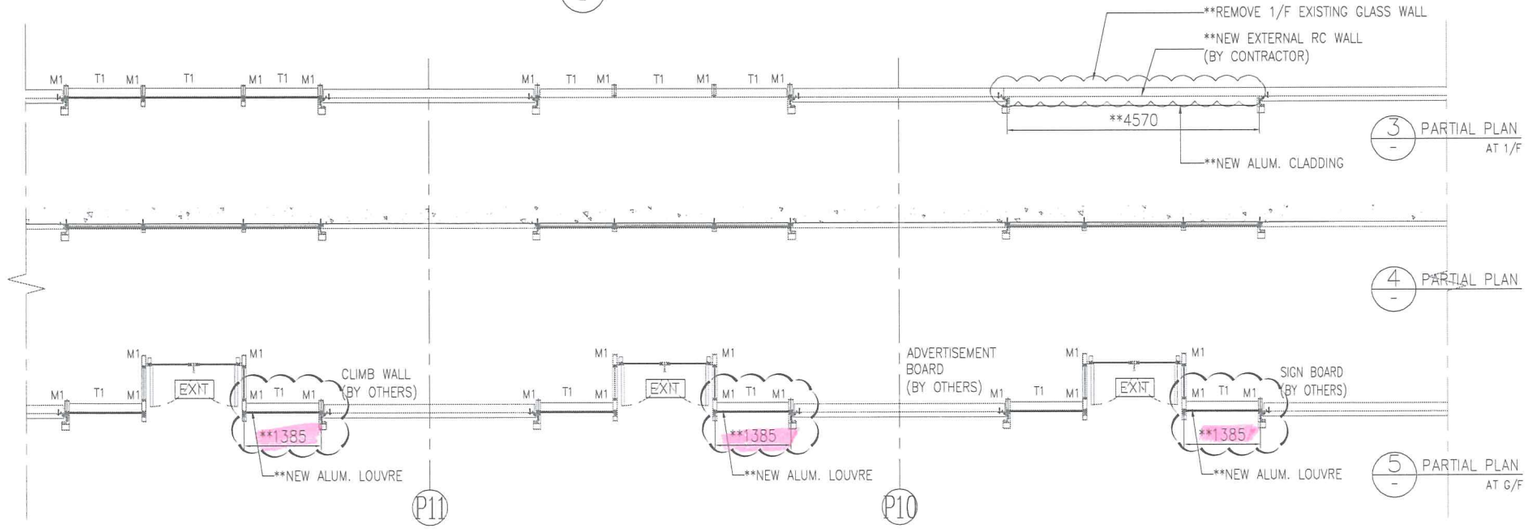

3 PARTIAL PLAN AT 1/F

4 PARTIAL PLAN

5 PARTIAL PLAN AT G/F

B.D. Ref.

F.P.B. Ref.

Legend :

1. F.F.L.-- Finished Floor Level
2. S.F.L.-- Structural Floor Level
3. /R -- Reversed Detail

X1 — DETAIL MARK NO.
X001 — REFER SHEET NO.

** -- FOR THIS SUBMISSION

21/01/19	A	MODIFY SETTING OUT
11/02/19	B	REVISED ARCHITECT'S COMMENTS
04/04/19	C	GENERAL REVISION

DATE/REVISION/AMENDMENTS

SUN HUNG KAI ARCHITECTS AND ENGINEERS LTD.
SUN HUNG KAI CENTRE, WANCHAI, HONGKONG
TEL. 28278111 FAX. 28272884

YEE FAI CONTRACTORS CO. LTD.
44/F SUN HUNG KAI CENTRE, WANCHAI, HONGKONG
TEL. 28278111 FAX. 28270717

美特鋁質有限公司
MIDI ALUMINIUM FABRICATOR LTD.
Units 6-8, Sunray Industrial Centre, 1/F
610 Cha Kwo Ling Road, Kowloon
Tel: 23489211-4 Fax: (852)27727666

This drawing and design are copyright of the authorized person. No portion may be reproduced without his written permission. Use written dimensions. Measurements to existing works to be verified on site. This drawing shall be read in conjunction with specification and condition of contract.

PROJECT

PROPOSED RESIDENTIAL DEVELOPMENT AT TSEUNG KWAN O AREA 66D2, T.K.O.T.L. 118

TITLE

PARTIAL ELEVATION & PLAN FOR A & A WORKS AT PODIUM

FILE NAME

DRAWN BY

CHECKED BY

PRINTED DATE


SCALE 1:100

JOB No.	DRAWING No.	REV.
J-835	J835-AA-PE09	C


R.S.E.

FOR B.D. APPROVAL


A1H

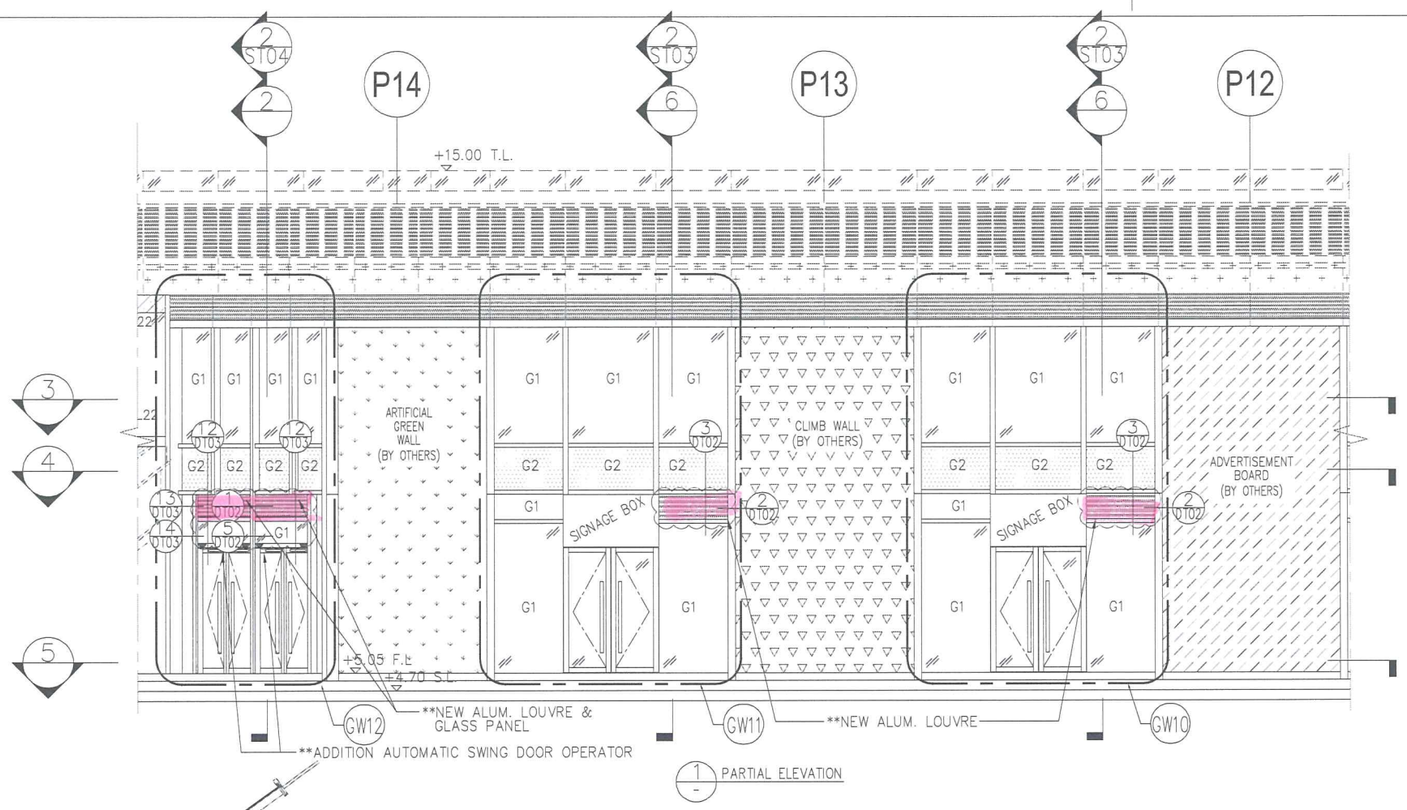


1 PARTIAL ELEVATION

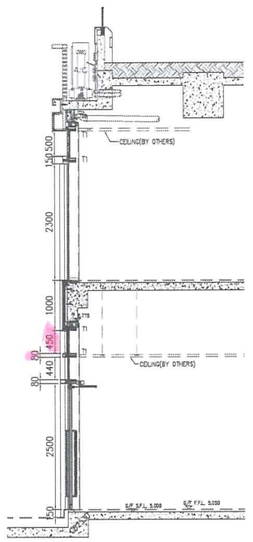

2 SECTION

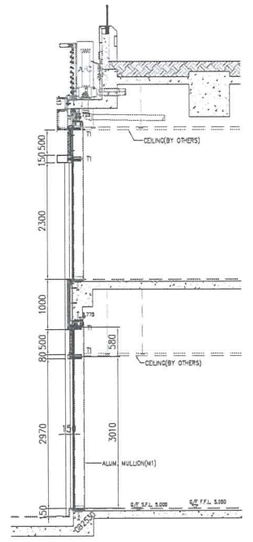

6 SECTION

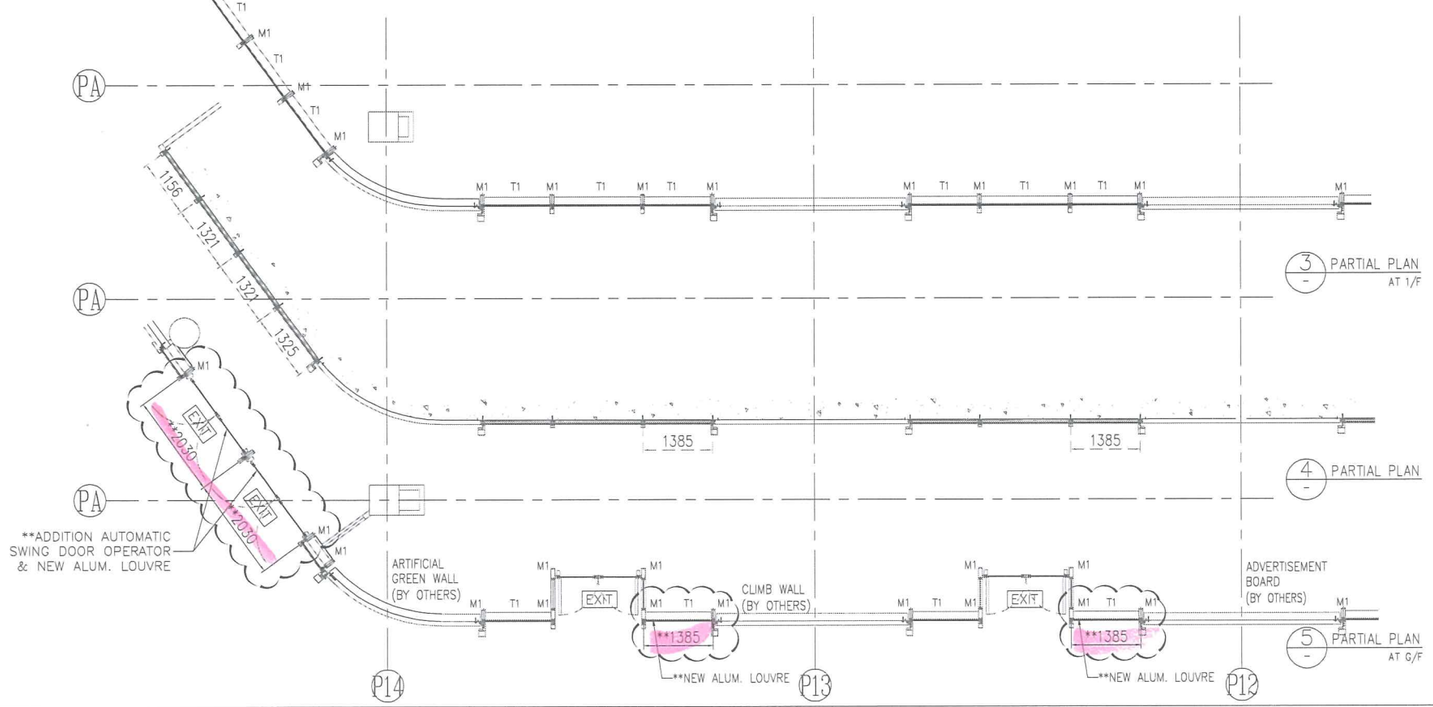

3 PARTIAL PLAN AT 1/F

4 PARTIAL PLAN

5 PARTIAL PLAN AT G/F

LEGEND:

- G1 — 12mm THK. CLEAR TEMPERED GLASS
- G2 — 12mm THK. CLEAR TEMPERED GLASS + ALUM. BACK PANEL
- ALUM. LOUVER
- M1: ALUM. MULLION (REF. TO J835-AA-GN02)
- T1: ALUM. TRANSOM (REF. TO J835-AA-GN02)

B.D. Ref.

F.P.B. Ref.

Legend :

1. F.F.L.-- Finished Floor Level
2. S.F.L.-- Structural Floor Level
3. (/R) -- Reversed Detail

X1 — DETAIL MARK NO.
X001 — REFER SHEET NO.

** -- FOR THIS SUBMISSION

DATE		DATE/REVISION/AMENDMENTS
21/01/19	A	MODIFY SETTING OUT
04/04/19	B	GENERAL REVISION

SUN HUNG KAI ARCHITECTS AND ENGINEERS LTD.
SUN HUNG KAI CENTRE, WANCHAI, HONGKONG
TEL. 28278111 FAX. 28272884

YEE FAI CONTRACTORS CO. LTD.
44/F SUN HUNG KAI CENTRE, WANCHAI, HONGKONG
TEL. 28278111 FAX. 28270717

美特鋁質有限公司
MIDI ALUMINIUM FABRICATOR LTD.
Units 6-8, Sunray Industrial Centre, 1/F
610 Cha Kwo Ling Road, Kowloon
Tel: 23489211-4 Fax: (852)27727666

This drawing and design are copyright of the authorized person. No portion may be reproduced without his written permission. Use written dimensions. Measurements to existing works to be verified on site. This drawing shall be read in conjunction with specification and condition of contract.

PROJECT

PROPOSED RESIDENTIAL DEVELOPMENT AT TSEUNG KWAN O AREA 66D2, T.K.O.T.L. 118

TITLE

PARTIAL ELEVATION & PLAN FOR A & A WORKS AT PODIUM


FILE NAME	
DRAWN BY	
CHECKED BY	
PRINTED DATE	
SCALE	1:100

JOB No.	DRAWING No.	REV.
J-835	J835-AA-PE10	B

R.S.E.


FOR B.D. APPROVAL

A1H

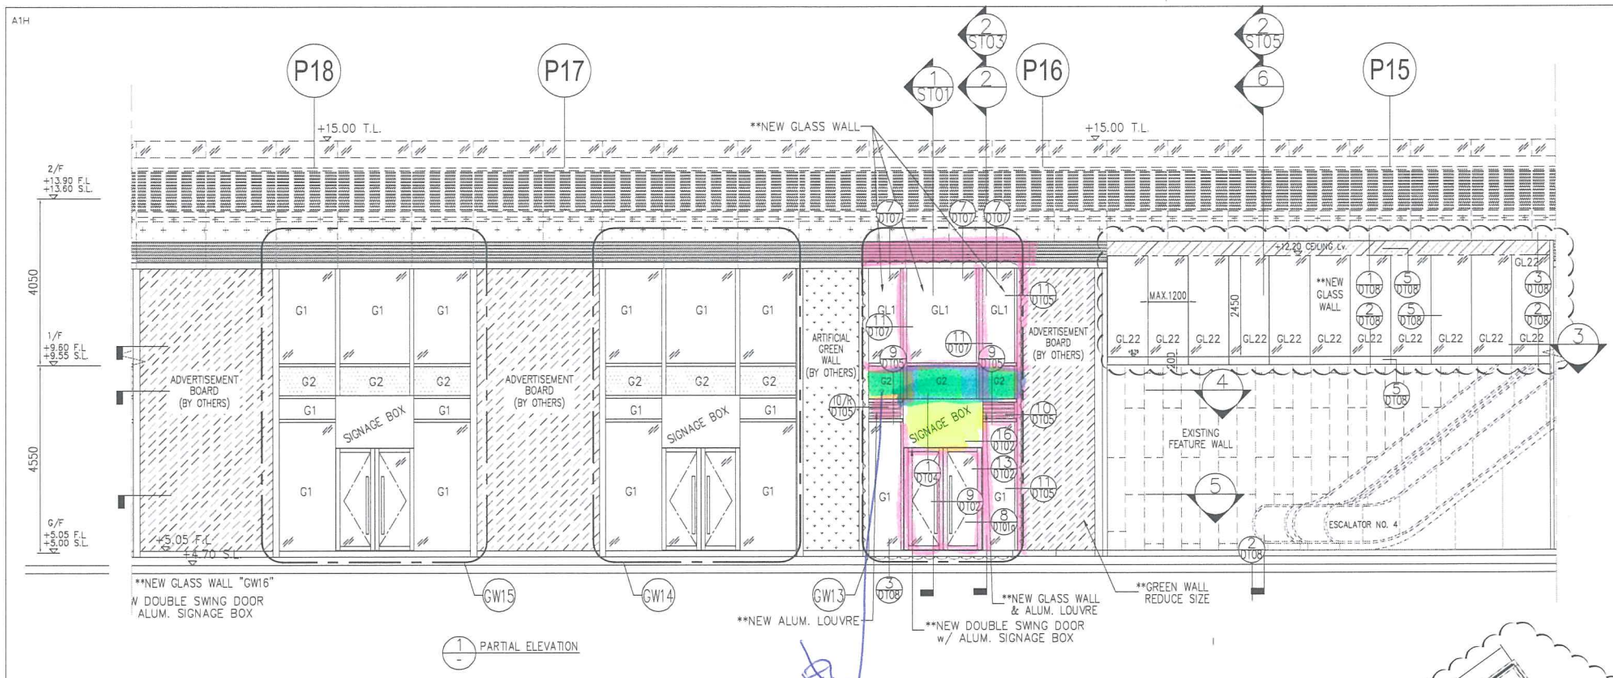


1 - PARTIAL ELEVATION


由 玻璃廠組裝

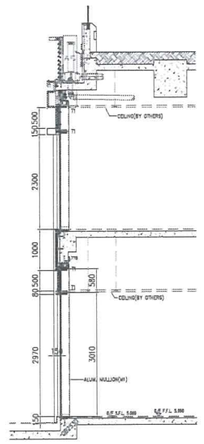

2 - SECTION

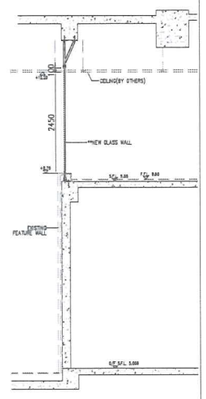

6 - SECTION
1/F GLASS WALL

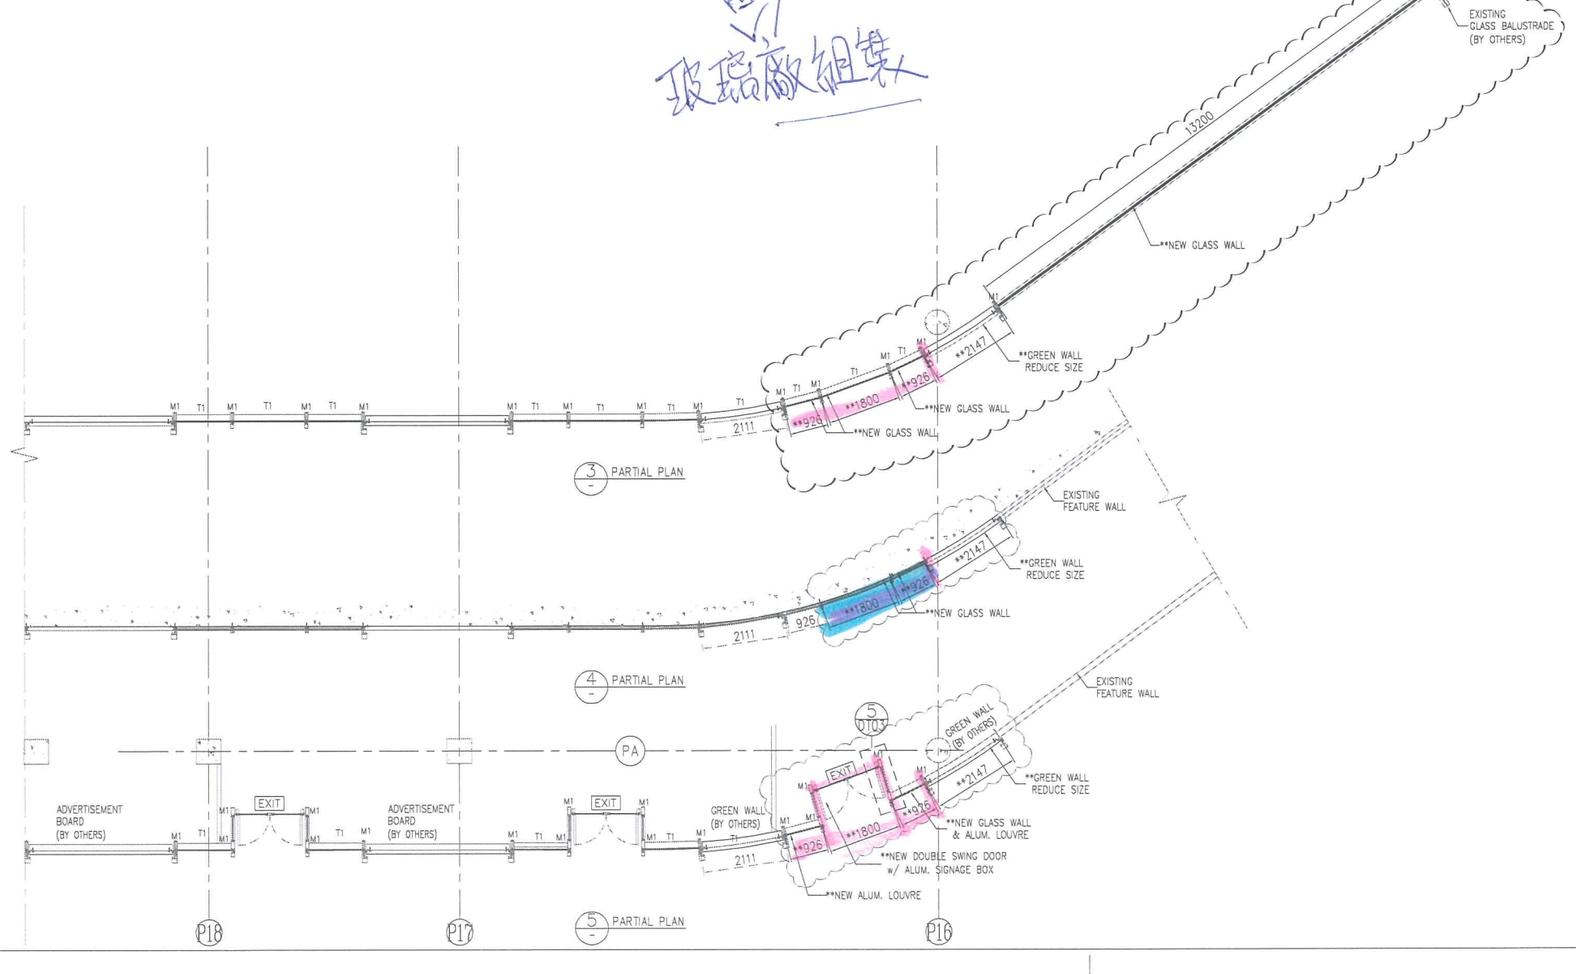

LEGEND:

- G1 — 12mm THK. CLEAR TEMPERED GLASS
- G2 — 12mm THK. CLEAR TEMPERED GLASS + ALUM. BACK PANEL
- GL1 — 8+1.5PVB+8mm THK. LAMINATED TEMPERED GLASS
- GL22 — 22+2.3PVB+22mm THK. LAMINATED TEMPERED GLASS
- ALUM. LOUVER

M1: ALUM. MULLION (REF. TO J835-AA-GN02)
T1: ALUM. TRANSOM (REF. TO J835-AA-GN02)

B.D. Ref.

F.P.B. Ref.

Legend :
1. F.F.L.-- Finished Floor Level
2. S.F.L.-- Structural Floor Level
3. /18 -- Reversed Detail
X1 — DETAIL MARK NO.
X001 — REFER SHEET NO.
** -- FOR THIS SUBMISSION

21/01/19	A	MODIFY SETTING OUT
11/02/19	B	REVISED ARCHITECT'S COMMENTS
04/04/19	C	ADDITIONAL WORKS AT 1/F AREA

DATE/REVISION/AMENDMENTS

SUN HUNG KAI ARCHITECTS AND ENGINEERS LTD.
SUN HUNG KAI CENTRE, WANCHAI, HONGKONG
TEL. 28278111 FAX. 28272884

YEE FAI CONTRACTORS CO. LTD.
44/F SUN HUNG KAI CENTRE, WANCHAI, HONGKONG
TEL. 28278111 FAX. 28270717

美特鋁質有限公司
MIDI ALUMINIUM FABRICATOR LTD.
Units 6-8, Sunray Industrial Centre, 1/F
610 Cha Kwo Ling Road, Kowloon
Tel: 23489211-4 Fax: (852)27727666

This drawing and design are copyright of the authorized person. No portion may be reproduced without his written permission. Use written dimensions. Measurements to existing works to be verified on site. This drawing shall be read in conjunction with specification and condition of contract.

PROJECT

PROPOSED RESIDENTIAL DEVELOPMENT AT TSEUNG KWAN O AREA 66D2, T.K.O.T.L. 118

TITLE

PARTIAL ELEVATION & PLAN FOR A & A WORKS AT PODIUM

FILE NAME

DRAWN BY

CHECKED BY


PRINTED DATE

SCALE 1:135


JOB No.	DRAWING No.	REV.
J-835	J835-AA-PE11	C

R.S.E.


FOR B.D. APPROVAL

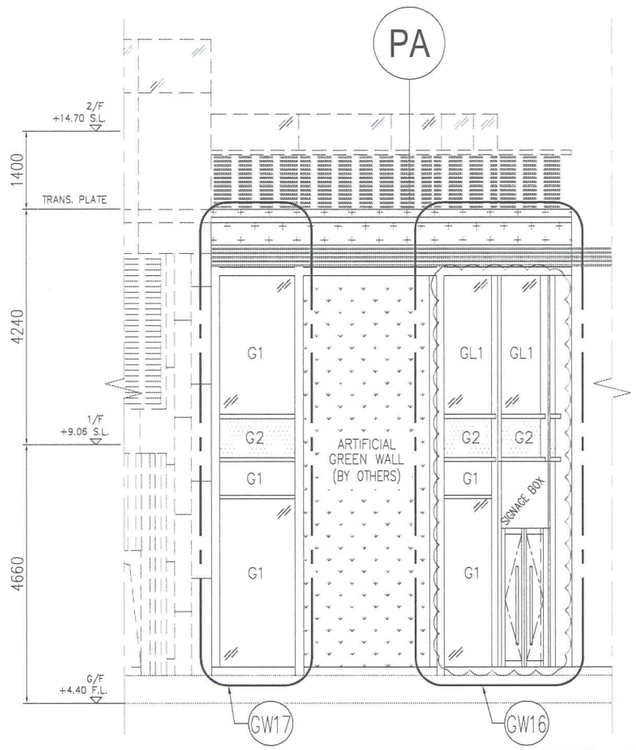


1 PARTIAL ELEVATION

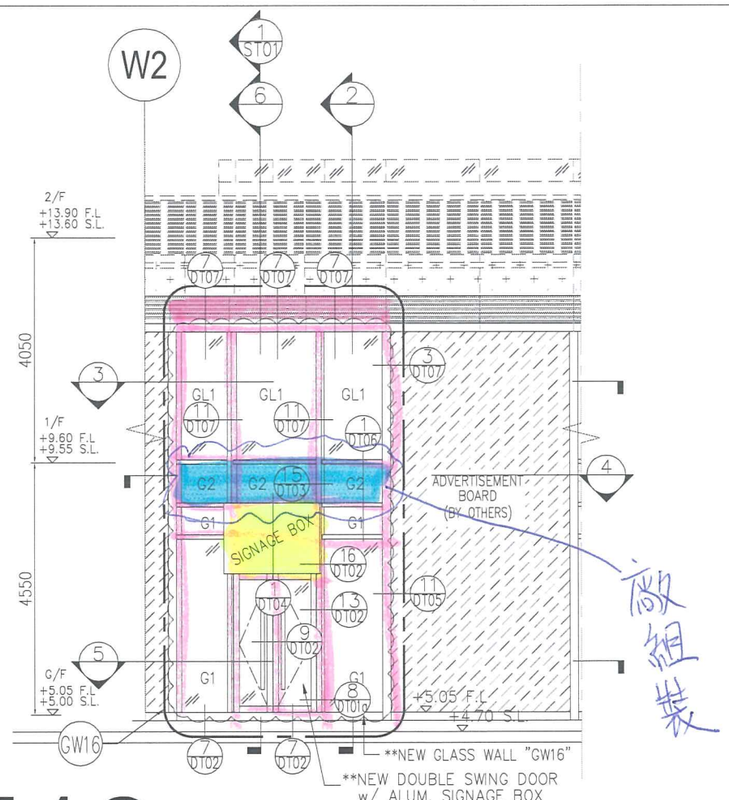

1A PARTIAL ELEVATION

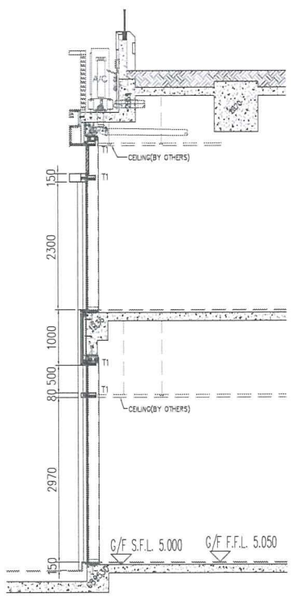


2 SECTION

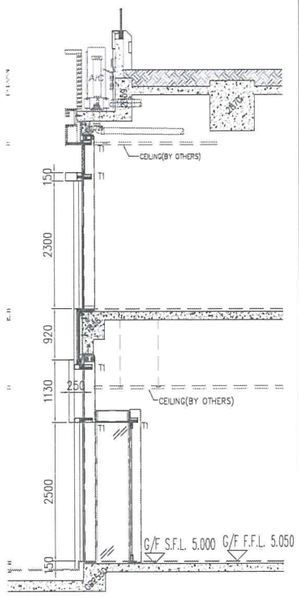


6 SECTION


PE12

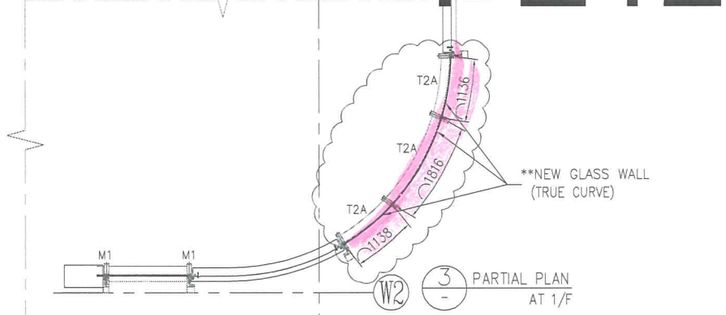

3 PARTIAL PLAN AT 1/F

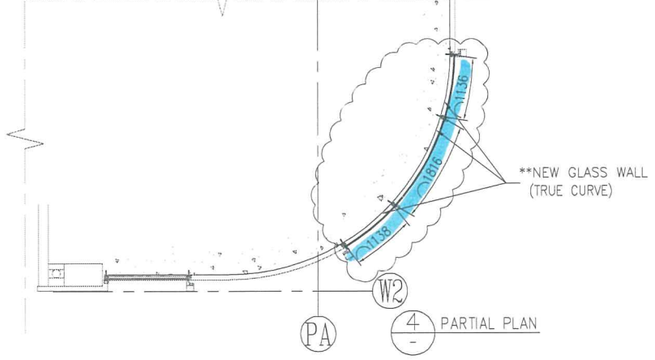

4 PARTIAL PLAN

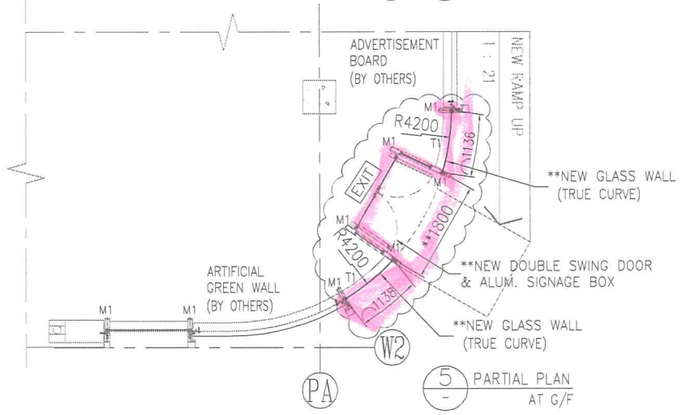

5 PARTIAL PLAN AT G/F

LEGEND:

- G1 — 12mm THK. CLEAR TEMPERED GLASS
- G2 — 12mm THK. CLEAR TEMPERED GLASS + ALUM. BACK PANEL
- GL1 — 8+1.5PVB+8mm THK. LAMINATED TEMPERED GLASS
- ALUM. LOUVER

M1: ALUM. MULLION (REF. TO J835-AA-GN02)
T1: ALUM. TRANSOM (REF. TO J835-AA-GN02)
T2A: ALUM. TRANSOM (REF. TO J835-AA-7/DT08)

B.D. Ref.

F.P.B. Ref.

Legend :

1. F.F.L.-- Finished Floor Level
2. S.F.L.-- Structural Floor Level
3. /R -- Reversed Detail

X1 — DETAIL MARK NO.
X001 — REFER SHEET NO.

** -- FOR THIS SUBMISSION

21/01/19	A	MODIFY SETTING OUT
11/02/19	B	REVISED ARCHITECT'S COMMENTS
05/04/19	C	GENERAL REVISION

DATE/REVISION/AMENDMENTS

SUN HUNG KAI
ARCHITECTS AND ENGINEERS LTD.
SUN HUNG KAI CENTRE, WANCHAI, HONGKONG
TEL. 28278111 FAX. 28272884

YEE FAI CONTRACTORS CO. LTD.
44/F SUN HUNG KAI CENTRE, WANCHAI, HONGKONG
TEL. 28278111 FAX. 28270717

美特鋁製有限公司
MIDI ALUMINIUM FABRICATOR LTD.
Units 6-8, Sunray Industrial Centre, 1/F
610 Cha Kwo Ling Road, Kowloon
Tel: 23489211-4 Fax:(852)27727666

This drawing and design are copyright of the authorized person. No portion may be reproduced without his written permission. Use written dimensions. Measurements to existing works to be verified on site. This drawing shall be read in conjunction with specification and condition of contract.

PROJECT

PROPOSED RESIDENTIAL
DEVELOPMENT AT
TSEUNG KWAN O
AREA 66D2, T.K.O.T.L. 118

TITLE


PARTIAL ELEVATION & PLAN
FOR A & A WORKS AT PODIUM

FILE NAME	
DRAWN BY	
CHECKED BY	
PRINTED DATE	
SCALE	1:100

JOB No.	DRAWING No.	REV.
J-835	J835-AA-PE12	C


R.S.E.

FOR B.D. APPROVAL

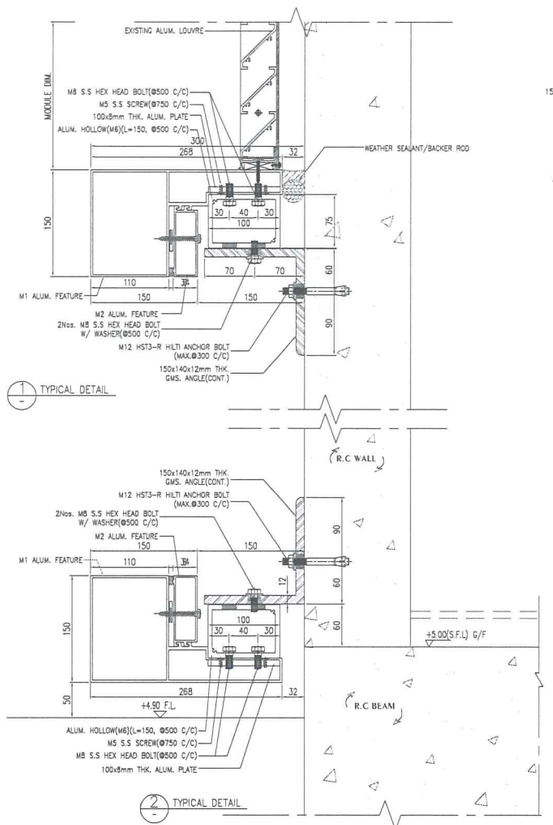


1 TYPICAL DETAIL


2 TYPICAL DETAIL

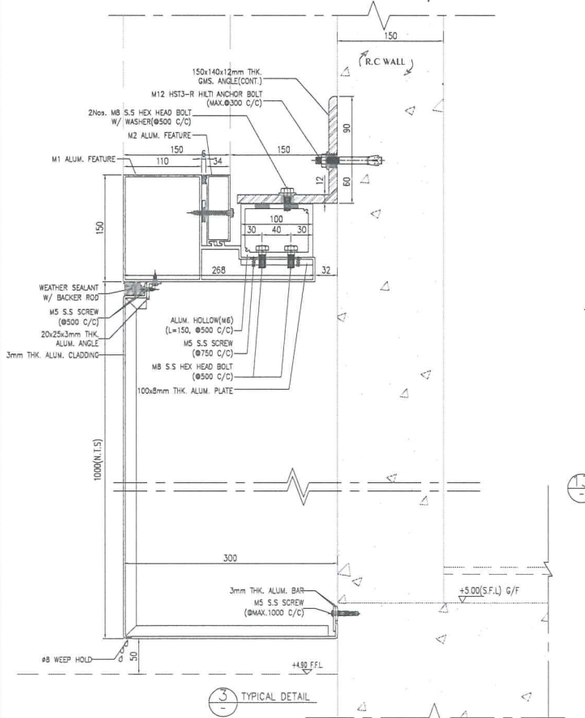


3 TYPICAL DETAIL

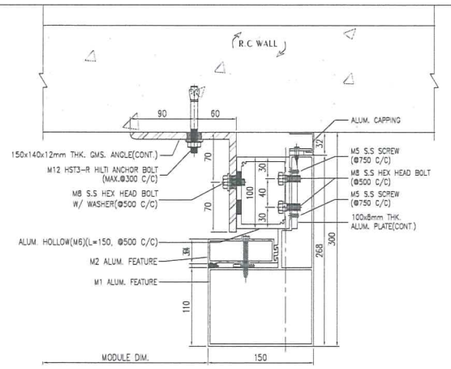


4 TYPICAL DETAIL

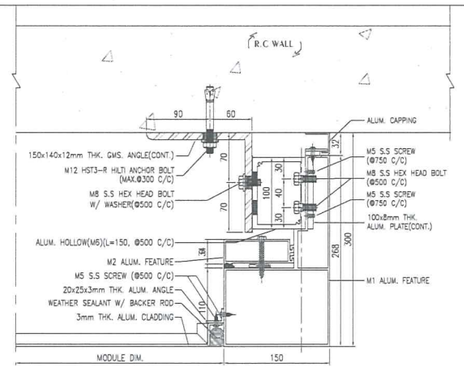

5 TYPICAL DETAIL

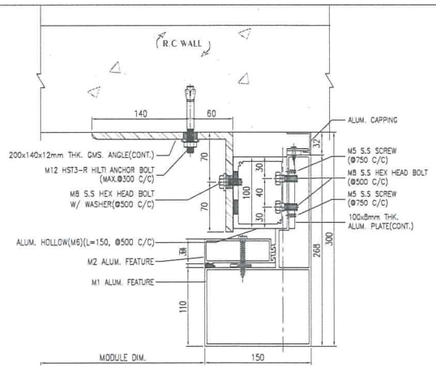


6 TYPICAL DETAIL
EXISTING ALUM. FEATURE

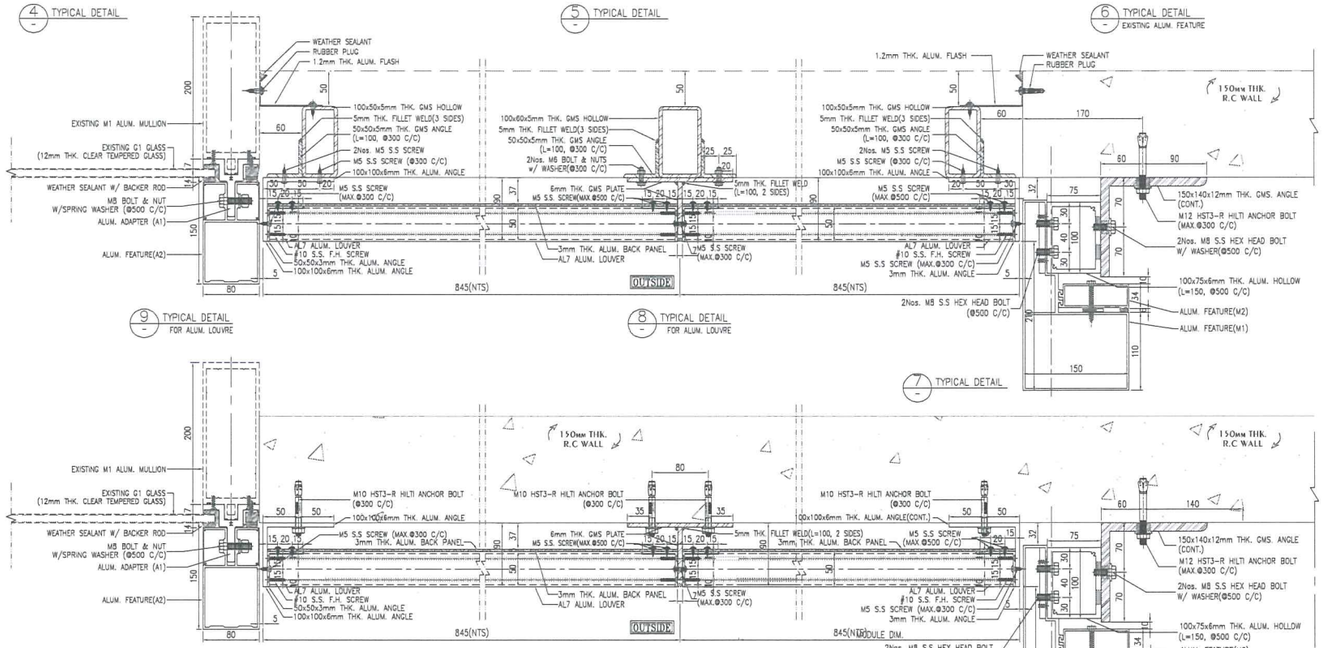

9 TYPICAL DETAIL
FOR ALUM. LOUVRE

8 TYPICAL DETAIL
FOR ALUM. LOUVRE


7 TYPICAL DETAIL

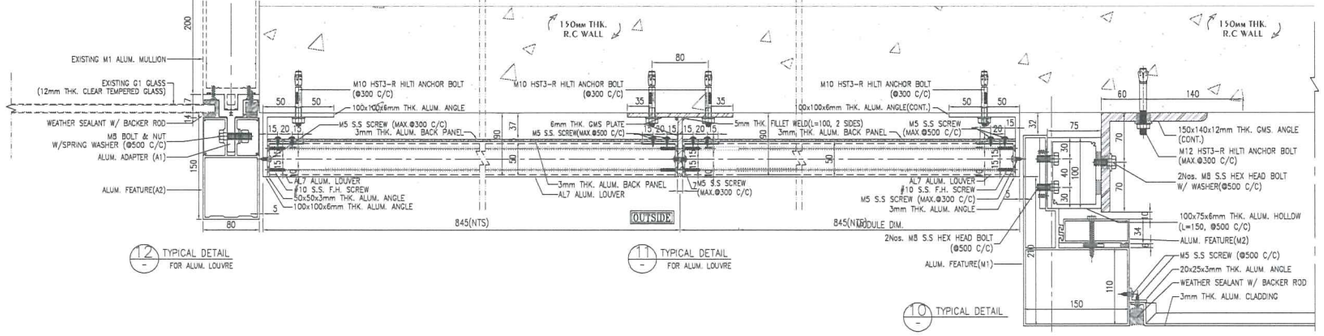

12 TYPICAL DETAIL
FOR ALUM. LOUVRE


11 TYPICAL DETAIL
FOR ALUM. LOUVRE

10 TYPICAL DETAIL

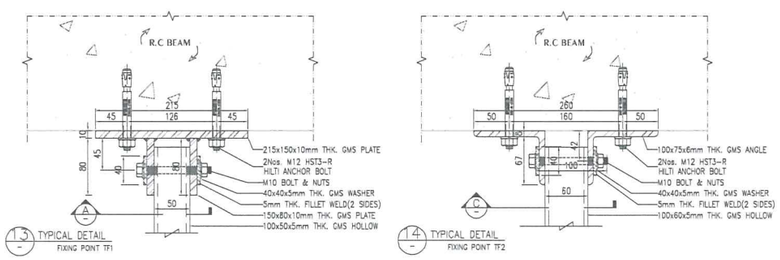


13 TYPICAL DETAIL
FIXING POINT TF1

14 TYPICAL DETAIL
FIXING POINT TF2

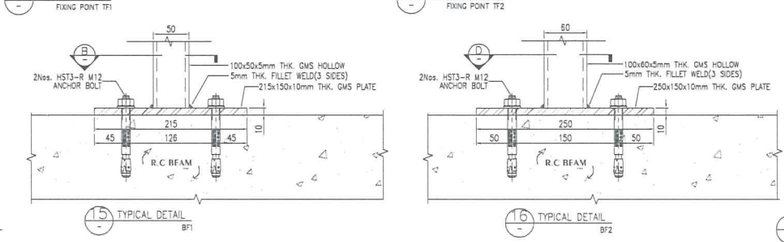

15 TYPICAL DETAIL
BF1

16 TYPICAL DETAIL
BF2

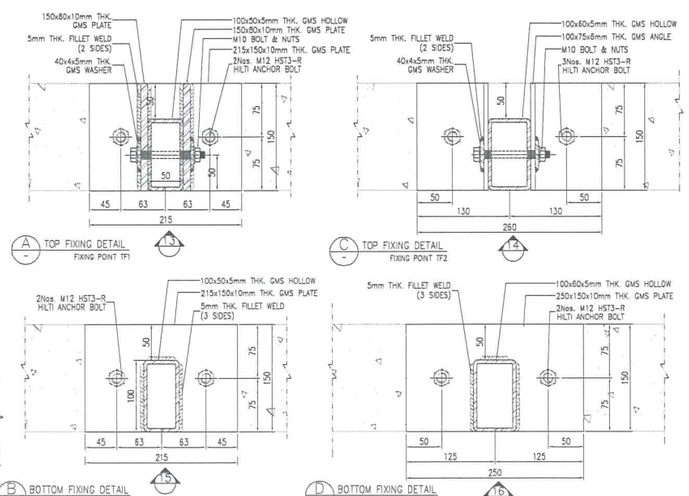

A TOP FIXING DETAIL
FIXING POINT TF1

C TOP FIXING DETAIL
FIXING POINT TF2

B BOTTOM FIXING DETAIL
FIXING POINT BF1

D BOTTOM FIXING DETAIL
FIXING POINT BF2

B.D. Ref.

F.P.B. Ref.

21/01/19	A	MODIFY SETTING OUT
11/02/19	B	REVISED ARCHITECT'S COMMENTS
04/04/19	C	GENERAL REVISION

DATE/REVISION/AMENDMENTS

SUN HUNG KAI ARCHITECTS AND ENGINEERS LTD.
SUN HUNG KAI CENTRE, WANCHAI, HONGKONG
TEL. 28278111 FAX. 28272884

YEE FAI CONTRACTORS CO. LTD.
44/F SUN HUNG KAI CENTRE, WANCHAI, HONGKONG
TEL. 28278111 FAX. 28270717

美特鋁製有限公司
MIDI ALUMINIUM FABRICATOR LTD.
Units 6-8, Sunray Industrial Centre, 1/F
610 Cha Kwo Ling Road, Kowloon
Tel: 23489211-4 Fax: (852)27727666

This drawing and design are copyright of the authorized person. No portion may be reproduced without his written permission. Use written dimensions. Measurements to existing works to be verified on site. This drawing shall be read in conjunction with specification and condition of contract.

PROJECT

PROPOSED RESIDENTIAL DEVELOPMENT AT TSEUNG KWAN O AREA 66D2, T.K.O.T.L. 118

TITLE

TYPICAL DETAILS FOR A & A WORKS AT PODIUM

FILE NAME

DRAWN BY

CHECKED BY

PRINTED DATE

SCALE

JOB No.	DRAWING No.	REV.
J-835	J835-AA-DT01	C

R.S.E.

FOR B.D. APPROVAL

18

B.D. Ref.

F.P.B. Ref.

DATE/REVISION/AMENDMENTS

SUN HUNG KAI
ARCHITECTS AND ENGINEERS LTD.

SUN HUNG KAI CENTRE, WANCHAI, HONGKONG
TEL. 28278111 FAX. 28272884

YEE FAI CONTRACTORS CO. LTD.
44/F SUN HUNG KAI CENTRE, WANCHAI, HONGKONG
TEL. 28278111 FAX. 28270717

美特鋁質有限公司
MIDI ALUMINIUM FABRICATOR LTD.
Units 6-8, Sunray Industrial Centre, 1/F
610 Cha Kwo Ling Road, Kowloon
Tel: 23489211-4 Fax: (852)27727666

This drawing and design are copyright of the authorized person. No portion may be reproduced without his written permission. Use written dimensions. Measurements to existing works to be verified on site. This drawing shall be read in conjunction with specification and condition of contract.

PROJECT

PROPOSED RESIDENTIAL DEVELOPMENT AT TSEUNG KWAN O AREA 66D2, T.K.O.T.L. 118

TITLE


TYPICAL DETAILS FOR A & A WORKS AT PODIUM

FILE NAME	
DRAWN BY	
CHECKED BY	
PRINTED DATE	
SCALE	


JOB No.	DRAWING No.	REV.
J-835	J835-AA-DT01a	-

R.S.E.


FOR B.D. APPROVAL

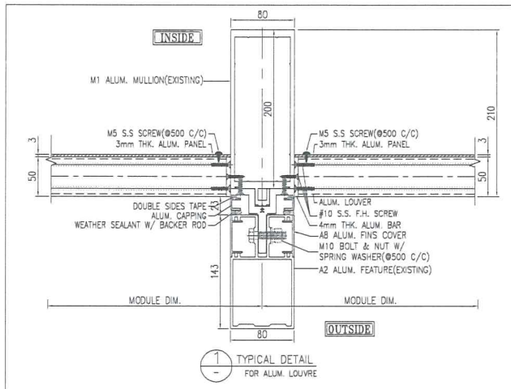


1 TYPICAL DETAIL
FOR ALUM. LOUVRE

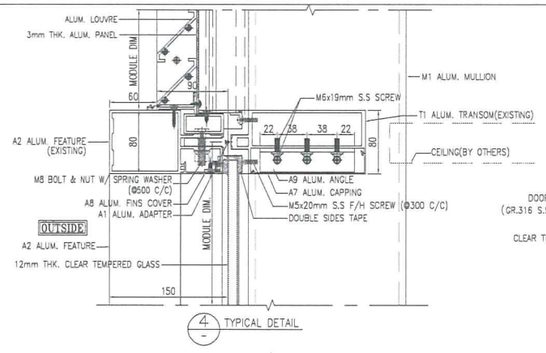


4 TYPICAL DETAIL

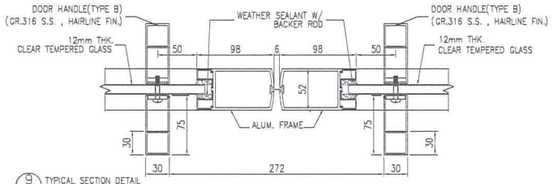


9 TYPICAL SECTION DETAIL
FOR SWING GLASS DOOR

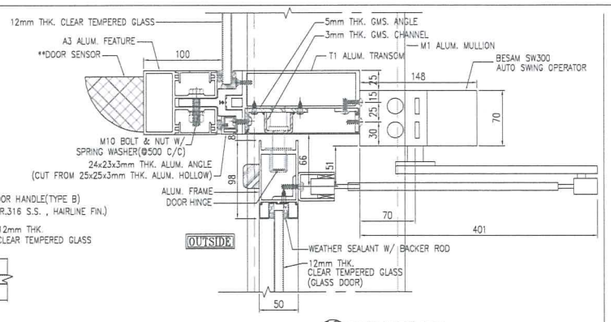


10 TYPICAL SECTION DETAIL
FOR AUTOMATIC SWING DOOR

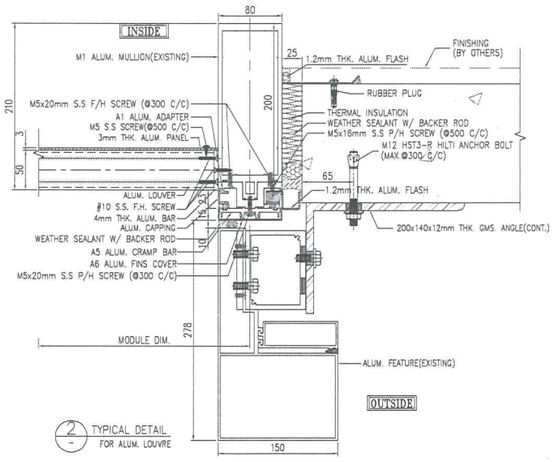


2 TYPICAL DETAIL
FOR ALUM. LOUVRE

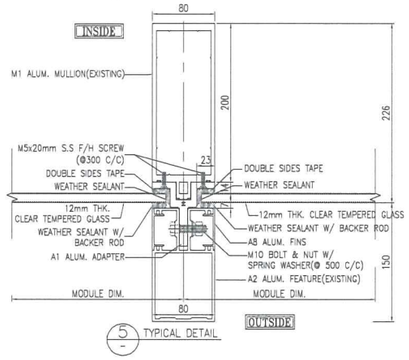

5 TYPICAL DETAIL

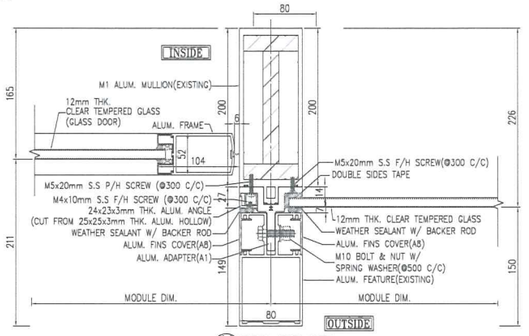


11 TYPICAL SECTION DETAIL
FOR SWING GLASS DOOR

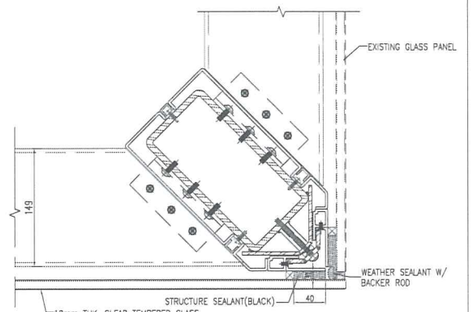


12 CONER MULLION DETAIL
FOR CONER GLASS FIXING


3 TYPICAL SECTION DETAIL
FOR ALUM. LOUVRE

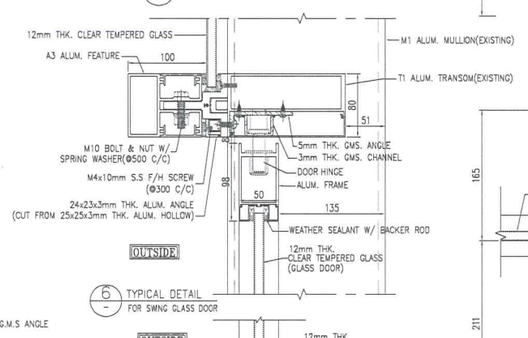


6 TYPICAL DETAIL
FOR SWING GLASS DOOR

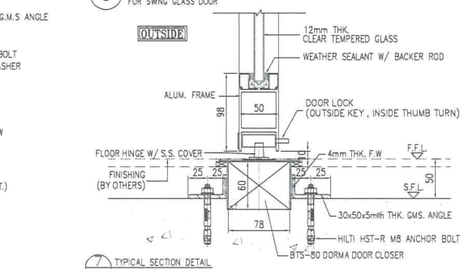


7 TYPICAL SECTION DETAIL
FOR SWING GLASS DOOR

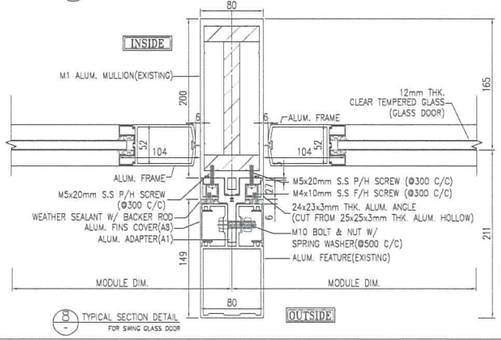


8 TYPICAL SECTION DETAIL
FOR SWING GLASS DOOR

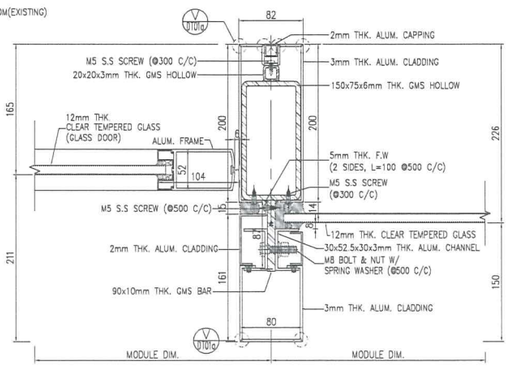


13 TYPICAL DETAIL

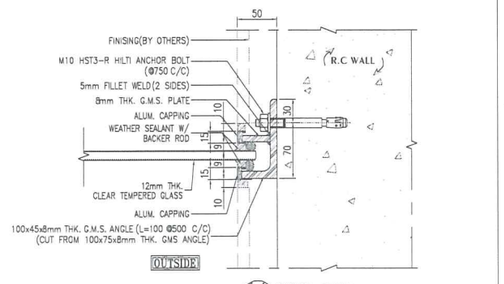

14 TYPICAL DETAIL

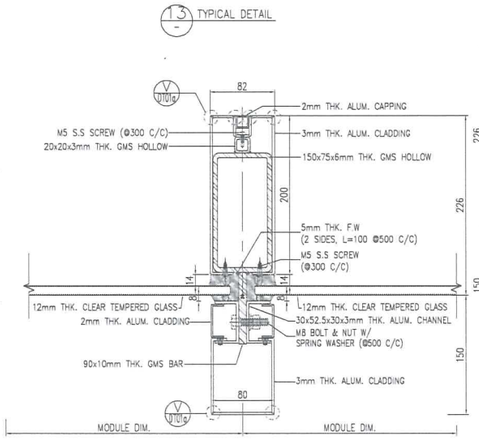

15 TYPICAL DETAIL

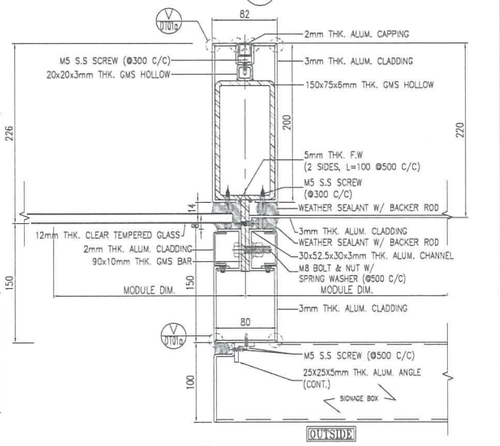

16 TYPICAL DETAIL

B.D. Ref.

F.P.B. Ref.

DATE/REVISION/AMENDMENTS		
21/01/19	A	MODIFY SETTING OUT
04/04/19	B	GENERAL REVISION

SUN HUNG KAI
ARCHITECTS AND ENGINEERS LTD.
SUN HUNG KAI CENTRE, WANCHAI, HONGKONG
TEL. 28278111 FAX. 28272884

YEE FAI CONTRACTORS CO. LTD.
44/F SUN HUNG KAI CENTRE, WANCHAI, HONGKONG
TEL. 28278111 FAX. 28270717

美特鋁製有限公司
MIDI ALUMINIUM FABRICATOR LTD.
Units 6-8, Sunray Industrial Centre, 1/F
610 Cha Kwo Ling Road, Kowloon
Tel: 23489211-4 Fax: (852)27727666

This drawing and design are copyright of the authorized person. No portion may be reproduced without his written permission. Use written dimensions. Measurements to existing works to be verified on site. This drawing shall be read in conjunction with specification and condition of contract.

PROJECT

PROPOSED RESIDENTIAL DEVELOPMENT AT TSEUNG KWAN O AREA 66D2, T.K.O.T.L. 118

TITLE

TYPICAL DETAILS FOR A & A WORKS AT PODIUM

FILE NAME

DRAWN BY

CHECKED BY


PRINTED DATE

SCALE

JOB No.	DRAWING No.	REV.
J-835	J835-AA-DT02	B

R.S.E.

FOR B.D. APPROVAL

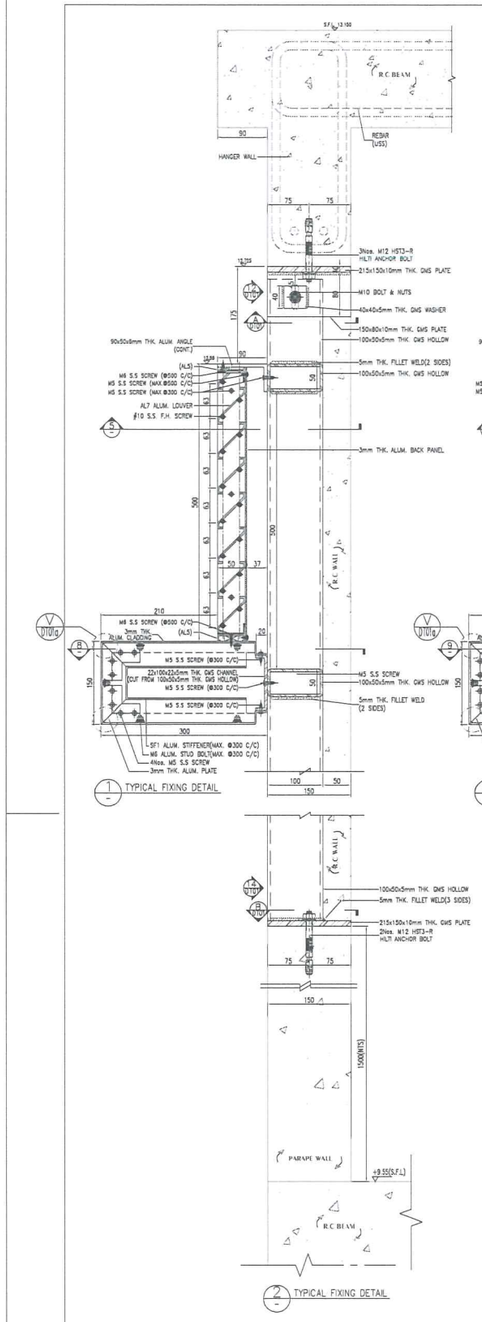

B.D. Ref.

F.P.B. Ref.

21/01/19	A	MODIFY SETTING OUT
11/02/19	B	REVISED ARCHITECT'S COMMENTS
04/04/19	C	GENERAL REVISION

DATE/REVISION/AMENDMENTS

SUN HUNG KAI ARCHITECTS AND ENGINEERS LTD.
SUN HUNG KAI CENTRE, WANCHAI, HONGKONG
TEL. 28278111 FAX. 28272884

YEE FAI CONTRACTORS CO. LTD.
44/F SUN HUNG KAI CENTRE, WANCHAI, HONGKONG
TEL. 28278111 FAX. 28270717

美特鋁貿有限公司
MIDI ALUMINIUM FABRICATOR LTD.
Units 6–8, Sunray Industrial Centre, 1/F
610 Cha Kwa Ling Road, Kowloon
Tel: 23489211–4 Fax: (852)27727666

This drawing and design are copyright of the authorized person. No portion may be reproduced without his written permission. Use written dimensions. Measurements to existing works to be verified on site. This drawing shall be read in conjunction with specification and condition of contract.

PROJECT

PROPOSED RESIDENTIAL DEVELOPMENT AT TSEUNG KWAN O AREA 66D2, T.K.O.T.L. 118

TITLE

TYPICAL DETAILS FOR A & A WORKS AT PODIUM

FILE NAME

DRAWN BY

CHECKED BY


PRINTED DATE

SCALE

JOB No.	DRAWING No.	REV.
J-835	J835-AA-DT03	C

R.S.E.

FOR B.D. APPROVAL

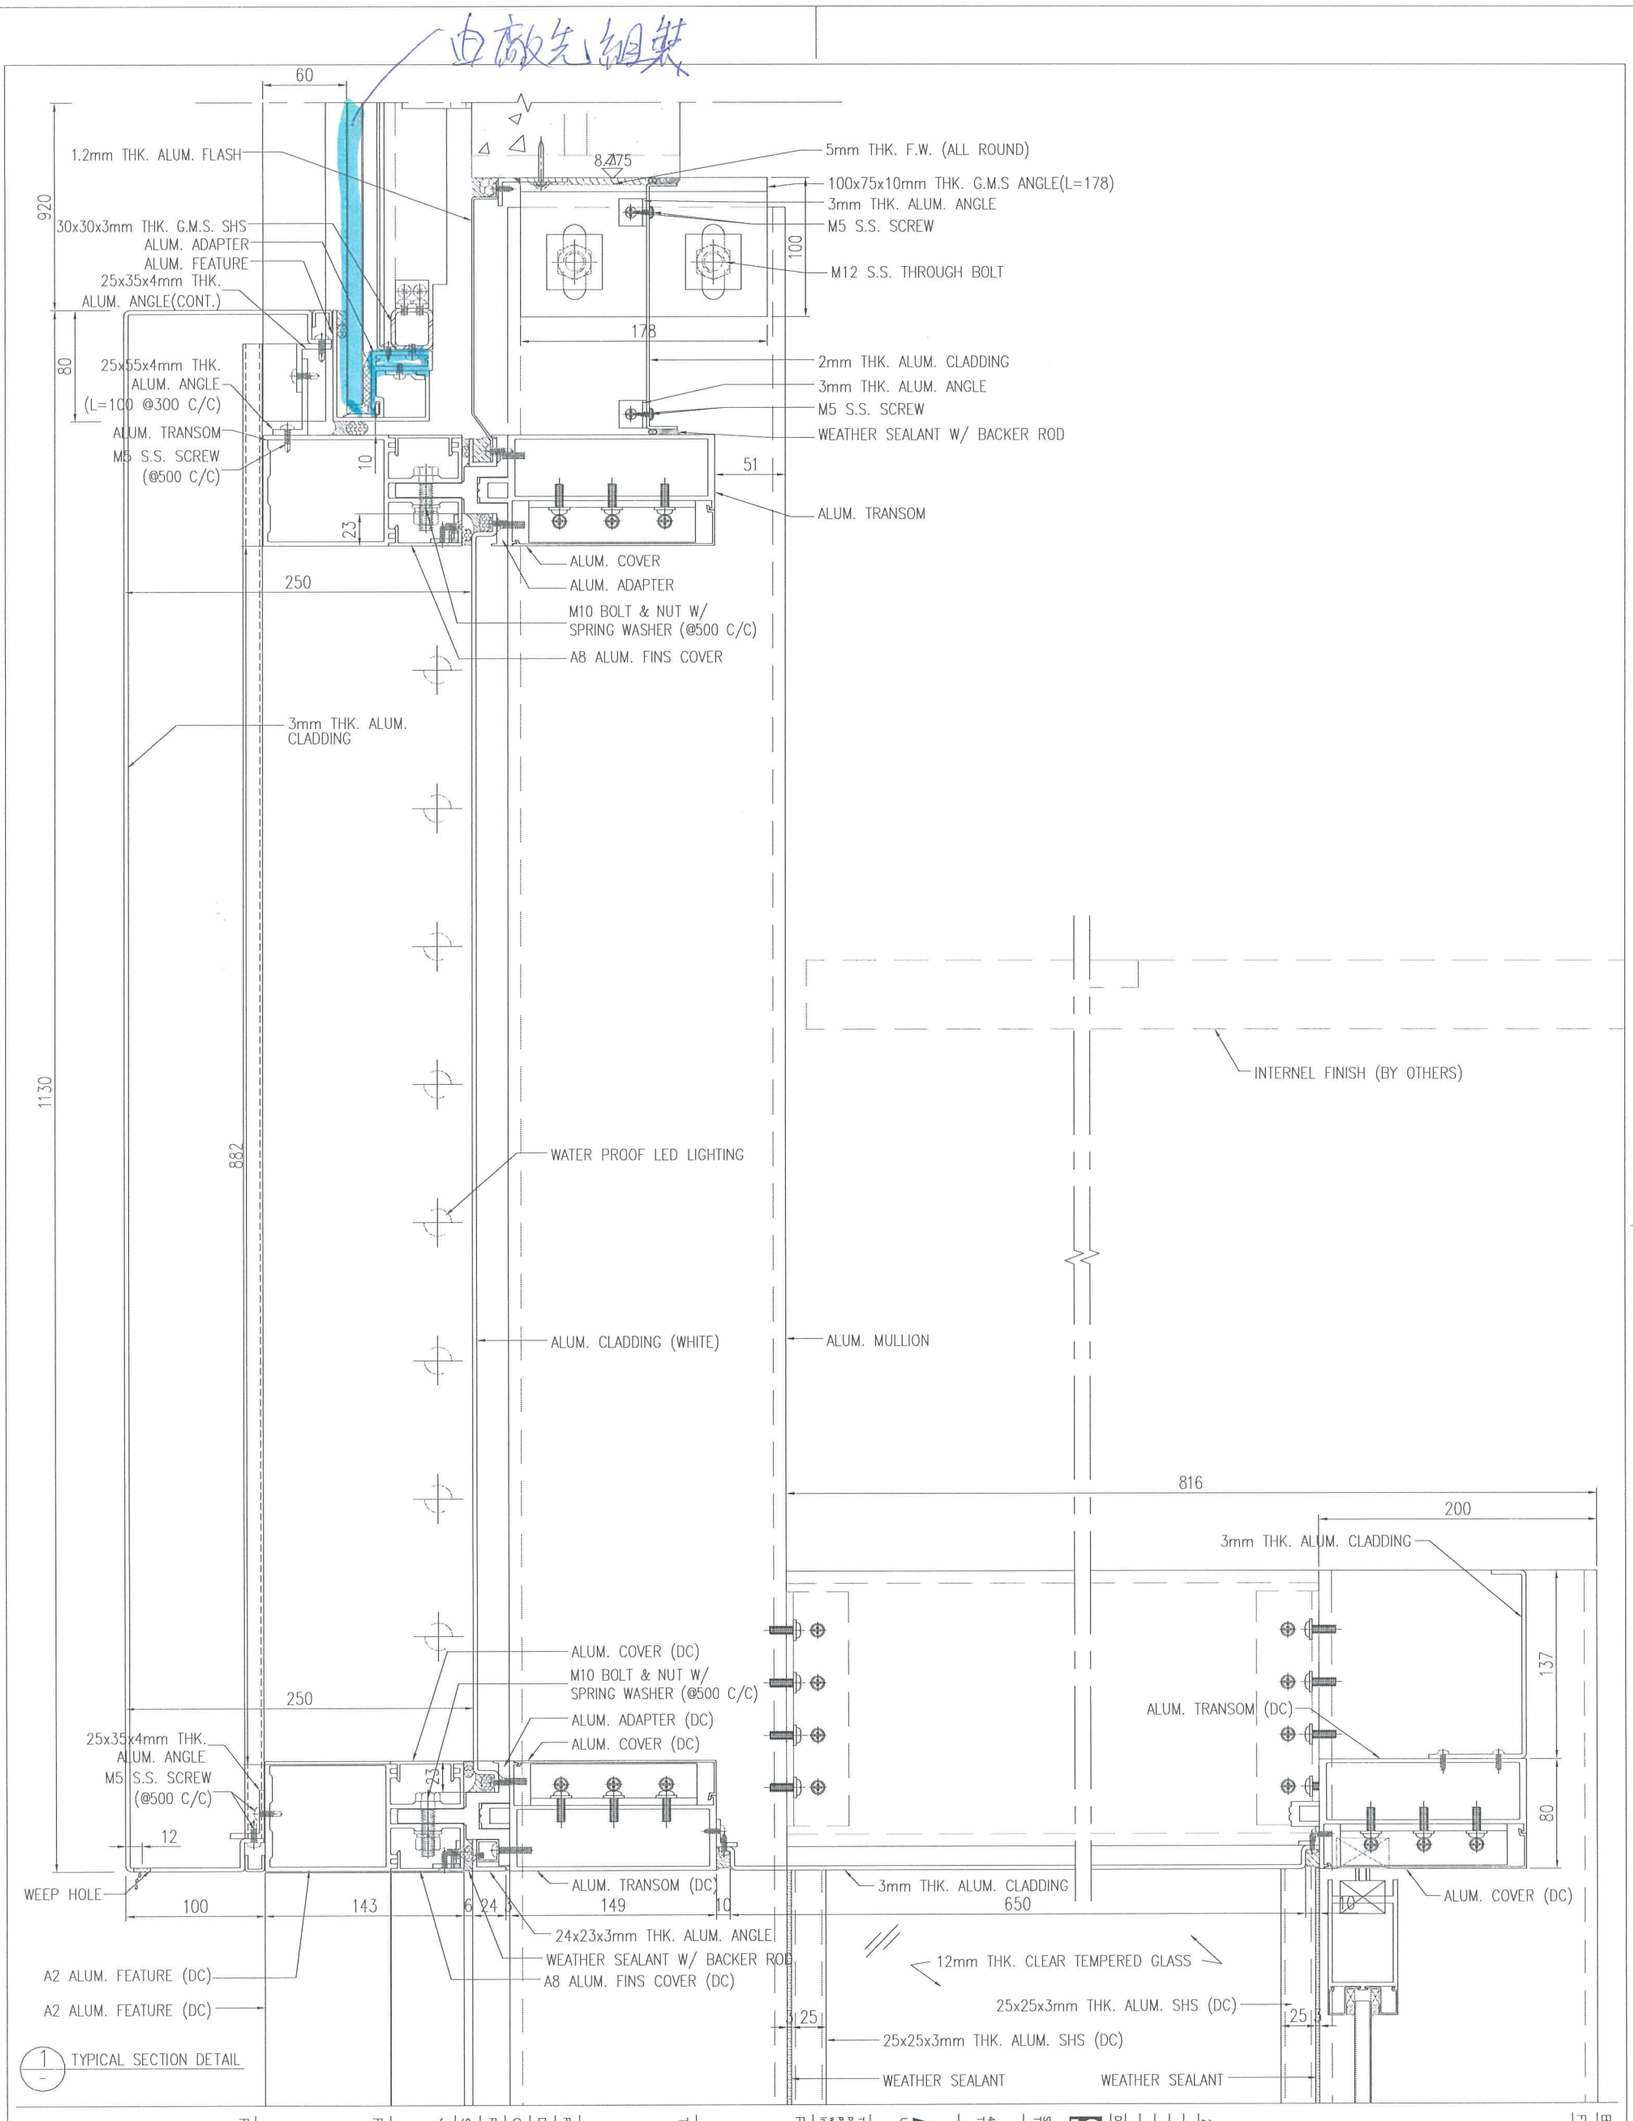

1 TYPICAL SECTION DETAIL

FOR B.D. APPROVAL

SCALE

JOB No.	DRAWING No.	REV.
J-835	J835-AA-DT04	B

R.S.E.

FILE NAME

DRAWN BY

CHECKED BY

PRINTED DATE

TITLE

TYPICAL DETAILS
FOR A & A WORKS AT PODIUM

PROJECT

PROPOSED RESIDENTIAL
DEVELOPMENT AT
TSEUNG KWAN O
AREA 66D2, T.K.O.T.L. 118

美特鋁質有限公司
MIDI ALUMINIUM FABRICATOR LTD.
Units 6-8, Sunray Industrial Centre, 1/F
610 Cho Kwo Ling Road, Kowloon
Tel:23489211-4 Fax:(852)27727666

This drawing and design are copyright of the authorized person. No portion may be reproduced without his written permission. Use written dimensions. Measurements to existing work to be verified by contractor. This drawing is to be read in conjunction with specification and condition of contract.


SUN HUNG KAI
ARCHITECTS AND ENGINEERS LTD.
SUN HUNG KAI CENTRE, WANCHAI, HONGKONG
TEL. 28278111 FAX. 28272884

YEE FAI CONTRACTORS CO. LTD.
44/F SUN HUNG KAI CENTRE, WANCHAI, HONGKONG
TEL. 28278111 FAX. 28270717

DATE/REVISION/AMENDMENTS	
2/10/19	A MODIFY SETTING OUT

B.D. Ref.

F.P.B. Ref.

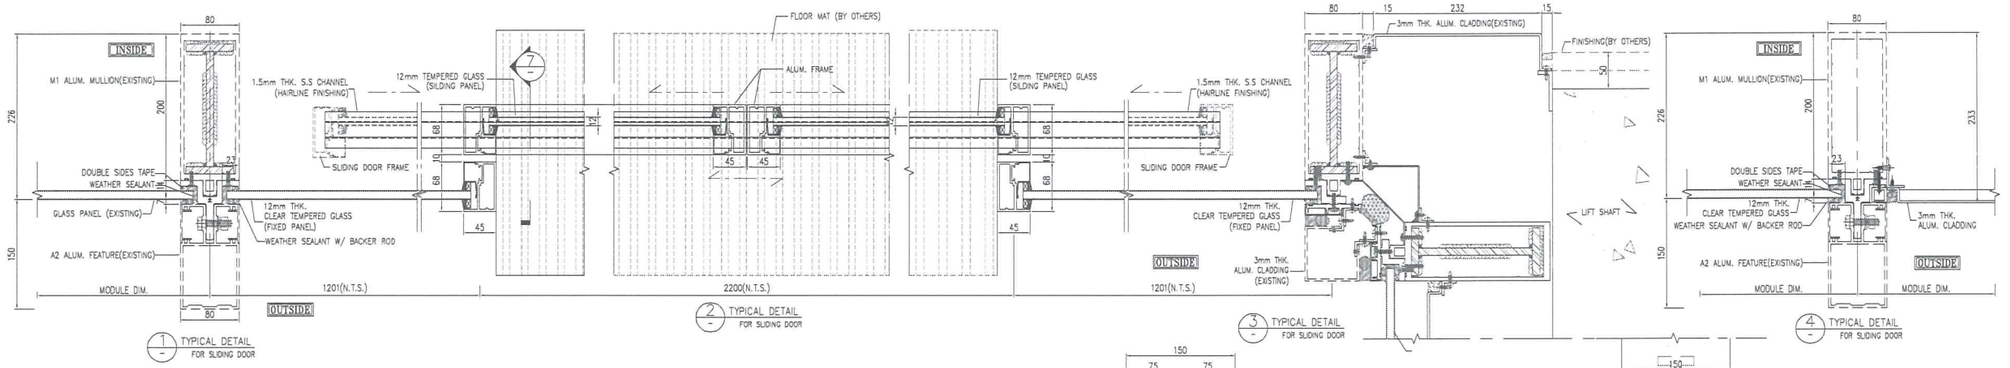


1 TYPICAL DETAIL FOR SLIDING DOOR


2 TYPICAL DETAIL FOR SLIDING DOOR

3 TYPICAL DETAIL FOR SLIDING DOOR


4 TYPICAL DETAIL FOR SLIDING DOOR

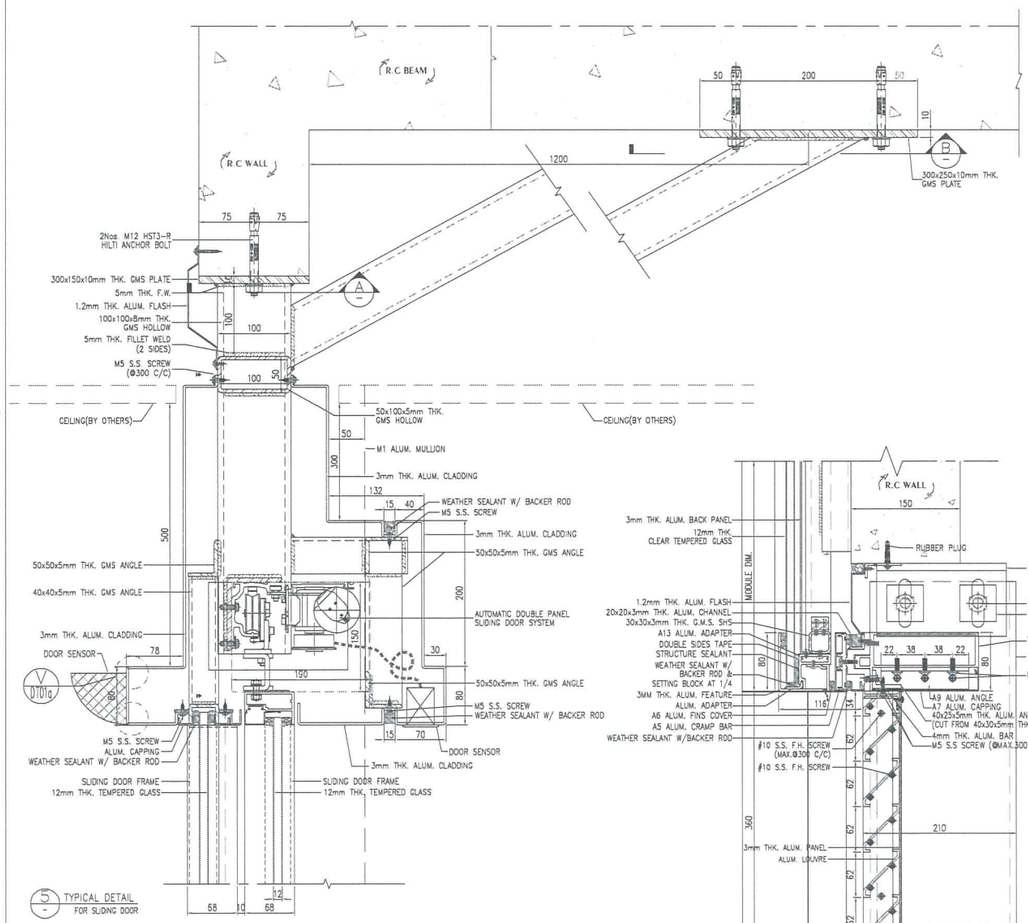


5 TYPICAL DETAIL FOR SLIDING DOOR

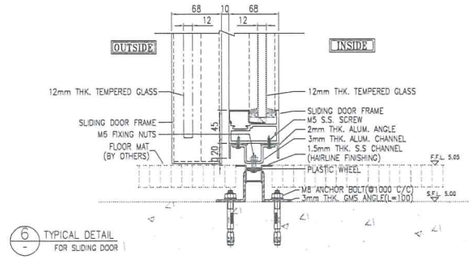


6 TYPICAL DETAIL FOR SLIDING DOOR

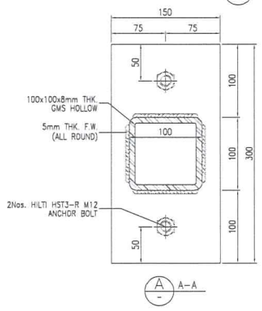


A A–A

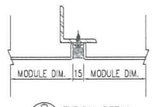


8 TYPICAL DETAIL

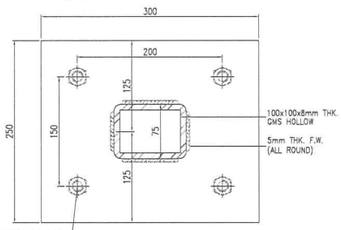


B B–B

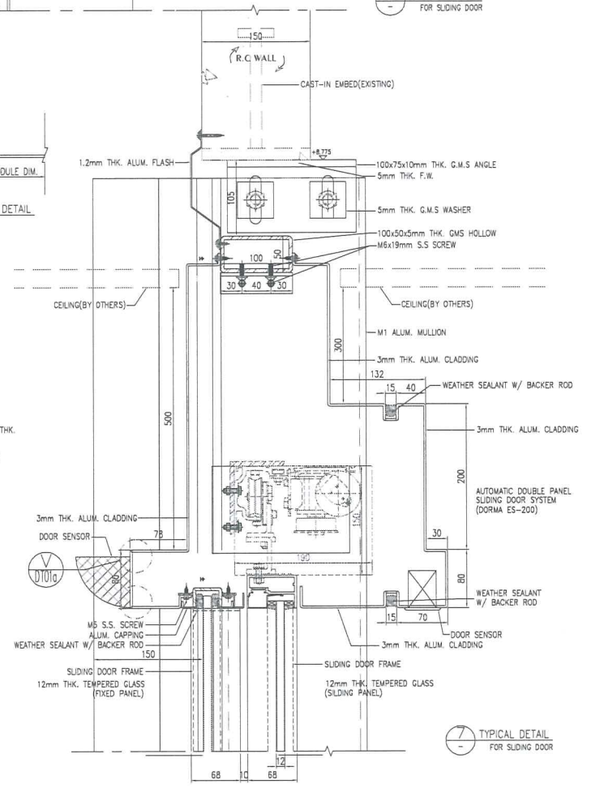


7 TYPICAL DETAIL FOR SLIDING DOOR

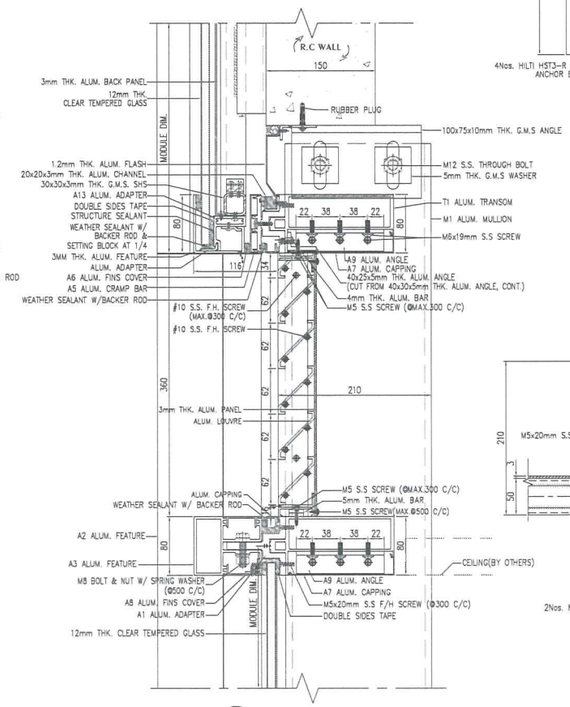

9 TYPICAL SECTION DETAIL

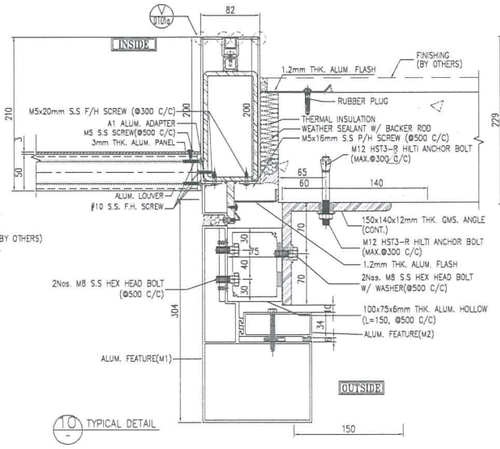

10 TYPICAL DETAIL

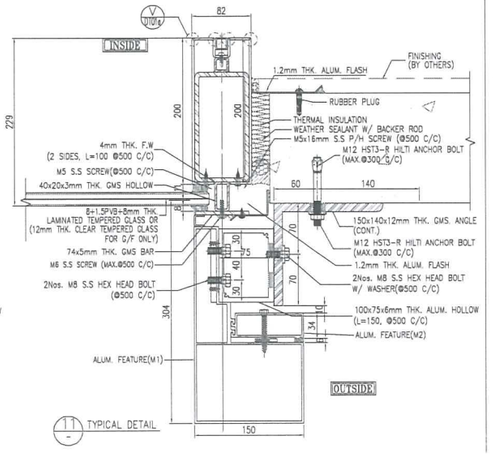

11 TYPICAL DETAIL

B.D. Ref.

F.P.B. Ref.

21/01/19	A	MODIFY SETTING OUT
04/04/19	B	GENERAL REVISION

DATE/REVISION/AMENDMENTS

SUN HUNG KAI ARCHITECTS AND ENGINEERS LTD.
SUN HUNG KAI CENTRE, WANCHAI, HONGKONG
TEL. 28278111 FAX. 28272884

YEE FAI CONTRACTORS CO. LTD.
44/F SUN HUNG KAI CENTRE, WANCHAI, HONGKONG
TEL. 28278111 FAX. 28270717

美特鋁質有限公司
MIDI ALUMINIUM FABRICATOR LTD.
Units 6–8, Sunray Industrial Centre, 1/F
610 Cha Kwo Ling Road, Kowloon
Tel: 23489211–4 Fax: (852)27727666

This drawing and design are copyright of the authorized person. No portion may be reproduced without his written permission. Use written dimensions. Measurements to existing works to be verified on site. This drawing shall be read in conjunction with specification and condition of contract.

PROJECT

PROPOSED RESIDENTIAL DEVELOPMENT AT TSEUNG KWAN O AREA 66D2, T.K.O.T.L. 118

TITLE

TYPICAL DETAILS FOR A & A WORKS AT PODIUM

FILE NAME

DRAWN BY

CHECKED BY


PRINTED DATE

SCALE

JOB No.	DRAWING No.	REV.
J-835	J835-AA-DT05	B

R.S.E.

FOR B.D. APPROVAL

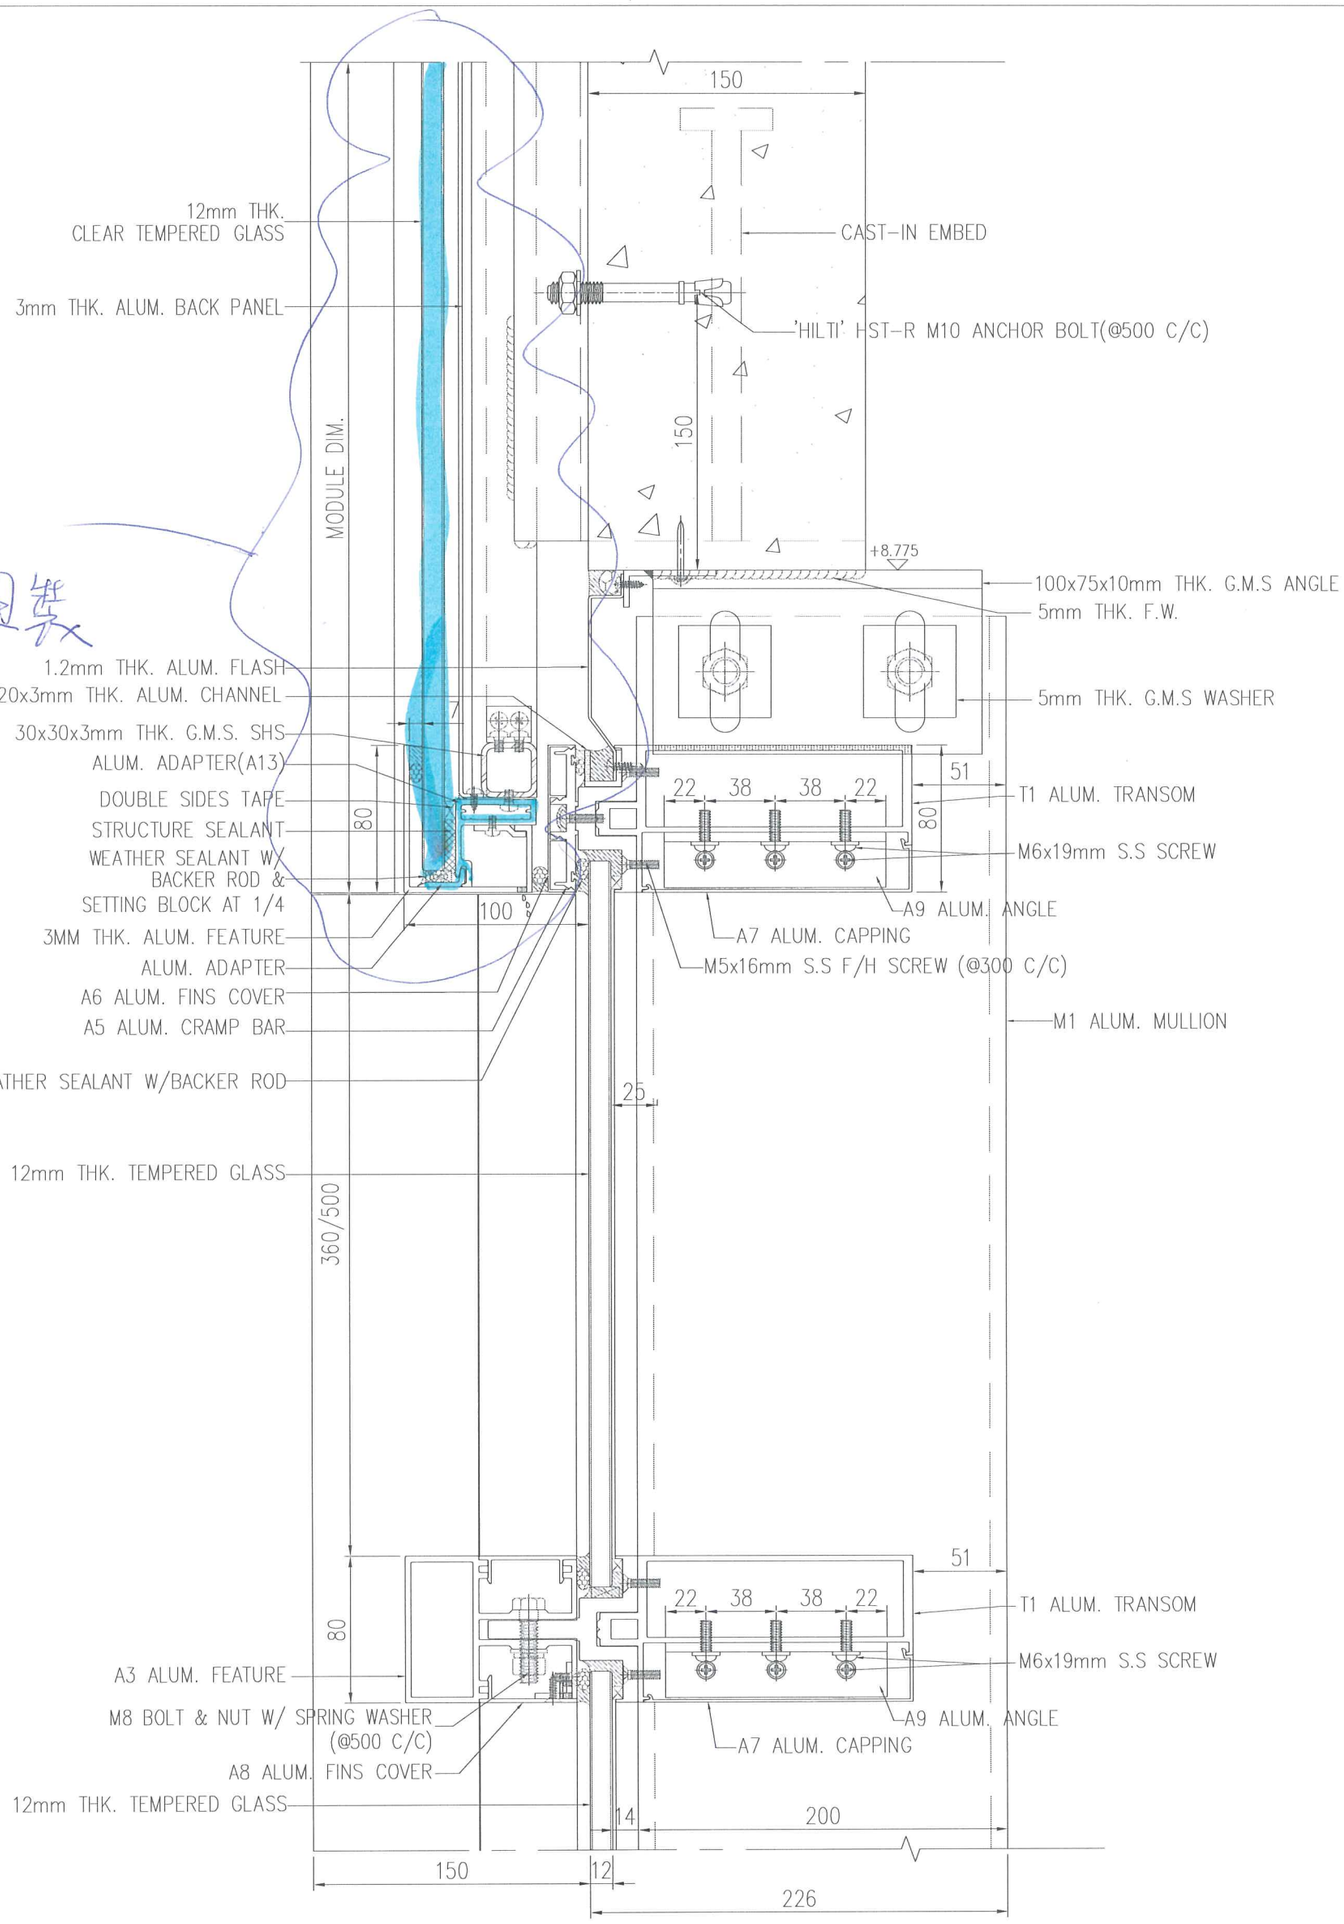

1 / - TYPICAL SECTION DETAIL
EXISTING GLASS WALL FIXING

B.D. Ref.
F.P.B. Ref.

21/01/19 A MODIFY SETTING OUT

DATE/REVISION/AMENDMENTS

SUN HUNG KAI ARCHITECTS AND ENGINEERS LTD.
SUN HUNG KAI CENTRE, WANCHAI HONGKONG
TEL. 28278111 FAX. 28272884

YEE FAI CONTRACTORS CO. LTD.
44/F SUN HUNG KAI CENTRE, WANCHAI, HONGKONG
TEL. 28278111 FAX. 28270717

美特鋁質有限公司
MIDI ALUMINIUM FABRICATOR LTD.
Units E-B, 10/F., Tower 1,
610 Cheung Sha Wan Road, Kowloon
Tel:23489211-4 Fax:(852)27727666


This drawing and design are copyright of the architects and no portion may be reproduced without his written permission. Use written dimensions. Measurements to existing work are to be verified by the contractor. In conjunction with specification and condition of contract.

PROJECT
PROPOSED RESIDENTIAL DEVELOPMENT AT TSEUNG KWAN O AREA 66D2, T.K.O.T.L. 118

TITLE
TYPICAL DETAILS FOR A & A WORKS AT PODIUM


FILE NAME
DRAWN BY
CHECKED BY
PRINTED DATE
SCALE
JOB No. J-835
DRAWING No. J835-AA-DT06
REV. A
R.S.E.

FOR B.D. APPROVAL

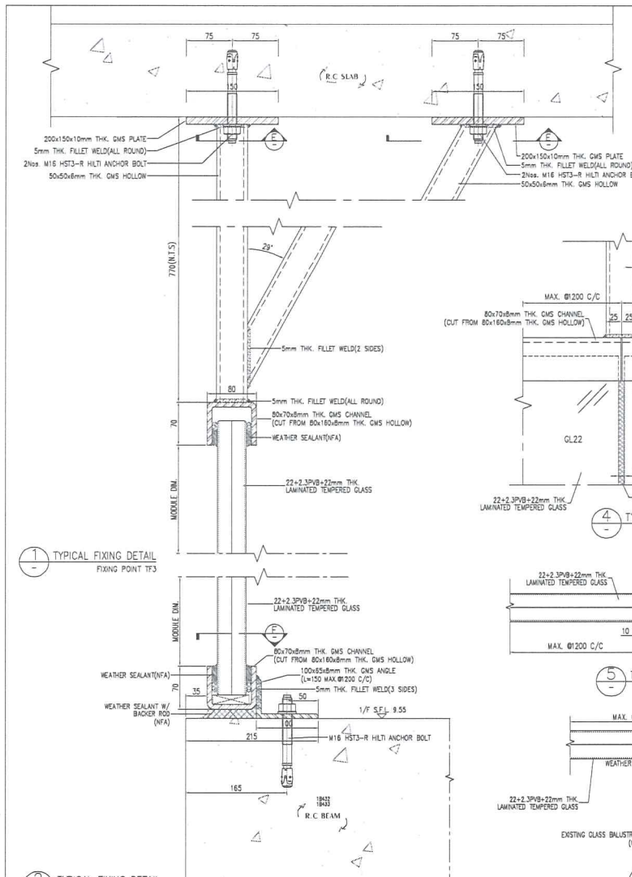


1 TYPICAL FIXING DETAIL
FIXING POINT TF3


2 TYPICAL FIXING DETAIL
FIXING POINT BF3

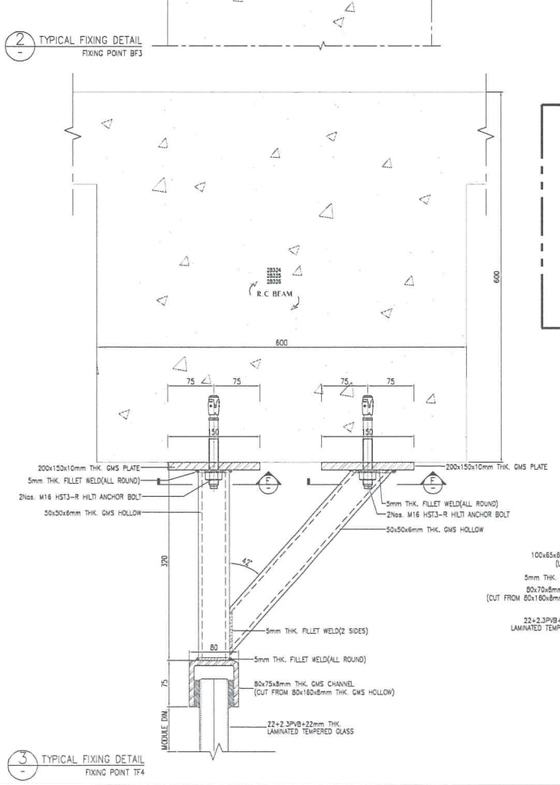


3 TYPICAL FIXING DETAIL
FIXING POINT TF4

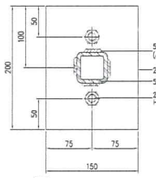


E TOP FIXING DETAIL

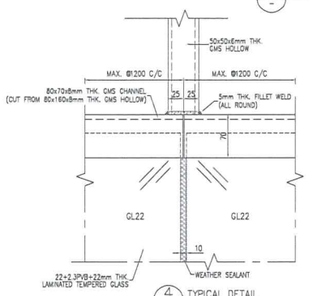


4 TYPICAL DETAIL

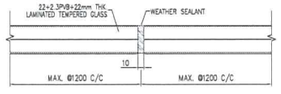


5 TYPICAL DETAIL

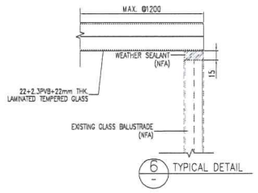


6 TYPICAL DETAIL

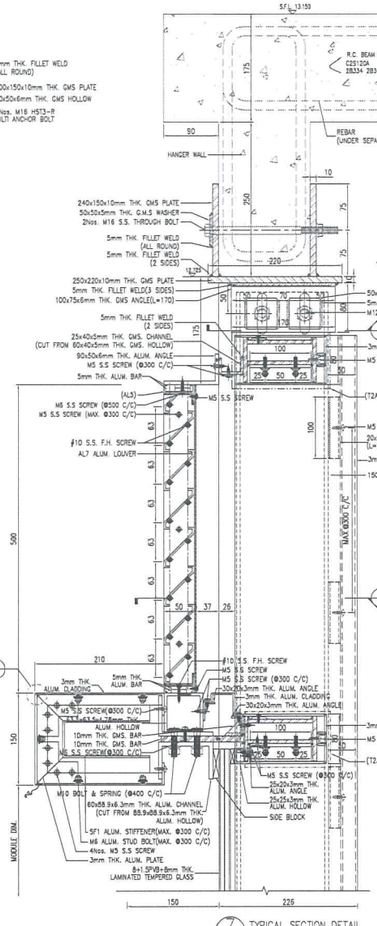


7 TYPICAL SECTION DETAIL
GLASS WALL

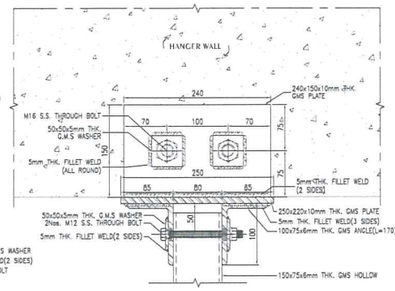


10 TOP FIXING DETAIL

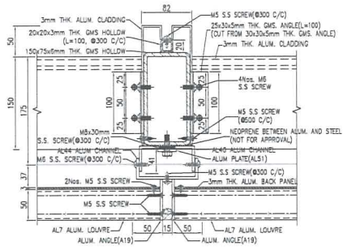


H TYPICAL DETAIL

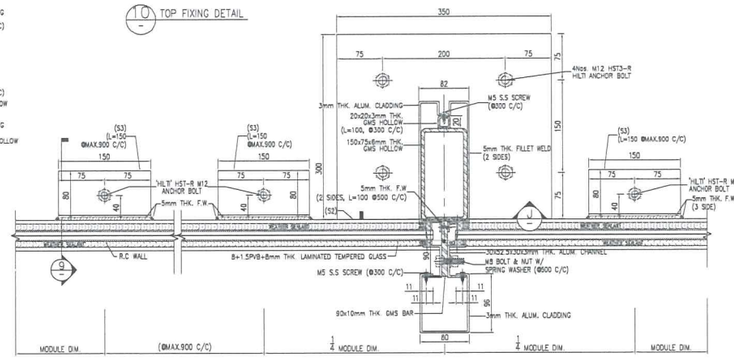


11 TYPICAL DETAIL
GLASS WALL

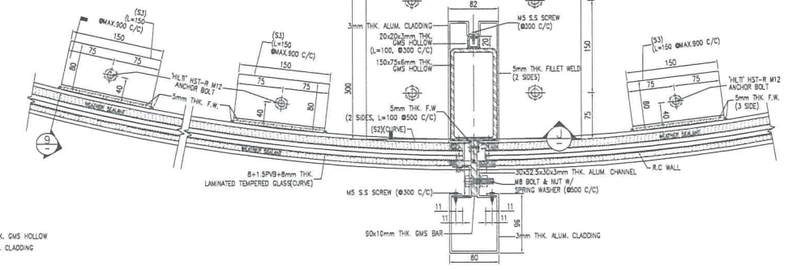


12 TYPICAL DETAIL
FOR CURVE ZONE GLASS WALL

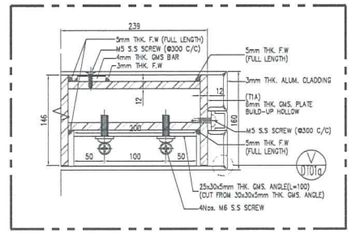


T2A (T2A)BLOW UP DETAIL
SCALE 2:1

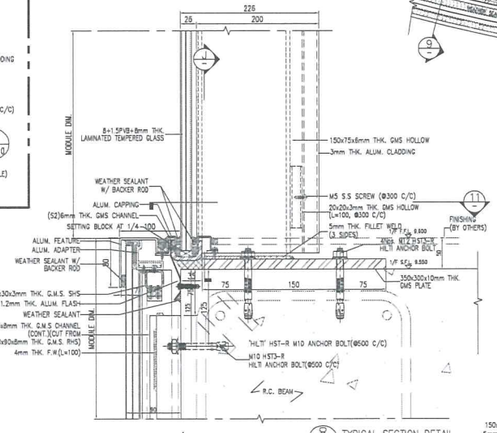


8 TYPICAL SECTION DETAIL
GLASS WALL

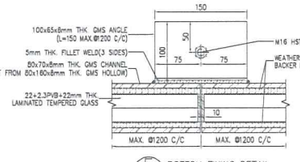


F BOTTOM FIXING DETAIL
FIXING POINT BF3

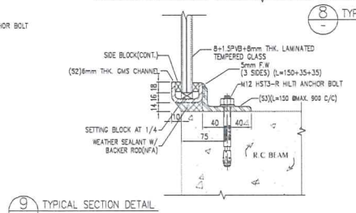

9 TYPICAL SECTION DETAIL
GLASS WALL

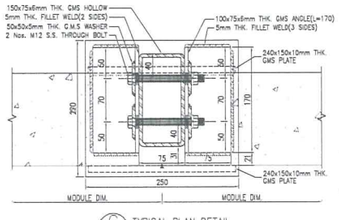

G TYPICAL PLAN DETAIL
TOP FIXING

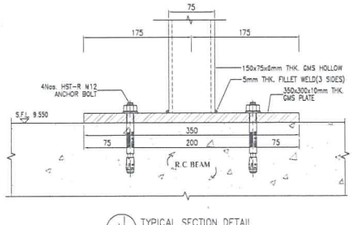

J TYPICAL SECTION DETAIL
BOTTOM FIXING

B.D. Ref.

F.P.B. Ref.

DATE/REVISION/AMENDMENTS

SUN HUNG KAI
ARCHITECTS AND ENGINEERS LTD.
SUN HUNG KAI CENTRE, WANCHAI, HONGKONG
TEL. 28278111 FAX. 28272884

YEE FAI CONTRACTORS CO. LTD.
44/F SUN HUNG KAI CENTRE, WANCHAI, HONGKONG
TEL. 28278111 FAX. 28270717

美特鋁貿有限公司
MIDI ALUMINIUM FABRICATOR LTD.
Units 6-8, Sunray Industrial Centre, 1/F
610 Cha Kwo Ling Road, Kowloon
Tel: 2348211-4 Fax:(852)27727666

This drawing and design are copyright of the authorized person. No portion may be reproduced without his written permission. Use written dimensions. Measurements to existing works to be verified on site. This drawing shall be read in conjunction with specification and condition of contract.

PROJECT

PROPOSED RESIDENTIAL
DEVELOPMENT AT
TSEUNG KWAN O
AREA 66D2, T.K.O.T.L. 118

TITLE

TYPICAL DETAIL
FOR A && A WORKS AT PODIUM

FILE NAME

DRAWN BY

CHECKED BY


PRINTED DATE

SCALE


JOB No.	DRAWING No.	REV.
J-835	J835-AA-DT07	-

R.S.E.


FOR B.D. APPROVAL

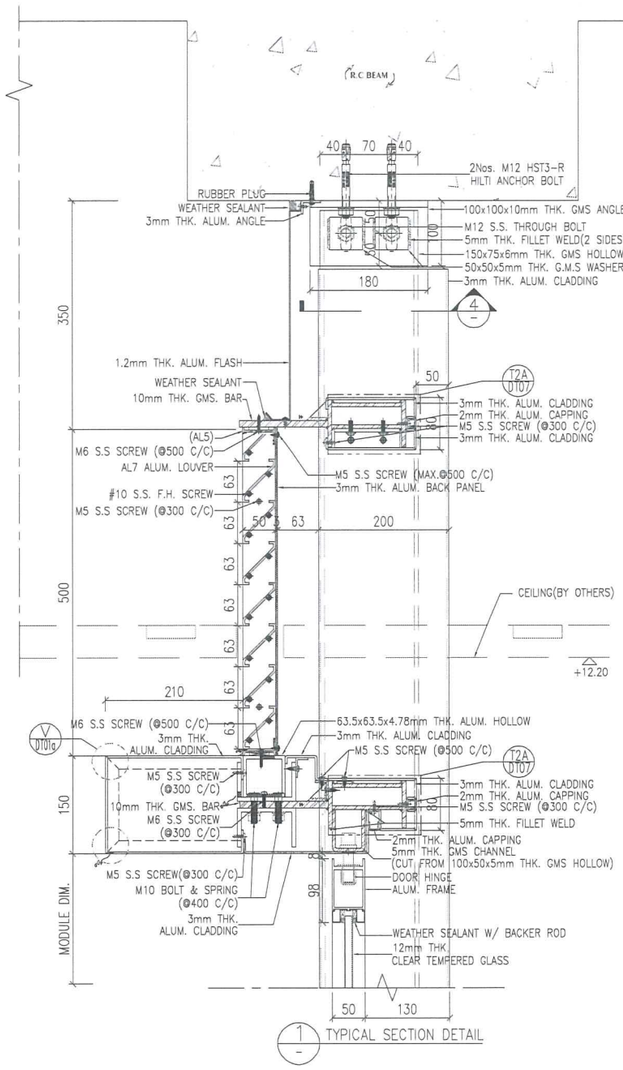


1 - TYPICAL SECTION DETAIL

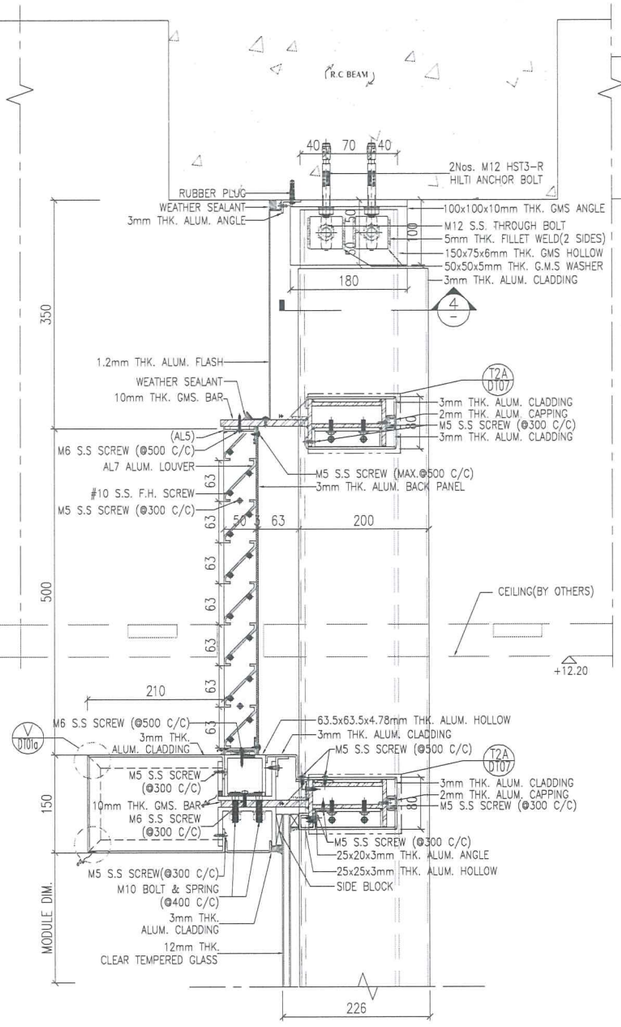

2 - TYPICAL SECTION DETAIL

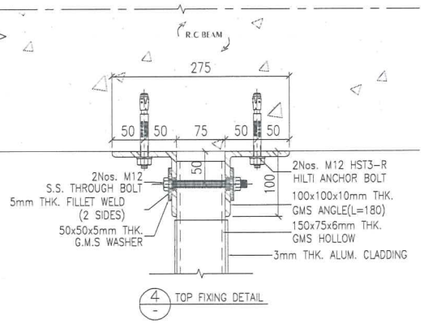

4 - TOP FIXING DETAIL

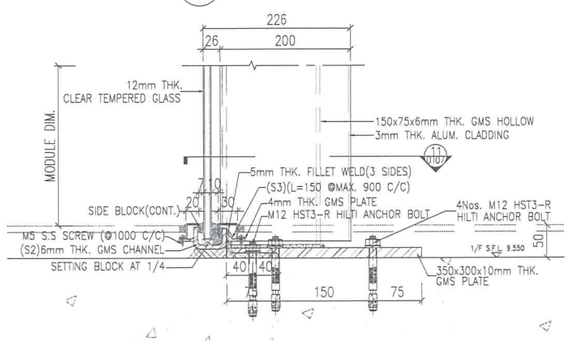

3 - TYPICAL SECTION DETAIL

B.D. Ref.

F.P.B. Ref.

DATE/REVISION/AMENDMENTS

SUN HUNG KAI ARCHITECTS AND ENGINEERS LTD.
SUN HUNG KAI CENTRE, WANCHAI, HONGKONG
TEL. 28278111 FAX. 28272884

YEE FAI CONTRACTORS CO. LTD.
44/F SUN HUNG KAI CENTRE, WANCHAI, HONGKONG
TEL. 28278111 FAX. 28270717

美特鋁質有限公司
MIDI ALUMINIUM FABRICATOR LTD.
Units 6-8, Sunray Industrial Centre, 1/F
610 Cha Kwo Ling Road, Kowloon
Tel: 23489211-4 Fax: (852)27727666

This drawing and design are copyright of the authorized person. No portion may be reproduced without his written permission. Use written dimensions. Measurements to existing works to be verified on site. This drawing shall be read in conjunction with specification and condition of contract.

PROJECT

PROPOSED RESIDENTIAL DEVELOPMENT AT TSEUNG KWAN O AREA 66D2, T.K.O.T.L. 118

TITLE

TYPICAL DETAIL FOR A & A WORKS AT PODIUM

FILE NAME

DRAWN BY

CHECKED BY


PRINTED DATE

SCALE

JOB No.	DRAWING No.	REV.
J-835	J835-AA-DT08	-

R.S.E.

FOR B.D. APPROVAL

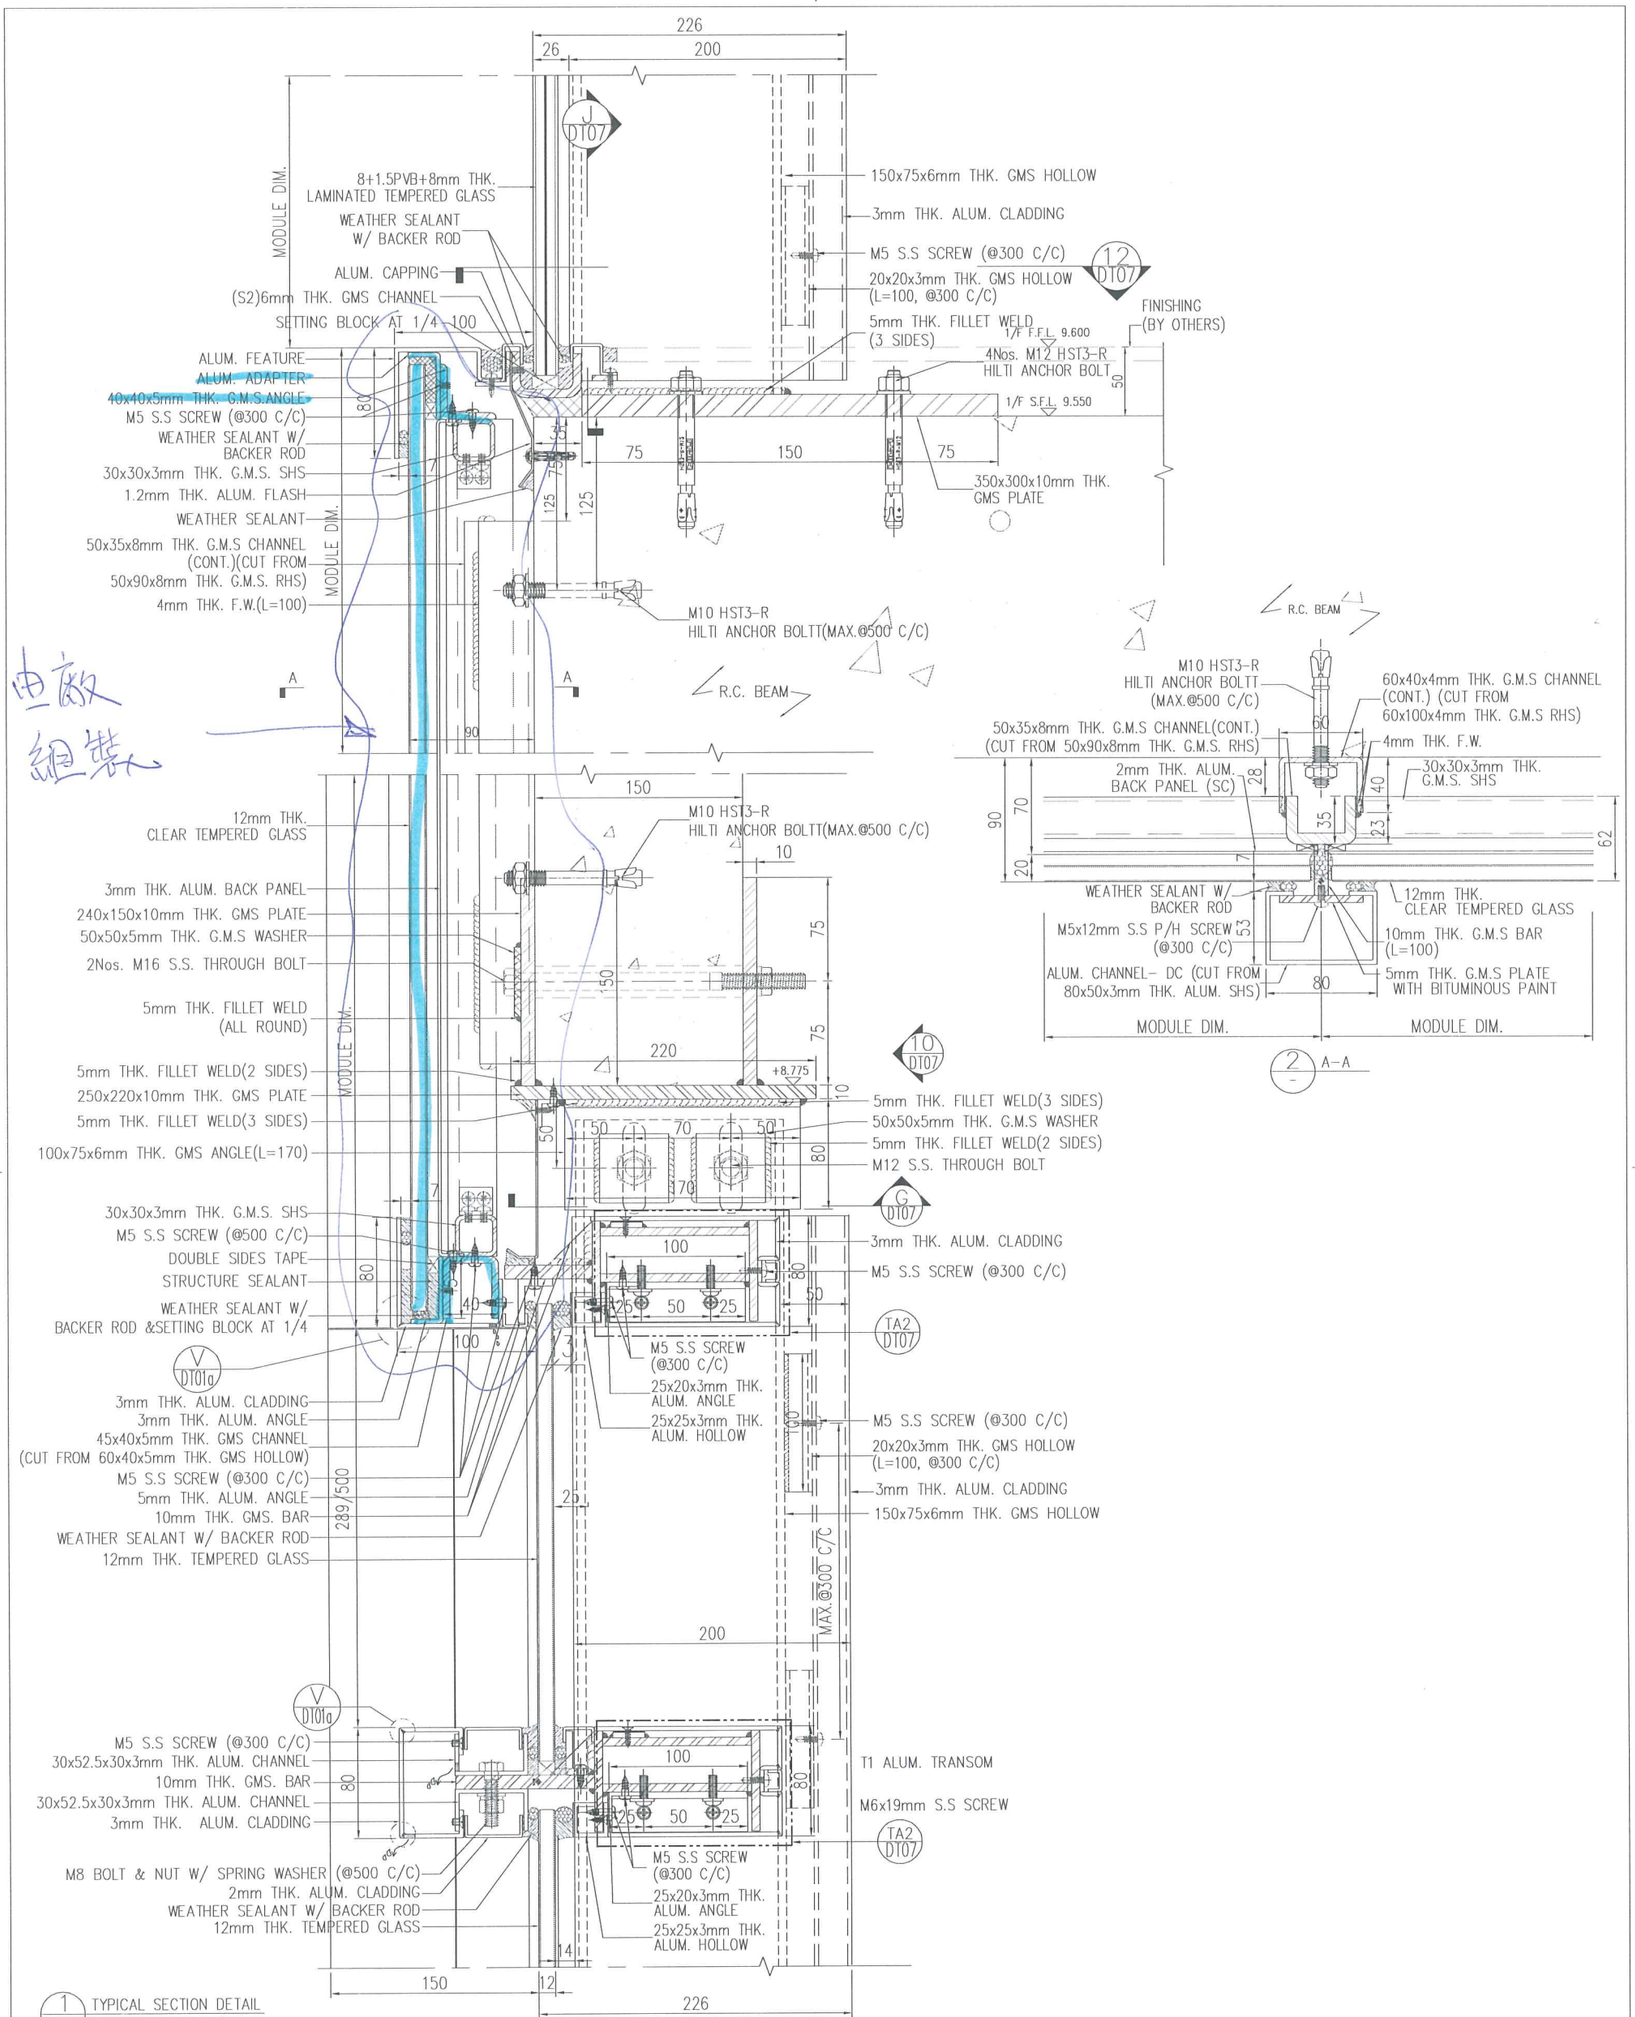

由敝
組裝

B.D. Ref.
F.P.B. Ref.

DATE/REVISION/AMENDMENTS

SUN HUNG KAI ARCHITECTS AND ENGINEERS LTD.
SUN HUNG KAI CENTRE, WANCHAI, HONGKONG
TEL. 28278111 FAX. 28272884

YEE FAI CONTRACTORS CO. LTD.
44/F SUN HUNG KAI CENTRE, WANCHAI, HONGKONG
TEL. 28278111 FAX. 28270717

美特鋁質有限公司
MIDI ALUMINIUM FABRICATOR LTD.
Units 6-8, Sunray Industrial Centre, 1/F
610 Cha Kwo Ling Road, Kowloon
Tel:23-69211-4 Fax:(852)27727666

This drawing and design are copyright of the authorised person and may not be reproduced without permission. Use written dimensions. Measurements by scaling works to be verified on site. This drawing shall be read in conjunction with specification and condition of contract.

PROJECT
PROPOSED RESIDENTIAL DEVELOPMENT AT TSEUNG KWAN O AREA 66D2, T.K.O.T.L. 118

TITLE
TYPICAL DETAILS FOR A & A WORKS AT PODIUM

FILE NAME
DRAWN BY
CHECKED BY
PRINTED DATE
SCALE
JOB No. J-835
DRAWING No. J835-AA-DT09
REV. -
R.S.E.

FOR B.D. APPROVAL

26