



工程指示 / 要求簡箋(E.I.)

工程指示編號：EI/ 9411 /18 修改版次：
 工程編號：JB36 工程名稱：日出康城7期平台
 工程項目：Window Wall (WW4 N-RH) 地盤用鐵件
 收件人：Maggie Lor 發件人：李耀鵬 日期：2018/6/6

要求提供 / 確認 事項：

- | | | |
|------------------------------------|-------------------------------------|-------------------------------|
| <input type="checkbox"/> 初步鋁料 B.M. | <input type="checkbox"/> 加工拆圖，然後生產 | <input type="checkbox"/> 尺寸表 |
| <input type="checkbox"/> 正式鋁料 B.M. | <input type="checkbox"/> 技術上資料 / 指示 | <input type="checkbox"/> 報價 |
| <input type="checkbox"/> 配件 B.M. | <input type="checkbox"/> 樣辦或貨品說明書 | <input type="checkbox"/> 分判合約 |
| <input type="checkbox"/> 其他：_____ | | |

內容：

請依附件資料，安排訂購鐵件送地盤

2018/7/10 先送 2B-1 ~ 2U-3 (2作位置)

這些鐵件均為熱浸鍍，S275 J0

(Email 回 BM 表給公司)

請在 2018/8/10 前完成上列要求。

附有關圖紙 / 文件：

以上項目為：

- 原合約工程包 原合約工程加 / 減賬 新工程報價

原因：-

分發東莞各部門：

- () 生產技術總監 連附件 () 技術部 連附件 () 生產部 連附件 () 機械設計部 連附件
 () 採購部 連附件 () 生產統籌部 連附件
 () 質檢部 連附件 () 會計部 連附件 () 報關組 連附件 () 其他 _____ 連附件

分發香港各部門：

- () 行政部 連附件 () 會計部 連附件 () 統籌部 連附件 () 工程部地盤科文 連附件
 () 採購部 連附件 () QS 部 連附件 () 維修部 連附件 () 其他 _____ 連附件

傳遞編號：

發件人簽署：

項目經理簽署：

S275 JO

熱浸鋅

④ BM表

WW4-构件清单

Assy Mk	Qty	Name	Profile	Area (m ²)	Weight (kg)
2B-1	2	BEAM	RHS120*80*6.3	0.65	30.55
2B-2	2	BEAM	RHS120*80*6.3	0.22	9.73
2B-3	2	BEAM	RHS120*80*6.3	0.65	30.51
2B-4	4	BEAM	RHS120*80*6.3	0.65	30.48
2B-5	2	BEAM	RHS120*80*6.3	0.65	30.50
2B-6	2	BEAM	RHS120*80*6.3	0.65	30.60
2B-7	1	BEAM	RHS120*80*6.3	0.66	30.98
2B-8	2	BEAM	RHS120*80*6.3	0.66	30.96
2B-9	13	BEAM	RHS120*80*6.3	0.65	30.67
2B-10	4	BEAM	RHS120*80*6.3	0.65	30.78
2B-11	2	BEAM	RHS120*80*6.3	0.65	30.71
2B-12	4	BEAM	RHS120*80*6.3	0.65	30.61
2B-13	2	BEAM	RHS120*80*6.3	0.64	30.26
2B-14	18	BEAM	RHS120*80*6.3	0.66	30.98
2B-15	7	BEAM	RHS120*80*6.3	0.65	30.94
2B-16	4	BEAM	RHS120*80*6.3	0.66	31.00
2B-17	7	BEAM	RHS120*80*6.3	0.66	31.01
2B-18	2	BEAM	RHS120*80*6.3	0.68	31.91
2B-19	2	BEAM	RHS120*80*6.3	0.65	30.43
2B-20	2	BEAM	RHS120*80*6.3	0.65	30.29
2B-21	2	BEAM	RHS120*80*6.3	0.65	30.30
2B-22	2	BEAM	RHS120*80*6.3	0.65	30.49
2B-23	13	BEAM	RHS120*80*6.3	0.65	30.73
2B-24	2	BEAM	RHS120*80*6.3	0.65	30.70
2B-25	1	BEAM	RHS120*80*6.3	0.13	5.52
2B-26	2	BEAM	RHS120*80*6.3	0.65	30.57
2C-1	4	COLUMN	RHS150*100*12.5	1.85	174.42
2C-2	5	COLUMN	RHS150*100*12.5	1.85	174.42
2C-3	1	COLUMN	RHS150*100*12.5	1.85	174.42
2C-4	3	COLUMN	RHS150*100*12.5	1.85	174.42
2C-5	3	COLUMN	RHS150*100*12.5	1.85	174.42
2C-6	37	COLUMN	RHS150*100*12.5	1.85	174.42
2C-7	1	COLUMN	RHS150*100*12.5	1.85	174.42
2C-8	1	COLUMN	RHS150*100*12.5	1.85	92.36
2C-10	1	BEAM	PL5*220.1	1.78	34.12
2JM-1	108	BEAM	RSA100*75*6	0.07	1.53
2SM-1	196	BEAM	RSA50*50*5	0.02	0.37
2SM-2	16	BEAM	RSA50*50*5	0.02	0.34
2U-1	43	BEAM	RSC75x75x6	1.02	25.14
2U-2	1	BEAM	RSC75x75x6	1.04	25.65
2U-3	1	BEAM	RSA100*75*8	0.08	2.41
3B-1	12	BEAM	RHS120*80*6.3	0.65	30.75
3B-2	2	BEAM	RHS120*80*6.3	0.65	30.80
3B-3	2	BEAM	RHS120*80*6.3	0.66	30.97
3B-4	2	BEAM	RHS120*80*6.3	0.65	30.84
3B-5	2	BEAM	RHS120*80*6.3	0.65	30.53
3B-6	20	BEAM	RHS120*80*6.3	0.65	30.66
3B-7	4	BEAM	RHS120*80*6.3	0.65	30.71
3B-8	4	BEAM	RHS120*80*6.3	0.65	30.78
3B-9	2	BEAM	RHS120*80*6.3	0.65	30.72
3B-10	10	BEAM	RHS120*80*6.3	0.65	30.61
3B-11	2	BEAM	RHS120*80*6.3	0.65	30.46
3B-12	6	BEAM	RHS120*80*6.3	0.64	30.26
3B-13	2	BEAM	RHS120*80*6.3	0.66	31.00




2/2 先送 10/07/2018




WW4-构件清单



3C-1	1	COLUMN	RHS150*100*12.5	1.85	174.42
3C-2	1	COLUMN	RHS150*100*12.5	1.69	159.27
3C-3	4	COLUMN	RHS150*100*12.5	1.85	174.42
3C-4	1	COLUMN	RHS150*100*12.5	1.85	174.42
3C-5	29	COLUMN	RHS150*100*12.5	1.69	159.27
3JM-1	72	BEAM	RSA100*75*6	0.07	1.53
3SM-1	124	BEAM	RSA50*50*5	0.02	0.37
3SM-2	16	BEAM	RSA50*50*5	0.02	0.34
3U-1	5	BEAM	RSC75x75x6	1.02	25.14
3U-2	30	BEAM	RSC75x75x6	1.11	27.31
4B-1	2	BEAM	RHS120*80*6.3	0.66	31.38
4B-2	4	BEAM	RHS120*80*6.3	0.65	30.75
4B-3	12	BEAM	RHS120*80*6.3	0.65	30.77
4B-4	22	BEAM	RHS120*80*6.3	0.65	30.70
4B-5	10	BEAM	RHS120*80*6.3	0.65	30.65
4B-6	2	BEAM	RHS120*80*6.3	0.65	30.39
4B-7	4	BEAM	RHS120*80*6.3	0.65	30.35
4B-8	2	BEAM	RHS120*80*6.3	0.64	30.11
4B-9	6	BEAM	RHS120*80*6.3	0.65	30.45
4B-10	2	BEAM	RHS120*80*6.3	0.65	30.59
4B-11	2	BEAM	RHS120*80*6.3	0.65	30.72
4B-12	4	BEAM	RHS120*80*6.3	0.65	30.76
4B-13	4	BEAM	RHS120*80*6.3	0.65	30.74
4B-14	8	BEAM	RHS120*80*6.3	0.66	31.01
4B-15	2	BEAM	RHS120*80*6.3	0.65	30.71
4B-16	2	BEAM	RHS120*80*6.3	0.65	30.84
4C-1	43	COLUMN	RHS150*100*12.5	1.85	174.42
4C-2	1	BEAM	PFC-100*50*10	1.67	37.31
4C-3	1	COLUMN	RHS150*100*12.5	1.85	174.42
4JM-1	88	BEAM	RSA100*75*6	0.07	1.53
4SM-1	28	BEAM	RSA50*50*5	0.02	0.34
4SM-2	146	BEAM	RSA50*50*5	0.02	0.37
4U-1	44	BEAM	RSC75x75x6	1.02	25.14
Total for 1319 assemblies:				576.01	34889.6

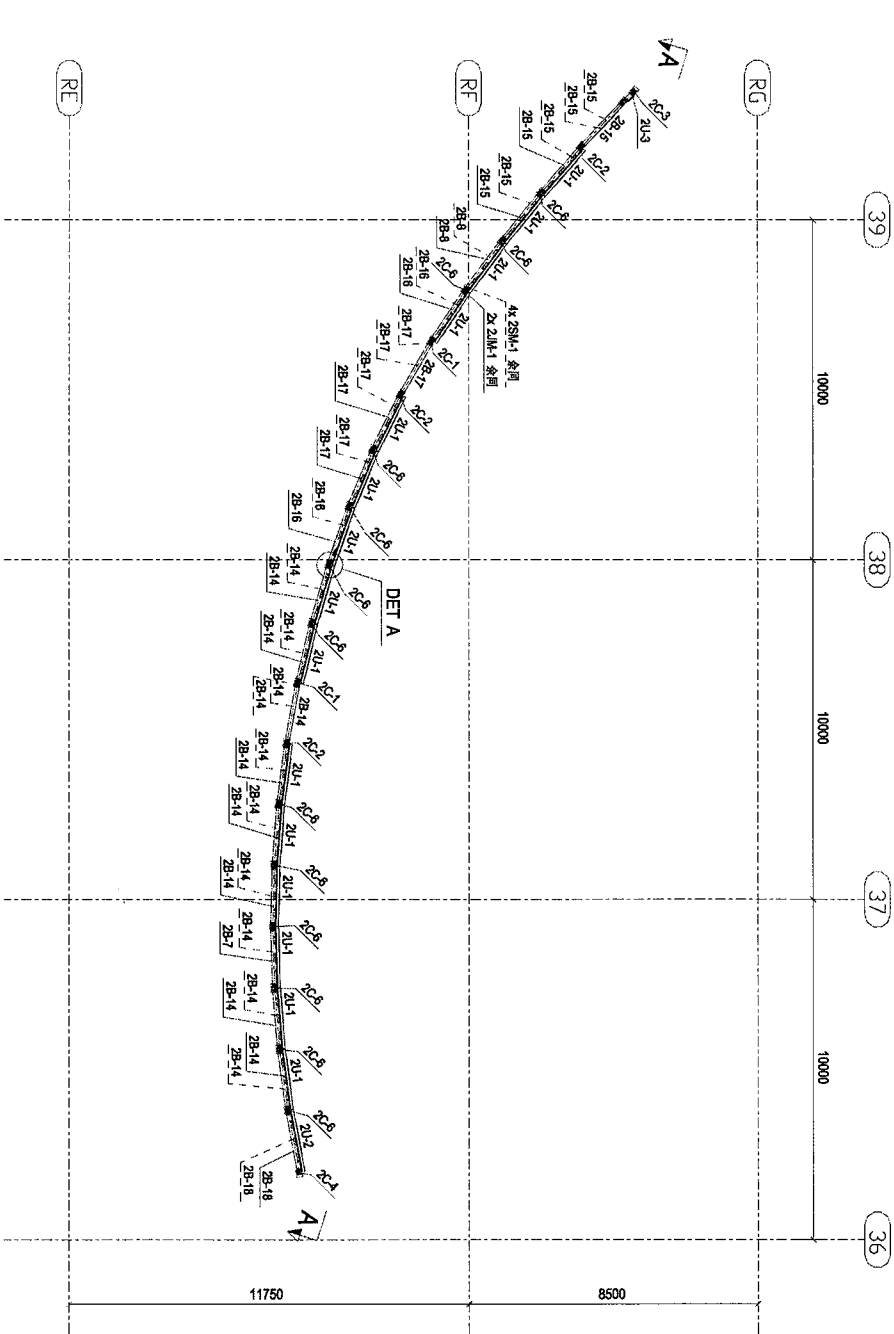

PART PLAN OF WINDOW-WALL (WW4)
 @2/F Scale: 1/150

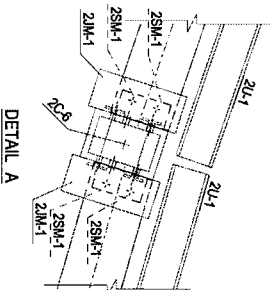

0	第一次推展	2018-05-30
Rev.	Description	Date
PROJECT: PROPOSED SITE C1 DEVELOPMENT AT AREA 86, TKOIL TO RP TSEUNG KWAN O, NEW TERRITORIES		
S 銀同有限公司 Silver Town Limited 140753-8335488 Fax: 0753-8335954 E-MAIL: ADMIN@SILVERTOWN.COM		
DRAWING TITLE: PART PLAN FOR WINDOW-WALL (WW4) @ 2/F		
CAD File Name :		
Designed by		
Drawn by		
Reviewed by		
Approved by		
Scale		
DWG NO.: J-836-WW4-MP01	REV.	0

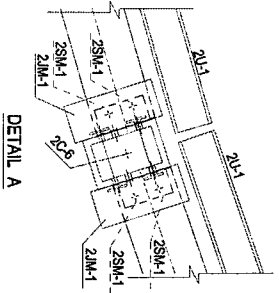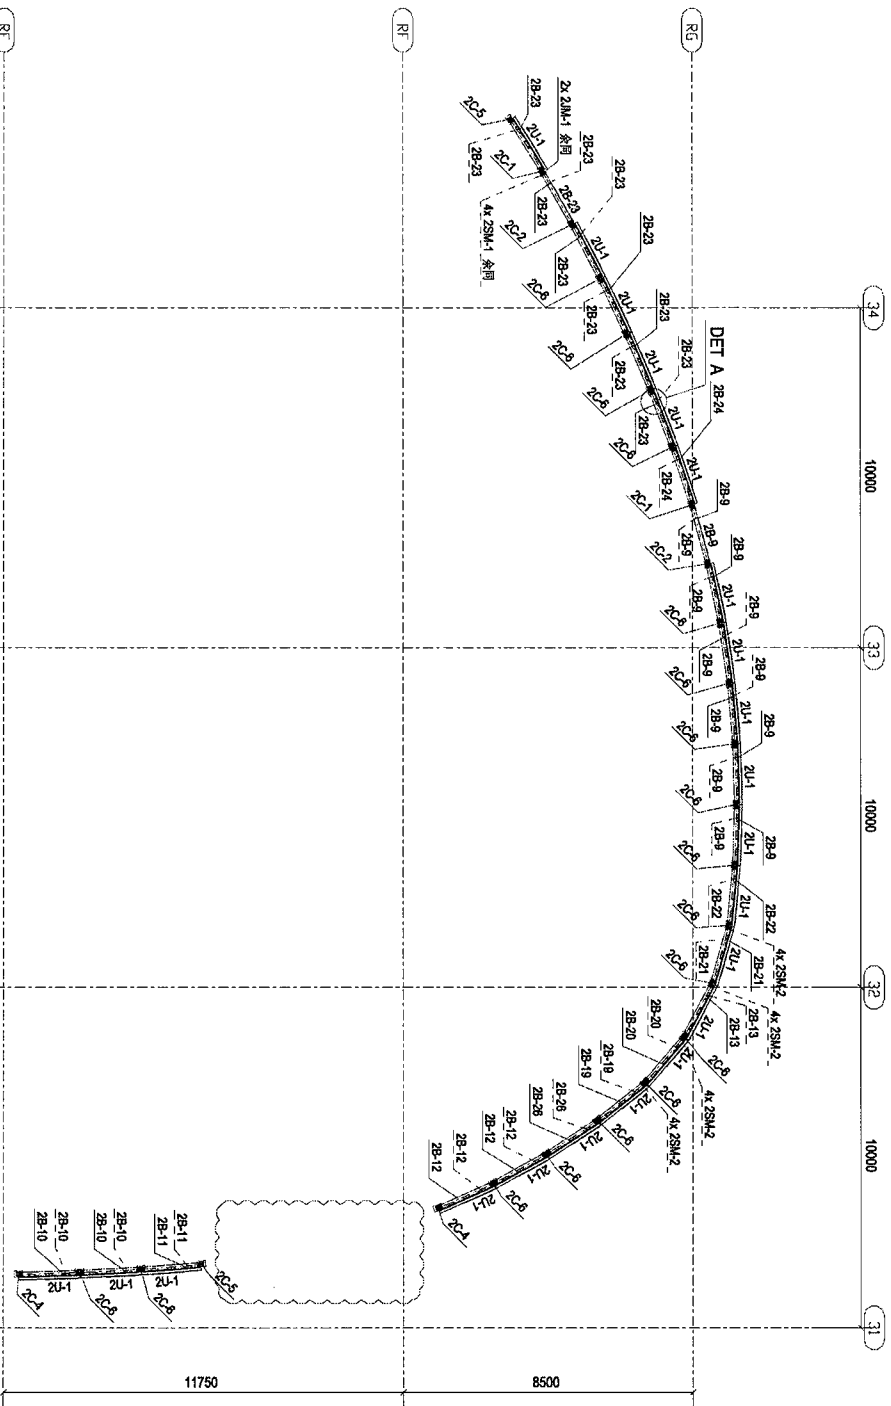

PART PLAN OF WINDOW-WALL (WW4)
 @2/F Scale: 1/150

Rev.	Description	Date
0	第一次报批	2018-05-30


PROJECT: PROPOSED SITE C1
 DEVELOPMENT AT AREA 88,
 TKOIL 70 RP, TSEUNG KWAN O,
 NEW TERRITORIES

CLIENT: 榮特經貿有限公司
 MIDAL ALUMINIUM FABRICATOR LTD.
 Unit 6-8, Sunny Industrial Centre, 1/F,
 610 Chee Kwo Ling Road, Kwai Tsing
 Tel: (852) 27172866


Silver Town Limited
 銀同有限公司
 Tel: (852) 3354588 Fax: (852) 3359594
 E-MAIL: ADDRESS@SILVERTOWN.COM

DRAWING TITLE: PART PLAN FOR WINDOW-WALL (WW4)
 @ 2/F

CAD File Name :	
Designed by :	
Drawn by :	
Reviewed by :	
Approved by :	
Scale :	
DWG NO.:	J-836-WW4-MP02
REV	0

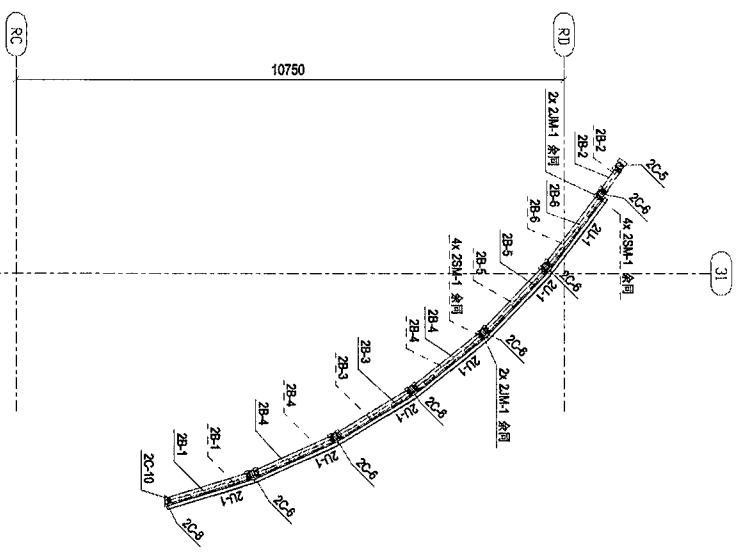

PART PLAN OF WINDOW-WALL (WW4)
 @2/F Scale: 1/150

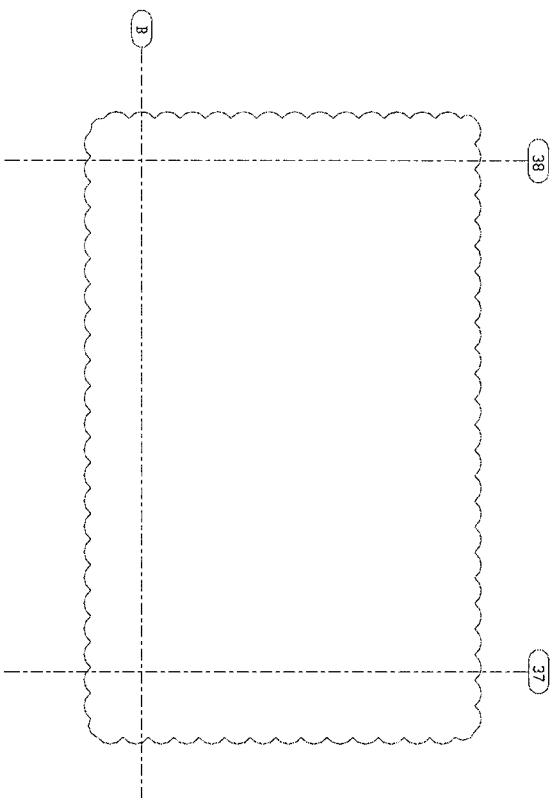

Rev.	Description	Date
0	第一次批	2019-05-30


PROJECT:
 PROPOSED SITE C1
 DEVELOPMENT AT AREA 86,
 TROTU 70 RP TSEUNG KWAN O,
 NEW TERRITORIES

CLIENT:
 美特 鋸 寶 有 限 公 司
 MIDI ALUMINIUM FABRICATOR LTD.
 Units 6-8, Sunny Industrial Centre, 1/F
 610 Chee Kwo Ling Road, Kowloon
 Tel: 23492711-4 Fax: (852) 27270685

 銀 同 有 限 公 司
 Silver Town Limited
 Tel: 0753-4153498 Fax: 0753-4153954
 E-MAIL: ADMIN@SILVERTOWN.LTD.COM


DRAWING TITLE :
 PART PLAN
 FOR WINDOW-WALL (WW4)
 @ 2/F

CAD File Name :


Designed by	
Drawn by	
Reviewed by	
Approved by	
Scale	


DWG NO.: J-836-WW4-MP03

REV.
0



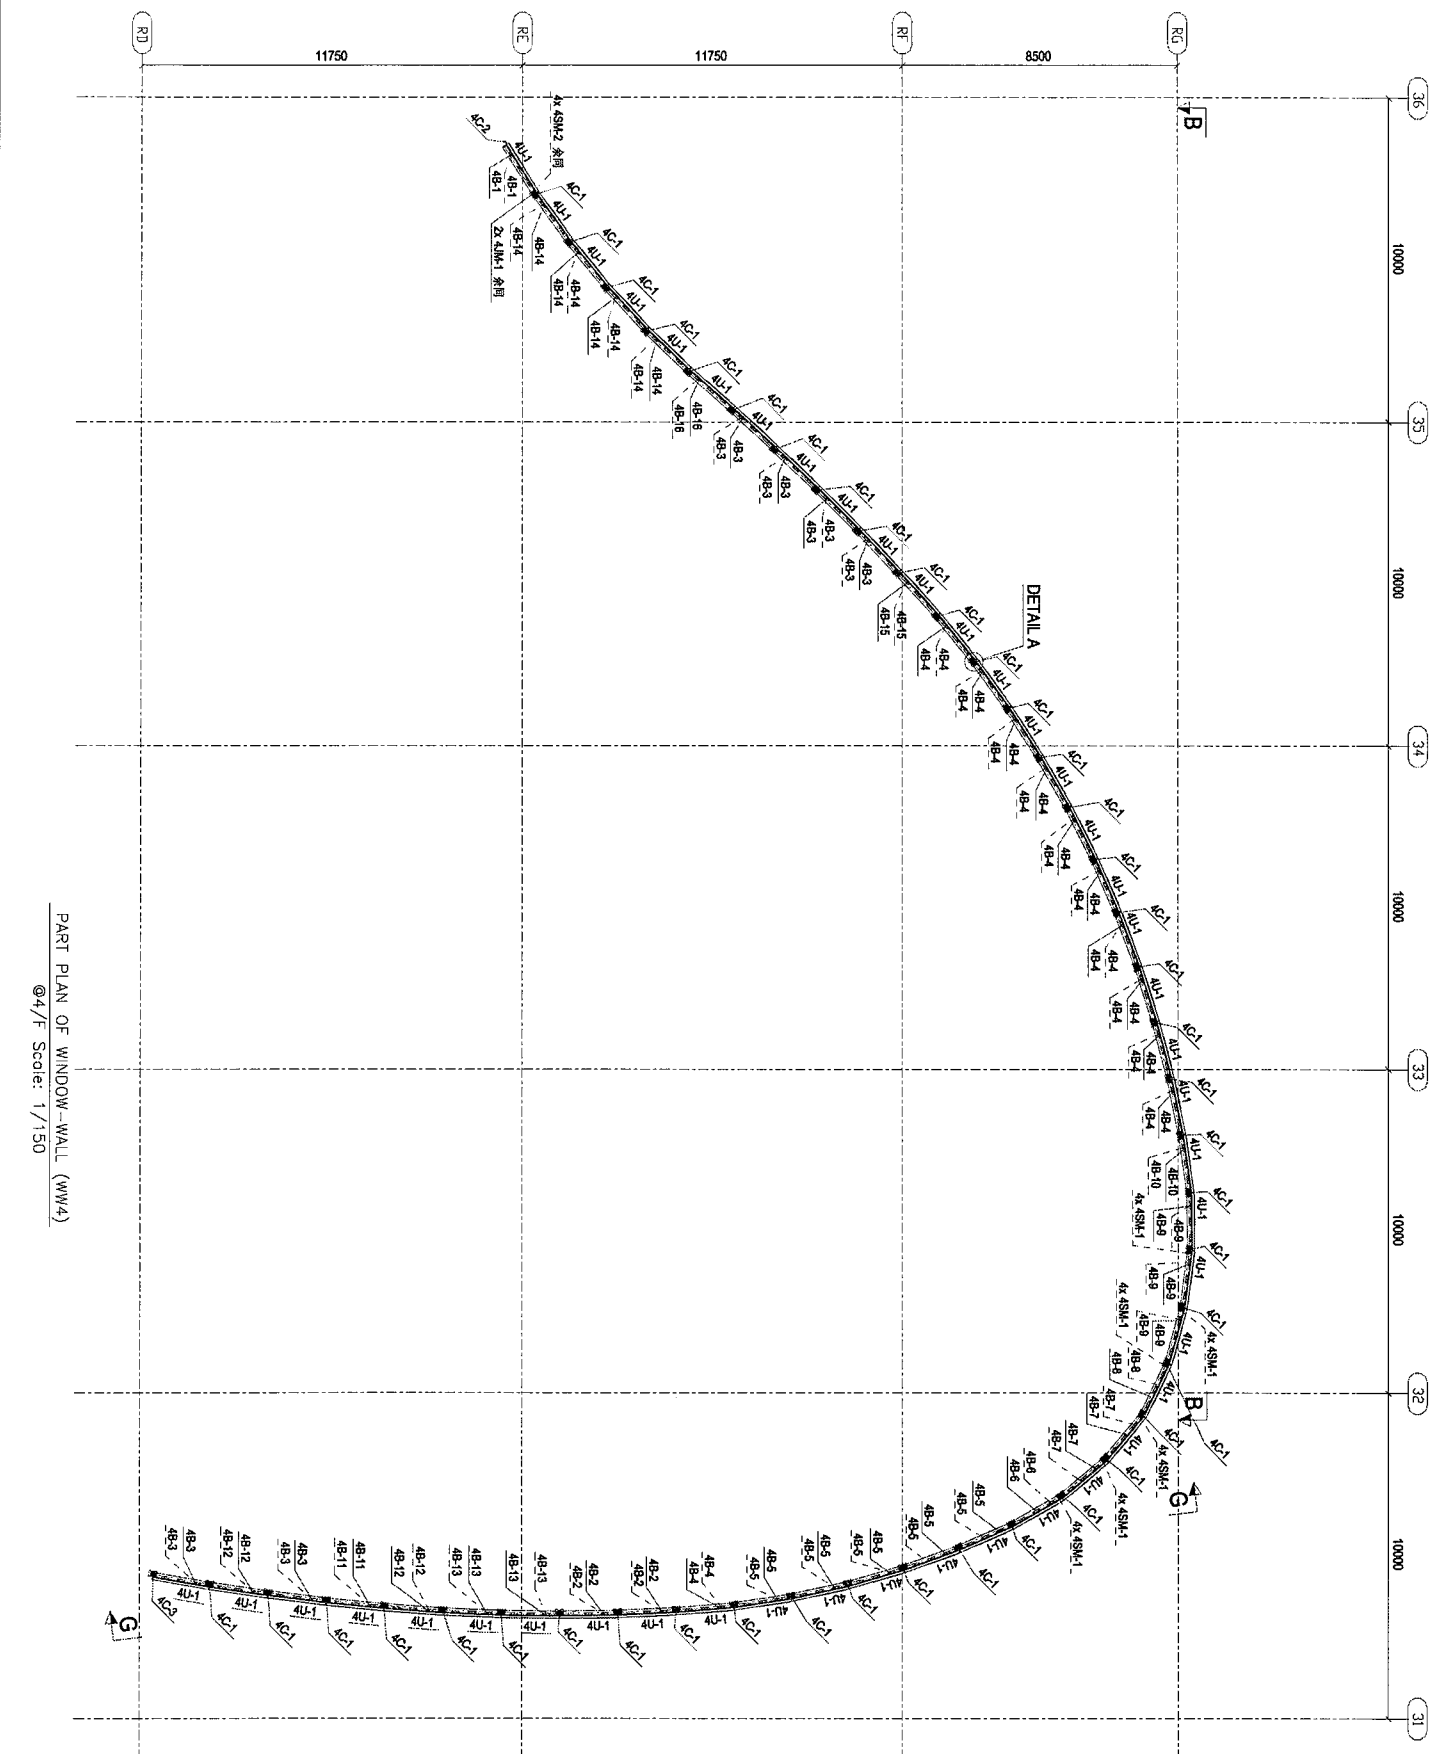


PART PLAN OF WINDOW-WALL (WW4)
 @4/F Scale: 1/150

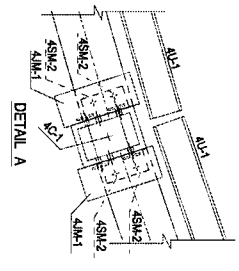

0	第一次提批	2018-05-30
Rev.	Description	Date
PROJECT: PROPOSED SITE C1 DEVELOPMENT AT AREA 88, TLOU TO RP TSEUNG KWAN O, NEW TERRITORIES		
CLIENT:  美特經貿有限公司 M(I)D ALUMINIUM FABRICATOR LTD. 510 Chee Koo Road, Kowloon Tel: (852) 271-1144 Fax: (852) 271-2086		
DRAWING TITLE: PART PLAN FOR WINDOW-WALL (WW4) @ 4/F		
CAD File Name: Designed by Drawn by Reviewed by Approved by Scale		
DWG NO.: J-886-WW4-MP05		

REV.	0
------	---

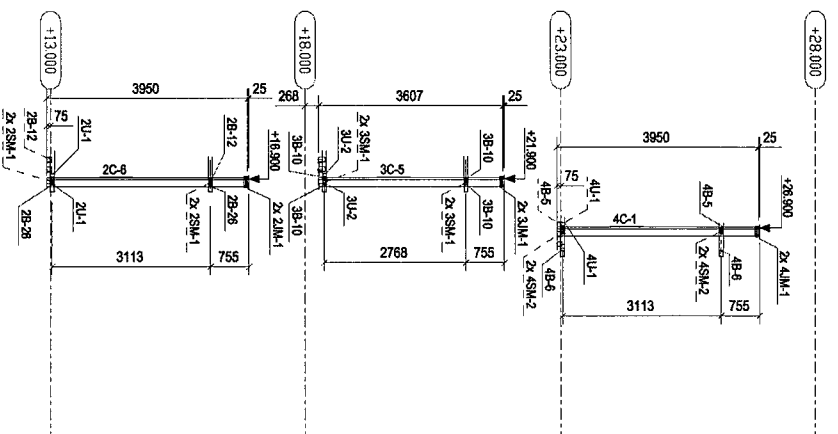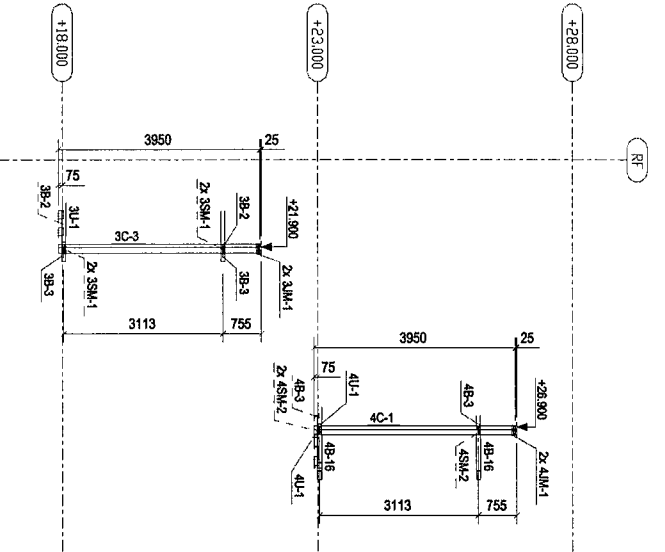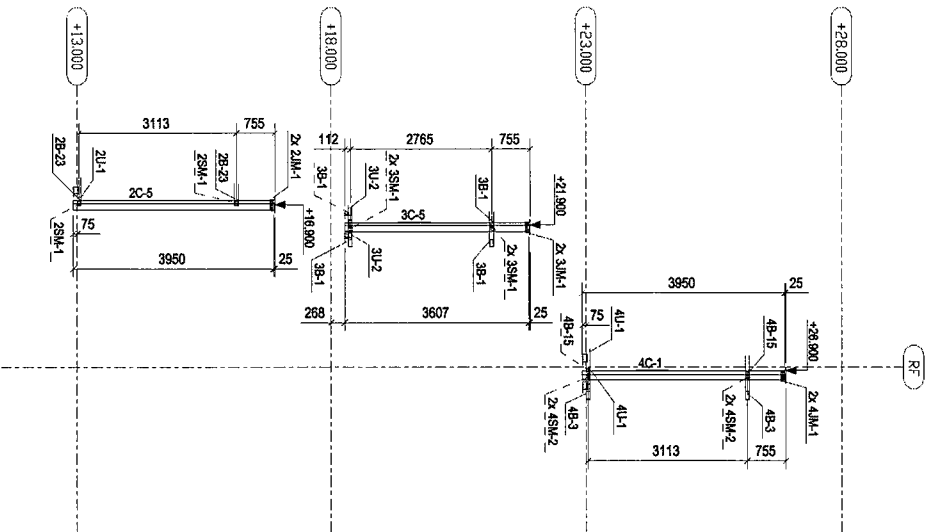

PART SECTION OF WINDOW-WAL (WW4)
COMBINE 2/F TO 4/F SCALE 1/100

PART SECTION OF WINDOW-WAL (WW4)
COMBINE 2/F TO 4/F SCALE 1/100

PART SECTION OF WINDOW-WAL (WW4)
COMBINE 2/F TO 4/F SCALE 1/100

Rev.	Description	Date
0	第一次提擬	2019-05-30


PROJECT: PROPOSED SITE C1
DEVELOPMENT AT AREA 86,
TKOITL 70 RP, TSEUNG KWAN O,
NEW TERRITORIES

CLIENT: 美特銀質有限公司
MIDI ALUMINIUM FABRICATOR LTD
Units 6-8, Sunny Industrial Centre, 1/F
610 Chee Koo Road, Kowloon
Tel: (852) 27778155 Fax: (852) 27778156

銀同有限公司
Silver Town Limited
Tel: 0755-8155068 Fax: 0755-8155954
E-Mail: KCB@RS35@foxmail.com, 183.COM

DRAWING TITLE: PART PLAN
FOR WINDOW-WALL (WW4)
@ 2/F

CAD File Name :	
Designed by :	
Drawn by :	
Reviewed by :	
Approved by :	
Scale :	
DWG NO.:	J-336-WW4-MF08
REV	0

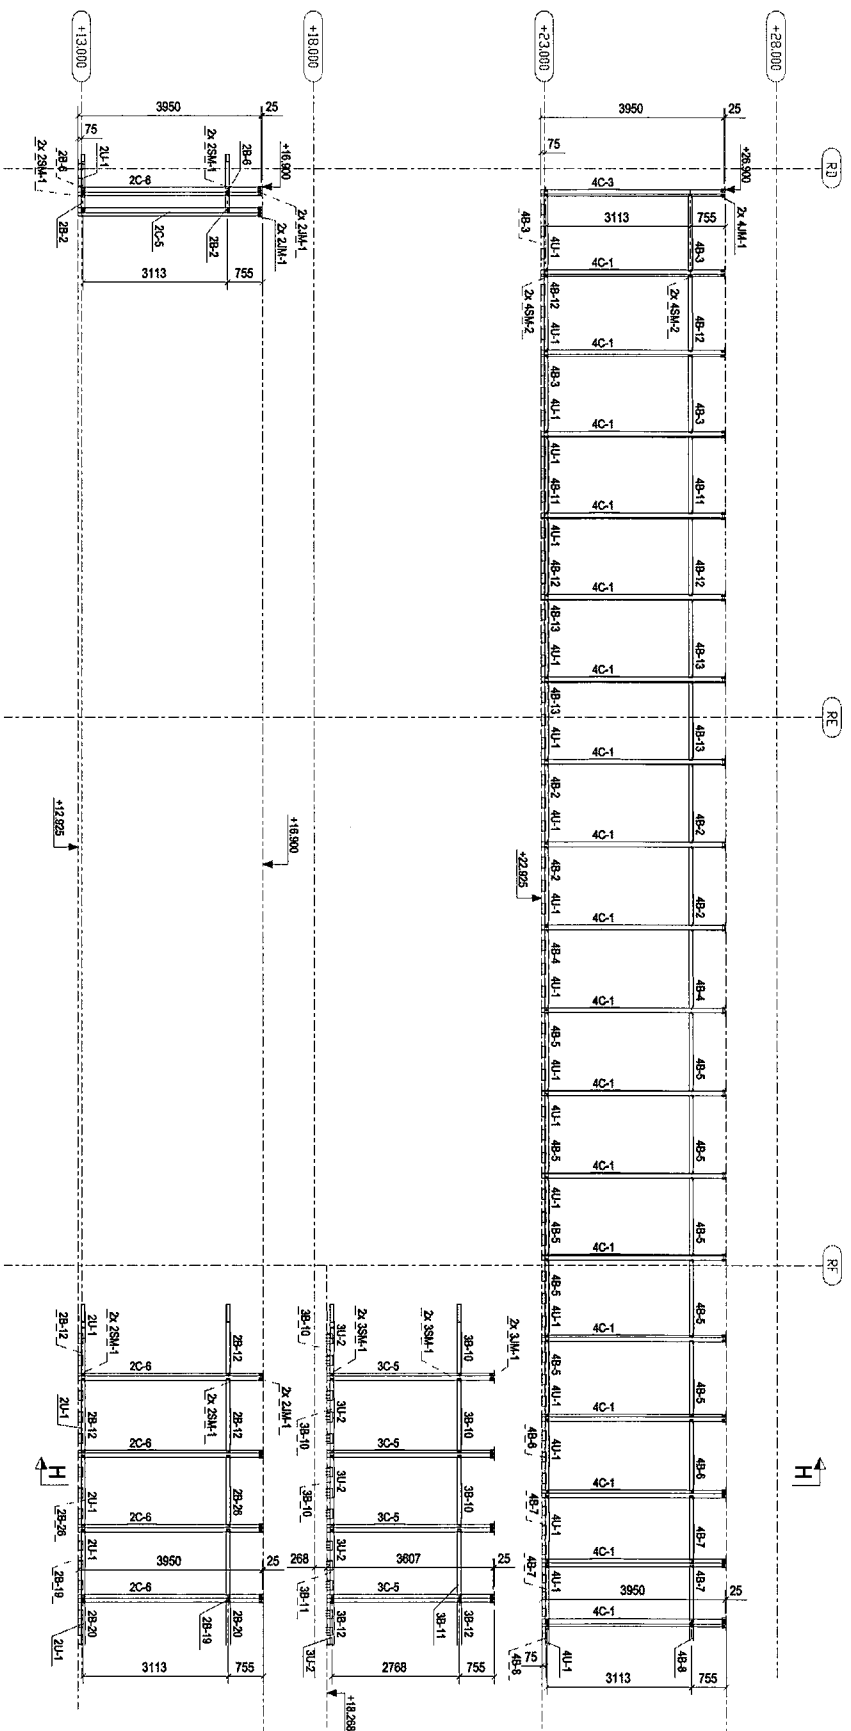

G - G
PART ELEV. OF WINDOW-WALL (WW4)
COMBINE 2/F TO 4/F SCALE 1/100

Rev.	Description	Date
0	第一次报批	2019-05-30

PROJECT: PROPOSED SITE C1
DEVELOPMENT AT AREA 88,
TKOIL TO RP, TSEUNG KWAN O,
NEW TERRITORIES


CLIENT: 美特 寔 有限公司
MIDI ALUMINIUM FABRICATOR LTD
Units 6-8, Sundry Industrial Centre, 1/F
510 Sha Kwo Ling Road, Kowloon
Tel: 23469211-4 Fax: (852) 2727886

銀同有限公司
Silver Town Limited
Tel: 076-8334988 Fax: 076-8333954
E-MAIL: 2008552@silvertown.hk

DRAWING TITLE: PART PLAN
FOR WINDOW-WALL (WW4)
@ 2/F

CAD File Name :	
Designed by :	
Drawn by :	
Reviewed by :	
Approved by :	
Scale :	
DWG NO.:	J-836-WW4-MP09
REV.	0

零件编号	2B-1	零件数量	2	零件重量	30.8
零件编号	规格(mm)	长度(mm)	宽度(mm)	厚度(mm)	表面粗糙度
M129	RHS120°90°6.3	1699	1	31	0.65
				合计	30.85

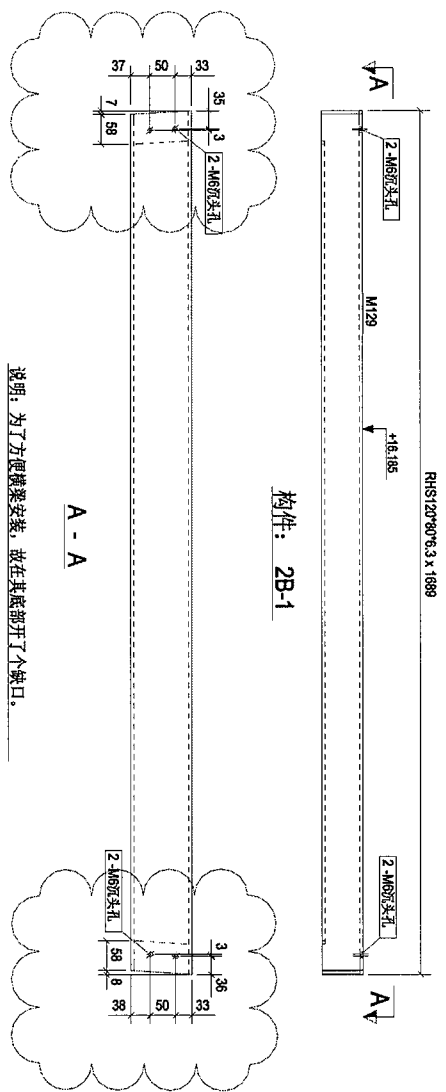

说明: 为了方便核算安装, 故在其底部开了个缺口。

0	第一次报批	2018-05-30
Rev.	Description	Date

PROJECT: PROPOSED SITE C1
DEVELOPMENT AT AREA 88,
TKOHL 70 BP, TSEUNG KWAN O,
NEW TERRITORIES


CLIENT: 基特銀質有限公司
MIDI Aluminium Fabricator Ltd.
Units 5-8, Sunny Industrial Centre, 1/F,
610 Cho Kwo Ling Road, Kowloon
Tel: (2348)211-4 Fax: (852)2722986

Silver Town Limited
Tel: (0789) 4235468 Fax: (0789) 4335554
E-MAIL: ADRES554@silvertown.ltd.com

DRAWING TITLE: WINDOW-WALL (MWA4)
[2B-1]

CAD File Name:	
Designed by	
Drawn by	
Reviewed by	
Approved by	
Scale	
DWG NO: J-836-MWA- [2B-1]	REV. 0

零件编号	2B-3	零件数量	2	零件重量	30.7
零件编号	规格(mm)	长度(mm)	数量	重量(kg)	表面积(m ²)
M131	RHS120*80*3	1866	1	31	0.65
合计:					30.51

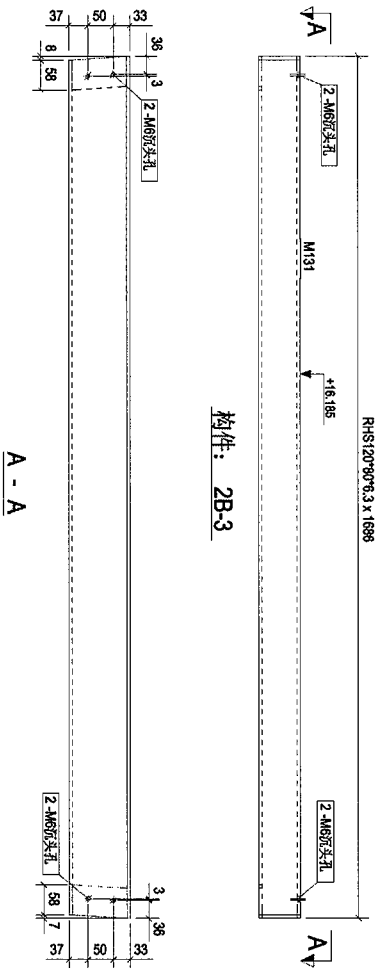

构件: 2B-3

A - A

Rev.	Description	Date
0	第一次报批	2018-05-30

PROJECT: PROPOSED SITE C1
DEVELOPMENT AT AREA B6,
TKOIL 70 RP, TSEUNG KWAN O,
NEW TERRITORIES


CLIENT: 華特經貿有限公司
MTDI Architecture Ltd.
Units 5-8, Sunway Industrial Centre, Y/F
510 Chee Kwo Ling Road, Kowloon
Tel: (852) 27721986

銀同有限公司
Silver Town Limited
Tel: 0759-8133888 Fax: 0759-8133554
E-MAIL: ADP@SILVERTOWN.COM

DRAWING TITLE: WINDOW-WALL (MM4)
[2B-3]

CAO File Name:	
Designed by:	
Drawn by:	
Reviewed by:	
Approved by:	
Scale:	
DWG NO: J-836-MW4-[2B-3]	REV: 0

物料编号	规格(mm)	数量	重量(kg)	共重(kg)	表面积(m ²)
M130	RHS120*90*6.3	1	30.48	30.48	0.65
合计				30.48	

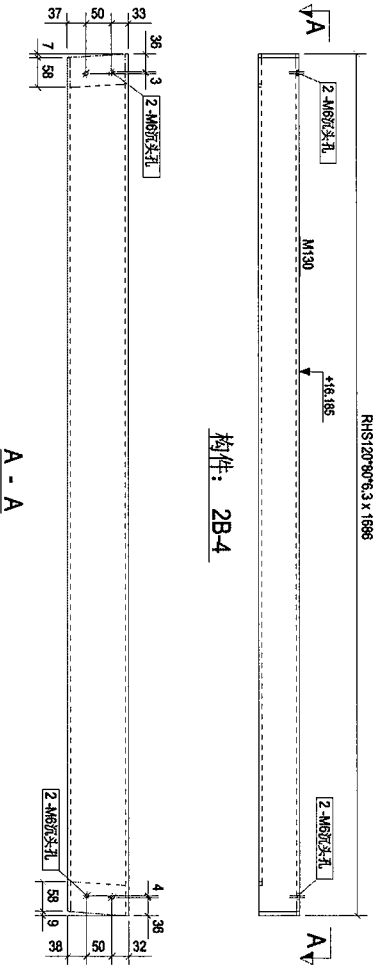

Rev.	Description	Date
0	第一次报批	2018-05-30

PROJECT: PROPOSED SITE C1
DEVELOPMENT AT AREA 86,
TKOIL TO RP TSEUNG KWAN O,
NEW TERRITORIES

CLIENT:
美特铝质有限公司
MIDI Aluminium Fabricator (M)
Units 6-8, Sunny Industrial Centre, 1/F
610 Chee Koo Ling Road, Kwai Tsuen
Tel: 23489211-4 Fax: (852) 27272986


银同有限公司
Silver Town Limited
Tel: 0753-8334988 Fax: 0753-8335954
E-MAIL: ADDRESS@silvertown.com

DRAWING TITLE:
WINDOW-WALL (MMW4)
[2B-.4]

CAO File Name:	
Designed by	
Drawn by	
Reviewed by	
Approved by	
Scale	
DWG NO: J-836-MW4-[2B-.4]	REV: 0

4

零件编号	规格(mm)	长度(mm)	数量	重量(kg)	共重(kg)	表面积(m ²)
M132	RHS120°90°6.3	1687	1	30.50	0.65	
合计:				30.50		

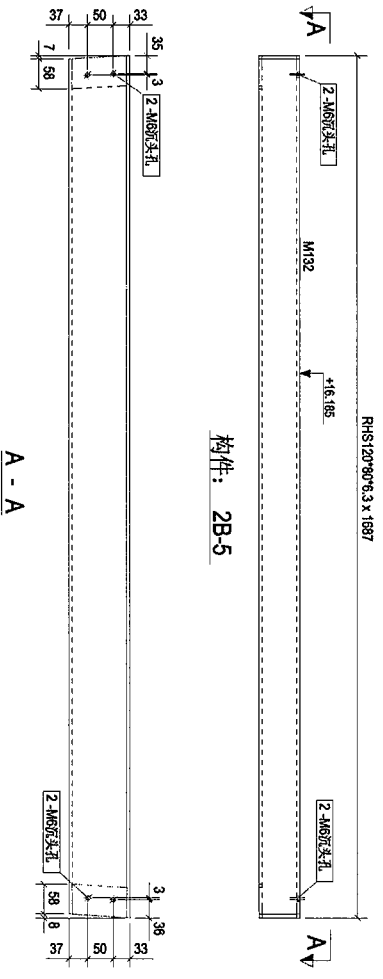

Rev.	Description	Date
0	第一次报批	2016-05-30

PROJECT: PROPOSED SITE C1
DEVELOPMENT AT AREA 88,
TKOIL ZONED, TSEUNG KWAN O,
NEW TERRITORIES

CLIENT: 美特铝业有限公司
MIDI Aluminium Manufacturer sm.
Units 6-8 Sunny Industrial Centre, 1/F
670 Cho Kuo Ling Road, Kowloon
Tel: 23499211-4 Fax: (852) 2722986


Silver Town Limited
Tel: 0753-4133498 Fax: 0753-4133554
E-MAIL: ADDRESS@silvertown.hk TEL: 00852-2722986

DRAWING TITLE: WINDOW-WALL (M132)
WINDOW-WALL (M132)
[2B-5]

CAO File Name:	
Designed by:	
Drawn by:	
Reviewed by:	
Approved by:	
Scale:	
DWG NO: J-836-MW4-[2B-5]	REV. 0

5

零件编号	2B-6	零件数量	2	零件重量	30.9
零件编号	规格(mm)	长度(mm)	数量	重量(kg)	表面面积
M133	RHS120*90*6.3	1690	1	30.60	0.65
合计				30.60	

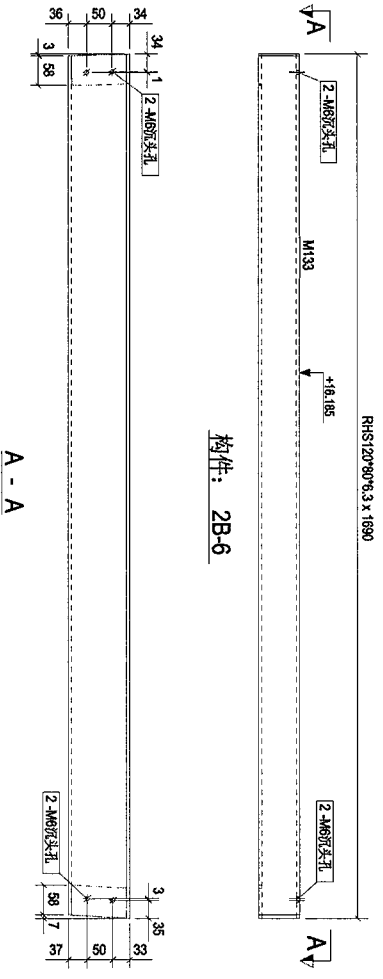

构件: 2B-6

A - A

Rev.	Description	Date
0	第一次报批	2016-05-30

PROJECT: PROPOSED SITE C1
DEVELOPMENT AT AREA 88,
TKOIL 70RP, TSEUNG KWAN O,
NEW TERRITORIES

CLIENT:
美特铝质有限公司
MTDI Aluminium Fabrication Ltd.
Units 5-8, Sunny Industrial Centre, 1/F
610 Chee Kwo Ling Road, Kowloon
Tel: (2349)211-4 Fax: (852)2722956


银同有限公司
Silver Town Limited
Tel: (876) 4334988 Fax: (876) 4335554
E-MAIL: ADDRESS@silvertown.hk TEL: CON

DRAWING TITLE:
WINDOW-WALL (MMW4)
[2B-.6]

CAD File Name :	
Designed by	
Drawn by	
Reviewed by	
Approved by	
Scale	
DWG NO. : J436-MW4- [2B-.6]	REV. 0

6

零件编号	规格	数量	重量	共重	表面积
M95	RHS120*80*6.3	1	31	30.98	0.66
合计:			30.98		

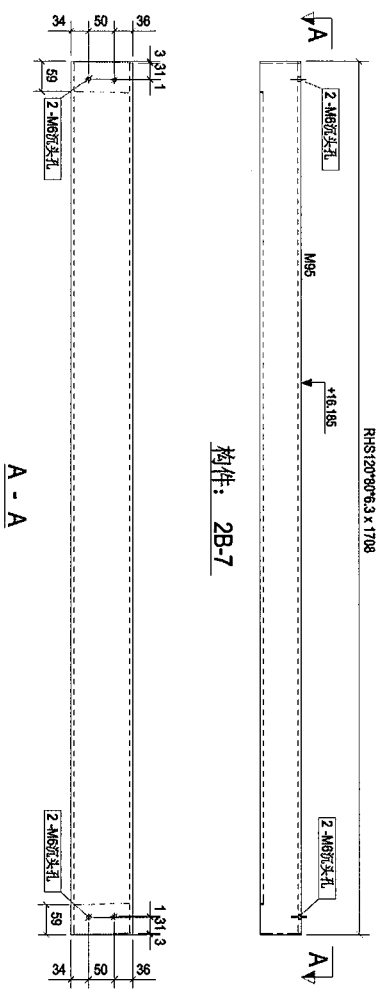

构件: 2B-7

A - A

Rev.	Description	Date
0	第一次报批	2018-05-30

PROJECT:
PROPOSED SITE C1
DEVELOPMENT AT AREA 86,
TKOIL TO RP, TSEUNG KWAN O,
NEW TERRITORIES


CLIENT:
基特銀寶有限公司
Units 5-8, Sunny Industrial Centre, 1/F
610 Chee Kwo Ling Road, Kowloon
Tel: (852) 4892111-4 Fax: (852) 2722586

银同有限公司
Silver Town Limited
Tel: (852) 4338488 Fax: (852) 789-8335/8554
E-MAIL: ADDRESS@SILVERTOWN.HK.COM

DRAWING TITLE:
WINDOW-WALL (MM4)
[2B-.7]

CAD File Name :	
Designed by	
Drawn by	
Reviewed by	
Approved by	
Scale	
DWG NO: J4836-MM4-[2B-.7]	REV. 0

图件编号:	2B-8	图件数量:	2	图件重量:	31.1
图件编号	规格(mm)	长度(mm)	数量	重量(kg)	表面积(m ²)
M85	RHS120*80*6.3	1707	1	30.96	0.66
合计:			30.96		

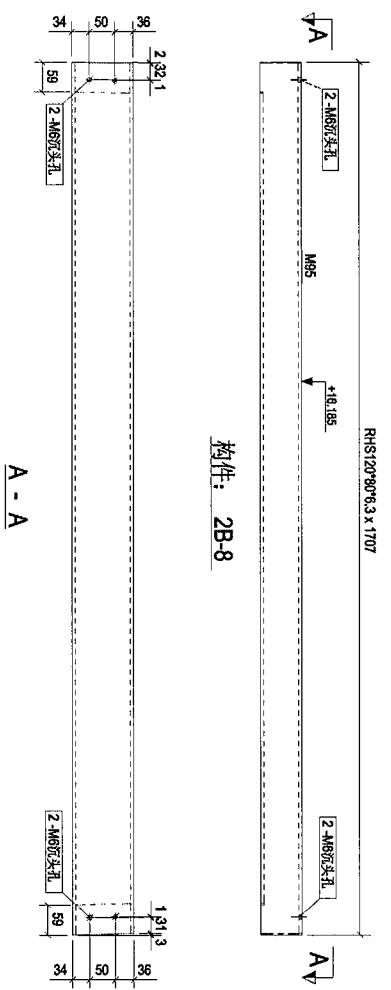

0	第一次报批	2018-05-30
Rev.	Description	Date

PROJECT:
 PROPOSED SITE C1
 DEVELOPMENT AT AREA B6,
 TKOIL TO RP, TSEUNG KWAN O,
 NEW TERRITORIES

CLIENT:
美特銀寶有限公司
 Units 5-8, Sunway Industrial Centre, 1/F
 610 Chee Kwo Ling Road, Kowloon
 Tel: 23499211-4 Fax: (852) 27215586


銀同有限公司
 Silver Town Limited
 Tel: 0759-8335488 Fax: 0759-8335554
 E-MAIL: ADDRESS: 4591486@90.hk3.com

DRAWING TITLE:
 WINDOW WALL (M85)
[2B-.8]

CAO File Name :	
Designed by	
Drawn by	
Reviewed by	
Approved by	
Scale	
DWG NO.:	J4836-MW4-[2B-.8]
REV.	0

8

零件号	2B-9	零件数量	13	所在层数	30.8
零件编号	规格(mm)	长度(mm)	数量	重量(kg)	表面面积
M88	RHS120°90°6.3	1692	1	30.67	0.65
合计:				30.67	

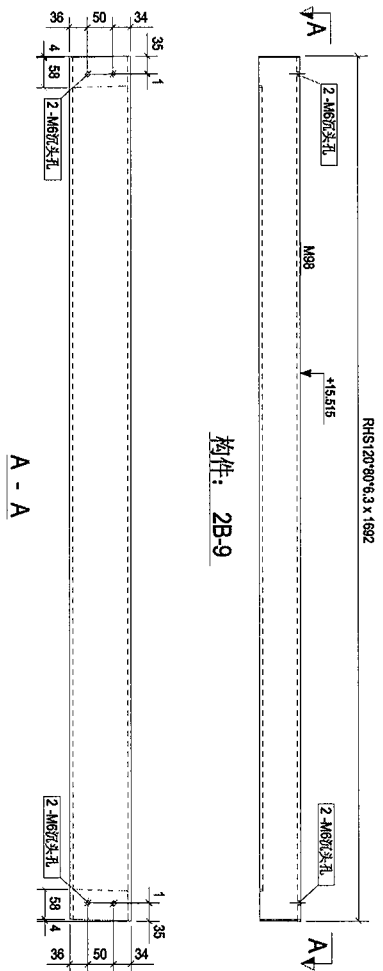

Rev.	Description	Date
0	第一次报批	2016-05-30

PROJECT: PROPOSED SITE C1
DEVELOPMENT AT AREA 88,
TKOIL 70 BP, TSEUNG KWAN O,
NEW TERRITORIES

CLIENT: 基特铝业有限公司
MIDI ALUMINUM FABRICATOR LTD.
Units 5-8, Sunny Industrial Centre, 1/F
610 Cho Kwai Ling Road, Kowloon
Tel: (852) 892111-4 Fax: (852) 27272986


Silver Town Limited
Tel: (876) -83384488 Fax: (876) -83359554
E-MAIL: A0BPC55@silvertown.hk.TCOM

DRAWING TITLE: WINDOW-WALL (MM4)
[2B-9]

CAJ File Name :	
Designed by	
Drawn by	
Reviewed by	
Approved by	
Scale	
DWG NO.: J836-MM4-[2B-9]	REV. 0

9

零件编号	2B-11	零件数量	2	零件重量	30.9
零件编号	规格(mm)	长度(mm)	数量	重量(kg)	表面积(m ²)
M101	RHS120*90*6.3	1693	1	31	0.65
				30.71	
			合计	30.71	

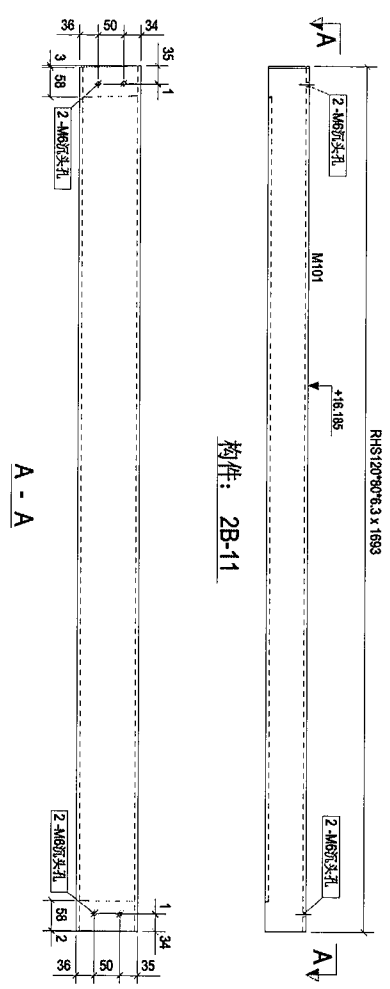

构件: 2B-11

Rev.	Description	Date
0	第一次报批	2016-05-30

PROJECT: PROPOSED SITE C1
DEVELOPMENT AT AREA 08,
NEW TERRITORIES

CLIENT: 業特銀寶有限公司
Unit 6-8, Simey Industrial Centre, 1/F
510 Che Kwo Ling Road, Kowloon
Tel: (852) 27277686 Fax: (852) 27277686

Silver Town Limited
银同有限公司
E-MAIL: ADDRESS@silvertown.com.hk

DRAWING TITLE: WINDOW-WALL (M101)
[2B-11]






零件编号:	2B-12	零件数量:	4	零件重量:	30.8
零件型号	规格(mm)	长度(mm)	数量	重量(kg)	重量(kg)
M102	RHS120*90*5.3	1890	1	30.61	0.65
			合计:	30.61	

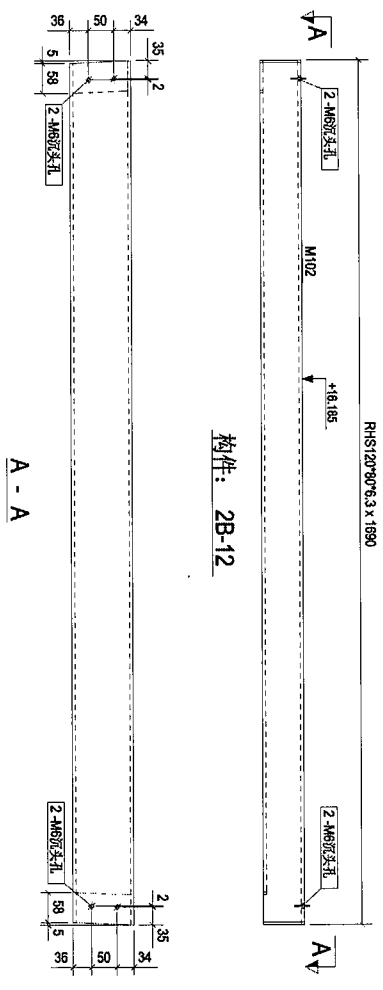

Rev.	0	第一次提纯	2018-05-30
Rev.		Description	Date

PROJECT: PROPOSED SITE C1
DEVELOPMENT AT AREA 88,
TKOIL 70 RP, TSEUNG KWAN O,
NEW TERRITORIES


CLIENT: 美特铝业有限公司
MIDI Aluminium Manufacture Ltd.
Units 6-8, Shing Hei Industrial Centre, V/F
810 Chee Kwo Jung Road, Tuen Mun
Tel: 23093111-4, Fax: (852) 27121886

银同有限公司
Silver Town Limited
Tel: 0759-83354668 Fax: 0759-8335934
E-MAIL: ADDRESS@silvertown.com.hk

DRAWING TITLE: WINDOW-WALL (MW4)
[2B-12]

CAD File Name:	
Designed by	
Drawn by	
Reviewed by	
Approved by	
Scale	
DWG NO.: J-836-MW4-[2B-12]	REV: 0

零件编号	规格(mm)	数量	单重(kg)	总重(kg)	备注
M104	RHS120°90°5.3	1	30.26	30.26	
合计:				30.26	

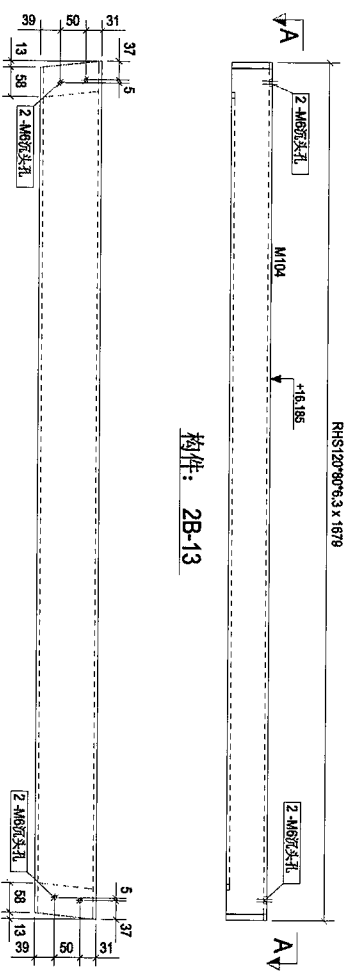

构件: 2B-13

A - A

Rev.	Description	Date
0	第一次报批	2018-05-30


PROJECT: PROPOSED SITE C1
DEVELOPMENT AT AREA 08,
TKOIL TOWN, TSEUNG KWAN O,
NEW TERRITORIES

CLIENT: 華特經貿有限公司
MIDI Architecture
Units 6-5, Sunray Industrial Centre, 1/F,
610 Cho Kwo Ling Road, Kowloon
Tel: 23449211-4 Fax: (852) 27272668

DRAWING TITLE: WINDOW-WALL (WWW)
[2B-13]

Scale	Scale
Scale	
Approved by	
Reviewed by	
Drawn by	
Designed by	
CAD File Name:	

构件编号	2B-14	构件名称	18	构件重量	31.1
规格		长度(m)	数量	单重(kg)	重量(kg)
M115	RHS120*80*6.3	1708	1	31.00	31.00
			31	0.66	0.66
合计				31.00	

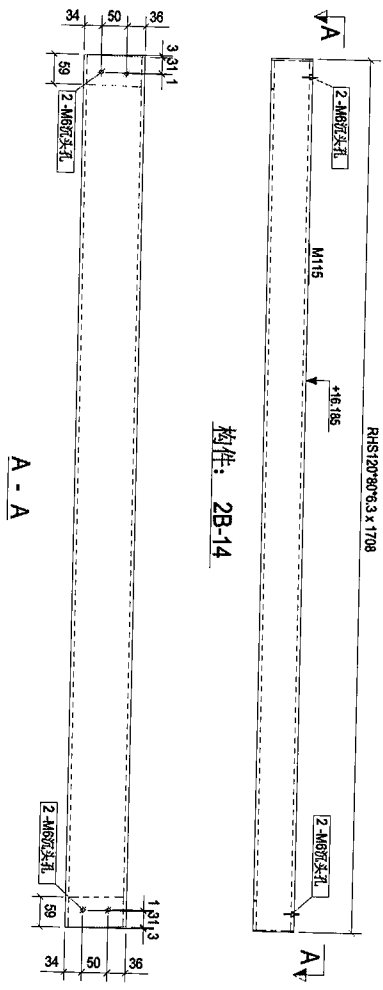

Rev.	Description	Date
0	第一次报批	2018-05-30

PROJECT: PROPOSED SITE C1
DEVELOPMENT AT AREA 86
TKOIL 70RP TSEUNG KWAN O,
NEW TERRITORIES


CLIENT: 美特铝业有限公司
MIDI Aluminium Fabricators Ltd.
Units 6-8, Sunny Industrial Centre, 1/F
510 Chee Kwo Ling Road, Kowloon
Tel: (852) 27277586 Fax: (852) 27277586

银同有限公司
Silver Town Limited
Tel: (852) 83254888 Fax: (852) 83255354
E-Mail: ADMIN@SSTsilvertown.com.hk

DRAWING TITLE: WINDOW-WALL (M115)
[2B-14]

CAD File Name :	
Designed by	
Drawn by	
Reviewed by	
Approved by	
Scale	
DWG NO. J-836-WM4 [2B-14]	REV. 0

零件编号	规格(mm)	数量	重量(g)	共重(g)	表面积(m ²)
M116	RHS120°80°6.3	1705	31	30.94	0.65
合计:		1	31	30.94	0.65

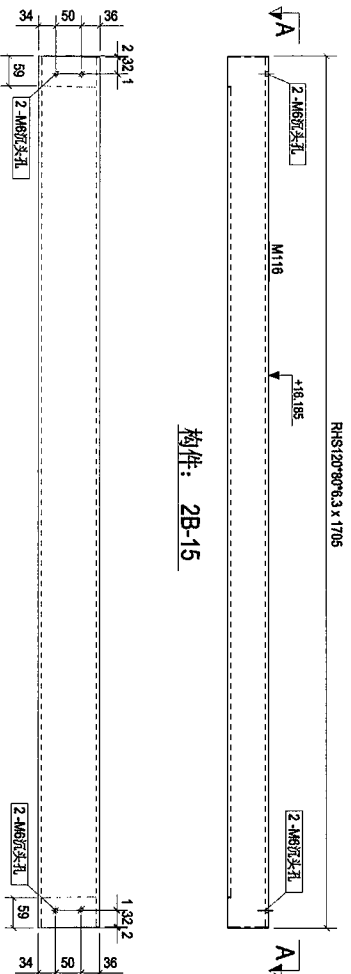

构件: 2B-15

A - A

Rev.	Description	Date
0	第一次报批	2018-05-30

PROJECT: PROPOSED SITE C1
DEVELOPMENT AT AREA B6,
TKOIL TO RP, TSEUNG KWAN O,
NEW TERRITORIES


CLIENT: 美特铝业有限公司
MIDI Aluminium Fabricator (M)
Units 6-8, Sunny Industrial Centre, 1/F
610 Che Kwo Ling Road, Kowloon
Tel: 23892111-4 Fax: (852) 27272866

Silver Town Limited
银同有限公司
Tel: 0783-8335468 Fax: 0783-8335554
E-MAIL: a00r255@silvertown.com.hk

DRAWING TITLE: WINDOW WALL (MM4)
[2B-15]

CA3 File Name:	
Designed by	
Drawn by	
Reviewed by	
Approved by	
Scale	
DWG NO.: J-836-MM4-[2B-15]	REV: 0

零件号	规格	数量	重量	面积
M117	RHS120°90°6.3	1	30.99	0.66
合计:		31	30.99	0.66

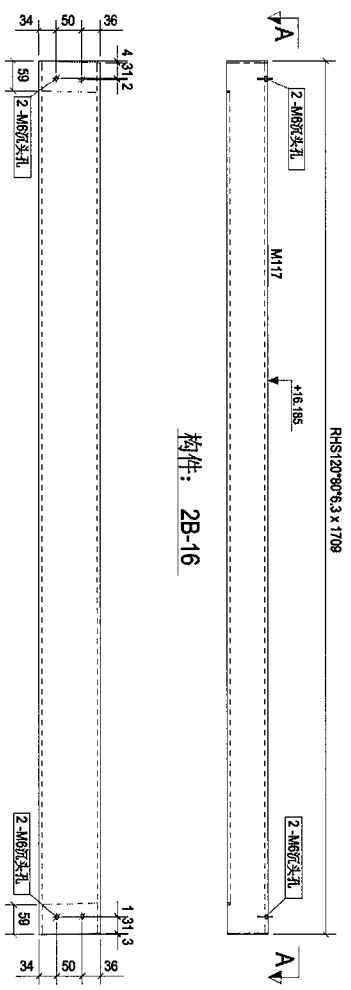

构件: 2B-16

A - A

Rev.	Description	Date
0	第一次报批	2018-05-30

PROJECT: PROPOSED SITE C1
DEVELOPMENT AT AREA 88,
TKOIL TO RP, TSEUNG KWAN O,
NEW TERRITORIES

CLIENT: 基特鋁質有限公司
MTDI Aluminium Fabricator Ltd.
Units 5-8, Sunny Industrial Centre, 1/F
610 Cho Koo Ling Road, Kowloon
Tel: (852) 27727866 Fax: (852) 27727866

S 银同有限公司
Silver Town Limited
Tel: (852) 41334888 Fax: (852) 41335554
E-MAIL: ADDRESS@SILVERTOWN.COM

DRAWING TITLE: WINDOW-WALL (MM4)
[2B-16]

Designated by	Drawn by	Reviewed by	Approved by	Scale


CAD File Name :

DWG NO.: J-836-MW4-[2B-16]

REV. 0


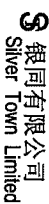
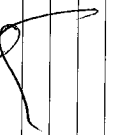
1/2

零件编号:	2B-17	零件数量:	7	零件重量:	31.1
零件编号:	规格(mm)	长度(mm)	数量	单重(kg)	共重(kg)
M118	RHS120*90*6.3	1710	1	31.01	0.66
				合计:	31.01

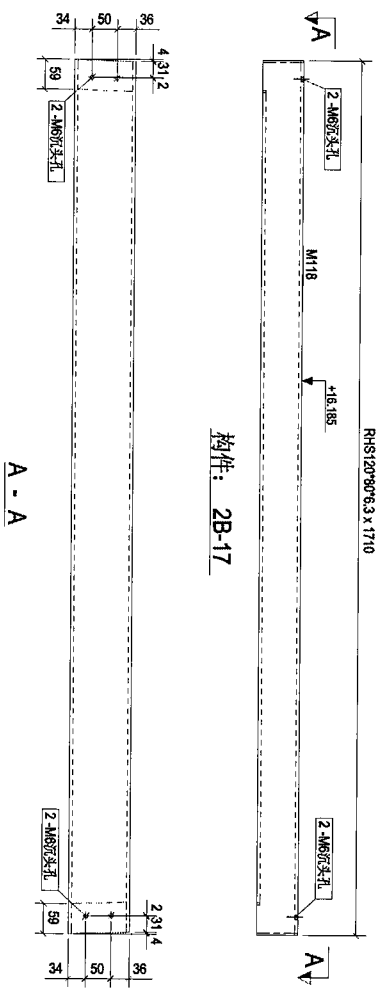


构件: 2B-17

A - A

Rev:	0	第一次提批	2018-05-30
Project:	PROPOSED SITE C1 DEVELOPMENT AT AREA 08, TKOIT 70/RP TSEUNG KWAN O, NEW TERRITORIES		
Client:	 華特鋁質有限公司 MIDI Aluminium Fabrication Ltd. Unit 6-8, Sunng Industrial Centre 1/F, 510 Chee Kwo Ling Road, Kowloon Tel: (2348)2111-4 Fax: (852)72725665		
Drawing Title:	 銀同有限公司 Silver Town Limited Tel: (852) 3335968 Fax: (852) 4135524 E-mail: ADDRESS@silvertown.com.hk, 151.COM		
CAD File Name:	WINDOW-WALL (WMA4) [2B-17]		
Designed by:			
Drawn by:			
Reviewed by:			
Approved by:			
Scale:			
DWG NO.:	J58G-WMA4-[2B-17]	REV:	0

零件编号	规格(mm)	长度(mm)	数量	重量(kg)	共重(kg)	表面积(m ²)
M119	RHS120*90*6.3	1758	1	32	31.91	0.88
合计:				31.91		

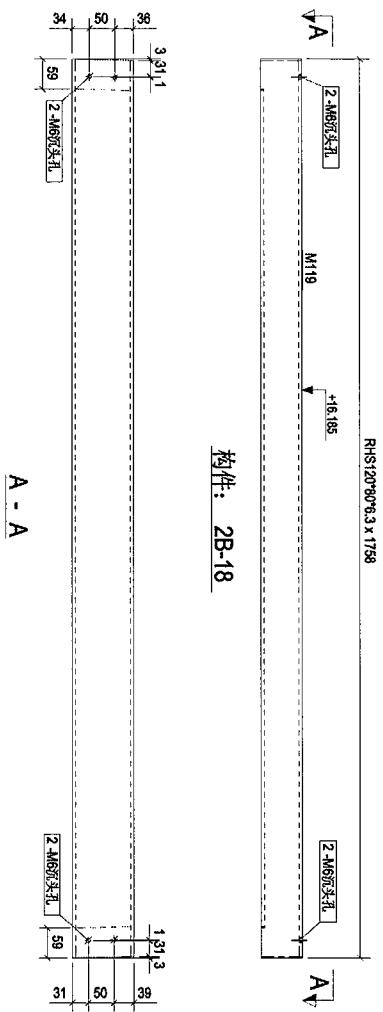

Rev.	Description	Date
0	第一次报批	2018-05-30

PROJECT: PROPOSED SITE C1
DEVELOPMENT AT AREA 86,
TKOIL 70 RP, TSEUNG KWAN O,
NEW TERRITORIES

CLIENT: 美特銀寶有限公司
MIDI Aluminium Fabrication s.m.
Units 6-8, Sunny Industrial Centre, 1/F
610 Cho Kuo Ling Road, Kowloon
Tel: 23989211-4 Fax: (852) 27229585


Silver Town Limited
Tel: 0789 4339488 Fax: 0789 4315954
E-MAIL: ADDRESS@silvertown.hk.TCOM

DRAWING TITLE: WINDOW-WALL (MMA)
[2B-18]

CA3D File Name :	
Designed by	
Drawn by	
Reviewed by	
Approved by	
Scale	
DWG NO.: J-836-WM4-[2B-18]	REV. 0

18

构件编号	2B-19	构件数量	2	构件重量	30.7
零件编号	规格(mm)	长度(mm)	宽度	厚度(mm)	重量(kg)
M120	RHS120*80*6.3	1895	1	30	30.43
合计					30.43

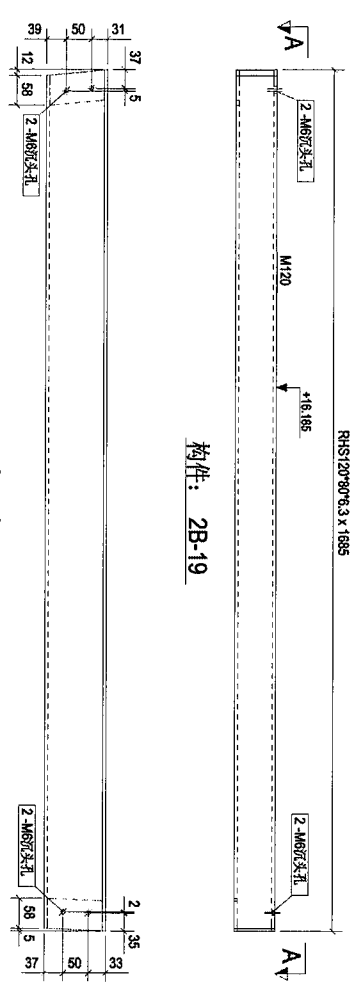

Rev.	Description	Date
0	第一次报批	2018-05-30

PROJECT: PROPOSED SITE C1
DEVELOPMENT AT LARSA 66,
TKO11 TO RP, TSEDOK/KYAW/O,
NEW TERRITORIES

CLIENT: 美特铝业有限公司
MIDI Aluminium Products Ltd.
Units 6-8, Simey Industrial Centre, V/F
510 Cho Kwo Ling Road, Kowloon
Tel: (852) 27777666 Fax: (852) 27777666


Silver Town Limited
Tel: (852) 4132468 Fax: (852) 4132554
E-MAIL: ADDRESS@silvertown.com.hk

[2B-19]

CAD File Name:	
Designed by	
Drawn by	
Reviewed by	
Approved by	
Scale	
DWG NO.: J486-MW4-[2B-19]	REV: 0

19

零件编号	2B-20	数量	2	构件数量	30.6
零件编号	规格(mm)	长度(mm)	数量	单重(kg)	总重(kg)
M121	RHS120*80*6.3	1690	1	30.29	0.65
合计					30.29

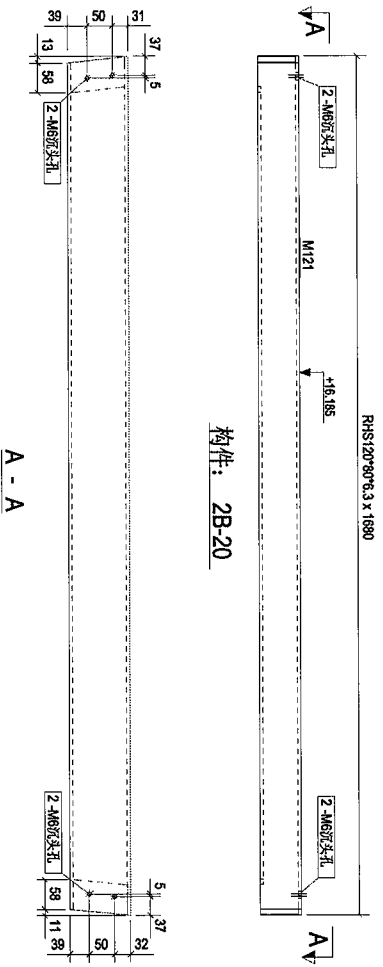

Rev.	Description	Date
0	第一次报批	2018-05-30

PROJECT: PROPOSED SITE C1
DEVELOPMENT AT AREA 86,
TKOIL 70 HP, TSEUNG KWAN O,
NEW TERRITORIES

CLIENT: 美特銀寶有限公司
MIDI AQUINUM PARTNERCO LTD
Units 5-8, Sunny Industrial Centre, 1/F
610 Sha Kuo Tung Road, Kowloon
Tel: (852) 27212056


銀同有限公司
Silver Town Limited
Tel: 0769-8338488 Fax: 0769-8339554
E-MAIL: ADDRESS@silvertown.hk TEL: 004

DRAWING TITLE: WINDOW-WALL (MW4)
[2B-20]

Designed by	
Drawn by	
Reviewed by	
Approved by	
Scale	
DWG NO.: J4836-MW4-[2B-20]	REV: 0

20

零件编号	规格(mm)	数量	长度(mm)	重量	表面积(m ²)	表面处理
M122	RHS120*90*6.3	1	1890	30.30	0.65	
合计:		30.30				

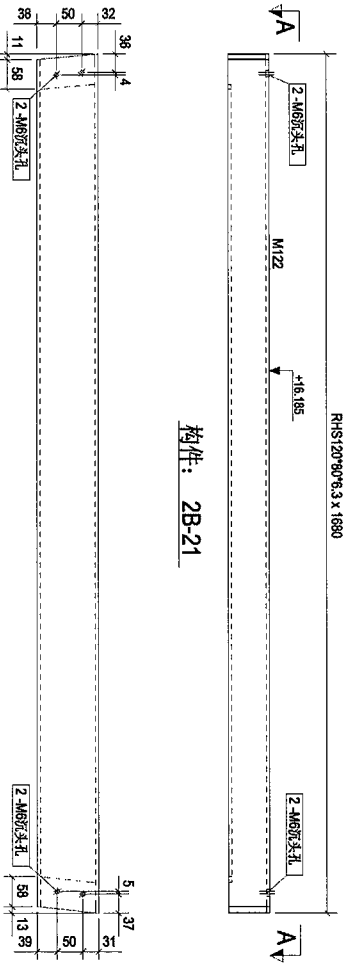

Rev.	Description	Date
0	第一次报批	2018-05-30

PROJECT: PROPOSED SITE C1
DEVELOPMENT AT AREA 86,
TKO1, TO RP, TSEUNG KWAN O,
NEW TERRITORIES


CLIENT: 美特铝业有限公司
MTDI Aluminium Fabricator Ltd.
Units 5-6, Sunny Industrial Centre, 1/F,
610 Chee Kwo Ling Road, Kamshan
Tel: 23989211-4 Fax: (852) 27272966

银同有限公司
Silver Town Limited
Tel: 3769-8155/8488 Fax: 3769-8155/5954
E-MAIL: ADDRESS@SILVERTOWN.COM

DRAWING TITLE: WINDOW WALL (RM4)
[2B-21]

CAO File Name:	
Designed by	
Drawn by	
Reviewed by	
Approved by	
Scale	
DWG NO: J-836-YM4- [2B-21]	REV: 0

零件编号	2B-22	零件数量	2	零件重量	30.7
零件编号	规格(mm)	长度(mm)	数量	重量(g)	表面积(m ²)
M123	RHS120°80°6.3	1896	1	30.49	0.55
合计:				30.49	

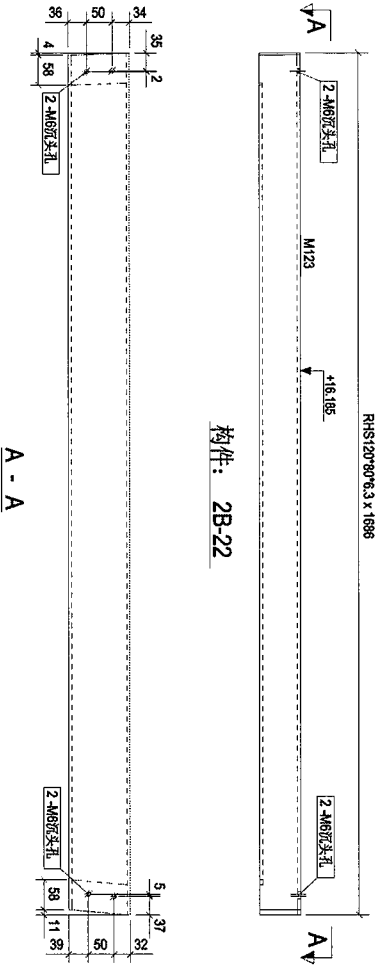

Rev.	Description	Date
0	第一次报批	2018-05-30

PROJECT:
 PROPOSED SITE C1
 DEVELOPMENT AT AREA 86,
 TKOIL TO RP, TSEUNG KWAN O,
 NEW TERRITORIES

CLIENT:
美特铝质有限公司
 MTDI Aluminium Fabricator Ltd.
 Unit 5-8, Sunny Industrial Centre, 1/F
 610 Che Kwo Ling Road, Kowloon
 Tel: 23892111-4 Fax: (852) 2727266


银同有限公司
 Silver Town Limited
 Tel: 2709-8338/468 Fax: 2709-8338/554
 E-Mail: ADP@SSTK.com.hk, I@SCTO.com

DRAWING TITLE:
 WINDOW WALL (RM4)
[2B-22]

CAD File Name :	
Designed by	
Drawn by	
Reviewed by	
Approved by	
Scale	
DWG NO. : J-836-MW4- [2B-22]	REV. 0

22

附件编号	2B-23	附件数量	13	附件重量	30.8
附件编号	规格(mm)	长度(mm)	数量	单重(kg)	总重(kg)
M124	RHS120*80*6.3	1694	1	30.73	0.65
合计:				30.73	

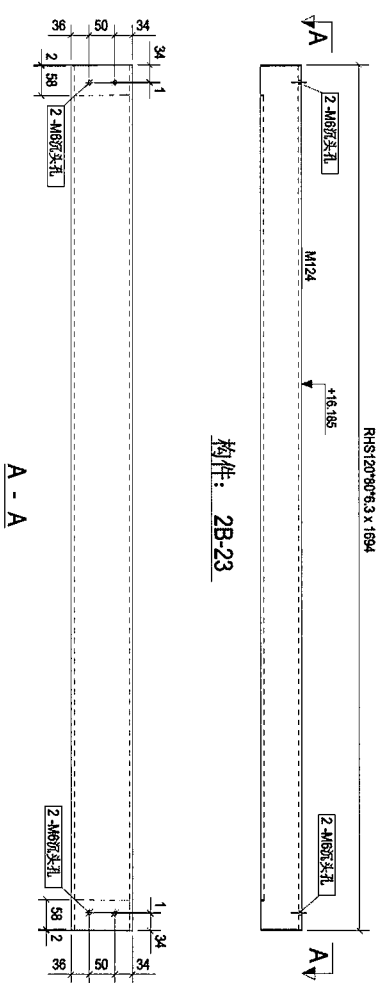

构件: 2B-23

A - A

Rev.	Description	Date
0	第一次报批	2018-05-30

PROJECT:
 PROPOSED SITE C1
 DEVELOPMENT AT AREA 86,
 TKO1, 70/F, TSEUNG KWAN O,
 NEW TERRITORIES

CLIENT:
英特经贸有限公司
 MID1 Architecture Limited
 Units 6-8, Sunray Industrial Centre, 1/F
 610 Chee Kwo Ling Road, Kowloon
 Tel: 23492711-4 Fax: (852) 27275865


银同有限公司
 Silver Town Limited
 Tel: 0769-83356668 Fax: 0769-83359554
 E-MAIL: ADDRESS@SILVERTOWN.LK3.COM

DRAWING TITLE:
 WINDOW-MALL (MM4)
[2B-23]

Designed by	
Drawn by	
Reviewed by	
Approved by	
Scale	
DWG NO.: J-896-WM4- [2B-23]	
REV.	0

23

构件编号	2B-24	构件数量	2	构件重量	30.8
构件编号	规格(mm)	长度(mm)	数量	重量(kg)	重量(kg)
M125	RHS120*80*6.3	1893	1	30.70	0.65
合计				30.70	

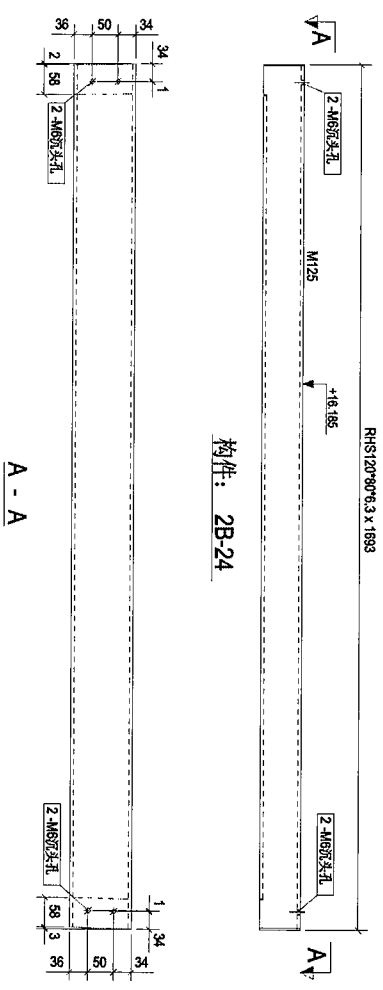

Rev.	Description	Date
0	第一次报批	2016-05-30

PROJECT: PROPOSED SITE DEVELOPMENT AT A/CEN 88, TKO1 TOWER, TSEUNG KWAN O, NEW TERRITORIES

CLIENT: 華特鋁質有限公司
MIDI Aluminium Products Ltd.
Units 6-8, Sunny Industrial Centre, 1/F
610 Che Kwo Ling Road, Kowloon
Tel: (852) 24192111-4 Fax: (852) 27272666


Silver Town Limited
Tel: (852) 24192111 Fax: (852) 27272666
E-MAIL: a09r353@silvertown.hk

DRAWING TITLE: WINDOW WALL (MM4)
[2B-24]

CAD File Name :	
Designed by	
Drawn by	
Reviewed by	
Approved by	
Scale	
DWG NO. : J-BS-MW4-[2B-24]	
REV.	0

24

零件编号	2B-25	零件数量	1	零件重量	6.1
零件编号	规格(mm)	长度(mm)	数量	重量(g)	重量(kg)
M128	RHS120*80*6.3	334	1	5.52	0.13
合计				5.52	

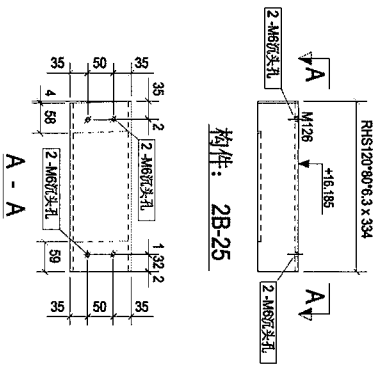

构件: 2B-25

A - A

Rev.	Description	Date
0	第一次报批	2018-05-30

PROJECT: PROPOSED SITE C1 DEVELOPMENT AT AREA B5, TKOIT TO RP TSEUNG KWAN O, NEW TERRITORIES


CLIENT: 慕特鋸質有限公司
 MID1 ACADEMY MANUFACTURE LTD.
 Units 5-8, Sunny Industrial Centre, Y/F
 610 Chee Kwo Ling Road, Kowloon
 Tel: 23489211-4 Fax: (852) 27271566

DRAWING TITLE: WINDOW-WALL (MM4) [2B-25]


Designed by	
Drawn by	
Reviewed by	
Approved by	
Scale	
DWG NO.: J-836-MM4-[2B-25]	REV: 0

25

零件编号	规格(mm)	数量	牛厘(吋)	表面錫(吋)	30.8
M86	RHS120°90°6.3	1	30.57	0.65	
		合计:	30.57		

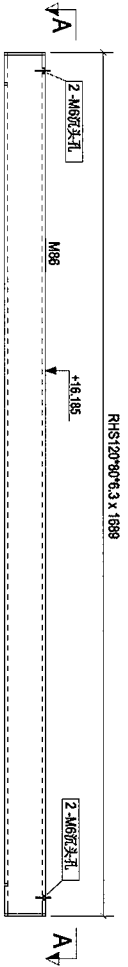

构件: 2B-26

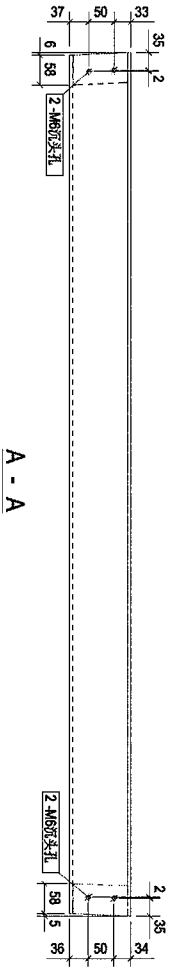

A - A

Rev.	Description	Date
0	第一次报批	2018-05-30

PROJECT: PROPOSED SITE C1
DEVELOPMENT AT AREA 86,
TKOIT TO RP, TSEUNG KWAN O,
NEW TERRITORIES


CLIENT: 美特鋁質有限公司
MIDI ALUMINIUM FABRICATOR LTD.
Units 6-8, Sunny Industrial Centre, 1/F
610 Cho Kuo Ling Road, Kwai Tsou
Tel: 2498211-4 Fax: (852) 27272866

銀同有限公司
Silver Town Limited
Tel: 0753-8135498 Fax: 0753-8135954
E-MAIL: ADDRESS@silvertown.com

DRAWING TITLE: WINDOW WALL (MM4)
[2B-26]

CAO File Name:	
Designed by	
Drawn by	
Reviewed by	
Approved by	
Scale	
DWG NO: J-836-MW4-[2B-26]	REV: 0

零件编号	规格(mm)	数量	重量(kg)	表面积(m ²)
M75	RHS150*100*12.5	1	174.42	1.85
合计:		1	174.42	

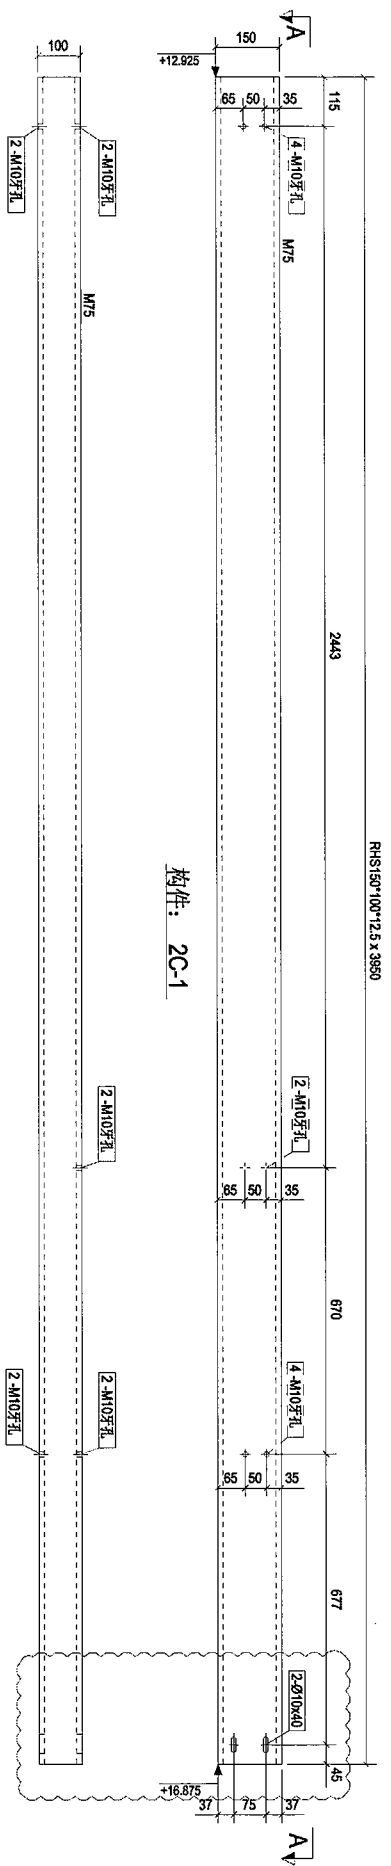

Rev.	Description	Date
A	第一次提批	2018-05-06

PROJECT: PROPOSED SITE C1
DEVELOPMENT AT AREA 88,
TKOIL TO RP, TSEUNG KWAN O,
NEW TERRITORIES

CLIENT: 華特銀質有限公司
MTDI Architecture Limited
Units 5-8, Sunny Industrial Centre, 1/F
610 Che Kwo Ling Road, Kowloon
Tel: (852) 9921-1-4 Fax: (852) 27225986

Silver Town Limited
Tel: (876) 4334488 Fax: (876) 4335554
E-MAIL: ADDRESS@SILVERTOWN.EDU.COM

DRAWING TITLE: WINDOW WALL (MMW)
[2C-1]


CAD File Name :

Scale	Approved by	Reviewed by	Drawn by	Designed by

DWG NO.: J835-MMW-[2C-1]

27

零件编号:	2C-2	零件数量:	5	零件重量:	189.3
零件编号:	规格(mm)	长度(mm)	数量	重量(g)	重量(kg)
M76	RHS150*100*12.5	3850	1	174.42	1.85
				174.42	
			合计	174.42	

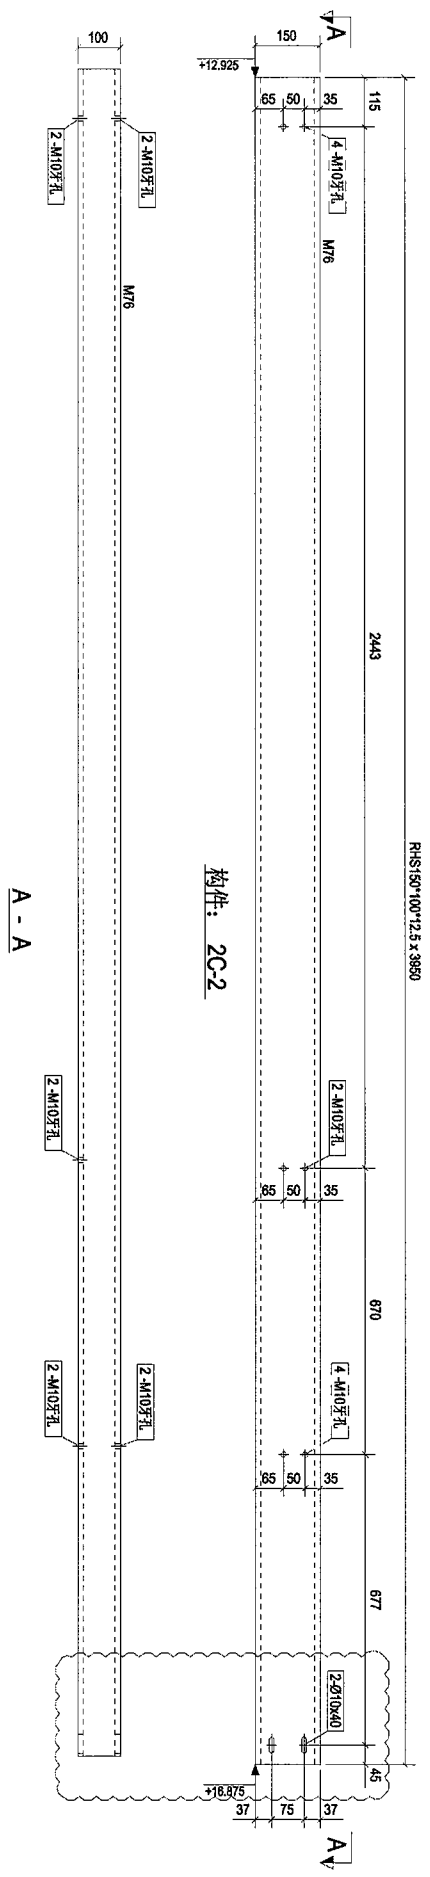

A	第2次报批	2018-06-06
Rev.	Description	Date

PROJECT: PROPOSED SITE C1
DEVELOPMENT AT AREA B6,
TKO1, TO RP, TSEUNG KWAN O,
NEW TERRORIES

CLIENT: 基特铝业有限公司
MIDI Aluminium Fabrication Ltd.
Units 6-R, Sunny Industrial Centre, V/F
610 Chee Kwo Ling Road, Kowloon
Tel: (852) 4892711-4 Fax: (852) 27272866


Silver Town Limited
Tel: (852) 43334888 Fax: (852) 43335554
E-MAIL: ADP@SILVERTOWN.COM

DRAWING TITLE: WINDOW-WALL (MM14)

CAO File Name:	
Designed by	
Drawn by	
Reviewed by	
Approved by	
Scale	

28

零件编号	2C-4	零件数量	3	零件重量	183.3
零件编号	规格(mm)	长度(mm)	数量	重量(g)	重量(kg)
M78	RHS150*100*12.5	3950	1	174.42	1.85
合计				174.42	

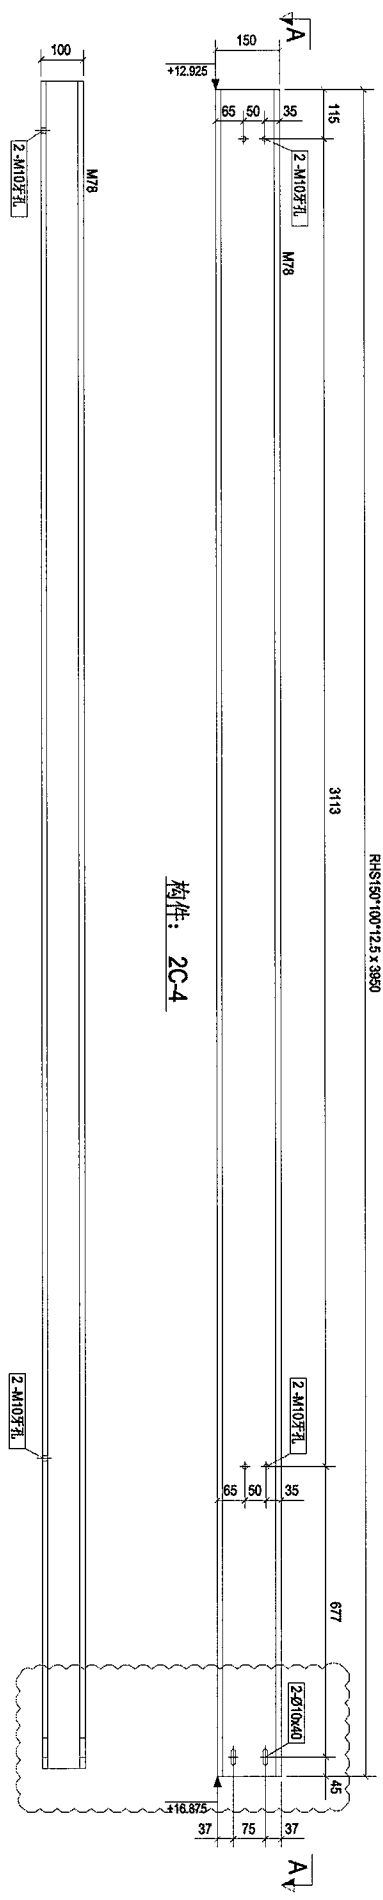

Rev.	Description	Date
A	第一次提批	2019-05-06

PROJECT: PROPOSED SITE C1
DEVELOPMENT AT AREA B5,
TKOIL TO RP, TSEUNG KWAN O,
NEW TERRORIES

CLIENT: 德特鋸質有限公司
MTDI AUTOMATED FABRICATOR LTD.
Units 5-8, Sunway Industrial Centre, 1/F
610 Chee Kwo Ling Road, Kowloon
Tel: (852) 989211-4 Fax: (852) 27215565


S 銀同有限公司
Silver Town Limited
Tel: (86) 43354988 Fax: (87) 59-83355554
E-MAIL: ADVERTISING@SILVERTOWN.COM

DRAWING TITLE: WINDOW-WALL (MM4)
[2C-4]

CDJ File Name :	
Designed by	
Drawn by	
Reviewed by	
Approved by	
Scale	
DWG NO.:	J485-MW4-[2C-4]
REV:	A

35

构件编号:	2C-5	构件数量:	3	构件重量:	169.3
零件编号	规格(mm)	长度(mm)	数量	重量(kg)	表面积(m ²)
M79	RHS150*100*12.5	3950	1	174.42	1.85
合计:				174.42	

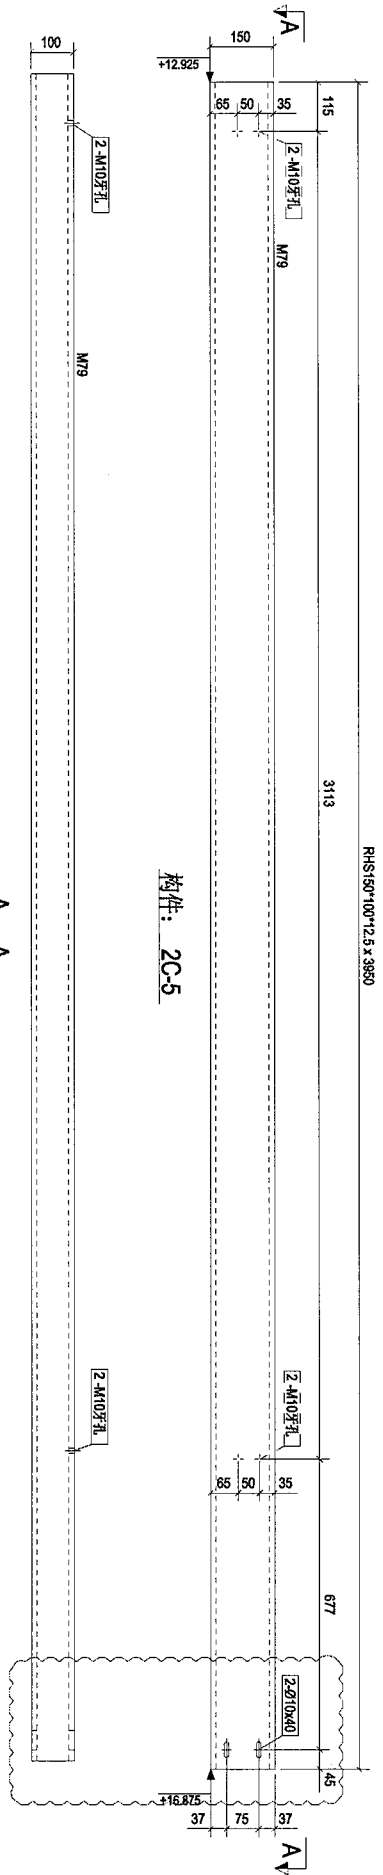

Rev.	Description	Date
A	第2次报数	2018-06-06

PROJECT: PROPOSED SITE C1 DEVELOPMENT AT AREA 66, TKOIT TO RP, TSEUNG KWAN O, NEW TERRITORIES

CLIENT: 美特铝有限公司
MIDI Aluminium Fabricator Ltd.
Units 6-8, Sunny Industrial Centre, 1/F
510 Cho Kwo Ling Road, Kwai Tsan
Tel: (23)692111-4 Fax: (852)77272866


Silver Town Limited
Tel: 07788-8135488 Fax: 07788-8135554
E-MAIL: ADDRESS@SILVERTOWN.LTD.COM

DRAWING TITLE: WINDOW WALL (RMW4)
[2C-5]

Designed by	
Drawn by	
Reviewed by	
Approved by	
Scale	
DWG NO.: J486-WW4-[2C-5]	REV: A

31

零件号	2C-6	零件数量	37	零件重量	189.3
零件编号	规格(mm)	长度(mm)	数量	重量(g)	表面积(mm ²)
M81	RHS150*100*12.5	3950	1	174.42	1.85
合计:				174.42	

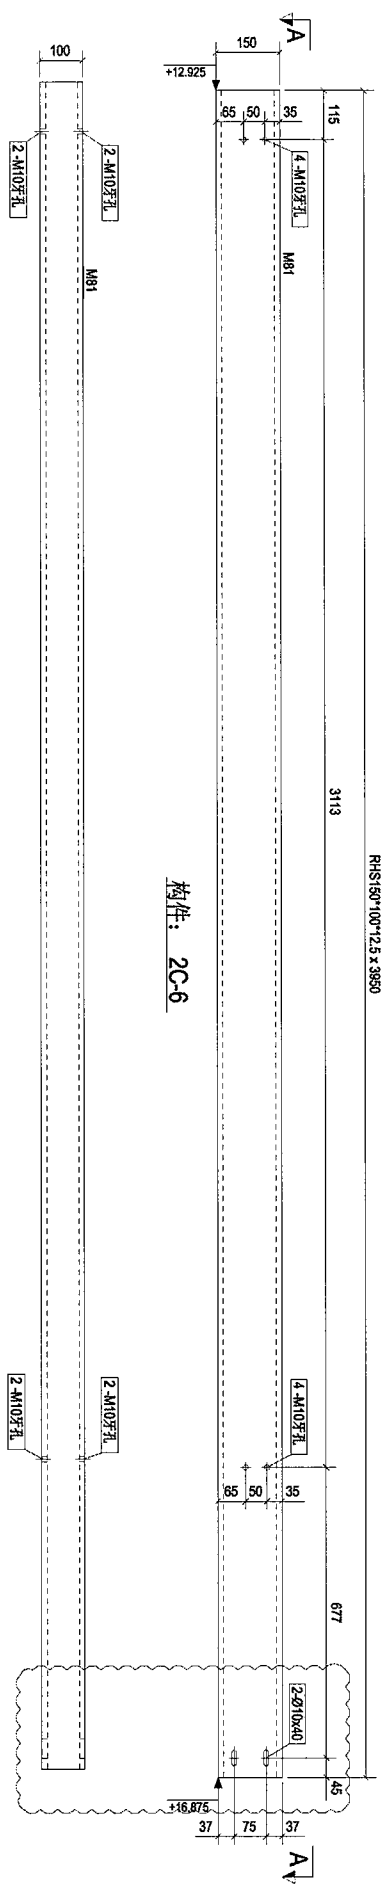

Rev.	Description	Date
A	第一次模数	2018-06-06

PROJECT: PROPOSED SITE C1
DEVELOPMENT AT AREA 88,
TKOIL 70/RP TSEUNG KWAN O,
NEW TERRITORIES

CLIENT: 美特鋁質有限公司
MIDI Aluminium Fabricator Ltd.
Units 5-8, Sanyo Industrial Centre, 1/F
610 Chee Kwo Ling Road, Kowloon
Tel: 23489211-4 Fax: (852) 27725566



银同有限公司
Silver Town Limited
Tel: 086-8338498 Fax: 0759-8339934
E-MAIL: ADDRESS@silvertown.com

DRAWING TITLE: WINDOW-MALL (MM4)
[2C-6]

Drawn by	Designed by	Checked by	Scale
Reviewed by	Approved by		
DWG NO.: J4836-WW4- [2C-6]			
REV:	A		

32

零件编号	2C-8	零件数量	1	零件重量	169.3
零件编号	规格(mm)	长度(mm)	数量	重量(g)	表面积(m ²)
M85	RHS150*100*12.5	3950	1	92.38	1.85
合计				92.38	

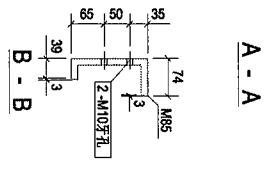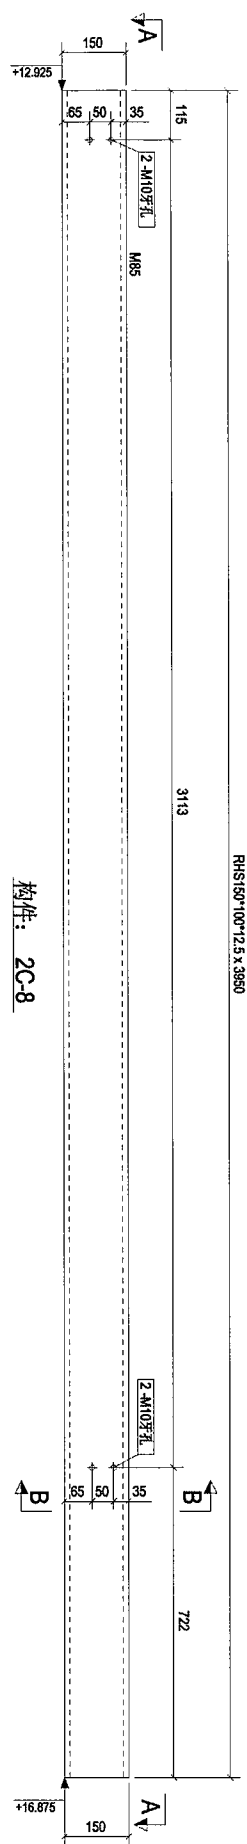

Rev.	Description	Date
0	第一次报批	2018-05-30

PROJECT: PROPOSED SITE C1
DEVELOPMENT AT AREA K6,
TKOIL 70/RP TSEUNG KWAN O,
NEW TERRITORIES

CLIENT: 美特鋁質有限公司
MIDI Aluminium Manufacturer Ltd.
Units 6-9, Sunry Industrial Centre, 1/F
510 Chee Kwo Ling Road, Kowloon
Tel: 23489211-4 Fax: (852) 27721565


S 银同有限公司
Silver Town Limited
Tel: 0759-8338498 Fax: 0759-8335554
E-MAIL: ADDRESS@silvertown.hk ISL.COM

DRAWING TITLE: WINDOW-HALL (MM14)
[2C-8]

Designed by	
Drawn by	
Reviewed by	
Approved by	
Scale	
DWG NO.: J-836-WW4- [2C-8]	
REV:	0

34

附件编号	2C-10	附件数量	1	附件重量	34.1
附件编号	规格(mm)	长度(mm)	数量	重量(kg)	重量(kg)
M135	PLS220.1	3950	1	34.12	1.78
合计:				34.12	

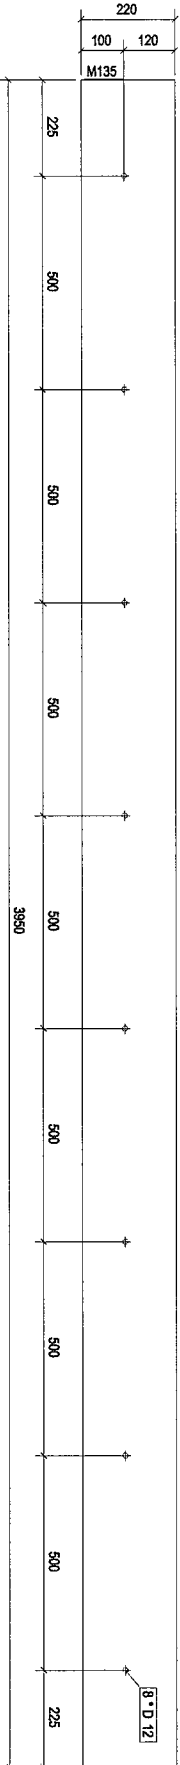

构件: 2C-10

Rev.	Description	Date
0	第一次报批	2018-05-30

PROJECT:
PROPOSED SITE C1
DEVELOPMENT AT AREA N5,
TKO1, 70 P2 TSEUNG KWAN O,
NEW TERRITORIES

CLIENT:

基特經貿有限公司
MIDI Architecture Ltd.
Units 6-8, Sunny Industrial Centre, 1/F
510 Che Kwo Ling Road, Kowloon
Tel: (852) 9921-1-4 Fax: (852) 7725865

銀同有限公司
Silver Town Limited
Tel: (852) 4334668 Fax: (852) 4339994
E-MAIL: ADDRESS@SILVERTOWN.LTD.COM

DRAWING TITLE :

WINDOW-FRAME (MM4)
[2C-10]

CAD File Name :

Designed by

Drawn by

Reviewed by

Approved by

Scale



DWG NO.: J886-WM4-[2C-10]

REV.

0

27

零件号	2JM-1	108	1.5
零件数量	长度(mm)	数量	重量(kg)
F31	PT440	40	0.00
M136	RSA100756	180	0.07
合计			1.53

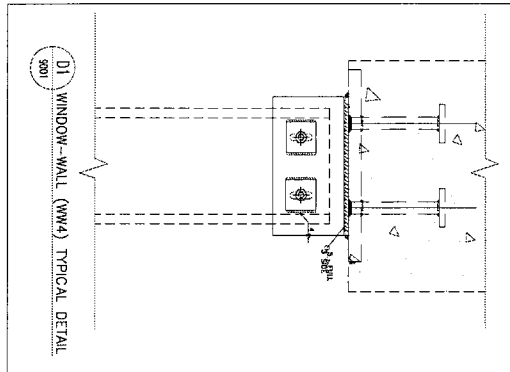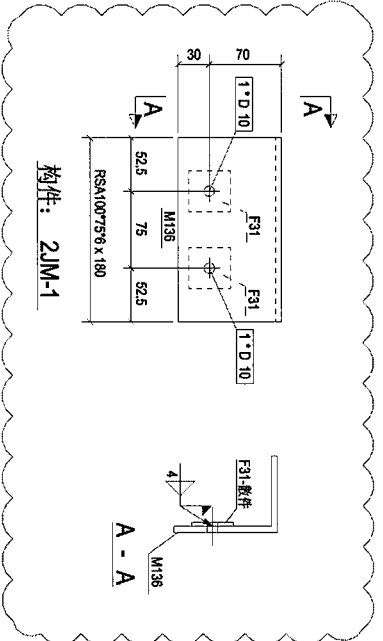

Rev.	Description	Date
A	第2次提批	2018-06-06

PROJECT: PROPOSED SITE C1
DEVELOPMENT AT AREA 86,
TKOIL TO RP, TSEUNG KWAN O,
NEW TERRITORIES

CLIENT: 義特銀質有限公司
MTDI Aluminium Fabricator Ltd.
Units 5-8, Sunny Industrial Centre, 1/F
610 Cho Kwo Ling Road, Kowloon
Tel: 23449211-4 Fax: (852) 2722586



Silver Town Limited
Tel: 0768-833688 Fax: 0768-8335954
E-MAIL: ADDRESS@SILVERTOWN.COM

DRAWING TITLE: WINDOW-WALL (WM4)
[2JM-1]

CAD File Name :	
Designed by	
Drawn by	
Reviewed by	
Approved by	
Scale	
DWG NO.:	J-835-WW4-[2JM-1]
REV.	A

36

附件编号	规格(mm)	数量	单位	共重(kg)	表面积(m ²)
M74	RS3A50*50*5	0		0.37	0.02
		1			
合计				0.37	

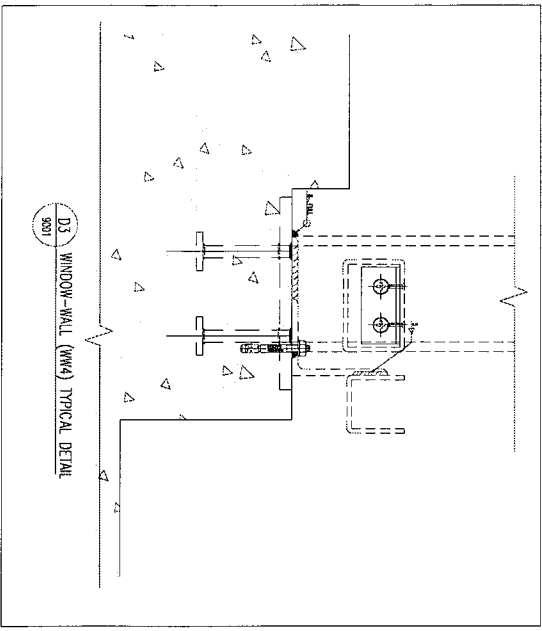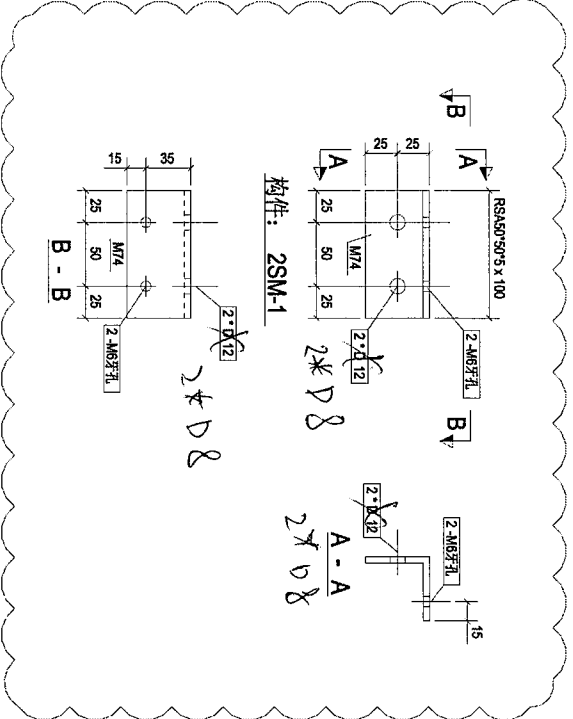

Rev.	Description	Date
A	第2次报批	2018-06-06

PROJECT: PROPOSED SITE C1
DEVELOPMENT AT AREA 86,
TKOIT TO RP, TSEUNG KWAN O,
NEW TERRITORIES

CLIENT: 美特鋁有限公司
MIDI Aluminium Fabricator Ltd.
Units 6-8, Sunny Industrial Centre, 1/F
510 Cho Kwo Ling Road, Kwai Tsien
Tel: 23892111-4 Fax: (852) 27227856


銀同有限公司
Silver Town Limited
Tel: 3783-8336/888 Fax: 3783-8335/554
E-MAIL: ADDRESS@silvertown.com

DRAWING TITLE: WINDOW-WALL (WM4)
[2SM-11]



Designed by	
Drawn by	
Reviewed by	
Approved by	
Scale	
DWG NO.: J-836-WM4-[2SM-11]	
REV.	A

27

零件编号	规格(mm)	长度(mm)	数量	单重(g)	共重(g)	表面积(㎡)
M141	RSA50*50*5	90	1	0.34	0.34	0.02
合计:					0.34	

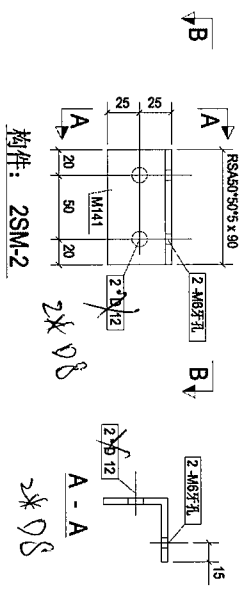

说明: 急转弯处角码, 为了避开与横梁相撞, 故两头缩短了5个。

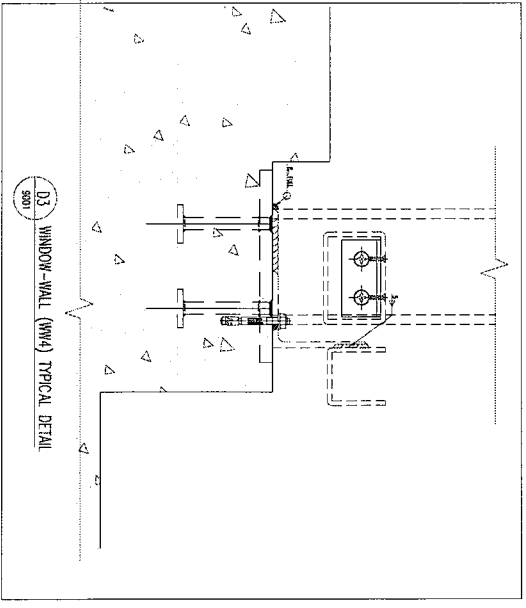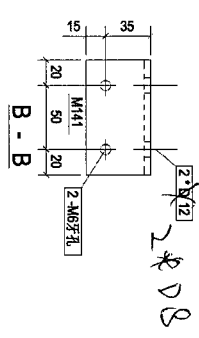

Rev.	Description	Date
A	第2次报批	2018-06-06

PROJECT: PROPOSED SITE C1 DEVELOPMENT AT AREA 06, TKO1, TO P' TSEUNG KWAN O, NEW TERRITORIES

CLIENT: 基特經貿有限公司
MIDI AUMUNION ZHUANGCHONG LTD.
Units 6-8, Sunny Industrial Centre, 1/F, 610 Che Kwo Ling Road, Kowloon
Tel: 23469211-4, Fax: (852) 27272885


銀同有限公司
Silver Town Limited
Tel: 0769-8335968 Fax: 0769-4339954
E-MAIL: ADMIN@SILVERTOWN.COM.HK

DRAWING TITLE: WINDOW-WALL (WNW4) [2SM-2]

CAD File Name:	
Designed by:	
Drawn by:	
Reviewed by:	
Approved by:	
Scale:	
DWG NO.:	J-836-WN4- [2SM-2]
REV.	A

38


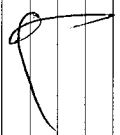
物料编号	2U-1	物料数量	43	物料重量	25.2
零件编号	料号(mm)	长度(mm)	宽度(mm)	重量(KG)	面积(平方)
M137	RSC75X75x6	1795	18	17.91	0.78
M140	RS4100*75*8	230	3	7.24	0.08
		合计:	25.14		

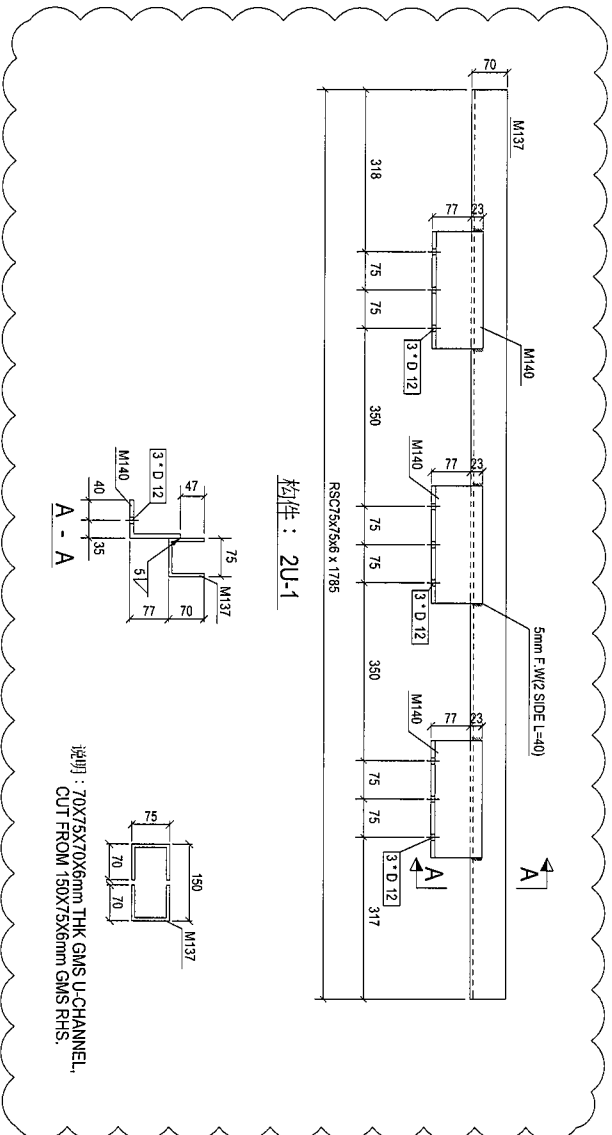


构件：2U-1

说明: 70X75X70X6mm THK GMS U-CHANNEL,
CUT FROM 150X75X6mm GMS RHS.


29

图号	A	第2次报批	2018-06-06
名称	PROPOSED SITE C1 DEVELOPMENT AT AREA 88, TKOTL 70 RP, TSEUNG KWAN O, NEW TERRITORIES		
设计/制图	WINDOM WALL (MM4) [2U-11]		
审核/批准			
DWG NO.	J-338-WM4-	[2U-11]	A

零件编号	213	零件数量	1	零件重量	2.4
零件编号	规格(mm)	长度(mm)	数量	单重(kg)	总重(kg)
M140	RSA100759	230	1	2.41	2.41
			2	2.41	0.08
			合计	2.41	

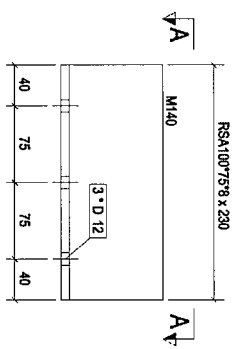

构件: 2U-3

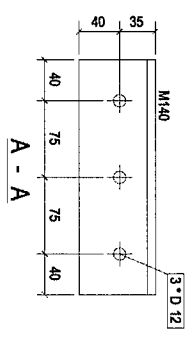

Rev.	Description	Date
0	第一次报批	2018.05.30

PROJECT:
**PROPOSED SITE C1
 DEVELOPMENT AT AREA 88,
 TKO1, TO RP, TSEUNG KWAN O,
 NEW TERRITORIES**

CLIENT:
美特铝有限公司
MIDI Aluminium Fabricator Ltd.
 Unit 6-9, Sunny Industrial Centre, 1/F
 610 Cho Kwo Ling Road, Kowloon
 Tel: (852) 27727805 Fax: (852) 27727805


银同有限公司
Silver Town Limited
 Tel: (755) 83354888 Fax: (755) 83355554
 E-MAIL: 40835353@silvertown.com.cn

DRAWING TITLE :
WINDOW WALL (MM4)
[2U-3]

CAD File Name :	
Designed by	
Drawn by	
Reviewed by	
Approved by	
Scale	
DWG NO.: J438-WW4-[2U-3]	REV: 0

41

物料编号	3B-1	物料数量	12	材料重量	30.9
物料描述	规格(mm)	长度(mm)	数量	重量(kg)	体积(m³)
M83	RHS120*80*6.3	1694	1	30.75	0.65
合计:				30.75	

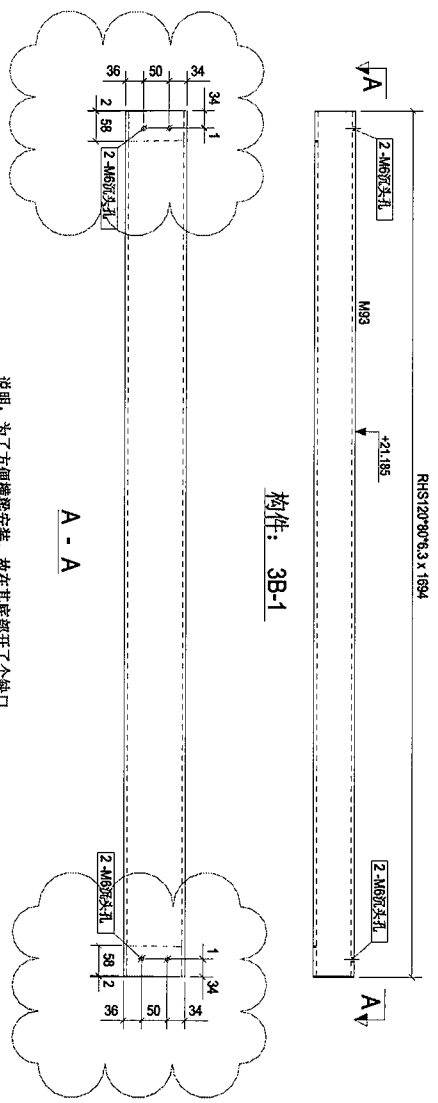

说明: 为了方便横梁安装, 故在其底部开了个缺口。

Rev	Description	Date
0	第一次报批	2018-05-30

PROJECT: PROPOSED SITE C1
DEVELOPMENT AT AREA 88,
TKO TOWER TSEUNG KWAN O,
NEW TERRITORIES

CLIENT: 華特經貿有限公司
MIDI Aluminium Windows Ltd.
Unit 6-8, Sunny Industrial Centre, 1/F
610 Chin Kwo Ling Road, Kowloon
Tel: 23489211-4 Fax: (852) 27272665


Silver Town Limited
1460769-4335468 Fax: 0759-433554
E-MAIL: M025535@silvertown.hk

DRAWING TITLE : WINDOW-WALL (MM4)
[3B-1]

CAD File Name :	
Designed by	
Drawn by	
Reviewed by	
Approved by	
Scale	
DWG NO. : J836-MW4 [3B-1]	REV: 0

42

料件编号	规格(mm)	料件数量	料件重量
M94	RHS120*80*6.3	1	30.80
合计:		1	30.80

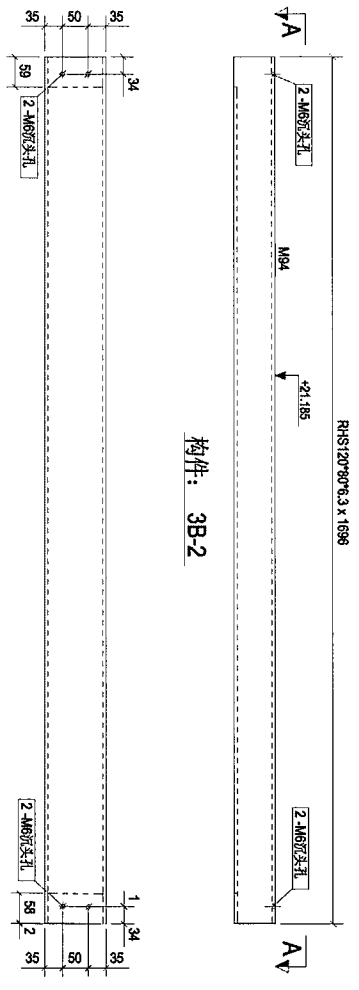

Rev.	Description	Date
0	第一次报批	2018-05-30

PROJECT:
 PROPOSED SITE C1
 DEVELOPMENT AT AREA 86
 TKOIT TO RP TSEUNG KWAN O,
 NEW TERRITORIES

CLIENT:
美特鋁質有限公司
 MID1 Aluminum Fabricator Ltd.
 Units 6-8, Sunny Industrial Centre, 1/F
 610 Cho Kwo Ling Road, Kwai Tsan
 Tseung Kwan O, N.T.
 Tel: 23489211-4 Fax: (852) 27272686

銀同有限公司
 Silver Town Limited
 Tel: 0755-83354681 Fax: 0755-83359554
 E-MAIL: ADDRESS@silvertown.com

DRAWING TITLE:
 WINDOW-WALL (MM4)
[3B-2]

CAD File Name :


Designed by	
Drawn by	
Reviewed by	
Approved by	
Scale	

DWG NO.: J-838-WW4- [3B-2]

REV.	0
------	---

43

零件编号	3B-3	零件数量	2	零件重量	31.1
零件型号	规格(mm)	长度(mm)	数量	单重(g)	重量(g)
M95	RHS120°90°6.3	1707	1	30.97	0.66
合计					30.97

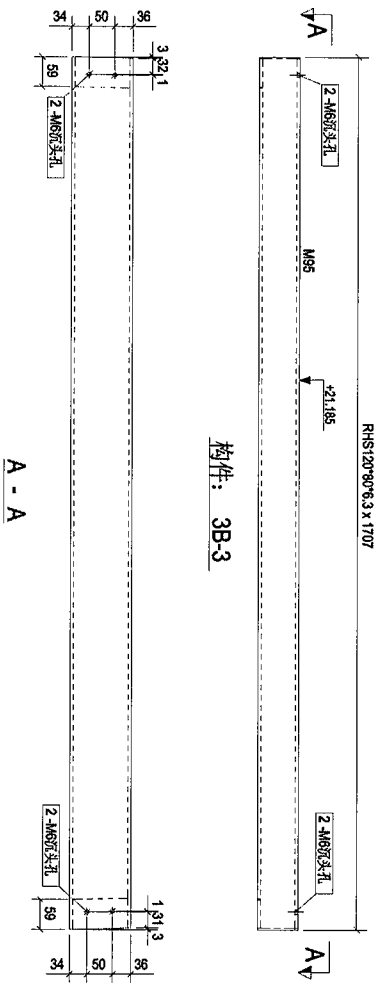

Rev.	Description	Date
0	第一次报批	2018-05-30

PROJECT: PROPOSED SITE C1
DEVELOPMENT AT AREA 86,
TKOIL TO PE TSEUNG KWAN O,
NEW TERRITORIES

CLIENT: 美特鋁業有限公司
MIDI Aluminium Industries Ltd.
Units 5-8, Sunny Industrial Centre, 1/F,
610 Chee Koo Ling Road, Kowloon
Tel: (852) 27727666 Fax: (852) 27727666


Silver Town Limited
Tel: (852) 83354668 Fax: (852) 8335854
E-MAIL: ADDRESS@silvertown.ltd.com

DRAWING TITLE : WINDOW-WALL (MWA4)
[3B-3]

CDJ File Name :	
Designed by	
Drawn by	
Reviewed by	
Approved by	
Scale	
DWG NO.:	J-836-MWA- [3B-3]
	REV 0

44

零件编号	规格(mm)	数量	重量(g)	表面面积
M06	RHS120°90°6.3	1	31.04	0.65
合计:		1	31.04	0.65

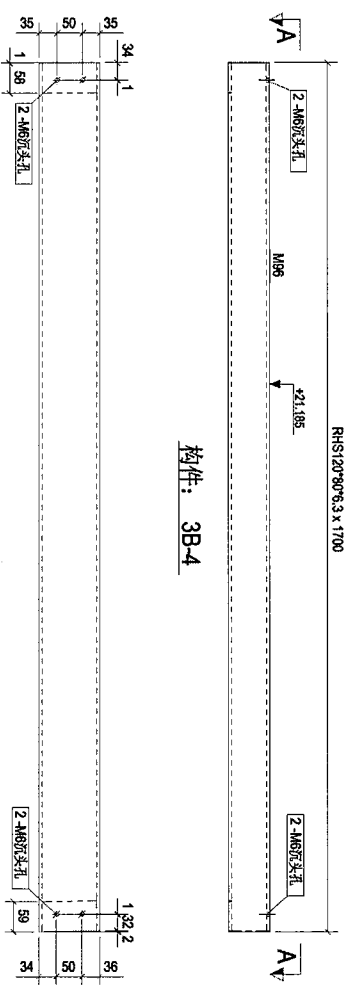

Rev.	Description	Date
0	第一次报批	2018-05-30

PROJECT: PROPOSED SITE C1
DEVELOPMENT AT AREA 86,
TKOIL 70 BP, TSEUNG KWAN O,
NEW TERRITORIES

CLIENT: 美特鋁質有限公司
MIDI Aluminium Fabricator Ltd.
Units 5-8, Sunny Industrial Centre, 1/F
610 Cho Kuo Ling Road, Kowloon
Tel: (852) 27722986


Silver Town Limited
Tel: (852) 43384968 Fax: (852) 43355554
E-MAIL: A03B2554@silvertown.com

DRAWING TITLE: WINDOW-WALL (MMW)
[3B-4]

Scale	Scale
1:1	1:1

45

构件编号:	3B-6	构件数量:	20	构件重量:	30.8
密件编号:	规格(mm)	长度(mm)	数量	重量(kg)	表面积(m ²)
M99	RHS120*90*5.3	1692	1	30.89	0.55
合计:				30.89	

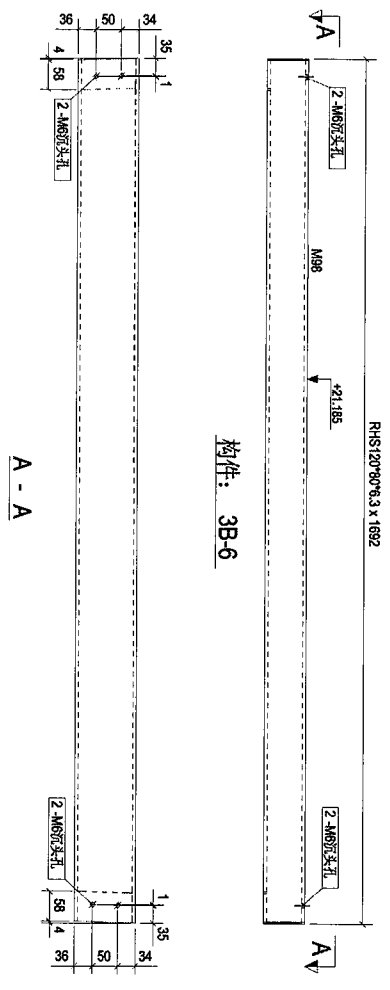

构件: 3B-6

A - A

Rev	Description	Date
0	第一次报批	2018-05-30

PROJECT: PROPOSED SITE C1 DEVELOPMENT AT AGENAS, TQTL 10/P, TSEDING KAWANO, NEW TERRITORIES


CLIENT: 華特經貿有限公司
MIDI (HONGKONG) DEVELOPMENT LTD.
Units 5-8, Sunny Industrial Centre, 1/7 510 Chin Kuo Ling Road, Kowloon
Tel: 23489211-4 Fax: (852) 27272966

DRAWING TITLE: WINDOW-WALL (WM4) [3B-6]

CAD File Name :	
Designed by	
Drawn by	
Reviewed by	
Approved by	
Scale	
DWG NO. J-89C-WM4 [3B-6]	REV: 0

47

零件编号	规格(mm)	长度(mm)	数量	单重(kg)	总重(kg)	重量比例
M99	RHS120°90°5.3	1993	1	30.72	30.72	0.85
合计:					30.72	

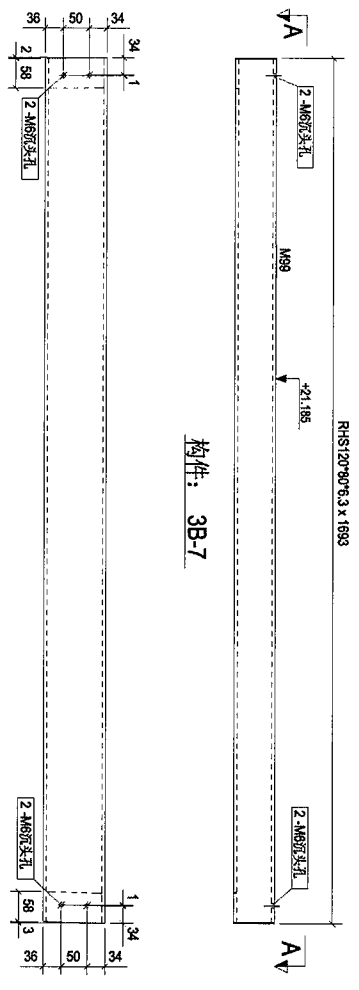

Rev.	Description	Date
0	第一次报批	2018-05-30

PROJECT: PROPOSED SITE C1 DEVELOPMENT AT AREA 88, TQTL TOWER TSEUNG KWAN HO, NEW TERRITORIES


CLIENT: 華特經貿有限公司
 MIDT (MUNICIPAL DEVELOPMENT) LIMITED
 Unit 6-5, Sunny Industrial Centre, 1/F,
 610 Che Kwo Ling Road, Kowloon
 Tel: (852) 24692711-4 Fax: (852) 27272666

DRAWING TITLE: WINDOW-WALL (MM4)
 [3B-7]

CAD File Name :	
Designed by	
Drawn by	
Reviewed by	
Approved by	
Scale	
DWG NO. J-886-MW4- [3B-7]	
REV.	0

48

料件编号	规格(mm)	长度(mm)	数量	重量(kg)	长度(mm)	重量(kg)	备注
M100	RHS120*90*6.3	1695	1	30.78	31	0.95	
合计				30.78			

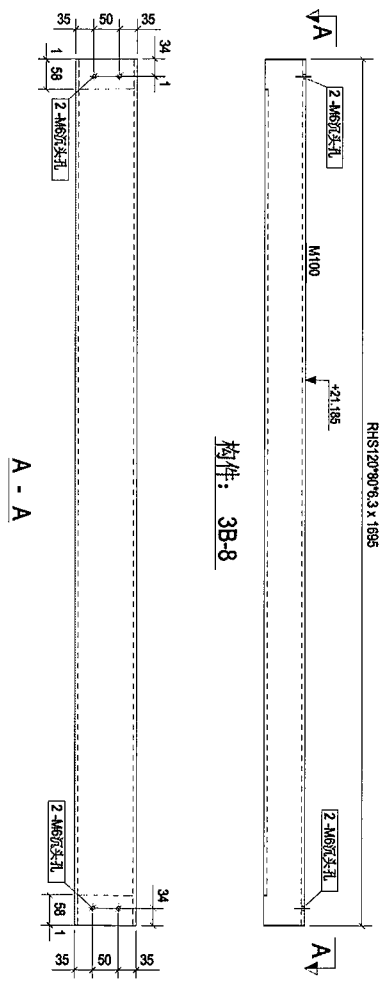

Rev.	Description	Date
0	第一次报数	2016-05-30

PROJECT: PROPOSED SITE C1 DEVELOPMENT AT AREA 86, TKOTI TOP, TSEUNGKWAN O, NEW TERRITORIES

CLIENT: 華特鋁質有限公司
MIDI Aluminium Fabricator Ltd.
Units 6-8, Sunny Industrial Centre, 1/F,
610 Cho Kwo Ling Road, Kowloon
Tel: (852) 27177866 Fax: (852) 27177866


Silver Town Limited
Tel: 07591-833468 Fax: 07591-833554
E-MAIL: ADDRESS@silvertown.com.hk

DRAWING TITLE: WINDOW-WALL (MWA)
[3B-8]

CAD File Name:	
Designed by:	
Drawn by:	
Reviewed by:	
Approved by:	
Scale:	
DWG NO.: J438-MWA-[3B-8]	
REV:	0

49

零件编号	3B-9	零件数量	2	零件重量	30.9
零件编号	规格(mm)	长度(mm)	宽度	厚度(mm)	表面面积
M101	RHS120°90°6.3	1693	1	31	30.72
合计					30.72

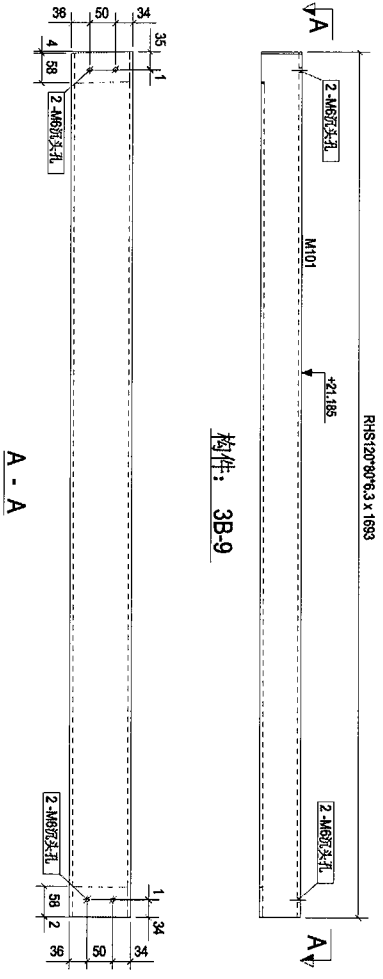

Rev.	Description	Date
0	第一次报批	2016-05-30

PROJECT: PROPOSED SITE C1
DEVELOPMENT AT AREA 86
TKOIT TO BP TSEUNG KWAN O,
NEW TERRORIES

CLIENT: 美特铝业有限公司
MIDI Aluminium Fabricator Ltd.
Suite 6-8, Sunny Industrial Centre, 1/F
610 Cho Kwo Ling Road, Kowloon
Tel: 23489211-4 Fax: (852) 27272686


Silver Town Limited
银同有限公司
Tel: 0759-8335488 Fax: 0759-8335554
E-MAIL: ADMIN@SILVERTOWN.COM

DRAWING TITLE: WINDOW WALL (MM4)
[3B-9]

CAD File Name :	
Designed by	
Drawn by	
Reviewed by	
Approved by	
Scale	
DWG NO.: J436-WW4-[3B-9]	REV: 0

50

零件编号	3B-10	零件数量	10	零件重量	30.8
零件编号	规格(mm)	数量	重量	单重	共重
M102	RHS120*80*6.3	1890	1	30.61	0.65
		合计:	30.61		

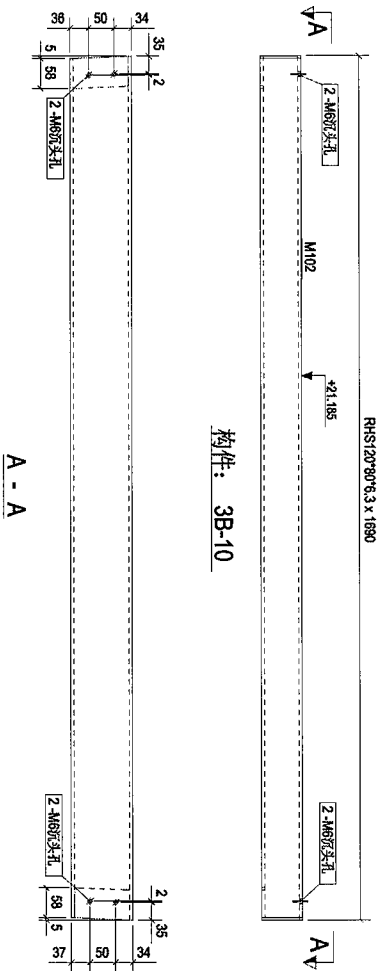

Rev.	Description	Date
0	第一次报批	2018-05-30

PROJECT: PROPOSED SITE C1
DEVELOPMENT AT AREA 86,
TKOIL TO RP TSEUNG KWAN O,
NEW TERRITORIES

CLIENT: 美特铝质有限公司
MIDI ALUMINUM FABRICATOR LTD.
Units 5-6, Sunny Industrial Centre, 1/F,
819 Chee Koo Jong Road, Kowloon
Tel: 23992111-4 Fax: (852) 27272966


银同有限公司
Silver Town Limited
Tel: 0759-83334968 Fax: 0759-83395954
E-MAIL: ADDRESS@silvertown.com.hk

DRAWING TITLE: WINDOW-WALL (M102)
[3B-10]

CAE File Name:	
Designed by:	
Drawn by:	
Reviewed by:	
Approved by:	
Scale:	
DWG NO.: J-836-MW4- [3B-10]	REV: 0

57

物料编号	规格(mm)	长度(mm)	数量	重量(kg)	长度(mm)	重量(kg)
M103	RHS120°90°6.3	1695	1	30.46	30	0.65
合计:				30.46		

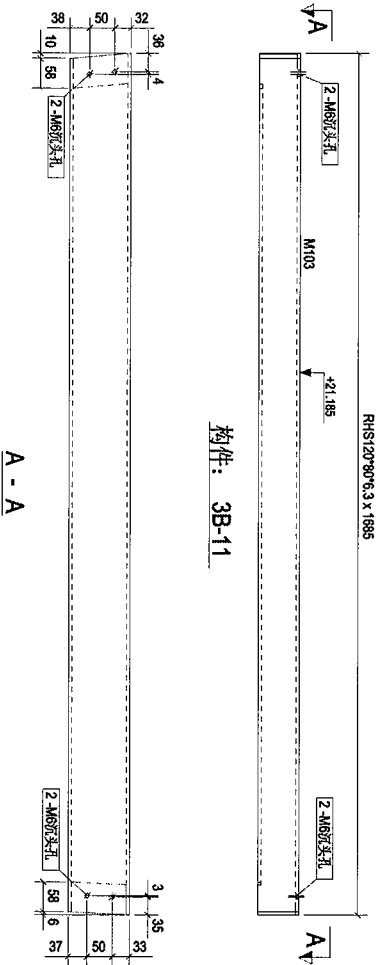

Rev.	Description	Date
0	第一次报批	2016-05-30

PROJECT: PROPOSED SITE C1 DEVELOPMENT AT AREA 86, TLOT 70 P, TSEUNG KWAN O, NEW TERRITORIES

CLIENT: 華特銀寶有限公司
MIDI ALUMINIUM FABRICATORS LTD.
Unit 6-8, Silver Industrial Centre, V/F
610 Che Kwo Ling Road, Kowloon
Tel: (852) 469211-4 Fax: (852) 2727566


Silver Town Limited
1460789-83354968 Fax: 0789-83355554
E-MAIL: ADDRESS@silvertown.hk, 1831004

DRAWING TITLE: WINDOW WALL (MM4)
[3B-11]

CAD File Name :	
Designed by	
Drawn by	
Reviewed by	
Approved by	
Scale	
DWG NO.: JBS3-MW4-[3B-11]	
REV	0

52

零件编号:	3B-12	零件数量:	6	零件重量:	30.8
零件编号:	规格(mm)	长度(mm)	数量	重量(kg)	卷重(kg)
M104	RHS120*80*6.3	1679	1	30.26	0.64
合计:				30.26	

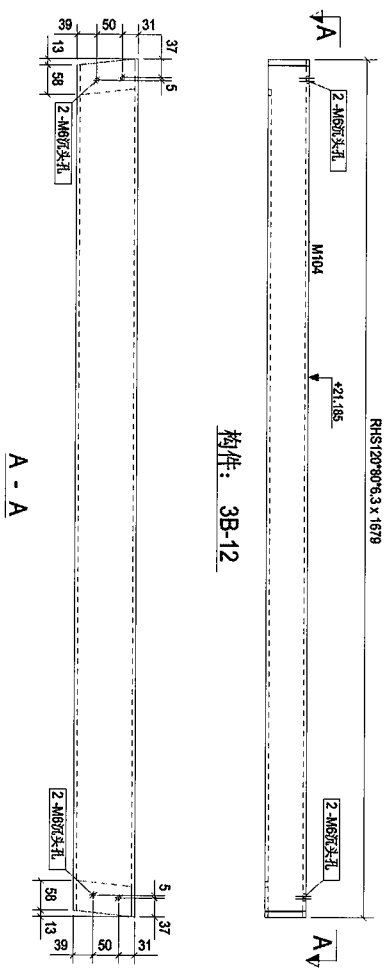

Rev:	0	第一次报批	2018-05-30
Description:			

PROJECT: PROPOSED SITE C1
DEVELOPMENT AT AREA 08,
TWO TOWER TOWNSHIP IN RMANO,
NEW TERRITORIES

CLIENT: 基特鋁質有限公司
MIDI Aluminium Industries Ltd.
Units 6-8, Sunny Industrial Centre, 1/
610 Chee Kwo Ling Road, Kowloon
Tel: (852) 27277366 Fax: (852) 27277366


Silver Town Limited
160780-433498 Fax: 0754-415994
E-MAIL: ADDRESS@silvertown.com

DRAWING TITLE: WINDOW-WALL (WMA4)
[3B-12]

Designed by	
Drawn by	
Reviewed by	
Approved by	
Scale	
DWG NO: J-836-WMA4 [3B-12]	
REV:	0

53

构件编号:	3B-13	构件数量:	2	构件重量:	31.1
零件编号	规格(mm)	长度(mm)	数量	重量(kg)	理论重量(kg)
M117	RHS120*90*5.3	1709	1	31.00	0.66
合计:				31.00	

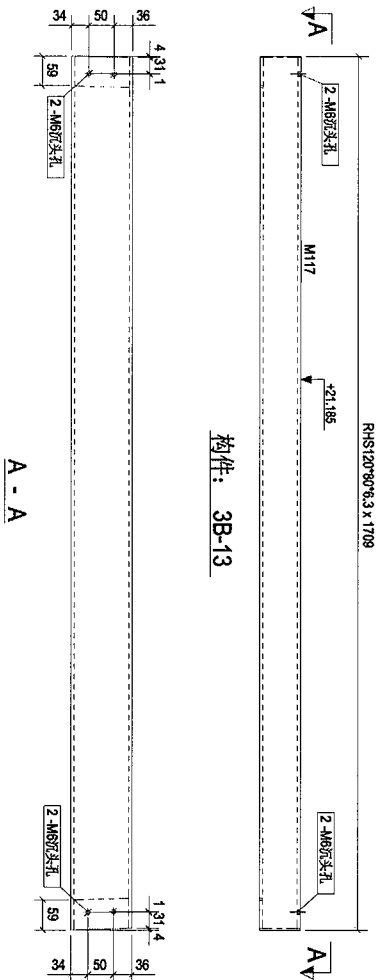

构件: 3B-13

A - A

Rev.	Description	Date
0	第一次报批	2018-05-30

PROJECT: PROPOSED SITE C1
DEVELOPMENT AT AREA 86
TKOIT TO RP TSEUNG KWAN O,
NEW TERRORIES

CLIENT: 美特鋁質有限公司
MIDI ALUMINIUM FABRICATOR LTD.
Units 6-8, Sunny Industrial Centre, 1/F
610 Cho Kwo Ling Road, Kowloon
Tel: (852) 89211-4 Fax: (852) 27272686


Silver Town Limited
Tel: 0789-8335468 Fax: 0789-8335954
E-MAIL: ADDRESS@SILVERTOWN.COM

DRAWING TITLE : WINDOW WALL (MM4)
[3B-13]

Designated by	
Drawn by	
Reviewed by	
Approved by	
Scale	
DWG NO.: J-836-W/M4- [3B-13]	
REV.	0

54

物料编号	3C-1	物料数量	1	物料重量	169.3
零件编号	规格(mm)	长度(mm)	数量	重量(吨)	表面积(m ²)
M79	RHS150*100*12.5	3950	1	174.42	1.85
				合计:	174.42

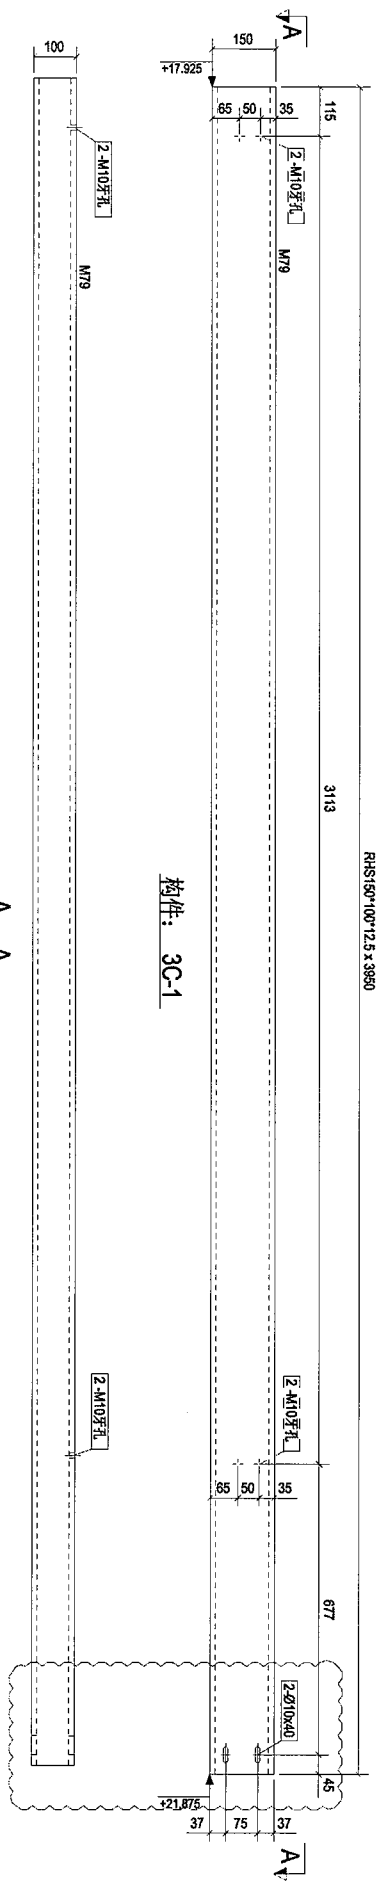

构件: 3C-1

A - A

Rev.	Description	Date
A	第2次报批	2019-06-06

PROJECT: PROPOSED SITE C1
DEVELOPMENT AT AREA 86,
TKOIL TO RP, TSEUNG KWAN O,
NEW TERRITORIES

CLIENT: 美特铝业有限公司
MIDI Aluminium Fabricator Ltd.
Units 6-8, Sunny Industrial Centre, 1/F
510 Cho Kwo Ling Road, Kwai Tsou
Tel: (23)892211-4 Fax: (65)27272956

Silver Town Limited
Tel: (852) 61354968 Fax: (852) 61355554
E-MAIL: adp@silvertown.com.hk; info@silvertown.com.hk


DRAWING TITLE: WINDOW WALL (MM4)
[3C-1]

Designed by	
Drawn by	
Reviewed by	
Approved by	
Scale	
DWG NO.: J-88-MW4-[3C-1]	REV: A

55

材料编号	规格(mm)	数量	单位	重量	共重(kg)	长度(m)	重量(kg)	
M80	RHS150*100*12.5	1	159	159.27	1.69			
合计							159.27	

RHS150*100*12.5 X 3807

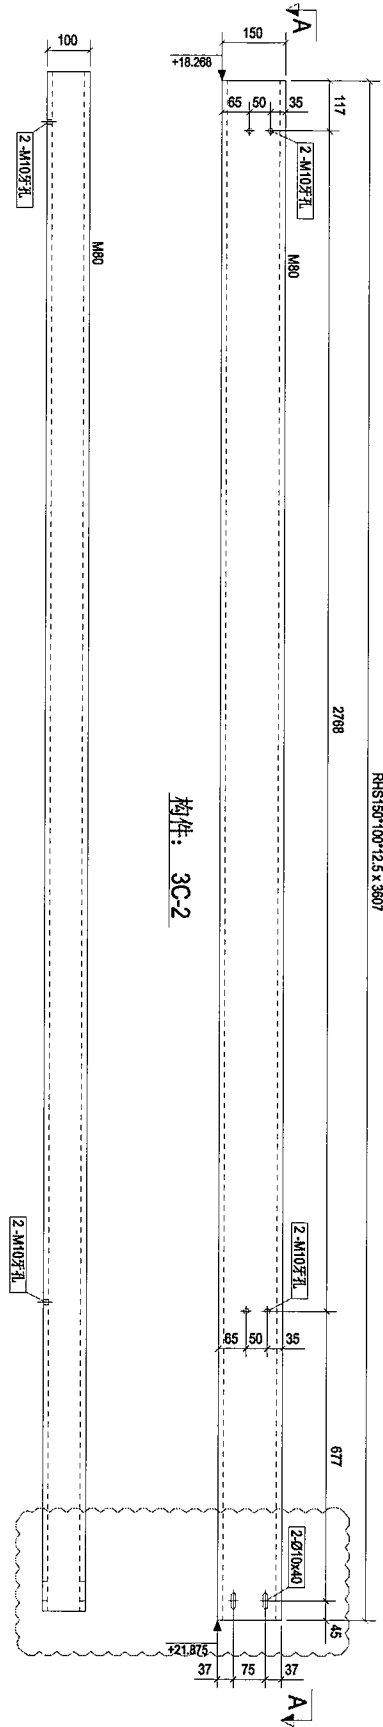

A - A

Rev.	Description	Date
A	第2次报批	2018-06-06

PROJECT: PROPOSED SITE C1
DEVELOPMENT AT AREA 06,
TKOJI TO RP TSEUNG KWAN O,
NEW TERRITORIES

CLIENT: 美特铝有限公司
MIDI Aluminium Fabricator Ltd.
Units 6-8, Sunny Industrial Centre, 1/F
610 Cho Kwo Ling Road, Kwun Tin
Tel: (852) 48921144 Fax: (852) 27272666


Silver Town Limited
Tel: 0759-43354668 Fax: 0759-43355554
E-MAIL: ADDRESS@silvertown.com.hk

DRAWING TITLE: WINDOW WALL (MW4)
[3C-2]

CAD File Name:	
Designed by:	
Drawn by:	
Reviewed by:	
Approved by:	
Scale:	
DMG NO.:	J838-MW4 [3C-2]
REV.	A

56

料号	3C-3	料号	4	料号	168.3
零件编号	规格(mm)	长度(mm)	数量	重量(g)	重量(kg)
M81	RHS150*100*12.5	3980	1	174.42	1.85
合计:				174.42	

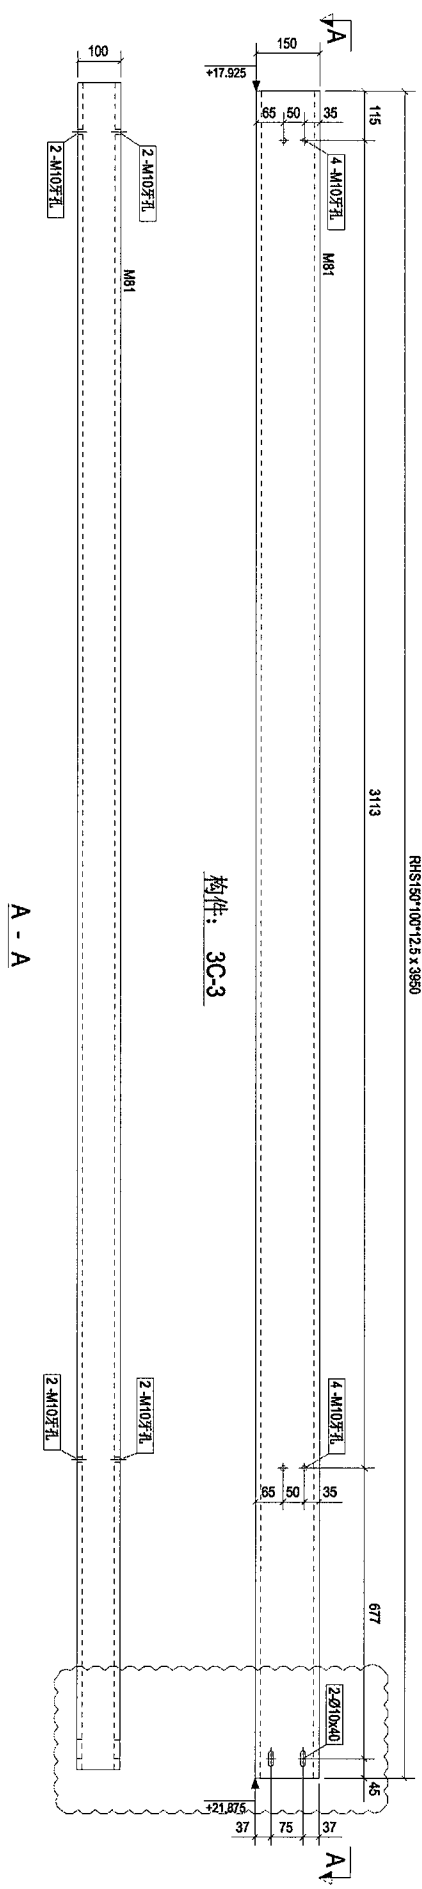

Rev.	Description	Date
A	第一次报批	2018-08-06

PROJECT:
 PROPOSED SITE C1
 DEVELOPMENT AT AREA 86,
 TJOIT TO PP TSEUNG KWAN O,
 NEW TERRITORIES

CLIENT:
英特铝业有限公司
MIDI Aluminium Fabricators Ltd.
 Units 6-8, Sunny Industrial Centre, 1/F
 610 Cho Kwo Ling Road, Kowloon
 Tel: 23489211-4 Fax: (852) 27275665


银同有限公司
Silver Town Limited
 Tel: 0759-83354668 Fax: 0759-83359554
 E-MAIL: ADP@SSTV.COM.HK, I&L@SSTV.COM

DRAWING TITLE:
WINDOW WALL (MMW)
[3C-3]

CAD File Name :	
Designed by	
Drawn by	
Reviewed by	
Approved by	
Scale	
DWG NO. : J-836-MMW- [3C-3]	REV. A

57

零件编号	3C-4	零件数量	1	零件重量	169.3
零件编号	规格(mm)	长度(mm)	数量	重量(kg)	重量(m³)
M82	RHS150*100*12.5	3950	1	174.42	1.85
				合计:	174.42

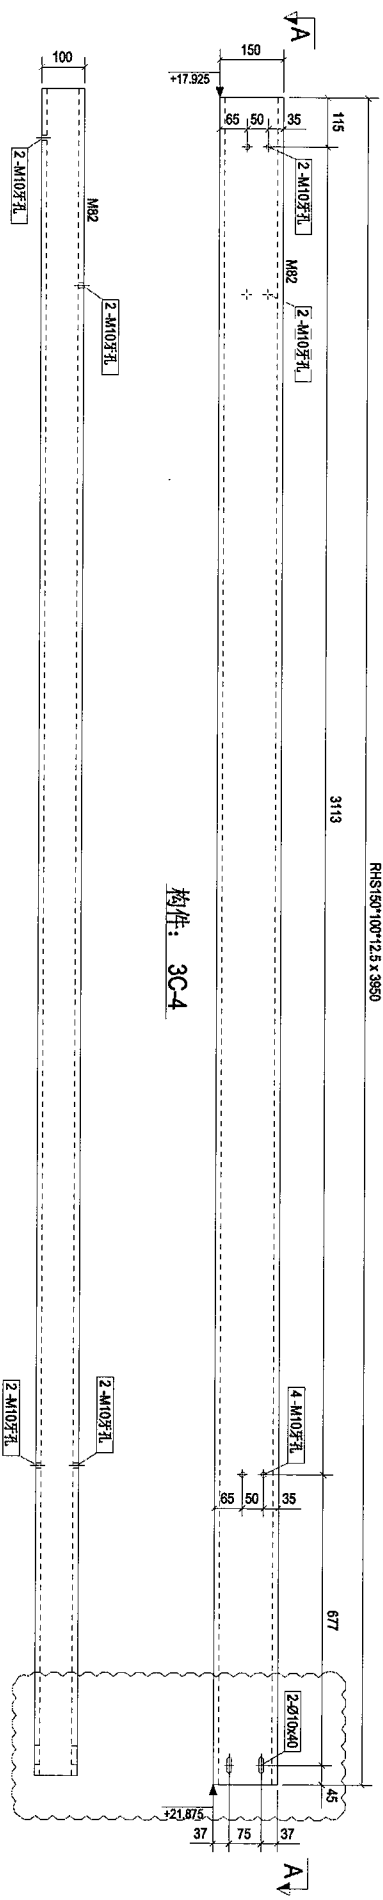

Rev.	Description	Date
A	首次提报	2018-08-08

PROJECT: PROPOSED SITE C1
DEVELOPMENT AT AREA 08,
KOTLITUP, SEUNG KWAN O,
NEW TERRITORIES

CLIENT: 慕特经贸有限公司
MIDI ALUMINUM FABRICATOR LTD.
Units 5-8, Simoy Industrial Centre, 1/F,
610 Cho Kwo Ling Road, Kowloon
Tel: 23489211-4 Fax: (852) 27229566


Silver Town Limited
Tel: 0750-4335468 Fax: 0750-4335554
E-MAIL: adp3554@silvertown.com.hk

DRAWING TITLE: WINDOW-WALL (MW4)
[3C-4]

Designed by	
Drawn by	
Reviewed by	
Approved by	
Scale	
DWG NO.:	J-336-MW4-[3C-4]
REV.	A

18

零件编号	3C-5	零件数量	29	材料重量	154.6
零件编号	规格(mm)	长度(mm)	数量	重量(kg)	长度(mm)
M83	RHS150*100*12.5	3907	1	159.27	1.69
合计				159.27	

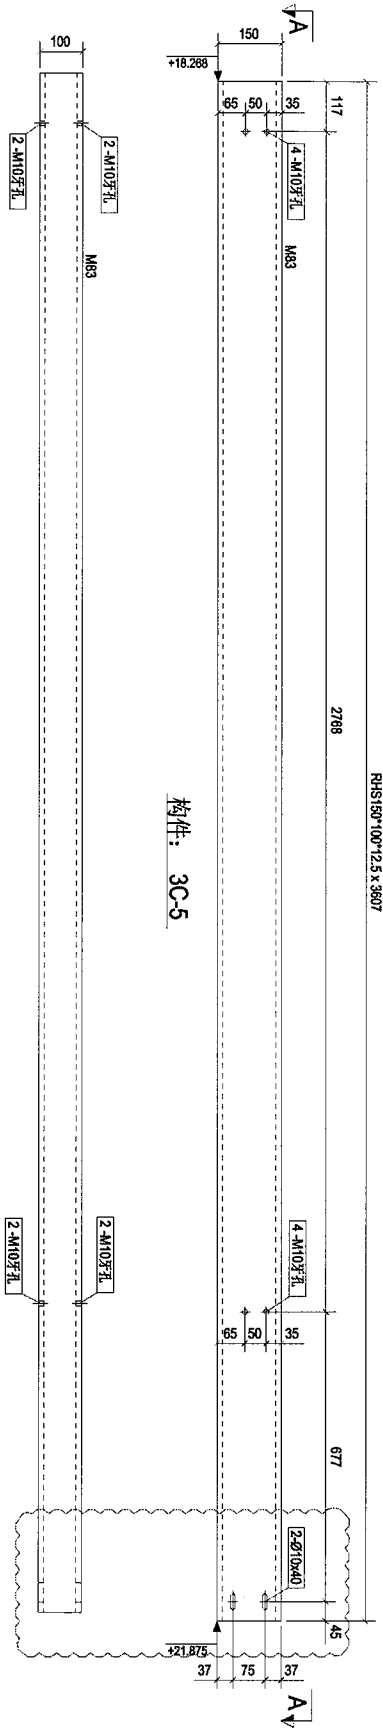

A - A

Rev.	Description	Date
A	第一次报批	2018-06-06

PROJECT: PROPOSED SITE C1
DEVELOPMENT AT AREA 08,
TKO1 TO RP TSEUNG KWAN O,
NEW TERRITORIES

CLIENT: 美特铝业有限公司
MIDI Aluminium Fabricator Ltd.
Units 6-8, Sunny Industrial Centre, 1/F
610 Cho Kwo Ling Road, Kowloon
Tel: (852) 2727-7666 Fax: (852) 2727-7666



Silver Town Limited
Tel: 0759-8135468 Fax: 0759-8135554
E-MAIL: ADMIN@SSTW.COM.HK

DRAWING TITLE: WINDOW WALL (MWH)
[3C-5]

CAD File Name :	
Designed by	
Drawn by	
Reviewed by	
Approved by	
Scale	
DWG NO.:	J436-MWH- [3C-5]
REV	A

59

零件编号	3JM-1	零件数量	72	零件重量	1.5
零件编号	规格(mm)	长度(mm)	数量	重量(kg)	重量(kg)
F31	PT4x40	40	2	0	0.10
M136	RS9A100756	180	1	1.43	0.07
合计:					1.53

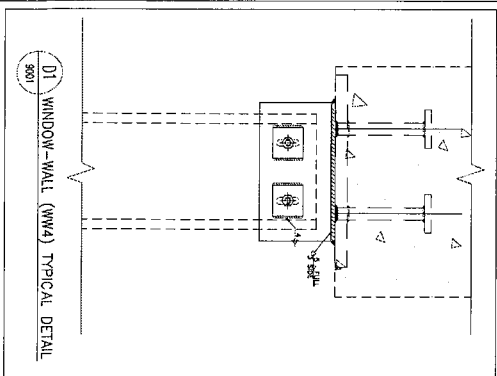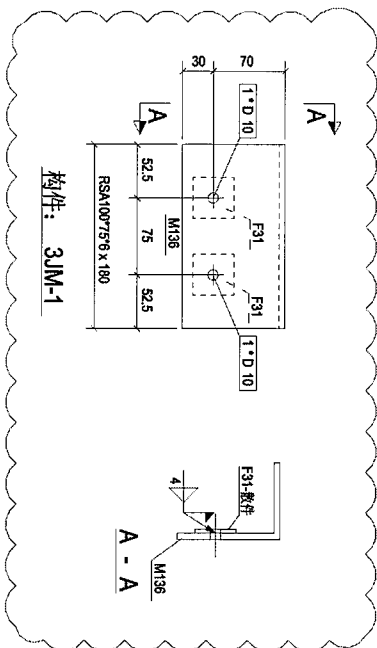

Rev.	Description	Date
A	第2次报批	2018-06-06

PROJECT: PROPOSED SITE C1
DEVELOPMENT AT AREA 86,
TKO1 TO RP TSEUNG KWAN O,
NEW TERRITORIES

CLIENT: 美特铝业有限公司
MIDI Aluminium Fabricator Ltd.
Units 6-8, Sunny Industrial Centre, 1/F
610 Cho Kwai Ling Road, Kwai Tsou
Tel: 23459211-4 Fax: (852) 27277666



银同有限公司
Silver Town Limited
Tel: 0759-8326468 Fax: 0759-8325554
E-MAIL: ADDRESS@silvertown.hk

DRAWING TITLE: WINDOW-WALL (Ww4)
[3JM-1]

CAO File Name:	
Designed by:	
Drawn by:	
Reviewed by:	
Approved by:	
Scale:	
DMG NO.:	J486-WW4- [3JM-1]
REV	A

60

零件编号:	3SM-1	构件数量:	124	构件重量:	0.4
零件编号	规格(mm)	长度(mm)	数量	重量(kg)	表面面积(m ²)
M74	RSAS675075	100	1	0.37	0.02
			0	0.37	0.02
		合计:		0.37	

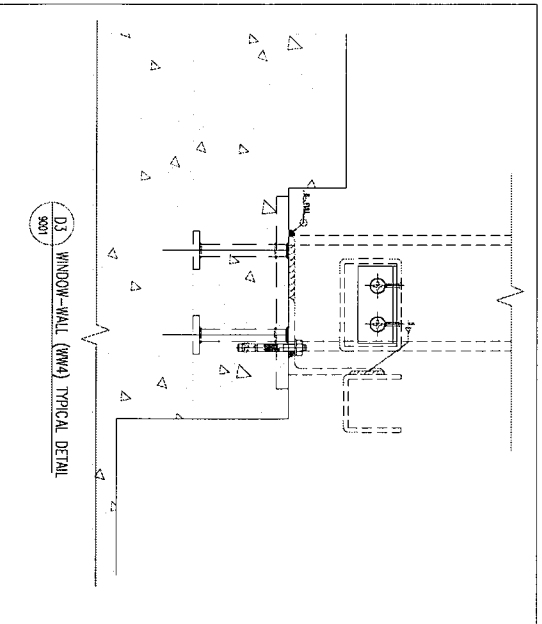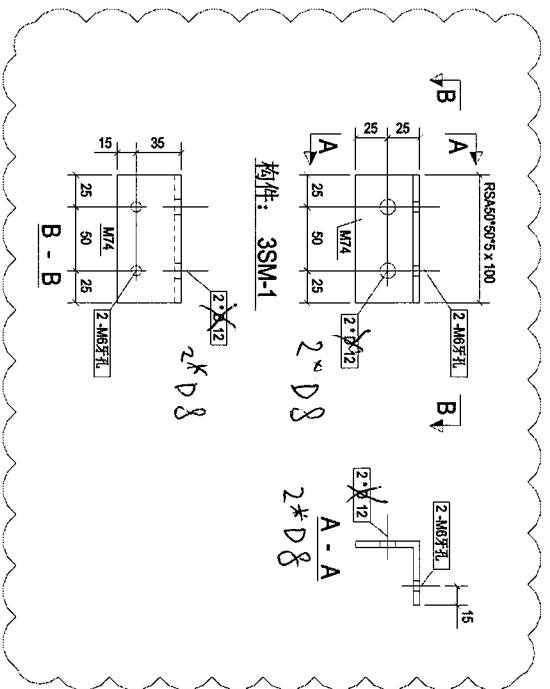

Rev.	A	第2次报批	2018-06-06
------	---	-------	------------

PROJECT: PROPOSED SITE C1
DEVELOPMENT AT AREA 86,
TKOIT TO RP, TSEUNG KWAN O,
NEW TERRITORIES

CLIENT: 美特鋁質有限公司
MIDI Aluminium Fabricator Ltd.
Units 6-8, Sunny Industrial Centre, 1/F
515 Chee Koo Ling Road, Kwai Tsan
Tel: (2369)2111-4 Fax: (852)7727266


銀同有限公司
Silver Town Limited
Tel: (755) 8335888 Fax: (755) 8335854
E-MAIL: ABBE552@silvertown.com

DRAWING TITLE: WINDOW-WALL (WW4)
[3SM-1]

CAD File Name:	
Designed by:	
Drawn by:	
Reviewed by:	
Approved by:	
Scale:	
DWG NO.:	J436-WW4-[3SM-1]
REV:	A

61

料号	3U-1	料号数量	5	料号重量	232
零件编号	规格(mm)	长度(mm)	料宽	面积(㎡)	重量(kg)
M137	RSC75X75x6	1785	1	18	17.91
M140	RSA100X75x8	230	3	2	7.24
合计:					25.14

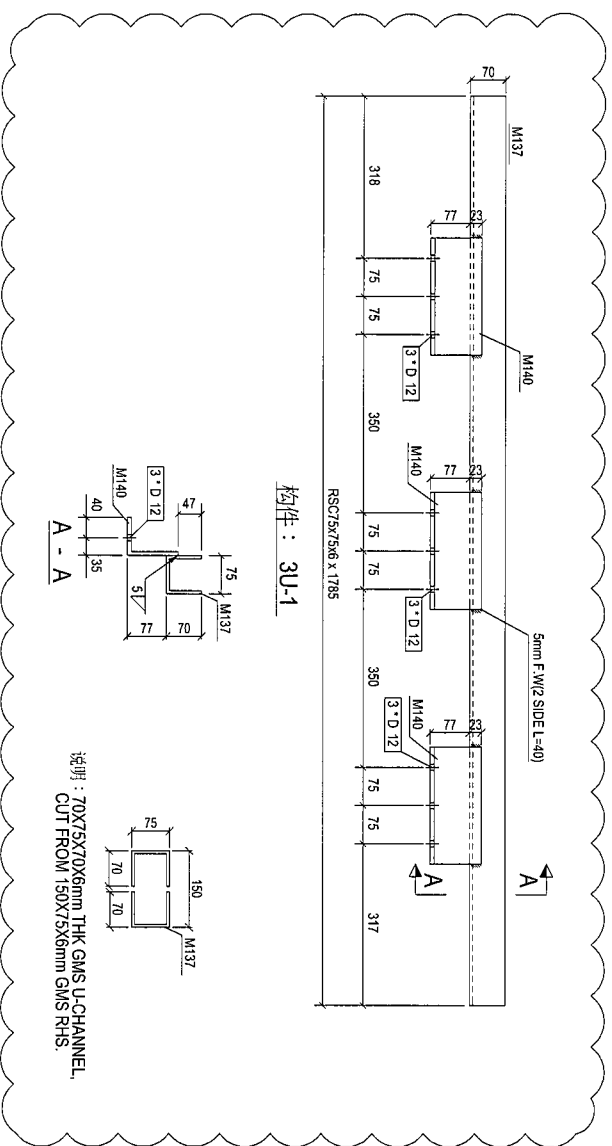


构/件：3U-1

说明：70X75X70x6mm THK GMS U-CHANNEL,
CUT FROM 150X75X6mm GMS RHS.

REV	REV	REV	REV
A	第2次校核	2018-06-06	
<p>PROPOSED SITE C1 DEVELOPMENT AT AREA 86, TKOIL 70 RE-USE/ING WMAN O, NEW TERRITORIES</p>			
<p>银同有限公司 Silver Town Limited</p>			
<p>WINDOW WALL (WMA)</p>			
<p>[3U-1]</p>			
<p>DWG NO: J-836-WMA [3U-1]</p>			

65

零件编号	3U-2	零件数量	30	零件重量	27.3
零件编号	规格(mm)	长度(mm)	数量	单重(g)	共重(g)
M137	RSC75x75x6	1795	1	17.91	0.78
M144	RS415x75x3	230	3	9.40	0.11
合计				27.31	

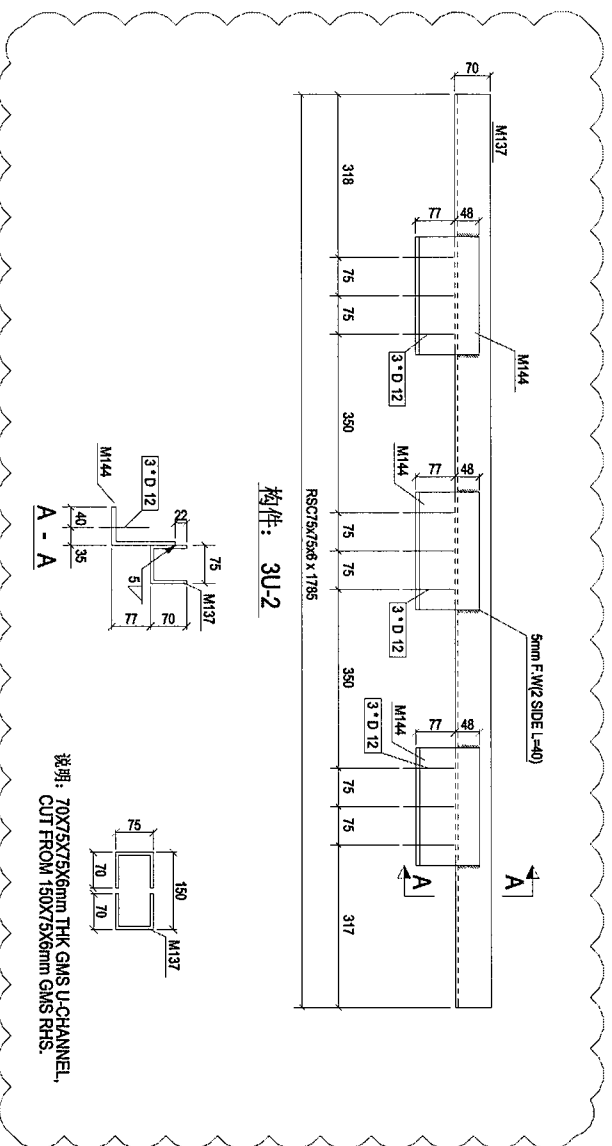

Rev.	Description	Date
A	第2次报批	2018-06-06

PROJECT: PROPOSED SITE C1
DEVELOPMENT AT AREA 88,
TKO TT TO RP, TSEUNG KWAN O,
NEW TERRITORIES

CLIENT: 美特銀寶有限公司
Units 5-8, Sunny Industrial Centre, 1/F
610 Chee Kwo Ling Road, Kwai Tsing
Tel: 32389211-4 Fax: 3227272866


银同有限公司
Silver Town Limited
Tel: 07769-8335468 Fax: 07769-8335554
E-MAIL: adp@silvertown.com.hk

DRAWING TITLE: WINDOW WALL (NMW)
[3U-2]

CAD File Name:	
Designed by:	
Drawn by:	
Reviewed by:	
Approved by:	
Scale:	
DWG NO.: J-88-WW4-[3U-2]	REV: A

64

零件编号	规格(mm)	数量	单位	重量(kg)	长度(m)	表面积(m ²)
M82	RHS120*90*6.3	1	1	31.38	17.11	0.66
合计:				31.38		

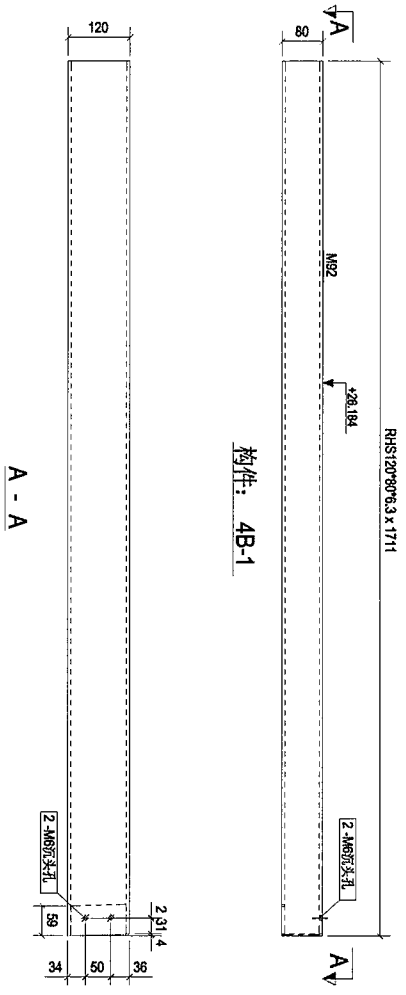

Rev.	Description	Date
0	第一次报批	2010-05-30

PROJECT: PROPOSED SITE C1
DEVELOPMENT AT AREA 08,
TKOJI TO BP TSEUNG KWAN O,
NEW TERRITORIES

CLIENT: 美特铝业有限公司
MIDI Aluminium Fabrication Ltd.
Units 6-8, Sunny Industrial Centre, 1/F
510 Cho Kwai Ling Road, Kowloon
Tel: (852) 992111-4 Fax: (852) 27277856


Silver Town Limited
Tel: 0759-8335488 Fax: 0759-8335534
E-MAIL: ADMIN@SILVERTOWN.COM

DRAWING TITLE: WINDOW WALL (MW4)
[4B-1]

CAD File Name:	
Designed by	
Drawn by	
Reviewed by	
Approved by	
Scale	
DWG NO.: J488-MW4-[4B-1]	REV: 0

65

料件编号:	4B-2	料件数量:	4	料件重量:	30.9
零件编号	规格(mm)	长度(mm)	数量	单重(kg)	共重(kg)
M83	RHS120*80*5.3	1894	1	30.75	0.85
合计:				30.75	

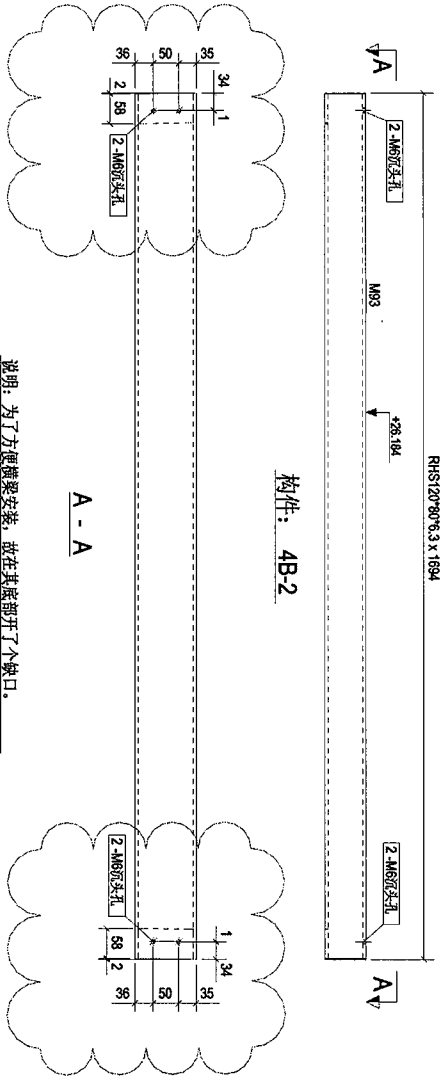

说明: 为了方便横梁安装, 故在其底部开了个缺口。

构件: 4B-2

Rev.	Description	Date
0	第一次报批	2018-05-30

PROJECT:
PROPOSED SITE C1
DEVELOPMENT AT AREA 88,
TKO1 TO RP, TSEUNG KWAN O,
NEW TERRITORIES

CLIENT:
美特铝业有限公司
MIDI ALUMINIUM FABRICATOR LTD.
Units 6-8, Sunny Industrial Centre, 1/F
610 Cho Koo Ling Road, Kowloon
Tel: (852) 2772686


银同有限公司
Silver Town Limited
Tel: 0769-83354668 Fax: 0769-83355554
E-MAIL: ADDRESS@silvertown.hk

DRAWING TITLE:
WINDOW WALL (MM4)
[4B-2]

CAO File Name:	
Designed by	
Drawn by	
Reviewed by	
Approved by	
Scale	
DWG NO.:	J438-WW4- [4B-2]
REV	0

66

料件编号	规格(mm)	数量	单位	重量(kg)	体积(m³)
M100	RHS120*90*6.3	1	30.78	0.65	
合计:				30.78	

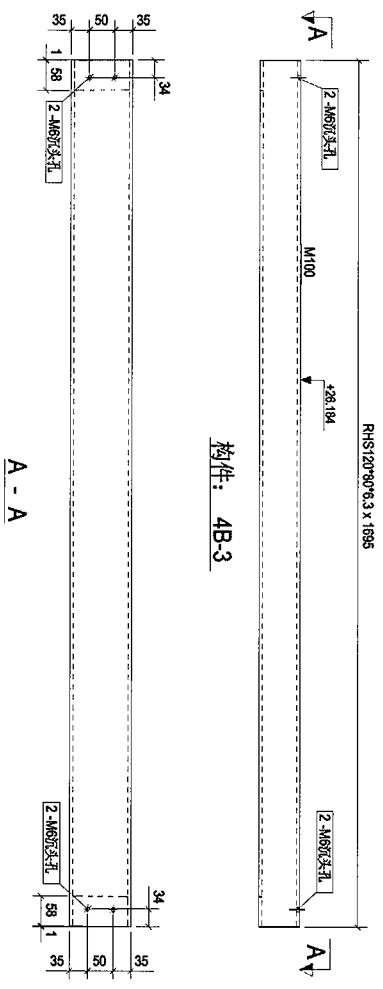

Rev.	Description	Date
0	第一次报批	2016-05-30

PROJECT: PROPOSED SITE C1
DEVELOPMENT AT AREA 88,
TKOIL TO BP TSEUNG KWAN O,
NEW TERRORIES

CLIENT: 美特鋁質有限公司
MIDI Aluminium Fabricators Ltd.
Units 5-8, Sunny Industrial Centre, 1/F
610 Chee Koo Ling Road, Kowloon
Tel: (852) 27727866 Fax: (852) 27727866


Silver Town Limited
Tel: (852) 43334488 Fax: (852) 43334454
E-MAIL: ADDRESS@silvertown.com.hk

DRAWING TITLE: WINDOW-WALL (MMW4)
[4B-3]

CAJ File Name:	
Designed by:	
Drawn by:	
Reviewed by:	
Approved by:	
Scale:	
DWG NO: JS36-MW4-[4B-3]	REV: 0

65

料序號	規格(mm)	長度(mm)	數量	單重(kg)	共重(kg)	表面積(m ²)
M105	RHS120*90*6.3	1692	1	30.69	30.69	0.85
合計:					30.69	

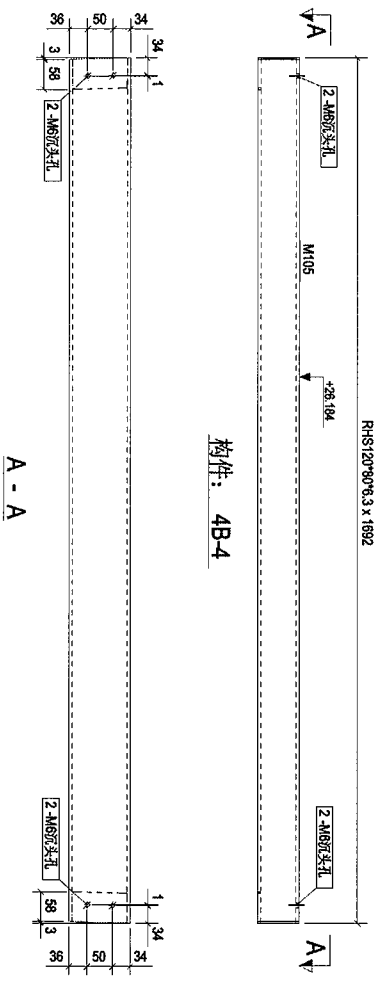

构件: 4B-4

A - A

Rev.	Description	Date
0	第一次投標	2018-05-30

PROJECT: PROPOSED SITE C1
DEVELOPMENT AT AREA 86
TKO1 TO PP TSEUNG KWAN O,
NEW TERRORIES

CLIENT: 華特鋁質有限公司
MIDI ALUMINIUM FABRICATOR LTD.
Unit 6-8, Sunny Industrial Centre, 1/F
510 Che Kwo Ling Road, Kowloon
Tel: (852) 4892111-4 Fax: (852) 27272666


Silver Town Limited
Tel: 0755-83356661 Fax: 0755-8335554
E-MAIL: ADDRESS@silvertown.com.cn, 1831004

DRAWING TITLE : WINDOW-WALL (MM4)
[4B-4]

Designed by	
Drawn by	
Reviewed by	
Approved by	
Scale	
DWG NO.:	J436-MW4-[4B-4]
REV	0

68

构件编号:	4B-5	构件数量:	10	构件重量:	30.8
零件编号	规格(mm)	长度(mm)	数量	重量(kg)	长度(mm)
M106	RH5120*90*5.3	1691	1	30.85	0.65
合计:			30.85		

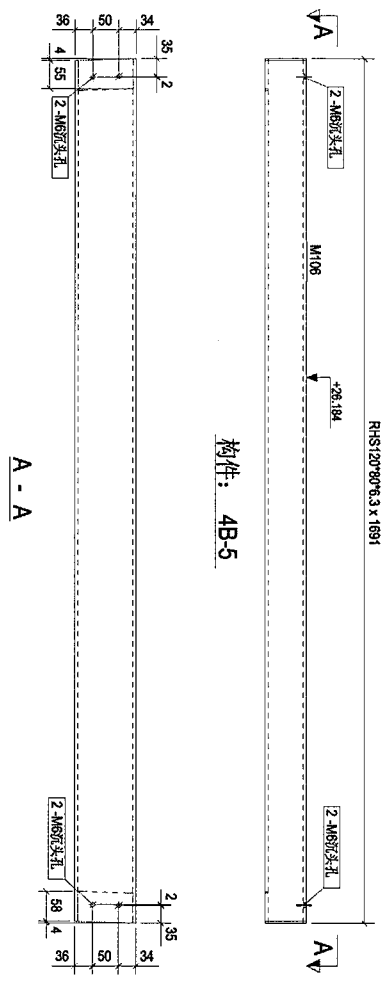

Rev.	0	第一次报批	2018-05-30
Rev.		Description	Date

PROJECT: PROPOSED SITE C1 DEVELOPMENT AT AREA 96, TKO1 TO RP TSEUNG KWAN O, NEW TERRITORIES

CLIENT: 美特鋁寶有限公司
MIDI ALUMINIUM FABRICATOR LTD.
Unit 6-8, Sunny Industrial Centre, 1/F
610 Cho Kwo Ling Road, Kwun Tong
Tel: (852) 23489211-4 Fax: (852) 27272686


Silver Town Limited
Tel: 07788 43354668 Fax: 0769 43355554
E-MAIL: ADDRESS@SILVERTOWN.BIZ.HK

DRAWING TITLE: WINDOW-WALL (M106)
[4B-5]

Designed by	
Drawn by	
Reviewed by	
Approved by	
Scale	
DWG NO.:	J438-M106- [4B-5]
REV.	0

19

物料编号	4B-6	物料数量	2	物料重量	30.7
零件编号	规格(mm)	长度(mm)	数量	单重(kg)	重量(kg)
M107	RHS120*90*5.3	1683	1	30.39	0.55
合计:					30.39

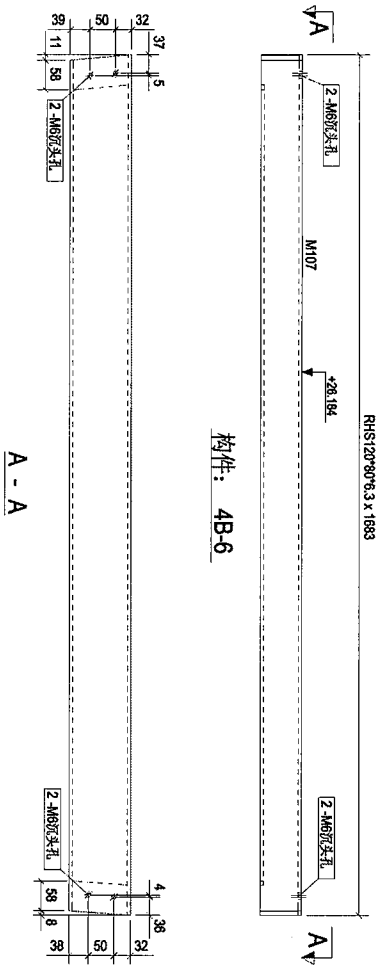

Rev.	Description	Date
0	第一次报批	2018-05-30

PROJECT: PROPOSED SITE C1
DEVELOPMENT AT AREA 88,
TKOTI 70 RP, TSEUNG KWAN O,
NEW TERRITORIES

CLIENT: 美特铝质有限公司
MIDI Aluminium Fabricator Ltd.
Units 6-8, Sunny Industrial Centre, 1/F
610 Cho Kuo Ling Road, Kowloon
Tel: (852) 2717-1144 Fax: (852) 2717-7686


Silver Town Limited
Tel: 07793 4334468 Fax: 07793 4335554
E-MAIL: ADDRESS@SILVERTOWN.COM

DRAWING TITLE: WINDOW WALL (M107)
[4B-6]

CAO File Name:	
Designed by:	
Drawn by:	
Reviewed by:	
Approved by:	
Scale:	
DWG NO.:	J436-MW4-[4B-6]
REV:	0

70

构件编号	4B-7	构件数量	4	构件重量	30.35
部件编号	规格(mm)	长度(mm)	数量	单重(kg)	表重(kg)
M108	RHS120*90*5.3	1892	1	30.35	0.85
合计:				30.35	

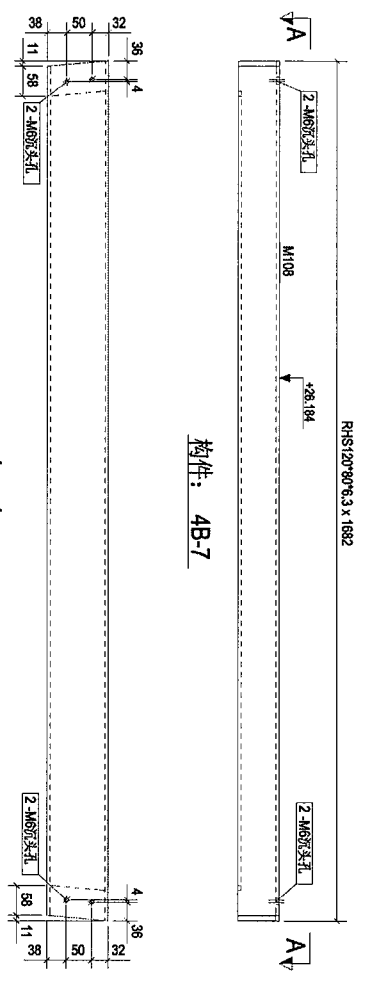

构件: 4B-7

A - A

Rev.	Description	Date
0	第一次报批	2018-05-30

PROJECT:
 PROPOSED SITE C1
 DEVELOPMENT AT AREA 66,
 TKOIL 70 RP, TSEUNG KWAN O,
 NEW TERRITORIES

CLIENT:
美特銀質有限公司
MIDI ALUMINIUM FABRICATORS LTD.
 Unit 6-8, Sunny Industrial Centre, 1/F
 610 Cho Kwo Ling Road, Kowloon
 Tel: 23489211-4 Fax: (852) 27272666

銀同有限公司
Silver Town Limited
 Tel: 0759-8335468 Fax: 0759-8335954
 E-MAIL: ADDRESS@SILVERTOWN.COM

DRAWING TITLE :
WINDOW WALL (MM4)
[4B-7]

CAD File Name :


Designed by	
Drawn by	
Reviewed by	
Approved by	
Scale	

DWG NO.: J-438-WM4- (4B-7)

REV.	0
------	---

31

物料编号	4B-8	物料数量	2	物料重量	30.5
零件编号	规格(mm)	长度(mm)	数量	单重(N)	重量(N)
M109	RHS120*80*6.3	1675	1	30.11	0.84
合计					30.11

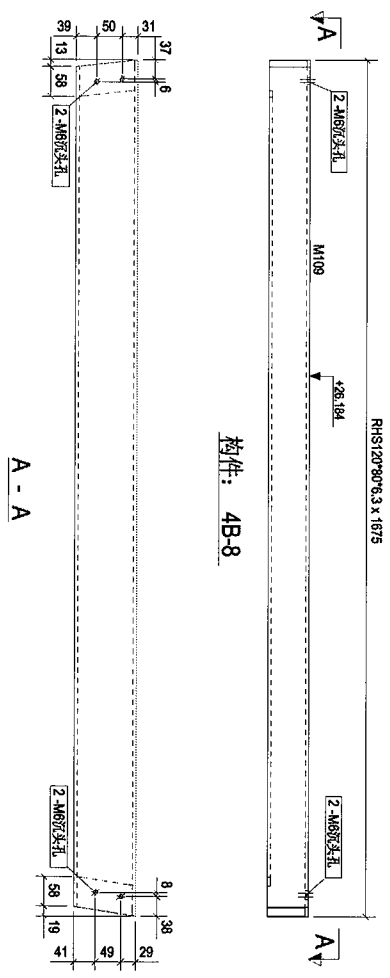

Rev.	Description	Date
0	第一次报批	2018-05-30

PROJECT:
 PROPOSED SITE C1
 DEVELOPMENT AT AREA 86,
 TKO TOWER TSEUNG KWAN O,
 NEW TERRITORIES

CLIENT:
美特銀寶有限公司
 5th/5-6, Sunray Industrial Centre, 1/F
 610 Chee Kwo Ling Road, Kowloon
 Tel: (852) 9211-14 Fax: (852) 27275665


银同有限公司
 Silver Town Limited
 Tel: (852) 4334668 Fax: (852) 4335554
 E-MAIL: ADVERTISING@SILVERTOWN.LTD.COM

DRAWING TITLE:
 WINDOW-WALL (MM4)
[4B-8]


CAD File Name :	
Designed by	
Drawn by	
Reviewed by	
Approved by	
Scale	
DWG NO. : J836-MW4- [4B-8]	REV. 0

72

料号	规格	数量	重量	长度	面积	体积
M110	RHS120*80*6.3	1	30.45	1885	30.45	0.85
合计:			30.45			

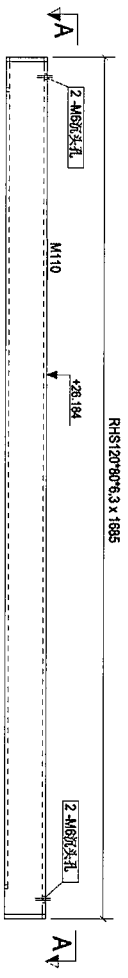

构件: 4B-9

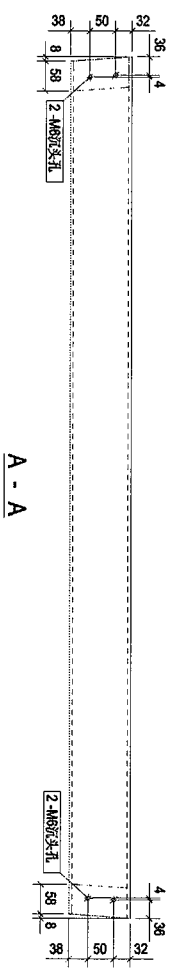

A - A

Rev	Description	Date
0	第一次报批	2018-05-30

PROJECT:
PROPOSED SITE C1
DEVELOPMENT AT AREA 86,
TKOJI 70/P, TSEUNG KWAN/O,
NEW TERRITORIES

CLIENT:
美特銀質有限公司
MIDI Aluminium Fabrications Ltd.
Units 6-8, Sunny Industrial Centre, 1/F
610 Chee Kwo Ling Road, Kwailoon
Tel: (2348) 9211-4 Fax: (852) 27275666


銀同有限公司
Silver Town Limited
Tel: 0769-4335488 Fax: 0769-4335954
E-MAIL: ADDRESS@silvertown.hk, IEX.COM

DRAWING TITLE :
WINDOW-WALL (MMW)
[4B-9]

CAD File Name :	
Designed by	
Drawn by	
Reviewed by	
Approved by	
Scale	
DWG NO. : J-836-MMW-[4B-9]	REV: 0

73

物料编号	规格(mm)	长度(mm)	数量	单重(kg)	重量(kg)	备注
M111	RHS120*80*6.3	1689	1	30.59	30.59	
合计:					30.59	

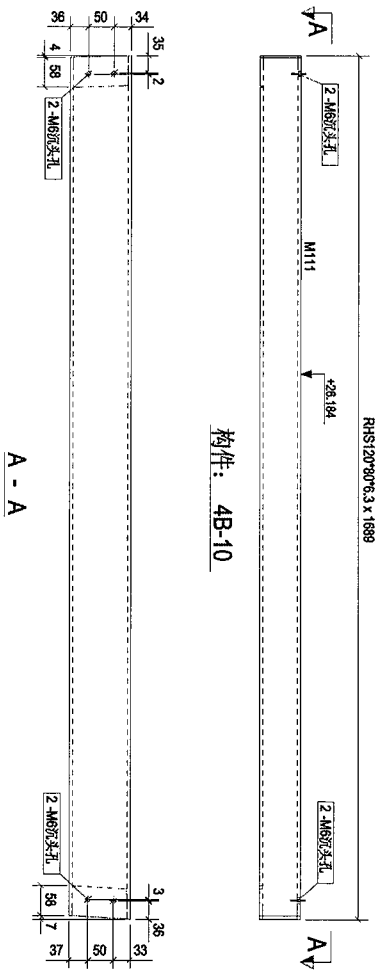

构件: 4B-10

74

Rev.	Description	Date
0	第一次报批	2018-05-30

PROJECT:
PROPOSED SITE C1
DEVELOPMENT AT AREA 85,
TKOJI 70 BP, TSEUNG KWAN O,
NEW TERRITORIES


CLIENT:
美特 经贸有限公司
MIDI Architecture Ltd.
Unit 6-8, Samoy Industrial Centre, 1/F
510 Chee Kwo Ling Road, Kowloon
Tel: 23489211-4 Fax: (852) 27275665

银同有限公司
Silver Town Limited
Tel: 0759-4333488 Fax: 0759-4333954
E-MAIL: ADDRESS@SILVERTOWN.COM.HK


DRAWING TITLE:
WINDOW-MALL (MM4)
[4B-10]

CAD File Name :	
Designed by	
Drawn by	
Reviewed by	
Approved by	
Scale	
DWG NO. : J896-WM4- [4B-10]	
REV.	0

物料编号	4B-11	物料数量	2	物料重量	30.8
物料编号	规格(mm)	长度(mm)	数量	重量(kg)	长度(mm)
M112	RHS120*80*6.3	1694	1	30.72	0.85
合计			30.72		

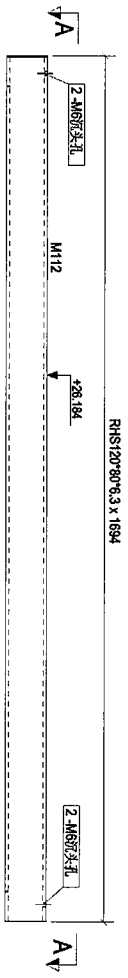

构件: 4B-11

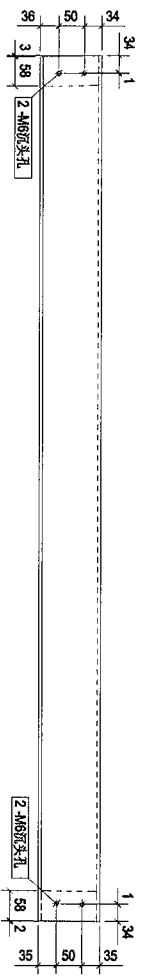

A - A

Rev.	Description	Date
0	第一次报数	2018-05-30

PROJECT:
PROPOSED SITE C1
DENIED OPMENT AT AREA 86
TKOYL TO PE TSEUNG NYAN/O,
NEW TERRITORIES

CLIENT:
美特銀寶有限公司
MIDI ADVISORY FINANCIALS LTD.
Units 6-8, Sunray Industrial Centre, 1/F
610 Chin Kwo Ling Road, Kwunshan
Tel: 23489211-4 Fax: (852) 27275665


银同有限公司
Silver Town Limited
Tel: 0769-3335488 Fax: 0769-3335954
E-MAIL: ADRIE.SS@silvertown.hk, ISX.COM

DRAWING TITLE:
WINDOW-MALL (MM4)
[4B-11]

CAD File Name :	
Designed by	
Drawn by	
Reviewed by	
Approved by	
Scale	
DWG NO.: J86-MW4 [4B-11]	REV: 0

25

零件编号:	4B-12	材料:	4	材料重量:	30.9
零件编号	规格(mm)	数量	单重(kg)	共重(kg)	公差(mm)
				合计:	30.76

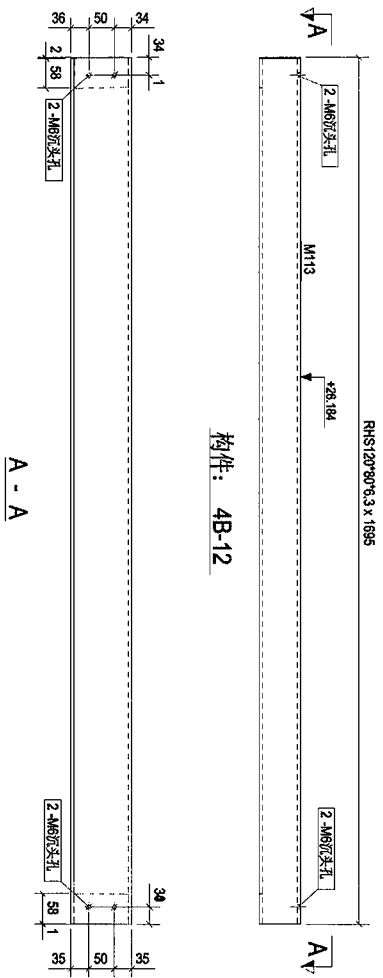

构件: 4B-12

Rev.	0	第一次报批	2016-05-30
Description			

PROJECT: PROPOSED SITE C1
DEVELOPMENT AT AREA 68,
TKOTI 70 RP, TSEUNG KWAN O,
NEW TERRITORIES

CLIENT: 美特鋁質有限公司
MIDI Aluminium Fabricator Ltd.
Units 6-8, Sunny Industrial Centre, 1/F
610 Cho Kwo Ling Road, Kowloon
Tel: (852) 27172686 Fax: (852) 27172686

Silver Town Limited
Tel: 07793 8335488 Fax: 0769 8335954
E-MAIL: ad@silvertown.com.hk, ts@silvertown.com.hk


DRAWING TITLE: WINDOW WALL (MM4)
[4B-12]

CAD File Name :

Designed by	
Drawn by	
Reviewed by	
Approved by	
Scale	
DMG NO.: J436-WM4-[4B-12]	REV: 0

76

零件编号	4B-13	零件数量	4	零件重量	30.9
零件编号	规格(mm)	长度(mm)	数量	重量(kg)	重量(kg)
M114	RHS120*80*6.3	1694	1	30.78	0.55
合计					30.78

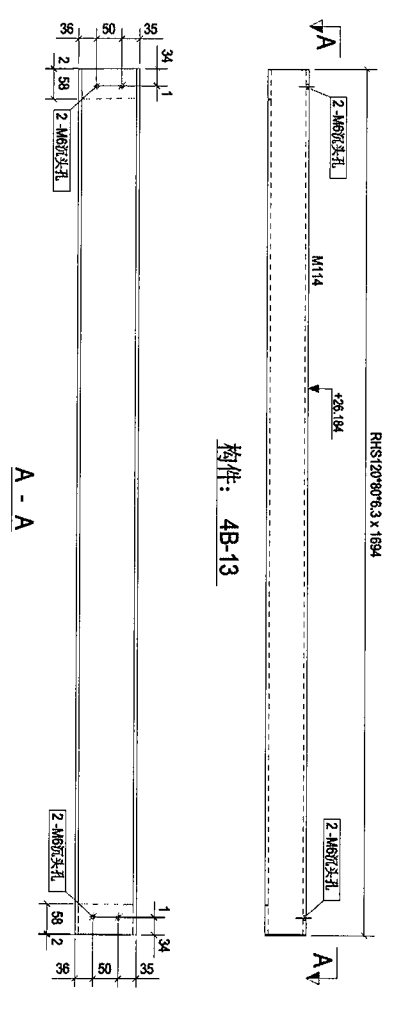

构件: 4B-13

Rev.	Description	Date
0	第一次报批	2018-05-30

PROJECT: PROPOSED SITE C1
DEVELOPMENT AT AREA 88,
TKO LUN R/F, TSEUNG KWAN O,
NEW TERRITORIES

CLIENT: 美特經貿有限公司
MIDI Aluminium Fabricator Ltd.
Units 6-8, Simoy Industrial Centre, 1/F
610 Cho Kuo Ling Road, Kowloon
Tel: 23498211-4 Fax: (852) 27272666


Silver Town Limited
Tel: 0758-8328468 Fax: 0758-4735534
E-MAIL: ADDRESS@silvertown.com.hk

DRAWING TITLE: WINDOW WALL (MW4)
[4B-13]


CAD File Name:	
Designed by:	
Drawn by:	
Reviewed by:	
Approved by:	
Scale:	
DWG NO.: J388-MW4-[4B-13]	REV: 0

77

零件编号	4B-14	零件数量	8	零件重量	31.1
零件编号	规格(mm)	长度(mm)	数量	重量(g)	重量(kg)
			合计	31.01	

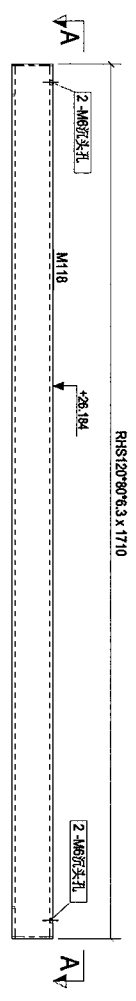

构件: 4B-14

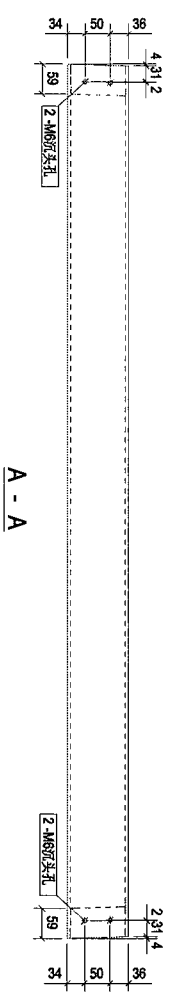

A - A

Rev.	Description	Date
0	第一次报批	2018-05-30

PROJECT: PROPOSED SITE C1 DEVELOPMENT AT AREA 86 TKOIT TO RP TSEUNG KWAN O, NEW TERRITORIES

CLIENT: 美特鋁有限公司
MIDI ALUMINIUM FABRICATOR LTD.
Units 6-8, Sunny Industrial Centre, 1/F
610 Cho Kwo Ling Road, Kowloon
Tel: 23489211-4, Fax: (852) 27272686


Silver Town Limited
Tel: 0769-8335468 Fax: 0769-8335954
E-MAIL: ADDRESS@SILVERTOWN.LICLTD

DRAWING TITLE : WINDOW-WALL (M118) [4B-14]

CAD File Name :	
Designed by	
Drawn by	
Reviewed by	
Approved by	
Scale	
DWG NO. : J436-M118- [4B-14]	
REV.	0

28

零件编号	规格(mm)	数量	重量(kg)	共重(kg)	备注
M125	RHS120*80*6.3	1	30.71	0.85	
合计			30.71		

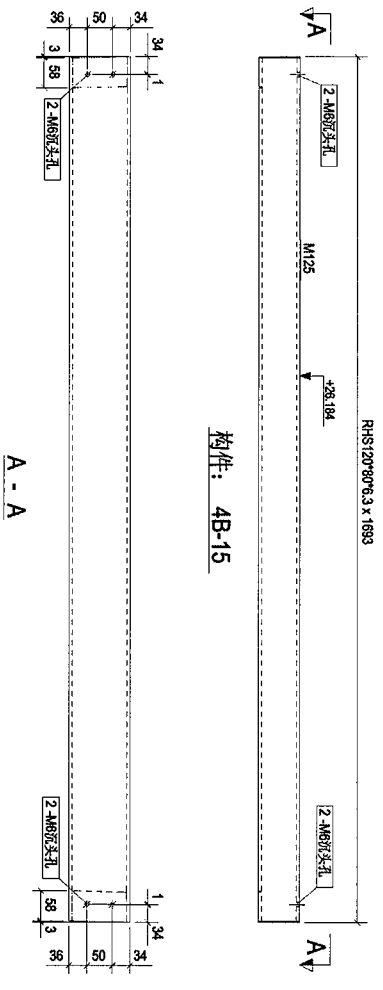

Rev.	Description	Date
0	第一次报批	2018-05-30

PROJECT:
 PROPOSED SITE C1
 DEVELOPMENT AT AREA 86,
 TROTT TO PE TSEUNG KWAN O,
 NEW TERRITORIES

CLIENT:
美特鋁質有限公司
MIDI ALUMINIUM FABRICATORS LTD.
 Units 6-8, Sunray Industrial Centre, 1/F
 610 Cho Kwong Road, Kowloon
 Tel: (852) 409211-4 Fax: (852) 27272666

銀同有限公司
Silver Town Limited
 Tel: 0759-8335468 Fax: 0759-8335554
 E-MAIL ADDRESS: silvertown@163.com

DRAWING TITLE :
WINDOW WALL (MM4)
[4B-15]

CAD File Name :


Designed by	
Drawn by	
Reviewed by	
Approved by	
Scale	

DWG NO.: JBS6-MMM- [4B-15]


REV.	0
------	---

7P

料号	规格	数量	单位	重量	共重	备注
M127	RHS120*90*6.3	1	个	30.84	0.85	
合计:				30.84		

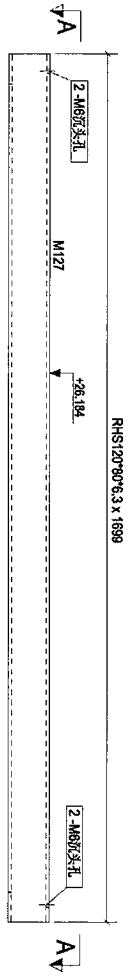

构件: 4B-16

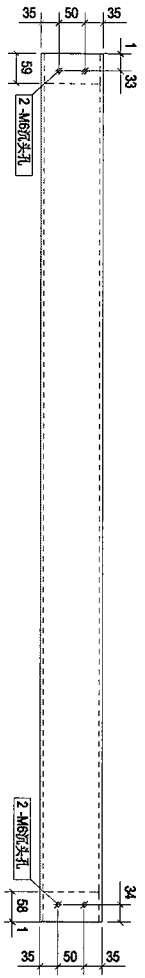

A - A

Rev.	Description	Date
0	第一次报批	2018-05-30

PROJECT:
 PROPOSED SITE C1
 DEVELOPMENT AT AREA 86,
 TKOIL TO PE TSEUNG KWAN O,
 NEW TERRITORIES

CLIENT:
美特铝质有限公司
 MIDT Aluminium Fabricators Ltd.
 Units 6-8, Sunny Industrial Centre, 1/F
 610 Chea Kwo Ling Road, Kowloon
 Tel: 23489211-4 Fax: (852) 27275665


CLIENT:
银同有限公司
 Silver Town Limited
 Tel: 0769-4334468 Fax: 0769-4335954
 E-MAIL: ADRES@silvertown.hk, I&I.COM

DRAWING TITLE:
 WINDOW WALL (W/M4)
[4B-16]

CAD File Name :	
Designed by	
Drawn by	
Reviewed by	
Approved by	
Scale	
DWG NO.:	J-836-W/M4-[4B-16]
REV:	0

Handwritten signature

物料编号	4C-1	物料数量	43	物料重量	159.3
物料编号	规格(mm)	长度(mm)	数量	单重(kg)	总重(kg)
M81	RHS150*100*12.5	3950	1	174.42	1.85
合计:				174.42	

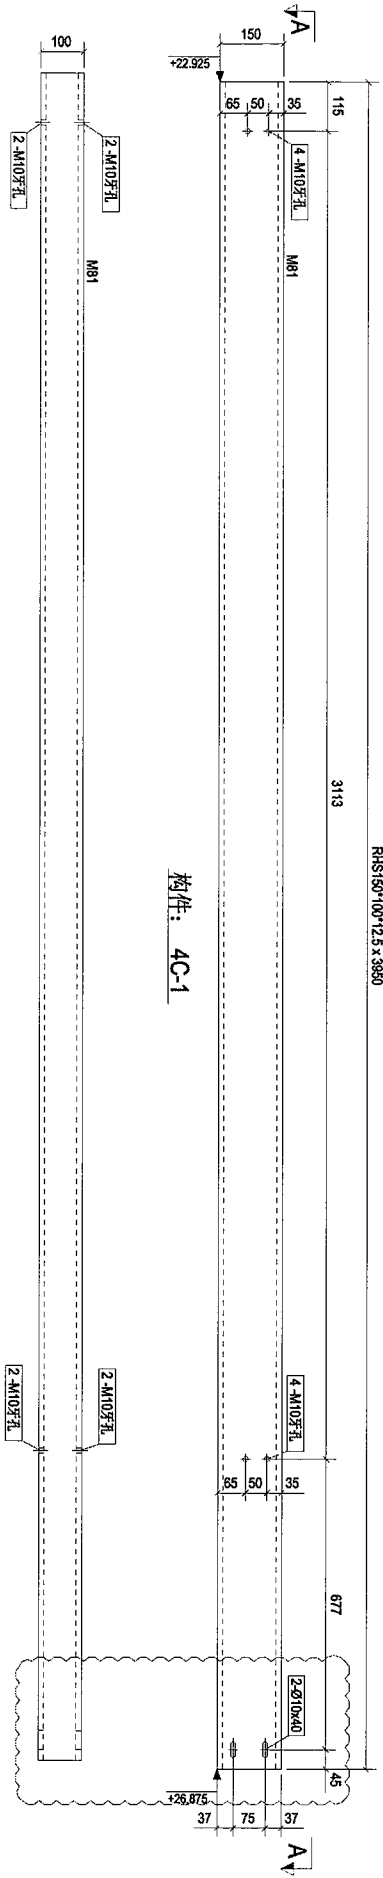

构件: 4C-1

A - A

Rev.	Description	Date
A	第2次报批	2018-06-06

PROJECT: PROPOSED SITE C1
DEVELOPMENT AT AREA 66
TKOJI TO RP TSEUNG KWAN O,
NEW TERRITORIES

CLIENT: 美特鋁質有限公司
MIDI ALUMINIUM PRODUCTS LTD.
Unit 5-8, Sanyo Industrial Centre, 1/F
610 Che Kwo Ling Road, Kwai Tsing
Tel: (852) 89211-4 Fax: (852) 27272666

Silver Town Limited
Tel: (8789) 8334668 Fax: (8789) 8335554
E-MAIL: ADDRESS@SILVERTOWN.HK.COM


DRAWING TITLE: WINDOW WALL (MM4)
[4C-1]

CAD File Name :	
Designed by	
Drawn by	
Reviewed by	
Approved by	
Scale	
DWG NO. : J838-MM4- [4C-1]	REV. A



87

料号	规格	数量	单位	重量	备注
M73	RSASA90°50°5	6	1	3.36	0.03


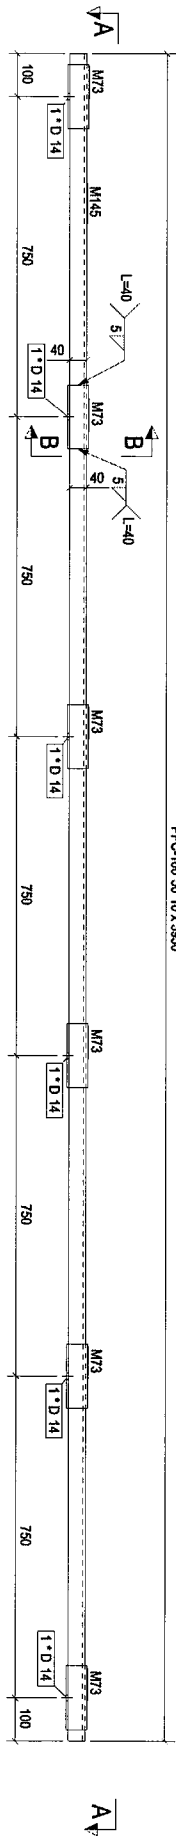

构件: 4C-2

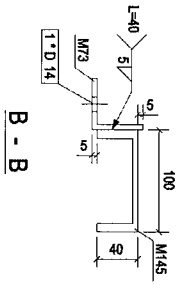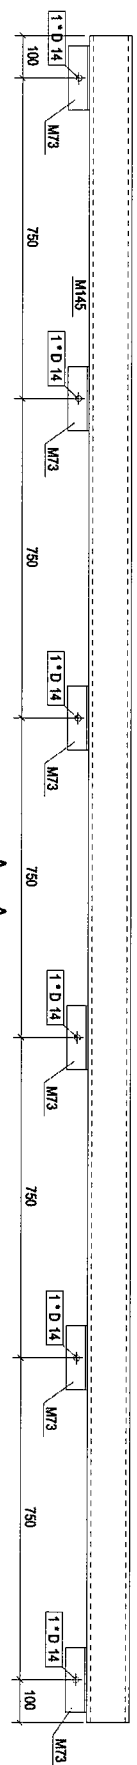

B - B

Rev.	Description	Date
0	第一次报批	2018-05-30

PROJECT: PROPOSED SITE C1
DEVELOPMENT AT AREA 08,
TKOT 70 RP TSEUNG KWAN O,
NEW TERRITORIES

CLIENT: 華特鋁業有限公司
MIDI Aluminium Fabrication Ltd.
Unit 6-4, Sunny Industrial Centre, 1/F
610 Chee Kwo Ling Road, Kowloon
Tel: (852) 4892111-4 Fax: (852) 27272666

Silver Town Limited
E-MAIL: ADRECS@silvertown.hk


DRAWING TITLE: WINDOW-WALL (MM4)
[4C-2]

CAD File Name :	
Designed by	
Drawn by	
Reviewed by	
Approved by	
Scale	

DWG NO: J836-MW4 [4C-2] REV 0

hr

物料编号	规格(mm)	物料数量	物料重量			
4C-3		1	189.3			
物料编号	规格(mm)	长度(mm)	数量	重量(kg)	长度(mm)	重量(kg)
M78	RHS150*100*12.5	3950	1	174	17442	1.85
合计:						17442

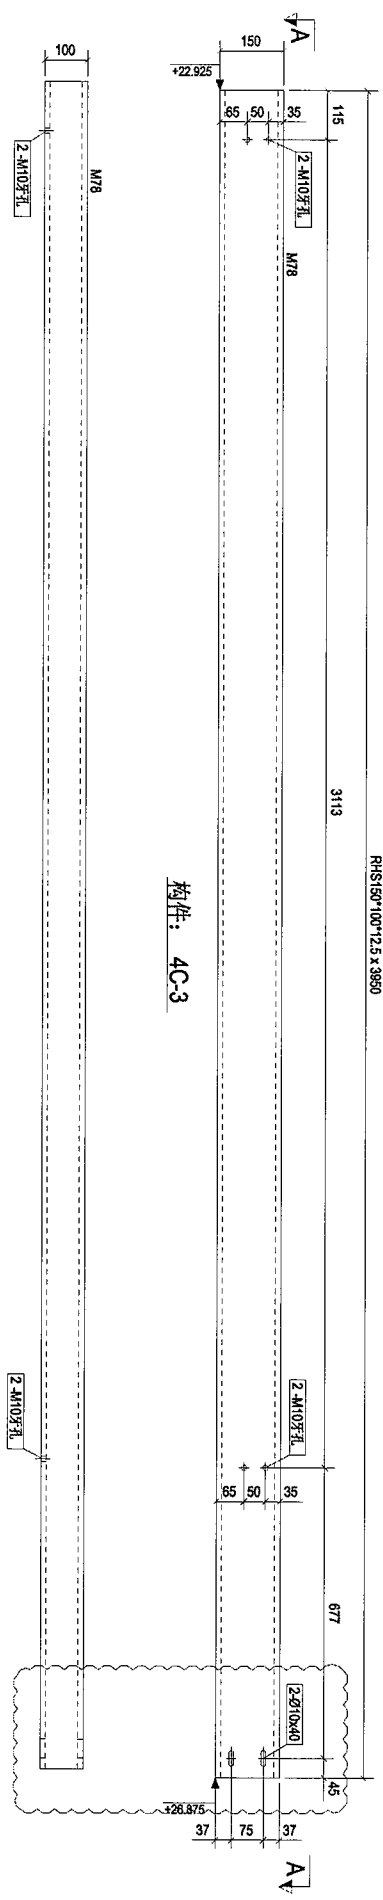

构件: 4C-3

A - A

Rev	Description	Date
A	第2次提批	2018-06-06

PROJECT: PROPOSED SITE C1
DEVELOPMENT AT AREA 88,
TKOJI 70/P, TSEUNG KWAN/O,
NEW TERRITORIES

CLIENT: 華特銀寶有限公司
MIDI AMUNOYA MANUFACTURE LTD.
Unit 6-8, Sunny Industrial Centre, 1/F,
610 Che Kwo Ling Road, Kowloon
Tel: (852) 4892111-4 Fax: (852) 27275666



DRAWING TITLE: WINDOW-WALL (MM4)
[4C-3]

Designated by	Drawn by	Reviewed by	Approved by	Scale

CAD File Name: WINDOW-WALL (MM4)
DWG NO.: J836-MM4 [4C-3]

83

料件编号	规格(mm)	料件数量	料件重量	1.5
F31	PLT440	40	0	0.00
M38	RSAN100756	180	1	1.43
合计				1.53

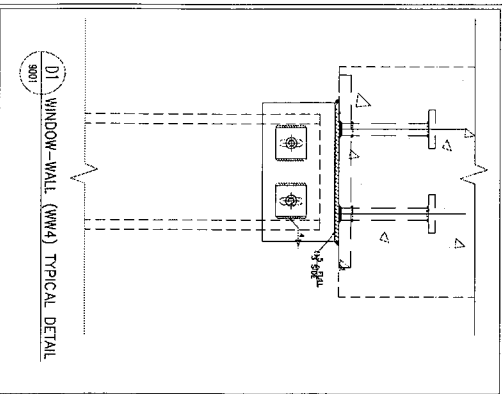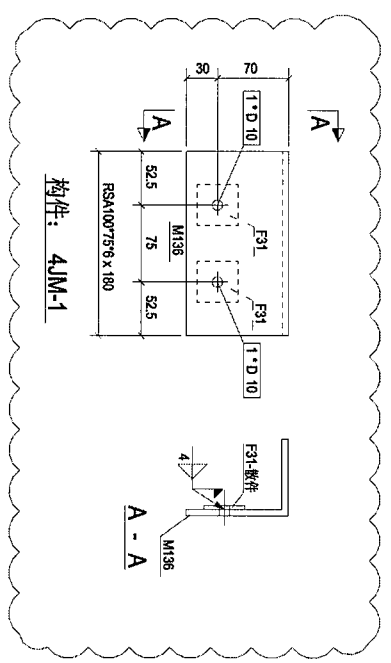

Rev.	Description	Date
A	初次报批	2018-06-06

PROJECT: PROPOSED SITE C1 DEVELOPMENT AT AREA 86, TROTT TO PE TSEUNG KWANNO, NEW TERRITORIES

CLIENT: 業特鋸寶有限公司
MIDI MANUFACTURING SYSTEMS LTD.
Unit 6-8, Sunny Industrial Centre, 1/F
610 Che Kwo Ling Road, Kowloon
Tel: (852) 4692111-4 Fax: (852) 27272666

Silver Town Limited
Tel: (852) 4354666 Fax: (852) 4339554
E-MAIL: ADDRESS@silvertown.ltd.hk



DRAWING TITLE: WINDOW-WALL (WM4)
[4JM-1]

CAD File Name :

DESIGNED BY	DRAWN BY	REVIEWED BY	APPROVED BY	SCALE	DWG NO.	REV.
					J-836-WM4- [4JM-1]	A

814

物料编号	规格	长度(m)	数量	重量(kg)	表面面积(m ²)
M141	RSAS0750*5	80	1	0	0.02
合计:				0.34	0.02

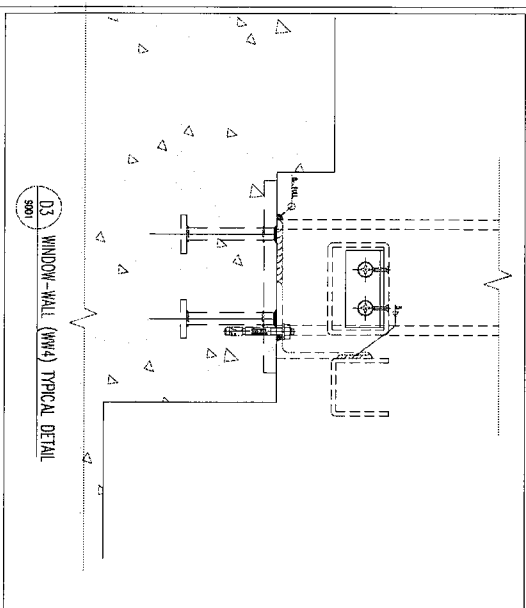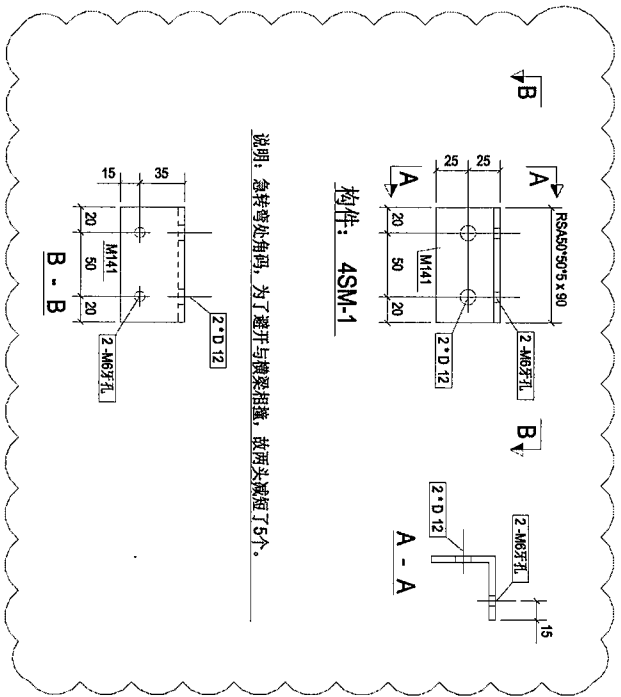

Rev.	Description	Date
A	第2次报批	2018-08-08

PROJECT: PROPOSED SITE C1 DEVELOPMENT AT AREA 88, TKOTI TO RP TSEING KWAN O, NEW TERRITORIES

CLIENT: 美特铝业有限公司
MIDI Aluminium Fabricators Ltd.
Units 6-8, Sunny Industrial Centre, 1/F
510 Cho Kwo Ling Road, Kowloon
Tel: 23389211-4 Fax: (852) 27272666



Silver Town Limited
Tel: 0793-8324668 Fax: 0793-8335954
E-MAIL: ADDRESS@SILVERTOWN.COM

DRAWING TITLE: WINDOW-WALL (W4) [4SM-1]

CAD File Name:	
Designed by:	
Drawn by:	
Reviewed by:	
Approved by:	
Scale:	
DWG NO.:	J436-WW4-[4SM-1]
REV:	A

87

零件编号	4SM-2	零件数量	148	材料重量	0.4
零件编号	规格(mm)	长度(mm)	数量	重量(kg)	表面积(m ²)
M74	RSAS0750'S	100	1	0	0.02
				0.37	
合计:				0.37	

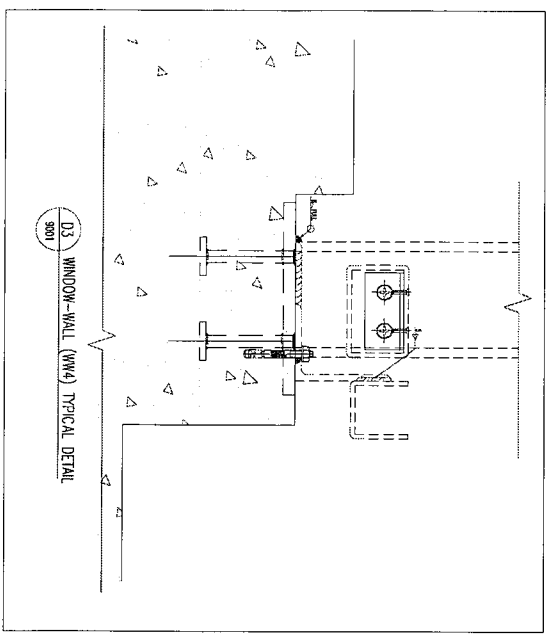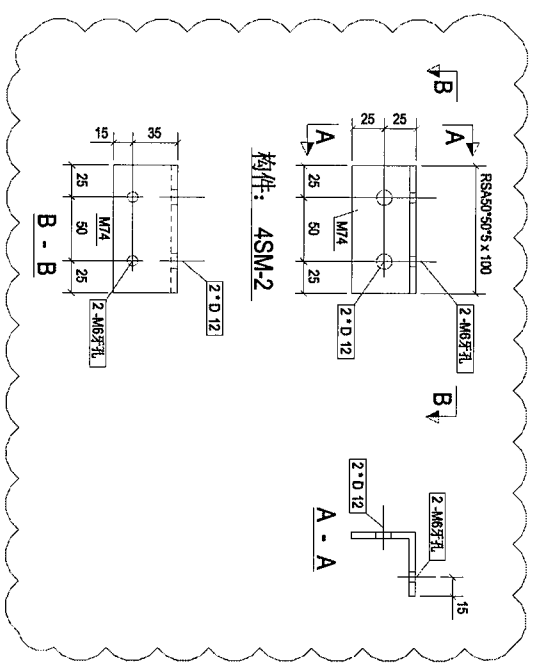

Rev.	Description	Date
A	第2次校核	2018-06-06

PROJECT: PROPOSED SITE C1
DEVELOPMENT AT AREA 86
TKOT1 TO RP TSEING KWAN O,
NEW TERRORIES

CLIENT: 美特銀寶有限公司
MIDI ADVANCING FABRICATOR LTD.
Units 6-8, Sanyo Industrial Centre, 1/F
610 Cho Kwo Ling Road, Kwai Tsan
Tel: 23489211-4 Fax: (852) 27272686


Silver Town Limited
Tel: 6709 4334/688 Fax: 0759-43359554
E-MAIL ADDRESS: sst@sktd.com.hk, ts.c.com

DRAWING TITLE: WINDOW-WALL (WM4)
[4SM-2]

CAD File Name:	
Designed by	
Drawn by	
Reviewed by	
Approved by	
Scale	
DWG NO.: JBS8-WM4-[4SM-2]	REV. A

86

M137	RSC75X75x6	1785	18	17.91	0.78
M140	RS4100758	230	3	7.24	0.09
		合计	25.14		

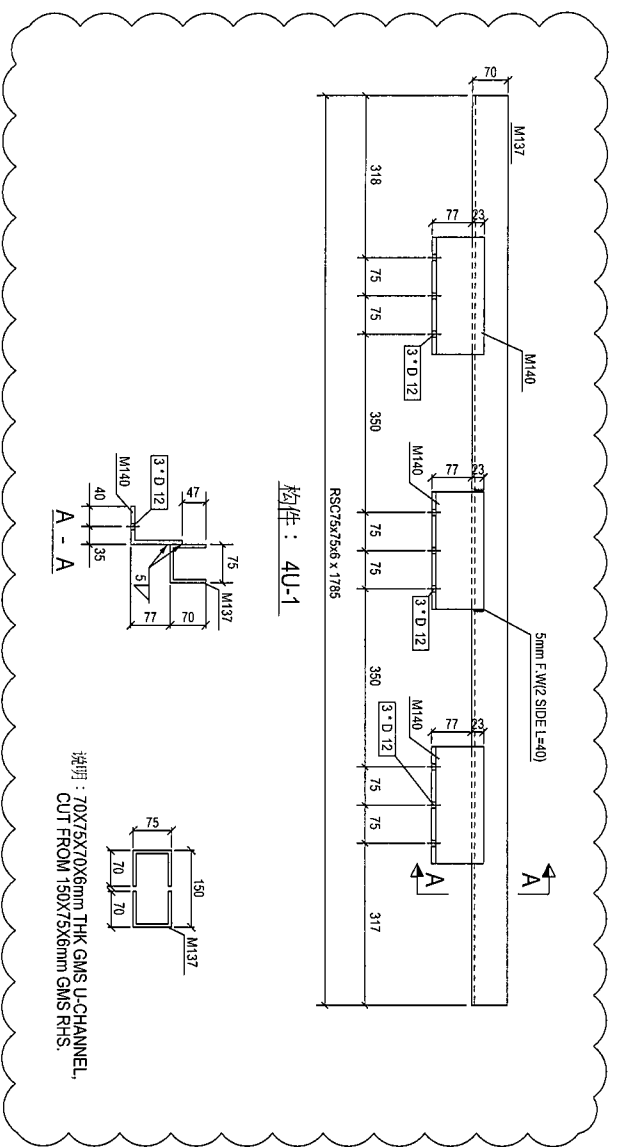

料件：4U-1

说明：70X75X70x6mm THK GMS U-CHANNEL,
CUT FROM 150X75X6mm GMS RHS.

A	第2次报推	2018-06-06
---	-------	------------

PROPOSED SITE C1
DEVELOPMENT AT AREA 86,
KOTU 70 RP, TSEUNG KWAN O,
NEW TERRITORIES

美特鋳實有限公司

銀同有限公司
Silver Town Limited

WINDO-WALL (MM4)
[4U-1]

Client Name:	
Drawn by:	
Checked by:	
Approved by:	
DWG NO.:	J-838-WW-4 [4U-1]

87