

工程指示 / 要求簡箋(E.I.)

工程指示編號：EI/ 9411 /18

修改版次： B

工程編號： J836

工程名稱： 日出康城7期平台

工程項目： WW4(N~RH)地盤用鐵料

收件人： Maggie Lor

發件人： Joe Chan

日期： 18/9/2018

要求提供 / 確認 事項：

- ( ) 初步鋁料 B.M.                      ( ) 加工拆圖，然後生產                      ( ) 尺寸表
- ( ) 正式鋁料 B.M.                      ( ) 技術上資料 / 指示                      ( ) 報價
- ( ) 配件 B.M.                              ( ) 樣辦或貨品說明書                      ( ) 分判合約
- ( ) 其他： \_\_\_\_\_

內容：

請依附件資料，在鐵件開孔

(原大圖有孔位，拆圖拆漏)

請在 30/9/2018 前完成上列要求。

附有關圖紙 / 文件：

7頁

以上項目為：

- 原合約工程包                       原合約工程加 / 減賬                       新工程報價

原因：-

分發東莞各部門：

- ( )生產技術總監 連附件    ( )技術部    連附件    ( )生產部    連附件    ( )機械設計部 連附件
- ( )採購部    連附件    ( )生產統籌部 連附件
- ( )質檢部    連附件    ( )會計部    連附件    ( )報關組    連附件    ( )其他 \_\_\_\_\_ 連附件

分發香港各部門：

- ( )行政部 連附件    ( )會計部 連附件    ( )統籌部 連附件    ( )工程部地盤科文 連附件
- ( )採購部 連附件    ( )QS 部 連附件    ( )維修部 連附件    ( )其他 \_\_\_\_\_ 連附件




積哥, 豪哥, 寧

傳遞編號：

發件人簽署：

項目經理簽署：

零件编号	规格(mm)	数量	单位	重量(kg)	共重(kg)	表面积(m <sup>2</sup> )
M79	RHS150*100*12.5	3950	174	174.42	185	
合计:				174.42		

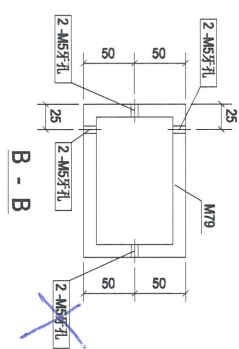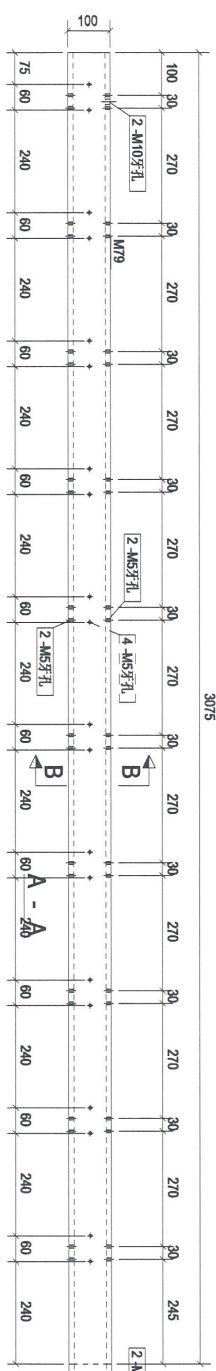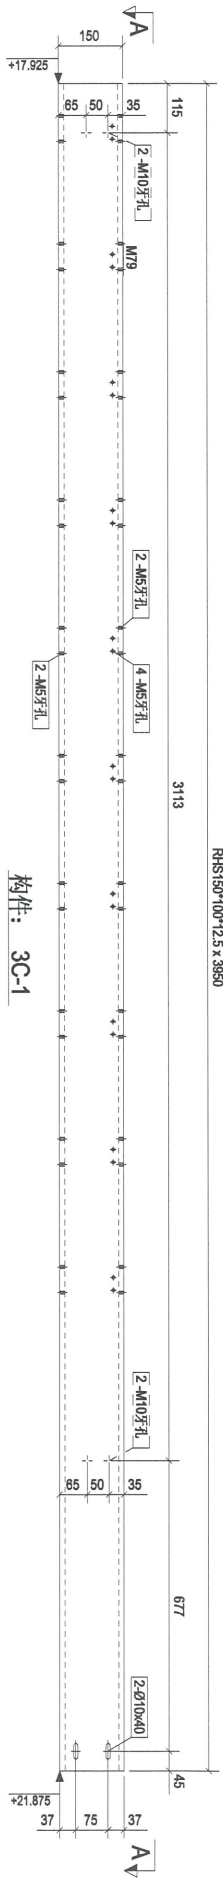

此端不用开孔

Rev.	Description	Date
B	第3次提批	2018-09-17

PROJECT: PROPOSED SITE C1 DEVELOPMENT AT AREA 88, TKOIL TO RP, TSEUNG KWAN O, NEW TERRITORIES

CLIENT: 美特铝业有限公司  
MIDI ALUMINIUM FABRICATOR LTD.  
Units 5-8, Sunny Industrial Centre, 1/F  
610 Sha Kuo Ling Road, Kowloon  
Tel: (23) 989211-4 Fax: (852) 27721686




Silver Town Limited  
Tel: 0769-83354988 Fax: 0769-83359594  
E-MAIL: ADDRESS@silvertown.com.hk

DRAWING TITLE: WINDOW-WALL (MMW4)  
[3C-1]

CAD File Name :	
Designed by	
Drawn by	
Reviewed by	
Approved by	
Scale	
DWG NO. : J-836-MW4- [3C-1]	R/V
	B

构件编号	规格(mm)	长度(m)	数量	单重(kg)	重量(kg)	表面面积(m <sup>2</sup> )
M80	RHS150*100*12.5	3807	1	159	159.27	1.89
合计:					159.27	

RHS150\*100\*12.5\*3807

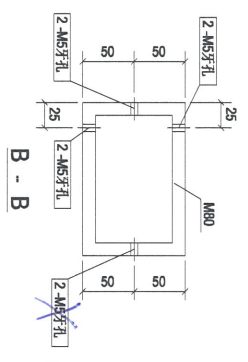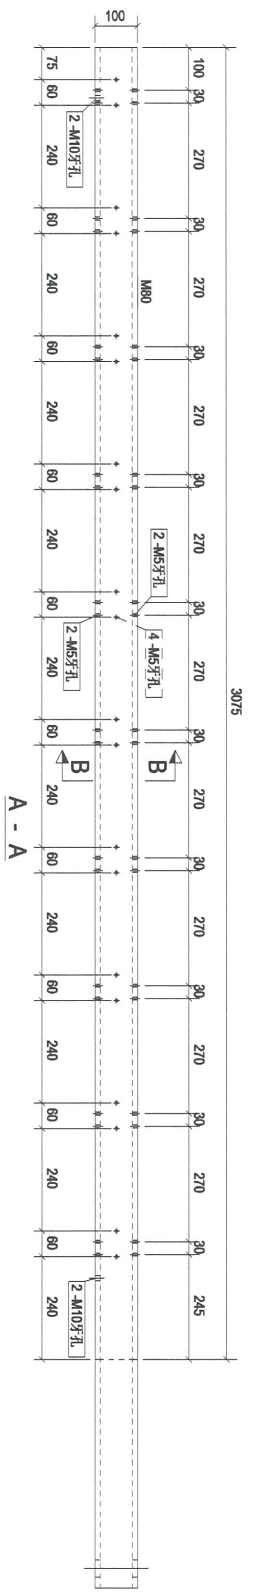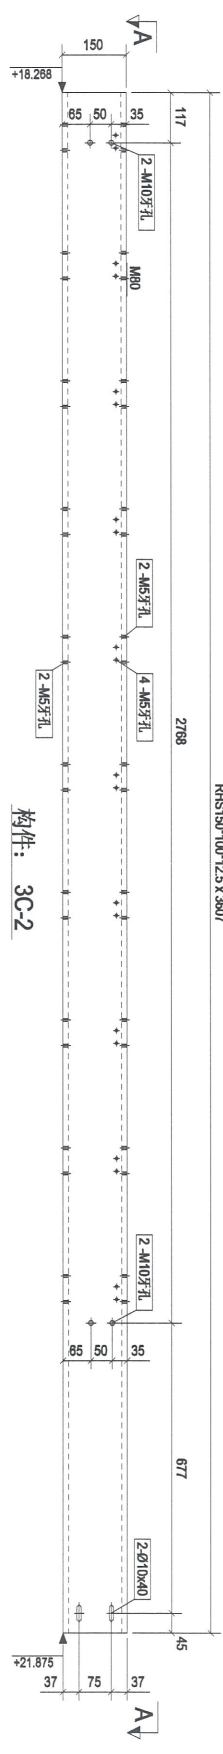

此端不用开孔

Rev.	Description	Date
B	第3次报批	2018-09-17

PROJECT: PROPOSED SITE C1 DEVELOPMENT AT AREA 88, TKOIL TO RP, TSEUNG KWAN O, NEW TERRITORIES


CLIENT: 美特铝业有限公司  
MIDI Aluminium Fabricator Ltd.  
Units 6-8, Sunny Industrial Centre, 1/F  
610 Chee Kwo Ling Road, Kwailoon  
Tel: (23)982111-4 Fax: (852)27272866

银同有限公司  
Silver Town Limited  
Tel: (77)69-8335968 Fax: (77)69-8335954  
E-MAIL: ADDRESS@silvertown.com.hk


DRAWING TITLE: WINDOW WALL (MM4)  
[3C-2]




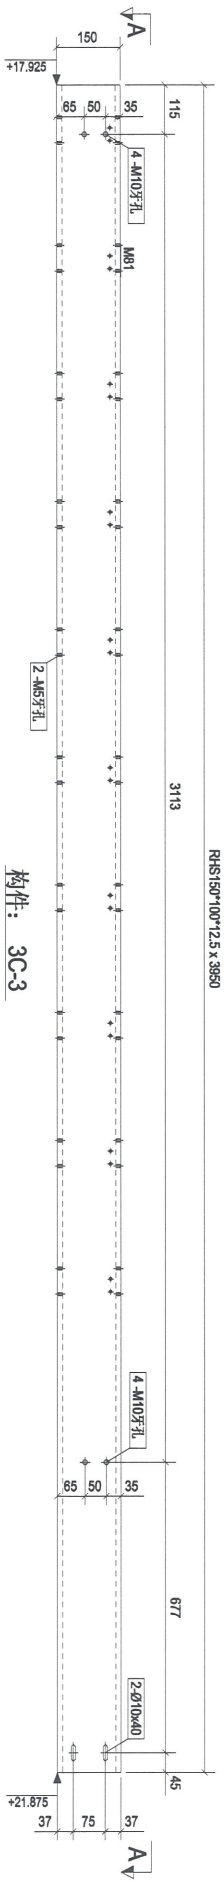

构件: 3C-3

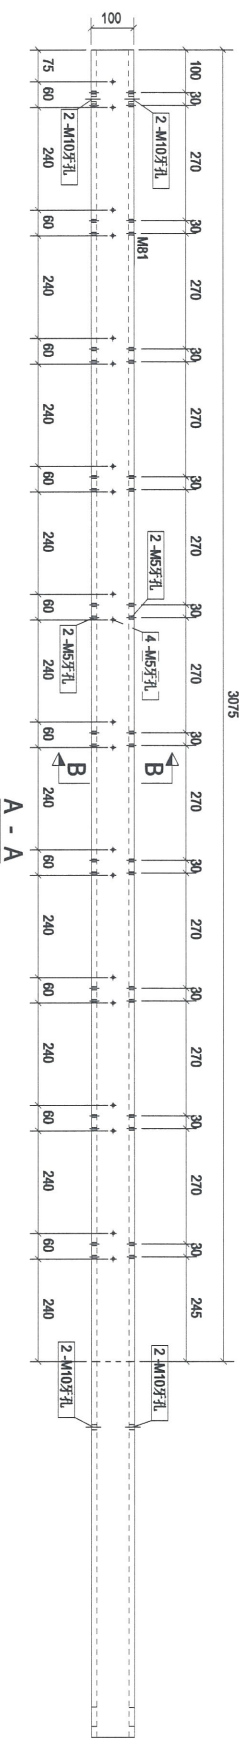

A - A

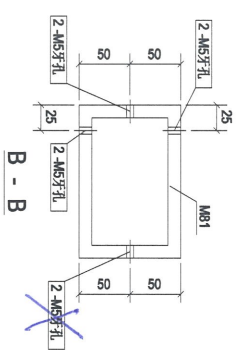

B - B

此端不用开孔

Rev.	Description	Date
B	第3次报批	2018-09-17

PROJECT: PROPOSED SITE C1 DEVELOPMENT AT AREA 88, TKOIL TO RP TSEING KWAN O, NEW TERRORIES




CLIENT: 美特鋁質有限公司  
MIDI ALUMINUM FABRICATOR LTD.  
Units 6-8, Sunny Industrial Centre, 1/F  
610 Chee Kwo Ling Road, Kowloon  
Tel: 23489211-4 Fax: (852) 27278566  
E-MAIL ADDRESS: sales@midiltd.com

银同有限公司  
Silver Town Limited  
Tel: 0759-8335988 Fax: 0759-8335954  
E-MAIL ADDRESS: sales@stltd.com

DRAWING TITLE: WINDOW-WALL (MW4) [3C-3]

CAD File Name:	
Designed by	
Drawn by	
Reviewed by	
Approved by	
Scale	
DWG NO.: J436-MW4-[3C-3]	REV: B

构件编号:	3C-4	构件数量:	1	构件重量:	169.3
零件编号	规格(mm)	长度(mm)	数量	重量(kg)	表面面积(m <sup>2</sup> )
M82	RHS150*100*12.5	3950	1	174.42	1.85
合计:				174.42	

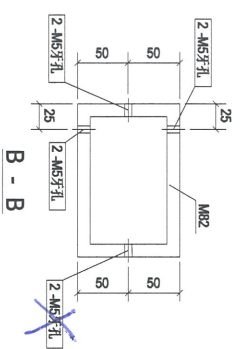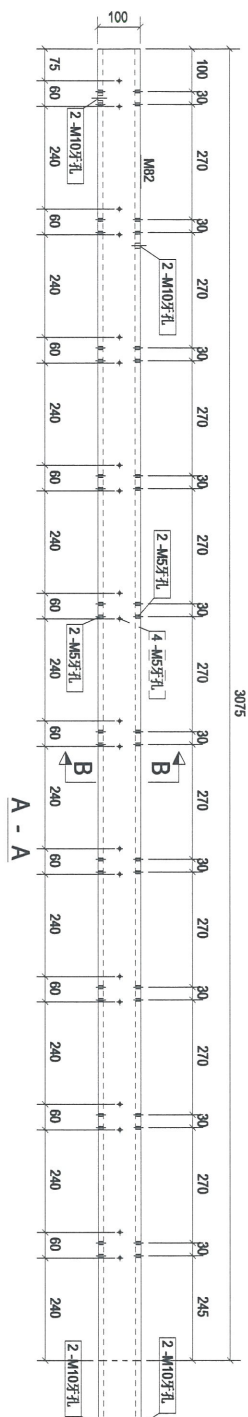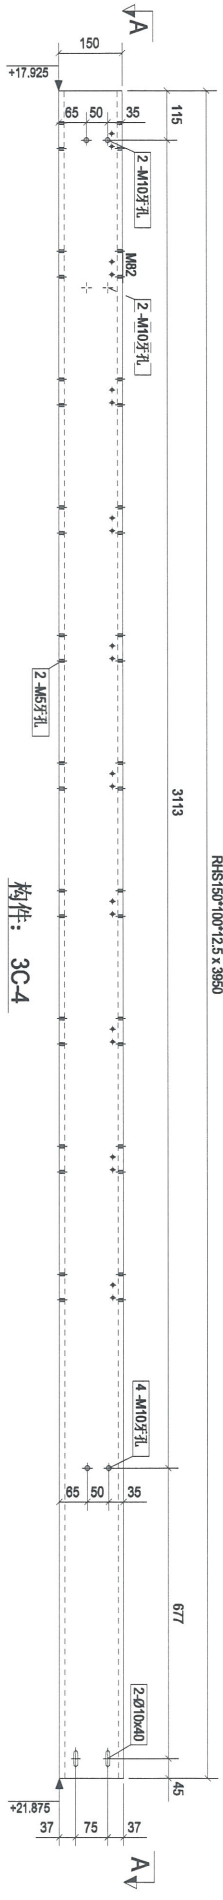

此端不用开孔

Rev.	Description	Date
B	第3次报批	2018-09-17

PROJECT: PROPOSED SITE C1 DEVELOPMENT AT AREA 88, TKOIT TO RP TSEUNG KWAN O, NEW TERRITORIES

CLIENT: 美特铝业有限公司  
MIDI Aluminium Fabricator Ltd.  
Units 6-8, Sunny Industrial Centre, 1/F  
510 Chee Kwo Ling Road, Kwun Tong  
Tel: 23892111-4 Fax: (852) 27272686



银同有限公司  
Silver Town Limited  
Tel: 0769-8333968 Fax: 0769-8333954  
E-MAIL ADDRESS: sgpl@stwp.163.com

DRAWING TITLE: WINDOW WALL (MW4)  
[3C-4]

Scale	
Approved by	
Reviewed by	
Drawn by	
Designed by	
CAD File Name:	
DWGNO.:	J-835-MW4 [3C-4]
	REV. B

零件编号:	3C-5	零件数量:	29	零件重量:	154.8
零件编号	规格(mm)	长度(mm)	数量	单重(kg)	共重(kg)
M83	RHS150*100*12.5	3807	1	159	159
				159.27	1.89
			合计:	159.27	

RHS150\*100\*12.5 x 3807

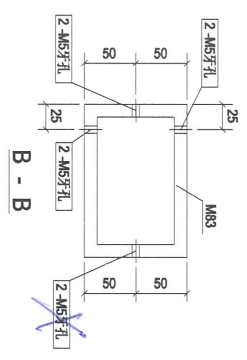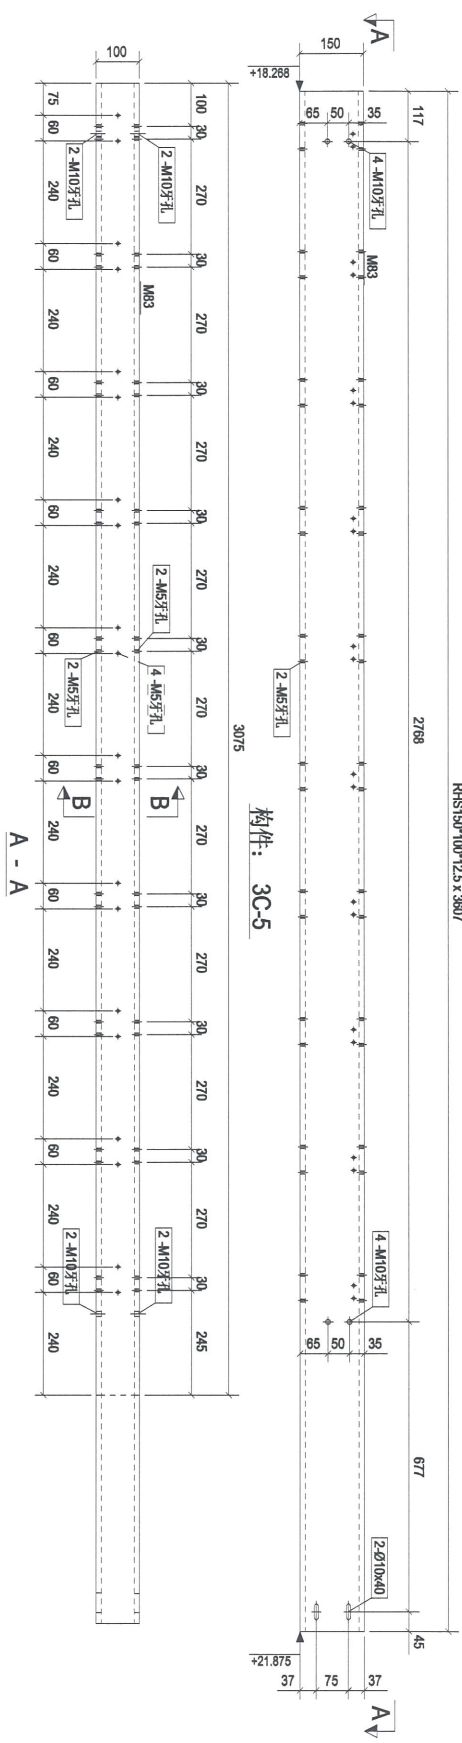

Rev.	Description	Date
B	第3次报批	2018-09-17

PROJECT: PROPOSED SITE C1 DEVELOPMENT AT AREA 88, TKOTI, 70 RP, TSEUNG KWAN O, NEW TERRITORIES



CLIENT: 美特 钰 有限公司  
Units 6-8, Sunny Industrial Centre, 1/F  
810 Chee Kwo Tong Road, Kwailoon  
Tel: (852) 27727866 Fax: (852) 27727866

Silver Town Limited  
Tel: 0769-8333968 Fax: 0769-8333954  
E-MAIL: ADDRESS@silvertown.com.hk

DRAWING TITLE: WINDOW WALL (MW4)  
[3C-5]

Scale	
Approved by	
Reviewed by	
Drawn by	
Designed by	
CAD File Name:	
DWG NO.:	J-838-MW4- [3C-5]
	R/V
	B

构件编号:	4C-1	构件数量:	43	构件重量:	169.3
零件编号	规格(mm)	长度(mm)	数量	重量(kg)	表面面积(m <sup>2</sup> )
合计:				174.42	

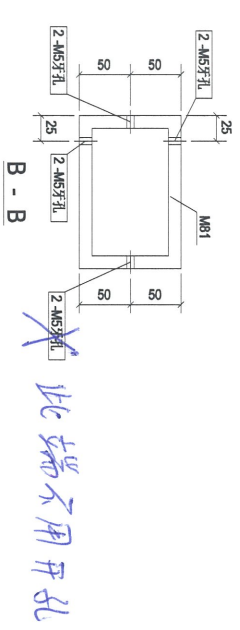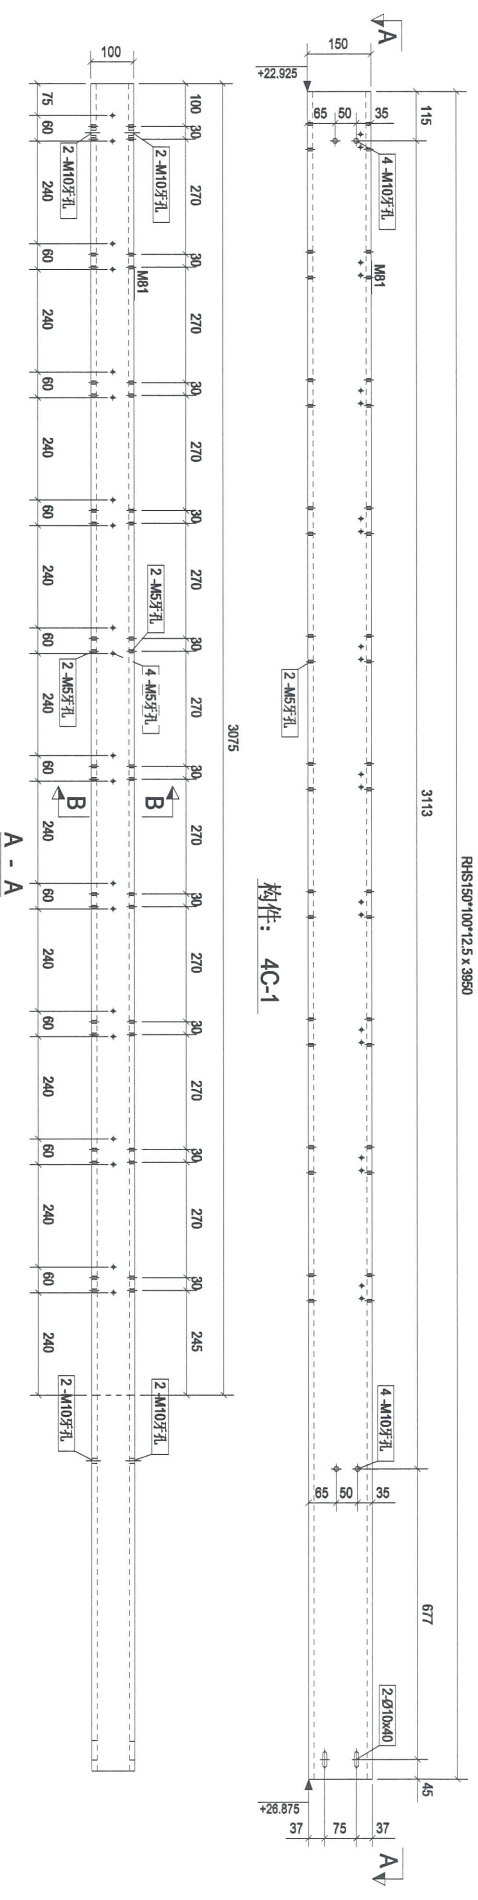

Rev.	Description	Date
B	第3次提批	2018-09-17

PROJECT: PROPOSED SITE C1  
DEVELOPMENT AT AREA 86,  
TKOIL TO RP TSEUNG KWAN O,  
NEW TERRITORIES

CLIENT: 美特鋁質有限公司  
MIDI Aluminium Fabrication Ltd.  
Units 8 & 9, Sunny Industrial Centre, 1/F  
50 Cheong Cheong Road, Kwai Chung, N.T.  
Tel: 23489211 - Fax: (852) 27272866

銀同有限公司  
Silver Town Limited  
Tel: 0789-8333988 Fax: 0789-8333954  
E-MAIL: ADDRESS@silvertown.com.hk

DRAWING TITLE: WINDOW-WALL (MW4)  
[4C-1]

CAD File Name:

Designed by

Drawn by

Reviewed by



Approved by

Scale

DWG NO.: J-836-MW4 [4C-1] R/V B

构件编号:	4C-3	构件数量:	1	构件重量:	169.3
编号	规格(mm)	长度(mm)	数量	单重(kg)	共重(kg)
M78	RHS150*100*12.5	3950	1	174.42	1.85
合计:					174.42

RHS150\*100\*12.5 x 3950

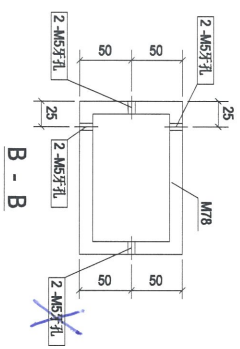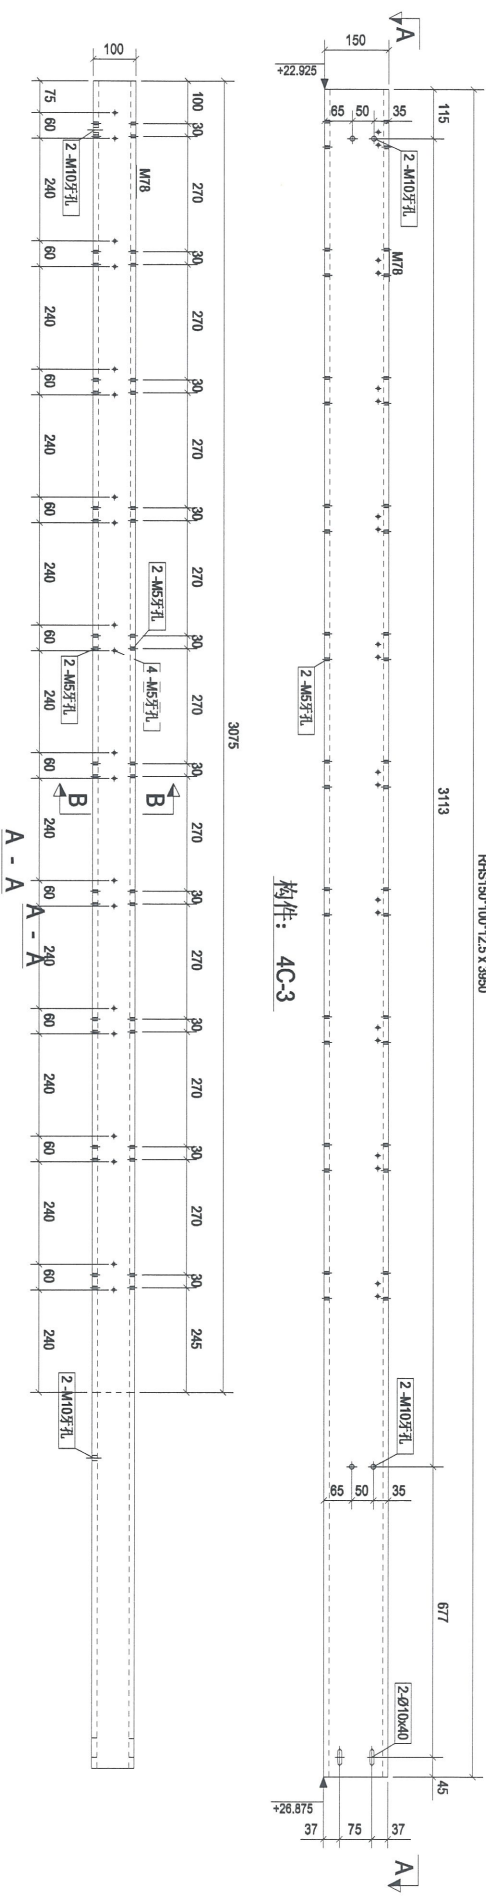

此端不用开孔

Rev.	Description	Date
B	第3次批	2018-08-17

PROJECT: PROPOSED SITE C1 DEVELOPMENT AT AREA 88, TKOT1 TO RP, TSEUNG KWAN O, NEW TERRITORIES

CLIENT: 美特铝业有限公司  
MIDT ALUMINIUM FABRICATOR LTD.  
Units 6-8, Sunray Industrial Centre, 1/F  
670 Chin Kwo Long Road, Kowloon  
Tel: 23469211-4 Fax: (852) 27272686

Silver Town Limited  
Tel: 0778-83354968 Fax: 0769-83359854  
E-Mail: 4008253@silvertown.com.hk

DRAWING TITLE: WINDOW WALL (MW4) [4C-3]

CAD File Name:	
Designed by	
Drawn by	
Reviewed by	
Approved by	
Scale	
DWG NO.: J-438-MW4 [4C-3]	R/V: B