

工程指示 / 要求簡箋(E.I.)

工程指示編號：EI/ 9496 /18 修改版次：A
 工程編號：JB36 工程名稱：日出麗城二期平台
 工程項目：WW4 (A~N) 地盤用鋁件修改。
 收件人：Maggie Lor 發件人：李權鵬 日期：2018/8/23

要求提供 / 確認 事項：

- | | | |
|------------------------------------|-------------------------------------|-------------------------------|
| <input type="checkbox"/> 初步鋁料 B.M. | <input type="checkbox"/> 加工拆圖，然後生產 | <input type="checkbox"/> 尺寸表 |
| <input type="checkbox"/> 正式鋁料 B.M. | <input type="checkbox"/> 技術上資料 / 指示 | <input type="checkbox"/> 報價 |
| <input type="checkbox"/> 配件 B.M. | <input type="checkbox"/> 樣辦或貨品說明書 | <input type="checkbox"/> 分判合約 |
| <input type="checkbox"/> 其他：_____ | | |

內容：

現確認附件內鋁件長度修正，煩請安排更正。

(因先前拆圖與施工圖不對，
是次修改沒有額外加工費用)

請在 2018/9/7 前完成上列要求。

附有關圖紙 / 文件：

58張

以上項目為：

- 原合約工程包 原合約工程加 / 減賬 新工程報價

原因：-

分發東莞各部門：

- () 生產技術總監 連附件 () 技術部 連附件 () 生產部 連附件 () 機械設計部 連附件
 () 採購部 連附件 () 生產統籌部 連附件
 () 質檢部 連附件 () 會計部 連附件 () 報關組 連附件 () 其他 _____ 連附件

分發香港各部門：


- () 行政部 連附件 () 會計部 連附件 () 統籌部 連附件 (/) 工程部地盤科文 連附件 豪
 () 採購部 連附件 () QS 部 連附件 () 維修部 連附件 () 其他 _____ 連附件

傳遞編號：


發件人簽署：

項目經理簽署：

零件编号: 2HL-3		零件数量: 4		零件重量: 33.51	
零件编号	长度(mm)	重量	单重(kg)	长度(mm)	表面积(m ²)
M289	PL550	1	2.89	1306	0.17
M447	RHS150756.0	1	30.53	1406	0.27
合计:					33.51

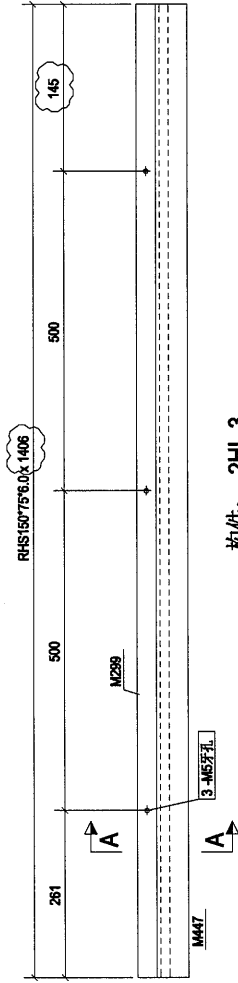

构件: 2HL-3

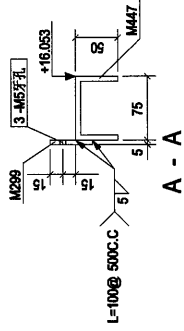

Rev	第2次深批	2018-08-22	Date
A	Description		

PROJECT: PROPOSED SITE C1
DEVELOPMENT AT AREA B8
TROTTOIR, TSEUNG KWAN O,
NEW TERRITORIES

CLIENT: 美特鋁質有限公司
MIDI ALUMINIUM FABRICATOR LTD.
Units 6-8, Sunny Industrial Centre, 1/F
610 Cho Mwo Ling Road, Kwloon
Tel: 23489211-4 Fax: (852) 7727686


銀同有限公司
Silver Town Limited
Tel: 0769-8335498 Fax: 0769-8335954
E-MAIL ADDRESS: sgpa@sp.163.COM

DRAWING TITLE :
[2HL-3]


CAD File Name :	
Designed by	
Drawn by	
Reviewed by	
Approved by	
Scale	

DWG NO.:	REV.
(WWW)2 - [2HL-3]	A

零件编号	2HL-4	零件数量	1	零件重量	33.62
零件编号	长度(mm)	数量	重量(kg)	共重(kg)	深重(km)
M504	PL5*50	1	3.00	3.00	0.17
M543	RHS150*75*6.0	1	30.62	30.62	0.27
合计:				33.62	

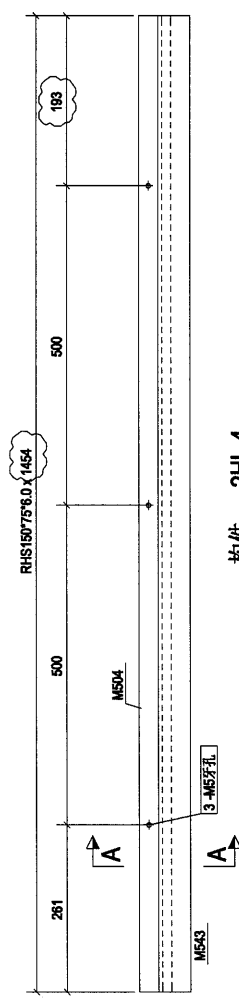


构件: 2HL-4

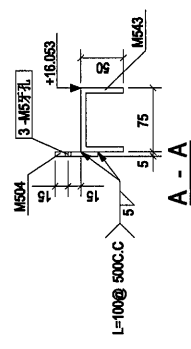


A	第2次提批	2018-08-22
Rev.	Description	Date
PROJECT: PROPOSED SITE C1 DEVELOPMENT AT AREA B8 TROTT ROAD, TSEUNG KWAN O, NEW TERRITORIES		
CLIENT: 美特鋁質有限公司 MIDI ALUMINIUM FABRICATOR LTD. Units 6-8, Sunny Industrial Centre, 1/F 610 Cho Kwo Ling Road, Kowloon Tel: 23489211-4 Fax: (852) 7727686		
S 銀同有限公司 Silver Town Limited Tel: 0769-8335488 Fax: 0769-8339854 E-MAIL ADDRESS: sjg@silvertown.com.hk		
DRAWING TITLE: [2HL-4]		
CAD File Name:		
Designed by		
Drawn by		
Reviewed by		
Approved by		
Scale		
DWG NO: (WW4)2 - [2HL-4]		REV. A

零件编号	3HL-47	零件数量	1	零件重量	33.19
零件编号	长度(mm)	数量	重量(kg)	长度(mm)	重量(kg)
M294	PL5*50	1	2.96	1400	0.17
M428	RHS150*75*6.0	1	30.23	1400	0.27
合计:				33.19	

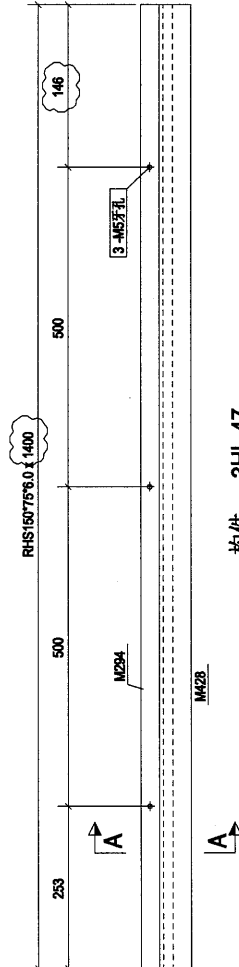


构件: 3HL-47

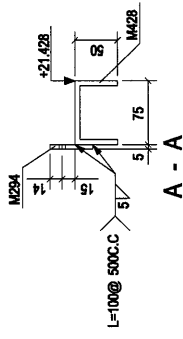


A	第2次探批	2018-08-22
Rev.	Description	Date
PROJECT: PROPOSED SITE C1 DEVELOPMENT AT AREA B8, TKO TI TO, TSEUNG KWAN O, NEW TERRITORIES		
CLIENT: 美特鋁質有限公司 MIDI ALUMINIUM ASSOCIATES LTD. Units 5-8, Sunray Industrial Centre, 1/F 610 Cho Kwo Ling Road, Kowloon Tel: 22489211-4 Fax: (852) 2727686		
S 銀同有限公司 Silver Town Limited Tel: 0769-8335488 Fax: 0769-8335954 E-MAIL ADDRESS: sg@silvertown.com.hk		
DRAWING TITLE: [3HL-47]		
CAD File Name :		
Designed by		
Drawn by		
Reviewed by		
Approved by		
Scale		
DWG NO: (WW4)2 - [3HL-47]		REV. A

构件编号: 3HL-49		构件数量: 1		构件重量: 27.97	
零件编号	长度(mm)	数量	重量(kg)	长度(mm)	重量(kg)
M296	PL5F50	1	2.49	2.49	0.14
M433	RHS150*75*6.0	1	25.48	25.48	0.22
		合计:		27.97	

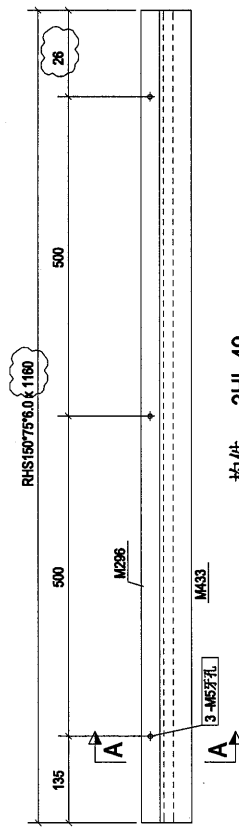

构件: 3HL-49

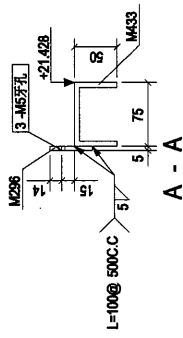

Rev.	Description	Date
A	第2次深批	2018-08-22

PROJECT: PROPOSED SITE C1
DEVELOPMENT AT AREA 08
TKOITI TO P. TSEUNG KWAN O,
NEW TERRITORIES

CLIENT: 美特鋁質有限公司
MIDI ALUMINIUM FABRICATOR LTD.
Units 6-8, Sunray Industrial Centre, 1/F
610 Cho Kwo Ling Road, Kowloon
Tel: 23489211-4 Fax: (852) 27272686

銀同有限公司
Silver Town Limited
Tel: 0769-83354868 Fax: 0769-83359554
E-MAIL ADDRESS: spt@silvertown.com.hk


DRAWING TITLE: [3HL-49]

CAD File Name:


Designed by
Drawn by
Reviewed by
Approved by
Scale

DWG NO: (MM)A/2 - [3HL-49] REV. A

制作编号: 3HL-50		构件数量: 1		构件重量: 30.80	
制作编号	规格(mm)	数量	重量(kg)	长度(mm)	截面面积(cm ²)
M297	PL5*50	1	2.74	2.74	0.15
M438	RHS150*75*6.0	1	28.06	28.06	0.25
合计:					30.80

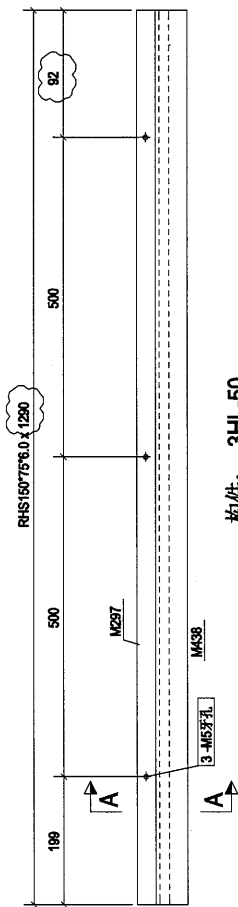


构件: 3HL-50

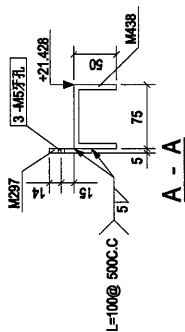



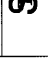
A	第2次校核	2018-08-22
Rev.	Description	Date
PROJECT: PROPOSED SITE C1 DEVELOPMENT AT AREA B8 TKO TI TO RP, TSEUNG KWAN O, NEW TERRITORIES		
CLIENT: 美特鋁質有限公司 MIDDI ALUMINIUM MANUFACTURE LTD. Units 6-8, Sunray Industrial Centre, 1/F 610 Chu Kwo Ling Road, Kwunboon Tel:23489211-4 Fax:(852)27272666		
S 銀同有限公司 Silver Town Limited Tel:0769-83354868 Fax:0769-83359554 E-MAIL: ADDRESS@silvertown.com.hk		
DRAWING TITLE: [3HL-50]		
CAD File Name:		
Designed by		
Drawn by		
Reviewed by		
Approved by		
Scale		
DWG NO: (MM4)2 - [3HL-50]		REV. A

零件编号:	3HL-51	零件数量:	1	零件重量:	28.82
				合计:	28.82

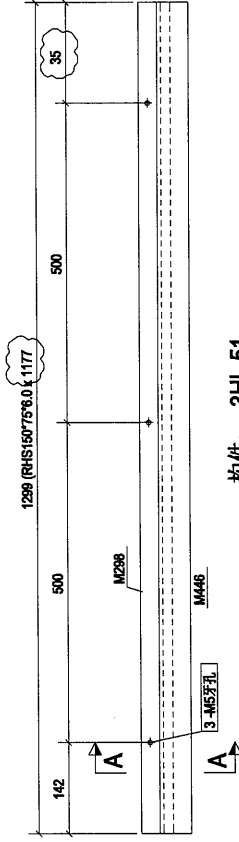


构件: 3HL-51

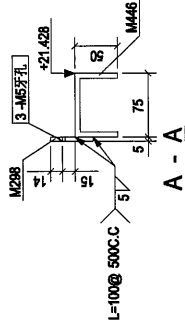


Rev.	第2次提批	Date	2018-08-22
PROJECT:	PROPOSED SITE C1 DEVELOPMENT AT AREA B5, TKOTI TO RP, TSEUNG KWAN O, NEW TERRITORIES		
CLIENT:	 美特鋁質有限公司 MIDTI ALUMINIUM FABRICATOR LTD. Units 6-8, Sunny Industrial Centre, 7/F 610 Chee Kwo Ling Road, Kwun Tong Tel: 2349211-4 Fax: (852) 27271656		
	 銀同有限公司 Silver Town Limited Tel: 0769-8335988 Fax: 0769-8335954 E-MAIL: ADDRESS@silvertown.com.hk		
DRAWING TITLE :	[3HL-51]		
CAO File Name :			
Designed by			
Drawn by			
Reviewed by			
Approved by			
Scale			
DWG NO.:	(MM4)-2 - [3HL-51]		
REV.	A		

制作编号: 3HL-52		构件数量: 1		构件重量: 14.78	
零件编号	规格(mm)	数量	单重(kg)	共重(kg)	截面系数
M300	PL5*50	1	1.32	1.32	0.07
M445	RHS150*75*8.0	1	13.47	13.47	0.12
合计:				14.78	

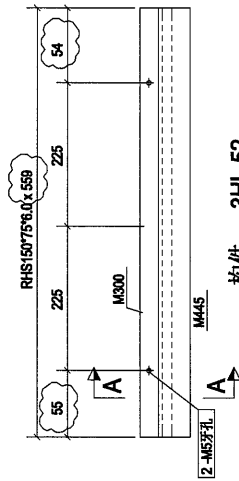

构件: 3HL-52

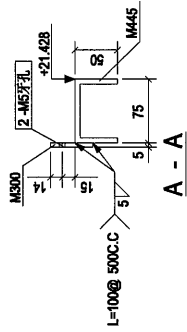

A	第2次报批	2018-08-22
Rev.	Description	Date

PROJECT: PROPOSED SITE C1
DEVELOPMENT AT AREA B6
TKOHL TO RP, TSEUNG KWAN O,
NEW TERRITORIES

CLIENT: 美特铝质有限公司
MIDI ALUMINIUM MANUFACTURING LTD.
Units 5-6, Sunny Industrial Centre, 1/F
610 Che Kwo Ling Road, Kwailoon
Tel: 2489211-4 Fax: (852) 27272656


S 银同有限公司
Silver Town Limited
Tel: 0769-8335488 Fax: 0769-8335954
E-MAIL: ADDRESS@silvertown.hk

DRAWING TITLE :
[3HL-52]


CAD File Name :	
Designed by	
Drawn by	
Reviewed by	
Approved by	
Scale	

DWG NO.:	(WW4)2 - [3HL-52]
REV.	A

零件编号		3HL-54		构件数量		11		构件重量		39.32	
合计:										39.32	

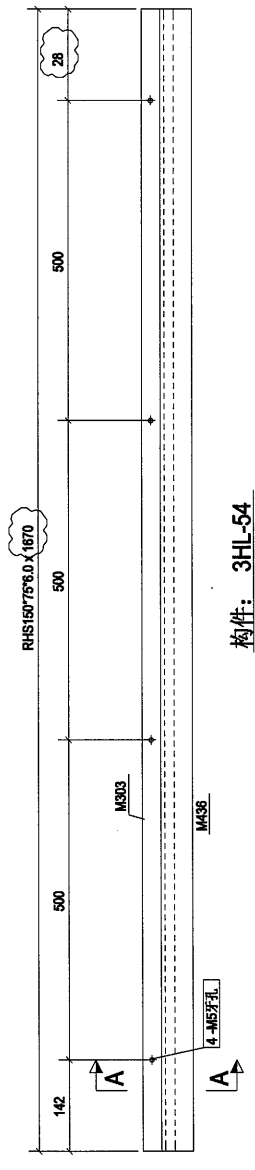


构件: 3HL-54

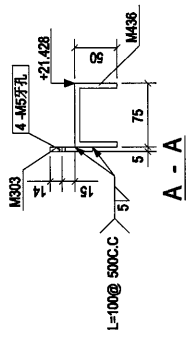


A	第2次修改	2018-08-22
Rev.	Description	Date
PROJECT: PROPOSED SITE C1 DEVELOPMENT AT AREA B8, TKO TIL TO PO, TSEUNG KWAN O, NEW TERRITORIES		
CLIENT: 美特鋁質有限公司 MIDI ALUMINIUM FABRICATOR LTD. Units 6-8, Sunny Industrial Centre, 1/F 610 Che Kwo Ling Road, Kwailoon Tel: 2499211-4 Fax: (852) 27272666		
S 銀同有限公司 Silver Town Limited Tel: 0769-8339488 Fax: 0769-8339954 E-MAIL ADDRESS: sg@silvertown.com		
DRAWING TITLE: [3HL-54]		
CAD File Name:		
Designed by		
Drawn by		
Reviewed by		
Approved by		
Scale		
DWG NO: (WWA)2 - [3HL-54]		REV. A

零件编号: 3HL-55		零件重量: 39.32	
零件编号	数量	重量	长度(mm)
M304	1	3.50	1670
M438	1	35.82	1670
合计:		39.32	

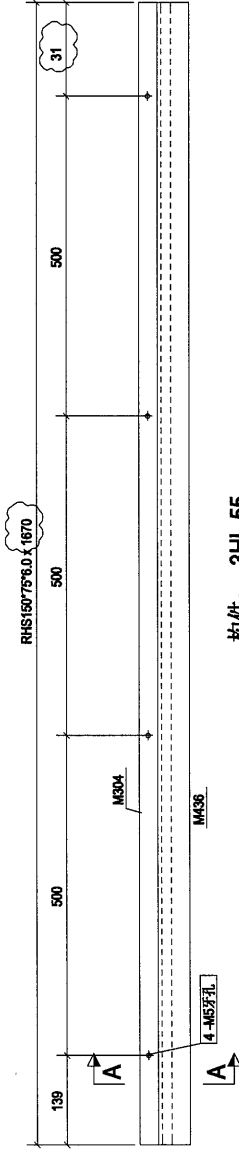


构件: 3HL-55

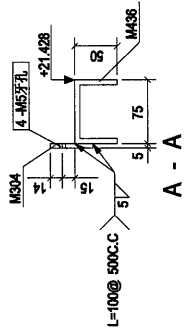

Rev.	Description	Date
A	第2次深批	2018-08-22

PROJECT:
 PROPOSED SITE C1
 DEVELOPMENT AT AREA B6,
 TKO T1 TO TP, TSEUNG KWAN O,
 NEW TERRITORIES

CLIENT:
 美特鋁質有限公司
 MIDI ALUMINIUM MANUFACTURER LTD.
 Units 6-8, Sunny Industrial Centre, 1/F
 610 Che Kwo Ling Road, Kwunloon
 Tel: 23489211-4 Fax: (852) 27271686


 銀同有限公司
 Silver Town Limited
 Tel: 0769-83354988 Fax: 0769-83359654
 E-MAIL ADDRESS: silvertown@163.com

DRAWING TITLE :
 [3HL-55]


CAD File Name :	
Designed by	
Drawn by	
Reviewed by	
Approved by	
Scale	

DWG NO.:	REV.
(WW4)-2 - [3HL-55]	A

零件编号:	3HL-56	零件数量:	3	构件重量:	39.24
零件编号	长度(mm)	重量	单重(N)	共重(N)	表面积(m ²)
M305	PL5*50	1	3.50	3.50	0.20
合计:					39.24

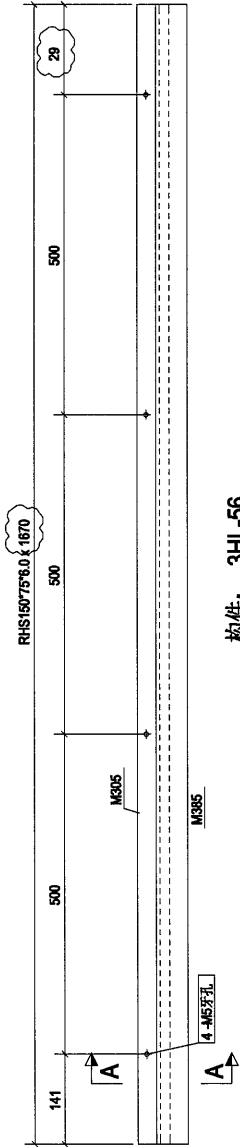

构件: 3HL-56

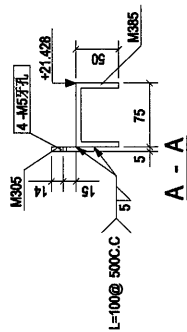

A	第2次报批	2018-08-22
Rev.	Description	Date

PROJECT: PROPOSED SITE C1
DEVELOPMENT AT AREA B8
TKO TL TO RP, TSEUNG KWAN O,
NEW TERRITORIES

CLIENT: 美特铝质有限公司
MIDI ALUMINIUM FABRICATOR LTD.
Units 6-8, Sunny Industrial Centre, 1/F
610 Chee Kwo Ling Road, Kowloon
Tel: 2499211-4 Fax: (852) 2727866


银同有限公司
Silver Town Limited
Tel: 0769-8339488 Fax: 0769-8339954
E-MAIL ADDRESS: spt@silvertown.com

DRAWING TITLE :
[3HL-56]


CAD File Name :	
Designed by	
Drawn by	
Reviewed by	
Approved by	
Scale	

DWG NO: (WW4)-2 - [3HL-56]	REV. A
----------------------------	--------

3HL-58		1		45.74	
零件编号	长度(mm)	数量	重量	共重(kg)	接續表(m)
M311	PL5*50 (1970)	1	4.08	4.08	0.23
M428	RHS15075*8.0 (1970)	1	41.66	41.66	0.37
合计:					45.74

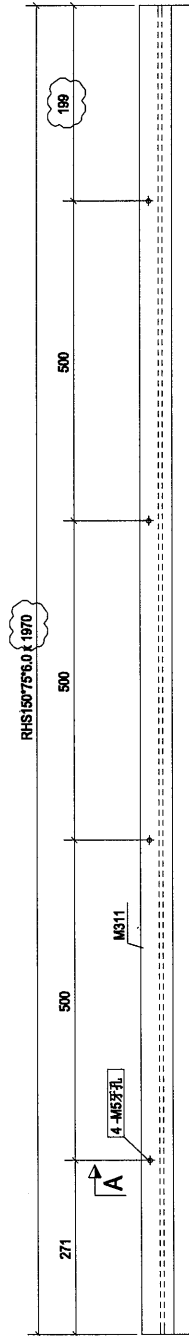

构件: 3HL-58

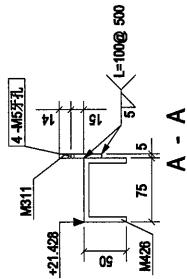

A	第2次發批	2018-08-22
Rev.	Description	Date

PROJECT: PROPOSED SITE C1
DEVELOPMENT AT AREA B8
TROTIL TO PP, TSEUNG KWAN O,
NEW TERRITORIES

CLIENT: 美特鋁質有限公司
MIDI ALUMINIUM MANUFACTURER LTD.
Units 6-8, Suncoy Industrial Centre, 1/F
610 Chu Kuo Ling Road, Kwailoon
Tel: 23489211-4 Fax: (852) 2727656


銀同有限公司
Silver Town Limited
Tel: 0769-8335488 Fax: 0769-8335954
E-MAIL: ADDRESS@silvertown-163.COM

DRAWING TITLE :
[3HL-58]


CAD File Name :	
Designed by	
Drawn by	
Reviewed by	
Approved by	
Scale	

DWG NO.:	(MM4)-2 - [3HL-58]
REV.	A

零件编号:	3HL-59	零件数量:	2	零件重量:	45.05
零件编号:	材料(mm)	数量	重量	长度(mm)	表面面积
M312	PL5*50	1	4.01	4.01	0.23
M427	RHS150775*8.0	1	41.04	41.04	0.38
		合计:	45.05		

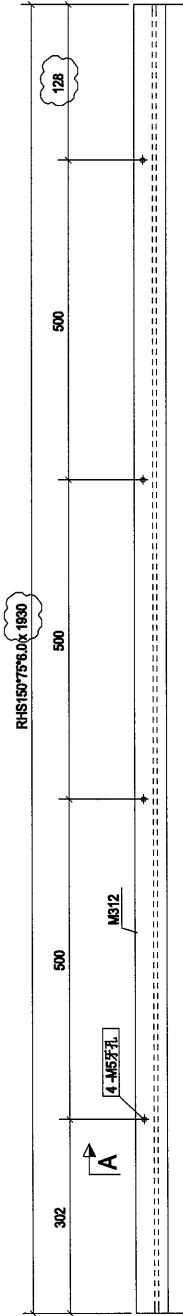


构件: 3HL-59

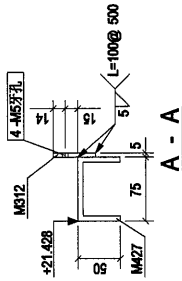


A	第2次报批	2018-08-22
Rev.	Description	Date
PROJECT: PROPOSED SITE C1 DEVELOPMENT AT AREA 88, TKOIL TO RP, TSEUNG KWAN O, NEW TERRITORIES		
CLIENT: 美特铝质有限公司 MIDI ALUMINIUM FABRICATOR LTD. Units 6-8, Sunny Industrial Centre, 1/F 610 Che Kwo Ling Road, Kwunoon Tel:23489211-4 Fax:(852)2727656		
银同有限公司 Silver Town Limited Tel:0769-8335988 Fax:0769-8335954 E-MAIL ADDRESS:silvertown@163.com		
DRAWING TITLE : [3HL-59]		
CAD File Name :		
Designed by		
Drawn by		
Reviewed by		
Approved by		
Scale		
DWG NO.: (MW4)-2 - [3HL-59]		REV. A

构件编号:	3HL-60	构件数量:	1	构件重量:	45.75
构件编号:	PK5*50	长度(mm):	1870	单重(kg):	4.08
M313	PK5*50	数量:	1	共重(kg):	4.08
M426	RHS150*75*6.0	长度(mm):	1870	单重(kg):	41.67
				共重(kg):	45.75

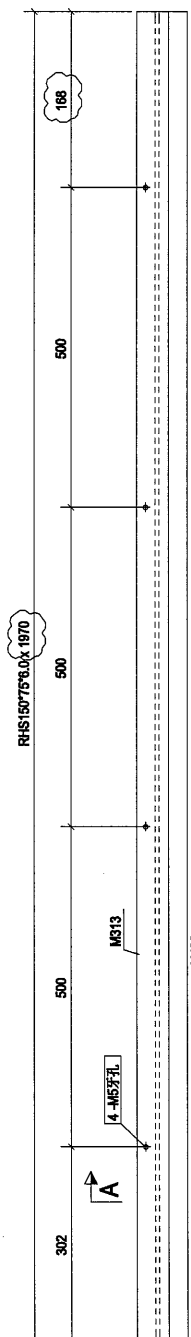


构件: 3HL-60

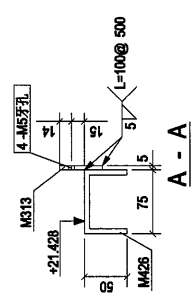


A	第一次核批	2018-08-22
Rev.	Description	Date
PROJECT: PROPOSED SITE C1 DEVELOPMENT AT AREA 88, TKOIL TO PP, TSEUNG KWAN O, NEW TERRITORIES		
CLIENT: 美特鋁質有限公司 MIDI ALUMINIUM FABRICATOR LTD. Units 6-8, Sunny Industrial Centre, 1/F 610 Chee Kwo Ling Road, Kowloon Tel: 23489211-4 Fax: (852) 2727656		
銀同有限公司 Silver Town Limited Tel: 6769-4334/488 Fax: 6769-4335/854 E-MAIL: ADDRESS@silvertown.com		
DRAWING TITLE: [3HL-60]		
CAD File Name:		
Designed by		
Drawn by		
Reviewed by		
Approved by		
Scale		
DWG NO.: (WW4)-2 - [3HL-60]		REV. A

零件编号: 3HL-61		零件数量: 2		零件重量: 45.06	
零件编号	规格(mm)	数量	重量(kg)	长度(mm)	厚度(mm)
M314	PL5*50	1	4.01	1830	4.01
M427	RHS15075*8.0	1	41.04	1830	8.0
		合计:		45.06	

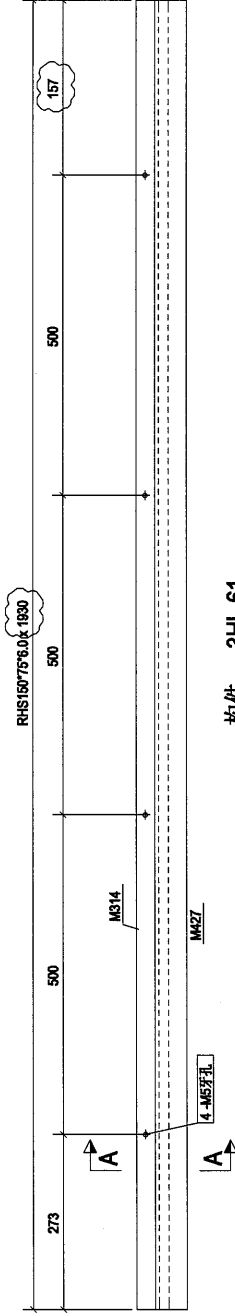


构件: 3HL-61

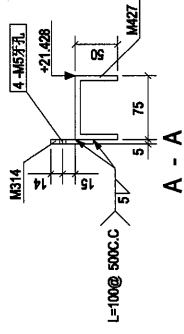


A	第2次核批	2018-08-22
Rev	Description	Date
PROJECT: PROPOSED SITE C1 DEVELOPMENT AT AREA 88, TMOIL TO PP, TSEUNG KWAN O, NEW TERRITORIES		
CLIENT: 美特鋁質有限公司 MIDI ALUMINIUM MANUFACTURER LTD. Units 6-8, Sanyee Industrial Centre, 1/F 510 Chu Kuo Ling Road, Kwunloon Tel: 23499211-4 Fax: (852) 27271986		
銀同有限公司 Silver Town Limited Tel: 0769-8335488 Fax: 0769-8335954 E-MAIL: ADDRESS: silvertown@163.COM		
DRAWING TITLE : [3HL-61]		
CAD File Name :		
Designed by		
Drawn by		
Reviewed by		
Approved by		
Scale		
DWG NO.:	(WW4)-2 - [3HL-61]	REV. A

物料编号		3HL-64		构件数量		1		构件重量		39.37	
合计:										39.37	

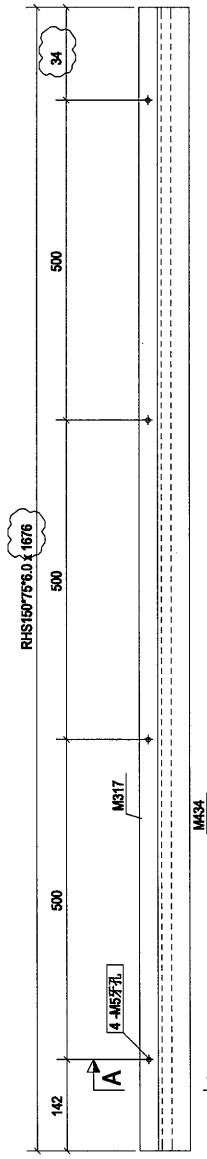


构件: 3HL-64

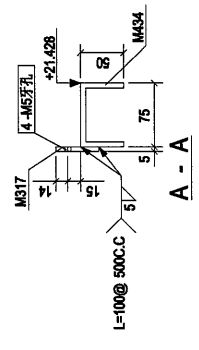




A	第2次报批	2018-08-22
Rev.	Description	Date
PROJECT: PROPOSED SITE C1 DEVELOPMENT AT AREA 68, TROTIL TO RP, TSEUNG KWAN O, NEW TERRITORIES		
CLIENT: 美特铝质有限公司 MIDI ALUMINIUM FABRICATOR LTD. Units 6-8, Sunny Industrial Centre, 1/F 510 Che Kwo Ling Road, Kwailoon Tel:23489211-4 Fax:(852)27272686		
银同有限公司 Silver Town Limited Tel:0769-83354988 Fax:0769-83359554 E-MAIL ADDRESS:silvertown@163.com		
DRAWING TITLE : [3HL-64]		
CAD File Name :		
Designed by		
Drawn by		
Reviewed by		
Approved by		
Scale		
DWG NO:	(WW4)-2 - [3HL-64]	REV. A

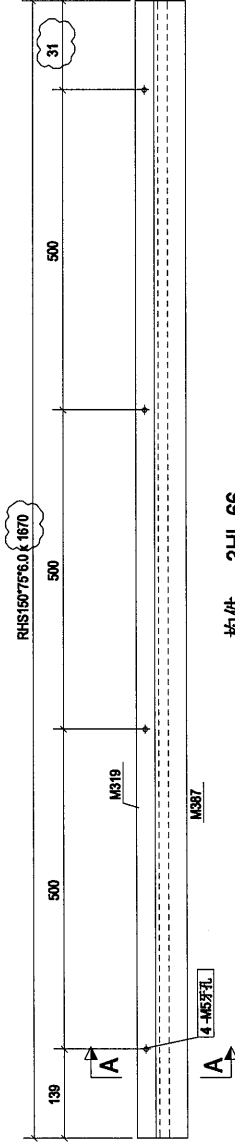物料编号:	3HL-66	构件数量:	3	构件重量:	39.15
物料名称:	3HL-66	长度(mm)	共重(kg)	共重(kg)	截面面积(m ²)
M319	PL5*50	1	3.49	3.49	0.20
M387	RHS150*75*8.0	1	35.67	35.67	0.31
合计:				39.15	

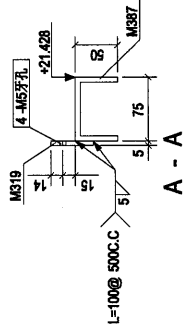


构件: 3HL-66




A	第2次修改	2018-08-22
Rev.	Description	Date
PROJECT:		
PROPOSED SITE C1 DEVELOPMENT AT AREA 88 TKOTL70 RP, TSEUNG KWAN O, NEW TERRITORIES		
CLIENT:		
 美特鋁質有限公司 MIDIA ALUMINIUM FABRICATOR LTD. Units 6-8, Sunny Industrial Centre, 1/F 810 Che Kwo Ling Road, Kowloon Tel: 23489211-4 Fax: (852) 2727866		
 银同有限公司 Silver Town Limited Tel: 0769-83354988 Fax: 0769-83359954 E-MAIL: ADDRESS@silvertown.com		
DRAWING TITLE :		
[3HL-.66]		
CAD File Name :		
Designed by		
Drawn by		
Reviewed by		
Approved by		
Scale		
DWG NO.: (WW4)-2 - [3HL-.66]		REV. A

构件编号: 3HL-67		构件数量: 1		构件重量: 38.65	
构件编号	规格(mm)	数量	重量(kg)	共重(kg)	截面面积(m ²)
M321	PL5*50	1	3.44	3.44	0.19
M441	RHS150*75*6.0	1	35.21	35.21	0.31
		合计:		38.65	

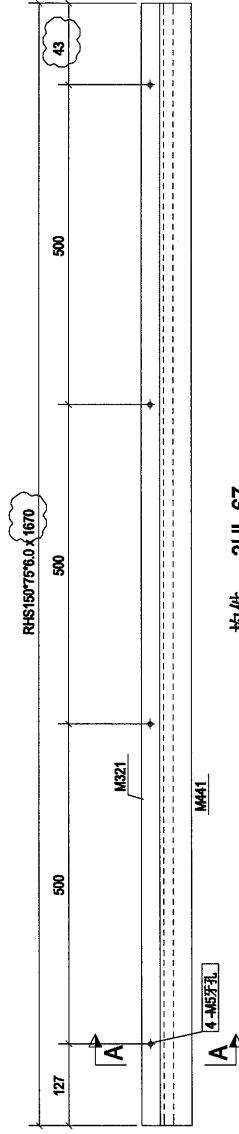

构件: 3HL-67

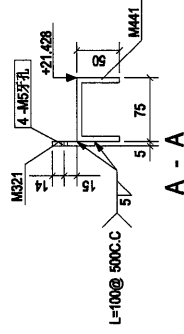

A	第2次排批	2018-08-22
Rev.	Description	Date

PROJECT:
PROPOSED SITE C1
DEVELOPMENT AT AREA B8
TKO TLO TP TSEUNG KWAN O,
NEW TERRITORIES

CLIENT:
美特鋁質有限公司
MIDI ALUMINIUM FABRICATOR LTD.
Units E-B, Sunny Industrial Centre, 1/F
610 Cho Kwo Ling Road, Kowloon
Tel: 23489211-4 Fax: (852) 27272565

银同有限公司
Silver Town Limited
Tel: 0769-8335468 Fax: 0769-8335954
E-MAIL: ADDRESS@stl.com.hk

DRAWING TITLE :


[3HL-67]

CAD File Name :


Designed by	
Drawn by	
Reviewed by	
Approved by	
Scale	

DWG NO.:	(MWA)-2 - [3HL-67]
REV.	A

3HL-68		构件数量: 1		构件重量: 39.28	
零件编号	规格(mm)	数量	重量(kg)	共重(kg)	长度(m)
M322	PL5*50	1	3.50	3.50	0.20
M383	RHS160*75*8.0	1	35.78	35.78	0.31
		合计:		39.28	

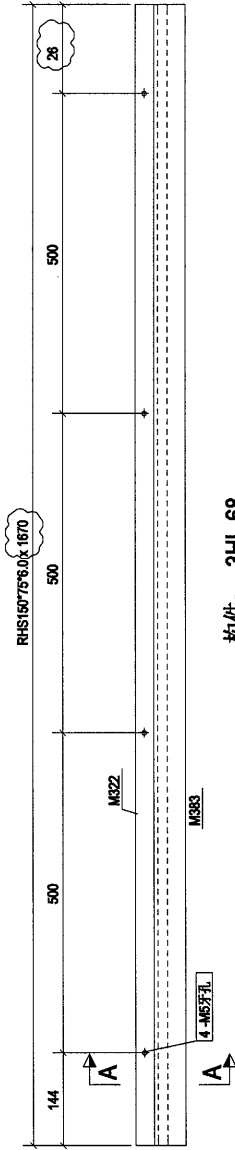


构件: 3HL-68

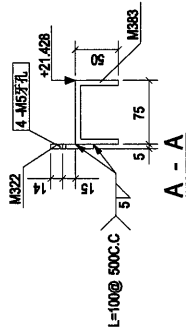


A	第2次球批	2018-08-22
Rev.	Description	Date
PROJECT: PROPOSED SITE C1 DEVELOPMENT AT AREA 88 TKOTL TO RP TSEUNG KWAN O, NEW TERRITORIES		
CLIENT: 美特铝质有限公司 MIDI ALUMINIUM FABRICATOR LTD. Units 6-8, Sunny Industrial Centre, 1/F 610 Che Kwo Ling Road, Kowloon Tel: 23489211-4 Fax: (852) 2727665		
银同有限公司 Silver Town Limited Tel: 0769-83354988 Fax: 0769-83359854 E-MAIL: ADDRESS@silvertown.com.hk		
DRAWING TITLE : [3HL-68]		
CAD File Name :		
Designed by		
Drawn by		
Reviewed by		
Approved by		
Scale		
DWG NO.:	(WWW)-2 - [3HL-68]	REV. A

物料清單		3HL-71		構件重量		39.56	
物料編號	規格(mm)	數量	單位	重量(kg)	共重(kg)	厚度(mm)	表面積(m ²)
M556	PL5*50	1		3.52	3.52	0.20	
M574	RHS150*75*6.0	1		36.03	36.03	0.32	
				合計:	39.56		

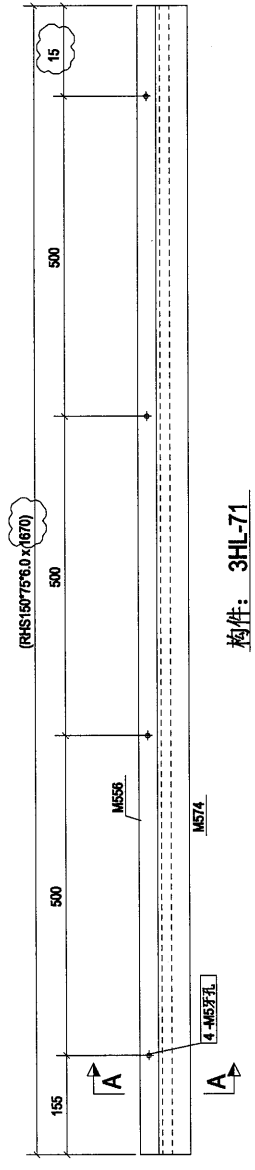


構件: 3HL-71

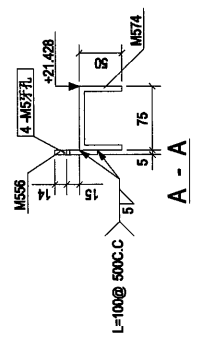


A	第2次核批	2018-08-22
Rev.	Description	Date
PROJECT: PROPOSED SITE C1 DEVELOPMENT AT AREA 86, TKOTL 70 RP, TSEUNG KWAN O, NEW TERRITORIES		
CLIENT: 美特鋁質有限公司 MIDI ALUMINUM FABRICATOR LTD. Units 6-8, Sunny Industrial Centre, 1/F, 910 Chee Kwo Ling Road, Kwun Tong, Tel: 23495211-3 Fax: (852) 27272686		
銀同有限公司 Silver Town Limited Tel: 0769-8335488 Fax: 0769-8335854 E-MAIL: ADDRESS@silvertown.com.hk		
DRAWING TITLE: [3HL-71]		
CAD File Name:		
Designed by		
Drawn by		
Reviewed by		
Approved by		
Scale		
DWG NO: (WW4)-2 - [3HL-71]		REV: A

4HL-68		1		26.53	
零件编号	数量	长度(mm)	重量(kg)	共重(kg)	接面积(m ²)
M280	1	1104	2.43	2.43	0.14
M381	1	1080	24.11	24.11	0.21
合计:					26.53

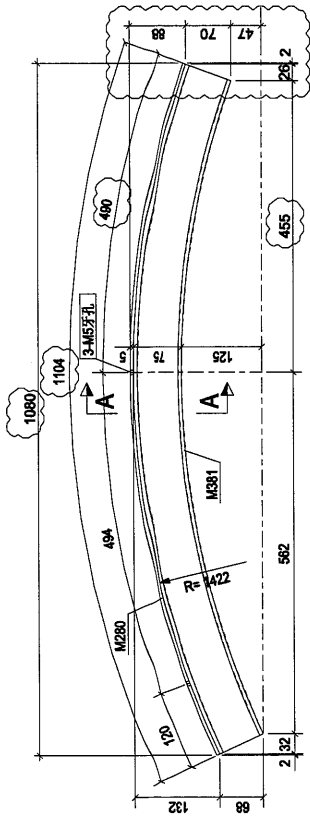


构件: 4HL-68

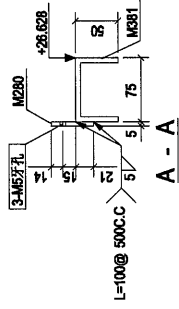


A	第2次核批	2018-08-22
Rev.	Description	Date
PROJECT: PROPOSED SITE C1 DEVELOPMENT AT AREA 88, TKOTL TO RP, TSEUNG KWAN O, NEW TERRITORIES		
CLIENT: 美特铝质有限公司 MIDI ALUMINIUM FABRICATOR LTD. Units 6-7, Sunny Industrial Centre, 1/F 810 Che Kwo Eng Road, Kwunam Tel: 23489211-4 Fax: (852) 27278585		
银同有限公司 Silver Town Limited Tel: 0769-8335498 Fax: 0769-8335954 E-MAIL: ADDRESS@silvertown.hk		
DRAWING TITLE : [4HL-68]		
CAD File Name :		
Designed by		
Drawn by		
Reviewed by		
Approved by		
Scale		
DWG NO: (WW4)-2 - [4HL-68]		REV. A

构件编号: 4HL-69		构件数量: 1		构件重量: 16.63	
零件编号	规格(mm)	数量	重量(kg)	共重(kg)	截面面积(m ²)
M281	PL5*50	1	1.52	1.52	0.09
M382	RHS150*75*8.0	1	15.11	15.11	0.13
		合计:		16.63	

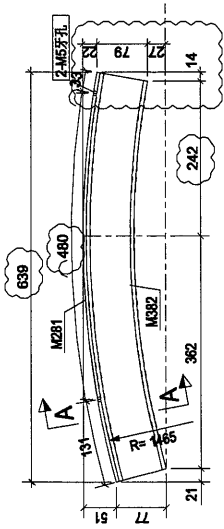


构件: 4HL-69

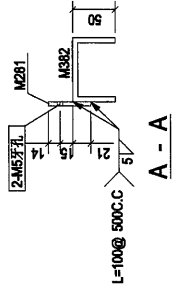


A	第2次球批	2018-08-22
Rev.	Description	Date
PROJECT: PROPOSED SITE C1 DEVELOPMENT AT AREA 88 TKOTL TO RP TSEUNG KWAN O, NEW TERRITORIES		
CLIENT: 美特鋁質有限公司 MIDI ALUMINIUM FABRICATOR LTD. Units 6-8, Sunny Industrial Centre, 1/F 610 Cho Kwo Ling Road, Kowloon Tel: 23489211-4 Fax: (852) 27271665		
银同有限公司 Silver Town Limited Tel: 0769-8335488 Fax: 0769-8335954 E-MAIL: ADDRESS@silvertown.com.hk		
DRAWING TITLE: [4HL-69]		
CAD File Name:		
Designed by		
Drawn by		
Reviewed by		
Approved by		
Scale		
DWG NO.: (MM4)-2 - [4HL-69]		REV. A

物料编号	4HL-70	物料数量	1	构件重量	37.09
物料名称	规格(mm)	数量	重量(kg)	长度(m)	深度(m)
M282	PL550	1	3.30	3.30	0.19
M405	RHS160*75*8.0	1	33.78	33.78	0.30
合计:				37.09	

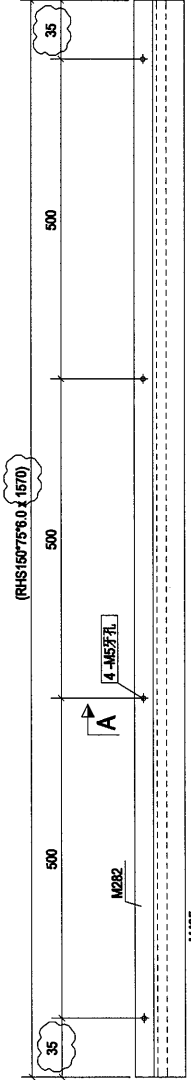


构件: 4HL-70

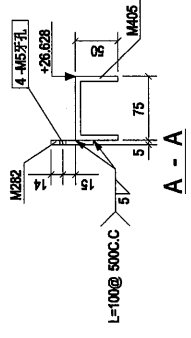


A	第2次报批	2018-08-22
Rev.	Description	Date
PROJECT: PROPOSED SITE C1 DEVELOPMENT AT AREA B8, TKO TLO REP. TSEUNG KWAN O, NEW TERRITORIES		
CLIENT: 美特铝质有限公司 MIDI ALUMINIUM FABRICATORS LTD. Units 5-8, Sunray Industrial Centre, 1/F 610 Cha Kwo Ling Road, Kowloon Tel: 23489211-4, Fax: (852) 2727866		
银同有限公司 Silver Town Limited Tel: 0769-8355988 Fax: 0769-8359854 E-MAIL: ADDRESS@silvertown.com.hk		
DRAWING TITLE: [4HL-70]		
CAD File Name:		
Designed by		
Drawn by		
Reviewed by		
Approved by		
Scale		
DWG NO: (WWA)2 - [4HL-70]		REV: A

物料编号	规格	长度(mm)	数量	构件重量		合计
				单重(kg)	共重(kg)	
M283	PL5*50	1470	1	3.11	3.11	0.17
M395	RHS160*75*8.0	1470	1	31.75	31.75	0.28
合计:						34.85

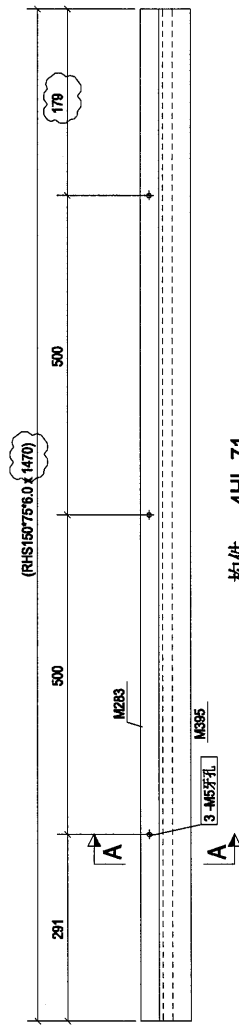


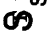
构件: 4HL-71

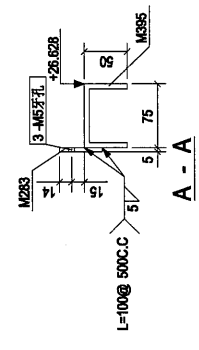

A	第2次排批	2018-08-22
Rev.	Description	Date

PROJECT:
 PROPOSED SITE C1
 DEVELOPMENT AT AREA 88
 TKO1, TO RP TSEUNG KWAN O,
 NEW TERRITORIES

CLIENT:
 美特铝质有限公司
 MIDAI ALUMINIUM MANUFACTURE LTD.
 Units 5-8, Sunny Industrial Centre, 1/F
 810 Cho Kwo Ling Road, Kowloon
 Tel: 23489211-4 Fax: (852) 2777686


 银同有限公司
 Silver Town Limited
 Tel: 0769-8335486 Fax: 0769-8335854
 E-MAIL: ADDRESS@silvertown.com.hk

DRAWING TITLE :
[4HL-71]


CAD File Name :	
Designed by	
Drawn by	
Reviewed by	
Approved by	
Scale	

DWG NO.:	(WWW)-2 - [4HL-71]
REV.	A

零件编号: 4HL-72		构件数量: 1		构件重量: 32.66	
零件编号	规格(mm)	数量	重量(kg)	共重(kg)	表面面积(m ²)
M284	PL5*50	1	2.91	2.91	0.18
		合计:		32.66	

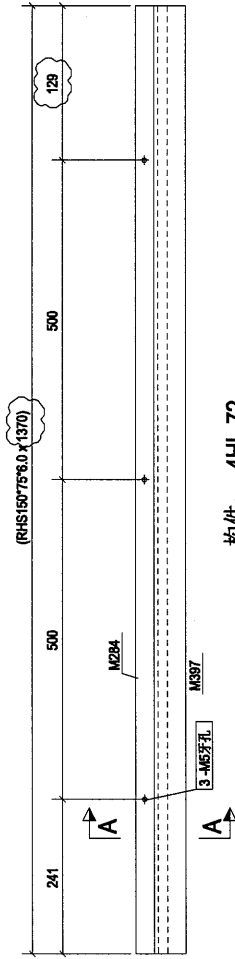


构件: 4HL-72

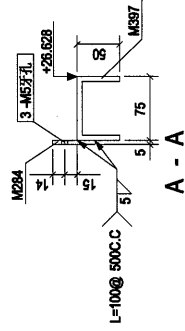


A	第2次球批	2018-08-22
Rev.	Description	Date
PROJECT: PROPOSED SITE C1 DEVELOPMENT AT AREA 88 TKOTL TO RP TSEUNG KWAN O, NEW TERRITORIES		
CLIENT: 美特鋁質有限公司 MIDI ALUMINIUM FABRICATOR LTD. Units E-8, Sunoy Industrial Centre, 1/F 610 Che Kwo Ling Road, Kowloon Tel: 23499211-4 Fax: (852) 2727666		
银同有限公司 Silver Town Limited Tel: 0769-83354968 Fax: 0769-83359854 E-MAIL: ADDRESS: silvertown@sp.63.COM		
DRAWING TITLE : [4HL-72]		
CAD File Name :		
Designed by		
Drawn by		
Reviewed by		
Approved by		
Scale		
DWG NO.: (WW4)-2 - [4HL-72]		REV. A

零件号: 4HL-73		零件数量: 1		零件重量: 30.43	
零件编号	规格(mm)	数量	重量(kg)	共重(kg)	深度(mm)
M285	PL5*50	1	2.71	2.71	0.15
M389	RHS150*75*6.0	1	27.72	27.72	0.24
		合计:		30.43	

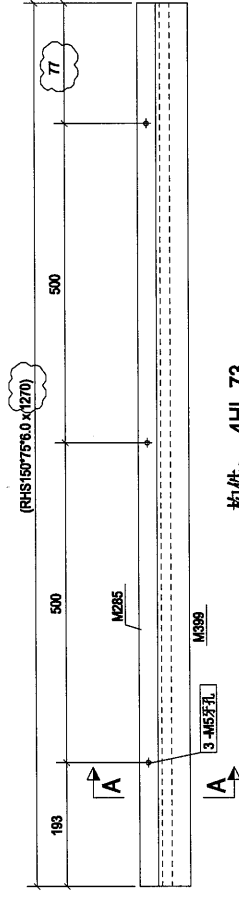


构件: 4HL-73

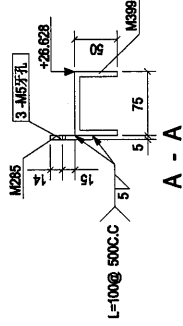


A	第2次报批	2018-08-22
Rev.	Description	Date
PROJECT: PROPOSED SITE C1 DEVELOPMENT AT AREA 86, TKOT, 70 RP, TSEUNG KWAN O, NEW TERRITORIES		
CLIENT: 美特铝质有限公司 MIDI ALUMINIUM FABRICATOR LTD. Units 6-8, Sunny Industrial Centre, 1/F 510 Che Kwo Ling Road, Kowloon TEL: 23983211-4 Fax: (852) 2727666		
银同有限公司 Silver Town Limited Tel: 0769-8335988 Fax: 0769-8335954 E-MAIL: ADDRESS@silvertown.com.hk		
DRAWING TITLE : [4HL-.73]		
CAD File Name :		
Designed by		
Drawn by		
Reviewed by		
Approved by		
Scale		
DWG NO. (WWW)2 - [4HL-.73]		REV. A

零件清单:		4HL-74		1		零件重量:		28.05	
合计:							28.05		

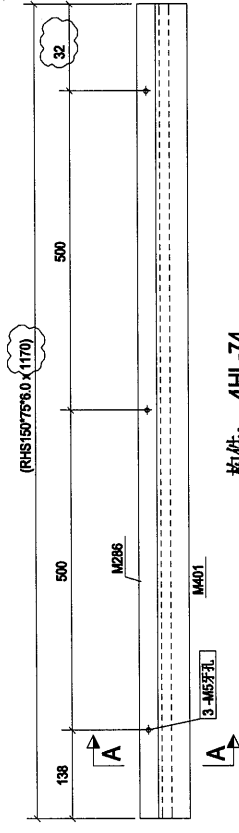


构件: 4HL-74

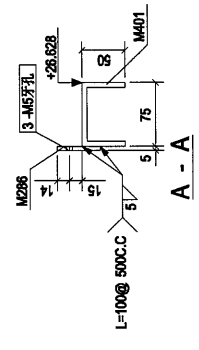




A	第2次核准	2018-08-22
Rev.	Description	Date
PROJECT: PROPOSED SITE C1 DEVELOPMENT AT AREA 86, TKOTL 70 RP, TSEUNG KWAN O, NEW TERRITORIES		
CLIENT: 美特铝质有限公司 MIDI ALUMINIUM FABRICATOR LTD. Units 8-9, Sunny Industrial Centre, 1/F 510 Cheung Wo Eng Road, Kowloon Tel: 23692111-5 Fax: (852) 27272666		
银同有限公司 Silver Town Limited Tel: 0769-8335488 Fax: 0769-8335854 E-mail: ADDRESS@silvertown.com.hk		
DRAWING TITLE: [4HL-74]		
CAD File Name:		
Designed by		
Drawn by		
Reviewed by		
Approved by		
Scale		
DWG NO: (WW4)-2 - [4HL-74]		REV: A

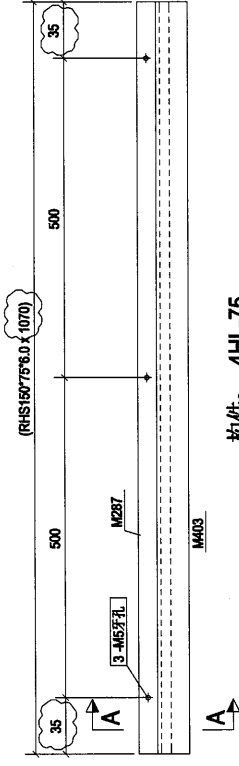物料编号		4HL-75		构件重量		25.91	
物料编号	规格(mm)	数量	重量(kg)	数量	重量(kg)	共重(kg)	接量比例
M287	PL5*50	1	2.31	1	2.31	2.31	0.13
M403	RHS150*75*6.0	1	23.60	1	23.60	23.60	0.21
合计:						25.91	

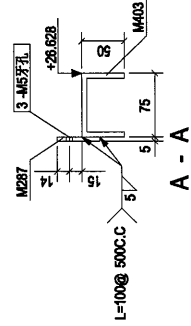


构件: 4HL-75




A	第2次报批	2018-08-22
Rev.	Description	Date
PROJECT: PROPOSED SITE C1 DEVELOPMENT AT AREA 06, TKOIL 70 RP, TSEUNG KWAN O, NEW TERRITORIES		
CLIENT:  美特铝质有限公司 MIDI Aluminum Fabricator Ltd. Units 8-9, Sunny Industrial Centre, 1/F 816 Cheong Cheong Street, Kwun Tong Kowloon, Hong Kong Tel: 2489211-4 Fax: (852) 2727686		
CLIENT:  银同有限公司 Silver Town Limited Tel: 0769-8335498 Fax: 0769-8335854 E-MAIL: ADDRESS@silvertown.hk, hk.com		
DRAWING TITLE :		
[4HL-75]		
CAD File Name :		
Designed by		
Drawn by		
Reviewed by		
Approved by		
Scale		
DWG NO.: (WWW)-2 - [4HL-75]		REV. A

4HL-76		4		25.92	
零件号	长度(mm)	数量	重量	长度(mm)	重量
M288	1070	1	2.31	1070	2.31
M403	RHS160*75*6.0	1	23.61	1070	23.61
合计:				25.92	0.21

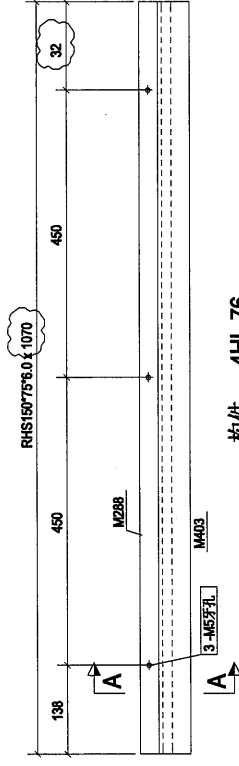


构件: 4HL-76

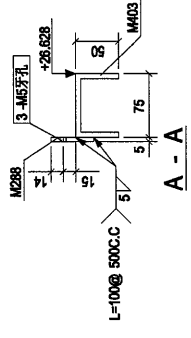


A	第2次提批	2016-06-22
Rev.	Description	Date
PROJECT: PROPOSED SITE C1 DEVELOPMENT AT AREA 88, TKO TL70 RP, TSEUNG KWAN O, NEW TERRITORIES		
CLIENT: 美特铝质有限公司 MIDI ALUMINIUM FABRICATORS LTD. Units 6-8, Sunny Industrial Centre, 1/F 810 Cha Kwo Ling Road, Kowloon Tel: 23489211-4, Fax: (852) 27272666		
银同有限公司 Silver Town Limited Tel: 0769-8335466 Fax: 0769-8335954 E-MAIL: ADDRESS@silvertown.com.hk		
DRAWING TITLE : [4HL-76]		
CAD File Name :		
Designed by		
Drawn by		
Reviewed by		
Approved by		
Scale		
DWG NO.:	(WWW)-2 - [4HL-76]	REV. A

物料编号	4HL-77	物料数量	1	操作重量	22.71
物料编号	规格(mm)	长度(mm)	数量	单重(kg)	共重(kg)
M289	PL5*50	920	1	2.02	2.02
M417	RHS15075*6.0	920	1	20.68	20.68
合计:					22.71


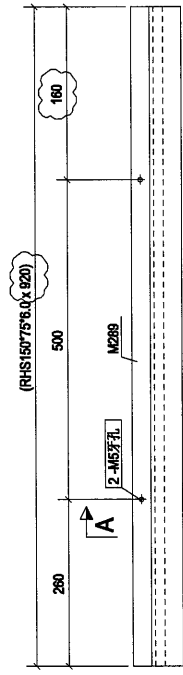


构性: 4HL-77

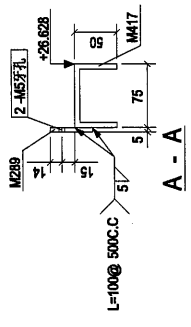


A	第2次提批	2018-08-22
Rev.	Description	Date
PROJECT: PROPOSED SITE C1 DEVELOPMENT AT AREA B8, TKOIL TO RP, TSEUNG KWAN O, NEW TERRITORIES		
CLIENT: 美特鋁質有限公司 MIDI ALUMINIUM FABRICATOR LTD. Units 8-9, Sunny Industrial Centre, 1/F 810 Cheung Ave. Tung, Tseung Kwan O, New Territories Tel: 23485211-4, Fax: (852) 27272666		
S 銀同有限公司 Silver Town Limited Tel: 0768-8335498 Fax: 0768-4335984 E-MAIL: ADDRESS@silvertown.com.hk		
DRAWING TITLE : [4HL-77]		
CAD File Name :		
Designed by		
Drawn by		
Reviewed by		
Approved by		
Scale		
DWG NO. (WWW)-2 - [4HL-77]		REV. A

构件编号		4HL-78		构件数量		1		构件重量		30.12	
零件号	规格(mm)	数量	重量(kg)	共重(kg)	长度(mm)	数量	重量(kg)	共重(kg)	截面面积(m ²)	长度(m)	重量(kg)
M290	PL5*50	1	2.68	2.68	1255	1	2.68	2.68		0.15	
M418	RHS150*75*8.0	1	27.44	27.44	1255	1	27.44	27.44		0.24	
合计:											30.12

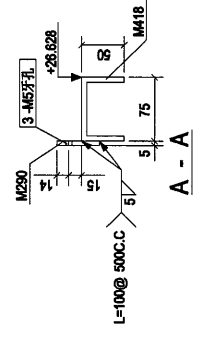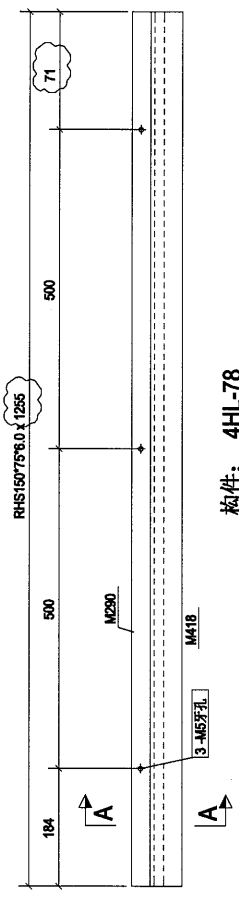


A	第2次设计	2018-08-22
Rev.	Description	Date
PROJECT: PROPOSED SITE C1 DEVELOPMENT AT AREA 08, TROTTOIR TSEING KWANCO, NEW TERRITORIES		
CLIENT: 美特铝业有限公司 MIDI ALUMINIUM FABRICATORS LTD. Units 6-8, Sunny Industrial Centre, 1/F 810 Cha Kwo Ling Road, Kowloon Tel: 23489211-4, Fax: (852) 2727866		
Silver Town Limited Tel: 0769-83354988 Fax: 0769-83359584 E-MAIL: ADDRESS@silvertown.com.hk		
DRAWING TITLE: [4HL-78]		
CAD File Name:		
Designed by		
Drawn by		
Reviewed by		
Approved by		
Scale		
DWG NO.: (WW4)2 - (4HL-78)		[REV.]
		A

构件数量: 4		构件重量: 28.08	
构件编号	长度(mm)	重量(kg)	共重(kg)
M291	1070	2.32	2.32
M420	1070	23.74	23.74
合计:		28.08	28.08

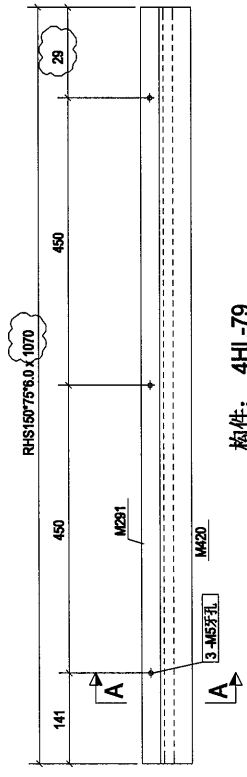


构件: 4HL-79

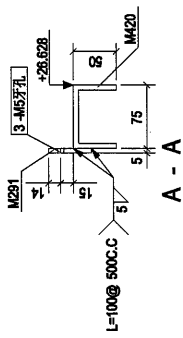


A	第2次採批	2016-08-22
Rev.	Description	Date
PROJECT: PROPOSED SITE C1 DEVELOPMENT AT AREA 88 TKOIL TO RP TSEUNG KWAN O, NEW TERRORIES		
CLIENT: 美特鋁質有限公司 MIDI ALUMINIUM MANUFACTURE LTD. Units 5-8, Sunny Industrial Centre, 1/F 610 Cho Kwo Ling Road, Kowloon Tel: 23489211-4 Fax: (852) 2777666		
銀同有限公司 Silver Town Limited Tel: 0769-83354986 Fax: 0769-83358854 E-MAIL ADDRESS: ag@silvertown.com.hk		
DRAWING TITLE : [4HL-79]		
CAD File Name :		
Designed by		
Drawn by		
Reviewed by		
Approved by		
Scale		
DWG NO.: (MWA)-2 - [4HL-79]		REV. A

物料编号	规格	数量	构件重量	
			长度(mm)	重量
M292	PL5*90	1	232	2.32
M422	RHS150*75*6.0	1	23.71	23.71
合计:				26.03

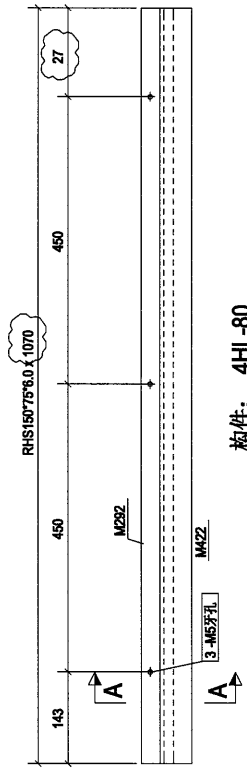


构件: 4HL-80

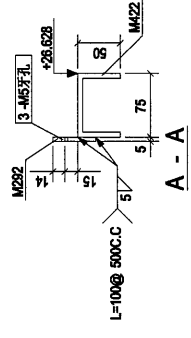


A	第2次排批	2018-08-22
Rev.	Description	Date
PROJECT: PROPOSED SITE C1 DEVELOPMENT AT AREA 88, TROTT ROAD, TSEING KWAN, NEW TERRITORIES		
CLIENT: 美特鋁質有限公司 MIDI ALUMINIUM MANUFACTURE LTD. Units 5-6, Sunny Industrial Centre, 1/F 810 Cha Kwo Ling Road, Kowloon Tel: 23489211-4 Fax: (852) 2727866		
銀同有限公司 Silver Town Limited Tel: 0769-8335988 Fax: 0769-8335984 E-MAIL ADDRESS: spt@vip.163.com		
DRAWING TITLE : [4HL-80]		
CAD File Name :		
Designed by		
Drawn by		
Reviewed by		
Approved by		
Scale		
DWG NO: (WVW)2 - [4HL-80]		REV. A

零件编号		4HL-81	零件数量	1	零件重量	25.78
零件编号	规格(mm)	数量	重量(kg)	共重(kg)	探伤比例	
M293	PL5*50	1	2.30	2.30	0.13	
M424	RHS160*75*8.0	1	23.48	23.48	0.21	
合计:					25.78	

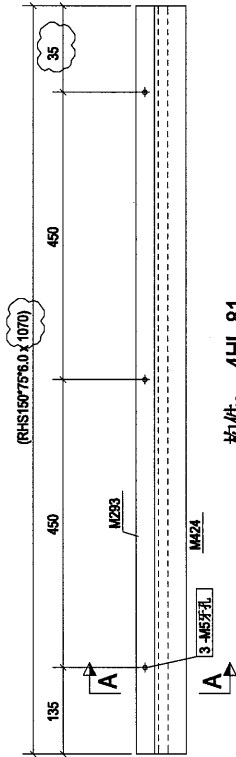

构件: 4HL-81

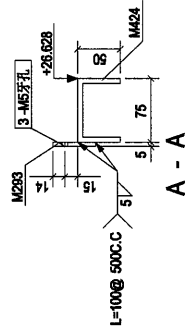

A	第2次报批	2018-08-22
Rev.	Description	Date
PROJECT: PROPOSED SITE C1 DEVELOPMENT AT AREA 88 TKO TLO PP TSEING KWANLO, NEW TERRITORIES		
CLIENT: 美特铝质有限公司 MIDI ALUMINIUM FABRICATOR LTD. Units 6-8, Sunray Industrial Centre, 1/F 610 Cha Kwo Ling Road, Kowloon Tel: 23489211-4, Fax: (852) 2727686		
Silver Town Limited Tel: 0769-8335988 Fax: 0769-8335984 E-MAIL ADDRESS: agsh@sp.163.COM		
DRAWING TITLE : [4HL-81]		
CAD File Name :		
Designed by		
Drawn by		
Reviewed by		
Approved by		
Scale		
DWG NO: (WWW)2 - [4HL-81]		REV. A


构件编号: 4HL-82		构件数量: 1		构件重量: 14.88	
构件编号	规格(mm)	数量	单重(kg)	共重(kg)	截面面积(m ²)
M301	PL5*50	1	1.33	1.33	0.07
M415	RHS150*75*6.0	1	13.56	13.56	0.12
合计:				14.88	




构件: 4HL-82

A	第2次报批	2018-08-22
Rev.	Description	Date
PROJECT: PROPOSED SITE C1 DEVELOPMENT AT AREA 88, TROTTOIR, TSEUNG KWAN O, NEW TERRORIES		
CLIENT: 美特鋁質有限公司 MIDI ALUMINIUM MANUFACTURE LTD. Units 5-8, Sunray Industrial Centre, 1/F 610 Cha Kwo Ling Road, Kowloon Tel: 23489211-4, Fax: (852) 27272666		
S 银同有限公司 Silver Town Limited Tel: 0769-8335988 Fax: 0769-8335984 E-MAIL: ADDRESS@silvertown.com.hk		
DRAWING TITLE: [4HL-82]		
CAD File Name:		
Designed by		
Drawn by		
Reviewed by		
Approved by		
Scale		
DWG NO: (WW4)-2 - [4HL-82]		REV. A

构件数量: 1		构件重量: 21.51	
构件编号	规格(mm)	数量	重量(kg)
M302	PL5*50	1	1.92
合计:			21.51

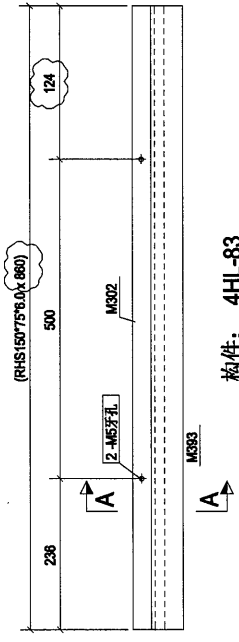


构件: 4HL-83

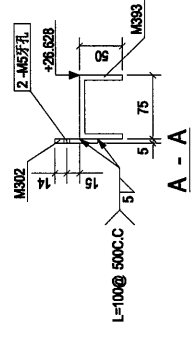


A	第2次校核	2018-08-22
Rev.	Description	Date
PROJECT: PROPOSED SITE C1 DEVELOPMENT AT AREA 86 TKOT TO RP TSEUNG KWAN O, NEW TERRITORIES		
CLIENT: 美特铝质有限公司 MIDI ALUMINIUM FABRICATOR LTD. Units E-8, Sunray Industrial Centre, 1/F 610 Cho Kwo Ling Road, Kowloon Tel: 23489211-4 Fax: (852) 27727666		
S 银同有限公司 Silver Town Limited Tel: 0769-83354966 Fax: 0769-83359854 E-MAIL ADDRESS: sgst@silvertown.com.hk		
DRAWING TITLE: [4HL-83]		
CAD File Name:		
Designed by		
Drawn by		
Reviewed by		
Approved by		
Scale		
DWG NO.: (WW4)-2 - [4HL-83]		REV. A

4HL-84		构件数量: 17		构件重量: 39.30	
零件编号	规格(mm)	数量	单重(kg)	共重(kg)	接續型(mm)
M303	PL5*50	1	3.50	3.50	0.20
		合计:		39.30	

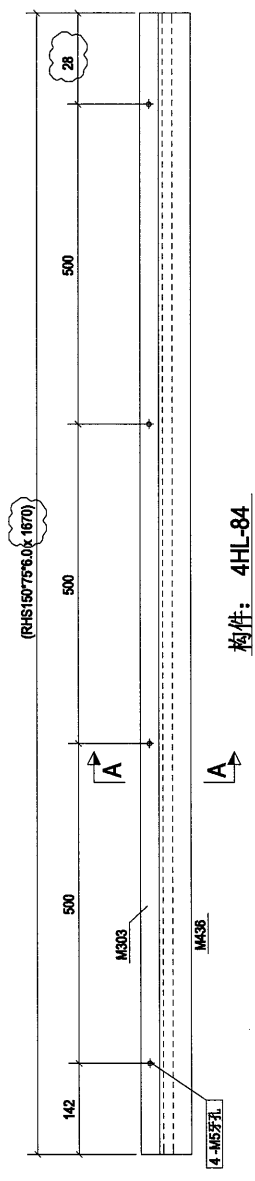


构件: 4HL-84

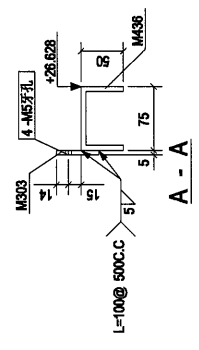


A	第2次修改	2018-08-22
Rev.	Description	Date
PROJECT: PROPOSED SITE C1 DEVELOPMENT AT AREA B6 TKOTL TO RP TSEUNG KWAN O, NEW TERRITORIES		
CLIENT: 美特鋁質有限公司 MIDI ALUMINIUM FABRICATOR LTD. Units E-9, Sunny Industrial Centre, 1/F 510 Cho Kwo Ling Road, Kowloon Tel: 23489211-4 Fax: (852) 27271866		
銀同有限公司 Silver Town Limited Tel: 0769-8335988 Fax: 0769-8335984 E-MAIL: ADDRESS@silvertown.com.hk		
DRAWING TITLE: [4HL-.84]		
CAD File Name:		
Designed by		
Drawn by		
Reviewed by		
Approved by		
Scale		
DWG NO.: (WWW)-2 - [4HL-.84]		REV. A

零件编号	4HL-85	零件数量	1	零件重量	38.30
零件编号	规格(mm)	数量	共重(kg)	表面积(m ²)	
M304	PL5*50	1	3.50	3.50	0.20
M438	RHS150*75*8.0	1	35.80	35.60	0.32
合计:				38.30	

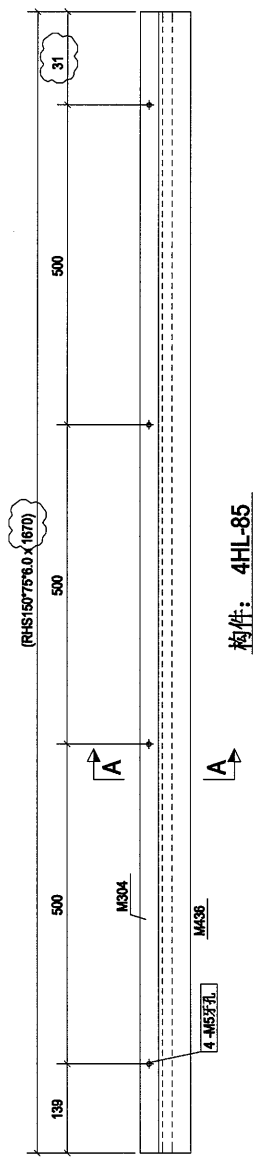


构件: 4HL-85

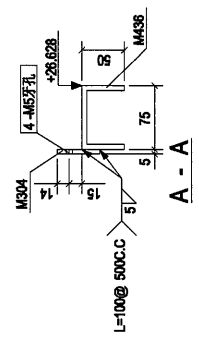


A	第2次球批	2018-08-22
Rev.	Description	Date
PROJECT: PROPOSED SITE C1 DEVELOPMENT AT AREA 88 TKOTL TO RP TSEUNG KWAN O, NEW TERRITORIES		
CLIENT: 美特铝质有限公司 MIDI ALUMINIUM FABRICATOR LTD. Units 6-8, Sunny Industrial Centre, 1/F 610 Che Kwo Ling Road, Kowloon Tel: 23489211-4 Fax: (852) 2727666		
S 银同有限公司 Silver Town Limited Tel: 0769-8335488 Fax: 0769-8335954 E-MAIL: ADDRESS@silvertown.com.hk		
DRAWING TITLE: [4HL-85]		
CAD File Name:		
Designed by		
Drawn by		
Reviewed by		
Approved by		
Scale		
DWG NO.: (MM4)-2 - [4HL-85]		REV. A

零件编号	4HL-86	零件数量	4	零件重量	39.25
零件描述	长度(mm) 重量 共重(kg) 表面面积(m ²) 表面重量(kg)				
M305	PL5*50	1	3.50	3.50	0.20
M385	RHS150*75*6.0	1	35.75	35.75	0.31
合计:				39.25	

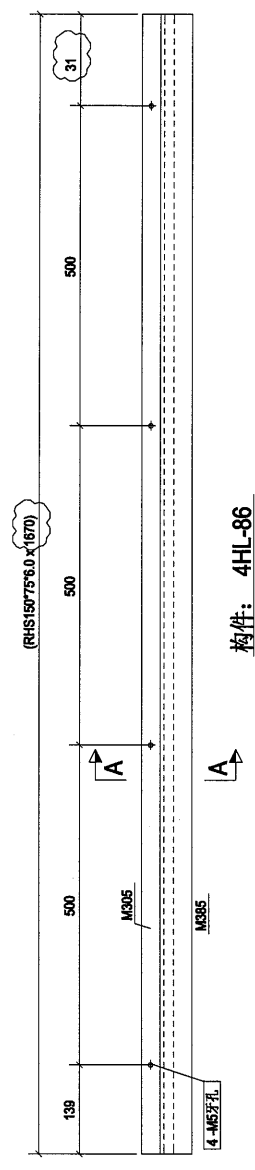


构件: 4HL-86

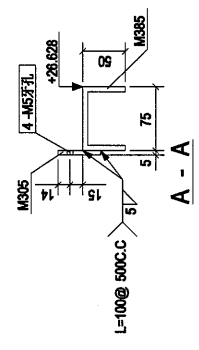


A	第2次排批	2018-08-22
Rev.	Description	Date
PROJECT: PROPOSED SITE C1 DEVELOPMENT AT AREA 88, TROTTOIR TSEUNG KWAN O, NEW TERRITORIES		
CLIENT: 美特鋁質有限公司 MIDI ALUMINIUM FABRICATOR LTD. Units 4-8, Suncoy Industrial Centre, 1/F 610 Cho Kwo Ling Road, Kowloon Tel: 23489211-4, Fax: (852) 27272666		
S 银同有限公司 Silver Town Limited Tel: 0769-83359868 Fax: 0769-83359854 E-MAIL: ADDRESS@silvertown.com.hk		
DRAWING TITLE : [4HL-86]		
CAD File Name :		
Designed by		
Drawn by		
Reviewed by		
Approved by		
Scale		
DWG NO: (WWA)2 - [4HL-86]		REV. A

零件编号:	4HL-87	零件数量:	1	零件重量:	39.27
零件编号:	材料(mm)	数量	重量(kg)	长度(mm)	深度(mm)
M305	PL5*50	1	3.50	1670	0.20
M383	RHS150*75*8.0	1	35.77	1670	0.31
合计:					39.27

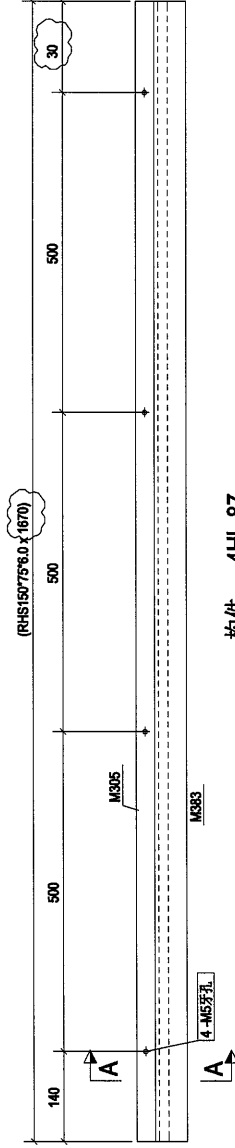


构件: 4HL-87

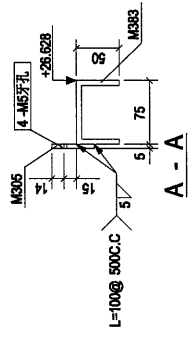


A	第2次发批	2018-08-22
Rev.	Description	Date
PROJECT: PROPOSED SITE C1 DEVELOPMENT AT AREA 88, TKOIL TO RP, TSEUNG KWAN O, NEW TERRITORIES		
CLIENT: 美特铝质有限公司 MIDI ALUMINIUM MANUFACTURER LTD. Units 6-8, Sunny Industrial Centre, Y/F 610 Chee Koo Ling Road, Kowloon Tel: 23489211-4 Fax: (852) 27271686		
S 银同有限公司 Silver Town Limited Tel: 0769-83334988 Fax: 0769-83339854 E-MAIL: ADDRESS: silvertown@163.COM		
DRAWING TITLE: [4HL-87]		
CAD File Name:		
Designed by		
Drawn by		
Reviewed by		
Approved by		
Scale		
DWG NO.: (WW4)-2 - (4HL-87)		REV. A

4HL-88		构件数量: 1		构件重量: 39.14	
零件编号	规格(mm)	数量	重量(kg)	长度(m)	截面面积(m ²)
M306	PL5*50	1	3.49	3.49	0.20
M387	RHS150*75*8.0	1	35.65	35.65	0.31
		合计:		39.14	

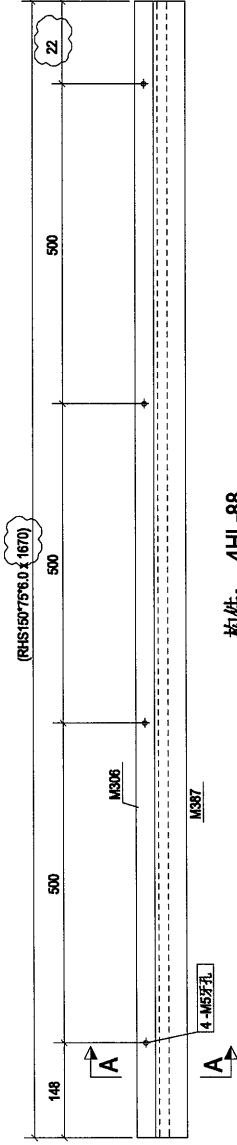


构件: 4HL-88

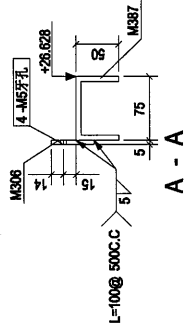


A	第2次提批	2018-08-22
Rev.	Description	Date
PROJECT: PROPOSED SITE C1 DEVELOPMENT AT AREA RA, TKOTL TO RP, TSEUNG KWAN O, NEW TERRITORIES		
CLIENT: 美特铝质有限公司 MIDI ALUMINIUM FABRICATOR LTD. Units 6-4, Sunny Industrial Centre, 1/F 510 Che Kwo Ling Road, Kwun Tong Tel: 2489211-4 Fax: (852) 2727886		
S 银同有限公司 Silver Town Limited Tel: 0769-8335488 Fax: 0769-8335954 E-MAIL ADDRESS: sg@stl.com.hk		
DRAWING TITLE: [4HL-88]		
CAD File Name:		
Designed by		
Drawn by		
Reviewed by		
Approved by		
Scale		
DWG NO.: (WW4)-2 - [4HL-88]		REV. A

4HL-89		构件数量: 1		构件重量: 39.21	
零件编号	规格(mm)	数量	重量(kg)	共重(kg)	表面积(m ²)
M307	PL5*50	1	3.49	3.49	0.20
M389	RHS150*75*6.0	1	35.71	35.71	0.31
		合计:		39.21	

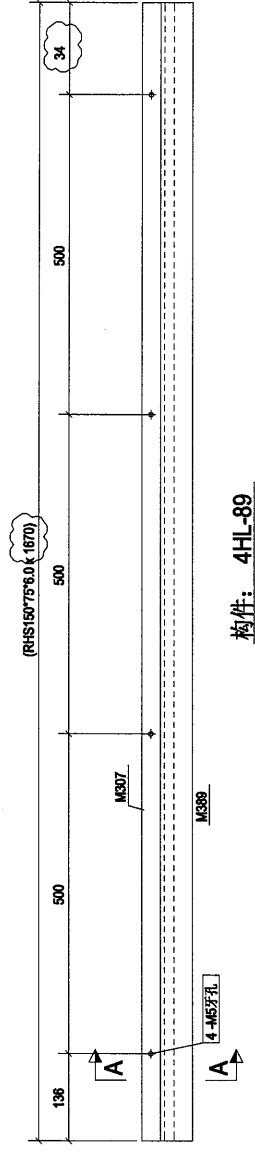


构件: 4HL-89

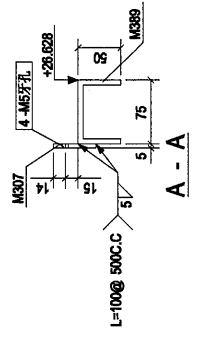


Rev.	A	第2次球批	2018-08-22
Description		Date	
PROJECT: PROPOSED SITE C1 DEVELOPMENT AREA 88, TOKTEL TO RP, TSEUNG KWAN O, NEW TERRITORIES			
CLIENT: 美特鋁質有限公司 MIDI Aluminium Fabrication Ltd. Units 6-8, Sunny Industrial Centre, Y/F 610 Che Kwo Ling Road, Kowloon Tel: 23489211-4 Fax: (852) 2727656			
S 銀同有限公司 Silver Town Limited Tel: 0769-4335488 Fax: 0769-4335854 E-MAIL: ADDRESS@silvertown.com.hk			
DRAWING TITLE: [4HL-89]			
CAD File Name:			
Designed by			
Drawn by			
Reviewed by			
Approved by			
Scale			
DWG NO.: (MW)4-2 - [4HL-89]			REV. A

零件编号	4HL-90	构件数量	1	构件重量	37.05
零件编号	规格(mm)	数量	重量(kg)	长度(mm)	截面面积(m ²)
M308	PL5*50	1	3.30	(1570)	0.19
M391	RHS150*75*6.0	1	33.75	(1570)	0.30
合计:				37.05	

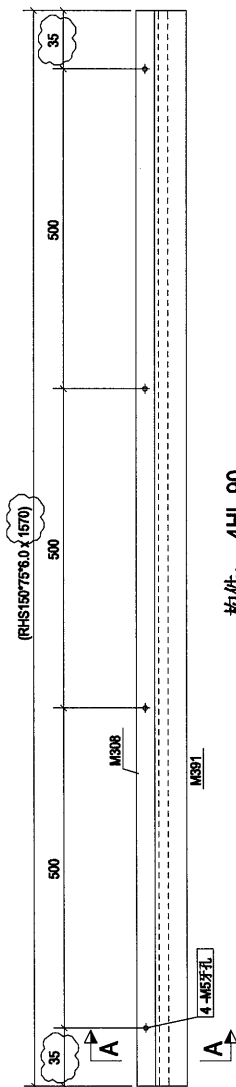


构件: 4HL-90

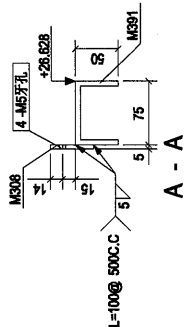



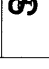
Rev.	A	第2次球批	2018-08-22
Rev.		Description	Date
PROJECT: PROPOSED SITE C1 DEVELOPMENT AT AREA B6, KOTI TO RP, TSEUNG KWAN O, NEW TERRITORIES			
CLIENT: 美特鋁質有限公司 MIDI Aluminium Fabricator Ltd. Units 6-8, Sunny Industrial Centre, 1/F 610 Cho Kwo Ling Road, Kowloon Tel: 23489211-4 Fax: (852) 27271666			
S 銀同有限公司 Silver Town Limited Tel: 0769-83354988 Fax: 0769-83358954 E-MAIL: ADDRESS@shp.163.COM			
DRAWING TITLE: [4HL-90]			
CAD File Name:			
Designed by			
Drawn by			
Reviewed by			
Approved by			
Scale			
DWG NO.: (WW4)-2 - [4HL-90]			REV. A

零件编号:	4HL-91	零件数量:	2	零件重量:	40.29
零件编号:	长度(mm)	重量	单重(N)	共重(N)	漆重(N)
M309	PL5*50	1	3.59	3.59	0.20
M413	RHS150*75*6.0	1	36.70	36.70	0.32
合计:				40.29	

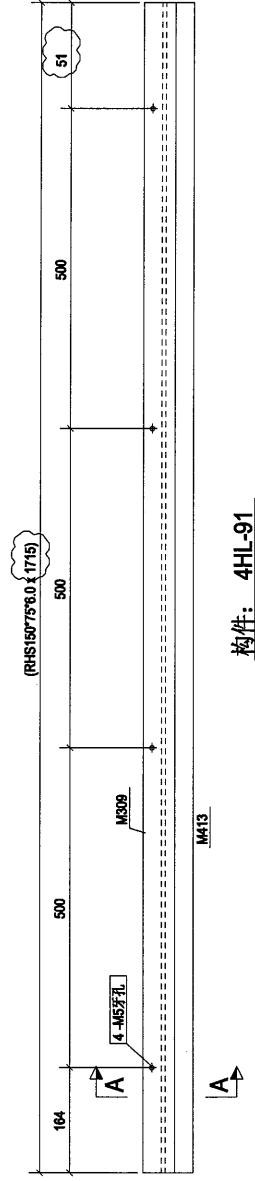


构件: 4HL-91

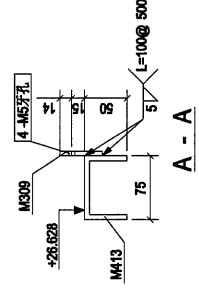


Rev.	第2次修版	Date	2018-08-22
PROJECT:	PROPOSED SITE C1 DEVELOPMENT AT AREA B8, TKOIL TO RP, TSEUNG KWAN O, NEW TERRITORIES		
CLIENT:	 美特铝质有限公司 MIDI Aluminium Fabrication Ltd. Units 6-8, Sunny Industrial Centre, 1/F 610 Che Kwo Ling Road, Kwailoon Tel:23489211-4 Fax:(852)2727686		
	 银同有限公司 Silver Town Limited Tel:0769-8335488 Fax:0769-8335854 E-MAIL: ADDRESS@silvertown.com		
DRAWING TITLE :			
[4HL-91]			
CAD File Name :			
Designed by			
Drawn by			
Reviewed by			
Approved by			
Scale			
DWG NO.:	(MWA)2 - [4HL-91]	REV.	A

44.

零件编号	4HL-92	零件数量	4	零件重量	45.93
零件编号	长度(mm)	重量	单重(kg)	共重(kg)	表面积(m ²)
M310	PL5*50	1	4.09	4.09	0.23
M414	RHS150*75*8.0	1	41.83	41.83	0.37
合计:				45.93	

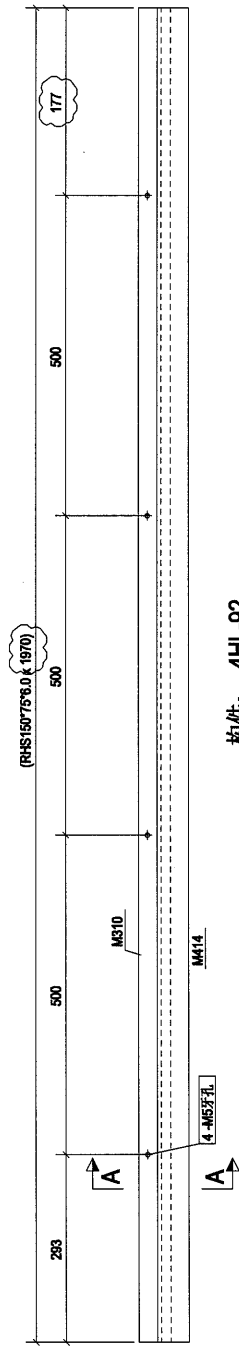


构件: 4HL-92

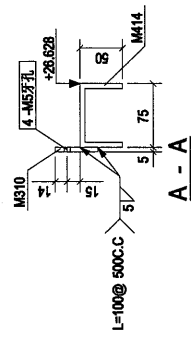


A	第2次修改	2018-08-22
Rev.	Description	Date
PROJECT: PROPOSED SITE C1 DEVELOPMENT AT AREA B6, TKOTIL TO RP, TSEUNG KWAN O, NEW TERRITORIES		
CLIENT: 美特銘質有限公司 MIDI ALUMINIUM FABRICATOR LTD. Units 6-4, Sunny Industrial Centre, 1/F 510 Che Kwo Ling Road, Kwunam Tel: 23489211-4 Fax: (852) 2727586		
S 銀同有限公司 Silver Town Limited Tel: 0769-8335488 Fax: 0769-8335954 E-MAIL: ADDRESS@silvertown.com		
DRAWING TITLE: [4HL-92]		
CAD File Name:		
Designed by		
Drawn by		
Reviewed by		
Approved by		
Scale		
DWG NO: (WWW)-2 - (4HL-92)	REV.	A

零件编号: 4HL-94		零件数量: 1		零件重量: 39.28	
零件编号	长度(mm)	重量	单重(kg)	长度(mm)	重量(kg)
M383	RHS150775*0.0	1	35.78	1870	0.31
M581	PL5750	1	3.50	1678	0.20
合计:				39.28	

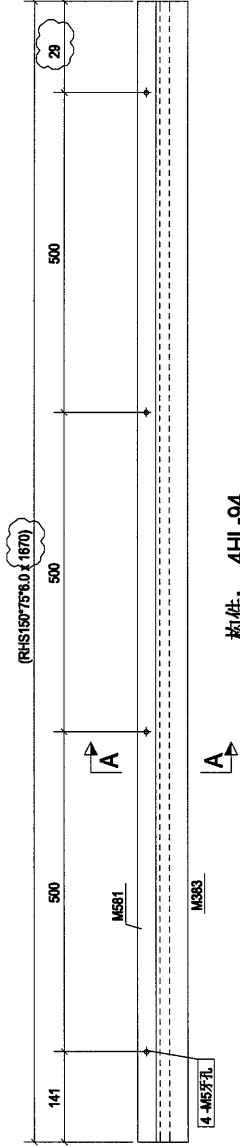

构件: 4HL-94

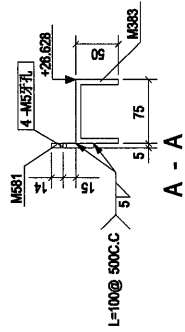

Rev.	Description	Date
A	第2次深批	2018-08-22

PROJECT: PROPOSED SITE C1
DEVELOPMENT AT AREA B8
TKO T1 TO TP, TSEUNG KWAN O,
NEW TERRITORIES

CLIENT: 美特鋁質有限公司
MIDI ALUMINIUM MANUFACTURER LTD.
Units 6-8, Sunny Industrial Centre, 1/F
610 Chu Kwo Ling Road, Kwailoon
Tel: 23489211-4 Fax: (852) 27272656


銀同有限公司
Silver Town Limited
Tel: 0769-83354868 Fax: 0769-83359554
E-MAIL: ADDRESS@silvertown.com.hk

DRAWING TITLE :
[4HL-94]


CAD File Name :	
Designed by	
Drawn by	
Reviewed by	
Approved by	
Scale	

DWG NO.:	REV.
(WW4)2 - [4HL-94]	A

零件编号:	4HL-98	零件数量:	2	零件重量:	45.83
零件编号:	规格(mm)	数量	重量(kg)	长度(mm)	表面面积(m ²)
M414	RHS150*75*6.0	1	41.83	41.83	0.37
M508	PL5*50	1	4.09	4.09	0.23
合计:					45.83

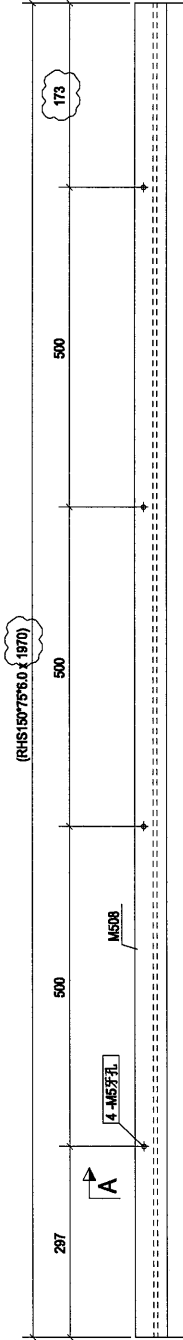


构件: 4HL-98

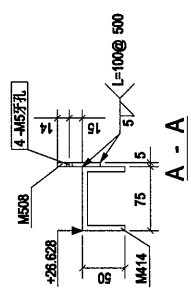




A	第2次报批	2018-08-22
Rev.	Description	Date
PROJECT: PROPOSED SITE C1 DEVELOPMENT AT AREA 88, TROTIL TO RP TSEUNG KWAN O, NEW TERRITORIES		
CLIENT: 美特铝质有限公司 MIDI ALUMINIUM MANUFACTURER LTD. Units 6-8, Sunray Industrial Centre, 1/F 610 Che Kwo Ling Road, Kwloon Tel: 2498211-4 Fax: (852) 2727686		
银同有限公司 Silver Town Limited Tel: 0769-8335488 Fax: 0769-8335954 E-MAIL: ADDRESS@silvertown.com.hk		
DRAWING TITLE: [4HL-98]		
CAD File Name:		
Designed by		
Drawn by		
Reviewed by		
Approved by		
Scale		
DWG NO:	(MW4)-2 - [4HL-98]	REV. A

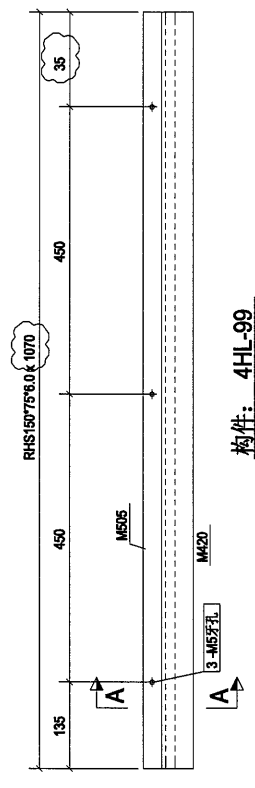零件编号:	4HL-99	零件数量:	1	零件重量:	26.06
零件描述:	规格(mm)	重量(kg)	长度(mm)	重量(kg)	长度(mm)
M420	RHS150*75*6.0	1	23.74	23.74	0.21
M505	PL5*50	1	2.32	2.32	0.13
合计:				26.06	

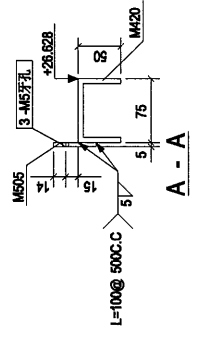


构件: 4HL-99




Rev.	A	第2次派批	2018-08-22	Date
PROJECT:	PROPOSED SITE C1 DEVELOPMENT AREA 88, TKO TOWER TSEUNG KWAN O, NEW TERRITORIES			
CLIENT:	 美特鋁質有限公司 MIDI Aluminium Manufacture Ltd. Units 6-8, Sunny Industrial Centre, 1/F, 610 Che Kwo Ling Road, Kowloon Tel: 23489211-4 Fax: (852) 2727686			
	 銀同有限公司 Silver Town Limited Tel: 0769-8335498 Fax: 0769-8335854 E-MAIL ADDRESS: gph@stl.com.hk			
DRAWING TITLE:	[4HL-99]			
CAD File Name:				
Designed by				
Drawn by				
Reviewed by				
Approved by				
Scale				
DWG NO.:	(WWW)2 - (4HL-99)			REV. A

零件编号:	4HL-100	零件数量:	1	零件重量:	39.12
				合计:	39.12

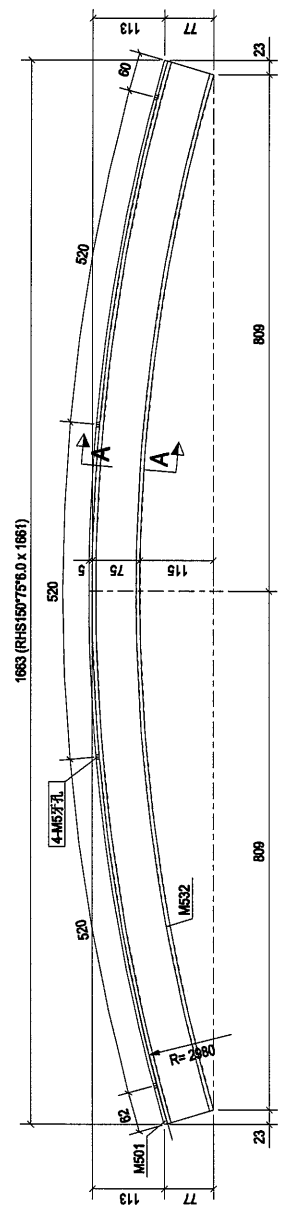


构件: 4HL-100

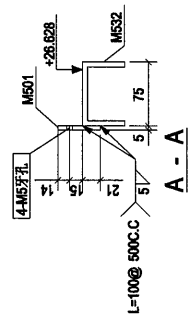


Rev.	A	第2次派批	2018-08-22
Description		Date	
PROJECT: PROPOSED SITE C1 DEVELOPMENT AT AREA 68, TROTIL TO RT, TSEUNG NYAN O, NEW TERRITORIES			
CLIENT: 美特鋁質有限公司 MID) ALUMINIUM FABRICATORS LTD. Units 6-8, Sunny Industrial Centre, 1/F, 610 Che Kwo Ling Road, Kwailoon Tel:23489211-4 Fax:(852)2727866			
S 银同有限公司 Silver Town Limited Tel:0769-8335488 Fax:0769-8335884 E-MAIL ADDRESS:sales@stl.com.hk			
DRAWING TITLE : [4HL-100]			
CAD File Name :			
Designed by			
Drawn by			
Reviewed by			
Approved by			
Scale			
DWG NO.:	(MNA)-2 - (4HL-100)	REV.	A

零件编号:	4HL-101	零件数量:	1	构件重量:	39.07
零件编号:	长度(mm)	数量	重量(kg)	重量(kg)	表面积(m ²)
M502	PL5*50	1	3.52	3.52	0.20
M534	RHS150*75*6.0	1	35.55	35.55	0.31
合计:				39.07	

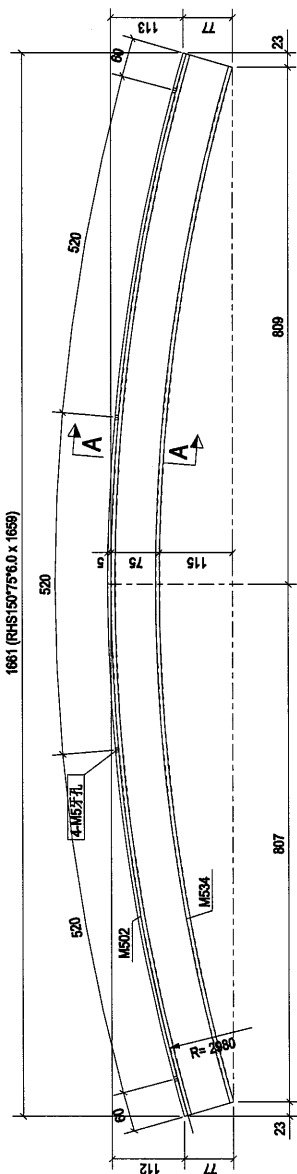


构件: 4HL-101

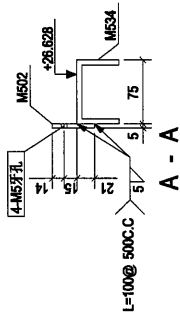


A	第2次校批	2018-08-22
Rev.	Description	Date
PROJECT: PROPOSED SITE C1 DEVELOPMENT AT AREA 88, TROTIL TO RP, TSEUNG KWAN O, NEW TERRITORIES		
CLIENT: 美特鋁質有限公司 MIDI ALUMINIUM MANUFACTURER LTD. Units 6-8, Sunny Industrial Centre, 1/F 610 Chu Kwo Ling Road, Kwunloon Tel: 23499211-4 Fax: (852) 27272656		
銀同有限公司 Silver Town Limited Tel: 0769-8338488 Fax: 0769-8338954 E-MAIL ADDRESS: silvertown@vip.163.com		
DRAWING TITLE: [4HL-101]		
CAD File Name:		
Designed by		
Drawn by		
Reviewed by		
Approved by		
Scale		
DWG NO.: (WW4)-2 - [4HL-101]		REV. A

零件号: 4HL-103		零件数量: 1		零件重量: 45.71	
零件编号	长度(mm)	数量	重量(kg)	长度(mm)	重量(kg)
M509	PL5*50	1	4.07	1800	0.29
M539	RHS150*75*6.0	1	41.64	1860	0.37
合计:				45.71	

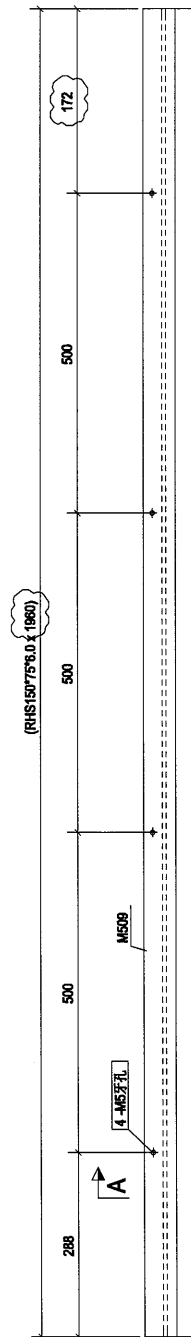


构件: 4HL-103

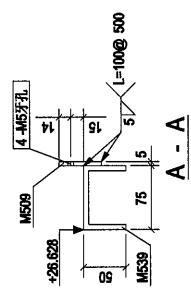


A	第2次报批	2018-08-22
Rev.	Description	Date
PROJECT: PROPOSED SITE C1 DEVELOPMENT AT AREA B8 TROTTOIR TSEUNG KWAN O, NEW TERRITORIES		
CLIENT: 美特铝质有限公司 MIDI ALUMINIUM MANUFACTURE LTD. Units 6-8, Sunray Industrial Centre, 1/F 510 Cho Kwo Ling Road, Kwunloon Tel: 23489211-4 Fax: (852) 72727686		
S 银同有限公司 Silver Town Limited Tel: 0769-83354888 Fax: 0769-83359554 E-MAIL ADDRESS: sg@silvertown.com.hk		
DRAWING TITLE: [4HL-103]		
CAD File Name:		
Designed by		
Drawn by		
Reviewed by		
Approved by		
Scale		
DWG NO: (WW4)2 - [4HL-103]		REV. A

料號	4HL-104	構件重量	46.14
規格	規格(mm)	數量	共重(kg)
M510	1975	1	4.11
M540	RHS150756.0	1	42.03
合計:			46.14

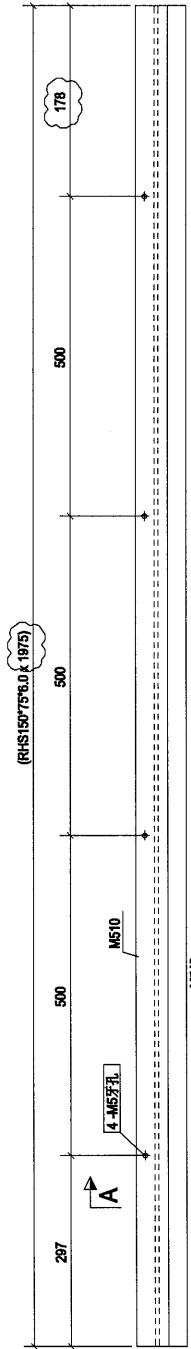


構件: 4HL-104

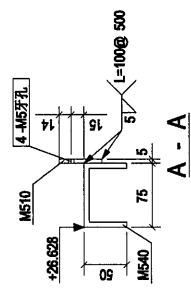


Rev.	第2次提批	2018-08-22	Date
PROJECT: PROPOSED SITE C1 DEVELOPMENT AT AREA B8, TROTIL TO RP, TSEUNG KWAN O, NEW TERRITORIES			
CLIENT: 美特鋁質有限公司 MIDI ALUMINIUM FABRICATORS LTD. Units 6-8, Sunray Industrial Centre, 1/F 610 Chee Kwo Ling Road, Kwun Tong Tel: (852) 2469211-4, Fax: (852) 27272686			
S 銀同有限公司 Silver Town Limited Tel: 0769-83354468 Fax: 0769-83359554 E-MAIL: ADDRESS@silvertown.hk, 63.COM			
DRAWING TITLE : [4HL-104]			
CAD File Name :			
Designed by			
Drawn by			
Reviewed by			
Approved by			
Scale			
DWG NO.:	(MWA)-2 - [4HL-104]	REV.	A

零件编号: 4HL-105		零件数量: 1		零件重量: 25.97	
零件编号	长度(mm)	重量	长度(mm)	重量	长度(mm)
M506	PL550	1	2.31	2.31	0.13
M537	RHS150*75*6.0	1	23.66	23.66	0.21
		合计:		25.97	

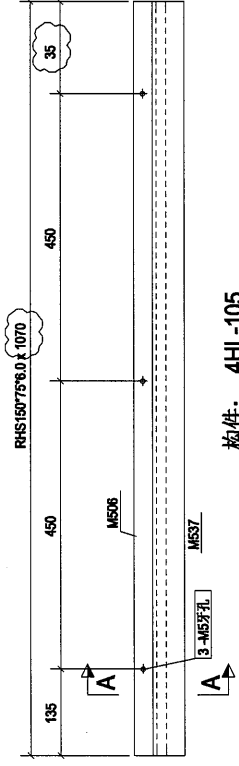

构件: 4HL-105

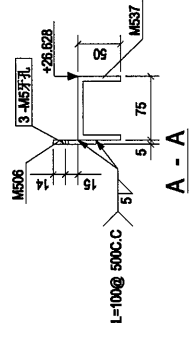

Rev.	Description	Date
A	第2次深批	2018-08-22

PROJECT: PROPOSED SITE C1
DEVELOPMENT AT AREA B8
TKO TI TO P. TSEUNG KWAN O,
NEW TERRITORIES

CLIENT: 美特鋁質有限公司
MIDI ALUMINIUM FABRICATOR LTD.
Units 6-8, Sunny Industrial Centre, 1/F
610 Cho Kwo Ling Road, Kowloon
Tel: 23489211-4 Fax: (852) 27272686

銀同有限公司
Silver Town Limited
Tel: 0769-83354888 Fax: 0769-83359554
E-MAIL: ADDRESS: gdp@silvertown.com


DRAWING TITLE: [4HL-105]

CAD File Name:


Designed by	
Drawn by	
Reviewed by	
Approved by	
Scale	

DWG NO: (WW4)2 - [4HL-105] REV. A

零件编号: 4HL-107		零件数量: 1		零件重量: 17.92	
零件编号	规格(mm)	数量	重量(kg)	长度(mm)	表面面积(m ²)
M57	PL5*50	1	1.60	70	0.09
M576	RHS150*75*6.0	1	16.32	70	0.14
		合计:		17.92	

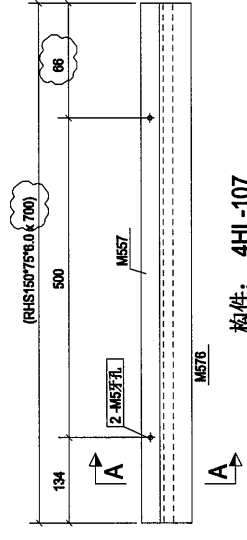


构件: 4HL-107

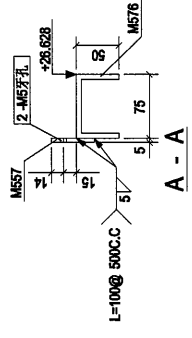


A	第2次派批	2018-08-22
Rev.	Description	Date
PROJECT: PROPOSED SITE C1 DEVELOPMENT AT AREA 86, TKOIL TO RP, TSEUNG KWAN O, NEW TERRITORIES		
CLIENT: 美特鋁質有限公司 MIDI ALUMINUM MANUFACTURE LTD. Units 6-8, Sunray Industrial Centre, 1/F 610 Che Kwo Ling Road, Kwailoon Tel: 23489211-4 Fax: (852) 27272656		
銀同有限公司 Silver Town Limited Tel: 0769-83354888 Fax: 0769-83359554 E-MAIL ADDRESS: sp@silvertown.com.hk		
DRAWING TITLE : [4HL-107]		
CAD File Name :		
Designed by		
Drawn by		
Reviewed by		
Approved by		
Scale		
DWG NO.:	(WW4)-2 - [4HL-107]	REV. A

零件编号: 4HL-108		零件数量: 1		零件重量: 17.94	
零件编号	规格(mm)	数量	重量(kg)	长度(mm)	表面面积(m²)
M57	PL5*50	1	1.60	700	0.09
M576	RHS15075*6.0	1	16.34	700	0.14
		合计:		17.94	

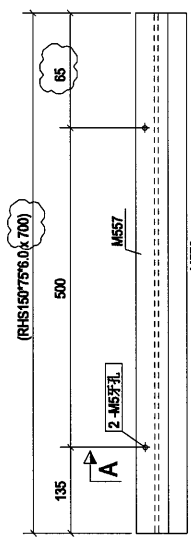


构件: 4HL-108

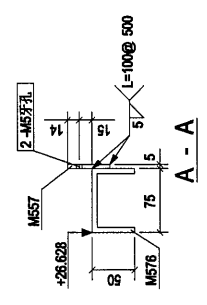


A	第2次派批	2018-08-22
Rev.	Description	Date
PROJECT: PROPOSED SITE C1 DEVELOPMENT AT AREA B8 TROTIL TO PP. TSEUNG KWAN O, NEW TERRITORIES		
CLIENT: 美特鋁質有限公司 MIDI ALUMINIUM FABRICATOR LTD. Units 6-8, Sunny Industrial Centre, 1/F 510 Cho Kwo Ling Road, Kwailoon Tel: 23489211-4 Fax: (852) 2727656		
S 銀同有限公司 Silver Town Limited Tel: 0769-83354988 Fax: 0769-83359554 E-MAIL: ADDRESS@silvertown-163.COM		
DRAWING TITLE: [4HL-.108]		
CAD File Name :		
Designed by		
Drawn by		
Reviewed by		
Approved by		
Scale		
DWG NO.: (MM4)-2 - [4HL-108]		REV: A

零件号: 4HL-109		零件数量: 1		零件重量: 18.01	
零件编号	规格(mm)	数量	重量(kg)	长度(mm)	表面积(m ²)
M558	PL5*50	1	1.60	700	0.09
M577	RHS150*75*8.0	1	16.41	700	0.14
		合计:		18.01	

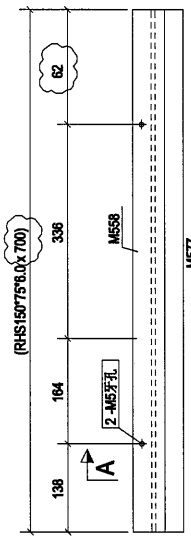

构件: 4HL-109

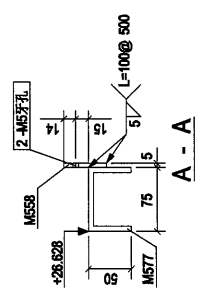

Rev.	第2次课批	Date
A		2018-08-22

PROJECT: PROPOSED SITE CI DEVELOPMENT AT AREA 88, TROTIL 70 RD, TSEUNG KWAN O, NEW TERRITORIES

CLIENT: 美特铝质有限公司
MIDI ALUMINIUM FABRICATOR LTD.
Units 6-8, Sunny Industrial Centre, 1/F
610 Che Kwo Ling Road, Kwailoon
Tel: 23483211-4 Fax: (852) 27271866

银同有限公司
Silver Town Limited
Tel: 0769-83354988 Fax: 0769-83359954
E-Mail: ADDRESS@silvertown.com


DRAWING TITLE: [4HL-109]

CAO File Name:


Designed by	
Drawn by	
Reviewed by	
Approved by	
Scale	

DWG NO: (MM)4-2 - [4HL-109] REV: A

零件编号: 4HL-110		零件数量: 1		零件重量: 18.16	
零件编号	规格(mm)	数量	重量(kg)	长度(mm)	厚度(mm)
		合计:	18.16		

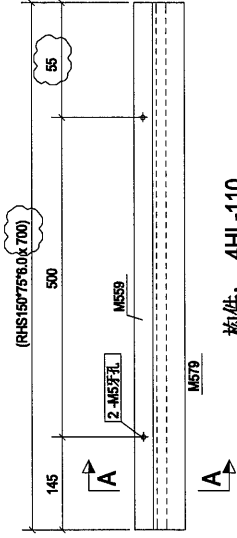

构件: 4HL-110

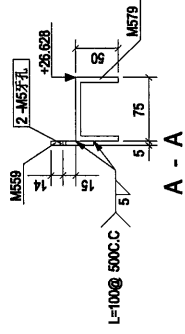

A	第2次修改	2018-08-22
Rev.	Description	Date
PROJECT: PROPOSED SITE C1 DEVELOPMENT AT AREA 86, TKOIL TO RP, TSEUNG KWAN O, NEW TERRITORIES		
CLIENT: 美特銀質有限公司 MIDI ALUMINIUM MANUFACTURER LTD. Units 6-8, Sunny Industrial Centre, 1/F 510 Chee Kwo Ling Road, Kwun Tong Tel: 23489211-4 Fax: (852) 27271986		
銀同有限公司 Silver Town Limited Tel: 0769-8334988 Fax: 0769-8335954 E-MAIL: ADDRESS: silvertown@163.com		
DRAWING TITLE: [4HL-.110]		
CAD File Name:		
Designed by		
Drawn by		
Reviewed by		
Approved by		
Scale		
DWG NO.: (WW4)-2 - [4HL-.110]		REV. A