

工程指示 / 要求簡箋(E.I.)

工程指示編號：EI/ 9620 /18 修改版次：  
 工程編號：J836 工程名稱：日出康城7期平台  
 工程項目：Skylight 鐵件生產  
 收件人：Maggie Lor 發件人：李耀鵬 日期：2018/8/15

要求提供 / 確認 事項：

- |                                    |                                     |                               |
|------------------------------------|-------------------------------------|-------------------------------|
| <input type="checkbox"/> 初步鋁料 B.M. | <input type="checkbox"/> 加工拆圖，然後生產  | <input type="checkbox"/> 尺寸表  |
| <input type="checkbox"/> 正式鋁料 B.M. | <input type="checkbox"/> 技術上資料 / 指示 | <input type="checkbox"/> 報價   |
| <input type="checkbox"/> 配件 B.M.   | <input type="checkbox"/> 樣辦或貨品說明書   | <input type="checkbox"/> 分判合約 |
| <input type="checkbox"/> 其他：_____  |                                     |                               |

內容：

煩請安排生產 Skylight 鐵件送地盤。  
 另拆圖注意指示回焊接位。  
 驗焊：100%目測，20%磁粉。

請在 2018/9/30 前完成上列要求。

附有關圖紙 / 文件：56 頁。

以上項目為：

- 原合約工程包                       原合約工程加 / 減賬                       新工程報價

原因：-

分發東莞各部門：

- ( ) 生產技術總監  連附件    ( ) 技術部     連附件    ( ) 生產部     連附件    ( ) 機械設計部  連附件  
 ( ) 採購部     連附件    ( ) 生產統籌部  連附件  
 ( ) 質檢部     連附件    ( ) 會計部     連附件    ( ) 報關組     連附件    ( ) 其他 \_\_\_\_\_  連附件

分發香港各部門：

- ( ) 行政部  連附件    ( ) 會計部  連附件    ( ) 統籌部  連附件    ( ) 工程部地盤科文  連附件  
 ( ) 採購部  連附件    ( ) QS 部  連附件    ( ) 維修部  連附件    ( ) 其他 \_\_\_\_\_  連附件


傳遞編號：

發件人簽署：

項目經理簽署：

1


30/09/18 送地盤

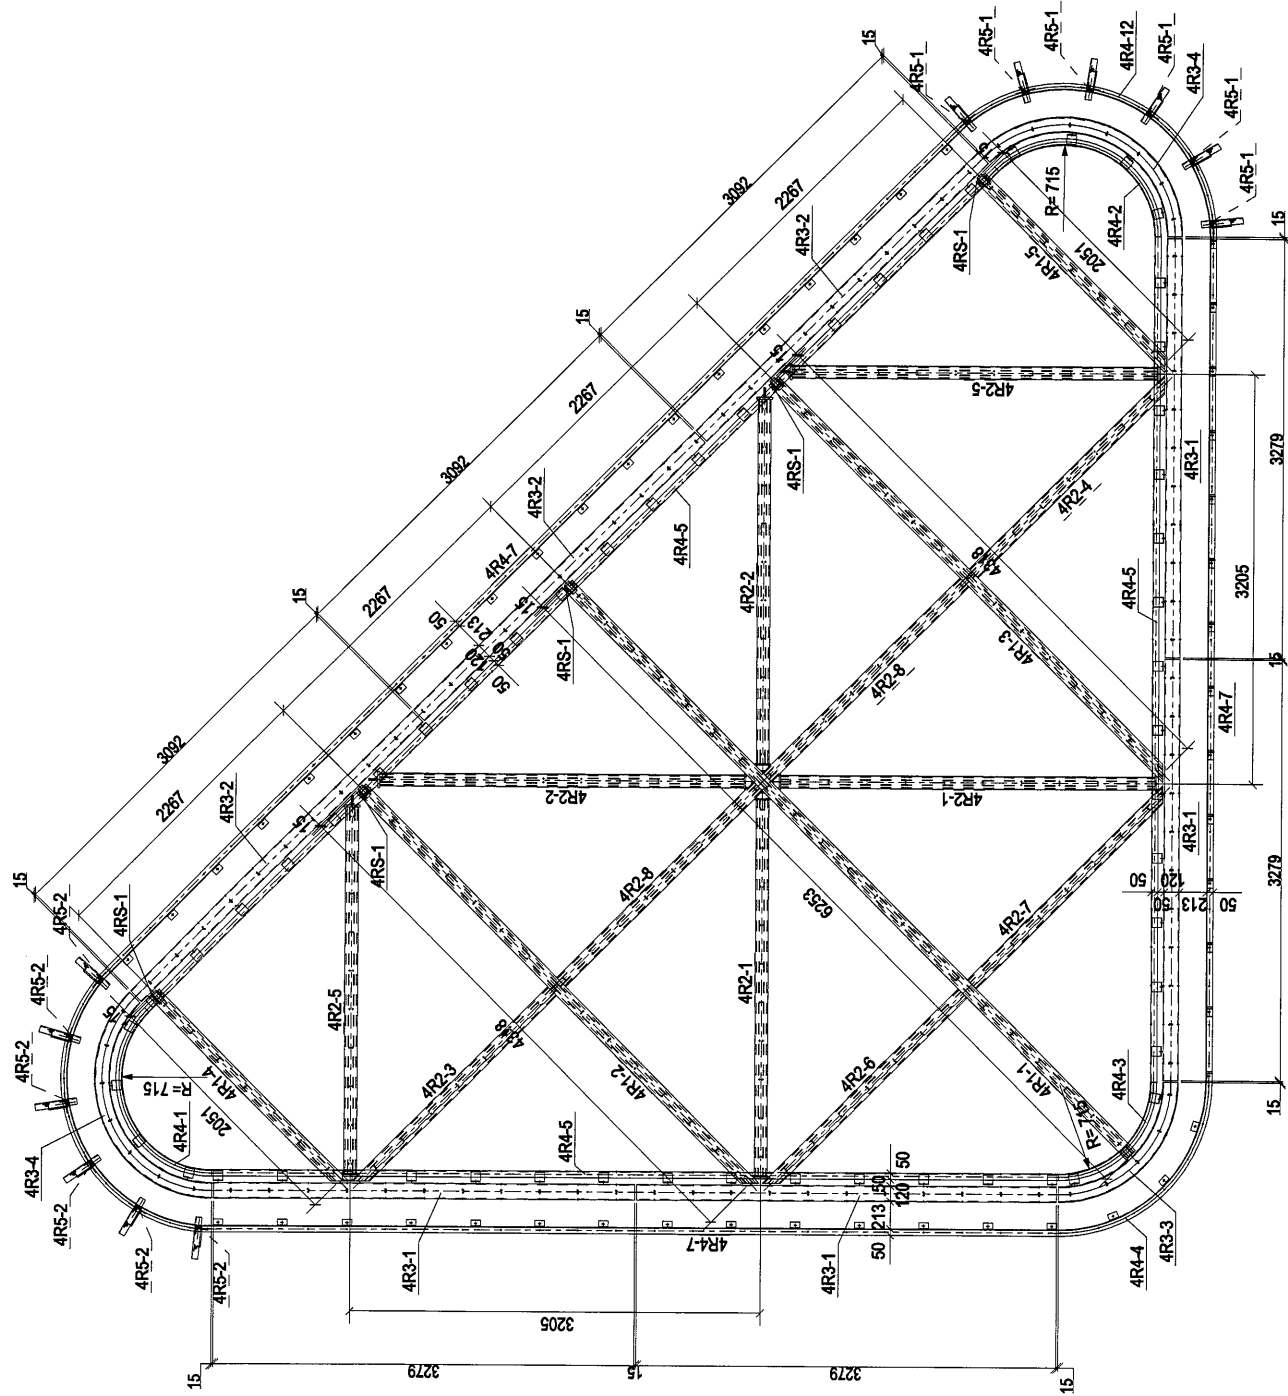


PART PLAN FOR SKYLIGHT AT 4/ F

A	第2次標批	2018-08-14
Rev.	Description	Date
PROJECT: PROPOSED SITE C1 DEVELOPMENT AT AREA 86, TROT 70 RP, TSEUNG KWAN O, NEW TERRITORIES		
CLIENT: 美特鋁質有限公司 MIDI ALUMINIUM MANUFACTURE LTD. Units 6-8, Sunny Industrial Centre, 1/F 510 Che Kwo Ling Road, Kwloon Tel: 23489211-4 Fax: (852) 27271656		
銀同有限公司 Silver Town Limited Tel: 0769-83354888 Fax: 0769-8335954 E-MAIL ADDRESS: silvertown@163.COM		
DRAWING TITLE: MARKING PLAN		
CAD File Name:		
Designed by:		
Drawn by:		
Reviewed by:		
Approved by:		
Scale:		
DWG NO.:	(SK-4/F) - MP01	REV. A

零件重量: 1		4R1-1		零件重量: 455.49	
零件编号	规格(mm)	数量	重量(kg)	共重(kg)	表面積(m <sup>2</sup> )
F39	PL15*33	2	5.29	10.58	0.24
F41	PL15*33.8	2	2.86	5.73	0.15
M616	PL5*99	1	8.43	8.43	0.45
M623	PL5*99	1	15.87	15.87	0.85
M641	RHS200*100*16.0	1	414.88	414.88	3.56
		合计:		455.49	

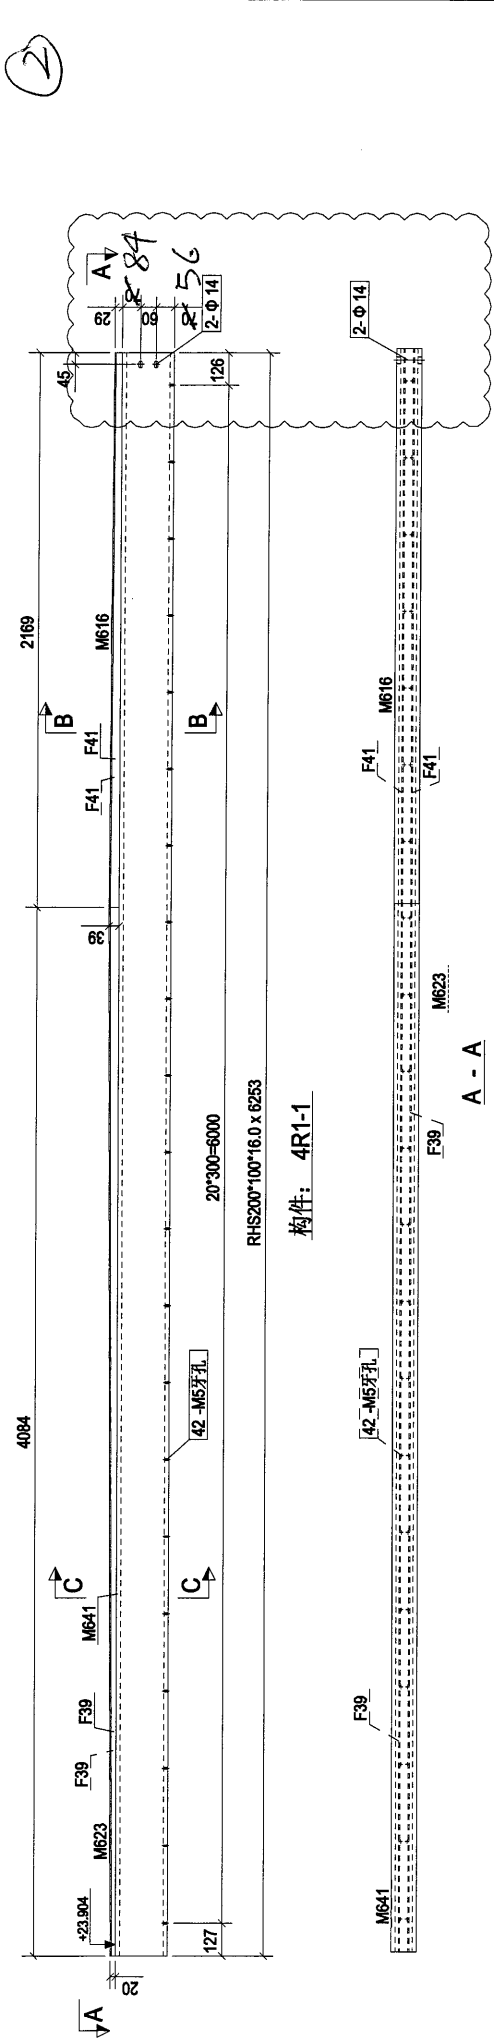


Rev.	第2次修改	2018-08-14	Date
PROJECT: PROPOSED SITE C1 DEVELOPMENT AT AREA 08, TKOIL TO RP, TSEUNG KWAN O, NEW TERRITORIES			
CLIENT: 美特鋁質有限公司 MIDI ALUMINIUM FABRICATOR LTD. Unit 8-B, Sunny Industrial Centre, 7/F 810 Cheong Chee Road, Kowloon TEL: 2469211-4 Fax: (852) 2722 686			
銀同有限公司 Silver Town Limited Tel: 0769-8335986 Fax: 0769-8335984 E-MAIL: ADDRESS@silvertown.hk			
DRAWING TITLE: [4R1-1]			
CAD File Name:			
Designed by:			
Drawn by:			
Reviewed by:			
Approved by:			
Scale:			
DWG NO.: (SK-41F) - [4R1-1]			
REV. A			

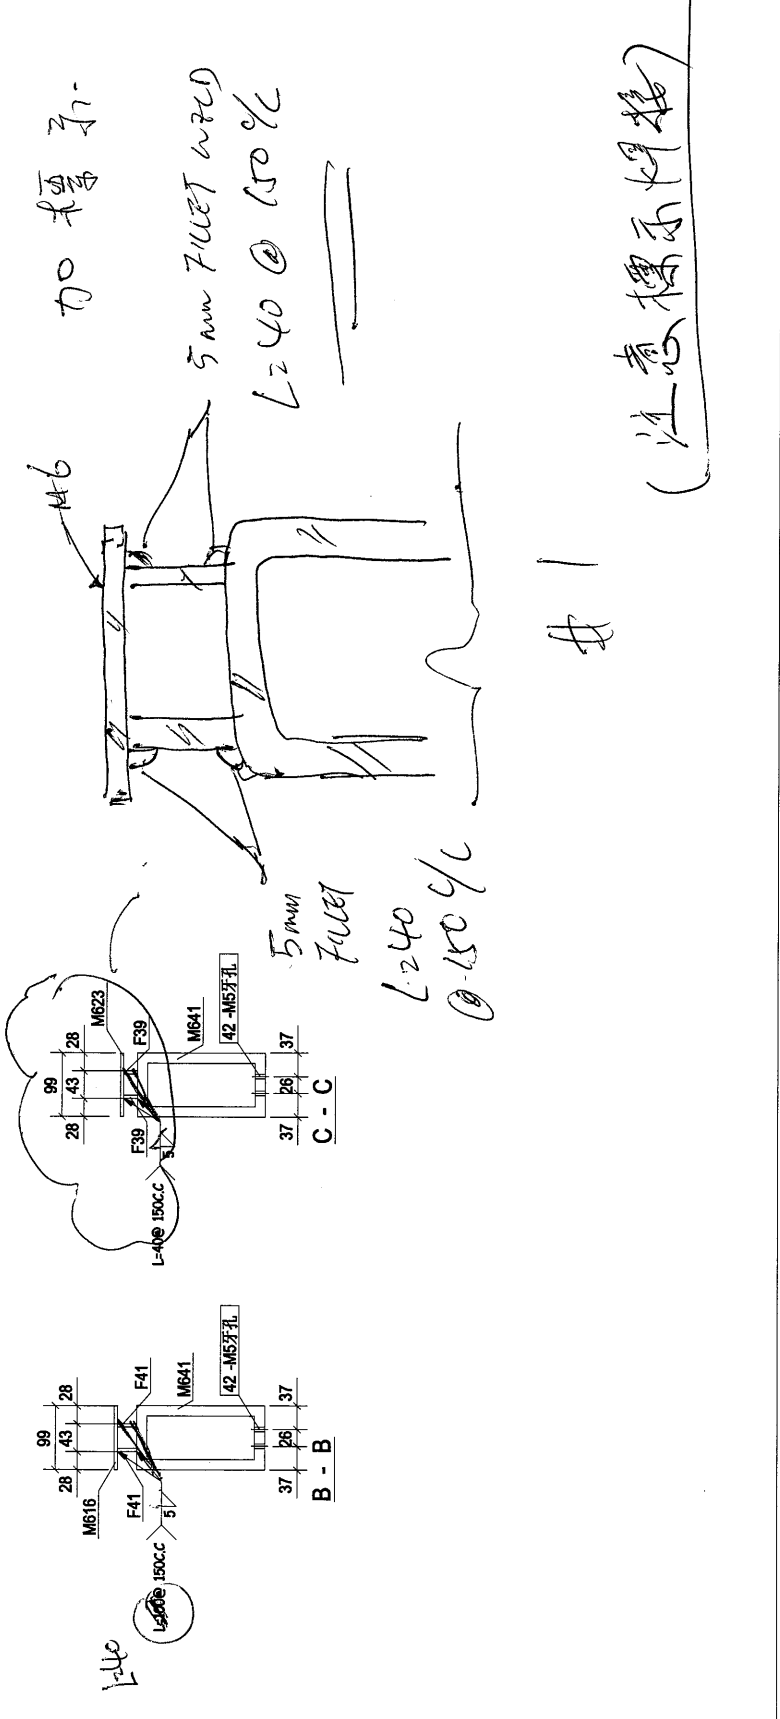

物料编号		4R1-2		物料数量		314.59	
零件号	规格	数量	单位	数量	单位	共重(kg)	注
F42	PL15*23.1	2	1.96	3.92	0.12		
F45	PL15*23.1	2183	1.93	1.93	0.11		
F46	PL15*23.1	2171	1.96	1.96	0.11		
M616	PL5*99	2169	1	8.43	8.43	0.45	
M617	PL5*99	2199	1	8.54	8.54	0.45	
M639	RHS200*100*16.0	4368	1	280.80	280.80	2.49	
合计:				314.59			

3

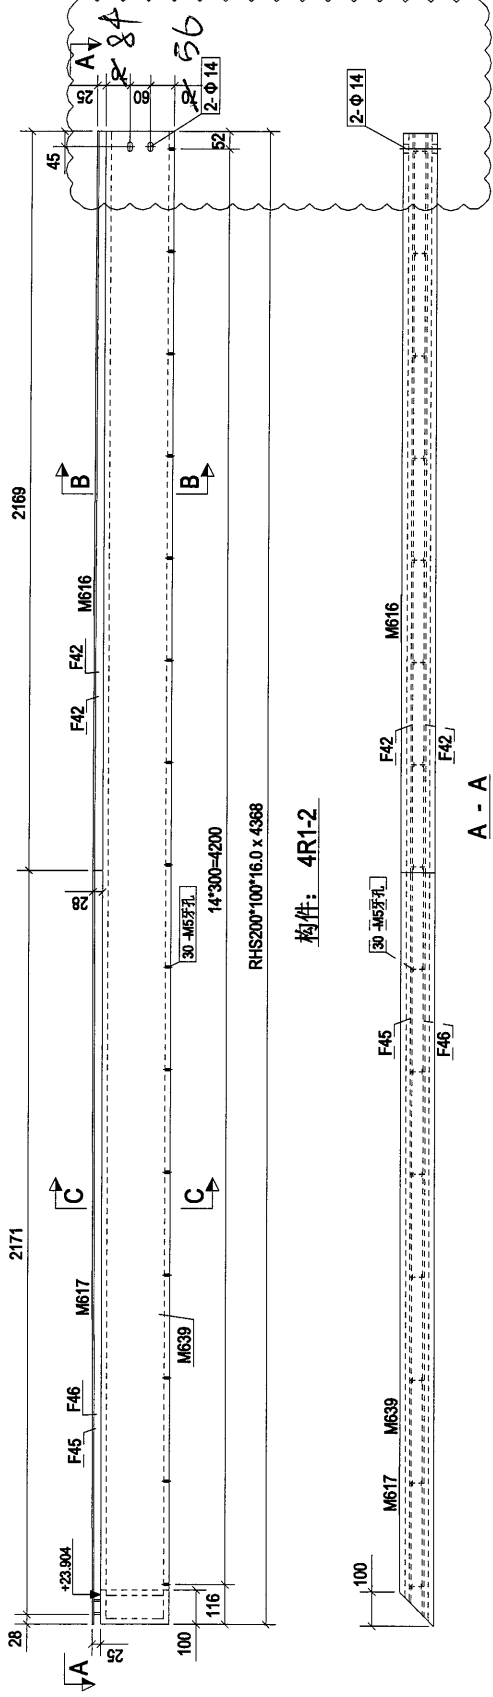

Rev.	第2次设计	2016-08-14	Date
A	Description		

PROJECT:  
 PROPOSED SITE C1  
 DEVELOPMENT AT AREA 08,  
 TKO TL70 RP, TSEUNG KWAN O,  
 NEW TERRITORIES


CLIENT:  
**美特铝质有限公司**  
 MTDI ALUMINIUM FABRICATORS LTD.  
 Unit 8-9, Sunray Industrial Centre, 1/F  
 810 Kwai Ling Road, Kwai Tsing  
 Tai Po, New Territories  
 Tel: 2468211-4 Fax: (852) 2727866

**银同有限公司**  
 Silver Town Limited  
 Tel: 0762-8335988 Fax: 0762-8335984  
 E-Mail: Address@silvertown.com.hk


DRAWING TITLE :  
**[4R1-2]**

CAD File Name :	
Designed by	
Drawn by	
Reviewed by	
Approved by	
Scale	


DWG NO.:	(SK-41F) - [4R1-2]	REV.	A
----------	--------------------	------	---

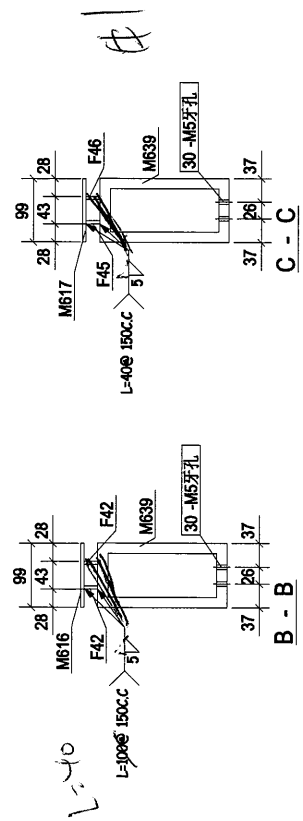

零件編號		4R1-3		零件數量		1		零件重量		314.59	
合計:										314.59	

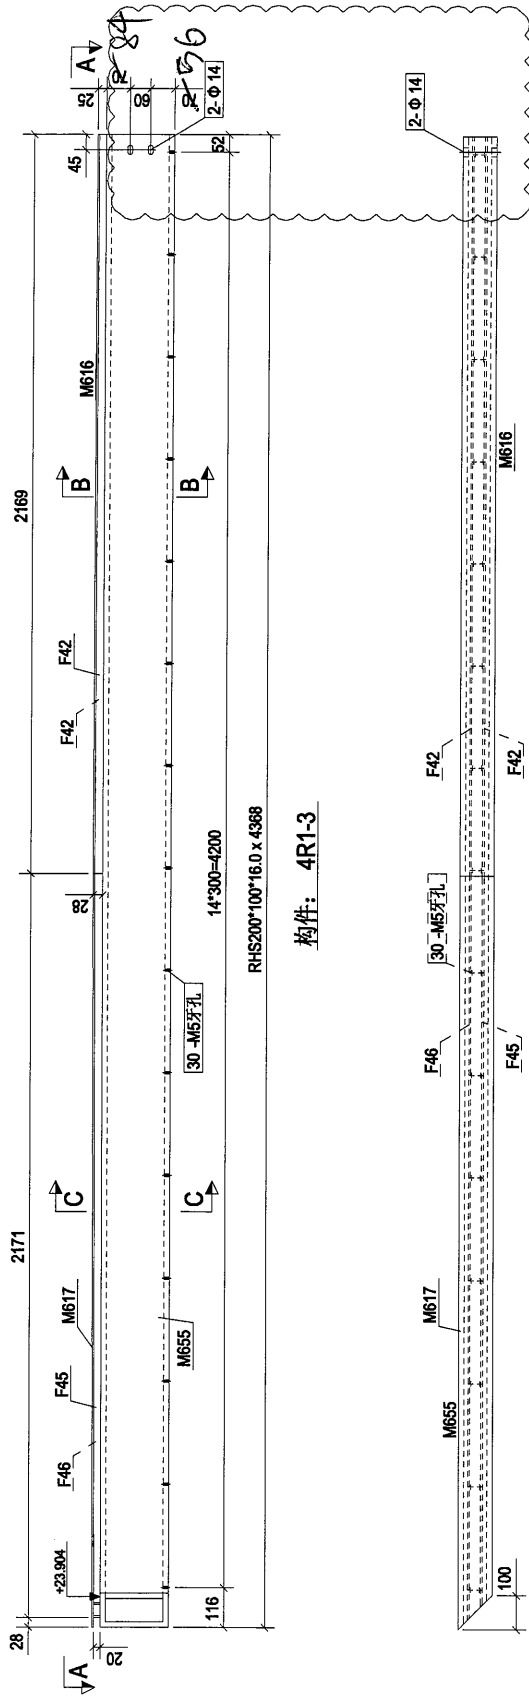


構件: 4R1-3

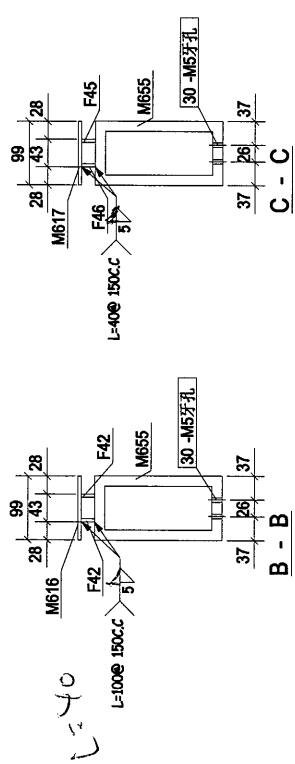


Rev.	第2次修改	Date	2018-08-14
PROJECT:	PROPOSED SITE C1 DEVELOPMENT AT AREA 06, TKOIL TO RP, TSEUNG KWAN O, NEW TERRITORIES		
CLIENT:	<b>美特鋁質有限公司</b> MIDALUMINUM MANUFACTURE LTD. Unit 6-8, Sunny Industrial Centre, 1/F 810 Cheung Yee Ling Road, Cheung Yee Ling Tai Po, New Territories, Hong Kong Tel: 23489211-4, Fax: (852) 27272686		
DRAWING TITLE:	<b>銀同有限公司</b> Silver Town Limited Tel: 0755-8335988 Fax: 0755-8335984 E-MAIL: ADDRESS@silvertown.hk.COM		
CAD File Name:	[4R1-3]		
Designed by			
Drawn by			
Reviewed by			
Approved by			
Scale			
DWG NO.:	(SK-41F) - [4R1-3]		REV. A

零件编号	4R1-4	零件数量	1	零件重量	149.67
零件编号	规格(mm)	数量	共重(kg)	表面积(m <sup>2</sup> )	
F43	PL15*13	2073	1.06	1.06	0.07
F44	PL15*13	2035	1.04	1.04	0.07
M613	PL5*99	2101	8.16	6.16	0.43
M640	RHS200*100*16.0	1	138.41	138.41	1.20
合计:				149.67	

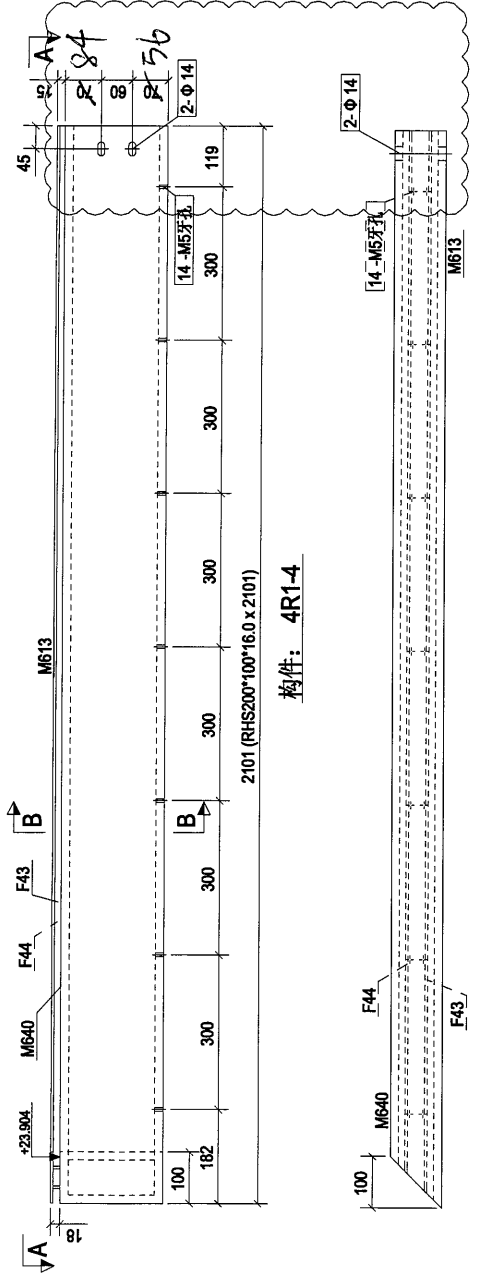

构件: 4R1-4

A - A

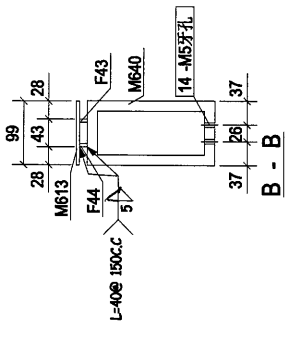


B - B

Rev.	第2次报批	Date	2018-08-14
PROJECT: PROPOSED SITE C1 DEVELOPMENT AT AREA 88, TKOIL 70 RP, TSEJING KWAN O, NEW TERRITORIES			
CLIENT: 美特铝质有限公司 MIDI ALUMINIUM FABRICATOR LTD. Unit 8-9, Sunny Industrial Centre, 1/F 810 Canton Road, Tseung Kwan O, New Territories Tel: 23489211-4 Fax: (852) 27727686			
S 银同有限公司 Silver Town Limited Tel: 0769-8335988 Fax: 0769-8305854 E-Mail: ADDRESS@silvertown.hk			
DRAWING TITLE: [4R1-4]			
CAD File Name:			
Designed by:			
Drawn by:			
Reviewed by:			
Approved by:			
Scale:			
DWG NO.: (SK-41F) - [4R1-4]			REV. A


零件编号	规格(mm)	数量	重量(kg)	共重(kg)	漆重(m)
F43	PL15*13	2073	1	1.06	0.07
F44	PL15*13	2035	1	1.04	0.07
M613	PL5*99	2101	1	8.16	0.43
M654	RHS200*100*16.0	2101	1	139.41	1.20
合计:				149.67	

零件重量: 149.67

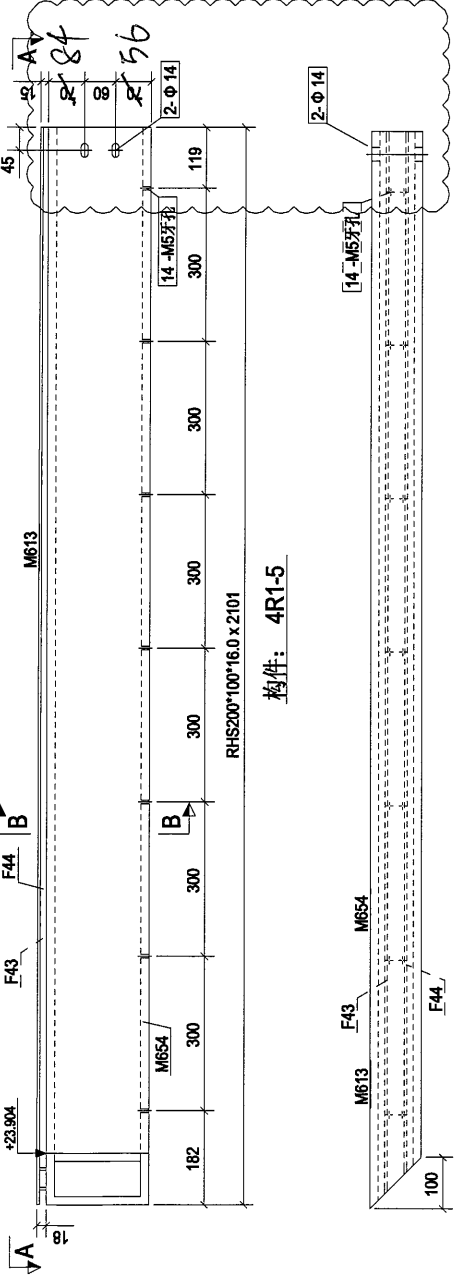

构件: 4R1-5

A - A

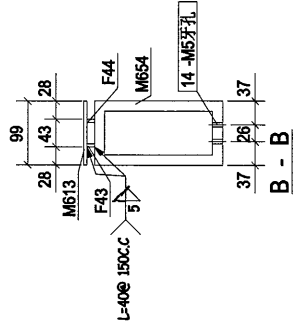


B - B

Rev.	第2次排批	Date	2018-08-14
PROJECT: PROPOSED SITE C1 DEVELOPMENT AT AREA B8, TKOIL TO RP, T'SEUNG KWAN O, NEW TERRITORIES			
CLIENT: 美特铝质有限公司 M.T.D. Aluminium Fabricator Ltd. Units 6-8, Sunny Industrial Centre, 610 Che Kwo Ling Road, Kwailoon, Tel: 2489211-4, Fax: (852) 27727666			
S 银同有限公司 Silver Town Limited FACILITY DEVELOPMENT DIVISION E-MAIL: ADDRESS@SILVERTOWN.COM			
DRAWING TITLE: [4R1-5]			
CAD File Name:			
Designed by			
Drawn by			
Reviewed by			
Approved by			
Scale			
DWG NO.: (SK-41F) - [4R1-5]			REV. A

6


4R2-1		2		148.11	
零件编号	数量	长度(mm)	重量(kg)	共重(kg)	表面积(m <sup>2</sup> )
F35	1	70	0.38	0.38	0.01
F38	2	2924	3.79	7.57	0.18
M621	1	2924	11.36	11.36	0.81
M632	1	200	1.91	1.91	0.05
M633	1	200	1.86	1.86	0.05
M653	1	2924	26.02	26.02	1.88
合计:				48.11	

②

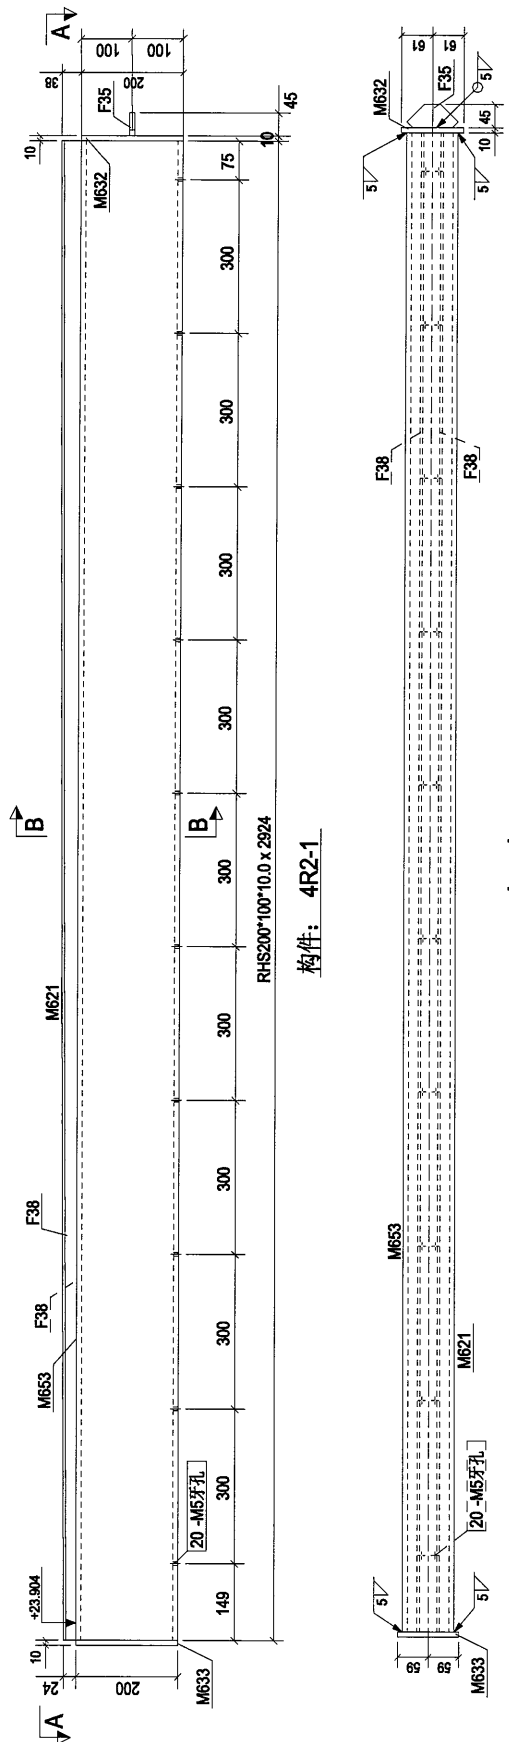

构件: 4R2-1


A - A

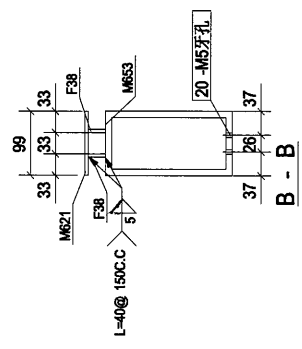


Rev.	0	第1次批准	2018-08-10	Date	
PROJECT: PROPOSED SITE C1 DEVELOPMENT AT AREA 88, TKOIL 70 RP, TSEUNG KWAN O, NEW TERRITORIES					
CLIENT: 美特鋁質有限公司 MTDI Aluminium Fabricative Ltd. 1188 S.8, Sunny Industrial Centre, 1/F, 510 Chee Chee Street, Tseung Kwan O, New Territories, Hong Kong Tel: 23489211-4, Fax: (852) 2727666					
S 銀同有限公司 Silver Town Limited Tel: 7762-8335988 Fax: 2789-4335984 E-Mail: Address@silvertown.com.hk					
DRAWING TITLE: [4R2-1]					
CAD File Name:					
Designed by:					
Drawn by:					
Reviewed by:					
Approved by:					
Scale:					
DWG NO.: (SK-41F) - [4R2-1]				REV.	0

零件编号: 4R2-2		零件数量: 2		零件重量: 148.27	
零件编号	规格(mm)	数量	重量(kg)	共重(kg)	表面积(m <sup>2</sup> )
F35	PL110*70	1	0.38	0.38	0.01
F40	PL15*33	2	3.69	7.38	0.18
M622	PL5*99	1	11.08	11.08	0.59
M630	PL15*125	200	2.94	2.94	0.08
M631	PL15*73.7	200	1.74	1.74	0.04
M632	PL10*121.4	200	1.91	1.91	0.05
M651	RHS200*100*10.0	2850	122.84	122.84	1.84
合计:				148.27	


8

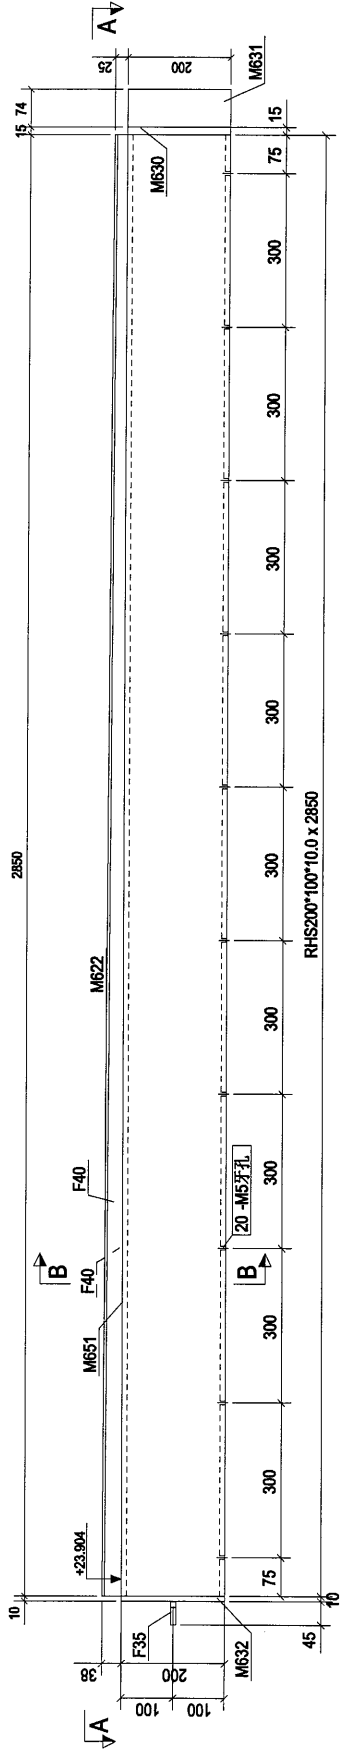

构件: 4R2-2

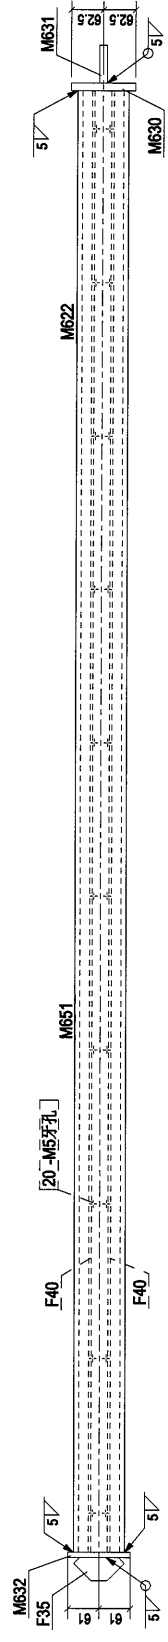


A - A

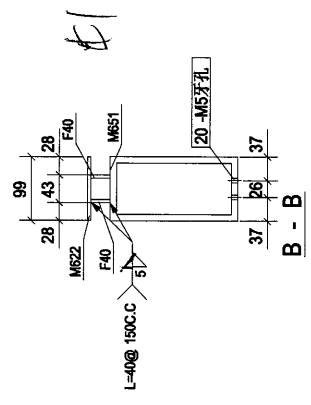


B - B

0	第1次报批	2018-08-10
Rev.	Description	Date
PROJECT: PROPOSED SITE C1 DEVELOPMENT AT AREA 88, TKOIL 70 RP, TSEJUNG KWAN O, NEW TERRITORIES		
CLIENT: 美特铝质有限公司 MIDI ALUMINIUM FABRICATOR LTD. Unit 6-8, Sunny Industrial Centre, 1/F 180 Cheung Ling Road, Tseung Kwan O, N.T. Tel: 2489211-4 Fax: (852) 27272666		
S 银同有限公司 Silver Town Limited Tel: 0769-8335968 Fax: 0769-8335954 E-MAIL: ADDRESS@silvertown.com.hk		
DRAWING TITLE: [4R2-2]		
CAD File Name:		
Designed by:		
Drawn by:		
Reviewed by:		
Approved by:		
Scale:		
DWG NO.: (SK-4/F) - [4R2-2]		REV: 0


零件编号:		4R2-3		零件数量:		1		零件重量:		104.84	
合计:										104.84	

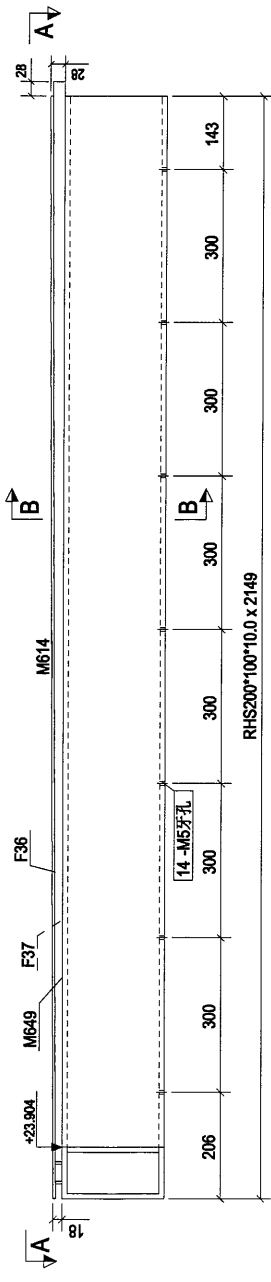

构件: 4R2-3

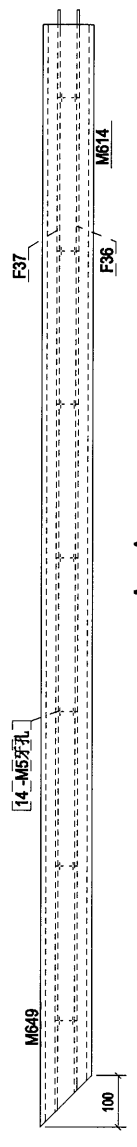

A - A

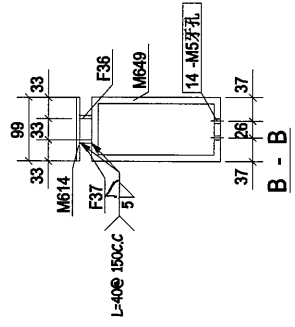


B - B


Rev.	0	第1次报数	2018-08-10	Date	
PROJECT: PROPOSED SITE C1 DEVELOPMENT AT AREA B6, TKOIL TO RP, TSEUNG KWAN O, NEW TERRITORIES					
CLIENT: 美特铝质有限公司 MIDI ALUMINIUM FABRICATORS LTD. Unit 5-8, Sunny Industrial Centre, 7/F 810 Cheong Cheong Street, Tseung Kwan O 16423489211-4 Fax: (852)27727666					
CLIENT: 银同有限公司 Silver Town Limited Tel: 7768-8335988 Fax: 7769-8335984 E-MAIL: ADDRESS@silvertown.com.hk					
DRAWING TITLE: [4R2-3]					
CAD File Name:					
Designed by:					
Drawn by:					
Reviewed by:					
Approved by:					
Scale:					
DWG NO.: (SK-4/F) - [4R2-3]				REV.	0



10

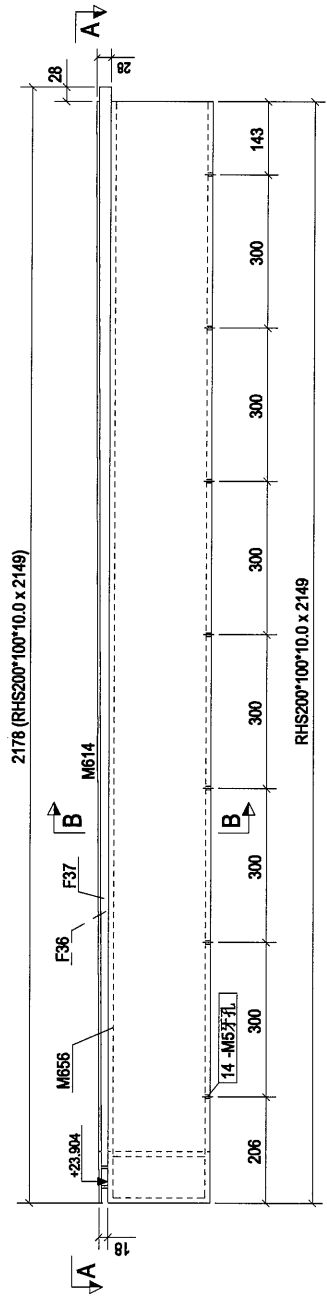

物料: 4R2-4

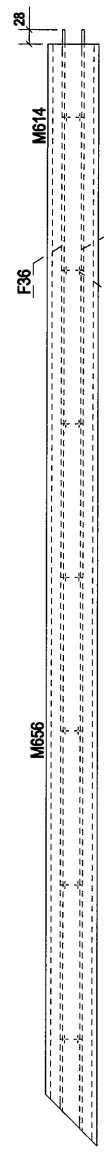

A - A

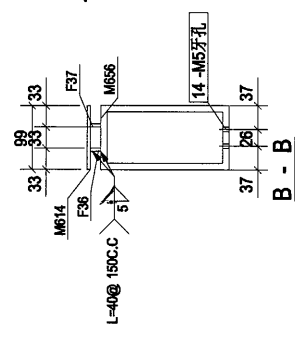


B - B



Rev.	0	第一次批准	2018-08-10	Date	
PROJECT: PROPOSED SITE C1 DEVELOPMENT AT AREA 86, 1KOTL 70 RP, TSEUNG KWAN O, NEW TERRITORIES					
CLIENT: 美特铝质有限公司 MTDI Aluminium Fabrication Ltd. 11th Floor, Sunny Industrial Centre, 7/F, 510 Canton Road, Tseung Kwan O, New Territories Tel: 23488211-4, Fax: (852) 2727866					
S 银同有限公司 Silver Town Limited Tel: 0768-8335988 Fax: 0768-8335984 E-Mail: Address@silvertown.com.hk					
DRAWING TITLE: [4R2-4]					
CAD File Name:					
Designed by:					
Drawn by:					
Reviewed by:					
Approved by:					
Scale:					
DWG NO. (SK-4/F) - [4R2-4]				REV.	0

零件编号		4R2-5		零件数量		2		零件重量		145.01	
合计:										145.01	

17

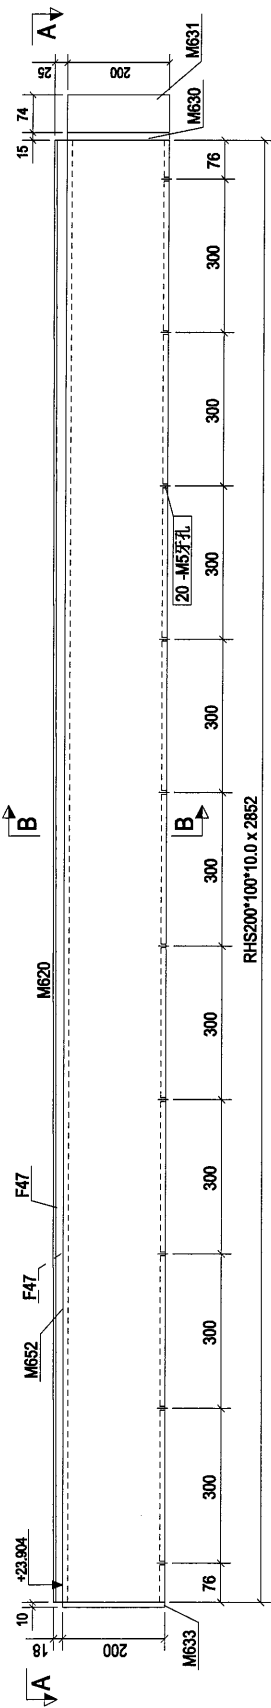

构件: 4R2-5

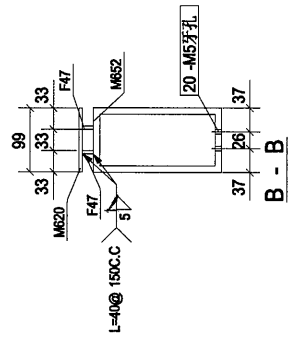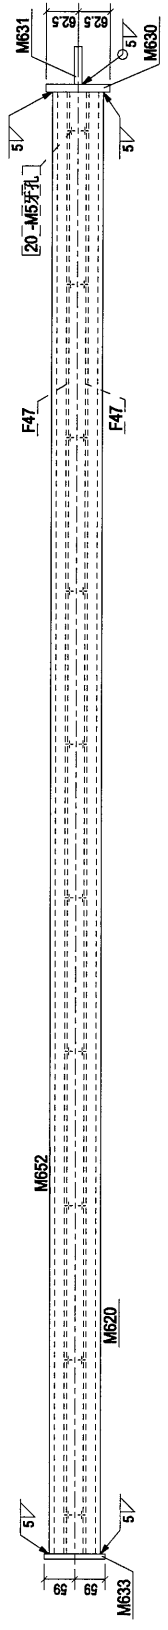


A - A

B - B


Rev.	0	第1次提批	2018-08-10	Date
PROJECT:	PROPOSED SITE C1 DEVELOPMENT AT AREA B6, TKOTI 70 RP, TSEUNG KWAN O, NEW TERRITORIES			
CLIENT:	美特铝质有限公司 MIDI ALUMINIUM FABRICATOR LTD. 15th Fl., Sunny Industrial Centre, 1/F 510 Chai Kwong Street, Tseung Kwan O Tel: 23483211-4, Fax: (852) 27727686			
DRAWING TITLE:	[4R2-5]			
CAD File Name:	[4R2-5]			
Designed by				
Drawn by				
Reviewed by				
Approved by				
Scale				
DWG NO.:	(SK-41F) - [4R2-5]			REV.
				0

零件编号		4R2-6		零件数量		1		零件重量		104.78	
零件编号	规格(mm)	数量	重量(kg)	数量	重量(kg)	共重(kg)	共重(lb)	表面积(m <sup>2</sup> )	表面积(ft <sup>2</sup> )		
M614	PL5*99	2149	1	1	8.35	8.35	0.44				
M649	RHS200*100*10.0	2149	1	1	92.62	92.62	1.23				
合计:										104.78	


12

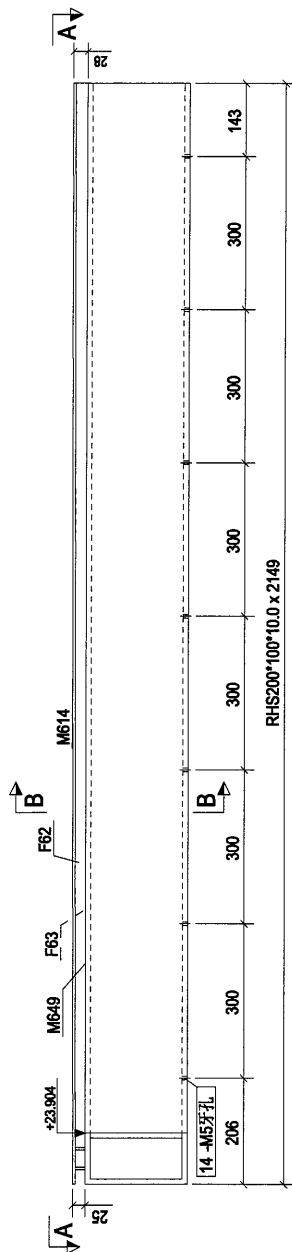

构件: 4R2-6

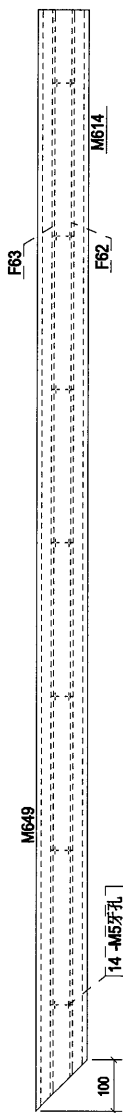

A - A

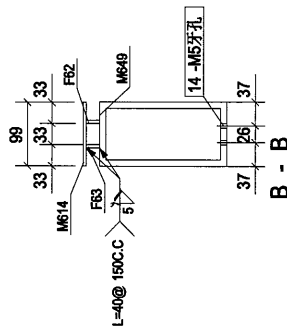


B - B



0	第1次报批	2018-08-10
Rev.	Description	Date
PROJECT: PROPOSED SITE C1 DEVELOPMENT AT AREA 86, TKOT, 70 RP, TSEUNG KWAN O, NEW TERRITORIES		
CLIENT: 美特铝质有限公司 MIDI ALUMINIUM FABRICATOR LTD. Units E-8, Sunny Industrial Centre, 1/F 140 Cheung Cheong Street, Cheung Sha Tel: 23488211-4 Fax: (852) 27272666		
S 银同有限公司 Silver Town Limited Tel: 0768-8335986 Fax: 0768-8335954 E-Mail: Address@silvertown.com.hk		
DRAWING TITLE: [4R2-6]		
CAD File Name:		
Designed by		
Drawn by		
Reviewed by		
Approved by		
Scale		
DWG NO.: (SK-41F) - [4R2-6]		REV: 0

构件数量: 1		构件重量: 104.78	
构件编号	长度(mm)	重量	共重(kg)
F62	2083	1.89	1.89
F63	2121	1.92	1.92
M614	2149	8.35	8.35
M656	RHS200*100*10.0	92.62	92.62
合计:			104.78

③

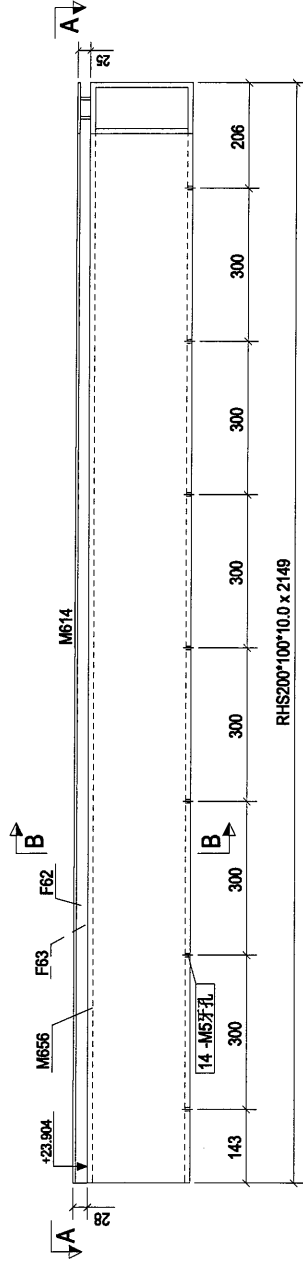


构件: 4R2-7

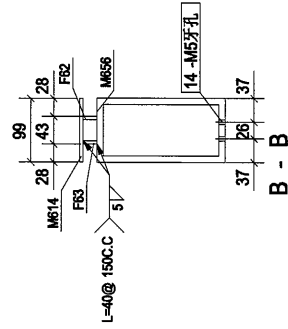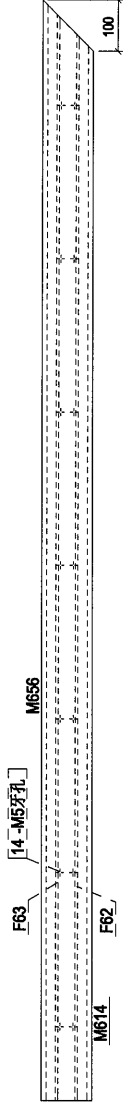


0	第一次报批	2018-08-10
Rev.	Description	Date
PROJECT: PROPOSED SITE C1 DEVELOPMENT AT AREA B6, TKOIL 70 RP, TSEUNG KWAN O, NEW TERRITORIES		
CLIENT: 美特铝质有限公司 MIDI ALUMINIUM FABRICATOR LTD. Units 6-8, Sunny Industrial Centre, 1/F On Yee Road, Kwai Tsing Tel: 23492411-4, Fax: (852) 2727666		
S 银同有限公司 Silver Town Limited Tel: 0769-4335488 Fax: 0769-4335954 E-MAIL: ADDRESS@silvertown.hk		
DRAWING TITLE : [4R2-7]		
CAD File Name :		
Designed by		
Drawn by		
Reviewed by		
Approved by		
Scale		
DWG NO: (SK-4/F) - [4R2-7]		REV: 0

料件编号:		4R2-8		料件数量:		2		料件重量:		107.59	
料件编号	规格(mm)	数量	重量(kg)	料件编号	规格(mm)	数量	重量(kg)	料件编号	规格(mm)	数量	重量(kg)
F64	PL15*33.8	2	2.90	M615	PL15*99	1	8.42	M650	RHS200*100*10.0	1	93.37
合计: 107.59											


(10)

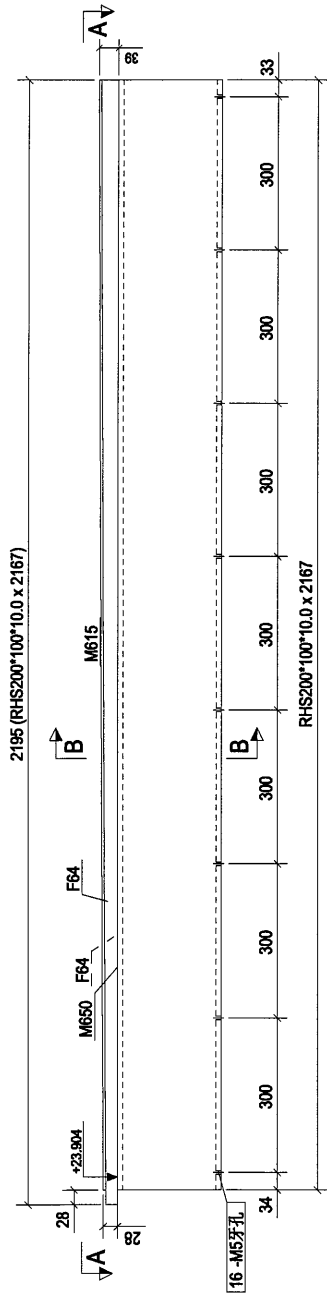

构件: 4R2-8

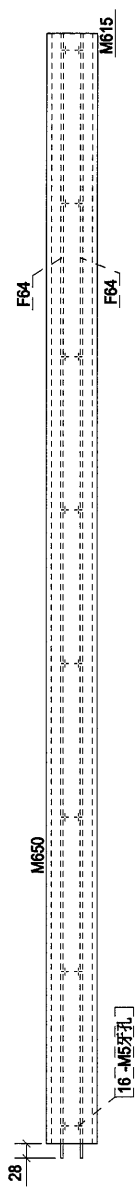

A - A

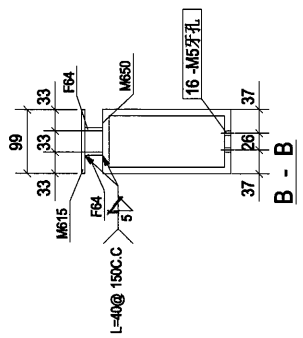


B - B


0	第1次报批	2016-08-10
Rev.	Description	Date
PROJECT: PROPOSED SITE C1 DEVELOPMENT AT AREA 08, TKOIL TO RP, TSEUNG KWAN O, NEW TERRITORIES		
CLIENT: 美特鋁質有限公司 MIDI ALUMINIUM FABRICATOR LTD. Unit 8-9, Saung Industrial Centre, 1/F 510 Canton Road, Kwun Tong, Kowloon Tel: 23488211-4 Fax: (852)27727886		
S 銀同有限公司 Silver Town Limited Tel: 0769-8332666 Fax: 0769-8332654 E-mail: address@silvertown.com.hk		
DRAWING TITLE: [4R2-8]		
CAD File Name:		
Designed by:		
Drawn by:		
Reviewed by:		
Approved by:		
Scale:		
DWG NO.: (SK-41F) - [4R2-8]		REV: 0

零件编号	4R3-1	零件数量	4	构作重量	96.91
零件编号	M624	长度(mm)	3279	重量	2.95
		厚度(mm)	1	共重(kg)	96.91
				共重(lb)	2.15
				合计	96.91

1.5

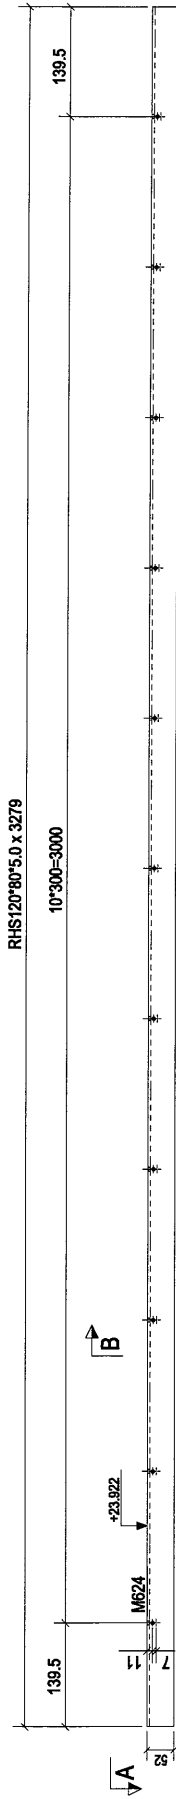

构件: 4R3-1

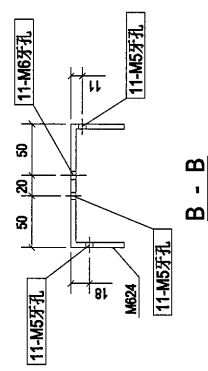

Rev.	A	第2次改排	2016-08-14
		Description	Date

PROJECT:  
 PROPOSED SITE C1  
 DEVELOPMENT AT AREA 08,  
 TKOIL 70 RP, TSEUNG KWAN O,  
 NEW TERRITORIES

CLIENT:  
**美特铝质有限公司**  
 MIDTI ALUMINIUM FABRICATOR LTD.  
 1/F, 8, Sunny Industrial Centre, 1/F  
 410, Cheong Cheong Street, Tseung Kwan O  
 Tel: 23482111-4, Fax: (852) 2727666

**S 银同有限公司**  
 Silver Town Limited  
 Tel: 0769-8335498 Fax: 0769-4335984  
 E-MAIL: ADDRESS@silvertown.com.hk


DRAWING TITLE :  
**[4R3-1]**

CAD File Name :	
Designed by	
Drawn by	
Reviewed by	
Approved by	
Scale	

DWG NO. (SK-4/F) - [4R3-1]	REV.
	A

零件编号	4R3-2	零件数量	3	零件重量	137.05
规格	RHS120*80*5.0	长度(mm)	3082	数量	1
M625		共重(kg)	137.05	共重(kg)	137.05
		面积(m <sup>2</sup> )		面积(m <sup>2</sup> )	3.61
				合计:	137.05

137.05

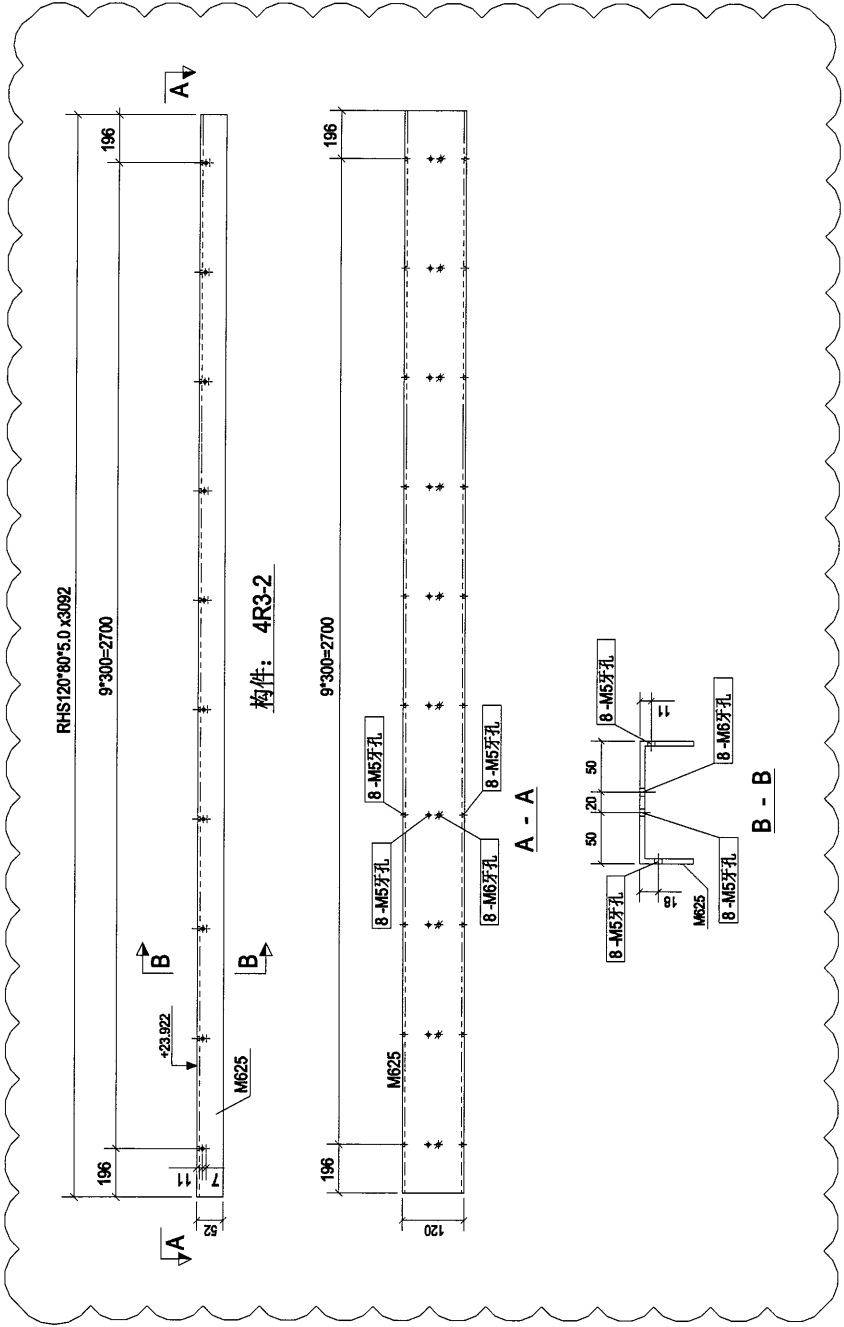

A	第2次排板	2018-08-14
Rev.	Description	Date

PROJECT:  
 PROPOSED SITE C1  
 DEVELOPMENT AT AREA 86,  
 TKOIL70 RP, TSEUNG KWAN O,  
 NEW TERRITORIES

CLIENT:  
**美特鋁質有限公司**  
 MIDTI ALUMINIUM FABRICATOR LTD.  
 Unit 5-8, Saing Industrial Centre, 1/F  
 818 Cheung Cheong Street,  
 Tai Po, New Territories  
 Tel: 23488211-1 Fax: (852) 27272866

**銀同有限公司**  
 Silver Town Limited  
 Tel: 0769-8339686 Fax: 0769-8339854  
 E-mail: alic@silvertown.hk


DRAWING TITLE :  
**[4R3-2]**

CAD File Name :	
Designed by	
Drawn by	
Reviewed by	
Approved by	
Scale	



DWG NO.:	(SK-41F) - [4R3-2]
REV.	A

料件编号:	4R3-3	料件数量:	1	料件重量:	20.18
零件号:	料号(mm)	数量	重量(kg)	共重(kg)	净重(kg)
M626	RHS120*80*5.0	1	20.18	20.18	0.53
			合计:	20.18	

17

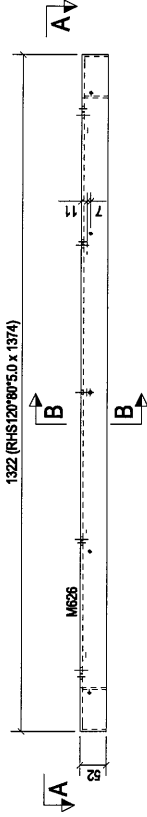


构件: 4R3-3

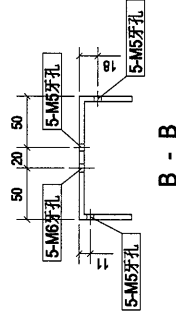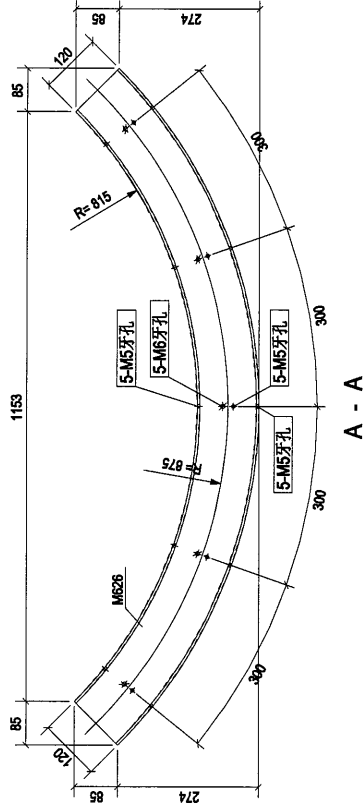



0	第一次提批	2018-08-10
Rev.	Description	Date
PROJECT: PROPOSED SITE C1 DEVELOPMENT AT AREA 08, TKOTL 70 RP, TSEUNG KWAN O, NEW TERRITORIES		
CLIENT: <b>美特铝质有限公司</b> MTDI Aluminium Fabrication Ltd. Unit 8-9, Sunny Industrial Centre, 1/F 500 Cheong Cheong Street, Tseung Kwan O, New Territories Tel: 23489211-4, Fax: (852) 2727686		
<b>银同有限公司</b> Silver Town Limited Tel: 0769-8335988 Fax: 0769-8335984 E-MAIL: ADDRESS@silvertown.com.hk		
DRAWING TITLE : <b>[4R3-3]</b>		
CAD File Name :		
Designed by		
Drawn by		
Reviewed by		
Approved by		
Scale		
DWG NO. (SK-41F) - [4R3-3]		REV. 0

料件编号:	4R3-4	料件数量:	2	料件重量:	30.26
零件编号:	RHS120*80*5.0	长度(mm):	2062	重量(kg):	30.26
M827		数量:	1	共重(kg):	30.26
				共重(kg):	0.80
				合计:	30.26

18

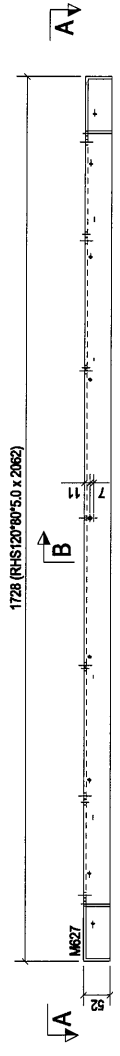


构件: 4R3-4

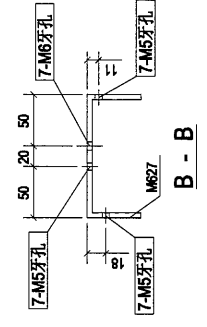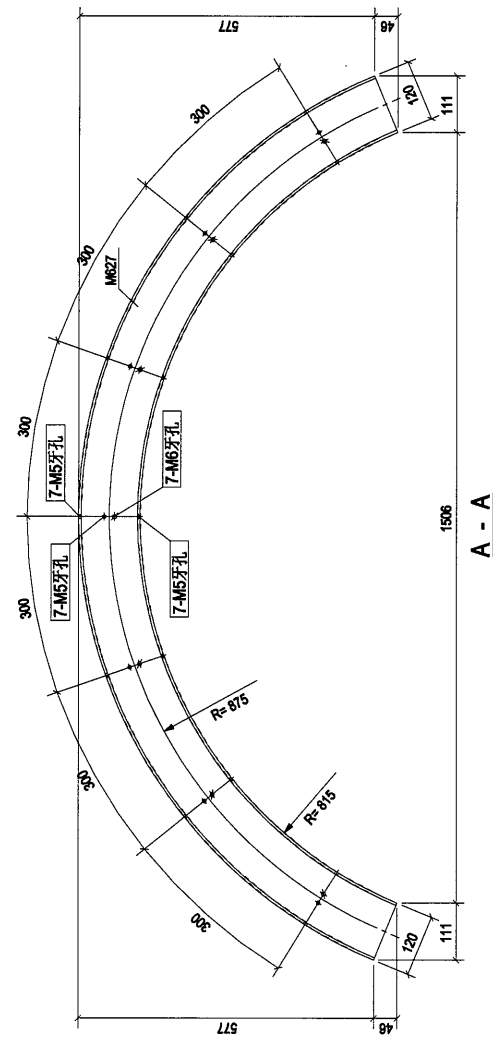

0	第1次批核	2016-08-10
Rev.	Description	Date
PROJECT: PROPOSED SITE C1 DEVELOPMENT AT AREA 08, TKOIL TQ RP, TSEUNG KWAN O, NEW TERRITORIES		
CLIENT: 美特铝质有限公司 M.T.D. Aluminium Fabricator Ltd. 116, 5th Floor, Sunco Industrial Building, 1/F, 810 Chee Kwo Ling Road, Kwai Tsing, New Territories Tel: 23489211-4, Fax: (852) 2727686		
S 银同有限公司 Silver Town Limited Tel: 0769-8339886 Fax: 0769-8339884 E-mail: 808233@silvertown.com.hk		
DRAWING TITLE: [4R3-4]		
CAD File Name:		
Designed by		
Drawn by		
Reviewed by		
Approved by		
Scale		
DWG NO.: (SK-4/F) - [4R3-4]		REV: 0


CS

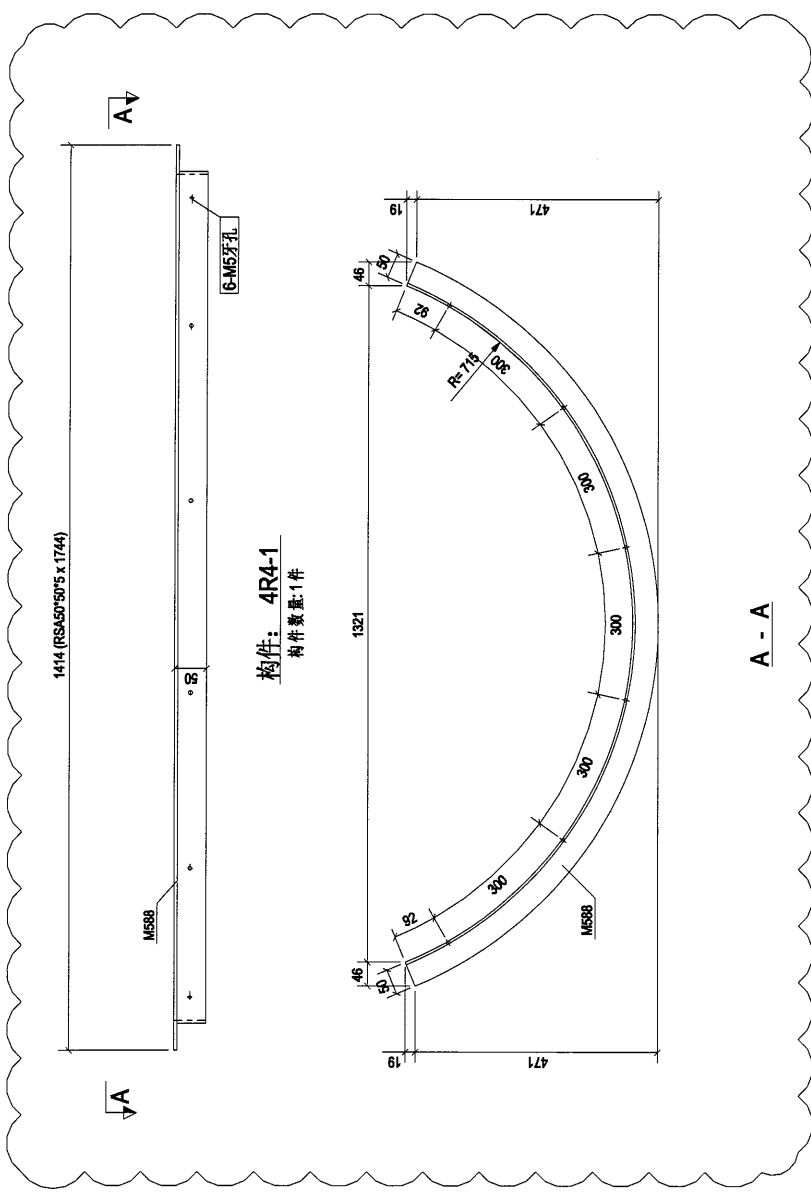

构件: 4R4-1  
 构件数量: 1件


A	第2次批准	2018-08-14
Rev.	Description	Date
PROJECT: PROPOSED SITE C1 DEVELOPMENT AT AREA 88, TKOIL 70 RP, TSEUNG KWAN O, NEW TERRITORIES		
CLIENT: 美特鋁質有限公司 MIDTI ALUMINIUM FABRICATOR LTD. Units C-6, Sunny Industrial Centre, 1/F 8160 Cheung Kwai Ling Road, Tseung Kwan O, New Territories Tel: 2489211-4 Fax: (852) 2727866		
銀同有限公司 Silver Town Limited Tel: 0768-8335968 Fax: 0768-8335954 E-MAIL: ADDRESS@silvertown.com.hk		
DRAWING TITLE: [4R4-1]		
CAD File Name :		
Designed by		
Drawn by		
Reviewed by		
Approved by		
Scale		
DWG NO.: (SK-41F) - [4R4-1]		REV. A

22

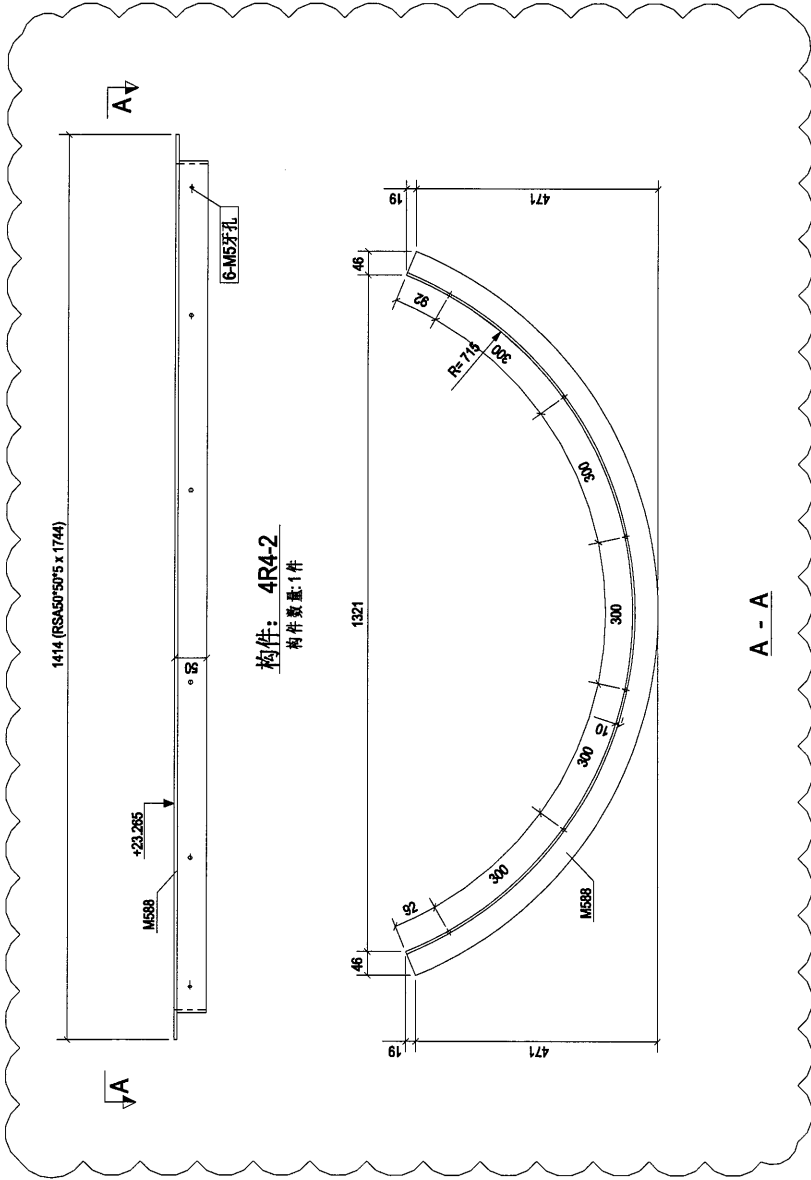

A	第2次批准	2018-08-14
Rev.	Description	Date
PROJECT: PROPOSED SITE C1 DEVELOPMENT AT AREA 88, TKO TL 70 RP, TSEUNG KWAN O, NEW TERRITORIES		
CLIENT: 美特鋁質有限公司 MTDI Aluminium Fabrication Ltd. Unit 5-8, Sunny Industrial Centre, 1/F 100, King Road, Tseung Kwan O, New Territories Tel: 23489211-4 Fax: (852) 27727886		
S 銀同有限公司 Silver Town Limited Tel: 3535988 Fax: 3535984 E-Mail: ADDRESS@silvertown.hk		
DRAWING TITLE : [4R4-2]		
CAD File Name :		
Designed by		
Drawn by		
Reviewed by		
Approved by		
Scale		
DWG NO. (SK-41F) - [4R4-2]		REV. A

21

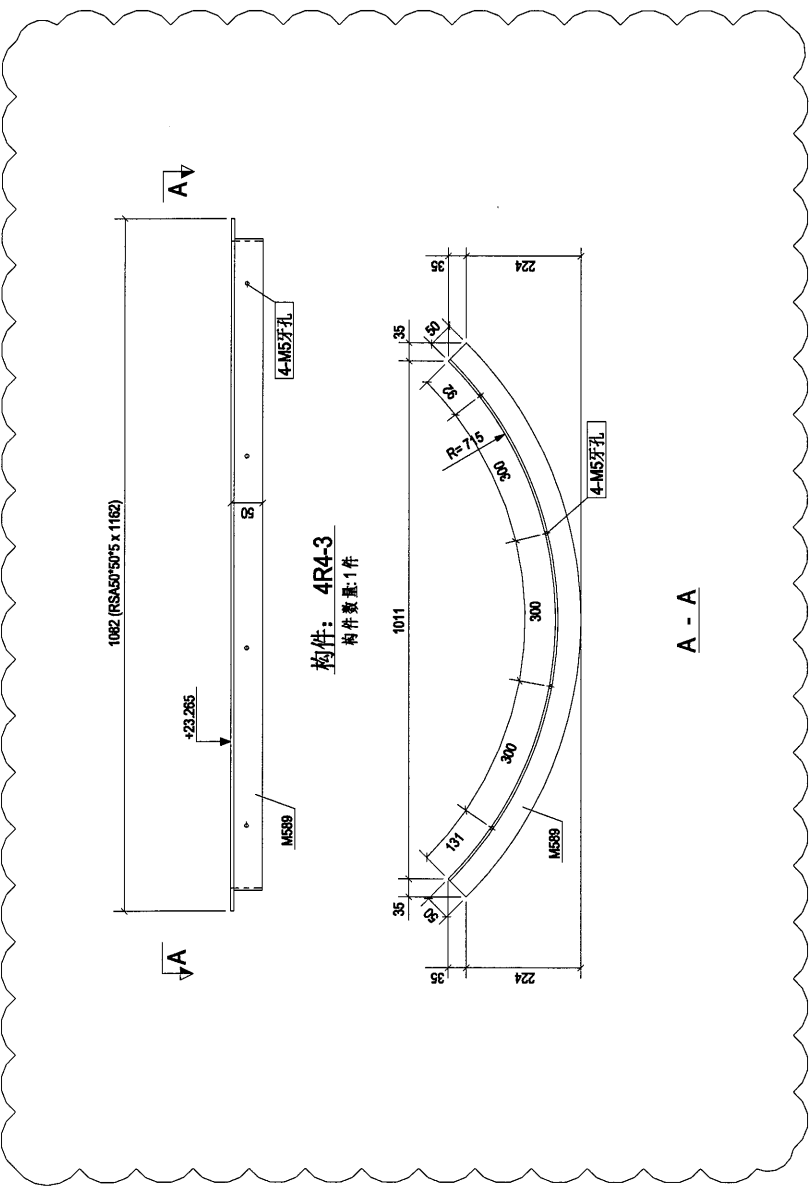


构件: 4R4-3  
 构件数量: 1件

A - A

A	第2次排批	2018-08-14
Rev.	Description	Date
PROJECT: PROPOSED SITE C1 DEVELOPMENT AT AREA 08, TKOIL 70 RP, TSEUNG KWAN O, NEW TERRITORIES		
CLIENT: 美特鋁質有限公司 MID Aluminum Fabricator Ltd. 14/F, Sunning Industrial Building, 810 Cheung Kwan Road, Kwai Tsing, NT Tel: (852) 2489211-4, Fax: (852) 2727686		
銀同有限公司 Silver Town Limited Tel: (852) 3332686, Fax: (852) 3332684 E-Mail: adm@silvertown.com.hk, www.st.com.hk		
DRAWING TITLE : [4R4-3]		
CAD File Name :		
Designed by		
Drawn by		
Reviewed by		
Approved by		
Scale		
DWG NO. : (SK-4/F) - [4R4-3]		REV. A

2

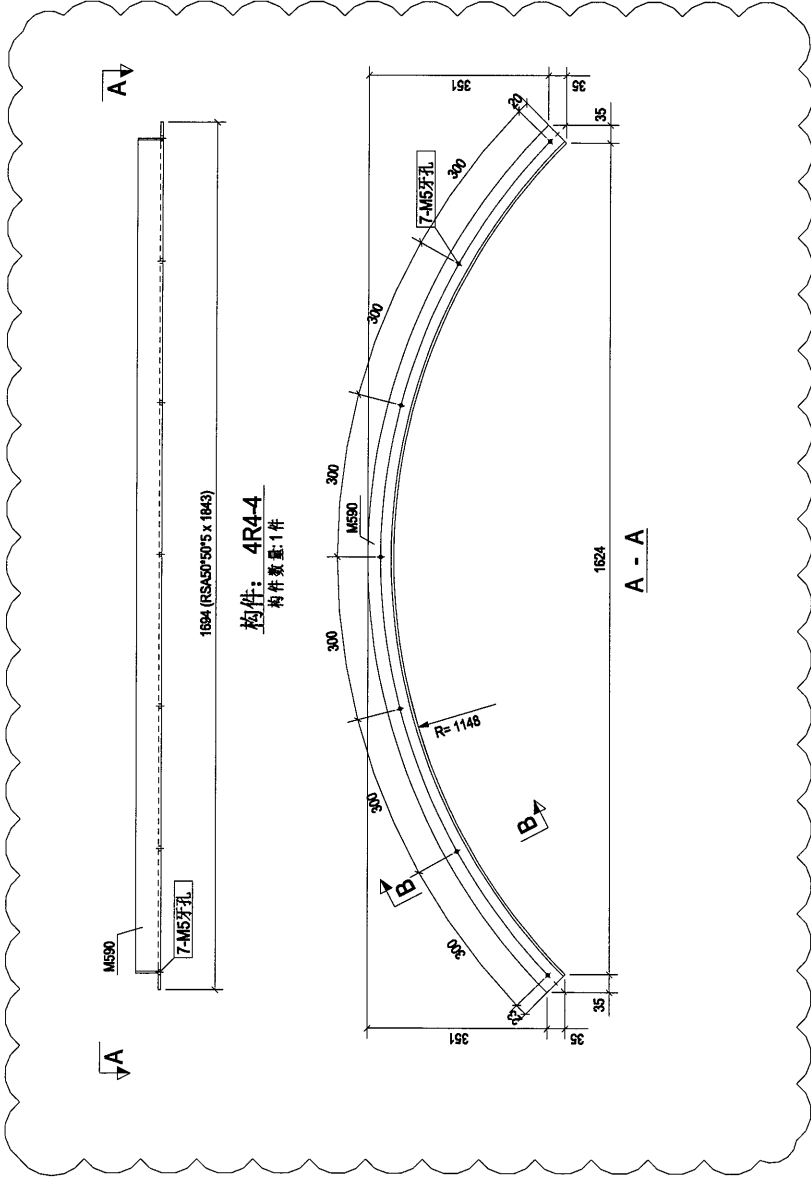


A

A


构件: 4R4-4  
构件数量: 1件

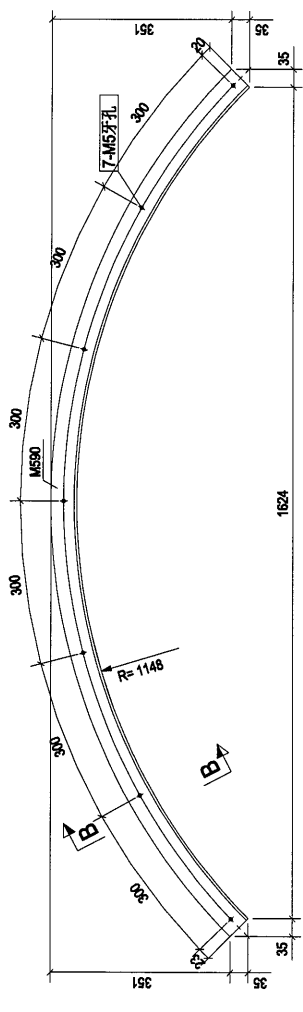


1624

A - A


A	第2次提报	2018-08-14
Rev.	Description	Date
PROJECT: PROPOSED SITE C1 DEVELOPMENT AT AREA 86, TKOTI 70 RP, TSEJUNG KWAN O, NEW TERRITORIES		
CLIENT: 美特铝质有限公司 MIDI ALUMINUM FABRICATOR LTD. Unit 8-B, Saing Industrial Centre, 1/F 810 Canton Road, Tseung Kwan O, New Territories Tel: 2368211-4 Fax: (852) 2727266		
S 银同有限公司 Silver Town Limited Tel: 0769-8330988 Fax: 0769-8335954 E-Mail: A000533@silvertown.hk 1.63.COM		
DRAWING TITLE: [4R4-4]		
CAD File Name:		
Designed by		
Drawn by		
Reviewed by		
Approved by		
Scale		
DWG NO.: (SK-41F) - [4R4-4]		REV. A

73

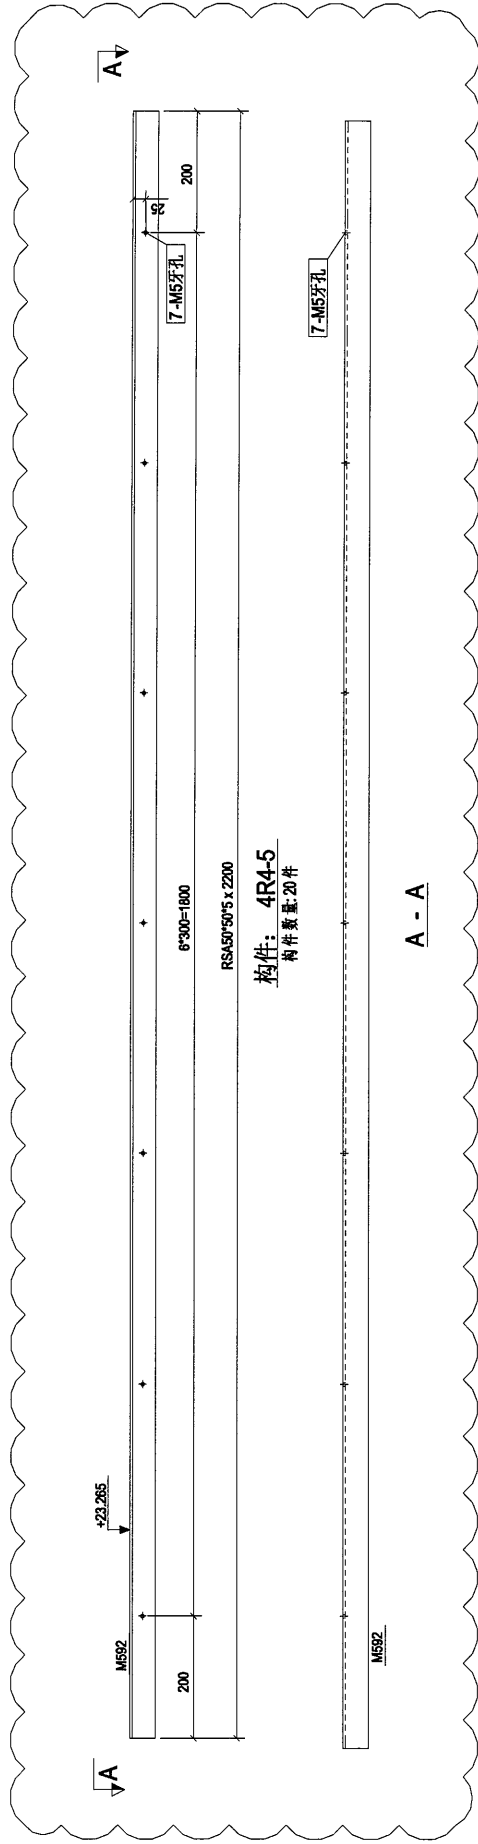

A	第2次排板	2018-08-14
Rev.	Description	Date
PROJECT: PROPOSED SITE C1 DEVELOPMENT AT AREA B8, TKOIL 70/RP, TSEUNG KWAN O, NEW TERRITORIES		
CLIENT: 美特銀質有限公司 MTDY Management & Technology Development 810 Che Kwo Ling Road, Kowloon Tel: 23489211-4, Fax: (852) 2727666		
銀同有限公司 Silver Town Limited 810 Che Kwo Ling Road, Kowloon Tel: 23489211-4, Fax: (852) 2727666		
DRAWING TITLE :		
[4R4-5]		
CAD File Name :		
Designed by		
Drawn by		
Reviewed by		
Approved by		
Scale		
DWG NO.: (SK-41F) - [4R4-5]		REV. A

70

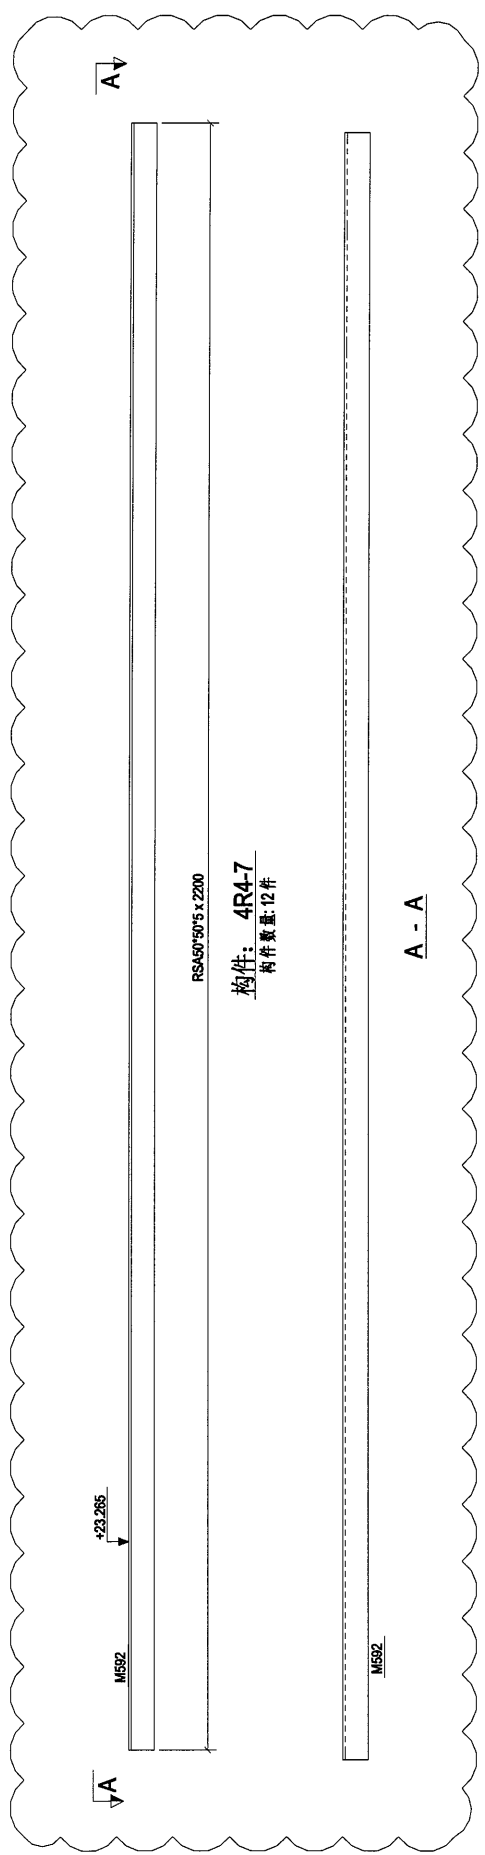

MS92

+23,265

MS92

MS92


构件: 4R4-7  
构件数量: 12件

A - A

<b>A</b>	第2次修改	2018-08-14
Rev.	Description	Date
PROJECT: PROPOSED SITE C1 DEVELOPMENT AT AREA 08, TKOIL TOWN, TSEUNG KWAN O, NEW TERRITORIES		
CLIENT: 美特銀質有限公司 MIDJ Jenny Yau Unit 8-8, Sunny Industrial Centre, 810 Che Kwo Ling Road, Kwun Tong, Tel: 2469211-4, Fax: 8522727666		
銀同有限公司 Silver Town Limited Tel: 2469211-4, Fax: 8522727666 E-MAIL: ADDRESS@silvertown.com.hk		
DRAWING TITLE : <b>[4R4-7]</b>		
CAD File Name :		
Designed by		
Drawn by		
Reviewed by		
Approved by		
Scale		
DWG NO.: (SK-4IF) - [4R4-7]		REV. <b>A</b>

材料编号:	4R4-11	材料数量:	1	材料重量:	10.48
零件编号:	M596	长度(mm):	2764	数量:	1
		重量(kg):	10.48	共重(kg):	10.48
		规格(mm):	RS450*50*5	厚度(mm):	0.53
				合计:	10.48

25

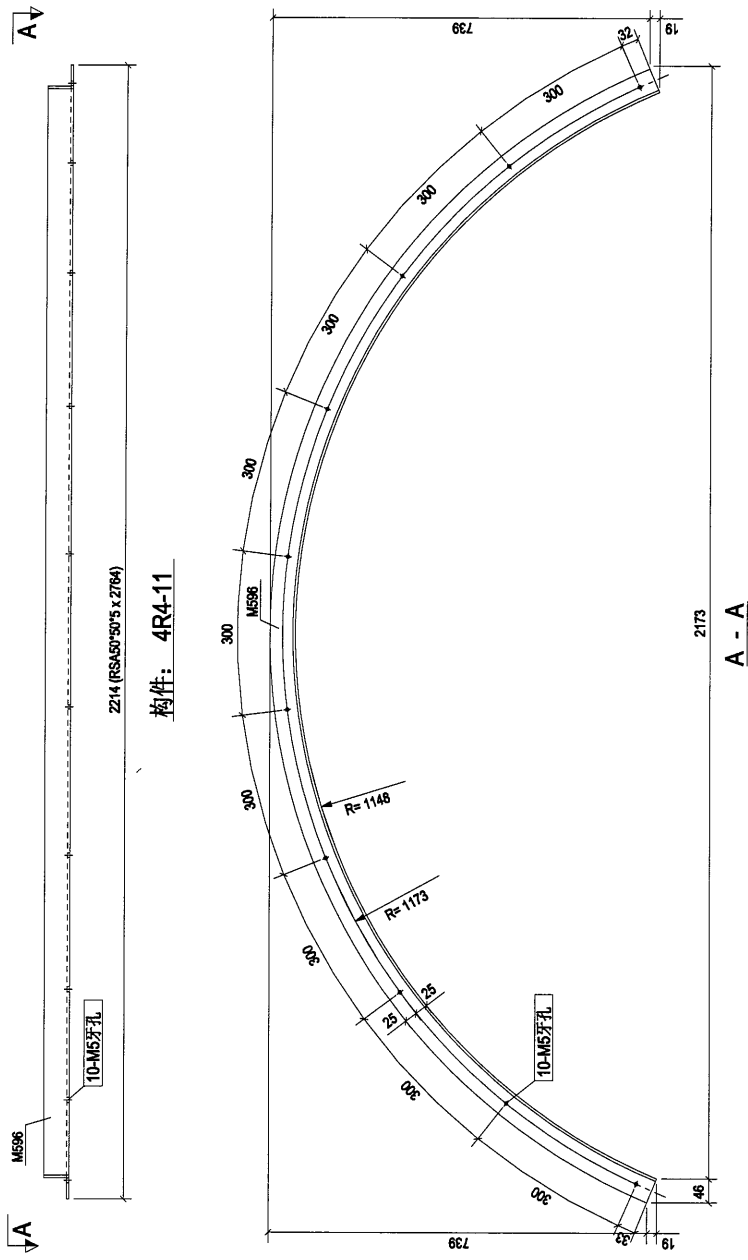

0	第1次批准	2018-08-10
Rev.	Description	Date

PROJECT:  
 PROPOSED SITE C1  
 DEVELOPMENT AT AREA 08,  
 TKO TL70 RP, TSEUNG KWAN O,  
 NEW TERRITORIES

CLIENT:  
**美特铝质有限公司**  
 MIDT ALUMINIUM FABRICATOR LTD.  
 Suite 8-3, Sunny Industrial Centre, 1/F  
 810 Aka Kwo Ling Road, Kowloon  
 Tel: 2469211-4 Fax: (852) 2727866


**银同有限公司**  
 Silver Town Limited  
 Tel: 0789-8335988 Fax: 0789-8335984  
 E-MAIL: ADDRESS@silvertown.com.hk

DRAWING TITLE :  
**[4R4-11]**

CAD File Name :	
Designed by	
Drawn by	
Reviewed by	
Approved by	
Scale	
DWG NO.:	(SK-41F) - (4R4-11)
REV.	0


零件编号	4R4-12	零件数量	1	零件重量	10.48
零件编号	MS97	长度(mm)	2764	数量	1
		重量(g)	10.48	共重(g)	10.48
				表面积(cm <sup>2</sup> )	0.53
				合计:	10.48

26

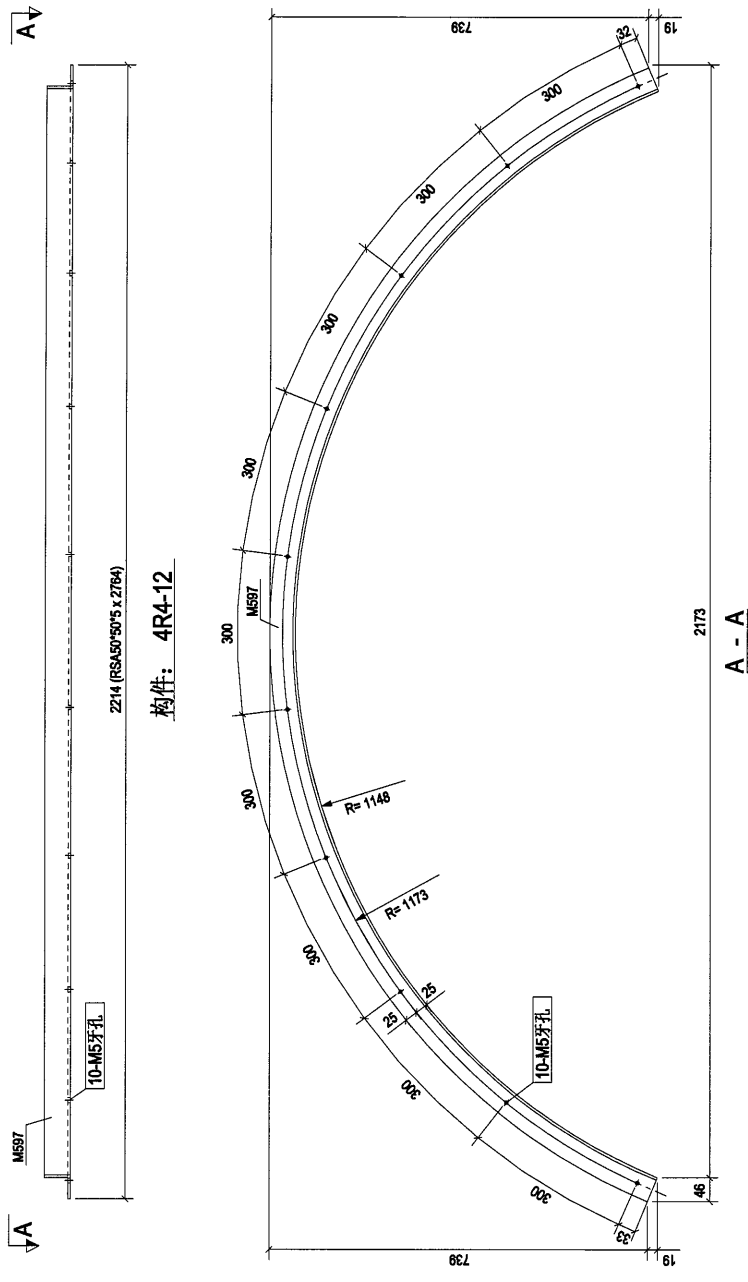

Rev.	第1次批准	Date	2016-08-10
PROJECT: PROPOSED SITE C1 DEVELOPMENT AT AREA B6, TKOIL TO RP, TSEUNG KWAN O, NEW TERRITORIES			
CLIENT: 美特鋁質有限公司 MIDI ALUMINIUM FABRICATOR LTD. Unit 8-9, Sunny Industrial Centre, 1/F 810 Canton Road, Tseung Kwan O, New Territories Tel: 23489211-4, Fax: (852) 27272666			
S 銀同有限公司 Silver Town Limited Tel: 0769-833968 Fax: 0769-833984 E-MAIL: ADDRESS@silvertown.hk			
DRAWING TITLE : [4R4-12]			
CAD File Name :			
Designed by			
Drawn by			
Reviewed by			
Approved by			
Scale			
DWG NO.: (SK-41F) - [4R4-12]			REV: 0



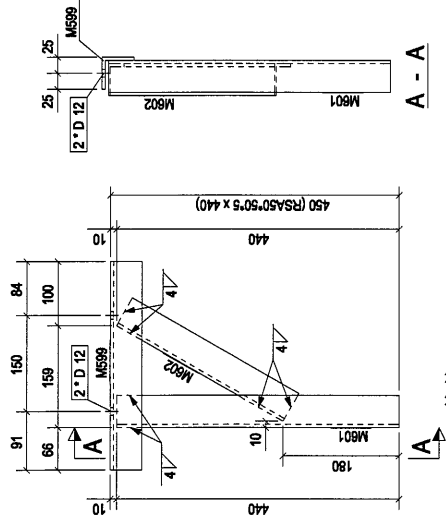

构件: 4R5-2


28

零件号:		4R5-2		零件数量:		6		零件重量:		4.04	
零件号	规格(mm)	数量	重量(kg)	长度(mm)	数量	重量(kg)	井重(kg)	长度(mm)	重量(kg)	井重(kg)	重量(kg)
M599	RS450*50*5	1	1.23	325	1	1.23	1.23	1.23	0.06	0.06	0.06
M601	RS450*50*5	440	1.87	440	1	1.87	1.87	1.87	0.08	0.08	0.08
M602	RS450*50*5	300	1.14	300	1	1.14	1.14	1.14	0.06	0.06	0.06
合计:										4.04	

0	第一次报批	2018-08-10
Rev.	Description	Date
PROJECT: PROPOSED SITE C1 DEVELOPMENT AT AREA B8, TKOIL 70 RP, TSEUNG KWAN O, NEW TERRITORIES		
CLIENT: <b>美特铝质有限公司</b> MIDE Aluminium Fabricator Ltd. Units 5-8, Sun A Industrial Centre, 7/ 610, Chee Keng Tse Road, Tseung Kwan O, New Territories Tel: 23489211-4, Fax: (852) 27272666		
<b>S 银同有限公司</b> Silver Town Limited Tel: 0782-333988, Fax: 0789-333984 E-Mail: adm@silvertown.hk, st.com		
DRAWING TITLE : <b>[4R5-2]</b>		
CAD File Name :		
Designed by		
Drawn by		
Reviewed by		
Approved by		
Scale		
DWG NO: (SK-4/F) - [4R5-2]		REV: 0

零件编号	4RS-1	零件数量	5	零件重量	1.26
零件编号	M634	长度(mm)	100	数量	1
		直径(mm)	1.26	并距(mm)	1.26
				深距(mm)	0.04
				合计:	1.26

29

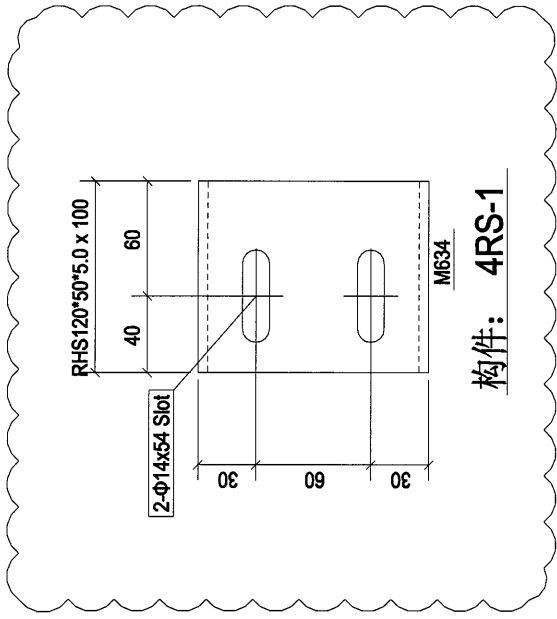

A	第2次报批	2016-08-14
Rev.	Description	Date

PROJECT:  
 PROPOSED SITE C1  
 DEVELOPMENT AT AREA 88,  
 TKOIL TO RP, TSEUNG KWAN O,  
 NEW TERRITORIES

CLIENT:  
**美特铝质有限公司**  
 MIDT Aluminium Fabricator Ltd.  
 16th Fl., Sunning Industrial Estate, 1/F  
 816 Cheung Kwan Road, Kowloon  
 Tel: 23489211-4 Fax: (852)27727666

**银同有限公司**  
**Silver Town Limited**  
 Tel: 0756-8335988 Fax: 0756-8335984  
 E-mail: Address@silvertown.com.hk


DRAWING TITLE :  
**[4RS-1]**

CAD File Name :	
Designed by	
Drawn by	
Reviewed by	
Approved by	
Scale	

DWG NO. (SK-4)F - [4RS-1]	REV.
	A

30

合计:				0.35	

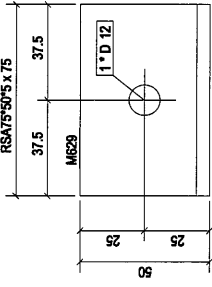


构件: R4S-1  
零件数量: 95件

0	第1次设计	2018-08-14
Rev.	Description	Date
PROJECT: PROPOSED SITE C1 DEVELOPMENT AT AREA 88, TKOTL 70 RP, TSEUNG KWAN O, NEW TERRITORIES		
CLIENT: 美特铝质有限公司 MID Aluminium Fabrication Ltd. Units 5 & 6, Sun Yee Industrial Estate, / 810 Chee Kwoi Ling Road, Kowloon Tel: 2468211-4, Fax: 652172686		
S 银同有限公司 Silver Town Limited Tel: 0769-333988, Fax: 0769-333984 E-Mail: address@silvertown.com.hk		
DRAWING TITLE : [R4S-1]		
CAD File Name :		
Designed by		
Drawn by		
Reviewed by		
Approved by		
Scale		
DWG NO. (SK-41F) - [R4S-1]		REV 0

零件编号	R4S-2	零件数量	40	零件重量	0.19
零件编号	M279	长度(mm)	50	数量	1
		共重(kg)	0.19	共重(kg)	0.01
				合计	0.19


21

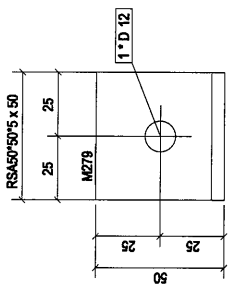

构件: R4S-2

0	第1次报批	2016-08-14
Rev.	Description	Date
PROJECT: PROPOSED SITE C1 DEVELOPMENT AT AREA 08, TKOT, 70 RP, TSEUNG KWAN O, NEW TERRITORIES		
CLIENT: <b>美特铝质有限公司</b> MIDI ALUMINIUM FABRICATOR LTD. Units 6-8, Sunny Industrial Centre, 1/F 60-62, Yee Yee Tung Road, Tai Po New Territories, Hong Kong Tel: 23489211-4, Fax: (852) 2727866		
<b>S 银同有限公司</b> Silver Town Limited Tel: 0769-8335486 Fax: 0769-8335954 E-MAIL: ADDRESS@silvertown.hk, 163.COM		
DRAWING TITLE : <b>[R4S-2]</b>		
CAD File Name :		
Designed by		
Drawn by		
Reviewed by		
Approved by		
Scale		
DWG NO: (SK-4/F) - [R4S-2]		REV. 0


32

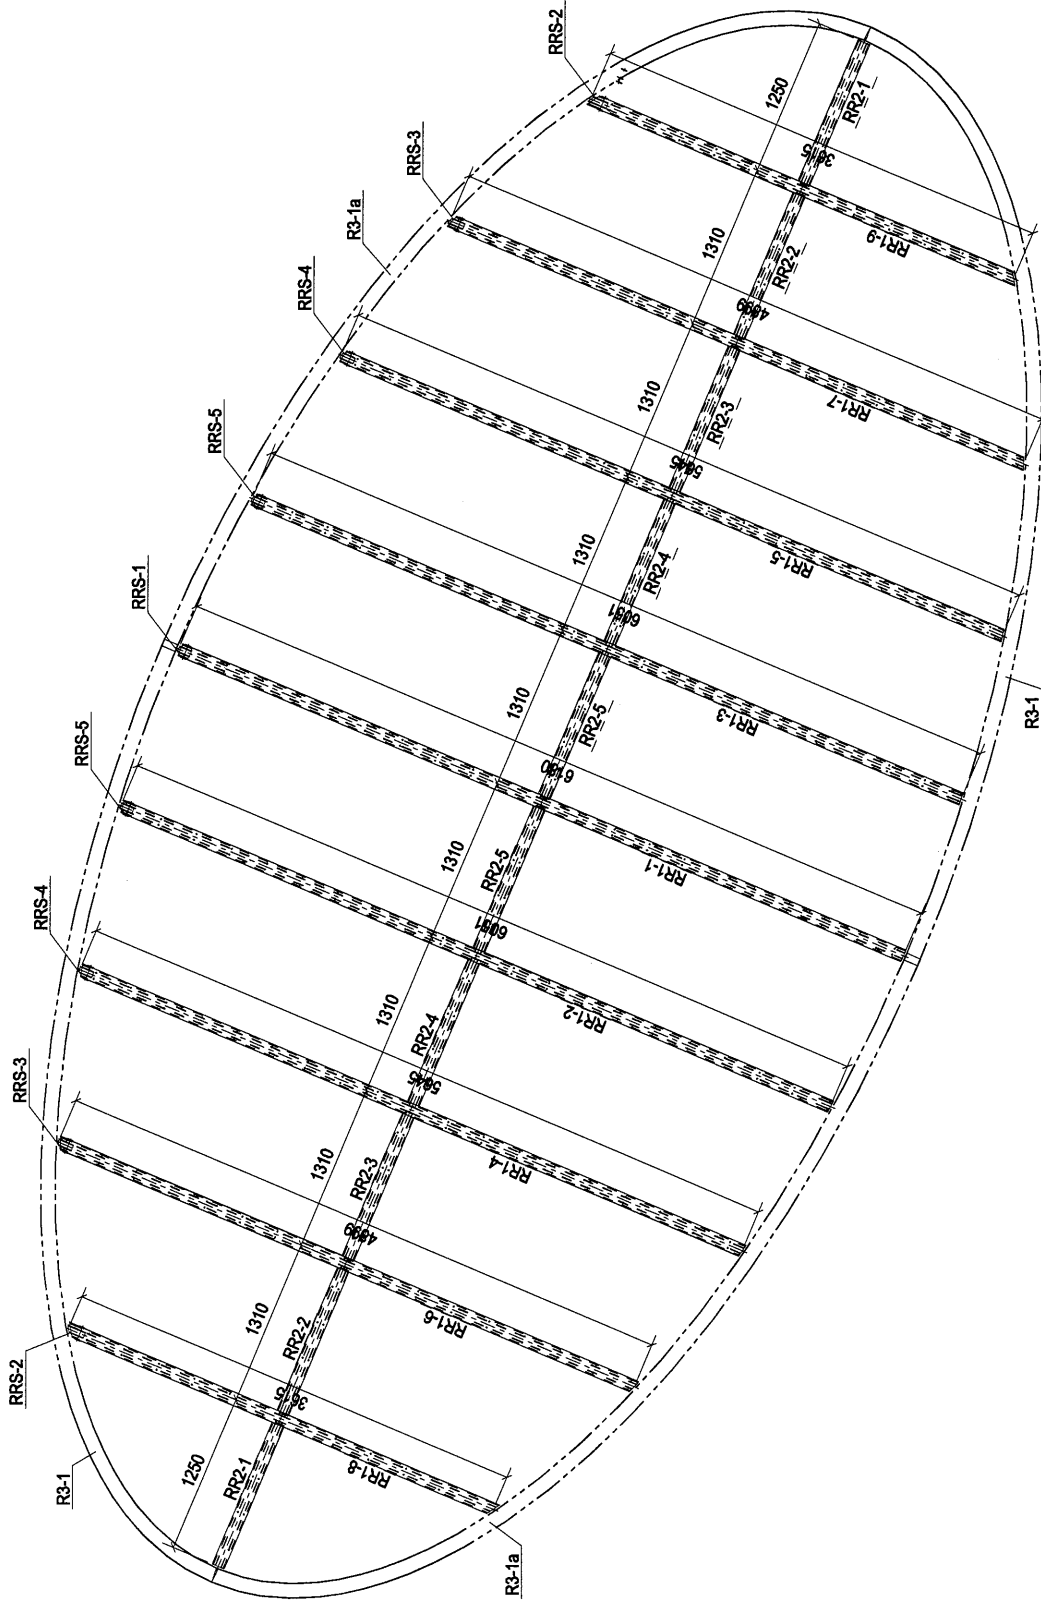

PART PART PLAN FOR SKYLIGHT AT PODIUM ROOF  
 MAIN STEEL MEMBER ONLY

0	第1次报批	2016-08-11
Rev.	Description	Date
PROJECT: PROPOSED SITE C1 DEVELOPMENT AT AREA B6, TKOIL 70 RP, TSEUNG KWAN O, NEW TERRITORIES		
CLIENT: 美特鋁質有限公司 MIDAL ALUMINIUM FABRICATORS LTD. 818 C-8, Sunny Industrial Centre, 1/F 818 Cheung King Road, Tseung Kwan O, New Territories Tel: 23489211-4 Fax: (852) 2727866		
S 銀同有限公司 Silver Town Limited Tel: 0759-8335988 Fax: 0759-8335984 E-mail: Address@silvertown.hk		
DRAWING TITLE: MARKING PLAN		
CAD File Name:		
Designed by:		
Drawn by:		
Reviewed by:		
Approved by:		
Scale:		
DWG NO.: (SK-RRF) - MP01		REV: 0

33

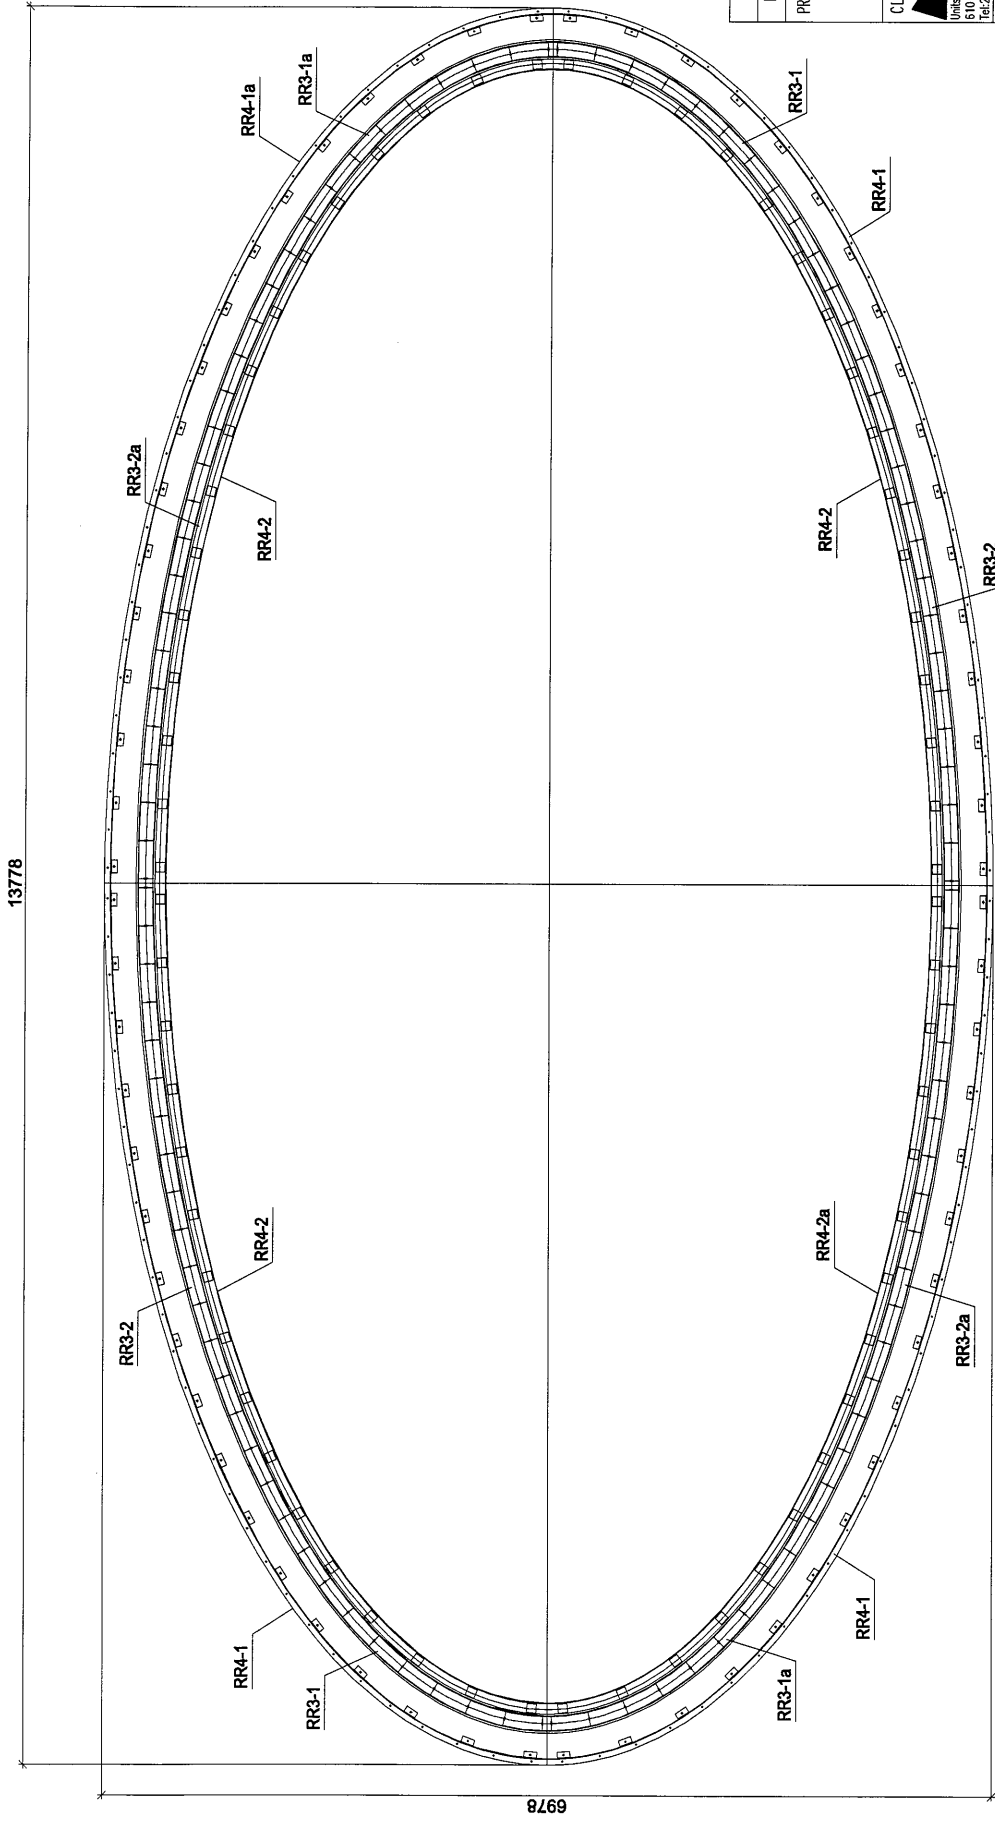

PLAN FOR SKYLIGHT AT PODIUM ROOF  
SECOND STEEL MEMBER ONLY

A	第2次提批	2018-08-14
Rev.	Description	Date

PROJECT:  
PROPOSED SITE C1  
DEVELOPMENT AT AREA B6,  
TKOIL 70 RP, TSEUNG KWAN O,  
NEW TERRITORIES

CLIENT:  
**美特鋁質有限公司**  
MIDI ALUMINIUM FABRICATOR LTD.  
Units 5-8, Sinyi Industrial Centre, 1/F  
5/F, C/O, 11/F, Wing Lok Industrial Centre  
No. 10, Tai Yee Street, Tai Po, N.T.  
Tel: 3468211-4, Fax: (852) 2727656


**S 銀同有限公司**  
Silver Town Limited  
Tel: 0769-8335488 Fax: 0769-8335954  
E-MAIL: ADDRESS@silvertown.hk, 163.COM

DRAWING TITLE :  
**MARKING PLAN**

CAD File Name :	
Designed by	
Drawn by	
Reviewed by	
Approved by	
Scale	
DWG NO: (SK-RF) - MP02	REV. A

零件编号:	RAS-1	零件数量:	40+40	零件重量:	0.35
零件图号:	MS29	长度(mm):	75	重量(kg):	0.35
		数量:	1	共重(kg):	0.35
		RSAT550'S		注量(m):	0.02
				合计:	0.35

30

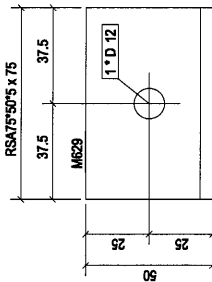

构件: RRS-1  
构件数量: 80件

0	第1次报批	2018-08-14
Rev.	Description	Date

PROJECT:  
PROPOSED SITE C1  
DEVELOPMENT AT AREA 06,  
TKOIL 70 RP, TSEUNG KWAN O,  
NEW TERRITORIES

CLIENT:  
**美特铝质有限公司**  
MIDI ALUMINIUM FABRICATORS LTD.  
Unit 6-8, Sunny Industrial Centre, 1/F  
816 Cheong Chee Road, #01-01  
Tel: 23498211-4 Fax: (852) 2727266

**银同有限公司**  
Silver Town Limited  
Tel: 0769-8335988 Fax: 0769-8339854  
E-MAIL: ADDRESS@silvertown.com.hk


DRAWING TITLE :  
**[RAS-1]**

CAD File Name :	
Designed by	
Drawn by	
Reviewed by	
Approved by	
Scale	

DWG NO.:	(SK-41F) - [RAS-1]	REV:	0
----------	--------------------	------	---


RRT-1		RRT-1		RRT-1	
零件编号	规格(mm)	数量	重量(kg)	数量	重量(kg)
F48	PL15*33	2	4.00	2	8.00
F49	PL15*33	2	3.98	2	7.97
M603	PL5*98	1	12.01	1	12.01
M604	PL5*98	1	11.95	1	11.95
M646	RHS200*100*10.0	1	285.69	1	285.69
		合计:		305.61	

35

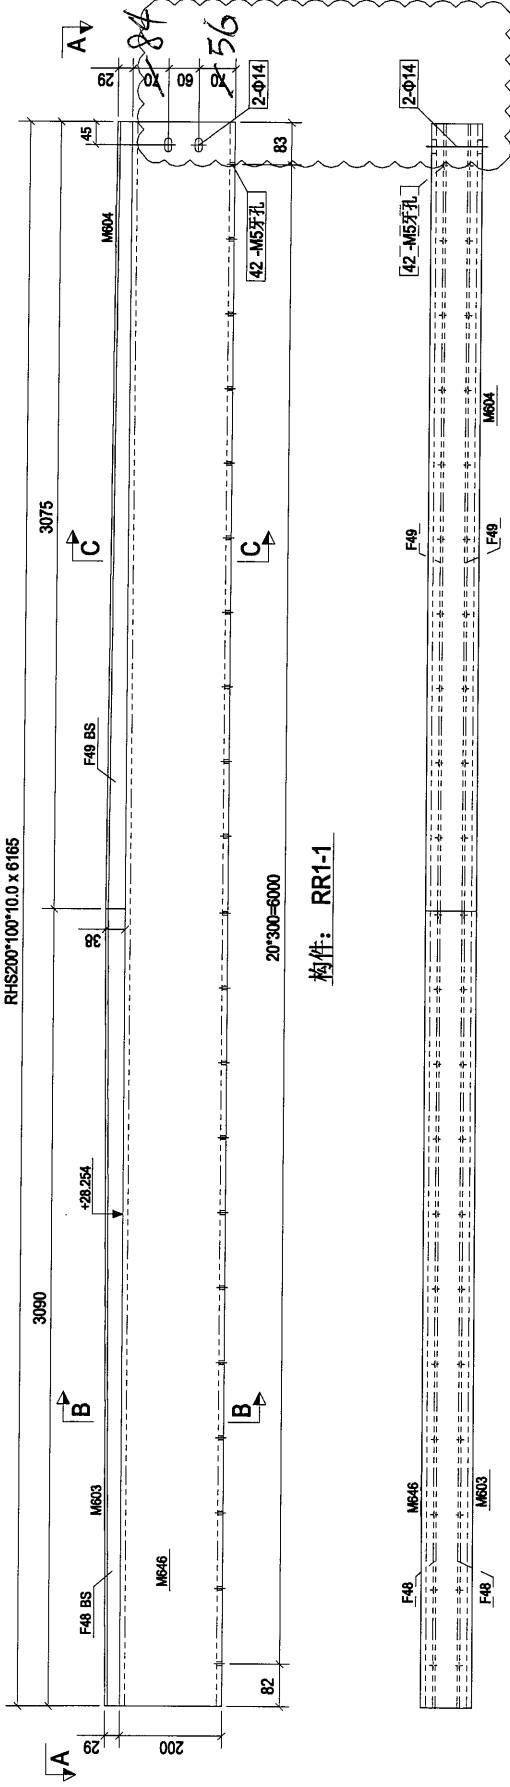


构件: RRT-1


A - A

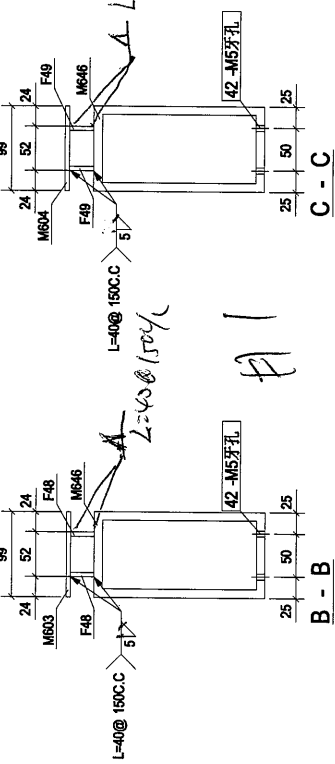

B - B

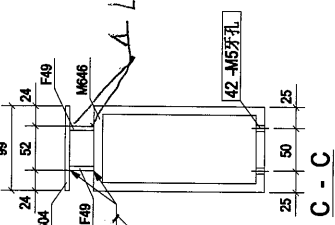


C - C

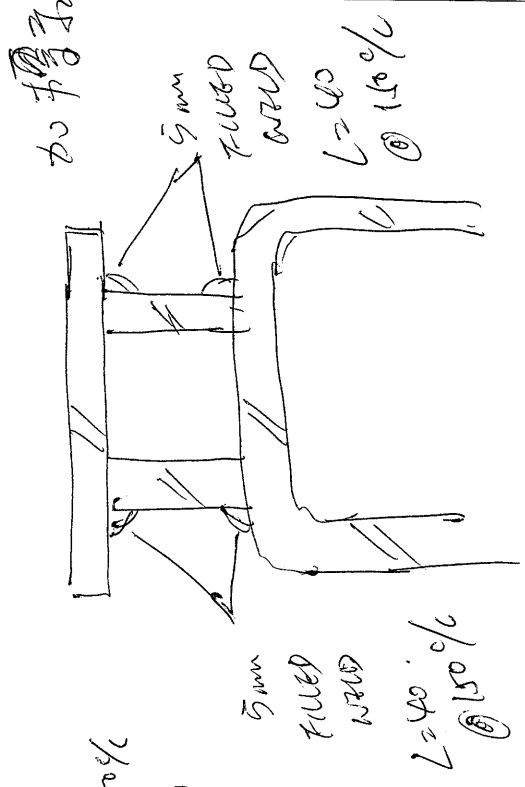

A	第2次报批	2016-08-14
Rev.	Description	Date
PROJECT:		
PROPOSED SITE C1 DEVELOPMENT AT AREA B8 TKOIT TO RT, TSEUNG KWAN O, NEW TERRITORIES		
CLIENT:		
美特铝质有限公司 MIDI ALUMINIUM FABRICATOR LTD. Units 6-8, Sunray Industrial Centre, 1/F 610 Chee Chee Ling Road, Kowloon Tel: 24892111-4 Fax: (852) 2727866		
Silver Town Limited Tel: 0769-8335488 Fax: 0769-8335954 E-MAIL: ADDRESS@SILVERTOWN.COM		
DRAWING TITLE:		
[RR1-1]		
CAD File Name:		
Designed by		
Drawn by		
Reviewed by		
Approved by		
Scale		
DWG NO. (SK-RF) - [RR1-1]		REV. A



零件编号	RR1-2	零件数量		RR1-2	长度(mm)	数量	重量(kg)	共重(kg)	表面面积(m <sup>2</sup> )
		数量	重量(kg)						
F50	PL15*29.3	1	3.46	3028	1	3.46	0.19		
F80	PL15*29.3	1	3.46	3013	1	3.46	0.18		
F73	PL15*29.3	1	3.46	3008	1	3.46	0.19		
M608	PL5*99	1	3.47	3023	1	3.47	0.19		
M612	PL5*99	1	11.77	3015	1	11.77	11.77	0.63	
M645	RHS200*100*10.0	1	280.53	6045	1	280.53	280.53	0.63	
合计:				287.90					

36

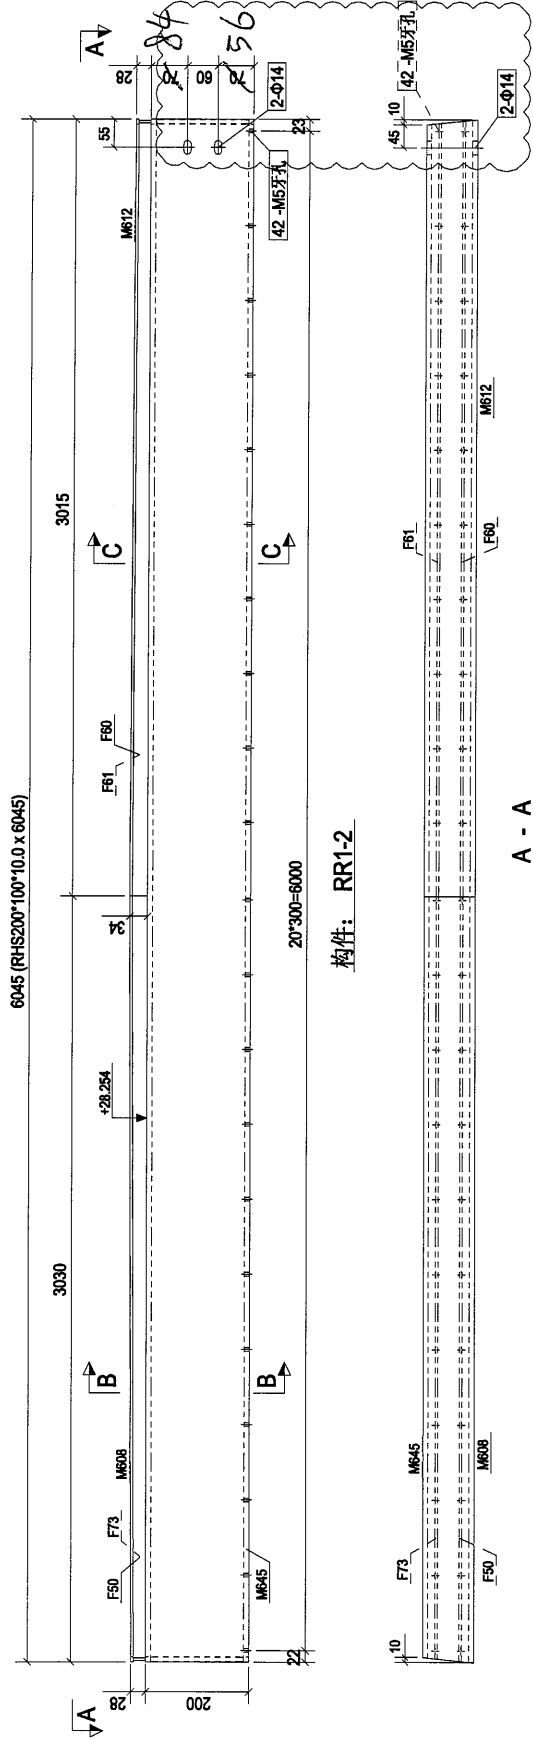

构件: RR1-2


A - A

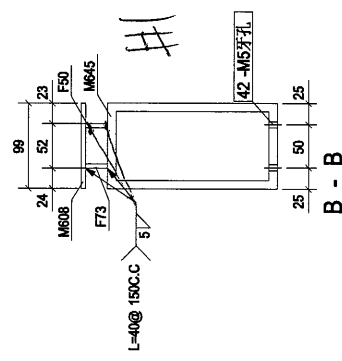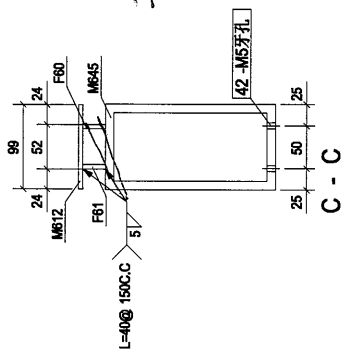

Rev.	第2次批准	Date	2018-08-14
PROJECT: PROPOSED SITE C1 DEVELOPMENT AT AREA B6, TKOIL TO RP, TSEUNG KWAN O, NEW TERRITORIES			
CLIENT: 美特鋁質有限公司 MIDI ALUMINIUM FABRICATOR LTD. Unit 8-9, Sunny Industrial Centre, 1/F 816 Canton Road, Kowloon Tel: 23682111-4, Fax: (852) 27727666			
S 銀同有限公司 Silver Town Limited Tel: 0769-8335988 Fax: 0769-8335954 E-MAIL: ADDRESS@silvertown.hk, info@silvertown.hk			
DRAWING TITLE: [RR1-2]			
CAD File Name:			
Designed by:			
Drawn by:			
Reviewed by:			
Approved by:			
Scale:			
DWG NO.: (SK-RP) - [RR1-2]			REV. A


材料編號		RR1-3		材料重量		2019.90	
零件編號	規格(mm)	數量	單位	重量(kg)	共重(kg)	長度(mm)	深寬度(mm)
F80	PL15*20.3	1	3.48	3.48	0.19		
F81	PL15*20.3	1	3.46	3.46	0.19		
F73	PL15*20.3	1	3.47	3.47	0.19		
M608	PL5*99	1	11.77	11.77	0.63		
M612	PL5*99	1	11.72	11.72	0.63		
M660	RHS200*100*10.0	1	260.53	260.53	3.47		
				合計:	297.90		

37

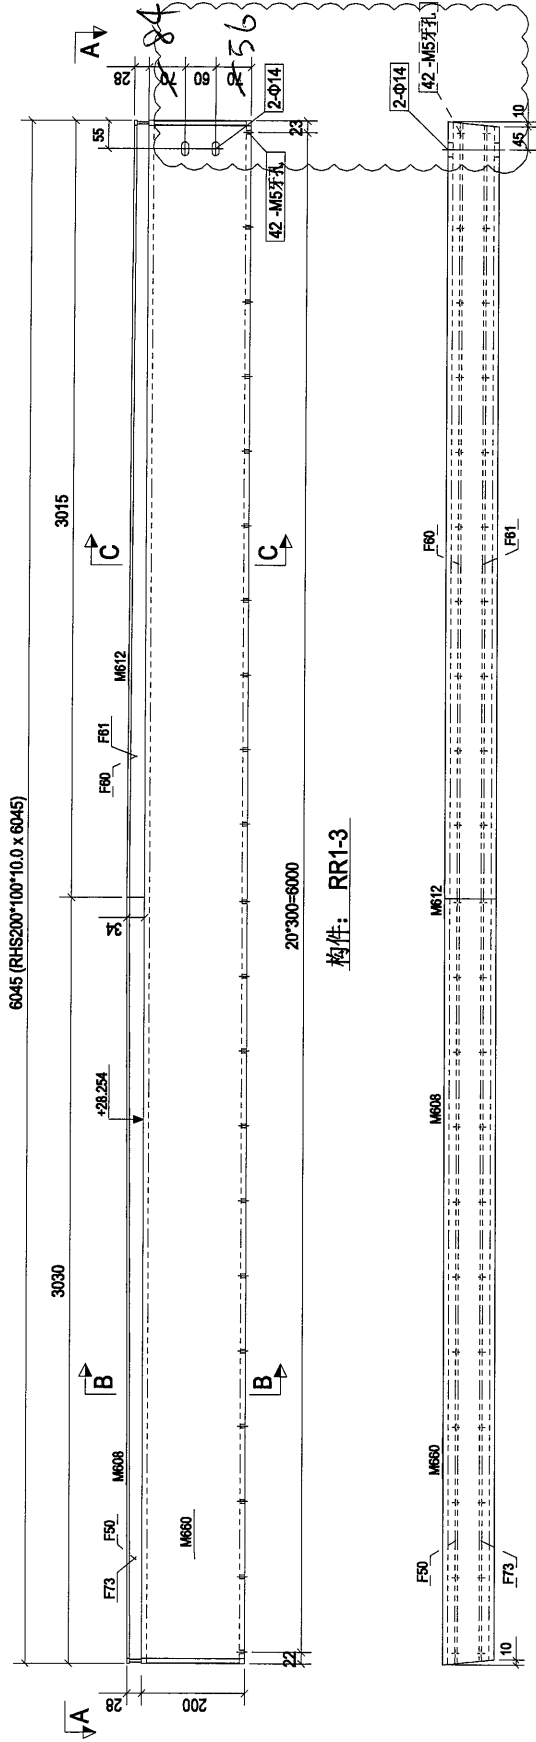

構件: RR1-3

A - A

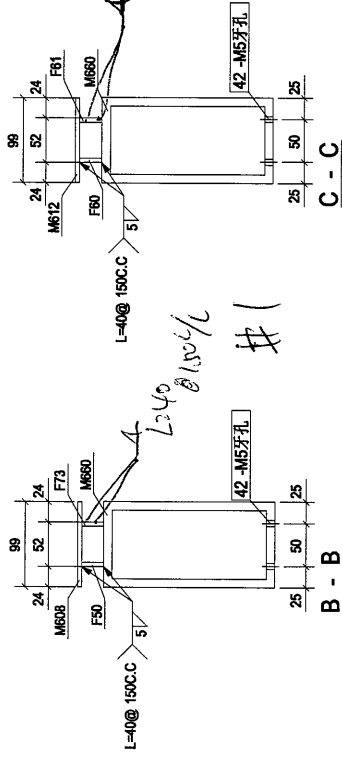


A	第2次批准	2018-08-14	Date
Rev.		Description	Date
PROJECT: PROPOSED SITE C1 DEVELOPMENT AT AREA 86, TKOIL TO RP, TSEUNG KWAN O, NEW TERRITORIES			
CLIENT: 美特鋁質有限公司 MTDI ALUMINIUM FABRICATOR LTD. Units 6-8, Sunray Industrial Centre, 1/F 810 Chee Kwo Ling Road, Kwun Tong Tel: 2489211-4, Fax: (852) 2727866			
銀同有限公司 Silver Town Limited Tel: 0769-8335488, Fax: 0769-8335854 E-MAIL: ADDRESS@silvertown.com.hk			
DRAWING TITLE: [RR1-3]			
CAD File Name:			
Designed by:			
Drawn by:			
Reviewed by:			
Approved by:			
Scale:			
DWG NO.: (SK-R1F) - [RR1-3]			REV. A




29

零件编号: RR1-5		零件数量: 1		零件重量: 276.74	
零件编号	规格(mm)	数量	重量(kg)	长度(mm)	厚度(mm)
F51	PL15*25.4	1	2.82	2828	0.16
F54	PL15*25.4	1	2.81	2813	0.16
F55	PL15*25.4	1	2.80	2803	0.16
F72	PL15*25.4	1	2.81	2818	0.16
M605	PL5*99	1	11.01	2833	0.59
M609	PL5*99	1	10.95	2818	0.59
M659	RHS200*100*10.0	1	243.54	5651	3.24
		合计:		276.74	

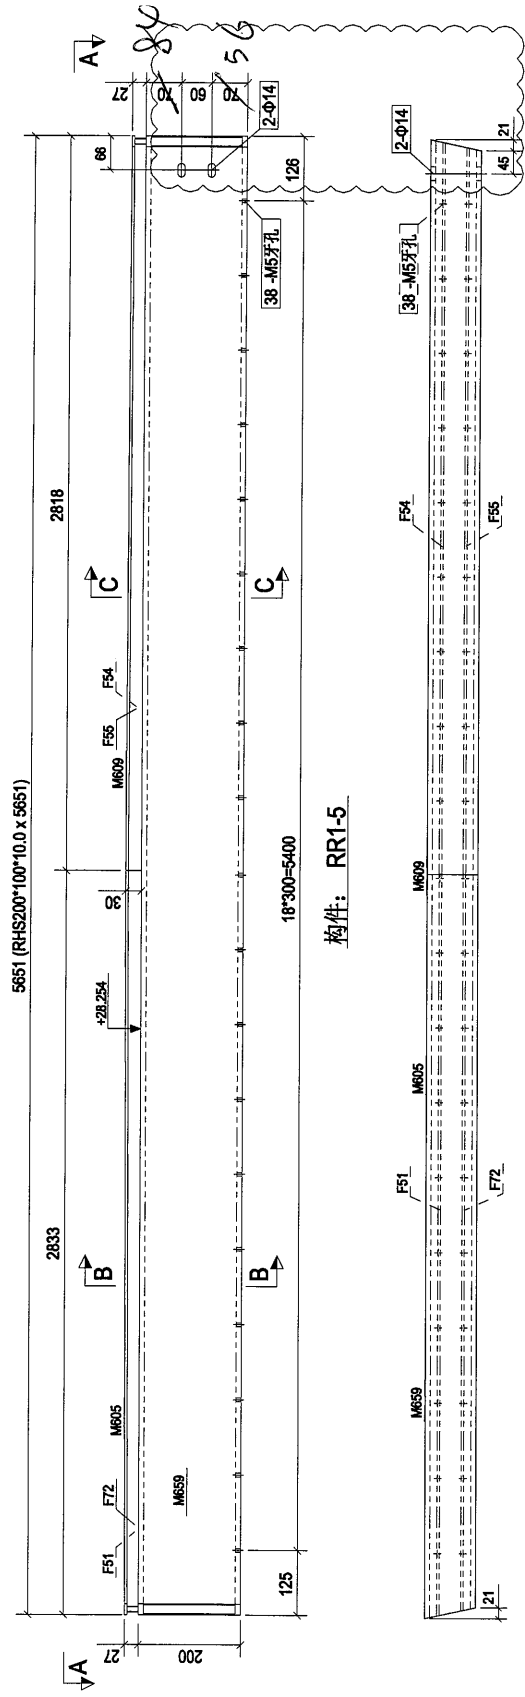

构件: RR1-5


A - A

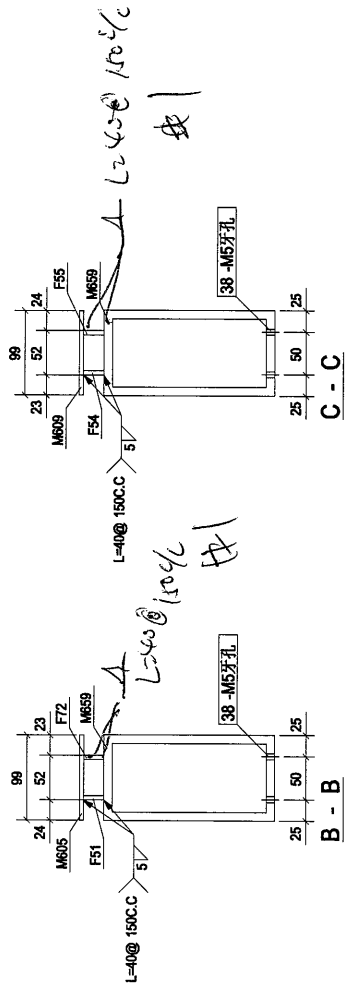

A	第2次提批	2018-08-14
Rev.	Description	Date
PROJECT: PROPOSED SITE C1 DEVELOPMENT AT AREA 88, TKOIL TO RP, TSEING KWAN'O, NEW TERRITORIES		
CLIENT: 美特铝质有限公司 MTDI ALUMINIUM FABRICATOR LTD. Units 8-9, Sunray Industrial Centre, 1/F 510 Che Kwo Ling Road, Kowloon Tel: 24892111-4, Fax: (852) 27727696		
银同有限公司 Silver Town Limited Tel: 0769-83354868 Fax: 0769-83359854 E-MAIL: ADDRESS@silvertown.com		
DRAWING TITLE: [RR1-5]		
CAD File Name:		
Designed by:		
Drawn by:		
Reviewed by:		
Approved by:		
Scale:		
DWG NO.: (SK-R/F) - [RR1-5]		REV. A


RR1-6		构件重量: 239.38	
零件编号	数量	重量(kg)	共重(kg)
F52	1	2.08	2.08
F56	1	2.07	2.07
F71	1	2.07	2.07
M606	1	9.59	9.59
M610	1	9.53	9.53
M643	1	212.00	212.00
合计:			239.38

40

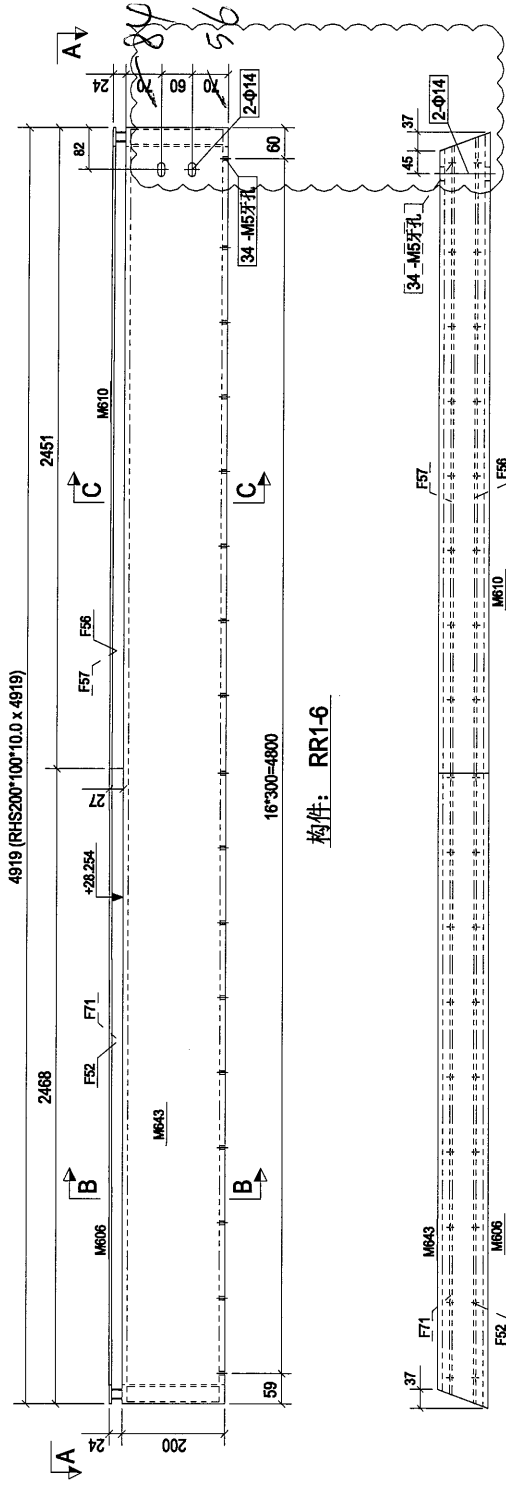

构件: RR1-6


A - A

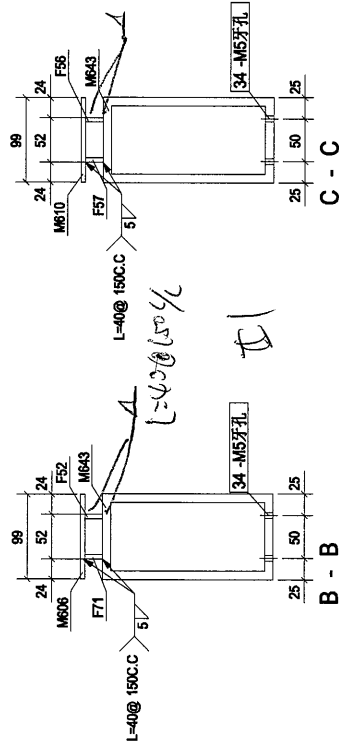

Rev.	第2次排批	2018-08-14	Date
PROJECT: PROPOSED SITE C1 DEVELOPMENT AT AREA B8, TKOIL TO RP, TSEUNG KWAN O, NEW TERRITORIES			
CLIENT: 美特鋁質有限公司 MIDI Aluminium Fabricative Ltd. Units 5 & 6, Sunny Industrial Centre, 7/F 810 Cheung Cheong Street, Tseung Kwan O Tel: (852) 2772 8866 Fax: (852) 2772 8866			
S 銀同有限公司 Silver Town Limited Tel: (852) 3333 9888 Fax: (852) 3333 9854 E-MAIL: ADDRESS@silvertown.hk			
DRAWING TITLE: [RR1-6]			
CAD File Name:			
Designed by:			
Drawn by:			
Reviewed by:			
Approved by:			
Scale:			
DWG NO.: (SK-RVF) - [RR1-6]			REV. A


零件编号	规格(mm)	RR1-7	零件数量	1	零件重量	239.38
FR2	PL15*21.6		长度(mm)		重量(kg)	体积(m <sup>3</sup> )
			数量	1	2.08	0.13
F56	PL15*21.6			1	2.07	0.12
F57	PL15*21.6			1	2.05	0.12
F71	PL15*21.6			1	2.07	0.12
M606	PL5*99			1	9.59	0.51
M610	PL5*99			1	9.53	0.51
M658	RHS200*100*10.0			1	212.00	2.82
合计:					239.38	

90

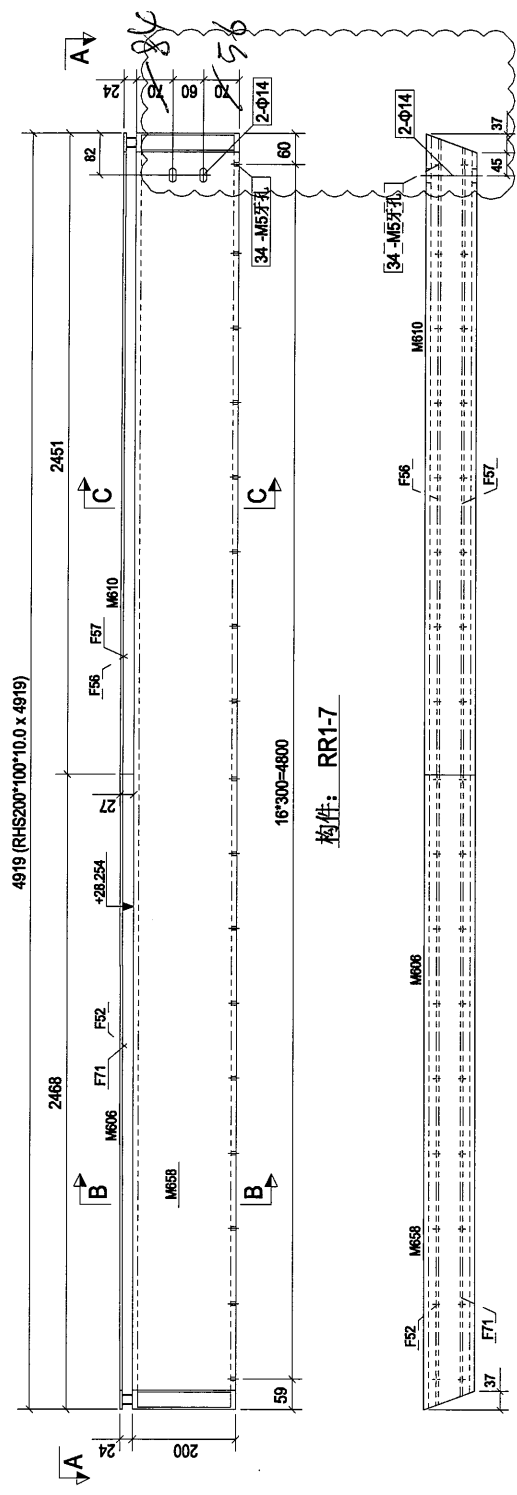

构件: RR1-7

A - A

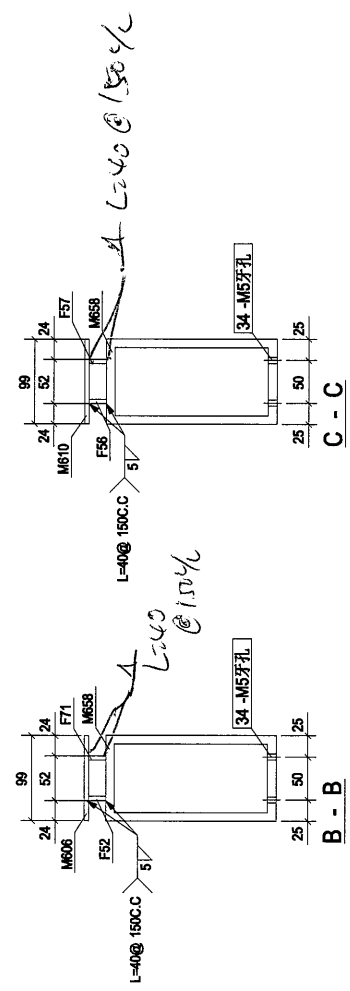


Rev.	第2次排批	2018-08-14
	Description	Date
PROJECT: PROPOSED SITE C1 DEVELOPMENT AT AREA 88, TKOIL 70 R/P, TSEUNG KWAN O, NEW TERRITORIES		
CLIENT: 美特鋁質有限公司 M.T.D. Aluminium Products Ltd. Units 5 & 8, Sunny Industrial Centre, 810 Cha Kwo Ling Road, Kowloon Tel: 23489211-4, Fax: (852) 2727666		
銀同有限公司 Silver Town Limited Tel: (852) 4332886, Fax: (852) 4332884 E-mail: Address@silvertown.com.hk		
DRAWING TITLE: [RR1-7]		
CAD File Name:		
Designed by:		
Drawn by:		
Reviewed by:		
Approved by:		
Scale:		
DWG NO.:	(SK-RIF) - [RR1-7]	REV. A







零件编号: RR2-1		零件数量: 2		零件重量: 58.07	
零件编号	规格(mm)	长度(mm)	重量	数量	共重(kg)
F85	PL15*17.6	1224	0.84	2	1.68
M619	PL5*98	1200	4.66	1	4.66
M647	RHS200*100*10.0	1200	51.72	1	51.72
合计:				2	58.07

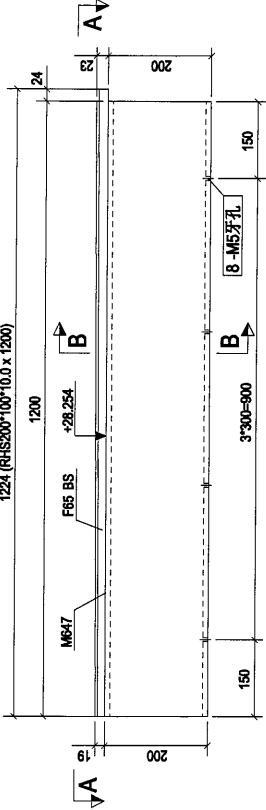

构件: RR2-1

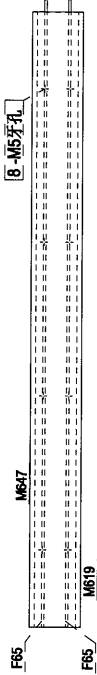

A - A

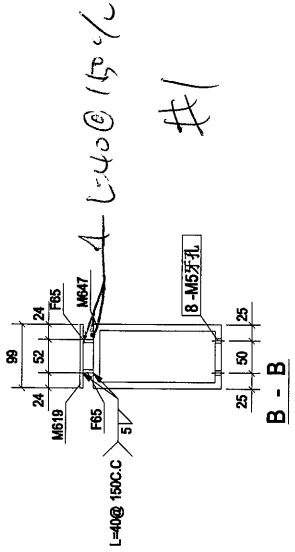


B - B

(Handwritten mark)


0	第一次球批	2018-08-11
Rev.	Description	Date
PROJECT: PROPOSED SITE C1 DEVELOPMENT AT AREA B6 TKOTL TO RP TSEUNG KWAN O, NEW TERRITORIES		
CLIENT: 美特铝质有限公司 MIDI ALUMINIUM FABRICATOR LTD. Units E-8, Sunny Industrial Centre, 1/F 610 Cho Kwo Ling Road, Kowloon Tel: 23689211-4 Fax: (852) 27271666		
S 银同有限公司 Silver Town Limited Tel: 0769-83354968 Fax: 0769-83359854 E-MAIL ADDRESS: sgstl@vip.1.163.COM		
DRAWING TITLE : [RR2-.1]		
CAD File Name :		
Designed by		
Drawn by		
Reviewed by		
Approved by		
Scale		
DWG NO. (SK-RIF) - [RR2-.1]		REV. 0

55


零件编号		RR2-2		零件数量		2		零件重量		58.97	
F66	PL15*21.5	2	1.06	2	2.12						0.06
M618	PL15*99	1	4.71	1	4.71						0.25
M648	RHS200*100*10.0	1	52.15	1	52.15						0.69
合计:										58.97	

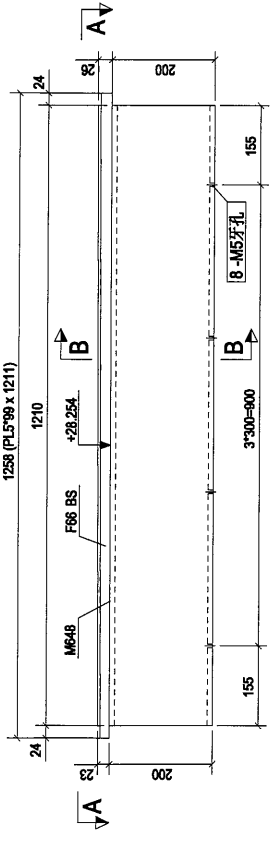

构件: RR2-2

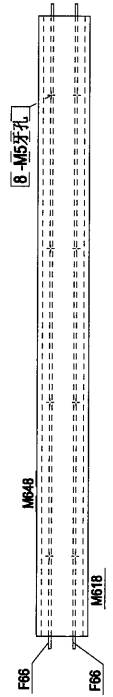


A - A

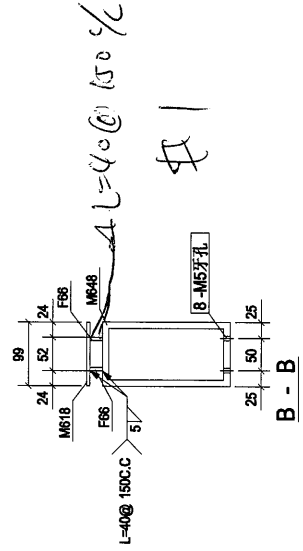


B - B

0	第一次报批	2018-08-11
Rev.	Description	Date
PROJECT: PROPOSED SITE C1 DEVELOPMENT AT AREA 86, TKOT, 70 RP, TSEUNG KWAN O, NEW TERRITORIES		
CLIENT: <b>美特铝质有限公司</b> MIDI ALUMINIUM FABRICATOR LTD. Units C-8, Sunny Industrial Centre, 1/F 810 Cheung King Road, Cheung King Tel: 2369211-4 Fax: (852) 27272686		
<b>银同有限公司</b> Silver Town Limited Tel: 0769-833998 Fax: 0769-833994 E-MAIL: ADDRESS@silvertown.com.hk		
DRAWING TITLE: <b>[RR2-2]</b>		
CAD File Name:		
Designed by		
Drawn by		
Reviewed by		
Approved by		
Scale		
DWG NO.: (SK-RIF) - [RR2-2]		REV. 0


零件编号	规格(mm)	数量	单重(kg)	共重(kg)	厚度(mm)
F87	PL15*25.3	2	1.25	2.50	0.07
M618	PL5*99	1	4.71	4.71	0.25
M648	RHS200*100*10.0	1	52.15	52.15	0.69
合计:				59.35	

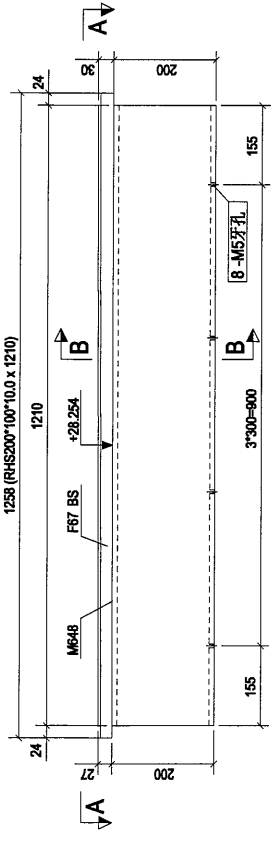

构件: RR2-3

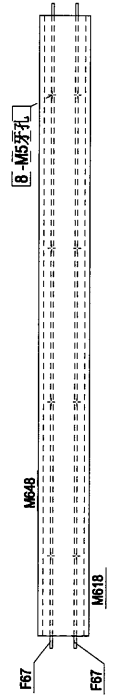

A - A

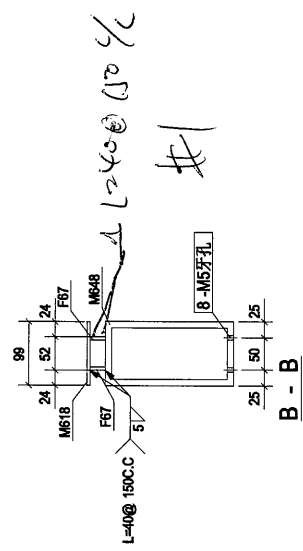


B - B

46


0	第一次报批	2018-08-11
Rev.	Description	Date
PROJECT: PROPOSED SITE C1 DEVELOPMENT AT AREA 86, TKOTL70 RP, TSEUNG KWAN O, NEW TERRITORIES		
S 银同有限公司 Silver Town Limited Tel: 0768-8335968 Fax: 0768-8335954 E-Mail: ADDRESS@silvertown.com.hk		
DRAWING TITLE: <b>[RR2-3]</b>		
CAD File Name:		
Designed by		
Drawn by		
Reviewed by		
Approved by		
Scale		
DWG NO.: (SK-PPF) - [RR2-3]		REV. 0

①


零件编号: RR2-4		零件数量: 2		零件重量: 59.74	
零件编号	规格(mm)	数量	重量	重量(kg)	表面积(m <sup>2</sup> )
F88	PL15*25.2	2	1.44	2.88	0.08
M618	PL5*99	1	4.71	4.71	0.25
MR48	RHS200*100*10.D	1	52.15	52.15	0.69
		合计:		59.74	

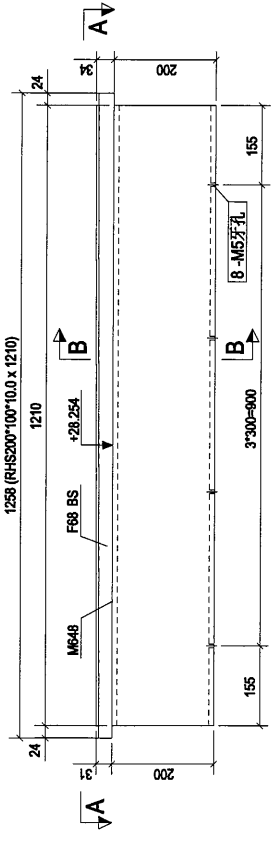

构件: RR2-4

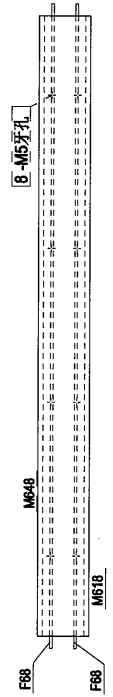

A - A

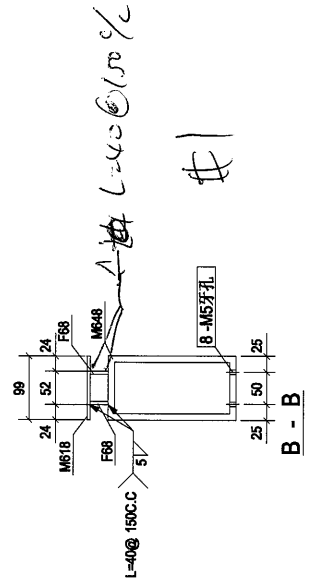


B - B


0	第一次放批	2018-08-11
Rev.	Description	Date
PROJECT: PROPOSED SITE C1 DEVELOPMENT AT AREA 86, TKOTI 70 RP, TSEUNG KWAN O, NEW TERRITORIES		
CLIENT: 美特鋁質有限公司 MIDI ALUMINIUM FABRICATOR LTD. Units 4-6, Sunny Industrial Centre, 1/F 4110 Cheung King Road, Cheung Sha Wan Tel: 23489211 + Fax: (852) 2772866		
S 銀同有限公司 Silver Town Limited Tel: 0769-8335968 Fax: 0769-8335954 E-MAIL: ADDRESS@silvertown.com.hk		
DRAWING TITLE: [RR2-4]		
CAD File Name:		
Designed by		
Drawn by		
Reviewed by		
Approved by		
Scale		
DWG NO.: (SK-PIF) - [RR2-4]		REV: 0

零件编号		RR2-5		零件数量		2		零件重量		60.11	
零件编号	规格(mm)	长度(mm)	数量	重量	共重(kg)	长度(mm)	数量	重量	共重(kg)	厚度(mm)	面积(cm <sup>2</sup> )
F89	PL15*33	1258	2	1.63	3.26	0.09					
M618	PL5*99	1211	1	4.70	4.70	0.25					
M648	RHS200*100*10.0	1210	1	52.15	52.15	0.89					
合计:										60.11	


98

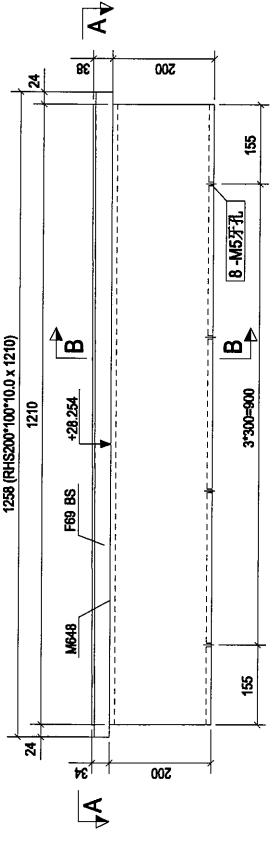

构件: RR2-5

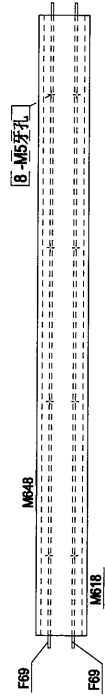

A - A

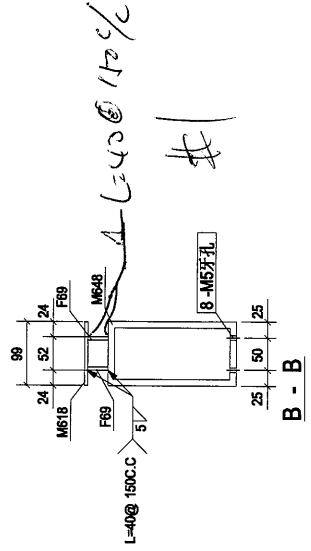


B - B

0	第一次核批	2018-08-11
Rev.	Description	Date
PROJECT: PROPOSED SITE C1 DEVELOPMENT AT AREA 86, TKOT L70 RP, TSEUNG KWAN O, NEW TERRITORIES		
<b>银同有限公司</b> Silver Town Limited Tel: 0768-8335988 Fax: 0768-8335954 E-MAIL: ADDRESS@silvertown.com.hk		
DRAWING TITLE: <b>[RR2-5]</b>		
CAD File Name:		
Designed by		
Drawn by		
Reviewed by		
Approved by		
Scale		
DWG NO.:	(SK-RF) - [RR2-5]	REV. 0

物料编号:	RRS-1	物料数量:	1	物料重量:	1.26
物料名称:	RRS-1	长度(mm):	100	单重(kg):	1.26
物料规格:	RHS120*50*5.0	数量:	1	共重(kg):	1.26
				表面积(m <sup>2</sup> ):	0.04
				合计:	1.26


AI

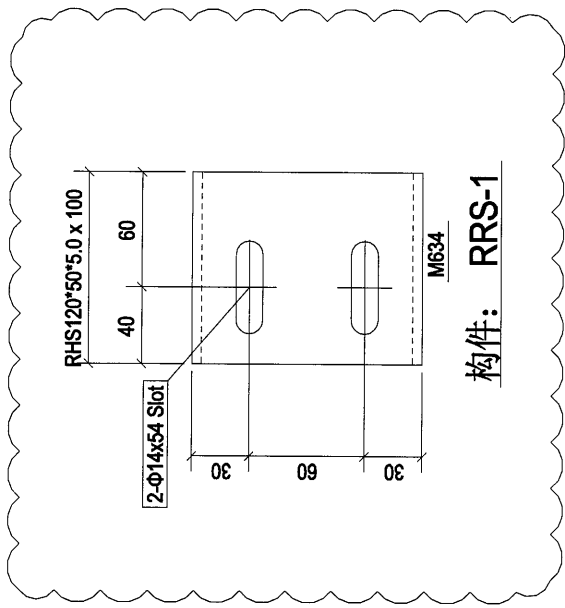


A	第2次草批	2018-08-14
Rev.	Description	Date
PROJECT:		
PROPOSED SITE C1 DEVELOPMENT AT AREA B6 TKOTL TO RP, TSEUNG KWAN O, NEW TERRITORIES		
CLIENT:		
美特铝质有限公司 ALUMINIUM FABRICATOR LTD. Units 6-8, Sunny Industrial Centre, 1/F 610 Cha Kwo Ling Road, Kowloon Tel: 23989211-4 Fax: (852) 27727865		
银同有限公司 Silver Town Limited Tel: 0769-8335968 Fax: 0769-8335984 E-MAIL: ADDRESS@silvertown.com.hk		
DRAWING TITLE :		
[RRS-1]		
CAD File Name :		
Designed by		
Drawn by		
Reviewed by		
Approved by		
Scale		
DWG NO. (SK-RIF) - [RRS-1]		REV. A

料件编号:	RRS-2	料件数量:	2	料件重量:	1.71
规格号:	RHS120*50*50	长度(mm):	153	单重(kg):	0.855
MSS		共重(kg):	1.71	共重(lb):	3.77
			合计:	1.71	0.06

90

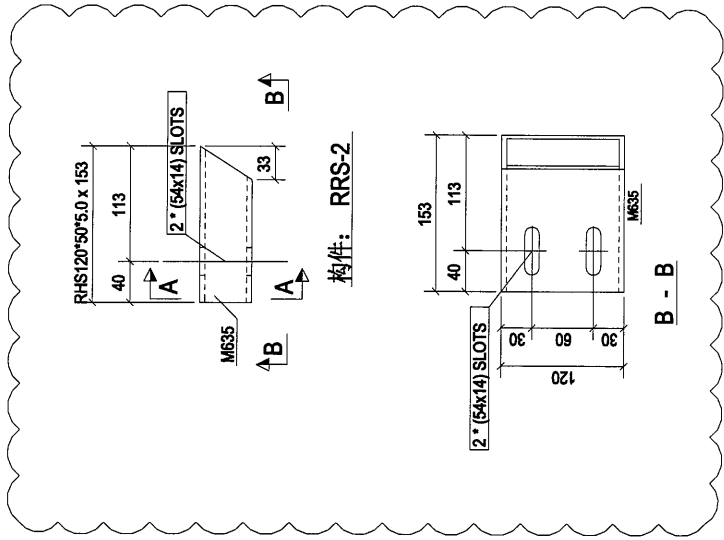

A	第2次球批	2018-08-14
Rev.	Description	Date
PROJECT:		
PROPOSED SITE C1 DEVELOPMENT AT AREA 86, TKOTL 70 RP, TSEUNG KWAN O, NEW TERRITORIES		
CLIENT:		
<b>美特鋁質有限公司</b> Units E-B, Saiyoy Industrial Centre, 1/F 610 Che Kwo Ling Road, Kowloon Tel: 23989211-4 Fax: (852) 2727866		
<b>银同有限公司</b> Silver Town Limited Tel: 0769-8335468 Fax: 0769-8335854 E-MAIL: ADDRESS@silvertown.com.hk		
DRAWING TITLE :		
[RRS-2]		
CAD File Name :		
Designed by		
Drawn by		
Reviewed by		
Approved by		
Scale		
DWG NO. (SK-RIF) - [RRS-2]		REV.
		A

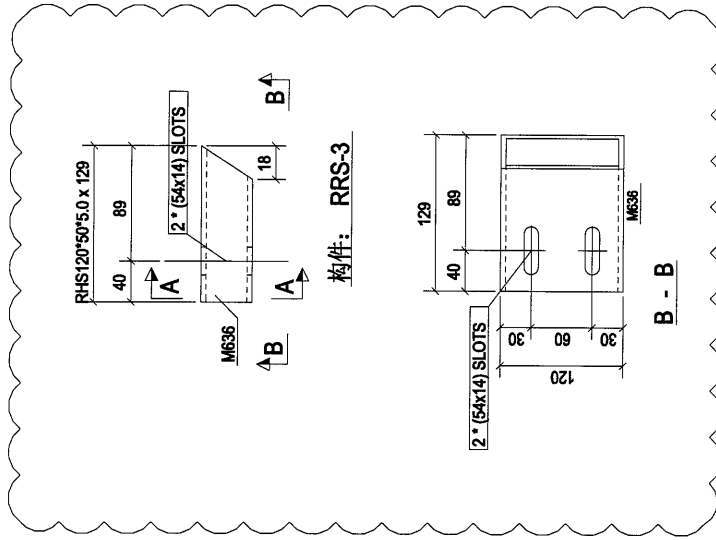


零件编号:	RRS-3	零件数量:	2	零件重量:	1.50
规格(mm)	M636	长度(mm)	129	单重(kg)	0.75
制作编号	RHS120*50*5.0	数量	1	共重(kg)	1.50
				表面积(m <sup>2</sup> )	0.04
				合计:	1.50



1571

A	第2次样批	2018-08-14
Rev.	Description	Date
PROJECT: PROPOSED SITE C1 DEVELOPMENT AT AREA B6 TKOTL 70 RP, TSEUNG KWAN O, NEW TERRITORIES		
CLIENT: 美特鋁質有限公司 MIDI ALUMINIUM FABRICATOR LTD. Units E-8, Sunny Industrial Centre, 1/F 810 Cha Kwo Ling Road, Kowloon Tel: 23499211-4 Fax: (852) 27727686		
S 银同有限公司 Silver Town Limited Tel: 0769-83354968 Fax: 0769-83359854 E-MAIL: ADDRESS@silvertown.com.hk		
DRAWING TITLE : [RRS-3]		
CAD File Name :		
Designed by		
Drawn by		
Reviewed by		
Approved by		
Scale		
DWG NO. (SK-RIF) - [RRS-3]		REV. A

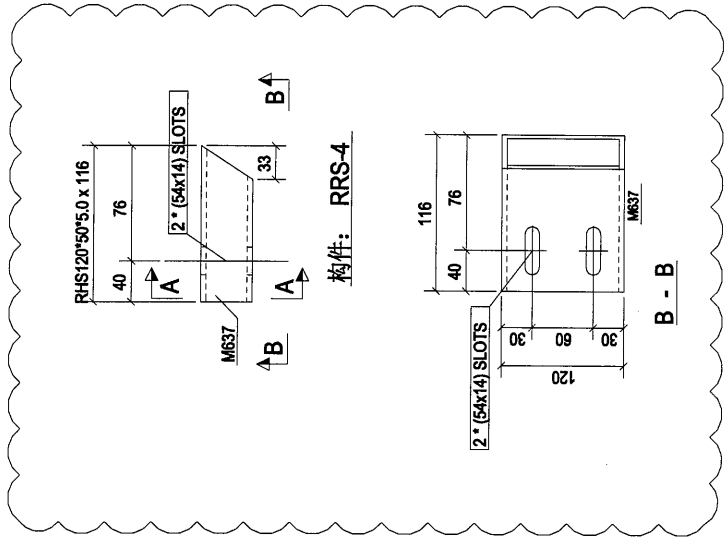零件编号:	RRS-4	零件数量:	2	零件重量:	1.40
规格(mm)	RHS120*50*5.0	长度(mm)	116	单重(Ng)	1.40
制作编号	M637	数量	1	共重(Ng)	1.40
				深重(Ng)	0.04
				合计:	1.40




构件: RRS-4

A	第2次样批	2018-08-14
Rev.	Description	Date
PROJECT:		
PROPOSED SITE C1 DEVELOPMENT AT AREA 86 TKOTL70 RP, TSEUNG KWAN O, NEW TERRITORIES		
CLIENT:		
 <b>美特铝质有限公司</b> ALUMINIUM FABRICATOR LTD. Units E-8, Sunny Industrial Centre, 1/F 810 Cho Kwo Ling Road, Kowloon Tel: 23489211-4 Fax: (852) 7727686		
 <b>银同有限公司</b> Silver Town Limited Tel: 0769-8335486 Fax: 0769-8335854 E-MAIL: ADDRESS@silvertown.com.hk		
DRAWING TITLE :		
[RRS-4]		
CAD File Name :		
Designed by		
Drawn by		
Reviewed by		
Approved by		
Scale		
DWG NO. (SK-RP) - [RRS-4]		REV. A


53

零件编号:	RRS-5	零件数量:	2	零件重量:	1.32
零件名称:	螺絲(mm)	长度(mm)	数量	重量	共重(g)
M638	RHS120°50°5.0	108	1	1.32	0.04
合计:				1.32	

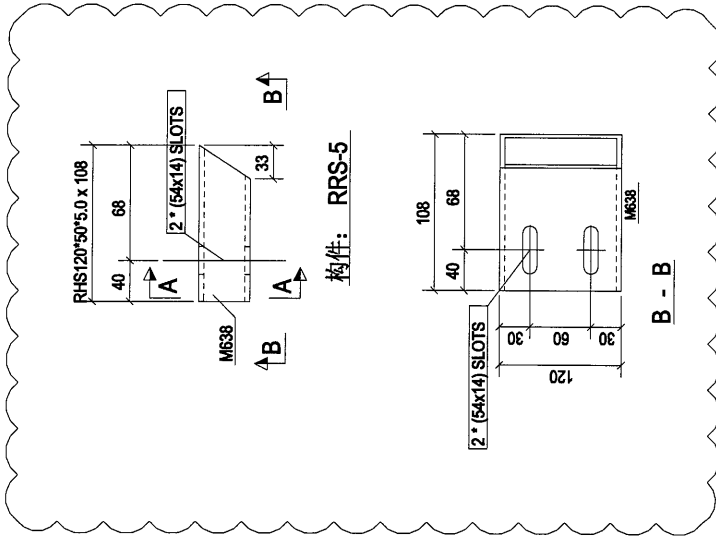


A	第2次核批	2018-08-14
Rev.	Description	Date
PROJECT: PROPOSED SITE C1 DEVELOPMENT AT AREA 86, TKOTL 70 RP, TSEUNG KWAN O, NEW TERRITORIES		
DRAWING TITLE: <b>S 銀同有限公司</b> Silver Town Limited Tel: 078-8335988 Fax: 078-8335954 E-Mail: ADDRESS@silvertown.com.hk		
CAD File Name : <b>[RRS-5]</b>		
Designed by		
Drawn by		
Reviewed by		
Approved by		
Scale		
DWG NO.: (SK-RFF) - [RRS-5]		REV. A

54

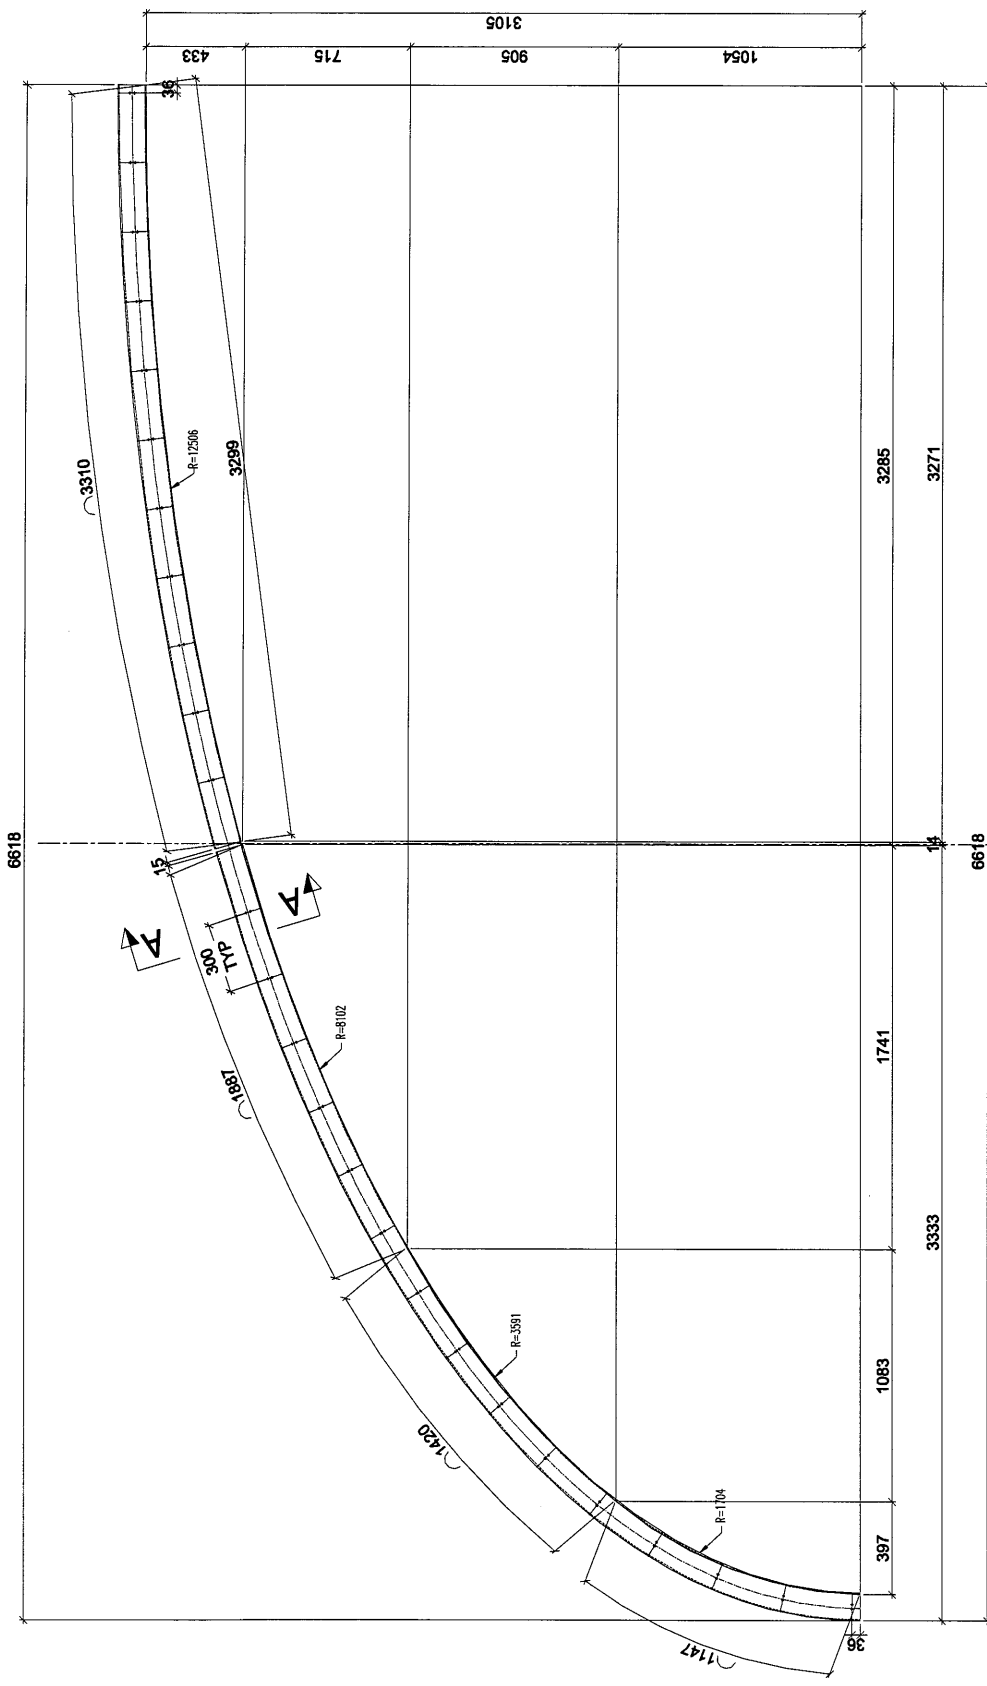


构件: RR3-1 (数量: 2 件)  
 构件: RR3-1a Similar But Handed (数量: 2 件)  
 构件: RR3-2 (数量: 2 件)  
 构件: RR3-2a Similar But Handed (数量: 2 件)

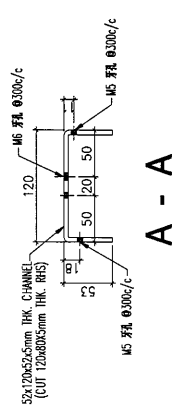

A	第2次报批	2018-08-15
Rev.	Description	Date
PROJECT: PROPOSED SITE C1 DEVELOPMENT AT AREA 86, TKOTI 70 RP, TSEUNG KWAN O, NEW TERRITORIES		
S 银同有限公司 Silver Town Limited Tel: 0769-8335988 Fax: 0769-8335984 E-MAIL: ADDRESS@silvertown.hk		
DRAWING TITLE: [RR3-1] [RR3-1a]		
CAD File Name :		
Designed by		
Drawn by		
Reviewed by		
Approved by		
Scale		
DWG NO.: (SK-PRF) - [RR3-1]		REV. A

55

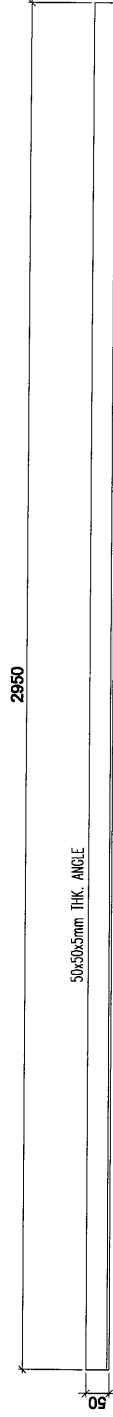

构件: RR4-1 (数量: 12 件)

A	第2次改批	2018-08-14
Rev.	Description	Date
PROJECT: PROPOSED SITE C1 DEVELOPMENT AT AREA 86, TKOTL 70 RP, TSEUNG KWAN O, NEW TERRITORIES.		
CLIENT: 美特鋁質有限公司 MIDI ALUMINIUM FABRICATOR LTD. Units E-B, Sunny Industrial Centre, 1/F 810 Chee Kwo Ling Road, Kowloon Tel: 23489211-4 Fax: (852) 27727866		
銀同有限公司 Silver Town Limited Tel: 0766-8335498 Fax: 0769-8335954 E-MAIL: ADDRESS@silvertown.com.hk		
DRAWING TITLE : [RR4-1] [RR4-1a]		
CAD File Name :		
Designed by		
Drawn by		
Reviewed by		
Approved by		
Scale		
DWG NO. : (SK-RIF) - [RR4-1]		REV. : A


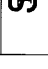
96

2950

50x50x5mm THK. ANGLE

50

构件: RR4-2 (数量: 12 件)

<b>A</b>	第2次报批	2018-08-14
Rev.	Description	Date
PROJECT: PROPOSED SITE C1 DEVELOPMENT AT AREA B6, TMOIL 70 RP, TSEUNG KWAN O, NEW TERRITORIES		
CLIENT:  美特铝质有限公司 MIDI ALUMINIUM FABRICATOR LTD. Units 6-8, Suncy Industrial Centre, 1/F 810 Chee Awo Ling Road, Kwunoon Tel: (852) 27272866 Fax: (852) 27272866 E-MAIL: ADDRESS@midialu.com.hk		
 银同有限公司 Silver Town Limited Tel: 0769-8335988 Fax: 0769-8335954 E-MAIL: ADDRESS@silvertown.com.hk		
DRAWING TITLE : [RR4-2] [RR4-2a]		
CAD File Name :		
Designed by		
Drawn by		
Reviewed by		
Approved by		
Scale		
DWG NO: (SK-R/F) - [RR4-2]		REV. A