



工程指示 / 要求簡箋(E.I.)

工程指示編號：EI/0270/19

修改版次：-

工程編號：J-837

工程名稱：觀塘裕民坊

工程項目：Glass Cladding 背板(樣板層)(7-9/F)(香檳金)(重出)

收件人：生統 / 永林

發件人：Eric Liu

日期：27/02/2019

要求提供 / 確認 事項：

- | | | |
|------------------------------------|-------------------------------------|-------------------------------|
| <input type="checkbox"/> 初步鋁料 B.M. | <input type="checkbox"/> 加工拆圖，然後生產 | <input type="checkbox"/> 尺寸表 |
| <input type="checkbox"/> 正式鋁料 B.M. | <input type="checkbox"/> 技術上資料 / 指示 | <input type="checkbox"/> 報價 |
| <input type="checkbox"/> 配件 B.M. | <input type="checkbox"/> 樣辦或貨品說明書 | <input type="checkbox"/> 分判合約 |
| <input type="checkbox"/> 其他：_____ | | |

內容：

請按加工圖 Glass Cladding 用鋁背板 (T1-T5 樣板層用)(7-9/F)

1) 則師改香檳金色(UCT803649FXL-3)

2) 因 EI0122 已噴色，需重出

(3) T1GC-E, T2GC-M 位置
因改名，新改裝後尺寸，先暫停(已在加工圖標註)

謝謝！

請在 2019/03/28 前完成上列要求。

03 08

附：11 頁加工圖 + 9 頁 B.M. + 7 頁位圖

以上項目為：

- 原合約工程包 原合約工程加 / 減賬 新工程報價

原因：-

分發東莞各部門：

- () 生產技術總監 連附件 (✓) 技術部 連附件 永林 () 生產部 連附件 () 機械設計部 連附件
 () 採購部 連附件 () 生產統籌部 連附件 梅
 () 質檢部 連附件 () 會計部 連附件 () 報關組 連附件 () 其他 楊榮輝 連附件

分發香港各部門：

- () 行政部 連附件 () 會計部 連附件 () 統籌部 連附件 (✓) 工程部地盤科文 連附件 阿哥
 () 採購部 連附件 () QS 部 連附件 () 維修部 連附件 () 其他 _____ 連附件

傳遞編號：

HK0489 /19

發件人簽署：

項目經理簽署：

 美特鋁質 有限公司 MIDI Aluminium Fabricator Ltd.		工程號: J-837	計算: 羅志光	日期:	2019/1/19			送呈: 胡哥					
		地盤名稱: 觀塘裕民坊	核對: 謝永林	日期:	2019/1/19			副本:					
廠用鋁板B.M.表		項目類別: Glass Cladding (7/8F)	批准:	日期:									
BM編號: 837-GC-M01-F-BP01		修改版次: EI10122 A版 (2019.02.19)		總V.F.:	150.69	總重量:	1346.54	此BM依據EI1006S計算					
序號	修改內容	鋁板圖號	鋁板名稱	顏色	實用	後備	總數	總重量	單件展 開面積	總展開面 積	單件V.F.	總V.F.	備註
									平方米		平方米		
1	A版修改色號	BL-1001	3mm厚鋁板	香檳金UCT803649FXL-3	1	0	1	11.892	1.463	1.463	1.350	1.350	
2	A版修改色號	BL-1004	3mm厚鋁板	香檳金UCT803649FXL-3	1	0	1	11.892	1.463	1.463	1.350	1.350	
3	A版修改色號	BL-1014	3mm厚鋁板	香檳金UCT803649FXL-3	1	0	1	11.892	1.463	1.463	1.350	1.350	
4	A版修改色號	BL-1017	3mm厚鋁板	香檳金UCT803649FXL-3	1	0	1	12.473	1.534	1.534	1.420	1.420	
5	A版修改色號	BL-1018	3mm厚鋁板	香檳金UCT803649FXL-3	1	0	1	11.892	1.463	1.463	1.350	1.350	
6	A版修改色號	BL-2002	3mm厚鋁板	香檳金UCT803649FXL-3	1	0	1	14.483	1.781	1.781	1.663	1.663	
7	A版修改色號	BL-2003	3mm厚鋁板	香檳金UCT803649FXL-3	1	0	1	11.892	1.463	1.463	1.350	1.350	
8	A版修改色號	BL-2006	3mm厚鋁板	香檳金UCT803649FXL-3	1	0	1	11.892	1.463	1.463	1.350	1.350	
9	A版修改色號	BL-2007	3mm厚鋁板	香檳金UCT803649FXL-3	1	0	1	12.042	1.481	1.481	1.368	1.368	
10	A版修改色號	BL-2008	3mm厚鋁板	香檳金UCT803649FXL-3	1	0	1	12.041	1.481	1.481	1.368	1.368	
11	A版修改色號	BL-2009	3mm厚鋁板	香檳金UCT803649FXL-3	1	0	1	12.041	1.481	1.481	1.368	1.368	
12	A版修改色號	BL-2020	3mm厚鋁板	香檳金UCT803649FXL-3	1	0	1	11.892	1.463	1.463	1.350	1.350	
13	A版修改色號	BL-3001	3mm厚鋁板	香檳金UCT803649FXL-3	1	0	1	11.892	1.463	1.463	1.350	1.350	
14	A版修改色號	BL-3002	3mm厚鋁板	香檳金UCT803649FXL-3	1	0	1	14.260	1.754	1.754	1.636	1.636	
15	A版修改色號	BL-3003	3mm厚鋁板	香檳金UCT803649FXL-3	1	0	1	14.260	1.754	1.754	1.636	1.636	
16	A版修改色號	BL-3004	3mm厚鋁板	香檳金UCT803649FXL-3	1	0	1	11.892	1.463	1.463	1.350	1.350	

 美特鋁質 有限公司 MIDI Aluminium Fabricator Ltd.		工程號: J-837	計算: 羅志光	日期: 2019/1/19				送呈: 胡哥					
		地盤名稱: 觀塘裕民坊	核對: 謝永林	日期: 2019/1/19				副本:					
廠用鋁板B.M.表		項目類別: Glass Cladding (7/8F)	批准:	日期:									
BM編號: 837-GC-M01-F-BP01		修改版次: EI0122 A版 (2019.02.19)		總V.F.:	150.69	總重量:	1346.54	此BM依據EI10008計算					
序號	修改內容	鋁板圖號	鋁板名稱	顏色	實用	後備	總數	總重量	單件展 開面積	總展開面 積	單件V.F.	總V.F.	備註
									平方米		平方米		
17	A版修改色號	BL-3005	3mm厚鋁板	香檳金UCT803649FXL-3	1	0	1	13.845	1.703	1.703	1.586	1.586	
18	A版修改色號	BL-3006	3mm厚鋁板	香檳金UCT803649FXL-3	1	0	1	13.842	1.703	1.703	1.585	1.585	
19	A版修改色號	BL-3007	3mm厚鋁板	香檳金UCT803649FXL-3	1	0	1	13.842	1.703	1.703	1.585	1.585	
20	A版修改色號	BL-3011	3mm厚鋁板	香檳金UCT803649FXL-3	1	0	1	11.892	1.463	1.463	1.350	1.350	
21	A版修改色號	BL-5001	3mm厚鋁板	香檳金UCT803649FXL-3	1	0	1	15.466	1.902	1.902	1.781	1.781	
22	A版修改色號	BL-5004	3mm厚鋁板	香檳金UCT803649FXL-3	1	0	1	15.466	1.902	1.902	1.781	1.781	
23	A版修改色號	BL-5005	3mm厚鋁板	香檳金UCT803649FXL-3	1	0	1	11.892	1.463	1.463	1.350	1.350	
24	A版修改色號	BL-5007	3mm厚鋁板	香檳金UCT803649FXL-3	1	0	1	13.667	1.681	1.681	1.564	1.564	
25	A版修改色號	BL-5008	3mm厚鋁板	香檳金UCT803649FXL-3	1	0	1	13.669	1.681	1.681	1.564	1.564	
26	A版修改色號	BL-5009	3mm厚鋁板	香檳金UCT803649FXL-3	1	0	1	13.669	1.681	1.681	1.564	1.564	
27	A版修改色號	BL-5010	3mm厚鋁板	香檳金UCT803649FXL-3	1	0	1	13.669	1.681	1.681	1.564	1.564	
28	A版修改色號	BL-5012	3mm厚鋁板	香檳金UCT803649FXL-3	1	0	1	14.483	1.781	1.781	1.663	1.663	
29	A版修改色號	BL-1015	3mm厚鋁板	香檳金UCT803649FXL-3	1	0	1	11.892	1.463	1.463	1.350	1.350	
30	A版修改色號	BL-1002	3mm厚鋁板	香檳金UCT803649FXL-3	1	0	1	11.580	1.424	1.424	1.312	1.312	
31	A版修改色號	BL-1003	3mm厚鋁板	香檳金UCT803649FXL-3	1	0	1	11.580	1.424	1.424	1.312	1.312	
32	A版修改色號	BL-1005	3mm厚鋁板	香檳金UCT803649FXL-3	1	0	1	9.591	1.180	1.180	1.072	1.072	

		工程號: J-837	計算: 羅志光	日期:	2019/1/19			送呈: 胡哥					
		地盤名稱: 觀塘裕民坊	核對: 謝永林	日期:	2019/1/19			副本:					
廠用鋁板B.M.表		項目類別: Glass Cladding (7/8F)	批准:	日期:									
BM編號: 837-GC-M01-F-BP01		修改版次: EI0122 A版 (2019.02.19)		總V.F.:	150.69	總重量:	1346.54	此BM依據EI10008計算					
序號	修改內容	鋁板圖號	鋁板名稱	顏色	實用	後備	總數	總重量	單件展 開面積	總展開面 積	單件V.F.	總V.F.	備註
									平方米		平方米		
33	A版修改色號	BL-1006	3mm厚鋁板	香檳金UCT803649FXL-3	1	0	1	9.591	1.180	1.180	1.072	1.072	
34	A版修改色號	BL-1007	3mm厚鋁板	香檳金UCT803649FXL-3	1	0	1	11.379	1.400	1.400	1.288	1.288	
35	A版修改色號	BL-1008	3mm厚鋁板	香檳金UCT803649FXL-3	1	0	1	11.513	1.416	1.416	1.304	1.304	
36	A版修改色號	BL-1009	3mm厚鋁板	香檳金UCT803649FXL-3	1	0	1	10.395	1.279	1.279	1.169	1.169	
37	A版修改色號	BL-1010	3mm厚鋁板	香檳金UCT803649FXL-3	1	0	1	10.529	1.295	1.295	1.185	1.185	
38	A版修改色號	BL-1012	3mm厚鋁板	香檳金UCT803649FXL-3	1	0	1	6.442	0.792	0.792	0.692	0.692	
39	A版修改色號	BL-1016	3mm厚鋁板	香檳金UCT803649FXL-3	1	0	1	11.312	1.391	1.391	1.280	1.280	
40	A版修改色號	BL-2001	3mm厚鋁板	香檳金UCT803649FXL-3	1	0	1	10.909	1.342	1.342	1.231	1.231	
41	A版修改色號	BL-2004	3mm厚鋁板	香檳金UCT803649FXL-3	1	0	1	11.580	1.424	1.424	1.312	1.312	
42	A版修改色號	BL-2005	3mm厚鋁板	香檳金UCT803649FXL-3	1	0	1	11.580	1.424	1.424	1.312	1.312	
43	A版修改色號	BL-2011	3mm厚鋁板	香檳金UCT803649FXL-3	1	0	1	9.099	1.119	1.119	1.013	1.013	
44	A版修改色號	BL-2012	3mm厚鋁板	香檳金UCT803649FXL-3	1	0	1	9.099	1.119	1.119	1.013	1.013	
45	A版修改色號	BL-2014	3mm厚鋁板	香檳金UCT803649FXL-3	1	0	1	11.195	1.377	1.377	1.266	1.266	
46	A版修改色號	BL-2015	3mm厚鋁板	香檳金UCT803649FXL-3	1	0	1	11.195	1.377	1.377	1.266	1.266	
47	A版修改色號	BL-2016	3mm厚鋁板	香檳金UCT803649FXL-3	1	0	1	11.195	1.377	1.377	1.266	1.266	
48	A版修改色號	BL-2017	3mm厚鋁板	香檳金UCT803649FXL-3	1	0	1	11.195	1.377	1.377	1.266	1.266	

		工程號: J-837	計算: 羅志光	日期:	2019/1/19			送呈: 胡哥					
		地盤名稱: 觀塘裕民坊	核對: 謝永林	日期:	2019/1/19			副本:					
廠用鋁板B.M.表		項目類別: Glass Cladding (7/8F)	批准:	日期:									
BM編號: 837-GC-M01-F-BP01		修改版次: EI0122 A版 (2019.02.19)		總V.F.:	150.69	總重量:	1346.54	此BM依據E110008計算					
序號	修改內容	鋁板圖號	鋁板名稱	顏色	實用	後備	總數	總重量	單件展開面積	總展開面積	單件V.F.	總V.F.	備註
									平方米		平方米		
49	A版修改色號	BL-2018	3mm厚鋁板	香檳金UCT803649FXL-3	1	0	1	11.195	1.377	1.377	1.266	1.266	
50	A版修改色號	BL-2019	3mm厚鋁板	香檳金UCT803649FXL-3	1	0	1	11.312	1.391	1.391	1.280	1.280	
51	A版修改色號	BL-3009	3mm厚鋁板	香檳金UCT803649FXL-3	1	0	1	11.580	1.424	1.424	1.312	1.312	
52	A版修改色號	BL-3010	3mm厚鋁板	香檳金UCT803649FXL-3	1	0	1	11.312	1.391	1.391	1.280	1.280	
53	A版修改色號	BL-5002	3mm厚鋁板	香檳金UCT803649FXL-3	1	0	1	11.580	1.424	1.424	1.312	1.312	
54	A版修改色號	BL-5003	3mm厚鋁板	香檳金UCT803649FXL-3	1	0	1	11.580	1.424	1.424	1.312	1.312	
55	A版修改色號	BL-5006	3mm厚鋁板	香檳金UCT803649FXL-3	1	0	1	11.312	1.391	1.391	1.280	1.280	
56	A版修改色號	BL-5011	3mm厚鋁板	香檳金UCT803649FXL-3	1	0	1	11.580	1.424	1.424	1.312	1.312	
57	A版修改色號	BL-5013	3mm厚鋁板	香檳金UCT803649FXL-3	1	0	1	11.151	1.372	1.372	1.260	1.260	
58	A版修改色號	BL-5014	3mm厚鋁板	香檳金UCT803649FXL-3	1	0	1	11.151	1.372	1.372	1.260	1.260	
59	A版修改色號	BL-5015	3mm厚鋁板	香檳金UCT803649FXL-3	1	0	1	11.151	1.372	1.372	1.260	1.260	
60	A版修改色號	BL-5016	3mm厚鋁板	香檳金UCT803649FXL-3	1	0	1	10.400	1.279	1.279	1.170	1.170	
61	A版修改色號	BL-5017	3mm厚鋁板	香檳金UCT803649FXL-3	1	0	1	10.400	1.279	1.279	1.170	1.170	
62	A版修改色號	BL-5018	3mm厚鋁板	香檳金UCT803649FXL-3	1	0	1	10.400	1.279	1.279	1.170	1.170	
63	A版修改色號	BL-1001a	3mm厚鋁板	香檳金UCT803649FXL-3	2	0	2	9.176	0.564	1.129	0.505	1.011	
64	A版修改色號	BL-1002a	3mm厚鋁板	香檳金UCT803649FXL-3	2	0	2	8.935	0.550	1.099	0.491	0.983	

		工程號: J-837	計算: 羅志光	日期:	2019/1/19			送呈: 胡哥					
		地盤名稱: 觀塘裕民坊	核對: 謝永林	日期:	2019/1/19			副本:					
廠用鋁板B.M.表		項目類別: Glass Cladding (7/8F)	批准:	日期:									
BM編號: 837-GC-M01-F-BP01		修改版次: EI10122 A版 (2019.02.19)		總V.F.:	150.69	總重量:	1346.54	此BM依據EI10008計算					
序號	修改內容	鋁板圖號	鋁板名稱	顏色	實用	後備	總數	總重量	單件展	總展開面	單件V.F.	總V.F.	備註
									開面積	積			
65	A版修改色號	BL-1003a	3mm厚鋁板	香檳金UCT803649FXL-3	2	0	2	8.935	0.550	1.099	0.491	0.983	
66	A版修改色號	BL-1004a	3mm厚鋁板	香檳金UCT803649FXL-3	2	0	2	9.176	0.564	1.129	0.505	1.011	
67	A版修改色號	BL-1005a	3mm厚鋁板	香檳金UCT803649FXL-3	2	0	2	7.400	0.455	0.910	0.401	0.803	
68	A版修改色號	BL-1006a	3mm厚鋁板	香檳金UCT803649FXL-3	2	0	2	7.400	0.455	0.910	0.401	0.803	
69	A版修改色號	BL-1007a	3mm厚鋁板	香檳金UCT803649FXL-3	2	0	2	8.781	0.540	1.080	0.482	0.964	
70	A版修改色號	BL-1008a	3mm厚鋁板	香檳金UCT803649FXL-3	2	0	2	8.884	0.546	1.093	0.488	0.977	
71	A版修改色號	BL-1009a	3mm厚鋁板	香檳金UCT803649FXL-3	2	0	2	8.021	0.493	0.987	0.438	0.875	
72	A版修改色號	BL-1010a	3mm厚鋁板	香檳金UCT803649FXL-3	2	0	2	8.124	0.500	0.999	0.444	0.888	
73	A版修改色號	BL-1012a	3mm厚鋁板	香檳金UCT803649FXL-3	2	0	2	4.971	0.306	0.611	0.259	0.518	
74	A版修改色號	BL-1014a	3mm厚鋁板	香檳金UCT803649FXL-3	2	0	2	9.176	0.564	1.129	0.505	1.011	
75	A版修改色號	BL-1015a	3mm厚鋁板	香檳金UCT803649FXL-3	2	0	2	9.176	0.564	1.129	0.505	1.011	
76	A版修改色號	BL-1016a	3mm厚鋁板	香檳金UCT803649FXL-3	2	0	2	8.728	0.537	1.074	0.479	0.958	
77	A版修改色號	BL-1017a	3mm厚鋁板	香檳金UCT803649FXL-3	2	0	2	9.624	0.592	1.184	0.532	1.063	
78	A版修改色號	BL-1018a	3mm厚鋁板	香檳金UCT803649FXL-3	2	0	2	9.176	0.564	1.129	0.505	1.011	
79	A版修改色號	BL-2001a	3mm厚鋁板	香檳金UCT803649FXL-3	2	0	2	8.418	0.518	1.035	0.461	0.922	
80	A版修改色號	BL-2002a	3mm厚鋁板	香檳金UCT803649FXL-3	2	0	2	11.176	0.687	1.375	0.623	1.245	

		工程號: J-837	計算: 羅志光	日期:	2019/1/19			送呈: 胡哥					
		地盤名稱: 觀塘裕民坊	核對: 謝永林	日期:	2019/1/19			副本:					
廠用鋁板B.M.表		項目類別: Glass Cladding (7/8F)	批准:	日期:									
BM編號: 837-GC-M01-F-BP01		修改版次: EI0122 A版 (2019.02.19)		總V.F.:	150.69	總重量:	1346.54	此BM依據EI10008計算					
序號	修改內容	鋁板圖號	鋁板名稱	顏色	實用	後備	總數	總重量	單件展 開面積	總展開面 積	單件V.F.	總V.F.	備註
									平方米		平方米		
81	A版修改色號	BL-2003a	3mm厚鋁板	香檳金UCT803649FXL-3	2	0	2	9.176	0.564	1.129	0.505	1.011	
82	A版修改色號	BL-2004a	3mm厚鋁板	香檳金UCT803649FXL-3	2	0	2	8.935	0.550	1.099	0.491	0.983	
83	A版修改色號	BL-2005a	3mm厚鋁板	香檳金UCT803649FXL-3	2	0	2	8.935	0.550	1.099	0.491	0.983	
84	A版修改色號	BL-2006a	3mm厚鋁板	香檳金UCT803649FXL-3	2	0	2	9.176	0.564	1.129	0.505	1.011	
85	A版修改色號	BL-2007a	3mm厚鋁板	香檳金UCT803649FXL-3	2	0	2	9.292	0.571	1.143	0.512	1.024	
86	A版修改色號	BL-2008a	3mm厚鋁板	香檳金UCT803649FXL-3	2	0	2	9.291	0.571	1.143	0.512	1.024	
87	A版修改色號	BL-2009a	3mm厚鋁板	香檳金UCT803649FXL-3	2	0	2	9.291	0.571	1.143	0.512	1.024	
88	A版修改色號	BL-2011a	3mm厚鋁板	香檳金UCT803649FXL-3	2	0	2	7.021	0.432	0.864	0.379	0.758	
89	A版修改色號	BL-2012a	3mm厚鋁板	香檳金UCT803649FXL-3	2	0	2	7.021	0.432	0.864	0.379	0.758	
90	A版修改色號	BL-2014a	3mm厚鋁板	香檳金UCT803649FXL-3	2	0	2	8.638	0.531	1.063	0.474	0.948	
91	A版修改色號	BL-2015a	3mm厚鋁板	香檳金UCT803649FXL-3	2	0	2	8.638	0.531	1.063	0.474	0.948	
92	A版修改色號	BL-2016a	3mm厚鋁板	香檳金UCT803649FXL-3	2	0	2	8.638	0.531	1.063	0.474	0.948	
93	A版修改色號	BL-2017a	3mm厚鋁板	香檳金UCT803649FXL-3	2	0	2	8.638	0.531	1.063	0.474	0.948	
94	A版修改色號	BL-2018a	3mm厚鋁板	香檳金UCT803649FXL-3	2	0	2	8.638	0.531	1.063	0.474	0.948	
95	A版修改色號	BL-2019a	3mm厚鋁板	香檳金UCT803649FXL-3	2	0	2	8.728	0.537	1.074	0.479	0.958	
96	A版修改色號	BL-2020a	3mm厚鋁板	香檳金UCT803649FXL-3	2	0	2	9.176	0.564	1.129	0.505	1.011	

		工程號: J-837	計算: 羅志光		日期:	2019/1/19				送呈: 胡哥			
		地盤名稱: 觀塘裕民坊	核對: 謝永林		日期:	2019/1/19				副本:			
廠用鋁板B.M.表		項目類別: Glass Cladding (7/8F)	批准:		日期:								
BM編號: 837-GC-M01-F-BP01		修改版次: EI0122 A版 (2019.02.19)		總V.F.:	150.69		總重量:	1346.54		此BM依據EI10008計算			
序號	修改內容	鋁板圖號	鋁板名稱	顏色	實用	後備	總數	總重量	單件展 開面積	總展開面 積	單件V.F.	總V.F.	備註
									平方米		平方米		
97	A版修改色號	BL-3001a	3mm厚鋁板	香檳金UCT803649FXL-3	2	0	2	9.176	0.564	1.129	0.505	1.011	
98	A版修改色號	BL-3002a	3mm厚鋁板	香檳金UCT803649FXL-3	2	0	2	11.003	0.677	1.353	0.612	1.225	
99	A版修改色號	BL-3003a	3mm厚鋁板	香檳金UCT803649FXL-3	2	0	2	11.003	0.677	1.353	0.612	1.225	
100	A版修改色號	BL-3004a	3mm厚鋁板	香檳金UCT803649FXL-3	2	0	2	9.176	0.564	1.129	0.505	1.011	
101	A版修改色號	BL-3005a	3mm厚鋁板	香檳金UCT803649FXL-3	2	0	2	10.683	0.657	1.314	0.594	1.187	
102	A版修改色號	BL-3006a	3mm厚鋁板	香檳金UCT803649FXL-3	2	0	2	10.681	0.657	1.314	0.594	1.187	
103	A版修改色號	BL-3007a	3mm厚鋁板	香檳金UCT803649FXL-3	2	0	2	10.681	0.657	1.314	0.594	1.187	
104	A版修改色號	BL-3009a	3mm厚鋁板	香檳金UCT803649FXL-3	2	0	2	8.935	0.550	1.099	0.491	0.983	
105	A版修改色號	BL-3010a	3mm厚鋁板	香檳金UCT803649FXL-3	2	0	2	8.728	0.537	1.074	0.479	0.958	
106	A版修改色號	BL-3011a	3mm厚鋁板	香檳金UCT803649FXL-3	2	0	2	9.176	0.564	1.129	0.505	1.011	
107	A版修改色號	BL-5001a	3mm厚鋁板	香檳金UCT803649FXL-3	2	0	2	11.934	0.734	1.468	0.667	1.334	
108	A版修改色號	BL-5002a	3mm厚鋁板	香檳金UCT803649FXL-3	2	0	2	8.935	0.550	1.099	0.491	0.983	
109	A版修改色號	BL-5003a	3mm厚鋁板	香檳金UCT803649FXL-3	2	0	2	8.935	0.550	1.099	0.491	0.983	
110	A版修改色號	BL-5004a	3mm厚鋁板	香檳金UCT803649FXL-3	2	0	2	11.934	0.734	1.468	0.667	1.334	
111	A版修改色號	BL-5005a	3mm厚鋁板	香檳金UCT803649FXL-3	2	0	2	9.176	0.564	1.129	0.505	1.011	
112	A版修改色號	BL-5006a	3mm厚鋁板	香檳金UCT803649FXL-3	2	0	2	8.728	0.537	1.074	0.479	0.958	

 美特鋁質 有限公司 MIDI Aluminium Fabricator Ltd.		工程號: J-837	計算: 羅志光	日期: 2019/1/19				送呈: 胡哥					
		地盤名稱: 觀塘裕民坊	核對: 謝永林	日期: 2019/1/19				副本:					
廠用鋁板B.M.表		項目類別: Glass Cladding (7/8F)	批准:	日期:									
BM編號: 837-GC-M01-F-BP01		修改版次: EI0122 A版 (2019.02.19)		總V.F.:	150.69	總重量:	1346.54	此BM依據EI10008計算					
序號	修改內容	鋁板圖號	鋁板名稱	顏色	實用	後備	總數	總重量	單件展 開面積	總展開面 積	單件V.F.	總V.F.	備註
									平方米		平方米		
113	A版修改色號	BL-5007a	3mm厚鋁板	香檳金UCT803649FXL-3	2	0	2	10.545	0.649	1.297	0.586	1.171	
114	A版修改色號	BL-5008a	3mm厚鋁板	香檳金UCT803649FXL-3	2	0	2	10.547	0.649	1.297	0.586	1.171	
115	A版修改色號	BL-5009a	3mm厚鋁板	香檳金UCT803649FXL-3	2	0	2	10.547	0.649	1.297	0.586	1.171	
116	A版修改色號	BL-5010a	3mm厚鋁板	香檳金UCT803649FXL-3	2	0	2	10.547	0.649	1.297	0.586	1.171	
117	A版修改色號	BL-5011a	3mm厚鋁板	香檳金UCT803649FXL-3	2	0	2	8.935	0.550	1.099	0.491	0.983	
118	A版修改色號	BL-5012a	3mm厚鋁板	香檳金UCT803649FXL-3	2	0	2	11.176	0.687	1.375	0.623	1.245	
119	A版修改色號	BL-5013a	3mm厚鋁板	香檳金UCT803649FXL-3	2	0	2	8.604	0.529	1.058	0.472	0.944	
120	A版修改色號	BL-5014a	3mm厚鋁板	香檳金UCT803649FXL-3	2	0	2	8.604	0.529	1.058	0.472	0.944	
121	A版修改色號	BL-5015a	3mm厚鋁板	香檳金UCT803649FXL-3	2	0	2	8.604	0.529	1.058	0.472	0.944	
122	A版修改色號	BL-5016a	3mm厚鋁板	香檳金UCT803649FXL-3	2	0	2	8.025	0.494	0.987	0.438	0.876	
123	A版修改色號	BL-5017a	3mm厚鋁板	香檳金UCT803649FXL-3	2	0	2	8.025	0.494	0.987	0.438	0.876	
124	A版修改色號	BL-5018a	3mm厚鋁板	香檳金UCT803649FXL-3	2	0	2	8.025	0.494	0.987	0.438	0.876	
125	A版修改色號	BL-2010	3mm厚鋁板	香檳金UCT803649FXL-3	1	0	1	6.215	0.764	0.764	0.696	0.696	
126	A版修改色號	BL-1011a	3mm厚鋁板	香檳金UCT803649FXL-3	2	0	2	10.285	0.633	1.265	0.570	1.141	
127	A版修改色號	BL-1013a	3mm厚鋁板	香檳金UCT803649FXL-3	2	0	2	8.166	0.502	1.004	0.447	0.894	
128	A版修改色號	BL-2013a	3mm厚鋁板	香檳金UCT803649FXL-3	2	0	2	8.039	0.494	0.989	0.440	0.879	

 美特鋁質 有限公司 MIDI Aluminium Fabricator Ltd.		工程號: J-837	計算: 羅志光	日期: 2019/1/19			送呈: 胡哥						
		地盤名稱: 觀塘裕民坊	核對: 謝永林	日期: 2019/1/19			副本:						
廠用鋁板B.M.表		項目類別: Glass Cladding (7/8F)	批准:	日期:									
BM編號: 837-GC-M01-F-BP01		修改版次: EI0122 A版 (2019.02.19)		總V.F.:	150.69	總重量:	1346.54 此BM依據EI10008計算						
序號	修改內容	鋁板圖號	鋁板名稱	顏色	實用	後備	總數	總重量	單件展 開面積	總展開面 積	單件V.F.	總V.F.	備註
									平方米		平方米		
129	A版修改色號	BL-2010a	3mm厚鋁板	香檳金UCT803649FXL-3	2	0	2	11.106	0.683	1.366	0.618	1.236	
130	A版修改色號	BL-1011	3mm厚鋁板	香檳金UCT803649FXL-3	1	0	1	1.606	0.198	0.198	0.157	0.157	
131	A版修改色號	BL-1013	3mm厚鋁板	香檳金UCT803649FXL-3	1	0	1	1.275	0.157	0.157	0.123	0.123	
132	A版修改色號	BL-2013	3mm厚鋁板	香檳金UCT803649FXL-3	1	0	1	1.280	0.157	0.157	0.123	0.123	
					合計:		198	1346.539		165.626		150.692	

圖則登記表
DRAWING REGISTER

工程名稱 Project Title: 觀塘裕民坊(7F~8F)
Glass Cladding背板拆圖
工程編號 Project No: J-837

接收日期 Receiving Date (適用於客戶圖則)

年										
月										
日										

分發予 Distributed To


發出日期 Issued Date

年	19	19								
月	01	02								
日	19	19								

圖則編號 Drg. No.	圖則名稱 Drawing Title
BL-1001	鋁板拆圖
BL-1001(1)	鋁板拆圖 (數據表)
BL-1001(2)	鋁板拆圖 (數據表)
BL-1001a	鋁板拆圖
BL-1001a(1)	鋁板拆圖 (數據表)
BL-1001a(2)	鋁板拆圖 (數據表)
BL-2010	鋁板拆圖
BL-1011a	鋁板拆圖
BL-2013a	鋁板拆圖
BL-2010a	鋁板拆圖
BL-1011	鋁板拆圖
J837-GC-2101	背板位置圖
J837-GC-2102	背板位置圖
J837-GC-2201	背板位置圖
J837-GC-2202	背板位置圖
J837-GC-2301	背板位置圖
J837-GC-2501	背板位置圖
J837-GC-2502	背板位置圖

修訂編號
Revision No.

1	-	A								
2	-	A								
3	-	A								
4	-	A								
5	-	A								
6	-	A								
7	-	A								
8	-	A								
9	-	A								
10	-	A								
11	-	A								
12	-	-								
13	-	-								
14	-	-								
15	-	-								
16	-	-								
17	-	-								
18	-	-								

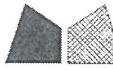


美特鋁質 有限公司
MIDI Aluminium Fabricator Ltd.

數據尺寸見附頁: BL-1001(1)/BL-1001(2)

工程號 J-837 地盤 觀塘裕民坊

工廠用

用於2250高度分格

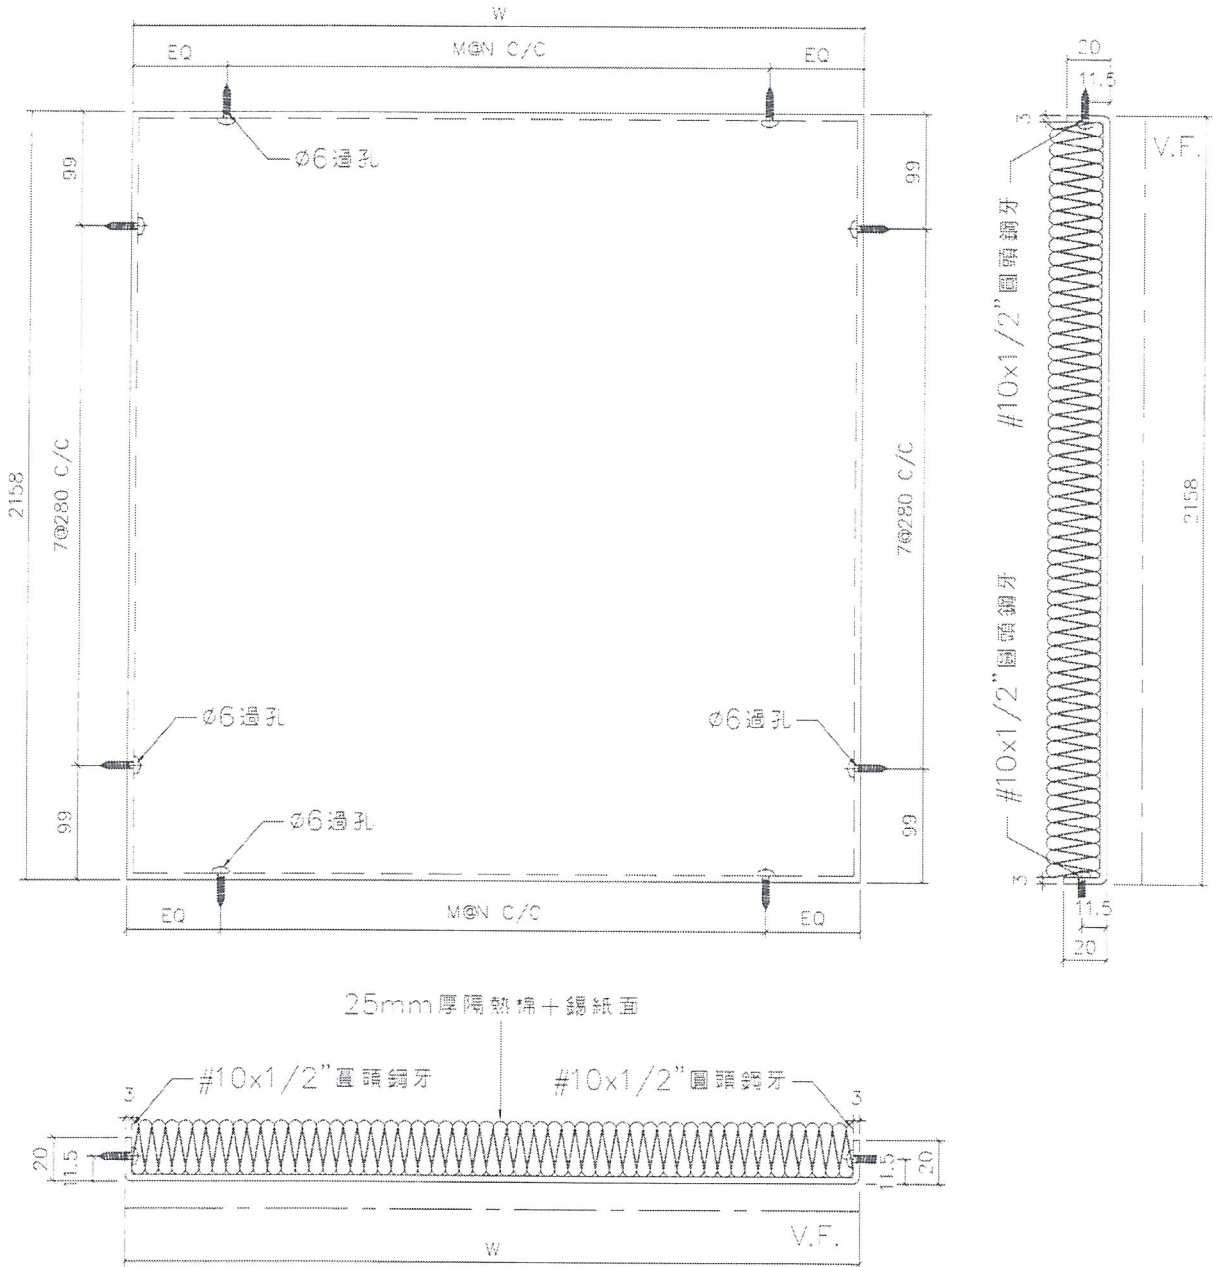

名稱	鋁板拆圖	制圖	羅志光	2019.01.18	修改	A
材料	3mm厚鋁板	復核	謝永林	2019.01.18	日期	2019.02.19
顏色	(香檳金UCT803649FXL-3)	批准			圖號	BL-1001



美特鋁質 有限公司
MIDI Aluminium Fabricator Ltd.

工程號 J-837 地盤 觀塘裕民坊

序號	物料編號	數量	W	EQ	M	N	使用位置	樓層	分格寬度	分格高度
1	BL-1001	1	625.5	62.75	2	250	T1GC-H	8/F	717.5	2250.0
2	BL-1004	1	625.5	62.75	2	250	T1GC-G	8/F	717.5	2250.0
3	BL-1014	1	625.5	62.75	2	250	T1GC-E	8/F	717.5	2250.0
4	BL-1017	1	658.0	79.00	2	250	T1GC-B	8/F	750.0	2250.0
5	BL-1018	1	625.5	62.75	2	250	T1GC-B	8/F	717.5	2250.0
6	BL-2002	1	770.5	85.25	2	300	T2GC-H	8/F	862.5	2250.0
7	BL-2003	1	625.5	62.75	2	250	T2GC-B	8/F	717.5	2250.0
8	BL-2006	1	625.5	62.75	2	250	T2GC-A	8/F	717.5	2250.0
9	BL-2007	1	633.9	66.95	2	250	T2GC-M	8/F	725.9	2250.0
10	BL-2008	1	633.8	66.90	2	250	T2GC-M	8/F	725.8	2250.0
11	BL-2009	1	633.8	66.90	2	250	T2GC-M	8/F	725.8	2250.0
12	BL-2020	1	625.5	62.75	2	250	T2GC-M	8/F	717.5	2250.0
13	BL-3001	1	625.5	62.75	2	250	T3GC-B	8/F	717.5	2250.0
14	BL-3002	1	758.0	79.00	2	300	T3GC-B	8/F	850.0	2250.0
15	BL-3003	1	758.0	79.00	2	300	T3GC-A	8/F	850.0	2250.0
16	BL-3004	1	625.5	62.75	2	250	T3GC-A	8/F	717.5	2250.0
17	BL-3005	1	734.8	67.40	2	300	T3GC-F	8/F	826.8	2250.0
18	BL-3006	1	734.6	67.30	2	300	T3GC-F	8/F	826.6	2250.0
19	BL-3007	1	734.6	67.30	2	300	T3GC-F	8/F	826.6	2250.0
20	BL-3011	1	625.5	62.75	2	250	T3GC-F	8/F	717.5	2250.0
21	BL-5001	1	825.5	112.75	2	300	T5GC-M	8/F	917.5	2250.0
22	BL-5004	1	825.5	112.75	2	300	T5GC-L	8/F	917.5	2250.0
23	BL-5005	1	625.5	62.75	2	250	T5GC-A	8/F	717.5	2250.0
24	BL-5007	1	724.8	62.40	2	300	T5GC-A	8/F	816.8	2250.0
25	BL-5008	1	724.9	62.45	2	300	T5GC-A	8/F	816.9	2250.0
26	BL-5009	1	724.9	62.45	2	300	T5GC-A	8/F	816.9	2250.0
27	BL-5010	1	724.9	62.45	2	300	T5GC-A	8/F	816.9	2250.0
28	BL-5012	1	770.5	85.25	2	300	T5GC-H	8/F	862.5	2250.0
29	BL-1015	1	625.5	62.75	2	250	T1GC-A	8/F	717.5	2250.0
30	BL-1002	1	608.0	54.00	2	250	T1GC-H	8/F	700.0	2250.0
31	BL-1003	1	608.0	54.00	2	250	T1GC-G	8/F	700.0	2250.0
	合計:	31								

名稱	鋁板拆圖 (數據表)	制圖	羅志光	2019. 01. 18	修改	A	
材料	3mm厚鋁板	復核	謝永林	2019. 01. 18	日期	2019. 02. 19	
顏色	(香檳金UCT803649FXL-3)	批准			圖號	BL-1001 (1)	



美特鋁質 有限公司
MIDI Aluminium Fabricator Ltd.

工程號 J-837 地盤 觀塘裕民坊

序號	物料編號	數量	W	EQ	M	N	使用位置	樓層	分格寬度	分格高度
1	BL-1005	1	496.7	98.35	1	300	T1GC-E	8/F	588.7	2250.0
2	BL-1006	1	496.7	98.35	1	300	T1GC-E	8/F	588.7	2250.0
3	BL-1007	1	596.8	48.40	2	250	T1GC-E	8/F	696.3	2250.0
4	BL-1008	1	604.3	52.15	2	250	T1GC-E	8/F	696.3	2250.0
5	BL-1009	1	541.7	120.85	1	300	T1GC-E	8/F	641.2	2250.0
6	BL-1010	1	549.2	124.60	1	300	T1GC-E	8/F	641.2	2250.0
7	BL-1012	1	320.5	60.25	1	200	T1GC-E	8/F	412.5	2250.0
8	BL-1016	1	593.0	46.50	2	250	T1GC-A	8/F	685.0	2250.0
9	BL-2001	1	570.5	135.25	1	300	T2GC-H	8/F	662.5	2250.0
10	BL-2004	1	608.0	54.00	2	250	T2GC-B	8/F	700.0	2250.0
11	BL-2005	1	608.0	54.00	2	250	T2GC-A	8/F	700.0	2250.0
12	BL-2011	1	469.2	84.60	1	300	T2GC-M	8/F	561.2	2250.0
13	BL-2012	1	469.2	84.60	1	300	T2GC-M	8/F	561.2	2250.0
14	BL-2014	1	586.5	143.25	1	300	T2GC-M	8/F	678.5	2250.0
15	BL-2015	1	586.5	143.25	1	300	T2GC-M	8/F	678.5	2250.0
16	BL-2016	1	586.5	143.25	1	300	T2GC-M	8/F	678.5	2250.0
17	BL-2017	1	586.5	143.25	1	300	T2GC-M	8/F	678.5	2250.0
18	BL-2018	1	586.5	143.25	1	300	T2GC-M	8/F	678.5	2250.0
19	BL-2019	1	593.0	46.50	2	250	T2GC-M	8/F	685.0	2250.0
20	BL-3009	1	608.0	54.00	2	250	T3GC-F	8/F	700.0	2250.0
21	BL-3010	1	593.0	46.50	2	250	T3GC-F	8/F	685.0	2250.0
22	BL-5002	1	608.0	54.00	2	250	T5GC-M	8/F	700.0	2250.0
23	BL-5003	1	608.0	54.00	2	250	T5GC-L	8/F	700.0	2250.0
24	BL-5006	1	593.0	46.50	2	250	T5GC-A	8/F	685.0	2250.0
25	BL-5011	1	608.0	54.00	2	250	T5GC-H	8/F	700.0	2250.0
26	BL-5013	1	584.0	142.00	1	300	T5GC-H	8/F	676.0	2250.0
27	BL-5014	1	584.0	142.00	1	300	T5GC-H	8/F	676.0	2250.0
28	BL-5015	1	584.0	142.00	1	300	T5GC-H	8/F	676.0	2250.0
29	BL-5016	1	542.0	121.00	1	300	T5GC-H	8/F	634.0	2250.0
30	BL-5017	1	542.0	121.00	1	300	T5GC-H	8/F	634.0	2250.0
31	BL-5018	1	542.0	121.00	1	300	T5GC-H	8/F	634.0	2250.0
合計:		31								

名稱	鋁板拆圖 (數據表)	制圖	羅志光	2019.01.18	修改	A	
材料	3mm厚鋁板	復核	謝永林	2019.01.18	日期	2019.02.19	
顏色	(香檳金UCT803649FXL-3)	批准			圖號	BL-1001 (2)	




美特鋁質有限公司
MIDI Aluminium Fabricator Ltd.

數據尺寸見附頁: BL-1001a(1)/BL-1001a(2)

工程號 J-837 地盤 觀塘裕民坊

工廠用

用於900高度分格

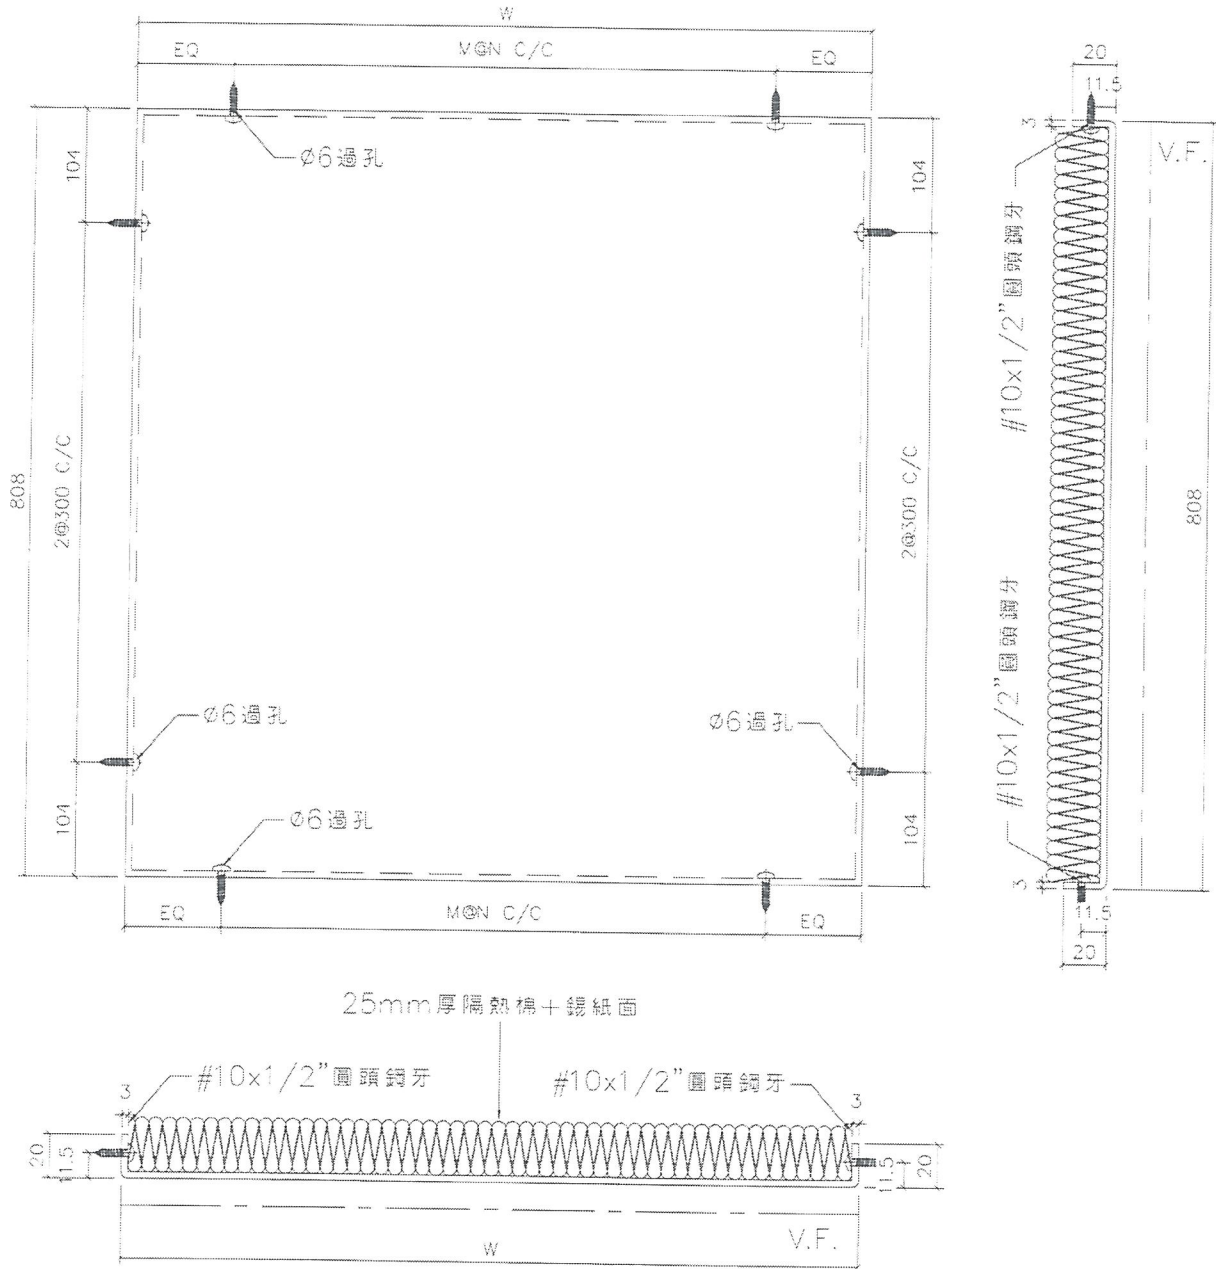

名稱	鋁板拆圖	制圖	羅志光	2019.01.18	修改	A	
材料	3mm厚鋁板	復核	謝永林	2019.01.18	日期	2019.02.19	
顏色	(香檳金UCT803649FXL-3)	批准			圖號	BL-1001a	



美特鋁質 有限公司
M/DI Aluminium Fabricator Ltd.

工程號 J-837 地盤 觀塘裕民坊

序號	物料編號	數量	W	EQ	M	N	使用位置	樓層	分格寬度	分格高度
1	BL-1001a	2	625.50	62.75	2	250	T1GC-H	7/F-8/F	717.5	900.0
2	BL-1002a	2	608.00	54.00	2	250	T1GC-H	7/F-8/F	700.0	900.0
3	BL-1003a	2	608.00	54.00	2	250	T1GC-G	7/F-8/F	700.0	900.0
4	BL-1004a	2	625.50	62.75	2	250	T1GC-G	7/F-8/F	717.5	900.0
5	BL-1005a	2	496.70	98.35	1	300	T1GC-E	7/F-8/F	588.7	900.0
6	BL-1006a	2	496.70	98.35	1	300	T1GC-E	7/F-8/F	588.7	900.0
7	BL-1007a	2	596.80	48.40	2	250	T1GC-E	7/F-8/F	696.3	900.0
8	BL-1008a	2	604.30	52.15	2	250	T1GC-E	7/F-8/F	696.3	900.0
9	BL-1009a	2	541.70	120.85	1	300	T1GC-E	7/F-8/F	641.2	900.0
10	BL-1010a	2	549.20	124.60	1	300	T1GC-E	7/F-8/F	641.2	900.0
11	BL-1012a	2	320.50	60.25	1	200	T1GC-E	7/F-8/F	412.5	900.0
12	BL-1014a	2	625.50	62.75	2	250	T1GC-E	7/F-8/F	717.5	900.0
13	BL-1015a	2	625.50	62.75	2	250	T1GC-A	7/F-8/F	717.5	900.0
14	BL-1016a	2	593.00	46.50	2	250	T1GC-A	7/F-8/F	685.0	900.0
15	BL-1017a	2	658.00	79.00	2	250	T1GC-B	7/F-8/F	750.0	900.0
16	BL-1018a	2	625.50	62.75	2	250	T1GC-B	7/F-8/F	717.5	900.0
17	BL-2001a	2	570.50	135.25	1	300	T2GC-H	7/F-8/F	662.5	900.0
18	BL-2002a	2	770.50	85.25	2	300	T2GC-H	7/F-8/F	862.5	900.0
19	BL-2003a	2	625.50	62.75	2	250	T2GC-B	7/F-8/F	717.5	900.0
20	BL-2004a	2	608.00	54.00	2	250	T2GC-B	7/F-8/F	700.0	900.0
21	BL-2005a	2	608.00	54.00	2	250	T2GC-A	7/F-8/F	700.0	900.0
22	BL-2006a	2	625.50	62.75	2	250	T2GC-A	7/F-8/F	717.5	900.0
23	BL-2007a	2	633.90	66.95	2	250	T2GC-M	7/F-8/F	725.9	900.0
24	BL-2008a	2	633.80	66.90	2	250	T2GC-M	7/F-8/F	725.8	900.0
25	BL-2009a	2	633.80	66.90	2	250	T2GC-M	7/F-8/F	725.8	900.0
26	BL-2011a	2	469.20	84.60	1	300	T2GC-M	7/F-8/F	561.2	900.0
27	BL-2012a	2	469.20	84.60	1	300	T2GC-M	7/F-8/F	561.2	900.0
28	BL-2014a	2	586.50	143.25	1	300	T2GC-M	7/F-8/F	678.5	900.0
29	BL-2015a	2	586.50	143.25	1	300	T2GC-M	7/F-8/F	678.5	900.0
30	BL-2016a	2	586.50	143.25	1	300	T2GC-M	7/F-8/F	678.5	900.0
31	BL-2017a	2	586.50	143.25	1	300	T2GC-M	7/F-8/F	678.5	900.0
合計：		62								

名稱	鋁板拆圖 (數據表)	制圖	羅志光	2019.01.18	修改	A
材料	3mm厚鋁板	復核	謝永林	2019.01.18	日期	2019.02.19
顏色	(香檳金UCT803649FXL-3)	批準			圖號	BL-1001a (1)




美特鋁質 有限公司
MIDI Aluminium Fabricator Ltd.

工程號 J-837 地盤 觀塘裕民坊

序號	物料編號	數量	W	EQ	M	N	使用位置	樓層	分格寬度	分格高度
1	BL-2018a	2	586.50	143.25	1	300	T2GC-M	7/F-8/F	678.5	900.0
2	BL-2019a	2	593.00	46.50	2	250	T2GC-M	7/F-8/F	685.0	900.0
3	BL-2020a	2	625.50	62.75	2	250	T2GC-M	7/F-8/F	717.5	900.0
4	BL-3001a	2	625.50	62.75	2	250	T3GC-B	7/F-8/F	717.5	900.0
5	BL-3002a	2	758.00	79.00	2	300	T3GC-B	7/F-8/F	850.0	900.0
6	BL-3003a	2	758.00	79.00	2	300	T3GC-A	7/F-8/F	850.0	900.0
7	BL-3004a	2	625.50	62.75	2	250	T3GC-A	7/F-8/F	717.5	900.0
8	BL-3005a	2	734.80	67.40	2	300	T3GC-F	7/F-8/F	826.8	900.0
9	BL-3006a	2	734.60	67.30	2	300	T3GC-F	7/F-8/F	826.6	900.0
10	BL-3007a	2	734.60	67.30	2	300	T3GC-F	7/F-8/F	826.6	900.0
11	BL-3009a	2	608.00	54.00	2	250	T3GC-F	7/F-8/F	700.0	900.0
12	BL-3010a	2	593.00	46.50	2	250	T3GC-F	7/F-8/F	685.0	900.0
13	BL-3011a	2	625.50	62.75	2	250	T3GC-F	7/F-8/F	717.5	900.0
14	BL-5001a	2	825.50	112.75	2	300	T5GC-M	7/F-8/F	917.5	900.0
15	BL-5002a	2	608.00	54.00	2	250	T5GC-M	7/F-8/F	700.0	900.0
16	BL-5003a	2	608.00	54.00	2	250	T5GC-L	7/F-8/F	700.0	900.0
17	BL-5004a	2	825.50	112.75	2	300	T5GC-L	7/F-8/F	917.5	900.0
18	BL-5005a	2	625.50	62.75	2	250	T5GC-A	7/F-8/F	717.5	900.0
19	BL-5006a	2	593.00	46.50	2	250	T5GC-A	7/F-8/F	685.0	900.0
20	BL-5007a	2	724.80	62.40	2	300	T5GC-A	7/F-8/F	816.8	900.0
21	BL-5008a	2	724.90	62.45	2	300	T5GC-A	7/F-8/F	816.9	900.0
22	BL-5009a	2	724.90	62.45	2	300	T5GC-A	7/F-8/F	816.9	900.0
23	BL-5010a	2	724.90	62.45	2	300	T5GC-A	7/F-8/F	816.9	900.0
24	BL-5011a	2	608.00	54.00	2	250	T5GC-H	7/F-8/F	700.0	900.0
25	BL-5012a	2	770.50	85.25	2	300	T5GC-H	7/F-8/F	862.5	900.0
26	BL-5013a	2	584.00	142.00	1	300	T5GC-H	7/F-8/F	676.0	900.0
27	BL-5014a	2	584.00	142.00	1	300	T5GC-H	7/F-8/F	676.0	900.0
28	BL-5015a	2	584.00	142.00	1	300	T5GC-H	7/F-8/F	676.0	900.0
29	BL-5016a	2	542.00	121.00	1	300	T5GC-H	7/F-8/F	634.0	900.0
30	BL-5017a	2	542.00	121.00	1	300	T5GC-H	7/F-8/F	634.0	900.0
31	BL-5018a	2	542.00	121.00	1	300	T5GC-H	7/F-8/F	634.0	900.0
合計：		62	60							

名稱	鋁板拆圖 (數據表)	制圖	羅志光	2019.01.18	修改	A
材料	3mm厚鋁板	復核	謝永林	2019.01.18	日期	2019.02.19
顏色	香檳金UCT803649FXL-3	批准			圖號	BL-1001a (2)

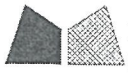


美特鋁質有限公司
MDI Aluminium Fabricator Ltd.

數量	使用位置	樓層	分格寬度	分格高度
1	T2GC-M	8/F	1010.0	850.0

工程號 J-837 地盤 觀塘裕民坊

工廠用

暫停

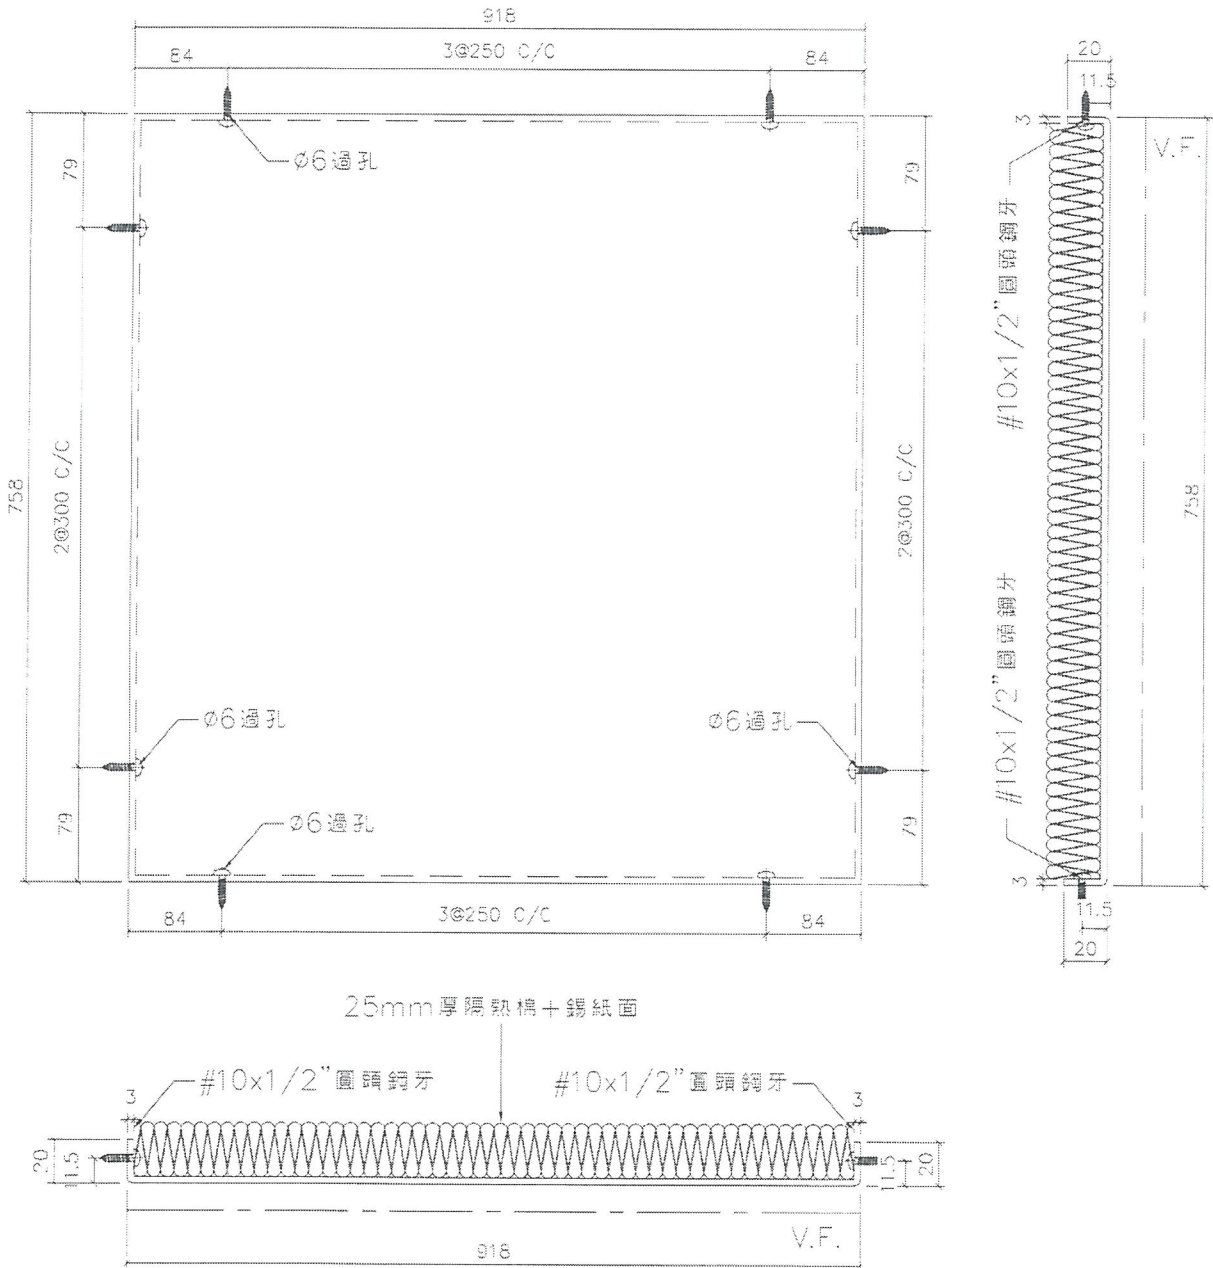

名稱	鋁板拆圖	制圖	羅志光	2019.01.18	修改	A	
材料	3mm厚鋁板	復核	謝永林	2019.01.18	日期	2019.02.19	
顏色	(香檳金UCT803649FXL-3)	批准			圖號	BL-2010	




美特鋁質有限公司
MIDI Aluminium Fabricator Ltd.


工程號 J-837 地盤 觀塘裕民坊

工廠用

序號	物料編號	數量	W	EQ	M	N	使用位置	樓層	分格寬度	分格高度
1	BL-1011a	2	773.0	86.50	2	300	T1GC-E	7/F-8/F	865.0	830.0
2	BL-1013a	2	605.5	52.75	2	250	T1GC-E	7/F-8/F	697.5	830.0
總計:		4	2							

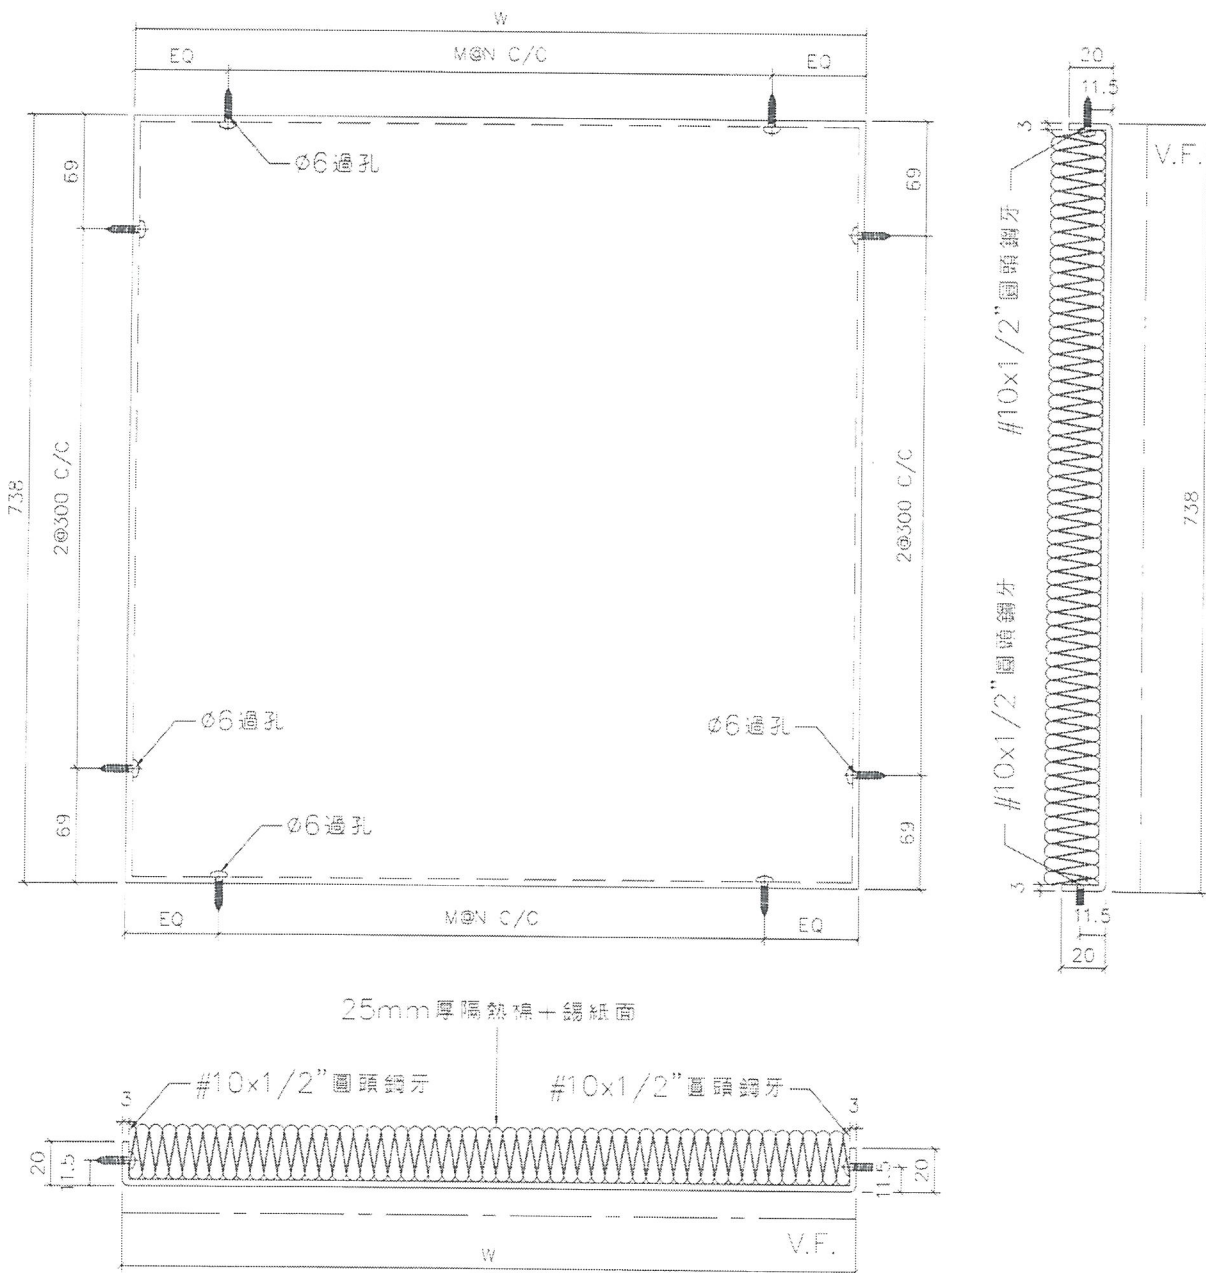

名稱	鋁板拆圖	制圖	羅志光	2019.01.18	修改	A		
材料	3mm厚鋁板	復核	謝永林	2019.01.18	日期	2019.02.19		
顏色	(香檳金UCT803649FXL-3)	批準			圖號	BL-1011a		

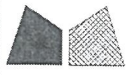


美特鋁質有限公司
MIDI Aluminium Fabricator Ltd.

數量	使用位置	樓層	分格寬度	分格高度
2	T2GC-M	7/F-8/F	700.0	815.0


工程號 J-837 地盤 觀塘裕民坊

工廠用

暫停

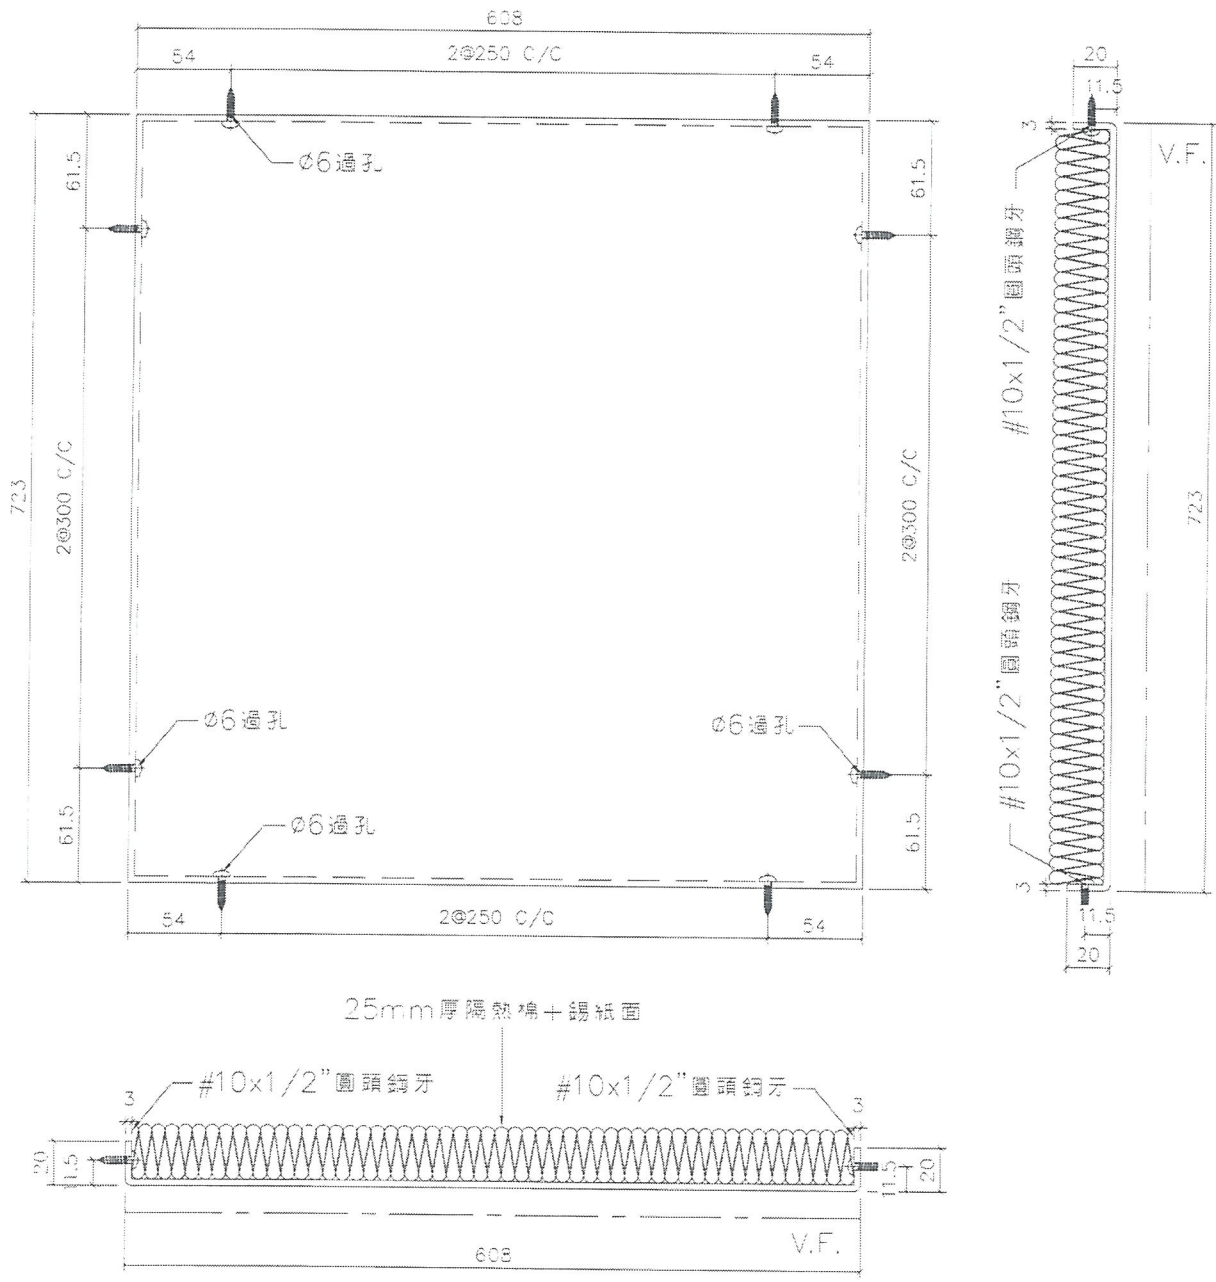

名稱	鋁板拆圖	制圖	羅志光	2019.01.18	修改	A	
材料	3mm厚鋁板	復核	謝永林	2019.01.18	日期	2019.02.19	
顏色	(香檳金UCT803649FXL-3)	批准			圖號	BL-2013a	

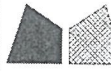


美特鋁質有限公司
MIDI Aluminium Fabricator Ltd.

數量	使用位置	樓層	分格寬度	分格高度
2	T2GC-M	7/F-8/F	1010.0	765.0

工程號	J-837	地盤	觀塘裕民坊
-----	-------	----	-------

工廠用

暫停

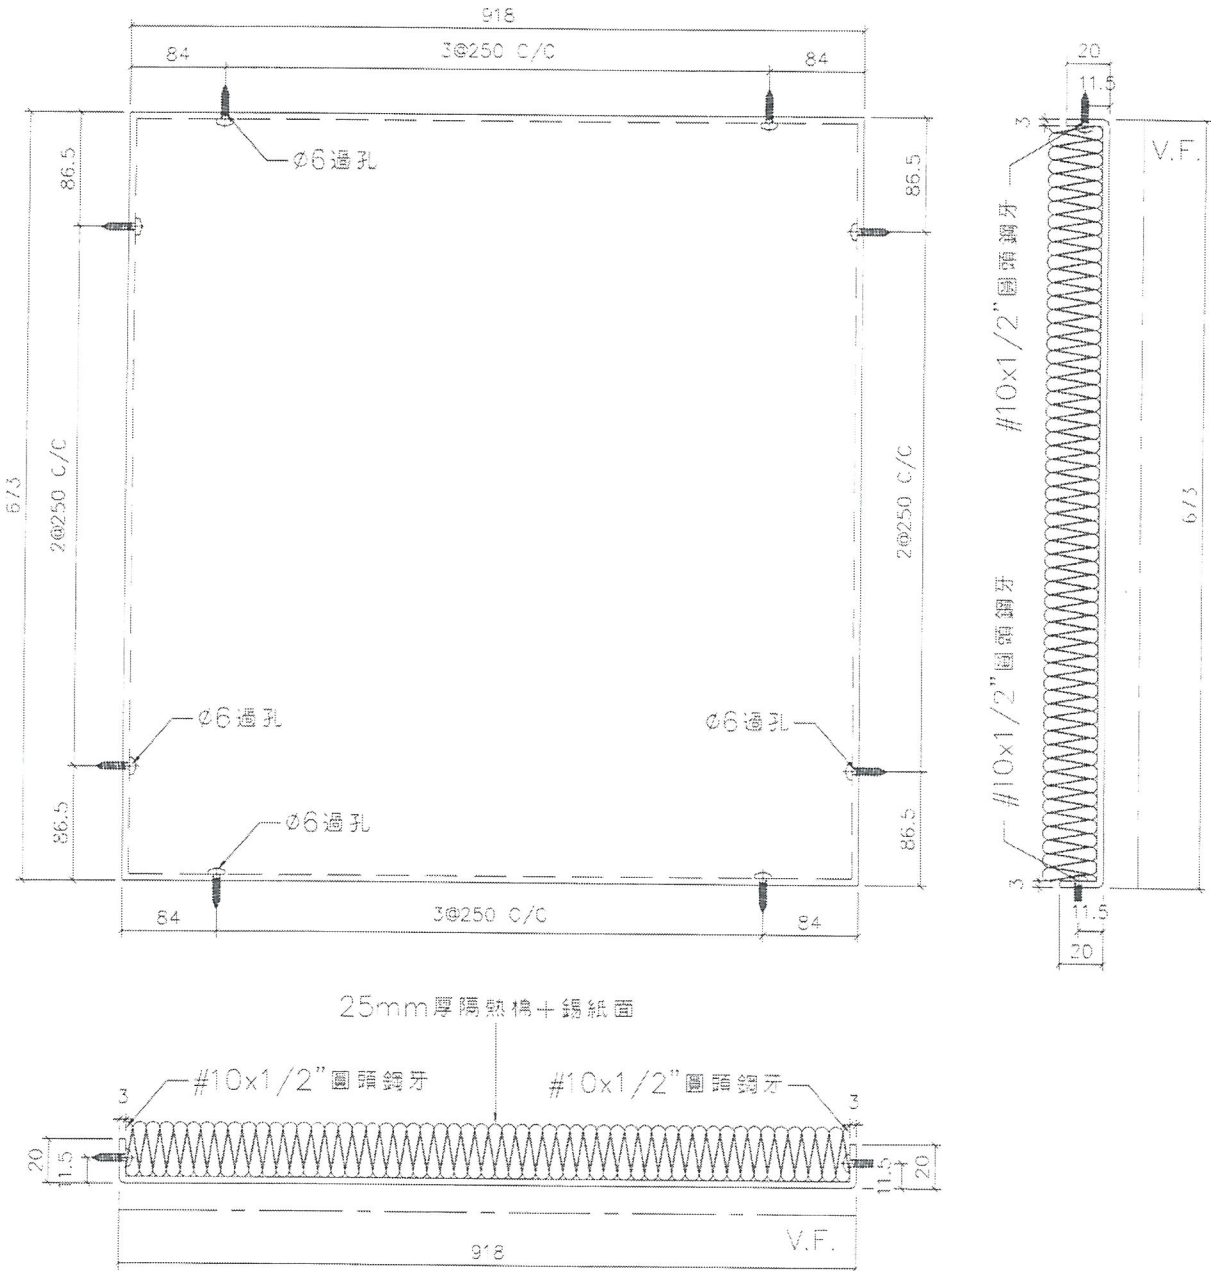

名稱	鋁板拆圖	制圖	羅志光	2019.01.18	修改	A
材料	3mm厚鋁板	復核	謝永林	2019.01.18	日期	2019.02.19
顏色	香檳金 UCT803649FXL-3	批准			圖號	BL-2010a




美特鋁質 有限公司
MIDI Aluminium Fabricator Ltd.

工程號 J-837 地盤 觀塘裕民坊

工廠用

序號	物料編號	數量	W	EQ	M	N	使用位置	樓層	分格寬度	分格高度
1	BL-1011	1	773.0	86.50	2	300	T1GC-E	8/F	865.0	295.0
2	BL-1013	1	605.5	52.75	2	250	T1GC-E	8/F	697.5	295.0
3	BL-2013	1	608.0	54.00	2	250	T2GC-M	8/F	700.0	295.0
合計:		3								

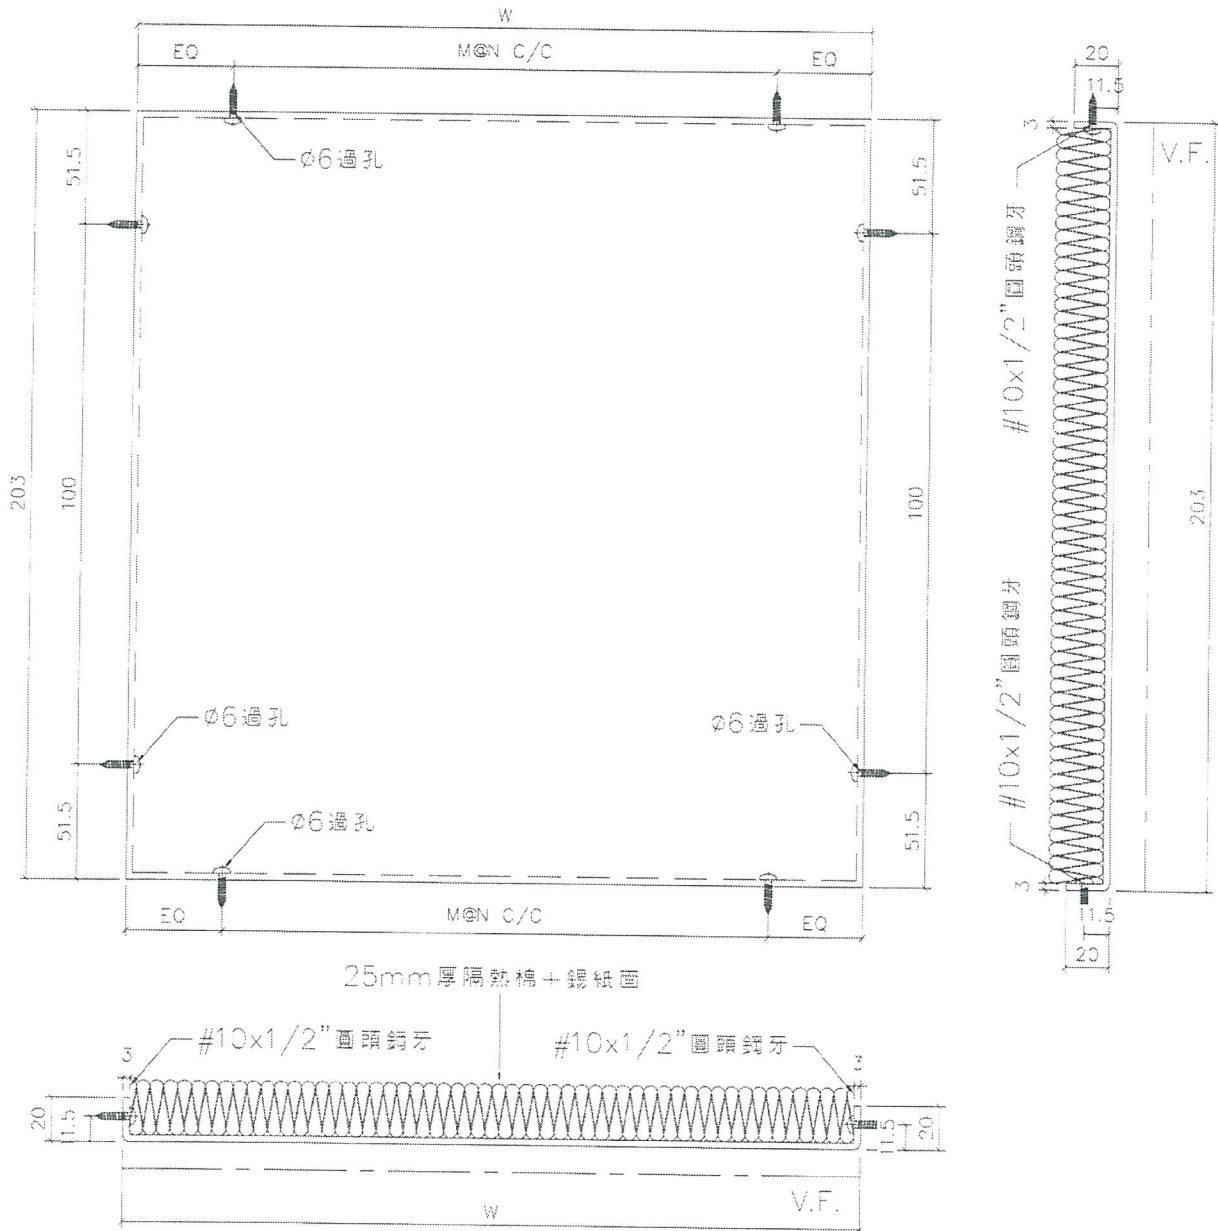

名稱	鋁板拆圖	制圖	羅志光	2019.01.18	修改	A	
材料	3mm厚鋁板	復核	謝永林	2019.01.18	日期	2019.02.19	
顏色	(香檳金UCT803649FXL-3)	批準			圖號	BL-1011	

midi@midiltd.com.hk

From: Wong Wai Yee Christina <christinawiyong@wongtung.com>
To: "SHW" <shw@cezegl.com.hk>
Copies to: WTPL - URA Kwun Tong Areas 2-3 <ura-kwuntong2-3@wongtung.com>,
"patrickcheung@sino.com" <patrickcheung@sino.com>,
"patrickluk@sino.com"
<patrickluk@sino.com>,
"elementho@sino.com" <elementho@sino.com>,
"leehoiyuen@sino.com" <leehoiyuen@sino.com>,
"lungkwokkeung@sino.com"
<lungkwokkeung@sino.com>,
"lamyihung@sino.com" <lamyihung@sino.com>,
"maikailun@sino.com" <maikailun@sino.com>,
"nkil6514@sino-land.com"
<nkil6514@sino-land.com>,
"dennis.chiu@aecom.com" <dennis.chiu@aecom.com>,
"gabriel.cheung@aecom.com" <gabriel.cheung@aecom.com>,
"urak7_aecom@aecom.com" <urak7_aecom@aecom.com>,
"Kim.Wong@aecom.com"
<Kim.Wong@aecom.com>,
"midi@midiltd.com.hk" <midi@midiltd.com.hk>,
"herbertthung@sino.com" <herbertthung@sino.com>
Subject: RE: NKIL 6514 [MC Tower] - Material & Sample Submission of Aluminium
Backpan TM09 & TG07 (Silver Blue) (SHW/CSF/MC/A/MAT/1379)
Date sent: Wed, 30 Jan 2019 07:35:48 +0000

Dear CR and Midi,

?

Per confirmation by SIMO PW Last Wednesday, please use colour champagne gold backpan for the mock up floor.

?

Regards

?

Christina Wong

WONG TUNG & PARTNERS LIMITED

T +852 2803 9888/F +852 2803 9763/F +852 2513 1728/W <http://www.wongtung.com>

18 F, Cityplaza 3, Taikoo Shing, Hong Kong.

?

Important Notice

This email and any attachments to it may be confidential and are intended solely for the use of the individual(s) to whom it is addressed. If you are not the intended recipient of this email, you must not take any action based upon its contents, nor copy or show it to anyone. Please contact the sender if you believe you have received this email in error.

?

From: SHW [mailto:shw@cezegl.com.hk]

Sent: 2018年12月13日 11:05

To: WTPL - URA Kwun Tong Areas 2-3; patrickcheung@sino.com; patrickluk@sino.com; elementho@sino.com; leehoiyuen@sino.com; lungkwokkeung@sino.com; lamyihung@sino.com; maikailun@sino.com; nkil6514@sino-land.com; dennis.chiu@aecom.com; gabriel.cheung@aecom.com; urak7_aecom@aecom.com; Kim.Wong@aecom.com; midi@midiltd.com.hk

Cc: 'SHW - Project'

Subject: NKIL 6514 [MC Tower] - Material & Sample Submission of Aluminium Backpan TM09 & TG07 (Silver Blue) (SHW/CSF/MC/A/MAT/1379)

?

Dear Ms. Kennis Chan

Please find the attached for your approval.

Original copy will be sent to your office accordingly.



B.D. REF :

CLIENT :
 信和置業有限公司
 Sino Land Company Limited

ARCHITECT :
 WONG TUNG & PARTNERS LIMITED
 ARCHITECTS & PLANNERS

MAIN CONTRACTOR :
 CR Construction Company Limited

STRUCTURAL ENGINEER :
 AECOM

FAÇADE CONSULTANT:
 AECOM

NOTE :
 1. ALL DIMENSIONS ARE IN mm.
 2. ALL ELEVATIONS ARE VIEWED FROM OUTSIDE.
 3. ALL DIMENSIONS TO BE VERIFIED ON SITE BEFORE FABRICATION.

LEGEND :
 x1 --- DETAIL MARK NO.
 x001 --- REFER SHEET NO.

1. F.F.L. --- FINISHED FLOOR LEVEL
 2. S.F.L. --- STRUCTURAL FLOOR LEVEL
 3. (R) --- REVERSED DETAIL

B	17/11/2018	GENERAL REVISED	
A	15/10/2018	GENERAL REVISED	
NO.	DATE	REVISED	BY

JOB NO. : J-837
 PROJECT :
 URA KWUN TONG TOWN CENTRE
 REDEVELOPMENT (AREA 2 & 3) AT
 NKIL 6514, KWUN TONG, KWLOON


TITLE :
 PART ELEVATION
 OF GLASS CLADDING
 AT TOWER 1

DATE : 04-JUL-18 SCALE : 1:60 (A1)
 DRAWN BY : ASING CHECKED BY : -


美特鋁質有限公司
 ALUMINIUM FABRICATOR LTD.
 Units 6-8, Sunray Industrial Centre, 1/F
 610 Cha Kwo Ling Road, Kowloon
 Tel:23489211-4 Fax:(852)2772666

DWG NO. : J837-GC-2101 REV. : B


- LEGEND:
- 50x37x5mm THK. G.M.S. CHANNEL (CUT FROM 100x50x5mm THK. G.M.S. R.H.S.)
 - 8 mm THK. HEAT STRENGTHENED BLUE TINTED GLASS (SPANDREL GLASS)
 - 8 mm THK. TEMPERED BLUE TINTED GLASS
 - 100x65x8mm THK. G.M.S. ANGLE BRACKET (L=250mm) W/ 2NOS-HILTI HST3-R M8 ANCHOR BOLT (MAX. @900c/c)
 - 100x65x8mm THK. G.M.S. ANGLE BRACKET (L=200mm) W/ 2NOS-HILTI HST3-R M8 ANCHOR BOLT (MAX. @900c/c)
 - 100x50x6mm THK. G.M.S. ANGLE BRACKET (L=250mm) W/ 2NOS-HILTI HST3-R M8 ANCHOR BOLT (@900c/c)
 - 100x50x6mm THK. G.M.S. ANGLE BRACKET (L=250mm) W/ 2NOS-Y12 STEEL BAR (BOND LENGTH=200mm)
 - 100x50x6mm THK. G.M.S. ANGLE BRACKET (L=200mm) W/ 1NO-Y12 STEEL BAR (BOND LENGTH=200mm)
 - S.J. - STACK JOINT
 - 3 mm THK. ALUM. CLADDING

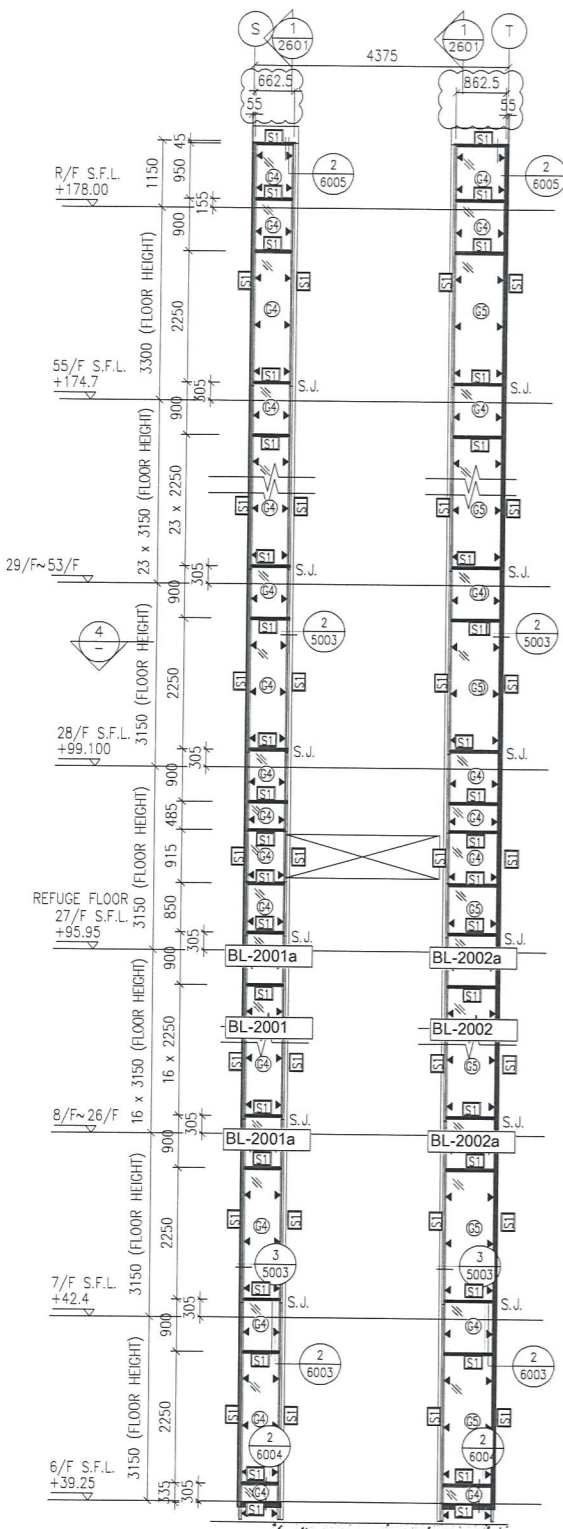


1 PART ELEVATION FOR GLASS CLADDING

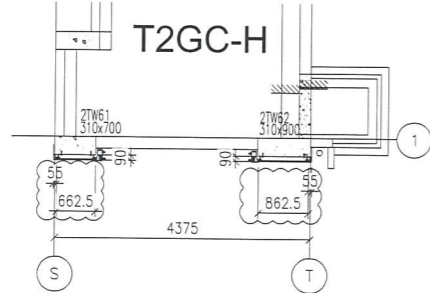


2 PART PLAN FOR GLASS CLADDING

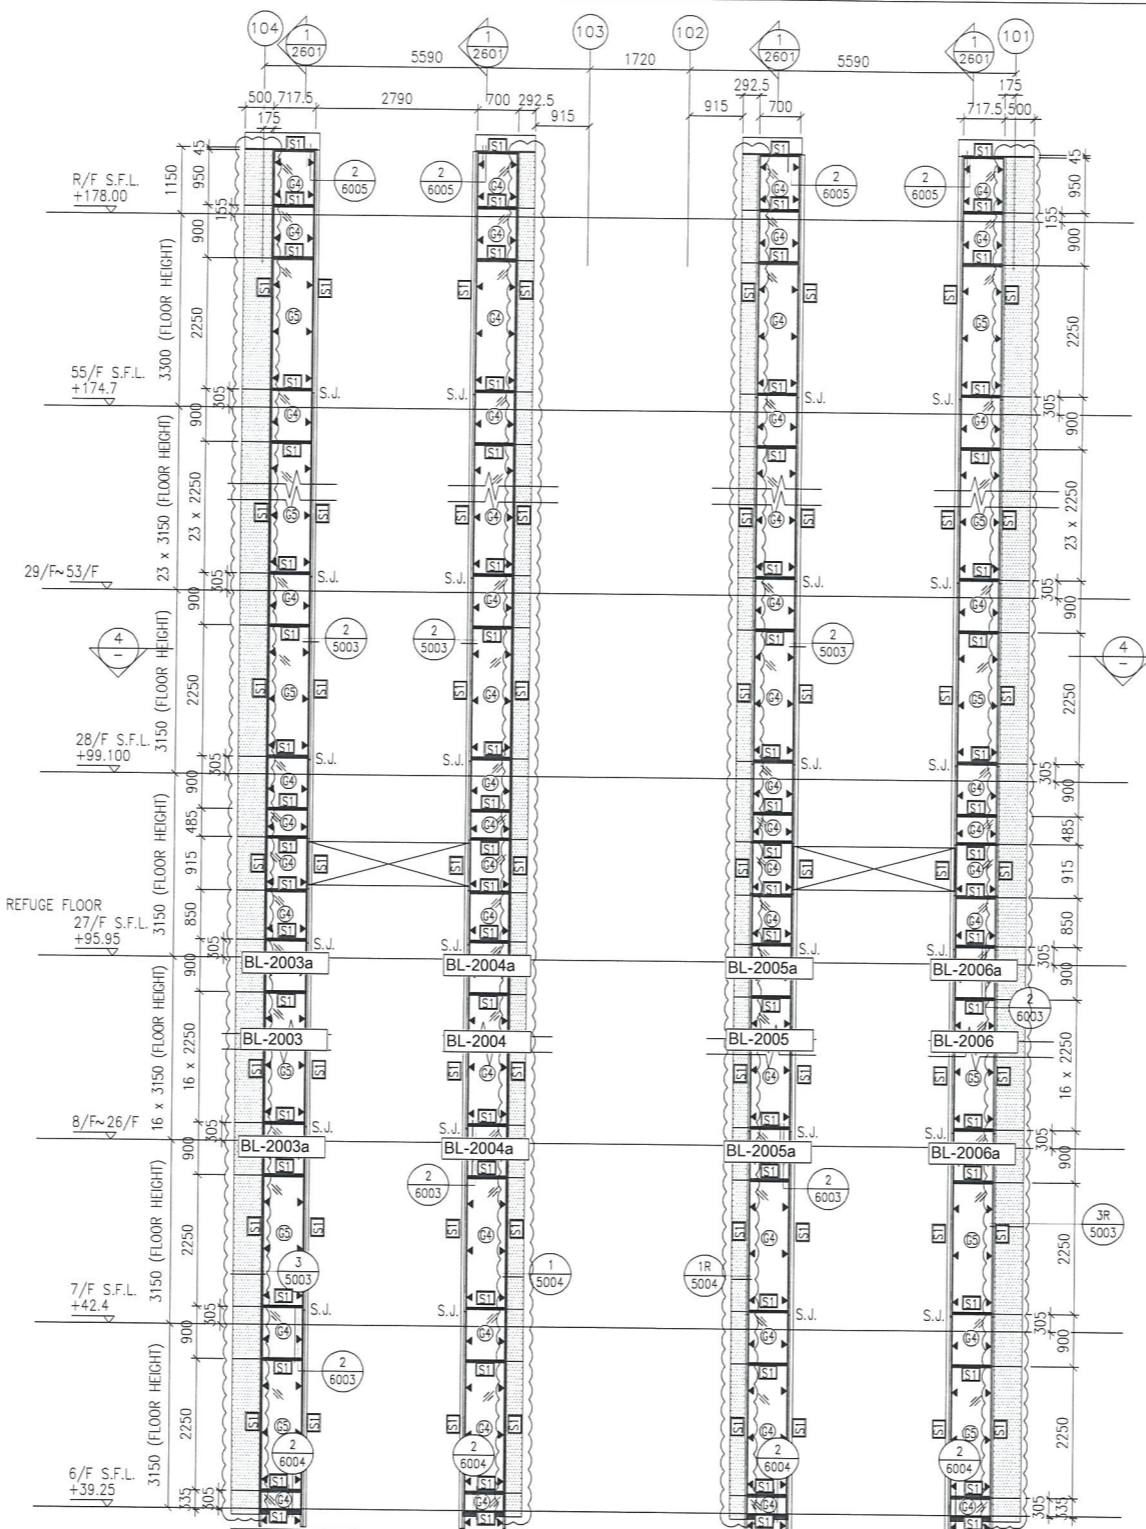


3 PART ELEVATION FOR GLASS CLADDING

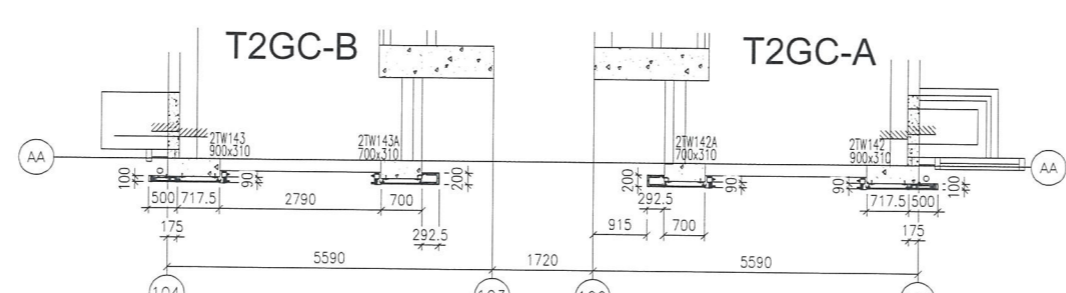

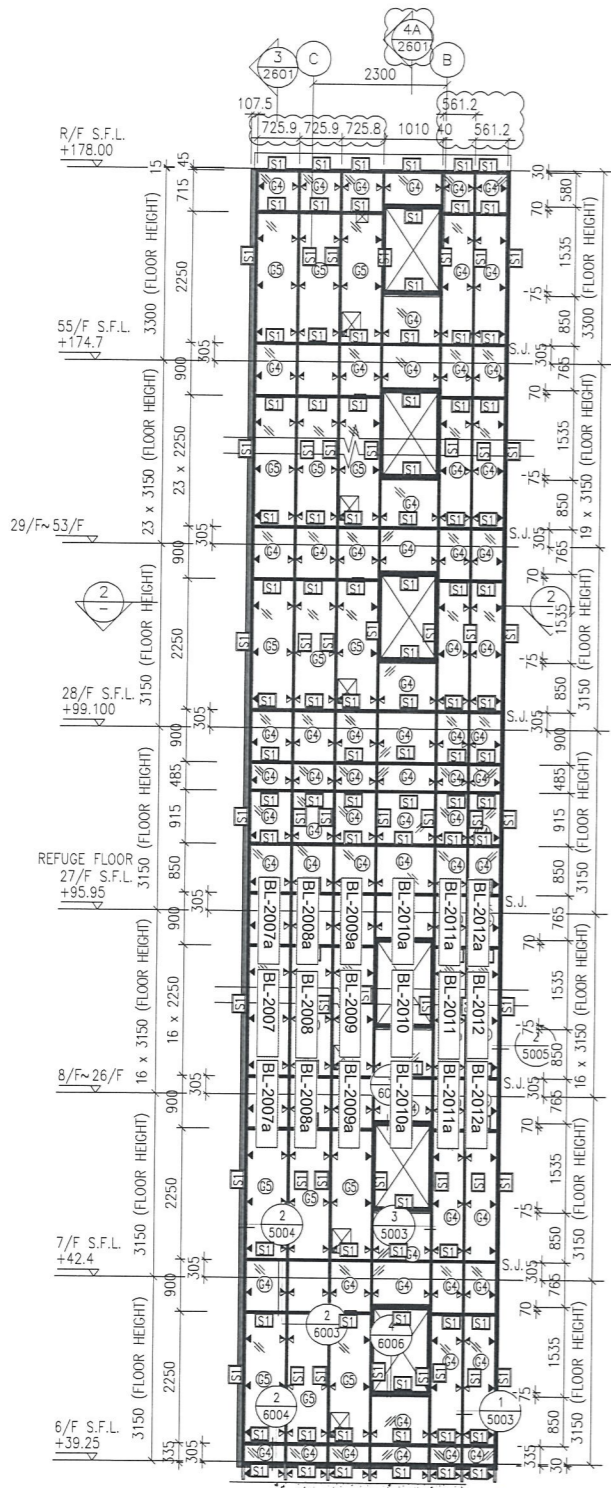


1 - PART ELEVATION FOR GLASS CLADDING

T2GC-M

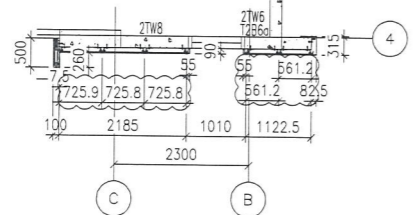


2 - PART PLAN FOR GLASS CLADDING

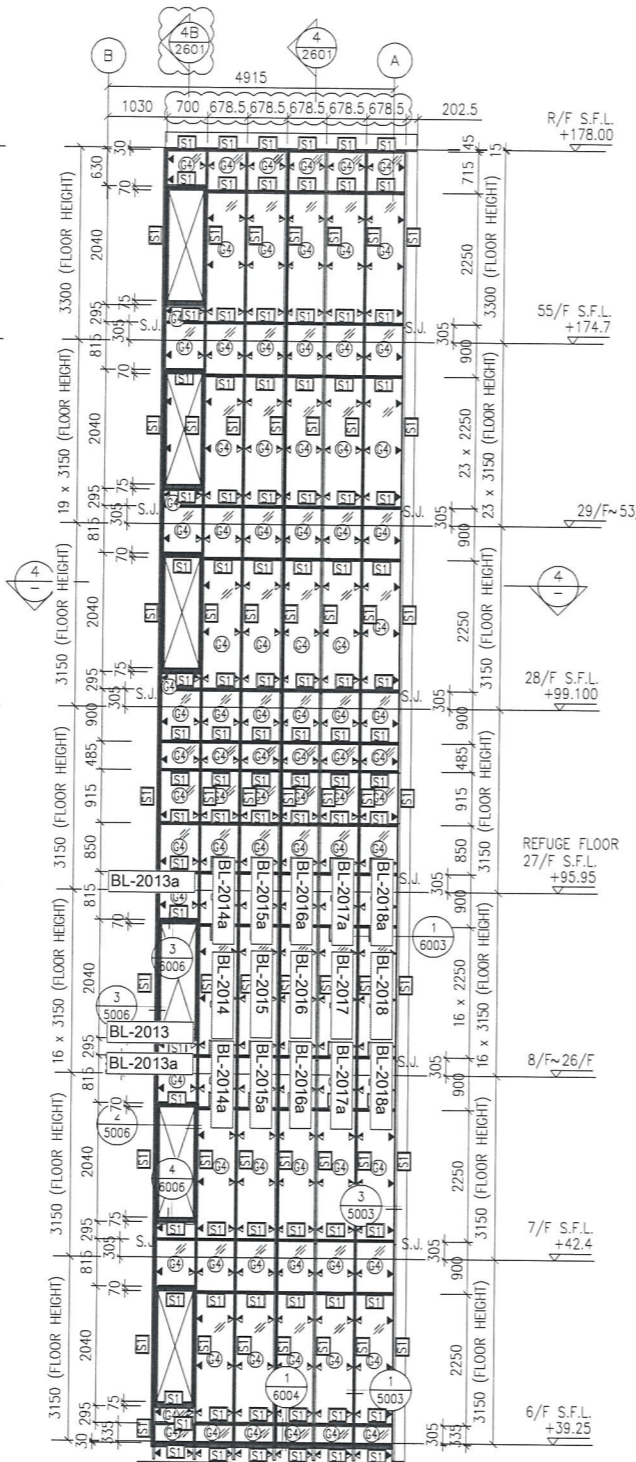


3 - PART ELEVATION FOR GLASS CLADDING

T2GC-M

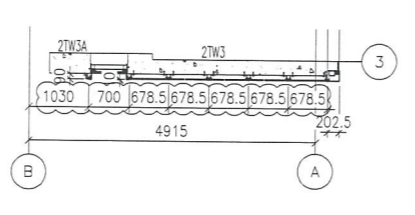


4 - PART PLAN FOR GLASS CLADDING

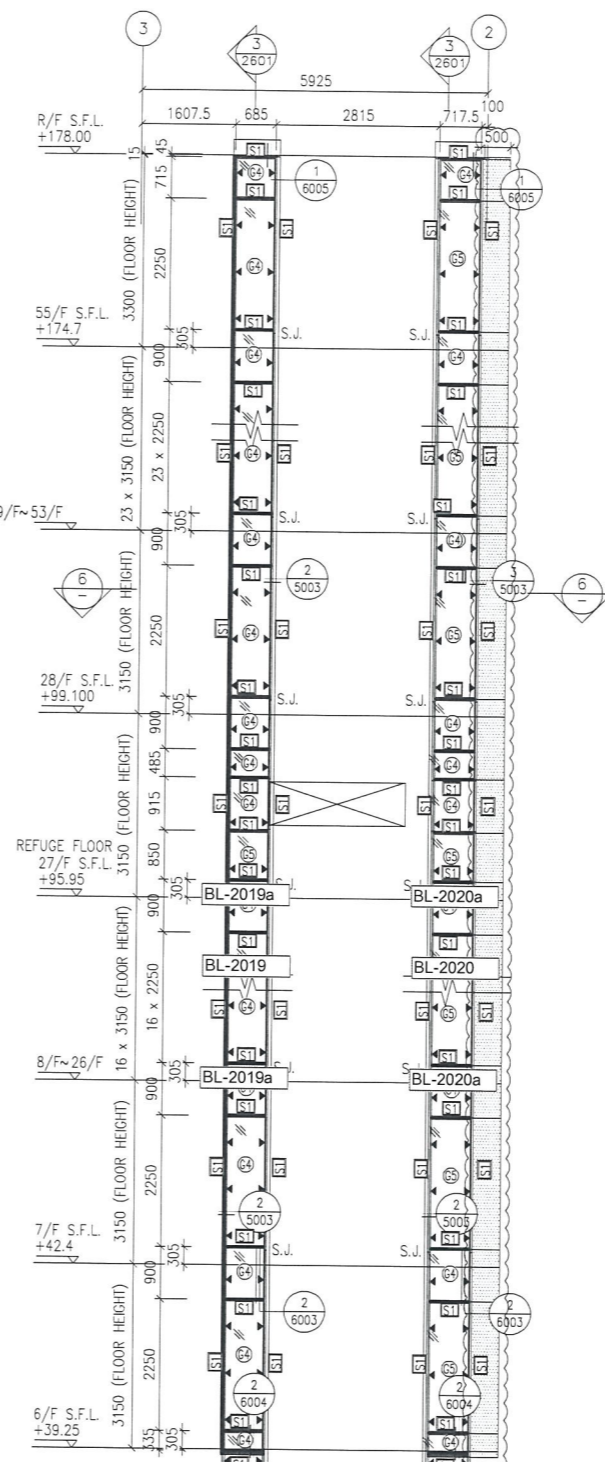

5 - PART ELEVATION FOR GLASS CLADDING

T2GC-M

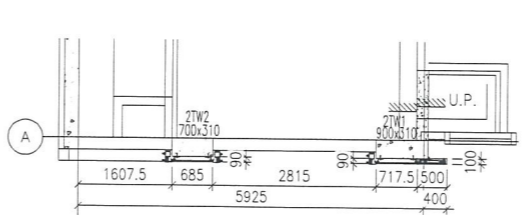

6 - PART PLAN FOR GLASS CLADDING

- LEGEND:**
- [ST] - 50x37x5mm THK. G.M.S. CHANNEL (CUT FROM 100x50x5mm THK. G.M.S. R.H.S.)
 - [G+T] - 8 mm THK. HEAT STRENGTHENED BLUE TINTED GLASS (SPANDREL GLASS)
 - [G] - 8 mm THK. TEMPERED BLUE TINTED GLASS
 - [AB1] - 100x65x8mm THK. G.M.S. ANGLE BRACKET (L=250mm) W/ 2NOS-HILTI HST3-R M8 ANCHOR BOLT (MAX. @900c/c)
 - [AB2] - 100x65x6mm THK. G.M.S. ANGLE BRACKET (L=200mm) W/ 2NOS-HILTI HST3-R M8 ANCHOR BOLT (MAX. @900c/c)
 - [AB3] - 100x50x6mm THK. G.M.S. ANGLE BRACKET (L=250mm) W/ 2NOS-HILTI HST3-R M8 ANCHOR BOLT (@900c/c)
 - [AB4] - 100x50x6mm THK. G.M.S. ANGLE BRACKET (L=200mm) W/ 2NOS-Y12 STEEL BAR (BOND LENGTH=200mm)
 - [AB5] - 100x50x6mm THK. G.M.S. ANGLE BRACKET (L=200mm) W/ 1NO-Y12 STEEL BAR (BOND LENGTH=200mm)
 - [S.J.] - STACK JOINT
 - [ALUM] - 3 mm THK. ALUM. CLADDING

B.D. REF :

CLIENT : 信和置業有限公司 Sino Land Company Limited

ARCHITECT : WONG TUNG & PARTNERS LIMITED ARCHITECTS & PLANNERS

MAIN CONTRACTOR : CR Construction Company Limited

STRUCTURAL ENGINEER : AECOM

FACADE CONSULTANT : AECOM

NOTE :

- ALL DIMENSIONS ARE IN mm.
- ALL ELEVATIONS ARE VIEWED FROM OUTSIDE.
- ALL DIMENSIONS TO BE VERIFIED ON SITE BEFORE FABRICATION.

LEGEND :

- (X1) - DETAIL MARK NO.
- (X001) - REFER SHEET NO.

- F.F.L. -- FINISHED FLOOR LEVEL
- S.F.L. -- STRUCTURAL FLOOR LEVEL
- (R) -- REVERSED DETAIL

B	17/11/2018	GENERAL REVISED	
A	15/10/2018	GENERAL REVISED	
NO.	DATE	REVISED	BY

JOB NO. : J-837

PROJECT : URA KWUN TONG TOWN CENTRE REDEVELOPMENT (AREA 2 & 3) AT NKIL 6514, KWUN TONG, KWLOON

TITLE : PART ELEVATION OF GLASS CLADDING AT TOWER 2

DATE : 04-JUL-18 SCALE : 1:60 (A1)

DRAWN BY : ASING CHECKED BY : -

MIDI ALUMINIUM FABRICATOR LTD. 美特鋁質有限公司
Units 6-8, Sunray Industrial Centre, 1/F
610 Cho Kwo Ling Road, Kowloon
Tel:23489211-4 Fax:(852)27727666

DWG NO. : J837-GC-2202 REV. : B

B.D. REF :

CLIENT :
信和置業有限公司
Sino Land Company Limited

ARCHITECT :
WONG TUNG & PARTNERS LIMITED
ARCHITECTS & PLANNERS

MAIN CONTRACTOR :
CR Construction Company Limited

STRUCTURAL ENGINEER :
AECOM

FAÇADE CONSULTANT:
AECOM

NOTE :
1. ALL DIMENSIONS ARE IN mm.
2. ALL ELEVATIONS ARE VIEWED FROM OUTSIDE.
3. ALL DIMENSIONS TO BE VERIFIED ON SITE BEFORE FABRICATION.

LEGEND :
① - DETAIL MARK NO.
② - REFER SHEET NO.

1. F.F.L. -- FINISHED FLOOR LEVEL
2. S.F.L. -- STRUCTURAL FLOOR LEVEL
3. (R) -- REVERSED DETAIL

B	17/11/2018	GENERAL REVISED	
A	15/10/2018	GENERAL REVISED	
NO.	DATE	REVISED	BY


JOB NO. : J-837
PROJECT :
URA KWUN TONG TOWN CENTRE
REDEVELOPMENT (AREA 2 & 3) AT
NKIL 6514, KWUN TONG, KWLOON

TITLE :
PART ELEVATION
OF GLASS CLADDING
AT TOWER 3


DATE : 04-JUL-18 SCALE : 1:60 (A1)
DRAWN BY : ASING CHECKED BY : -

美特鋁質有限公司
MIDI ALUMINIUM FABRICATOR LTD.
Units 6-8, Sunray Industrial Centre, 1/F
610 Cho Kwo Ling Road, Kowloon
Tel:23489211-4 Fax:(852)2772666


DWG NO. : J837-GC-2301 REV. : B

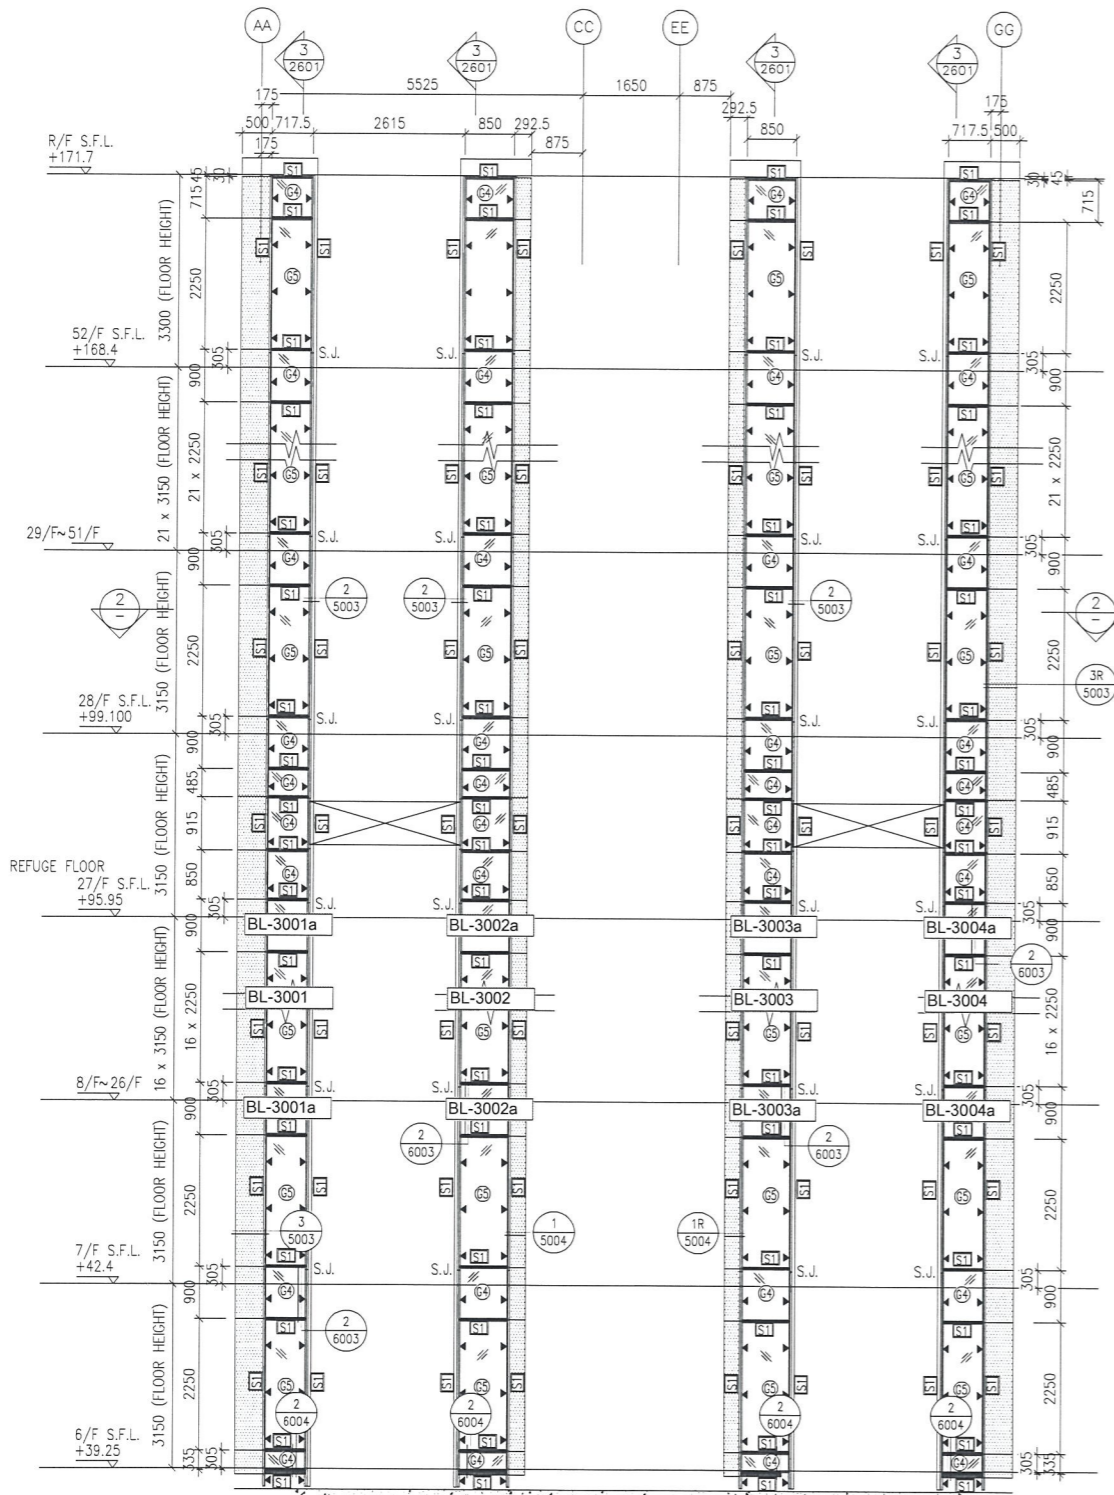


1 PART ELEVATION FOR GLASS CLADDING

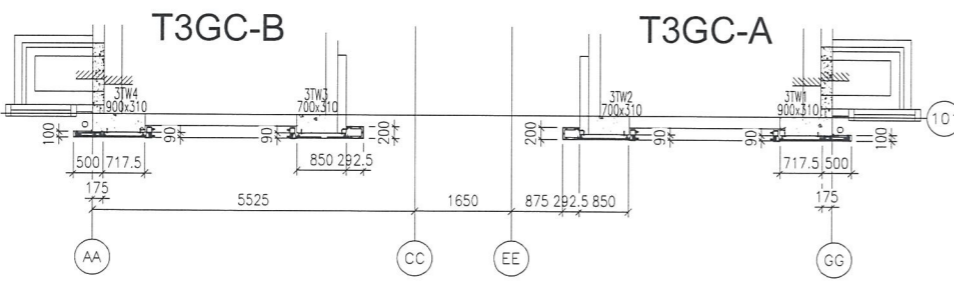

2 PART PLAN FOR GLASS CLADDING

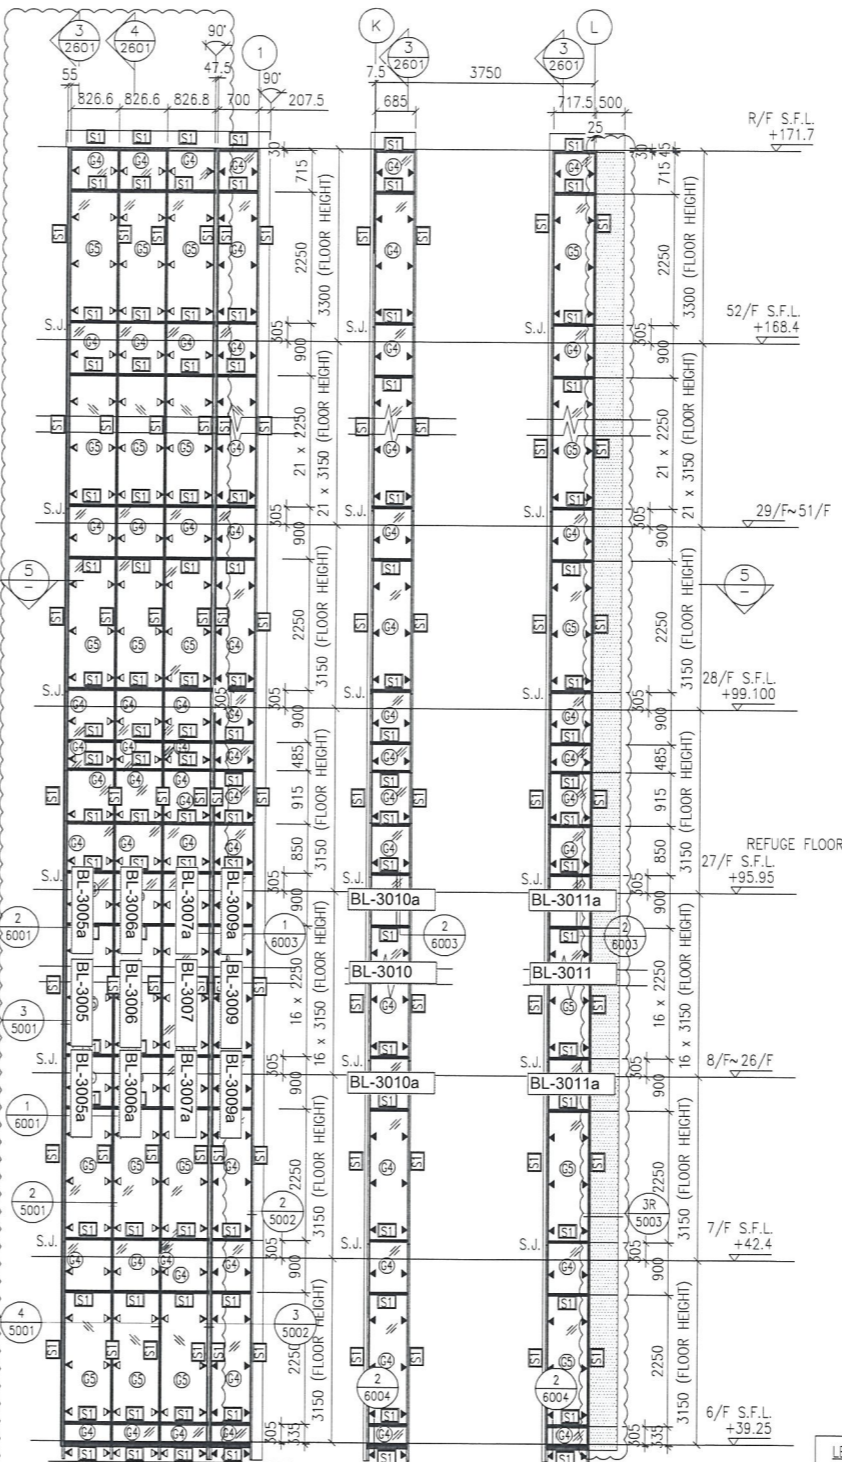

3 PART ELEVATION FOR GLASS CLADDING

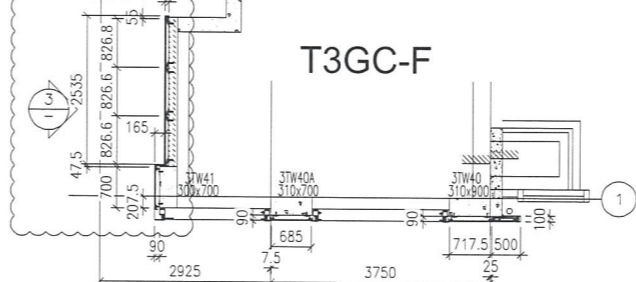

5 PART PLAN FOR GLASS CLADDING

- LEGEND:
- ST - 50x37x5mm THK. G.M.S. CHANNEL (CUT FROM 100x50x5mm THK. G.M.S. R.H.S.)
 - ② - 8 mm THK. HEAT STRENGTHENED BLUE TINTED GLASS (SPANDREL GLASS)
 - ③ - 8 mm THK. TEMPERED BLUE TINTED GLASS
 - ▲ - 100x65x8mm THK. G.M.S. ANGLE BRACKET (L=250mm) W/ 2NOS-HILTI HST3-R MB ANCHOR BOLT (MAX. @900c/c)
 - ▲ - 100x65x8mm THK. G.M.S. ANGLE BRACKET (L=200mm) W/ 1NO-HILTI HST3-R MB ANCHOR BOLT (MAX. @900c/c)
 - ▲ - 100x50x6mm THK. G.M.S. ANGLE BRACKET (L=250mm) W/ 2NOS-HILTI HST3-R MB ANCHOR BOLT (@900c/c)
 - ▲ - 100x50x6mm THK. G.M.S. ANGLE BRACKET (L=250mm) W/ 2NOS-Y12 STEEL BAR (BOND LENGTH=200mm)
 - ▲ - 100x50x6mm THK. G.M.S. ANGLE BRACKET (L=200mm) W/ 1NO-Y12 STEEL BAR (BOND LENGTH=200mm)
 - S.J. - STACK JOINT
 - - 3 mm THK. ALUM. CLADDING

B.D. REF :

CLIENT :
信和置業有限公司
Sino Land Company Limited

ARCHITECT :
WONG TUNG & PARTNERS LIMITED
ARCHITECTS & PLANNERS

MAIN CONTRACTOR :
CR Construction Company Limited

STRUCTURAL ENGINEER :
AECOM

FAÇADE CONSULTANT:
AECOM

NOTE :
1. ALL DIMENSIONS ARE IN mm.
2. ALL ELEVATIONS ARE VIEWED FROM OUTSIDE.
3. ALL DIMENSIONS TO BE VERIFIED ON SITE BEFORE FABRICATION.

LEGEND :
X1 - DETAIL MARK NO.
X001 - REFER SHEET NO.
1. F.F.L. -- FINISHED FLOOR LEVEL
2. S.F.L. -- STRUCTURAL FLOOR LEVEL
3. R - REVERSED DETAIL

B	17/11/2018	GENERAL REVISED	
A	15/10/2018	GENERAL REVISED	
NO.	DATE	REVISED	BY

JOB NO. : J-837
PROJECT :
URA KWUN TONG TOWN CENTRE
REDEVELOPMENT (AREA 2 & 3) AT
NKIL 6514, KWUN TONG, KWLOON


TITLE :
PART ELEVATION
OF GLASS CLADDING
AT TOWER 5

DATE : 04-JUL-18 SCALE : 1:60 (A1)


DRAWN BY : ASING CHECKED BY : -

美特鋁質有限公司
MIDI ALUMINIUM FABRICATOR LTD.
Units 6-8, Sunray Industrial Centre, 1/F
610 Cha Kwo Ling Road, Kowloon
Tel:23489211-4 Fax:(852)2772666

DWG NO. : JB37-GC-2501 REV. : B

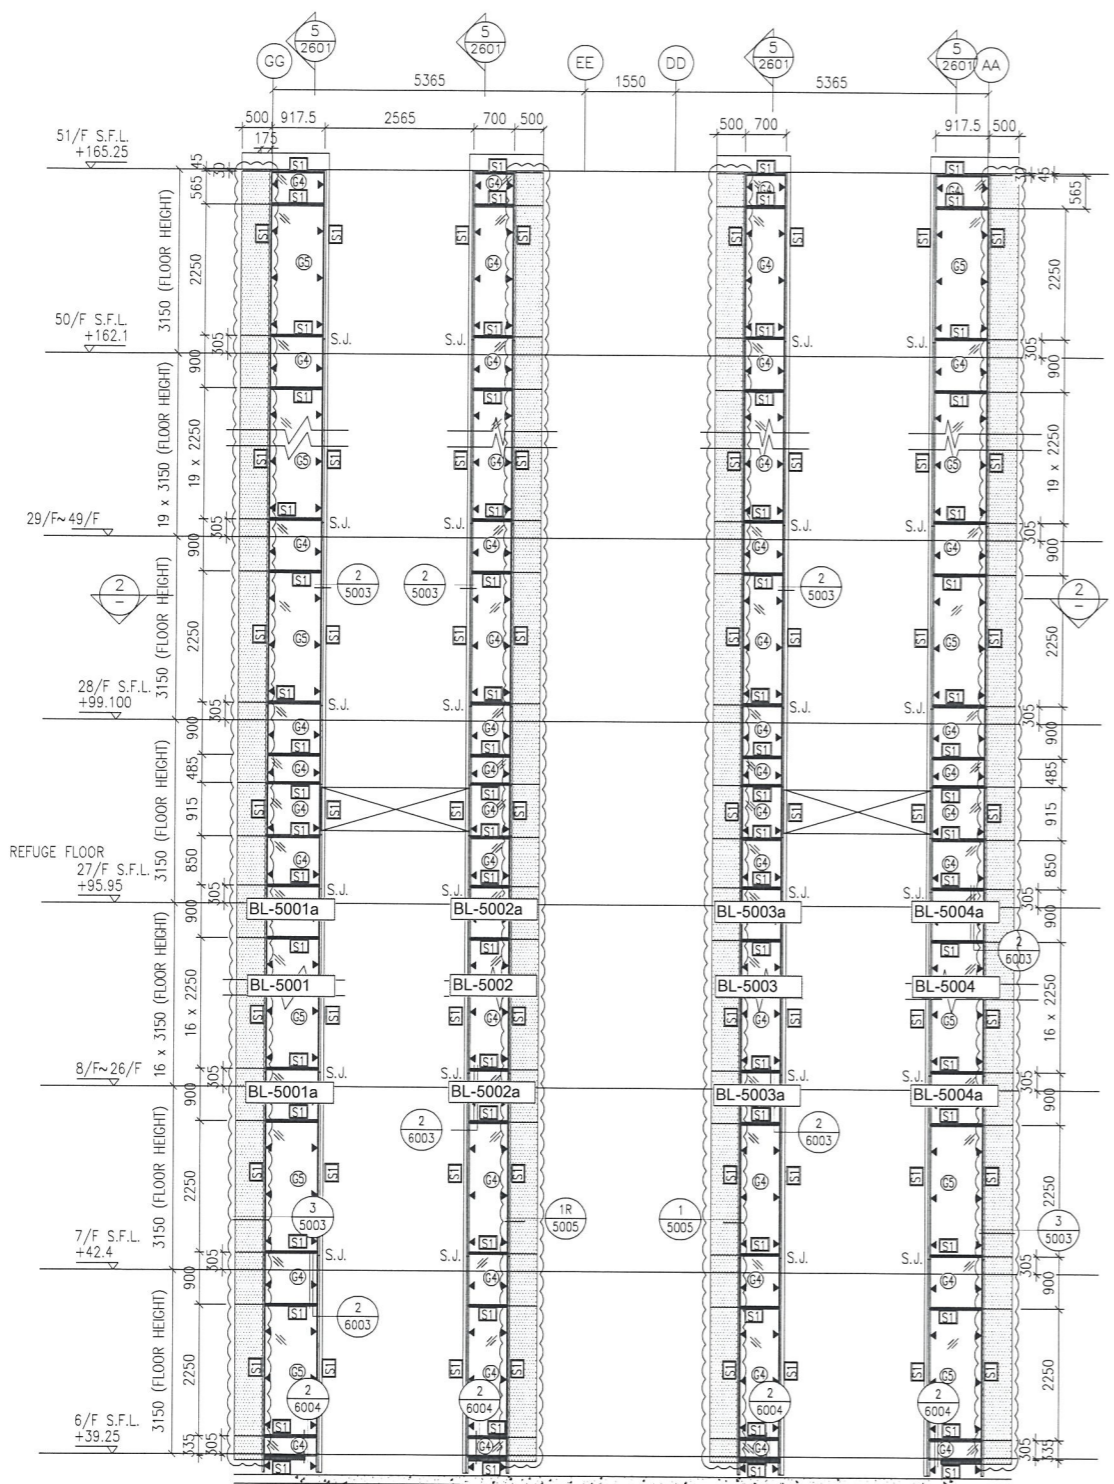


1 PART ELEVATION FOR GLASS CLADDING

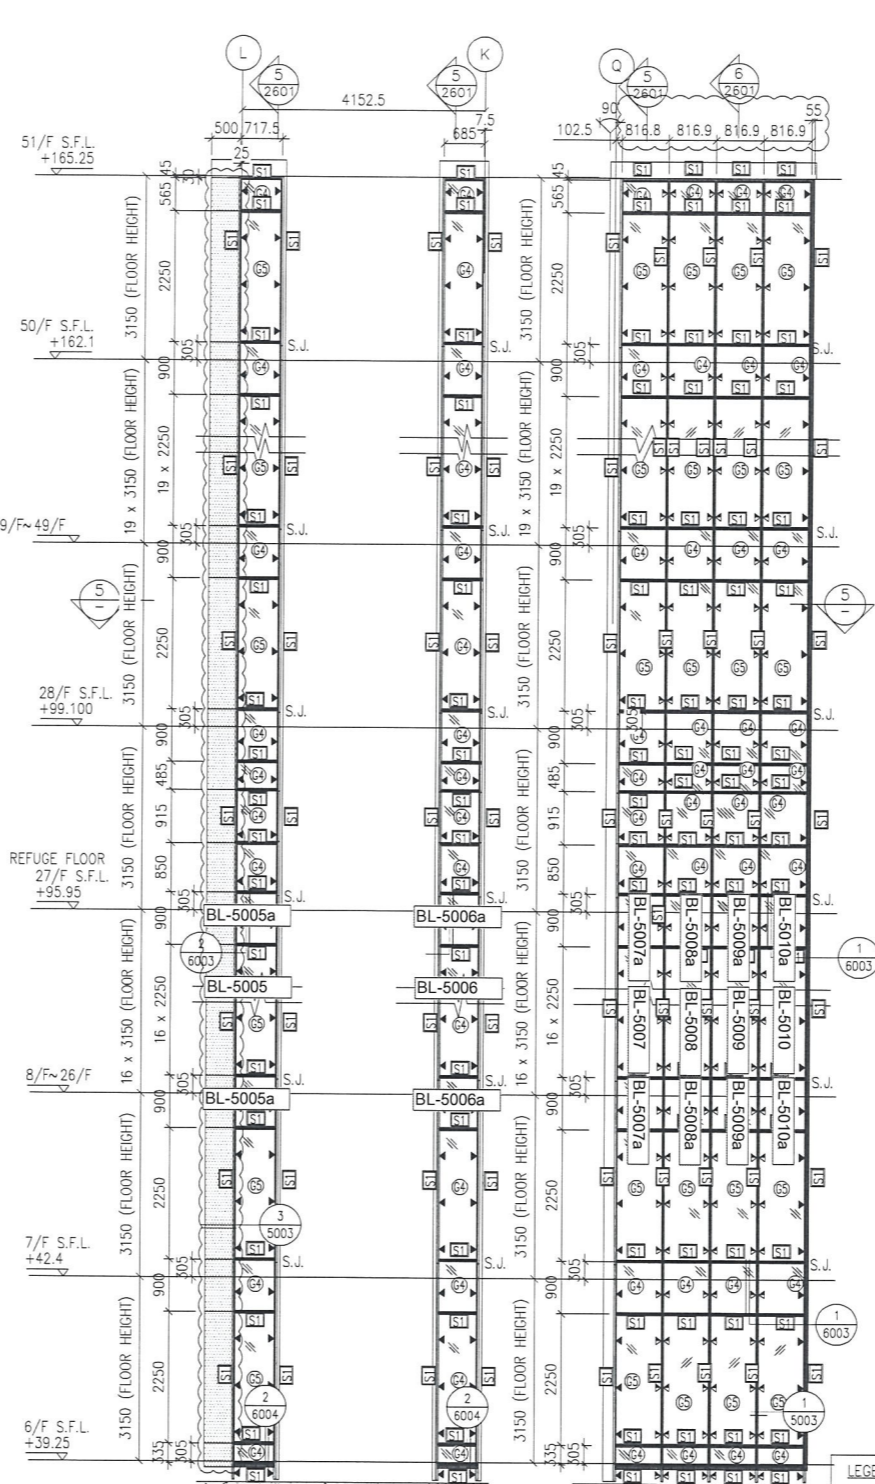


3 PART ELEVATION FOR GLASS CLADDING

4 PART ELEVATION FOR GLASS CLADDING

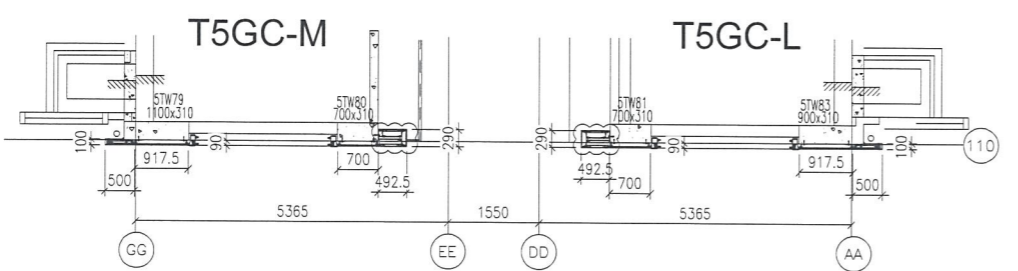

2 PART PLAN FOR GLASS CLADDING

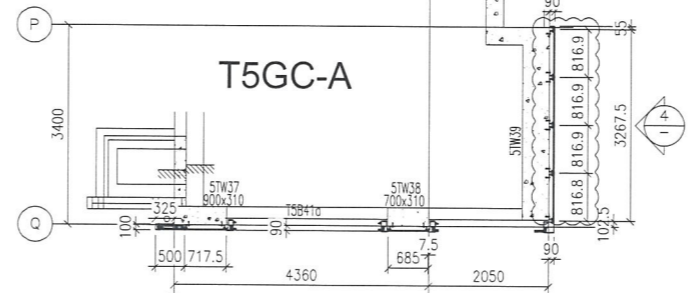

5 PART PLAN FOR GLASS CLADDING

- LEGEND:
- ST1 - 50x37x5mm THK. G.M.S. CHANNEL (CUT FROM 100x50x5mm THK. G.M.S. R.H.S.)
 - 8 - 8 mm THK. HEAT STRENGTHENED BLUE TINTED GLASS (SPANDREL GLASS)
 - 8 - 8 mm THK. TEMPERED BLUE TINTED GLASS
 - ▲ (100x65x8mm) THK. G.M.S. ANGLE BRACKET (L=250mm) W/ 2NOS-HILTI HST3-R MB ANCHOR BOLT (MAX. @900c/c)
 - ▲ (100x65x8mm) THK. G.M.S. ANGLE BRACKET (L=200mm) W/ 1NO-HILTI HST3-R MB ANCHOR BOLT (MAX. @900c/c)
 - ▲ (100x50x6mm) THK. G.M.S. ANGLE BRACKET (L=250mm) W/ 2NOS-HILTI HST3-R MB ANCHOR BOLT (MAX. @900c/c)
 - ▲ (100x50x6mm) THK. G.M.S. ANGLE BRACKET (L=200mm) W/ 2NOS-Y12 STEEL BAR (BOND LENGTH=200mm)
 - ▲ (100x50x6mm) THK. G.M.S. ANGLE BRACKET (L=200mm) W/ 1NO-Y12 STEEL BAR (BOND LENGTH=200mm)
 - S.J. - STACK JOINT
 - - 3 mm THK. ALUM. CLADDING

