美 特 鋁 質 有 限 公 司
MIDI ALUMINIUM FABRICATOR LTD.

工程指示 / 要求簡箋(E.I.)

工程指示編號：**EI / 0282 / 19** 修改版次：**G**

工程編號 ：**J - 837** 工程名稱 ：觀塘裕民坊

工程項目 ：幕牆 大圖 (第 6 份大圖 rev2)

收件人 ：生統 / 永林 發件人 ： **Eric Liu** 日 期 ：**21/08/2019**

☐要求提供 / ☐確認 事項 ：

( ) 初步鋁料 B.M. ( ) 加工拆圖，然後生產 ( ) 尺寸表

( ) 正式鋁料 B.M. ( ) 技術上資料 / 指示 ( ) 報價

( ) 配件 B.M. ( ) 樣辦或貨品說明書 ( ) 分判合約

( ) 其他 ：_____

內容 ：

因 EI9536 已到 J 版，無法登記，現以此 EI0282 為準

G 版: 提供第 6 份大圖 REV2

請按此提供玻璃 BM，鋁料，配件拆圖

優先提供 6/F 及標準層最後一層拆圖

謝謝！

請在 **2019/ 08 / 24** 前完成上列要求。

附： **206 頁大圖+CAD**

以上項目為:

☐ 原合約工程包 ☐ 原合約工程加 / 減賬 ☐ 新工程報價

原因 :-

分發東莞各部門 ：

( )生產技術總監☐連附件 (✓)技術部 ☐連附件 ( )生產部 ☐連附件 ( )機械設計部☐連附件

( )採購部 ☐連附件 (✓)生產統籌部☐連附件

( )質檢部 ☐連附件 ( )會計部 ☐連附件 ( )報關組 ☐連附件 ( )其他 楊榮輝 ☐連附件

分發香港各部門 ：

( )行政部☐連附件 ( )會計部☐連附件 ( )統籌部☐連附件 ( )工程部地盤科文 ☐連附件

( )採購部☐連附件 ( )QS 部 ☐連附件 ( )維修部☐連附件 ( )其他 _____☐連附件

傳遞編號： **HK 1856 /19**

發件人簽署：

項目經理簽署：

PROJECT :

URA KWUN TONG TOWN CENTRE
REDEVELOPMENT (AREA 2 & 3) AT NKIL 6514, KWUN TONG, KWLOON

5

TITLE : CURTAIN WALL AT TOWER
SHOPDRAWING SUBMISSION

DATE: 19 - Aug- 2019

美特鋁製有限公司
MIDI ALUMINIUM FABRICATOR LTD.
Units 6-8, Sunray Industrial Centre, 1/F
610 Cha Kwo Ling Road, Kowloon
Tel:23489211-4 Fax:(852)27727666

DWG NO. : J837-CW-CP01 REV. : E

DRAWING SUBMISSION REGISTER

PROJECT :
URA KWUN TONG TOWN CENTRE
REDEVELOPMENT (AREA 2 & 3) AT
NKIL 6514, KWUN TONG, KWLOON

TITLE :
SHOPDRAWING FOR
CURTAIN WALL AT TOWER

| DRAWING TITLE | DWG. NO. | DATE OF ISSUE / REVISIONS | | |

DRAWING SUBMISSION REGISTER

PROJECT :
URA KWUN TONG TOWN CENTRE
REDEVELOPMENT (AREA 2 & 3) AT
NKIL 6514, KWUN TONG, KWLOON

TITLE :
SHOPDRAWING FOR
CURTAIN WALL AT TOWER

DATE OF ISSUE											
ISSUE	01	02	03	04	05	06					
DAY	23	10	24	22	28	20					
MONTH	07	09	11	12	01	05					
YEAR	18	18	18	18	19	19					

SUBMISSION STATE (FOR B.D / A.S.D)
AP - APPROVED
AC - APPROVED SUB. TO CONDITION
NA - NOT APPROVED

SUBMISSION STATE (FOR CLIENT / CONSULTANT)
AP - APPROVED
AC - APPROVED SUB. TO CONDITION
NA - NOT APPROVED

SUBMISSION STATE (FOR ARCHITECT)
AP - APPROVED
AC - APPROVED SUB. TO CONDITION
NA - NOT APPROVED

FABRICATION / CONSTRUCTION STATE
ISSUE TO CHINA OFFICE
ISSUE TO SITE
ISSUE TO SUB-CONTRACTOR

DRAWING TITLE	DWG. NO.	REVISIONS										COMMENT DATE	REV.	STATE	COMMENT DATE	REV.	STATE	COMMENT DATE	REV.	STATE	REV.	DATE	REV.	DATE	REV.	DATE
CAST IN CHANNEL & EMBED TYPICAL DETAILS OF CURTAIN WALL	J837-CW-ED05	-	A	B	C	D	D																			
CAST IN CHANNEL & EMBED TYPICAL DETAILS OF CURTAIN WALL	J837-CW-ED06		-	A	B	C	C																			
CAST IN CHANNEL & EMBED TYPICAL DETAILS OF CURTAIN WALL	J837-CW-ED07		-	A	B	B	B																			
CAST IN CHANNEL & EMBED TYPICAL DETAILS OF CURTAIN WALL	J837-CW-ED08		-	A	A	A	B																			
CAST IN CHANNEL & EMBED TYPICAL DETAILS OF CURTAIN WALL	J837-CW-ED09		-	A	A	A	B																			
CAST IN CHANNEL & EMBED TYPICAL DETAILS OF CURTAIN WALL	J837-CW-ED10		-	A	A	A	B																			
CAST IN CHANNEL & EMBED TYPICAL DETAILS OF CURTAIN WALL	J837-CW-ED11		A	A	A	A	A																			
CAST IN CHANNEL & EMBED TYPICAL DETAILS OF CURTAIN WALL	J837-CW-ED12		-	-	A	A	C																			
CAST IN CHANNEL & EMBED TYPICAL DETAILS OF CURTAIN WALL	J837-CW-ED13					-	-																			
CAST IN CHANNEL & EMBED TYPICAL DETAILS OF CURTAIN WALL	J837-CW-ED14					-	-																			
CAST IN CHANNEL & EMBED TYPICAL DETAILS OF CURTAIN WALL	J837-CW-ED15					-	A																			
CAST IN CHANNEL & EMBED TYPICAL DETAILS OF CURTAIN WALL	J837-CW-ED16					-	A																			
CAST IN CHANNEL & EMBED TYPICAL DETAILS OF CURTAIN WALL	J837-CW-ED17						-																			
CAST IN CHANNEL & EMBED TYPICAL DETAILS OF CURTAIN WALL	J837-CW-ED18						-																			
CAST IN CHANNEL & EMBED TYPICAL DETAILS OF CURTAIN WALL	J837-CW-ED19						-																			
CAST IN CHANNEL & EMBED TYPICAL DETAILS OF CURTAIN WALL	J837-CW-ED20						-																			
CAST IN CHANNEL & EMBED TYPICAL DETAILS OF CURTAIN WALL	J837-CW-ED21						-																			
PART ELEVATION OF CURTAIN WALL AT TOWER 1	J837-CW-2101	-	A	B	C	E	F																			
PART ELEVATION OF CURTAIN WALL AT TOWER 1	J837-CW-2102	-	A	B	C	E	G																			
PART ELEVATION OF CURTAIN WALL AT TOWER 1	J837-CW-2103	-	A	B	C	E	H																			
PART ELEVATION OF CURTAIN WALL AT TOWER 1	J837-CW-2104	-	A	B	C	E	G																			
PART ELEVATION OF CURTAIN WALL AT TOWER 1	J837-CW-2105	-	A	B	C	E	G																			
PART ELEVATION OF CURTAIN WALL AT TOWER 1	J837-CW-2106	-	A	B	C	E	H																			
PART ELEVATION OF CURTAIN WALL AT TOWER 1	J837-CW-2107	-	A	B	C	E	G																			
PART ELEVATION OF CURTAIN WALL AT TOWER 1	J837-CW-2108	-	A	B	B	E	F																			
PART ELEVATION OF CURTAIN WALL AT TOWER 1	J837-CW-2109	-	A	B	C	E	H																			
PART ELEVATION OF CURTAIN WALL AT TOWER 1	J837-CW-2110	-	A	B	C	E	G																			
PART ELEVATION OF CURTAIN WALL AT TOWER 1	J837-CW-2111	-	A	B	C	E	G																			
PART ELEVATION OF CURTAIN WALL AT TOWER 1	J837-CW-2112	-	A	B	C	E	G																			
PART ELEVATION OF CURTAIN WALL AT TOWER 1	J837-CW-2113	-	A	B	C	E	G																			
PART ELEVATION OF CURTAIN WALL AT TOWER 1	J837-CW-2114					-	B																			
PART ELEVATION OF CURTAIN WALL AT TOWER 2	J837-CW-2201	-	A	B	C	E	H																			
PART ELEVATION OF CURTAIN WALL AT TOWER 2	J837-CW-2202	-	A	B	C	E	G																			
PART ELEVATION OF CURTAIN WALL AT TOWER 2	J837-CW-2203	-	A	B	C	E	G																			
PART ELEVATION OF CURTAIN WALL AT TOWER 2	J837-CW-2204	-	A	B	C	E	G																			
PART ELEVATION OF CURTAIN WALL AT TOWER 2	J837-CW-2205	-	A	B	C	E	G																			
PART ELEVATION OF CURTAIN WALL AT TOWER 2	J837-CW-2206	-	A	B	C	E	G																			
PART ELEVATION OF CURTAIN WALL AT TOWER 2	J837-CW-2207	-	A	B	C	E	F																			
PART ELEVATION OF CURTAIN WALL AT TOWER 2	J837-CW-2208	-	A	B	C	E	G																			
PART ELEVATION OF CURTAIN WALL AT TOWER 2	J837-CW-2209	-	A	B	C	E	F																			
PART ELEVATION OF CURTAIN WALL AT TOWER 2	J837-CW-2210	-	A	B	C	E	F																			
PART ELEVATION OF CURTAIN WALL AT TOWER 2	J837-CW-2211	-	A	B	C	E	G																			
PART ELEVATION OF CURTAIN WALL AT TOWER 2	J837-CW-2212	-	A	B	C	E	G																			
PART ELEVATION OF CURTAIN WALL AT TOWER 2	J837-CW-2213	-	A	B	C	E	F																			
TOTAL PAGES : (INCLUDING COVERPAGE AND DRAWING SUBMISSION REGISTER)							44																			

IN-HOUSE DESIGN CHECKER

美特鋁質有限公司
MIDI ALUMINIUM FABRICATOR LTD.
Units 6-8, Sunray Industrial Centre, 1/F
610 Cha Kwo Ling Road, Kowloon
Tel:23489211-4 Fax:(852)27727666

DWG NO. : J837-CW-DR02 | REV. : E

DRAWING SUBMISSION REGISTER

PROJECT :
URA KWUN TONG TOWN CENTRE
REDEVELOPMENT (AREA 2 & 3) AT
NKIL 6514, KWUN TONG, KWLOON

TITLE :
SHOPDRAWING FOR
CURTAIN WALL AT TOWER

DRAWING TITLE	DWG. NO.	REVISIONS	DATE OF ISSUE	SUBMISSION STATE (FOR B.D / A.S.D)	SUBMISSION STATE (FOR CLIENT / CONSULTANT)	SUBMISSION STATE (FOR ARCHITECT)	FABRICATION / CONSTRUCTION STATE
			ISSUE 01 02 03 04 05 06	AP - APPROVED	AP - APPROVED	AP - APPROVED	ISSUE TO CHINA OFFICE
			DAY 23 10 24 22 28 20	AC - APPROVED SUB. TO CONDITION	AC - APPROVED SUB. TO CONDITION	AC - APPROVED SUB. TO CONDITION	ISSUE TO SITE
			MONTH 07 09 11 12 01 05	NA - NOT APPROVED	NA - NOT APPROVED	NA - NOT APPROVED	ISSUE TO SUB-CONTRACTOR
			YEAR 18 18 18 18 19 19	COMMENT DATE / REV. / STATE	COMMENT DATE / REV. / STATE	COMMENT DATE / REV. / STATE	REV. / DATE / REV. / DATE / REV. / DATE
PART ELEVATION OF CURTAIN WALL AT TOWER 2	J837-CW-2214	- C					
PART ELEVATION OF CURTAIN WALL AT TOWER 3	J837-CW-2301	- A B C E H					
PART ELEVATION OF CURTAIN WALL AT TOWER 3	J837-CW-2302	- A B C E F					
PART ELEVATION OF CURTAIN WALL AT TOWER 3	J837-CW-2303	- A B C E F					
PART ELEVATION OF CURTAIN WALL AT TOWER 3	J837-CW-2304	- A B C E G					
PART ELEVATION OF CURTAIN WALL AT TOWER 3	J837-CW-2305	- A B C E H					
PART ELEVATION OF CURTAIN WALL AT TOWER 3	J837-CW-2306	- A B C E H					
PART ELEVATION OF CURTAIN WALL AT TOWER 3	J837-CW-2307	- A B C E G					
PART ELEVATION OF CURTAIN WALL AT TOWER 3	J837-CW-2308	- A B C E F					
PART ELEVATION OF CURTAIN WALL AT TOWER 3	J837-CW-2309	-- A B C E F					
PART ELEVATION OF CURTAIN WALL AT TOWER 3	J837-CW-2310	- A B C E F					
PART ELEVATION OF CURTAIN WALL AT TOWER 3	J837-CW-2311	- A B C E H					
PART ELEVATION OF CURTAIN WALL AT TOWER 3	J837-CW-2312	- A B C E F					
PART ELEVATION OF CURTAIN WALL AT TOWER 3	J837-CW-2313	--					
PART ELEVATION OF CURTAIN WALL AT TOWER 5	J837-CW-2501	- A B C E F					
PART ELEVATION OF CURTAIN WALL AT TOWER 5	J837-CW-2502	- A B C E F					
PART ELEVATION OF CURTAIN WALL AT TOWER 5	J837-CW-2503	-- A B C E F					
PART ELEVATION OF CURTAIN WALL AT TOWER 5	J837-CW-2504	- A B C E F					
PART ELEVATION OF CURTAIN WALL AT TOWER 5	J837-CW-2505	- A B C E F					
PART ELEVATION OF CURTAIN WALL AT TOWER 5	J837-CW-2506	- A B C E F					
PART ELEVATION OF CURTAIN WALL AT TOWER 5	J837-CW-2507	- A B C E F					
PART ELEVATION OF CURTAIN WALL AT TOWER 5	J837-CW-2508	- A B C E G					
PART ELEVATION OF CURTAIN WALL AT TOWER 5	J837-CW-2509	- A B C E G					
PART ELEVATION OF CURTAIN WALL AT TOWER 5	J837-CW-2510	- A B C E F					
PART ELEVATION OF CURTAIN WALL AT TOWER 5	J837-CW-2511	- A B C E G					
PART ELEVATION OF CURTAIN WALL AT TOWER 5	J837-CW-2512	- A B C E G					
PART ELEVATION OF CURTAIN WALL AT TOWER 5	J837-CW-2513	-- - C					
6TH FLOOR FULL LAYOUT PLAN AT TOWER 1	J837-CW-3101	- A D E G J					
TYPICAL FLOOR FULL LAYOUT PLAN AT TOWER 1	J837-CW-3102	-- A C D F G					
50TH FLOOR FULL LAYOUT PLAN AT TOWER 1	J837-CW-3103	- B C G I					
ROOF FLOOR FULL LAYOUT PLAN AT TOWER 1	J837-CW-3104	- - - B C					
6TH FLOOR FULL LAYOUT PLAN AT TOWER 2	J837-CW-3201	- A D E F H					
TYPICAL FLOOR FULL LAYOUT PLAN AT TOWER 2	J837-CW-3202	- A C D E E					
55TH FLOOR FULL LAYOUT PLAN AT TOWER 2	J837-CW-3203	- A B D F					
ROOF FLOOR FULL LAYOUT PLAN AT TOWER 2	J837-CW-3204	- -- A B C					
6TH FLOOR FULL LAYOUT PLAN AT TOWER 3	J837-CW-3301	-- A C C D F					
TYPICAL FLOOR FULL LAYOUT PLAN AT TOWER 3	J837-CW-3302	- A C C C C					
52ND FLOOR FULL LAYOUT PLAN AT TOWER 3	J837-CW-3303	- B C C F					
ROOF FLOOR FULL LAYOUT PLAN AT TOWER 3	J837-CW-3304	- -- - - A					
6TH FLOOR FULL LAYOUT PLAN AT TOWER 5	J837-CW-3501	-- A E F G I					
TYPICAL FLOOR FULL LAYOUT PLAN(7F~21F) AT TOWER 5	J837-CW-3502	- A D E F F					
TYPICAL FLOOR FULL LAYOUT PLAN(22~50F) AT TOWER 5	J837-CW-3503	- C D E E					
51ST FLOOR FULL LAYOUT PLAN AT TOWER 5	J837-CW-3504	- -- A A D					
ROOF FLOOR FULL LAYOUT PLAN AT TOWER 5	J837-CW-3505	- - A A B					
TOTAL PAGES : (INCLUDING COVERPAGE AND DRAWING SUBMISSION REGISTER)		44					

IN-HOUSE DESIGN CHECKER

美特鋁質有限公司
MIDI ALUMINIUM FABRICATOR LTD.
Units 6-8, Sunray Industrial Centre, 1/F
610 Cha Kwo Ling Road, Kowloon
Tel:23489211-4 Fax:(852)27727666

DWG NO. : J837-CW-DR03 | REV. : E

DRAWING SUBMISSION REGISTER

PROJECT :
URA KWUN TONG TOWN CENTRE
REDEVELOPMENT (AREA 2 & 3) AT
NKIL 6514, KWUN TONG, KWLOON

TITLE :
SHOPDRAWING FOR
CURTAIN WALL AT TOWER

DRAWING TITLE	DWG. NO.	REVISIONS	DATE OF ISSUE	SUBMISSION STATE (FOR B.D / A.S.D)			SUBMISSION STATE (FOR CLIENT / CONSULTANT)			SUBMISSION STATE (FOR ARCHITECT)			FABRICATION / CONSTRUCTION STATE					
			ISSUE 01 02 03 04 05 06 DAY 23 10 24 22 28 20 MONTH 07 09 11 12 01 05 YEAR 18 18 18 18 19 19	AP - APPROVED AC - APPROVED SUB. TO CONDITION NA - NOT APPROVED			AP - APPROVED AC - APPROVED SUB. TO CONDITION NA - NOT APPROVED			AP - APPROVED AC - APPROVED SUB. TO CONDITION NA - NOT APPROVED			ISSUE TO CHINA OFFICE		ISSUE TO SITE		ISSUE TO SUB-CONTRACTOR	
				COMMENT DATE	REV.	STATE	COMMENT DATE	REV.	STATE	COMMENT DATE	REV.	STATE	REV.	DATE	REV.	DATE	REV.	DATE
TYPICAL MULLION DETAIL FOR CURTAIN WALL AT TOWER	J837-CW-5001	– A B B B B																
TYPICAL MULLION DETAIL FOR CURTAIN WALL AT TOWER	J837-CW-5002	– A B C C D																
TYPICAL MULLION DETAIL FOR CURTAIN WALL AT TOWER	J837-CW-5003	– A B B B C																
TYPICAL MULLION DETAIL FOR CURTAIN WALL AT TOWER	J837-CW-5004	– A B C E E																
TYPICAL MULLION DETAIL FOR CURTAIN WALL AT TOWER	J837-CW-5005	– A B C D F																
TYPICAL MULLION DETAIL FOR CURTAIN WALL AT TOWER	J837-CW-5006	– A B C E E																
TYPICAL MULLION DETAIL FOR CURTAIN WALL AT TOWER	J837-CW-5007	– – – – –																
TYPICAL MULLION DETAIL FOR CURTAIN WALL AT TOWER	J837-CW-5008	– – – – –																
TYPICAL MULLION DETAIL FOR CURTAIN WALL AT TOWER	J837-CW-5009	– A A B B																
TYPICAL MULLION DETAIL FOR CURTAIN WALL AT TOWER	J837-CW-5010	– A B B B																
TYPICAL MULLION DETAIL FOR CURTAIN WALL AT TOWER	J837-CW-5011	– A A B B																
TYPICAL MULLION DETAIL FOR CURTAIN WALL AT TOWER	J837-CW-5012	A B B C																
TYPICAL MULLION DETAIL FOR CURTAIN WALL AT TOWER	J837-CW-5013	– A A B																
TYPICAL MULLION DETAIL FOR CURTAIN WALL AT TOWER	J837-CW-5014	– A A																
TYPICAL MULLION DETAIL FOR CURTAIN WALL AT TOWER	J837-CW-5015	– B																
TYPICAL MULLION DETAIL FOR CURTAIN WALL AT TOWER	J837-CW-5016	– –																
TYPICAL MULLION DETAIL FOR CURTAIN WALL AT TOWER	J837-CW-5017	– –																
REMEDIAL DETAILS FOR CURTAIN WALL AT TOWER	J837-CW-5018	A A																
TYPICAL MULLION DETAIL FOR CURTAIN WALL AT TOWER	J837-CW-5019	– –																
TYPICAL MULLION DETAIL FOR CURTAIN WALL AT TOWER	J837-CW-5020	– –																
TYPICAL MULLION DETAIL FOR CURTAIN WALL AT TOWER	J837-CW-5021	– –																
TYPICAL MULLION DETAIL FOR CURTAIN WALL AT TOWER	J837-CW-5022	– –																
TYPICAL TRANSOM DETAIL FOR CURTAIN WALL AT TOWER	J837-CW-6001	– A B B B B																
TYPICAL TRANSOM DETAIL FOR CURTAIN WALL AT TOWER	J837-CW-6002	– A B C E E																
TYPICAL TRANSOM DETAIL FOR CURTAIN WALL AT TOWER	J837-CW-6003	– A B C D D																
TYPICAL TRANSOM DETAIL FOR CURTAIN WALL AT TOWER	J837-CW-6004	– A B B D D																
TYPICAL TRANSOM DETAIL FOR CURTAIN WALL AT TOWER	J837-CW-6005	– A B B B B																
TYPICAL TRANSOM DETAIL FOR CURTAIN WALL AT TOWER	J837-CW-6006	– A B B D D																
TYPICAL TRANSOM DETAIL FOR CURTAIN WALL AT TOWER	J837-CW-6007	– A B C C C																
TYPICAL TRANSOM DETAIL FOR CURTAIN WALL AT TOWER	J837-CW-6008	– A B B B B																
TYPICAL TRANSOM DETAIL FOR CURTAIN WALL AT TOWER	J837-CW-6009	– A B C D E																
TYPICAL TRANSOM DETAIL FOR CURTAIN WALL AT TOWER	J837-CW-6010	– A B B B B																
TYPICAL TRANSOM DETAIL FOR CURTAIN WALL AT TOWER	J837-CW-6011	– A B C E E																
TYPICAL TRANSOM DETAIL FOR CURTAIN WALL AT TOWER	J837-CW-6012	– A B C E E																
TYPICAL TRANSOM DETAIL FOR CURTAIN WALL AT TOWER	J837-CW-6013	– A B B C D																
TYPICAL TRANSOM DETAIL FOR CURTAIN WALL AT TOWER	J837-CW-6013A	– A A A A																
TYPICAL TRANSOM DETAIL FOR CURTAIN WALL AT TOWER	J837-CW-6014	– A B B B																
TYPICAL TRANSOM DETAIL FOR CURTAIN WALL AT TOWER	J837-CW-6015	– A B B B																
TYPICAL TRANSOM DETAIL FOR CURTAIN WALL AT TOWER	J837-CW-6016	– A A B B																
TYPICAL TRANSOM DETAIL FOR CURTAIN WALL AT TOWER	J837-CW-6017	– A A B B																
TYPICAL TRANSOM DETAIL FOR CURTAIN WALL AT TOWER	J837-CW-6018	– A A B B																
TYPICAL TRANSOM DETAIL FOR CURTAIN WALL AT TOWER	J837-CW-6019	A A B B																
TYPICAL TRANSOM DETAIL FOR CURTAIN WALL AT TOWER	J837-CW-6020	A B D D																
TYPICAL TRANSOM DETAIL FOR CURTAIN WALL AT TOWER	J837-CW-6021	– C C																
TOTAL PAGES : (INCLUDING COVERPAGE AND DRAWING SUBMISSION REGISTER)		44																

IN-HOUSE DESIGN CHECKER

美特鋁質有限公司
MIDI ALUMINIUM FABRICATOR LTD.
Units 6-8, Sunray Industrial Centre, 1/F
610 Cha Kwo Ling Road, Kowloon
Tel:23489211-4 Fax:(852)27727666

DWG NO. : J837-CW-DR04 | REV. : E

DRAWING SUBMISSION REGISTER

PROJECT :
URA KWUN TONG TOWN CENTRE
REDEVELOPMENT (AREA 2 & 3) AT
NKIL 6514, KWUN TONG, KWLOON

TITLE :
SHOPDRAWING FOR
CURTAIN WALL AT TOWER

DATE OF ISSUE										
ISSUE	01	02	03	04	05	06				
DAY	23	10	24	22	28	20				
MONTH	07	09	11	12	01	05				
YEAR	18	18	18	18	19	19				

SUBMISSION STATE (FOR B.D / A.S.D)
AP - APPROVED
AC - APPROVED SUB. TO CONDITION
NA - NOT APPROVED

SUBMISSION STATE (FOR CLIENT / CONSULTANT)
AP - APPROVED
AC - APPROVED SUB. TO CONDITION
NA - NOT APPROVED

SUBMISSION STATE (FOR ARCHITECT)
AP - APPROVED
AC - APPROVED SUB. TO CONDITION
NA - NOT APPROVED

FABRICATION / CONSTRUCTION STATE

DRAWING TITLE	DWG. NO.	REVISIONS	COMMENT DATE	REV.	STATE	COMMENT DATE	REV.	STATE	COMMENT DATE	REV.	STATE	ISSUE TO CHINA OFFICE REV.	ISSUE TO CHINA OFFICE DATE	ISSUE TO SITE REV.	ISSUE TO SITE DATE	ISSUE TO SUB-CONTRACTOR REV.	ISSUE TO SUB-CONTRACTOR DATE
TYPICAL TRANSOM DETAIL FOR CURTAIN WALL AT TOWER	J837-CW-6022	- A A															
TYPICAL TRANSOM DETAIL FOR CURTAIN WALL AT TOWER	J837-CW-6023	- A A															
TYPICAL TRANSOM DETAIL FOR CURTAIN WALL AT TOWER	J837-CW-6024	- - A															
TYPICAL TRANSOM DETAIL FOR CURTAIN WALL AT TOWER	J837-CW-6025	A A															
TYPICAL TRANSOM DETAIL FOR CURTAIN WALL AT TOWER	J837-CW-6026	A A															
TYPICAL TRANSOM DETAIL FOR CURTAIN WALL AT TOWER	J837-CW-6027	- --															
TYPICAL TRANSOM DETAIL FOR CURTAIN WALL AT TOWER	J837-CW-6028	A A															
TYPICAL TRANSOM DETAIL FOR CURTAIN WALL AT TOWER	J837-CW-6029	A B															
TYPICAL TRANSOM DETAIL FOR CURTAIN WALL AT TOWER	J837-CW-6030	- -															
TYPICAL TRANSOM DETAIL FOR CURTAIN WALL AT TOWER	J837-CW-6031	- A															
TYPICAL TRANSOM DETAIL FOR CURTAIN WALL AT TOWER	J837-CW-6032	-- -															
TYPICAL TRANSOM DETAIL FOR CURTAIN WALL AT TOWER	J837-CW-6033	- A															
TYPICAL TRANSOM DETAIL FOR CURTAIN WALL AT TOWER	J837-CW-6034	- -															
TYPICAL TRANSOM DETAIL FOR CURTAIN WALL AT TOWER	J837-CW-6035	- -															
TYPICAL TRANSOM DETAIL FOR CURTAIN WALL AT TOWER	J837-CW-6036	- -															
TYPICAL TRANSOM DETAIL FOR CURTAIN WALL AT TOWER	J837-CW-6037	- -															
TYPICAL TRANSOM DETAIL FOR CURTAIN WALL AT TOWER	J837-CW-6038	-															
TYPICAL TRANSOM DETAIL FOR CURTAIN WALL AT TOWER	J837-CW-6039	-															
TYPICAL TRANSOM DETAIL FOR CURTAIN WALL AT TOWER	J837-CW-6040	-															
TYPICAL TRANSOM DETAIL FOR CURTAIN WALL AT TOWER	J837-CW-6041	-															
TYPICAL TRANSOM DETAIL FOR CURTAIN WALL AT TOWER	J837-CW-6042	-															
TYPICAL TRANSOM DETAIL FOR CURTAIN WALL AT TOWER	J837-CW-6043	-															
TYPICAL TRANSOM DETAIL FOR CURTAIN WALL AT TOWER	J837-CW-6044	--															
TYPICAL TRANSOM DETAIL FOR CURTAIN WALL AT TOWER	J837-CW-6045	-															
TYPICAL TRANSOM DETAIL FOR CURTAIN WALL AT TOWER	J837-CW-6046	-															
TYPICAL TRANSOM DETAIL FOR CURTAIN WALL AT TOWER	J837-CW-6047	-															
TYPICAL TRANSOM DETAIL FOR CURTAIN WALL AT TOWER	J837-CW-6048	-															
TYPICAL TRANSOM DETAIL FOR CURTAIN WALL AT TOWER	J837-CW-6049	-															
TYPICAL TRANSOM DETAIL FOR CURTAIN WALL AT TOWER	J837-CW-6050	-															
TYPICAL TRANSOM DETAIL FOR CURTAIN WALL AT TOWER	J837-CW-6051	-															
TOTAL PAGES : (INCLUDING COVERPAGE AND DRAWING SUBMISSION REGISTER)		30															

IN-HOUSE DESIGN CHECKER

美特鋁質有限公司
MIDI ALUMINIUM FABRICATOR LTD.
Units 6-8, Sunray Industrial Centre, 1/F
610 Cha Kwo Ling Road, Kowloon
Tel:23489211-4 Fax:(852)27727686

DWG NO. : J837-CW-DR05 | REV. : A

GENERAL NOTES FOR CURTAIN WALL

1. DESIGN CODES :
   a) BUILDING (CONSTRUCTION) REGULATIONS , 1990 HONG KONG.
   b) CODE OF PRACTICE FOR THE STRUCTURAL USE OF STEEL , 2011 HONG KONG
   c) CODE OF PRACTICE FOR THE STRUCTURAL USE OF CONCRETE, 2013 HONG KONG
   d) CODE OF PRACTICE ON WIND EFFECTS IN HONG KONG 2004.
   e) BS 8118 – THE STRUCTURAL USE OF ALUMINIUM , PART I – 1991.
   f) BS 6262 –CODE OF PRACTICE FOR GLAZING OF BUILDING – 2005.
   g) BS EN 10088: 2005 STAINLESS STEELS.
   h) ALL RELEVANT CODES AND STANDARDS AS PER PROJECT TECHNICAL SPECIFICATIONS.
   i) CODE OF PRACTICE FOR DEAD AND IMPOSED LOAD 2011

2. DESIGN LOADS :
   a) WIND LOAD :
      HEIGHT ABOVE GROUND LEVEL = 188.42mPD – 8.58mPD = 179.84m
      DESIGN WIND PRESSURE FOR CURTAIN WALL
      BASE WIND LOAD: 3.14 KPa
      DESIGN WIND LOAD (Cp = +1.0/–1.4): 3.14 x (Cp = +1.0) = 3.14 KPa (FOR INWARD)
      3.14 x (Cp = –1.4) = –4.396 KPa (FOR OUTWARD)

   b) IMPOSED LOAD : (FOR RESIDENTIAL FLOOR)
      NONCROWDED LOAD – HORIZONTAL IMPOSED LOAD SHALL BE COMPLIED CODE OF PRACTICE FOR DEAD & IMPOSED LOADS 2011.
      i) LINE LOAD TO BE APPLIED AT A HEIGHT OF 1.1m ABOVE F.F.L. = 0.75 kN/m
      ii) UNIFORMLY DISTRIBUTED LOAD TO BE APPLIED ON THE INFILL BETWEEN FLOOR AND TOP RAIL = 1.0 kPa
      iii) CONCENTRATED LOAD TO BE APPLIED ON ANY PART OF THE INFILL BETWEEN FLOOR AND TOP RAIL = 0.5 kN

   c) DEAD LOAD :
      GLASS WEIGHT: 26 kN/m³
      STEEL WEIGHT: 77 kN/m³
      ALUM. WEIGHT: 27.2 kN/m³

3. GLASS :
   a) FACIAL GLASS FOR CURTAIN WALL USED TO BE :
      i) G1 : IGU 10 mm THK. TEMPERED BLUE TINTED GLASS (OUTER)+ 9 mm AIR SPACE + 8 mm THK. TEMPERED CLEAR GLASS (INNER) (FOR VISION ZONE)
      ii) G2 : IGU 8 mm THK. HEAT STRENGTHENED TINTED GLASS (OUTER)+ 9 mm AIR SPACE + 8 mm THK. HEAT STRENGTHENED CLEAR GLASS (INNER) (FOR VISION ZONE)
      iii) G3 : IGU 10 mm THK. HEAT STRENGTHENED BLUE TINTED GLASS (OUTER)+ 9 mm AIR SPACE + 8 mm THK. TEMPERED CLEAR GLASS (INNER) (FOR VISION ZONE)
      iv) G4 : 8 mm THK. BLUE TINTED HEAT STRENGTHENED GLASS WITH BACK PAN (FOR SPANDREL ZONE)
      v) G5 : IGU 8 mm THK. HEAT STRENGTHENED BLUE TINTED GLASS (OUTER)+ 9 mm AIR SPACE + 8 mm THK. TEMPERED CLEAR GLASS (INNER) (FOR VISION ZONE)
      vi) G6 : 8 mm THK. BLUE TINTED TEMPERED GLASS WITH BACK PAN (FOR SPANDREL ZONE)
      vii) G7 : 8 mm THK. HEAT STRENGTHENED TINTED GLASS (OUTER)+ 1.52PVB + 8 mm THK. HEAT STRENGTHENED CLEAR LAMINATED GLASS (INNER) (FOR VISION ZONE)
      vii) 10mm THK CLEAR TEMPERED GLASS (FOR PROTECTIVE BARIER)

   b) FULL TEMPERED GLASS TO BE 100% HEAT SOAK TESTED IN ACCORDANCE WITH BS EN 14179–1:2005 AND PMAP APP 37.

   c) DESIGN OF GLASS SHALL COMPLY TO B.S. 6262 , 2005. :
      –ALLOWABLE BENDING STRENGTH (TEMPERED) =50 N/mm²
      –ALLOWABLE BENDING STRENGTH (HEAT STRENGTHENED) =25 N/mm²
      –YOUNG'S MODULUS =70,000 N/mm²
      –DENSITY =26 kN/m³

   d) GLASS MATERIALS SHALL COMPLY TO BS 952:1995
   e) ALL GLASS UNDER 1.1m ABOVE F.F.L. SHALL BE COMPLY IMPACT TEST TO BS 6206 CLASS A.
   f) RESIDUAL SURFACE COMPRESSION FOR TEMPERED GLASS TO BE NOT LESS THAN 69 MPa.

4. ALUMINIUM ALLOY :
   a) ALUMINIUM SHEET :
      ALL ALUMINIUM SHEET TO BE ALLOY 3003–H14 TO ALUMINIUM DESIGN MANUAL: BS EN485–2:2008
      0.2% PROOF (YIELD) STRENGTH = 125 MPa
      MINIMUM ULTIMATE TENSILE STRESS = 145 MPa
      MODULUS OF ELASTICITY (E) = 70000 MPa.
   b) ALUMINIUM EXTRUSION : IN ACCORDANCE WITH DESIGN CODE BS: 8118–1:1991, COMPLY TO BS EN 755–2, 2008
      i) ALUMINIUM EXTRUSION – TO BE ALLOY 6063–T5
      0.2% PROOF STRENGTH = 110 MPa
      MINIMUM TENSILE STRENGTH = 130 MPa
      MODULUS OF ELASTICITY = 70000 MPa.
      ii) ALUMINIUM EXTRUSION – TO BE ALLOY 6063–T6
      0.2% PROOF STRENGTH = 160 MPa
      MINIMUM TENSILE STRENGTH = 175 MPa
      MODULUS OF ELASTICITY = 70000 MPa.
      iii) ALUMINIUM EXTRUSION – TO BE ALLOY 6061–T6
      0.2% PROOF STRENGTH = 240 MPa
      MINIMUM TENSILE STRENGTH = 260 MPa
      MODULUS OF ELASTICITY = 70000 MPa.

5. STEEL :
   a) ALL STEEL MEMBERS SHALL MEET THE MINIMUM REQUIREMENTS OF BS EN10025 S275 JO AND CLASS 1 TO C.O.P. FOR THE STRUCTURAL USE OF STEEL 2011.
   b) SURFACE TREATMENT SHALL BE HOT–DIP GALVANIZED COMPLIED WITH BS EN ISO 1461, 2009. (MIN. THICKNESS = 85 MICRONS)

FOR THICKNESS "T" : T≤16mm (GRADE S275)		FOR THICKNESS "T" : 16mm<T≤40mm (GRADE S275)	
YOUNG'S MODULUS	205,000 N/mm²	YOUNG'S MODULUS	205,000 N/mm²
DENSITY	77 kN/m³	DENSITY	77 kN/m³
YIELD STRENGTH	275 N/mm²	YIELD STRENGTH	265 N/mm²
TENSILE STRENGTH	275 N/mm²	TENSILE STRENGTH	265 N/mm²
BENDING STRENGTH	275 N/mm²	BENDING STRENGTH	265 N/mm²
SHEAR STRENGTH	158.8 N/mm²	SHEAR STRENGTH	153 N/mm²

6. WELDING :
   a) ALL WELDS SHALL COMPLY TO BS EN 1011 & BS EN 440 OR EQUIVALENT TO HKSC 2011.
      DESIGN STRENGTH 220 N/mm²
   b) UNLESS OTHERWISE INDICATED, ALL WELDS SHALL BE 5mm THICK FILLET WELD.
   c) ALL WELDING SHALL BE ELECTRODE PERFORMED BY QUALIFIED WELDERS, TO BE COMPLY WITH BS EN 1011.
   d) ALL SITE WELDS SHALL BE RECEIVED 2 COATS OF ZINE CHROMATE PRIMER.

7. SILICONE SEALANT :
   a) " DOW SIL – 791 " TO BE USED AS WEATHER SEALED & CAULKING SEALANT.

8. GASKET & SETTING BLOCK :
   a) ALL GASKET USED SHALL BE DENSE EXTRUDED SANTOPRENE WITH A HARDNESS OF 60°±5°.
   b) SETTING BLOCKS SHALL BE DENSE EXTRUDED SANTOPRENE WITH A HARDNESS OF 85°±5° DUROMETER SHORE A , A MIN. LENGTH OF 120 mm & A MIN. WIDTH CORRESPONDING TO THE GLASS THICKNESS & LOCATED AT GLASS 1/8 POINTS.

9. FASTENERS
   ALL FASTENERS, BOLTS & NUTS SHALL BE STAINLESS STEEL GRADE A4–70 COMPLYING WITH BS EN ISO 3506.

		FOR GRADE A4–70
MINIMUM YIELD STRENGTH, Ysb	=	450 MPa
ULTIMATE TENSILE STRENGTH, Usb	=	700 MPa
SHEAR STRENGTH, Psb	=	311 MPa
TENSILE STRENGTH, Ptb	=	450 MPa
BEARING STRENGTH, Pbb	=	828 MPa

   UNLESS OTHER SPECIFIED, ALL SCREWS SHALL BE M6 AT 300 C/C GRADE A4–70 STAINLESS STEEL COMPLIED WITH BS EN ISO 3506.(FOR NON–EXPOSED AREA)

10. CAST–IN CHANNEL, CAST–IN BOLT AND CAST–IN EMBED
    a) CAST–IN EMBED SHALL BE GRADE 8.8 COMPLY TO DIN975 & NUT TO BE GRADE 10 COMPLY TO BE BS 4190
       –TENSILE STRENGTH = 550N/m
       –SHEAR STRENGTH = 375N/m
       –BEARING STRENGTH = 1000N/m
    c) CAST–IN ROD SHALL BE GRADE JO S275 G.M.S. ROD TO BS EN 10025. GR. S275: YIELD STRENGTH = 275 N/mm
    d) CAST–IN BRACKETS. STIFFENERS AND GUSSET PLATES TO BE GRADE S275 JO (CLASS 1) TO BS EN 10025.
    e) ALL CAST IN CHANNEL SHALL BE " GRADE S235 G.M.S. ANCHOR CHANNEL
    f) ALL T HEAD BOLT USED TO BE " HILTI , HBC – C " – M16 (GRADE 8.8)
    g) THE DESIGN & INSTALLATION OF " HILTI " ANCHOR CHANNEL & T HEAD BOLT ARE STRICTLY IN ACCORDING WITH MANUFACTURER'S RECOMMENDATION

CHANNEL MODEL	BD REF. NO	MINIMUM DESIGN CRITERIA: CONCRETE THICKNESS (mm)	MINIMUM DESIGN CRITERIA: EDGE DISTANCE (UP/DOWN)(mm)	RECOMMENDED LOAD (kN) (CRACKED CONCRETE): TENSION	RECOMMENDED LOAD (kN) (CRACKED CONCRETE): SHEAR	PULL OUT TEST LOAD (kN) (1.5 x RECOMMENDED LOAD)
HAC-50	BD-AF134	250	150	27	23	33
HAC-70	BD-AF132	250	200	34.7	29.8	52.05

11. INSULATION
    a) FIRE STOP (BD REF. NO. BD–FS011)
    ALUMINIUM SOFFIT/CEILING/WALL SURFACE SHALL SEALED WITH FIRE SHEET & STEEL / CONCRETE INTERFACE 2 HOUR FIRE RAITING THERMAL INSULATION
    b) THERMAL INSULATION
    "CSR" 110Kg/mm ROCKWOOL FIBERTEX–820 SHALL BE 50mm THK.
    c) SMOKE SEAL SHALL BE COMPLY WITH FIRE CODE CLAUSE C10.2

12. OPENABLE WINDOWS
    a) ALL OPENABLE WINDOW SHALL BE CLOSED UNDER STRONG WIND CONDITION.
    b) ALL OPENABLE WINDOW SHALL BE APPROVAL UNDER LOCKED CONDITION.

13. ISOLATION FOR METALS

    SHALL BE APPLIED A LAYER OF BITUMINOUS PAINT FOR PROTECTION AGAINST BI–METALLIC CORROSION.

14. CONCRETE GRADE
    CONCRETE STRUCTURE SHOWN IN THE SUBMISSION SHALL BE OF GRADE 45D MINIMUM.

15. ANCHOR BOLT FOR ALUM. CLADDING
    ANCHOR BOLT TO BE "HILTI" TYPE,DESIGN AND INSTALLATION TO BE IN ACCORDANCE(FOR CRACKED CONCRETE)

Anchor Type	BD REF. NO	Min. embedment depth (mm) into sound concrete	Minimum edge distance in concrete	Minimum spacing in concrete	Recommended Load: Tensile (kN)	Recommended Load: Shear (kN)	Test load(1.5 x recommended tensile load) (kN)
~~M8x74 HST3-R~~	~~BD-AF151~~	~~64~~	~~40~~	~~50~~	~~2.5~~	~~5.2~~	~~=1.5x1.142x2.5=5.033~~
M10x90 HST3-R	BD-AF149	78	45	90	4.0	8.4	=1.5x1.15x4.0=7.080
M16x140 HST3-R	BD-AF148	82	80	70	8.3	16.8	=1.5x1.15x9.4=16.538

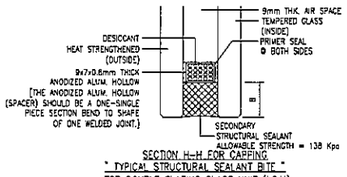

SECTION H–H FOR CAPPING
" TYPICAL STRUCTURAL SEALANT BITE "
FOR DOUBLE GLAZING GLASS UNIT (I.G.U)

QUALITY ASSURANCE DOCUMENT SUCH AS TEST REPORT / CERTIFICATES INDICATING COMPILES WITH ASTM E2190 OR EQUIVALENT WITH RESPECT TO THE SEAL PERFORMANCE FOR INSTALLING GLASS UNIT SHALL BE SUBMITTED TO BD PRIOR TO COMMENCE OF WORKS.

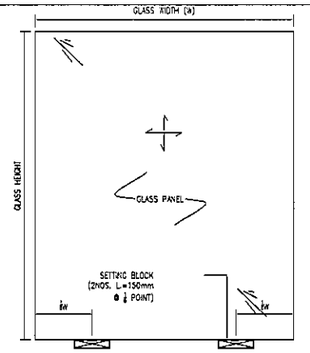

" TYPICAL ELEVATION FOR SETTING BLOCK LOCATION "
(N.T.S.)

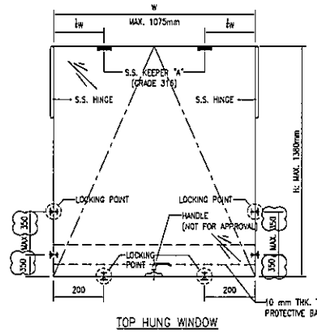

TOP HUNG WINDOW

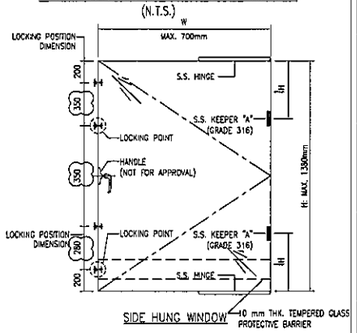

SIDE HUNG WINDOW — 10 mm THK. TEMPERED GLASS PROTECTIVE BARRIER

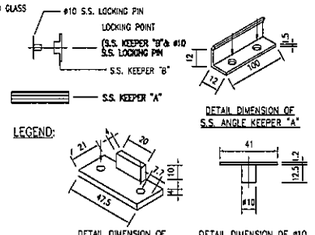

DETAIL DIMENSION OF S.S. ANGLE KEEPER "A"

LEGEND:

DETAIL DIMENSION OF S.S. KEEPER "B"

DETAIL DIMENSION OF ø10 S.S. LOCKING PIN

" TYPICAL CONFIGURATION OF OPENABLE WINDOW IN LOCKED POSITION "
(FOR APPROVAL UNDER THIS SUBMISSION)

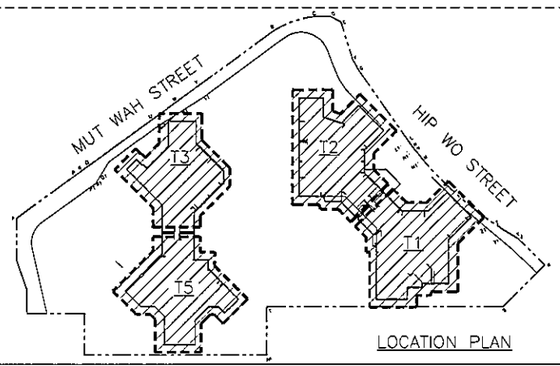

B.D. REF :

CLIENT :
偉和置業有限公司
Sino Land Company Limited

ARCHITECT : WONG TUNG & PARTNERS LIMITED ARCHITECTS & PLANNERS

MAIN CONTRACTOR :
CR Construction Company Limited

STRUCTURAL ENGINEER : AECOM

FACADE CONSULTANT: AECOM

NOTE :
1. ALL DIMENSIONS ARE IN mm.
2. ALL ELEVATIONS ARE VIEWED FROM OUTSIDE.
3. ALL DIMENSIONS TO BE VERIFIED ON SITE BEFORE FABRICATION.

LEGEND :
X1 / X001 — DETAIL MARK NO. / REFER SHEET NO.
1. F.F.L. --FINISHED FLOOR LEVEL
2. S.F.L. --STRUCTURAL FLOOR LEVEL
3. (R) --REVERSED DETAIL

NO.	DATE	REVISED	BY
D	20/05/2018	GENERAL REVISED	
C	22/12/2018	GENERAL REVISED	
B	25/11/2018	GENERAL REVISED	
A	10/9/2018	GENERAL REVISED	

JOB NO. : J–837

PROJECT :
URA KWUN TONG TOWN CENTRE REDEVELOPMENT (AREA 2 & 3) AT NKIL 6514, KWUN TONG, KWLOON

TITLE :
GENERAL NOTES FOR CURTAIN WALL

DATE : 13–JUL–18 | SCALE : 1:1 (A1)

DRAWN BY : ASING | CHECKED BY : –

美特鋁質有限公司
MIDI ALUMINIUM FABRICATOR LTD.
Units 6–8, Sunray Industrial Centre, 1/F
610 Cha Kwo Ling Road, Kowloon
Tel:23489211–4 Fax:(852)27727666

DWG NO. : J837–CW–GN01 | REV. : D

M1 --- ALUMINIUM MULLION | COATING --- PVF2 COATING
GRADE --- 6063 T6

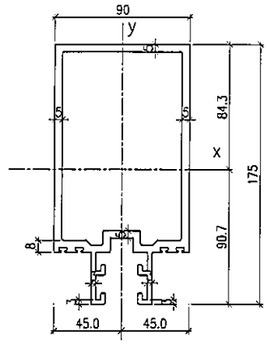

MASS PROPERTIES (UNIT)	VALUES
Area (mm²) :	2685.6
Perimeter (mm) :	1168.9
Bounding Box – X (mm):	–45.0 to 45.0
Bounding Box – Y (mm):	–90.7 to 84.3
Centroid – X (mm) :	0.0
Centroid – Y (mm) :	0.0
Moments of inertia – X (mm⁴) :	8560927.0
Moments of inertia – Y (mm⁴) :	3111287.7
Product of inertia – XY (mm⁴) :	0.0
Radii of gyration – X (mm) :	56.4
Radii of gyration – Y (mm) :	34.0
Principal moments along X–Y (mm⁴) :	8560927.0 along [1.0 0.0]
Principal moments along Y–X (mm⁴) :	3111287.7 along [0.0 1.0]
Elastic Modulus – Zx (mm³):	I / y–max= 94344.9
Elastic Modulus – Zy (mm³):	J / x–max= 69139.7

M2 --- ALUMINIUM MULLION | COATING --- PVF2 COATING
GRADE --- 6063 T6

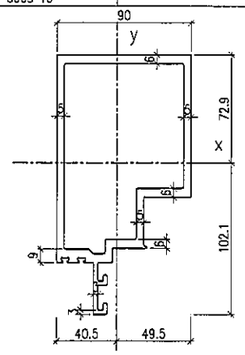

MASS PROPERTIES (UNIT)	VALUES
Area (mm²) :	2560.0
Perimeter (mm) :	1002.9
Bounding Box – X (mm):	–40.5 to 49.5
Bounding Box – Y (mm):	–102.1 to 72.9
Centroid – X (mm) :	0.0
Centroid – Y (mm) :	0.0
Moments of inertia – X (mm⁴) :	7148090.8
Moments of inertia – Y (mm⁴) :	2693592.6
Product of inertia – XY (mm⁴) :	–858464.6
Radii of gyration – X (mm) :	52.8
Radii of gyration – Y (mm) :	32.4
Principal moments along X–Y (mm⁴) :	7307806.3 along [1.0 –0.2]
Principal moments along Y–X (mm⁴) :	2533877.1 along [0.2 1.0]
Elastic Modulus – Zx (mm³):	I / y–max= 69979.9
Elastic Modulus – Zy (mm³):	J / x–max= 54419.8

M3 --- ALUMINIUM MULLION | COATING --- PVF2 COATING
GRADE --- 6063 T6

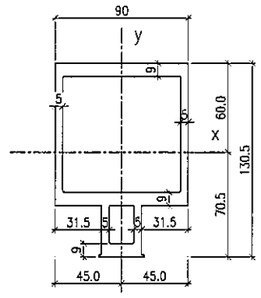

MASS PROPERTIES (UNIT)	VALUES
Area (mm²) :	2904.8
Perimeter (mm) :	845.0
Bounding Box – X (mm):	–45.0 to 45.0
Bounding Box – Y (mm):	–70.5 to 60.0
Centroid – X (mm) :	0.0
Centroid – Y (mm) :	0.0
Moments of inertia – X (mm⁴) :	5525541.9
Moments of inertia – Y (mm⁴) :	2552618.8
Product of inertia – XY (mm⁴) :	0.0
Radii of gyration – X (mm) :	43.6
Radii of gyration – Y (mm) :	29.6
Principal moments along X–Y (mm⁴) :	5525541.9 along [1.0 0.0]
Principal moments along Y–X (mm⁴) :	2552618.8 along [0.0 1.0]
Elastic Modulus – Zx (mm³):	I / y–max= 78397.1
Elastic Modulus – Zy (mm³):	J / x–max= 56724.9

M4 --- ALUMINIUM MULLION | COATING --- PVF2 COATING
GRADE --- 6063 T6

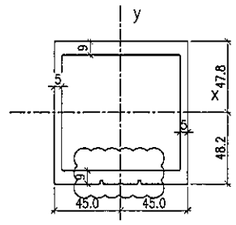

MASS PROPERTIES (UNIT)	VALUES
Area (mm²) :	2391.5
Perimeter (mm) :	694.8
Bounding Box – X (mm):	–45.0 to 45.0
Bounding Box – Y (mm):	–48.2 to 47.8
Centroid – X (mm) :	0.0
Centroid – Y (mm) :	0.0
Moments of inertia – X (mm⁴) :	3452385.8
Moments of inertia – Y (mm⁴) :	2503996.5
Product of inertia – XY (mm⁴) :	0.0
Radii of gyration – X (mm) :	38.0
Radii of gyration – Y (mm) :	32.4
Principal moments along X–Y (mm⁴) :	2503996.5 along [0.0 1.0]
Principal moments along Y–X (mm⁴) :	3452385.8 along [–1.0 0.0]
Elastic Modulus – Zx (mm³):	I / y–max= 71650.3
Elastic Modulus – Zy (mm³):	J / x–max= 55644.4

M5 --- ALUMINIUM MULLION | COATING --- PVF2 COATING
GRADE --- 6063 T6

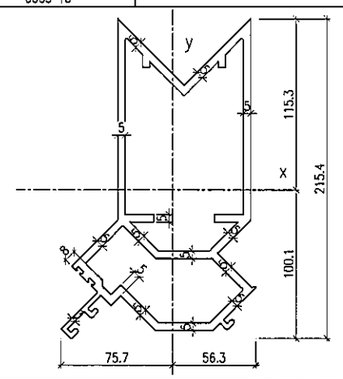

MASS PROPERTIES (UNIT)	VALUES
Area (mm²) :	4006.3
Perimeter (mm) :	1633.1
Bounding Box – X (mm):	–75.7 to 56.3
Bounding Box – Y (mm):	–100.1 to 115.3
Centroid – X (mm) :	0.0
Centroid – Y (mm) :	0.0
Moments of inertia – X (mm⁴) :	17546808.7
Moments of inertia – Y (mm⁴) :	5955158.6
Product of inertia – XY (mm⁴) :	–1928247.4
Radii of gyration – X (mm) :	66.2
Radii of gyration – Y (mm) :	38.6
Principal moments along X–Y (mm⁴) :	17859152.5 along [1.0 –0.2]
Principal moments along Y–X (mm⁴) :	5642814.9 along [0.2 1.0]
Elastic Modulus – Zx (mm³):	I / y–max= 152220.1
Elastic Modulus – Zy (mm³):	J / x–max= 78715.3

M6 --- ALUMINIUM MULLION | COATING --- PVF2 COATING
GRADE --- 6063 T6

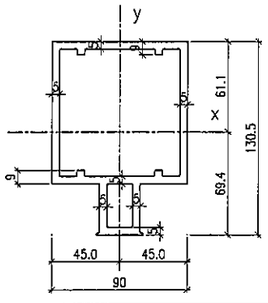

MASS PROPERTIES (UNIT)	VALUES
Area (mm²) :	2278.1
Perimeter (mm) :	895.8
Bounding Box – X (mm):	–45.0 to 45.0
Bounding Box – Y (mm):	–69.4 to 61.1
Centroid – X (mm) :	0.0
Centroid – Y (mm) :	0.0
Moments of inertia – X (mm⁴) :	4229062.4
Moments of inertia – Y (mm⁴) :	2263514.5
Product of inertia – XY (mm⁴) :	0.0
Radii of gyration – X (mm) :	43.1
Radii of gyration – Y (mm) :	31.5
Principal moments along X–Y (mm⁴) :	4229062.4 along [1.0 0.0]
Principal moments along Y–X (mm⁴) :	2263514.5 along [0.0 1.0]
Elastic Modulus – Zx (mm³):	I / y–max= 60912.9
Elastic Modulus – Zy (mm³):	J / x–max= 50300.3

M7 --- ALUMINIUM MULLION | COATING --- PVF2 COATING
GRADE --- 6063 T6

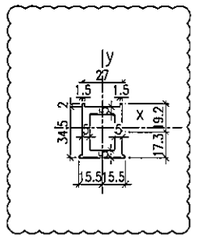

MASS PROPERTIES (UNIT)	VALUES
Area (mm²) :	526.8
Perimeter (mm) :	218.3
Bounding Box – X (mm):	–15.5 to 15.5
Bounding Box – Y (mm):	–17.3 to 19.2
Centroid – X (mm) :	0.0
Centroid – Y (mm) :	0.0
Moments of inertia – X (mm⁴) :	75041.8
Moments of inertia – Y (mm⁴) :	48619.6
Product of inertia – XY (mm⁴) :	0.0
Radii of gyration – X (mm) :	11.9
Radii of gyration – Y (mm) :	9.6
Principal moments along X–Y (mm⁴) :	48619.6 along [0.0 1.0]
Principal moments along Y–X (mm⁴) :	75041.8 along [–1.0 0.0]
Elastic Modulus – Zx (mm³):	I / y–max= 3908.2
Elastic Modulus – Zy (mm³):	J / x–max= 3136.7

T1 --- ALUMINIUM TRANSOM | COATING --- PVF2 COATING
GRADE --- 6063 T6

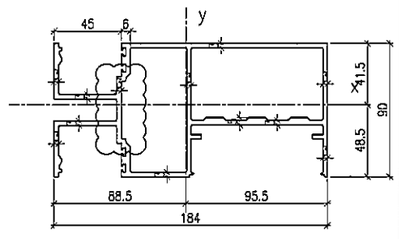

MASS PROPERTIES (UNIT)	VALUES
Area (mm²) :	2283.2
Perimeter (mm) :	1446.4
Bounding Box – X (mm):	–88.5 to 95.5
Bounding Box – Y (mm):	–48.5 to 41.5
Centroid – X (mm) :	0.0
Centroid – Y (mm) :	0.0
Moments of inertia – X (mm⁴) :	1841389.3
Moments of inertia – Y (mm⁴) :	8107752.5
Product of inertia – XY (mm⁴) :	–388294.0
Radii of gyration – X (mm) :	28.4
Radii of gyration – Y (mm) :	59.6
Principal moments along X–Y (mm⁴) :	1817420.4 along [1.0 0.1]
Principal moments along Y–X (mm⁴) :	8131721.4 along [–0.1 1.0]
Elastic Modulus – Zx (mm³):	I / y–max= 37934.0
Elastic Modulus – Zy (mm³):	J / x–max= 84907.9

T2 --- ALUMINIUM TRANSOM | COATING --- PVF2 COATING
GRADE --- 6063 T6

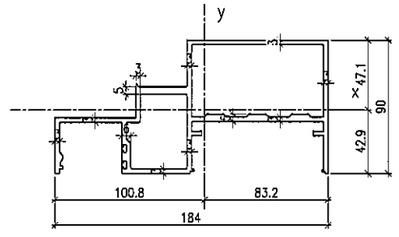

MASS PROPERTIES (UNIT)	VALUES
Area (mm²) :	1969.2
Perimeter (mm) :	1203.5
Bounding Box – X (mm):	–100.8 to 83.2
Bounding Box – Y (mm):	–42.9 to 47.1
Centroid – X (mm) :	0.0
Centroid – Y (mm) :	0.0
Moments of inertia – X (mm⁴) :	1401920.1
Moments of inertia – Y (mm⁴) :	6039676.5
Product of inertia – XY (mm⁴) :	1059596.3
Radii of gyration – X (mm) :	26.7
Radii of gyration – Y (mm) :	55.4
Principal moments along X–Y (mm⁴) :	1171300.2 along [1.0 0.2]
Principal moments along Y–X (mm⁴) :	6270296.4 along [–0.2 1.0]
Elastic Modulus – Zx (mm³):	I / y–max= 29761.3
Elastic Modulus – Zy (mm³):	J / x–max= 59896.7

T3 --- ALUMINIUM TRANSOM | COATING --- PVF2 COATING
GRADE --- 6063 T6

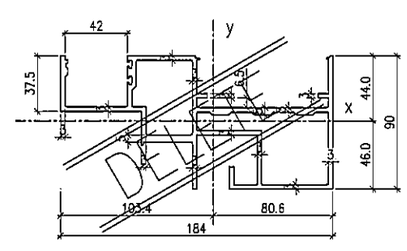

MASS PROPERTIES (UNIT)	VALUES
Area (mm²) :	2171.4
Perimeter (mm) :	1338.9
Bounding Box – X (mm):	–103.4 to 80.6
Bounding Box – Y (mm):	–46.0 to 44.0
Centroid – X (mm) :	0.0
Centroid – Y (mm) :	0.0
Moments of inertia – X (mm⁴) :	1410096.2
Moments of inertia – Y (mm⁴) :	6188637.8
Product of inertia – XY (mm⁴) :	–1175811.4
Radii of gyration – X (mm) :	25.5
Radii of gyration – Y (mm) :	53.4
Principal moments along X–Y (mm⁴) :	1136446.1 along [1.0 –0.2]
Principal moments along Y–X (mm⁴) :	6462287.9 along [0.2 1.0]
Elastic Modulus – Zx (mm³):	I / y–max= 30624.6
Elastic Modulus – Zy (mm³):	J / x–max= 59868.0

M4A --- ALUMINIUM MULLION | COATING --- PVF2 COATING
GRADE --- 6063 T6 & GRADE : S275

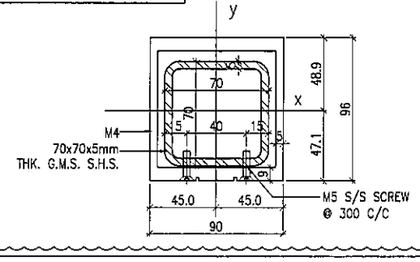

MASS PROPERTIES (UNIT)	VALUES
Area (mm²) :	3627.1
Perimeter (mm) :	1189.0
Bounding Box – X (mm):	–45.0 to 45.0
Bounding Box – Y (mm):	–47.1 to 48.9
Centroid – X (mm) :	0.0
Centroid – Y (mm) :	0.0
Moments of inertia – X (mm⁴) :	4307019.9
Moments of inertia – Y (mm⁴) :	3350288.4
Product of inertia – XY (mm⁴) :	0.0
Radii of gyration – X (mm) :	34.5
Radii of gyration – Y (mm) :	30.4
Principal moments along X–Y (mm⁴) :	3350288.4 along [0.0 1.0]
Principal moments along Y–X (mm⁴) :	4307019.9 along [–1.0 0.0]
Elastic Modulus – Zx (mm³):	I / y–max= 88066.8
Elastic Modulus – Zy (mm³):	J / x–max= 74450.9

B.D. REF :

CLIENT :
信和置業有限公司
Sino Land Company Limited

ARCHITECT :
WONG TUNG & PARTNERS LIMITED
ARCHITECTS & PLANNERS

MAIN CONTRACTOR :
CR Construction Company Limited

STRUCTURAL ENGINEER :
AECOM

FACADE CONSULTANT:
AECOM

NOTE :
1. ALL DIMENSIONS ARE IN mm.
2. ALL ELEVATIONS ARE VIEWED FROM OUTSIDE.
3. ALL DIMENSIONS TO BE VERIFIED ON SITE BEFORE FABRICATION.

LEGEND :
X1 / X001 — DETAIL MARK NO. / REFER SHEET NO.
1. F.F.L. --FINISHED FLOOR LEVEL
2. S.F.L. --STRUCTURAL FLOOR LEVEL
3. (/P) --REVERSED DETAIL

NO.	DATE	REVISED	BY
B	25/11/2018	GENERAL REVISED	
A	10/9/2018	GENERAL REVISED	

JOB NO. : J–837

PROJECT :
URA KWUN TONG TOWN CENTRE REDEVELOPMENT (AREA 2 & 3) AT NKIL 6514, KWUN TONG, KWLOON

TITLE :
TYPICAL MULLION DETAIL FOR CURTAIN WALL

DATE : 13–JUL–18 | SCALE : 1:2 (A1)

DRAWN BY : ASING | CHECKED BY : –

美特鋁質有限公司
MIDI ALUMINIUM FABRICATOR LTD.
Units 6–8, Sunray Industrial Centre, 1/F
610 Cha Kwo Ling Road, Kowloon
Tel:23489211–4 Fax:(852)27727666

DWG NO. : J837–CW–ML01 | REV. : B

T3A --- ALUMINIUM TRANSOM | COATING --- PVF2 COATING

GRADE --- 6063 T6

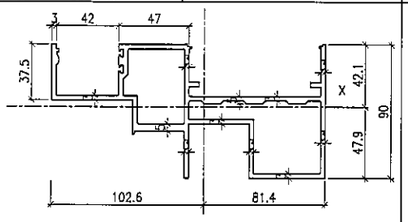

MASS PROPERTIES (UNIT)	VALUES
Area (mm2) :	2078.4
Perimeter (mm) :	1276.9
Bounding Box – X (mm):	−102.6 to 81.4
Bounding Box – Y (mm):	−47.9 to 42.1
Centroid – X (mm) :	0.0
Centroid – Y (mm) :	0.0
Moments of inertia – X (mm⁴) :	1239902.0
Moments of inertia – Y (mm⁴) :	6157299.2
Product of inertia – XY (mm⁴) :	−1105578.0
Radii of gyration – X (mm) :	24.4
Radii of gyration – Y (mm) :	54.4
Principal moments along X–Y (mm⁴) :	1002770.2 along [1.0 −0.2]
Principal moments along Y–X (mm⁴) :	6394431.0 along [0.2 1.0]
Elastic Modulus – Zx (mm³):	I / y-max= 25881.0
Elastic Modulus – Zy (mm³):	J / x-max= 60007.2

A01 --- ALUMINIUM CAP | COATING --- PVF2 COATING

GRADE --- 6063 T5

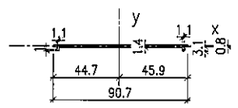

MASS PROPERTIES (UNIT)	VALUES
Area (mm2) :	132.6
Perimeter (mm) :	194.5
Bounding Box – X (mm):	−44.7 to 45.9
Bounding Box – Y (mm):	−3.1 to 0.8
Centroid – X (mm) :	0.0
Centroid – Y (mm) :	0.0
Moments of inertia – X (mm⁴) :	51.8
Moments of inertia – Y (mm⁴) :	96748.1
Product of inertia – XY (mm⁴) :	118.1
Radii of gyration – X (mm) :	0.6
Radii of gyration – Y (mm) :	27.0
Principal moments along X–Y (mm⁴) :	51.7 along [1.0 0.0]
Principal moments along Y–X (mm⁴) :	96748.3 along [0.0 1.0]
Elastic Modulus – Zx (mm³):	I / y-max= 16.6
Elastic Modulus – Zy (mm³):	J / x-max= 2107.2

A02 --- ALUM. WINDOW SASH | COATING --- PVF2 COATING

GRADE --- 6063 T6

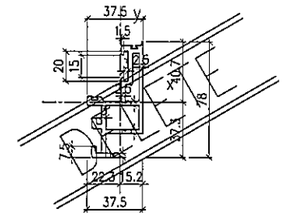

MASS PROPERTIES (UNIT)	VALUES
Area (mm2) :	673.8
Perimeter (mm) :	465.0
Bounding Box – X (mm):	−22.3 to 15.2
Bounding Box – Y (mm):	−37.3 to 40.7
Centroid – X (mm) :	0.0
Centroid – Y (mm) :	0.0
Moments of inertia – X (mm⁴) :	287162.6
Moments of inertia – Y (mm⁴) :	88704.2
Product of inertia – XY (mm⁴) :	−87527.0
Radii of gyration – X (mm) :	20.6
Radii of gyration – Y (mm) :	11.5
Principal moments along X–Y (mm⁴) :	320249.0 along [0.9 −0.4]
Principal moments along Y–X (mm⁴) :	55617.8 along [0.4 0.9]
Elastic Modulus – Zx (mm³):	I / y-max= 7060.2
Elastic Modulus – Zy (mm³):	J / x-max= 3982.3

A03 --- ALUMINIUM CAPPING | COATING --- PVF2 COATING

GRADE --- 6063 T6

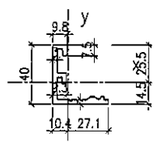

MASS PROPERTIES (UNIT)	VALUES
Area (mm2) :	304.6
Perimeter (mm) :	199.5
Bounding Box – X (mm):	−10.4 to 27.1
Bounding Box – Y (mm):	−14.5 to 25.5
Centroid – X (mm) :	0.0
Centroid – Y (mm) :	0.0
Moments of inertia – X (mm⁴) :	56645.9
Moments of inertia – Y (mm⁴) :	36421.8
Product of inertia – XY (mm⁴) :	−25163.9
Radii of gyration – X (mm) :	13.6
Radii of gyration – Y (mm) :	10.9
Principal moments along X–Y (mm⁴) :	19414.2 along [0.6 −0.8]
Principal moments along Y–X (mm⁴) :	73653.5 along [0.8 0.6]
Elastic Modulus – Zx (mm³):	I / y-max= 2224.1
Elastic Modulus – Zy (mm³):	J / x-max= 1346.3

A04 --- ALUM. WINDOW SASH | COATING --- PVF2 COATING

GRADE --- 6063 T6

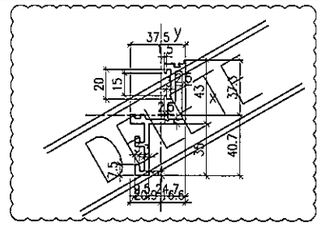

MASS PROPERTIES (UNIT)	VALUES
Area (mm2) :	559.7
Perimeter (mm) :	388.6
Bounding Box – X (mm):	−20.9 to 16.6
Bounding Box – Y (mm):	−40.7 to 37.3
Centroid – X (mm) :	0.0
Centroid – Y (mm) :	0.0
Moments of inertia – X (mm⁴) :	246529.6
Moments of inertia – Y (mm⁴) :	75425.8
Product of inertia – XY (mm⁴) :	−100120.7
Radii of gyration – X (mm) :	21.0
Radii of gyration – Y (mm) :	11.6
Principal moments along X–Y (mm⁴) :	292671.6 along [0.9 −0.4]
Principal moments along Y–X (mm⁴) :	29283.8 along [0.4 0.9]
Elastic Modulus – Zx (mm³):	I / y-max= 6058.8
Elastic Modulus – Zy (mm³):	J / x-max= 3609.7

A05 --- ALUMINIUM ADAPTER | COATING --- PVF2 COATING

GRADE --- 6063 T6

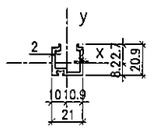

MASS PROPERTIES (UNIT)	VALUES
Area (mm2) :	138.3
Perimeter (mm) :	142.3
Bounding Box – X (mm):	−10.1 to 10.9
Bounding Box – Y (mm):	−8.2 to 12.7
Centroid – X (mm) :	0.0
Centroid – Y (mm) :	0.0
Moments of inertia – X (mm⁴) :	5995.3
Moments of inertia – Y (mm⁴) :	8724.2
Product of inertia – XY (mm⁴) :	−2.7
Radii of gyration – X (mm) :	6.6
Radii of gyration – Y (mm) :	7.9
Principal moments along X–Y (mm⁴) :	5995.3 along [1.0 0.0]
Principal moments along Y–X (mm⁴) :	8724.2 along [0.0 1.0]
Elastic Modulus – Zx (mm³):	I / y-max= 472.3
Elastic Modulus – Zy (mm³):	J / x-max= 798.7

A06 --- ALUM. SUB-FRAME | COATING --- PVF2 COATING

GRADE --- 6063 T6

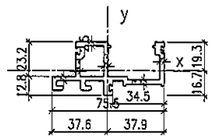

MASS PROPERTIES (UNIT)	VALUES
Area (mm2) :	644.3
Perimeter (mm) :	426.8
Bounding Box – X (mm):	−37.6 to 37.9
Bounding Box – Y (mm):	−16.7 to 19.3
Centroid – X (mm) :	0.0
Centroid – Y (mm) :	0.0
Moments of inertia – X (mm⁴) :	67511.8
Moments of inertia – Y (mm⁴) :	317162.2
Product of inertia – XY (mm⁴) :	−18128.4
Radii of gyration – X (mm) :	10.2
Radii of gyration – Y (mm) :	22.2
Principal moments along X–Y (mm⁴) :	66202.3 along [1.0 0.1]
Principal moments along Y–X (mm⁴) :	318471.7 along [−0.1 1.0]
Elastic Modulus – Zx (mm³):	I / y-max= 3500.1
Elastic Modulus – Zy (mm³):	J / x-max= 8373.3

A07 --- ALUM. SUB-FRAME | COATING --- PVF2 COATING

GRADE --- 6063 T6

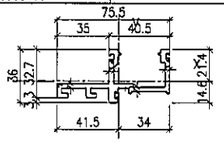

MASS PROPERTIES (UNIT)	VALUES
Area (mm2) :	542.1
Perimeter (mm) :	360.0
Bounding Box – X (mm):	−41.5 to 34.0
Bounding Box – Y (mm):	−14.6 to 21.4
Centroid – X (mm) :	0.0
Centroid – Y (mm) :	0.0
Moments of inertia – X (mm⁴) :	47327.7
Moments of inertia – Y (mm⁴) :	273371.8
Product of inertia – XY (mm⁴) :	−43936.6
Radii of gyration – X (mm) :	9.3
Radii of gyration – Y (mm) :	22.5
Principal moments along X–Y (mm⁴) :	39088.0 along [1.0 0.2]
Principal moments along Y–X (mm⁴) :	281611.5 along [−0.2 1.0]
Elastic Modulus – Zx (mm³):	I / y-max= 2215.7
Elastic Modulus – Zy (mm³):	J / x-max= 6593.1

A08 --- ALUMINIUM CAP | COATING --- PVF2 COATING

GRADE --- 6063 T5

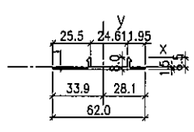

MASS PROPERTIES (UNIT)	VALUES
Area (mm2) :	99.0
Perimeter (mm) :	152.5
Bounding Box – X (mm):	−33.9 to 28.1
Bounding Box – Y (mm):	−1.5 to 6.5
Centroid – X (mm) :	0.0
Centroid – Y (mm) :	0.0
Moments of inertia – X (mm⁴) :	367.5
Moments of inertia – Y (mm⁴) :	26487.8
Product of inertia – XY (mm⁴) :	−416.4
Radii of gyration – X (mm) :	1.9
Radii of gyration – Y (mm) :	16.4
Principal moments along X–Y (mm⁴) :	360.9 along [1.0 0.0]
Principal moments along Y–X (mm⁴) :	26494.4 along [0.0 1.0]
Elastic Modulus – Zx (mm³):	I / y-max= 56.5
Elastic Modulus – Zy (mm³):	J / x-max= 780.7

A09 --- ALUMINIUM CAP | COATING --- PVF2 COATING

GRADE --- 6063 T5

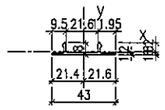

MASS PROPERTIES (UNIT)	VALUES
Area (mm2) :	78.5
Perimeter (mm) :	114.5
Bounding Box – X (mm):	−21.4 to 21.6
Bounding Box – Y (mm):	−1.8 to 6.2
Centroid – X (mm) :	0.0
Centroid – Y (mm) :	0.0
Moments of inertia – X (mm⁴) :	340.2
Moments of inertia – Y (mm⁴) :	10718.4
Product of inertia – XY (mm⁴) :	94.9
Radii of gyration – X (mm) :	2.1
Radii of gyration – Y (mm) :	11.7
Principal moments along X–Y (mm⁴) :	339.3 along [1.0 0.0]
Principal moments along Y–X (mm⁴) :	10719.3 along [0.0 1.0]
Elastic Modulus – Zx (mm³):	I / y-max= 54.4
Elastic Modulus – Zy (mm³):	J / x-max= 496.3

A10--- ALUMINIUM SLEEVE | COATING --- N/A FINISHED

GRADE --- 6061 T6

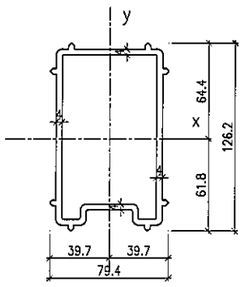

MASS PROPERTIES (UNIT)	VALUES
Area (mm2) :	1610.0
Perimeter (mm) :	796.5
Bounding Box – X (mm):	−39.7 to 39.7
Bounding Box – Y (mm):	−61.8 to 64.4
Centroid – X (mm) :	0.0
Centroid – Y (mm) :	0.0
Moments of inertia – X (mm⁴) :	3033893.6
Moments of inertia – Y (mm⁴) :	1355281.8
Product of inertia – XY (mm⁴) :	0.0
Radii of gyration – X (mm) :	43.4
Radii of gyration – Y (mm) :	29.0
Principal moments along X–Y (mm⁴) :	3033893.6 along [1.0 0.0]
Principal moments along Y–X (mm⁴) :	1355281.8 along [0.0 1.0]
Elastic Modulus – Zx (mm³):	I / y-max= 47097.3
Elastic Modulus – Zy (mm³):	J / x-max= 34138.1

A11--- ALUMINIUM SLEEVE | COATING --- N/A FINISHED

GRADE --- 6061 T6

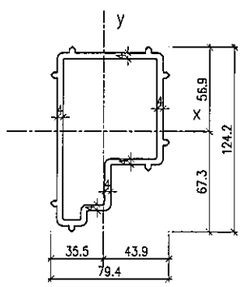

MASS PROPERTIES (UNIT)	VALUES
Area (mm2) :	1513.2
Perimeter (mm) :	748.1
Bounding Box – X (mm):	−35.5 to 43.9
Bounding Box – Y (mm):	−67.3 to 56.9
Centroid – X (mm) :	0.0
Centroid – Y (mm) :	0.0
Moments of inertia – X (mm⁴) :	2280153.3
Moments of inertia – Y (mm⁴) :	1114388.9
Product of inertia – XY (mm⁴) :	−380553.7
Radii of gyration – X (mm) :	38.8
Radii of gyration – Y (mm) :	27.1
Principal moments along X–Y (mm⁴) :	2393383.7 along [1.0 −0.3]
Principal moments along Y–X (mm⁴) :	1001158.5 along [0.3 1.0]
Elastic Modulus – Zx (mm³):	I / y-max= 33883.4
Elastic Modulus – Zy (mm³):	J / x-max= 25407.2

A12--- ALUMINIUM SLEEVE | COATING --- N/A FINISHED

GRADE --- 6061 T6

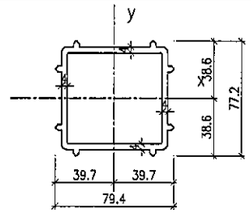

MASS PROPERTIES (UNIT)	VALUES
Area (mm2) :	1150.1
Perimeter (mm) :	568.7
Bounding Box – X (mm):	−39.7 to 39.7
Bounding Box – Y (mm):	−38.6 to 38.6
Centroid – X (mm) :	0.0
Centroid – Y (mm) :	0.0
Moments of inertia – X (mm⁴) :	832674.0
Moments of inertia – Y (mm⁴) :	888679.5
Product of inertia – XY (mm⁴) :	0.0
Radii of gyration – X (mm) :	26.9
Radii of gyration – Y (mm) :	27.8
Principal moments along X–Y (mm⁴) :	832674.0 along [1.0 0.0]
Principal moments along Y–X (mm⁴) :	888679.5 along [0.0 1.0]
Elastic Modulus – Zx (mm³):	I / y-max= 21571.9
Elastic Modulus – Zy (mm³):	J / x-max= 22384.9

A13--- ALUMINIUM SLEEVE | COATING --- N/A FINISHED

GRADE --- 6061 T6

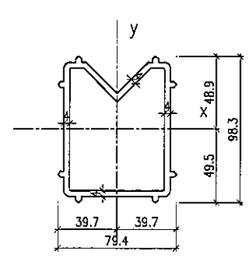

MASS PROPERTIES (UNIT)	VALUES
Area (mm2) :	1391.1
Perimeter (mm) :	689.2
Bounding Box – X (mm):	−39.7 to 39.7
Bounding Box – Y (mm):	−49.5 to 48.9
Centroid – X (mm) :	0.0
Centroid – Y (mm) :	0.0
Moments of inertia – X (mm⁴) :	1512584.9
Moments of inertia – Y (mm⁴) :	1092190.4
Product of inertia – XY (mm⁴) :	0.0
Radii of gyration – X (mm) :	33.0
Radii of gyration – Y (mm) :	28.0
Principal moments along X–Y (mm⁴) :	1512584.9 along [1.0 0.0]
Principal moments along Y–X (mm⁴) :	1092190.4 along [0.0 1.0]
Elastic Modulus – Zx (mm³):	I / y-max= 30570.9
Elastic Modulus – Zy (mm³):	J / x-max= 27511.1

A14--- ALUMINIUM CAPPING | COATING --- N/A FINISHED

GRADE --- 6063 T6

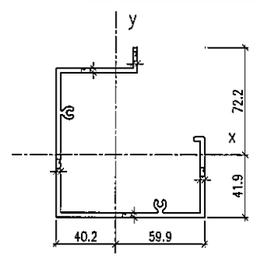

MASS PROPERTIES (UNIT)	VALUES
Area (mm2) :	1035.4
Perimeter (mm) :	703.6
Bounding Box – X (mm):	−40.2 to 59.9
Bounding Box – Y (mm):	−41.9 to 72.2
Centroid – X (mm) :	0.0
Centroid – Y (mm) :	0.0
Moments of inertia – X (mm⁴) :	1566832.4
Moments of inertia – Y (mm⁴) :	1420341.0
Product of inertia – XY (mm⁴) :	485422.7
Radii of gyration – X (mm) :	38.9
Radii of gyration – Y (mm) :	37.0
Principal moments along X–Y (mm⁴) :	1984504.3 along [0.8 0.7]
Principal moments along Y–X (mm⁴) :	1002669.1 along [−0.7 0.8]
Elastic Modulus – Zx (mm³):	I / y-max= 21697.1
Elastic Modulus – Zy (mm³):	J / x-max= 23696.2

B.D. REF :

CLIENT :
信和置業有限公司
Sino Land Company Limited

ARCHITECT :
WONG TUNG & PARTNERS LIMITED
ARCHITECTS & PLANNERS

MAIN CONTRACTOR :
CR Construction Company Limited

STRUCTURAL ENGINEER :
AECOM

FACADE CONSULTANT:
AECOM

NOTE :
1. ALL DIMENSIONS ARE IN mm.
2. ALL ELEVATIONS ARE VIEWED FROM OUTSIDE.
3. ALL DIMENSIONS TO BE VERIFIED ON SITE BEFORE FABRICATION.

LEGEND :
X1 — DETAIL MARK NO.
X001 — REFER SHEET NO.

1. F.F.L. --FINISHED FLOOR LEVEL
2. S.F.L. --STRUCTURAL FLOOR LEVEL
3. (R) --REVERSED DETAIL

NO.	DATE	REMARK	BY
C	22/12/2018	GENERAL REVISED	
B	25/11/2018	GENERAL REVISED	
A	10/9/2018	GENERAL REVISED	

JOB NO. : J-837

PROJECT :
URA KWUN TONG TOWN CENTRE REDEVELOPMENT (AREA 2 & 3) AT NKIL 6514, KWUN TONG, KWLOON

TITLE :
TYPICAL MULLION DETAIL FOR CURTAIN WALL

DATE : 13-JUL-18 | SCALE : 1:2 (A1)

DRAWN BY : ASING | CHECKED BY : –

美特鋁質有限公司
MIDI ALUMINIUM FABRICATOR LTD.
Units 6-8, Sunray Industrial Centre, 1/F
610 Cha Kwo Ling Road, Kowloon
Tel:23489211-4 Fax:(852)27727666

DWG NO. : J837-CW-MLO2 | REV. : C

A15 --- ALUMINIUM ADAPTER | COATING --- N/A FINISHED

GRADE --- 6063 T6

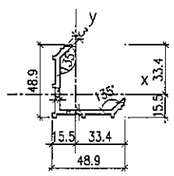

MASS PROPERTIES (UNIT)	VALUES
Area (mm²) :	315.6
Perimeter (mm) :	227.1
Bounding Box – X (mm):	−15.5 to 33.4
Bounding Box – Y (mm):	−15.5 to 33.4
Centroid – X (mm) :	0.0
Centroid – Y (mm) :	0.0
Moments of inertia – X (mm⁴) :	71527.2
Moments of inertia – Y (mm⁴) :	71527.2
Product of inertia – XY (mm⁴) :	−35469.7
Radii of gyration – X (mm) :	15.1
Radii of gyration – Y (mm) :	15.1
Principal moments along X–Y (mm⁴) :	36057.4 along [0.7 −0.7]
Principal moments along Y–X (mm⁴) :	106996.9 along [0.7 0.7]
Elastic Modulus – Zx (mm³):	I / y–max= 2142.2
Elastic Modulus – Zy (mm³):	J / x–max= 2142.2

A16 --- ALUMINIUM CAP | COATING --- PVF2 COATING

GRADE --- 6063 T5

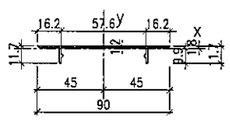

MASS PROPERTIES (UNIT)	VALUES
Area (mm²) :	135.5
Perimeter (mm) :	224.1
Bounding Box – X (mm):	−45.0 to 45.0
Bounding Box – Y (mm):	−9.9 to 1.8
Centroid – X (mm) :	0.0
Centroid – Y (mm) :	0.0
Moments of inertia – X (mm⁴) :	1029.5
Moments of inertia – Y (mm⁴) :	94802.7
Product of inertia – XY (mm⁴) :	0.0
Radii of gyration – X (mm) :	2.8
Radii of gyration – Y (mm) :	26.5
Principal moments along X–Y (mm⁴) :	1029.5 along [1.0 0.0]
Principal moments along Y–X (mm⁴) :	94802.7 along [0.0 1.0]
Elastic Modulus – Zx (mm³):	I / y–max= 104.5
Elastic Modulus – Zy (mm³):	J / x–max= 2106.7

A17 --- ALUMINIUM BAR | COATING --- PVF2 COATING

GRADE --- 6061 T6

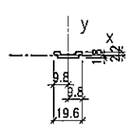

MASS PROPERTIES (UNIT)	VALUES
Area (mm²) :	51.2
Perimeter (mm) :	47.6
Bounding Box – X (mm):	−9.8 to 9.8
Bounding Box – Y (mm):	−1.8 to 2.2
Centroid – X (mm) :	0.0
Centroid – Y (mm) :	0.0
Moments of inertia – X (mm⁴) :	59.4
Moments of inertia – Y (mm⁴) :	1508.7
Product of inertia – XY (mm⁴) :	0.0
Radii of gyration – X (mm) :	1.1
Radii of gyration – Y (mm) :	5.4
Principal moments along X–Y (mm⁴) :	59.4 along [1.0 0.0]
Principal moments along Y–X (mm⁴) :	1508.7 along [0.0 1.0]
Elastic Modulus – Zx (mm³):	I / y–max= 26.9
Elastic Modulus – Zy (mm³):	J / x–max= 153.9

S01 --- ALUMINIUM ADAPTER | COATING --- PVF2 COATING

GRADE --- 6063 T6

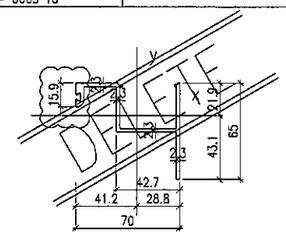

MASS PROPERTIES (UNIT)	VALUES
Area (mm²) :	432.3
Perimeter (mm) :	369.4
Bounding Box – X (mm):	−41.2 to 28.8
Bounding Box – Y (mm):	−43.1 to 21.9
Centroid – X (mm) :	0.0
Centroid – Y (mm) :	0.0
Moments of inertia – X (mm⁴) :	125442.4
Moments of inertia – Y (mm⁴) :	275101.2
Product of inertia – XY (mm⁴) :	−119565.0
Radii of gyration – X (mm) :	17.0
Radii of gyration – Y (mm) :	25.2
Principal moments along X–Y (mm⁴) :	59221.4 along [0.9 −0.5]
Principal moments along Y–X (mm⁴) :	341322.2 along [0.5 0.9]
Elastic Modulus – Zx (mm³):	I / y–max= 2910.1
Elastic Modulus – Zy (mm³):	J / x–max= 6675.8

S02 --ALUMINIUM DOOR FRAME | COATING --- PVF2 COATING

GRADE --- 6063 T6

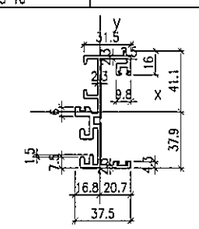

MASS PROPERTIES (UNIT)	VALUES
Area (mm²) :	587.9
Perimeter (mm) :	494.5
Bounding Box – X (mm):	−16.8 to 20.7
Bounding Box – Y (mm):	−37.9 to 41.1
Centroid – X (mm) :	0.0
Centroid – Y (mm) :	0.0
Moments of inertia – X (mm⁴) :	408805.4
Moments of inertia – Y (mm⁴) :	55024.6
Product of inertia – XY (mm⁴) :	44223.2
Radii of gyration – X (mm) :	26.4
Radii of gyration – Y (mm) :	9.7
Principal moments along X–Y (mm⁴) :	49580.4 along [0.1 1.0]
Principal moments along Y–X (mm⁴) :	414249.6 along [−1.0 0.1]
Elastic Modulus – Zx (mm³):	I / y–max= 9943.6
Elastic Modulus – Zy (mm³):	J / x–max= 2652.8

S03 --- ALUMINIUM ADAPTER | COATING --- PVF2 COATING

GRADE --- 6063 T6

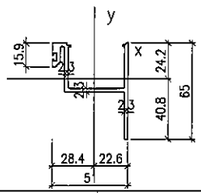

MASS PROPERTIES (UNIT)	VALUES
Area (mm²) :	388.6
Perimeter (mm) :	331.4
Bounding Box – X (mm):	−28.4 to 22.6
Bounding Box – Y (mm):	−40.8 to 24.2
Centroid – X (mm) :	0.0
Centroid – Y (mm) :	0.0
Moments of inertia – X (mm⁴) :	104504.4
Moments of inertia – Y (mm⁴) :	154744.3
Product of inertia – XY (mm⁴) :	−71275.1
Radii of gyration – X (mm) :	16.4
Radii of gyration – Y (mm) :	20.0
Principal moments along X–Y (mm⁴) :	54052.2 along [0.8 −0.6]
Principal moments along Y–X (mm⁴) :	205196.5 along [0.6 0.8]
Elastic Modulus – Zx (mm³):	I / y–max= 2563.1
Elastic Modulus – Zy (mm³):	J / x–max= 5440.7

S04 --ALUMINIUM DOOR FRAME | COATING --- PVF2 COATING

GRADE --- 6063 T6

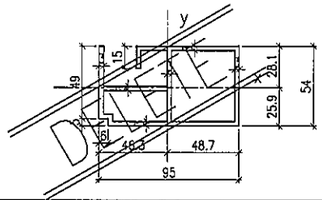

MASS PROPERTIES (UNIT)	VALUES
Area (mm²) :	1098.0
Perimeter (mm) :	732.6
Bounding Box – X (mm):	−46.3 to 48.7
Bounding Box – Y (mm):	−25.9 to 28.1
Centroid – X (mm) :	0.0
Centroid – Y (mm) :	0.0
Moments of inertia – X (mm⁴) :	416878.4
Moments of inertia – Y (mm⁴) :	1054801.2
Product of inertia – XY (mm⁴) :	41128.1
Radii of gyration – X (mm) :	19.5
Radii of gyration – Y (mm) :	31.0
Principal moments along X–Y (mm⁴) :	414237.8 along [1.0 0.1]
Principal moments along Y–X (mm⁴) :	1057441.9 along [−0.1 1.0]
Elastic Modulus – Zx (mm³):	I / y–max= 14840.4
Elastic Modulus – Zy (mm³):	J / x–max= 21644.0

S05 --- ALUMINIUM FRAME | COATING --- PVF2 COATING

GRADE --- 6063 T6

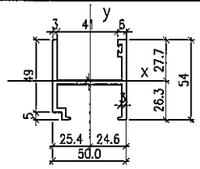

MASS PROPERTIES (UNIT)	VALUES
Area (mm²) :	504.5
Perimeter (mm) :	348.1
Bounding Box – X (mm):	−25.4 to 24.6
Bounding Box – Y (mm):	−26.3 to 27.7
Centroid – X (mm) :	0.0
Centroid – Y (mm) :	0.0
Moments of inertia – X (mm⁴) :	102891.8
Moments of inertia – Y (mm⁴) :	215062.9
Product of inertia – XY (mm⁴) :	−13391.3
Radii of gyration – X (mm) :	14.3
Radii of gyration – Y (mm) :	20.6
Principal moments along X–Y (mm⁴) :	101315.2 along [1.0 0.1]
Principal moments along Y–X (mm⁴) :	216639.4 along [−0.1 1.0]
Elastic Modulus – Zx (mm³):	I / y–max= 3711.5
Elastic Modulus – Zy (mm³):	J / x–max= 8464.2

S06 --- ALUMINIUM ADAPTER | COATING --- PVF2 COATING

GRADE --- 6063 T6

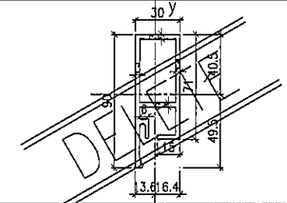

MASS PROPERTIES (UNIT)	VALUES
Area (mm²) :	707.2
Perimeter (mm) :	480.2
Bounding Box – X (mm):	−13.6 to 16.4
Bounding Box – Y (mm):	−49.5 to 40.5
Centroid – X (mm) :	0.0
Centroid – Y (mm) :	0.0
Moments of inertia – X (mm⁴) :	459441.1
Moments of inertia – Y (mm⁴) :	99079.8
Product of inertia – XY (mm⁴) :	35988.4
Radii of gyration – X (mm) :	25.5
Radii of gyration – Y (mm) :	11.8
Principal moments along X–Y (mm⁴) :	463000.0 along [−1.0 0.1]
Principal moments along Y–X (mm⁴) :	95520.9 along [0.1 1.0]
Elastic Modulus – Zx (mm³):	I / y–max= 9285.8
Elastic Modulus – Zy (mm³):	J / x–max= 6046.4

S07 --- ALUMINIUM ADAPTER | COATING --- PVF2 COATING

GRADE --- 6063 T6

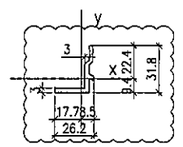

MASS PROPERTIES (UNIT)	VALUES
Area (mm²) :	156.3
Perimeter (mm) :	116.4
Bounding Box – X (mm):	−17.7 to 8.5
Bounding Box – Y (mm):	−9.4 to 22.4
Centroid – X (mm) :	0.0
Centroid – Y (mm) :	0.0
Moments of inertia – X (mm⁴) :	13005.1
Moments of inertia – Y (mm⁴) :	8019.9
Product of inertia – XY (mm⁴) :	6587.5
Radii of gyration – X (mm) :	9.1
Radii of gyration – Y (mm) :	7.2
Principal moments along X–Y (mm⁴) :	3469.2 along [0.6 0.8]
Principal moments along Y–X (mm⁴) :	17555.8 along [−0.8 0.6]
Elastic Modulus – Zx (mm³):	I / y–max= 581.5
Elastic Modulus – Zy (mm³):	J / x–max= 452.9

S08 --- ALUMINIUM ADAPTER | COATING --- PVF2 COATING

GRADE --- 6063 T6

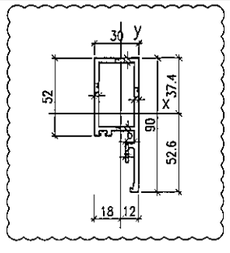

MASS PROPERTIES (UNIT)	VALUES
Area (mm²) :	630.7
Perimeter (mm) :	425.0
Bounding Box – X (mm):	−18.0 to 12.0
Bounding Box – Y (mm):	−52.6 to 37.4
Centroid – X (mm) :	0.0
Centroid – Y (mm) :	0.0
Moments of inertia – X (mm⁴) :	403620.5
Moments of inertia – Y (mm⁴) :	83564.6
Product of inertia – XY (mm⁴) :	−63394.8
Radii of gyration – X (mm) :	25.3
Radii of gyration – Y (mm) :	11.5
Principal moments along X–Y (mm⁴) :	71465.2 along [0.2 −1.0]
Principal moments along Y–X (mm⁴) :	415720.0 along [1.0 0.2]
Elastic Modulus – Zx (mm³):	I / y–max= 7676.3
Elastic Modulus – Zy (mm³):	J / x–max= 4647.2

S09 --- ALUMINIUM CAP | COATING --- PVF2 COATING

GRADE --- 6063 T5

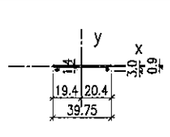

MASS PROPERTIES (UNIT)	VALUES
Area (mm²) :	61.3
Perimeter (mm) :	92.7
Bounding Box – X (mm):	−19.4 to 20.4
Bounding Box – Y (mm):	−3.0 to 0.9
Centroid – X (mm) :	0.0
Centroid – Y (mm) :	0.0
Moments of inertia – X (mm⁴) :	38.4
Moments of inertia – Y (mm⁴) :	8823.5
Product of inertia – XY (mm⁴) :	42.8
Radii of gyration – X (mm) :	0.8
Radii of gyration – Y (mm) :	12.0
Principal moments along X–Y (mm⁴) :	38.2 along [1.0 0.0]
Principal moments along Y–X (mm⁴) :	8823.7 along [0.0 1.0]
Elastic Modulus – Zx (mm³):	I / y–max= 12.9
Elastic Modulus – Zy (mm³):	J / x–max= 432.8

S10--- ALUMINIUM ADAPTER | COATING --- N/A FINISHED

GRADE --- 6063 T6

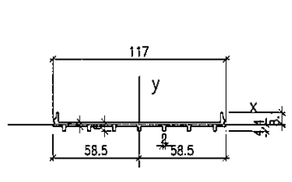

MASS PROPERTIES (UNIT)	VALUES
Area (mm²) :	415.1
Perimeter (mm) :	301.1
Bounding Box – X (mm):	−58.5 to 58.5
Bounding Box – Y (mm):	−4.4 to 8.1
Centroid – X (mm) :	0.0
Centroid – Y (mm) :	0.0
Moments of inertia – X (mm⁴) :	1191.9
Moments of inertia – Y (mm⁴) :	517216.1
Product of inertia – XY (mm⁴) :	0.0
Radii of gyration – X (mm) :	1.7
Radii of gyration – Y (mm) :	35.3
Principal moments along X–Y (mm⁴) :	1191.9 along [1.0 0.0]
Principal moments along Y–X (mm⁴) :	517216.1 along [0.0 1.0]
Elastic Modulus – Zx (mm³):	I / y–max= 148.0
Elastic Modulus – Zy (mm³):	J / x–max= 8841.3

S11--- ALUMINIUM CHANNEL | COATING --- PVF2 COATING

GRADE --- 6063 T6

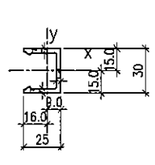

MASS PROPERTIES (UNIT)	VALUES
Area (mm²) :	224.8
Perimeter (mm) :	154.0
Bounding Box – X (mm):	−16.0 to 9.0
Bounding Box – Y (mm):	−15.0 to 15.0
Centroid – X (mm) :	0.0
Centroid – Y (mm) :	0.0
Moments of inertia – X (mm⁴) :	31228.0
Moments of inertia – Y (mm⁴) :	13928.5
Product of inertia – XY (mm⁴) :	0.0
Radii of gyration – X (mm) :	11.8
Radii of gyration – Y (mm) :	7.9
Principal moments along X–Y (mm⁴) :	31228.0 along [1.0 0.0]
Principal moments along Y–X (mm⁴) :	13928.5 along [0.0 1.0]
Elastic Modulus – Zx (mm³):	I / y–max= 2081.9
Elastic Modulus – Zy (mm³):	J / x–max= 871.6

S12 --- ALUMINIUM ADAPTER | COATING --- PVF2 COATING

GRADE --- 6063 T6

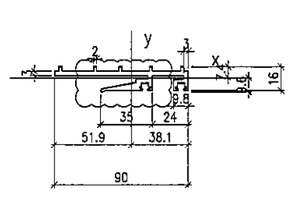

MASS PROPERTIES (UNIT)	VALUES
Area (mm²) :	500.8
Perimeter (mm) :	364.3
Bounding Box – X (mm):	−51.9 to 38.1
Bounding Box – Y (mm):	−9.6 to 7.4
Centroid – X (mm) :	0.0
Centroid – Y (mm) :	0.0
Moments of inertia – X (mm⁴) :	9631.4
Moments of inertia – Y (mm⁴) :	298985.8
Product of inertia – XY (mm⁴) :	−11984.1
Radii of gyration – X (mm) :	4.4
Radii of gyration – Y (mm) :	24.4
Principal moments along X–Y (mm⁴) :	9135.9 along [1.0 0.0]
Principal moments along Y–X (mm⁴) :	299481.3 along [0.0 1.0]
Elastic Modulus – Zx (mm³):	I / y–max= 1004.5
Elastic Modulus – Zy (mm³):	J / x–max= 5755.3

B.D. REF :

CLIENT :
信和置業有限公司
Sino Land Company Limited

ARCHITECT :
WONG TUNG & PARTNERS LIMITED
ARCHITECTS & PLANNERS

MAIN CONTRACTOR :
CR Construction Company Limited

STRUCTURAL ENGINEER :
AECOM

FACADE CONSULTANT:
AECOM

NOTE :
1. ALL DIMENSIONS ARE IN mm.
2. ALL ELEVATIONS ARE VIEWED FROM OUTSIDE.
3. ALL DIMENSIONS TO BE VERIFIED ON SITE BEFORE FABRICATION.

LEGEND :
- X1 / <001 — DETAIL MARK NO. / REFER SHEET NO.
1. F.F.L. --FINISHED FLOOR LEVEL
2. S.F.L. --STRUCTURAL FLOOR LEVEL
3. (P) --REVERSED DETAIL

NO.	DATE	REVISED	BY
C	22/12/2018	GENERAL REVISED	
B	25/11/2018	GENERAL REVISED	
A	10/9/2018	GENERAL REVISED	

JOB NO. : J–837

PROJECT :
URA KWUN TONG TOWN CENTRE REDEVELOPMENT (AREA 2 & 3) AT NKIL 6514, KWUN TONG, KWLOON

TITLE :
TYPICAL MULLION DETAIL FOR CURTAIN WALL

DATE : 13–JUL–18 | SCALE : 1:2 (A1)

DRAWN BY : ASING | CHECKED BY : –

美特鋁質有限公司
MIDI ALUMINIUM FABRICATOR LTD.
Units 6–8, Sunray Industrial Centre, 1/F
610 Cha Kwo Ling Road, Kowloon
Tel:23489211–4 Fax:(852)27727666

DWG NO. : J837–CW–ML03 | REV. : C

S13 --- ALUMINIUM FRAME / COATING --- PVF2 COATING

GRADE --- 6063 T6

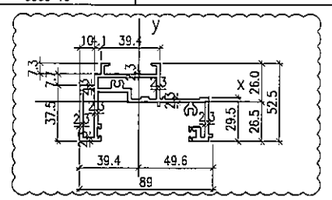
y
x
10.1
39.4
7.3
7.1
2.3
2.3
2.3
2.3
2.3
2.3
37.5
2.3
2.3
2.3
2.3
2.3
2.3

AB01--- ALUMINIUM BRACKET | COATING --- N/A FINISHED

GRADE --- 6061 T6

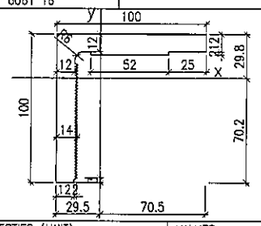

MASS PROPERTIES (UNIT)	VALUES
Area (mm2) :	2465.2
Perimeter (mm) :	464.1
Bounding Box - X (mm):	-29.5 to 70.5
Bounding Box - Y (mm):	-70.2 to 29.8
Centroid - X (mm) :	0.0
Centroid - Y (mm) :	0.0
Moments of inertia - X (mm4) :	2263878.7
Moments of inertia - Y (mm4) :	2192677.8
Product of inertia - XY (mm4) :	1315331.7
Radii of gyration - X (mm) :	30.3
Radii of gyration - Y (mm) :	29.8
Principal moments along X-Y (mm4) :	912464.8 along [0.7 0.7]
Principal moments along Y-X (mm4) :	3544091.7 along [-0.7 0.7]
Elastic Modulus - Zx (mm3):	I / y-max= 32262.0
Elastic Modulus - Zy (mm3):	J / x-max= 31110.8

AB2--- ALUM. SERRATE PLATE | COATING --- N/A FINISHED

GRADE --- 6061 T6

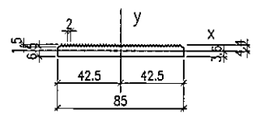

MASS PROPERTIES (UNIT)	VALUES
Area (mm2) :	613.6
Perimeter (mm) :	248.0
Bounding Box - X (mm):	-42.5 to 42.5
Bounding Box - Y (mm):	-3.6 to 4.4
Centroid - X (mm) :	0.0
Centroid - Y (mm) :	0.0
Moments of inertia - X (mm4) :	2728.1
Moments of inertia - Y (mm4) :	366334.2
Product of inertia - XY (mm4) :	0.0
Radii of gyration - X (mm) :	2.1
Radii of gyration - Y (mm) :	24.4
Principal moments along X-Y (mm4) :	2728.1 along [1.0 0.0]
Principal moments along Y-X (mm4) :	366334.2 along [0.0 1.0]
Elastic Modulus - Zx (mm3):	I / y-max= 623.4
Elastic Modulus - Zy (mm3):	J / x-max= 8619.6

AB4--- ALUM. ANGLE BRACKET | COATING --- N/A FINISHED

GRADE --- 6061 T6

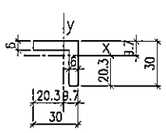

MASS PROPERTIES (UNIT)	VALUES
Area (mm2) :	324.0
Perimeter (mm) :	120.0
Bounding Box - X (mm):	-20.3 to 9.7
Bounding Box - Y (mm):	-20.3 to 9.7
Centroid - X (mm) :	0.0
Centroid - Y (mm) :	0.0
Moments of inertia - X (mm4) :	25452.0
Moments of inertia - Y (mm4) :	25452.0
Product of inertia - XY (mm4) :	-14400.0
Radii of gyration - X (mm) :	8.9
Radii of gyration - Y (mm) :	8.9
Principal moments along X-Y (mm4) :	11052.0 along [0.7 -0.7]
Principal moments along Y-X (mm4) :	39852.0 along [0.7 0.7]
Elastic Modulus - Zx (mm3):	I / y-max= 1251.7
Elastic Modulus - Zy (mm3):	J / x-max= 1251.7

AB5--- ALUM. ANGLE BRACKET | COATING --- N/A FINISHED

GRADE --- 6061 T6

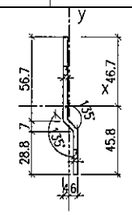

MASS PROPERTIES (UNIT)	VALUES
Area (mm2) :	324.0
Perimeter (mm) :	120.0
Bounding Box - X (mm):	-20.3 to 9.7
Bounding Box - Y (mm):	-20.3 to 9.7
Centroid - X (mm) :	0.0
Centroid - Y (mm) :	0.0
Moments of inertia - X (mm4) :	25452.0
Moments of inertia - Y (mm4) :	25452.0
Product of inertia - XY (mm4) :	-14400.0
Radii of gyration - X (mm) :	8.9
Radii of gyration - Y (mm) :	8.9
Principal moments along X-Y (mm4) :	11052.0 along [0.7 -0.7]
Principal moments along Y-X (mm4) :	39852.0 along [0.7 0.7]
Elastic Modulus - Zx (mm3):	I / y-max= 1251.7
Elastic Modulus - Zy (mm3):	J / x-max= 1251.7

AB6---ALUM. SERRATE WASHER | COATING --- N/A FINISHED

GRADE --- 6061 T6

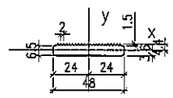

MASS PROPERTIES (UNIT)	VALUES
Area (mm2) :	343.7
Perimeter (mm) :	143.2
Bounding Box - X (mm):	-24.0 to 24.0
Bounding Box - Y (mm):	-3.6 to 4.4
Centroid - X (mm) :	0.0
Centroid - Y (mm) :	0.0
Moments of inertia - X (mm4) :	1509.7
Moments of inertia - Y (mm4) :	64737.2
Product of inertia - XY (mm4) :	0.0
Radii of gyration - X (mm) :	2.1
Radii of gyration - Y (mm) :	13.7
Principal moments along X-Y (mm4) :	1509.7 along [1.0 0.0]
Principal moments along Y-X (mm4) :	64737.2 along [0.0 1.0]
Elastic Modulus - Zx (mm3):	I / y-max= 344.2
Elastic Modulus - Zy (mm3):	J / x-max= 2697.4

AB7--- ALUM. ANGLE BRACKET | COATING --- N/A FINISHED

GRADE --- 6063 T5

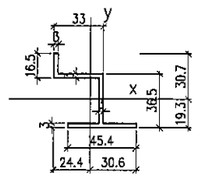

MASS PROPERTIES (UNIT)	VALUES
Area (mm2) :	367.2
Perimeter (mm) :	250.8
Bounding Box - X (mm):	-24.4 to 30.6
Bounding Box - Y (mm):	-19.3 to 30.7
Centroid - X (mm) :	0.0
Centroid - Y (mm) :	0.0
Moments of inertia - X (mm4) :	98770.4
Moments of inertia - Y (mm4) :	73005.2
Product of inertia - XY (mm4) :	-54327.9
Radii of gyration - X (mm) :	16.4
Radii of gyration - Y (mm) :	14.1
Principal moments along X-Y (mm4) :	30053.4 along [0.6 -0.8]
Principal moments along Y-X (mm4) :	141722.2 along [0.8 0.6]
Elastic Modulus - Zx (mm3):	I / y-max= 3218.4
Elastic Modulus - Zy (mm3):	J / x-max= 2389.2

AB8--- ALUMINIUM SLEEVE | COATING --- PVF2 COATING

GRADE --- 6061 T6

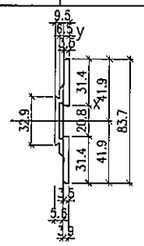

MASS PROPERTIES (UNIT)	VALUES
Area (mm2) :	383.3
Perimeter (mm) :	203.7
Bounding Box - X (mm):	-5.6 to 3.9
Bounding Box - Y (mm):	-41.9 to 41.9
Centroid - X (mm) :	0.0
Centroid - Y (mm) :	0.0
Moments of inertia - X (mm4) :	196853.9
Moments of inertia - Y (mm4) :	3047.6
Product of inertia - XY (mm4) :	0.1
Radii of gyration - X (mm) :	22.7
Radii of gyration - Y (mm) :	2.8
Principal moments along X-Y (mm4) :	3047.6 along [0.0 1.0]
Principal moments along Y-X (mm4) :	196853.9 along [-1.0 0.0]
Elastic Modulus - Zx (mm3):	I / y-max= 4703.4
Elastic Modulus - Zy (mm3):	J / x-max= 541.3

S23 --- ALUMINIUM CAPPING | COATING --- PVF2 COATING

GRADE --- 6063 T6

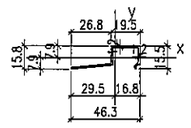

MASS PROPERTIES (UNIT)	VALUES
Area (mm2) :	81.3
Perimeter (mm) :	148.9
Bounding Box - X (mm):	-29.5 to 16.8
Bounding Box - Y (mm):	-7.9 to 7.9
Centroid - X (mm) :	0.0
Centroid - Y (mm) :	0.0
Moments of inertia - X (mm4) :	2714.0
Moments of inertia - Y (mm4) :	15005.0
Product of inertia - XY (mm4) :	3830.9
Radii of gyration - X (mm) :	5.8
Radii of gyration - Y (mm) :	13.6
Principal moments along X-Y (mm4) :	1617.7 along [1.0 0.3]
Principal moments along Y-X (mm4) :	16101.3 along [-0.3 1.0]
Elastic Modulus - Zx (mm3):	I / y-max= 342.4
Elastic Modulus - Zy (mm3):	J / x-max= 509.3

S24 --- ALUMINIUM CAPPING | COATING --- PVF2 COATING

GRADE --- 6063 T6

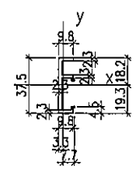

MASS PROPERTIES (UNIT)	VALUES
Area (mm2) :	144.4
Perimeter (mm) :	136.7
Bounding Box - X (mm):	-3.3 to 7.7
Bounding Box - Y (mm):	-19.3 to 18.2
Centroid - X (mm) :	0.0
Centroid - Y (mm) :	0.0
Moments of inertia - X (mm4) :	22312.0
Moments of inertia - Y (mm4) :	1332.5
Product of inertia - XY (mm4) :	106.1
Radii of gyration - X (mm) :	12.4
Radii of gyration - Y (mm) :	3.0
Principal moments along X-Y (mm4) :	1332.0 along [0.0 1.0]
Principal moments along Y-X (mm4) :	22312.5 along [-1.0 0.0]
Elastic Modulus - Zx (mm3):	I / y-max= 1157.9
Elastic Modulus - Zy (mm3):	J / x-max= 173.8

S25 --- ALUMINIUM FRAME | COATING --- PVF2 COATING

GRADE --- 6063 T6

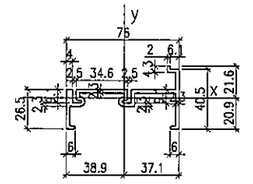

MASS PROPERTIES (UNIT)	VALUES
Area (mm2) :	450.0
Perimeter (mm) :	383.5
Bounding Box - X (mm):	-38.9 to 37.1
Bounding Box - Y (mm):	-20.9 to 21.6
Centroid - X (mm) :	0.0
Centroid - Y (mm) :	0.0
Moments of inertia - X (mm4) :	35329.1
Moments of inertia - Y (mm4) :	358824.1
Product of inertia - XY (mm4) :	29243.1
Radii of gyration - X (mm) :	8.9
Radii of gyration - Y (mm) :	28.2
Principal moments along X-Y (mm4) :	32706.9 along [1.0 0.1]
Principal moments along Y-X (mm4) :	361446.3 along [-0.1 1.0]
Elastic Modulus - Zx (mm3):	I / y-max= 1638.8
Elastic Modulus - Zy (mm3):	J / x-max= 9229.1

S26 --- ALUMINIUM FRAME | COATING --- PVF2 COATING

GRADE --- 6063 T6

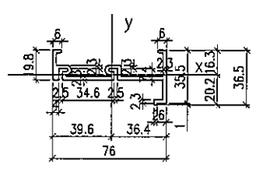

MASS PROPERTIES (UNIT)	VALUES
Area (mm2) :	407.4
Perimeter (mm) :	350.1
Bounding Box - X (mm):	-39.6 to 36.4
Bounding Box - Y (mm):	-20.2 to 16.3
Centroid - X (mm) :	0.0
Centroid - Y (mm) :	0.0
Moments of inertia - X (mm4) :	22371.1
Moments of inertia - Y (mm4) :	312330.4
Product of inertia - XY (mm4) :	-28556.2
Radii of gyration - X (mm) :	7.4
Radii of gyration - Y (mm) :	27.7
Principal moments along X-Y (mm4) :	19585.5 along [1.0 -0.1]
Principal moments along Y-X (mm4) :	315115.9 along [0.1 1.0]
Elastic Modulus - Zx (mm3):	I / y-max= 1105.2
Elastic Modulus - Zy (mm3):	J / x-max= 7877.7

A18 --- ALUM. WINDOW SASH | COATING --- PVF2 COATING

GRADE --- 6063 T6

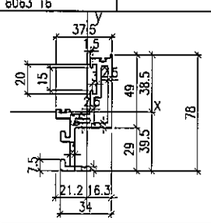

MASS PROPERTIES (UNIT)	VALUES
Area (mm2) :	620.5
Perimeter (mm) :	426.1
Bounding Box - X (mm):	-21.2 to 16.3
Bounding Box - Y (mm):	-39.5 to 38.5
Centroid - X (mm) :	0.0
Centroid - Y (mm) :	0.0
Moments of inertia - X (mm4) :	253671.5
Moments of inertia - Y (mm4) :	79636.7
Product of inertia - XY (mm4) :	97243.8
Radii of gyration - X (mm) :	20.2
Radii of gyration - Y (mm) :	11.3
Principal moments along X-Y (mm4) :	36161.2 along [0.4 0.9]
Principal moments along Y-X (mm4) :	297146.9 along [-0.9 0.4]
Elastic Modulus - Zx (mm3):	I / y-max= 6424.1
Elastic Modulus - Zy (mm3):	J / x-max= 3756.7

F06 --ALUMINIUM FRAME | COATING --- PVF2 COATING

GRADE --- 6063 T6

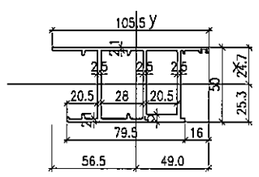

MASS PROPERTIES (UNIT)	VALUES
Area (mm2) :	817.9
Perimeter (mm) :	667.2
Bounding Box - X (mm):	-56.5 to 49.0
Bounding Box - Y (mm):	-25.3 to 24.7
Centroid - X (mm) :	0.0
Centroid - Y (mm) :	0.0
Moments of inertia - X (mm4) :	321201.0
Moments of inertia - Y (mm4) :	510627.5
Product of inertia - XY (mm4) :	-14435.7
Radii of gyration - X (mm) :	19.8
Radii of gyration - Y (mm) :	25.0
Principal moments along X-Y (mm4) :	321002.0 along [1.0 -0.1]
Principal moments along Y-X (mm4) :	511726.5 along [0.1 1.0]
Elastic Modulus - Zx (mm3):	I / y-max= 12746.6
Elastic Modulus - Zy (mm3):	J / x-max= 9032.0

S27 --- ALUMINIUM BAR | COATING --- PVF2 COATING

GRADE --- 6061 T6

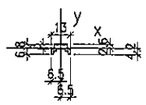

MASS PROPERTIES (UNIT)	VALUES
Area (mm2) :	43.6
Perimeter (mm) :	44.8
Bounding Box - X (mm):	-6.5 to 6.5
Bounding Box - Y (mm):	-4.2 to 2.6
Centroid - X (mm) :	0.0
Centroid - Y (mm) :	0.0
Moments of inertia - X (mm4) :	127.3
Moments of inertia - Y (mm4) :	631.4
Product of inertia - XY (mm4) :	0.0
Radii of gyration - X (mm) :	1.7
Radii of gyration - Y (mm) :	3.8
Principal moments along X-Y (mm4) :	127.3 along [1.0 0.0]
Principal moments along Y-X (mm4) :	631.4 along [0.0 1.0]
Elastic Modulus - Zx (mm3):	I / y-max= 30.6
Elastic Modulus - Zy (mm3):	J / x-max= 97.1

A21 --- ALUMINIUM CAP | COATING --- PVF2 COATING

GRADE --- 6061 T6

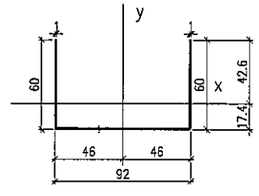

MASS PROPERTIES (UNIT)	VALUES
Area (mm2) :	209.6
Perimeter (mm) :	421.1
Bounding Box - X (mm):	-46.0 to 46.0
Bounding Box - Y (mm):	-17.4 to 42.6
Centroid - X (mm) :	0.0
Centroid - Y (mm) :	0.0
Moments of inertia - X (mm4) :	80636.9
Moments of inertia - Y (mm4) :	308290.6
Product of inertia - XY (mm4) :	0.0
Radii of gyration - X (mm) :	19.6
Radii of gyration - Y (mm) :	38.4
Principal moments along X-Y (mm4) :	80636.9 along [1.0 0.0]
Principal moments along Y-X (mm4) :	308290.6 along [0.0 1.0]
Elastic Modulus - Zx (mm3):	I / y-max= 1892.5
Elastic Modulus - Zy (mm3):	J / x-max= 6702.0

B.D. REF :

CLIENT :
信和置業有限公司
Sino Land Company Limited

ARCHITECT :
WONG TUNG & PARTNERS LIMITED
ARCHITECTS & PLANNERS

MAIN CONTRACTOR :
CR Construction Company Limited

STRUCTURAL ENGINEER :
AECOM

FACADE CONSULTANT:
AECOM

NOTE :
1. ALL DIMENSIONS ARE IN mm.
2. ALL ELEVATIONS ARE VIEWED FROM OUTSIDE.
3. ALL DIMENSIONS TO BE VERIFIED ON SITE BEFORE FABRICATION.

LEGEND :
- (X1 / XD01) — DETAIL MARK NO. / REFER SHEET NO.
1. F.F.L. --FINISHED FLOOR LEVEL
2. S.F.L. --STRUCTURAL FLOOR LEVEL
3. (/R) --REVERSED DETAIL

NO.	DATE	REVISED	BY
C	28/01/2019	GENERAL REVISED	
B	22/12/2018	GENERAL REVISED	
A	25/11/2018	GENERAL REVISED	

JOB NO. : J-837

PROJECT :
URA KWUN TONG TOWN CENTRE REDEVELOPMENT (AREA 2 & 3) AT NKIL 6514, KWUN TONG, KWLOON

TITLE :
TYPICAL MULLION DETAIL FOR CURTAIN WALL

DATE : 10-SEP-18 | SCALE : 1:2 (A1)

DRAWN BY : ASING | CHECKED BY : -

美特鋁質有限公司
MIDI ALUMINIUM FABRICATOR LTD.
Units 6-8, Sunray Industrial Centre, 1/F
610 Cha Kwo Ling Road, Kowloon
Tel:23489211-4 Fax:(852)27727666

DWG NO. : J837-CW-ML05 | REV. : C

Z01--- ALUMINIUM FRAME | COATING --- PVF2 COATING

GRADE --- 6063 T5

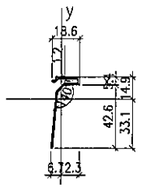

MASS PROPERTIES (UNIT)	VALUES
Area (mm²) :	83.0
Perimeter (mm) :	158.4
Bounding Box – X (mm):	-6.7 to 12.3
Bounding Box – Y (mm):	-33.1 to 14.9
Centroid – X (mm) :	0.0
Centroid – Y (mm) :	0.0
Moments of inertia – X (mm⁴) :	18694.5
Moments of inertia – Y (mm⁴) :	2804.5
Product of inertia – XY (mm⁴) :	5057.0
Radii of gyration – X (mm) :	15.0
Radii of gyration – Y (mm) :	5.8
Principal moments along X–Y (mm⁴) :	1331.7 along [0.3 1.0]
Principal moments along Y–X (mm⁴) :	20167.4 along [-1.0 0.3]
Elastic Modulus – Zx (mm³):	I / y-max= 565.0
Elastic Modulus – Zy (mm³):	J / x-max= 228.7

Z02 --ALUMINIUM DOOR FRAME | COATING --- PVF2 COATING

GRADE --- 6063 T6

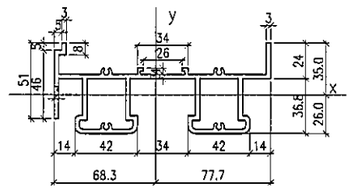

MASS PROPERTIES (UNIT)	VALUES
Area (mm²) :	1436.0
Perimeter (mm) :	980.1
Bounding Box – X (mm):	-68.3 to 77.7
Bounding Box – Y (mm):	-26.0 to 35.0
Centroid – X (mm) :	0.0
Centroid – Y (mm) :	0.0
Moments of inertia – X (mm⁴) :	399402.5
Moments of inertia – Y (mm⁴) :	3096515.2
Product of inertia – XY (mm⁴) :	-11940.5
Radii of gyration – X (mm) :	16.7
Radii of gyration – Y (mm) :	46.4
Principal moments along X–Y (mm⁴) :	399349.7 along [1.0 0.0]
Principal moments along Y–X (mm⁴) :	3096568.0 along [0.0 1.0]
Elastic Modulus – Zx (mm³):	I / y-max= 11411.5
Elastic Modulus – Zy (mm³):	J / x-max= 39859.3

Z03--- ALUMINIUM FRAME | COATING --- PVF2 COATING

GRADE --- 6063 T6

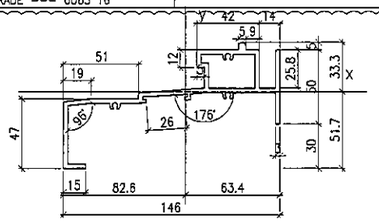

MASS PROPERTIES (UNIT)	VALUES
Area (mm²) :	1110.0
Perimeter (mm) :	753.1
Bounding Box – X (mm):	-82.6 to 63.4
Bounding Box – Y (mm):	-51.7 to 33.3
Centroid – X (mm) :	0.0
Centroid – Y (mm) :	0.0
Moments of inertia – X (mm⁴) :	425129.7
Moments of inertia – Y (mm⁴) :	2771143.0
Product of inertia – XY (mm⁴) :	738703.4
Radii of gyration – X (mm) :	19.6
Radii of gyration – Y (mm) :	50.0
Principal moments along X–Y (mm⁴) :	211908.6 along [1.0 0.3]
Principal moments along Y–X (mm⁴) :	2984364.0 along [-0.3 1.0]
Elastic Modulus – Zx (mm³):	I / y-max= 8219.1
Elastic Modulus – Zy (mm³):	J / x-max= 33563.8

Z04 --- ALUMINIUM ADAPTER | COATING --- PVF2 COATING

GRADE --- 6063 T6

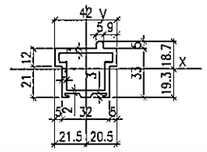

MASS PROPERTIES (UNIT)	VALUES
Area (mm²) :	433.1
Perimeter (mm) :	298.0
Bounding Box – X (mm):	-21.5 to 20.5
Bounding Box – Y (mm):	-19.3 to 18.7
Centroid – X (mm) :	0.0
Centroid – Y (mm) :	0.0
Moments of inertia – X (mm⁴) :	61303.9
Moments of inertia – Y (mm⁴) :	77707.7
Product of inertia – XY (mm⁴) :	3385.8
Radii of gyration – X (mm) :	11.9
Radii of gyration – Y (mm) :	13.4
Principal moments along X–Y (mm⁴) :	60632.5 along [1.0 0.2]
Principal moments along Y–X (mm⁴) :	78379.0 along [-0.2 1.0]
Elastic Modulus – Zx (mm³):	I / y-max= 3176.8
Elastic Modulus – Zy (mm³):	J / x-max= 3616.1

Z05 --- ALUMINIUM ADAPTER | COATING --- PVF2 COATING

GRADE --- 6063 T6

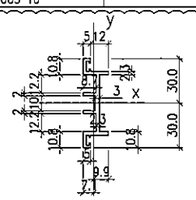

MASS PROPERTIES (UNIT)	VALUES
Area (mm²) :	256.9
Perimeter (mm) :	240.2
Bounding Box – X (mm):	-7.1 to 9.9
Bounding Box – Y (mm):	-30.0 to 30.0
Centroid – X (mm) :	0.0
Centroid – Y (mm) :	0.0
Moments of inertia – X (mm⁴) :	78744.2
Moments of inertia – Y (mm⁴) :	4673.4
Product of inertia – XY (mm⁴) :	0.0
Radii of gyration – X (mm) :	17.5
Radii of gyration – Y (mm) :	4.3
Principal moments along X–Y (mm⁴) :	4673.4 along [0.0 1.0]
Principal moments along Y–X (mm⁴) :	78744.2 along [-1.0 0.0]
Elastic Modulus – Zx (mm³):	I / y-max= 2624.8
Elastic Modulus – Zy (mm³):	J / x-max= 473.8

Z06 ---ALUMINIUM DOOR SASH | COATING --- PVF2 COATING

GRADE --- 6063 T6

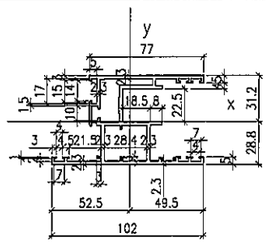

MASS PROPERTIES (UNIT)	VALUES
Area (mm²) :	890.7
Perimeter (mm) :	852.4
Bounding Box – X (mm):	-52.5 to 49.5
Bounding Box – Y (mm):	-28.8 to 31.2
Centroid – X (mm) :	0.0
Centroid – Y (mm) :	0.0
Moments of inertia – X (mm⁴) :	472857.2
Moments of inertia – Y (mm⁴) :	489265.1
Product of inertia – XY (mm⁴) :	70558.1
Radii of gyration – X (mm) :	23.0
Radii of gyration – Y (mm) :	23.4
Principal moments along X–Y (mm⁴) :	410027.7 along [0.7 0.7]
Principal moments along Y–X (mm⁴) :	552094.6 along [-0.7 0.7]
Elastic Modulus – Zx (mm³):	I / y-max= 9326.3
Elastic Modulus – Zy (mm³):	J / x-max= 15166.8

Z07 --- ALUMINIUM ADAPTER | COATING --- PVF2 COATING

GRADE --- 6063 T6

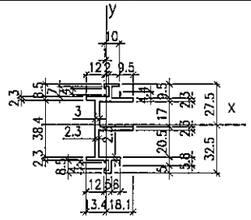

MASS PROPERTIES (UNIT)	VALUES
Area (mm²) :	351.0
Perimeter (mm) :	317.8
Bounding Box – X (mm):	-13.4 to 18.1
Bounding Box – Y (mm):	-32.5 to 27.5
Centroid – X (mm) :	0.0
Centroid – Y (mm) :	0.0
Moments of inertia – X (mm⁴) :	108319.6
Moments of inertia – Y (mm⁴) :	18552.3
Product of inertia – XY (mm⁴) :	6061.8
Radii of gyration – X (mm) :	17.6
Radii of gyration – Y (mm) :	7.3
Principal moments along X–Y (mm⁴) :	18144.8 along [0.1 1.0]
Principal moments along Y–X (mm⁴) :	108727.1 along [-1.0 0.1]
Elastic Modulus – Zx (mm³):	I / y-max= 3332.4
Elastic Modulus – Zy (mm³):	J / x-max= 1025.6

Z08--- ALUMINIUM ADAPTER | COATING --- PVF2 COATING

GRADE --- 6063 T6

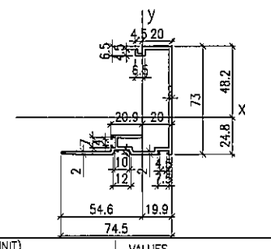

MASS PROPERTIES (UNIT)	VALUES
Area (mm²) :	410.1
Perimeter (mm) :	433.0
Bounding Box – X (mm):	-54.6 to 19.9
Bounding Box – Y (mm):	-24.8 to 48.2
Centroid – X (mm) :	0.0
Centroid – Y (mm) :	0.0
Moments of inertia – X (mm⁴) :	295765.9
Moments of inertia – Y (mm⁴) :	166387.4
Product of inertia – XY (mm⁴) :	111909.6
Radii of gyration – X (mm) :	26.9
Radii of gyration – Y (mm) :	20.1
Principal moments along X–Y (mm⁴) :	101815.4 along [0.5 0.9]
Principal moments along Y–X (mm⁴) :	360337.9 along [-0.9 0.5]
Elastic Modulus – Zx (mm³):	I / y-max= 6134.4
Elastic Modulus – Zy (mm³):	J / x-max= 3044.7

Z09--- ALUMINIUM FRAME | COATING --- N/A FINISHED

GRADE --- 6063 T5

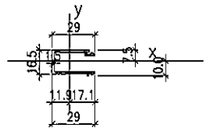

MASS PROPERTIES (UNIT)	VALUES
Area (mm²) :	101.9
Perimeter (mm) :	158.6
Bounding Box – X (mm):	-11.9 to 17.1
Bounding Box – Y (mm):	-10.0 to 7.5
Centroid – X (mm) :	0.0
Centroid – Y (mm) :	0.0
Moments of inertia – X (mm⁴) :	4520.6
Moments of inertia – Y (mm⁴) :	9044.8
Product of inertia – XY (mm⁴) :	185.0
Radii of gyration – X (mm) :	6.7
Radii of gyration – Y (mm) :	9.4
Principal moments along X–Y (mm⁴) :	4513.0 along [1.0 0.0]
Principal moments along Y–X (mm⁴) :	9052.3 along [0.0 1.0]
Elastic Modulus – Zx (mm³):	I / y-max= 453.8
Elastic Modulus – Zy (mm³):	J / x-max= 529.5

Z10---ALUMINIUM FRAME | COATING --- PVF2 COATING

GRADE --- 6063 T6

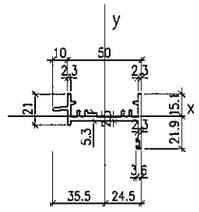

MASS PROPERTIES (UNIT)	VALUES
Area (mm²) :	331.5
Perimeter (mm) :	279.7
Bounding Box – X (mm):	-35.5 to 24.5
Bounding Box – Y (mm):	-21.9 to 15.1
Centroid – X (mm) :	0.0
Centroid – Y (mm) :	0.0
Moments of inertia – X (mm⁴) :	15939.6
Moments of inertia – Y (mm⁴) :	127742.4
Product of inertia – XY (mm⁴) :	-15797.0
Radii of gyration – X (mm) :	6.9
Radii of gyration – Y (mm) :	19.6
Principal moments along X–Y (mm⁴) :	13750.5 along [1.0 -0.1]
Principal moments along Y–X (mm⁴) :	129931.5 along [0.1 1.0]
Elastic Modulus – Zx (mm³):	I / y-max= 726.8
Elastic Modulus – Zy (mm³):	J / x-max= 3596.6

Z11 --- ALUMINIUM FRAME | COATING --- PVF2 COATING

GRADE --- 6063 T6

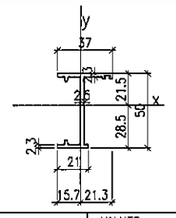

MASS PROPERTIES (UNIT)	VALUES
Area (mm²) :	259.2
Perimeter (mm) :	229.7
Bounding Box – X (mm):	-15.7 to 21.3
Bounding Box – Y (mm):	-28.5 to 21.5
Centroid – X (mm) :	0.0
Centroid – Y (mm) :	0.0
Moments of inertia – X (mm⁴) :	97631.2
Moments of inertia – Y (mm⁴) :	15103.8
Product of inertia – XY (mm⁴) :	12020.3
Radii of gyration – X (mm) :	19.4
Radii of gyration – Y (mm) :	7.6
Principal moments along X–Y (mm⁴) :	13388.6 along [0.1 1.0]
Principal moments along Y–X (mm⁴) :	99346.3 along [-1.0 0.1]
Elastic Modulus – Zx (mm³):	I / y-max= 3425.4
Elastic Modulus – Zy (mm³):	J / x-max= 710.7

Z12 --- ALUMINIUM FRAME | COATING --- PVF2 COATING

GRADE --- 6063 T6

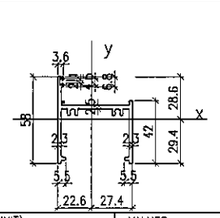

MASS PROPERTIES (UNIT)	VALUES
Area (mm²) :	392.4
Perimeter (mm) :	348.4
Bounding Box – X (mm):	-22.6 to 27.4
Bounding Box – Y (mm):	-29.4 to 28.6
Centroid – X (mm) :	0.0
Centroid – Y (mm) :	0.0
Moments of inertia – X (mm⁴) :	76284.5
Moments of inertia – Y (mm⁴) :	162456.9
Product of inertia – XY (mm⁴) :	-19283.7
Radii of gyration – X (mm) :	13.9
Radii of gyration – Y (mm) :	20.3
Principal moments along X–Y (mm⁴) :	72166.1 along [1.0 -0.2]
Principal moments along Y–X (mm⁴) :	166575.3 along [0.2 1.0]
Elastic Modulus – Zx (mm³):	I / y-max= 2593.9
Elastic Modulus – Zy (mm³):	J / x-max= 5922.4

Z13 --- ALUMINIUM FRAME | COATING --- N/A FINISHED

GRADE --- 6063 T6

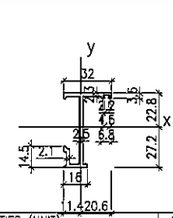

MASS PROPERTIES (UNIT)	VALUES
Area (mm²) :	254.0
Perimeter (mm) :	227.3
Bounding Box – X (mm):	-11.4 to 20.6
Bounding Box – Y (mm):	-27.2 to 22.8
Centroid – X (mm) :	0.0
Centroid – Y (mm) :	0.0
Moments of inertia – X (mm⁴) :	89284.3
Moments of inertia – Y (mm⁴) :	11809.4
Product of inertia – XY (mm⁴) :	14236.2
Radii of gyration – X (mm) :	18.7
Radii of gyration – Y (mm) :	6.8
Principal moments along X–Y (mm⁴) :	9276.3 along [0.2 1.0]
Principal moments along Y–X (mm⁴) :	91817.5 along [-1.0 0.2]
Elastic Modulus – Zx (mm³):	I / y-max= 3282.4
Elastic Modulus – Zy (mm³):	J / x-max= 574.3

Z14 ---- ALUMINIUM FRAME | COATING --- PVF2 COATING

GRADE ---- 6063 T5

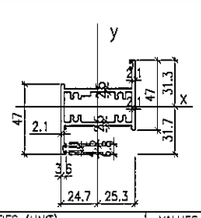

MASS PROPERTIES (UNIT)	VALUES
Area (mm²) :	517.8
Perimeter (mm) :	453.5
Bounding Box – X (mm):	-24.7 to 25.3
Bounding Box – Y (mm):	-31.7 to 31.3
Centroid – X (mm) :	0.0
Centroid – Y (mm) :	0.0
Moments of inertia – X (mm⁴) :	88026.5
Moments of inertia – Y (mm⁴) :	173305.3
Product of inertia – XY (mm⁴) :	39895.2
Radii of gyration – X (mm) :	13.0
Radii of gyration – Y (mm) :	18.3
Principal moments along X–Y (mm⁴) :	72272.8 along [0.9 0.4]
Principal moments along Y–X (mm⁴) :	189058.9 along [-0.4 0.9]
Elastic Modulus – Zx (mm³):	I / y-max= 2773.7
Elastic Modulus – Zy (mm³):	J / x-max= 6844.5

Z15 ---ALUMINIUM DOOR SASH | COATING --- PVF2 COATING

GRADE --- 6063 T6

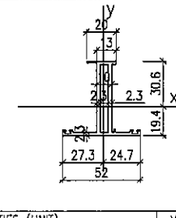

MASS PROPERTIES (UNIT)	VALUES
Area (mm²) :	389.2
Perimeter (mm) :	348.0
Bounding Box – X (mm):	-27.3 to 24.7
Bounding Box – Y (mm):	-19.4 to 30.6
Centroid – X (mm) :	0.0
Centroid – Y (mm) :	0.0
Moments of inertia – X (mm⁴) :	114990.8
Moments of inertia – Y (mm⁴) :	32732.4
Product of inertia – XY (mm⁴) :	3686.7
Radii of gyration – X (mm) :	17.6
Radii of gyration – Y (mm) :	9.4
Principal moments along X–Y (mm⁴) :	32567.5 along [0.0 1.0]
Principal moments along Y–X (mm⁴) :	115155.7 along [-1.0 0.0]
Elastic Modulus – Zx (mm³):	I / y-max= 3758.4
Elastic Modulus – Zy (mm³):	J / x-max= 1197.5

B.D. REF :

CLIENT :
信和置業有限公司
Sino Land Company Limited

ARCHITECT :
WONG TUNG & PARTNERS LIMITED
ARCHITECTS & PLANNERS

MAIN CONTRACTOR :
CR Construction Company Limited

STRUCTURAL ENGINEER :
AECOM

FACADE CONSULTANT:
AECOM

NOTE :
1. ALL DIMENSIONS ARE IN mm.
2. ALL ELEVATIONS ARE VIEWED FROM OUTSIDE.
3. ALL DIMENSIONS TO BE VERIFIED ON SITE BEFORE FABRICATION.

LEGEND :
X1 / X001 — DETAIL MARK NO. / REFER SHEET NO.
1. F.F.L. --FINISHED FLOOR LEVEL
2. S.F.L. --STRUCTURAL FLOOR LEVEL
3. (Y/R) --REVERSED DETAIL

NO.	DATE	REVISED	BY
A	16/07/2019	GENERAL REVISED	

JOB NO. : J-837

PROJECT :
URA KWUN TONG TOWN CENTRE REDEVELOPMENT (AREA 2 & 3) AT NKIL 6514, KWUN TONG, KWLOON

TITLE :
TYPICAL MULLION DETAIL FOR CURTAIN WALL

DATE : 21-FEB-19 | SCALE : 1:2 (A1)

DRAWN BY : ASING | CHECKED BY : --

美特鋁質有限公司
MIDI ALUMINIUM FABRICATOR LTD.
Units 6-8, Sunray Industrial Centre, 1/F
610 Cha Kwo Ling Road, Kowloon
Tel:23489211-4 Fax:(852)27727666

DWG NO. : J837-CW-ML06 | REV. : A

Z16--- ALUMINIUM FRAME	COATING --- PVF2 COATING
GRADE --- 6063 T6	

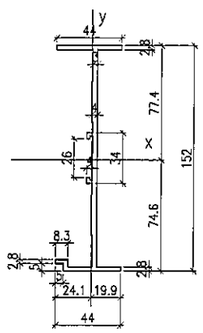

MASS PROPERTIES (UNIT)	VALUES
Area (mm2) :	775.3
Perimeter (mm) :	510.5
Bounding Box - X (mm):	-24.1 to 19.9
Bounding Box - Y (mm):	-74.6 to 77.4
Centroid - X (mm) :	0.0
Centroid - Y (mm) :	0.0
Moments of inertia - X (mm4) :	2290039.9
Moments of inertia - Y (mm4) :	47126.6
Product of inertia - XY (mm4) :	18594.1
Radii of gyration - X (mm) :	54.4
Radii of gyration - Y (mm) :	7.8
Principal moments along X-Y (mm4) :	46972.4 along [0.0 1.0]
Principal moments along Y-X (mm4) :	2290194.0 along [-1.0 0.0]
Elastic Modulus - Zx (mm3):	I / y-max= 29589.3
Elastic Modulus - Zy (mm3):	J / x-max= 1956.3

Z17--- ALUMINIUM FRAME	COATING --- PVF2 COATING
GRADE --- 6063 T6	

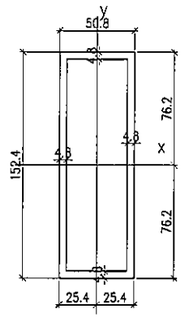

MASS PROPERTIES (UNIT)	VALUES
Area (mm2) :	1851.1
Perimeter (mm) :	773.2
Bounding Box - X (mm):	-25.4 to 25.4
Bounding Box - Y (mm):	-76.2 to 76.2
Centroid - X (mm) :	0.0
Centroid - Y (mm) :	0.0
Moments of inertia - X (mm4) :	4967652.4
Moments of inertia - Y (mm4) :	829940.1
Product of inertia - XY (mm4) :	0.0
Radii of gyration - X (mm) :	51.8
Radii of gyration - Y (mm) :	21.2
Principal moments along X-Y (mm4) :	829940.1 along [0.0 1.0]
Principal moments along Y-X (mm4) :	4967652.4 along [-1.0 0.0]
Elastic Modulus - Zx (mm3):	I / y-max= 65192.3
Elastic Modulus - Zy (mm3):	J / x-max= 32674.8

B.D. REF :

CLIENT :
信和置業有限公司
Sino Land Company Limited

ARCHITECT :
WONG TUNG & PARTNERS LIMITED
ARCHITECTS & PLANNERS

MAIN CONTRACTOR :
CR Construction Company Limited

STRUCTURAL ENGINEER :
AECOM

FACADE CONSULTANT:
AECOM

NOTE :
1. ALL DIMENSIONS ARE IN mm.
2. ALL ELEVATIONS ARE VIEWED FROM OUTSIDE.
3. ALL DIMENSIONS TO BE VERIFIED ON SITE BEFORE FABRICATION.

LEGEND :
- x1 / x001 — DETAIL MARK NO. / REFER SHEET NO.
1. F.F.L. --FINISHED FLOOR LEVEL
2. S.F.L. --STRUCTURAL FLOOR LEVEL
3. (/P) --REVERSED DETAIL

NO.	DATE	REVISED	BY
A	16/07/2019	GENERAL REVISED	

JOB NO. : J-837

PROJECT :
URA KWUN TONG TOWN CENTRE REDEVELOPMENT (AREA 2 & 3) AT NKIL 6514, KWUN TONG, KWLOON

TITLE :
TYPICAL MULLION DETAIL FOR CURTAIN WALL

DATE : 21-FEB-19 | SCALE : 1:2 (A1)

DRAWN BY : ASING | CHECKED BY : -

美特鋁質有限公司
MIDI ALUMINIUM FABRICATOR LTD.
Units 6-8, Sunray Industrial Centre, 1/F
610 Cha Kwo Ling Road, Kowloon
Tel:23489211-4 Fax:(852)27727666

DWG NO. : JB37-CW-ML07 | REV. : A

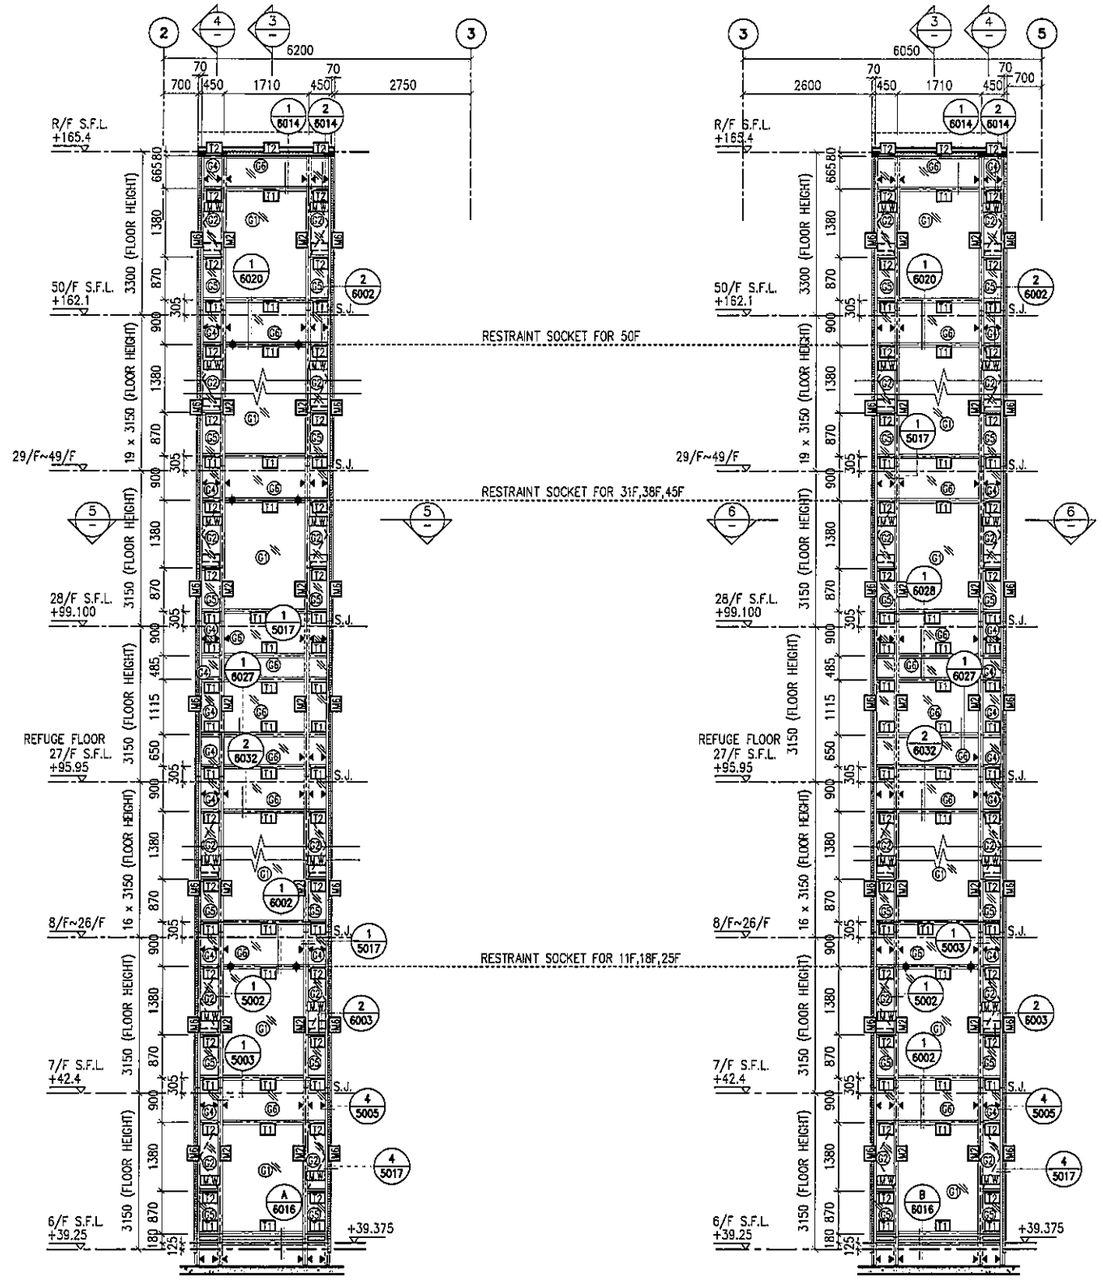

1 / – PART ELEVATION FOR CURTAIN WALL

2 / – PART ELEVATION FOR CURTAIN WALL

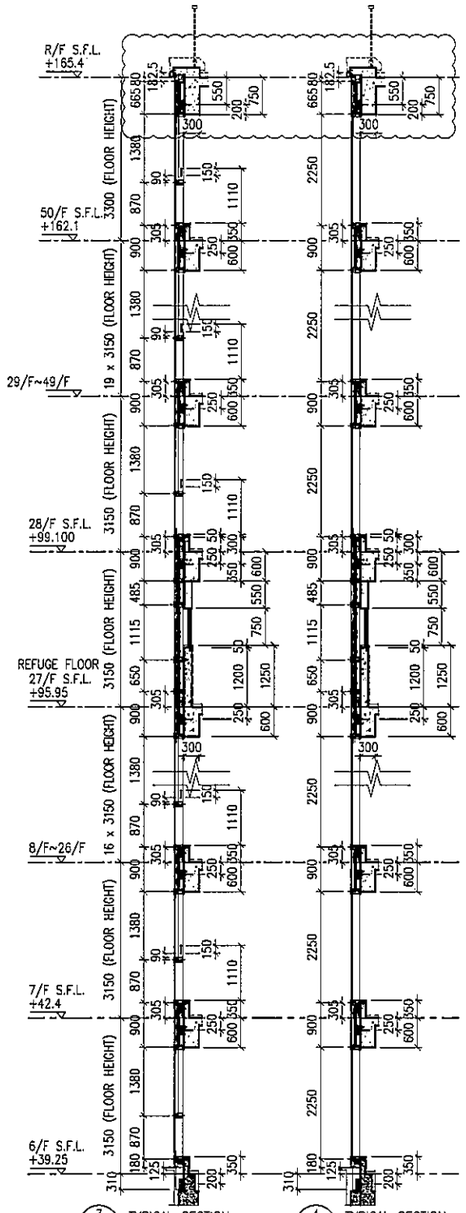

3 / – TYPICAL SECTION FOR CURTAIN WALL

4 / – TYPICAL SECTION FOR CURTAIN WALL

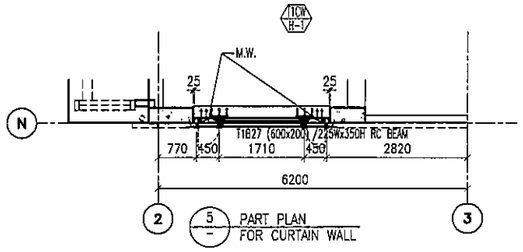

5 / – PART PLAN FOR CURTAIN WALL

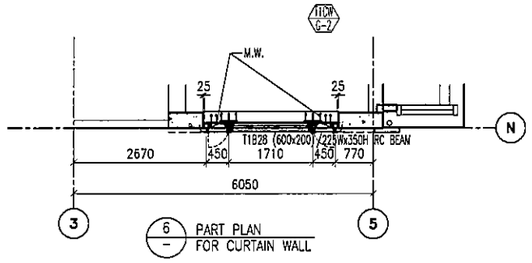

6 / – PART PLAN FOR CURTAIN WALL

LEGEND:

- 10 mm THK. TEMPERED BLUE TINTED GLASS (OUTER) + 9 mm AIR SPACE + 8 mm THK. TEMPERED CLEAR GLASS (INNER)
- 8 mm THK. HEAT STRENGTHENED TINTED GLASS (OUTER)+ 9 mm AIR SPACE + 8 mm THK. HEAT STRENGTHENED CLEAR GLASS (INNER)
- 10 mm THK. HEAT STRENGTHENED BLUE TINTED GLASS (OUTER)+ 9 mm AIR SPACE + 8 mm THK. TEMPERED CLEAR GLASS (INNER)
- 8 mm THK. HEAT STRENGTHENED BLUE TINTED GLASS (SPANDREL GLASS)
- 8 mm THK. HEAT STRENGTHENED BLUE TINTED GLASS (OUTER)+ 9 mm AIR SPACE + 8 mm THK. TEMPERED CLEAR GLASS (INNER)
- 8 mm THK. TEMPERED BLUE TINTED GLASS (SPANDREL GLASS)
- 8 mm THK. HEAT STRENGTHENED TINTED GLASS (OUTER)+ 1.52PVB + 8 mm THK. HEAT STRENGTHENED CLEAR LAMINATED GLASS (INNER)
- 10 mm THK. TEMPERED GLASS (INTERNAL PROTECTIVE BARRIER)
- 3 mm THK. ALUM. CLADDING
- M.W. – MAINTENANCE WINDOW
- S.J. – STACK JOINT
- AF-01 – ALUM. EXTRUSION DIE NO.
- ▲ – SUPPORT POINT
- ◆ – RESTRAINT SOCKET

B.D. REF :

CLIENT :
信和置業有限公司
Sino Land Company Limited

ARCHITECT :
WONG TUNG & PARTNERS LIMITED
ARCHITECTS & PLANNERS

MAIN CONTRACTOR :
CR Construction Company Limited

STRUCTURAL ENGINEER :
AECOM

FACADE CONSULTANT:
AECOM

NOTE :
1. ALL DIMENSIONS ARE IN mm.
2. ALL ELEVATIONS ARE VIEWED FROM OUTSIDE.
3. ALL DIMENSIONS TO BE VERIFIED ON SITE BEFORE FABRICATION.

LEGEND :
X1 / X001 — DETAIL MARK NO. / REFER SHEET NO.
1. F.F.L. – FINISHED FLOOR LEVEL
2. S.F.L. – STRUCTURAL FLOOR LEVEL
3. /R – REVERSED DETAIL

NO.	DATE	REVISED	BY
F	16/07/2019	GENERAL REVISED	
E	17/01/2019	GENERAL REVISED	
D	22/12/2018	GENERAL REVISED	
C	04/12/2018	GENERAL REVISED	
B	24/11/2018	GENERAL REVISED	
A	10/9/2018	GENERAL REVISED	

JOB NO. : J-837

PROJECT :
URA KWUN TONG TOWN CENTRE REDEVELOPMENT (AREA 2 & 3) AT NKIL 6514, KWUN TONG, KWLOON

TITLE :
PART ELEVATION OF CURTAIN WALL AT TOWER 1

DATE : 04-JUL-18 | SCALE : 1:50 (A1)

DRAWN BY : ASING | CHECKED BY : –

美特鋁質有限公司
MIDI ALUMINIUM FABRICATOR LTD.
Units 6-8, Sunray Industrial Centre, 1/F
610 Cha Kwo Ling Road, Kowloon
Tel:23489211-4 Fax:(852)27727666

DWG NO. : J837-CW-2101 | REV. : F

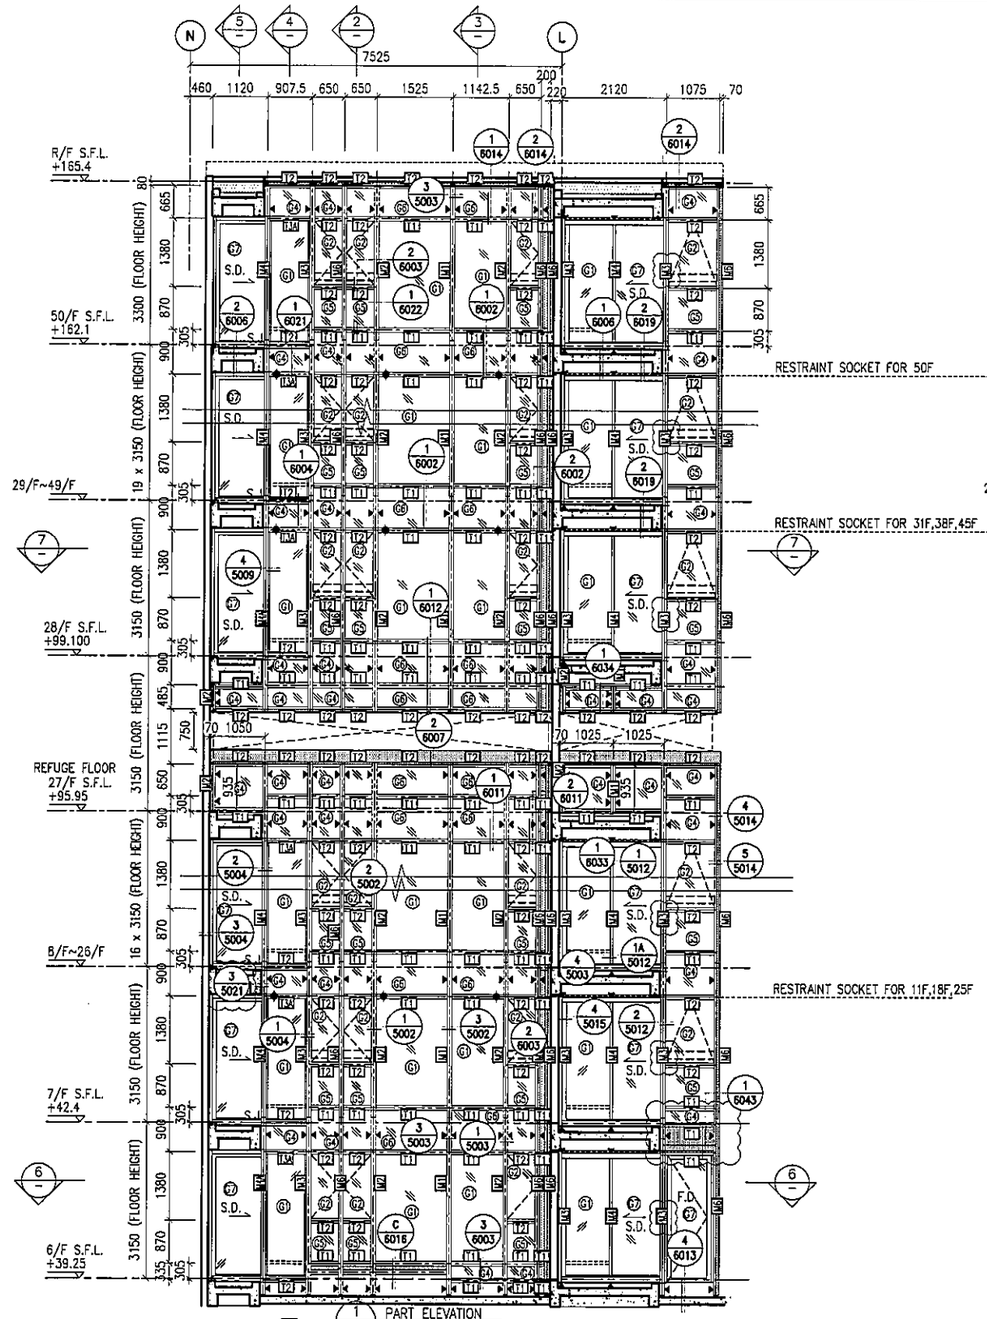

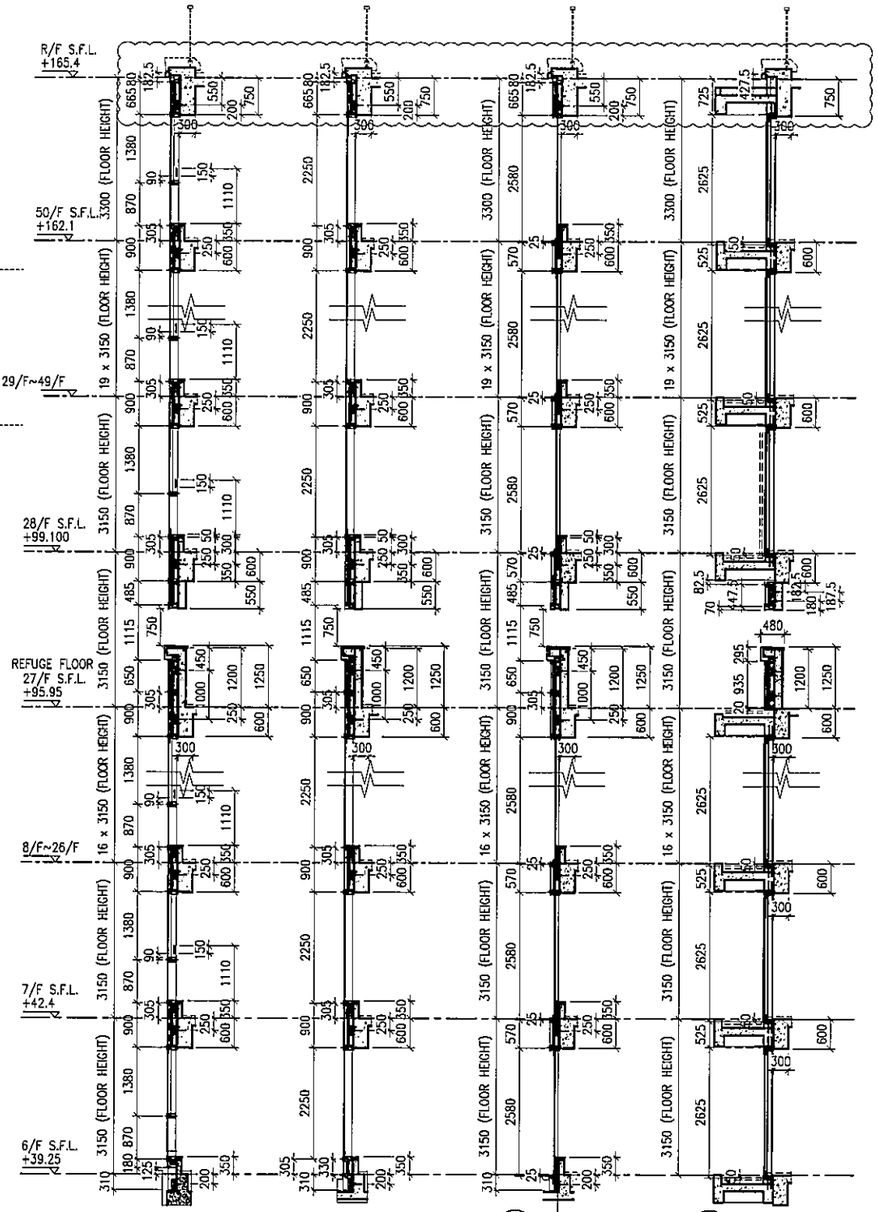

2 TYPICAL SECTION FOR CURTAIN WALL

3 TYPICAL SECTION FOR CURTAIN WALL

4 TYPICAL SECTION FOR CURTAIN WALL

5 TYPICAL SECTION FOR CURTAIN WALL

1 PART ELEVATION FOR CURTAIN WALL

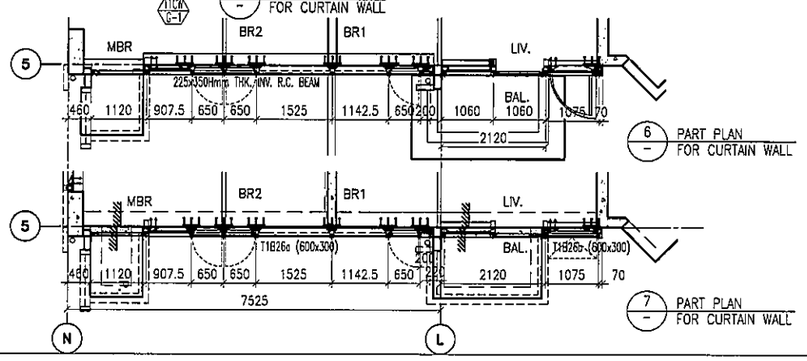

6 PART PLAN FOR CURTAIN WALL

7 PART PLAN FOR CURTAIN WALL

LEGEND:

- 10 mm THK. TEMPERED BLUE TINTED GLASS (OUTER) + 9 mm AIR SPACE + 8 mm THK. TEMPERED CLEAR GLASS (INNER)
- 8 mm THK. HEAT STRENGTHENED TINTED GLASS (OUTER)+ 9 mm AIR SPACE + 8 mm THK. HEAT STRENGTHENED CLEAR GLASS (INNER)
- 10 mm THK. HEAT STRENGTHENED BLUE TINTED GLASS (OUTER)+ 9 mm AIR SPACE + 8 mm THK. TEMPERED CLEAR GLASS (INNER)
- 8 mm THK. HEAT STRENGTHENED BLUE TINTED GLASS (SPANDREL GLASS)
- 8 mm THK. HEAT STRENGTHENED BLUE TINTED GLASS (OUTER)+ 9 mm AIR SPACE + 8 mm THK. TEMPERED CLEAR GLASS (INNER)
- 8 mm THK. TEMPERED BLUE TINTED GLASS (SPANDREL GLASS)
- 8 mm THK. HEAT STRENGTHENED TINTED GLASS (OUTER)+ 1.52PVB + 8 mm THK. HEAT STRENGTHENED CLEAR LAMINATED GLASS (INNER)
- 10 mm THK. TEMPERED GLASS (INTERNAL PROTECTIVE BARRIER)
- 3 mm THK. ALUM. CLADDING
- M.W. – MAINTENANCE WINDOW
- S.J. – STACK JOINT
- AE01 – ALUM. EXTRUSION DIE NO.
- ▲ – SUPPORT POINT
- ✦ – RESTRAINT SOCKET

B.D. REF :

CLIENT :
信和置業有限公司
Sino Land Company Limited

ARCHITECT :
WONG TUNG & PARTNERS LIMITED
ARCHITECTS & PLANNERS

MAIN CONTRACTOR :
CR Construction Company Limited

STRUCTURAL ENGINEER :
AECOM

FACADE CONSULTANT:
AECOM

NOTE :
1. ALL DIMENSIONS ARE IN mm.
2. ALL ELEVATIONS ARE VIEWED FROM OUTSIDE.
3. ALL DIMENSIONS TO BE VERIFIED ON SITE BEFORE FABRICATION.

LEGEND :
- (X1 / XC01) — DETAIL MARK NO. / REFER SHEET NO.
1. F.F.L. --FINISHED FLOOR LEVEL
2. S.F.L. --STRUCTURAL FLOOR LEVEL
3. (/R) --REVERSED DETAIL

NO.	DATE	REVISED	BY
G	16/07/2019	GENERAL REVISED	
F	12/05/2019	GENERAL REVISED	
E	17/01/2019	GENERAL REVISED	
D	22/12/2018	GENERAL REVISED	
C	04/12/2018	GENERAL REVISED	
B	24/11/2018	GENERAL REVISED	
A	10/9/2018	GENERAL REVISED	

JOB NO. : J-837

PROJECT :
URA KWUN TONG TOWN CENTRE REDEVELOPMENT (AREA 2 & 3) AT NKIL 6514, KWUN TONG, KWLOON

TITLE :
PART ELEVATION OF CURTAIN WALL AT TOWER 1

DATE : 04-JUL-18 | SCALE : 1:60 (A1)

DRAWN BY : ASING | CHECKED BY : –

美特鋁質有限公司
MIDI ALUMINIUM FABRICATOR LTD.
Units 6-8, Sunray Industrial Centre, 1/F
610 Cha Kwo Ling Road, Kowloon
Tel:23489211-4 Fax:(852)27727666

DWG NO. : J837-CW-2102 | REV. : G

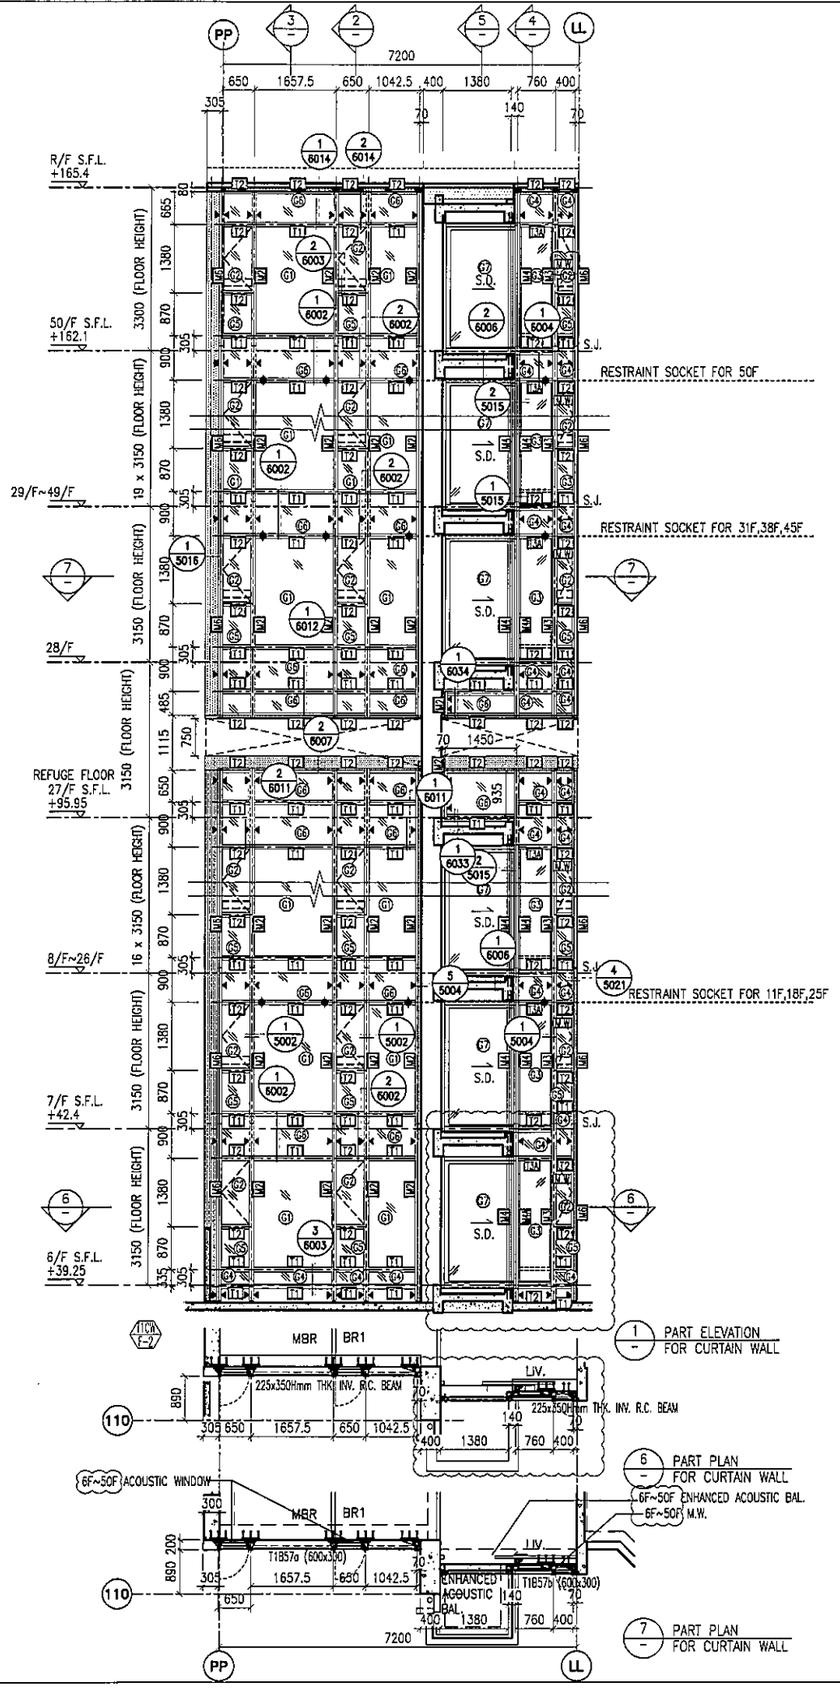

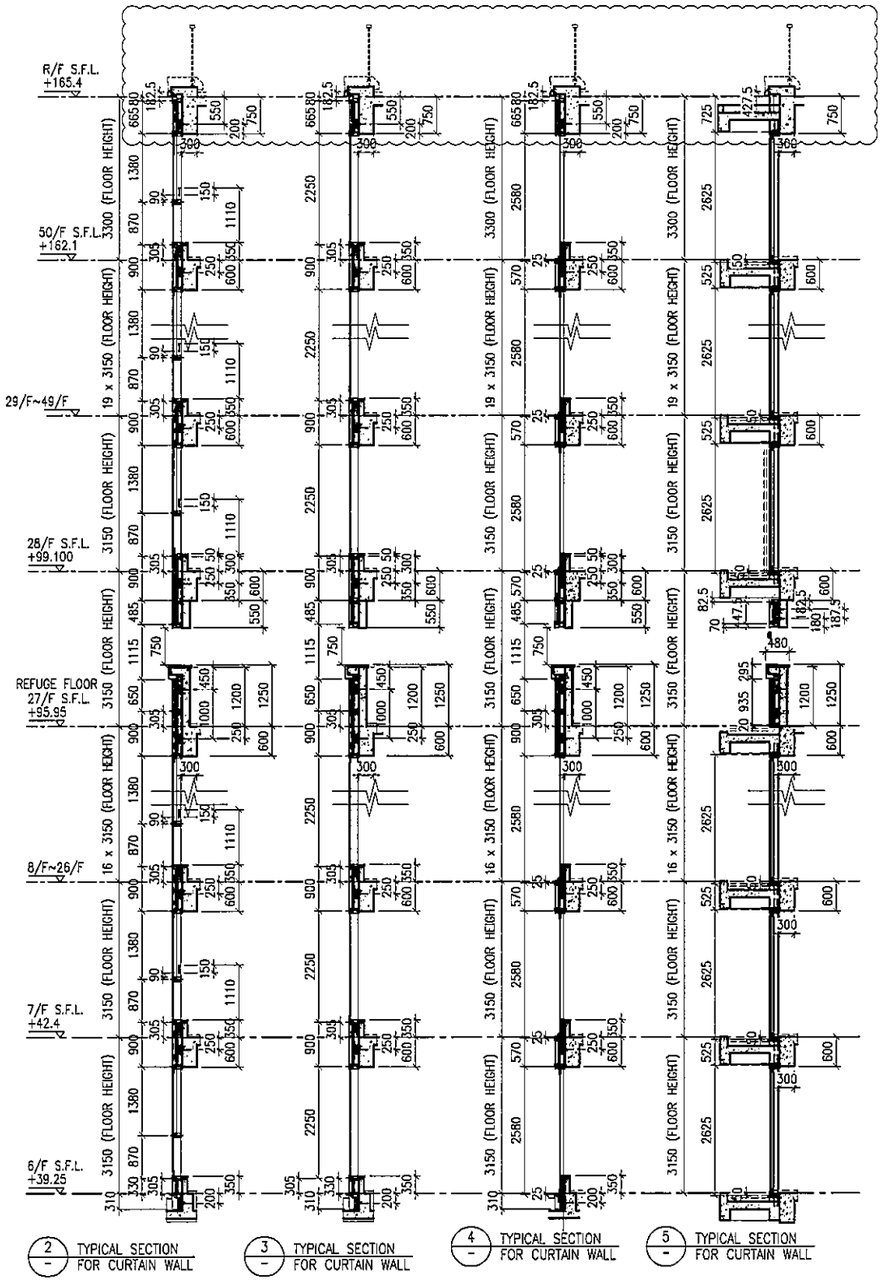

LEGEND:

- 10 mm THK. TEMPERED BLUE TINTED GLASS (OUTER) + 9 mm AIR SPACE + 8 mm THK. TEMPERED CLEAR GLASS (INNER)
- 8 mm THK. HEAT STRENGTHENED TINTED GLASS (OUTER)+ 9 mm AIR SPACE + 8 mm THK. HEAT STRENGTHENED CLEAR GLASS (INNER)
- 10 mm THK. HEAT STRENGTHENED BLUE TINTED GLASS (OUTER)+ 9 mm AIR SPACE + 8 mm THK. TEMPERED CLEAR GLASS (INNER)
- 8 mm THK. HEAT STRENGTHENED BLUE TINTED GLASS (SPANDREL GLASS)
- 8 mm THK. HEAT STRENGTHENED BLUE TINTED GLASS (OUTER)+ 9 mm AIR SPACE + 8 mm THK. TEMPERED CLEAR GLASS (INNER)
- 8 mm THK. TEMPERED BLUE TINTED GLASS (SPANDREL GLASS)
- 8 mm THK. HEAT STRENGTHENED TINTED GLASS (OUTER)+ 1.52PVB + 8 mm THK. HEAT STRENGTHENED CLEAR LAMINATED GLASS (INNER) 10 mm THK. TEMPERED GLASS (INTERNAL PROTECTIVE BARRIER)
- 3 mm THK. ALUM. CLADDING
- M.W. – MAINTENANCE WINDOW
- S.J. – STACK JOINT
- AE01 – ALUM. EXTRUSION DIE NO.
- ▲ – SUPPORT POINT
- ✦ – RESTRAINT SOCKET

B.D. REF :

CLIENT :
信和置業有限公司
Sino Land Company Limited

ARCHITECT : WONG TUNG & PARTNERS LIMITED
ARCHITECTS & PLANNERS

MAIN CONTRACTOR :
CR Construction Company Limited

STRUCTURAL ENGINEER :
AECOM

FACADE CONSULTANT:
AECOM

NOTE :
1. ALL DIMENSIONS ARE IN mm.
2. ALL ELEVATIONS ARE VIEWED FROM OUTSIDE.
3. ALL DIMENSIONS TO BE VERIFIED ON SITE BEFORE FABRICATION.

LEGEND :
X1 / X001 – DETAIL MARK NO. / REFER SHEET NO.
1. F.F.L. --FINISHED FLOOR LEVEL
2. S.F.L. --STRUCTURAL FLOOR LEVEL
3. /R --REVERSED DETAIL

NO.	DATE	REVISED	BY
H	16/07/2019	GENERAL REVISED	
G	26/05/2019	GENERAL REVISED	
F	21/05/2019	GENERAL REVISED	
E	17/01/2019	GENERAL REVISED	
D	22/12/2018	GENERAL REVISED	
C	04/12/2018	GENERAL REVISED	
B	24/11/2018	GENERAL REVISED	
A	10/9/2018	GENERAL REVISED	

JOB NO. : J-837

PROJECT :
URA KWUN TONG TOWN CENTRE REDEVELOPMENT (AREA 2 & 3) AT NKIL 6514, KWUN TONG, KWLOON

TITLE :
PART ELEVATION OF CURTAIN WALL AT TOWER 1

DATE : 04-JUL-18 | SCALE : 1:60 (A1)
DRAWN BY : ASING | CHECKED BY : --

美特鋁質有限公司
MIDI ALUMINIUM FABRICATOR LTD.
Units 6-8, Sunray Industrial Centre, 1/F
610 Cha Kwo Ling Road, Kowloon
Tel:23489211-4 Fax:(852)27727666

DWG NO. : J837-CW-2103 | REV. : H

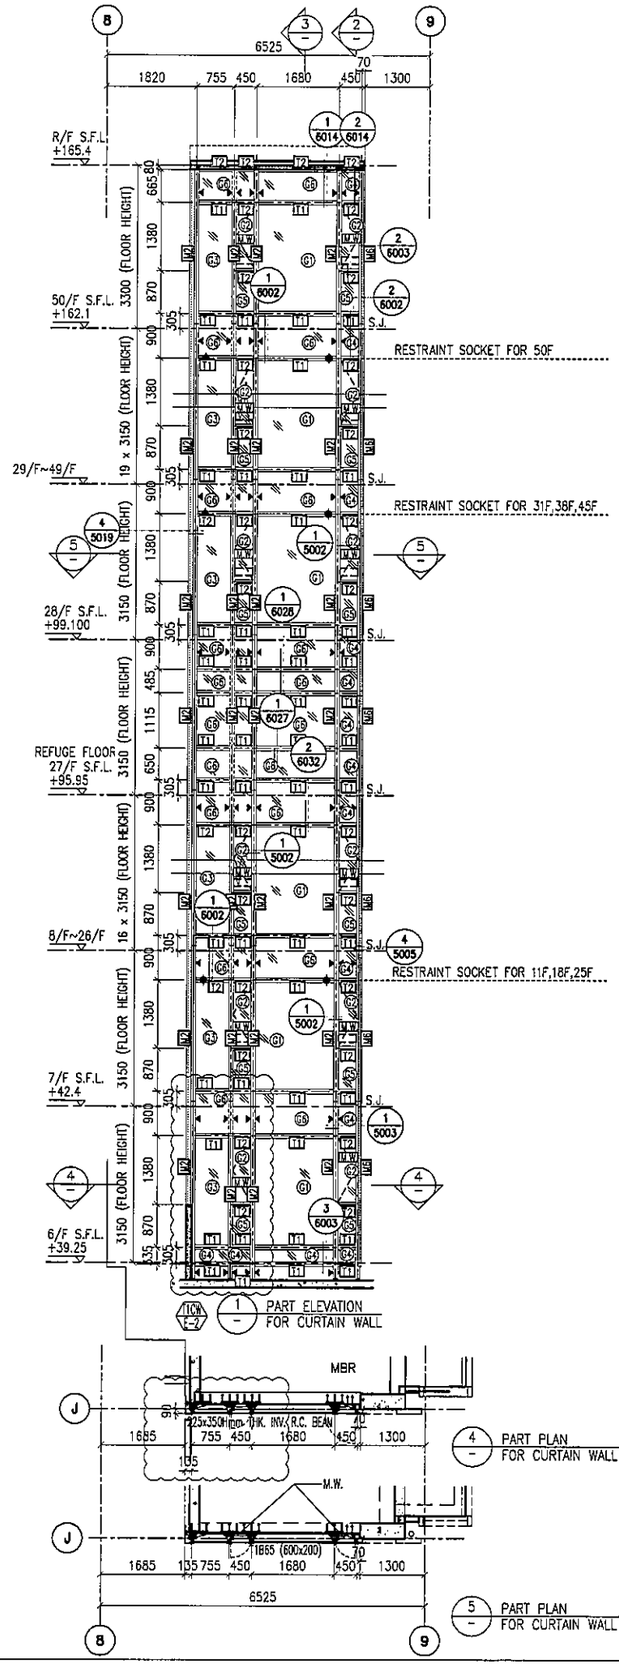

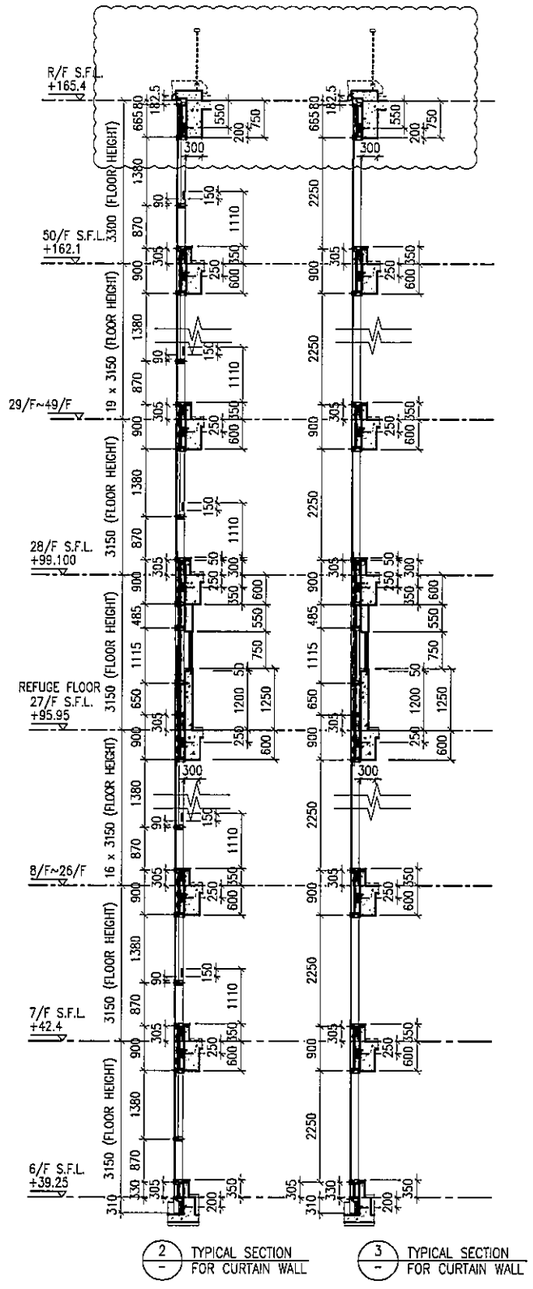

LEGEND:

- G1 – 10 mm THK. TEMPERED BLUE TINTED GLASS (OUTER) + 9 mm AIR SPACE + 8 mm THK. TEMPERED CLEAR GLASS (INNER)
- G2 – 8 mm THK. HEAT STRENGTHENED TINTED GLASS (OUTER)+ 9 mm AIR SPACE + 8 mm THK. HEAT STRENGTHENED CLEAR GLASS (INNER)
- G3 – 10 mm THK. HEAT STRENGTHENED BLUE TINTED GLASS (OUTER)+ 9 mm AIR SPACE + 8 mm THK. TEMPERED CLEAR GLASS (INNER)
- G4 – 8 mm THK. HEAT STRENGTHENED BLUE TINTED GLASS (SPANDREL GLASS)
- G5 – 8 mm THK. HEAT STRENGTHENED BLUE TINTED GLASS (OUTER)+ 9 mm AIR SPACE + 8 mm THK. TEMPERED CLEAR GLASS (INNER)
- G6 – 8 mm THK. TEMPERED BLUE TINTED GLASS (SPANDREL GLASS)
- G7 – 8 mm THK. HEAT STRENGTHENED TINTED GLASS (OUTER)+ 1.52PVB + 8 mm THK. HEAT STRENGTHENED CLEAR LAMINATED GLASS (INNER) 10 mm THK. TEMPERED GLASS (INTERNAL PROTECTIVE BARRIER)
- 3 mm THK. ALUM. CLADDING
- M.W. – MAINTENANCE WINDOW
- S.J. – STACK JOINT
- AE01 – ALUM. EXTRUSION DIE NO.
- ▲ – SUPPORT POINT
- ◆ – RESTRAINT SOCKET

B.D. REF :

CLIENT :
信和置業有限公司
Sino Land Company Limited

ARCHITECT :
WONG TUNG & PARTNERS LIMITED
ARCHITECTS & PLANNERS

MAIN CONTRACTOR :
CR Construction Company Limited

STRUCTURAL ENGINEER :
AECOM

FACADE CONSULTANT:
AECOM

NOTE :
1. ALL DIMENSIONS ARE IN mm.
2. ALL ELEVATIONS ARE VIEWED FROM OUTSIDE.
3. ALL DIMENSIONS TO BE VERIFIED ON SITE BEFORE FABRICATION.

LEGEND :
X1 / X001 — DETAIL MARK NO. / REFER SHEET NO.
1. F.F.L. --FINISHED FLOOR LEVEL
2. S.F.L. --STRUCTURAL FLOOR LEVEL
3. (R) --REVERSED DETAIL

NO.	DATE	REVISED	BY
G	16/07/2019	GENERAL REVISED	
F	19/05/2019	GENERAL REVISED	
E	17/01/2019	GENERAL REVISED	
D	22/12/2018	GENERAL REVISED	
C	04/12/2018	GENERAL REVISED	
B	24/11/2018	GENERAL REVISED	
A	10/9/2018	GENERAL REVISED	

JOB NO. : J-837

PROJECT :
URA KWUN TONG TOWN CENTRE REDEVELOPMENT (AREA 2 & 3) AT NKIL 6514, KWUN TONG, KWLOON

TITLE :
PART ELEVATION OF CURTAIN WALL AT TOWER 1

DATE : 04-JUL-18 | SCALE : 1:60 (A1)

DRAWN BY : ASING | CHECKED BY : –

美特鋁質有限公司
MIDI ALUMINIUM FABRICATOR LTD.
Units 6-8, Sunray Industrial Centre, 1/F
610 Cha Kwo Ling Road, Kowloon
Tel:23489211-4 Fax:(852)27727666

DWG NO. : J837-CW-2104 | REV. : G

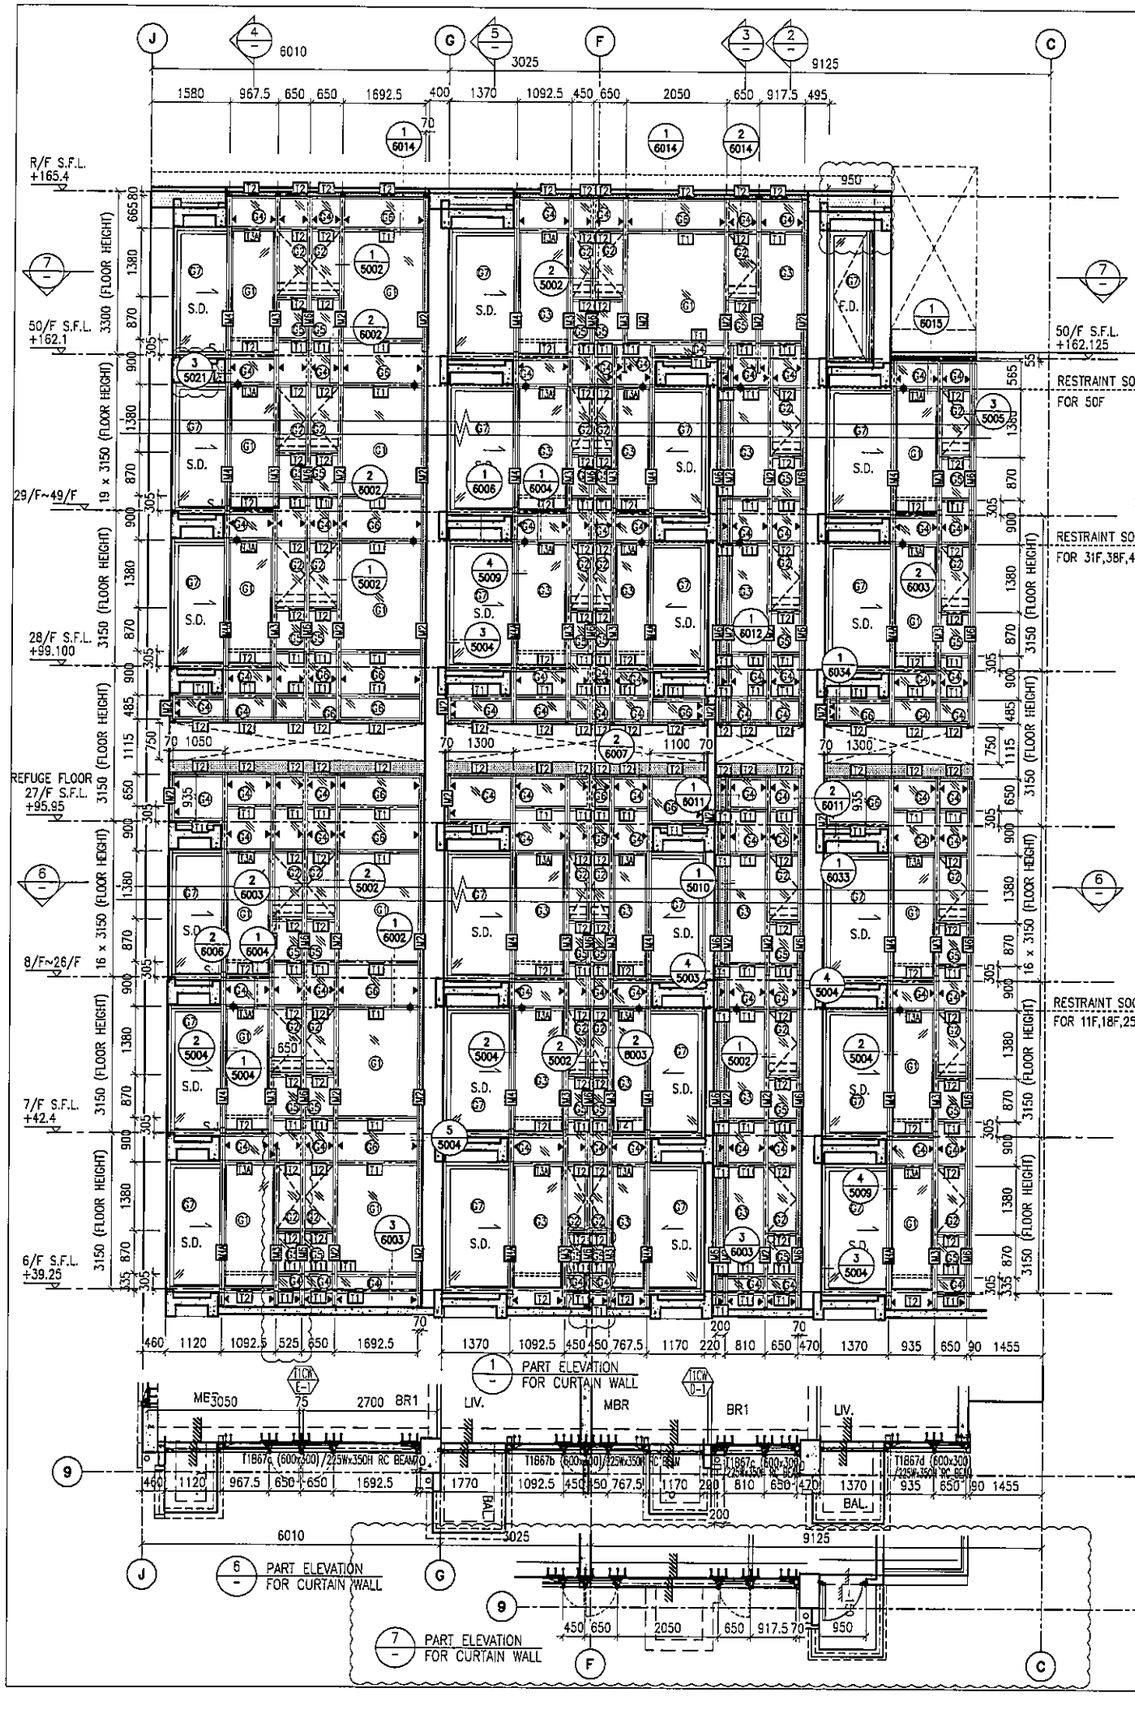

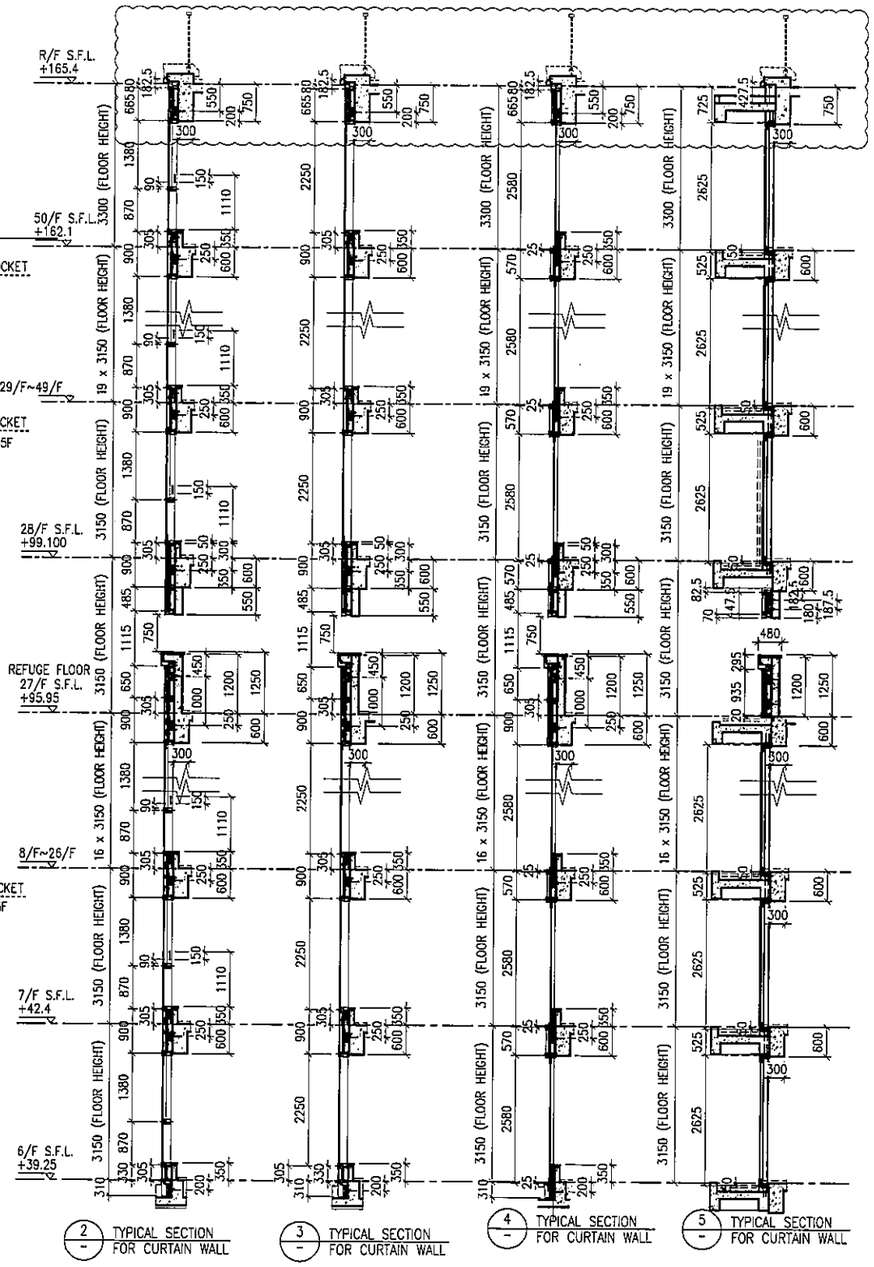

LEGEND:

- G1 – 10 mm THK. TEMPERED BLUE TINTED GLASS (OUTER) + 9 mm AIR SPACE + 8 mm THK. TEMPERED CLEAR GLASS (INNER)
- G2 – 8 mm THK. HEAT STRENGTHENED TINTED GLASS (OUTER)+ 9 mm AIR SPACE + 8 mm THK. HEAT STRENGTHENED CLEAR GLASS (INNER)
- G3 – 10 mm THK. HEAT STRENGTHENED BLUE TINTED GLASS (OUTER)+ 9 mm AIR SPACE + 8 mm THK. TEMPERED CLEAR GLASS (INNER)
- G4 – 8 mm THK. HEAT STRENGTHENED BLUE TINTED GLASS (SPANDREL GLASS)
- G5 – 8 mm THK. HEAT STRENGTHENED BLUE TINTED GLASS (OUTER)+ 9 mm AIR SPACE + 8 mm THK. TEMPERED CLEAR GLASS (INNER)
- G6 – 8 mm THK. TEMPERED BLUE TINTED GLASS (SPANDREL GLASS)
- G7 – 8 mm THK. HEAT STRENGTHENED TINTED GLASS (OUTER)+ 1.52PVB + 8 mm THK. HEAT STRENGTHENED CLEAR LAMINATED GLASS (INNER)
- 10 mm THK. TEMPERED GLASS (INTERNAL PROTECTIVE BARRIER)
- 3 mm THK. ALUM. CLADDING
- M.W. – MAINTENANCE WINDOW
- S.J. – STACK JOINT
- AE01 – ALUM. EXTRUSION DIE NO.
- ▲ – SUPPORT POINT
- ◆ – RESTRAINT SOCKET

B.D. REF :

CLIENT :
信和置業有限公司
Sino Land Company Limited

ARCHITECT :
WONG TUNG & PARTNERS LIMITED
ARCHITECTS & PLANNERS

MAIN CONTRACTOR :
CR Construction Company Limited

STRUCTURAL ENGINEER :
AECOM

FACADE CONSULTANT:
AECOM

NOTE :
1. ALL DIMENSIONS ARE IN mm.
2. ALL ELEVATIONS ARE VIEWED FROM OUTSIDE.
3. ALL DIMENSIONS TO BE VERIFIED ON SITE BEFORE FABRICATION.

LEGEND :
X1 — DETAIL MARK NO.
X001 — REFER SHEET NO.

1. F.F.L. --FINISHED FLOOR LEVEL
2. S.F.L. --STRUCTURAL FLOOR LEVEL
3. (R) --REVERSED DETAIL

NO.	DATE	REVISED	BY
G	16/07/2019	GENERAL REVISED	
F	26/05/2019	GENERAL REVISED	
E	17/01/2019	GENERAL REVISED	
D	22/12/2018	GENERAL REVISED	
C	04/12/2018	GENERAL REVISED	
B	24/11/2018	GENERAL REVISED	
A	10/9/2018	GENERAL REVISED	

JOB NO. : J-837

PROJECT :
URA KWUN TONG TOWN CENTRE REDEVELOPMENT (AREA 2 & 3) AT NKIL 6514, KWUN TONG, KWLOON

TITLE :
PART ELEVATION OF CURTAIN WALL AT TOWER 1

DATE : 04-JUL-18 | SCALE : 1:60 (A1)

DRAWN BY : ASING | CHECKED BY : –

美特鋁質有限公司
MIDI ALUMINIUM FABRICATOR LTD.
Units 6-8, Sunray Industrial Centre, 1/F
610 Cha Kwo Ling Road, Kowloon
Tel:23489211-4 Fax:(852)27727666

DWG NO. : J837-CW-2105 | REV. : G

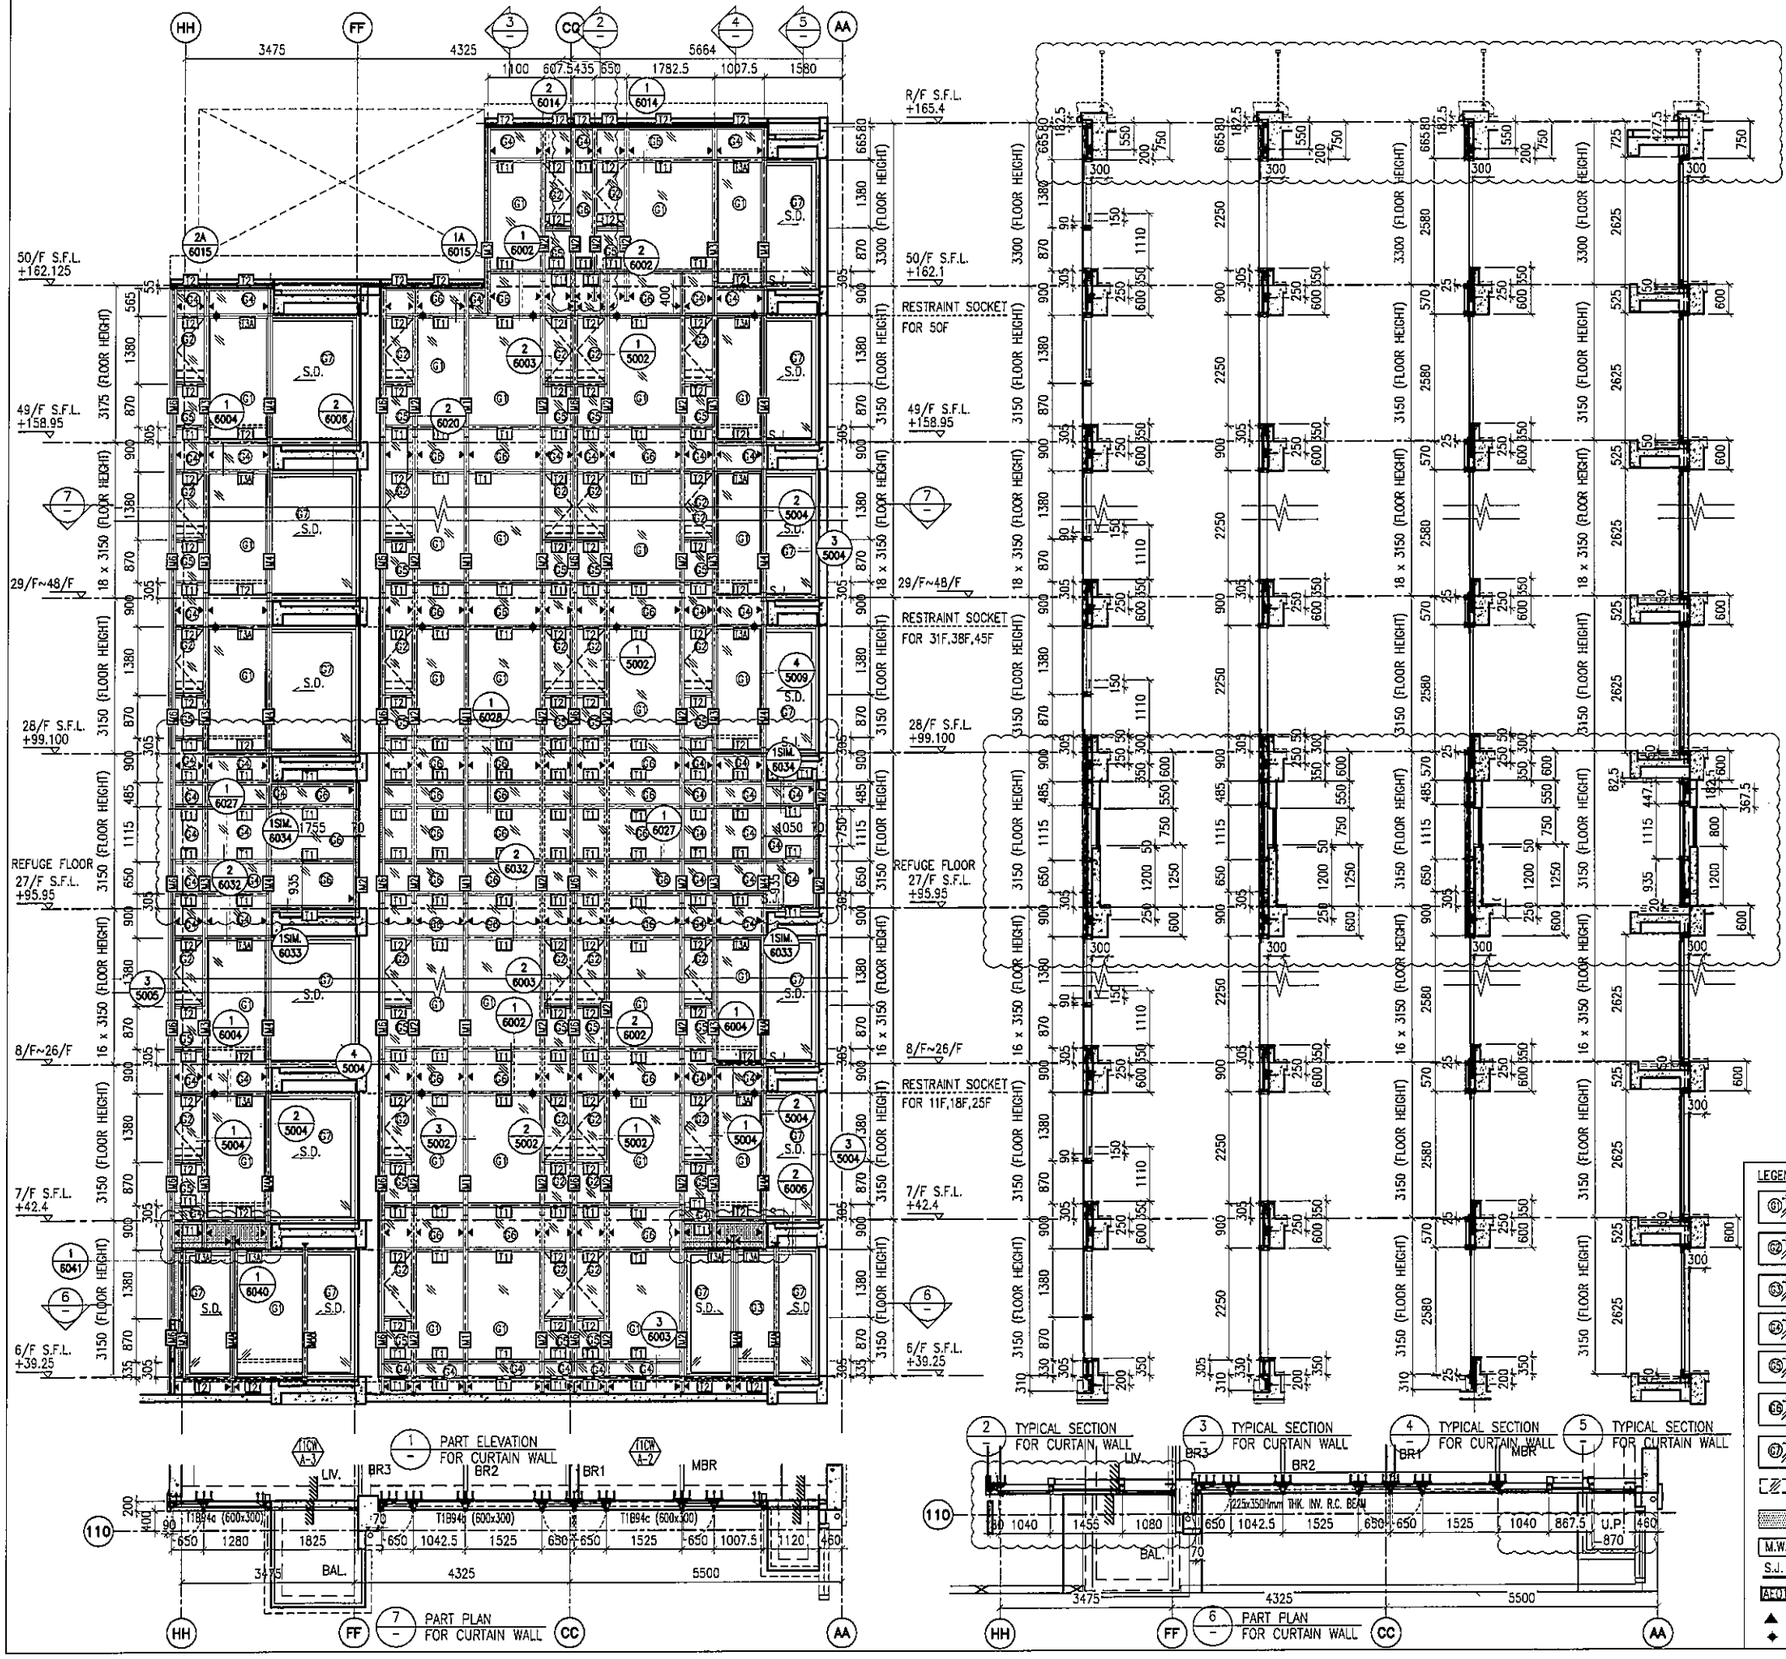

LEGEND:

- 6mm+ – 10 mm THK. TEMPERED BLUE TINTED GLASS (OUTER) + 9 mm AIR SPACE + 8 mm THK. TEMPERED CLEAR GLASS (INNER)
- 6mm+ – 8 mm THK. HEAT STRENGTHENED TINTED GLASS (OUTER)+ 9 mm AIR SPACE + 8 mm THK. HEAT STRENGTHENED CLEAR GLASS (INNER)
- 6mm+ – 10 mm THK. HEAT STRENGTHENED BLUE TINTED GLASS (OUTER)+ 9 mm AIR SPACE + 8 mm THK. TEMPERED CLEAR GLASS (INNER)
- 8mm+ – 8 mm THK. HEAT STRENGTHENED BLUE TINTED GLASS (SPANDREL GLASS)
- 8mm+ – 8 mm THK. HEAT STRENGTHENED BLUE TINTED GLASS (OUTER)+ 9 mm AIR SPACE + 8 mm THK. TEMPERED CLEAR GLASS (INNER)
- 8mm+ – 8 mm THK. TEMPERED BLUE TINTED GLASS (SPANDREL GLASS)
- 8mm+ – 8 mm THK. HEAT STRENGTHENED TINTED GLASS (OUTER)+ 1.52PVB + 8 mm THK. HEAT STRENGTHENED CLEAR LAMINATED GLASS (INNER)
- 10 mm THK. TEMPERED GLASS (INTERNAL PROTECTIVE BARRIER)
- 3 mm THK. ALUM. CLADDING
- M.W. – MAINTENANCE WINDOW
- S.J. – STACK JOINT
- AE-01 – ALUM. EXTRUSION DIE NO.
- ▲ – SUPPORT POINT
- ◆ – RESTRAINT SOCKET

B.D. REF :

CLIENT :
信和置業有限公司
Sino Land Company Limited

ARCHITECT :
WONG TUNG & PARTNERS LIMITED
ARCHITECTS & PLANNERS

MAIN CONTRACTOR :
CR Construction Company Limited

STRUCTURAL ENGINEER :
AECOM

FACADE CONSULTANT:
AECOM

NOTE :
1. ALL DIMENSIONS ARE IN mm.
2. ALL ELEVATIONS ARE VIEWED FROM OUTSIDE.
3. ALL DIMENSIONS TO BE VERIFIED ON SITE BEFORE FABRICATION.

LEGEND :
X1 — DETAIL MARK NO.
X001 — REFER SHEET NO.

1. F.F.L. --FINISHED FLOOR LEVEL
2. S.F.L. --STRUCTURAL FLOOR LEVEL
3. /R --REVERSED DETAIL

NO.	DATE	REVISED	BY
H	16/07/2019	GENERAL REVISED	
G	26/05/2019	GENERAL REVISED	
F	07/04/2019	GENERAL REVISED	
E	17/01/2019	GENERAL REVISED	
D	22/12/2018	GENERAL REVISED	
C	04/12/2018	GENERAL REVISED	
B	24/11/2018	GENERAL REVISED	
A	10/9/2018	GENERAL REVISED	

JOB NO. : J-837

PROJECT :
URA KWUN TONG TOWN CENTRE REDEVELOPMENT (AREA 2 & 3) AT NKIL 6514, KWUN TONG, KWLOON

TITLE :
PART ELEVATION OF CURTAIN WALL AT TOWER 1

DATE : 04-JUL-18 | SCALE : 1:60 (A1)

DRAWN BY : ASING | CHECKED BY : -

美特鋁製有限公司
MIDI ALUMINIUM FABRICATOR LTD.
Units 6-8, Sunray Industrial Centre, 1/F
610 Cha Kwo Ling Road, Kowloon
Tel:23489211-4 Fax:(852)27727666

DWG NO. : J837-CW-2106 | REV. : H

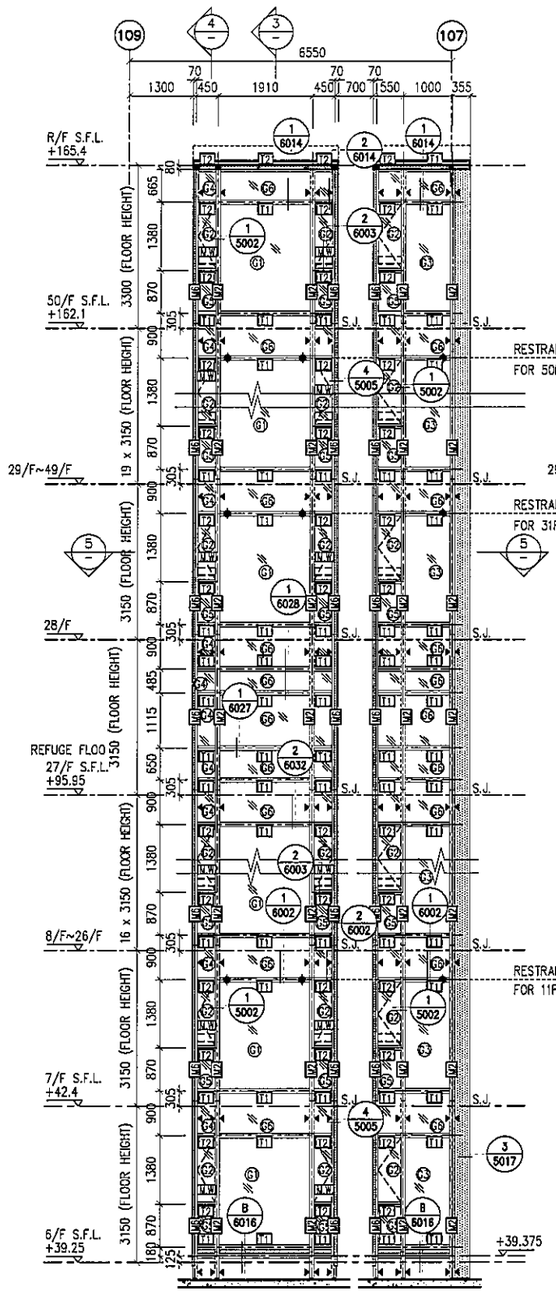

1 / – PART ELEVATION FOR CURTAIN WALL

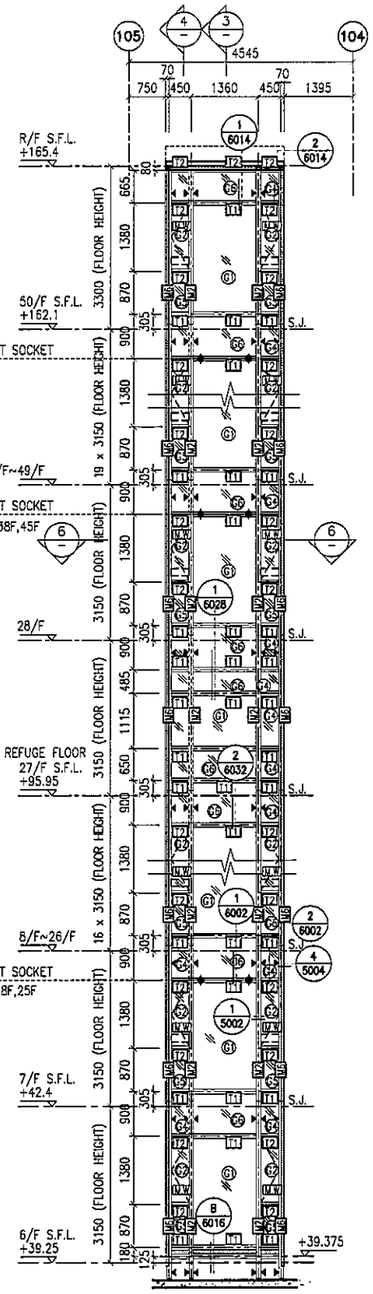

2 / – PART ELEVATION FOR CURTAIN WALL

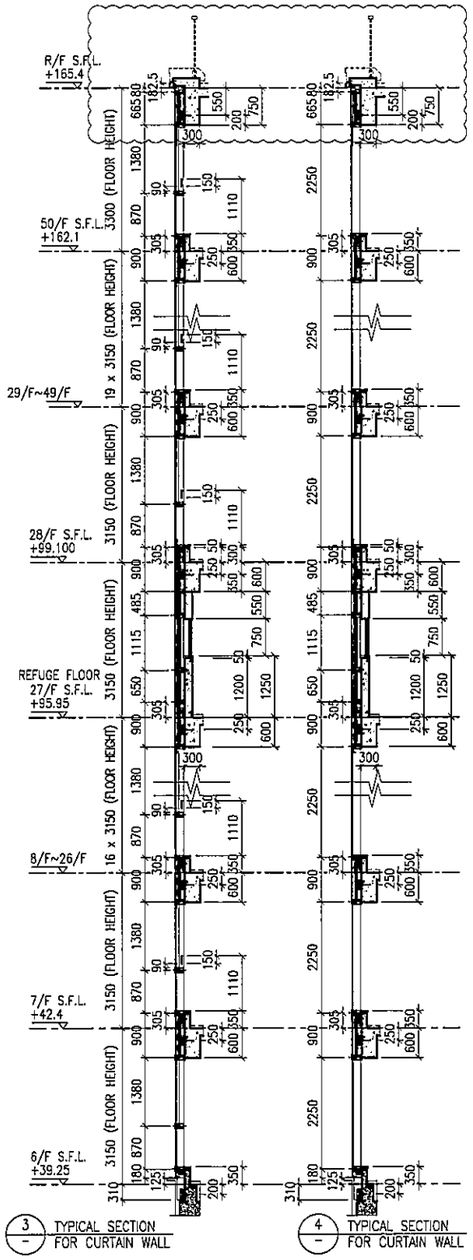

3 / – TYPICAL SECTION FOR CURTAIN WALL

4 / – TYPICAL SECTION FOR CURTAIN WALL

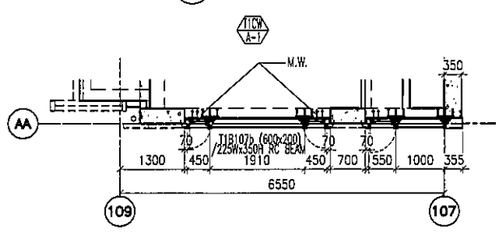

5 / – PART PLAN FOR CURTAIN WALL

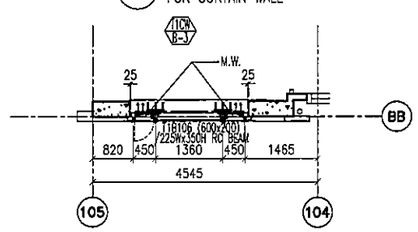

6 / – PART PLAN FOR CURTAIN WALL

LEGEND:

- G1 – 10 mm THK. TEMPERED BLUE TINTED GLASS (OUTER) + 9 mm AIR SPACE + 8 mm THK. TEMPERED CLEAR GLASS (INNER)
- G2 – 8 mm THK. HEAT STRENGTHENED TINTED GLASS (OUTER)+ 9 mm AIR SPACE + 8 mm THK. HEAT STRENGTHENED CLEAR GLASS (INNER)
- G3 – 10 mm THK. HEAT STRENGTHENED BLUE TINTED GLASS (OUTER)+ 9 mm AIR SPACE + 8 mm THK. TEMPERED CLEAR GLASS (INNER)
- G5 – 8 mm THK. HEAT STRENGTHENED BLUE TINTED GLASS (SPANDREL GLASS)
- G6 – 8 mm THK. HEAT STRENGTHENED BLUE TINTED GLASS (OUTER)+ 9 mm AIR SPACE + 8 mm THK. TEMPERED CLEAR GLASS (INNER)
- G6 – 8 mm THK. TEMPERED BLUE TINTED GLASS (SPANDREL GLASS)
- G7 – 8 mm THK. HEAT STRENGTHENED TINTED GLASS (OUTER)+ 1.52PVB + 8 mm THK. HEAT STRENGTHENED CLEAR LAMINATED GLASS (INNER) 10 mm THK. TEMPERED GLASS (INTERNAL PROTECTIVE BARRIER)
- 3 mm THK. ALUM. CLADDING
- M.W. – MAINTENANCE WINDOW
- S.J. – STACK JOINT
- AE01 – ALUM. EXTRUSION DIE NO.
- ▲ – SUPPORT POINT
- ◆ – RESTRAINT SOCKET

B.D. REF :

CLIENT :
信和置業有限公司
Sino Land Company Limited

ARCHITECT :
WONG TUNG & PARTNERS LIMITED
ARCHITECTS & PLANNERS

MAIN CONTRACTOR :
CR Construction Company Limited

STRUCTURAL ENGINEER :
AECOM

FACADE CONSULTANT:
AECOM

NOTE :
1. ALL DIMENSIONS ARE IN mm.
2. ALL ELEVATIONS ARE VIEWED FROM OUTSIDE.
3. ALL DIMENSIONS TO BE VERIFIED ON SITE BEFORE FABRICATION.

LEGEND :
X1 / XD01 — DETAIL MARK NO. / REFER SHEET NO.
1. F.F.L. --FINISHED FLOOR LEVEL
2. S.F.L. --STRUCTURAL FLOOR LEVEL
3. /R --REVERSED DETAIL

NO.	DATE	REVISED	BY
G	16/07/2019	GENERAL REVISED	
F	17/01/2019	GENERAL REVISED	
E	02/01/2019	GENERAL REVISED	
D	22/12/2018	GENERAL REVISED	
C	04/12/2018	GENERAL REVISED	
B	24/11/2018	GENERAL REVISED	
A	10/9/2018	GENERAL REVISED	

JOB NO. : J-837

PROJECT :
URA KWUN TONG TOWN CENTRE REDEVELOPMENT (AREA 2 & 3) AT NKIL 6514, KWUN TONG, KWLOON

TITLE :
PART ELEVATION OF CURTAIN WALL AT TOWER 1

DATE : 04-JUL-18	SCALE : 1:60 (A1)
DRAWN BY : ASING	CHECKED BY : –

美特鋁質有限公司
MIDI ALUMINIUM FABRICATOR LTD.
Units 6-8, Sunray Industrial Centre, 1/F
610 Cho Kwo Ling Road, Kowloon
Tel:23489211-4 Fax:(852)27727666

DWG NO. : J837-CW-2107 | REV. : G

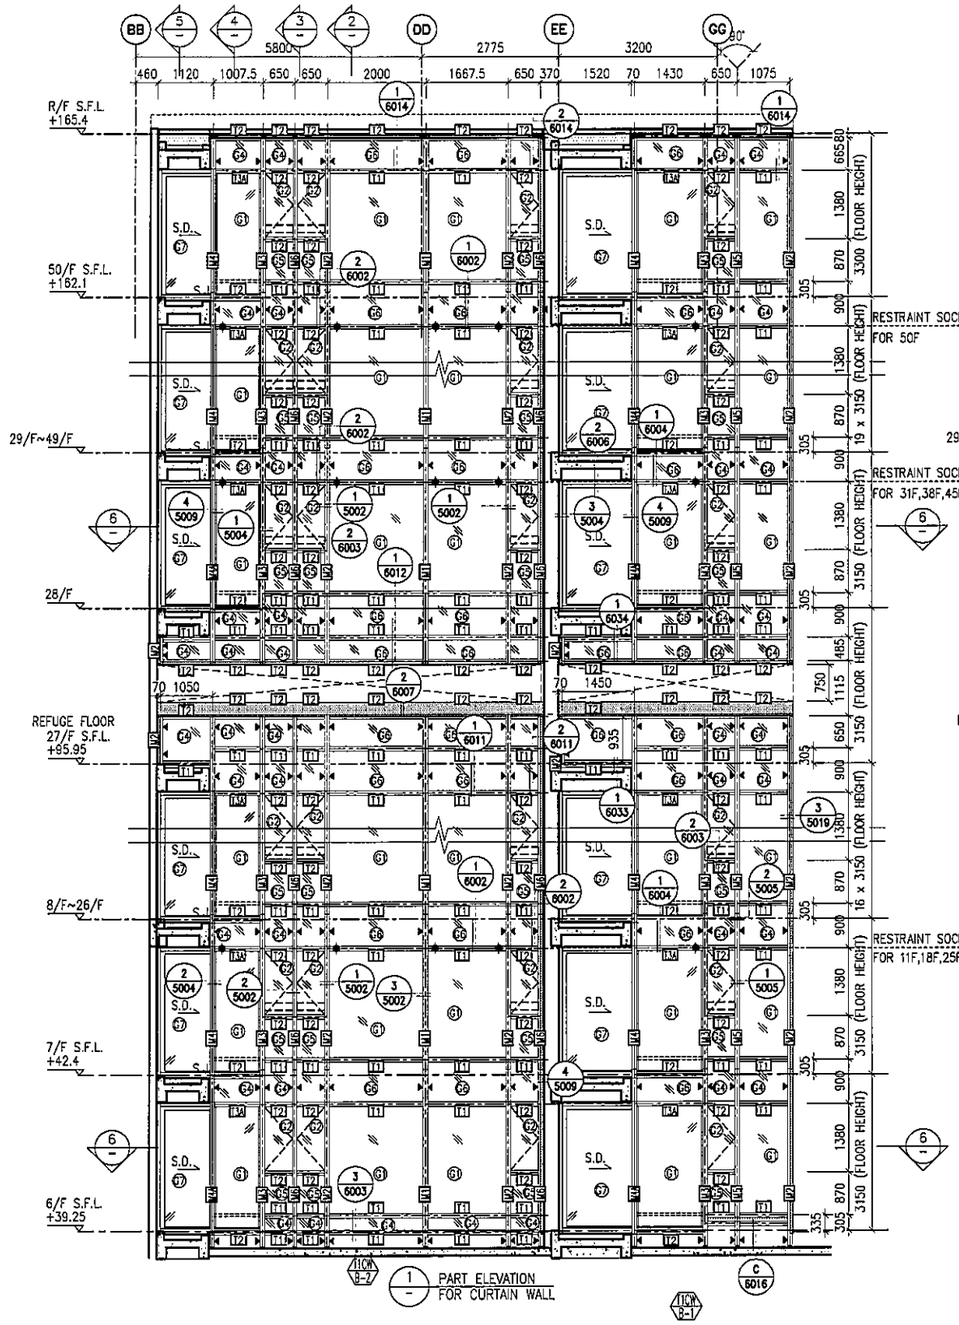

1 PART ELEVATION FOR CURTAIN WALL

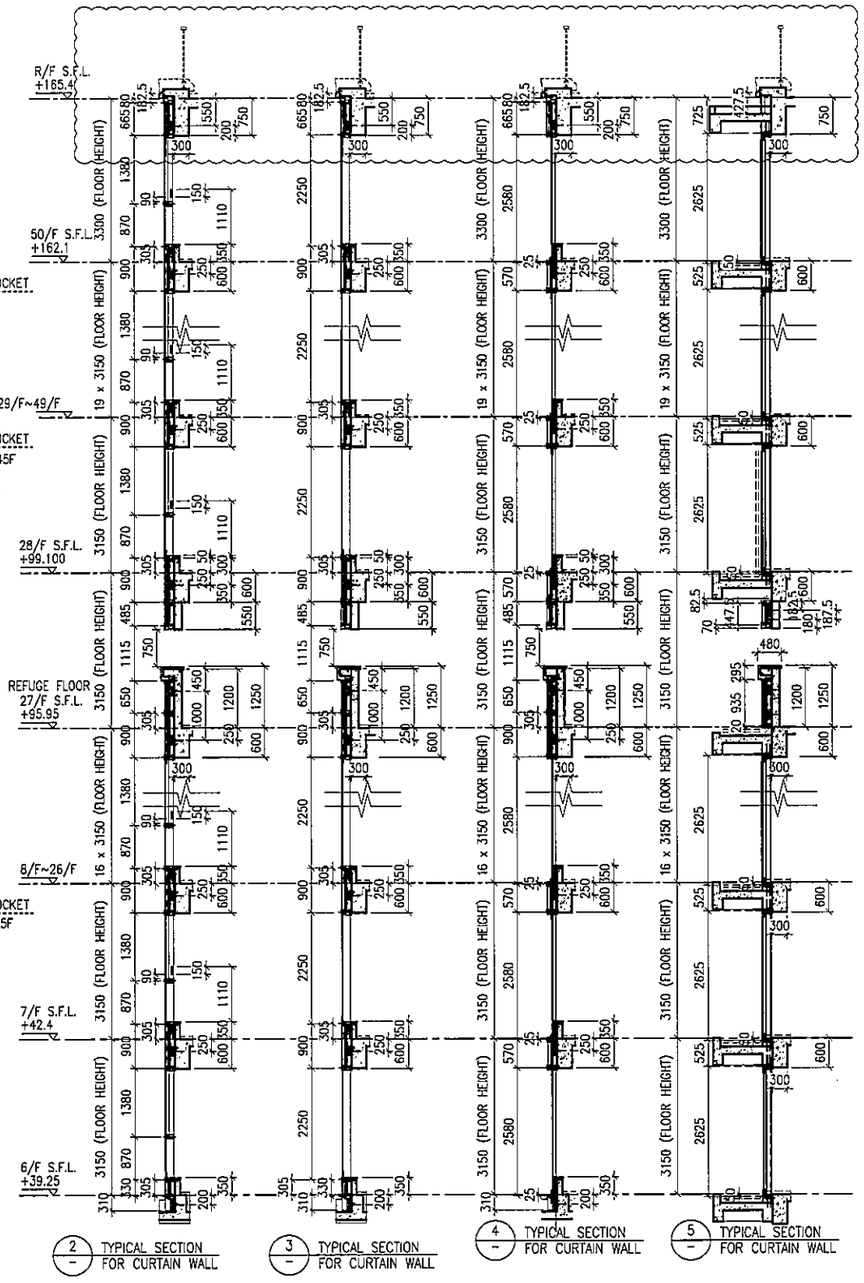

2 TYPICAL SECTION FOR CURTAIN WALL

3 TYPICAL SECTION FOR CURTAIN WALL

4 TYPICAL SECTION FOR CURTAIN WALL

5 TYPICAL SECTION FOR CURTAIN WALL

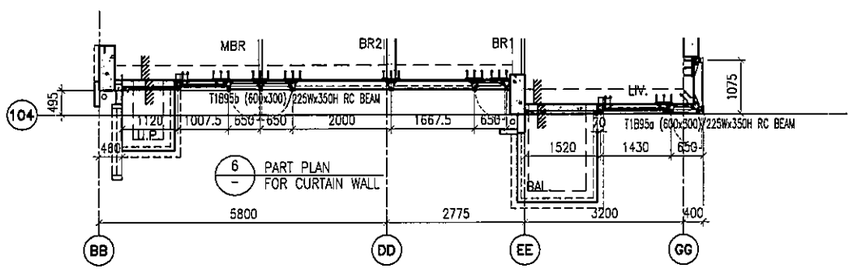

6 PART PLAN FOR CURTAIN WALL

LEGEND:

- 10 mm THK. TEMPERED BLUE TINTED GLASS (OUTER) + 9 mm AIR SPACE + 8 mm THK. TEMPERED CLEAR GLASS (INNER)
- 8 mm THK. HEAT STRENGTHENED TINTED GLASS (OUTER)+ 9 mm AIR SPACE + 8 mm THK. HEAT STRENGTHENED CLEAR GLASS (INNER)
- 10 mm THK. HEAT STRENGTHENED BLUE TINTED GLASS (OUTER)+ 9 mm AIR SPACE + 8 mm THK. TEMPERED CLEAR GLASS (INNER)
- 8 mm THK. HEAT STRENGTHENED BLUE TINTED GLASS (SPANDREL GLASS)
- 8 mm THK. HEAT STRENGTHENED BLUE TINTED GLASS (OUTER)+ 9 mm AIR SPACE + 8 mm THK. TEMPERED CLEAR GLASS (INNER)
- 8 mm THK. TEMPERED BLUE TINTED GLASS (SPANDREL GLASS)
- 8 mm THK. HEAT STRENGTHENED TINTED GLASS (OUTER)+ 1.52PVB + 8 mm THK. HEAT STRENGTHENED CLEAR LAMINATED GLASS (INNER)
- 10 mm THK. TEMPERED GLASS (INTERNAL PROTECTIVE BARRIER)
- 3 mm THK. ALUM. CLADDING
- M.W. – MAINTENANCE WINDOW
- S.J. – STACK JOINT
- AE01 – ALUM. EXTRUSION DIE NO.
- ▲ – SUPPORT POINT
- ◆ – RESTRAINT SOCKET

B.D. REF :

CLIENT :
信和置業有限公司
Sino Land Company Limited

ARCHITECT : WONG TUNG & PARTNERS LIMITED
ARCHITECTS & PLANNERS

MAIN CONTRACTOR :
CR Construction Company Limited

STRUCTURAL ENGINEER :
AECOM

FACADE CONSULTANT:
AECOM

NOTE :
1. ALL DIMENSIONS ARE IN mm.
2. ALL ELEVATIONS ARE VIEWED FROM OUTSIDE.
3. ALL DIMENSIONS TO BE VERIFIED ON SITE BEFORE FABRICATION.

LEGEND :
- X1 / X001 – DETAIL MARK NO. / REFER SHEET NO.
1. F.F.L. --FINISHED FLOOR LEVEL
2. S.F.L. --STRUCTURAL FLOOR LEVEL
3. /R --REVERSED DETAIL

NO.	DATE	REVISED	BY
F	16/07/2019	GENERAL REVISED	
E	17/01/2019	GENERAL REVISED	
D	22/12/2018	GENERAL REVISED	
C	04/12/2018	GENERAL REVISED	
B	24/11/2018	GENERAL REVISED	
A	10/9/2018	GENERAL REVISED	

JOB NO. : J-837

PROJECT :
URA KWUN TONG TOWN CENTRE REDEVELOPMENT (AREA 2 & 3) AT NKIL 6514, KWUN TONG, KWLOON

TITLE :
PART ELEVATION OF CURTAIN WALL AT TOWER 1

DATE : 04-JUL-18 | SCALE : 1:60 (A1)

DRAWN BY : ASING | CHECKED BY : –

美特鋁質有限公司
MIDI ALUMINIUM FABRICATOR LTD.
Units 6-8, Sunray Industrial Centre, 1/F
610 Cha Kwo Ling Road, Kowloon
Tel:23489211-4 Fax:(852)27727666

DWG NO. : J837-CW-2108 | REV. : F

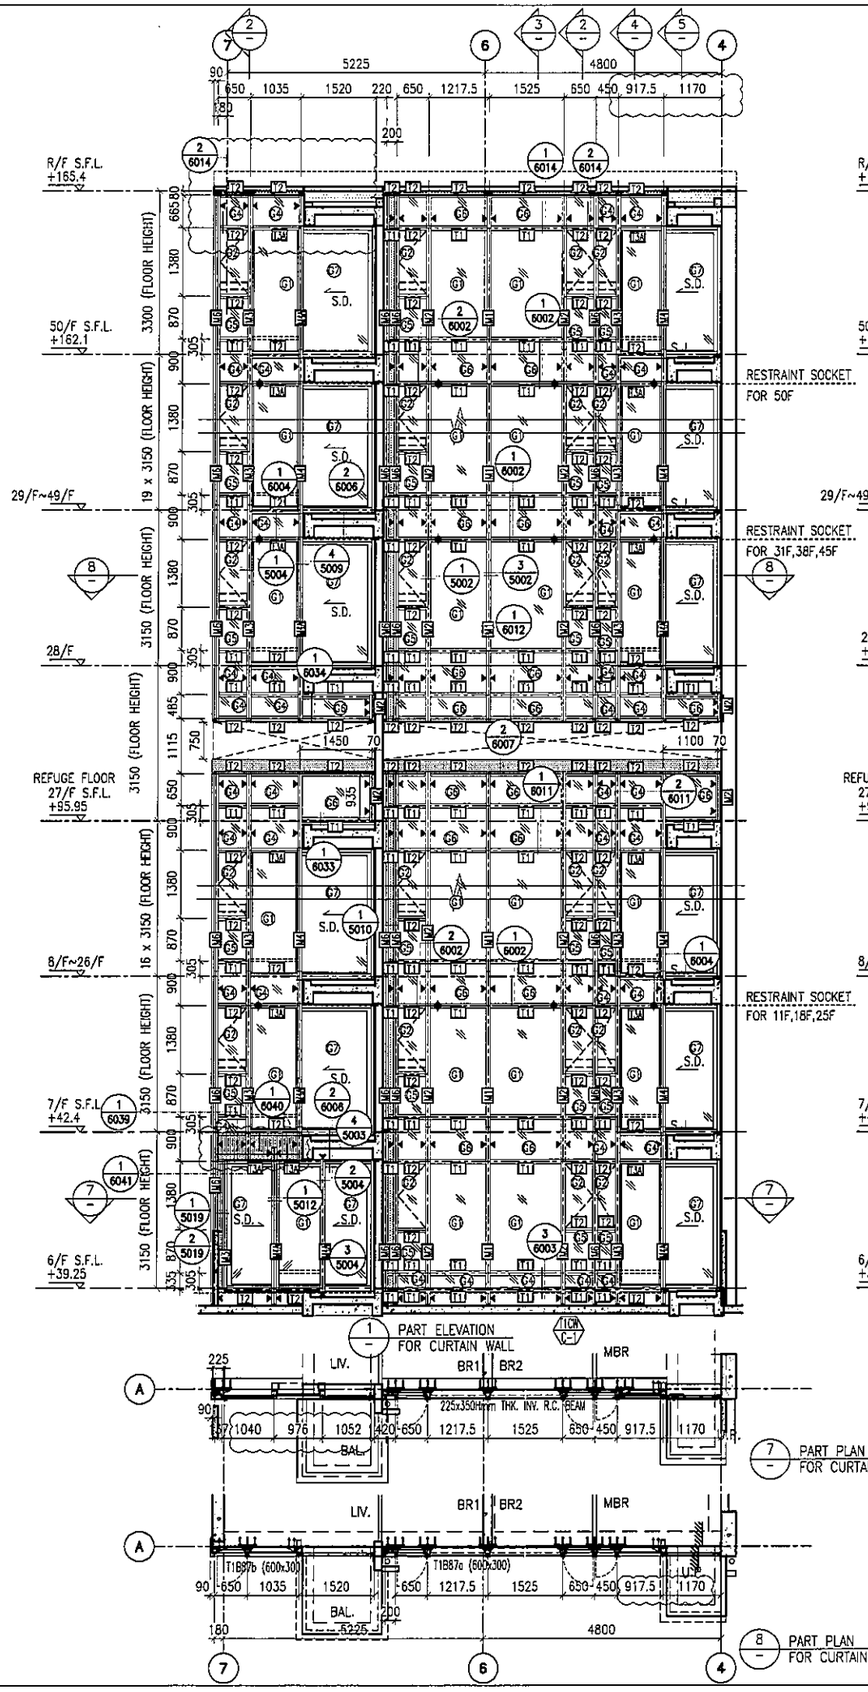

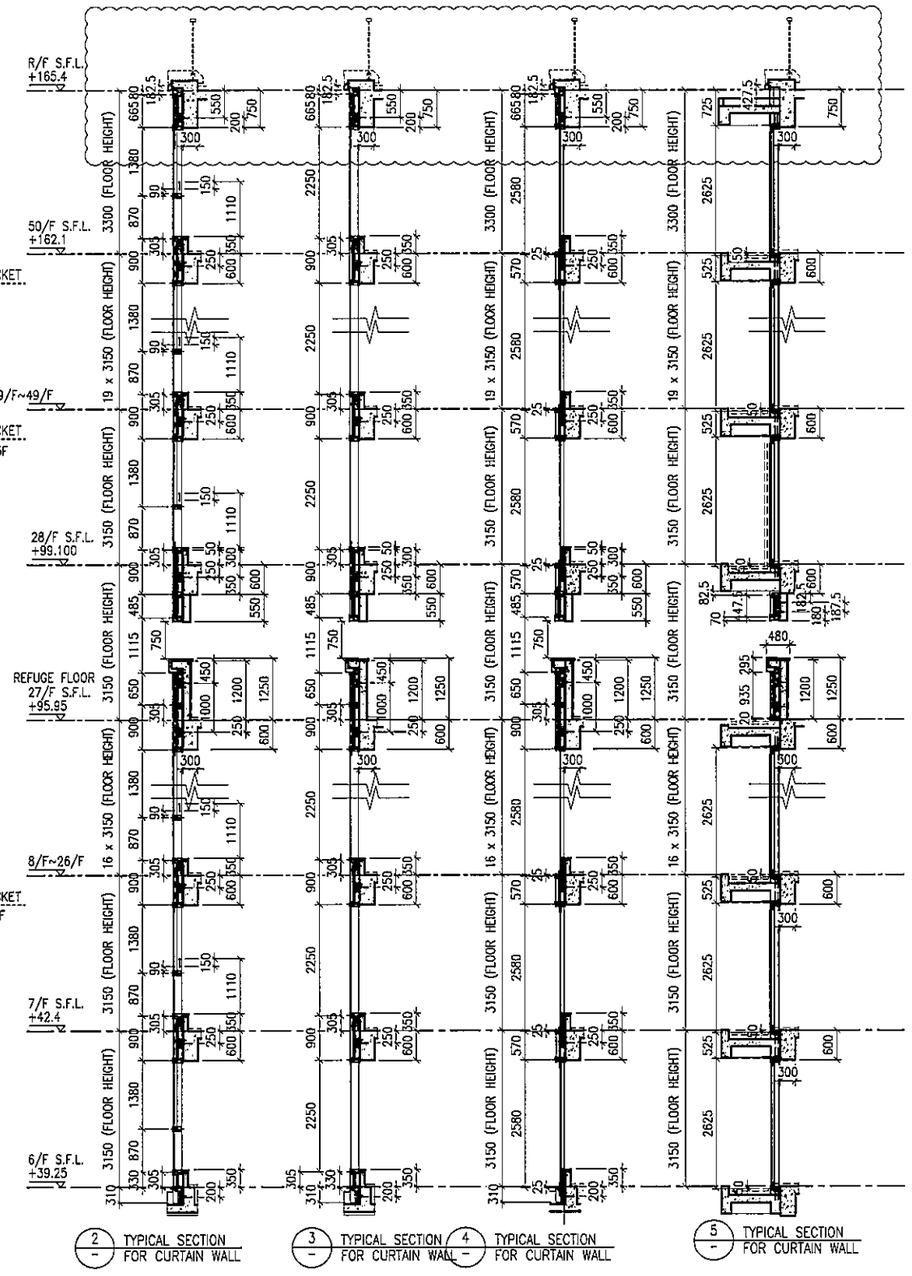

LEGEND:

- 10 mm THK. TEMPERED BLUE TINTED GLASS (OUTER) + 9 mm AIR SPACE + 8 mm THK. TEMPERED CLEAR GLASS (INNER)
- 8 mm THK. HEAT STRENGTHENED TINTED GLASS (OUTER)+ 9 mm AIR SPACE + 8 mm THK. HEAT STRENGTHENED CLEAR GLASS (INNER)
- 10 mm THK. HEAT STRENGTHENED BLUE TINTED GLASS (OUTER)+ 9 mm AIR SPACE + 8 mm THK. TEMPERED CLEAR GLASS (INNER)
- 8 mm THK. HEAT STRENGTHENED BLUE TINTED GLASS (SPANDREL GLASS)
- 8 mm THK. HEAT STRENGTHENED BLUE TINTED GLASS (OUTER)+ 9 mm AIR SPACE + 8 mm THK. TEMPERED CLEAR GLASS (INNER)
- 8 mm THK. TEMPERED BLUE TINTED GLASS (SPANDREL GLASS)
- 8 mm THK. HEAT STRENGTHENED TINTED GLASS (OUTER)+ 1.52PVB + 8 mm THK. HEAT STRENGTHENED CLEAR LAMINATED GLASS (INNER) 10 mm THK. TEMPERED GLASS (INTERNAL PROTECTIVE BARRIER)
- 3 mm THK. ALUM. CLADDING
- M.W. – MAINTENANCE WINDOW
- S.J. – STACK JOINT
- AE01 – ALUM. EXTRUSION DIE NO.
- ▲ – SUPPORT POINT
- ◆ – RESTRAINT SOCKET

B.D. REF :

CLIENT :
信和置業有限公司
Sino Land Company Limited

ARCHITECT : WONG TUNG & PARTNERS LIMITED ARCHITECTS & PLANNERS

MAIN CONTRACTOR :
CR Construction Company Limited

STRUCTURAL ENGINEER : AECOM

FACADE CONSULTANT: AECOM

NOTE :
1. ALL DIMENSIONS ARE IN mm.
2. ALL ELEVATIONS ARE VIEWED FROM OUTSIDE.
3. ALL DIMENSIONS TO BE VERIFIED ON SITE BEFORE FABRICATION.

LEGEND :
X1 — DETAIL MARK NO.
X001 — REFER SHEET NO.

1. F.F.L. --FINISHED FLOOR LEVEL
2. S.F.L. --STRUCTURAL FLOOR LEVEL
3. (R) --REVERSED DETAIL

NO.	DATE	REVISED	BY
H	16/07/2019	GENERAL REVISED	
G	26/05/2019	GENERAL REVISED	
F	07/04/2019	GENERAL REVISED	
E	17/01/2019	GENERAL REVISED	
D	22/12/2018	GENERAL REVISED	
C	04/12/2018	GENERAL REVISED	
B	24/11/2018	GENERAL REVISED	
A	10/9/2018	GENERAL REVISED	

JOB NO. : J-837

PROJECT :
URA KWUN TONG TOWN CENTRE REDEVELOPMENT (AREA 2 & 3) AT NKIL 6514, KWUN TONG, KWLOON

TITLE :
PART ELEVATION OF CURTAIN WALL AT TOWER 1

DATE : 04-JUL-18	SCALE : 1:60 (A1)
DRAWN BY : ASING	CHECKED BY : -

美特鋁質有限公司
MIDI ALUMINIUM FABRICATOR LTD.
Units 6-8, Sunray Industrial Centre, 1/F
610 Cha Kwo Ling Road, Kowloon
Tel:23489211-4 Fax:(852)27727666

DWG NO. : J837-CW-2109 | REV. : H

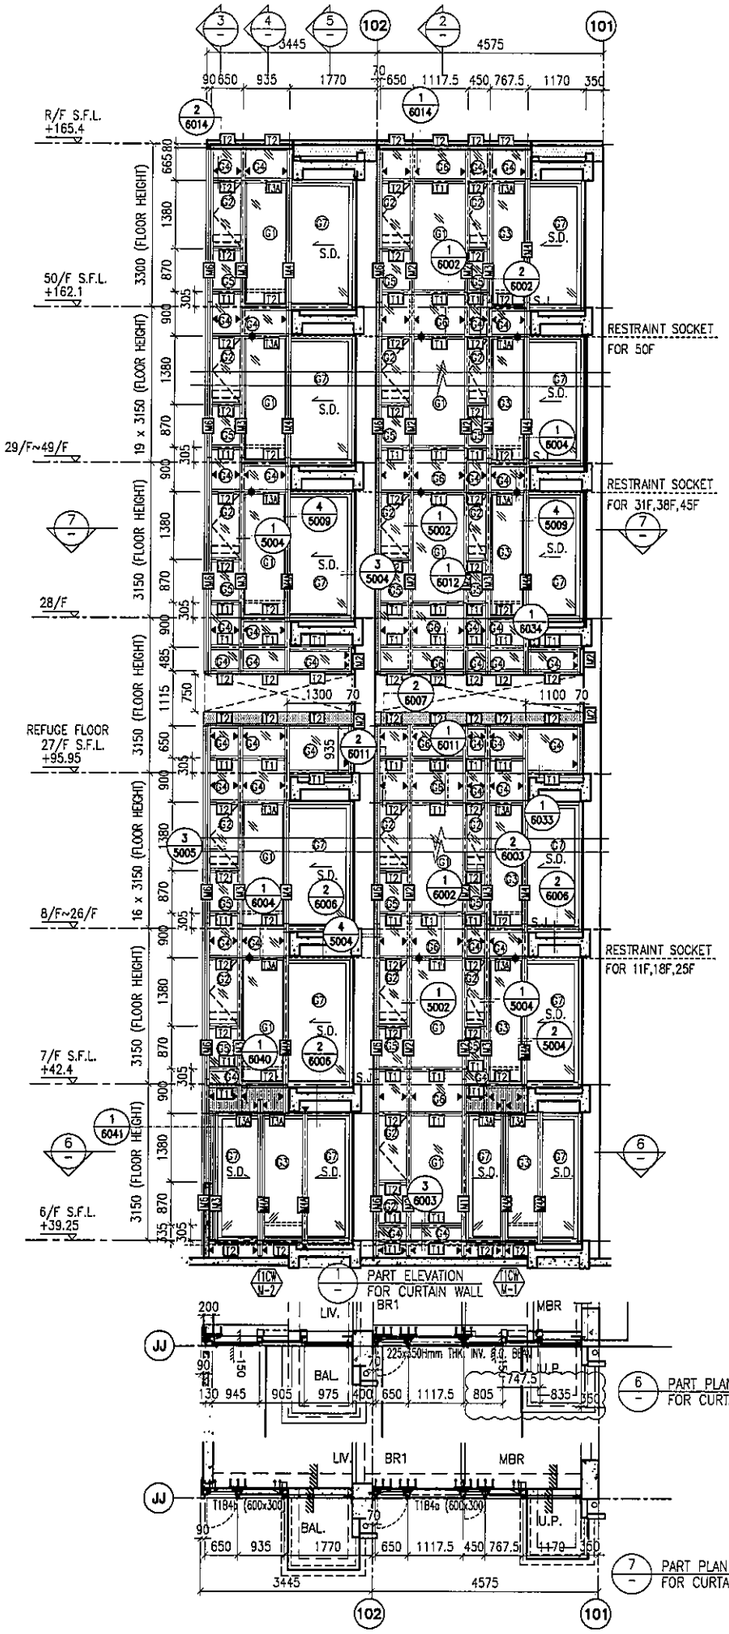

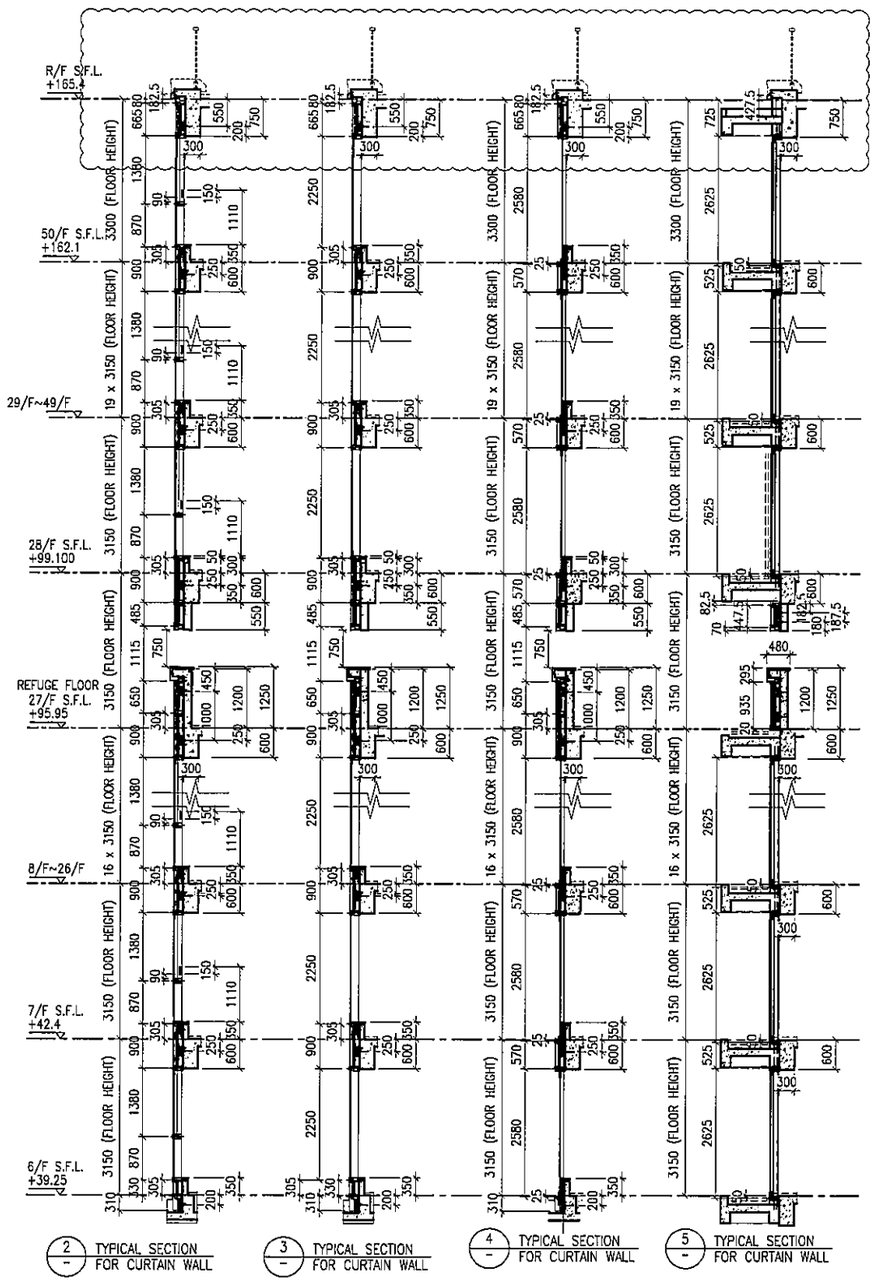

2 / – TYPICAL SECTION FOR CURTAIN WALL

3 / – TYPICAL SECTION FOR CURTAIN WALL

4 / – TYPICAL SECTION FOR CURTAIN WALL

5 / – TYPICAL SECTION FOR CURTAIN WALL

LEGEND:

- 10 mm THK. TEMPERED BLUE TINTED GLASS (OUTER) + 9 mm AIR SPACE + 8 mm THK. TEMPERED CLEAR GLASS (INNER)
- 8 mm THK. HEAT STRENGTHENED TINTED GLASS (OUTER)+ 9 mm AIR SPACE + 8 mm THK. HEAT STRENGTHENED CLEAR GLASS (INNER)
- 10 mm THK. HEAT STRENGTHENED BLUE TINTED GLASS (OUTER)+ 9 mm AIR SPACE + 8 mm THK. TEMPERED CLEAR GLASS (INNER)
- 8 mm THK. HEAT STRENGTHENED BLUE TINTED GLASS (SPANDREL GLASS)
- 8 mm THK. HEAT STRENGTHENED BLUE TINTED GLASS (OUTER)+ 9 mm AIR SPACE + 8 mm THK. TEMPERED CLEAR GLASS (INNER)
- 8 mm THK. TEMPERED BLUE TINTED GLASS (SPANDREL GLASS)
- 8 mm THK. HEAT STRENGTHENED TINTED GLASS (OUTER)+ 1.52PVB + 8 mm THK. HEAT STRENGTHENED CLEAR LAMINATED GLASS (INNER) 10 mm THK. TEMPERED GLASS (INTERNAL PROTECTIVE BARRIER)
- 3 mm THK. ALUM. CLADDING
- M.W. – MAINTENANCE WINDOW
- S.J. – STACK JOINT
- AE01 – ALUM. EXTRUSION DIE NO.
- ▲ – SUPPORT POINT
- ◆ – RESTRAINT SOCKET

B.D. REF :

CLIENT :
信和置業有限公司
Sino Land Company Limited

ARCHITECT :
WONG TUNG & PARTNERS LIMITED
ARCHITECTS & PLANNERS

MAIN CONTRACTOR :
CR Construction Company Limited

STRUCTURAL ENGINEER :
AECOM

FACADE CONSULTANT:
AECOM

NOTE :
1. ALL DIMENSIONS ARE IN mm.
2. ALL ELEVATIONS ARE VIEWED FROM OUTSIDE.
3. ALL DIMENSIONS TO BE VERIFIED ON SITE BEFORE FABRICATION.

LEGEND :
X1 / X001 — DETAIL MARK NO. / REFER SHEET NO.
1. F.F.L. --FINISHED FLOOR LEVEL
2. S.F.L. --STRUCTURAL FLOOR LEVEL
3. (R) --REVERSED DETAIL

NO.	DATE	REVISED	BY
G	16/07/2019	GENERAL REVISED	
F	26/05/2019	GENERAL REVISED	
E	17/01/2019	GENERAL REVISED	
D	22/12/2018	GENERAL REVISED	
C	04/12/2018	GENERAL REVISED	
B	24/11/2018	GENERAL REVISED	
A	10/9/2018	GENERAL REVISED	

JOB NO. : J-837

PROJECT :
URA KWUN TONG TOWN CENTRE REDEVELOPMENT (AREA 2 & 3) AT NKIL 6514, KWUN TONG, KWLOON

TITLE :
PART ELEVATION OF CURTAIN WALL AT TOWER 1

DATE : 04-JUL-18 | SCALE : 1:60 (A1)

DRAWN BY : ASING | CHECKED BY : –

美特鋁製有限公司
MIDI ALUMINIUM FABRICATOR LTD.
Units 6-8, Sunray Industrial Centre, 1/F
610 Cha Kwo Ling Road, Kowloon
Tel:23489211-4 Fax:(852)27727666

DWG NO. : J837-CW-2110 | REV. : G

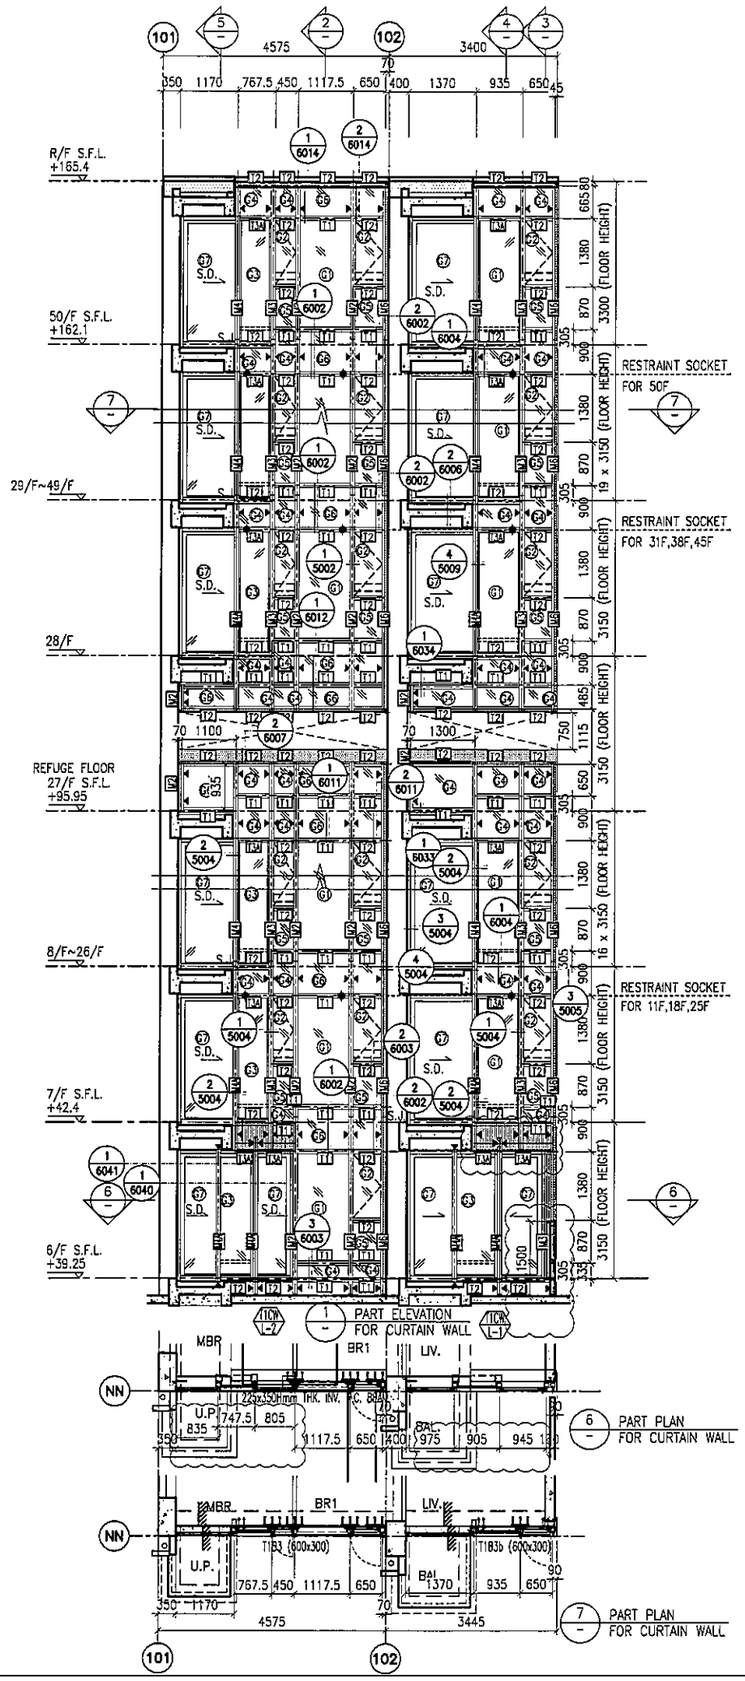

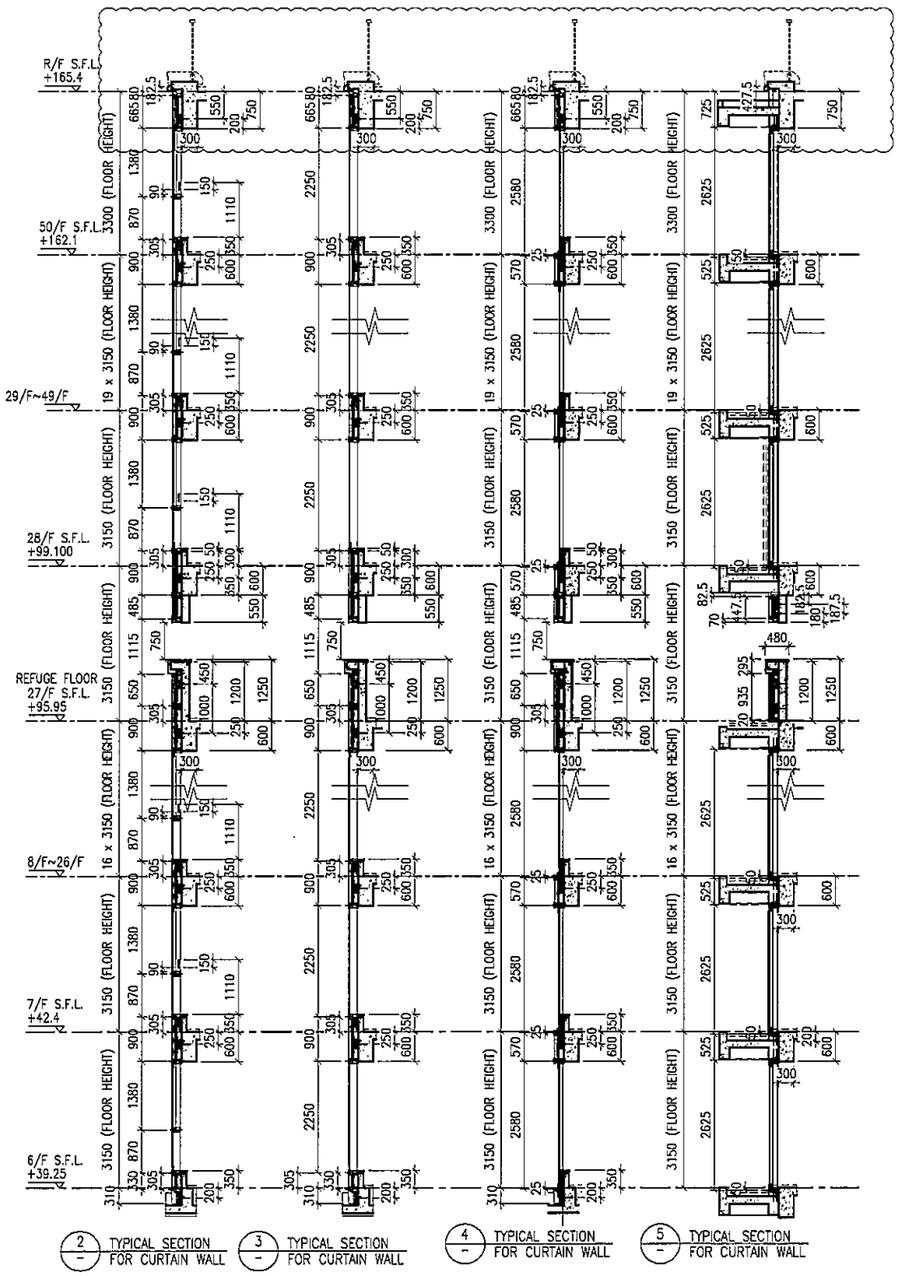

LEGEND:

- 10 mm THK. TEMPERED BLUE TINTED GLASS (OUTER) + 9 mm AIR SPACE + 8 mm THK. TEMPERED CLEAR GLASS (INNER)
- 8 mm THK. HEAT STRENGTHENED TINTED GLASS (OUTER)+ 9 mm AIR SPACE + 8 mm THK. HEAT STRENGTHENED CLEAR GLASS (INNER)
- 10 mm THK. HEAT STRENGTHENED BLUE TINTED GLASS (OUTER)+ 9 mm AIR SPACE + 8 mm THK. TEMPERED CLEAR GLASS (INNER)
- 8 mm THK. HEAT STRENGTHENED BLUE TINTED GLASS (SPANDREL GLASS)
- 8 mm THK. HEAT STRENGTHENED BLUE TINTED GLASS (OUTER)+ 9 mm AIR SPACE + 8 mm THK. TEMPERED CLEAR GLASS (INNER)
- 8 mm THK. TEMPERED BLUE TINTED GLASS (SPANDREL GLASS)
- 8 mm THK. HEAT STRENGTHENED TINTED GLASS (OUTER)+ 1.52PVB + 8 mm THK. HEAT STRENGTHENED CLEAR LAMINATED GLASS (INNER) 10 mm THK. TEMPERED GLASS (INTERNAL PROTECTIVE BARRIER)
- 3 mm THK. ALUM. CLADDING
- M.W. – MAINTENANCE WINDOW
- S.J. – STACK JOINT
- AE01 – ALUM. EXTRUSION DIE NO.
- ▲ – SUPPORT POINT
- ✦ – RESTRAINT SOCKET

B.D. REF :

CLIENT :
信和置業有限公司
Sino Land Company Limited

ARCHITECT :
WONG TUNG & PARTNERS LIMITED
ARCHITECTS & PLANNERS

MAIN CONTRACTOR :
CR Construction Company Limited

STRUCTURAL ENGINEER :
AECOM

FACADE CONSULTANT:
AECOM

NOTE :
1. ALL DIMENSIONS ARE IN mm.
2. ALL ELEVATIONS ARE VIEWED FROM OUTSIDE.
3. ALL DIMENSIONS TO BE VERIFIED ON SITE BEFORE FABRICATION.

LEGEND :
X1 – DETAIL MARK NO.
X001 – REFER SHEET NO.
1. F.F.L. – FINISHED FLOOR LEVEL
2. S.F.L. – STRUCTURAL FLOOR LEVEL
3. (R) – REVERSED DETAIL

NO.	DATE	REVISED	BY
G	16/07/2019	GENERAL REVISED	
F	26/05/2019	GENERAL REVISED	
E	17/01/2019	GENERAL REVISED	
D	22/12/2018	GENERAL REVISED	
C	04/12/2018	GENERAL REVISED	
B	24/11/2018	GENERAL REVISED	
A	10/9/2018	GENERAL REVISED	

JOB NO. : J-837

PROJECT :
URA KWUN TONG TOWN CENTRE REDEVELOPMENT (AREA 2 & 3) AT NKIL 6514, KWUN TONG, KWLOON

TITLE :
PART ELEVATION OF CURTAIN WALL AT TOWER 1

DATE : 04-JUL-18 | SCALE : 1:60 (A1)

DRAWN BY : ASING | CHECKED BY : –

美特鋁製有限公司
MIDI ALUMINIUM FABRICATOR LTD.
Units 6-8, Sunray Industrial Centre, 1/F
610 Cha Kwo Ling Road, Kowloon
Tel:23489211-4 Fax:(852)27727666

DWG NO. : J837-CW-2111 | REV. : G

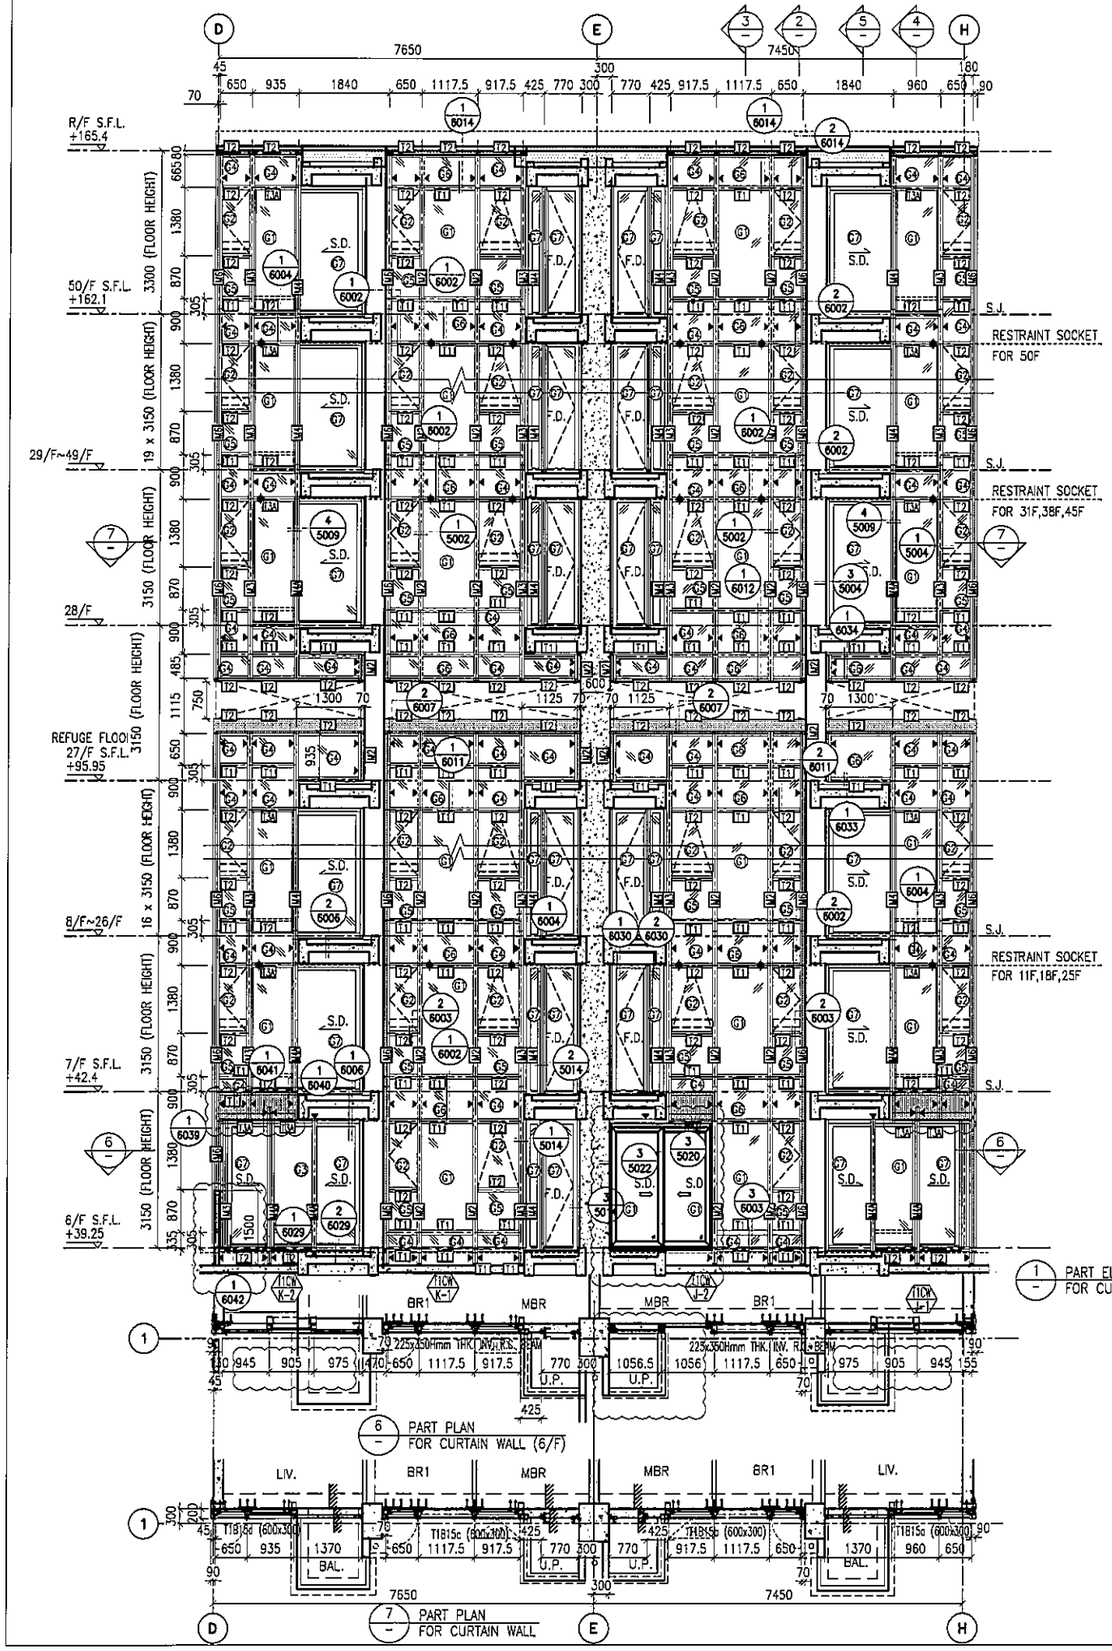

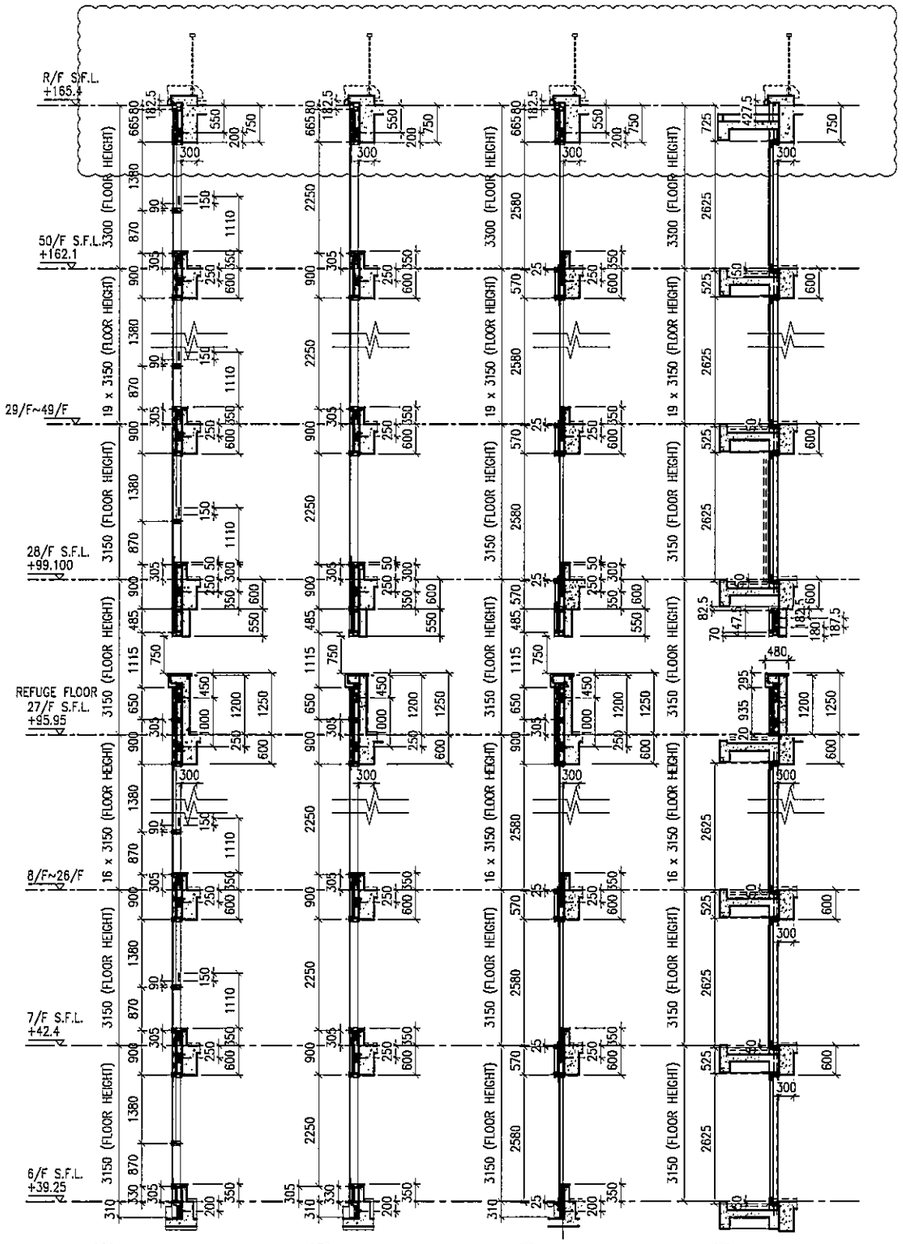

LEGEND:

- 10 mm THK. TEMPERED BLUE TINTED GLASS (OUTER) + 9 mm AIR SPACE + 8 mm THK. TEMPERED CLEAR GLASS (INNER)
- 8 mm THK. HEAT STRENGTHENED TINTED GLASS (OUTER)+ 9 mm AIR SPACE + 8 mm THK. HEAT STRENGTHENED CLEAR GLASS (INNER)
- 10 mm THK. HEAT STRENGTHENED BLUE TINTED GLASS (OUTER)+ 9 mm AIR SPACE + 8 mm THK. TEMPERED CLEAR GLASS (INNER)
- 8 mm THK. HEAT STRENGTHENED BLUE TINTED GLASS (SPANDREL GLASS)
- 8 mm THK. HEAT STRENGTHENED BLUE TINTED GLASS (OUTER)+ 9 mm AIR SPACE + 8 mm THK. TEMPERED CLEAR GLASS (INNER)
- 8 mm THK. TEMPERED BLUE TINTED GLASS (SPANDREL GLASS)
- 8 mm THK. HEAT STRENGTHENED TINTED GLASS (OUTER)+ 1.52PVB + 8 mm THK. HEAT STRENGTHENED CLEAR LAMINATED GLASS (INNER)
- 10 mm THK. TEMPERED GLASS (INTERNAL PROTECTIVE BARRIER)
- 3 mm THK. ALUM. CLADDING
- M.W. – MAINTENANCE WINDOW
- S.J. – STACK JOINT
- AE.01 – ALUM. EXTRUSION DIE NO.
- ▲ – SUPPORT POINT
- ✦ – RESTRAINT SOCKET

B.D. REF :

CLIENT :
信和置業有限公司
Sino Land Company Limited

ARCHITECT :
WONG TUNG & PARTNERS LIMITED
ARCHITECTS & PLANNERS

MAIN CONTRACTOR :
CR Construction Company Limited

STRUCTURAL ENGINEER :
AECOM

FACADE CONSULTANT:
AECOM

NOTE :
1. ALL DIMENSIONS ARE IN mm.
2. ALL ELEVATIONS ARE VIEWED FROM OUTSIDE.
3. ALL DIMENSIONS TO BE VERIFIED ON SITE BEFORE FABRICATION.

LEGEND :
X1 — DETAIL MARK NO.
X001 — REFER SHEET NO.
1. F.F.L. --FINISHED FLOOR LEVEL
2. S.F.L. --STRUCTURAL FLOOR LEVEL
3. (R) --REVERSED DETAIL

NO.	DATE	REVISED	BY
G	16/07/2019	GENERAL REVISED	
F	26/05/2019	GENERAL REVISED	
E	17/01/2019	GENERAL REVISED	
D	22/12/2018	GENERAL REVISED	
C	04/12/2018	GENERAL REVISED	
B	24/11/2018	GENERAL REVISED	
A	10/9/2018	GENERAL REVISED	

JOB NO. : J-837

PROJECT :
URA KWUN TONG TOWN CENTRE REDEVELOPMENT (AREA 2 & 3) AT NKIL 6514, KWUN TONG, KWLOON

TITLE :
PART ELEVATION OF CURTAIN WALL AT TOWER 1

DATE : 04-JUL-18 | SCALE : 1:60 (A1)

DRAWN BY : ASING | CHECKED BY : -

美特鋁質有限公司
MIDI ALUMINIUM FABRICATOR LTD.
Units 6-8, Sunray Industrial Centre, 1/F
610 Cha Kwo Ling Road, Kowloon
Tel:23489211-4 Fax:(852)27727666

DWG NO. : J837-CW-2112 | REV. : G

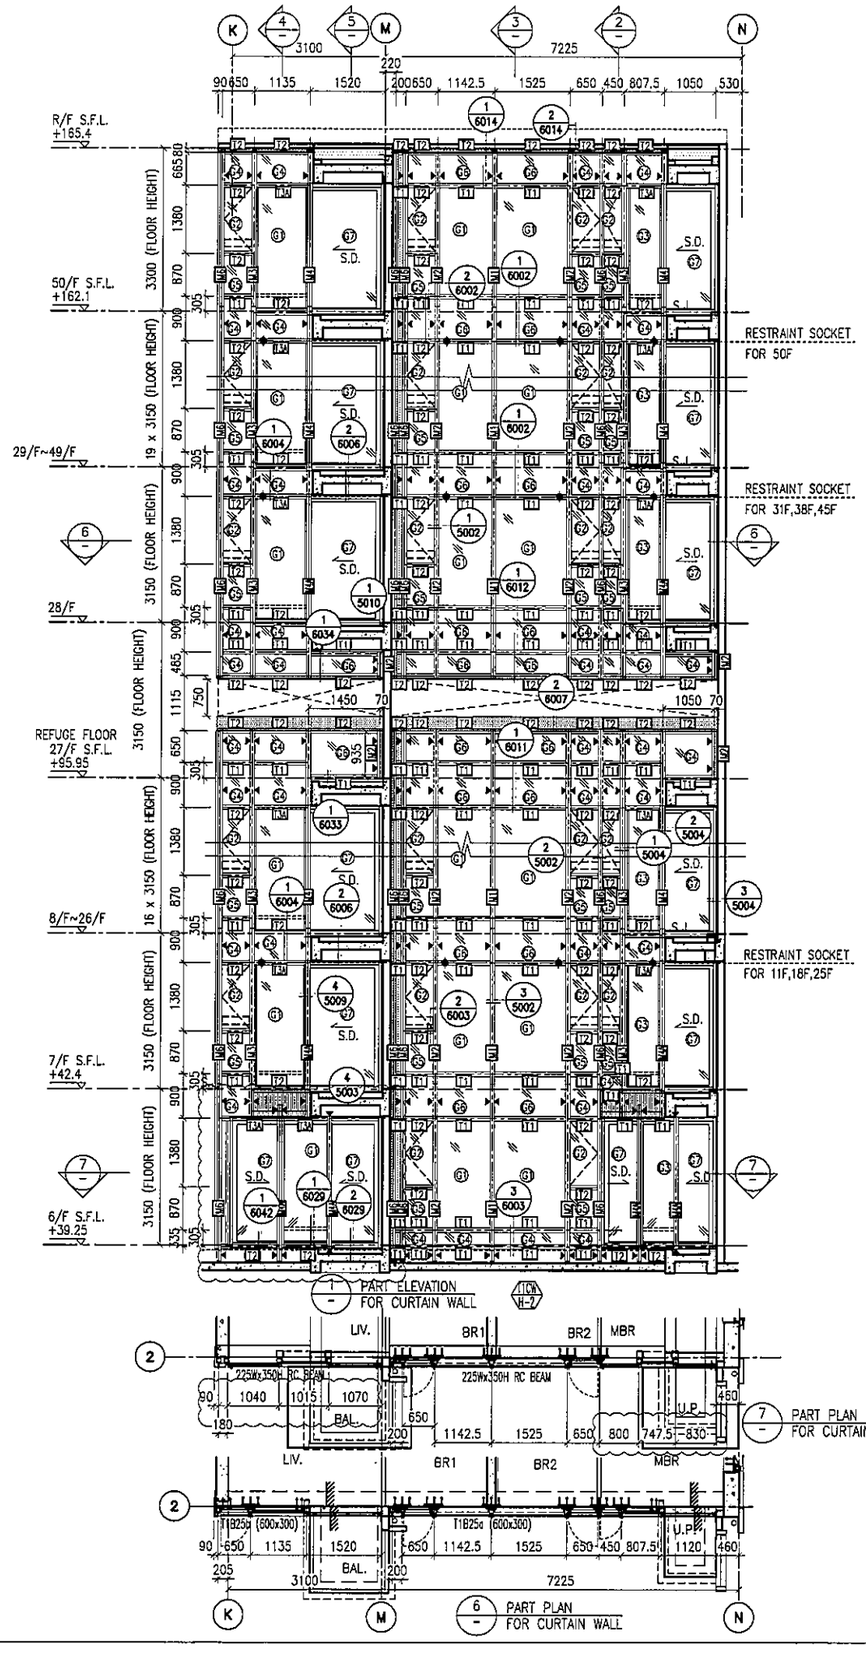

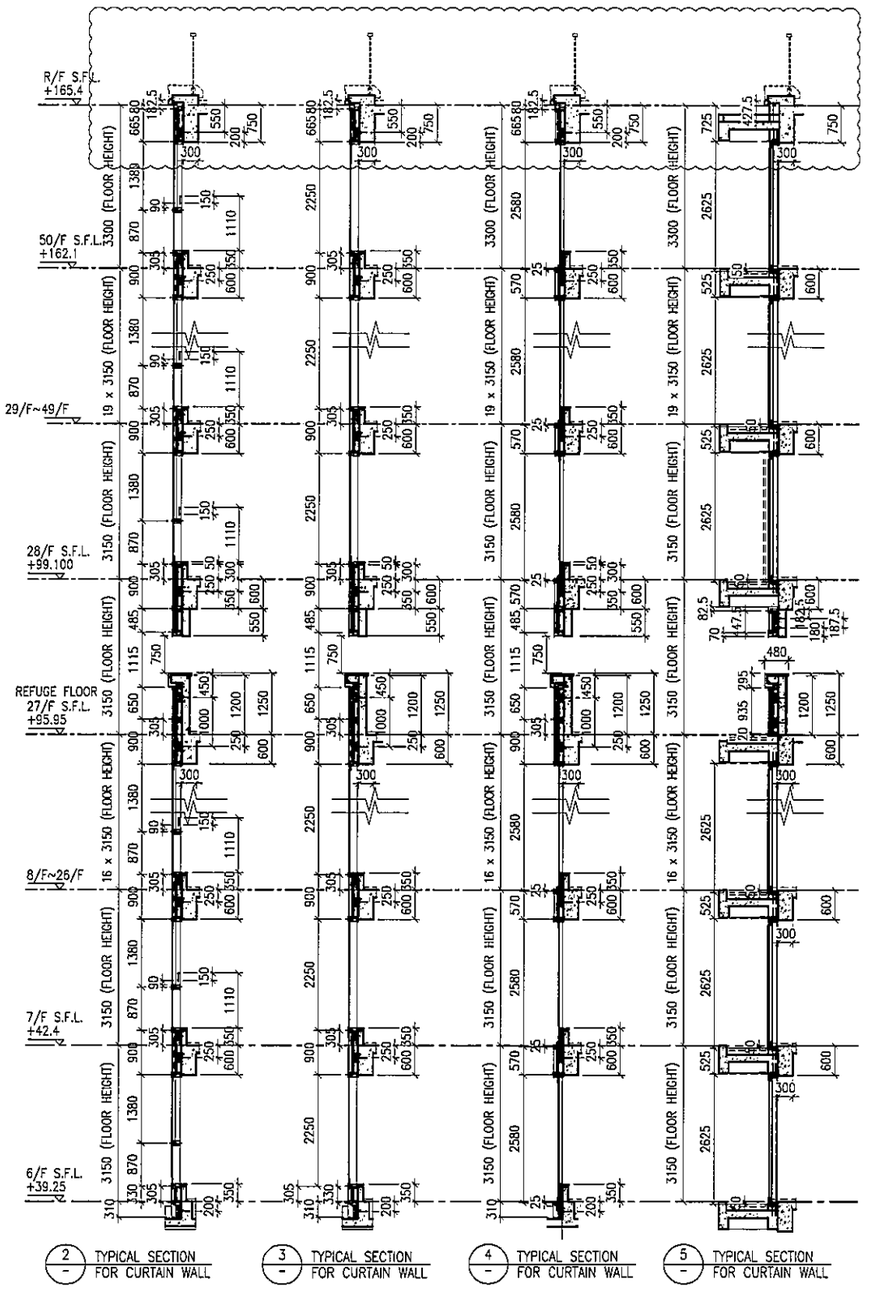

LEGEND:

- 10 mm THK. TEMPERED BLUE TINTED GLASS (OUTER) + 9 mm AIR SPACE + 8 mm THK. TEMPERED CLEAR GLASS (INNER)
- 8 mm THK. HEAT STRENGTHENED TINTED GLASS (OUTER)+ 9 mm AIR SPACE + 8 mm THK. HEAT STRENGTHENED CLEAR GLASS (INNER)
- 10 mm THK. HEAT STRENGTHENED BLUE TINTED GLASS (OUTER)+ 9 mm AIR SPACE + 8 mm THK. TEMPERED CLEAR GLASS (INNER)
- 8 mm THK. HEAT STRENGTHENED BLUE TINTED GLASS (SPANDREL GLASS)
- 8 mm THK. HEAT STRENGTHENED BLUE TINTED GLASS (OUTER)+ 9 mm AIR SPACE + 8 mm THK. TEMPERED CLEAR GLASS (INNER)
- 8 mm THK. TEMPERED BLUE TINTED GLASS (SPANDREL GLASS)
- 8 mm THK. HEAT STRENGTHENED TINTED GLASS (OUTER)+ 1.52PVB + 8 mm THK. HEAT STRENGTHENED CLEAR LAMINATED GLASS (INNER) 10 mm THK. TEMPERED GLASS (INTERNAL PROTECTIVE BARRIER)
- 3 mm THK. ALUM. CLADDING
- M.W. – MAINTENANCE WINDOW
- S.J. – STACK JOINT
- AE01 – ALUM. EXTRUSION DIE NO.
- ▲ – SUPPORT POINT
- ◆ – RESTRAINT SOCKET

B.D. REF :

CLIENT :
信和置業有限公司
Sino Land Company Limited

ARCHITECT : WONG TUNG & PARTNERS LIMITED ARCHITECTS & PLANNERS

MAIN CONTRACTOR :
CR Construction Company Limited

STRUCTURAL ENGINEER : AECOM

FACADE CONSULTANT: AECOM

NOTE :
1. ALL DIMENSIONS ARE IN mm.
2. ALL ELEVATIONS ARE VIEWED FROM OUTSIDE.
3. ALL DIMENSIONS TO BE VERIFIED ON SITE BEFORE FABRICATION.

LEGEND :
- X1 / X001 – DETAIL MARK NO. / REFER SHEET NO.
1. F.F.L. --FINISHED FLOOR LEVEL
2. S.F.L. --STRUCTURAL FLOOR LEVEL
3. /R – REVERSED DETAIL

NO.	DATE	REVISED	BY
G	16/07/2019	GENERAL REVISED	
F	26/05/2019	GENERAL REVISED	
E	17/01/2019	GENERAL REVISED	
D	22/12/2018	GENERAL REVISED	
C	04/12/2018	GENERAL REVISED	
B	24/11/2018	GENERAL REVISED	
A	10/9/2018	GENERAL REVISED	

JOB NO. : J-837

PROJECT :
URA KWUN TONG TOWN CENTRE REDEVELOPMENT (AREA 2 & 3) AT NKIL 6514, KWUN TONG, KWLOON

TITLE :
PART ELEVATION OF CURTAIN WALL AT TOWER 1

DATE : 04-JUL-18 | SCALE : 1:60 (A1)

DRAWN BY : ASING | CHECKED BY : –

美特鋁質有限公司
MIDI ALUMINIUM FABRICATOR LTD.
Units 6-8, Sunray Industrial Centre, 1/F
610 Cha Kwo Ling Road, Kowloon
Tel:23489211-4 Fax:(852)27727666

DWG NO. : J837-CW-2113 | REV. : G

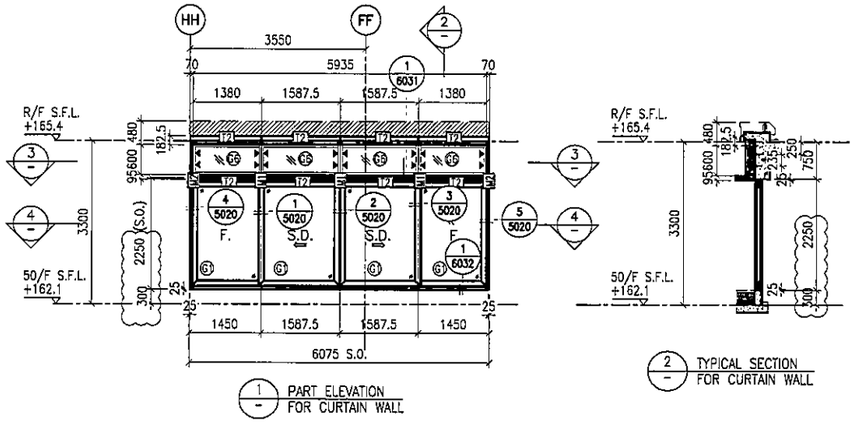

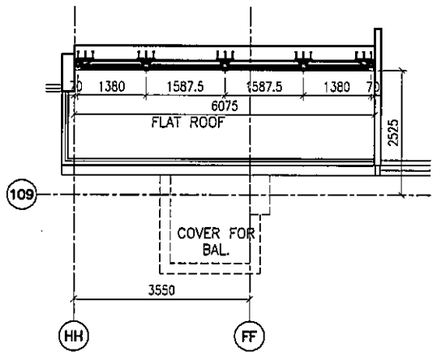

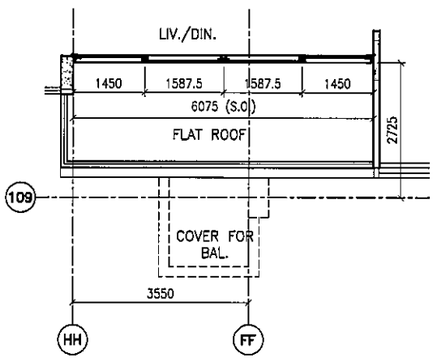

LEGEND:

- G1 – 10 mm THK. TEMPERED BLUE TINTED GLASS (OUTER) + 9 mm AIR SPACE + 8 mm THK. TEMPERED CLEAR GLASS (INNER)
- G2 – 8 mm THK. HEAT STRENGTHENED TINTED GLASS (OUTER)+ 9 mm AIR SPACE + 8 mm THK. HEAT STRENGTHENED CLEAR GLASS (INNER)
- G3 – 10 mm THK. HEAT STRENGTHENED BLUE TINTED GLASS (OUTER)+ 9 mm AIR SPACE + 8 mm THK. TEMPERED CLEAR GLASS (INNER)
- G4 – 8 mm THK. HEAT STRENGTHENED BLUE TINTED GLASS (SPANDREL GLASS)
- G5 – 8 mm THK. HEAT STRENGTHENED BLUE TINTED GLASS (OUTER)+ 9 mm AIR SPACE + 8 mm THK. TEMPERED CLEAR GLASS (INNER)
- G6 – 8 mm THK. TEMPERED BLUE TINTED GLASS (SPANDREL GLASS)
- G7 – 8 mm THK. HEAT STRENGTHENED TINTED GLASS (OUTER)+ 1.52PVB + 8 mm THK. HEAT STRENGTHENED CLEAR LAMINATED GLASS (INNER)
- 10 mm THK. TEMPERED GLASS (INTERNAL PROTECTIVE BARRIER)
- 3 mm THK. ALUM. CLADDING
- M.W. – MAINTENANCE WINDOW
- S.J. – STACK JOINT
- AE01 – ALUM. EXTRUSION DIE NO.
- ▲ – SUPPORT POINT
- ✦ – RESTRAINT SOCKET

B.D. REF :

CLIENT :
信和置業有限公司
Sino Land Company Limited

ARCHITECT : WONG TUNG & PARTNERS LIMITED
ARCHITECTS & PLANNERS

MAIN CONTRACTOR :
CR Construction Company Limited

STRUCTURAL ENGINEER :
AECOM

FACADE CONSULTANT:
AECOM

NOTE :
1. ALL DIMENSIONS ARE IN mm.
2. ALL ELEVATIONS ARE VIEWED FROM OUTSIDE.
3. ALL DIMENSIONS TO BE VERIFIED ON SITE BEFORE FABRICATION.

LEGEND :
X1 / X001 — DETAIL MARK NO. / REFER SHEET NO.
1. F.F.L. --FINISHED FLOOR LEVEL
2. S.F.L. --STRUCTURAL FLOOR LEVEL
3. (/R) --REVERSED DETAIL

NO.	DATE	REVISED	BY
B	16/07/2019	GENERAL REVISED	
A	26/05/2019	GENERAL REVISED	

JOB NO. : J-837

PROJECT :
URA KWUN TONG TOWN CENTRE REDEVELOPMENT (AREA 2 & 3) AT NKIL 6514, KWUN TONG, KWLOON

TITLE :
PART ELEVATION OF CURTAIN WALL AT TOWER 1

DATE : 18-FEB-19 | SCALE : 1:60 (A1)

DRAWN BY : ASING | CHECKED BY : -

美特鋁質有限公司
MIDI ALUMINIUM FABRICATOR LTD.
Units 6-8, Sunray Industrial Centre, 1/F
610 Cha Kwo Ling Road, Kowloon
Tel:23489211-4 Fax:(852)27727666

DWG NO. : J837-CW-2114 | REV. : B

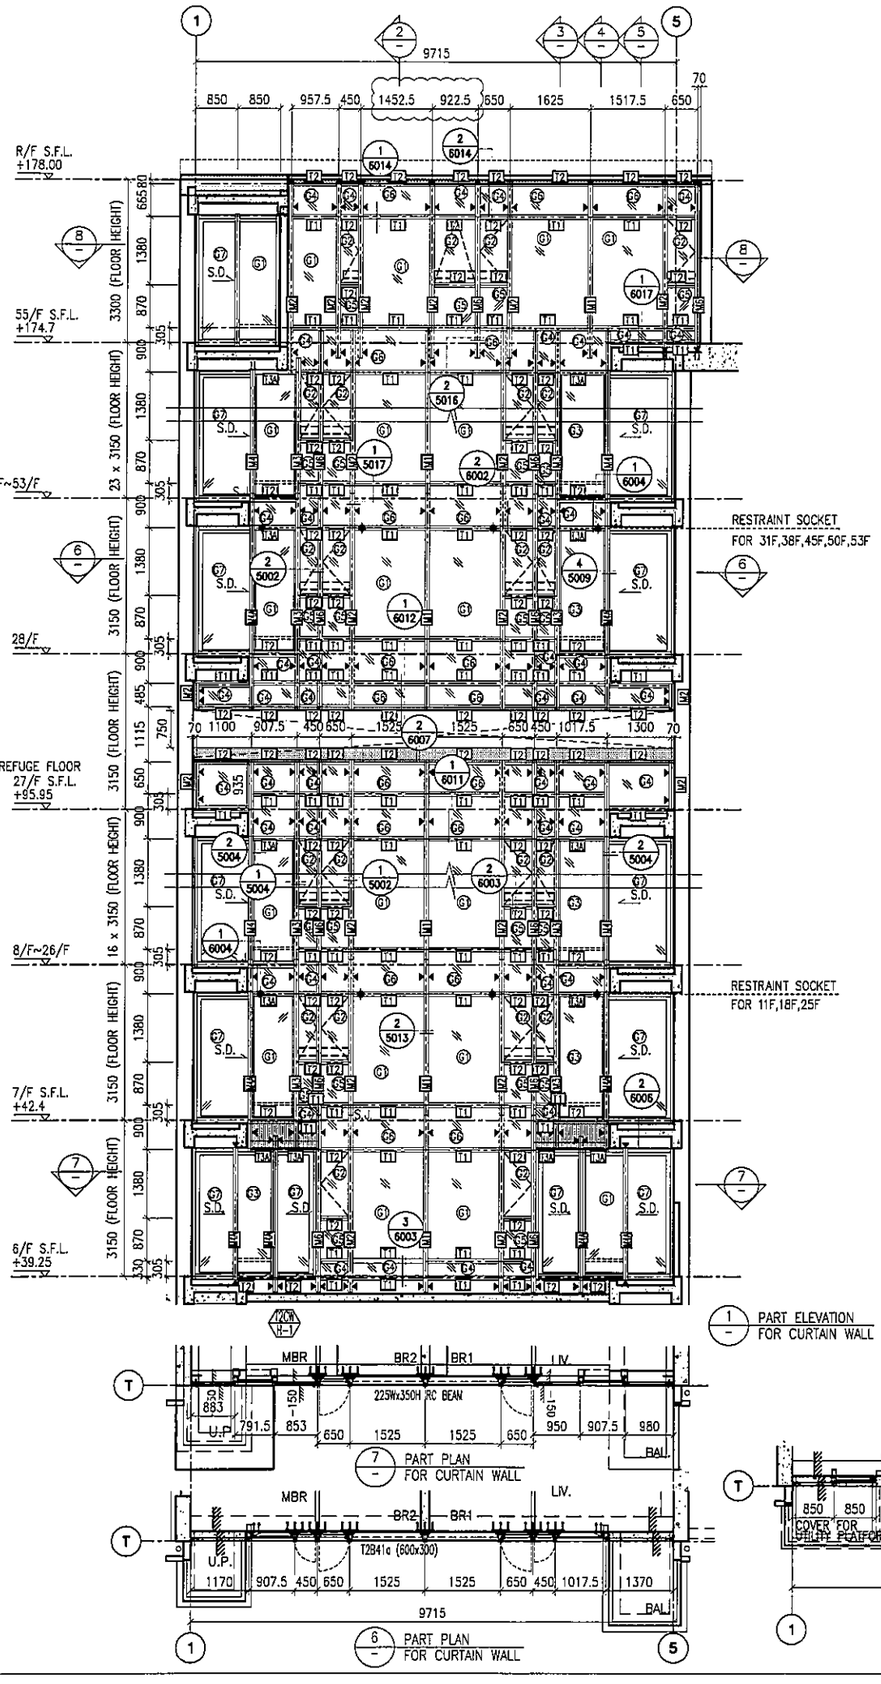

1 PART ELEVATION FOR CURTAIN WALL

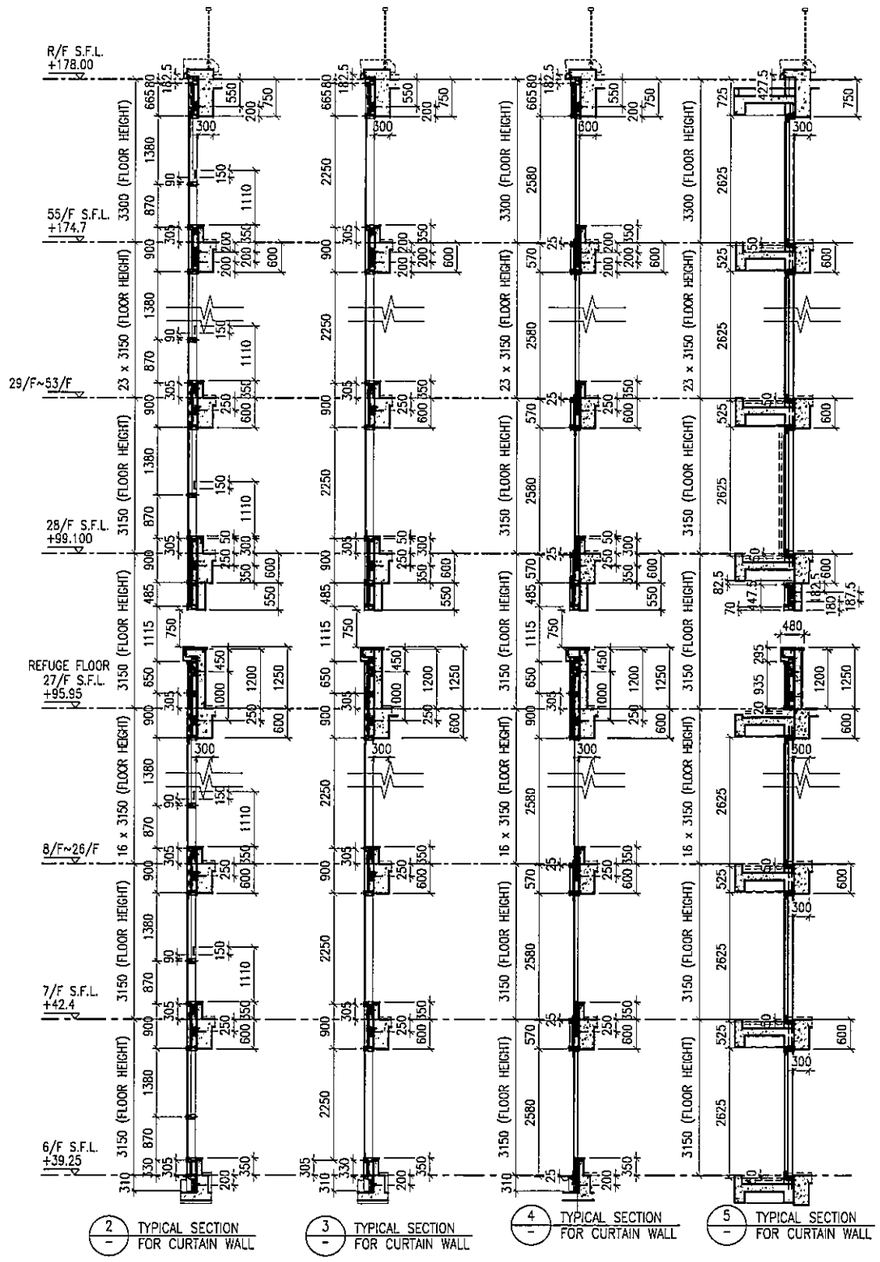

2 TYPICAL SECTION FOR CURTAIN WALL

3 TYPICAL SECTION FOR CURTAIN WALL

4 TYPICAL SECTION FOR CURTAIN WALL

5 TYPICAL SECTION FOR CURTAIN WALL

7 PART PLAN FOR CURTAIN WALL

6 PART PLAN FOR CURTAIN WALL

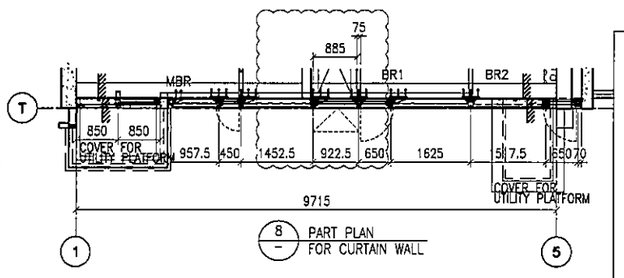

8 PART PLAN FOR CURTAIN WALL

LEGEND:

- 10 mm THK. TEMPERED BLUE TINTED GLASS (OUTER) + 9 mm AIR SPACE + 8 mm THK. TEMPERED CLEAR GLASS (INNER)
- 8 mm THK. HEAT STRENGTHENED TINTED GLASS (OUTER)+ 9 mm AIR SPACE + 8 mm THK. HEAT STRENGTHENED CLEAR GLASS (INNER)
- 10 mm THK. HEAT STRENGTHENED BLUE TINTED GLASS (OUTER)+ 9 mm AIR SPACE + 8 mm THK. TEMPERED CLEAR GLASS (INNER)
- 8 mm THK. HEAT STRENGTHENED BLUE TINTED GLASS (SPANDREL GLASS)
- 8 mm THK. HEAT STRENGTHENED BLUE TINTED GLASS (OUTER)+ 9 mm AIR SPACE + 8 mm THK. TEMPERED CLEAR GLASS (INNER)
- 8 mm THK. TEMPERED BLUE TINTED GLASS (SPANDREL GLASS)
- 8 mm THK. HEAT STRENGTHENED TINTED GLASS (OUTER)+ 1.52PVB + 8 mm THK. HEAT STRENGTHENED CLEAR LAMINATED GLASS (INNER) 10 mm THK. TEMPERED GLASS (INTERNAL PROTECTIVE BARRIER)
- 3 mm THK. ALUM. CLADDING
- M.W. – MAINTENANCE WINDOW
- S.J. – STACK JOINT
- AE01 – ALUM. EXTRUSION DIE NO.
- ▲ – SUPPORT POINT
- ◆ – RESTRAINT SOCKET

B.D. REF :

CLIENT :
信和置業有限公司
Sino Land Company Limited

ARCHITECT :
WONG TUNG & PARTNERS LIMITED
ARCHITECTS & PLANNERS

MAIN CONTRACTOR :
CR Construction Company Limited

STRUCTURAL ENGINEER :
AECOM

FACADE CONSULTANT:
AECOM

NOTE :
1. ALL DIMENSIONS ARE IN mm.
2. ALL ELEVATIONS ARE VIEWED FROM OUTSIDE.
3. ALL DIMENSIONS TO BE VERIFIED ON SITE BEFORE FABRICATION.

LEGEND :
- X1 / X001 – DETAIL MARK NO. / REFER SHEET NO.
1. F.F.L. --FINISHED FLOOR LEVEL
2. S.F.L. --STRUCTURAL FLOOR LEVEL
3. (R) --REVERSED DETAIL

NO.	DATE	REVISED	BY
I	02/08/2019	GENERAL REVISED	
H	16/07/2019	GENERAL REVISED	
G	26/05/2019	GENERAL REVISED	
F	07/04/2019	GENERAL REVISED	
E	17/01/2019	GENERAL REVISED	
D	22/12/2018	GENERAL REVISED	
C	04/12/2018	GENERAL REVISED	
B	24/11/2018	GENERAL REVISED	
A	10/9/2018	GENERAL REVISED	

JOB NO. : J-837

PROJECT :
URA KWUN TONG TOWN CENTRE REDEVELOPMENT (AREA 2 & 3) AT NKIL 6514, KWUN TONG, KWLOON

TITLE :
PART ELEVATION OF CURTAIN WALL AT TOWER 2

DATE : 04-JUL-18	SCALE : 1:60 (A1)
DRAWN BY : ASING	CHECKED BY : –

美特鋁質有限公司
MIDI ALUMINIUM FABRICATOR LTD.
Units 6-8, Sunray Industrial Centre, 1/F
610 Cha Kwo Ling Road, Kowloon
Tel:23489211-4 Fax:(852)27727666

DWG NO. : JB37-CW-2201 REV. : I

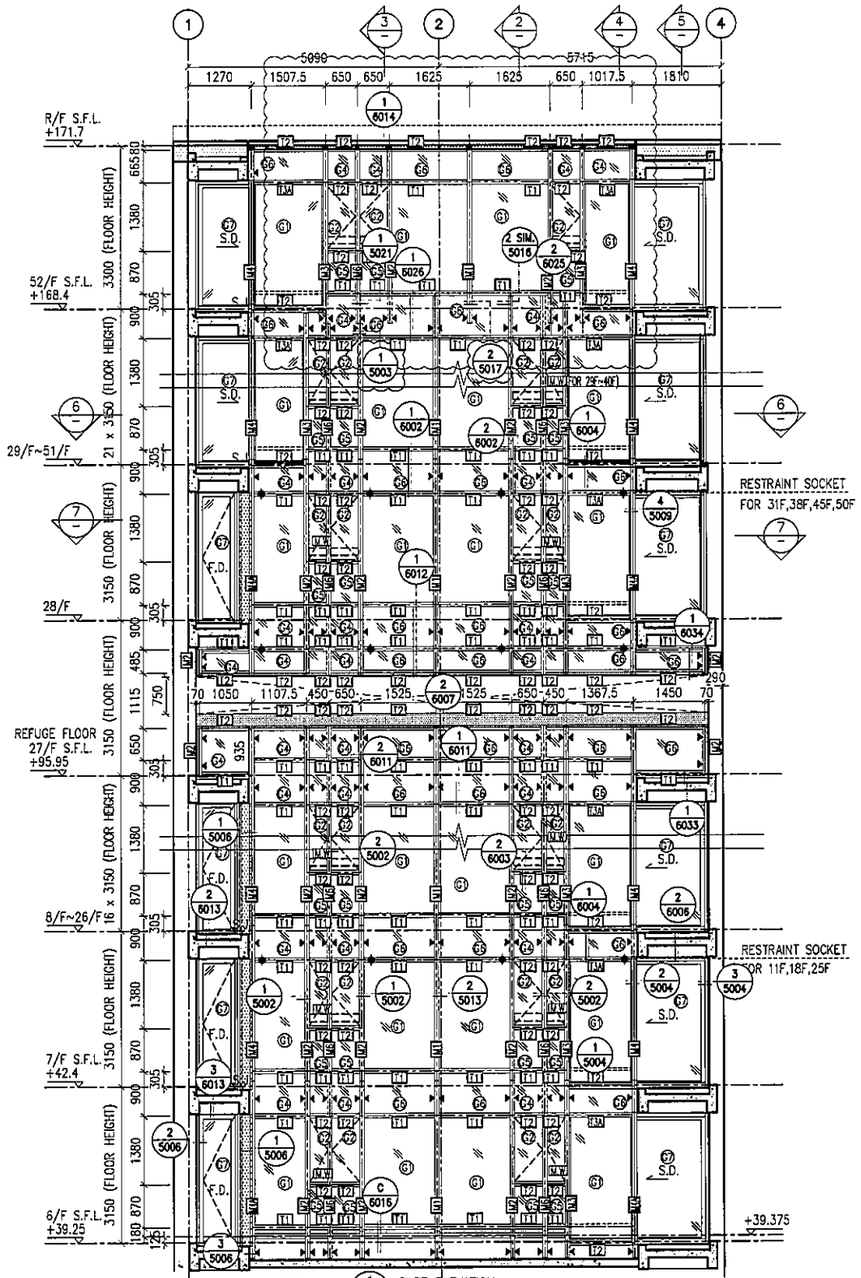

1 PART ELEVATION FOR CURTAIN WALL

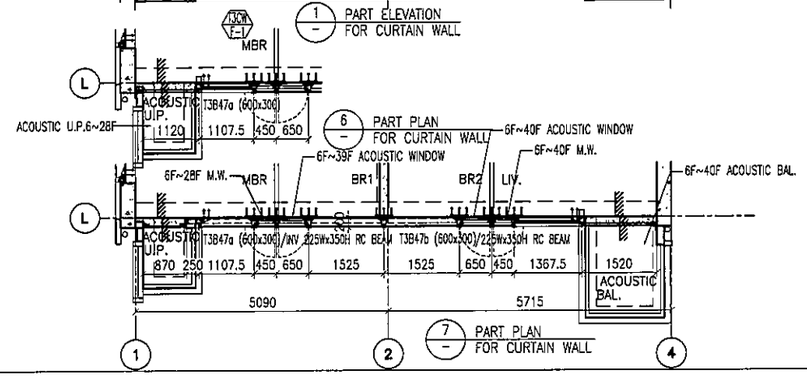

6 PART PLAN FOR CURTAIN WALL

7 PART PLAN FOR CURTAIN WALL

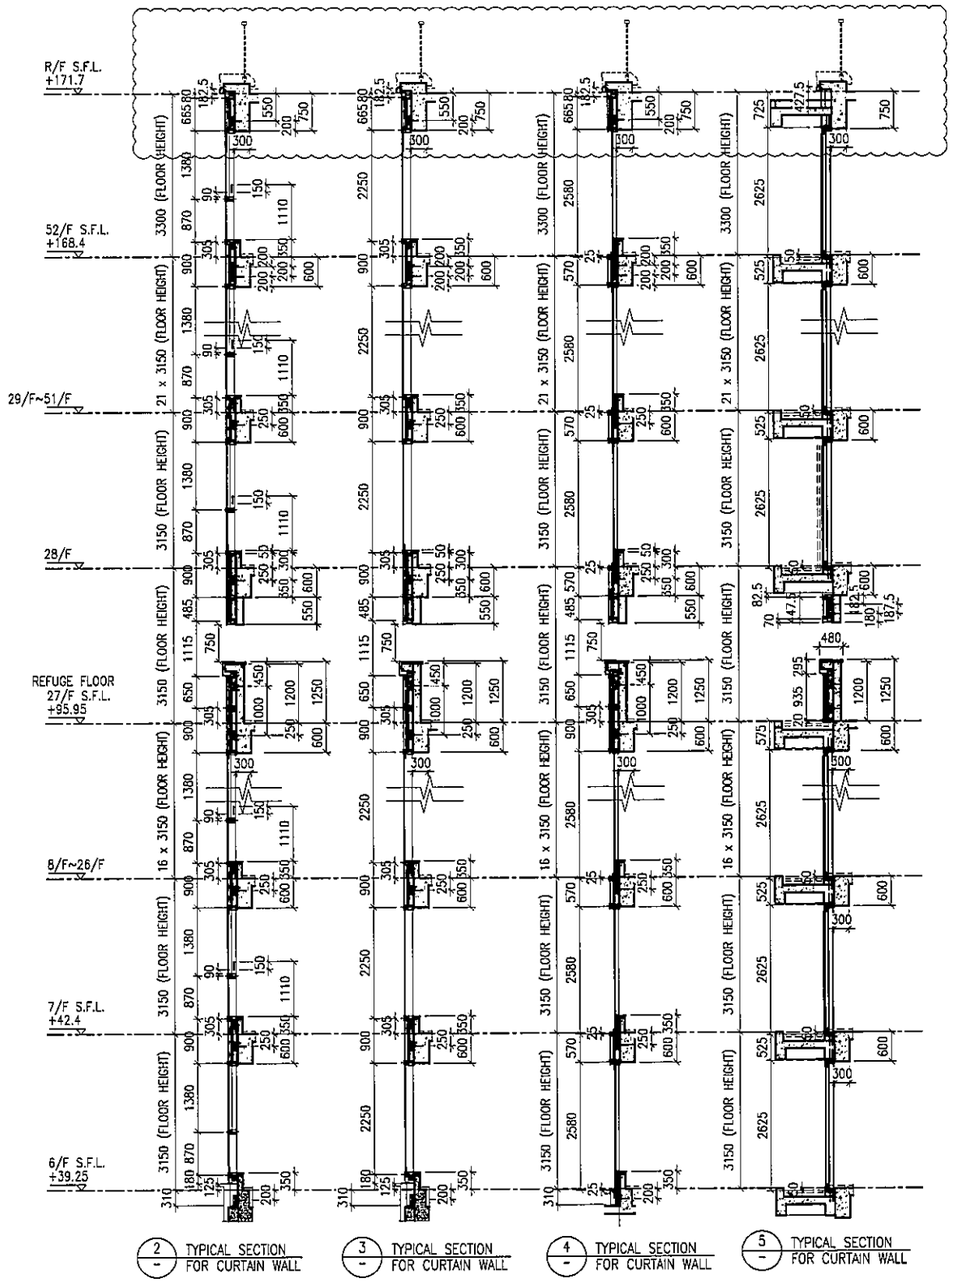

2 TYPICAL SECTION FOR CURTAIN WALL

3 TYPICAL SECTION FOR CURTAIN WALL

4 TYPICAL SECTION FOR CURTAIN WALL

5 TYPICAL SECTION FOR CURTAIN WALL

LEGEND:

- G1 – 10 mm THK. TEMPERED BLUE TINTED GLASS (OUTER) + 9 mm AIR SPACE + 8 mm THK. TEMPERED CLEAR GLASS (INNER)
- G2 – 8 mm THK. HEAT STRENGTHENED TINTED GLASS (OUTER)+ 9 mm AIR SPACE + 8 mm THK. HEAT STRENGTHENED CLEAR GLASS (INNER)
- G3 – 10 mm THK. HEAT STRENGTHENED BLUE TINTED GLASS (OUTER)+ 9 mm AIR SPACE + 8 mm THK. TEMPERED CLEAR GLASS (INNER)
- G4 – 8 mm THK. HEAT STRENGTHENED BLUE TINTED GLASS (SPANDREL GLASS)
- G5 – 8 mm THK. HEAT STRENGTHENED BLUE TINTED GLASS (OUTER)+ 9 mm AIR SPACE + 8 mm THK. TEMPERED CLEAR GLASS (INNER)
- G6 – 8 mm THK. TEMPERED BLUE TINTED GLASS (SPANDREL GLASS)
- G7 – 8 mm THK. HEAT STRENGTHENED TINTED GLASS (OUTER)+ 1.52PVB + 8 mm THK. HEAT STRENGTHENED CLEAR LAMINATED GLASS (INNER)
- 10 mm THK. TEMPERED GLASS (INTERNAL PROTECTIVE BARRIER)
- 3 mm THK. ALUM. CLADDING
- M.W. – MAINTENANCE WINDOW
- S.J. – STACK JOINT
- AE-01 – ALUM. EXTRUSION DIE NO.
- ▲ – SUPPORT POINT
- ◆ – RESTRAINT SOCKET

B.D. REF :

CLIENT :
信和置業有限公司
Sino Land Company Limited

ARCHITECT :
WONG TUNG & PARTNERS LIMITED
ARCHITECTS & PLANNERS

MAIN CONTRACTOR :
CR Construction Company Limited

STRUCTURAL ENGINEER :
AECOM

FACADE CONSULTANT:
AECOM

NOTE :
1. ALL DIMENSIONS ARE IN mm.
2. ALL ELEVATIONS ARE VIEWED FROM OUTSIDE.
3. ALL DIMENSIONS TO BE VERIFIED ON SITE BEFORE FABRICATION.

LEGEND :
- X1 / X001 – DETAIL MARK NO. / REFER SHEET NO.
1. F.F.L. --FINISHED FLOOR LEVEL
2. S.F.L. --STRUCTURAL FLOOR LEVEL
3. (R) --REVERSED DETAIL

NO.	DATE	REVISED	BY
H	16/07/2019	GENERAL REVISED	
G	26/5/2019	GENERAL REVISED	
F	6/3/2019	GENERAL REVISED	
E	17/01/2019	GENERAL REVISED	
D	22/12/2018	GENERAL REVISED	
C	04/12/2018	GENERAL REVISED	
B	24/11/2018	GENERAL REVISED	
A	10/9/2018	GENERAL REVISED	

JOB NO. : J-837

PROJECT :
URA KWUN TONG TOWN CENTRE REDEVELOPMENT (AREA 2 & 3) AT NKIL 6514, KWUN TONG, KWLOON

TITLE :
PART ELEVATION OF CURTAIN WALL AT TOWER 3

DATE : 04-JUL-18	SCALE : 1:60 (A1)
DRAWN BY : ASING	CHECKED BY : -

美特鋁質有限公司
MIDI ALUMINIUM FABRICATOR LTD.
Units 6-8, Sunray Industrial Centre, 1/F
610 Cha Kwo Ling Road, Kowloon
Tel:23489211-4 Fax:(852)27727666

DWG NO. : J837-CW-2301 REV. : H

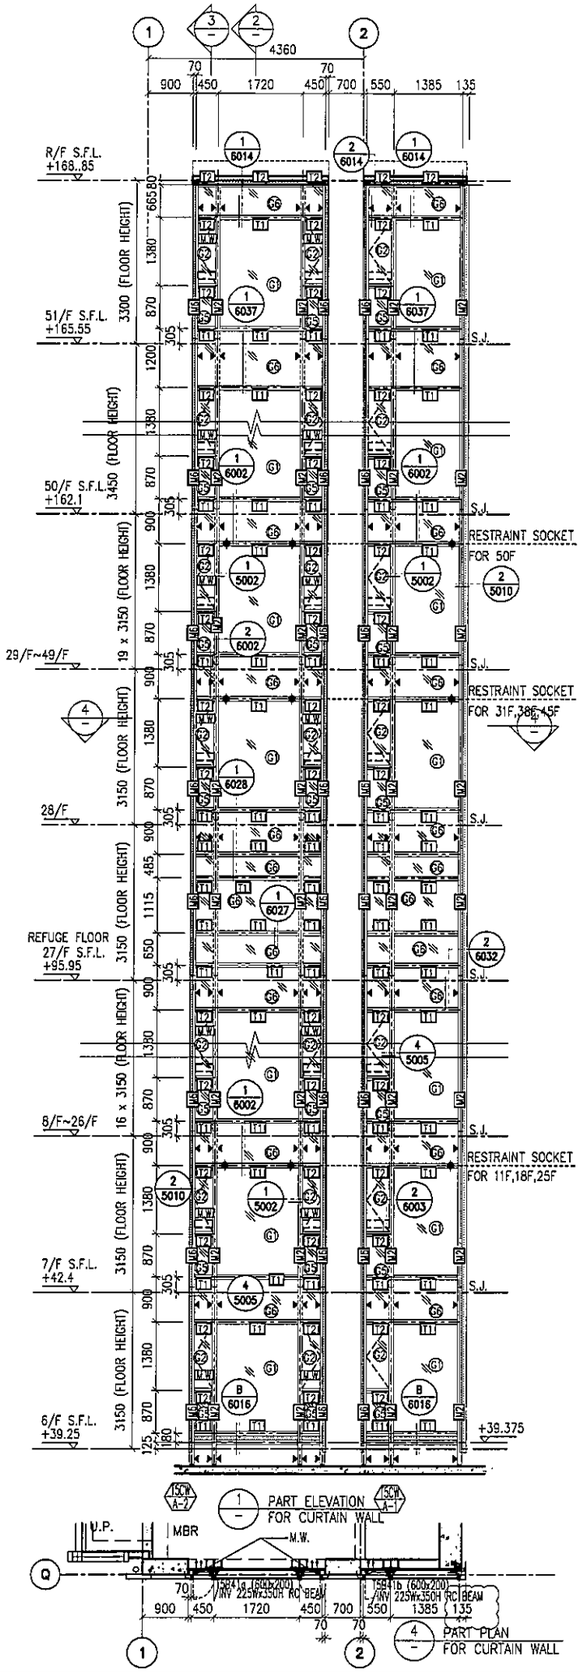

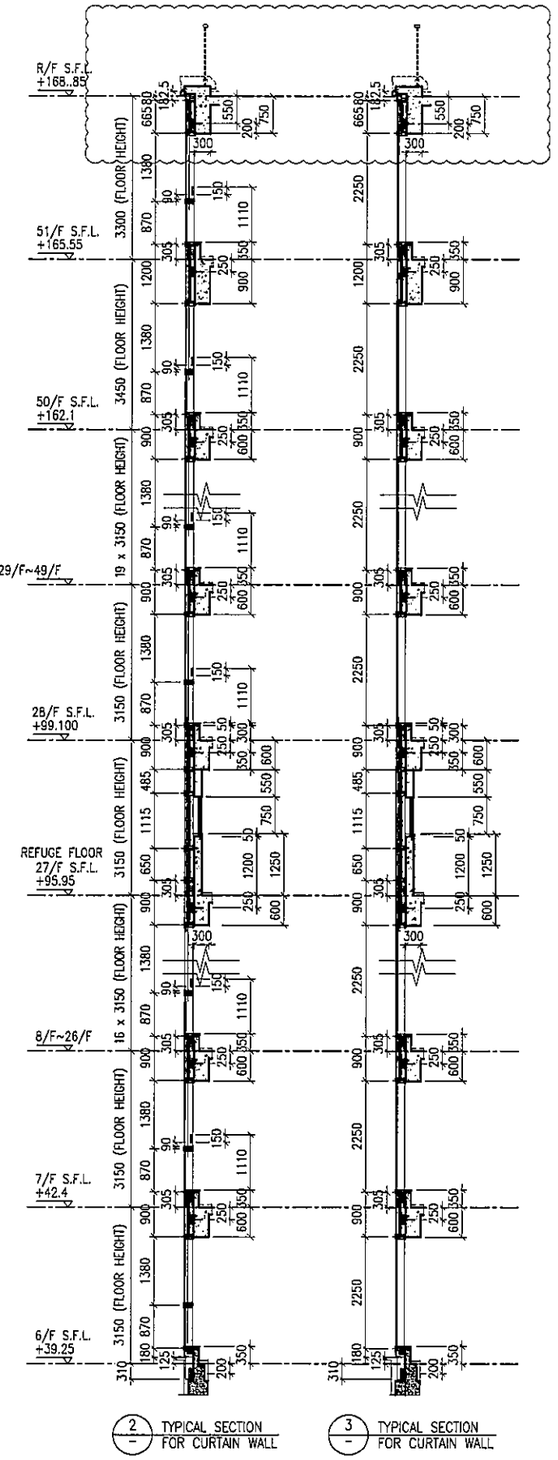

LEGEND:

- G1+ – 10 mm THK. TEMPERED BLUE TINTED GLASS (OUTER) + 9 mm AIR SPACE + 8 mm THK. TEMPERED CLEAR GLASS (INNER)
- G2+ – 8 mm THK. HEAT STRENGTHENED TINTED GLASS (OUTER)+ 9 mm AIR SPACE + 8 mm THK. HEAT STRENGTHENED CLEAR GLASS (INNER)
- G3+ – 10 mm THK. HEAT STRENGTHENED BLUE TINTED GLASS (OUTER)+ 9 mm AIR SPACE + 8 mm THK. TEMPERED CLEAR GLASS (INNER)
- G4+ – 8 mm THK. HEAT STRENGTHENED BLUE TINTED GLASS (SPANDREL GLASS)
- G5+ – 8 mm THK. HEAT STRENGTHENED BLUE TINTED GLASS (OUTER)+ 9 mm AIR SPACE + 8 mm THK. TEMPERED CLEAR GLASS (INNER)
- G6+ – 8 mm THK. TEMPERED BLUE TINTED GLASS (SPANDREL GLASS)
- G7+ – 8 mm THK. HEAT STRENGTHENED TINTED GLASS (OUTER)+ 1.52PVB + 8 mm THK. HEAT STRENGTHENED CLEAR LAMINATED GLASS (INNER)
- 10 mm THK. TEMPERED GLASS (INTERNAL PROTECTIVE BARRIER)
- 3 mm THK. ALUM. CLADDING
- M.W. – MAINTENANCE WINDOW
- S.J. – STACK JOINT
- AE01 – ALUM. EXTRUSION DIE NO.
- ▲ – SUPPORT POINT
- ✦ – RESTRAINT SOCKET

B.D. REF :

CLIENT :
信和置業有限公司
Sino Land Company Limited

ARCHITECT :
WONG TUNG & PARTNERS LIMITED
ARCHITECTS & PLANNERS

MAIN CONTRACTOR :
CR Construction Company Limited

STRUCTURAL ENGINEER :
AECOM

FACADE CONSULTANT:
AECOM

NOTE :
1. ALL DIMENSIONS ARE IN mm.
2. ALL ELEVATIONS ARE VIEWED FROM OUTSIDE.
3. ALL DIMENSIONS TO BE VERIFIED ON SITE BEFORE FABRICATION.

LEGEND :
- X1 / X001 — DETAIL MARK NO. / REFER SHEET NO.
1. F.F.L. --FINISHED FLOOR LEVEL
2. S.F.L. --STRUCTURAL FLOOR LEVEL
3. /R --REVERSED DETAIL

NO.	DATE	REVISED	BY
F	16/07/2019	GENERAL REVISED	
E	17/01/2019	GENERAL REVISED	
D	22/12/2018	GENERAL REVISED	
C	04/12/2018	GENERAL REVISED	
B	24/11/2018	GENERAL REVISED	
A	10/9/2018	GENERAL REVISED	

JOB NO. : J-837

PROJECT :
URA KWUN TONG TOWN CENTRE REDEVELOPMENT (AREA 2 & 3) AT NKIL 6514, KWUN TONG, KWLOON

TITLE :
PART ELEVATION OF CURTAIN WALL AT TOWER 5

DATE : 04-JUL-18 | SCALE : 1:60 (A1)

DRAWN BY : ASING | CHECKED BY : -

美特鋁製有限公司
MIDI ALUMINIUM FABRICATOR LTD.
Units 6-8, Sunray Industrial Centre, 1/F
610 Cha Kwo Ling Road, Kowloon
Tel:23489211-4 Fax:(852)27727686

DWG NO. : J837-CW-2501 | REV. : F

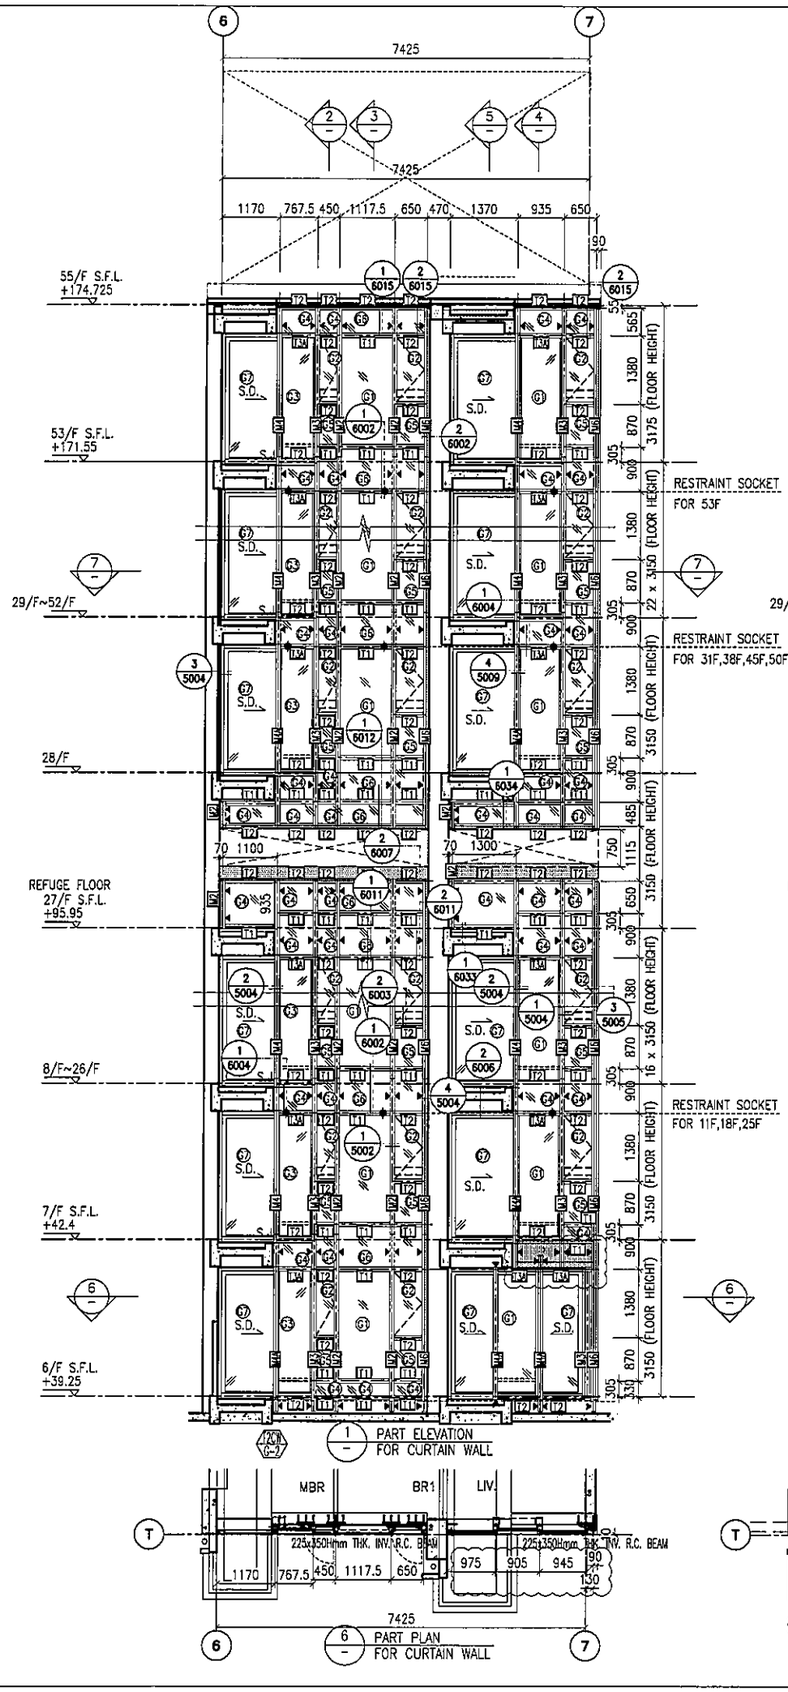

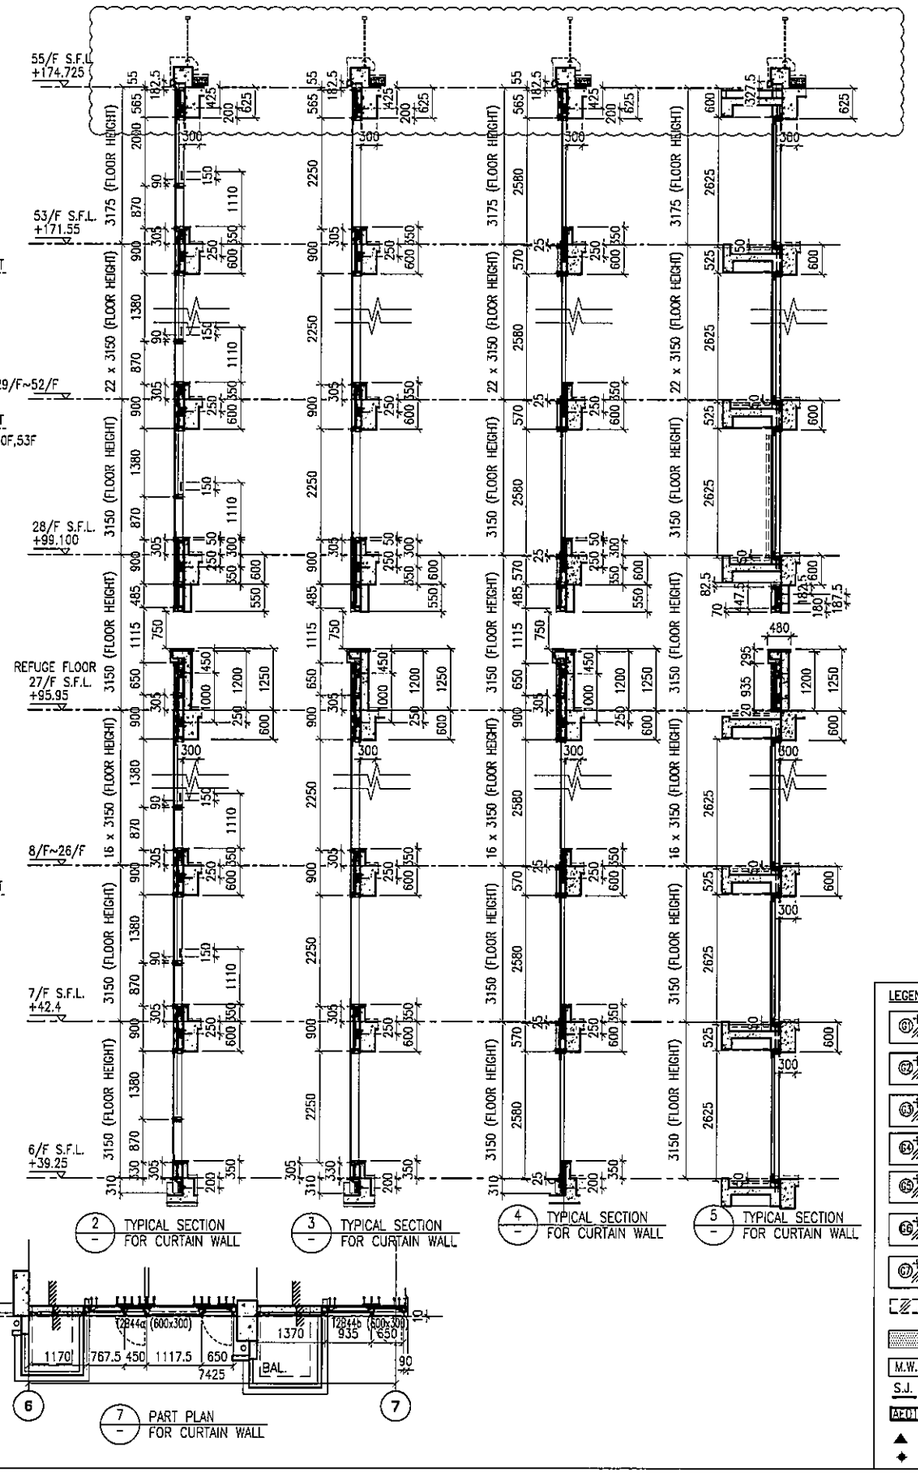

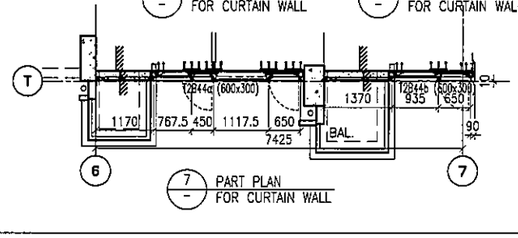

LEGEND:

- G1+ – 10 mm THK. TEMPERED BLUE TINTED GLASS (OUTER) + 9 mm AIR SPACE + 8 mm THK. TEMPERED CLEAR GLASS (INNER)
- G2+ – 8 mm THK. HEAT STRENGTHENED TINTED GLASS (OUTER)+ 9 mm AIR SPACE + 8 mm THK. HEAT STRENGTHENED CLEAR GLASS (INNER)
- G3+ – 10 mm THK. HEAT STRENGTHENED BLUE TINTED GLASS (OUTER)+ 9 mm AIR SPACE + 8 mm THK. TEMPERED CLEAR GLASS (INNER)
- G4+ – 8 mm THK. HEAT STRENGTHENED BLUE TINTED GLASS (SPANDREL GLASS)
- G5+ – 8 mm THK. HEAT STRENGTHENED BLUE TINTED GLASS (OUTER)+ 9 mm AIR SPACE + 8 mm THK. TEMPERED CLEAR GLASS (INNER)
- G6+ – 8 mm THK. TEMPERED BLUE TINTED GLASS (SPANDREL GLASS)
- G7+ – 8 mm THK. HEAT STRENGTHENED TINTED GLASS (OUTER)+ 1.52PVB + 8 mm THK. HEAT STRENGTHENED CLEAR LAMINATED GLASS (INNER)
- 10 mm THK. TEMPERED GLASS (INTERNAL PROTECTIVE BARRIER)
- 3 mm THK. ALUM. CLADDING
- M.W. – MAINTENANCE WINDOW
- S.J. – STACK JOINT
- AP01 – ALUM. EXTRUSION DIE NO.
- ▲ – SUPPORT POINT
- ◆ – RESTRAINT SOCKET

B.O. REF :

CLIENT :
信和置業有限公司
Sino Land Company Limited

ARCHITECT :
WONG TUNG & PARTNERS LIMITED
ARCHITECTS & PLANNERS

MAIN CONTRACTOR :
CR Construction Company Limited

STRUCTURAL ENGINEER :
AECOM

FACADE CONSULTANT:
AECOM

NOTE :
1. ALL DIMENSIONS ARE IN mm.
2. ALL ELEVATIONS ARE VIEWED FROM OUTSIDE.
3. ALL DIMENSIONS TO BE VERIFIED ON SITE BEFORE FABRICATION.

LEGEND :
- X1 / XC01 — DETAIL MARK NO. / REFER SHEET NO.
1. F.F.L. --FINISHED FLOOR LEVEL
2. S.F.L. --STRUCTURAL FLOOR LEVEL
3. (R) --REVERSED DETAIL

NO.	DATE	REVISED	BY
G	16/07/2019	GENERAL REVISED	
F	26/05/2019	GENERAL REVISED	
E	17/01/2019	GENERAL REVISED	
D	22/12/2018	GENERAL REVISED	
C	04/12/2018	GENERAL REVISED	
B	24/11/2018	GENERAL REVISED	
A	10/9/2018	GENERAL REVISED	

JOB NO. : J-837

PROJECT :
URA KWUN TONG TOWN CENTRE REDEVELOPMENT (AREA 2 & 3) AT NKIL 6514, KWUN TONG, KWLOON

TITLE :
PART ELEVATION OF CURTAIN WALL AT TOWER 2

DATE : 04-JUL-18 | SCALE : 1:60 (A1)

DRAWN BY : ASING | CHECKED BY : --

美特鋁質有限公司
MIDI ALUMINIUM FABRICATOR LTD.
Units 6-8, Sunray Industrial Centre, 1/F
610 Cha Kwo Ling Road, Kowloon
Tel:23489211-4 Fax:(852)27727666

DWG NO. : J837-CW-2202 | REV. : G

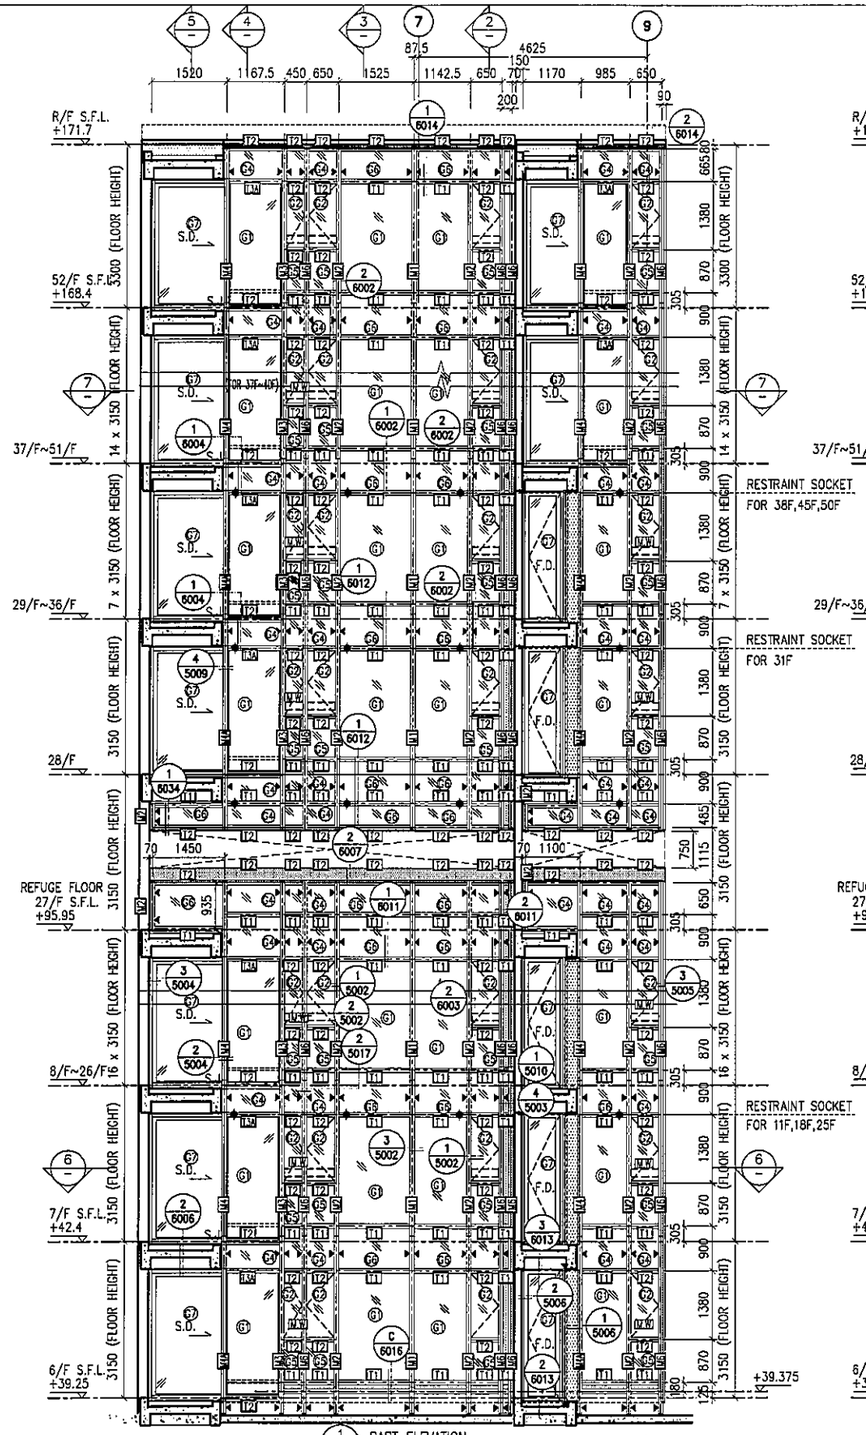

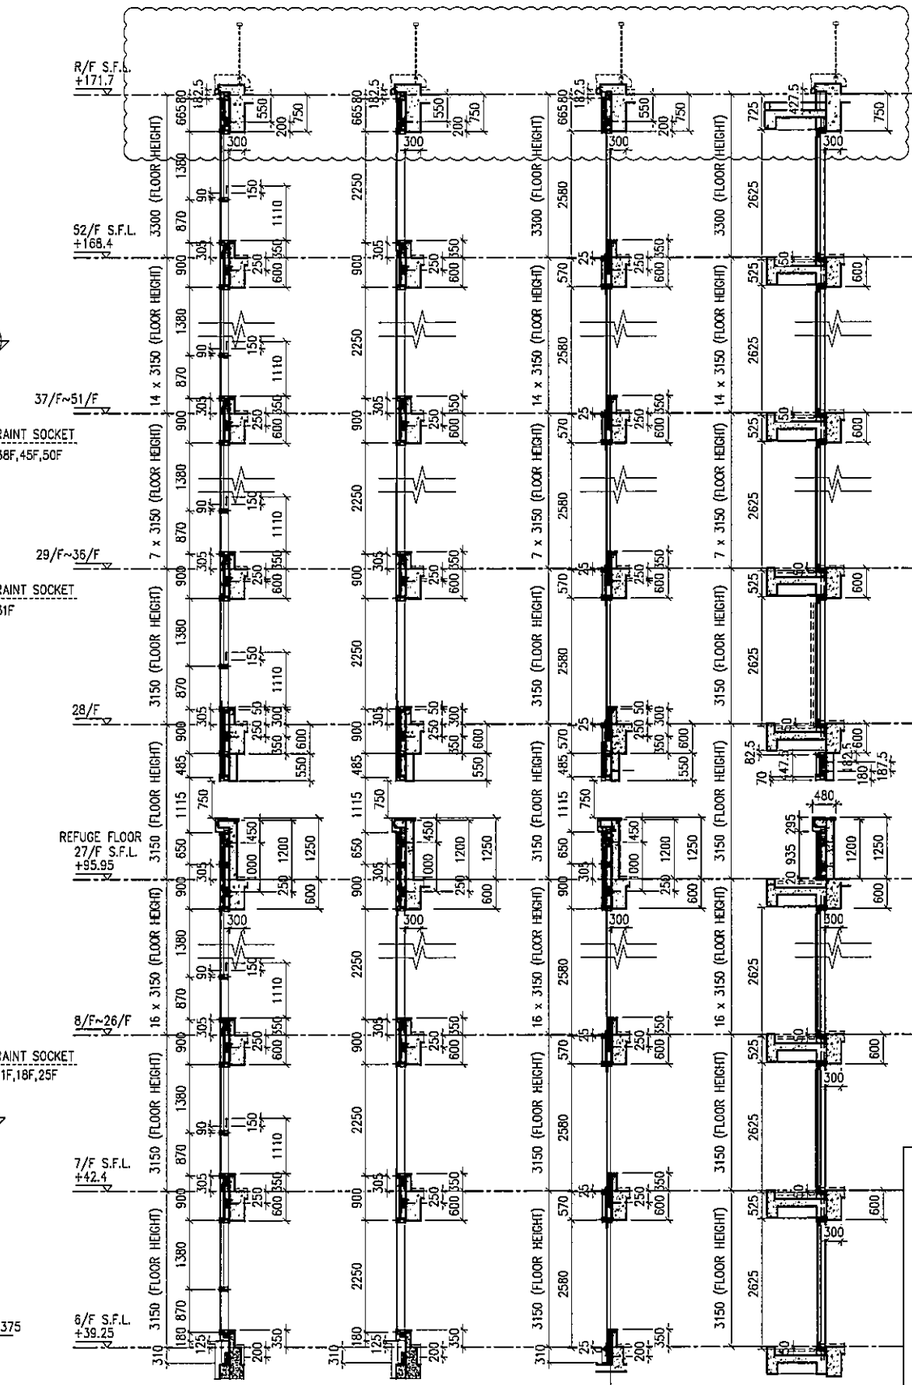

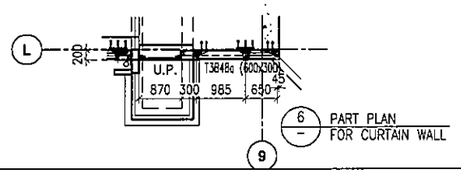

LEGEND:

- G1 – 10 mm THK. TEMPERED BLUE TINTED GLASS (OUTER) + 9 mm AIR SPACE + 8 mm THK. TEMPERED CLEAR GLASS (INNER)
- G2 – 8 mm THK. HEAT STRENGTHENED TINTED GLASS (OUTER)+ 9 mm AIR SPACE + 8 mm THK. HEAT STRENGTHENED CLEAR GLASS (INNER)
- G3 – 10 mm THK. HEAT STRENGTHENED BLUE TINTED GLASS (OUTER)+ 9 mm AIR SPACE + 8 mm THK. TEMPERED CLEAR GLASS (INNER)
- G4 – 8 mm THK. HEAT STRENGTHENED BLUE TINTED GLASS (SPANDREL GLASS)
- G5 – 8 mm THK. HEAT STRENGTHENED BLUE TINTED GLASS (OUTER)+ 9 mm AIR SPACE + 8 mm THK. TEMPERED CLEAR GLASS (INNER)
- G6 – 8 mm THK. TEMPERED BLUE TINTED GLASS (SPANDREL GLASS)
- G7 – 8 mm THK. HEAT STRENGTHENED TINTED GLASS (OUTER)+ 1.52PVB + 8 mm THK. HEAT STRENGTHENED CLEAR LAMINATED GLASS (INNER)
- 10 mm THK. TEMPERED GLASS (INTERNAL PROTECTIVE BARRIER)
- 3 mm THK. ALUM. CLADDING
- M.W. – MAINTENANCE WINDOW
- S.J. – STACK JOINT
- AE01 – ALUM. EXTRUSION DIE NO.
- ▲ – SUPPORT POINT
- ✦ – RESTRAINT SOCKET

B.D. REF :

CLIENT :
信和置業有限公司
Sino Land Company Limited

ARCHITECT : WONG TUNG & PARTNERS LIMITED ARCHITECTS & PLANNERS

MAIN CONTRACTOR :
CR Construction Company Limited

STRUCTURAL ENGINEER :
AECOM

FACADE CONSULTANT:
AECOM

NOTE :
1. ALL DIMENSIONS ARE IN mm.
2. ALL ELEVATIONS ARE VIEWED FROM OUTSIDE.
3. ALL DIMENSIONS TO BE VERIFIED ON SITE BEFORE FABRICATION.

LEGEND :
- X1 / X001 – DETAIL MARK NO. / REFER SHEET NO.
1. F.F.L. --FINISHED FLOOR LEVEL
2. S.F.L. --STRUCTURAL FLOOR LEVEL
3. (/R) --REVERSED DETAIL

NO.	DATE	REVISED	BY
F	16/07/2019	GENERAL REVISED	
E	17/01/2019	GENERAL REVISED	
D	22/12/2018	GENERAL REVISED	
C	04/12/2018	GENERAL REVISED	
B	24/11/2018	GENERAL REVISED	
A	10/9/2018	GENERAL REVISED	

JOB NO. : J-837

PROJECT :
URA KWUN TONG TOWN CENTRE REDEVELOPMENT (AREA 2 & 3) AT NKIL 6514, KWUN TONG, KWLOON

TITLE :
PART ELEVATION OF CURTAIN WALL AT TOWER 3

DATE : 04-JUL-18	SCALE : 1:60 (A1)
DRAWN BY : ASING	CHECKED BY : -

美特鋁質有限公司
MIDI ALUMINUM FABRICATOR LTD.
Units 6-8, Sunray Industrial Centre, 1/F
610 Cha Kwo Ling Road, Kowloon
Tel:23489211-4 Fax:(852)27727666

DWG NO. : J837-CW-2302 REV. : F

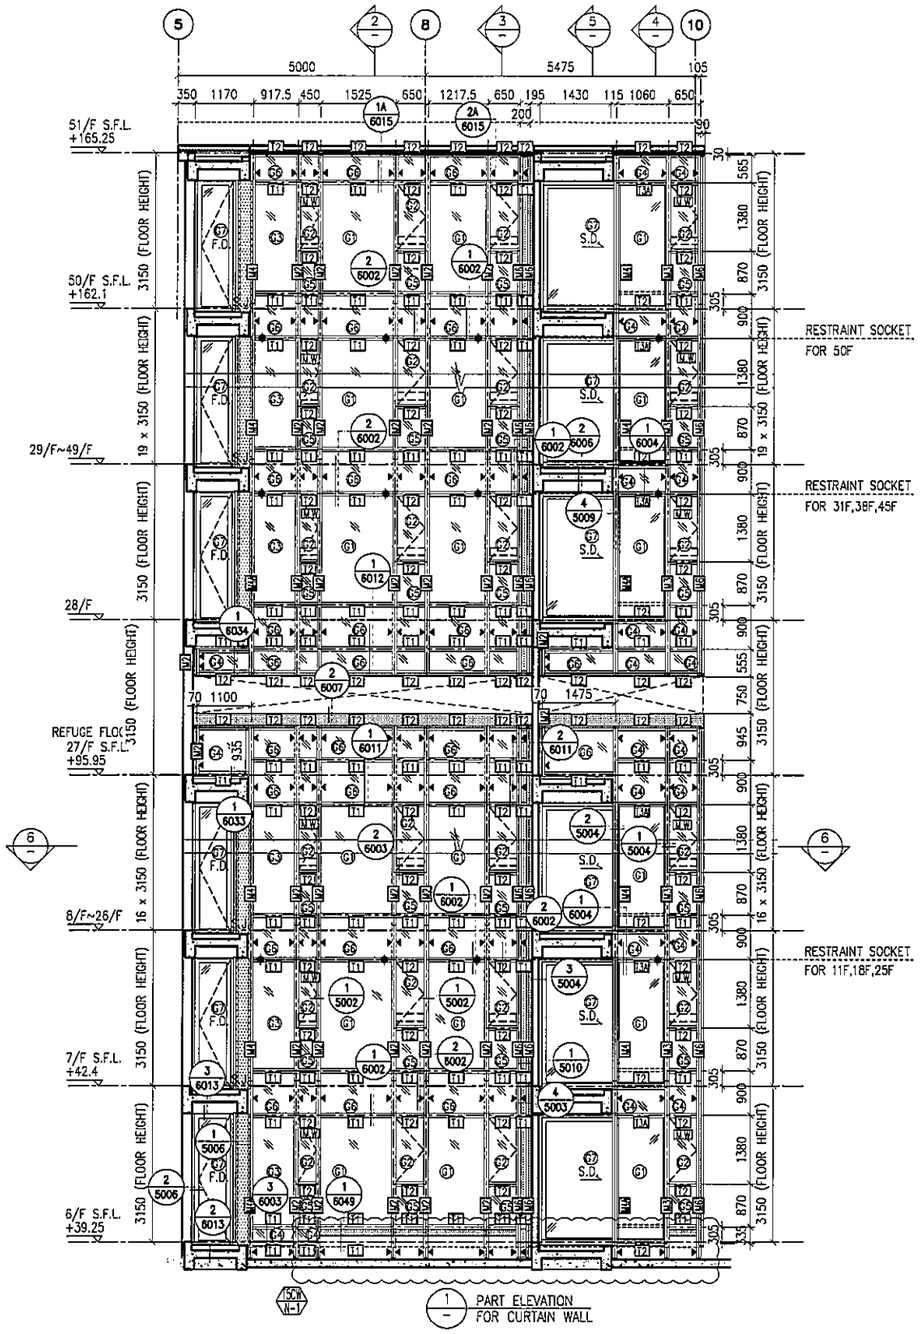

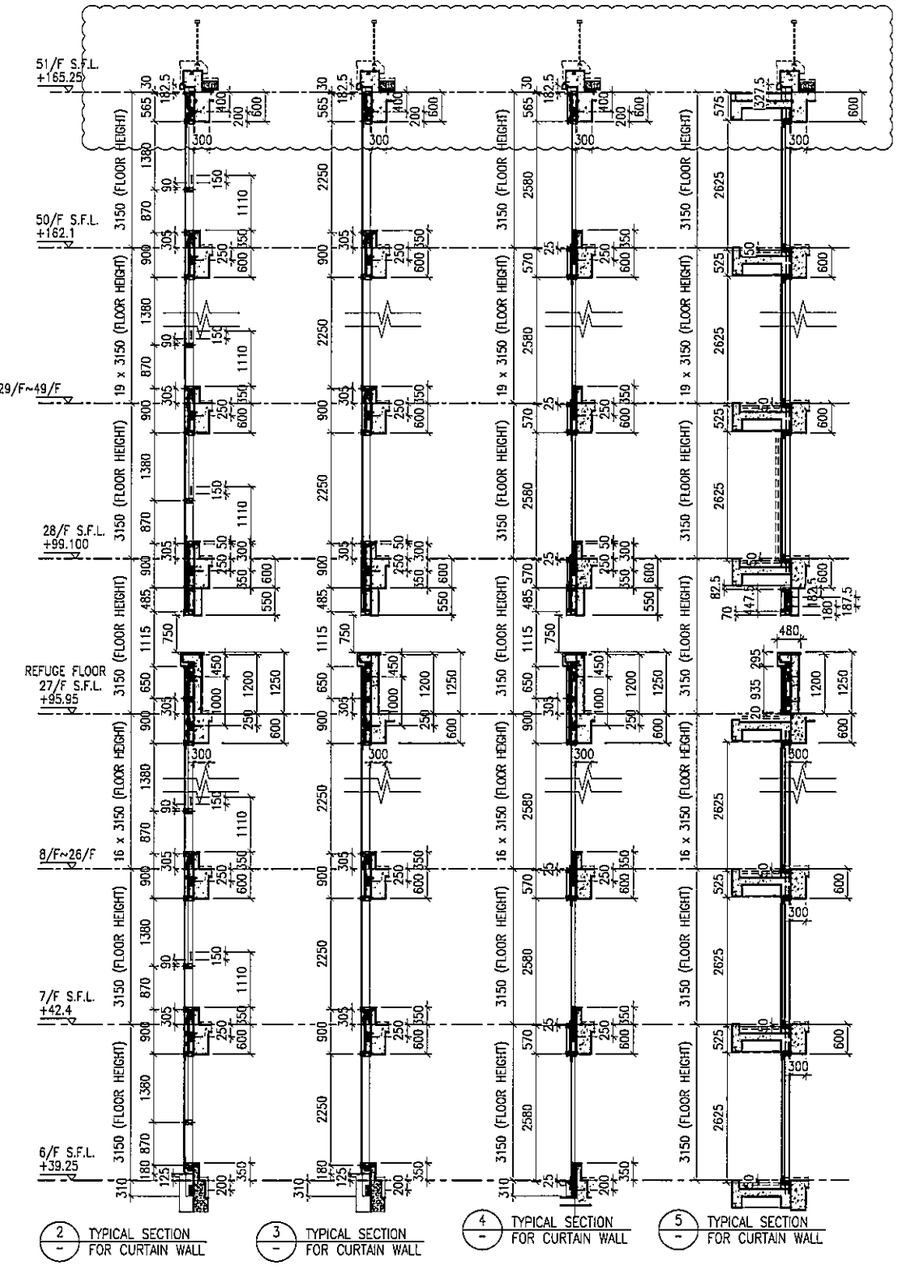

LEGEND:

- 10 mm THK. TEMPERED BLUE TINTED GLASS (OUTER) + 9 mm AIR SPACE + 8 mm THK. TEMPERED CLEAR GLASS (INNER)
- 8 mm THK. HEAT STRENGTHENED TINTED GLASS (OUTER)+ 9 mm AIR SPACE + 8 mm THK. HEAT STRENGTHENED CLEAR GLASS (INNER)
- 10 mm THK. HEAT STRENGTHENED BLUE TINTED GLASS (OUTER)+ 9 mm AIR SPACE + 8 mm THK. TEMPERED CLEAR GLASS (INNER)
- 8 mm THK. HEAT STRENGTHENED BLUE TINTED GLASS (SPANDREL GLASS)
- 8 mm THK. HEAT STRENGTHENED BLUE TINTED GLASS (OUTER)+ 9 mm AIR SPACE + 8 mm THK. TEMPERED CLEAR GLASS (INNER)
- 8 mm THK. TEMPERED BLUE TINTED GLASS (SPANDREL GLASS)
- 8 mm THK. HEAT STRENGTHENED TINTED GLASS (OUTER)+ 1.52PVB + 8 mm THK. HEAT STRENGTHENED CLEAR LAMINATED GLASS (INNER) 10 mm THK. TEMPERED GLASS (INTERNAL PROTECTIVE BARRIER)
- 3 mm THK. ALUM. CLADDING
- M.W. – MAINTENANCE WINDOW
- S.J. – STACK JOINT
- AE01 – ALUM. EXTRUSION DIE NO.
- ▲ – SUPPORT POINT
- ◆ – RESTRAINT SOCKET

B.D. REF :

CLIENT :
信和置業有限公司
Sino Land Company Limited

ARCHITECT :
WONG TUNG & PARTNERS LIMITED
ARCHITECTS & PLANNERS

MAIN CONTRACTOR :
CR Construction Company Limited

STRUCTURAL ENGINEER :
AECOM

FACADE CONSULTANT:
AECOM

NOTE :
1. ALL DIMENSIONS ARE IN mm.
2. ALL ELEVATIONS ARE VIEWED FROM OUTSIDE.
3. ALL DIMENSIONS TO BE VERIFIED ON SITE BEFORE FABRICATION.

LEGEND :
- X1 / X001 – DETAIL MARK NO. / REFER SHEET NO.
1. F.F.L. --FINISHED FLOOR LEVEL
2. S.F.L. --STRUCTURAL FLOOR LEVEL
3. /R --REVERSED DETAIL

NO.	DATE	REVISED	BY
F	16/07/2019	GENERAL REVISED	
E	17/01/2019	GENERAL REVISED	
D	22/12/2018	GENERAL REVISED	
C	04/12/2018	GENERAL REVISED	
B	24/11/2018	GENERAL REVISED	
A	10/9/2018	GENERAL REVISED	

JOB NO. : J-837

PROJECT :
URA KWUN TONG TOWN CENTRE REDEVELOPMENT (AREA 2 & 3) AT NKIL 6514, KWUN TONG, KWLOON

TITLE :
PART ELEVATION OF CURTAIN WALL AT TOWER 5

DATE : 04-JUL-18 | SCALE : 1:60 (A1)

DRAWN BY : ASING | CHECKED BY : -

美特鋁質有限公司
MIDI ALUMINIUM FABRICATOR LTD.
Units 6-8, Sunray Industrial Centre, 1/F
610 Cha Kwo Ling Road, Kowloon
Tel:23489211-4 Fax:(852)27727666

DWG NO. : J837-CW-2502 | REV. : F

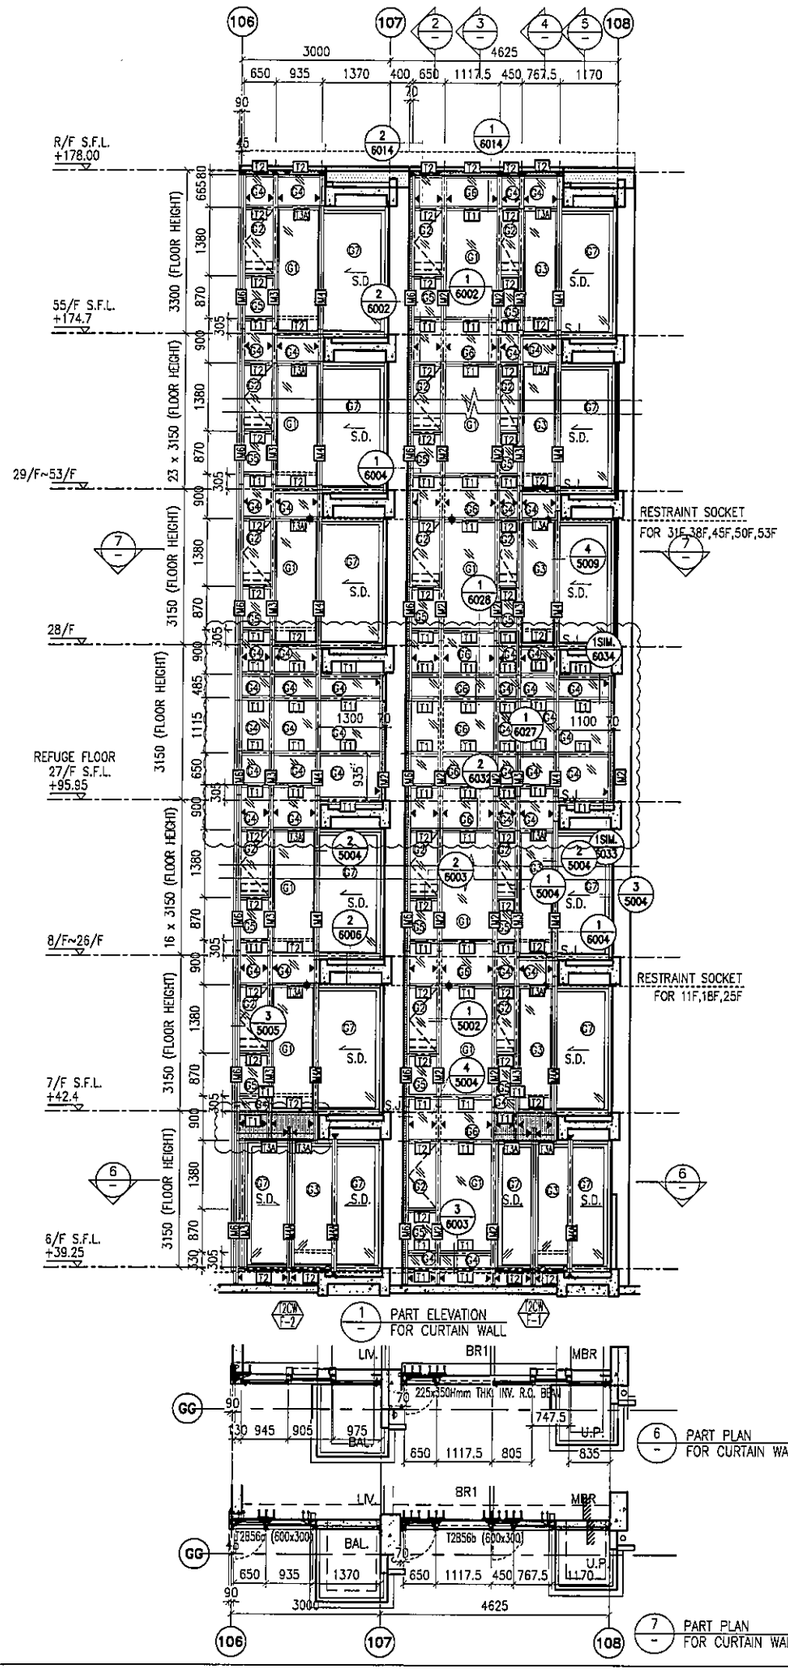

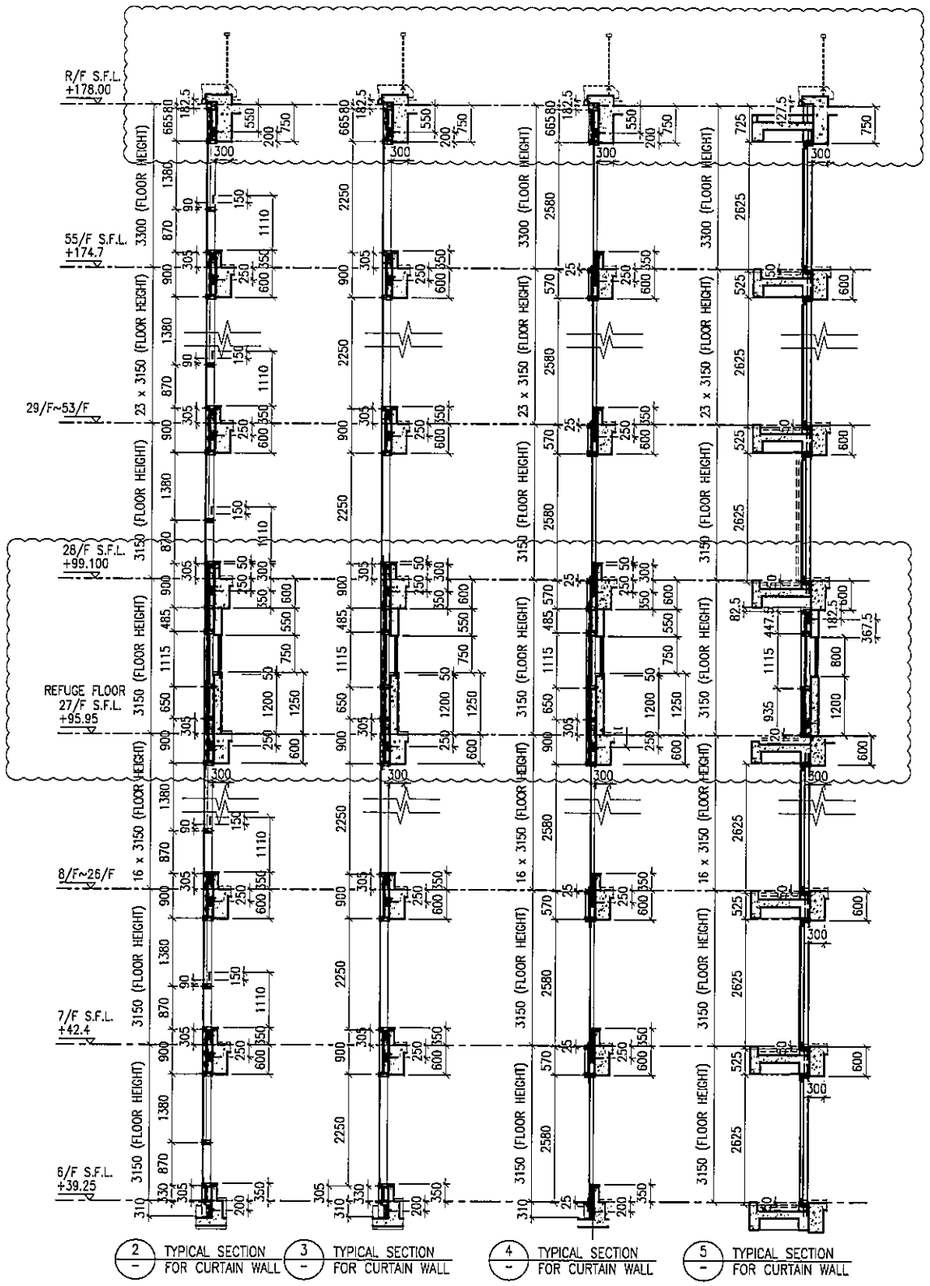

LEGEND:

- G1 – 10 mm THK. TEMPERED BLUE TINTED GLASS (OUTER) + 9 mm AIR SPACE + 8 mm THK. TEMPERED CLEAR GLASS (INNER)
- G2 – 8 mm THK. HEAT STRENGTHENED TINTED GLASS (OUTER)+ 9 mm AIR SPACE + 8 mm THK. HEAT STRENGTHENED CLEAR GLASS (INNER)
- G3 – 10 mm THK. HEAT STRENGTHENED BLUE TINTED GLASS (OUTER)+ 9 mm AIR SPACE + 8 mm THK. TEMPERED CLEAR GLASS (INNER)
- G4 – 8 mm THK. HEAT STRENGTHENED BLUE TINTED GLASS (SPANDREL GLASS)
- G5 – 8 mm THK. HEAT STRENGTHENED BLUE TINTED GLASS (OUTER)+ 9 mm AIR SPACE + 8 mm THK. TEMPERED CLEAR GLASS (INNER)
- G6 – 8 mm THK. TEMPERED BLUE TINTED GLASS (SPANDREL GLASS)
- G7 – 8 mm THK. HEAT STRENGTHENED TINTED GLASS (OUTER)+ 1.52PVB + 8 mm THK. HEAT STRENGTHENED CLEAR LAMINATED GLASS (INNER)
- 10 mm THK. TEMPERED GLASS (INTERNAL PROTECTIVE BARRIER)
- 3 mm THK. ALUM. CLADDING
- M.W. – MAINTENANCE WINDOW
- S.J. – STACK JOINT
- AE01 – ALUM. EXTRUSION DIE NO.
- ▲ – SUPPORT POINT
- ✦ – RESTRAINT SOCKET

B.D. REF :

CLIENT :
信和置業有限公司
Sino Land Company Limited

ARCHITECT :
WONG TUNG & PARTNERS LIMITED
ARCHITECTS & PLANNERS

MAIN CONTRACTOR :
CR Construction Company Limited

STRUCTURAL ENGINEER :
AECOM

FACADE CONSULTANT:
AECOM

NOTE :
1. ALL DIMENSIONS ARE IN mm.
2. ALL ELEVATIONS ARE VIEWED FROM OUTSIDE.
3. ALL DIMENSIONS TO BE VERIFIED ON SITE BEFORE FABRICATION.

LEGEND :
- X1 / X001 — DETAIL MARK NO. / REFER SHEET NO.
1. F.F.L. --FINISHED FLOOR LEVEL
2. S.F.L. --STRUCTURAL FLOOR LEVEL
3. /R --REVERSED DETAIL

NO.	DATE	REVISED	BY
G	16/07/2019	GENERAL REVISED	
F	26/05/2019	GENERAL REVISED	
E	17/01/2019	GENERAL REVISED	
D	22/12/2018	GENERAL REVISED	
C	04/12/2018	GENERAL REVISED	
B	24/11/2018	GENERAL REVISED	
A	10/9/2018	GENERAL REVISED	

JOB NO. : J-837

PROJECT :
URA KWUN TONG TOWN CENTRE REDEVELOPMENT (AREA 2 & 3) AT NKIL 6514, KWUN TONG, KWLOON

TITLE :
PART ELEVATION OF CURTAIN WALL AT TOWER 2

DATE : 04-JUL-18 | SCALE : 1:60 (A1)

DRAWN BY : ASING | CHECKED BY : -

美特鋁質有限公司
MIDI ALUMINIUM FABRICATOR LTD.
Units 6-8, Sunray Industrial Centre, 1/F
610 Cha Kwo Ling Road, Kowloon
Tel:23489211-4 Fax:(852)27727666

DWG NO. : J837-CW-2203 | REV. : G

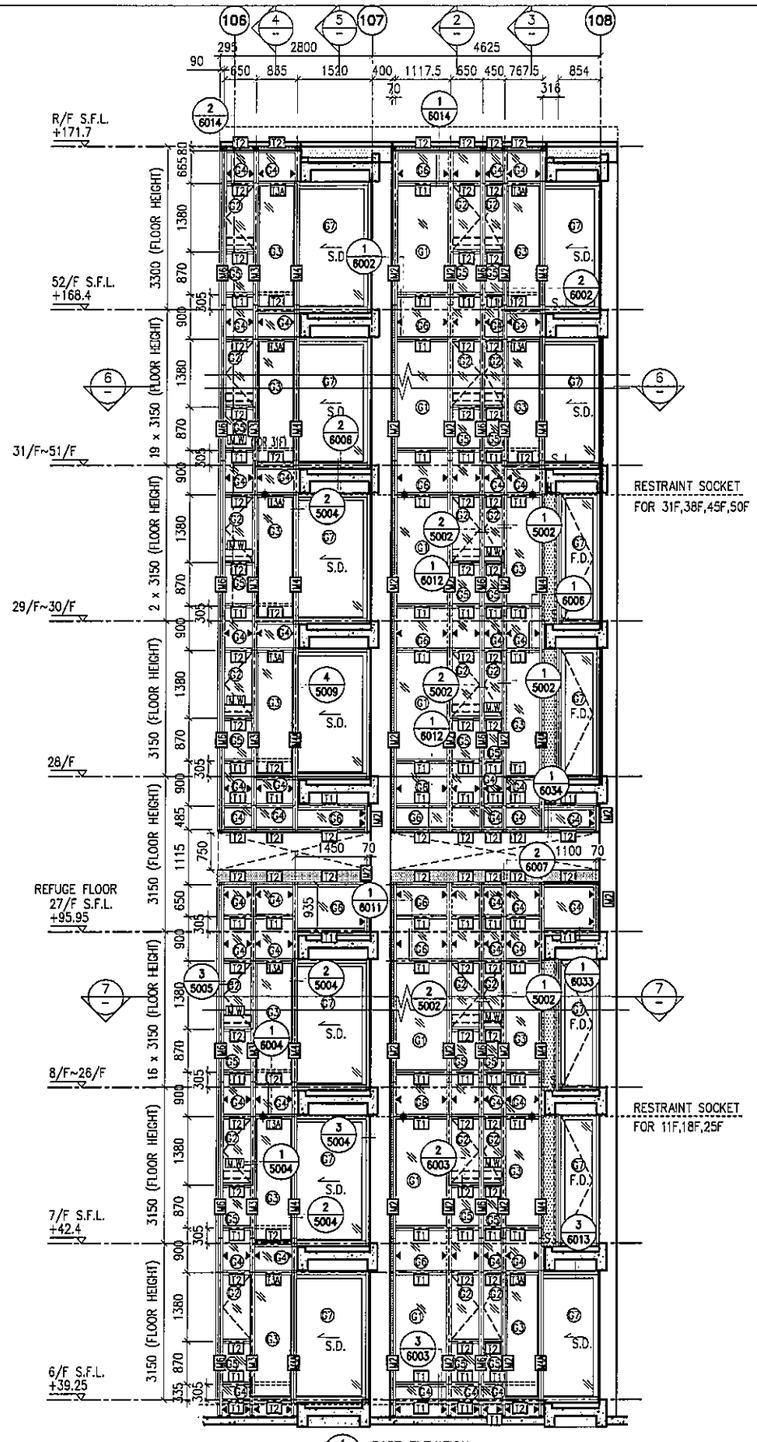

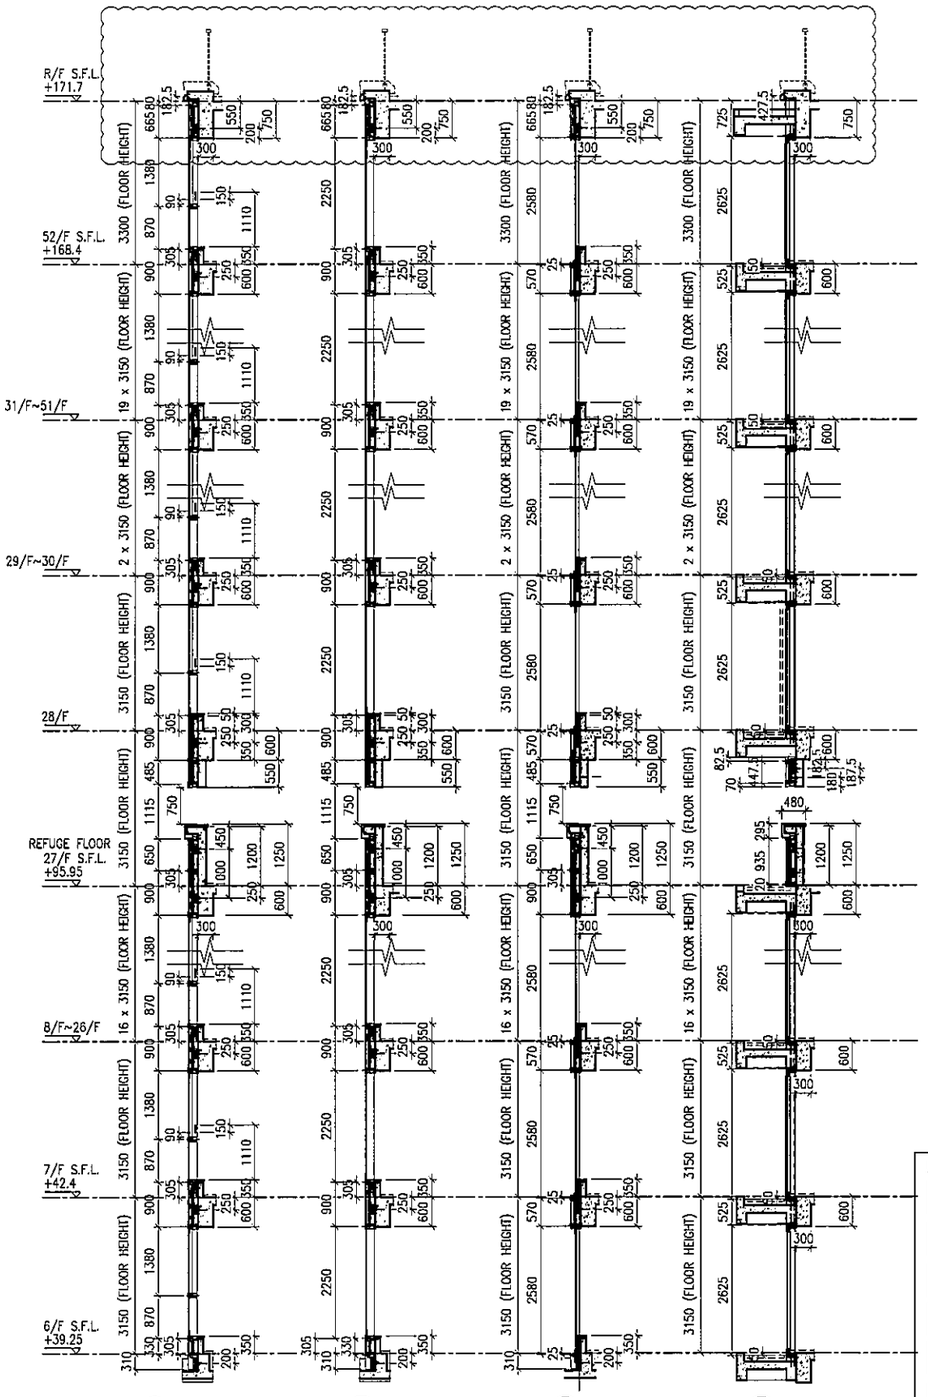

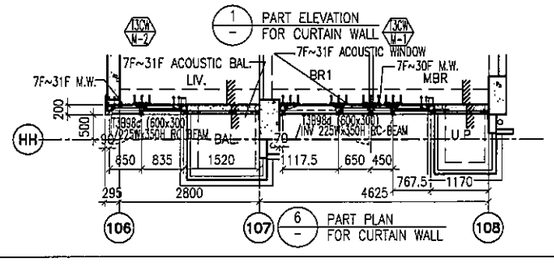

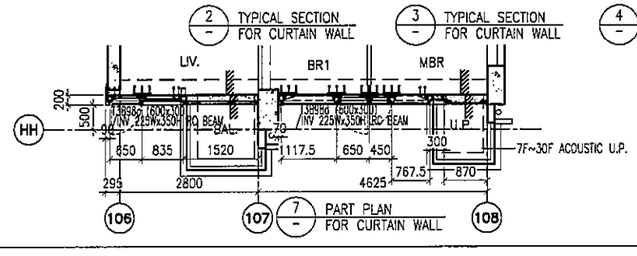

LEGEND:

- G1 – 10 mm THK. TEMPERED BLUE TINTED GLASS (OUTER) + 9 mm AIR SPACE + 8 mm THK. TEMPERED CLEAR GLASS (INNER)
- G2 – 8 mm THK. HEAT STRENGTHENED TINTED GLASS (OUTER)+ 9 mm AIR SPACE + 8 mm THK. HEAT STRENGTHENED CLEAR GLASS (INNER)
- G3 – 10 mm THK. HEAT STRENGTHENED BLUE TINTED GLASS (OUTER)+ 9 mm AIR SPACE + 8 mm THK. TEMPERED CLEAR GLASS (INNER)
- G4 – 8 mm THK. HEAT STRENGTHENED BLUE TINTED GLASS (SPANDREL GLASS)
- G5 – 8 mm THK. HEAT STRENGTHENED BLUE TINTED GLASS (OUTER)+ 9 mm AIR SPACE + 8 mm THK. TEMPERED CLEAR GLASS (INNER)
- G6 – 8 mm THK. TEMPERED BLUE TINTED GLASS (SPANDREL GLASS)
- G7 – 8 mm THK. HEAT STRENGTHENED TINTED GLASS (OUTER)+ 1.52PVB + 8 mm THK. HEAT STRENGTHENED CLEAR LAMINATED GLASS (INNER)
- 10 mm THK. TEMPERED GLASS (INTERNAL PROTECTIVE BARRIER)
- 3 mm THK. ALUM. CLADDING
- M.W. – MAINTENANCE WINDOW
- S.J. – STACK JOINT
- AE01 – ALUM. EXTRUSION DIE NO.
- ▲ – SUPPORT POINT
- ✦ – RESTRAINT SOCKET

B.D. REF :

CLIENT :
信和置業有限公司
Sino Land Company Limited

ARCHITECT :
WONG TUNG & PARTNERS LIMITED
ARCHITECTS & PLANNERS

MAIN CONTRACTOR :
CR Construction Company Limited

STRUCTURAL ENGINEER :
AECOM

FACADE CONSULTANT:
AECOM

NOTE :
1. ALL DIMENSIONS ARE IN mm.
2. ALL ELEVATIONS ARE VIEWED FROM OUTSIDE.
3. ALL DIMENSIONS TO BE VERIFIED ON SITE BEFORE FABRICATION.

LEGEND :
- X1 / X001 – DETAIL MARK NO. / REFER SHEET NO.
1. F.F.L. --FINISHED FLOOR LEVEL
2. S.F.L. --STRUCTURAL FLOOR LEVEL
3. (R) --REVERSED DETAIL

NO.	DATE	REVISED	BY
F	16/07/2019	GENERAL REVISED	
E	17/01/2019	GENERAL REVISED	
D	22/12/2018	GENERAL REVISED	
C	04/12/2018	GENERAL REVISED	
B	24/11/2018	GENERAL REVISED	
A	10/9/2018	GENERAL REVISED	

JOB NO. : J-837

PROJECT :
URA KWUN TONG TOWN CENTRE REDEVELOPMENT (AREA 2 & 3) AT NKIL 6514, KWUN TONG, KWLOON

TITLE :
PART ELEVATION OF CURTAIN WALL AT TOWER 3

DATE : 04-JUL-18 | SCALE : 1:60 (A1)

DRAWN BY : ASING | CHECKED BY : –

美特鋁質有限公司
MIDI ALUMINIUM FABRICATOR LTD.
Units 6-8, Sunray Industrial Centre, 1/F
610 Cha Kwo Ling Road, Kowloon
Tel:23489211-4 Fax:(852)27727666

DWG NO. : J837-CW-2303 | REV. : F

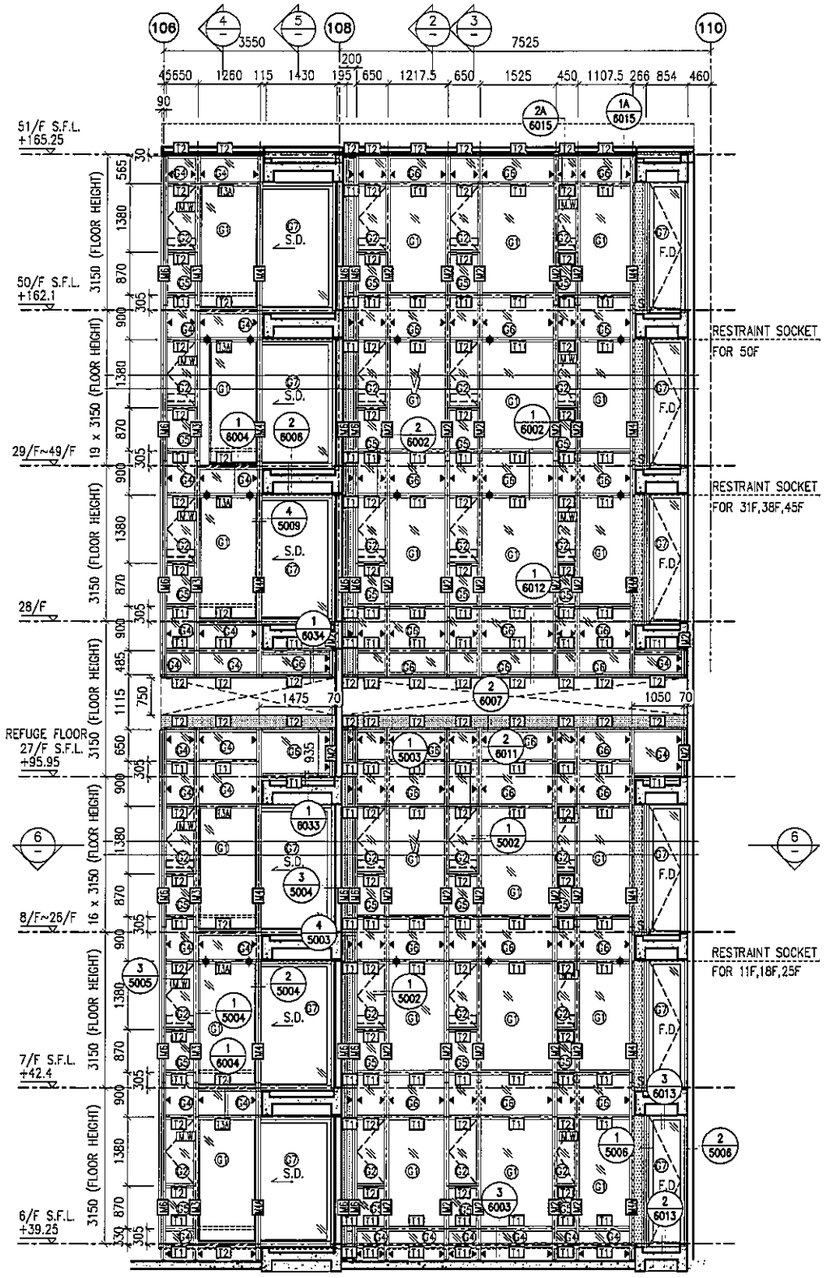

1 PART ELEVATION FOR CURTAIN WALL

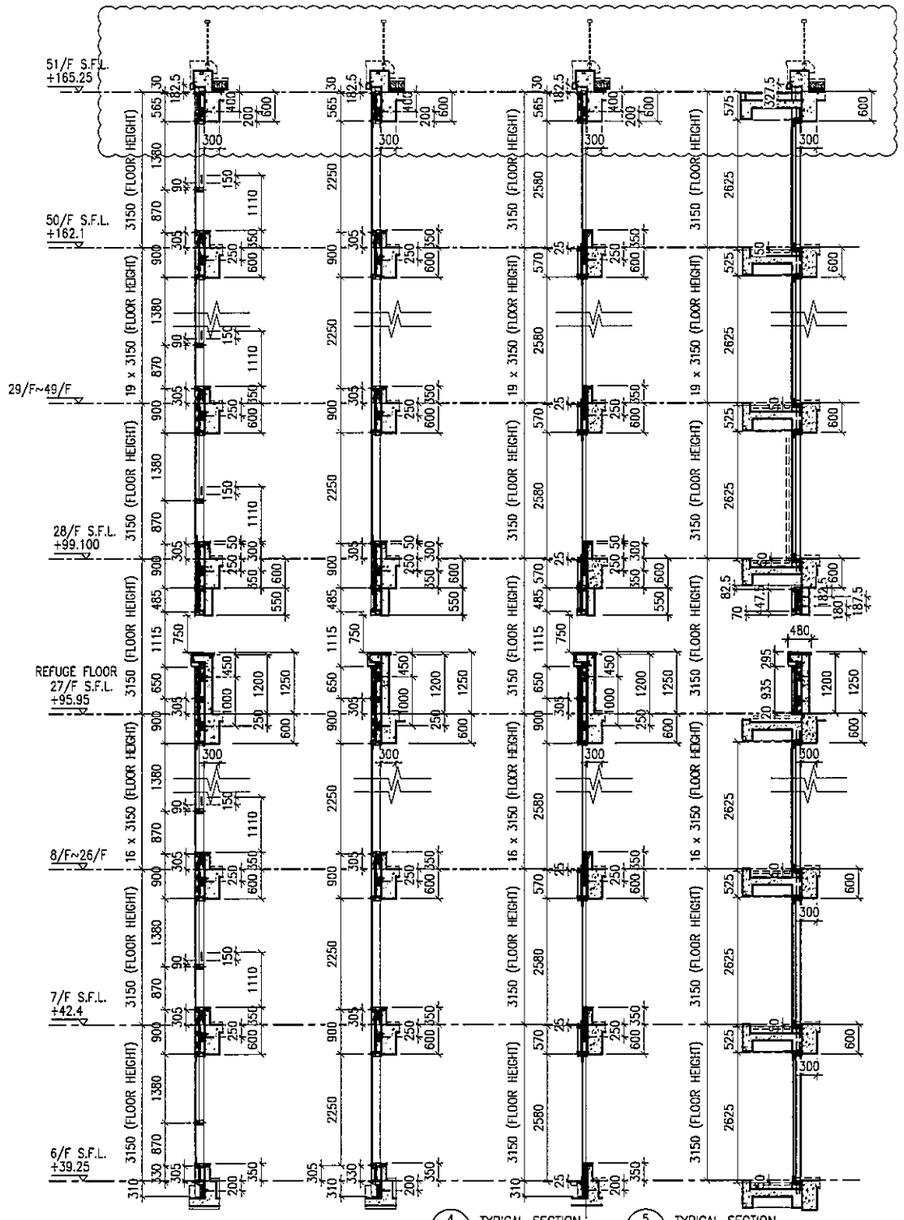

2 TYPICAL SECTION FOR CURTAIN WALL

3 TYPICAL SECTION FOR CURTAIN WALL

4 TYPICAL SECTION FOR CURTAIN WALL

5 TYPICAL SECTION FOR CURTAIN WALL

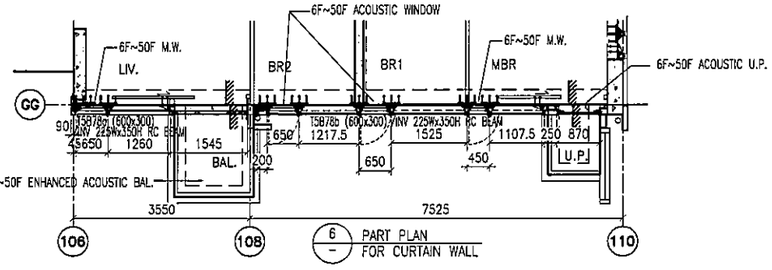

6 PART PLAN FOR CURTAIN WALL

LEGEND:

- G1+ – 10 mm THK. TEMPERED BLUE TINTED GLASS (OUTER) + 9 mm AIR SPACE + 8 mm THK. TEMPERED CLEAR GLASS (INNER)
- G2+ – 8 mm THK. HEAT STRENGTHENED TINTED GLASS (OUTER)+ 9 mm AIR SPACE + 8 mm THK. HEAT STRENGTHENED CLEAR GLASS (INNER)
- G3+ – 10 mm THK. HEAT STRENGTHENED BLUE TINTED GLASS (OUTER)+ 9 mm AIR SPACE + 8 mm THK. TEMPERED CLEAR GLASS (INNER)
- G4+ – 8 mm THK. HEAT STRENGTHENED BLUE TINTED GLASS (SPANDREL GLASS)
- G5+ – 8 mm THK. HEAT STRENGTHENED BLUE TINTED GLASS (OUTER)+ 9 mm AIR SPACE + 8 mm THK. TEMPERED CLEAR GLASS (INNER)
- G6+ – 8 mm THK. TEMPERED BLUE TINTED GLASS (SPANDREL GLASS)
- G7+ – 8 mm THK. HEAT STRENGTHENED TINTED GLASS (OUTER)+ 1.52PVB + 8 mm THK. HEAT STRENGTHENED CLEAR LAMINATED GLASS (INNER) 10 mm THK. TEMPERED GLASS (INTERNAL PROTECTIVE BARRIER)
- 3 mm THK. ALUM. CLADDING
- M.W. – MAINTENANCE WINDOW
- S.J. – STACK JOINT
- AE01 – ALUM. EXTRUSION DIE NO.
- ▲ – SUPPORT POINT
- ✦ – RESTRAINT SOCKET

B.D. REF :

CLIENT :
信和置業有限公司
Sino Land Company Limited

ARCHITECT : WONG TUNG & PARTNERS LIMITED ARCHITECTS & PLANNERS

MAIN CONTRACTOR :
CR Construction Company Limited

STRUCTURAL ENGINEER :
AECOM

FACADE CONSULTANT:
AECOM

NOTE :
1. ALL DIMENSIONS ARE IN mm.
2. ALL ELEVATIONS ARE VIEWED FROM OUTSIDE.
3. ALL DIMENSIONS TO BE VERIFIED ON SITE BEFORE FABRICATION.

LEGEND :
- X1 / X001 – DETAIL MARK NO. / REFER SHEET NO.
1. F.F.L. --FINISHED FLOOR LEVEL
2. S.F.L. --STRUCTURAL FLOOR LEVEL
3. /R --REVERSED DETAIL

NO.	DATE	REVISED	BY
F	16/07/2019	GENERAL REVISED	
E	17/01/2019	GENERAL REVISED	
D	22/12/2018	GENERAL REVISED	
C	04/12/2018	GENERAL REVISED	
B	24/11/2018	GENERAL REVISED	
A	10/9/2018	GENERAL REVISED	

JOB NO. : J-837

PROJECT :
URA KWUN TONG TOWN CENTRE REDEVELOPMENT (AREA 2 & 3) AT NKIL 6514, KWUN TONG, KWLOON

TITLE :
PART ELEVATION OF CURTAIN WALL AT TOWER 5

DATE : 04-JUL-18 | SCALE : 1:60 (A1)

DRAWN BY : ASING | CHECKED BY : –

美特鋁質有限公司
MIDI ALUMINIUM FABRICATOR LTD.
Units 6-8, Sunray Industrial Centre, 1/F
610 Cha Kwo Ling Road, Kowloon
Tel:23489211-4 Fax:(852)27727666

DWG NO. : J837-CW-2503 | REV. : F

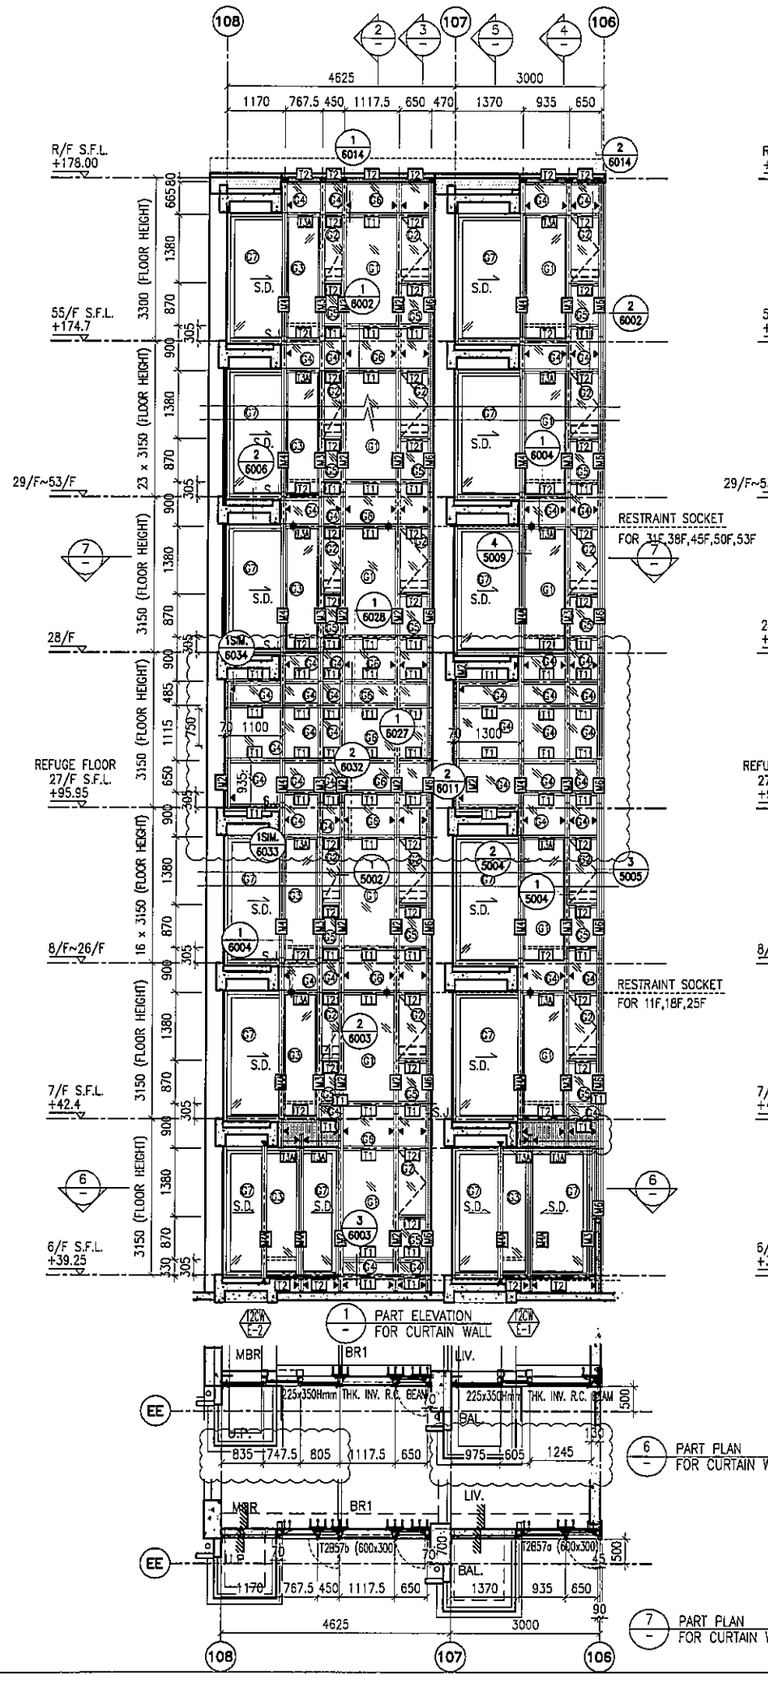

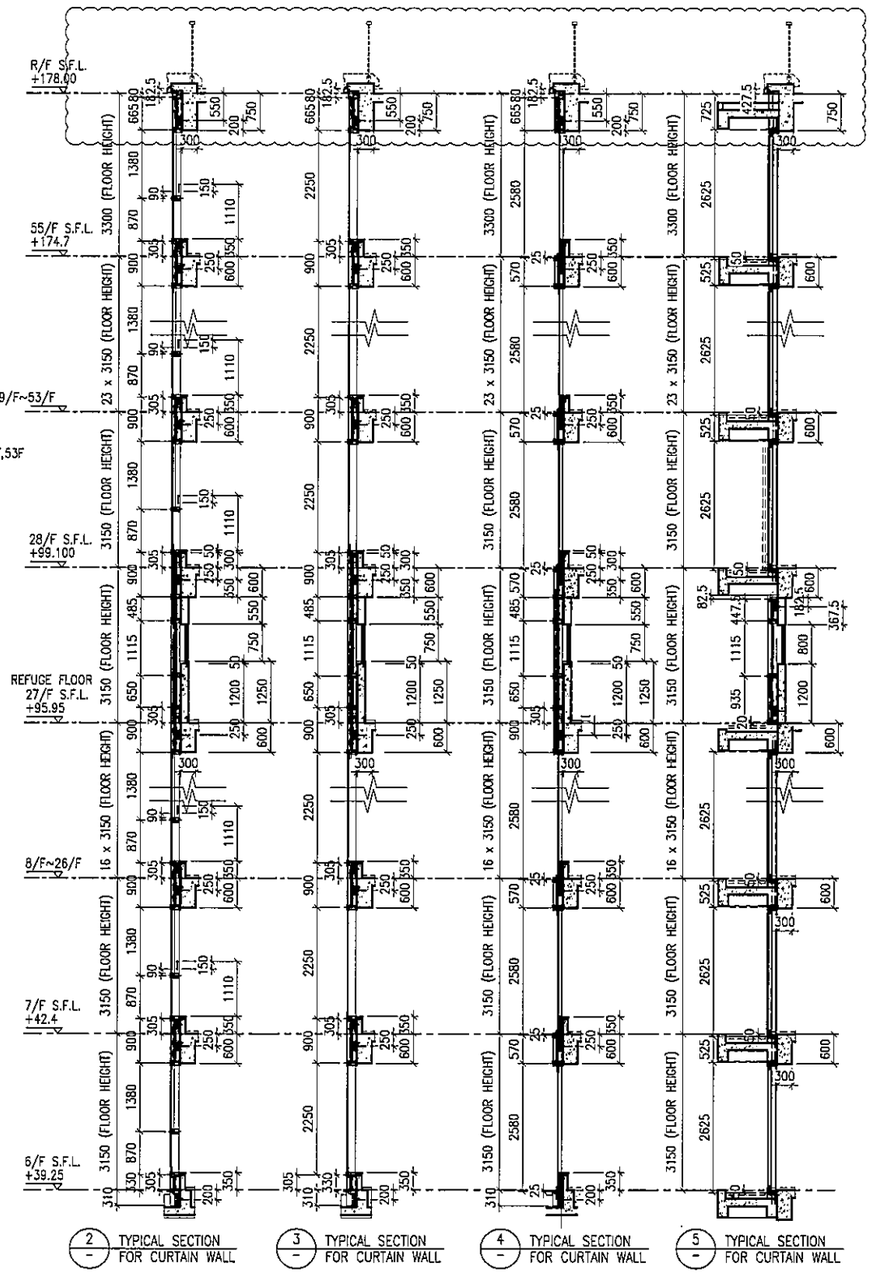

LEGEND:

- 10 mm THK. TEMPERED BLUE TINTED GLASS (OUTER) + 9 mm AIR SPACE + 8 mm THK. TEMPERED CLEAR GLASS (INNER)
- 8 mm THK. HEAT STRENGTHENED TINTED GLASS (OUTER)+ 9 mm AIR SPACE + 8 mm THK. HEAT STRENGTHENED CLEAR GLASS (INNER)
- 10 mm THK. HEAT STRENGTHENED BLUE TINTED GLASS (OUTER)+ 9 mm AIR SPACE + 8 mm THK. TEMPERED CLEAR GLASS (INNER)
- 8 mm THK. HEAT STRENGTHENED BLUE TINTED GLASS (SPANDREL GLASS)
- 8 mm THK. HEAT STRENGTHENED BLUE TINTED GLASS (OUTER)+ 9 mm AIR SPACE + 8 mm THK. TEMPERED CLEAR GLASS (INNER)
- 8 mm THK. TEMPERED BLUE TINTED GLASS (SPANDREL GLASS)
- 8 mm THK. HEAT STRENGTHENED TINTED GLASS (OUTER)+ 1.52PVB + 8 mm THK. HEAT STRENGTHENED CLEAR LAMINATED GLASS (INNER) 10 mm THK. TEMPERED GLASS (INTERNAL PROTECTIVE BARRIER)
- 3 mm THK. ALUM. CLADDING
- M.W. – MAINTENANCE WINDOW
- S.J. – STACK JOINT
- AE01 – ALUM. EXTRUSION DIE NO.
- ▲ – SUPPORT POINT
- ✦ – RESTRAINT SOCKET

B.D. REF :

CLIENT :
信和置業有限公司
Sino Land Company Limited

ARCHITECT : WONG TUNG & PARTNERS LIMITED
ARCHITECTS & PLANNERS

MAIN CONTRACTOR :
CR Construction Company Limited

STRUCTURAL ENGINEER :
AECOM

FACADE CONSULTANT:
AECOM

NOTE :
1. ALL DIMENSIONS ARE IN mm.
2. ALL ELEVATIONS ARE VIEWED FROM OUTSIDE.
3. ALL DIMENSIONS TO BE VERIFIED ON SITE BEFORE FABRICATION.

LEGEND :
X1 – DETAIL MARK NO.
X001 – REFER SHEET NO.

1. F.F.L. --FINISHED FLOOR LEVEL
2. S.F.L. --STRUCTURAL FLOOR LEVEL
3. (VR) --REVERSED DETAIL

NO.	DATE	REVISED	BY
G	16/07/2019	GENERAL REVISED	
F	26/05/2019	GENERAL REVISED	
E	17/01/2019	GENERAL REVISED	
D	22/12/2018	GENERAL REVISED	
C	04/12/2018	GENERAL REVISED	
B	24/11/2018	GENERAL REVISED	
A	10/9/2018	GENERAL REVISED	

JOB NO. : J-837

PROJECT :
URA KWUN TONG TOWN CENTRE REDEVELOPMENT (AREA 2 & 3) AT NKIL 6514, KWUN TONG, KWLOON

TITLE :
PART ELEVATION OF CURTAIN WALL AT TOWER 2

DATE : 04-JUL-18 | SCALE : 1:60 (A1)

DRAWN BY : ASING | CHECKED BY : –

美特鋁質有限公司
MIDI ALUMINIUM FABRICATOR LTD.
Units 6-8, Sunray Industrial Centre, 1/F
610 Cha Kwo Ling Road, Kowloon
Tel:23489211-4 Fax:(852)27727666

DWG NO. : J837-CW-2204 | REV. : G

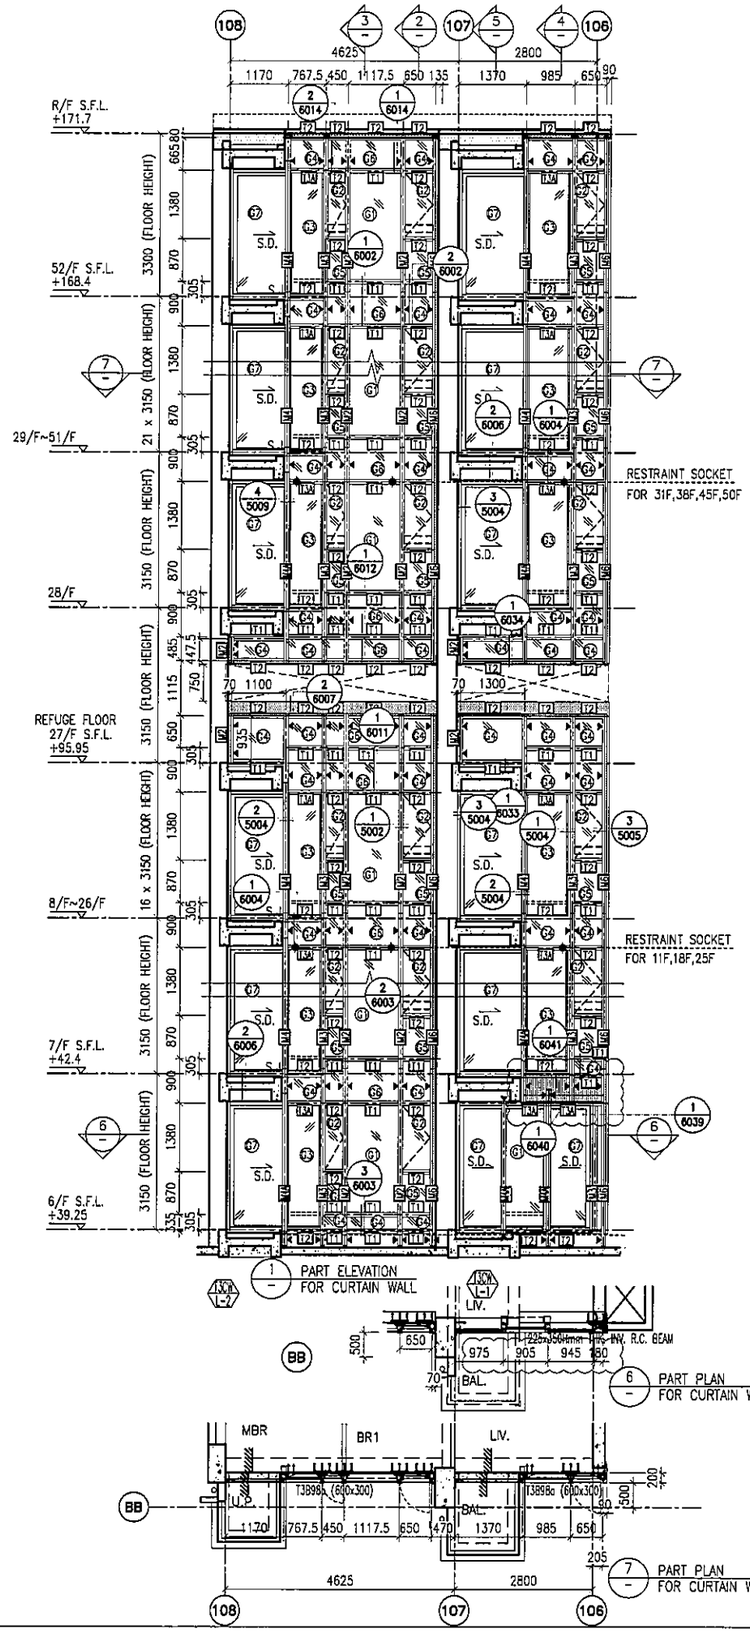

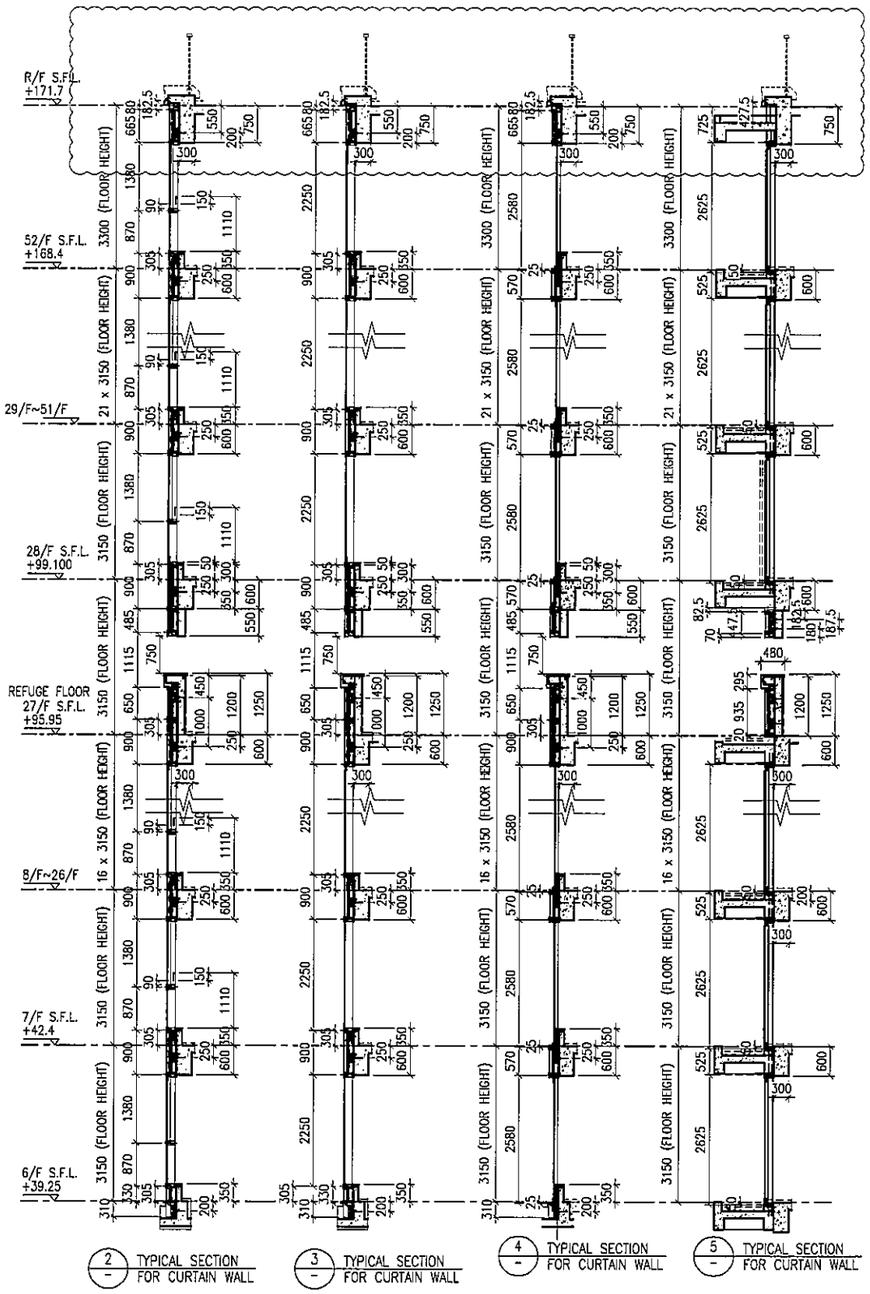

LEGEND:

- 10 mm THK. TEMPERED BLUE TINTED GLASS (OUTER) + 9 mm AIR SPACE + 8 mm THK. TEMPERED CLEAR GLASS (INNER)
- 8 mm THK. HEAT STRENGTHENED TINTED GLASS (OUTER)+ 9 mm AIR SPACE + 8 mm THK. HEAT STRENGTHENED CLEAR GLASS (INNER)
- 10 mm THK. HEAT STRENGTHENED BLUE TINTED GLASS (OUTER)+ 9 mm AIR SPACE + 8 mm THK. TEMPERED CLEAR GLASS (INNER)
- 8 mm THK. HEAT STRENGTHENED BLUE TINTED GLASS (SPANDREL GLASS)
- 8 mm THK. HEAT STRENGTHENED BLUE TINTED GLASS (OUTER)+ 9 mm AIR SPACE + 8 mm THK. TEMPERED CLEAR GLASS (INNER)
- 8 mm THK. TEMPERED BLUE TINTED GLASS (SPANDREL GLASS)
- 8 mm THK. HEAT STRENGTHENED TINTED GLASS (OUTER)+ 1.52PVB + 8 mm THK. HEAT STRENGTHENED CLEAR LAMINATED GLASS (INNER)
- 10 mm THK. TEMPERED GLASS (INTERNAL PROTECTIVE BARRIER)
- 3 mm THK. ALUM. CLADDING
- M.W. – MAINTENANCE WINDOW
- S.J. – STACK JOINT
- AE01 – ALUM. EXTRUSION DIE NO.
- ▲ – SUPPORT POINT
- ✦ – RESTRAINT SOCKET

B.D. REF :

CLIENT :
信和置業有限公司
Sino Land Company Limited

ARCHITECT :
WONG TUNG & PARTNERS LIMITED
ARCHITECTS & PLANNERS

MAIN CONTRACTOR :
CR Construction Company Limited

STRUCTURAL ENGINEER :
AECOM

FACADE CONSULTANT:
AECOM

NOTE :
1. ALL DIMENSIONS ARE IN mm.
2. ALL ELEVATIONS ARE VIEWED FROM OUTSIDE.
3. ALL DIMENSIONS TO BE VERIFIED ON SITE BEFORE FABRICATION.

LEGEND :
X1 — DETAIL MARK NO.
X001 — REFER SHEET NO.
1. F.F.L. --FINISHED FLOOR LEVEL
2. S.F.L. --STRUCTURAL FLOOR LEVEL
3. (R) --REVERSED DETAIL

NO.	DATE	REVISED	BY
G	16/07/2019	GENERAL REVISED	
F	26/05/2019	GENERAL REVISED	
E	17/01/2019	GENERAL REVISED	
D	22/12/2018	GENERAL REVISED	
C	04/12/2018	GENERAL REVISED	
B	24/11/2018	GENERAL REVISED	
A	10/9/2018	GENERAL REVISED	

JOB NO. : J-837

PROJECT :
URA KWUN TONG TOWN CENTRE REDEVELOPMENT (AREA 2 & 3) AT NKIL 6514, KWUN TONG, KWLOON

TITLE :
PART ELEVATION OF CURTAIN WALL AT TOWER 3

DATE : 04-JUL-18 | SCALE : 1:60 (A1)

DRAWN BY : ASING | CHECKED BY : –

美特鋁質有限公司
MIDI ALUMINIUM FABRICATOR LTD.
Units 6-8, Sunray Industrial Centre, 1/F
610 Cha Kwo Ling Road, Kowloon
Tel:23489211-4 Fax:(852)27727666

DWG NO. : J837-CW-2304 | REV. : G

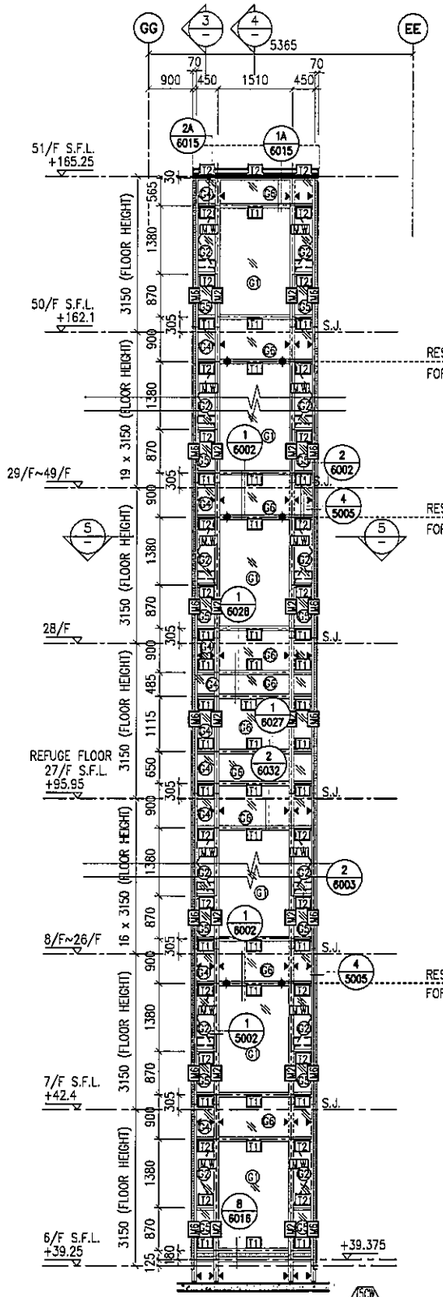

1 PART ELEVATION FOR CURTAIN WALL

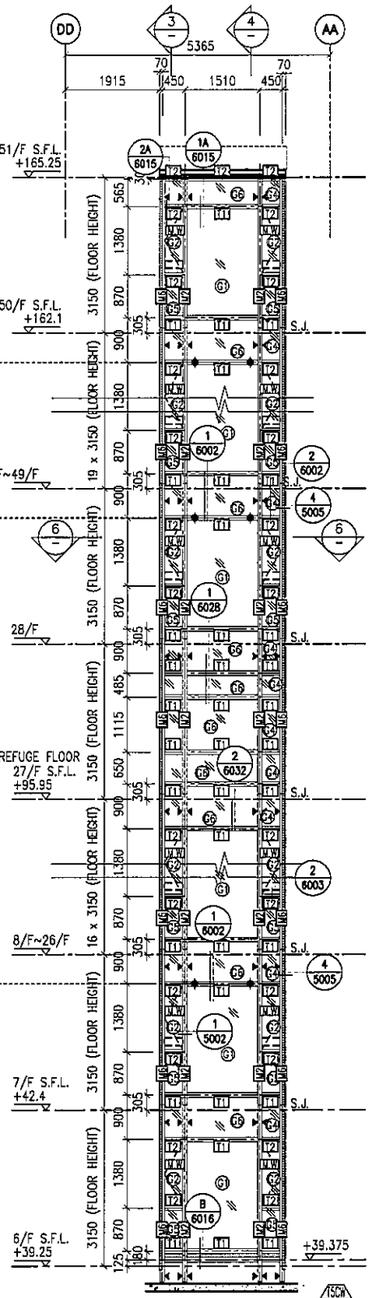

2 PART ELEVATION FOR CURTAIN WALL

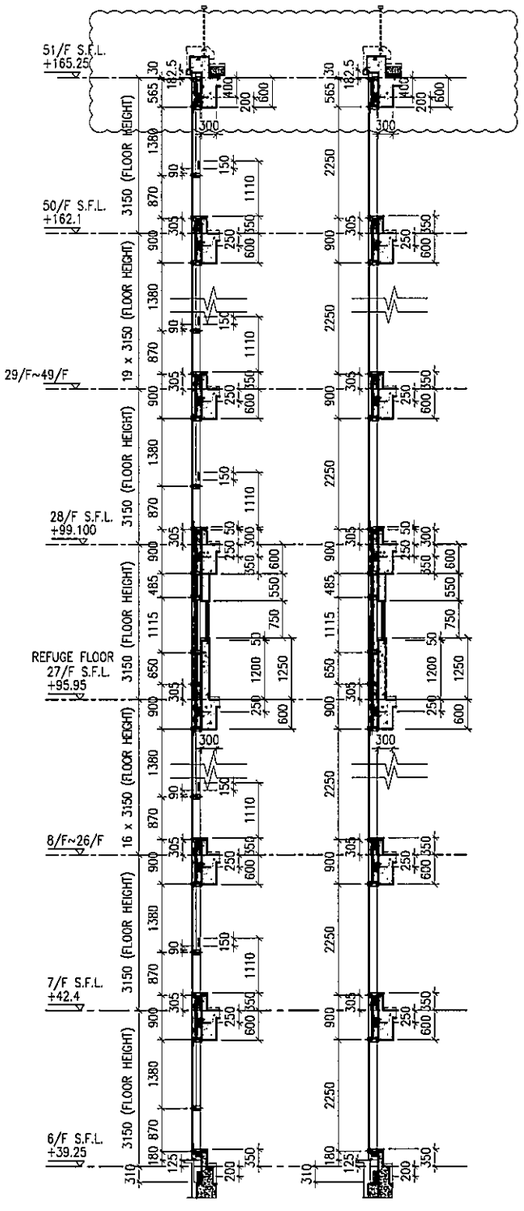

3 TYPICAL SECTION FOR CURTAIN WALL

4 TYPICAL SECTION FOR CURTAIN WALL

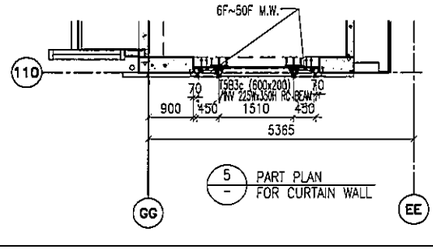

5 PART PLAN FOR CURTAIN WALL

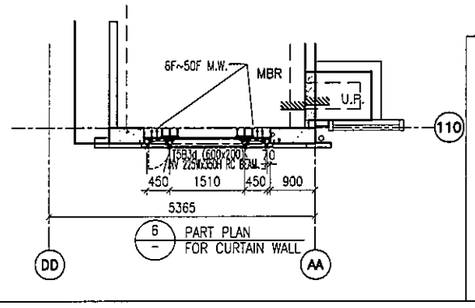

6 PART PLAN FOR CURTAIN WALL

LEGEND:

- 10 mm THK. TEMPERED BLUE TINTED GLASS (OUTER) + 9 mm AIR SPACE + 8 mm THK. TEMPERED CLEAR GLASS (INNER)
- 8 mm THK. HEAT STRENGTHENED TINTED GLASS (OUTER)+ 9 mm AIR SPACE + 8 mm THK. HEAT STRENGTHENED CLEAR GLASS (INNER)
- 10 mm THK. HEAT STRENGTHENED BLUE TINTED GLASS (OUTER)+ 9 mm AIR SPACE + 8 mm THK. TEMPERED CLEAR GLASS (INNER)
- 8 mm THK. HEAT STRENGTHENED BLUE TINTED GLASS (SPANDREL GLASS)
- 8 mm THK. HEAT STRENGTHENED BLUE TINTED GLASS (OUTER)+ 9 mm AIR SPACE + 8 mm THK. TEMPERED CLEAR GLASS (INNER)
- 8 mm THK. TEMPERED BLUE TINTED GLASS (SPANDREL GLASS)
- 8 mm THK. HEAT STRENGTHENED TINTED GLASS (OUTER)+ 1.52PVB + 8 mm THK. HEAT STRENGTHENED CLEAR LAMINATED GLASS (INNER)
- 10 mm THK. TEMPERED GLASS (INTERNAL PROTECTIVE BARRIER)
- 3 mm THK. ALUM. CLADDING
- M.W. – MAINTENANCE WINDOW
- S.J. – STACK JOINT
- AE01 – ALUM. EXTRUSION DIE NO.
- ▲ – SUPPORT POINT
- ◆ – RESTRAINT SOCKET

B.D. REF :

CLIENT :
信和置業有限公司
Sino Land Company Limited

ARCHITECT :
WONG TUNG & PARTNERS LIMITED
ARCHITECTS & PLANNERS

MAIN CONTRACTOR :
CR Construction Company Limited

STRUCTURAL ENGINEER :
AECOM

FACADE CONSULTANT:
AECOM

NOTE :
1. ALL DIMENSIONS ARE IN mm.
2. ALL ELEVATIONS ARE VIEWED FROM OUTSIDE.
3. ALL DIMENSIONS TO BE VERIFIED ON SITE BEFORE FABRICATION.

LEGEND :
- X1 / XC01 – DETAIL MARK NO. / REFER SHEET NO.
1. F.F.L. --FINISHED FLOOR LEVEL
2. S.F.L. --STRUCTURAL FLOOR LEVEL
3. /R --REVERSED DETAIL

NO.	DATE	REVISED	BY
F	16/07/2019	GENERAL REVISED	
E	17/01/2019	GENERAL REVISED	
D	22/12/2018	GENERAL REVISED	
C	04/12/2018	GENERAL REVISED	
B	24/11/2018	GENERAL REVISED	
A	10/9/2018	GENERAL REVISED	

JOB NO. : J-837

PROJECT :
URA KWUN TONG TOWN CENTRE
REDEVELOPMENT (AREA 2 & 3) AT
NKIL 6514, KWUN TONG, KWLOON

TITLE :
PART ELEVATION
OF CURTAIN WALL
AT TOWER 5

DATE : 04-JUL-18 | SCALE : 1:60 (A1)

DRAWN BY : ASING | CHECKED BY : --

美特鋁製有限公司
MIDI ALUMINIUM FABRICATOR LTD.
Units 6-8, Sunray Industrial Centre, 1/F
610 Cha Kwo Ling Road, Kowloon
Tel:23489211-4 Fax:(852)27727666

DWG NO. : J837-CW-2504 | REV. : F

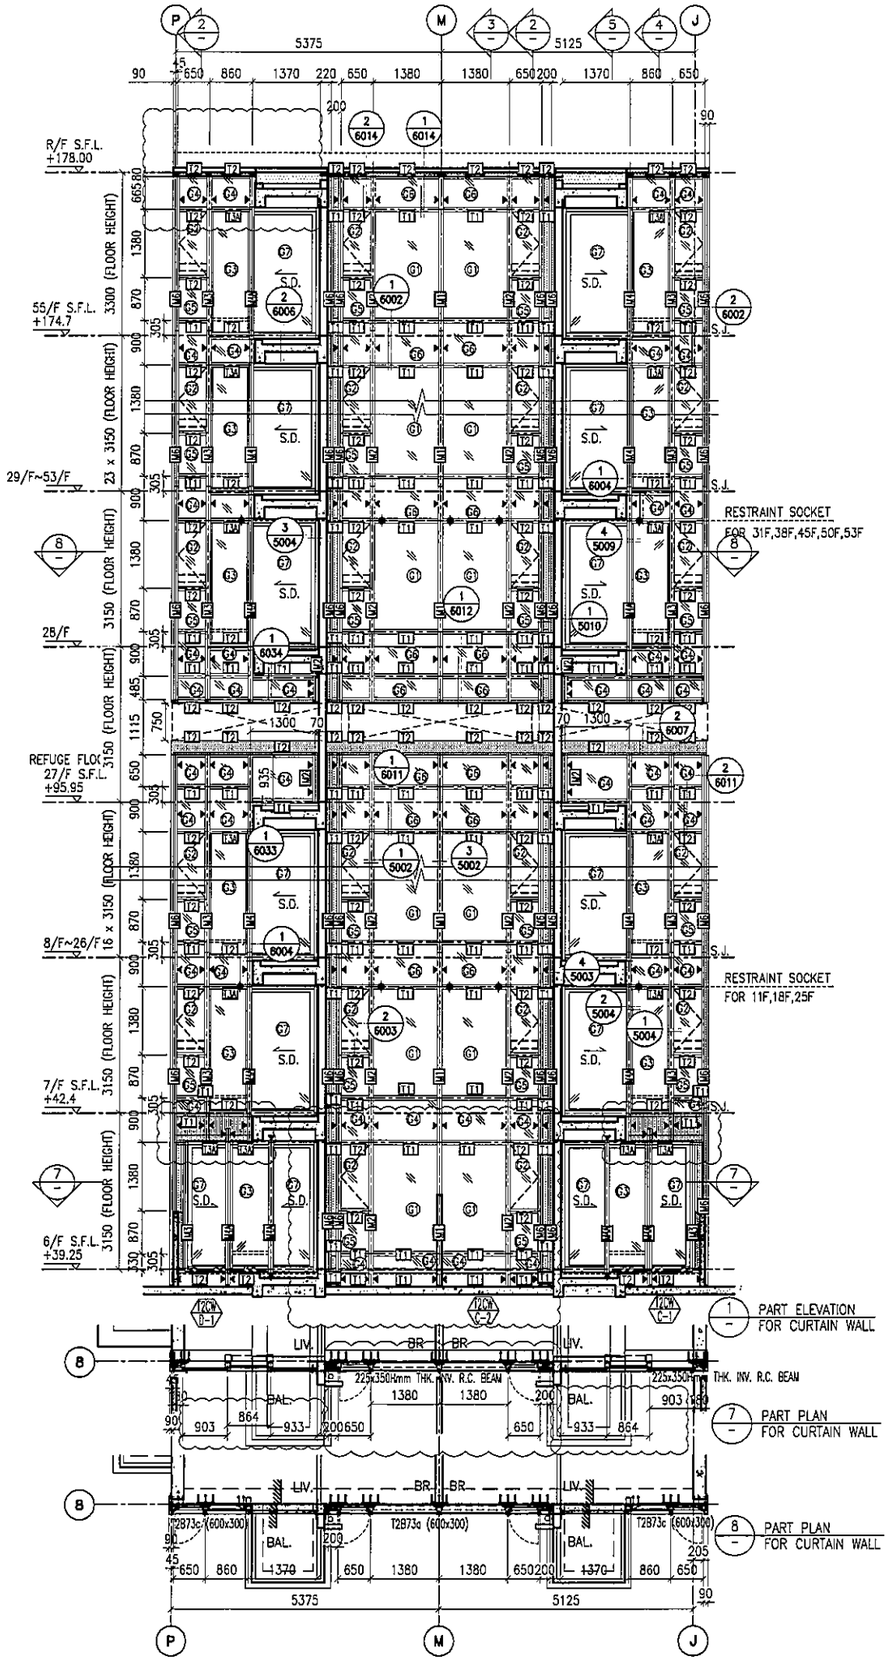

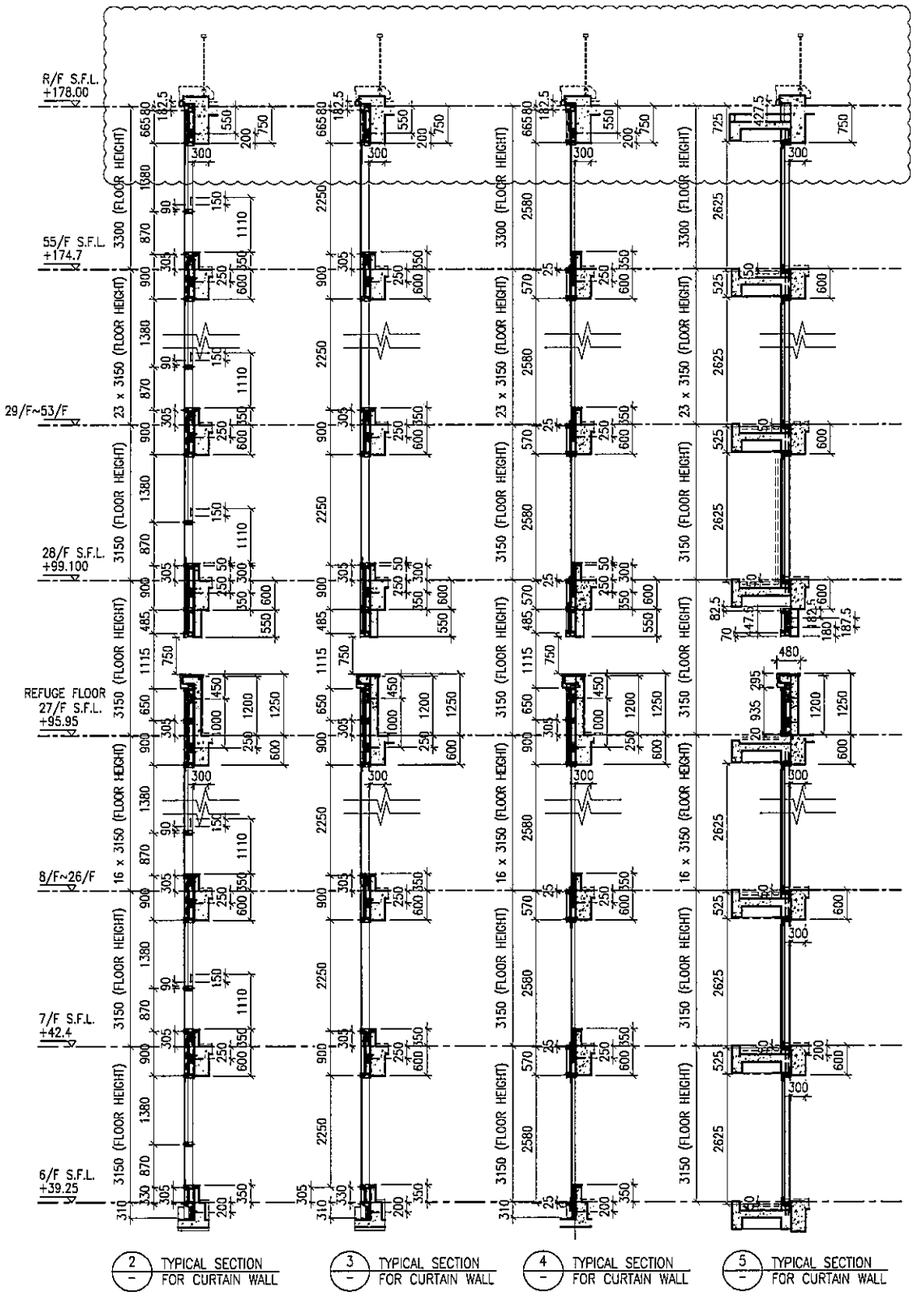

LEGEND:

- 10 mm THK. TEMPERED BLUE TINTED GLASS (OUTER) + 9 mm AIR SPACE + 8 mm THK. TEMPERED CLEAR GLASS (INNER)
- 8 mm THK. HEAT STRENGTHENED TINTED GLASS (OUTER)+ 9 mm AIR SPACE + 8 mm THK. HEAT STRENGTHENED CLEAR GLASS (INNER)
- 10 mm THK. HEAT STRENGTHENED BLUE TINTED GLASS (OUTER)+ 9 mm AIR SPACE + 8 mm THK. TEMPERED CLEAR GLASS (INNER)
- 8 mm THK. HEAT STRENGTHENED BLUE TINTED GLASS (SPANDREL GLASS)
- 8 mm THK. HEAT STRENGTHENED BLUE TINTED GLASS (OUTER)+ 9 mm AIR SPACE + 8 mm THK. TEMPERED CLEAR GLASS (INNER)
- 8 mm THK. TEMPERED BLUE TINTED GLASS (SPANDREL GLASS)
- 8 mm THK. HEAT STRENGTHENED TINTED GLASS (OUTER)+ 1.52PVB + 8 mm THK. HEAT STRENGTHENED CLEAR LAMINATED GLASS (INNER) 10 mm THK. TEMPERED GLASS (INTERNAL PROTECTIVE BARRIER)
- 3 mm THK. ALUM. CLADDING
- M.W. – MAINTENANCE WINDOW
- S.J. – STACK JOINT
- AE01 – ALUM. EXTRUSION DIE NO.
- ▲ – SUPPORT POINT
- ◆ – RESTRAINT SOCKET

B.D. REF :

CLIENT :
信和置業有限公司
Sino Land Company Limited

ARCHITECT : WONG TUNG & PARTNERS LIMITED ARCHITECTS & PLANNERS

MAIN CONTRACTOR :
CR Construction Company Limited

STRUCTURAL ENGINEER :
AECOM

FACADE CONSULTANT:
AECOM

NOTE :
1. ALL DIMENSIONS ARE IN mm.
2. ALL ELEVATIONS ARE VIEWED FROM OUTSIDE.
3. ALL DIMENSIONS TO BE VERIFIED ON SITE BEFORE FABRICATION.

LEGEND :
X1 — DETAIL MARK NO.
X001 — REFER SHEET NO.
1. F.F.L. --FINISHED FLOOR LEVEL
2. S.F.L. --STRUCTURAL FLOOR LEVEL
3. (R) --REVERSED DETAIL

NO.	DATE	REVISED	BY
G	16/07/2019	GENERAL REVISED	
F	26/05/2019	GENERAL REVISED	
E	17/01/2019	GENERAL REVISED	
D	22/12/2018	GENERAL REVISED	
C	04/12/2018	GENERAL REVISED	
B	24/11/2018	GENERAL REVISED	
A	10/9/2018	GENERAL REVISED	

JOB NO. : J-837

PROJECT :
URA KWUN TONG TOWN CENTRE REDEVELOPMENT (AREA 2 & 3) AT NKIL 6514, KWUN TONG, KWLOON

TITLE :
PART ELEVATION OF CURTAIN WALL AT TOWER 2

DATE : 04-JUL-18 | SCALE : 1:60 (A1)

DRAWN BY : ASING | CHECKED BY : –

美特鋁質有限公司
MIDI ALUMINIUM FABRICATOR LTD.
Units 6-8, Sunray Industrial Centre, 1/F
610 Cha Kwo Ling Road, Kowloon
Tel:23489211-4 Fax:(852)27727666

DWG NO. : J837-CW-2205 | REV. : G

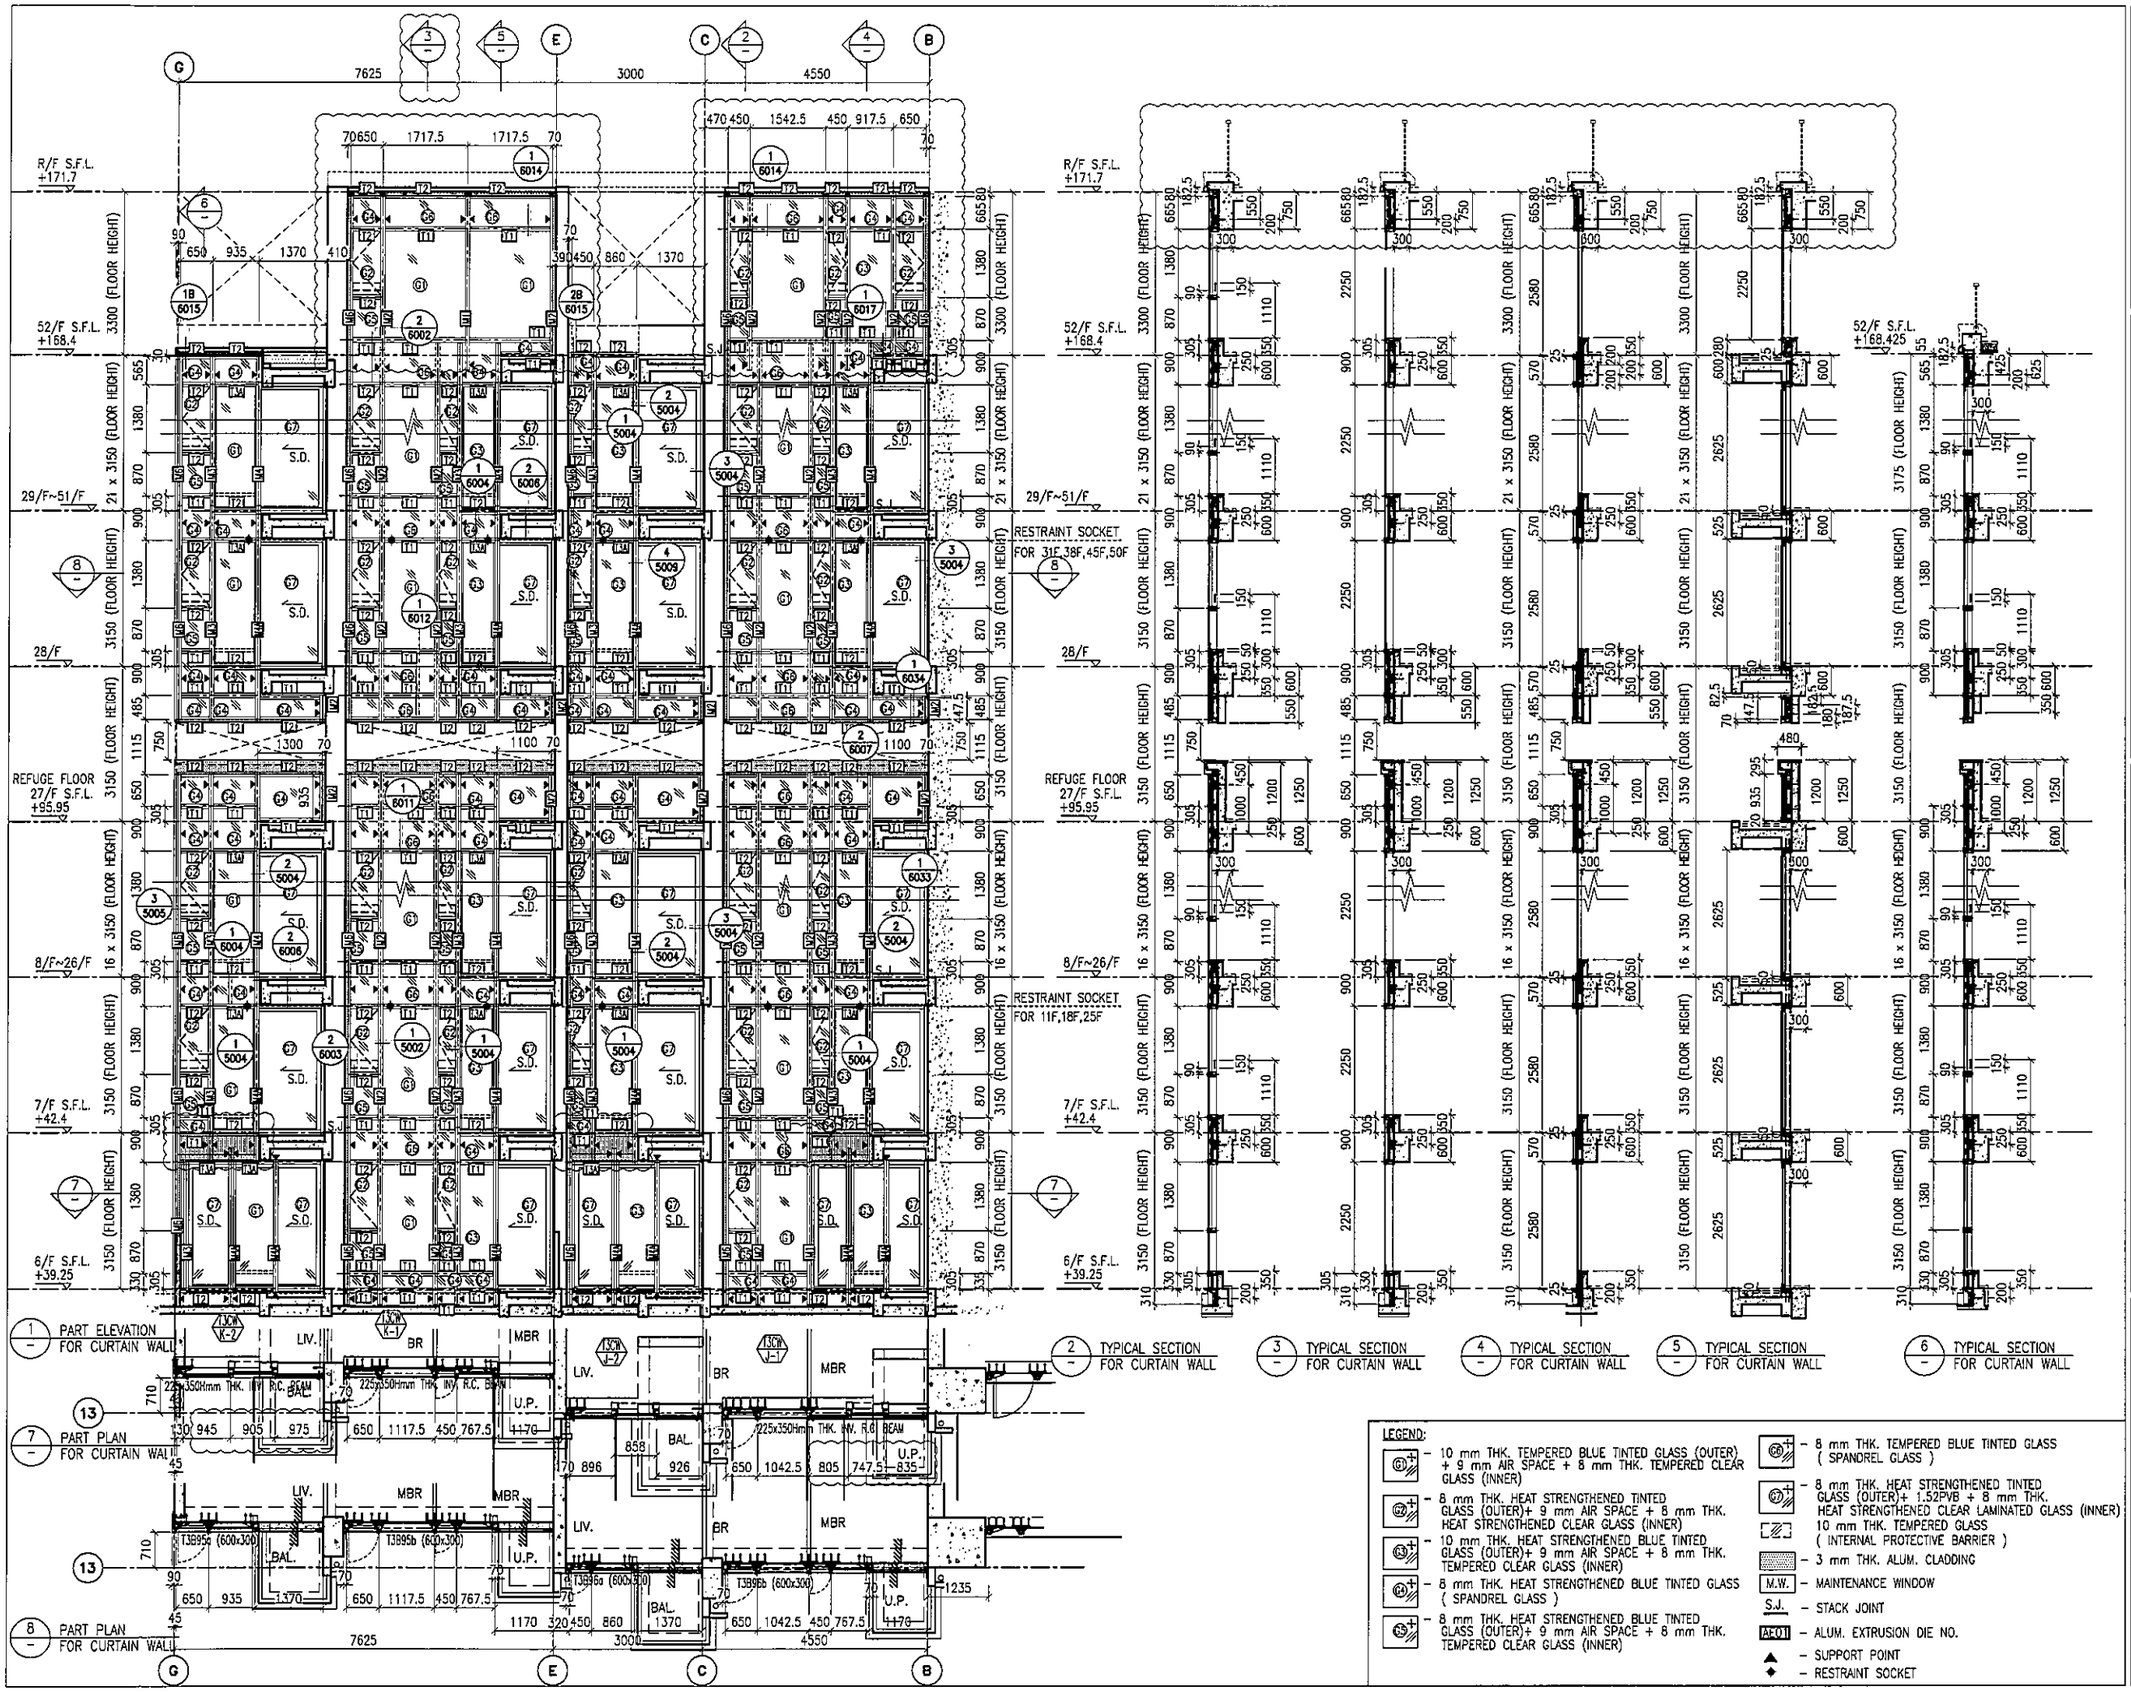

1 PART ELEVATION FOR CURTAIN WALL

7 PART PLAN FOR CURTAIN WALL

8 PART PLAN FOR CURTAIN WALL

2 TYPICAL SECTION FOR CURTAIN WALL

3 TYPICAL SECTION FOR CURTAIN WALL

4 TYPICAL SECTION FOR CURTAIN WALL

5 TYPICAL SECTION FOR CURTAIN WALL

6 TYPICAL SECTION FOR CURTAIN WALL

LEGEND:

- G1+ – 10 mm THK. TEMPERED BLUE TINTED GLASS (OUTER) + 9 mm AIR SPACE + 8 mm THK. TEMPERED CLEAR GLASS (INNER)
- G2+ – 8 mm THK. HEAT STRENGTHENED TINTED GLASS (OUTER)+ 9 mm AIR SPACE + 8 mm THK. HEAT STRENGTHENED CLEAR GLASS (INNER)
- G3+ – 10 mm THK. HEAT STRENGTHENED BLUE TINTED GLASS (OUTER)+ 9 mm AIR SPACE + 8 mm THK. TEMPERED CLEAR GLASS (INNER)
- G4+ – 8 mm THK. HEAT STRENGTHENED BLUE TINTED GLASS (SPANDREL GLASS)
- G5+ – 8 mm THK. HEAT STRENGTHENED BLUE TINTED GLASS (OUTER)+ 9 mm AIR SPACE + 8 mm THK. TEMPERED CLEAR GLASS (INNER)
- G6+ – 8 mm THK. TEMPERED BLUE TINTED GLASS (SPANDREL GLASS)
- G7+ – 8 mm THK. HEAT STRENGTHENED TINTED GLASS (OUTER)+ 1.52PVB + 8 mm THK. HEAT STRENGTHENED CLEAR LAMINATED GLASS (INNER) 10 mm THK. TEMPERED GLASS (INTERNAL PROTECTIVE BARRIER)
- 3 mm THK. ALUM. CLADDING
- M.W. – MAINTENANCE WINDOW
- S.J. – STACK JOINT
- AE01 – ALUM. EXTRUSION DIE NO.
- ▲ – SUPPORT POINT
- ◆ – RESTRAINT SOCKET

B.O. REF :

CLIENT :
信和置業有限公司
Sino Land Company Limited

ARCHITECT :
WONG TUNG & PARTNERS LIMITED
ARCHITECTS & PLANNERS

MAIN CONTRACTOR :
CR Construction Company Limited

STRUCTURAL ENGINEER :
AECOM

FACADE CONSULTANT:
AECOM

NOTE :
1. ALL DIMENSIONS ARE IN mm.
2. ALL ELEVATIONS ARE VIEWED FROM OUTSIDE.
3. ALL DIMENSIONS TO BE VERIFIED ON SITE BEFORE FABRICATION.

LEGEND :
- X1 / XC01 — DETAIL MARK NO. / REFER SHEET NO.
1. F.F.L. --FINISHED FLOOR LEVEL
2. S.F.L. --STRUCTURAL FLOOR LEVEL
3. /R --REVERSED DETAIL

NO.	DATE	REVISED	BY
H	16/07/2019	GENERAL REVISED	
G	26/05/2019	GENERAL REVISED	
F	07/04/2019	GENERAL REVISED	
E	17/01/2019	GENERAL REVISED	
D	22/12/2018	GENERAL REVISED	
C	04/12/2018	GENERAL REVISED	
B	24/11/2018	GENERAL REVISED	
A	10/9/2018	GENERAL REVISED	

JOB NO. : J-837

PROJECT :
URA KWUN TONG TOWN CENTRE REDEVELOPMENT (AREA 2 & 3) AT NKIL 6514, KWUN TONG, KWLOON

TITLE :
PART ELEVATION OF CURTAIN WALL AT TOWER 3

DATE : 04-JUL-18 | SCALE : 1:60 (A1)

DRAWN BY : ASING | CHECKED BY : –

美特鋁質有限公司
MIDI ALUMINIUM FABRICATOR LTD.
Units 6-8, Sunray Industrial Centre, 1/F
610 Cha Kwo Ling Road, Kowloon
Tel:23489211-4 Fax:(852)27727666

DWG NO. : J837-CW-2305 | REV. : H

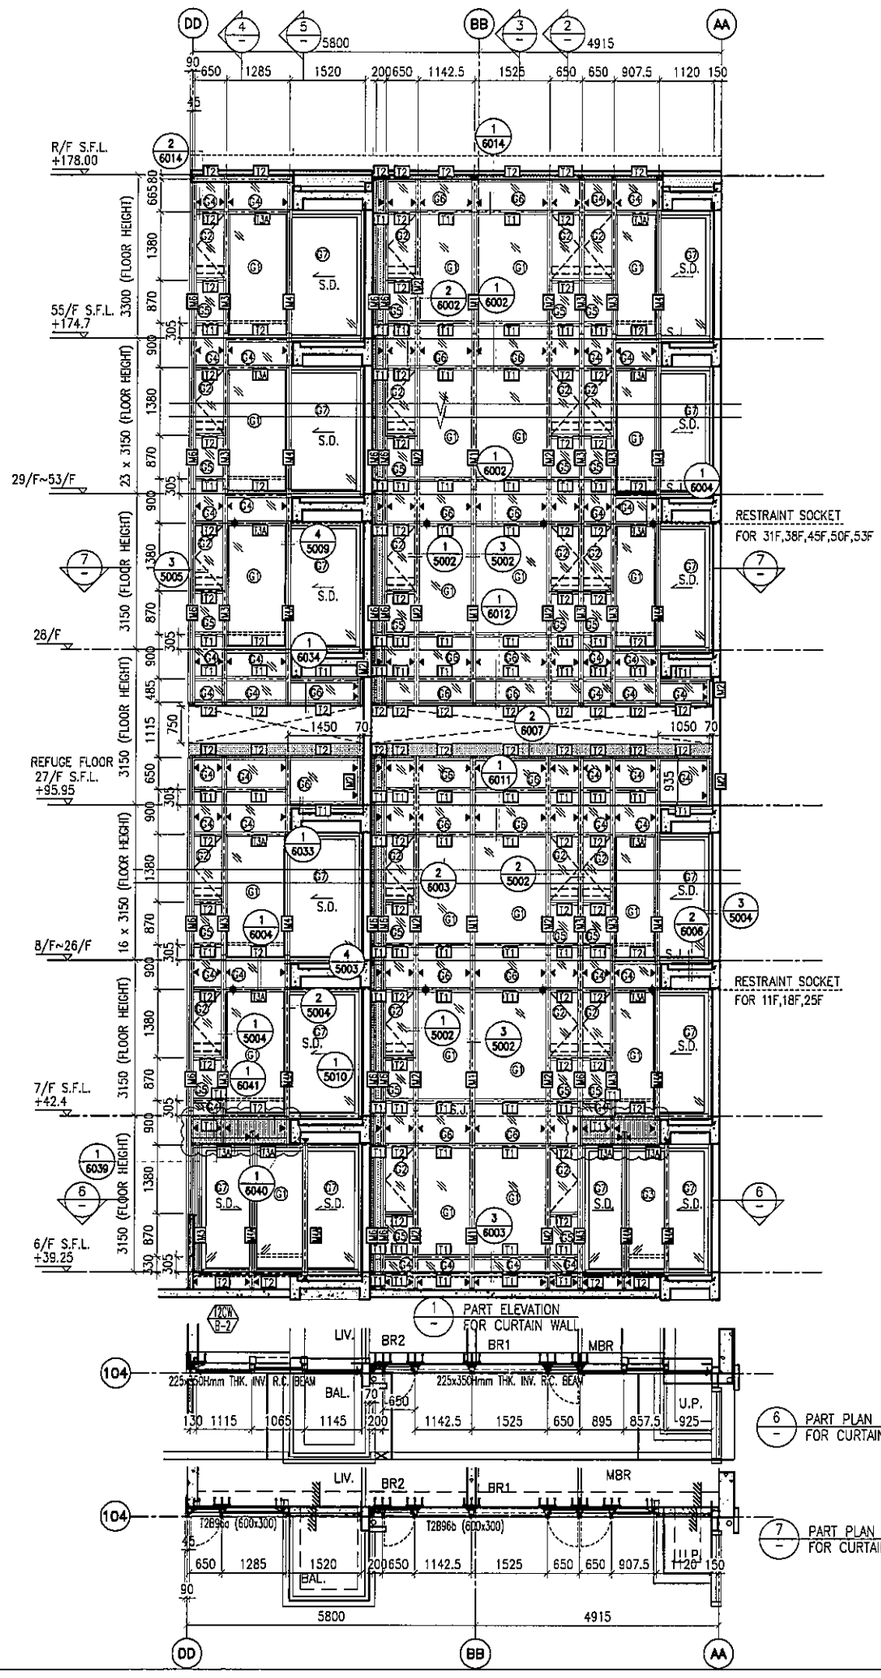

6 PART PLAN FOR CURTAIN WALL

7 PART PLAN FOR CURTAIN WALL

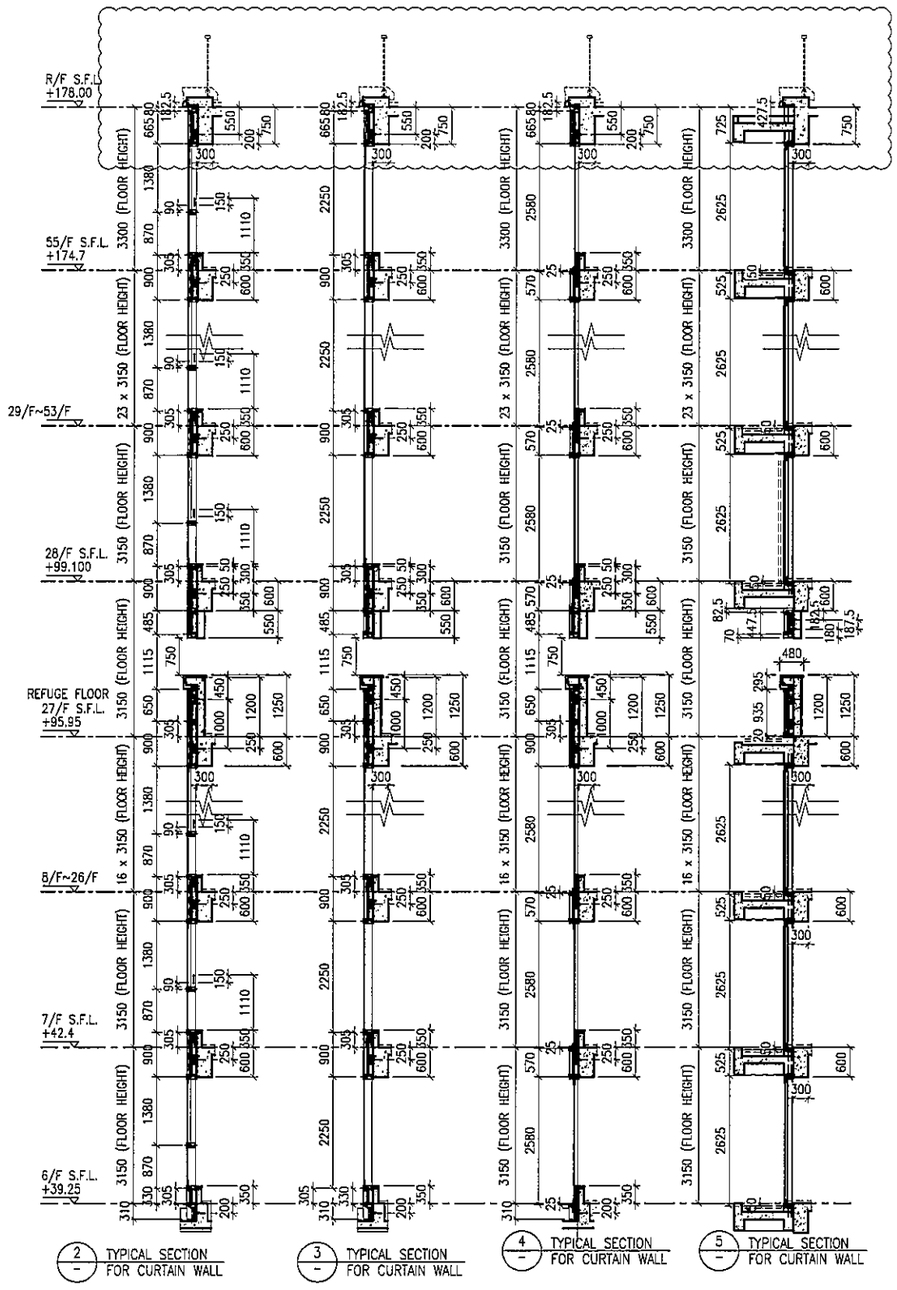

2 TYPICAL SECTION FOR CURTAIN WALL

3 TYPICAL SECTION FOR CURTAIN WALL

4 TYPICAL SECTION FOR CURTAIN WALL

5 TYPICAL SECTION FOR CURTAIN WALL

LEGEND:

- G1+ – 10 mm THK. TEMPERED BLUE TINTED GLASS (OUTER) + 9 mm AIR SPACE + 8 mm THK. TEMPERED CLEAR GLASS (INNER)
- G2+ – 8 mm THK. HEAT STRENGTHENED TINTED GLASS (OUTER)+ 9 mm AIR SPACE + 8 mm THK. HEAT STRENGTHENED CLEAR GLASS (INNER)
- G3+ – 10 mm THK. HEAT STRENGTHENED BLUE TINTED GLASS (OUTER)+ 9 mm AIR SPACE + 8 mm THK. TEMPERED CLEAR GLASS (INNER)
- G4+ – 8 mm THK. HEAT STRENGTHENED BLUE TINTED GLASS (SPANDREL GLASS)
- G5+ – 8 mm THK. HEAT STRENGTHENED BLUE TINTED GLASS (OUTER)+ 9 mm AIR SPACE + 8 mm THK. TEMPERED CLEAR GLASS (INNER)
- G6+ – 8 mm THK. TEMPERED BLUE TINTED GLASS (SPANDREL GLASS)
- G7+ – 8 mm THK. HEAT STRENGTHENED TINTED GLASS (OUTER)+ 1.52PVB + 8 mm THK. HEAT STRENGTHENED CLEAR LAMINATED GLASS (INNER) 10 mm THK. TEMPERED GLASS (INTERNAL PROTECTIVE BARRIER)
- – 3 mm THK. ALUM. CLADDING
- M.W. – MAINTENANCE WINDOW
- S.J. – STACK JOINT
- AE01 – ALUM. EXTRUSION DIE NO.
- ▲ – SUPPORT POINT
- ✦ – RESTRAINT SOCKET

B.D. REF :

CLIENT :
信和置業有限公司
Sino Land Company Limited

ARCHITECT :
WONG TUNG & PARTNERS LIMITED
ARCHITECTS & PLANNERS

MAIN CONTRACTOR :
CR Construction Company Limited

STRUCTURAL ENGINEER :
AECOM

FACADE CONSULTANT:
AECOM

NOTE :
1. ALL DIMENSIONS ARE IN mm.
2. ALL ELEVATIONS ARE VIEWED FROM OUTSIDE.
3. ALL DIMENSIONS TO BE VERIFIED ON SITE BEFORE FABRICATION.

LEGEND :
- X1 / X001 – DETAIL MARK NO. / REFER SHEET NO.
1. F.F.L. --FINISHED FLOOR LEVEL
2. S.F.L. --STRUCTURAL FLOOR LEVEL
3. (R) --REVERSED DETAIL

NO.	DATE	REVISED	BY
G	16/07/2019	GENERAL REVISED	
F	26/05/2019	GENERAL REVISED	
E	17/01/2019	GENERAL REVISED	
D	22/12/2018	GENERAL REVISED	
C	04/12/2018	GENERAL REVISED	
B	24/11/2018	GENERAL REVISED	
A	10/9/2018	GENERAL REVISED	

JOB NO. : J-837

PROJECT :
URA KWUN TONG TOWN CENTRE REDEVELOPMENT (AREA 2 & 3) AT NKIL 6514, KWUN TONG, KWLOON

TITLE :
PART ELEVATION OF CURTAIN WALL AT TOWER 2

DATE : 04-JUL-18 | SCALE : 1:60 (A1)

DRAWN BY : ASING | CHECKED BY : –

美特鋁質有限公司
MIDI ALUMINIUM FABRICATOR LTD.
Units 6-8, Sunray Industrial Centre, 1/F
610 Cha Kwo Ling Road, Kowloon
Tel:23489211-4 Fax:(852)27727666

DWG NO. : J837-CW-2206 | REV. : G

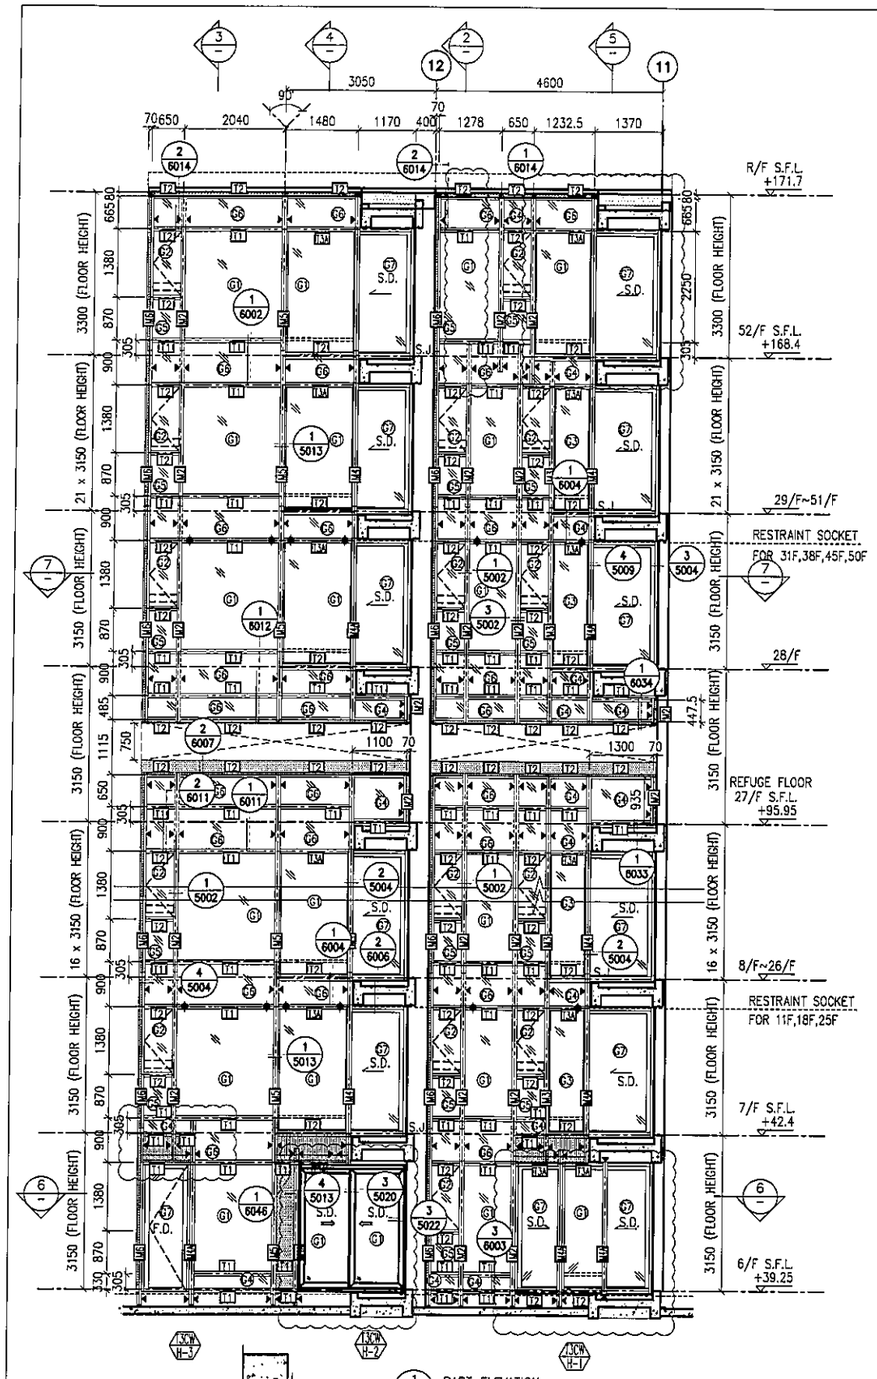

1 PART ELEVATION FOR CURTAIN WALL

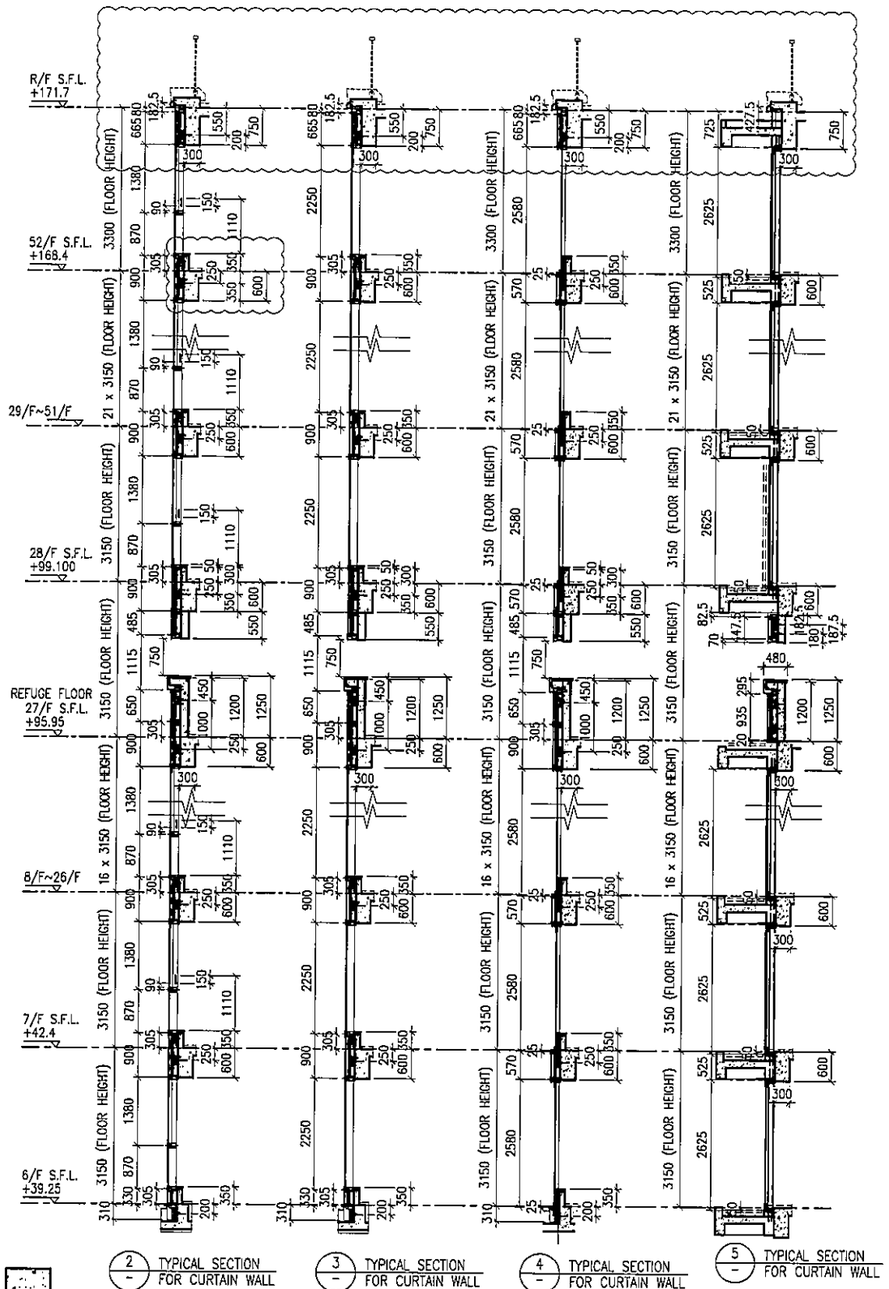

2 TYPICAL SECTION FOR CURTAIN WALL

3 TYPICAL SECTION FOR CURTAIN WALL

4 TYPICAL SECTION FOR CURTAIN WALL

5 TYPICAL SECTION FOR CURTAIN WALL

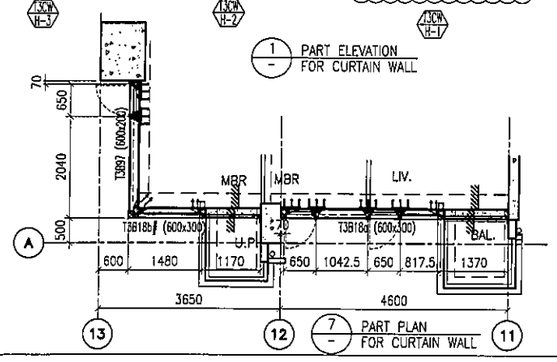

7 PART PLAN FOR CURTAIN WALL

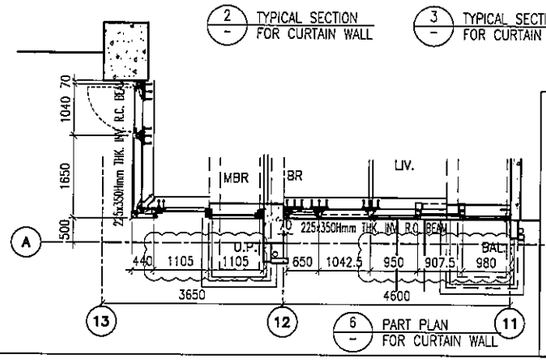

6 PART PLAN FOR CURTAIN WALL

LEGEND:

- G1 – 10 mm THK. TEMPERED BLUE TINTED GLASS (OUTER) + 9 mm AIR SPACE + 8 mm THK. TEMPERED CLEAR GLASS (INNER)
- G2 – 8 mm THK. HEAT STRENGTHENED TINTED GLASS (OUTER)+ 9 mm AIR SPACE + 8 mm THK. HEAT STRENGTHENED CLEAR GLASS (INNER)
- G3 – 10 mm THK. HEAT STRENGTHENED BLUE TINTED GLASS (OUTER)+ 9 mm AIR SPACE + 8 mm THK. TEMPERED CLEAR GLASS (INNER)
- G4 – 8 mm THK. HEAT STRENGTHENED BLUE TINTED GLASS (SPANDREL GLASS)
- G5 – 8 mm THK. HEAT STRENGTHENED BLUE TINTED GLASS (OUTER)+ 9 mm AIR SPACE + 8 mm THK. TEMPERED CLEAR GLASS (INNER)
- G6 – 8 mm THK. TEMPERED BLUE TINTED GLASS (SPANDREL GLASS)
- G7 – 8 mm THK. HEAT STRENGTHENED TINTED GLASS (OUTER)+ 1.52PVB + 8 mm THK. HEAT STRENGTHENED CLEAR LAMINATED GLASS (INNER)
- 10 mm THK. TEMPERED GLASS (INTERNAL PROTECTIVE BARRIER)
- 3 mm THK. ALUM. CLADDING
- M.W. – MAINTENANCE WINDOW
- S.J. – STACK JOINT
- AE01 – ALUM. EXTRUSION DIE NO.
- ▲ – SUPPORT POINT
- ✦ – RESTRAINT SOCKET

B.D. REF :

CLIENT :
信和置業有限公司
Sino Land Company Limited

ARCHITECT :
WONG TUNG & PARTNERS LIMITED
ARCHITECTS & PLANNERS

MAIN CONTRACTOR :
CR Construction Company Limited

STRUCTURAL ENGINEER :
AECOM

FACADE CONSULTANT:
AECOM

NOTE :
1. ALL DIMENSIONS ARE IN mm.
2. ALL ELEVATIONS ARE VIEWED FROM OUTSIDE.
3. ALL DIMENSIONS TO BE VERIFIED ON SITE BEFORE FABRICATION.

LEGEND :
- X1 / X001 – DETAIL MARK NO. / REFER SHEET NO.
1. F.F.L. --FINISHED FLOOR LEVEL
2. S.F.L. --STRUCTURAL FLOOR LEVEL
3. (R) --REVERSED DETAIL

NO.	DATE	REVISED	BY
H	16/07/2019	GENERAL REVISED	
G	26/05/2019	GENERAL REVISED	
F	07/04/2019	GENERAL REVISED	
E	22/12/2018	GENERAL REVISED	
D	22/12/2018	GENERAL REVISED	
C	04/12/2018	GENERAL REVISED	
B	24/11/2018	GENERAL REVISED	
A	10/9/2018	GENERAL REVISED	

JOB NO. : J-837

PROJECT :
URA KWUN TONG TOWN CENTRE REDEVELOPMENT (AREA 2 & 3) AT NKIL 6514, KWUN TONG, KWLOON

TITLE :
PART ELEVATION OF CURTAIN WALL AT TOWER 3

DATE : 04-JUL-18 | SCALE : 1:60 (A1)

DRAWN BY : ASING | CHECKED BY : –

美特鋁質有限公司
MIDI ALUMINIUM FABRICATOR LTD.
Units 6-8, Sunray Industrial Centre, 1/F
610 Cha Kwo Ling Road, Kowloon
Tel:23489211-4 Fax:(852)27727666

DWG NO. : J837-CW-2306 | REV. : H

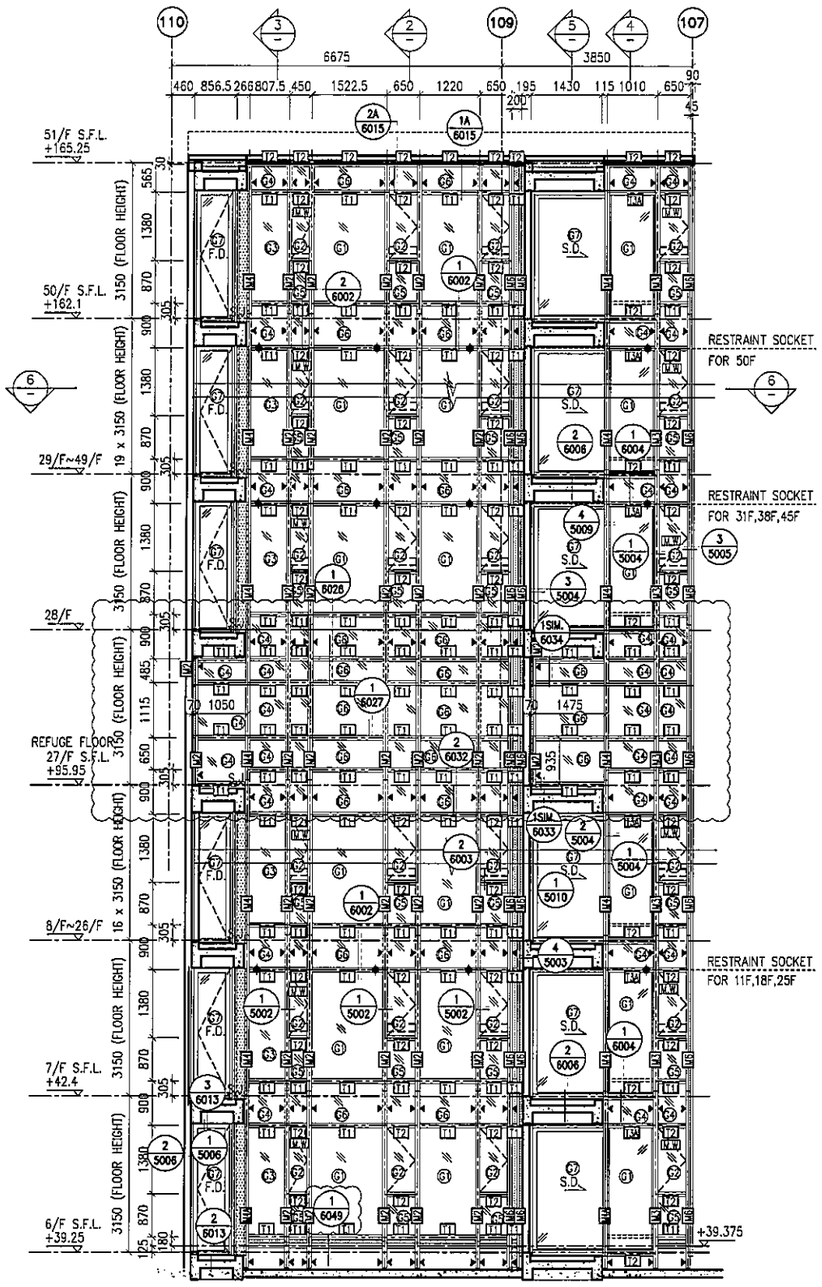

1 PART ELEVATION FOR CURTAIN WALL

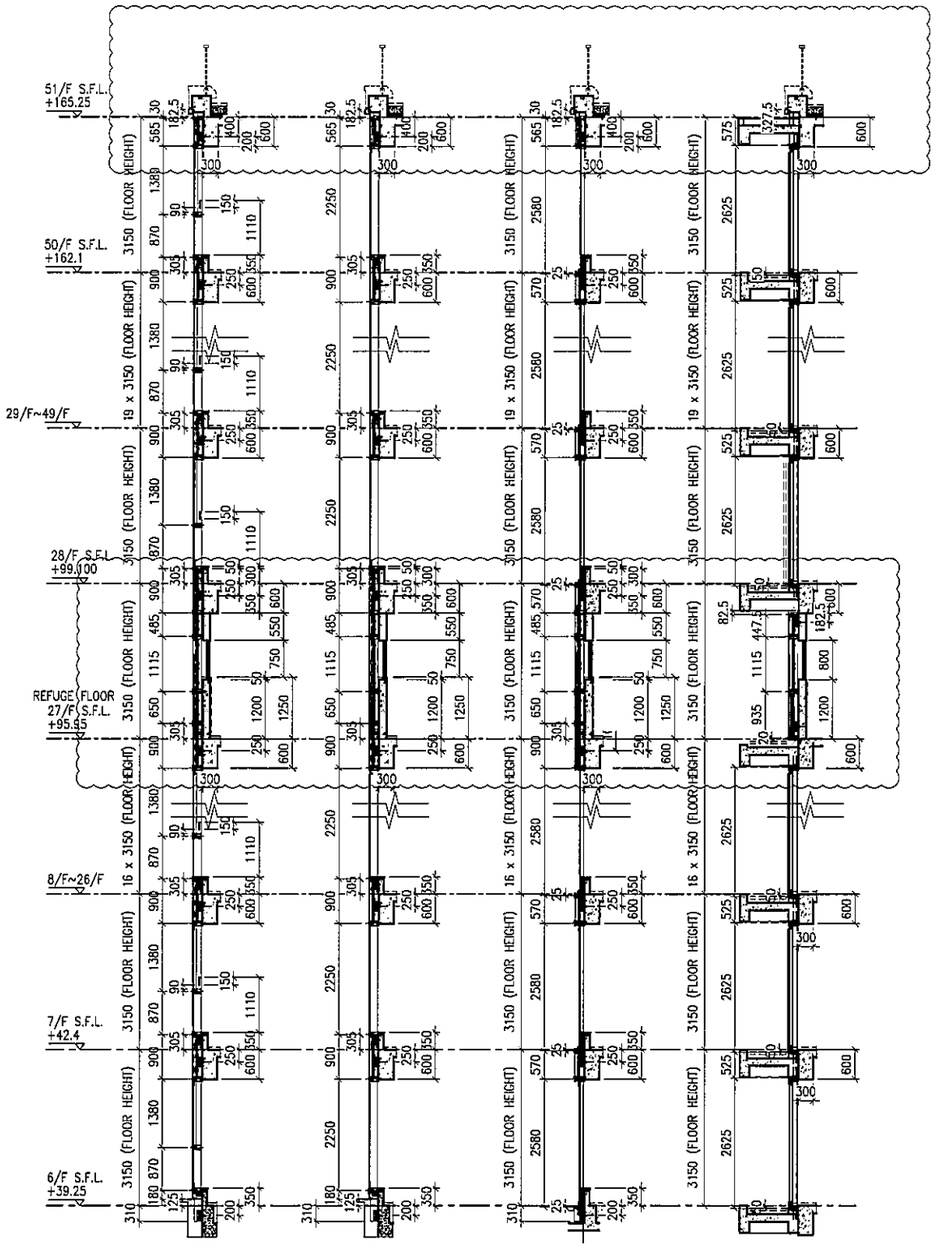

2 TYPICAL SECTION FOR CURTAIN WALL

3 TYPICAL SECTION FOR CURTAIN WALL

4 TYPICAL SECTION FOR CURTAIN WALL

5 TYPICAL SECTION FOR CURTAIN WALL

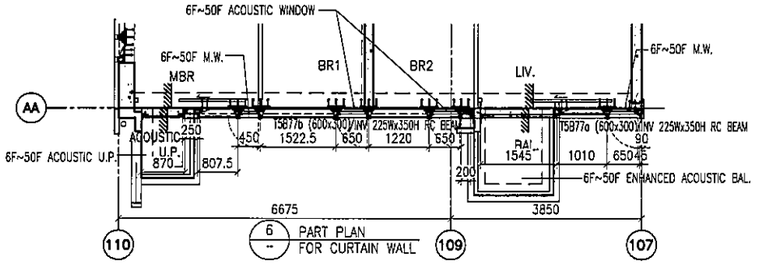

6 PART PLAN FOR CURTAIN WALL

LEGEND:

- 10 mm THK. TEMPERED BLUE TINTED GLASS (OUTER) + 9 mm AIR SPACE + 8 mm THK. TEMPERED CLEAR GLASS (INNER)
- 8 mm THK. HEAT STRENGTHENED TINTED GLASS (OUTER)+ 9 mm AIR SPACE + 8 mm THK. HEAT STRENGTHENED CLEAR GLASS (INNER)
- 10 mm THK. HEAT STRENGTHENED BLUE TINTED GLASS (OUTER)+ 9 mm AIR SPACE + 8 mm THK. TEMPERED CLEAR GLASS (INNER)
- 8 mm THK. HEAT STRENGTHENED BLUE TINTED GLASS (SPANDREL GLASS)
- 8 mm THK. HEAT STRENGTHENED BLUE TINTED GLASS (OUTER)+ 9 mm AIR SPACE + 8 mm THK. TEMPERED CLEAR GLASS (INNER)
- 8 mm THK. TEMPERED BLUE TINTED GLASS (SPANDREL GLASS)
- 8 mm THK. HEAT STRENGTHENED TINTED GLASS (OUTER)+ 1.52PVB + 8 mm THK. HEAT STRENGTHENED CLEAR LAMINATED GLASS (INNER)
- 10 mm THK. TEMPERED GLASS (INTERNAL PROTECTIVE BARRIER)
- 3 mm THK. ALUM. CLADDING
- M.W. – MAINTENANCE WINDOW
- S.J. – STACK JOINT
- AE01 – ALUM. EXTRUSION DIE NO.
- ▲ – SUPPORT POINT
- ✦ – RESTRAINT SOCKET

B.D. REF :

CLIENT :
信和置業有限公司
Sino Land Company Limited

ARCHITECT :
WONG TUNG & PARTNERS LIMITED
ARCHITECTS & PLANNERS

MAIN CONTRACTOR :
CR Construction Company Limited

STRUCTURAL ENGINEER :
AECOM

FACADE CONSULTANT:
AECOM

NOTE :
1. ALL DIMENSIONS ARE IN mm.
2. ALL ELEVATIONS ARE VIEWED FROM OUTSIDE.
3. ALL DIMENSIONS TO BE VERIFIED ON SITE BEFORE FABRICATION.

LEGEND :
X1 / X001 — DETAIL MARK NO. / REFER SHEET NO.
1. F.F.L. --FINISHED FLOOR LEVEL
2. S.F.L. --STRUCTURAL FLOOR LEVEL
3. (/R) --REVERSED DETAIL

NO.	DATE	REVISED	BY
F	16/07/2019	GENERAL REVISED	
E	17/01/2019	GENERAL REVISED	
D	22/12/2018	GENERAL REVISED	
C	04/12/2018	GENERAL REVISED	
B	24/11/2018	GENERAL REVISED	
A	10/9/2018	GENERAL REVISED	

JOB NO. : J-837

PROJECT :
URA KWUN TONG TOWN CENTRE REDEVELOPMENT (AREA 2 & 3) AT NKIL 6514, KWUN TONG, KWLOON

TITLE :
PART ELEVATION OF CURTAIN WALL AT TOWER 5

DATE : 04-JUL-18 | SCALE : 1:60 (A1)

DRAWN BY : ASING | CHECKED BY : –

美特鋁製有限公司
MIDI ALUMINIUM FABRICATOR LTD.
Units 6-8, Sunray Industrial Centre, 1/F
610 Cha Kwo Ling Road, Kowloon
Tel:23489211-4 Fax:(852)27727666

DWG NO. : J837-CW-2505 | REV. : F

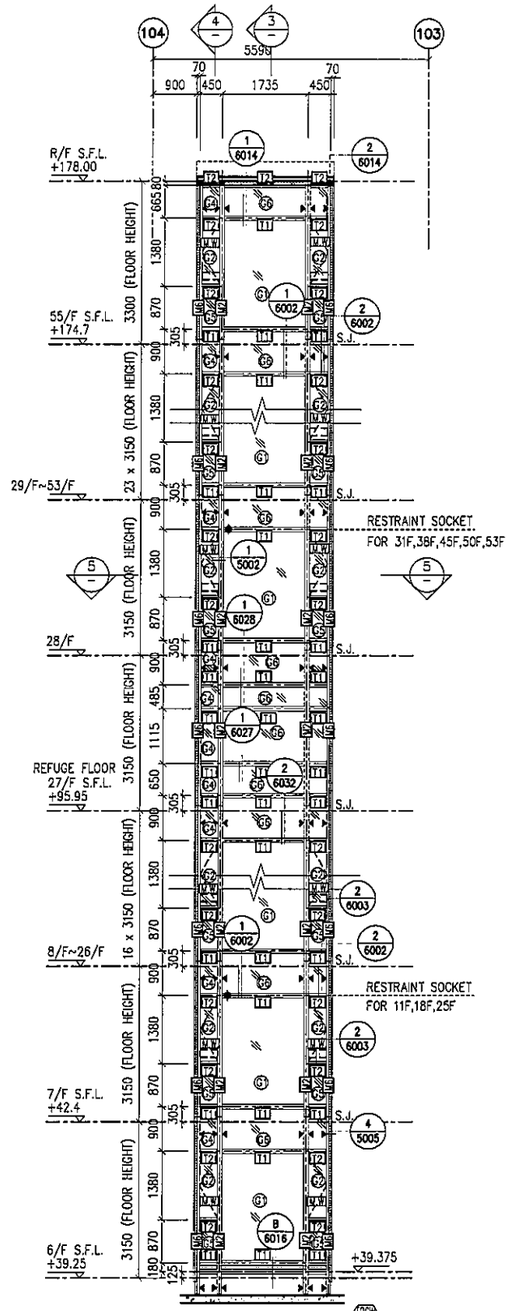

1 / – PART ELEVATION FOR CURTAIN WALL

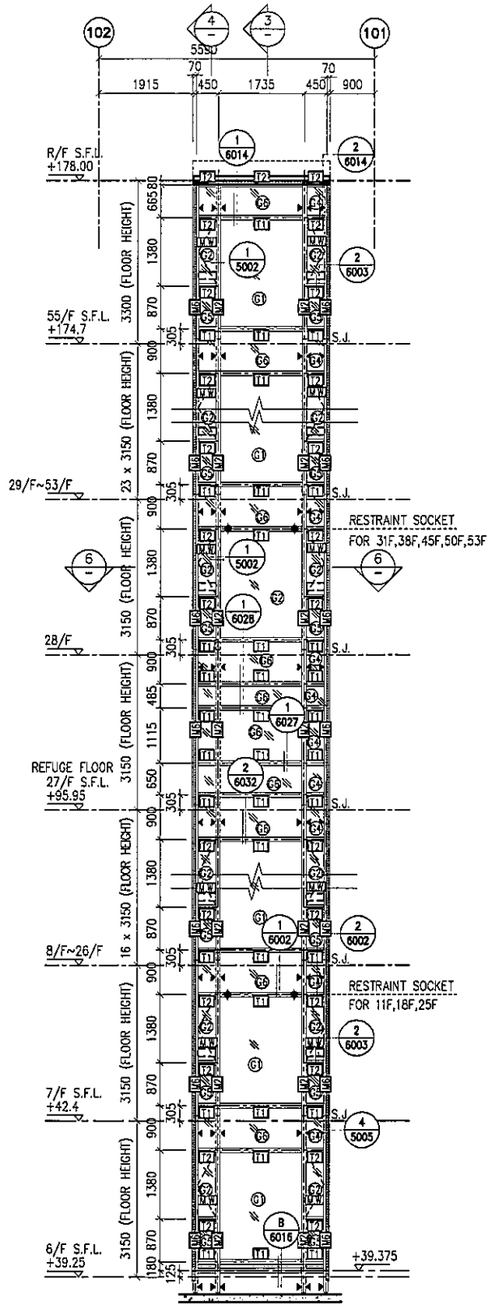

2 / – PART ELEVATION FOR CURTAIN WALL

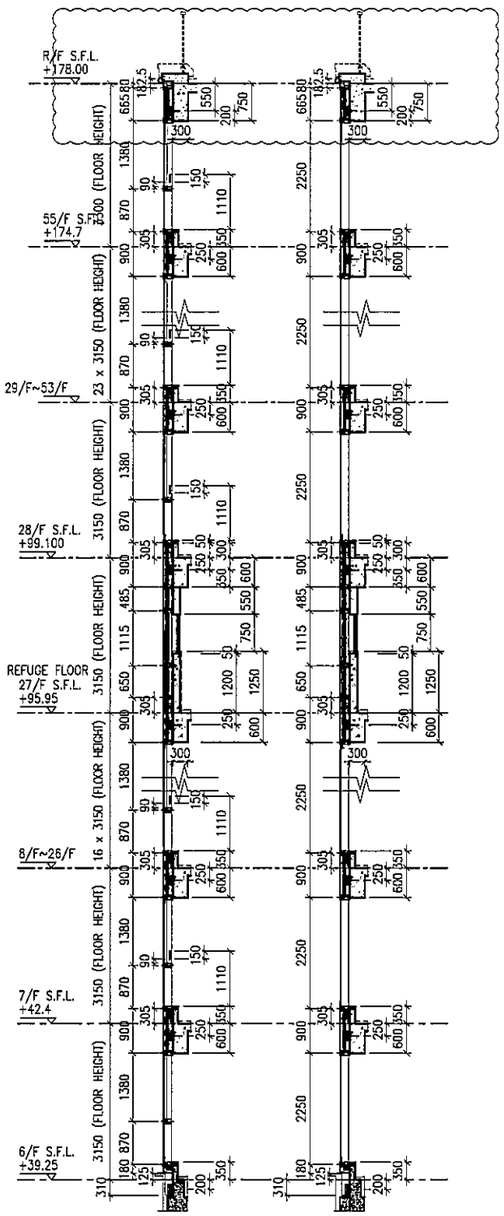

3 / – TYPICAL SECTION FOR CURTAIN WALL

4 / – TYPICAL SECTION FOR CURTAIN WALL

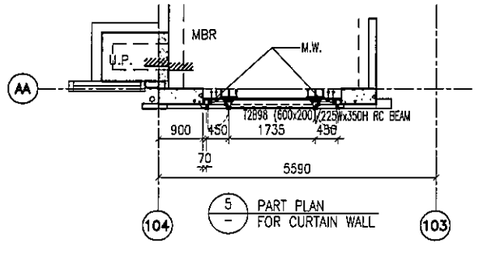

5 / – PART PLAN FOR CURTAIN WALL

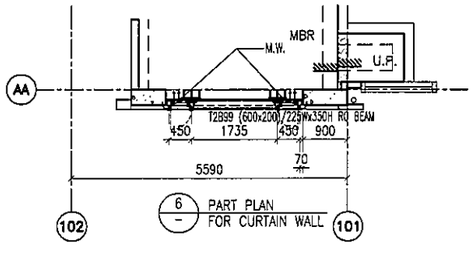

6 / – PART PLAN FOR CURTAIN WALL

LEGEND:

- – 10 mm THK. TEMPERED BLUE TINTED GLASS (OUTER) + 9 mm AIR SPACE + 8 mm THK. TEMPERED CLEAR GLASS (INNER)
- – 8 mm THK. HEAT STRENGTHENED TINTED GLASS (OUTER)+ 9 mm AIR SPACE + 8 mm THK. HEAT STRENGTHENED CLEAR GLASS (INNER)
- – 10 mm THK. HEAT STRENGTHENED BLUE TINTED GLASS (OUTER)+ 9 mm AIR SPACE + 8 mm THK. TEMPERED CLEAR GLASS (INNER)
- – 8 mm THK. HEAT STRENGTHENED BLUE TINTED GLASS (SPANDREL GLASS)
- – 8 mm THK. HEAT STRENGTHENED BLUE TINTED GLASS (OUTER)+ 9 mm AIR SPACE + 8 mm THK. TEMPERED CLEAR GLASS (INNER)
- – 8 mm THK. TEMPERED BLUE TINTED GLASS (SPANDREL GLASS)
- – 8 mm THK. HEAT STRENGTHENED TINTED GLASS (OUTER)+ 1.52PVB + 8 mm THK. HEAT STRENGTHENED CLEAR LAMINATED GLASS (INNER) 10 mm THK. TEMPERED GLASS (INTERNAL PROTECTIVE BARRIER)
- – 3 mm THK. ALUM. CLADDING
- M.W. – MAINTENANCE WINDOW
- S.J. – STACK JOINT
- AE01 – ALUM. EXTRUSION DIE NO.
- ▲ – SUPPORT POINT
- ✦ – RESTRAINT SOCKET

B.D. REF :

CLIENT :
信和置業有限公司
Sino Land Company Limited

ARCHITECT : WONG TUNG & PARTNERS LIMITED
ARCHITECTS & PLANNERS

MAIN CONTRACTOR :
CR Construction Company Limited

STRUCTURAL ENGINEER :
AECOM

FACADE CONSULTANT:
AECOM

NOTE :
1. ALL DIMENSIONS ARE IN mm.
2. ALL ELEVATIONS ARE VIEWED FROM OUTSIDE.
3. ALL DIMENSIONS TO BE VERIFIED ON SITE BEFORE FABRICATION.

LEGEND :
X1 / X001 — DETAIL MARK NO. / REFER SHEET NO.
1. F.F.L. --FINISHED FLOOR LEVEL
2. S.F.L. --STRUCTURAL FLOOR LEVEL
3. /R --REVERSED DETAIL

NO.	DATE	REVISED	BY
F	16/07/2019	GENERAL REVISED	
E	17/01/2019	GENERAL REVISED	
D	22/12/2018	GENERAL REVISED	
C	04/12/2018	GENERAL REVISED	
B	24/11/2018	GENERAL REVISED	
A	10/9/2018	GENERAL REVISED	

JOB NO. : J-837

PROJECT :
URA KWUN TONG TOWN CENTRE
REDEVELOPMENT (AREA 2 & 3) AT
NKIL 6514, KWUN TONG, KWLOON

TITLE :
PART ELEVATION
OF CURTAIN WALL
AT TOWER 2

DATE : 04-JUL-18 | SCALE : 1:60 (A1)

DRAWN BY : ASING | CHECKED BY : –

美特鋁質有限公司
MIDI ALUMINIUM FABRICATOR LTD.
Units 6-8, Sunray Industrial Centre, 1/F
610 Cha Kwo Ling Road, Kowloon
Tel:23489211-4 Fax:(852)27727666

DWG NO. : J837-CW-2207 | REV. : F

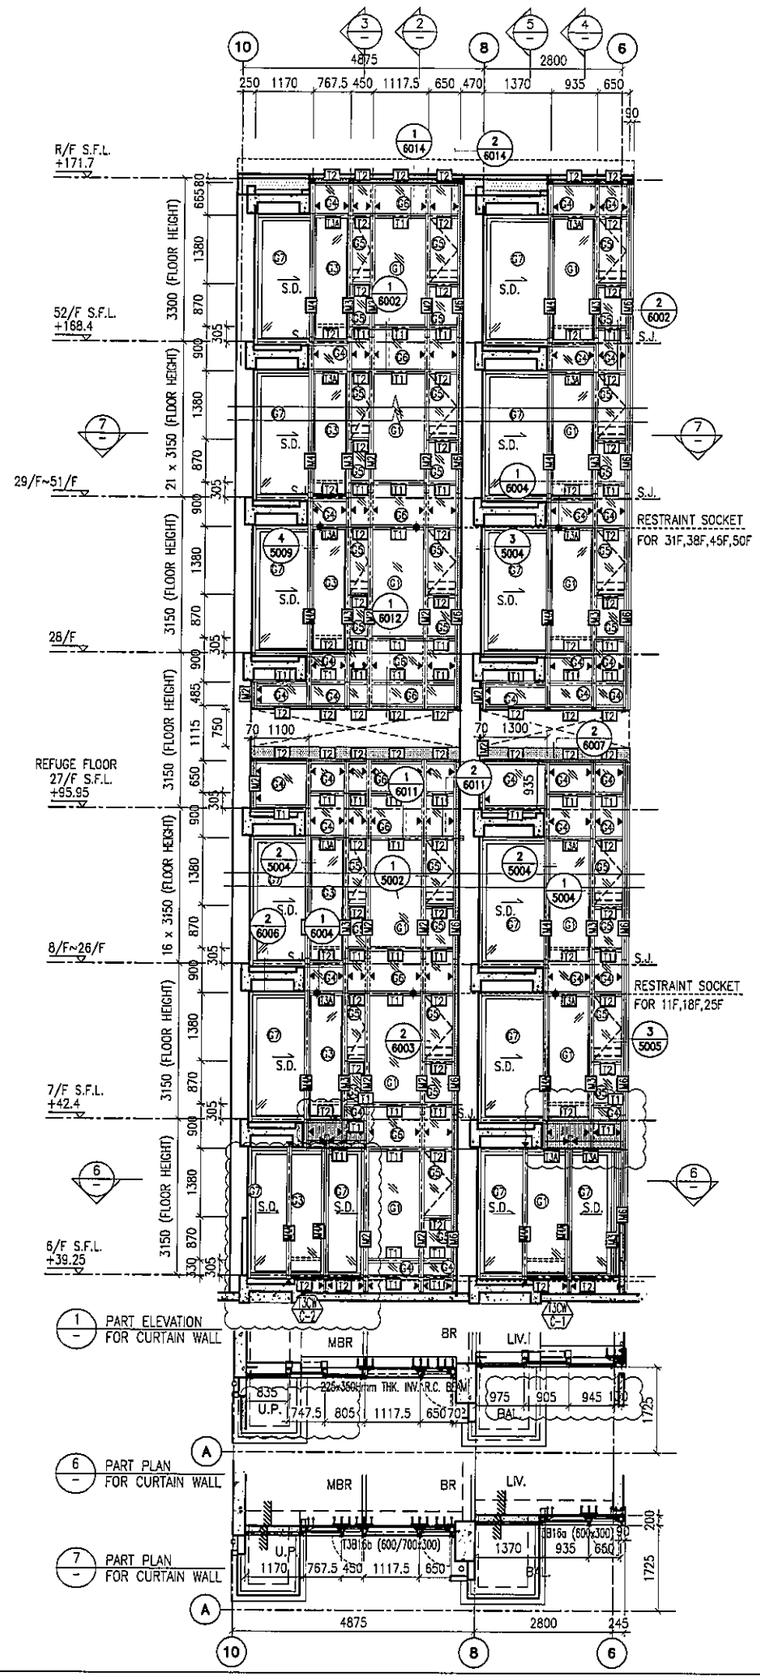

1 PART ELEVATION FOR CURTAIN WALL

6 PART PLAN FOR CURTAIN WALL

7 PART PLAN FOR CURTAIN WALL

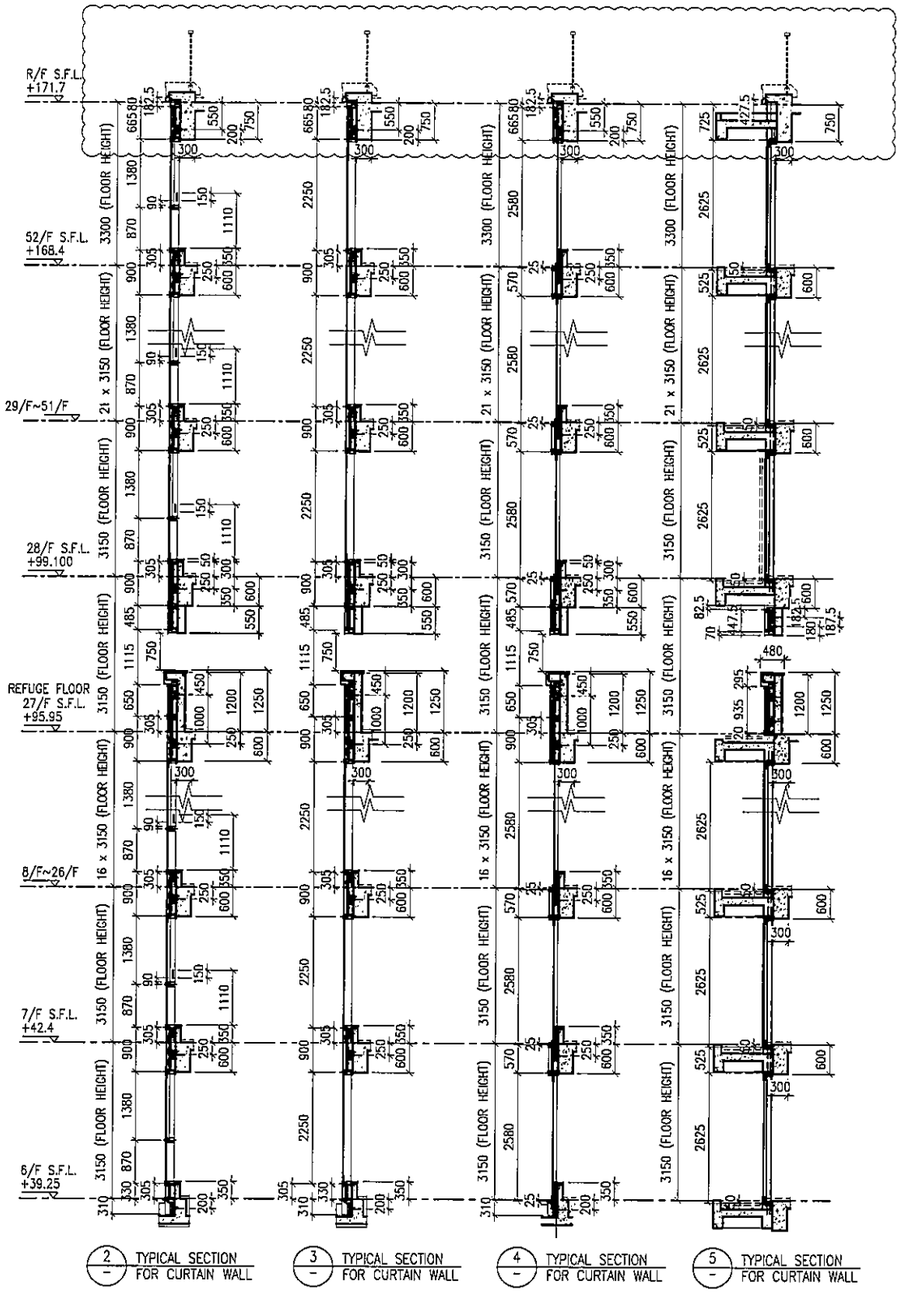

2 TYPICAL SECTION FOR CURTAIN WALL

3 TYPICAL SECTION FOR CURTAIN WALL

4 TYPICAL SECTION FOR CURTAIN WALL

5 TYPICAL SECTION FOR CURTAIN WALL

LEGEND:

- 10 mm THK. TEMPERED BLUE TINTED GLASS (OUTER) + 9 mm AIR SPACE + 8 mm THK. TEMPERED CLEAR GLASS (INNER)
- 8 mm THK. HEAT STRENGTHENED TINTED GLASS (OUTER)+ 9 mm AIR SPACE + 8 mm THK. HEAT STRENGTHENED CLEAR GLASS (INNER)
- 10 mm THK. HEAT STRENGTHENED BLUE TINTED GLASS (OUTER)+ 9 mm AIR SPACE + 8 mm THK. TEMPERED CLEAR GLASS (INNER)
- 8 mm THK. HEAT STRENGTHENED BLUE TINTED GLASS (SPANDREL GLASS)
- 8 mm THK. HEAT STRENGTHENED BLUE TINTED GLASS (OUTER)+ 9 mm AIR SPACE + 8 mm THK. TEMPERED CLEAR GLASS (INNER)
- 8 mm THK. TEMPERED BLUE TINTED GLASS (SPANDREL GLASS)
- 8 mm THK. HEAT STRENGTHENED TINTED GLASS (OUTER)+ 1.52PVB + 8 mm THK. HEAT STRENGTHENED CLEAR LAMINATED GLASS (INNER) 10 mm THK. TEMPERED GLASS (INTERNAL PROTECTIVE BARRIER)
- 3 mm THK. ALUM. CLADDING
- M.W. – MAINTENANCE WINDOW
- S.J. – STACK JOINT
- AE01 – ALUM. EXTRUSION DIE NO.
- ▲ – SUPPORT POINT
- ✦ – RESTRAINT SOCKET

B.D. REF :

CLIENT :
信和置業有限公司
Sino Land Company Limited

ARCHITECT :
WONG TUNG & PARTNERS LIMITED
ARCHITECTS & PLANNERS

MAIN CONTRACTOR :
CR Construction Company Limited

STRUCTURAL ENGINEER :
AECOM

FACADE CONSULTANT:
AECOM

NOTE :
1. ALL DIMENSIONS ARE IN mm.
2. ALL ELEVATIONS ARE VIEWED FROM OUTSIDE.
3. ALL DIMENSIONS TO BE VERIFIED ON SITE BEFORE FABRICATION.

LEGEND :
X1 / XD01 — DETAIL MARK NO. / REFER SHEET NO.
1. F.F.L. --FINISHED FLOOR LEVEL
2. S.F.L. --STRUCTURAL FLOOR LEVEL
3. (VR) --REVERSED DETAIL

NO.	DATE	REVISED	BY
G	16/07/2019	GENERAL REVISED	
F	26/05/2019	GENERAL REVISED	
E	17/01/2019	GENERAL REVISED	
D	22/12/2018	GENERAL REVISED	
C	04/12/2018	GENERAL REVISED	
B	24/11/2018	GENERAL REVISED	
A	10/9/2018	GENERAL REVISED	

JOB NO. : J-837

PROJECT :
URA KWUN TONG TOWN CENTRE REDEVELOPMENT (AREA 2 & 3) AT NKIL 6514, KWUN TONG, KWLOON

TITLE :
PART ELEVATION OF CURTAIN WALL AT TOWER 3

DATE : 04-JUL-18 | SCALE : 1:60 (A1)

DRAWN BY : ASING | CHECKED BY : -

美特鋁質有限公司
MIDI ALUMINIUM FABRICATOR LTD.
Units 6-8, Sunray Industrial Centre, 1/F
610 Cha Kwo Ling Road, Kowloon
Tel:23489211-4 Fax:(852)27727666

DWG NO. : J837-CW-2307 | REV. : G

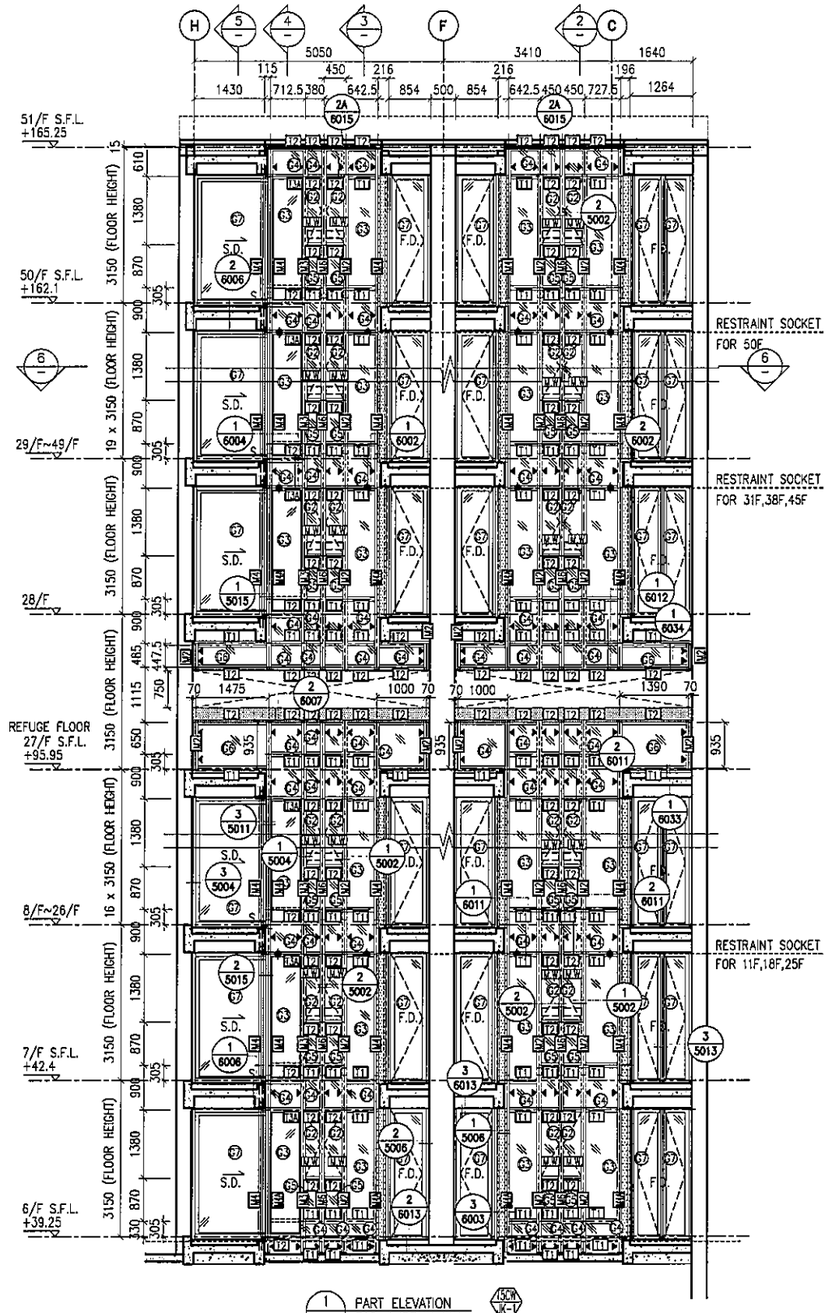

1 PART ELEVATION FOR CURTAIN WALL

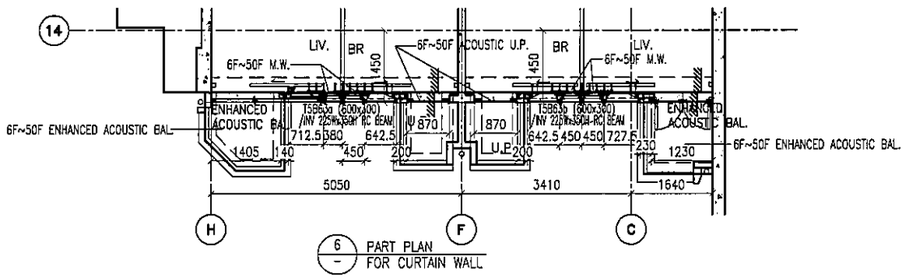

6 PART PLAN FOR CURTAIN WALL

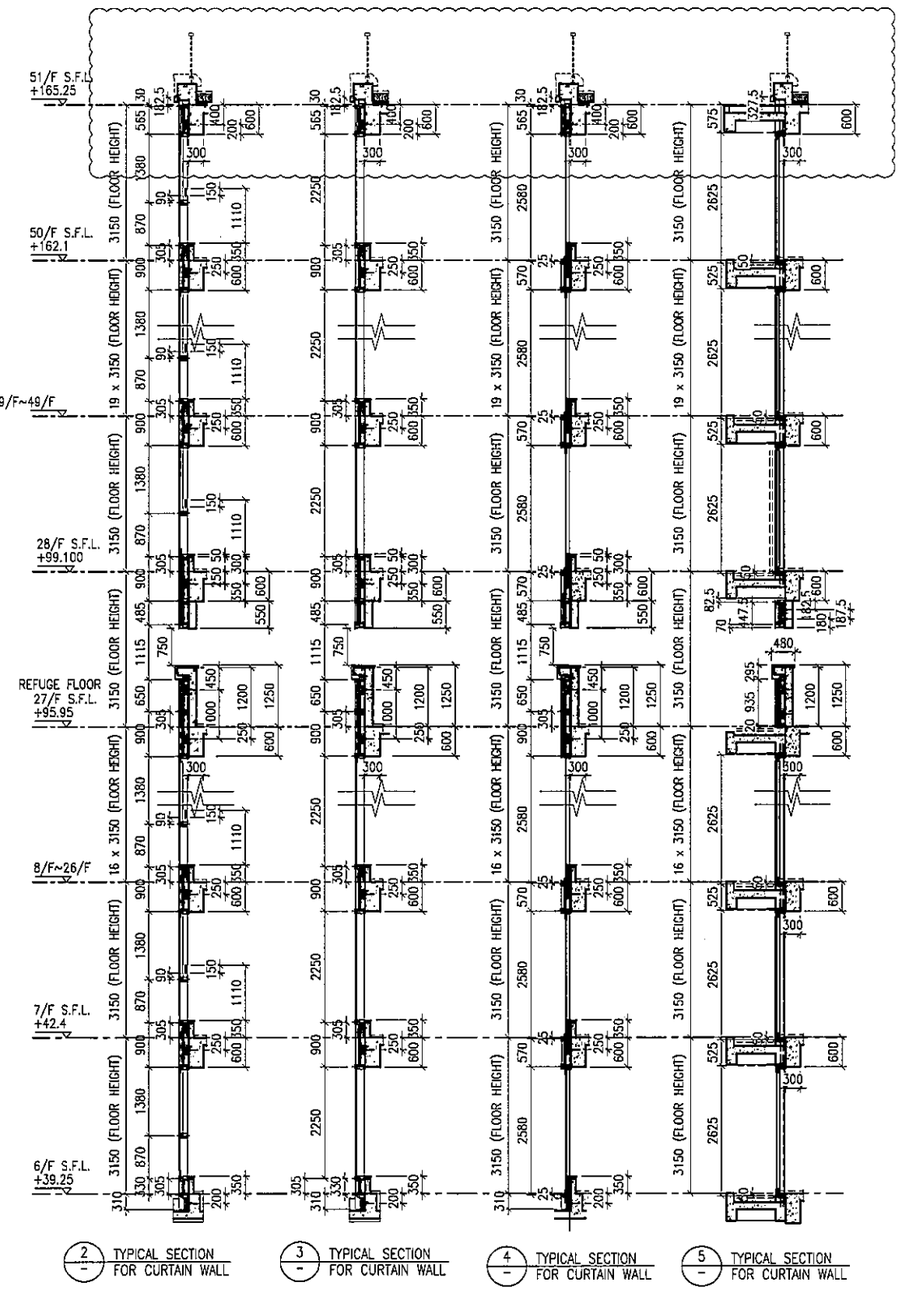

2 TYPICAL SECTION FOR CURTAIN WALL

3 TYPICAL SECTION FOR CURTAIN WALL

4 TYPICAL SECTION FOR CURTAIN WALL

5 TYPICAL SECTION FOR CURTAIN WALL

LEGEND:

- 6+ – 10 mm THK. TEMPERED BLUE TINTED GLASS (OUTER) + 9 mm AIR SPACE + 8 mm THK. TEMPERED CLEAR GLASS (INNER)
- 7+ – 8 mm THK. HEAT STRENGTHENED TINTED GLASS (OUTER)+ 9 mm AIR SPACE + 8 mm THK. HEAT STRENGTHENED CLEAR GLASS (INNER)
- 8+ – 10 mm THK. HEAT STRENGTHENED BLUE TINTED GLASS (OUTER)+ 9 mm AIR SPACE + 8 mm THK. TEMPERED CLEAR GLASS (INNER)
- 9+ – 8 mm THK. HEAT STRENGTHENED BLUE TINTED GLASS (SPANDREL GLASS)
- 10+ – 8 mm THK. HEAT STRENGTHENED BLUE TINTED GLASS (OUTER)+ 9 mm AIR SPACE + 8 mm THK. TEMPERED CLEAR GLASS (INNER)
- 6+ – 8 mm THK. TEMPERED BLUE TINTED GLASS (SPANDREL GLASS)
- 7+ – 8 mm THK. HEAT STRENGTHENED TINTED GLASS (OUTER)+ 1.52PVB + 8 mm THK. HEAT STRENGTHENED CLEAR LAMINATED GLASS (INNER) 10 mm THK. TEMPERED GLASS (INTERNAL PROTECTIVE BARRIER)
- 3 mm THK. ALUM. CLADDING
- M.W. – MAINTENANCE WINDOW
- S.J. – STACK JOINT
- AE01 – ALUM. EXTRUSION DIE NO.
- ▲ – SUPPORT POINT
- ✦ – RESTRAINT SOCKET

B.D. REF :

CLIENT :
信和置業有限公司
Sino Land Company Limited

ARCHITECT : WONG TUNG & PARTNERS LIMITED
ARCHITECTS & PLANNERS

MAIN CONTRACTOR :
CR Construction Company Limited

STRUCTURAL ENGINEER :
AECOM

FACADE CONSULTANT:
AECOM

NOTE :
1. ALL DIMENSIONS ARE IN mm.
2. ALL ELEVATIONS ARE VIEWED FROM OUTSIDE.
3. ALL DIMENSIONS TO BE VERIFIED ON SITE BEFORE FABRICATION.

LEGEND :
X1 / X001 – DETAIL MARK NO. / REFER SHEET NO.
1. F.F.L. --FINISHED FLOOR LEVEL
2. S.F.L. --STRUCTURAL FLOOR LEVEL
3. /R --REVERSED DETAIL

NO.	DATE	REVISED	BY
F	16/07/2019	GENERAL REVISED	
E	17/01/2019	GENERAL REVISED	
D	22/12/2018	GENERAL REVISED	
C	04/12/2018	GENERAL REVISED	
B	24/11/2018	GENERAL REVISED	
A	10/9/2018	GENERAL REVISED	

JOB NO. : J-837

PROJECT :
URA KWUN TONG TOWN CENTRE REDEVELOPMENT (AREA 2 & 3) AT NKIL 6514, KWUN TONG, KWLOON

TITLE :
PART ELEVATION OF CURTAIN WALL AT TOWER 5

DATE : 04-JUL-18 | SCALE : 1:60 (A1)
DRAWN BY : ASING | CHECKED BY : -

美特鋁質有限公司
MIDI ALUMINIUM FABRICATOR LTD.
Units 6-8, Sunray Industrial Centre, 1/F
610 Cha Kwo Ling Road, Kowloon
Tel:23489211-4 Fax:(852)27727666

DWG NO. : J837-CW-2506 | REV. : F

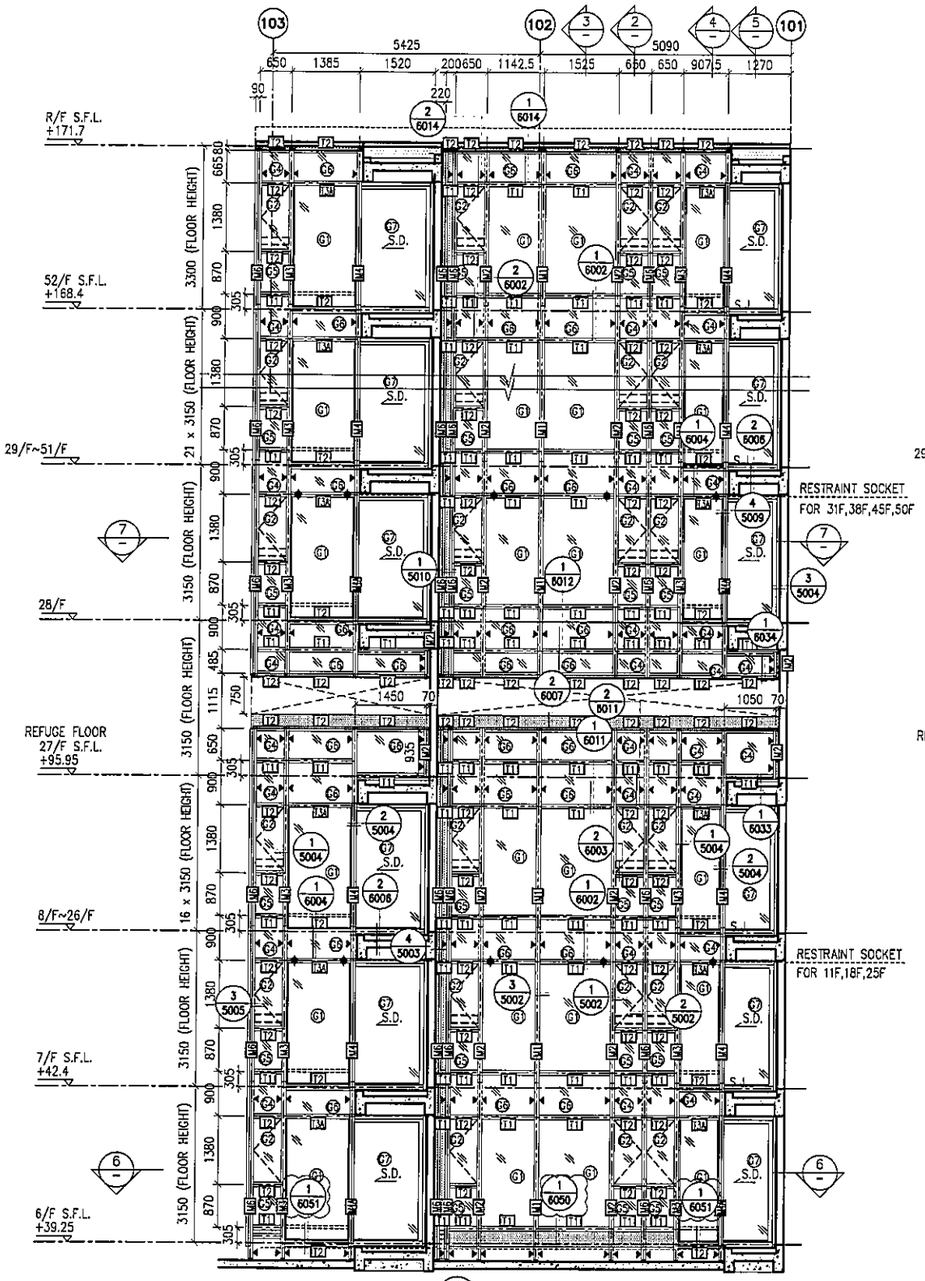

1 PART ELEVATION FOR CURTAIN WALL

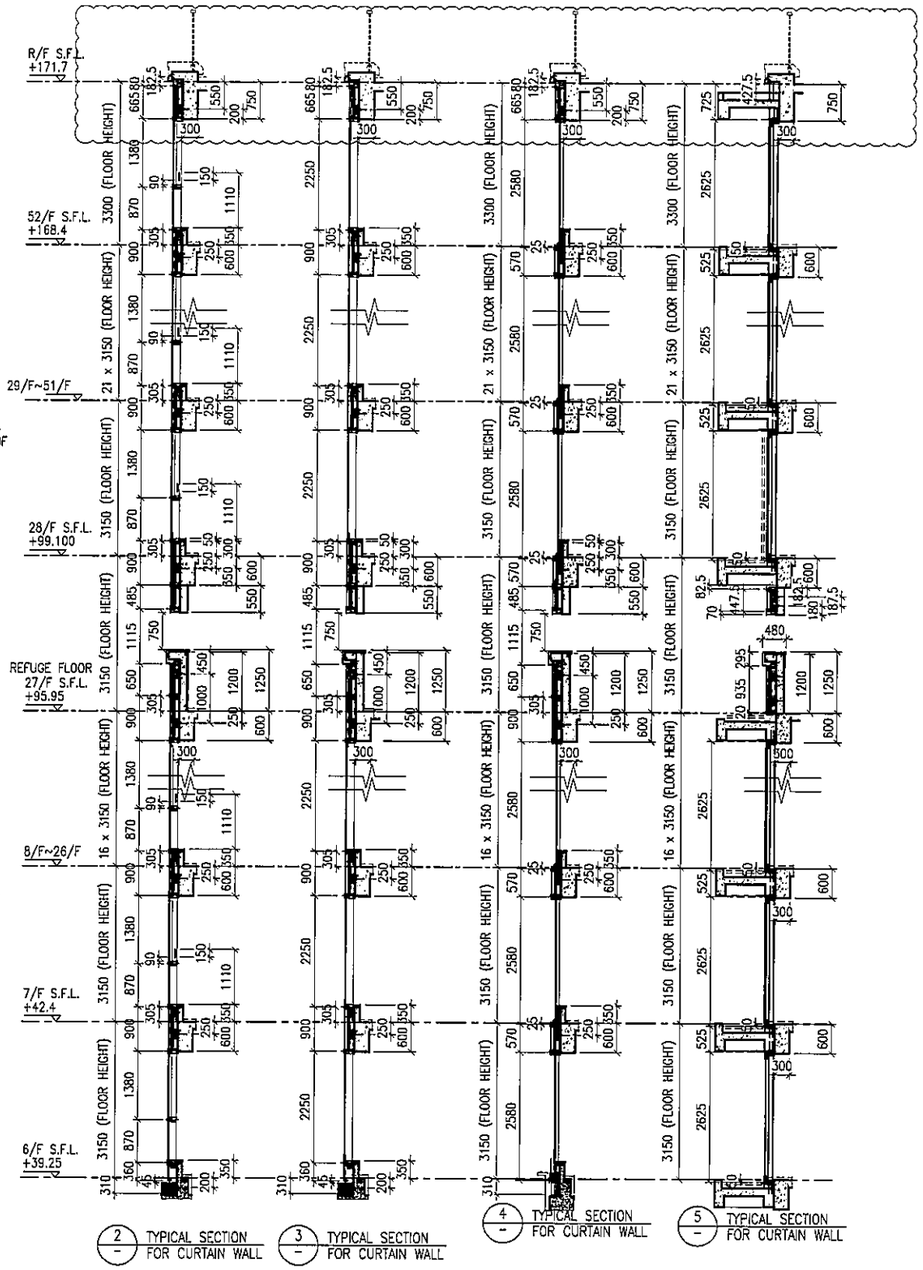

2 TYPICAL SECTION FOR CURTAIN WALL

3 TYPICAL SECTION FOR CURTAIN WALL

4 TYPICAL SECTION FOR CURTAIN WALL

5 TYPICAL SECTION FOR CURTAIN WALL

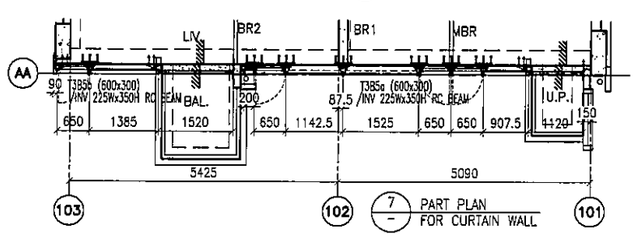

6 PART PLAN FOR CURTAIN WALL

7 PART PLAN FOR CURTAIN WALL

LEGEND:

- G1 – 10 mm THK. TEMPERED BLUE TINTED GLASS (OUTER) + 9 mm AIR SPACE + 8 mm THK. TEMPERED CLEAR GLASS (INNER)
- G2 – 8 mm THK. HEAT STRENGTHENED TINTED GLASS (OUTER)+ 9 mm AIR SPACE + 8 mm THK. HEAT STRENGTHENED CLEAR GLASS (INNER)
- G3 – 10 mm THK. HEAT STRENGTHENED BLUE TINTED GLASS (OUTER)+ 9 mm AIR SPACE + 8 mm THK. TEMPERED CLEAR GLASS (INNER)
- G4 – 8 mm THK. HEAT STRENGTHENED BLUE TINTED GLASS (SPANDREL GLASS)
- G5 – 8 mm THK. HEAT STRENGTHENED BLUE TINTED GLASS (OUTER)+ 9 mm AIR SPACE + 8 mm THK. TEMPERED CLEAR GLASS (INNER)
- G6 – 8 mm THK. TEMPERED BLUE TINTED GLASS (SPANDREL GLASS)
- G7 – 8 mm THK. HEAT STRENGTHENED TINTED GLASS (OUTER)+ 1.52PVB + 8 mm THK. HEAT STRENGTHENED CLEAR LAMINATED GLASS (INNER) 10 mm THK. TEMPERED GLASS (INTERNAL PROTECTIVE BARRIER)
- 3 mm THK. ALUM. CLADDING
- M.W. – MAINTENANCE WINDOW
- S.J. – STACK JOINT
- AE01 – ALUM. EXTRUSION DIE NO.
- ▲ – SUPPORT POINT
- ◆ – RESTRAINT SOCKET

B.O. REF :

CLIENT :
偉和置業有限公司
Sino Land Company Limited

ARCHITECT :
WONG TUNG & PARTNERS LIMITED
ARCHITECTS & PLANNERS

MAIN CONTRACTOR :
CR Construction Company Limited

STRUCTURAL ENGINEER :
AECOM

FACADE CONSULTANT:
AECOM

NOTE :
1. ALL DIMENSIONS ARE IN mm.
2. ALL ELEVATIONS ARE VIEWED FROM OUTSIDE.
3. ALL DIMENSIONS TO BE VERIFIED ON SITE BEFORE FABRICATION.

LEGEND :
- X1 — DETAIL MARK NO.
- X001 — REFER SHEET NO.

1. F.F.L. --FINISHED FLOOR LEVEL
2. S.F.L. --STRUCTURAL FLOOR LEVEL
3. (R) --REVERSED DETAIL

NO.	DATE	REVISED	BY
F	16/07/2019	GENERAL REVISED	
E	17/01/2019	GENERAL REVISED	
D	22/12/2018	GENERAL REVISED	
C	04/12/2018	GENERAL REVISED	
B	24/11/2018	GENERAL REVISED	
A	10/9/2018	GENERAL REVISED	

JOB NO. : J-837

PROJECT :
URA KWUN TONG TOWN CENTRE REDEVELOPMENT (AREA 2 & 3) AT NKIL 6514, KWUN TONG, KWLOON

TITLE :
PART ELEVATION OF CURTAIN WALL AT TOWER 3

DATE : 04-JUL-18 | SCALE : 1:60 (A1)

DRAWN BY : ASING | CHECKED BY : –

美特鋁質有限公司
MIDI ALUMINIUM FABRICATOR LTD.
Units 6-8, Sunray Industrial Centre, 1/F
610 Cha Kwo Ling Road, Kowloon
Tel:23489211-4 Fax:(852)27727666

DWG NO. : J837-CW-2308 | REV. : F

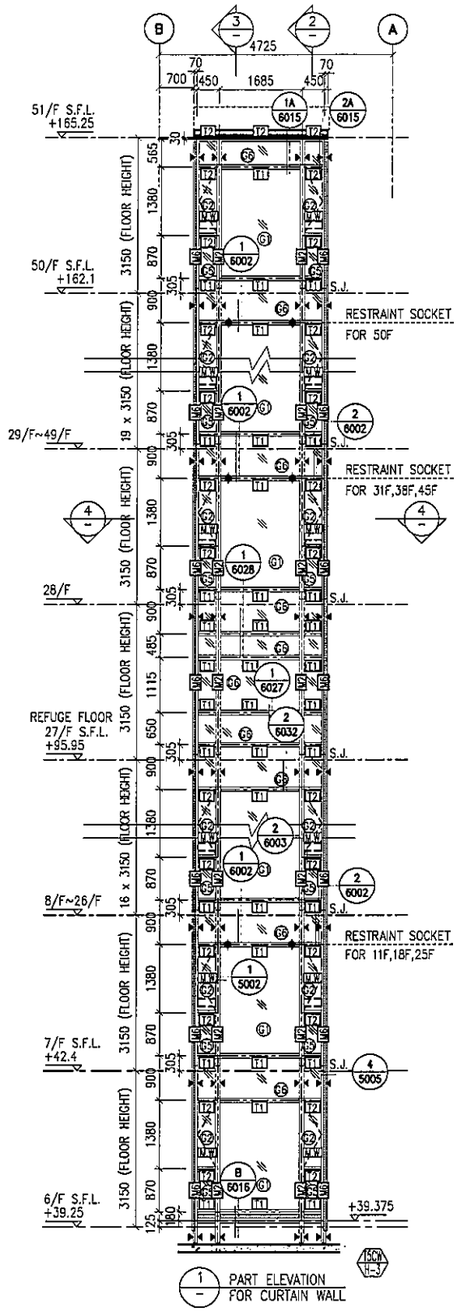

1 PART ELEVATION FOR CURTAIN WALL

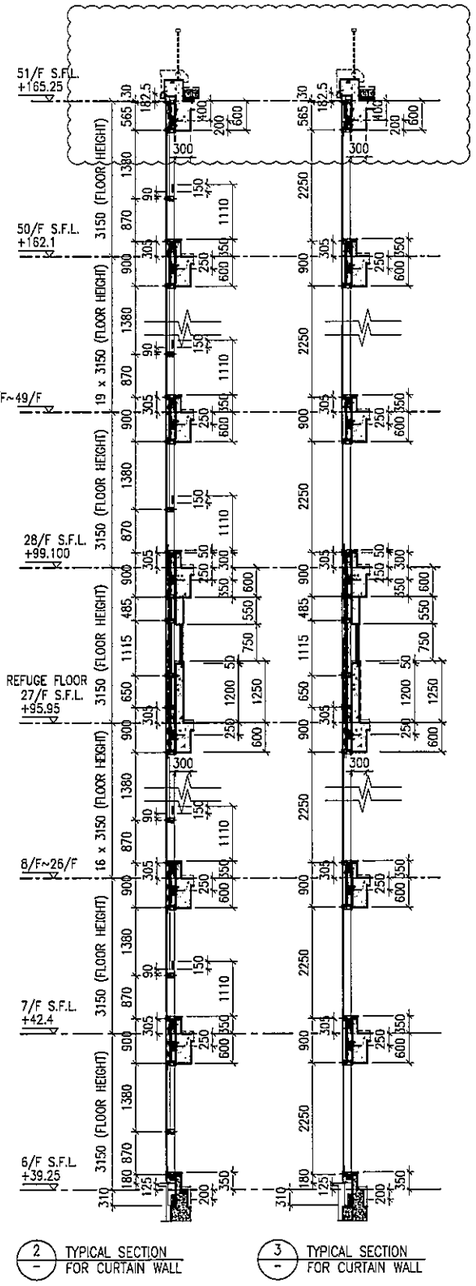

2 TYPICAL SECTION FOR CURTAIN WALL

3 TYPICAL SECTION FOR CURTAIN WALL

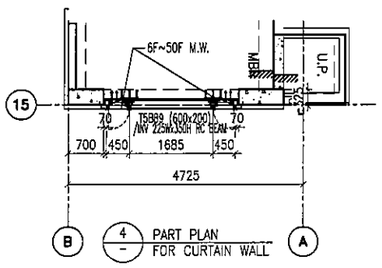

4 PART PLAN FOR CURTAIN WALL

LEGEND:

- 10 mm THK. TEMPERED BLUE TINTED GLASS (OUTER) + 9 mm AIR SPACE + 8 mm THK. TEMPERED CLEAR GLASS (INNER)
- 8 mm THK. HEAT STRENGTHENED TINTED GLASS (OUTER)+ 9 mm AIR SPACE + 8 mm THK. HEAT STRENGTHENED CLEAR GLASS (INNER)
- 10 mm THK. HEAT STRENGTHENED BLUE TINTED GLASS (OUTER)+ 9 mm AIR SPACE + 8 mm THK. TEMPERED CLEAR GLASS (INNER)
- 8 mm THK. HEAT STRENGTHENED BLUE TINTED GLASS (SPANDREL GLASS)
- 8 mm THK. HEAT STRENGTHENED BLUE TINTED GLASS (OUTER)+ 9 mm AIR SPACE + 8 mm THK. TEMPERED CLEAR GLASS (INNER)
- 8 mm THK. TEMPERED BLUE TINTED GLASS (SPANDREL GLASS)
- 8 mm THK. HEAT STRENGTHENED TINTED GLASS (OUTER)+ 1.52PVB + 8 mm THK. HEAT STRENGTHENED CLEAR LAMINATED GLASS (INNER) 10 mm THK. TEMPERED GLASS (INTERNAL PROTECTIVE BARRIER)
- 3 mm THK. ALUM. CLADDING
- M.W. – MAINTENANCE WINDOW
- S.J. – STACK JOINT
- AE-01 – ALUM. EXTRUSION DIE NO.
- ▲ – SUPPORT POINT
- ◆ – RESTRAINT SOCKET

B.D. REF :

CLIENT :
信和置業有限公司
Sino Land Company Limited

ARCHITECT : WONG TUNG & PARTNERS LIMITED ARCHITECTS & PLANNERS

MAIN CONTRACTOR :
CR Construction Company Limited

STRUCTURAL ENGINEER :
AECOM

FACADE CONSULTANT:
AECOM

NOTE :
1. ALL DIMENSIONS ARE IN mm.
2. ALL ELEVATIONS ARE VIEWED FROM OUTSIDE.
3. ALL DIMENSIONS TO BE VERIFIED ON SITE BEFORE FABRICATION.

LEGEND :
- X1 / X001 — DETAIL MARK NO. / REFER SHEET NO.
1. F.F.L. --FINISHED FLOOR LEVEL
2. S.F.L. --STRUCTURAL FLOOR LEVEL
3. /R --REVERSED DETAIL

NO.	DATE	REVISED	BY
F	16/07/2019	GENERAL REVISED	
E	17/01/2019	GENERAL REVISED	
D	22/12/2018	GENERAL REVISED	
C	04/12/2018	GENERAL REVISED	
B	24/11/2018	GENERAL REVISED	
A	10/9/2018	GENERAL REVISED	

JOB NO. : J-837

PROJECT :
URA KWUN TONG TOWN CENTRE REDEVELOPMENT (AREA 2 & 3) AT NKIL 6514, KWUN TONG, KWLOON

TITLE :
PART ELEVATION OF CURTAIN WALL AT TOWER 5

DATE : 04-JUL-18	SCALE : 1:60 (A1)
DRAWN BY : ASING	CHECKED BY : -

美特鋁質有限公司
MIDI ALUMINIUM FABRICATOR LTD.
Units 6-8, Sunray Industrial Centre, 1/F
610 Cha Kwo Ling Road, Kowloon
Tel:23489211-4 Fax:(852)27727666

DWG NO. : J837-CW-2507 REV. : F

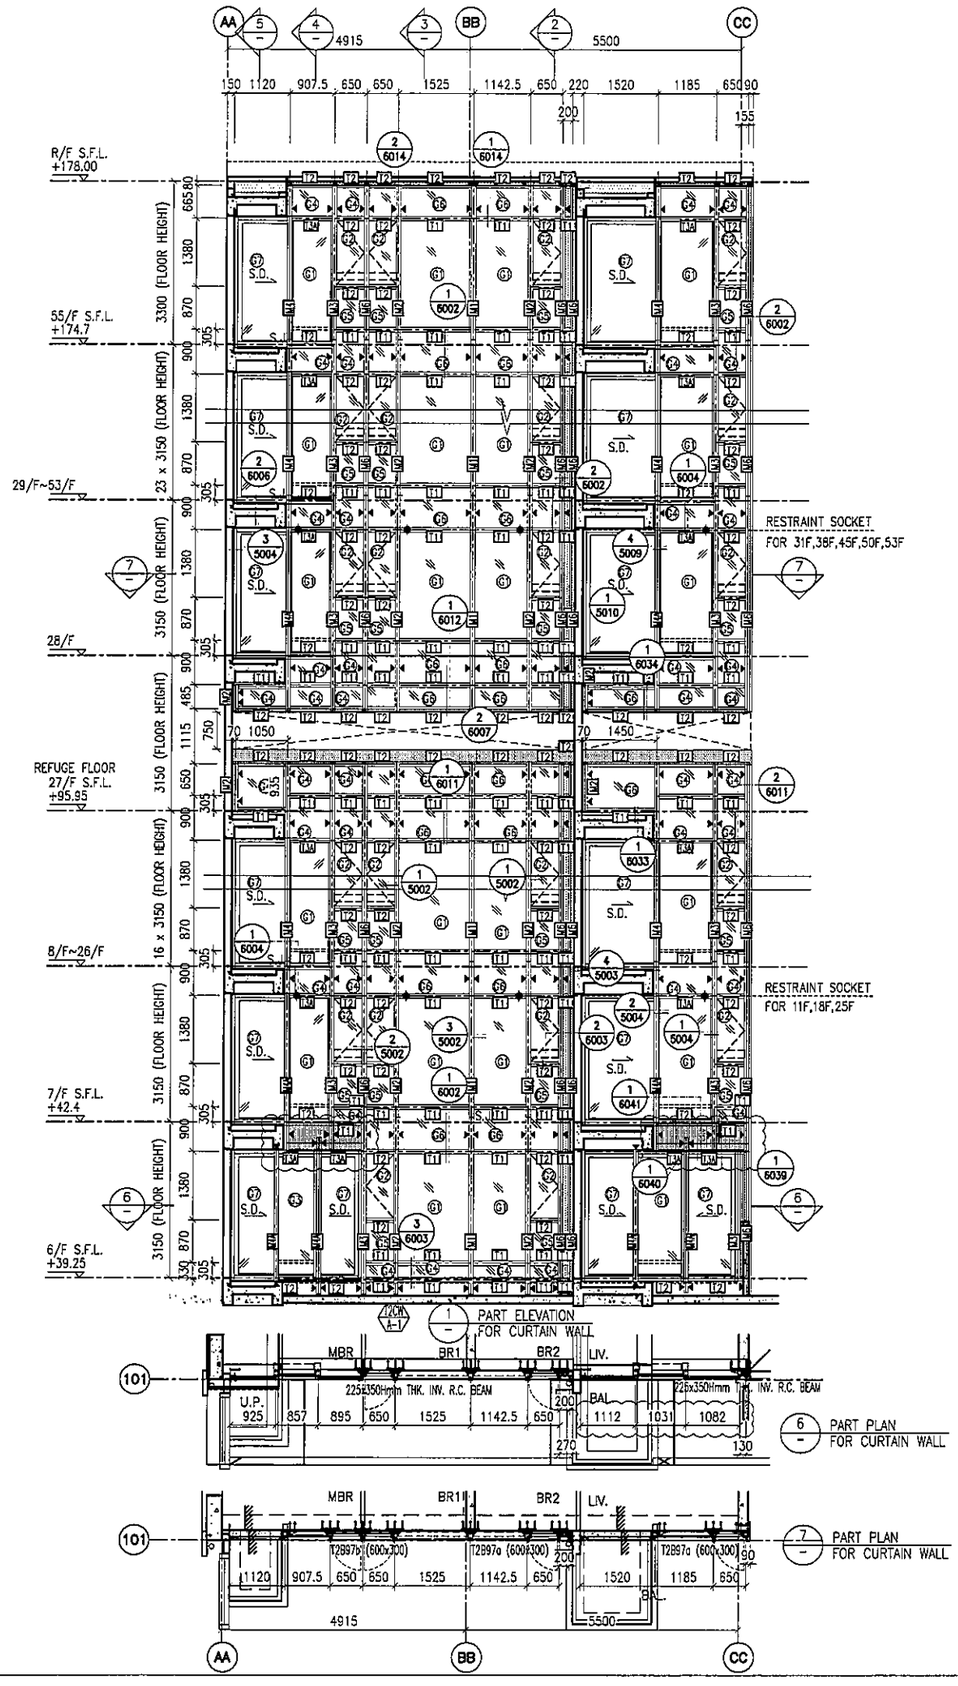

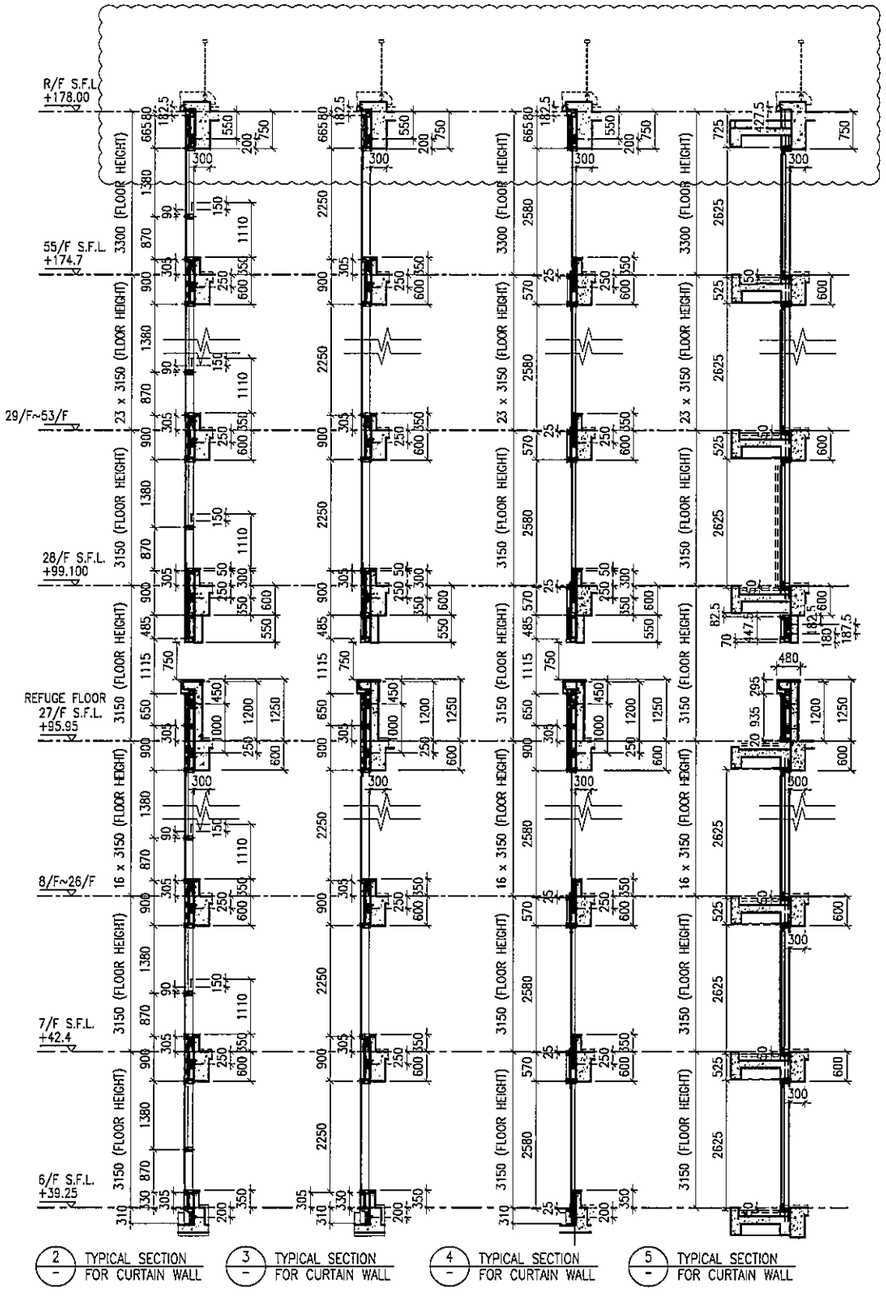

2 TYPICAL SECTION FOR CURTAIN WALL
3 TYPICAL SECTION FOR CURTAIN WALL
4 TYPICAL SECTION FOR CURTAIN WALL
5 TYPICAL SECTION FOR CURTAIN WALL

LEGEND:

- 10 mm THK. TEMPERED BLUE TINTED GLASS (OUTER) + 9 mm AIR SPACE + 8 mm THK. TEMPERED CLEAR GLASS (INNER)
- 8 mm THK. HEAT STRENGTHENED TINTED GLASS (OUTER)+ 9 mm AIR SPACE + 8 mm THK. HEAT STRENGTHENED CLEAR GLASS (INNER)
- 10 mm THK. HEAT STRENGTHENED BLUE TINTED GLASS (OUTER)+ 9 mm AIR SPACE + 8 mm THK. TEMPERED CLEAR GLASS (INNER)
- 8 mm THK. HEAT STRENGTHENED BLUE TINTED GLASS (SPANDREL GLASS)
- 8 mm THK. HEAT STRENGTHENED BLUE TINTED GLASS (OUTER)+ 9 mm AIR SPACE + 8 mm THK. TEMPERED CLEAR GLASS (INNER)
- 8 mm THK. TEMPERED BLUE TINTED GLASS (SPANDREL GLASS)
- 8 mm THK. HEAT STRENGTHENED TINTED GLASS (OUTER)+ 1.52PVB + 8 mm THK. HEAT STRENGTHENED CLEAR LAMINATED GLASS (INNER)
- 10 mm THK. TEMPERED GLASS (INTERNAL PROTECTIVE BARRIER)
- 3 mm THK. ALUM. CLADDING
- M.W. – MAINTENANCE WINDOW
- S.J. – STACK JOINT
- AE-01 – ALUM. EXTRUSION DIE NO.
- ▲ – SUPPORT POINT
- ◆ – RESTRAINT SOCKET

B.D. REF :

CLIENT :
信和置業有限公司
Sino Land Company Limited

ARCHITECT : WONG TUNG & PARTNERS LIMITED
ARCHITECTS & PLANNERS

MAIN CONTRACTOR :
CR Construction Company Limited

STRUCTURAL ENGINEER :
AECOM

FACADE CONSULTANT:
AECOM

NOTE :
1. ALL DIMENSIONS ARE IN mm.
2. ALL ELEVATIONS ARE VIEWED FROM OUTSIDE.
3. ALL DIMENSIONS TO BE VERIFIED ON SITE BEFORE FABRICATION.

LEGEND :
X1 / XC01 – DETAIL MARK NO. / REFER SHEET NO.
1. F.F.L. --FINISHED FLOOR LEVEL
2. S.F.L. --STRUCTURAL FLOOR LEVEL
3. (R) --REVERSED DETAIL

NO.	DATE	REVISED	BY
G	16/07/2019	GENERAL REVISED	
F	26/05/2019	GENERAL REVISED	
E	17/01/2019	GENERAL REVISED	
D	22/12/2018	GENERAL REVISED	
C	04/12/2018	GENERAL REVISED	
B	24/11/2018	GENERAL REVISED	
A	10/9/2018	GENERAL REVISED	

JOB NO. : J-837

PROJECT :
URA KWUN TONG TOWN CENTRE REDEVELOPMENT (AREA 2 & 3) AT NKIL 6514, KWUN TONG, KWLOON

TITLE :
PART ELEVATION OF CURTAIN WALL AT TOWER 2

DATE : 04-JUL-18 | SCALE : 1:60 (A1)
DRAWN BY : ASING | CHECKED BY : –

美特鋁質有限公司
MIDI ALUMINIUM FABRICATOR LTD.
Units 6-8, Sunray Industrial Centre, 1/F
610 Cha Kwo Ling Road, Kowloon
Tel:23489211-4 Fax:(852)27727666

DWG NO. : J837-CW-2208 | REV. : G

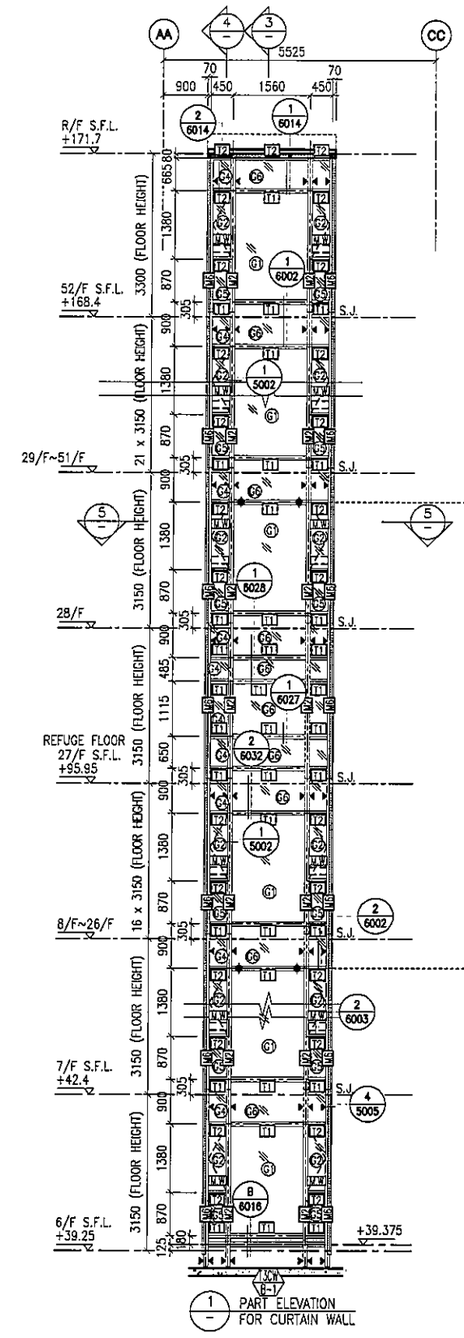

1 / – PART ELEVATION FOR CURTAIN WALL

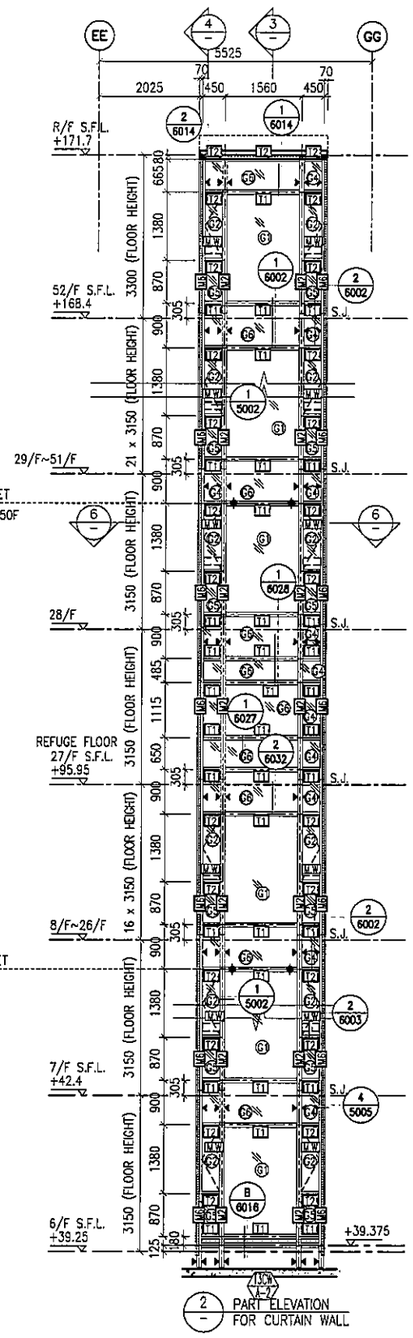

2 / – PART ELEVATION FOR CURTAIN WALL

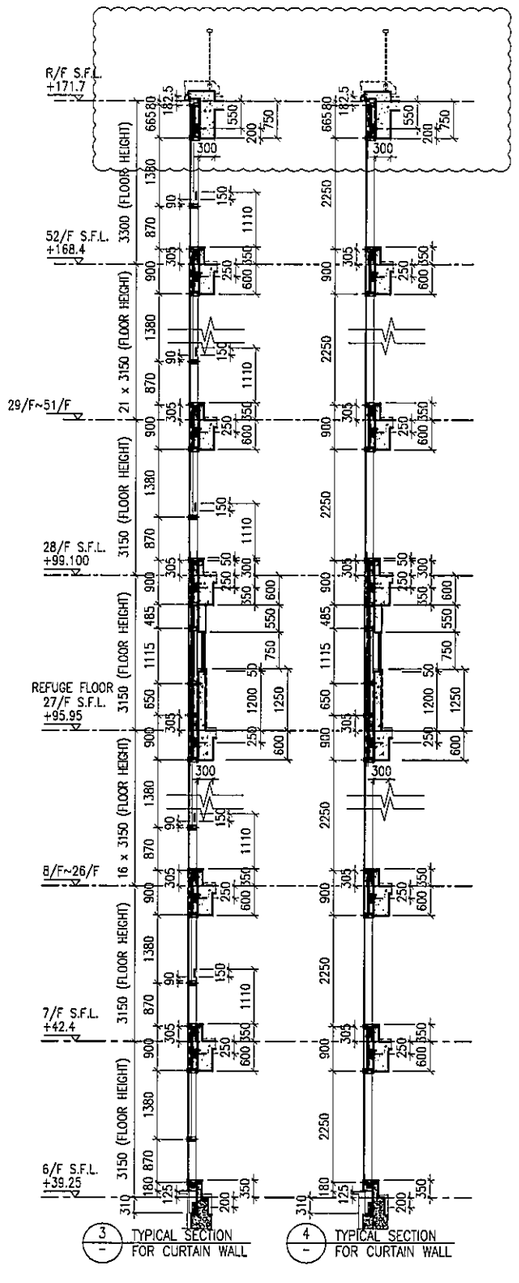

3 / – TYPICAL SECTION FOR CURTAIN WALL

4 / – TYPICAL SECTION FOR CURTAIN WALL

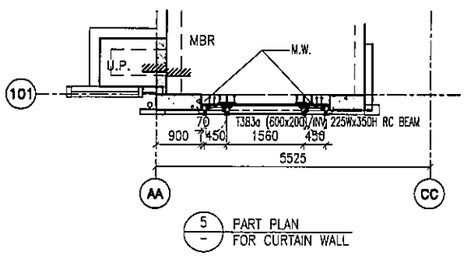

5 / – PART PLAN FOR CURTAIN WALL

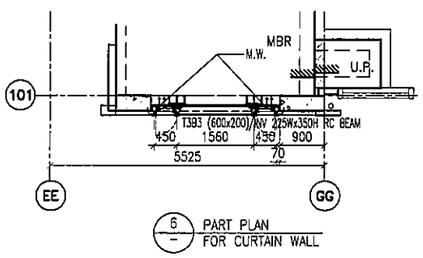

6 / – PART PLAN FOR CURTAIN WALL

LEGEND:

- G1+ – 10 mm THK. TEMPERED BLUE TINTED GLASS (OUTER) + 9 mm AIR SPACE + 8 mm THK. TEMPERED CLEAR GLASS (INNER)
- G2+ – 8 mm THK. HEAT STRENGTHENED TINTED GLASS (OUTER)+ 9 mm AIR SPACE + 8 mm THK. HEAT STRENGTHENED CLEAR GLASS (INNER)
- G3+ – 10 mm THK. HEAT STRENGTHENED BLUE TINTED GLASS (OUTER)+ 9 mm AIR SPACE + 8 mm THK. TEMPERED CLEAR GLASS (INNER)
- G4+ – 8 mm THK. HEAT STRENGTHENED BLUE TINTED GLASS (SPANDREL GLASS)
- G5+ – 8 mm THK. HEAT STRENGTHENED BLUE TINTED GLASS (OUTER)+ 9 mm AIR SPACE + 8 mm THK. TEMPERED CLEAR GLASS (INNER)
- G6+ – 8 mm THK. TEMPERED BLUE TINTED GLASS (SPANDREL GLASS)
- G7+ – 8 mm THK. HEAT STRENGTHENED TINTED GLASS (OUTER)+ 1.52PVB + 8 mm THK. HEAT STRENGTHENED CLEAR LAMINATED GLASS (INNER) 10 mm THK. TEMPERED GLASS (INTERNAL PROTECTIVE BARRIER)
- 3 mm THK. ALUM. CLADDING
- M.W. – MAINTENANCE WINDOW
- S.J. – STACK JOINT
- AE01 – ALUM. EXTRUSION DIE NO.
- ▲ – SUPPORT POINT
- ◆ – RESTRAINT SOCKET

B.D. REF :

CLIENT :
信和置業有限公司
Sino Land Company Limited

ARCHITECT :
WONG TUNG & PARTNERS LIMITED
ARCHITECTS & PLANNERS

MAIN CONTRACTOR :
CR Construction Company Limited

STRUCTURAL ENGINEER :
AECOM

FACADE CONSULTANT:
AECOM

NOTE :
1. ALL DIMENSIONS ARE IN mm.
2. ALL ELEVATIONS ARE VIEWED FROM OUTSIDE.
3. ALL DIMENSIONS TO BE VERIFIED ON SITE BEFORE FABRICATION.

LEGEND :
- X1 / X001 — DETAIL MARK NO. / REFER SHEET NO.
1. F.F.L. --FINISHED FLOOR LEVEL
2. S.F.L. --STRUCTURAL FLOOR LEVEL
3. /R --REVERSED DETAIL

NO.	DATE	REVISED	BY
F	16/07/2019	GENERAL REVISED	
E	17/01/2019	GENERAL REVISED	
D	22/12/2018	GENERAL REVISED	
C	04/12/2018	GENERAL REVISED	
B	24/11/2018	GENERAL REVISED	
A	10/9/2018	GENERAL REVISED	

JOB NO. : J-837

PROJECT :
URA KWUN TONG TOWN CENTRE REDEVELOPMENT (AREA 2 & 3) AT NKIL 6514, KWUN TONG, KWLOON

TITLE :
PART ELEVATION OF CURTAIN WALL AT TOWER 3

DATE : 04-JUL-18 | SCALE : 1:60 (A1)

DRAWN BY : ASING | CHECKED BY : –

美特鋁質有限公司
MIDI ALUMINIUM FABRICATOR LTD.
Units 6-8, Sunray Industrial Centre, 1/F
610 Cha Kwo Ling Road, Kowloon
Tel:23489211-4 Fax:(852)27727666

DWG NO. : J837-CW-2309 | REV. : F

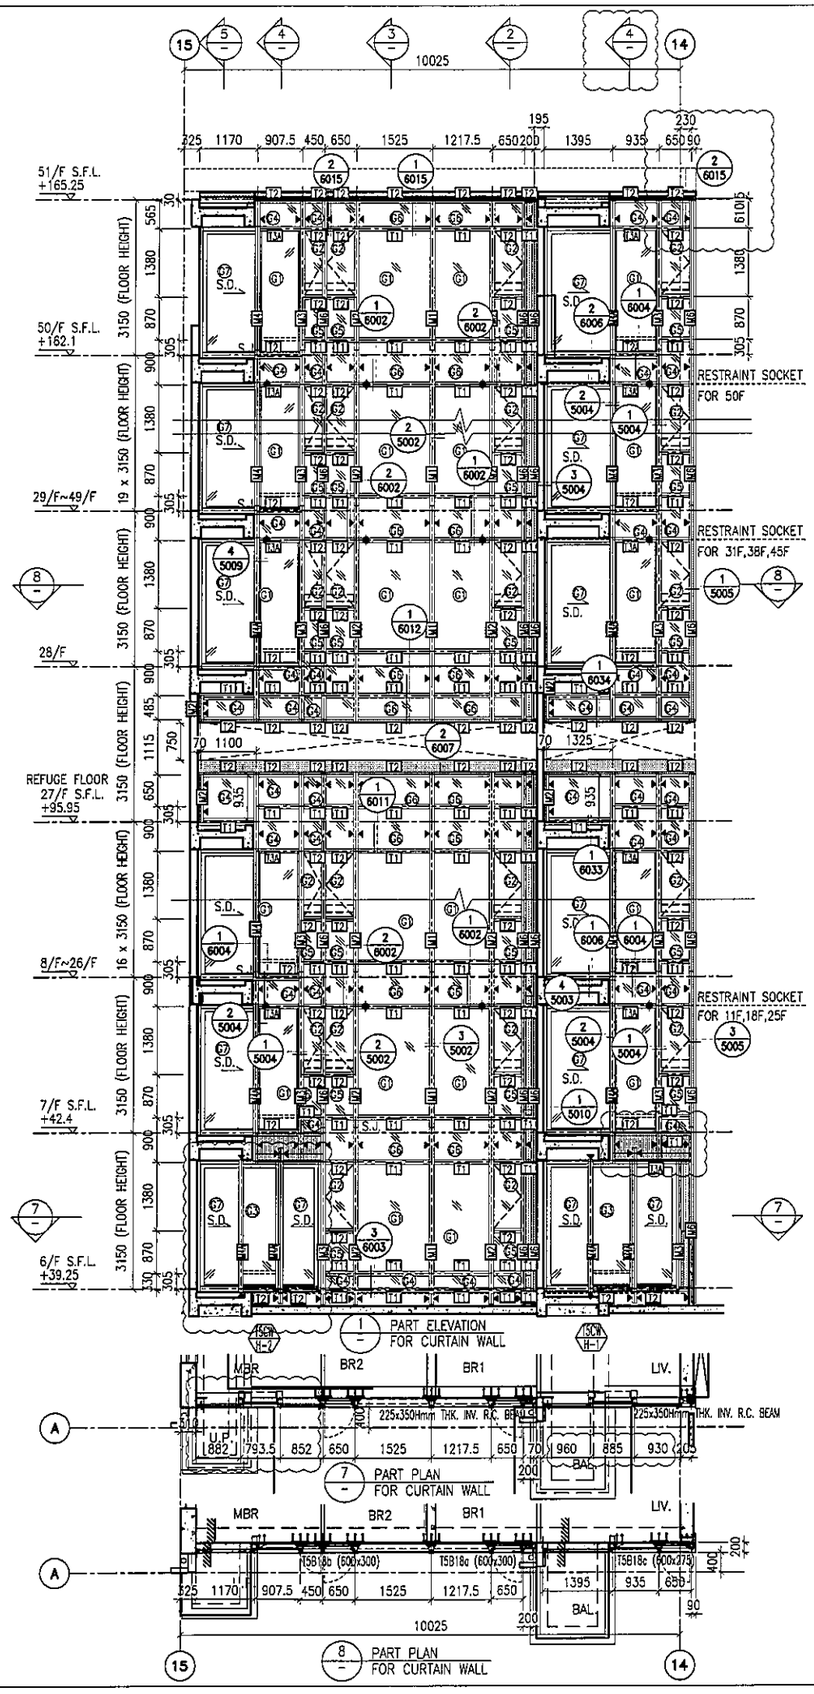

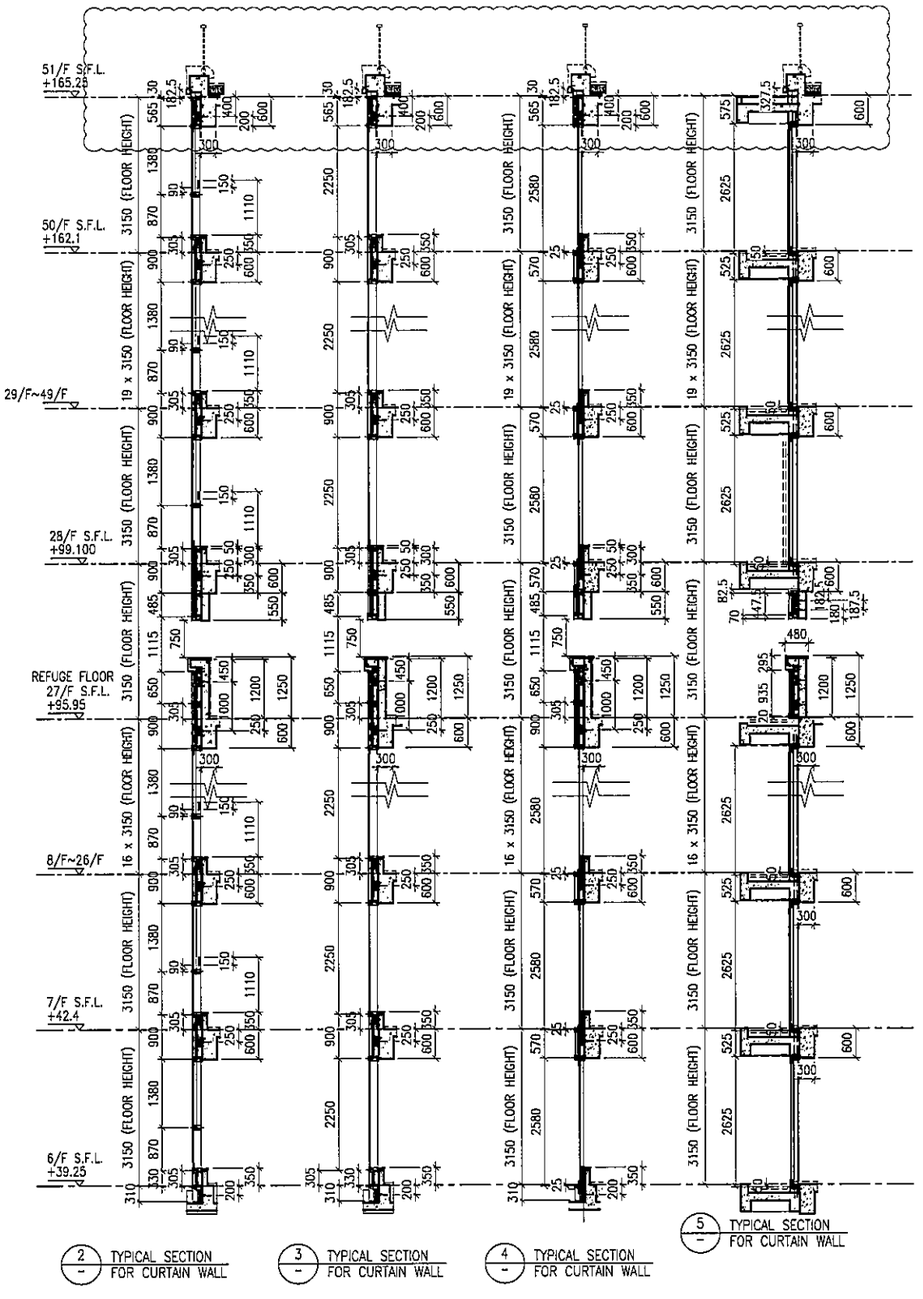

2 TYPICAL SECTION FOR CURTAIN WALL

3 TYPICAL SECTION FOR CURTAIN WALL

4 TYPICAL SECTION FOR CURTAIN WALL

5 TYPICAL SECTION FOR CURTAIN WALL

LEGEND:

- 10 mm THK. TEMPERED BLUE TINTED GLASS (OUTER) + 9 mm AIR SPACE + 8 mm THK. TEMPERED CLEAR GLASS (INNER)
- 8 mm THK. HEAT STRENGTHENED TINTED GLASS (OUTER)+ 9 mm AIR SPACE + 8 mm THK. HEAT STRENGTHENED CLEAR GLASS (INNER)
- 10 mm THK. HEAT STRENGTHENED BLUE TINTED GLASS (OUTER)+ 9 mm AIR SPACE + 8 mm THK. TEMPERED CLEAR GLASS (INNER)
- 8 mm THK. HEAT STRENGTHENED BLUE TINTED GLASS (SPANDREL GLASS)
- 8 mm THK. HEAT STRENGTHENED BLUE TINTED GLASS (OUTER)+ 9 mm AIR SPACE + 8 mm THK. TEMPERED CLEAR GLASS (INNER)
- 8 mm THK. TEMPERED BLUE TINTED GLASS (SPANDREL GLASS)
- 8 mm THK. HEAT STRENGTHENED TINTED GLASS (OUTER)+ 1.52PVB + 8 mm THK. HEAT STRENGTHENED CLEAR LAMINATED GLASS (INNER) 10 mm THK. TEMPERED GLASS (INTERNAL PROTECTIVE BARRIER)
- 3 mm THK. ALUM. CLADDING
- M.W. – MAINTENANCE WINDOW
- S.J. – STACK JOINT
- AE01 – ALUM. EXTRUSION DIE NO.
- ▲ – SUPPORT POINT
- ◆ – RESTRAINT SOCKET

B.D. REF :

CLIENT :
信和置業有限公司
Sino Land Company Limited

ARCHITECT :
WONG TUNG & PARTNERS LIMITED
ARCHITECTS & PLANNERS

MAIN CONTRACTOR :
CR Construction Company Limited

STRUCTURAL ENGINEER :
AECOM

FACADE CONSULTANT:
AECOM

NOTE :
1. ALL DIMENSIONS ARE IN mm.
2. ALL ELEVATIONS ARE VIEWED FROM OUTSIDE.
3. ALL DIMENSIONS TO BE VERIFIED ON SITE BEFORE FABRICATION.

LEGEND :
X1 / X001 – DETAIL MARK NO. / REFER SHEET NO.
1. F.F.L. --FINISHED FLOOR LEVEL
2. S.F.L. --STRUCTURAL FLOOR LEVEL
3. /R --REVERSED DETAIL

NO.	DATE	REVISED	BY
G	16/07/2019	GENERAL REVISED	
F	26/05/2019	GENERAL REVISED	
E	17/01/2019	GENERAL REVISED	
D	22/12/2018	GENERAL REVISED	
C	04/12/2018	GENERAL REVISED	
B	24/11/2018	GENERAL REVISED	
A	10/9/2018	GENERAL REVISED	

JOB NO. : J-837

PROJECT :
URA KWUN TONG TOWN CENTRE REDEVELOPMENT (AREA 2 & 3) AT NKIL 6514, KWUN TONG, KWLOON

TITLE :
PART ELEVATION OF CURTAIN WALL AT TOWER 5

DATE : 04-JUL-18 | SCALE : 1:60 (A1)

DRAWN BY : ASING | CHECKED BY : –

美特鋁質有限公司
MIDI ALUMINIUM FABRICATOR LTD.
Units 6-8, Sunray Industrial Centre, 1/F
610 Cha Kwo Ling Road, Kowloon
Tel:23489211-4 Fax:(852)27727666

DWG NO. : J837-CW-2508 | REV. : G

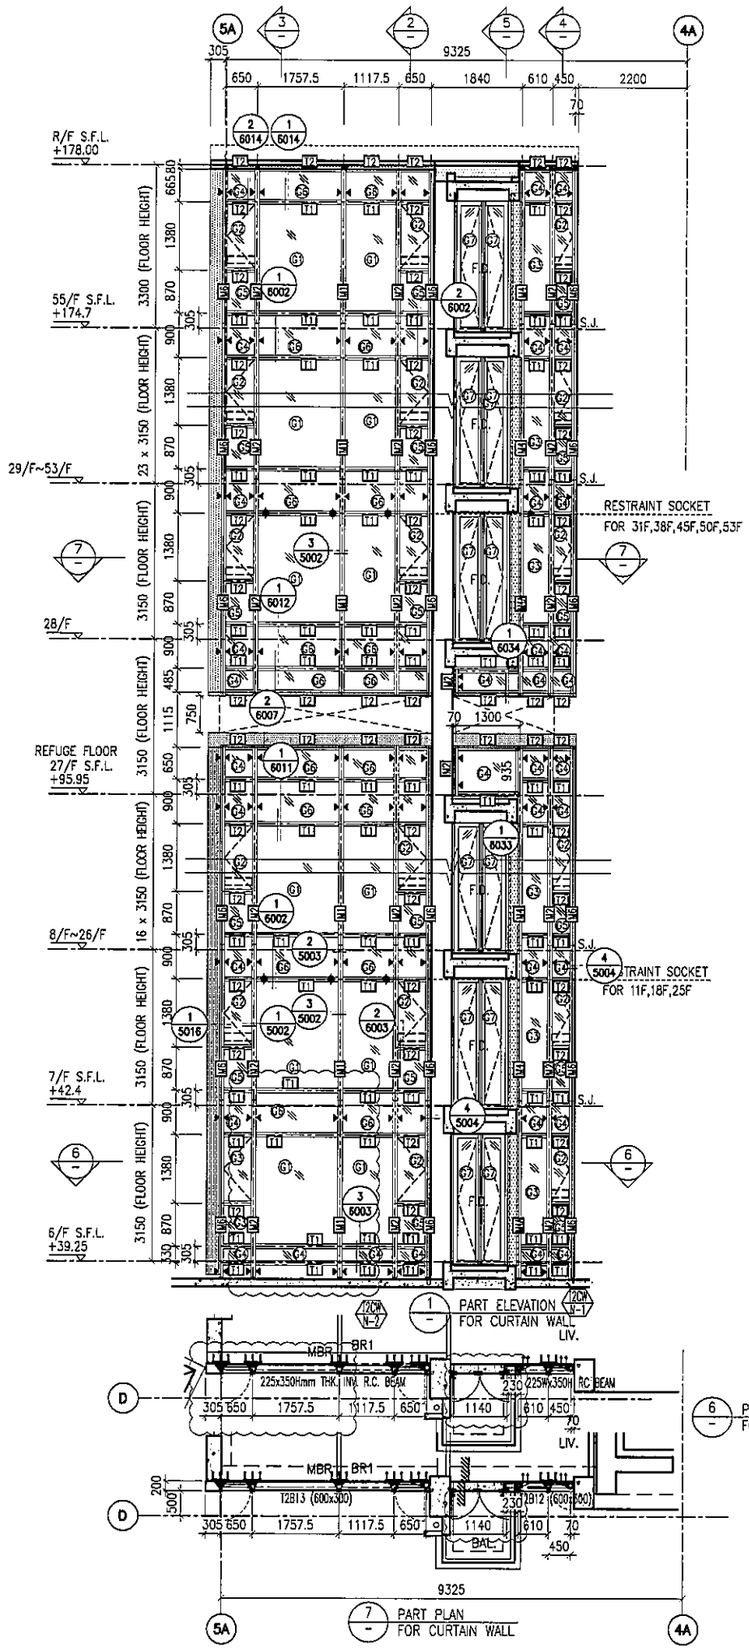

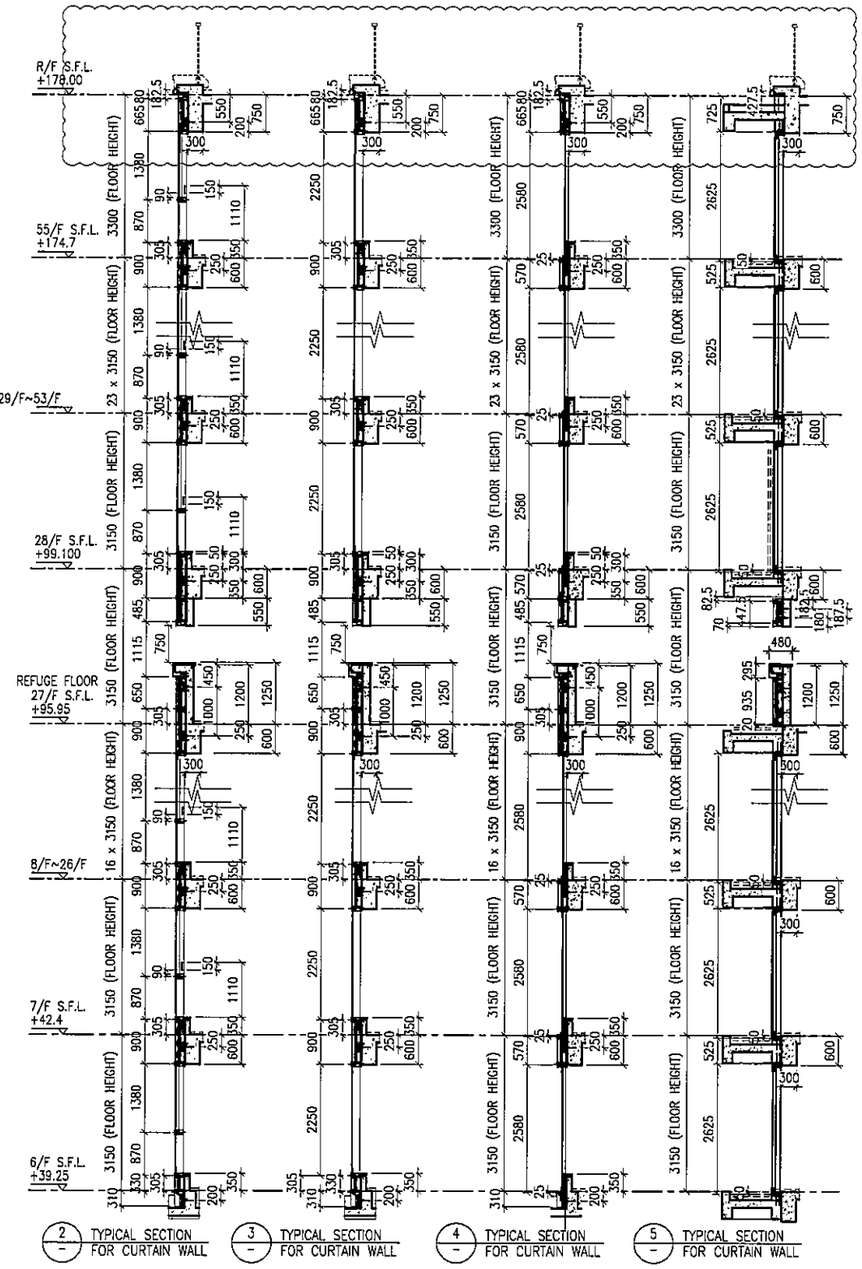

LEGEND:

- G1+ – 10 mm THK. TEMPERED BLUE TINTED GLASS (OUTER) + 9 mm AIR SPACE + 8 mm THK. TEMPERED CLEAR GLASS (INNER)
- G2+ – 8 mm THK. HEAT STRENGTHENED TINTED GLASS (OUTER)+ 9 mm AIR SPACE + 8 mm THK. HEAT STRENGTHENED CLEAR GLASS (INNER)
- G3+ – 10 mm THK. HEAT STRENGTHENED BLUE TINTED GLASS (OUTER)+ 9 mm AIR SPACE + 8 mm THK. TEMPERED CLEAR GLASS (INNER)
- G4+ – 8 mm THK. HEAT STRENGTHENED BLUE TINTED GLASS (SPANDREL GLASS)
- G5+ – 8 mm THK. HEAT STRENGTHENED BLUE TINTED GLASS (OUTER)+ 9 mm AIR SPACE + 8 mm THK. TEMPERED CLEAR GLASS (INNER)
- G6+ – 8 mm THK. TEMPERED BLUE TINTED GLASS (SPANDREL GLASS)
- G7+ – 8 mm THK. HEAT STRENGTHENED TINTED GLASS (OUTER)+ 1.52PVB + 8 mm THK. HEAT STRENGTHENED CLEAR LAMINATED GLASS (INNER) 10 mm THK. TEMPERED GLASS (INTERNAL PROTECTIVE BARRIER)
- 3 mm THK. ALUM. CLADDING
- M.W. – MAINTENANCE WINDOW
- S.J. – STACK JOINT
- AE01 – ALUM. EXTRUSION DIE NO.
- ▲ – SUPPORT POINT
- ✦ – RESTRAINT SOCKET

B.D. REF :

CLIENT :
信和置業有限公司
Sino Land Company Limited

ARCHITECT :
WONG TUNG & PARTNERS LIMITED
ARCHITECTS & PLANNERS

MAIN CONTRACTOR :
CR Construction Company Limited

STRUCTURAL ENGINEER :
AECOM

FACADE CONSULTANT:
AECOM

NOTE :
1. ALL DIMENSIONS ARE IN mm.
2. ALL ELEVATIONS ARE VIEWED FROM OUTSIDE.
3. ALL DIMENSIONS TO BE VERIFIED ON SITE BEFORE FABRICATION.

LEGEND :
X1 / X001 – DETAIL MARK NO. / REFER SHEET NO.
1. F.F.L. --FINISHED FLOOR LEVEL
2. S.F.L. --STRUCTURAL FLOOR LEVEL
3. /R – REVERSED DETAIL

NO.	DATE	REVISED	BY
F	16/07/2019	GENERAL REVISED	
E	17/01/2019	GENERAL REVISED	
D	22/12/2018	GENERAL REVISED	
C	04/12/2018	GENERAL REVISED	
B	24/11/2018	GENERAL REVISED	
A	10/9/2018	GENERAL REVISED	

JOB NO. : J-837

PROJECT :
URA KWUN TONG TOWN CENTRE REDEVELOPMENT (AREA 2 & 3) AT NKIL 6514, KWUN TONG, KWLOON

TITLE :
PART ELEVATION OF CURTAIN WALL AT TOWER 2

DATE : 04-JUL-18 | SCALE : 1:60 (A1)

DRAWN BY : ASING | CHECKED BY : -

美特鋁質有限公司
MIDI ALUMINIUM FABRICATOR LTD.
Units 6-8, Sunray Industrial Centre, 1/F
610 Cha Kwo Ling Road, Kowloon
Tel:23489211-4 Fax:(852)27727666

DWG NO. : J837-CW-2209 | REV. : F

B.D. REF :

CLIENT :
信和置業有限公司
Sino Land Company Limited

ARCHITECT :
WONG TUNG & PARTNERS LIMITED
ARCHITECTS & PLANNERS

MAIN CONTRACTOR :
CR Construction Company Limited

STRUCTURAL ENGINEER :
AECOM

FACADE CONSULTANT:
AECOM

NOTE :
1. ALL DIMENSIONS ARE IN mm.
2. ALL ELEVATIONS ARE VIEWED FROM OUTSIDE.
3. ALL DIMENSIONS TO BE VERIFIED ON SITE BEFORE FABRICATION.

LEGEND :
- X1 / X001 — DETAIL MARK NO. / REFER SHEET NO.
1. F.F.L. --FINISHED FLOOR LEVEL
2. S.F.L. --STRUCTURAL FLOOR LEVEL
3. /R --REVERSED DETAIL

NO.	DATE	REVISED	BY
G	16/07/2019	GENERAL REVISED	
F	26/05/2019	GENERAL REVISED	
E	17/01/2019	GENERAL REVISED	
D	22/12/2018	GENERAL REVISED	
C	04/12/2018	GENERAL REVISED	
B	24/11/2018	GENERAL REVISED	
A	10/9/2018	GENERAL REVISED	

LEGEND:
- 10 mm THK. TEMPERED BLUE TINTED GLASS (OUTER) + 9 mm AIR SPACE + 8 mm THK. TEMPERED CLEAR GLASS (INNER)
- 8 mm THK. HEAT STRENGTHENED TINTED GLASS (OUTER)+ 9 mm AIR SPACE + 8 mm THK. HEAT STRENGTHENED CLEAR GLASS (INNER)
- 10 mm THK. HEAT STRENGTHENED BLUE TINTED GLASS (OUTER)+ 9 mm AIR SPACE + 8 mm THK. TEMPERED CLEAR GLASS (INNER)
- 8 mm THK. HEAT STRENGTHENED BLUE TINTED GLASS (SPANDREL GLASS)
- 8 mm THK. HEAT STRENGTHENED BLUE TINTED GLASS (OUTER)+ 9 mm AIR SPACE + 8 mm THK. TEMPERED CLEAR GLASS (INNER)
- 8 mm THK. TEMPERED BLUE TINTED GLASS (SPANDREL GLASS)
- 8 mm THK. HEAT STRENGTHENED TINTED GLASS (OUTER)+ 1.52PVB + 8 mm THK. HEAT STRENGTHENED CLEAR LAMINATED GLASS (INNER)
- 10 mm THK. TEMPERED GLASS (INTERNAL PROTECTIVE BARRIER)
- 3 mm THK. ALUM. CLADDING
- M.W. — MAINTENANCE WINDOW
- S.J. — STACK JOINT
- AE-01 — ALUM. EXTRUSION DIE NO.
- ▲ — SUPPORT POINT
- ◆ — RESTRAINT SOCKET

JOB NO. : J-837

PROJECT :
URA KWUN TONG TOWN CENTRE REDEVELOPMENT (AREA 2 & 3) AT NKIL 6514, KWUN TONG, KWLOON

TITLE :
PART ELEVATION OF CURTAIN WALL AT TOWER 5

DATE : 04-JUL-18	SCALE : 1:60 (A1)
DRAWN BY : ASING	CHECKED BY : -

美特鋁質有限公司
MIDI ALUMINIUM FABRICATOR LTD.
Units 6-8, Sunray Industrial Centre, 1/F
610 Cha Kwo Ling Road, Kowloon
Tel:23489211-4 Fax:(852)27727666

DWG NO. : J837-CW-2509 | REV. : G

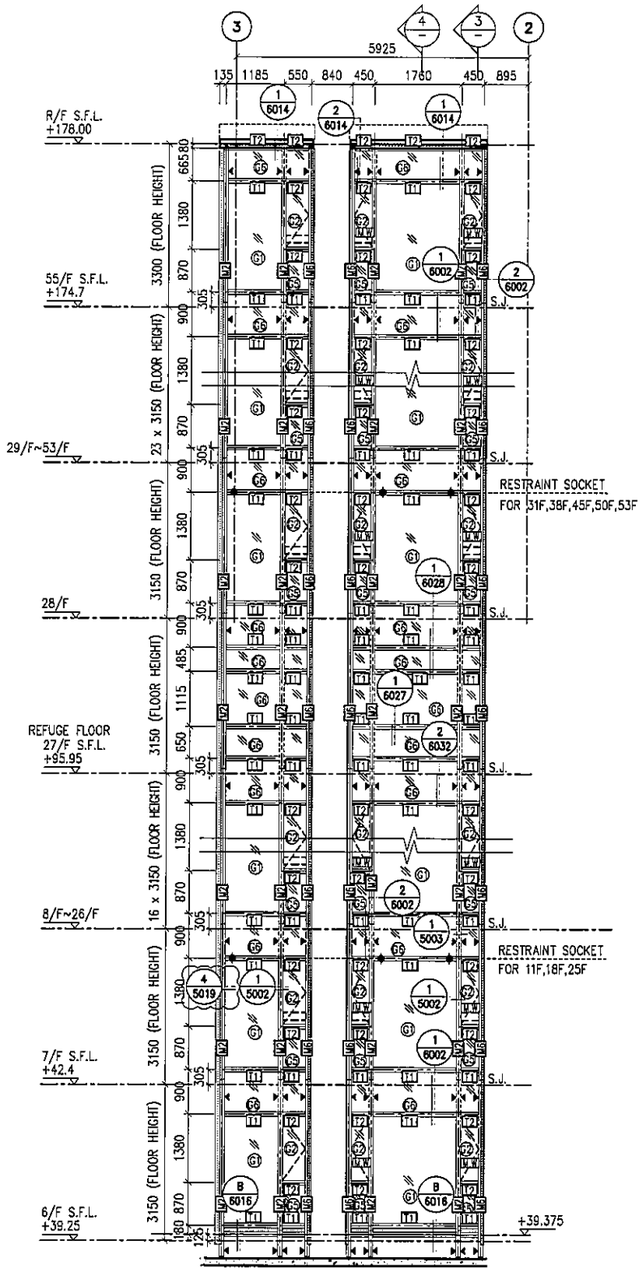

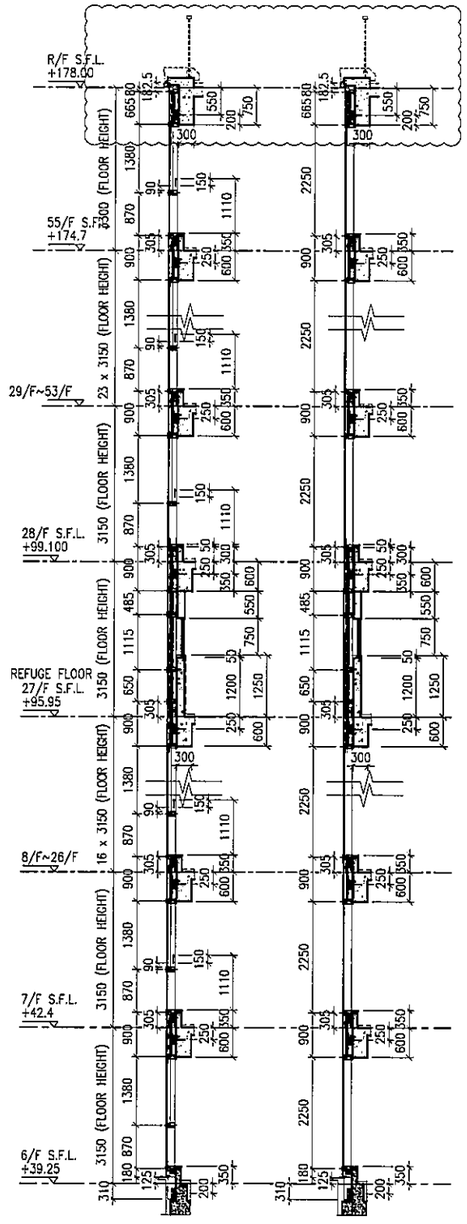

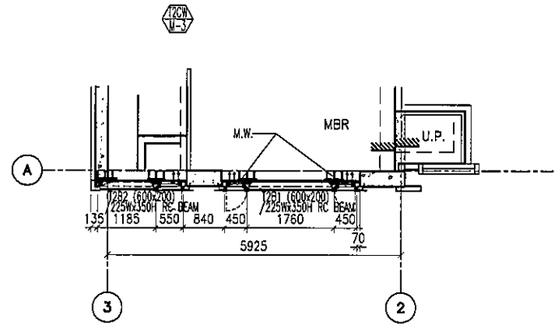

LEGEND:

- 10 mm THK. TEMPERED BLUE TINTED GLASS (OUTER) + 9 mm AIR SPACE + 8 mm THK. TEMPERED CLEAR GLASS (INNER)
- 8 mm THK. HEAT STRENGTHENED TINTED GLASS (OUTER)+ 9 mm AIR SPACE + 8 mm THK. HEAT STRENGTHENED CLEAR GLASS (INNER)
- 10 mm THK. HEAT STRENGTHENED BLUE TINTED GLASS (OUTER)+ 9 mm AIR SPACE + 8 mm THK. TEMPERED CLEAR GLASS (INNER)
- 8 mm THK. HEAT STRENGTHENED BLUE TINTED GLASS (SPANDREL GLASS)
- 8 mm THK. HEAT STRENGTHENED BLUE TINTED GLASS (OUTER)+ 9 mm AIR SPACE + 8 mm THK. TEMPERED CLEAR GLASS (INNER)
- 8 mm THK. TEMPERED BLUE TINTED GLASS (SPANDREL GLASS)
- 8 mm THK. HEAT STRENGTHENED TINTED GLASS (OUTER)+ 1.52PVB + 8 mm THK. HEAT STRENGTHENED CLEAR LAMINATED GLASS (INNER) 10 mm THK. TEMPERED GLASS (INTERNAL PROTECTIVE BARRIER)
- 3 mm THK. ALUM. CLADDING
- M.W. – MAINTENANCE WINDOW
- S.J. – STACK JOINT
- AE01 – ALUM. EXTRUSION DIE NO.
- ▲ – SUPPORT POINT
- ◆ – RESTRAINT SOCKET

B.D. REF :

CLIENT :
信和置業有限公司
Sino Land Company Limited

ARCHITECT :
WONG TUNG & PARTNERS LIMITED
ARCHITECTS & PLANNERS

MAIN CONTRACTOR :
CR Construction Company Limited

STRUCTURAL ENGINEER :
AECOM

FACADE CONSULTANT:
AECOM

NOTE :
1. ALL DIMENSIONS ARE IN mm.
2. ALL ELEVATIONS ARE VIEWED FROM OUTSIDE.
3. ALL DIMENSIONS TO BE VERIFIED ON SITE BEFORE FABRICATION.

LEGEND :
(X1 / XDD1) — DETAIL MARK NO. / REFER SHEET NO.
1. F.F.L. --FINISHED FLOOR LEVEL
2. S.F.L. --STRUCTURAL FLOOR LEVEL
3. (/R) --REVERSED DETAIL

NO.	DATE	REVISED	BY
F	16/07/2019	GENERAL REVISED	
E	17/01/2019	GENERAL REVISED	
D	22/12/2018	GENERAL REVISED	
C	04/12/2018	GENERAL REVISED	
B	24/11/2018	GENERAL REVISED	
A	10/9/2018	GENERAL REVISED	

JOB NO. : J-837

PROJECT :
URA KWUN TONG TOWN CENTRE REDEVELOPMENT (AREA 2 & 3) AT NKIL 6514, KWUN TONG, KWLOON

TITLE :
PART ELEVATION OF CURTAIN WALL AT TOWER 2

DATE : 04-JUL-18 | SCALE : 1:60 (A1)

DRAWN BY : ASING | CHECKED BY : -

美特鋁質有限公司
MIDI ALUMINIUM FABRICATOR LTD.
Units 6-8, Sunray Industrial Centre, 1/F
610 Cha Kwo Ling Road, Kowloon
Tel:23489211-4 Fax:(852)27727666

DWG NO. : J837-CW-2210 | REV. : F

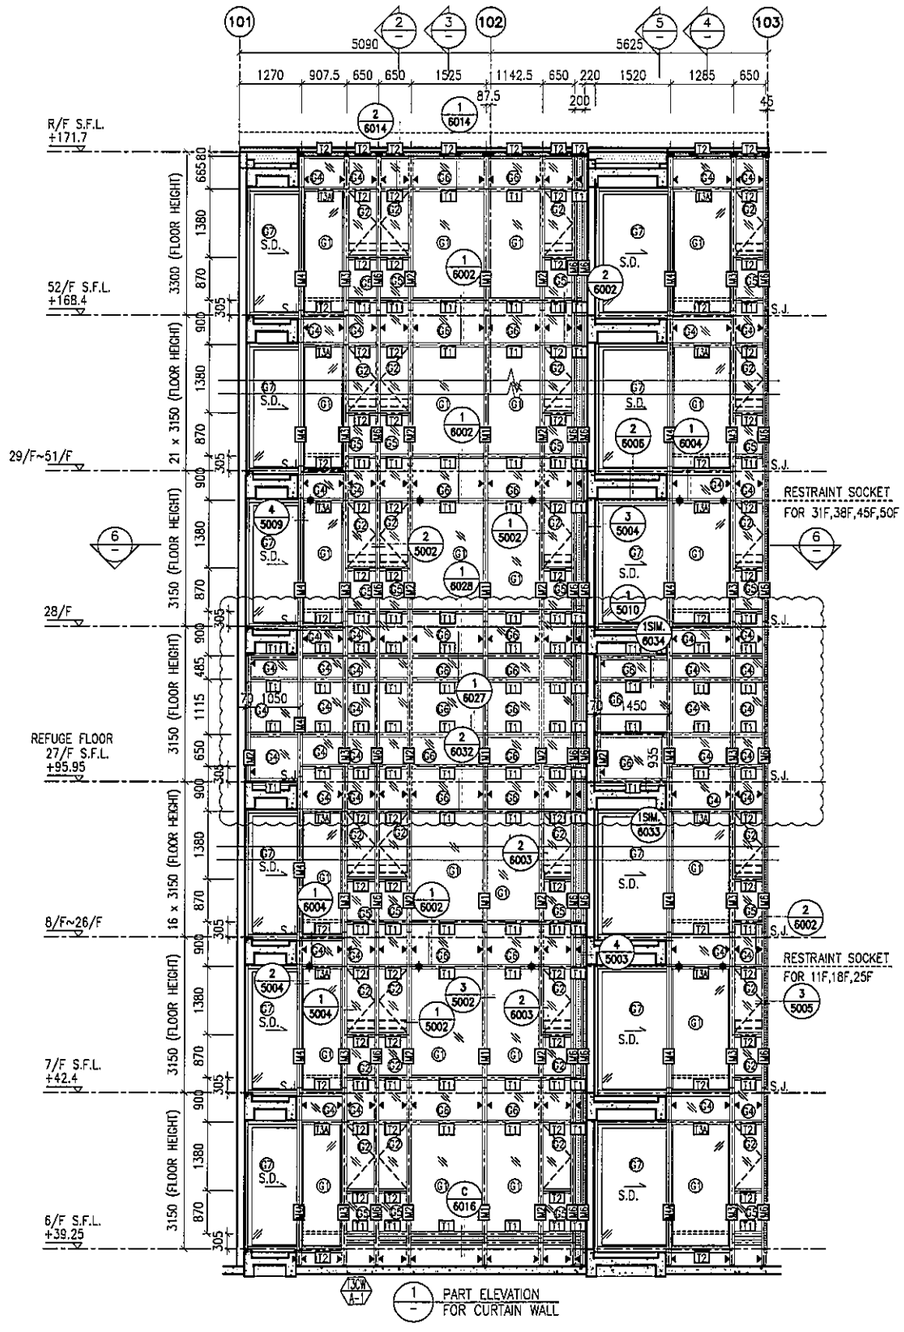

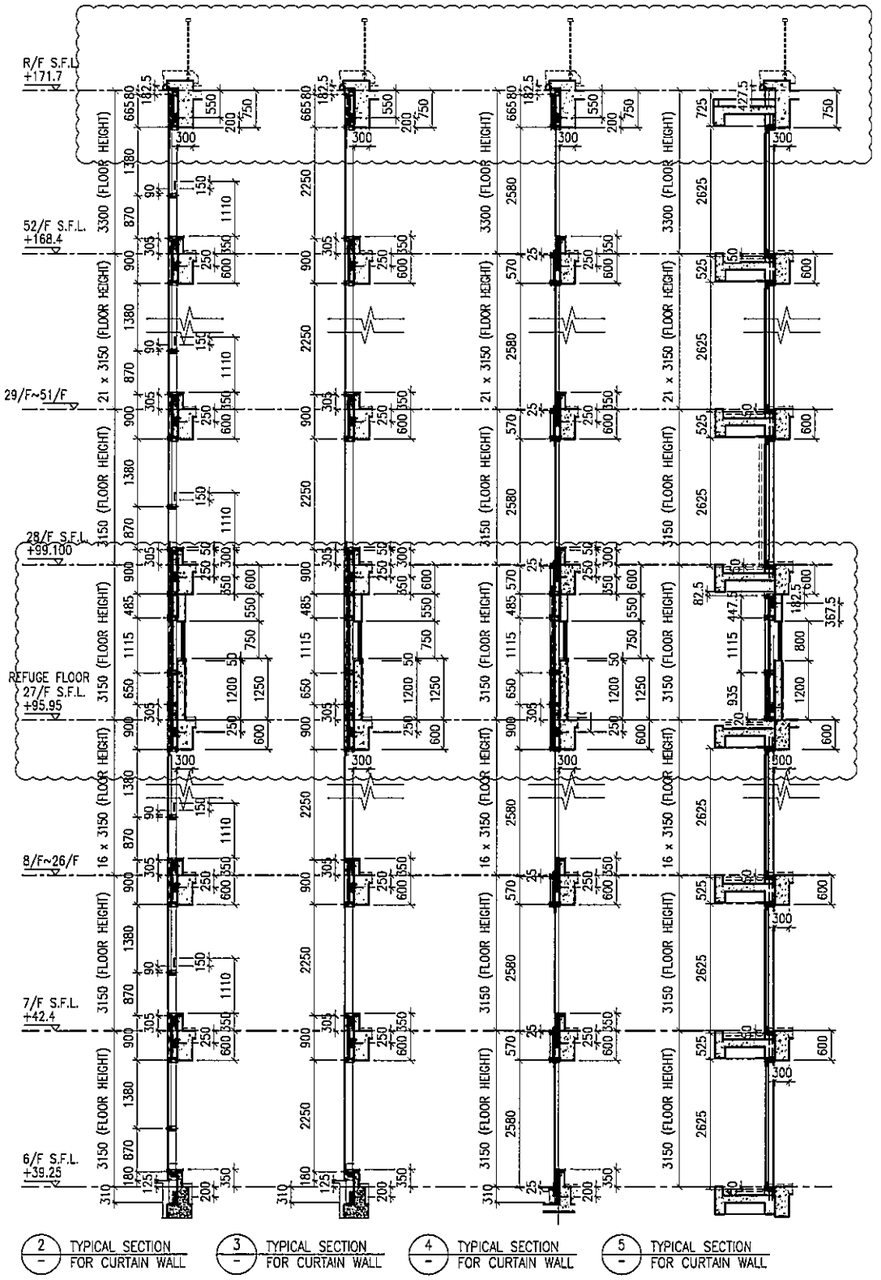

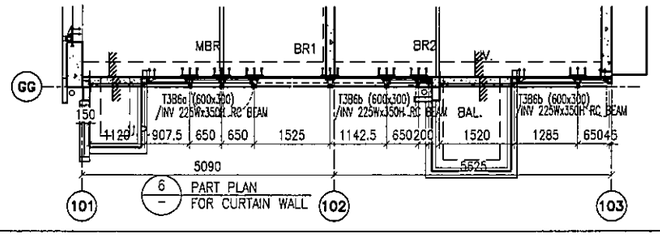

LEGEND:

- G1+ – 10 mm THK. TEMPERED BLUE TINTED GLASS (OUTER) + 9 mm AIR SPACE + 8 mm THK. TEMPERED CLEAR GLASS (INNER)
- G2+ – 8 mm THK. HEAT STRENGTHENED TINTED GLASS (OUTER)+ 9 mm AIR SPACE + 8 mm THK. HEAT STRENGTHENED CLEAR GLASS (INNER)
- G3+ – 10 mm THK. HEAT STRENGTHENED BLUE TINTED GLASS (OUTER)+ 9 mm AIR SPACE + 8 mm THK. TEMPERED CLEAR GLASS (INNER)
- G4+ – 8 mm THK. HEAT STRENGTHENED BLUE TINTED GLASS (SPANDREL GLASS)
- G5+ – 8 mm THK. HEAT STRENGTHENED BLUE TINTED GLASS (OUTER)+ 9 mm AIR SPACE + 8 mm THK. TEMPERED CLEAR GLASS (INNER)
- G6+ – 8 mm THK. TEMPERED BLUE TINTED GLASS (SPANDREL GLASS)
- G7+ – 8 mm THK. HEAT STRENGTHENED TINTED GLASS (OUTER)+ 1.52PVB + 8 mm THK. HEAT STRENGTHENED CLEAR LAMINATED GLASS (INNER) 10 mm THK. TEMPERED GLASS (INTERNAL PROTECTIVE BARRIER)
- 3 mm THK. ALUM. CLADDING
- M.W. – MAINTENANCE WINDOW
- S.J. – STACK JOINT
- AE01 – ALUM. EXTRUSION DIE NO.
- ▲ – SUPPORT POINT
- ◆ – RESTRAINT SOCKET

B.D. REF :

CLIENT :
信和置業有限公司
Sino Land Company Limited

ARCHITECT : WONG TUNG & PARTNERS LIMITED ARCHITECTS & PLANNERS

MAIN CONTRACTOR :
CR Construction Company Limited

STRUCTURAL ENGINEER :
AECOM

FACADE CONSULTANT:
AECOM

NOTE :
1. ALL DIMENSIONS ARE IN mm.
2. ALL ELEVATIONS ARE VIEWED FROM OUTSIDE.
3. ALL DIMENSIONS TO BE VERIFIED ON SITE BEFORE FABRICATION.

LEGEND :
- X1 / X001 — DETAIL MARK NO. / REFER SHEET NO.
1. F.F.L. --FINISHED FLOOR LEVEL
2. S.F.L. --STRUCTURAL FLOOR LEVEL
3. /R --REVERSED DETAIL

NO.	DATE	REVISED	BY
F	16/07/2019	GENERAL REVISED	
E	17/01/2019	GENERAL REVISED	
D	22/12/2018	GENERAL REVISED	
C	04/12/2018	GENERAL REVISED	
B	24/11/2018	GENERAL REVISED	
A	10/9/2018	GENERAL REVISED	

JOB NO. : J-837

PROJECT :
URA KWUN TONG TOWN CENTRE REDEVELOPMENT (AREA 2 & 3) AT NKIL 6514, KWUN TONG, KWLOON

TITLE :
PART ELEVATION OF CURTAIN WALL AT TOWER 3

DATE : 04-JUL-18	SCALE : 1:60 (A1)
DRAWN BY : ASING	CHECKED BY : –

美特鋁質有限公司
MIDI ALUMINIUM FABRICATOR LTD.
Units 6-8, Sunray Industrial Centre, 1/F
610 Cha Kwo Ling Road, Kowloon
Tel:23489211-4 Fax:(852)27727666

DWG NO. : J837-CW-2310 REV. : F

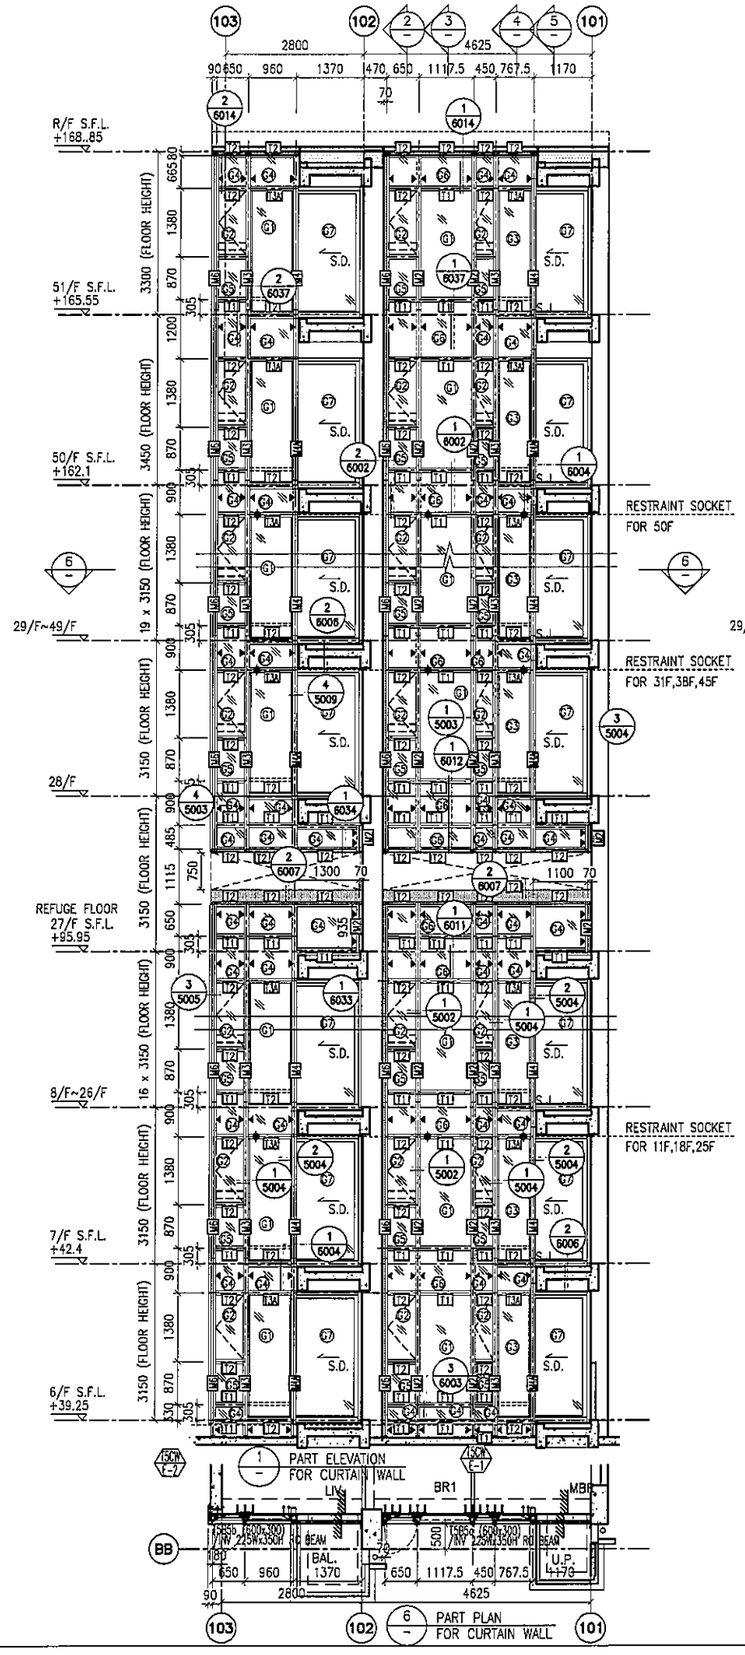

1 PART ELEVATION FOR CURTAIN WALL

6 PART PLAN FOR CURTAIN WALL

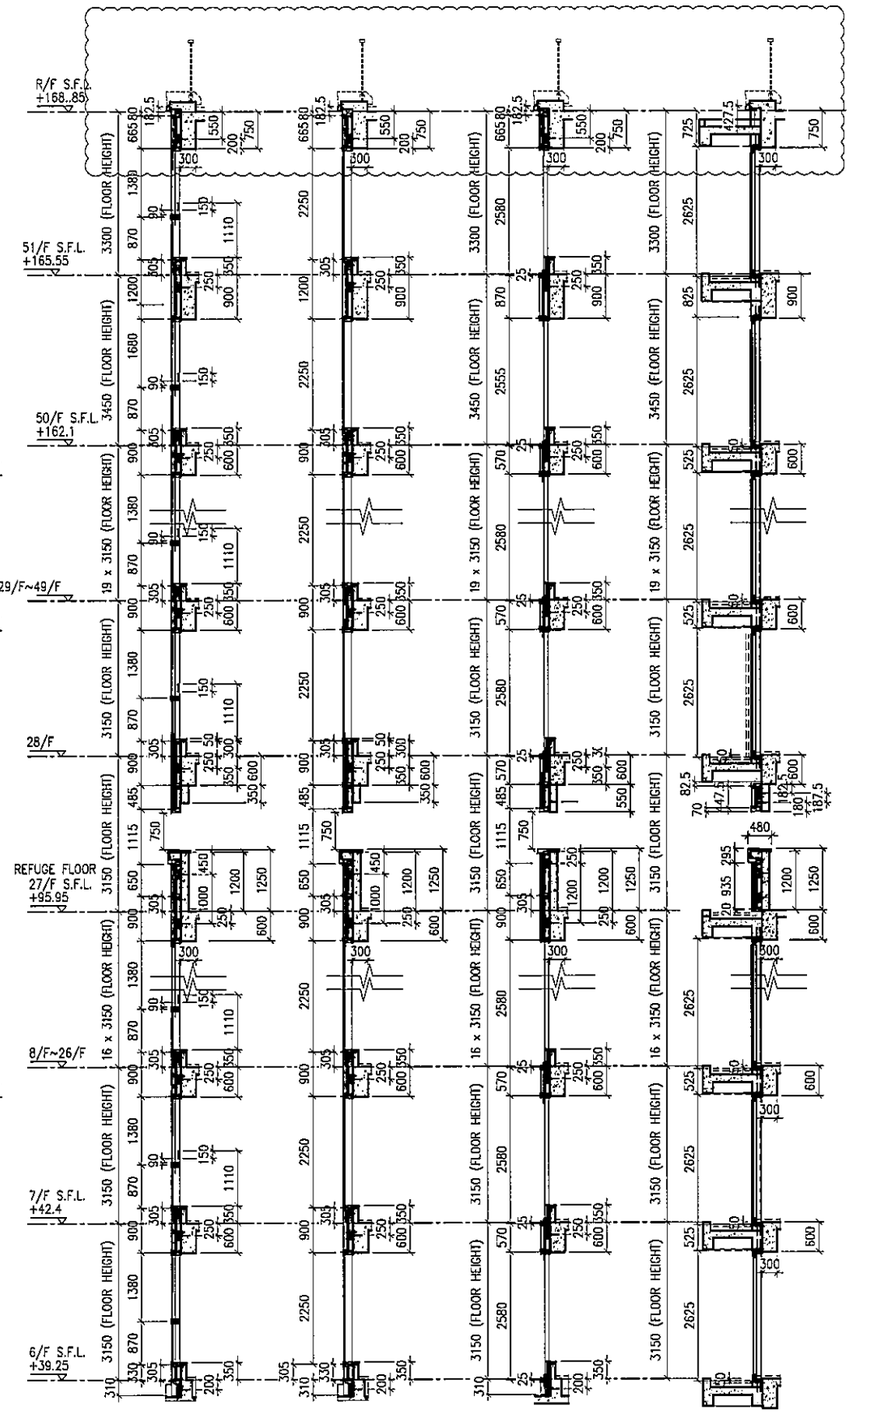

2 TYPICAL SECTION FOR CURTAIN WALL

3 TYPICAL SECTION FOR CURTAIN WALL

4 TYPICAL SECTION FOR CURTAIN WALL

5 TYPICAL SECTION FOR CURTAIN WALL

LEGEND:

- G1 – 10 mm THK. TEMPERED BLUE TINTED GLASS (OUTER) + 9 mm AIR SPACE + 8 mm THK. TEMPERED CLEAR GLASS (INNER)
- G2 – 8 mm THK. HEAT STRENGTHENED TINTED GLASS (OUTER)+ 9 mm AIR SPACE + 8 mm THK. HEAT STRENGTHENED CLEAR GLASS (INNER)
- G3 – 10 mm THK. HEAT STRENGTHENED BLUE TINTED GLASS (OUTER)+ 9 mm AIR SPACE + 8 mm THK. TEMPERED CLEAR GLASS (INNER)
- G4 – 8 mm THK. HEAT STRENGTHENED BLUE TINTED GLASS (SPANDREL GLASS)
- G5 – 8 mm THK. HEAT STRENGTHENED BLUE TINTED GLASS (OUTER)+ 9 mm AIR SPACE + 8 mm THK. TEMPERED CLEAR GLASS (INNER)
- G6 – 8 mm THK. TEMPERED BLUE TINTED GLASS (SPANDREL GLASS)
- G7 – 8 mm THK. HEAT STRENGTHENED TINTED GLASS (OUTER)+ 1.52PVB + 8 mm THK. HEAT STRENGTHENED CLEAR LAMINATED GLASS (INNER)
- 10 mm THK. TEMPERED GLASS (INTERNAL PROTECTIVE BARRIER)
- 3 mm THK. ALUM. CLADDING
- M.W. – MAINTENANCE WINDOW
- S.J. – STACK JOINT
- AK01 – ALUM. EXTRUSION DIE NO.
- ▲ – SUPPORT POINT
- ◆ – RESTRAINT SOCKET

B.D. REF :

CLIENT :
信和置業有限公司
Sino Land Company Limited

ARCHITECT :
WONG TUNG & PARTNERS LIMITED
ARCHITECTS & PLANNERS

MAIN CONTRACTOR :
CR Construction Company Limited

STRUCTURAL ENGINEER :
AECOM

FACADE CONSULTANT:
AECOM

NOTE :
1. ALL DIMENSIONS ARE IN mm.
2. ALL ELEVATIONS ARE VIEWED FROM OUTSIDE.
3. ALL DIMENSIONS TO BE VERIFIED ON SITE BEFORE FABRICATION.

LEGEND :
- X1 / X001 — DETAIL MARK NO. / REFER SHEET NO.
1. F.F.L. --FINISHED FLOOR LEVEL
2. S.F.L. --STRUCTURAL FLOOR LEVEL
3. /R --REVERSED DETAIL

NO.	DATE	REVISED	BY
F	16/07/2019	GENERAL REVISED	
E	17/01/2019	GENERAL REVISED	
D	22/12/2018	GENERAL REVISED	
C	04/12/2018	GENERAL REVISED	
B	24/11/2018	GENERAL REVISED	
A	10/9/2018	GENERAL REVISED	

JOB NO. : J-837

PROJECT :
URA KWUN TONG TOWN CENTRE REDEVELOPMENT (AREA 2 & 3) AT NKIL 6514, KWUN TONG, KWLOON

TITLE :
PART ELEVATION OF CURTAIN WALL AT TOWER 5

DATE : 04-JUL-18 | SCALE : 1:60 (A1)

DRAWN BY : ASING | CHECKED BY : --

美特鋁製有限公司
MIDI ALUMINIUM FABRICATOR LTD.
Units 6-8, Sunray Industrial Centre, 1/F
610 Cha Kwo Ling Road, Kowloon
Tel:23489211-4 Fax:(852)27727666

DWG NO. : J837-CW-2510 | REV. : F

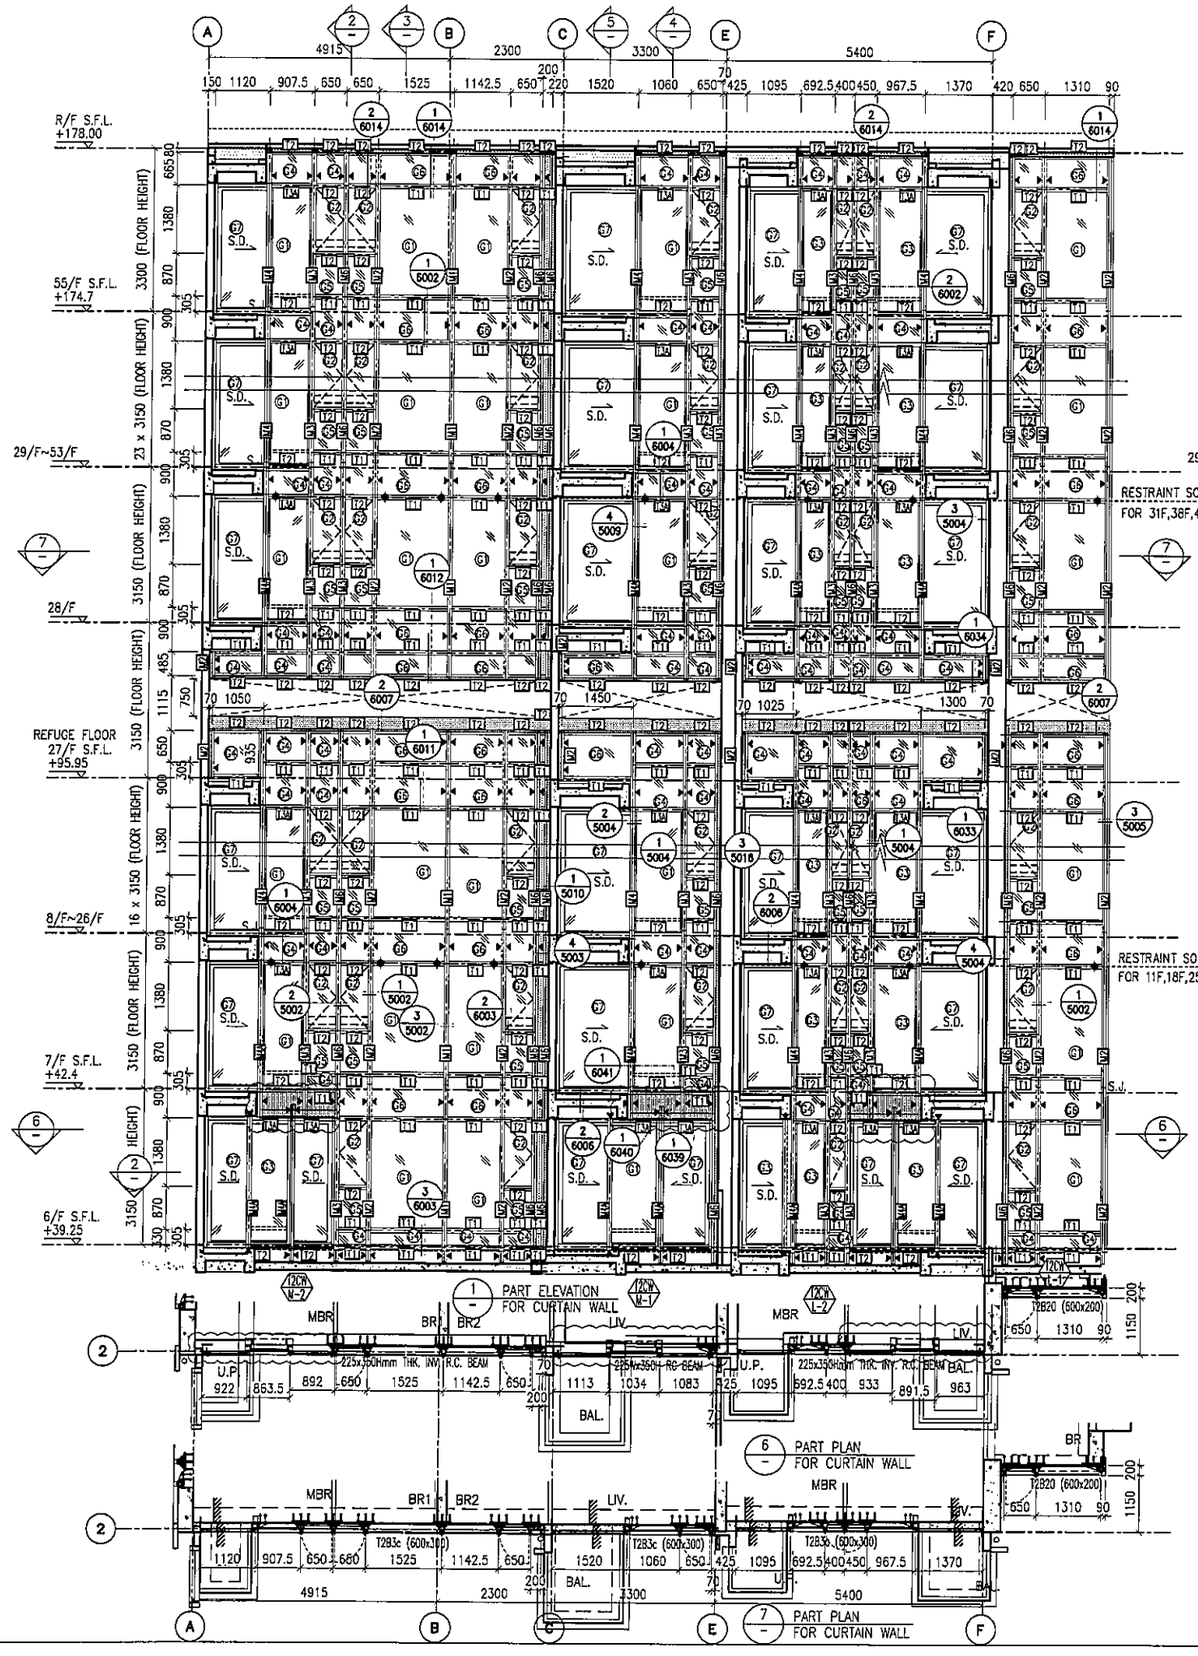

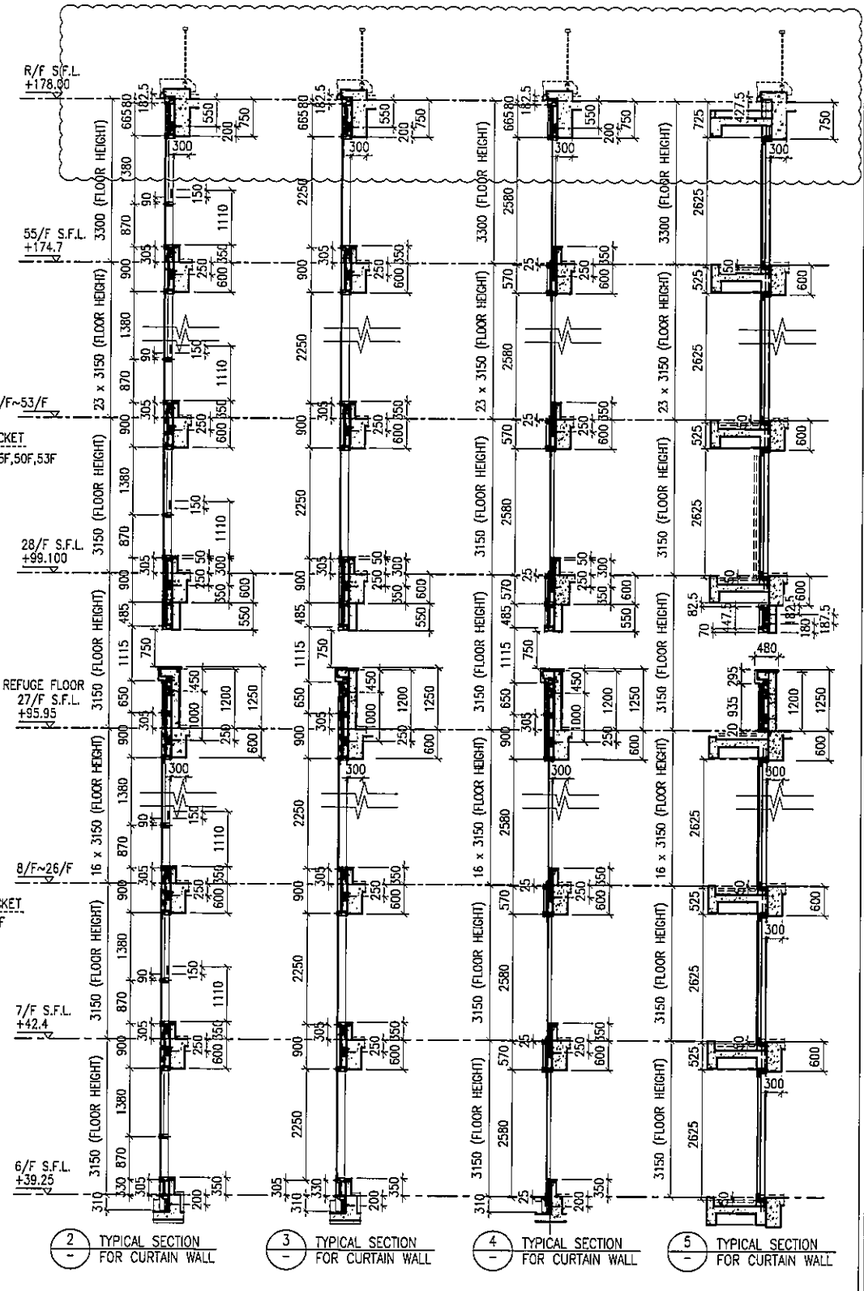

LEGEND:

- G1 – 10 mm THK. TEMPERED BLUE TINTED GLASS (OUTER) + 9 mm AIR SPACE + 8 mm THK. TEMPERED CLEAR GLASS (INNER)
- G2 – 8 mm THK. HEAT STRENGTHENED TINTED GLASS (OUTER)+ 9 mm AIR SPACE + 8 mm THK. HEAT STRENGTHENED CLEAR GLASS (INNER)
- G3 – 10 mm THK. HEAT STRENGTHENED BLUE TINTED GLASS (OUTER)+ 9 mm AIR SPACE + 8 mm THK. TEMPERED CLEAR GLASS (INNER)
- G4 – 8 mm THK. HEAT STRENGTHENED BLUE TINTED GLASS (SPANDREL GLASS)
- G5 – 8 mm THK. HEAT STRENGTHENED BLUE TINTED GLASS (OUTER)+ 9 mm AIR SPACE + 8 mm THK. TEMPERED CLEAR GLASS (INNER)
- G5 – 8 mm THK. TEMPERED BLUE TINTED GLASS (SPANDREL GLASS)
- G7 – 8 mm THK. HEAT STRENGTHENED TINTED GLASS (OUTER)+ 1.52PVB + 8 mm THK. HEAT STRENGTHENED CLEAR LAMINATED GLASS (INNER) 10 mm THK. TEMPERED GLASS (INTERNAL PROTECTIVE BARRIER)
- 3 mm THK. ALUM. CLADDING
- M.W. – MAINTENANCE WINDOW
- S.J. – STACK JOINT
- AF01 – ALUM. EXTRUSION DIE NO.
- ▲ – SUPPORT POINT
- ◆ – RESTRAINT SOCKET

B.D. REF :

CLIENT :
信和置業有限公司
Sino Land Company Limited

ARCHITECT :
WONG TUNG & PARTNERS LIMITED
ARCHITECTS & PLANNERS

MAIN CONTRACTOR :
CR Construction Company Limited

STRUCTURAL ENGINEER :
AECOM

FACADE CONSULTANT:
AECOM

NOTE :
1. ALL DIMENSIONS ARE IN mm.
2. ALL ELEVATIONS ARE VIEWED FROM OUTSIDE.
3. ALL DIMENSIONS TO BE VERIFIED ON SITE BEFORE FABRICATION.

LEGEND :
X1 / X001 – DETAIL MARK NO. / REFER SHEET NO.
1. F.F.L. --FINISHED FLOOR LEVEL
2. S.F.L. --STRUCTURAL FLOOR LEVEL
3. (R) --REVERSED DETAIL

NO.	DATE	REVISED	BY
G	16/07/2019	GENERAL REVISED	
F	26/05/2019	GENERAL REVISED	
E	17/01/2019	GENERAL REVISED	
D	22/12/2018	GENERAL REVISED	
C	04/12/2018	GENERAL REVISED	
B	24/11/2018	GENERAL REVISED	
A	10/9/2018	GENERAL REVISED	

JOB NO. : J-837

PROJECT :
URA KWUN TONG TOWN CENTRE REDEVELOPMENT (AREA 2 & 3) AT NKIL 6514, KWUN TONG, KWLOON

TITLE :
PART ELEVATION OF CURTAIN WALL AT TOWER 2

DATE : 04-JUL-18 | SCALE : 1:60 (A1)

DRAWN BY : ASING | CHECKED BY : –

美特鋁質有限公司
MIDI ALUMINIUM FABRICATOR LTD.
Units 6-8, Sunray Industrial Centre, 1/F
610 Cha Kwo Ling Road, Kowloon
Tel:23489211-4 Fax:(852)27727666

DWG NO. : J837-CW-2211 | REV. : G

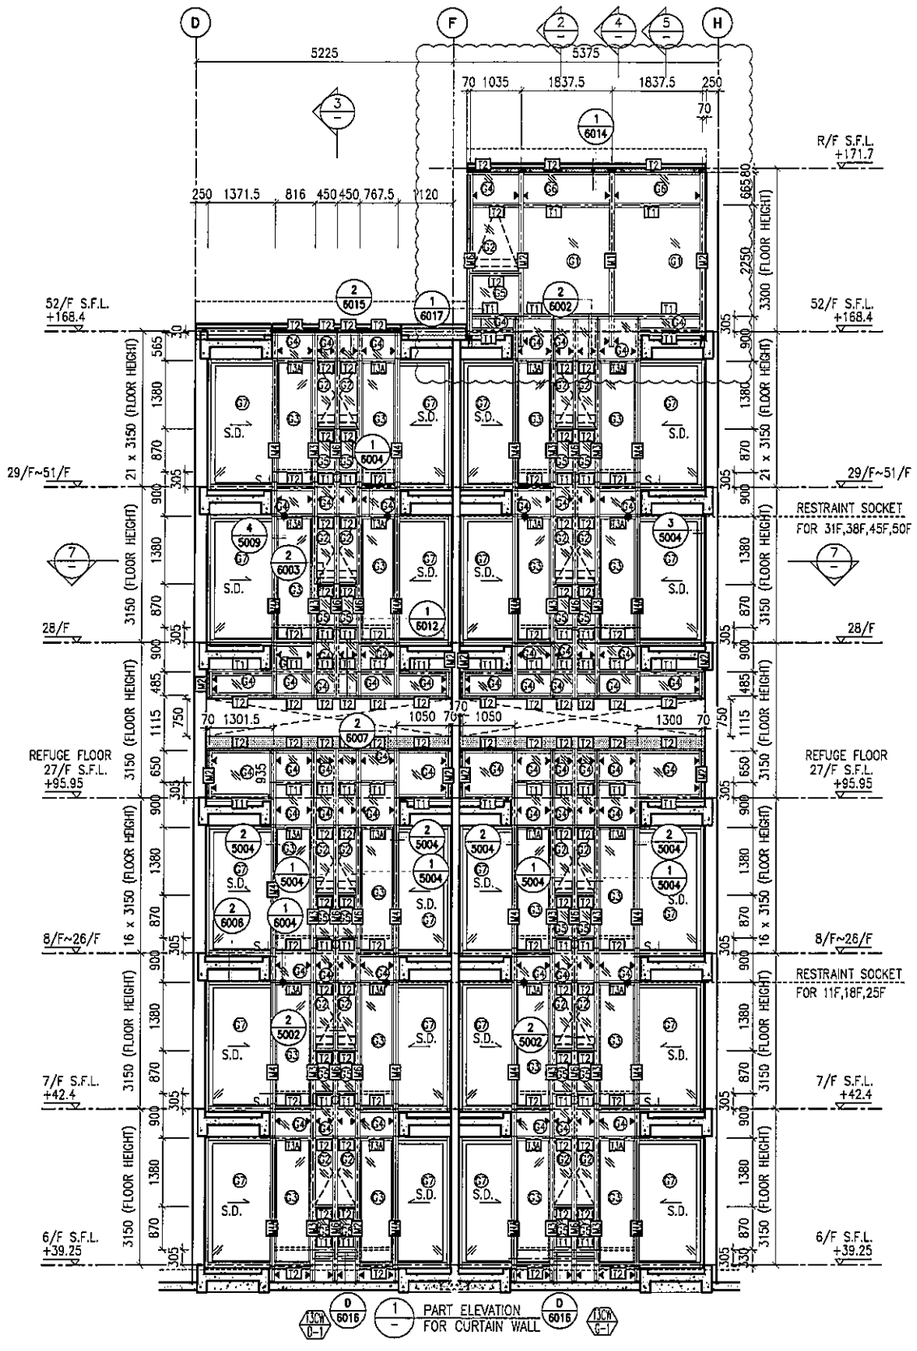

1 / PART ELEVATION FOR CURTAIN WALL

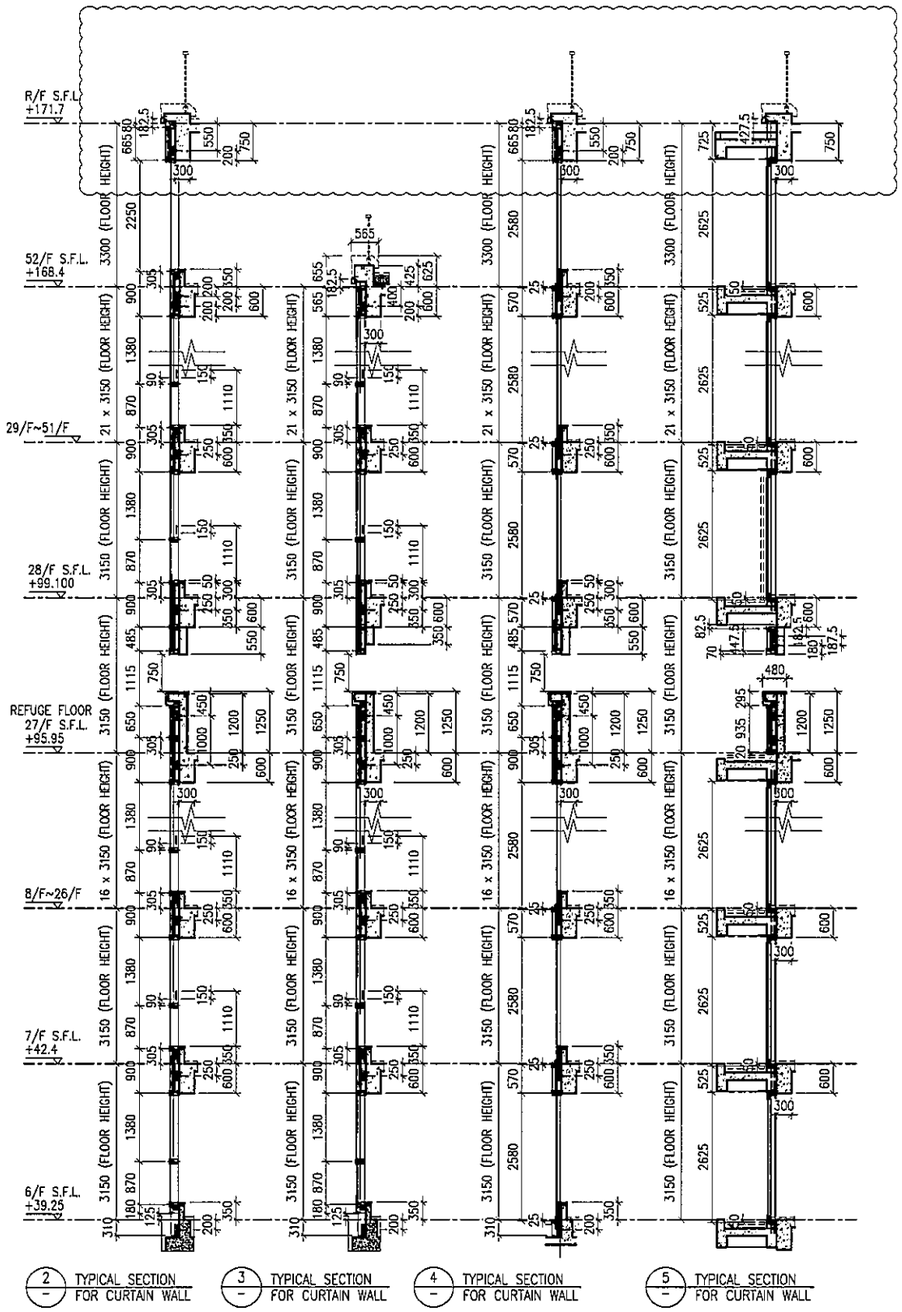

2 / TYPICAL SECTION FOR CURTAIN WALL

3 / TYPICAL SECTION FOR CURTAIN WALL

4 / TYPICAL SECTION FOR CURTAIN WALL

5 / TYPICAL SECTION FOR CURTAIN WALL

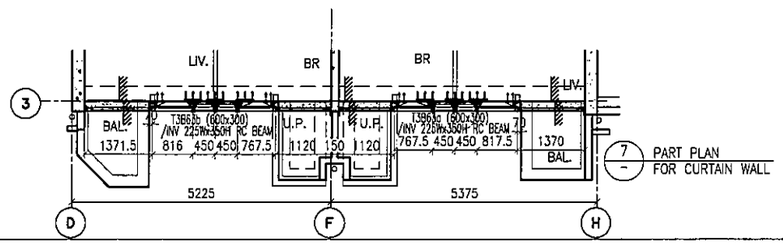

7 / PART PLAN FOR CURTAIN WALL

LEGEND:

- 10 mm THK. TEMPERED BLUE TINTED GLASS (OUTER) + 9 mm AIR SPACE + 8 mm THK. TEMPERED CLEAR GLASS (INNER)
- 8 mm THK. HEAT STRENGTHENED TINTED GLASS (OUTER)+ 9 mm AIR SPACE + 8 mm THK. HEAT STRENGTHENED CLEAR GLASS (INNER)
- 10 mm THK. HEAT STRENGTHENED BLUE TINTED GLASS (OUTER)+ 9 mm AIR SPACE + 8 mm THK. TEMPERED CLEAR GLASS (INNER)
- 8 mm THK. HEAT STRENGTHENED BLUE TINTED GLASS (SPANDREL GLASS)
- 8 mm THK. HEAT STRENGTHENED BLUE TINTED GLASS (OUTER)+ 9 mm AIR SPACE + 8 mm THK. TEMPERED CLEAR GLASS (INNER)
- 8 mm THK. TEMPERED BLUE TINTED GLASS (SPANDREL GLASS)
- 8 mm THK. HEAT STRENGTHENED TINTED GLASS (OUTER)+ 1.52PVB + 8 mm THK. HEAT STRENGTHENED CLEAR LAMINATED GLASS (INNER) 10 mm THK. TEMPERED GLASS (INTERNAL PROTECTIVE BARRIER)
- 3 mm THK. ALUM. CLADDING
- M.W. – MAINTENANCE WINDOW
- S.J. – STACK JOINT
- AE01 – ALUM. EXTRUSION DIE NO.
- ▲ – SUPPORT POINT
- ◆ – RESTRAINT SOCKET

B.D. REF :

CLIENT :
信和置業有限公司
Sino Land Company Limited

ARCHITECT :
WONG TUNG & PARTNERS LIMITED
ARCHITECTS & PLANNERS

MAIN CONTRACTOR :
CR Construction Company Limited

STRUCTURAL ENGINEER :
AECOM

FACADE CONSULTANT:
AECOM

NOTE :
1. ALL DIMENSIONS ARE IN mm.
2. ALL ELEVATIONS ARE VIEWED FROM OUTSIDE.
3. ALL DIMENSIONS TO BE VERIFIED ON SITE BEFORE FABRICATION.

LEGEND :
X1 — DETAIL MARK NO.
X001 — REFER SHEET NO.

1. F.F.L. --FINISHED FLOOR LEVEL
2. S.F.L. --STRUCTURAL FLOOR LEVEL
3. /R --REVERSED DETAIL

NO.	DATE	REVISED	BY
H	16/07/2019	GENERAL REVISED	
G	26/05/2019	GENERAL REVISED	
F	22/05/2019	GENERAL REVISED	
E	17/01/2019	GENERAL REVISED	
D	22/12/2018	GENERAL REVISED	
C	04/12/2018	GENERAL REVISED	
B	24/11/2018	GENERAL REVISED	
A	10/9/2018	GENERAL REVISED	

JOB NO. : J-837

PROJECT :
URA KWUN TONG TOWN CENTRE REDEVELOPMENT (AREA 2 & 3) AT NKIL 6514, KWUN TONG, KWLOON

TITLE :
PART ELEVATION OF CURTAIN WALL AT TOWER 3

DATE : 04-JUL-18 | SCALE : 1:60 (A1)

DRAWN BY : ASING | CHECKED BY : --

美特鋁製有限公司
MIDI ALUMINIUM FABRICATOR LTD.
Units 6-8, Sunray Industrial Centre, 1/F
610 Cha Kwo Ling Road, Kowloon
Tel:23489211-4 Fax:(852)27727666

DWG NO. : JB37-CW-2311 | REV. : H

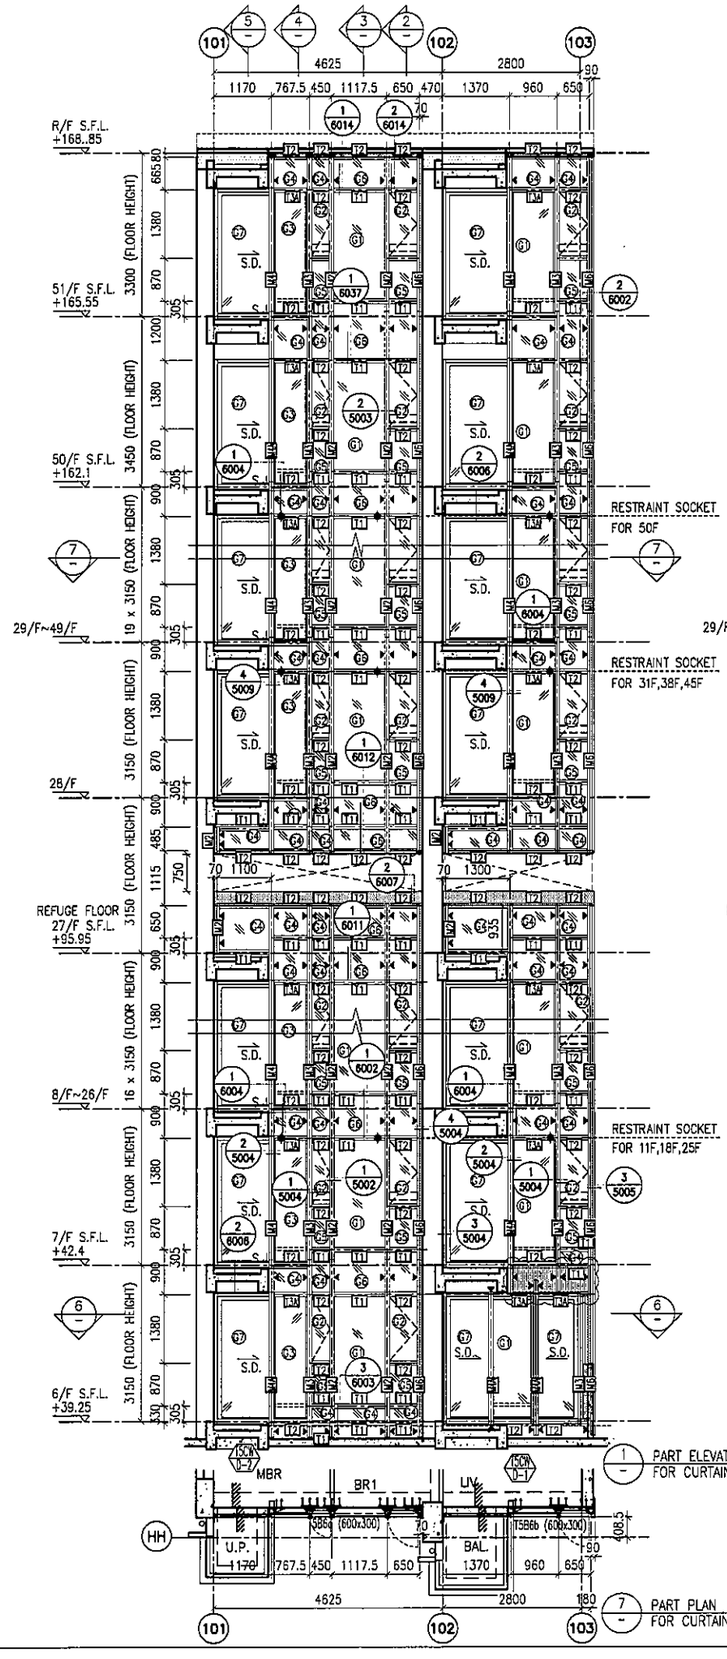

1 PART ELEVATION FOR CURTAIN WALL

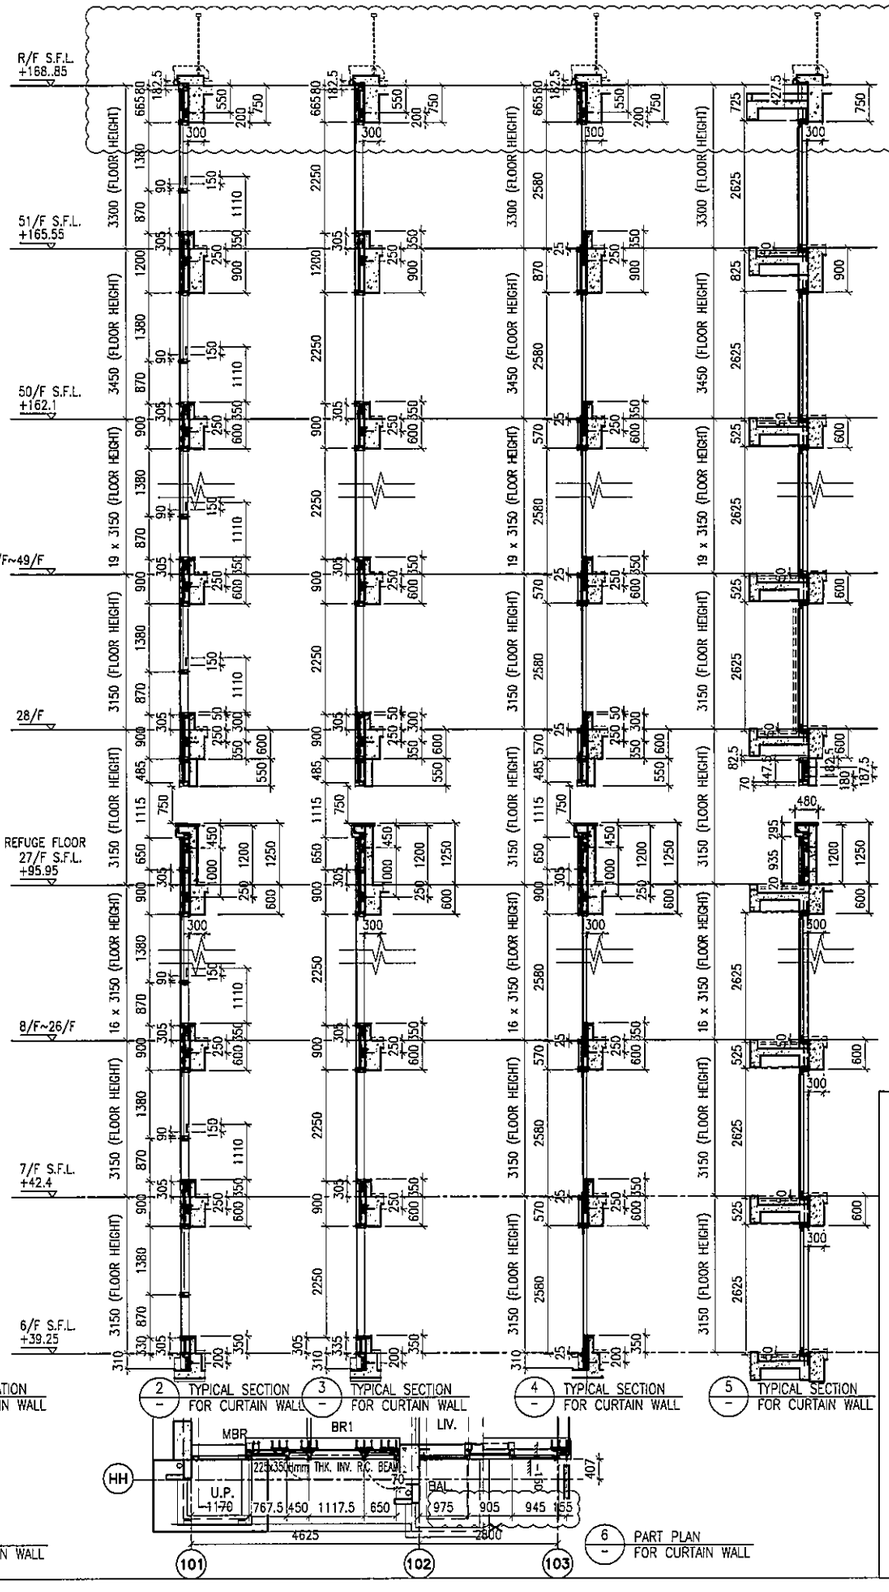

2 TYPICAL SECTION FOR CURTAIN WALL

3 TYPICAL SECTION FOR CURTAIN WALL

4 TYPICAL SECTION FOR CURTAIN WALL

5 TYPICAL SECTION FOR CURTAIN WALL

6 PART PLAN FOR CURTAIN WALL

7 PART PLAN FOR CURTAIN WALL

LEGEND:

- 10 mm THK. TEMPERED BLUE TINTED GLASS (OUTER) + 9 mm AIR SPACE + 8 mm THK. TEMPERED CLEAR GLASS (INNER)
- 8 mm THK. HEAT STRENGTHENED TINTED GLASS (OUTER)+ 9 mm AIR SPACE + 8 mm THK. HEAT STRENGTHENED CLEAR GLASS (INNER)
- 10 mm THK. HEAT STRENGTHENED BLUE TINTED GLASS (OUTER)+ 9 mm AIR SPACE + 8 mm THK. TEMPERED CLEAR GLASS (INNER)
- 8 mm THK. HEAT STRENGTHENED BLUE TINTED GLASS (SPANDREL GLASS)
- 8 mm THK. HEAT STRENGTHENED BLUE TINTED GLASS (OUTER)+ 9 mm AIR SPACE + 8 mm THK. TEMPERED CLEAR GLASS (INNER)
- 8 mm THK. TEMPERED BLUE TINTED GLASS (SPANDREL GLASS)
- 8 mm THK. HEAT STRENGTHENED TINTED GLASS (OUTER)+ 1.52PVB + 8 mm THK. HEAT STRENGTHENED CLEAR LAMINATED GLASS (INNER)
- 10 mm THK. TEMPERED GLASS (INTERNAL PROTECTIVE BARRIER)
- 3 mm THK. ALUM. CLADDING
- M.W. – MAINTENANCE WINDOW
- S.J. – STACK JOINT
- AF-01 – ALUM. EXTRUSION DIE NO.
- ▲ – SUPPORT POINT
- ✦ – RESTRAINT SOCKET

B.D. REF :

CLIENT :
信和置業有限公司
Sino Land Company Limited

ARCHITECT :
WONG TUNG & PARTNERS LIMITED
ARCHITECTS & PLANNERS

MAIN CONTRACTOR :
CR Construction Company Limited

STRUCTURAL ENGINEER :
AECOM

FACADE CONSULTANT:
AECOM

NOTE :
1. ALL DIMENSIONS ARE IN mm.
2. ALL ELEVATIONS ARE VIEWED FROM OUTSIDE.
3. ALL DIMENSIONS TO BE VERIFIED ON SITE BEFORE FABRICATION.

LEGEND :
(X1 / X001) — DETAIL MARK NO. / REFER SHEET NO.
1. F.F.L. --FINISHED FLOOR LEVEL
2. S.F.L. --STRUCTURAL FLOOR LEVEL
3. /R --REVERSED DETAIL

NO.	DATE	REVISED	BY
G	16/07/2019	GENERAL REVISED	
F	26/05/2019	GENERAL REVISED	
E	17/01/2019	GENERAL REVISED	
D	22/12/2018	GENERAL REVISED	
C	04/12/2018	GENERAL REVISED	
B	24/11/2018	GENERAL REVISED	
A	10/9/2018	GENERAL REVISED	

JOB NO. : J-837

PROJECT :
URA KWUN TONG TOWN CENTRE REDEVELOPMENT (AREA 2 & 3) AT NKIL 6514, KWUN TONG, KWLOON

TITLE :
PART ELEVATION OF CURTAIN WALL AT TOWER 5

DATE : 04-JUL-18 | SCALE : 1:60 (A1)

DRAWN BY : ASING | CHECKED BY : –

美特鋁質有限公司
MIDI ALUMINIUM FABRICATOR LTD.
Units 6-8, Sunray Industrial Centre, 1/F
610 Cha Kwo Ling Road, Kowloon
Tel:23489211-4 Fax:(852)27727666

DWG NO. : J837-CW-2511 | REV. : G

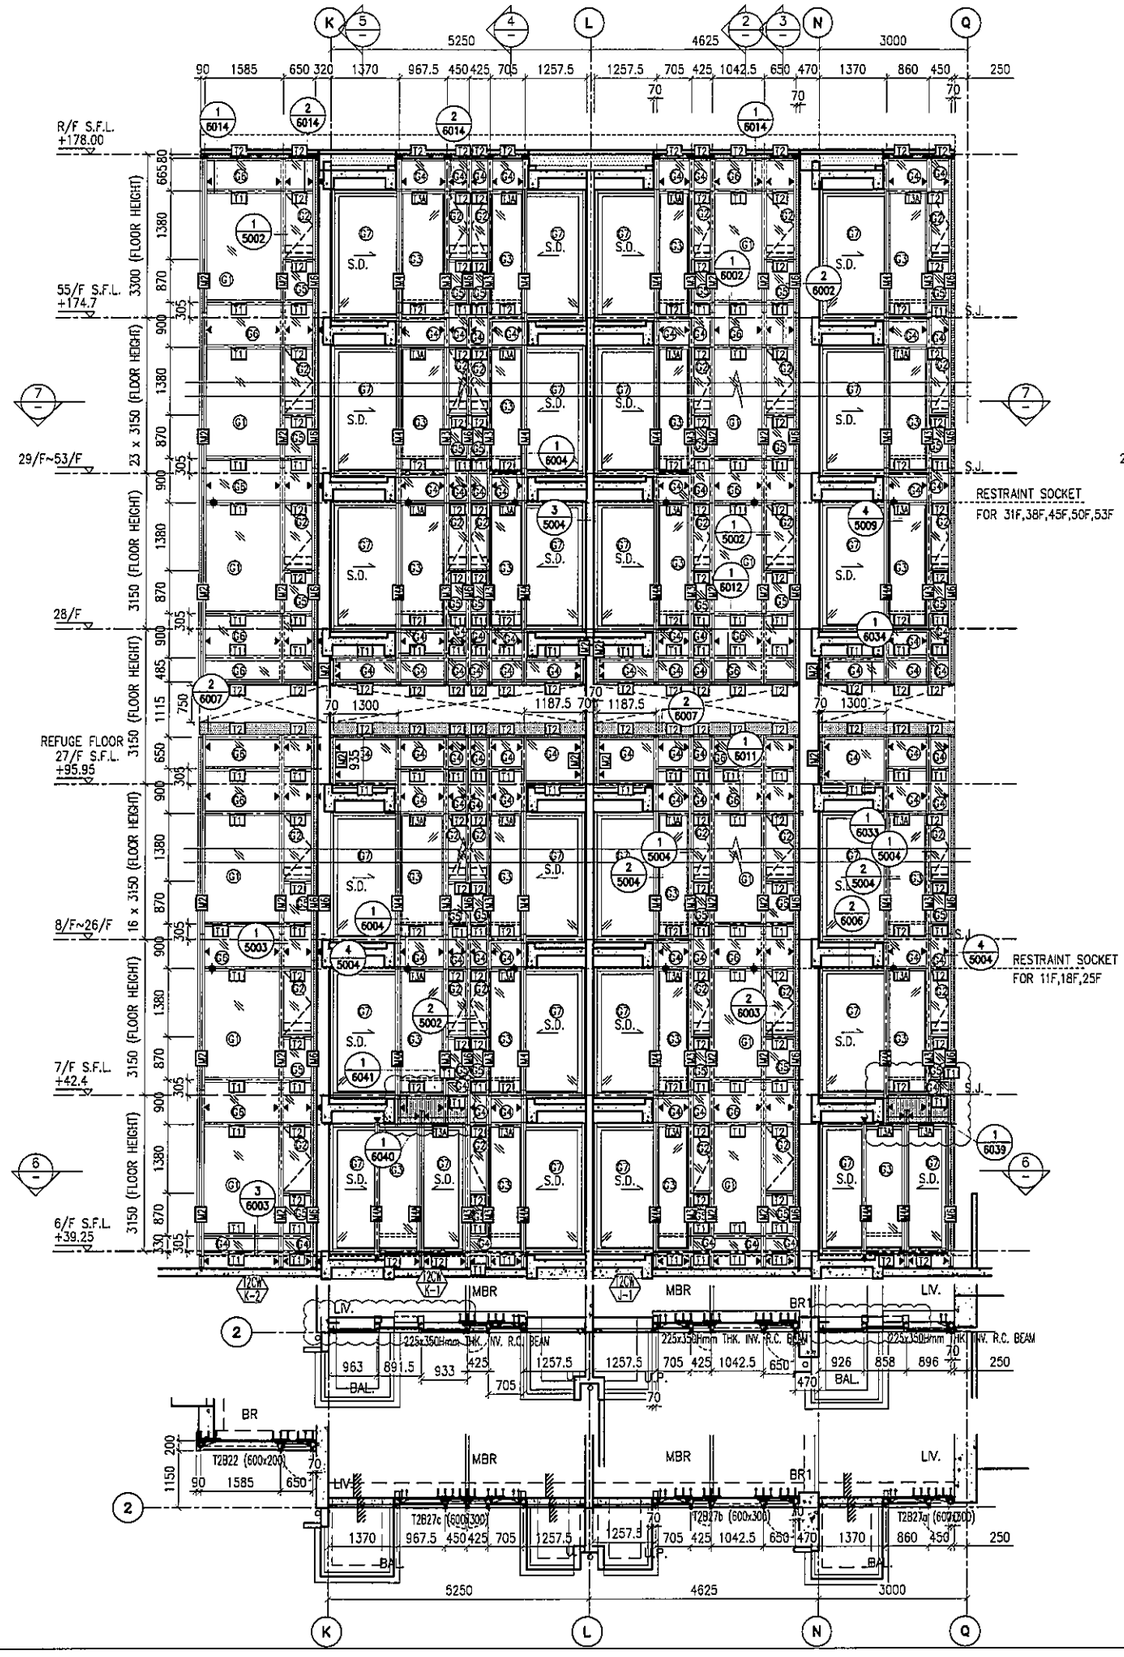

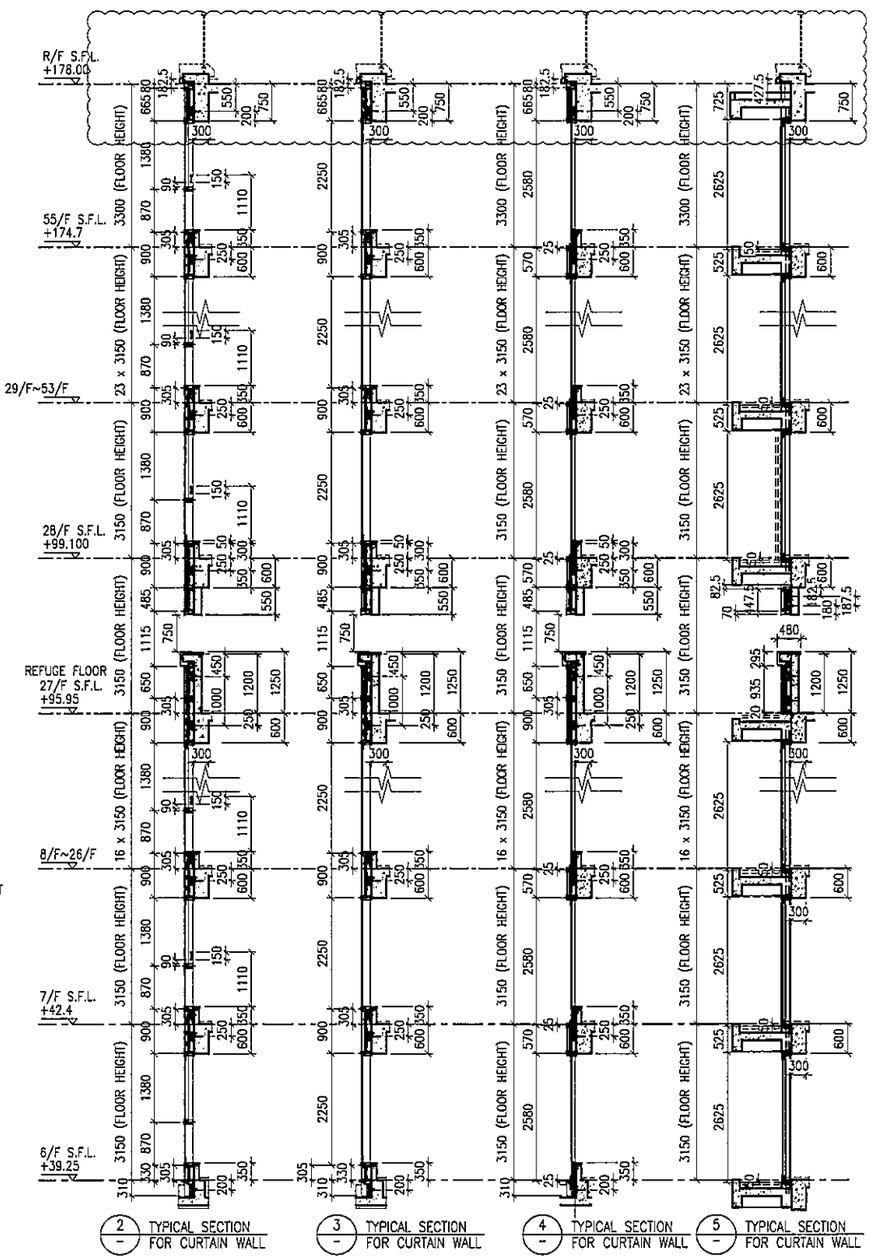

LEGEND:

- 10 mm THK. TEMPERED BLUE TINTED GLASS (OUTER) + 9 mm AIR SPACE + 8 mm THK. TEMPERED CLEAR GLASS (INNER)
- 8 mm THK. HEAT STRENGTHENED TINTED GLASS (OUTER)+ 9 mm AIR SPACE + 8 mm THK. HEAT STRENGTHENED CLEAR GLASS (INNER)
- 10 mm THK. HEAT STRENGTHENED BLUE TINTED GLASS (OUTER)+ 9 mm AIR SPACE + 8 mm THK. TEMPERED CLEAR GLASS (INNER)
- 8 mm THK. HEAT STRENGTHENED BLUE TINTED GLASS (SPANDREL GLASS)
- 8 mm THK. HEAT STRENGTHENED BLUE TINTED GLASS (OUTER)+ 9 mm AIR SPACE + 8 mm THK. TEMPERED CLEAR GLASS (INNER)
- 8 mm THK. TEMPERED BLUE TINTED GLASS (SPANDREL GLASS)
- 8 mm THK. HEAT STRENGTHENED TINTED GLASS (OUTER)+ 1.52PVB + 8 mm THK. HEAT STRENGTHENED CLEAR LAMINATED GLASS (INNER) 10 mm THK. TEMPERED GLASS (INTERNAL PROTECTIVE BARRIER)
- 3 mm THK. ALUM. CLADDING
- M.W. – MAINTENANCE WINDOW
- S.J. – STACK JOINT
- AE01 – ALUM. EXTRUSION DIE NO.
- ▲ – SUPPORT POINT
- ✦ – RESTRAINT SOCKET

B.D. REF :

CLIENT :
信和置業有限公司
Sino Land Company Limited

ARCHITECT : WONG TUNG & PARTNERS LIMITED ARCHITECTS & PLANNERS

MAIN CONTRACTOR :
CR Construction Company Limited

STRUCTURAL ENGINEER : AECOM

FACADE CONSULTANT: AECOM

NOTE :
1. ALL DIMENSIONS ARE IN mm.
2. ALL ELEVATIONS ARE VIEWED FROM OUTSIDE.
3. ALL DIMENSIONS TO BE VERIFIED ON SITE BEFORE FABRICATION.

LEGEND :
- X1 / XD01 — DETAIL MARK NO. / REFER SHEET NO.
1. F.F.L. --FINISHED FLOOR LEVEL
2. S.F.L. --STRUCTURAL FLOOR LEVEL
3. /R --REVERSED DETAIL

NO.	DATE	REVISED	BY
G	16/07/2019	GENERAL REVISED	
F	26/05/2019	GENERAL REVISED	
E	17/01/2019	GENERAL REVISED	
D	22/12/2018	GENERAL REVISED	
C	04/12/2018	GENERAL REVISED	
B	24/11/2018	GENERAL REVISED	
A	10/9/2018	GENERAL REVISED	

JOB NO. : J-837

PROJECT :
URA KWUN TONG TOWN CENTRE REDEVELOPMENT (AREA 2 & 3) AT NKIL 6514, KWUN TONG, KWLOON

TITLE :
PART ELEVATION OF CURTAIN WALL AT TOWER 2

DATE : 04-JUL-18 | SCALE : 1:60 (A1)

DRAWN BY : ASING | CHECKED BY : –

美特鋁製有限公司
MIDI ALUMINIUM FABRICATOR LTD.
Units 6-8, Sunray Industrial Centre, 1/F
610 Cha Kwo Ling Road, Kowloon
Tel:23489211-4 Fax:(852)27727666

DWG NO. : J837-CW-2212 | REV. : G

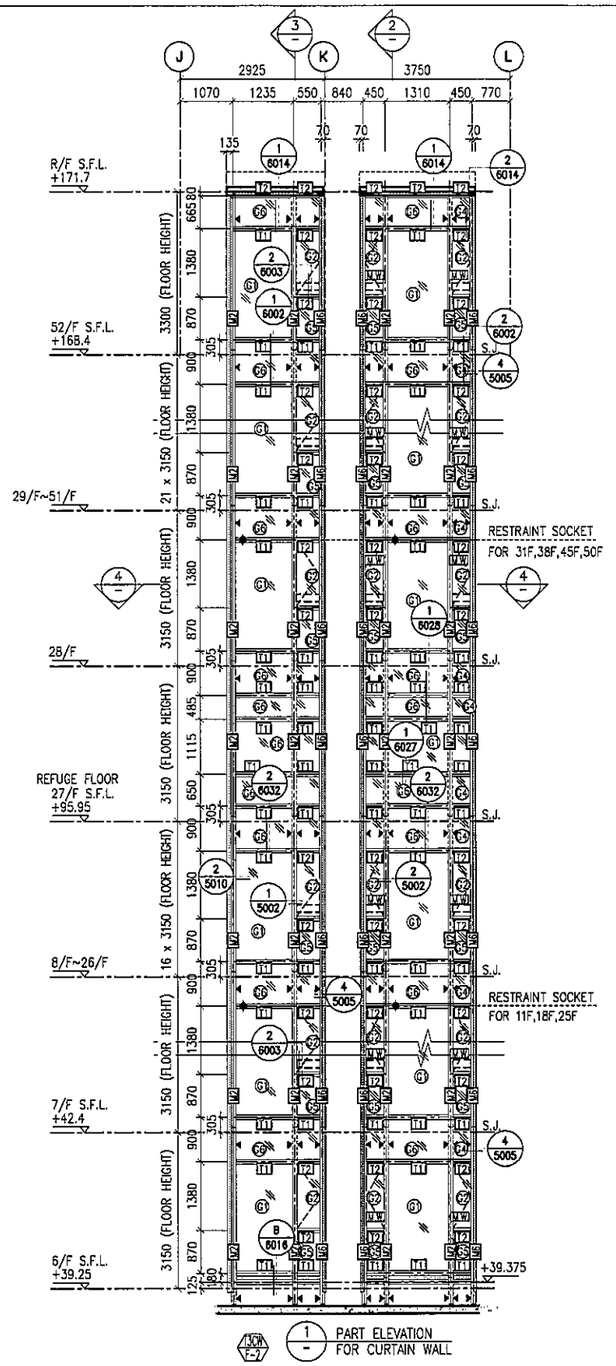

1 PART ELEVATION FOR CURTAIN WALL

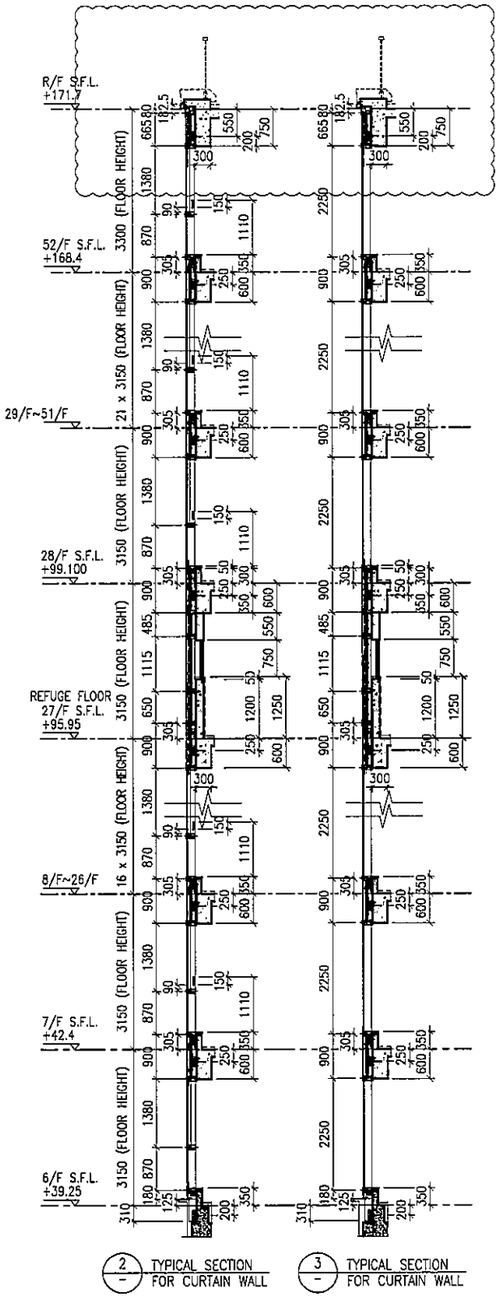

2 TYPICAL SECTION FOR CURTAIN WALL

3 TYPICAL SECTION FOR CURTAIN WALL

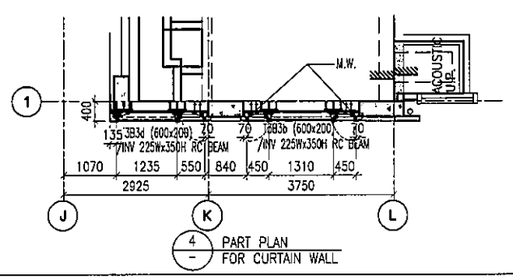

4 PART PLAN FOR CURTAIN WALL

LEGEND:

- 10 mm THK. TEMPERED BLUE TINTED GLASS (OUTER) + 9 mm AIR SPACE + 8 mm THK. TEMPERED CLEAR GLASS (INNER)
- 8 mm THK. HEAT STRENGTHENED TINTED GLASS (OUTER)+ 9 mm AIR SPACE + 8 mm THK. HEAT STRENGTHENED CLEAR GLASS (INNER)
- 10 mm THK. HEAT STRENGTHENED BLUE TINTED GLASS (OUTER)+ 9 mm AIR SPACE + 8 mm THK. TEMPERED CLEAR GLASS (INNER)
- 8 mm THK. HEAT STRENGTHENED BLUE TINTED GLASS (SPANDREL GLASS)
- 8 mm THK. HEAT STRENGTHENED BLUE TINTED GLASS (OUTER)+ 9 mm AIR SPACE + 8 mm THK. TEMPERED CLEAR GLASS (INNER)
- 8 mm THK. TEMPERED BLUE TINTED GLASS (SPANDREL GLASS)
- 8 mm THK. HEAT STRENGTHENED TINTED GLASS (OUTER)+ 1.52PVB + 8 mm THK. HEAT STRENGTHENED CLEAR LAMINATED GLASS (INNER) 10 mm THK. TEMPERED GLASS (INTERNAL PROTECTIVE BARRIER)
- 3 mm THK. ALUM. CLADDING
- M.W. - MAINTENANCE WINDOW
- S.J. - STACK JOINT
- AE01 - ALUM. EXTRUSION DIE NO.
- ▲ - SUPPORT POINT
- ◆ - RESTRAINT SOCKET

B.D. REF :

CLIENT :
信和置業有限公司
Sino Land Company Limited

ARCHITECT :
WONG TUNG & PARTNERS LIMITED
ARCHITECTS & PLANNERS

MAIN CONTRACTOR :
CR Construction Company Limited

STRUCTURAL ENGINEER :
AECOM

FACADE CONSULTANT:
AECOM

NOTE :
1. ALL DIMENSIONS ARE IN mm.
2. ALL ELEVATIONS ARE VIEWED FROM OUTSIDE.
3. ALL DIMENSIONS TO BE VERIFIED ON SITE BEFORE FABRICATION.

LEGEND :
- X1 / X001 — DETAIL MARK NO. / REFER SHEET NO.
1. F.F.L. --FINISHED FLOOR LEVEL
2. S.F.L. --STRUCTURAL FLOOR LEVEL
3. /R --REVERSED DETAIL

NO	DATE	REVISED	BY
F	16/07/2019	GENERAL REVISED	
E	17/01/2019	GENERAL REVISED	
D	22/12/2018	GENERAL REVISED	
C	04/12/2018	GENERAL REVISED	
B	24/11/2018	GENERAL REVISED	
A	10/9/2018	GENERAL REVISED	

JOB NO. : J-837

PROJECT :
URA KWUN TONG TOWN CENTRE REDEVELOPMENT (AREA 2 & 3) AT NKIL 6514, KWUN TONG, KWLOON

TITLE :
PART ELEVATION OF CURTAIN WALL AT TOWER 3

DATE : 04-JUL-18	SCALE : 1:60 (A1)
DRAWN BY : ASING	CHECKED BY : --

美特鋁質有限公司
MIDI ALUMINIUM FABRICATOR LTD.
Units 6-8, Sunray Industrial Centre, 1/F
610 Cha Kwo Ling Road, Kowloon
Tel:23489211-4 Fax:(852)27727666

DWG NO. : J837-CW-2312 REV. : F

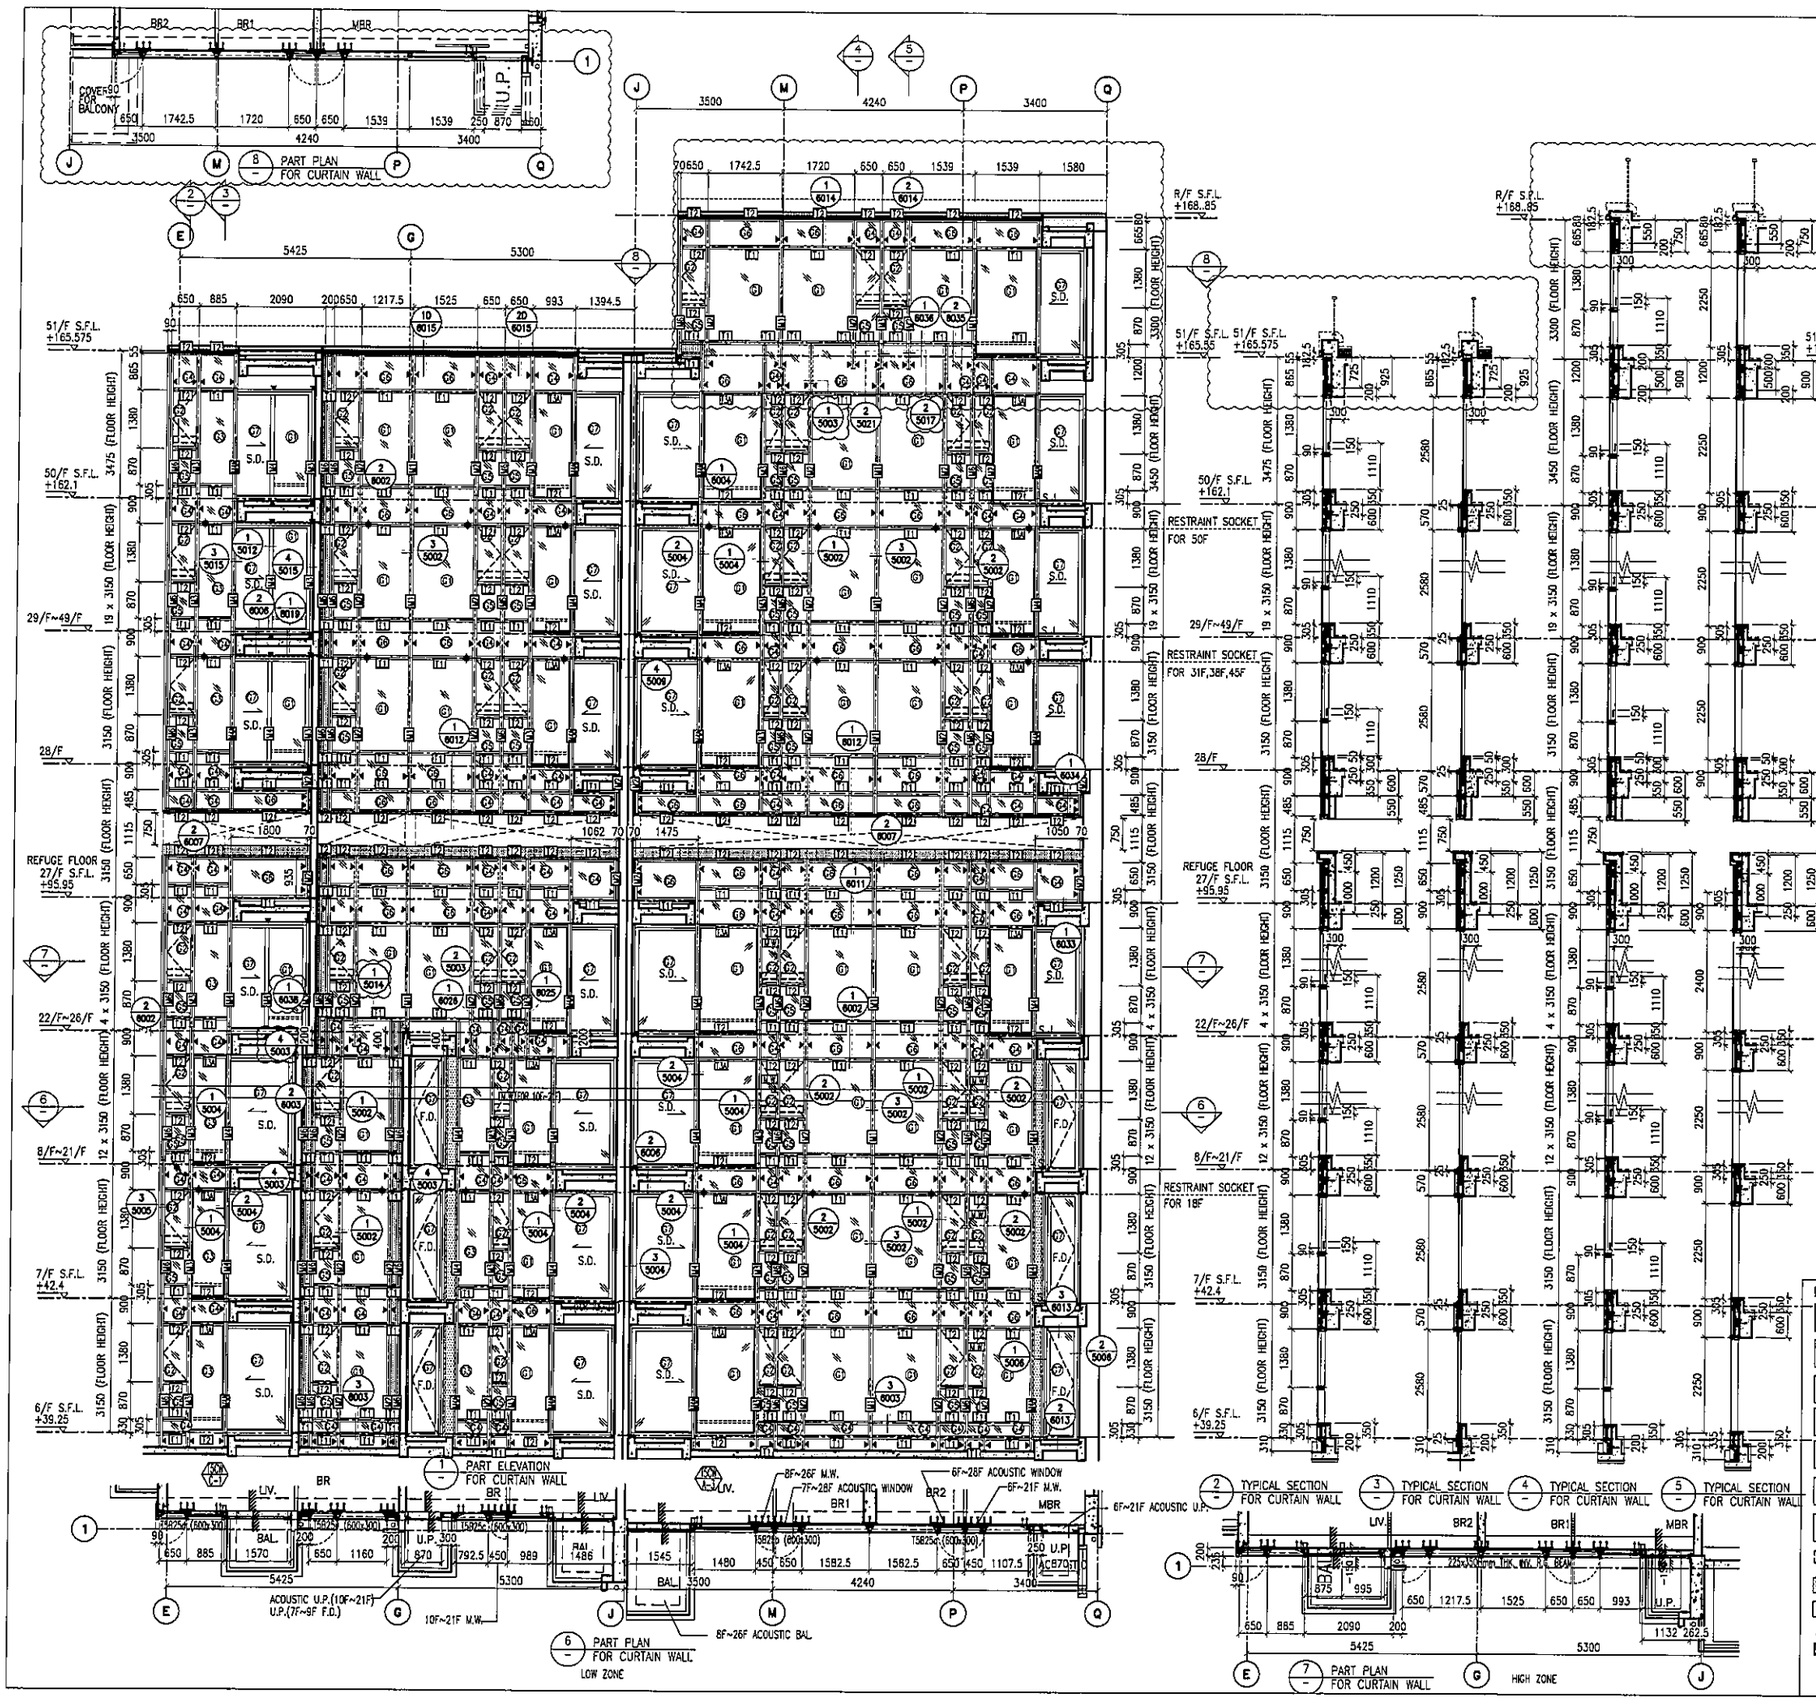

B.D. REF :

CLIENT :
信和置業有限公司
Sino Land Company Limited

ARCHITECT :
WONG TUNG & PARTNERS LIMITED
ARCHITECTS & PLANNERS

MAIN CONTRACTOR :
CR Construction Company Limited

STRUCTURAL ENGINEER :
AECOM

FACADE CONSULTANT:
AECOM

NOTE :
1. ALL DIMENSIONS ARE IN mm.
2. ALL ELEVATIONS ARE VIEWED FROM OUTSIDE.
3. ALL DIMENSIONS TO BE VERIFIED ON SITE BEFORE FABRICATION.

LEGEND :
- X1 / X001 — DETAIL MARK NO. / REFER SHEET NO.
1. F.F.L. --FINISHED FLOOR LEVEL
2. S.F.L. --STRUCTURAL FLOOR LEVEL
3. (/R) --REVERSED DETAIL

NO.	DATE	REVISED	BY
G	16/07/2019	GENERAL REVISED	
F	5/3/2019	GENERAL REVISED	
E	17/01/2019	GENERAL REVISED	
D	22/12/2018	GENERAL REVISED	
C	04/12/2018	GENERAL REVISED	
B	24/11/2018	GENERAL REVISED	
A	10/9/2018	GENERAL REVISED	

LEGEND:
- 10 mm THK. TEMPERED BLUE TINTED GLASS (OUTER) + 9 mm AIR SPACE + 8 mm THK. TEMPERED CLEAR GLASS (INNER)
- 8 mm THK. HEAT STRENGTHENED TINTED GLASS (OUTER)+ 9 mm AIR SPACE + 8 mm THK. HEAT STRENGTHENED CLEAR GLASS (INNER)
- 10 mm THK. HEAT STRENGTHENED BLUE TINTED GLASS (OUTER)+ 9 mm AIR SPACE + 8 mm THK. TEMPERED CLEAR GLASS (INNER)
- 8 mm THK. HEAT STRENGTHENED BLUE TINTED GLASS (SPANDREL GLASS)
- 8 mm THK. HEAT STRENGTHENED BLUE TINTED GLASS (OUTER)+ 9 mm AIR SPACE + 8 mm THK. TEMPERED CLEAR GLASS (INNER)
- 8 mm THK. TEMPERED BLUE TINTED GLASS (SPANDREL GLASS)
- 8 mm THK. HEAT STRENGTHENED TINTED GLASS (OUTER)+ 1.52PVB + 8 mm THK. HEAT STRENGTHENED CLEAR LAMINATED GLASS (INNER)
- 10 mm THK. TEMPERED GLASS (INTERNAL PROTECTIVE BARRIER)
- 3 mm THK. ALUM. CLADDING
- M.W. — MAINTENANCE WINDOW
- S.J. — STACK JOINT
- AE-01 — ALUM. EXTRUSION DIE NO.
- ▲ — SUPPORT POINT
- ◆ — RESTRAINT SOCKET

JOB NO. : J-837

PROJECT :
URA KWUN TONG TOWN CENTRE REDEVELOPMENT (AREA 2 & 3) AT NKIL 6514, KWUN TONG, KWLOON

TITLE :
PART ELEVATION OF CURTAIN WALL AT TOWER 5

DATE : 04-JUL-18 | SCALE : 1:60 (A1)

DRAWN BY : ASING | CHECKED BY : -

美特鋁質有限公司
MIDI ALUMINIUM FABRICATOR LTD.
Units 6-8, Sunray Industrial Centre, 1/F
610 Cha Kwo Ling Road, Kowloon
Tel:23489211-4 Fax:(852)27727666

DWG NO. : J837-CW-2512 | REV. : G

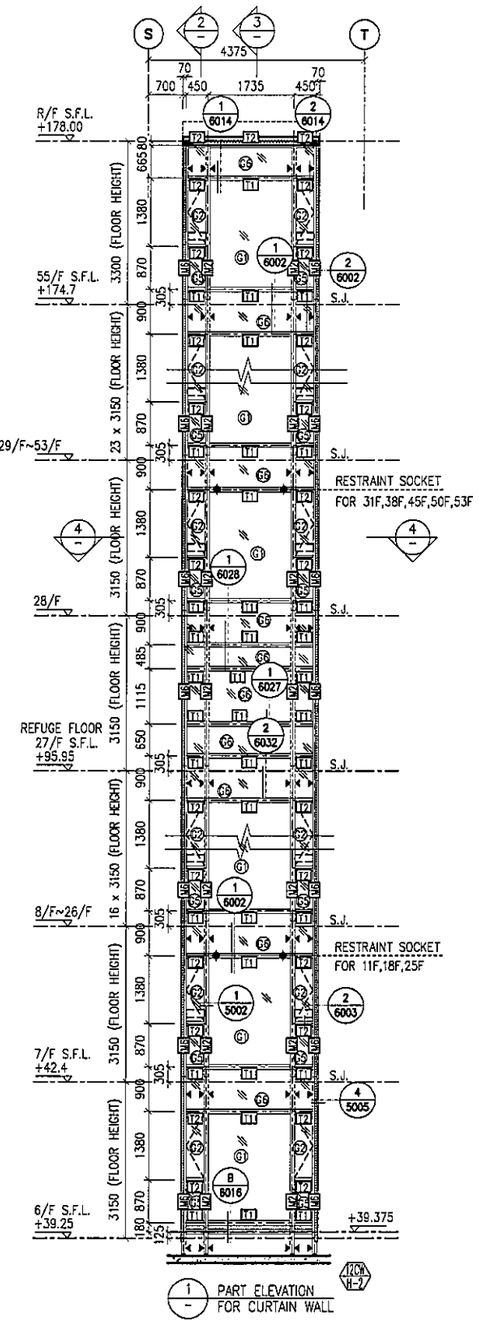

1 / – PART ELEVATION FOR CURTAIN WALL

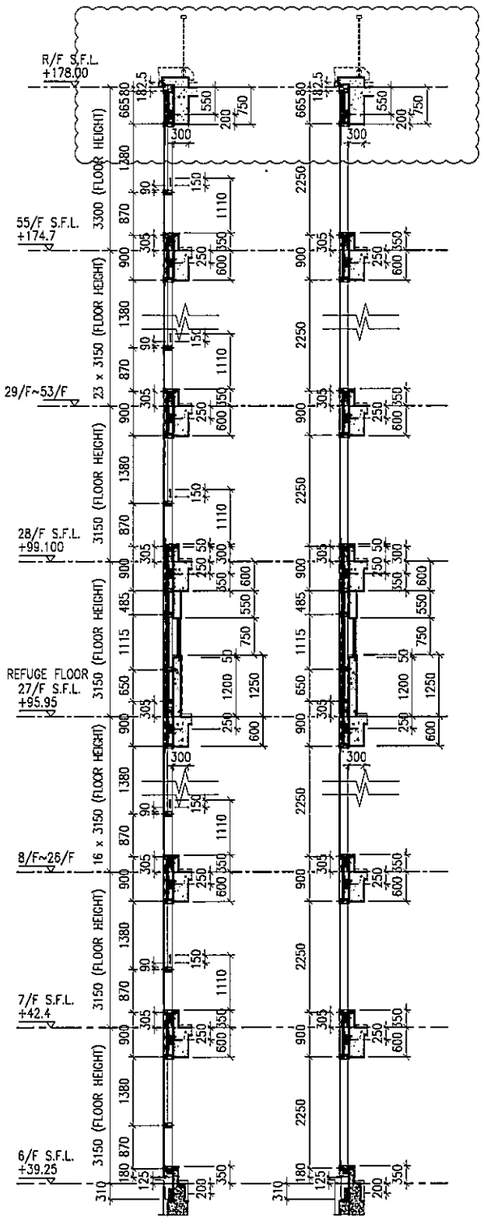

2 / – TYPICAL SECTION FOR CURTAIN WALL

3 / – TYPICAL SECTION FOR CURTAIN WALL

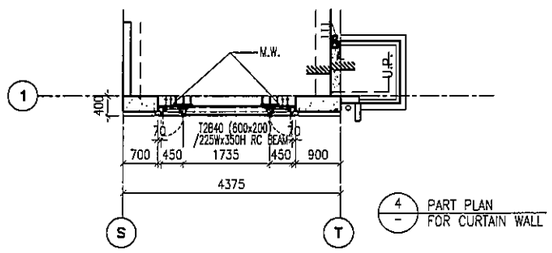

4 / – PART PLAN FOR CURTAIN WALL

LEGEND:

- 10 mm THK. TEMPERED BLUE TINTED GLASS (OUTER) + 9 mm AIR SPACE + 8 mm THK. TEMPERED CLEAR GLASS (INNER)
- 8 mm THK. HEAT STRENGTHENED TINTED GLASS (OUTER)+ 9 mm AIR SPACE + 8 mm THK. HEAT STRENGTHENED CLEAR GLASS (INNER)
- 10 mm THK. HEAT STRENGTHENED BLUE TINTED GLASS (OUTER)+ 9 mm AIR SPACE + 8 mm THK. TEMPERED CLEAR GLASS (INNER)
- 8 mm THK. HEAT STRENGTHENED BLUE TINTED GLASS (SPANDREL GLASS)
- 8 mm THK. HEAT STRENGTHENED BLUE TINTED GLASS (OUTER)+ 9 mm AIR SPACE + 8 mm THK. TEMPERED CLEAR GLASS (INNER)
- 8 mm THK. TEMPERED BLUE TINTED GLASS (SPANDREL GLASS)
- 8 mm THK. HEAT STRENGTHENED TINTED GLASS (OUTER)+ 1.52PVB + 8 mm THK. HEAT STRENGTHENED CLEAR LAMINATED GLASS (INNER) 10 mm THK. TEMPERED GLASS (INTERNAL PROTECTIVE BARRIER)
- 3 mm THK. ALUM. CLADDING
- M.W. – MAINTENANCE WINDOW
- S.J. – STACK JOINT
- AE01 – ALUM. EXTRUSION DIE NO.
- ▲ – SUPPORT POINT
- ◆ – RESTRAINT SOCKET

B.D. REF :

CLIENT :
信和置業有限公司
Sino Land Company Limited

ARCHITECT :
WONG TUNG & PARTNERS LIMITED
ARCHITECTS & PLANNERS

MAIN CONTRACTOR :
CR Construction Company Limited

STRUCTURAL ENGINEER :
AECOM

FACADE CONSULTANT:
AECOM

NOTE :
1. ALL DIMENSIONS ARE IN mm.
2. ALL ELEVATIONS ARE VIEWED FROM OUTSIDE.
3. ALL DIMENSIONS TO BE VERIFIED ON SITE BEFORE FABRICATION.

LEGEND :
X1 / X001 — DETAIL MARK NO. / REFER SHEET NO.

1. F.F.L. --FINISHED FLOOR LEVEL
2. S.F.L. --STRUCTURAL FLOOR LEVEL
3. /R --REVERSED DETAIL

NO.	DATE	REVISED	BY
F	16/07/2019	GENERAL REVISED	
E	17/01/2019	GENERAL REVISED	
D	22/12/2018	GENERAL REVISED	
C	04/12/2018	GENERAL REVISED	
B	24/11/2018	GENERAL REVISED	
A	10/9/2018	GENERAL REVISED	

JOB NO. : J-837

PROJECT :
URA KWUN TONG TOWN CENTRE REDEVELOPMENT (AREA 2 & 3) AT NKIL 6514, KWUN TONG, KWLOON

TITLE :
PART ELEVATION OF CURTAIN WALL AT TOWER 2

DATE : 04-JUL-18 | SCALE : 1:60 (A1)

DRAWN BY : ASING | CHECKED BY : –

美特鋁製有限公司
MIDI ALUMINIUM FABRICATOR LTD.
Units 6-8, Sunray Industrial Centre, 1/F
610 Cha Kwo Ling Road, Kowloon
Tel:23489211-4 Fax:(852)27727666

DWG NO. : J837-CW-2213 | REV. : F

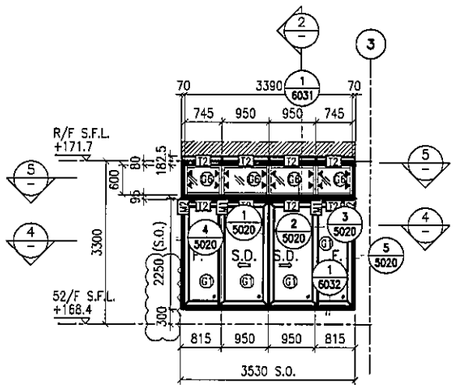

1 PART ELEVATION FOR CURTAIN WALL

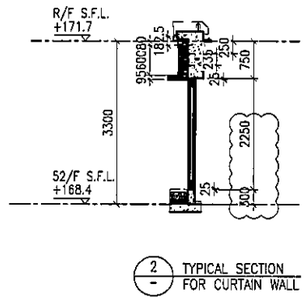

2 TYPICAL SECTION FOR CURTAIN WALL

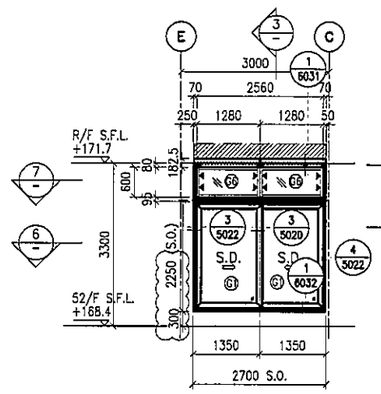

2 PART ELEVATION FOR CURTAIN WALL

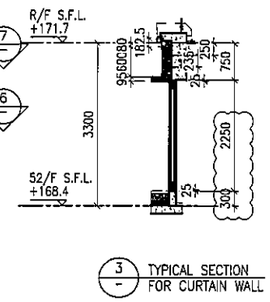

3 TYPICAL SECTION FOR CURTAIN WALL

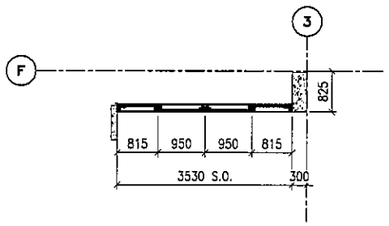

4 PART PLAN FOR CURTAIN WALL

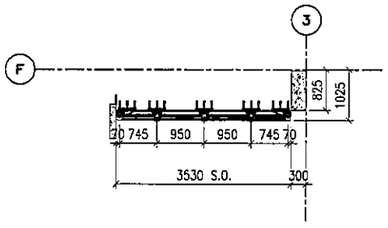

5 PART PLAN FOR CURTAIN WALL

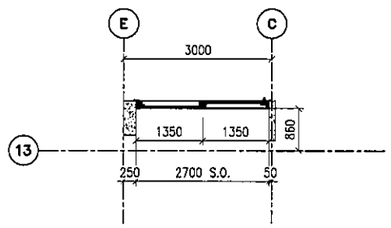

6 PART PLAN FOR CURTAIN WALL

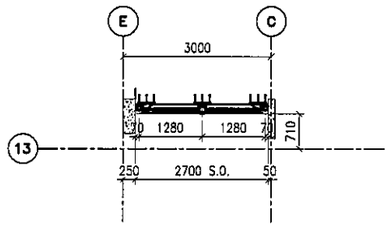

7 PART PLAN FOR CURTAIN WALL

LEGEND:

- 10 mm THK. TEMPERED BLUE TINTED GLASS (OUTER) + 9 mm AIR SPACE + 8 mm THK. TEMPERED CLEAR GLASS (INNER)
- 8 mm THK. HEAT STRENGTHENED TINTED GLASS (OUTER)+ 9 mm AIR SPACE + 8 mm THK. HEAT STRENGTHENED CLEAR GLASS (INNER)
- 10 mm THK. HEAT STRENGTHENED BLUE TINTED GLASS (OUTER)+ 9 mm AIR SPACE + 8 mm THK. TEMPERED CLEAR GLASS (INNER)
- 8 mm THK. HEAT STRENGTHENED BLUE TINTED GLASS (SPANDREL GLASS)
- 8 mm THK. HEAT STRENGTHENED BLUE TINTED GLASS (OUTER)+ 9 mm AIR SPACE + 8 mm THK. TEMPERED CLEAR GLASS (INNER)
- 8 mm THK. TEMPERED BLUE TINTED GLASS (SPANDREL GLASS)
- 8 mm THK. HEAT STRENGTHENED TINTED GLASS (OUTER)+ 1.52PVB + 8 mm THK. HEAT STRENGTHENED CLEAR LAMINATED GLASS (INNER) 10 mm THK. TEMPERED GLASS (INTERNAL PROTECTIVE BARRIER)
- 3 mm THK. ALUM. CLADDING
- M.W. – MAINTENANCE WINDOW
- S.J. – STACK JOINT
- AE-01 – ALUM. EXTRUSION DIE NO.
- ▲ – SUPPORT POINT
- ✦ – RESTRAINT SOCKET

B.D. REF :

CLIENT :
信和置業有限公司
Sino Land Company Limited

ARCHITECT :
WONG TUNG & PARTNERS LIMITED
ARCHITECTS & PLANNERS

MAIN CONTRACTOR :
CR Construction Company Limited

STRUCTURAL ENGINEER :
AECOM

FACADE CONSULTANT:
AECOM

NOTE :
1. ALL DIMENSIONS ARE IN mm.
2. ALL ELEVATIONS ARE VIEWED FROM OUTSIDE.
3. ALL DIMENSIONS TO BE VERIFIED ON SITE BEFORE FABRICATION.

LEGEND :
X1 / X001 — DETAIL MARK NO. / REFER SHEET NO.
1. F.F.L. --FINISHED FLOOR LEVEL
2. S.F.L. --STRUCTURAL FLOOR LEVEL
3. /R --REVERSED DETAIL

NO.	DATE	REVISED	BY

JOB NO. : J-837

PROJECT :
URA KWUN TONG TOWN CENTRE REDEVELOPMENT (AREA 2 & 3) AT NKIL 6514, KWUN TONG, KWLOON

TITLE :
PART ELEVATION OF CURTAIN WALL AT TOWER 3

DATE : 30-JUN-19	SCALE : 1:60 (A1)
DRAWN BY : ASING	CHECKED BY : -

美特鋁質有限公司
MIDI ALUMINIUM FABRICATOR LTD.
Units 6-8, Sunray Industrial Centre, 1/F
610 Cha Kwo Ling Road, Kowloon
Tel:23489211-4 Fax:(852)27727666

DWG NO. : J837-CW-2313 REV. : -

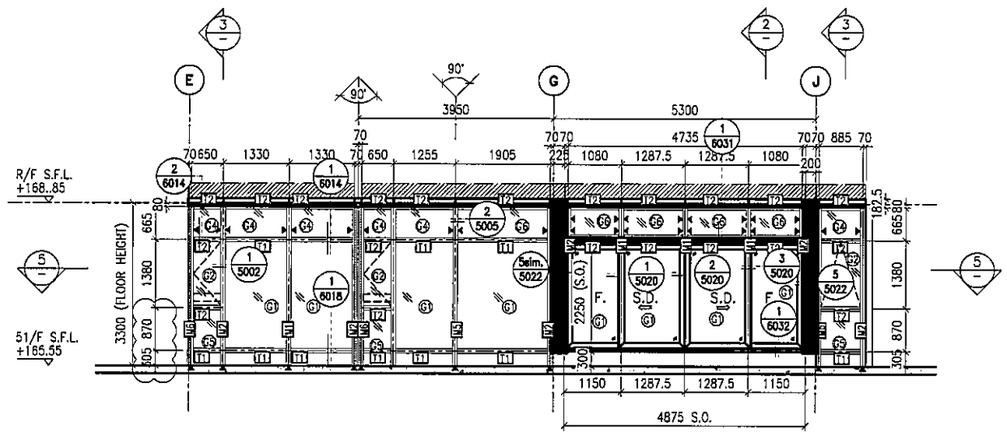

1 PART ELEVATION FOR CURTAIN WALL

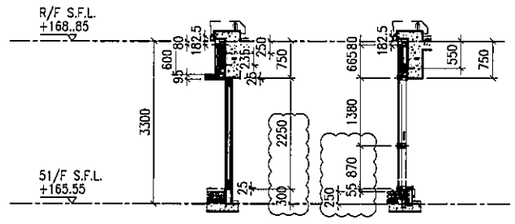

2 TYPICAL SECTION FOR CURTAIN WALL

3 TYPICAL SECTION FOR CURTAIN WALL

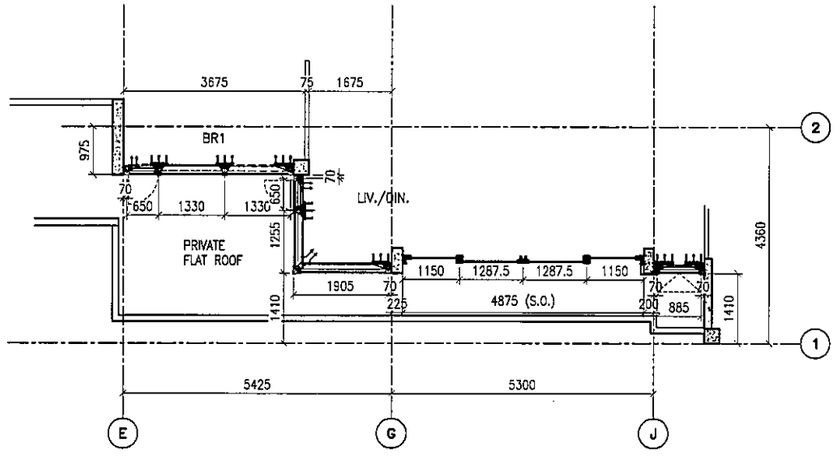

5 PART PLAN FOR CURTAIN WALL

LEGEND:

- G1 – 10 mm THK. TEMPERED BLUE TINTED GLASS (OUTER) + 9 mm AIR SPACE + 8 mm THK. TEMPERED CLEAR GLASS (INNER)
- G2 – 8 mm THK. HEAT STRENGTHENED TINTED GLASS (OUTER)+ 9 mm AIR SPACE + 8 mm THK. HEAT STRENGTHENED CLEAR GLASS (INNER)
- G3 – 10 mm THK. HEAT STRENGTHENED BLUE TINTED GLASS (OUTER)+ 9 mm AIR SPACE + 8 mm THK. TEMPERED CLEAR GLASS (INNER)
- G4 – 8 mm THK. HEAT STRENGTHENED BLUE TINTED GLASS (SPANDREL GLASS)
- G5 – 8 mm THK. HEAT STRENGTHENED BLUE TINTED GLASS (OUTER)+ 9 mm AIR SPACE + 8 mm THK. TEMPERED CLEAR GLASS (INNER)
- G6 – 8 mm THK. TEMPERED BLUE TINTED GLASS (SPANDREL GLASS)
- G7 – 8 mm THK. HEAT STRENGTHENED TINTED GLASS (OUTER)+ 1.52PVB + 8 mm THK. HEAT STRENGTHENED CLEAR LAMINATED GLASS (INNER)
- 10 mm THK. TEMPERED GLASS (INTERNAL PROTECTIVE BARRIER)
- 3 mm THK. ALUM. CLADDING
- M.W. – MAINTENANCE WINDOW
- S.J. – STACK JOINT
- A601 – ALUM. EXTRUSION DIE NO.
- ▲ – SUPPORT POINT
- ◆ – RESTRAINT SOCKET

B.D. REF :

CLIENT :
信和置業有限公司
Sino Land Company Limited

ARCHITECT :
WONG TUNG & PARTNERS LIMITED
ARCHITECTS & PLANNERS

MAIN CONTRACTOR :
CR Construction Company Limited

STRUCTURAL ENGINEER :
AECOM

FACADE CONSULTANT:
AECOM

NOTE :
1. ALL DIMENSIONS ARE IN mm.
2. ALL ELEVATIONS ARE VIEWED FROM OUTSIDE.
3. ALL DIMENSIONS TO BE VERIFIED ON SITE BEFORE FABRICATION.

LEGEND :
- X1 / X001 — DETAIL MARK NO. / REFER SHEET NO.
1. F.F.L. --FINISHED FLOOR LEVEL
2. S.F.L. --STRUCTURAL FLOOR LEVEL
3. /R --REVERSED DETAIL

NO.	DATE	REVISED	BY
C	16/07/2019	GENERAL REVISED	
B	23/05/2019	GENERAL REVISED	
A	07/04/2019	GENERAL REVISED	

JOB NO. : J-837

PROJECT :
URA KWUN TONG TOWN CENTRE REDEVELOPMENT (AREA 2 & 3) AT NKIL 6514, KWUN TONG, KWLOON

TITLE :
PART ELEVATION OF CURTAIN WALL AT TOWER 5

DATE : 22-DEC-18 | SCALE : 1:60 (A1)

DRAWN BY : ASING | CHECKED BY : –

美特鋁質有限公司
MIDI ALUMINIUM FABRICATOR LTD.
Units 6-8, Sunray Industrial Centre, 1/F
610 Cha Kwo Ling Road, Kowloon
Tel:23489211-4 Fax:(852)27727666

DWG NO. : J837-CW-2513 | REV. : C

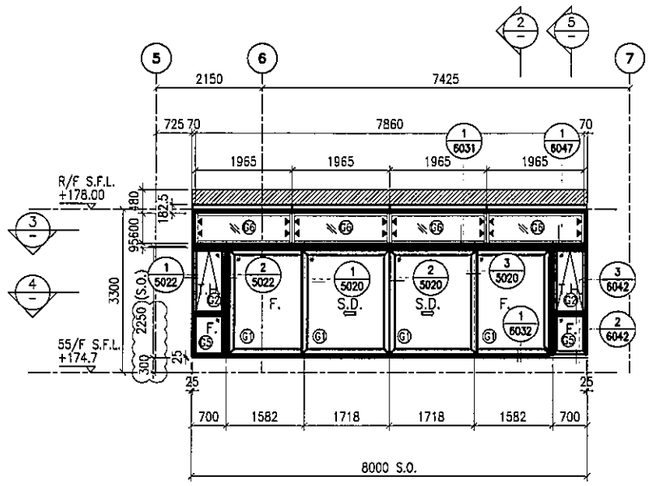

1 / – PART ELEVATION FOR CURTAIN WALL

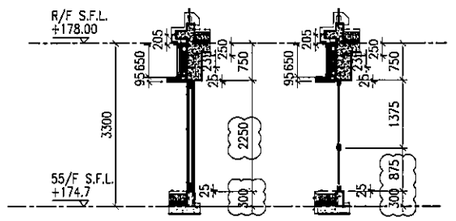

2 / – TYPICAL SECTION FOR CURTAIN WALL

5 / – TYPICAL SECTION FOR CURTAIN WALL

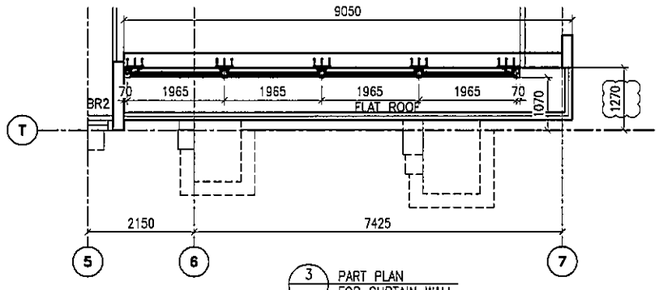

3 / – PART PLAN FOR CURTAIN WALL

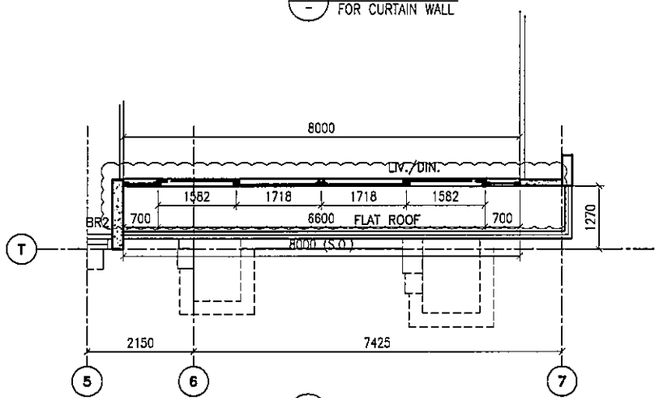

4 / – PART PLAN FOR CURTAIN WALL

LEGEND:

- 10 mm THK. TEMPERED BLUE TINTED GLASS (OUTER) + 9 mm AIR SPACE + 8 mm THK. TEMPERED CLEAR GLASS (INNER)
- 8 mm THK. HEAT STRENGTHENED TINTED GLASS (OUTER)+ 9 mm AIR SPACE + 8 mm THK. HEAT STRENGTHENED CLEAR GLASS (INNER)
- 10 mm THK. HEAT STRENGTHENED BLUE TINTED GLASS (OUTER)+ 9 mm AIR SPACE + 8 mm THK. TEMPERED CLEAR GLASS (INNER)
- 8 mm THK. HEAT STRENGTHENED BLUE TINTED GLASS (SPANDREL GLASS)
- 8 mm THK. HEAT STRENGTHENED BLUE TINTED GLASS (OUTER)+ 9 mm AIR SPACE + 8 mm THK. TEMPERED CLEAR GLASS (INNER)
- 8 mm THK. TEMPERED BLUE TINTED GLASS (SPANDREL GLASS)
- 8 mm THK. HEAT STRENGTHENED TINTED GLASS (OUTER)+ 1.52PVB + 8 mm THK. HEAT STRENGTHENED CLEAR LAMINATED GLASS (INNER)
- 10 mm THK. TEMPERED GLASS (INTERNAL PROTECTIVE BARRIER)
- 3 mm THK. ALUM. CLADDING
- M.W. – MAINTENANCE WINDOW
- S.J. – STACK JOINT
- AE01 – ALUM. EXTRUSION DIE NO.
- ▲ – SUPPORT POINT
- ✦ – RESTRAINT SOCKET

B.D. REF :

CLIENT :
信和置業有限公司
Sino Land Company Limited

ARCHITECT : WONG TUNG & PARTNERS LIMITED
ARCHITECTS & PLANNERS

MAIN CONTRACTOR :
CR Construction Company Limited

STRUCTURAL ENGINEER :
AECOM

FACADE CONSULTANT:
AECOM

NOTE :
1. ALL DIMENSIONS ARE IN mm.
2. ALL ELEVATIONS ARE VIEWED FROM OUTSIDE.
3. ALL DIMENSIONS TO BE VERIFIED ON SITE BEFORE FABRICATION.

LEGEND :
X1 / X001 — DETAIL MARK NO. / REFER SHEET NO.
1. F.F.L. --FINISHED FLOOR LEVEL
2. S.F.L. --STRUCTURAL FLOOR LEVEL
3. /R --REVERSED DETAIL

NO.	DATE	REVISED	BY
C	16/07/2019	GENERAL REVISED	
B	26/05/2019	GENERAL REVISED	
A	16/05/2019	GENERAL REVISED	

JOB NO. : J-837

PROJECT :
URA KWUN TONG TOWN CENTRE REDEVELOPMENT (AREA 2 & 3) AT NKIL 6514, KWUN TONG, KWLOON

TITLE :
PART ELEVATION OF CURTAIN WALL AT TOWER 2

DATE : 18-FEB-19 | SCALE : 1:60 (A1)

DRAWN BY : ASING | CHECKED BY : –

美特鋁質有限公司
MIDI ALUMINIUM FABRICATOR LTD.
Units 6-8, Sunray Industrial Centre, 1/F
610 Cha Kwo Ling Road, Kowloon
Tel:23489211-4 Fax:(852)27727666

DWG NO. : J837-CW-2214 | REV. : C

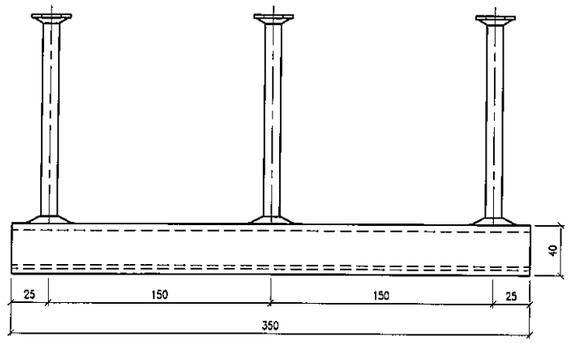

SECTION 'A-A'
HILTI CHANNEL HAC-70

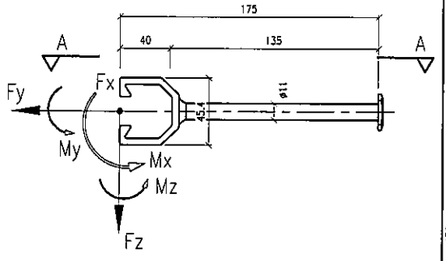

MAX. UNFACTORED LOAD:

	WL	DL
Fx (kN)	0	0
Fy (kN)	23.5	0
Fz (kN)	0	3.5
Mx (kNm)	0.6	0.6
My (kNm)	0	0
Mz (kNm)	0	0

EMBED TYPE : E01

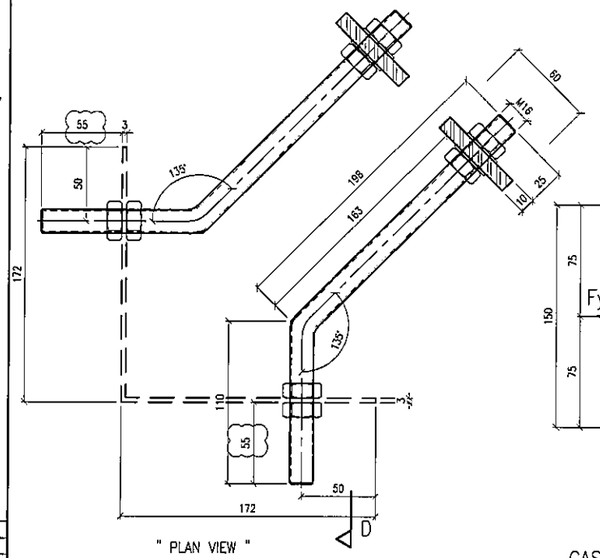

" PLAN VIEW "

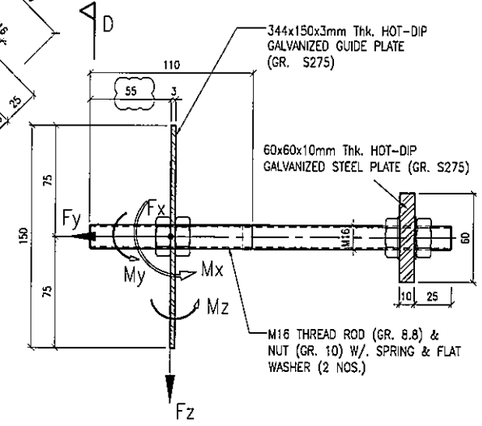

SECTION 'D-D'
CAST-IN HOLDING DOWN BOLT

MAX. UNFACTORED LOAD:

	WL	DL
Fx (kN)	6.76	0
Fy (kN)	6.76	0
Fz (kN)	0	1.75
Mx (kNm)	0	0
My (kNm)	0	0
Mz (kNm)	0	0

EMBED TYPE : E04

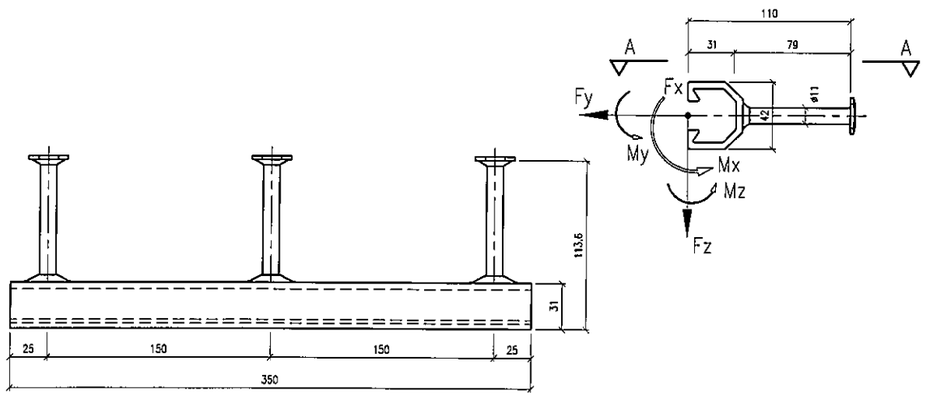

SECTION 'A-A'
HILTI CHANNEL HAC-50

MAX. UNFACTORED LOAD:

	WL	DL
Fx (kN)		
Fy (kN)		
Fz (kN)		
Mx (kNm)		
My (kNm)		
Mz (kNm)		

EMBED TYPE : E02

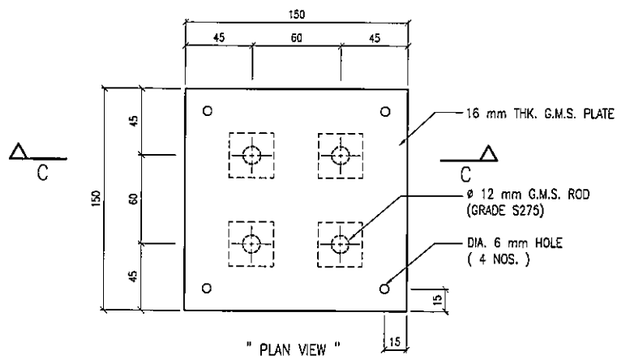

" PLAN VIEW "

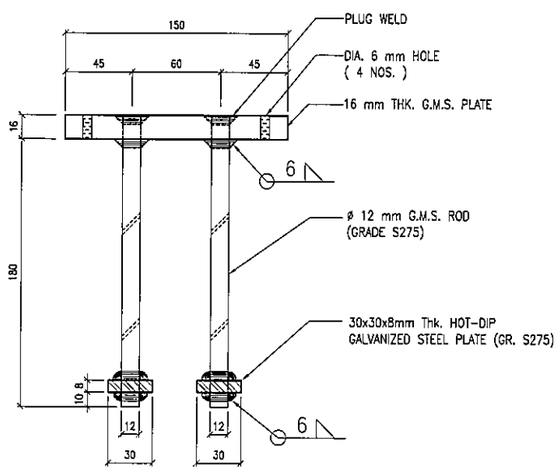

SECTION 'C-C'

" CAST IN EMBED DETAILED DIMENSION "

EMBED TYPE : E03

B.D. REF :

CLIENT :
信和置業有限公司
Sino Land Company Limited

ARCHITECT :
WONG TUNG & PARTNERS LIMITED
ARCHITECTS & PLANNERS

MAIN CONTRACTOR :
CR Construction Company Limited

STRUCTURAL ENGINEER :
AECOM

FACADE CONSULTANT:
AECOM

NOTE :
1. ALL DIMENSIONS ARE IN mm.
2. ALL ELEVATIONS ARE VIEWED FROM OUTSIDE.
3. ALL DIMENSIONS TO BE VERIFIED ON SITE BEFORE FABRICATION.

LEGEND :
X1 / X001 — DETAIL MARK NO. / REFER SHEET NO.
1. F.F.L. --FINISHED FLOOR LEVEL
2. S.F.L. --STRUCTURAL FLOOR LEVEL
3. /R --REVERSED DETAIL

NO.	DATE	REVISED	BY
A	10/9/2018	GENERAL REVISED	

JOB NO. : J-837

PROJECT :
URA KWUN TONG TOWN CENTRE REDEVELOPMENT (AREA 2 & 3) AT NKIL 6514, KWUN TONG, KWLOON

TITLE :
CAST IN CHANNEL & EMBED TYPICAL DETAILS FOR CURTAIN WALL

DATE : 04-JUL-18 | SCALE : 1:2 (A1)

DRAWN BY : ASING | CHECKED BY : -

美特鋁製有限公司
MIDI ALUMINIUM FABRICATOR LTD.
Units 6-8, Sunray Industrial Centre, 1/F
610 Cha Kwo Ling Road, Kowloon
Tel:23489211-4 Fax:(852)27727666

DWG NO. : J837-CW-ED01 | REV. : A

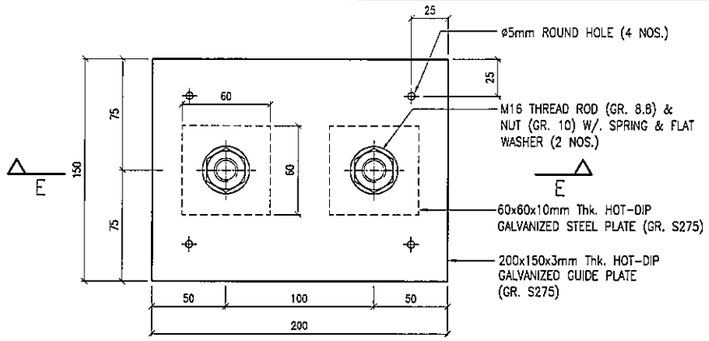

" PLAN VIEW "

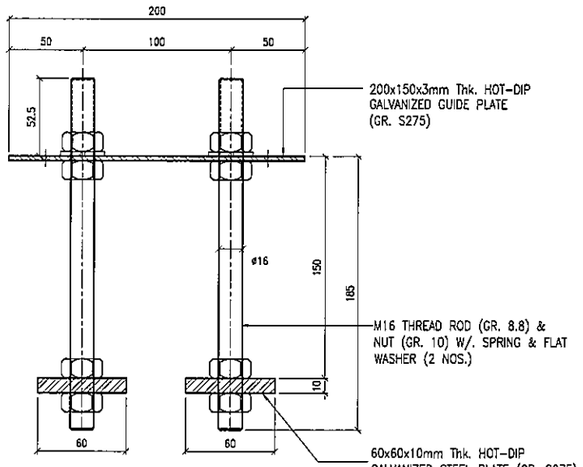

SECTION 'E-E'

CAST-IN HOLDING DOWN BOLT

EMBED TYPE : E05

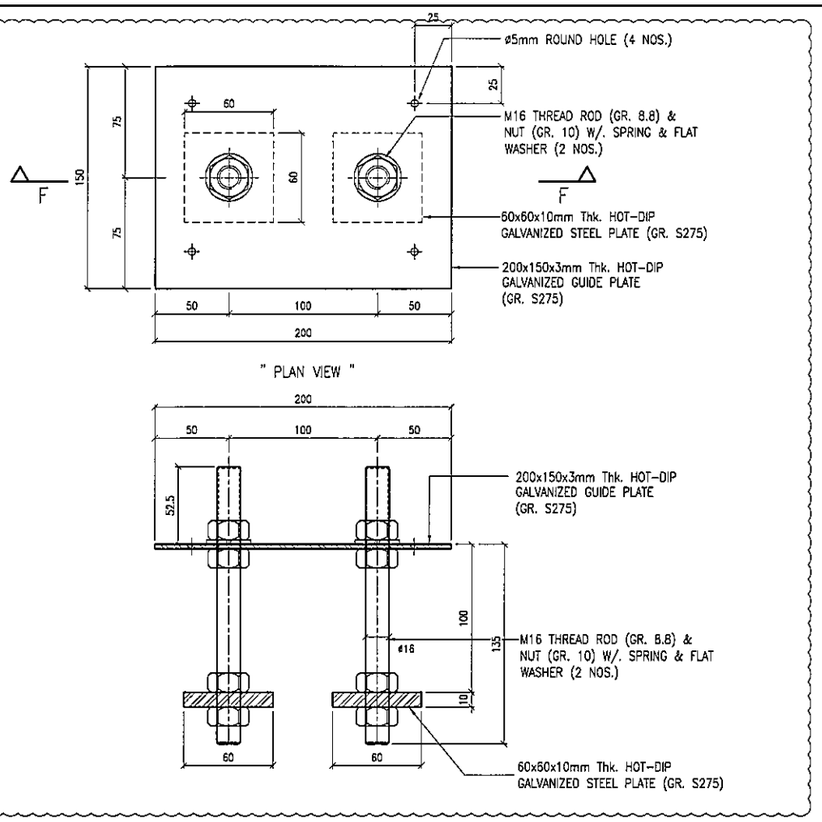

" PLAN VIEW "

SECTION 'F-F'

CAST-IN HOLDING DOWN BOLT

EMBED TYPE : E06

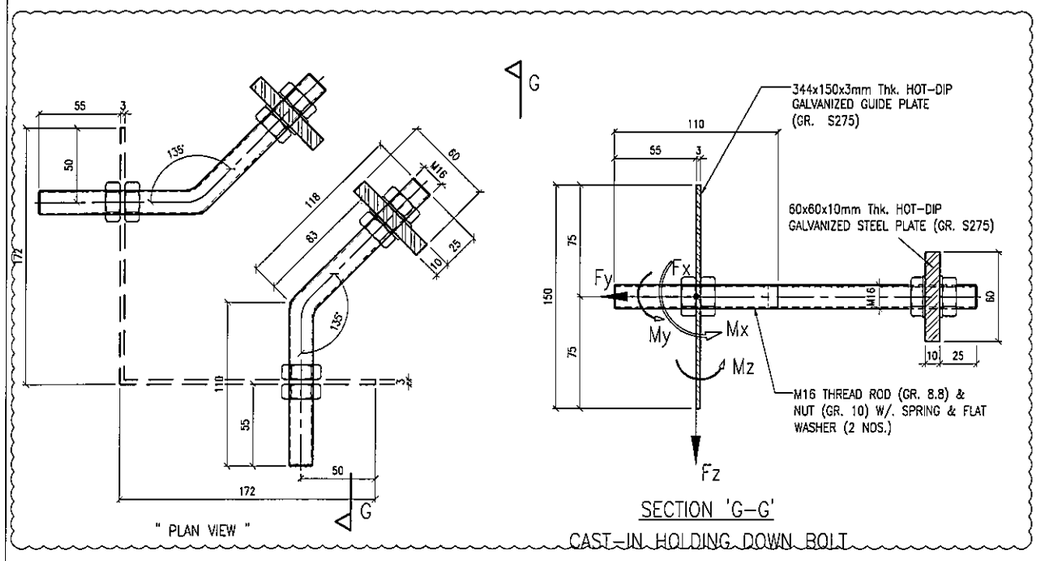

SECTION 'G-G'

CAST-IN HOLDING DOWN BOLT

EMBED TYPE : E07

B.D. REF :

CLIENT :
信和置業有限公司
Sino Land Company Limited

ARCHITECT :
WONG TUNG & PARTNERS LIMITED
ARCHITECTS & PLANNERS

MAIN CONTRACTOR :
CR Construction Company Limited

STRUCTURAL ENGINEER :
AECOM

FACADE CONSULTANT:
AECOM

NOTE :
1. ALL DIMENSIONS ARE IN mm.
2. ALL ELEVATIONS ARE VIEWED FROM OUTSIDE.
3. ALL DIMENSIONS TO BE VERIFIED ON SITE BEFORE FABRICATION.

LEGEND :
X1 — DETAIL MARK NO.
X001 — REFER SHEET NO.

1. F.F.L. --FINISHED FLOOR LEVEL
2. S.F.L. --STRUCTURAL FLOOR LEVEL
3. (/R) --REVERSED DETAIL

NO.	DATE	REVISED	BY
A	10/9/2018	GENERAL REVISED	

JOB NO. : J-837

PROJECT :
URA KWUN TONG TOWN CENTRE
REDEVELOPMENT (AREA 2 & 3) AT
NKIL 6514, KWUN TONG, KWLOON

TITLE :
CAST IN CHANNEL &
EMBED TYPICAL DETAILS
FOR CURTAIN WALL

DATE : 04-JUL-18 | SCALE : 1:2 (A1)

DRAWN BY : ASING | CHECKED BY : -

美特鋁質有限公司
MIDI ALUMINIUM FABRICATOR LTD.
Units 6-8, Sunray Industrial Centre, 1/F
610 Cha Kwo Ling Road, Kowloon
Tel:23489211-4 Fax:(852)27727666

DWG NO. : J837-CW-ED02 | REV. : A

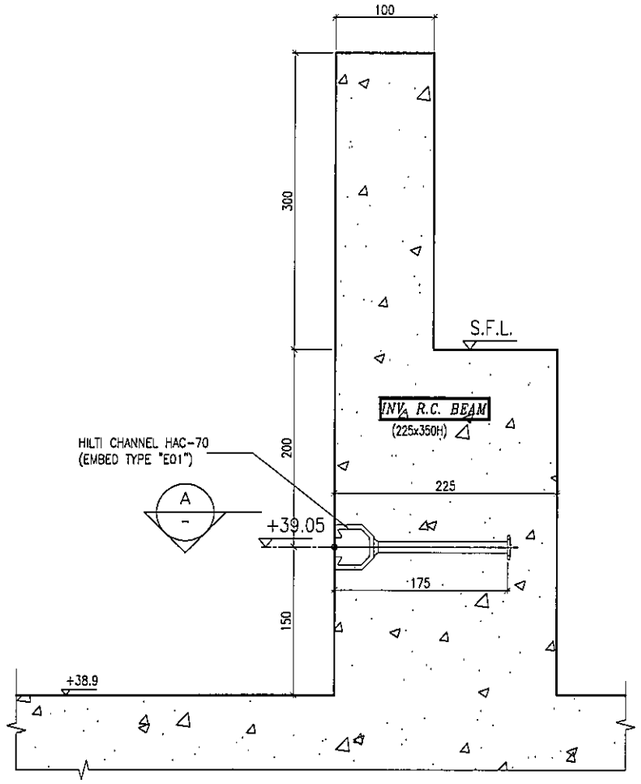

S01 EMBED INSTALLATION DETAIL
SECTION TYPE "S01"

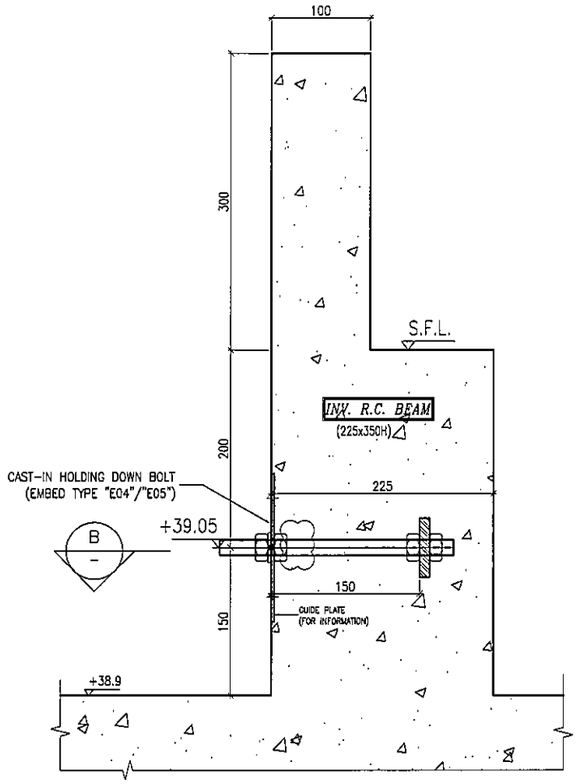

S02 EMBED INSTALLATION DETAIL
SECTION TYPE "S02"

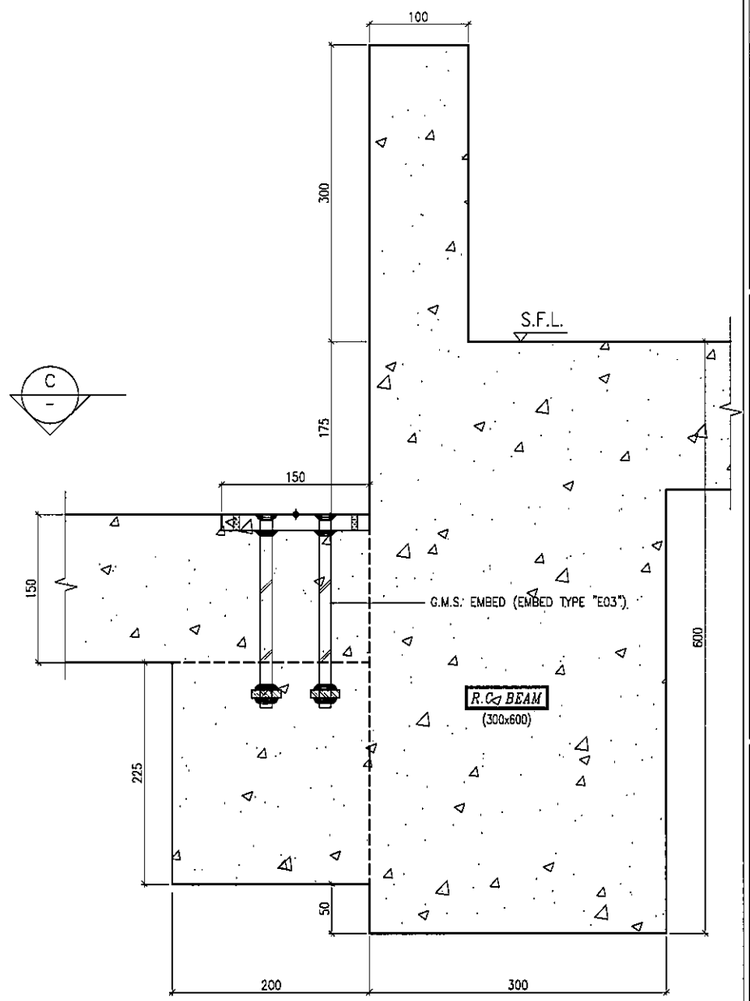

S03 EMBED INSTALLATION DETAIL
SECTION TYPE "S03"

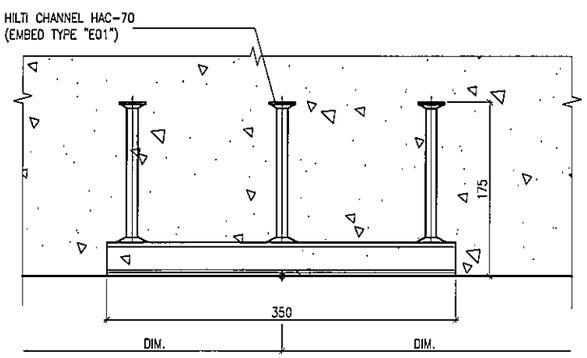

SECTION 'A'

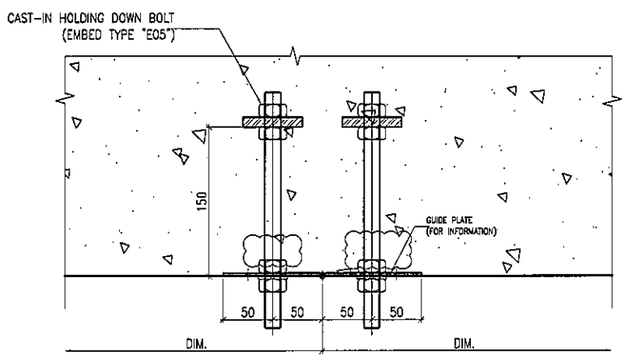

SECTION 'B'

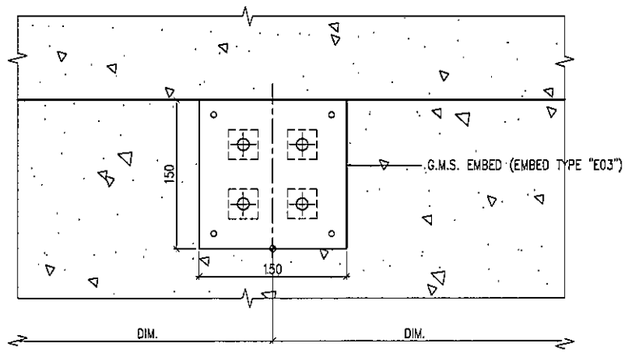

SECTION 'C'

B.O. REF :

CLIENT :
信和置業有限公司
Sino Land Company Limited

ARCHITECT :
WONG TUNG & PARTNERS LIMITED
ARCHITECTS & PLANNERS

MAIN CONTRACTOR :
CR Construction Company Limited

STRUCTURAL ENGINEER :
AECOM

FACADE CONSULTANT:
AECOM

NOTE :
1. ALL DIMENSIONS ARE IN mm.
2. ALL ELEVATIONS ARE VIEWED FROM OUTSIDE.
3. ALL DIMENSIONS TO BE VERIFIED ON SITE BEFORE FABRICATION.

LEGEND :
X1 — DETAIL MARK NO.
X001 — REFER SHEET NO.
1. F.F.L. --FINISHED FLOOR LEVEL
2. S.F.L. --STRUCTURAL FLOOR LEVEL
3. /R --REVERSED DETAIL

NO.	DATE	REVISED	BY
B	24/11/2018	GENERAL REVISED	
A	10/9/2018	GENERAL REVISED	

JOB NO. : J-837

PROJECT :
URA KWUN TONG TOWN CENTRE
REDEVELOPMENT (AREA 2 & 3) AT
NKIL 6514, KWUN TONG, KWLOON

TITLE :
EMBED TYPICAL DETAILS
FOR CURTAIN WALL

DATE : 13-JUL-18 | SCALE : 1:3 (A1)

DRAWN BY : Asing | CHECKED BY : -

美特鋁質有限公司
MIDI ALUMINIUM FABRICATOR LTD.
Units 6-8, Sunray Industrial Centre, 1/F
610 Cha Kwo Ling Road, Kowloon
Tel:23489211-4 Fax:(852)27727666

DWG NO. : J837-CW-ED03 | REV. : B

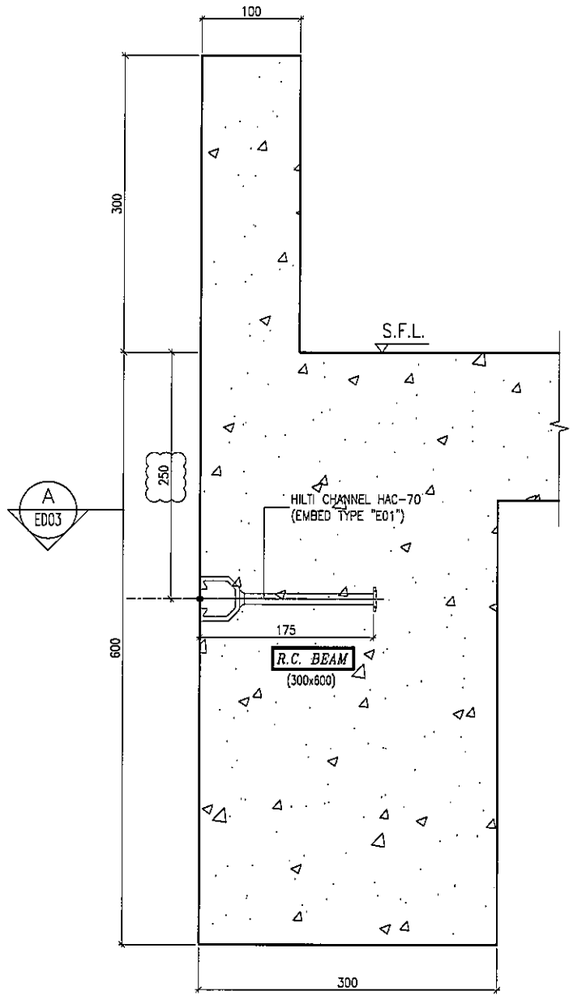

S04 EMBED INSTALLATION DETAIL
– SECTION TYPE "S04"

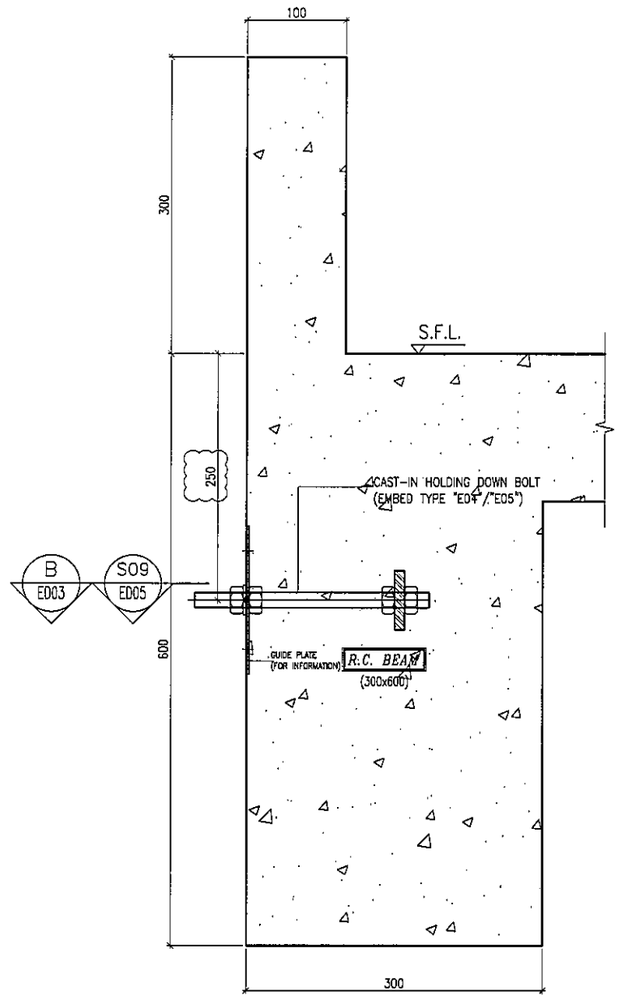

S05 EMBED INSTALLATION DETAIL
– SECTION TYPE "S05"

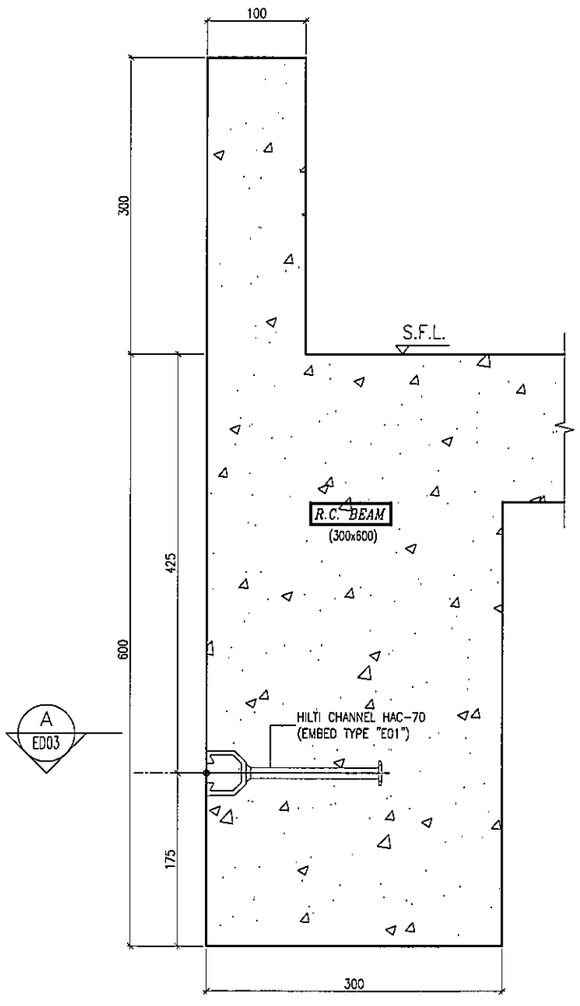

S06 EMBED INSTALLATION DETAIL
– SECTION TYPE "S06"

B.D. REF :

CLIENT :
信和置業有限公司
Sino Land Company Limited

ARCHITECT :
WONG TUNG & PARTNERS LIMITED
ARCHITECTS & PLANNERS

MAIN CONTRACTOR :
CR Construction Company Limited

STRUCTURAL ENGINEER :
AECOM

FACADE CONSULTANT:
AECOM

NOTE :
1. ALL DIMENSIONS ARE IN mm.
2. ALL ELEVATIONS ARE VIEWED FROM OUTSIDE.
3. ALL DIMENSIONS TO BE VERIFIED ON SITE BEFORE FABRICATION.

LEGEND :
X1 / X001 — DETAIL MARK NO. / REFER SHEET NO.
1. F.F.L. --FINISHED FLOOR LEVEL
2. S.F.L. --STRUCTURAL FLOOR LEVEL
3. /R --REVERSED DETAIL

NO.	DATE	REVISED	BY
B	04/12/2018	GENERAL REVISED	
A	24/11/2018	GENERAL REVISED	

JOB NO. : J-837

PROJECT :
URA KWUN TONG TOWN CENTRE
REDEVELOPMENT (AREA 2 & 3) AT
NKIL 6514, KWUN TONG, KWLOON

TITLE :
EMBED TYPICAL DETAILS
FOR CURTAIN WALL

DATE : 13-JUL-18 | SCALE : 1:3 (A1)

DRAWN BY : Asing | CHECKED BY : –

美特鋁質有限公司
MIDI ALUMINIUM FABRICATOR LTD.
Units 6-8, Sunray Industrial Centre, 1/F
610 Cha Kwo Ling Road, Kowloon
Tel:23489211-4 Fax:(852)27727666

DWG NO. : J837-CW-ED04 | REV. : B

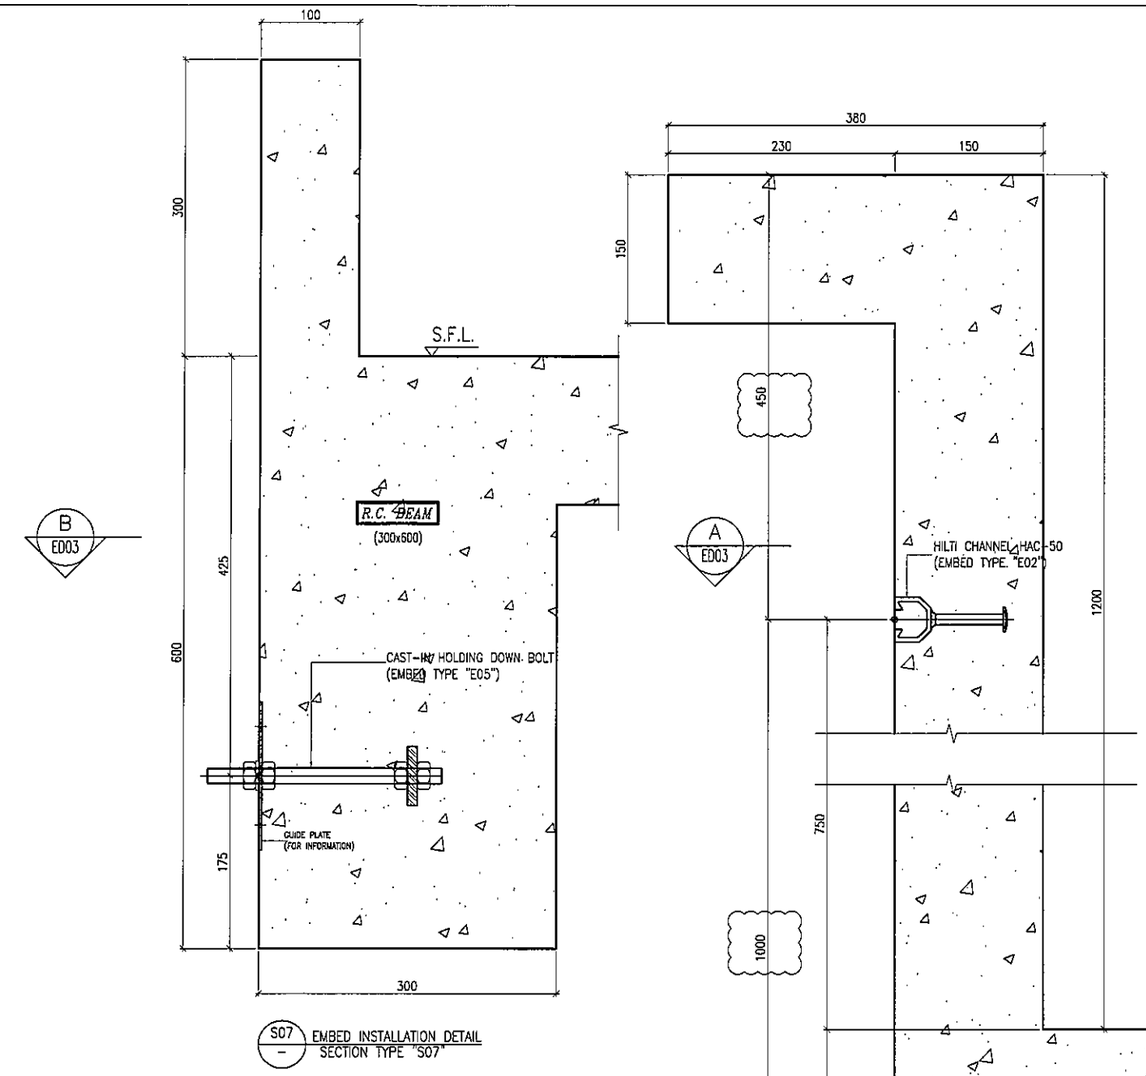

S07 EMBED INSTALLATION DETAIL
– SECTION TYPE "S07"

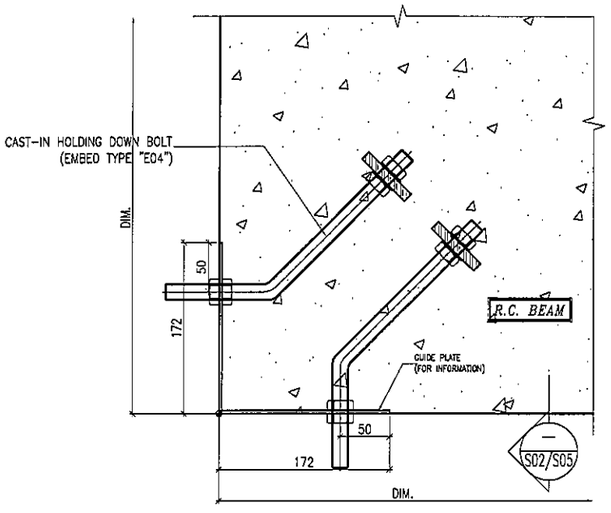

S09 EMBED INSTALLATION DETAIL
– SECTION TYPE "S09"

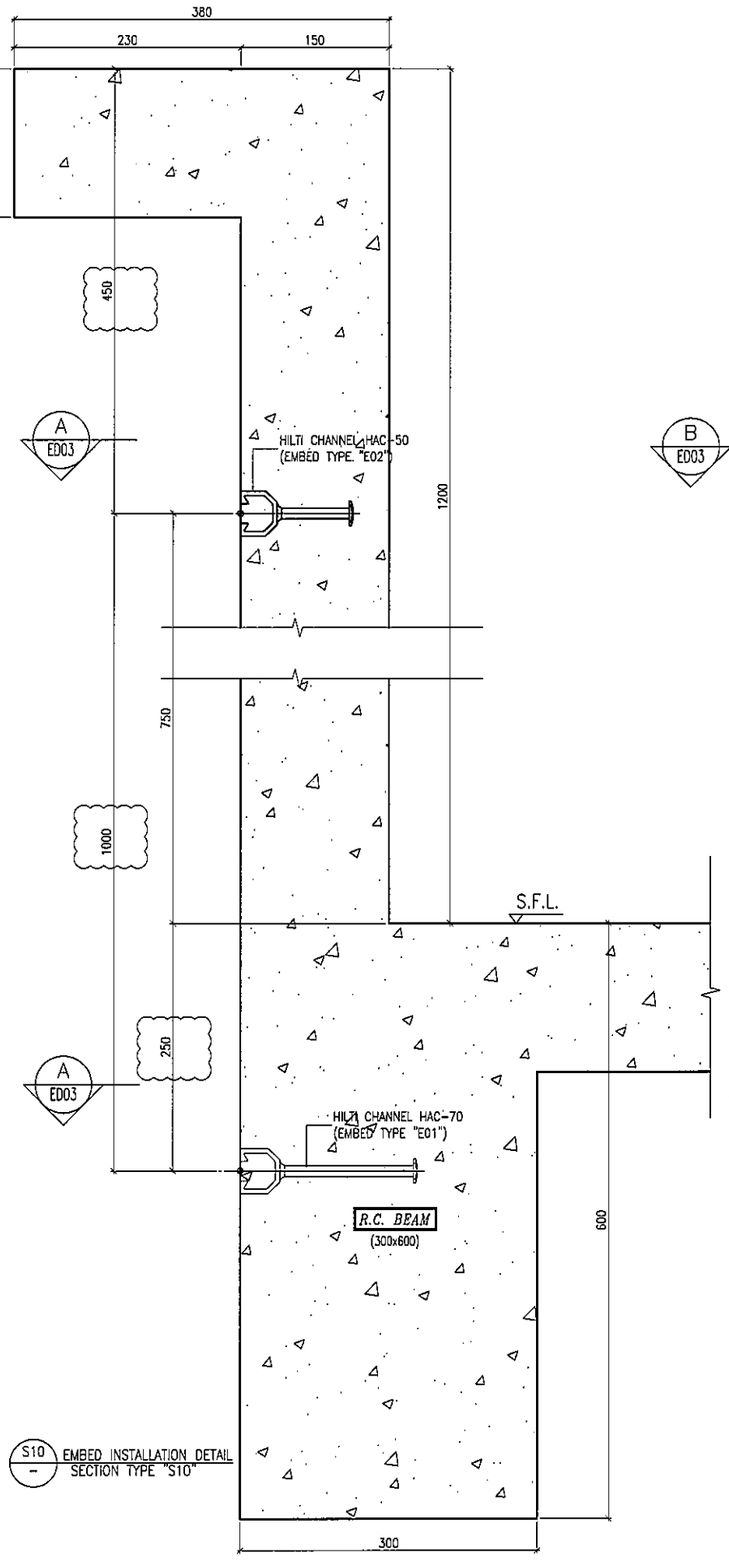

S10 EMBED INSTALLATION DETAIL
– SECTION TYPE "S10"

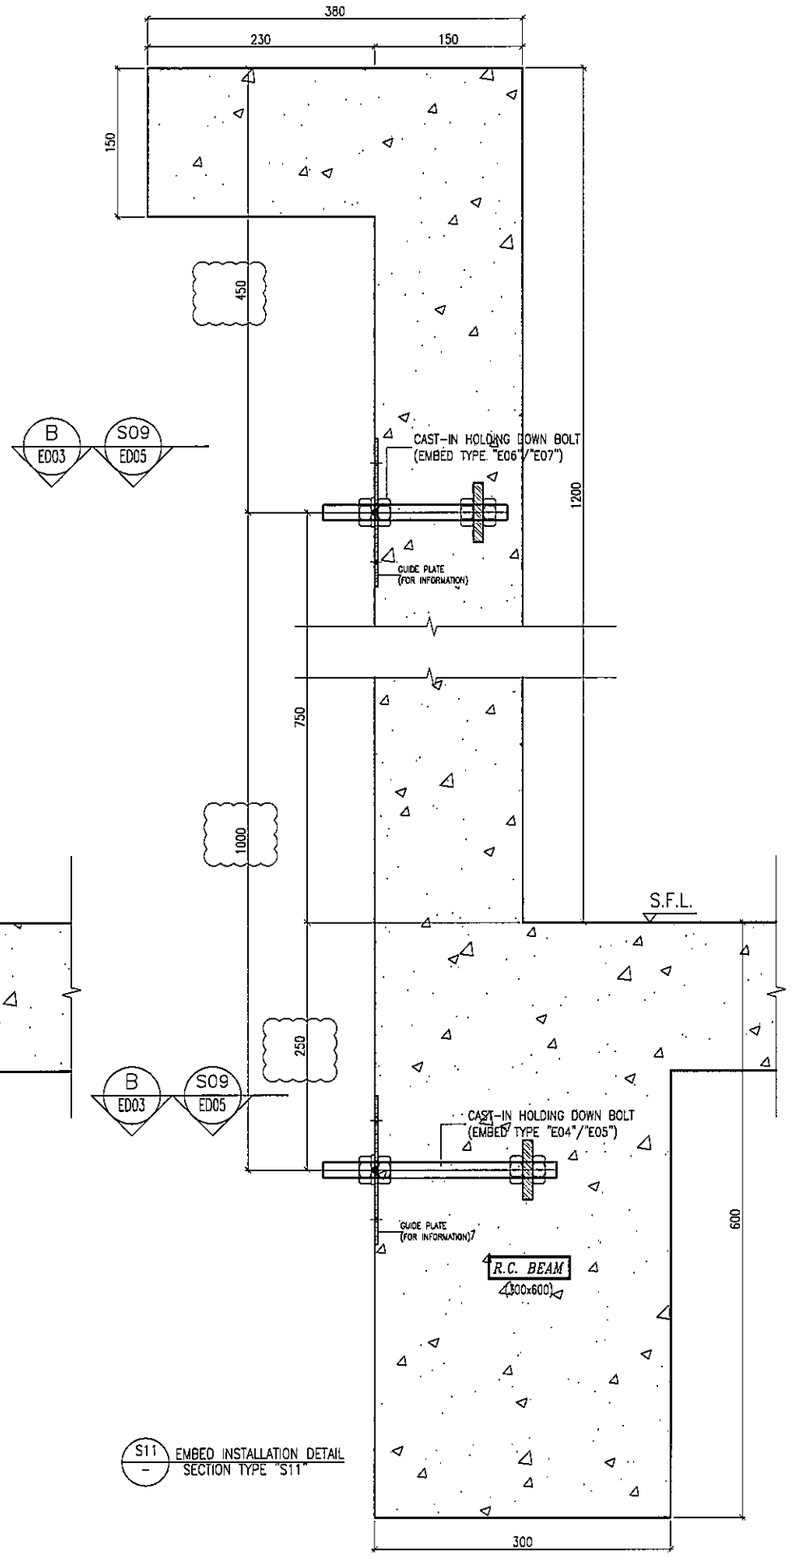

S11 EMBED INSTALLATION DETAIL
– SECTION TYPE "S11"

B.D. REF :

CLIENT :
信和置業有限公司
Sino Land Company Limited

ARCHITECT :
WONG TUNG & PARTNERS LIMITED
ARCHITECTS & PLANNERS

MAIN CONTRACTOR :
CR Construction Company Limited

STRUCTURAL ENGINEER :
AECOM

FACADE CONSULTANT:
AECOM

NOTE :
1. ALL DIMENSIONS ARE IN mm.
2. ALL ELEVATIONS ARE VIEWED FROM OUTSIDE.
3. ALL DIMENSIONS TO BE VERIFIED ON SITE BEFORE FABRICATION.

LEGEND :
X1 — DETAIL MARK NO.
X001 — REFER SHEET NO.

1. F.F.L. --FINISHED FLOOR LEVEL
2. S.F.L. --STRUCTURAL FLOOR LEVEL
3. /R --REVERSED DETAIL

NO.	DATE	REVISED	BY
D	09/01/2019	GENERAL REVISED	
C	22/12/2018	GENERAL REVISED	
B	24/11/2018	GENERAL REVISED	
A	10/9/2018	GENERAL REVISED	

JOB NO. : J-837

PROJECT :
URA KWUN TONG TOWN CENTRE REDEVELOPMENT (AREA 2 & 3) AT NKIL 6514, KWUN TONG, KWLOON

TITLE :
EMBED TYPICAL DETAILS FOR CURTAIN WALL

DATE : 13-JUL-18 | SCALE : 1:3 (A1)

DRAWN BY : Asing | CHECKED BY : –

美特鋁質有限公司
MIDI ALUMINIUM FABRICATOR LTD.
Units 6-8, Sunray Industrial Centre, 1/F
610 Cha Kwo Ling Road, Kowloon
Tel:23489211-4 Fax:(852)27727666

DWG NO. : J837-CW-ED05 | REV. : D

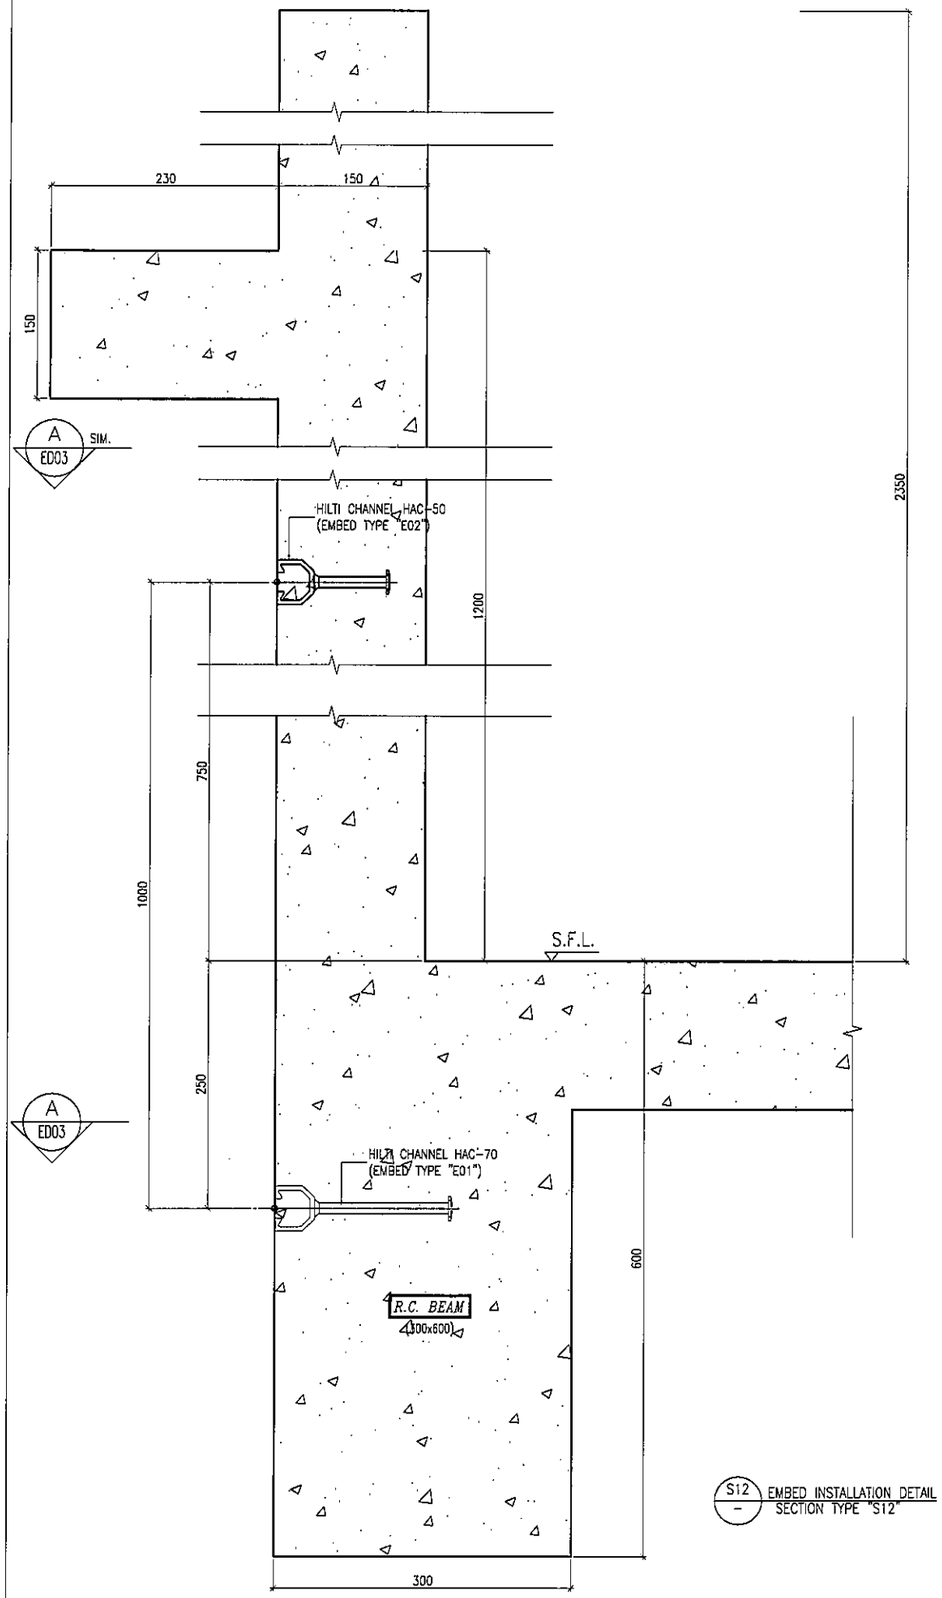

S12 — EMBED INSTALLATION DETAIL SECTION TYPE "S12"

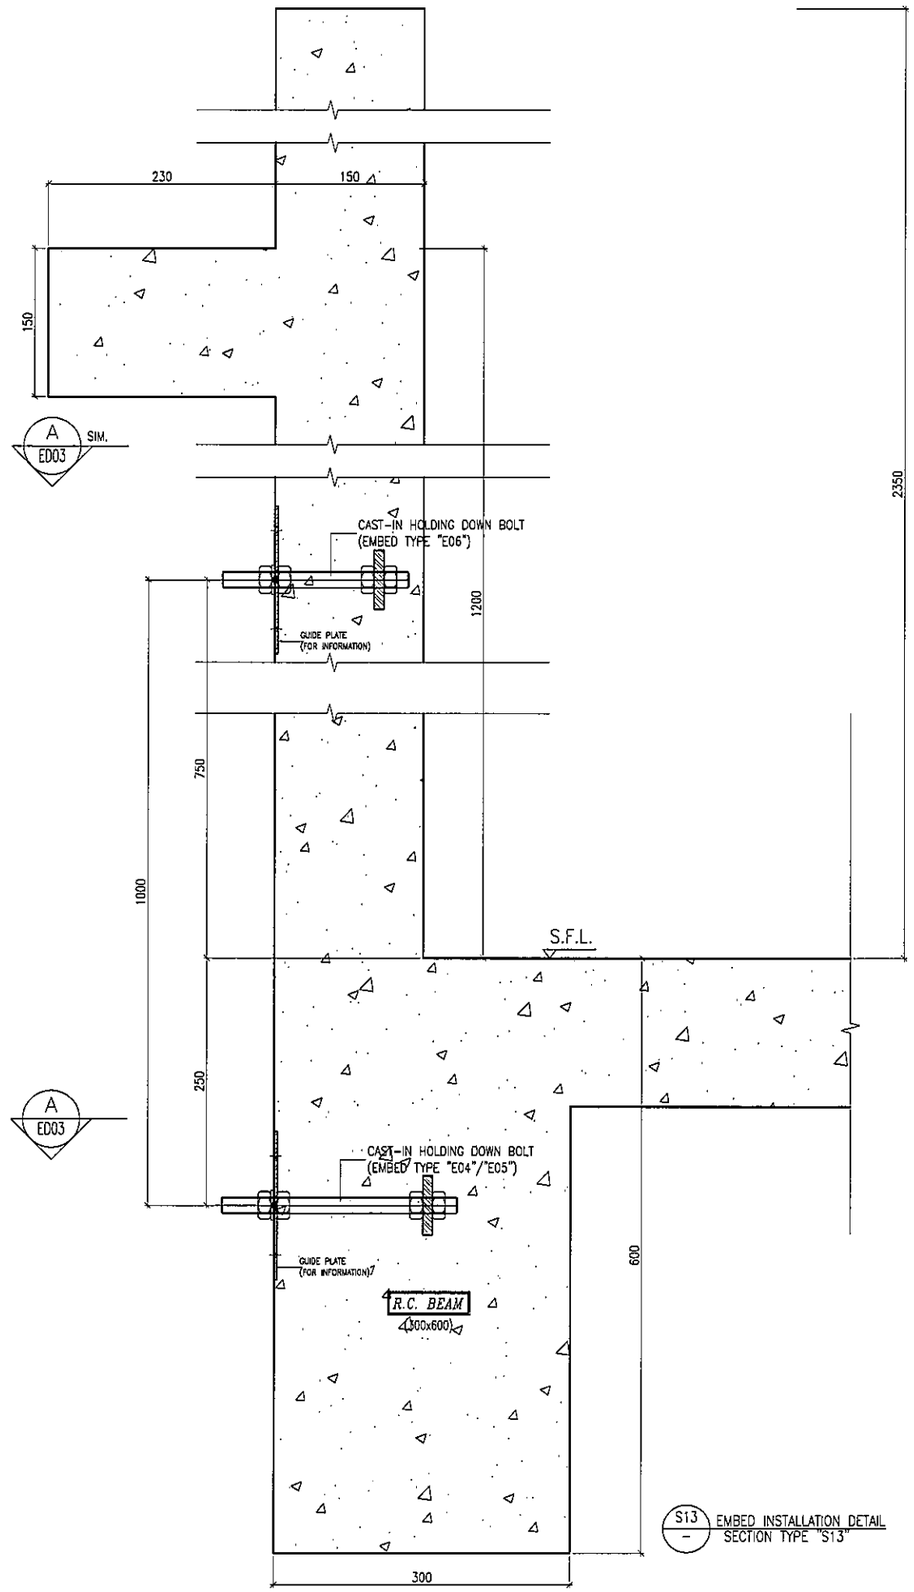

S13 — EMBED INSTALLATION DETAIL SECTION TYPE "S13"

B.D. REF :

CLIENT :
信和置業有限公司
Sino Land Company Limited

ARCHITECT :
WONG TUNG & PARTNERS LIMITED
ARCHITECTS & PLANNERS

MAIN CONTRACTOR :
CR Construction Company Limited

STRUCTURAL ENGINEER :
AECOM

FACADE CONSULTANT:
AECOM

NOTE :
1. ALL DIMENSIONS ARE IN mm.
2. ALL ELEVATIONS ARE VIEWED FROM OUTSIDE.
3. ALL DIMENSIONS TO BE VERIFIED ON SITE BEFORE FABRICATION.

LEGEND :
X1 / X001 — DETAIL MARK NO. / REFER SHEET NO.
1. F.F.L. --FINISHED FLOOR LEVEL
2. S.F.L. --STRUCTURAL FLOOR LEVEL
3. /R --REVERSED DETAIL

NO.	DATE	REVISED	BY
C	09/01/2019	GENERAL REVISED	
B	22/12/2018	GENERAL REVISED	
A	24/11/2018	GENERAL REVISED	

JOB NO. : J-837

PROJECT :
URA KWUN TONG TOWN CENTRE REDEVELOPMENT (AREA 2 & 3) AT NKIL 6514, KWUN TONG, KWLOON

TITLE :
EMBED TYPICAL DETAILS FOR CURTAIN WALL

DATE : 10-SEP-18 | SCALE : 1:3 (A1)

DRAWN BY : Asing | CHECKED BY : -

美特鋁質有限公司
MIDI ALUMINIUM FABRICATOR LTD.
Units 6-8, Sunray Industrial Centre, 1/F
610 Cha Kwo Ling Road, Kowloon
Tel:23489211-4 Fax:(852)27727666

DWG NO. : J837-CW-ED06 | REV. : C

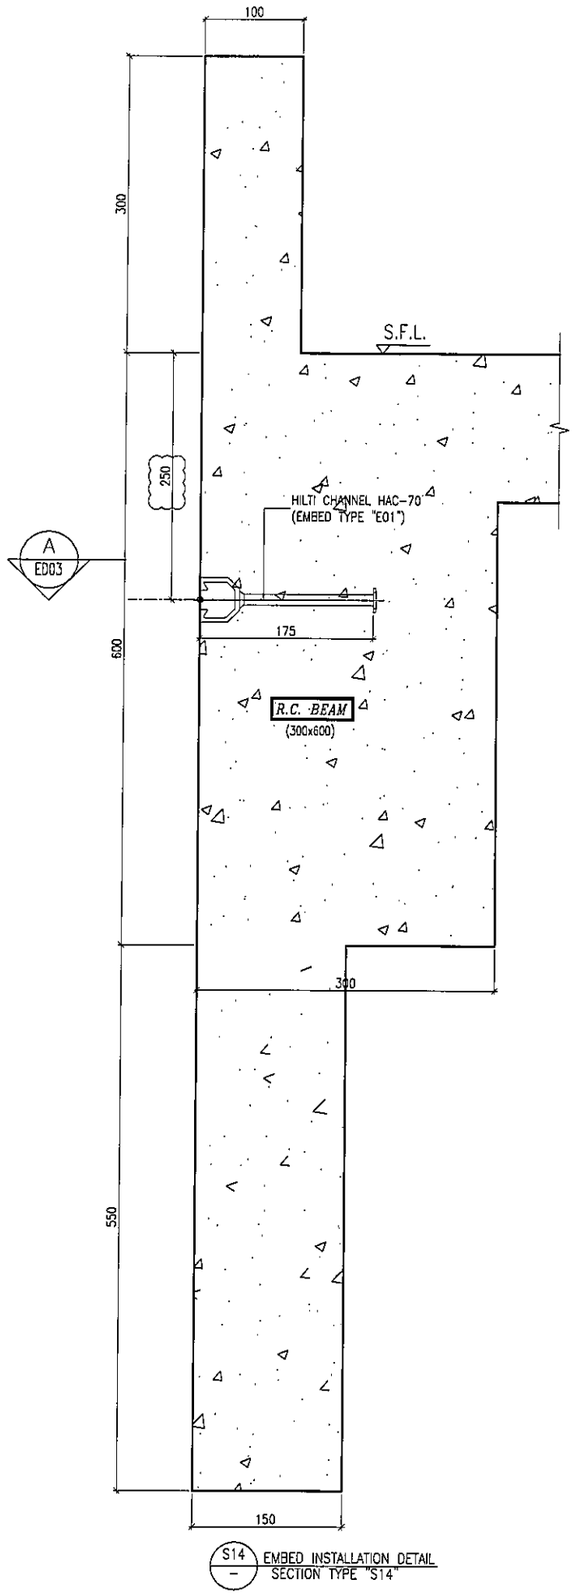

S14 / – EMBED INSTALLATION DETAIL
SECTION TYPE "S14"

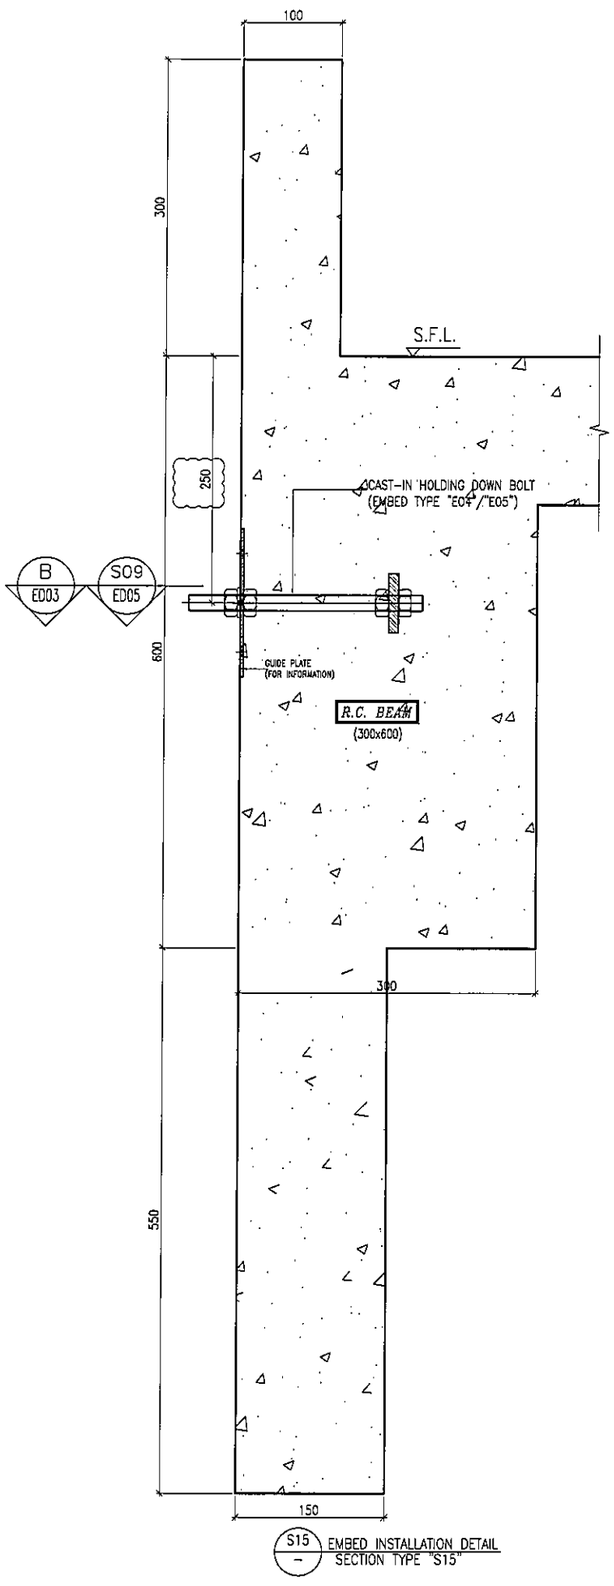

S15 / – EMBED INSTALLATION DETAIL
SECTION TYPE "S15"

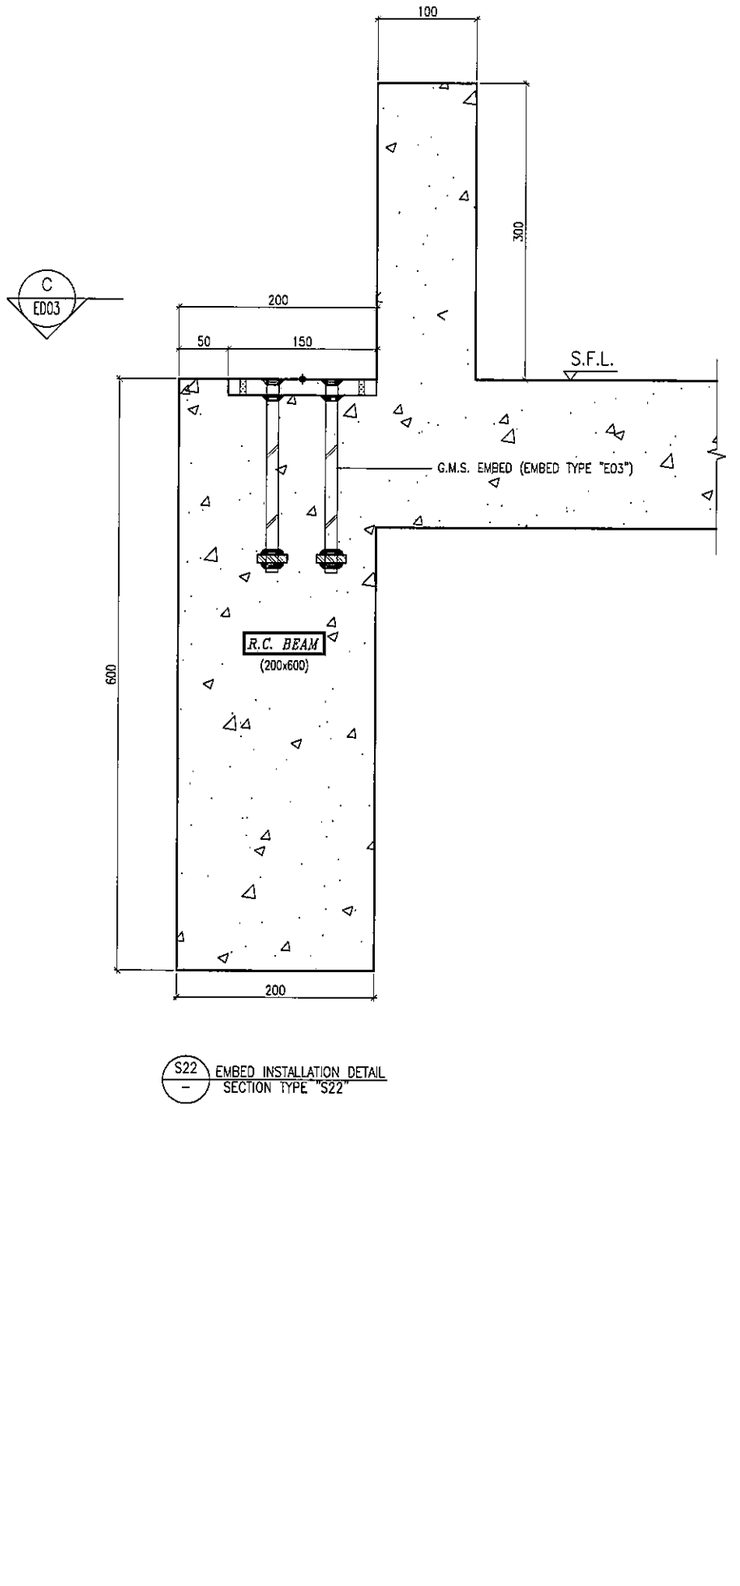

S22 / – EMBED INSTALLATION DETAIL
SECTION TYPE "S22"

B.D. REF :

CLIENT :
信和置業有限公司
Sino Land Company Limited

ARCHITECT :
WONG TUNG & PARTNERS LIMITED
ARCHITECTS & PLANNERS

MAIN CONTRACTOR :
CR Construction Company Limited

STRUCTURAL ENGINEER :
AECOM

FACADE CONSULTANT:
AECOM

NOTE :
1. ALL DIMENSIONS ARE IN mm.
2. ALL ELEVATIONS ARE VIEWED FROM OUTSIDE.
3. ALL DIMENSIONS TO BE VERIFIED ON SITE BEFORE FABRICATION.

LEGEND :
X1 / X001 — DETAIL MARK NO. / REFER SHEET NO.
1. F.F.L. --FINISHED FLOOR LEVEL
2. S.F.L. --STRUCTURAL FLOOR LEVEL
3. /R --REVERSED DETAIL

NO.	DATE	REVISED	BY
B	04/12/2018	GENERAL REVISED	
A	24/11/2018	GENERAL REVISED	

JOB NO. : J-837

PROJECT :
URA KWUN TONG TOWN CENTRE
REDEVELOPMENT (AREA 2 & 3) AT
NKIL 6514, KWUN TONG, KWLOON

TITLE :
EMBED TYPICAL DETAILS
FOR CURTAIN WALL

DATE : 10-SEP-18 | SCALE : 1:3 (A1)

DRAWN BY : Asing | CHECKED BY : -

美特鋁質有限公司
MIDI ALUMINIUM FABRICATOR LTD.
Units 6-8, Sunray Industrial Centre, 1/F
610 Cha Kwo Ling Road, Kowloon
Tel:23489211-4 Fax:(852)27727666

DWG NO. : J837-CW-ED07 | REV. : B

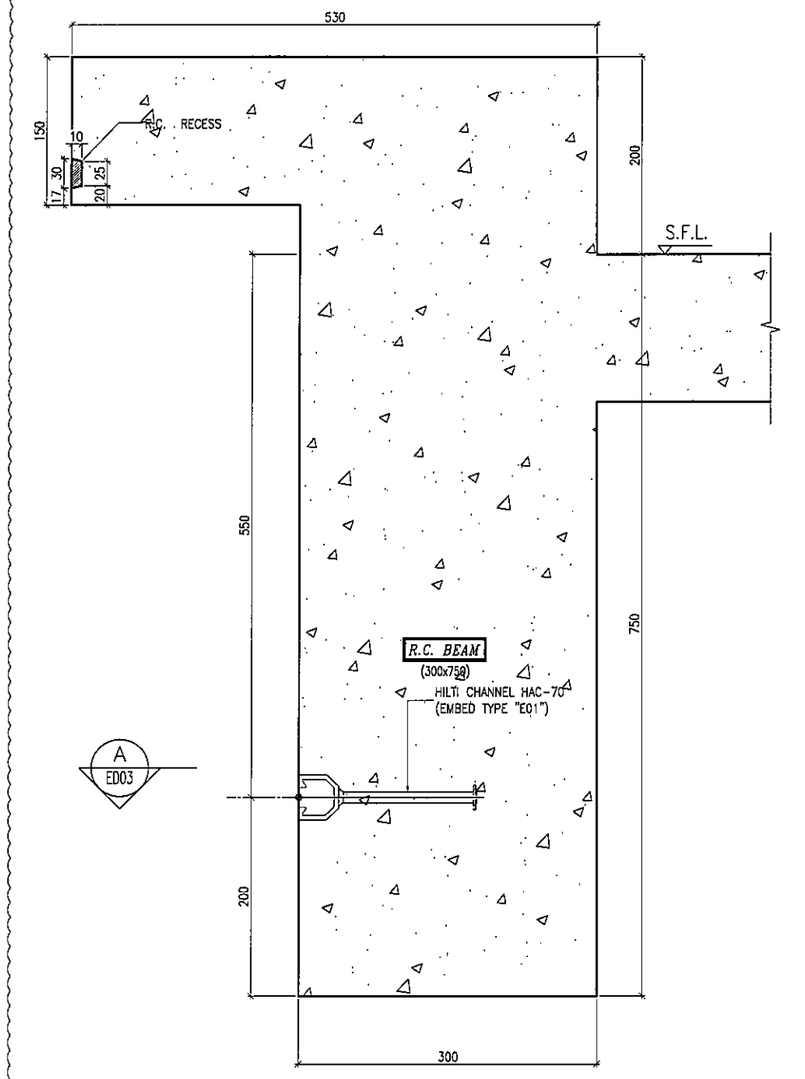

S16 / – EMBED INSTALLATION DETAIL
SECTION TYPE "S16"

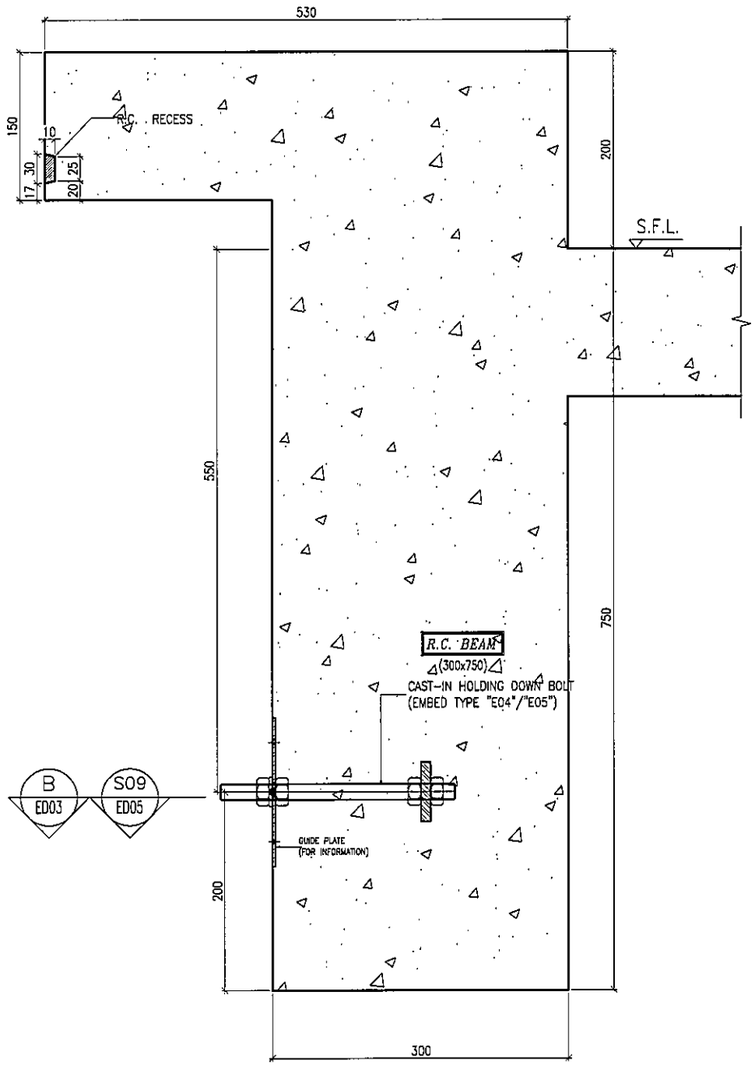

S17 / – EMBED INSTALLATION DETAIL
SECTION TYPE "S17"

B.D. REF :

CLIENT :
信和置業有限公司
Sino Land Company Limited

ARCHITECT :
WONG TUNG & PARTNERS LIMITED
ARCHITECTS & PLANNERS

MAIN CONTRACTOR :
CR Construction Company Limited

STRUCTURAL ENGINEER :
AECOM

FACADE CONSULTANT:
AECOM

NOTE :
1. ALL DIMENSIONS ARE IN mm.
2. ALL ELEVATIONS ARE VIEWED FROM OUTSIDE.
3. ALL DIMENSIONS TO BE VERIFIED ON SITE BEFORE FABRICATION.

LEGEND :
X1 / X001 — DETAIL MARK NO. / REFER SHEET NO.
1. F.F.L. --FINISHED FLOOR LEVEL
2. S.F.L. --STRUCTURAL FLOOR LEVEL
3. /R --REVERSED DETAIL

NO.	DATE	REVISED	BY
B	24/06/2019	GENERAL REVISED	
A	24/11/2018	GENERAL REVISED	

JOB NO. : J-837

PROJECT :
URA KWUN TONG TOWN CENTRE
REDEVELOPMENT (AREA 2 & 3) AT
NKIL 6514, KWUN TONG, KWLOON

TITLE :
EMBED TYPICAL DETAILS
FOR CURTAIN WALL

DATE : 10-SEP-18 | SCALE : 1:3 (A1)

DRAWN BY : Asing | CHECKED BY : –

美特鋁質有限公司
MIDI ALUMINIUM FABRICATOR LTD.
Units 6-8, Sunray Industrial Centre, 1/F
610 Cha Kwo Ling Road, Kowloon
Tel:23489211-4 Fax:(852)27727666

DWG NO. : J837-CW-ED08 | REV. : B

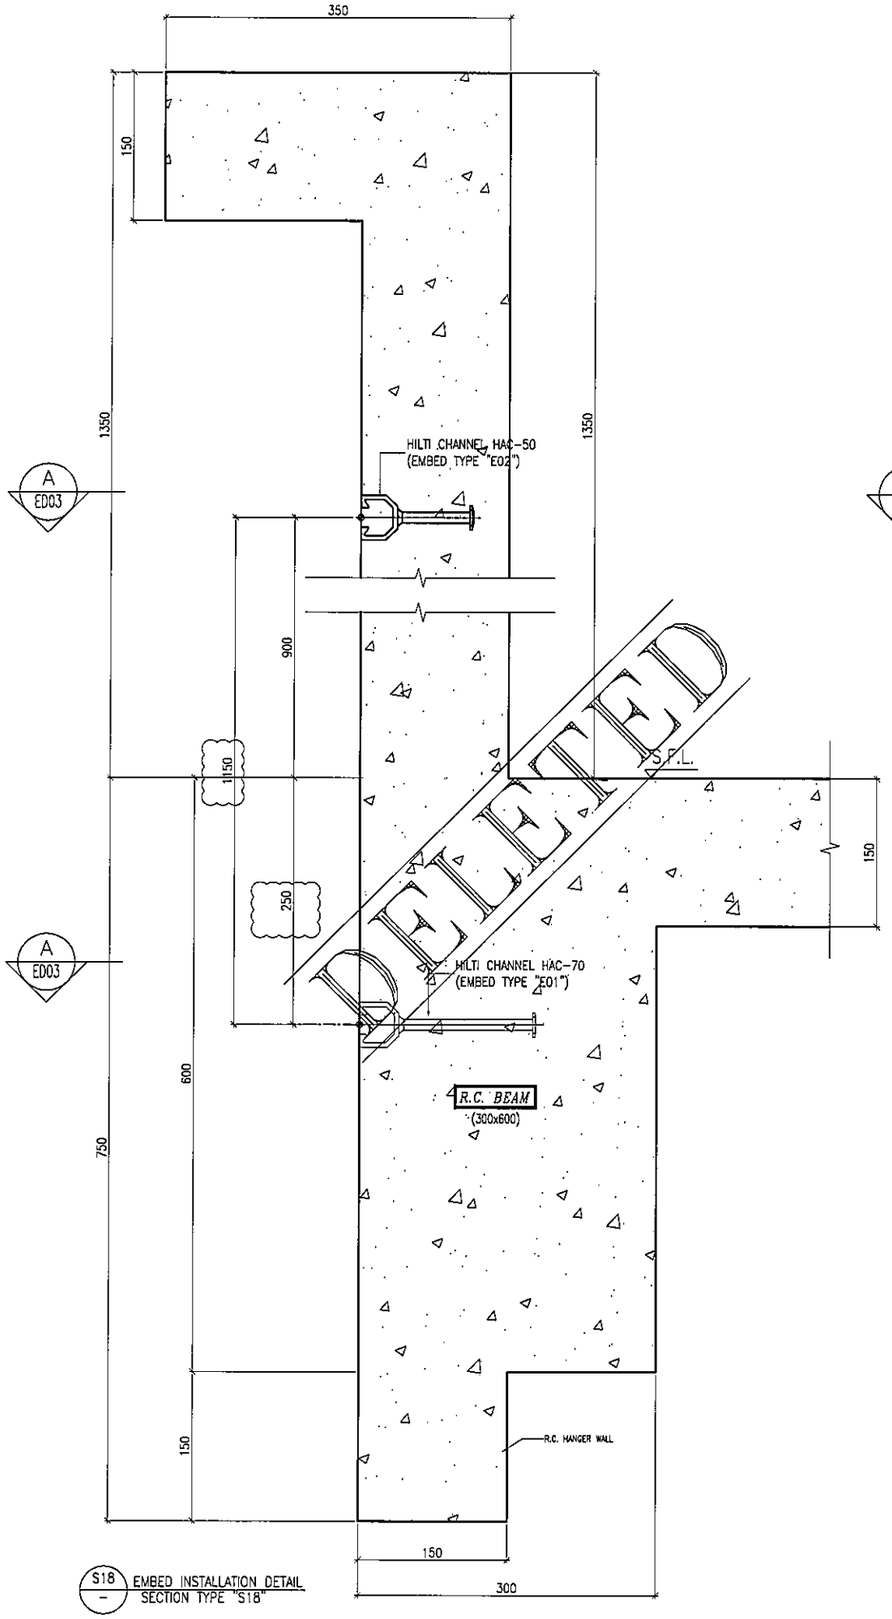

S18 — EMBED INSTALLATION DETAIL
SECTION TYPE "S18"

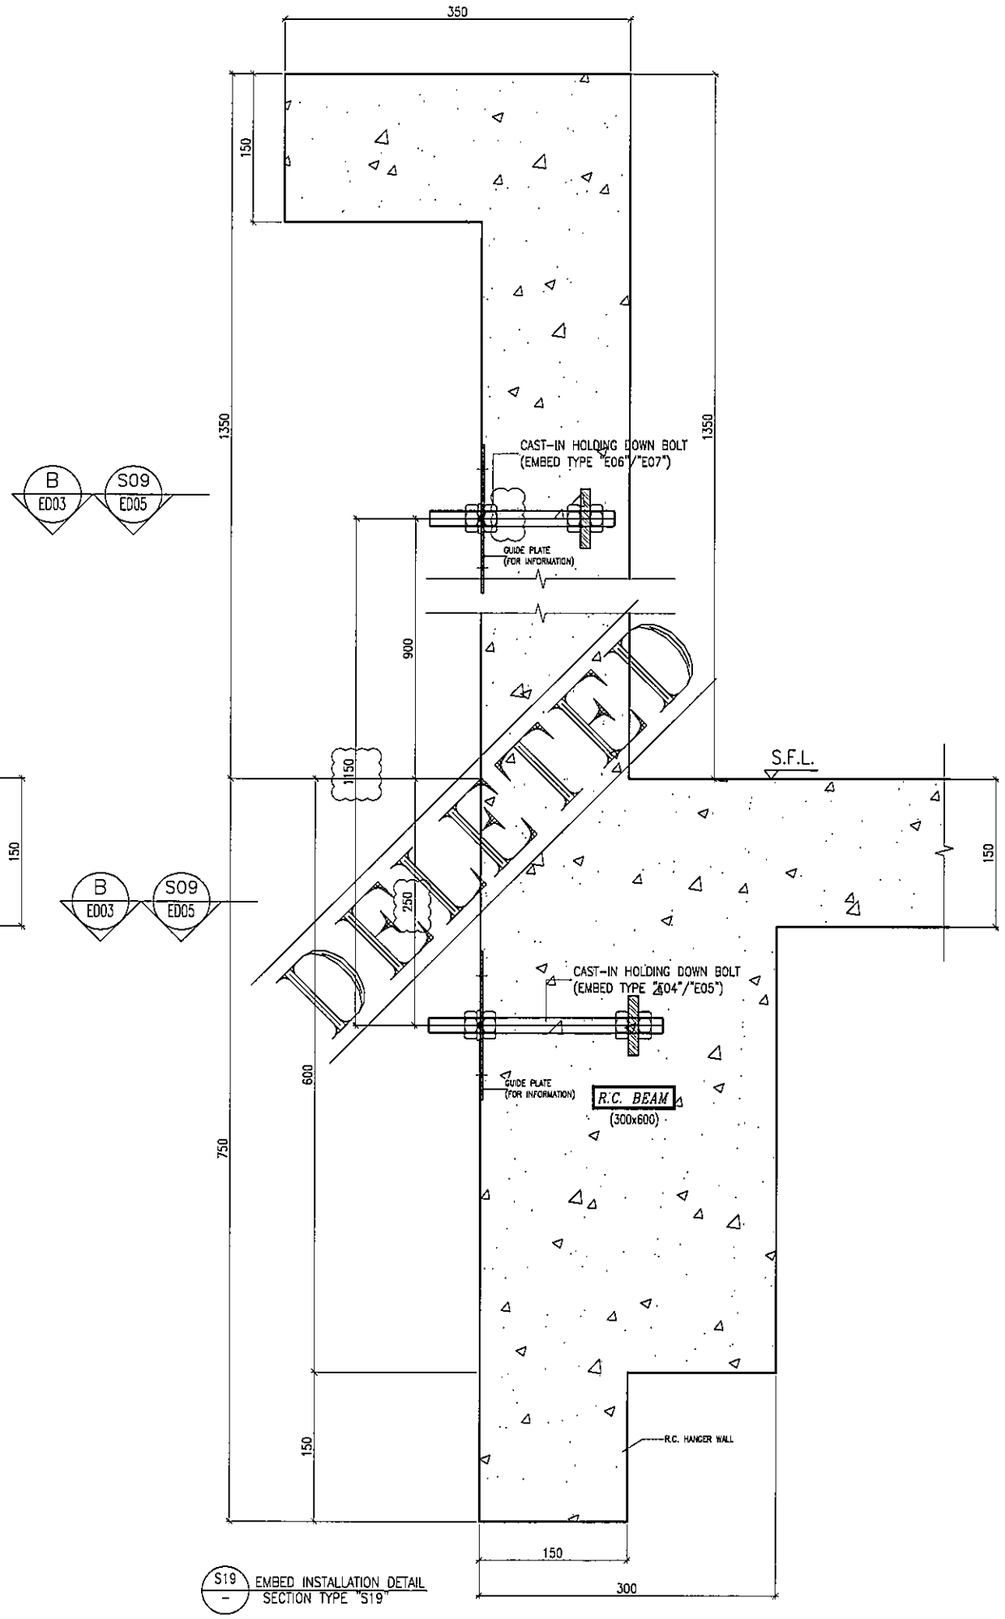

S19 — EMBED INSTALLATION DETAIL
SECTION TYPE "S19"

B.D. REF :

CLIENT :
信和置業有限公司
Sino Land Company Limited

ARCHITECT :
WONG TUNG & PARTNERS LIMITED
ARCHITECTS & PLANNERS

MAIN CONTRACTOR :
CR Construction Company Limited

STRUCTURAL ENGINEER :
AECOM

FACADE CONSULTANT:
AECOM

NOTE :
1. ALL DIMENSIONS ARE IN mm.
2. ALL ELEVATIONS ARE VIEWED FROM OUTSIDE.
3. ALL DIMENSIONS TO BE VERIFIED ON SITE BEFORE FABRICATION.

LEGEND :
X1 / XD01 — DETAIL MARK NO. / REFER SHEET NO.
1. F.F.L. --FINISHED FLOOR LEVEL
2. S.F.L. --STRUCTURAL FLOOR LEVEL
3. (R) --REVERSED DETAIL

NO.	DATE	REVISED	BY
B	26/5/2019	GENERAL REVISED	
A	24/11/2018	GENERAL REVISED	

JOB NO. : J-837

PROJECT :
URA KWUN TONG TOWN CENTRE
REDEVELOPMENT (AREA 2 & 3) AT
NKIL 6514, KWUN TONG, KWLOON

TITLE :
EMBED TYPICAL DETAILS
FOR CURTAIN WALL

DATE : 10-SEP-18 | SCALE : 1:3 (A1)

DRAWN BY : Asing | CHECKED BY : -

美特鋁製有限公司
MIDI ALUMINIUM FABRICATOR LTD.
Units 6-8, Sunray Industrial Centre, 1/F
610 Cha Kwo Ling Road, Kowloon
Tel:23489211-4 Fax:(852)27727666

DWG NO. : J837-CW-ED09 | REV. : B

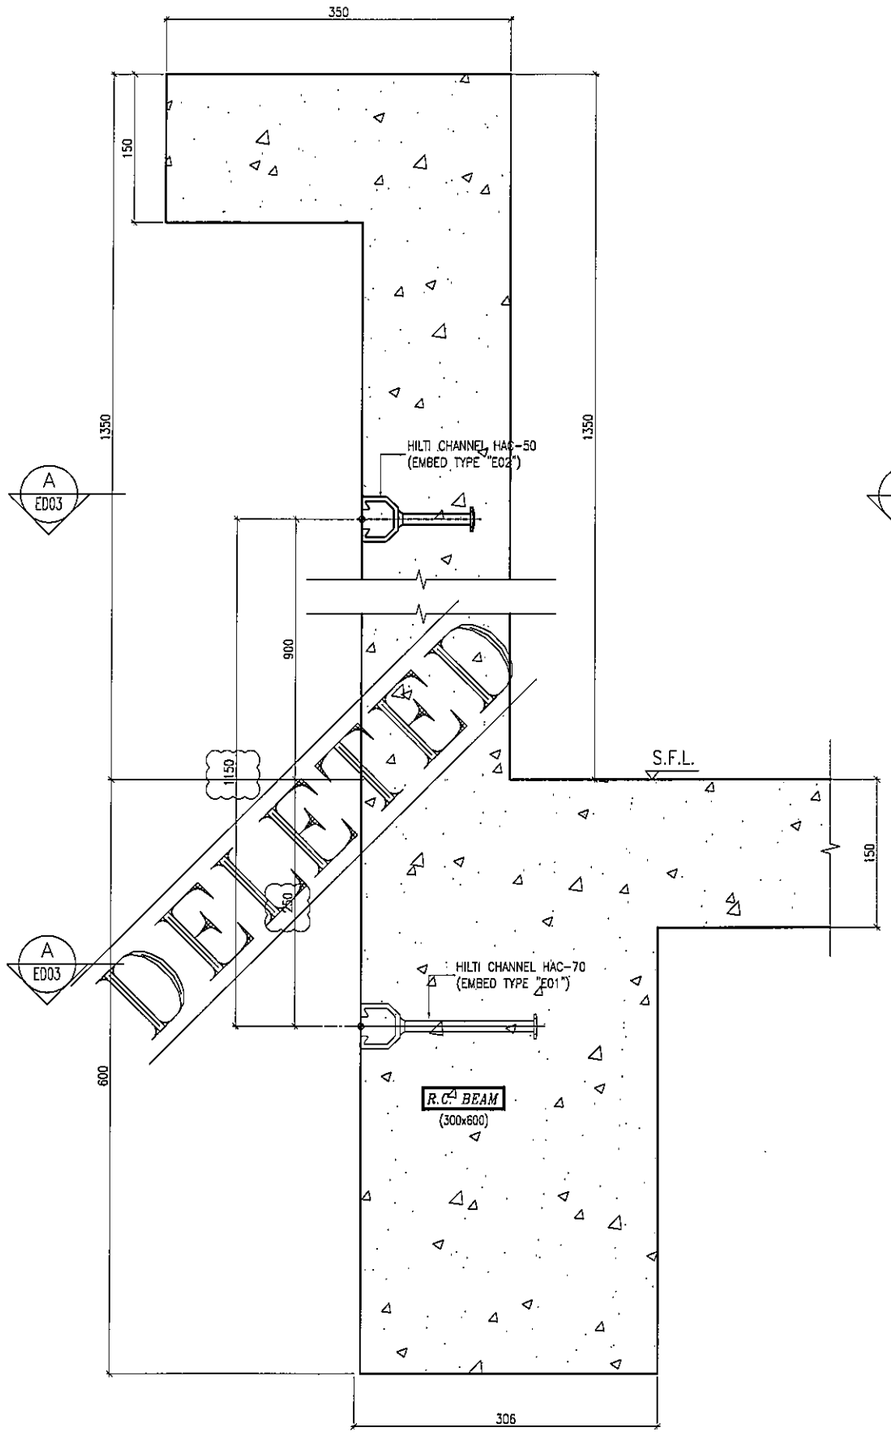

S20 / – EMBED INSTALLATION DETAIL
SECTION TYPE "S20"

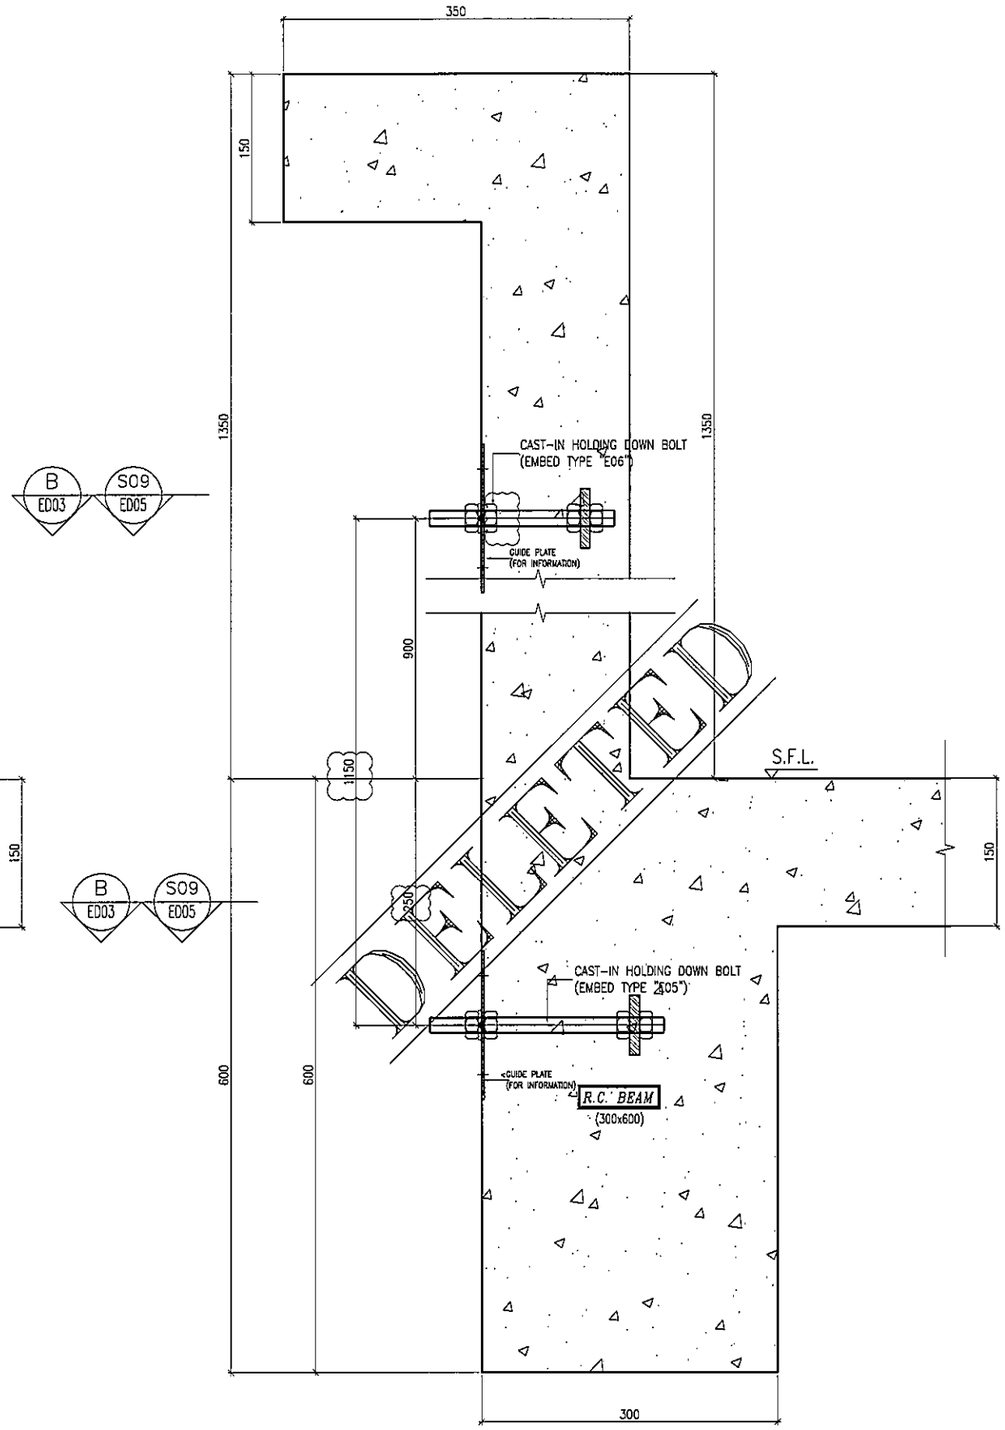

S21 / – EMBED INSTALLATION DETAIL
SECTION TYPE "S21"

B.D. REF :

CLIENT :
信和置業有限公司
Sino Land Company Limited

ARCHITECT :
WONG TUNG & PARTNERS LIMITED
ARCHITECTS & PLANNERS

MAIN CONTRACTOR :
CR Construction Company Limited

STRUCTURAL ENGINEER :
AECOM

FACADE CONSULTANT:
AECOM

NOTE :
1. ALL DIMENSIONS ARE IN mm.
2. ALL ELEVATIONS ARE VIEWED FROM OUTSIDE.
3. ALL DIMENSIONS TO BE VERIFIED ON SITE BEFORE FABRICATION.

LEGEND :
X1 / X001 — DETAIL MARK NO. / REFER SHEET NO.
1. F.F.L. --FINISHED FLOOR LEVEL
2. S.F.L. --STRUCTURAL FLOOR LEVEL
3. (R) --REVERSED DETAIL

NO.	DATE	REVISED	BY
B	26/5/2019	GENERAL REVISED	
A	24/11/2018	GENERAL REVISED	

JOB NO. : J-837

PROJECT :
URA KWUN TONG TOWN CENTRE
REDEVELOPMENT (AREA 2 & 3) AT
NKIL 6514, KWUN TONG, KWLOON

TITLE :
EMBED TYPICAL DETAILS
FOR CURTAIN WALL

DATE : 10-SEP-18 | SCALE : 1:3 (A1)

DRAWN BY : Asing | CHECKED BY : –

美特鋁製有限公司
MIDI ALUMINIUM FABRICATOR LTD.
Units 6-8, Sunray Industrial Centre, 1/F
610 Cha Kwo Ling Road, Kowloon
Tel:23489211-4 Fax:(852)27727666

DWG NO. : J837-CW-ED10 | REV. : B

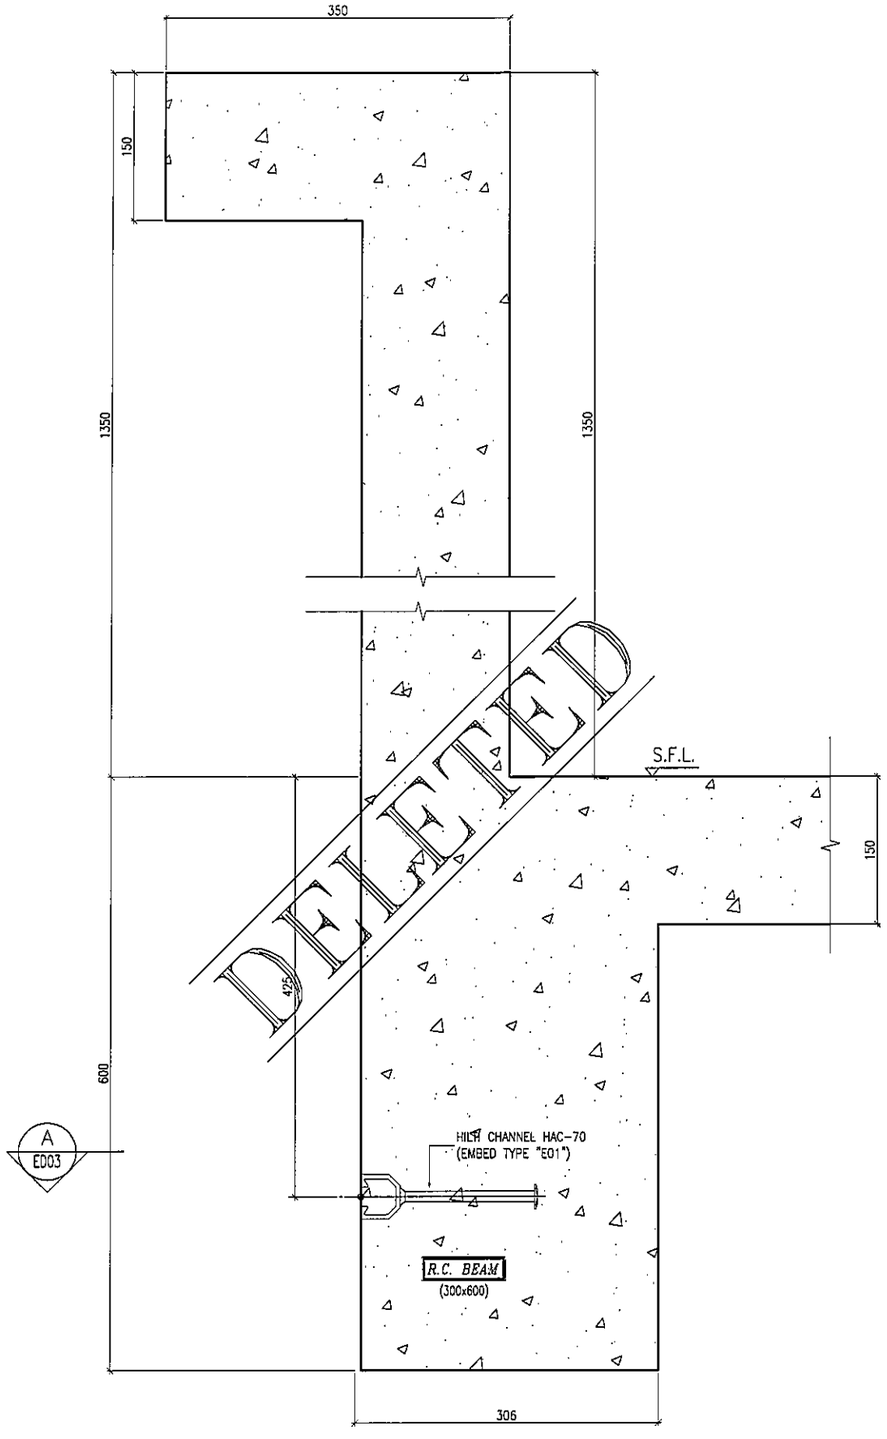

S23 – EMBED INSTALLATION DETAIL SECTION TYPE "S23"

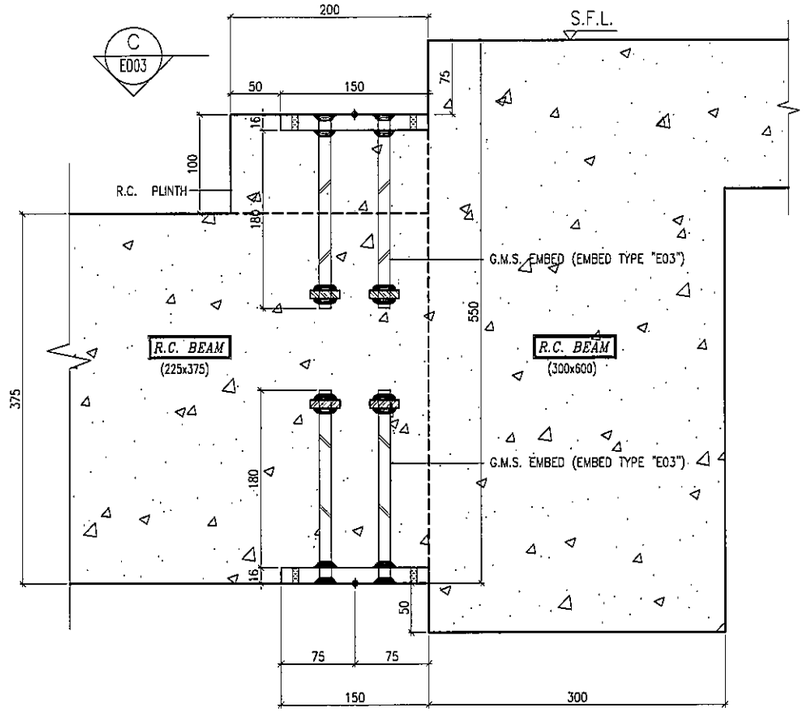

S24 – EMBED INSTALLATION DETAIL SECTION TYPE "S24"

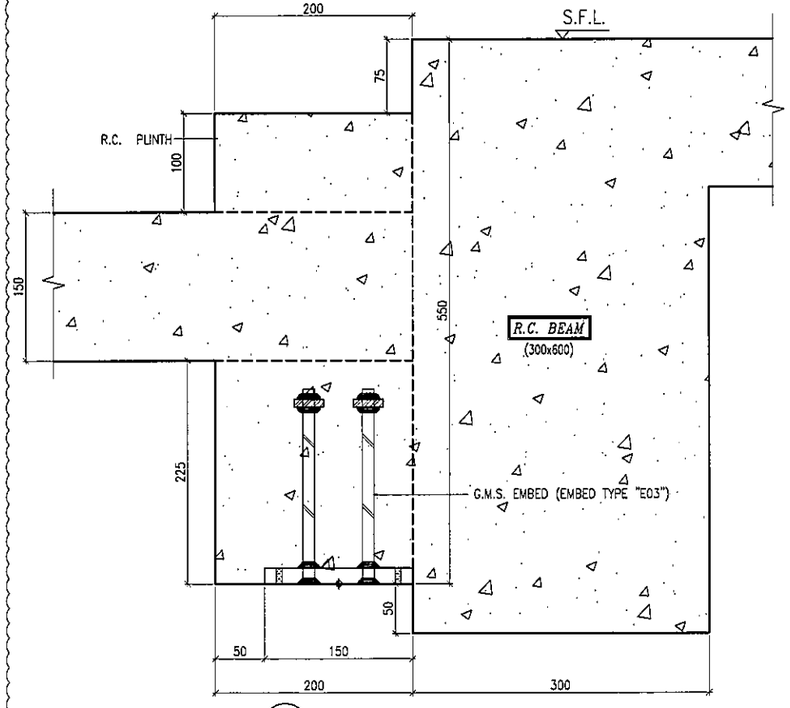

S25 – EMBED INSTALLATION DETAIL SECTION TYPE "S25"

B.D. REF :

CLIENT :
信和置業有限公司
Sino Land Company Limited

ARCHITECT : WONG TUNG & PARTNERS LIMITED
ARCHITECTS & PLANNERS

MAIN CONTRACTOR :
CR Construction Company Limited

STRUCTURAL ENGINEER :
AECOM

FACADE CONSULTANT:
AECOM

NOTE :
1. ALL DIMENSIONS ARE IN mm.
2. ALL ELEVATIONS ARE VIEWED FROM OUTSIDE.
3. ALL DIMENSIONS TO BE VERIFIED ON SITE BEFORE FABRICATION.

LEGEND :
X1 / XDD1 — DETAIL MARK NO. / REFER SHEET NO.
1. F.F.L. --FINISHED FLOOR LEVEL
2. S.F.L. --STRUCTURAL FLOOR LEVEL
3. /R --REVERSED DETAIL

NO.	DATE	REVISED	BY
A	14/9/2018	GENERAL REVISED	

JOB NO. : J-837

PROJECT :
URA KWUN TONG TOWN CENTRE REDEVELOPMENT (AREA 2 & 3) AT NKIL 6514, KWUN TONG, KWLOON

TITLE :
EMBED TYPICAL DETAILS FOR CURTAIN WALL

DATE : 10-SEP-18 | SCALE : 1:3 (A1)

DRAWN BY : Asing | CHECKED BY : -

美特鋁質有限公司
MIDI ALUMINIUM FABRICATOR LTD.
Units 6-8, Sunray Industrial Centre, 1/F
610 Cha Kwo Ling Road, Kowloon
Tel:23489211-4 Fax:(852)27727666

DWG NO. : J837-CW-ED11 | REV. : A

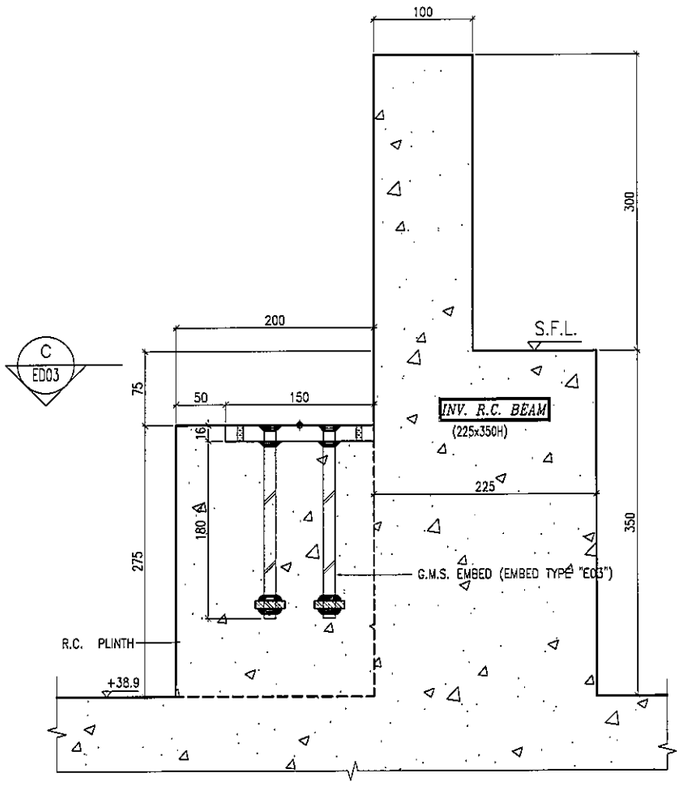

S26 EMBED INSTALLATION DETAIL
– SECTION TYPE "S26"

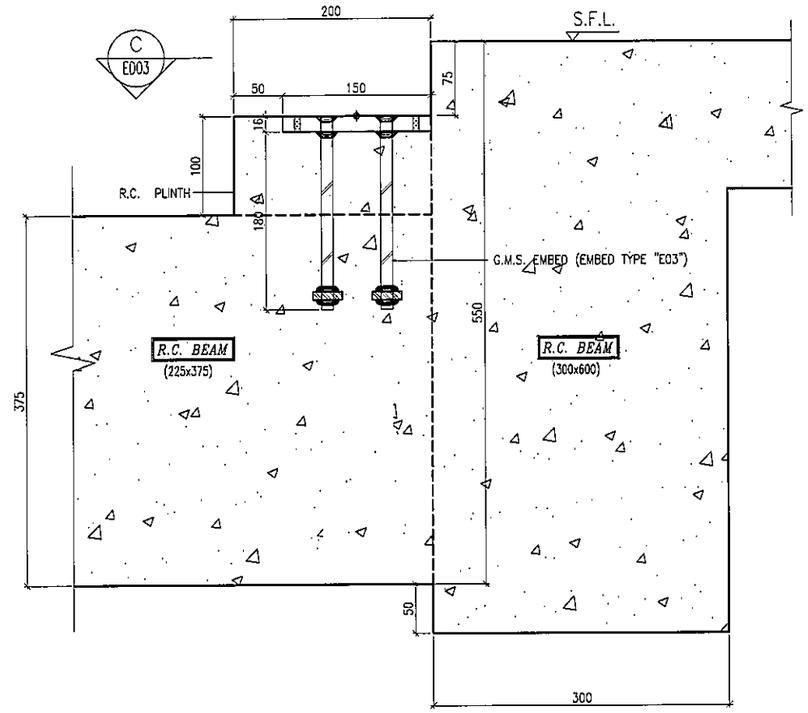

S27 EMBED INSTALLATION DETAIL
– SECTION TYPE "S27"

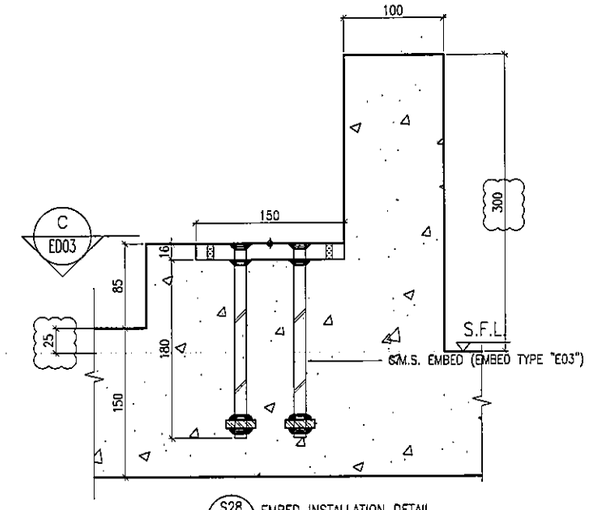

S28 EMBED INSTALLATION DETAIL
– SECTION TYPE "S28"

B.D. REF :

CLIENT :
信和置業有限公司
Sino Land Company Limited

ARCHITECT :
WONG TUNG & PARTNERS LIMITED
ARCHITECTS & PLANNERS

MAIN CONTRACTOR :
CR Construction Company Limited

STRUCTURAL ENGINEER :
AECOM

FACADE CONSULTANT:
AECOM

NOTE :
1. ALL DIMENSIONS ARE IN mm.
2. ALL ELEVATIONS ARE VIEWED FROM OUTSIDE.
3. ALL DIMENSIONS TO BE VERIFIED ON SITE BEFORE FABRICATION.

LEGEND :
X1 / X001 — DETAIL MARK NO. / REFER SHEET NO.
1. F.F.L. --FINISHED FLOOR LEVEL
2. S.F.L. --STRUCTURAL FLOOR LEVEL
3. /R --REVERSED DETAIL

NO.	DATE	REVISED	BY
C	18/08/2019	GENERAL REVISED	
B	20/06/2019	GENERAL REVISED	
A	22/12/2018	GENERAL REVISED	

JOB NO. : J-837

PROJECT :
URA KWUN TONG TOWN CENTRE REDEVELOPMENT (AREA 2 & 3) AT NKIL 6514, KWUN TONG, KWLOON

TITLE :
EMBED TYPICAL DETAILS FOR CURTAIN WALL

DATE : 14-SEP-18 | SCALE : 1:3 (A1)

DRAWN BY : Asing | CHECKED BY : –

美特鋁質有限公司
MIDI ALUMINIUM FABRICATOR LTD.
Units 6-8, Sunray Industrial Centre, 1/F
610 Cha Kwo Ling Road, Kowloon
Tel:23489211-4 Fax:(852)27727666

DWG NO. : J837-CW-ED12 | REV. : C

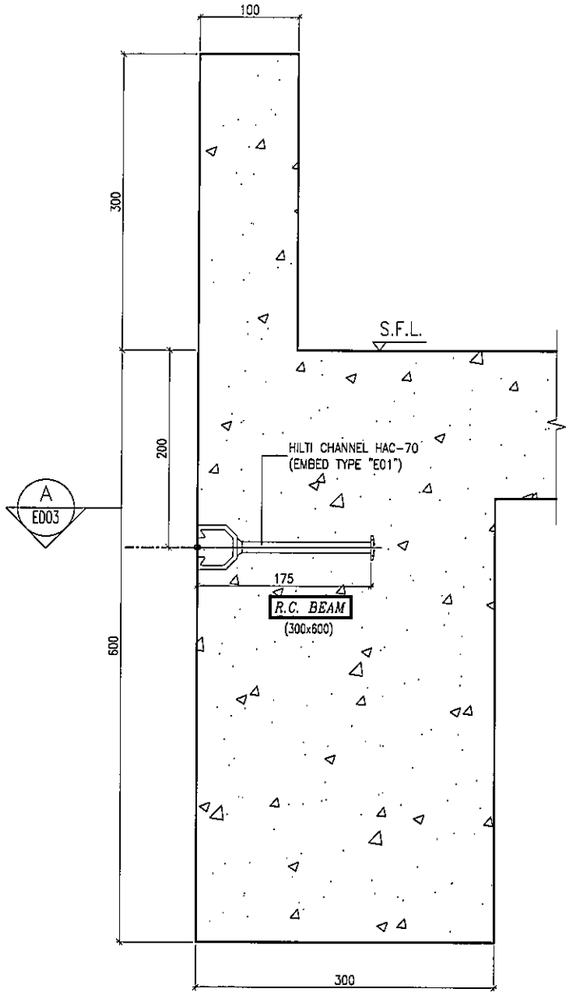

S29 – EMBED INSTALLATION DETAIL
SECTION TYPE "S29"

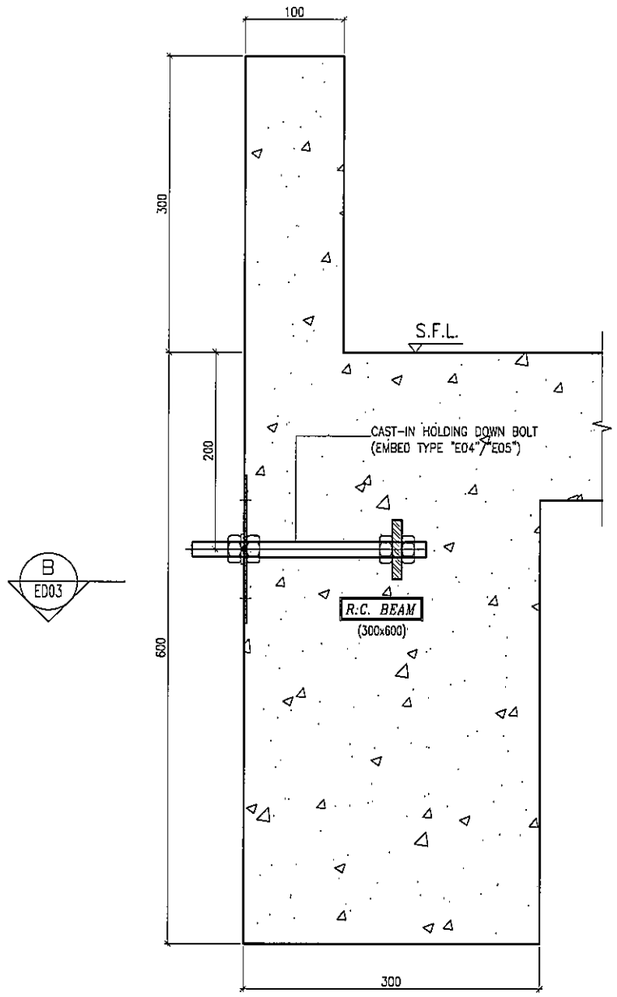

S30 – EMBED INSTALLATION DETAIL
SECTION TYPE "S30"

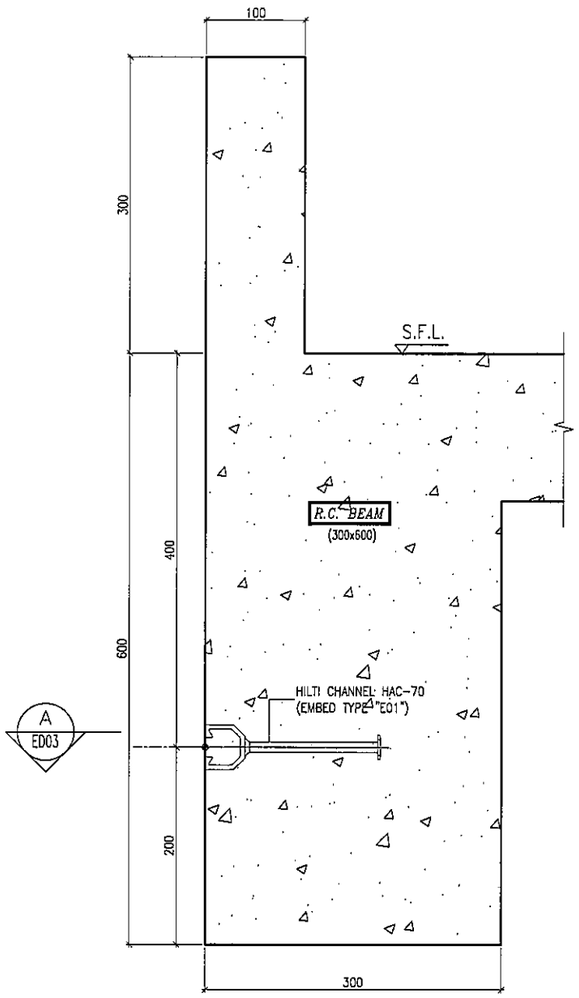

S31 – EMBED INSTALLATION DETAIL
SECTION TYPE "S31"

B.D. REF :

CLIENT :
信和置業有限公司
Sino Land Company Limited

ARCHITECT :
WONG TUNG & PARTNERS LIMITED
ARCHITECTS & PLANNERS

MAIN CONTRACTOR :
CR Construction Company Limited

STRUCTURAL ENGINEER :
AECOM

FACADE CONSULTANT:
AECOM

NOTE :
1. ALL DIMENSIONS ARE IN mm.
2. ALL ELEVATIONS ARE VIEWED FROM OUTSIDE.
3. ALL DIMENSIONS TO BE VERIFIED ON SITE BEFORE FABRICATION.

LEGEND :
X1 / X001 — DETAIL MARK NO. / REFER SHEET NO.
1. F.F.L. --FINISHED FLOOR LEVEL
2. S.F.L. --STRUCTURAL FLOOR LEVEL
3. (/R) --REVERSED DETAIL

NO.	DATE	REVISED	BY

JOB NO. : J-837

PROJECT :
URA KWUN TONG TOWN CENTRE
REDEVELOPMENT (AREA 2 & 3) AT
NKIL 6514, KWUN TONG, KWLOON

TITLE :
EMBED TYPICAL DETAILS
FOR CURTAIN WALL

DATE : 28-JAN-19	SCALE : 1:3 (A1)
DRAWN BY : Asing	CHECKED BY : -

美特鋁質有限公司
MIDI ALUMINIUM FABRICATOR LTD.
Units 6-8, Sunray Industrial Centre, 1/F
610 Cha Kwo Ling Road, Kowloon
Tel:23489211-4 Fax:(852)27727666

DWG NO. : J837-CW-ED13 | REV. : --

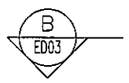

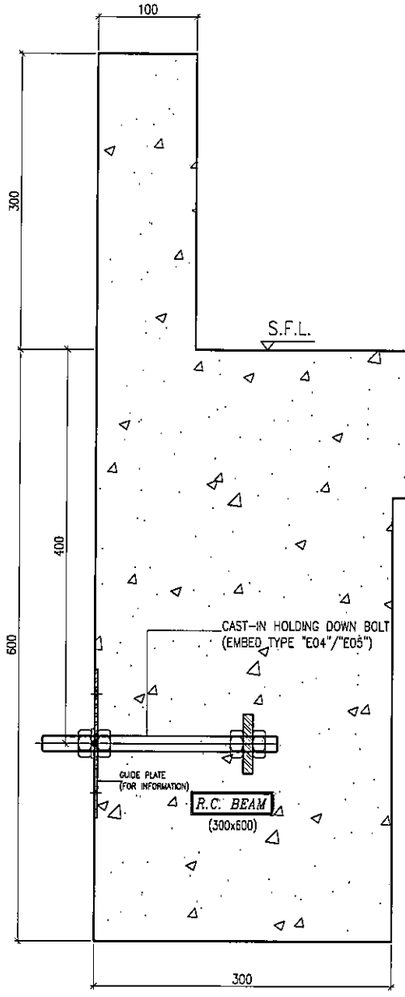

S32 – EMBED INSTALLATION DETAIL SECTION TYPE "S32"

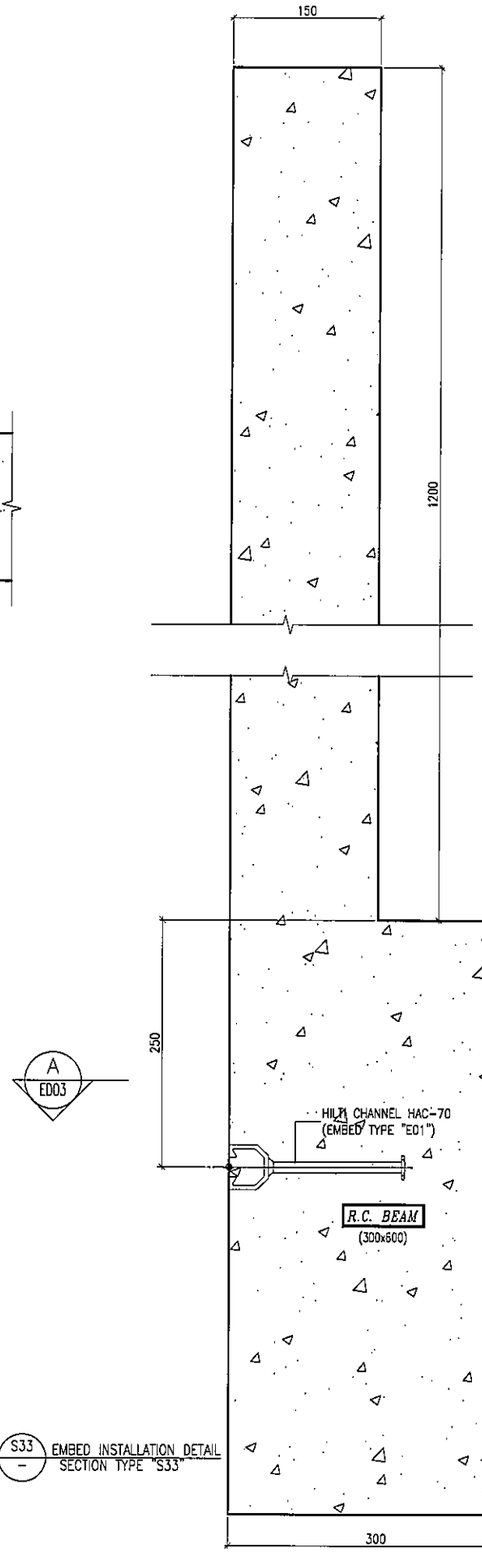

S33 – EMBED INSTALLATION DETAIL SECTION TYPE "S33"

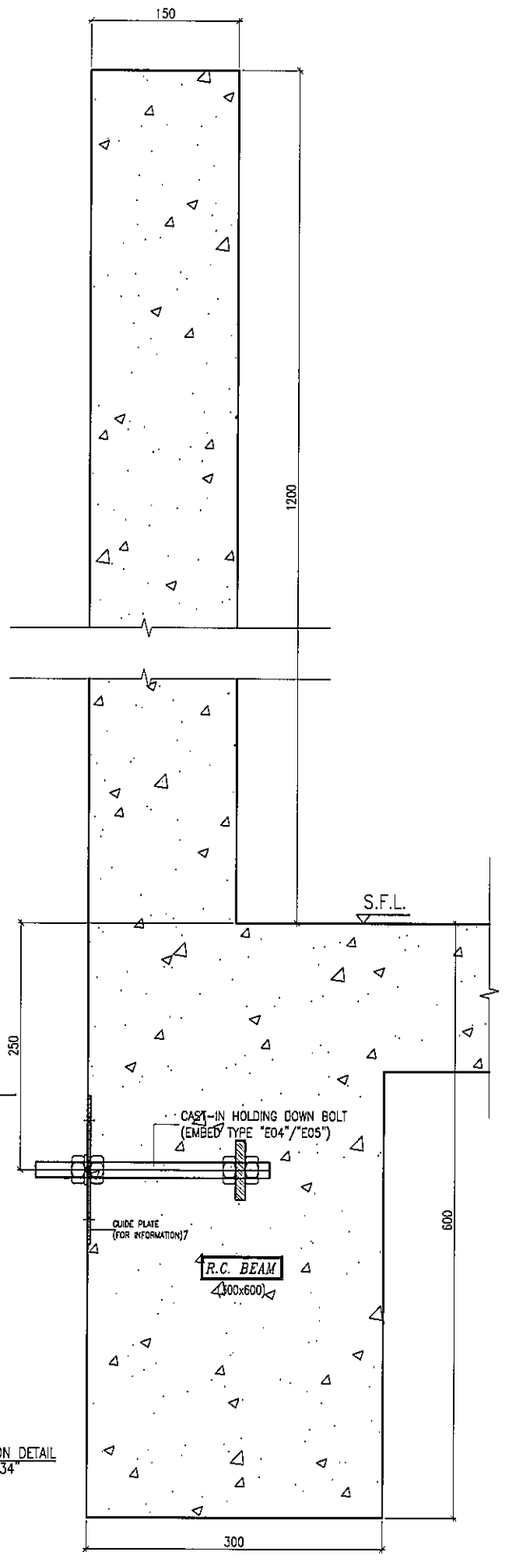

S34 – EMBED INSTALLATION DETAIL SECTION TYPE "S34"

B.D. REF :

CLIENT :
信和置業有限公司
Sino Land Company Limited

ARCHITECT :
WONG TUNG & PARTNERS LIMITED
ARCHITECTS & PLANNERS

MAIN CONTRACTOR :
CR Construction Company Limited

STRUCTURAL ENGINEER :
AECOM

FACADE CONSULTANT:
AECOM

NOTE :
1. ALL DIMENSIONS ARE IN mm.
2. ALL ELEVATIONS ARE VIEWED FROM OUTSIDE.
3. ALL DIMENSIONS TO BE VERIFIED ON SITE BEFORE FABRICATION.

LEGEND :
X1 / X001 — DETAIL MARK NO. / REFER SHEET NO.
1. F.F.L. --FINISHED FLOOR LEVEL
2. S.F.L. --STRUCTURAL FLOOR LEVEL
3. /R --REVERSED DETAIL

NO.	DATE	REVISED	BY

JOB NO. : J-837

PROJECT :
URA KWUN TONG TOWN CENTRE REDEVELOPMENT (AREA 2 & 3) AT NKIL 6514, KWUN TONG, KWLOON

TITLE :
EMBED TYPICAL DETAILS FOR CURTAIN WALL

DATE : 28-JAN-19 | SCALE : 1:3 (A1)

DRAWN BY : Asing | CHECKED BY : –

美特鋁質有限公司
MIDI ALUMINUM FABRICATOR LTD.
Units 6-8, Sunray Industrial Centre, 1/F
610 Cha Kwo Ling Road, Kowloon
Tel:23489211-4 Fax:(852)27727666

DWG NO. : J837-CW-ED14 | REV. : –

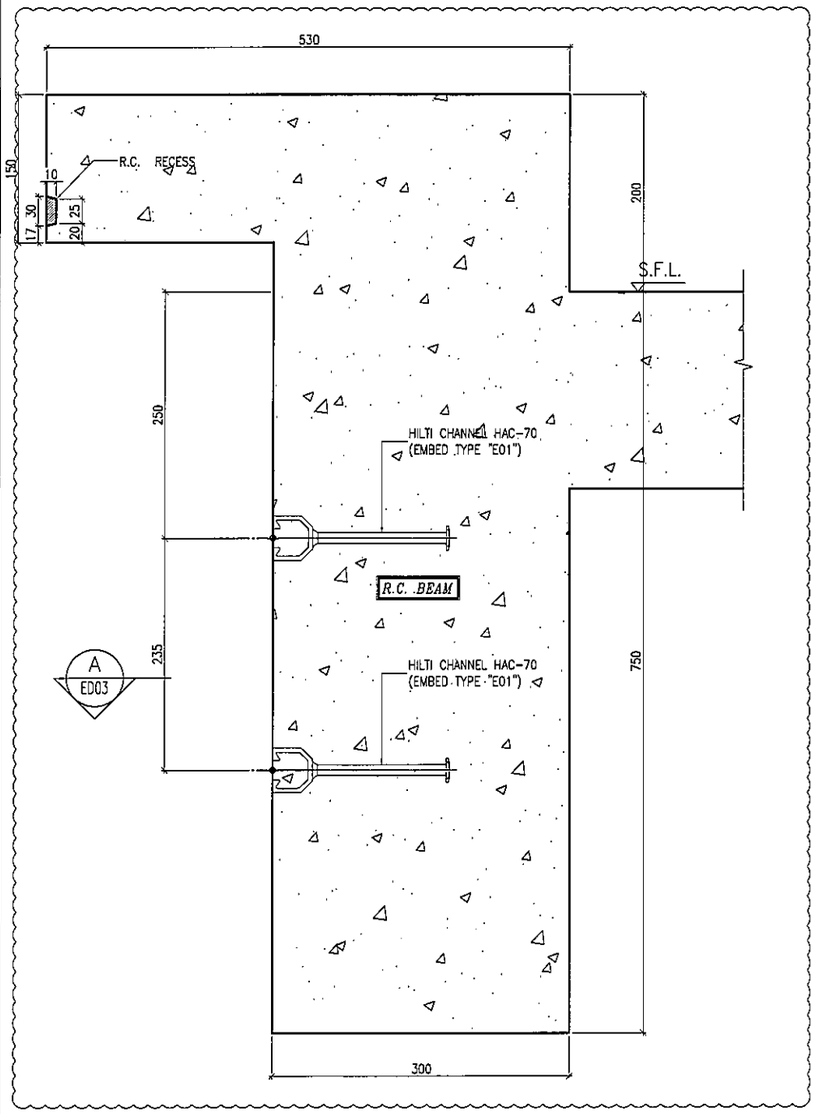

S35 — EMBED INSTALLATION DETAIL
SECTION TYPE "S35"

A
ED03

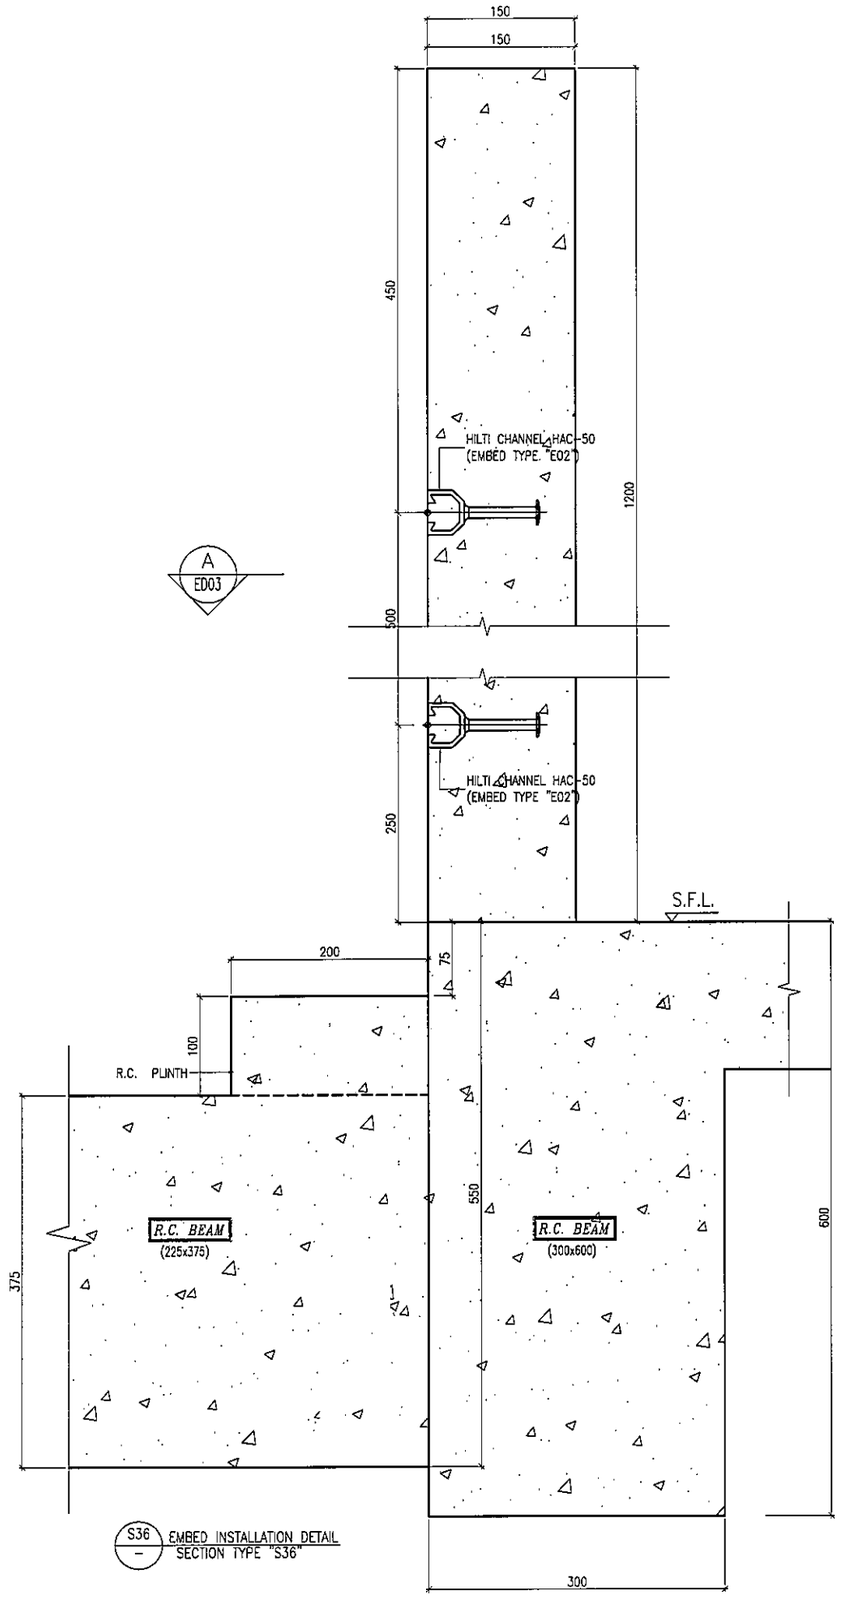

S36 — EMBED INSTALLATION DETAIL
SECTION TYPE "S36"

B.D. REF :

CLIENT :
信和置業有限公司
Sino Land Company Limited

ARCHITECT : WONG TUNG & PARTNERS LIMITED
ARCHITECTS & PLANNERS

MAIN CONTRACTOR :
CR Construction Company Limited

STRUCTURAL ENGINEER :
AECOM

FACADE CONSULTANT:
AECOM

NOTE :
1. ALL DIMENSIONS ARE IN mm.
2. ALL ELEVATIONS ARE VIEWED FROM OUTSIDE.
3. ALL DIMENSIONS TO BE VERIFIED ON SITE BEFORE FABRICATION.

LEGEND :
X1 / X001 — DETAIL MARK NO. / REFER SHEET NO.
1. F.F.L. --FINISHED FLOOR LEVEL
2. S.F.L. --STRUCTURAL FLOOR LEVEL
3. /R --REVERSED DETAIL

NO.	DATE	REVISED	BY
A	20/06/2019	GENERAL REVISED	

JOB NO. : J-837

PROJECT :
URA KWUN TONG TOWN CENTRE
REDEVELOPMENT (AREA 2 & 3) AT
NKIL 6514, KWUN TONG, KWLOON

TITLE :
EMBED TYPICAL DETAILS
FOR CURTAIN WALL

DATE : 18-FEB-19 | SCALE : 1:3 (A1)
DRAWN BY : Asing | CHECKED BY : -

美特鋁質有限公司
MIDI ALUMINIUM FABRICATOR LTD.
Units 6-8, Sunray Industrial Centre, 1/F
610 Cha Kwo Ling Road, Kowloon
Tel:23489211-4 Fax:(852)27727666

DWG NO. : J837-CW-ED15 | REV. : A

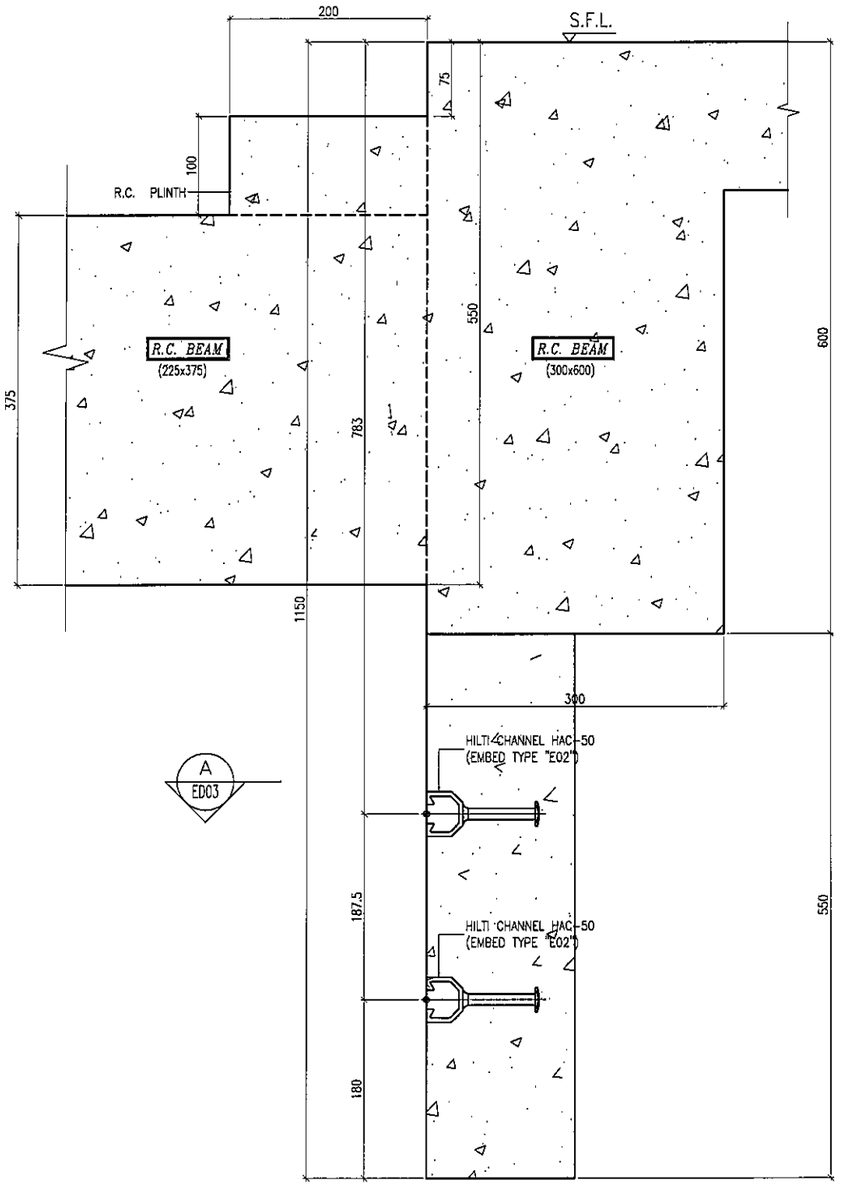

S37 EMBED INSTALLATION DETAIL
SECTION TYPE "S37"

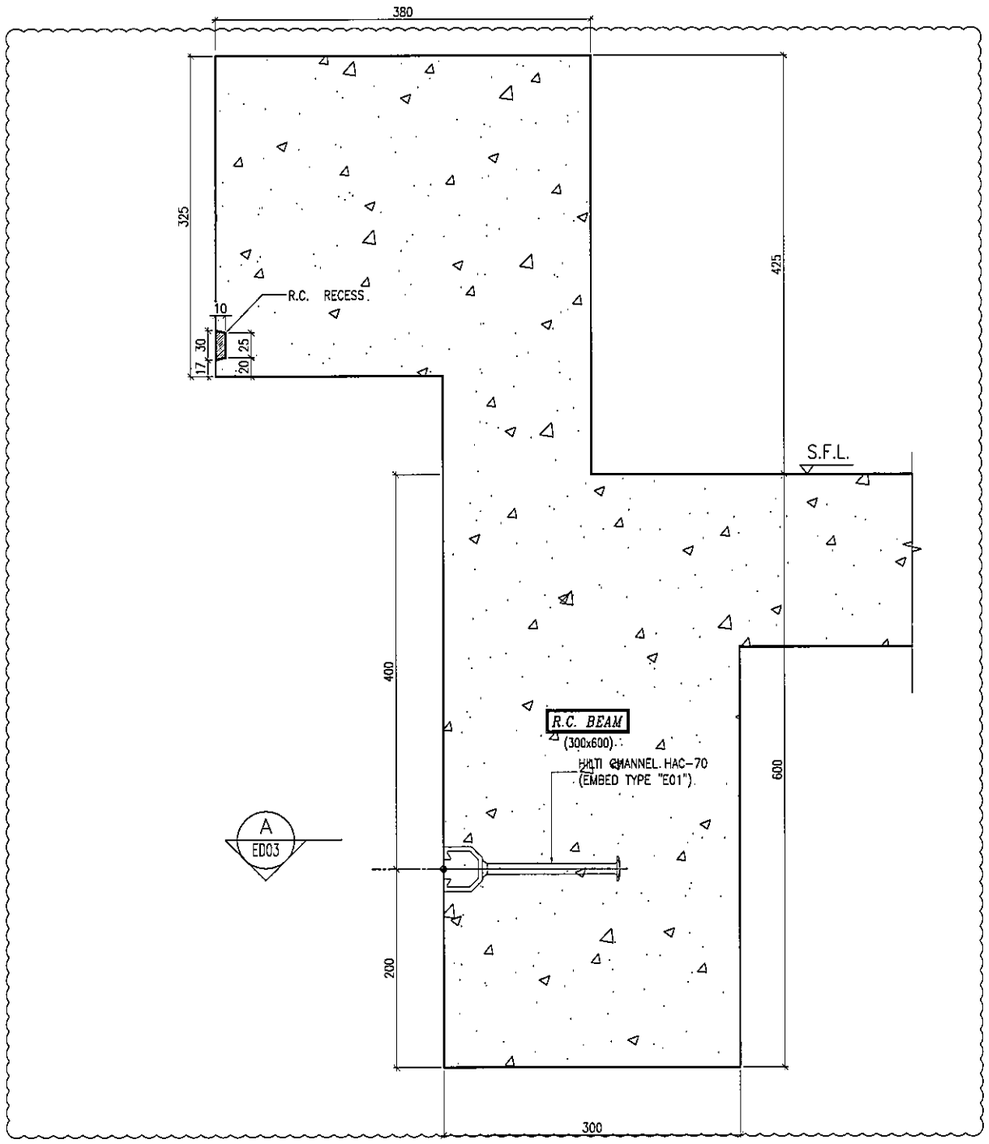

S38 EMBED INSTALLATION DETAIL
SECTION TYPE "S38"

B.D. REF :

CLIENT :
信和置業有限公司
Sino Land Company Limited

ARCHITECT : WONG TUNG & PARTNERS LIMITED
ARCHITECTS & PLANNERS

MAIN CONTRACTOR :
CR Construction Company Limited

STRUCTURAL ENGINEER :
AECOM

FACADE CONSULTANT:
AECOM

NOTE :
1. ALL DIMENSIONS ARE IN mm.
2. ALL ELEVATIONS ARE VIEWED FROM OUTSIDE.
3. ALL DIMENSIONS TO BE VERIFIED ON SITE BEFORE FABRICATION.

LEGEND :
X1 / X001 — DETAIL MARK NO. / REFER SHEET NO.
1. F.F.L. --FINISHED FLOOR LEVEL
2. S.F.L. --STRUCTURAL FLOOR LEVEL
3. /R --REVERSED DETAIL

NO.	DATE	REVISED	BY
A	20/06/2019	GENERAL REVISED	

JOB NO. : J-837

PROJECT :
URA KWUN TONG TOWN CENTRE
REDEVELOPMENT (AREA 2 & 3) AT
NKIL 6514, KWUN TONG, KWLOON

TITLE :
EMBED TYPICAL DETAILS
FOR CURTAIN WALL

DATE : 18-FEB-19 | SCALE : 1:3 (A1)
DRAWN BY : Asing | CHECKED BY : -

美特鋁質有限公司
MIDI ALUMINIUM FABRICATOR LTD.
Units 6-8, Sunray Industrial Centre, 1/F
610 Cha Kwo Ling Road, Kowloon
Tel:23489211-4 Fax:(852)27727666

DWG NO. : J837-CW-ED16 | REV. : A

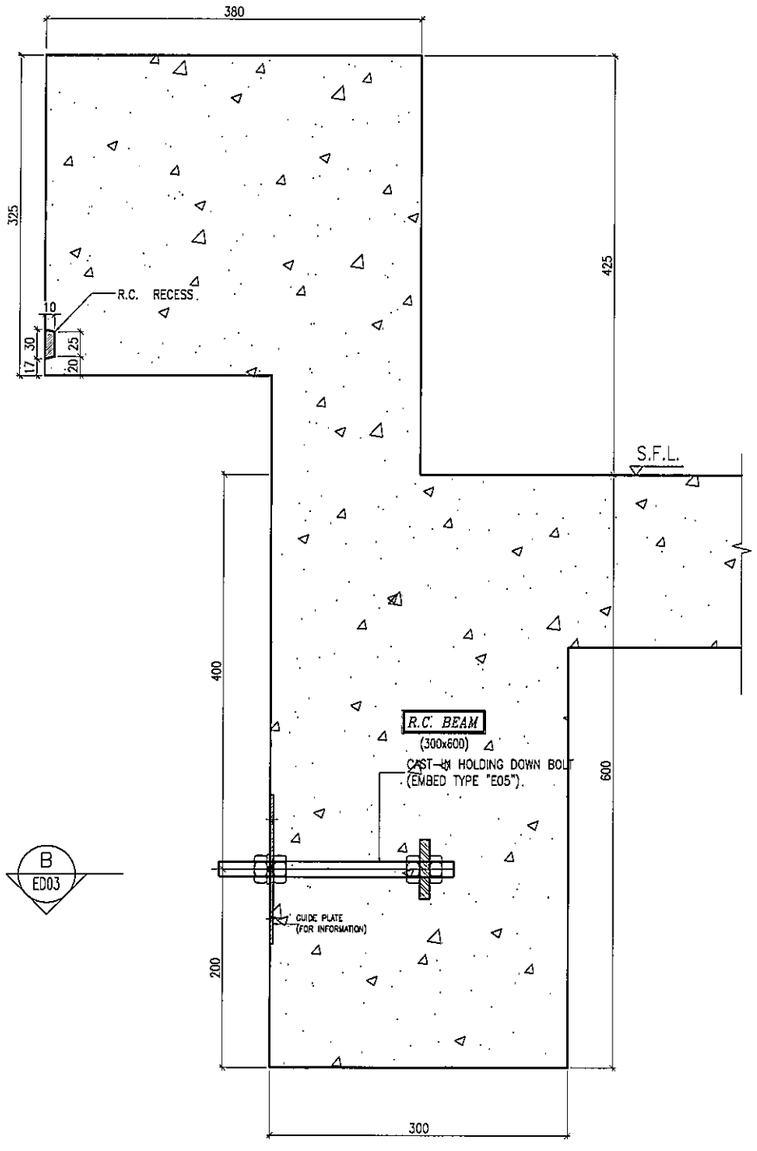

S39 – EMBED INSTALLATION DETAIL
SECTION TYPE "S39"

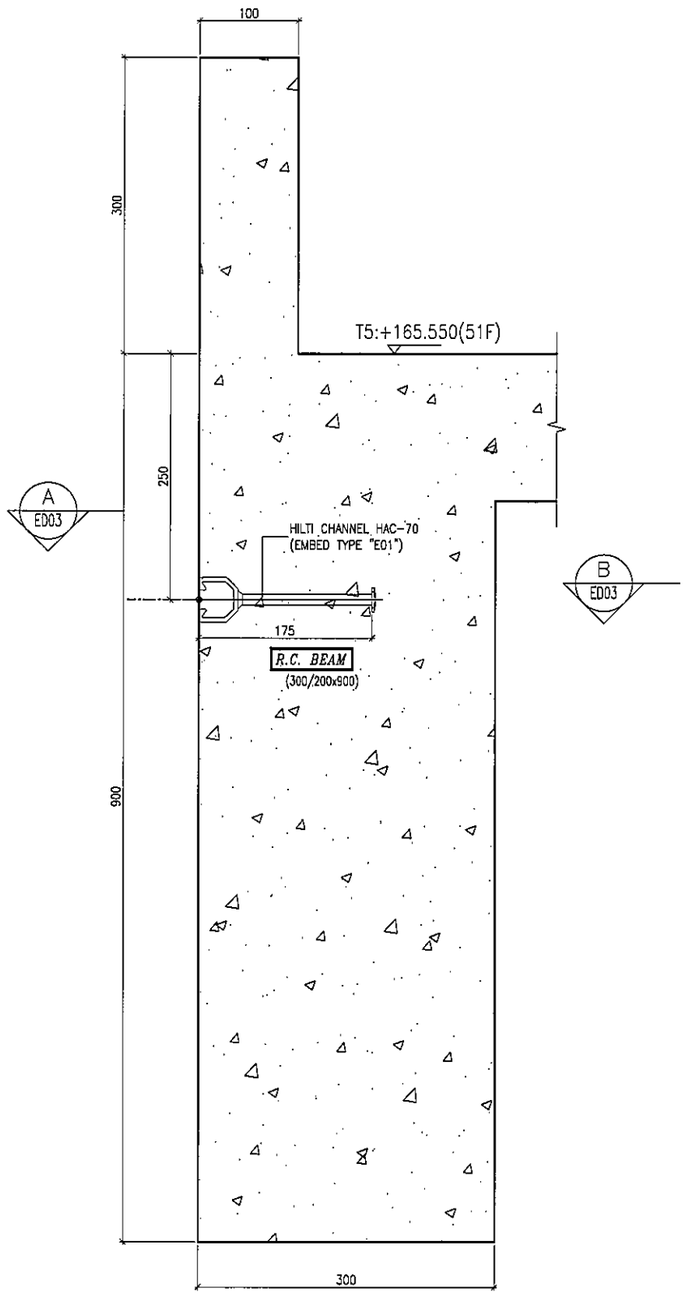

S40 – EMBED INSTALLATION DETAIL
SECTION TYPE "S40"

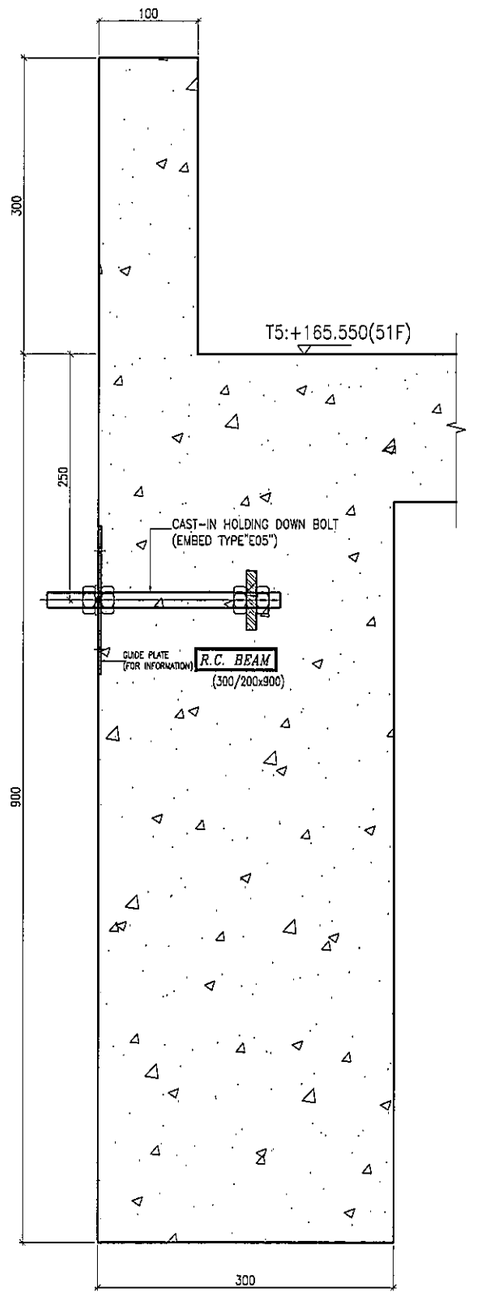

S41 – EMBED INSTALLATION DETAIL
SECTION TYPE "S41"

B.D. REF :

CLIENT :
信和置業有限公司
Sino Land Company Limited

ARCHITECT :
WONG TUNG & PARTNERS LIMITED
ARCHITECTS & PLANNERS

MAIN CONTRACTOR :
CR Construction Company Limited

STRUCTURAL ENGINEER :
AECOM

FACADE CONSULTANT:
AECOM

NOTE :
1. ALL DIMENSIONS ARE IN mm.
2. ALL ELEVATIONS ARE VIEWED FROM OUTSIDE.
3. ALL DIMENSIONS TO BE VERIFIED ON SITE BEFORE FABRICATION.

LEGEND :
X1 / XD01 — DETAIL MARK NO. / REFER SHEET NO.
1. F.F.L. --FINISHED FLOOR LEVEL
2. S.F.L. --STRUCTURAL FLOOR LEVEL
3. /R --REVERSED DETAIL

NO.	DATE	REVISED	BY

JOB NO. : J-837

PROJECT :
URA KWUN TONG TOWN CENTRE
REDEVELOPMENT (AREA 2 & 3) AT
NKIL 6514, KWUN TONG, KWLOON

TITLE :
EMBED TYPICAL DETAILS
FOR CURTAIN WALL

DATE : 24-JUN-19 | SCALE : 1:3 (A1)

DRAWN BY : Asing | CHECKED BY : --

美特鋁質有限公司
MIDI ALUMINIUM FABRICATOR LTD.
Units 6-8, Sunray Industrial Centre, 1/F
610 Cha Kwo Ling Road, Kowloon
Tel:23489211-4 Fax:(852)27727666

DWG NO. : J837-CW-ED17 | REV. : --

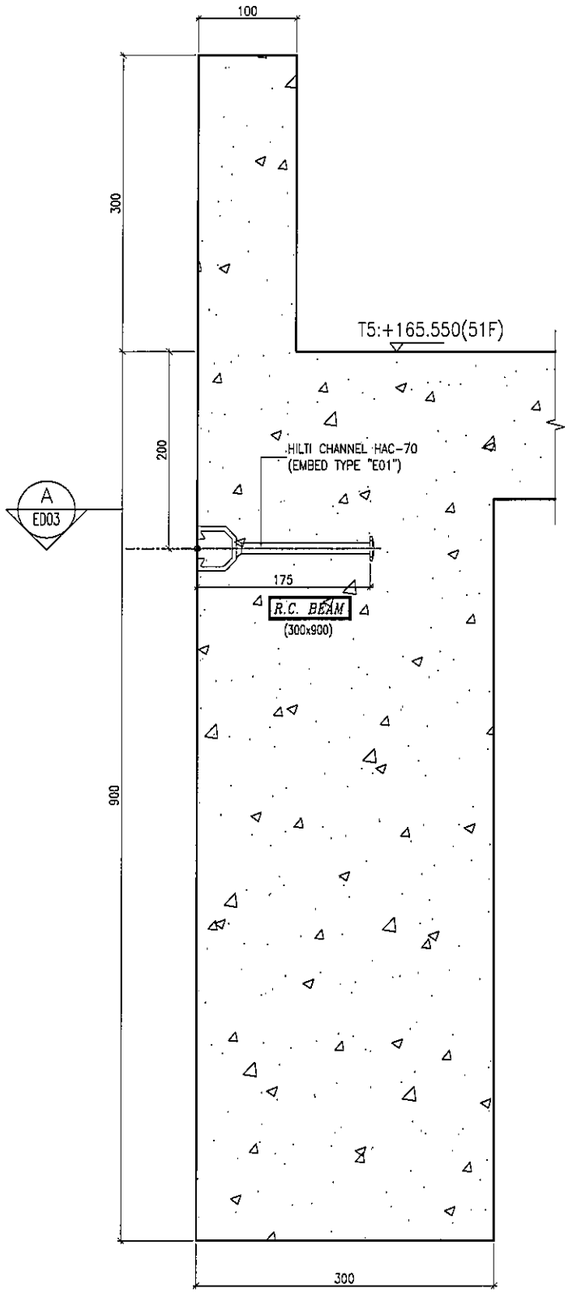

S42 – EMBED INSTALLATION DETAIL
SECTION TYPE "S42"

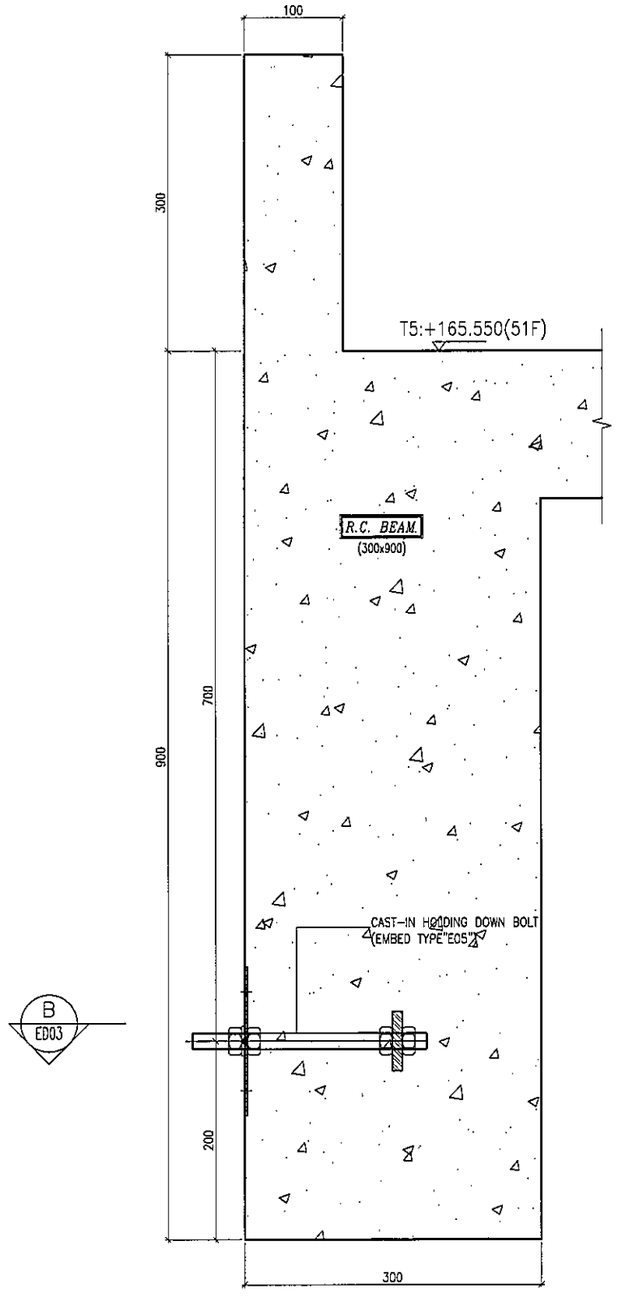

S43 – EMBED INSTALLATION DETAIL
SECTION TYPE "S43"

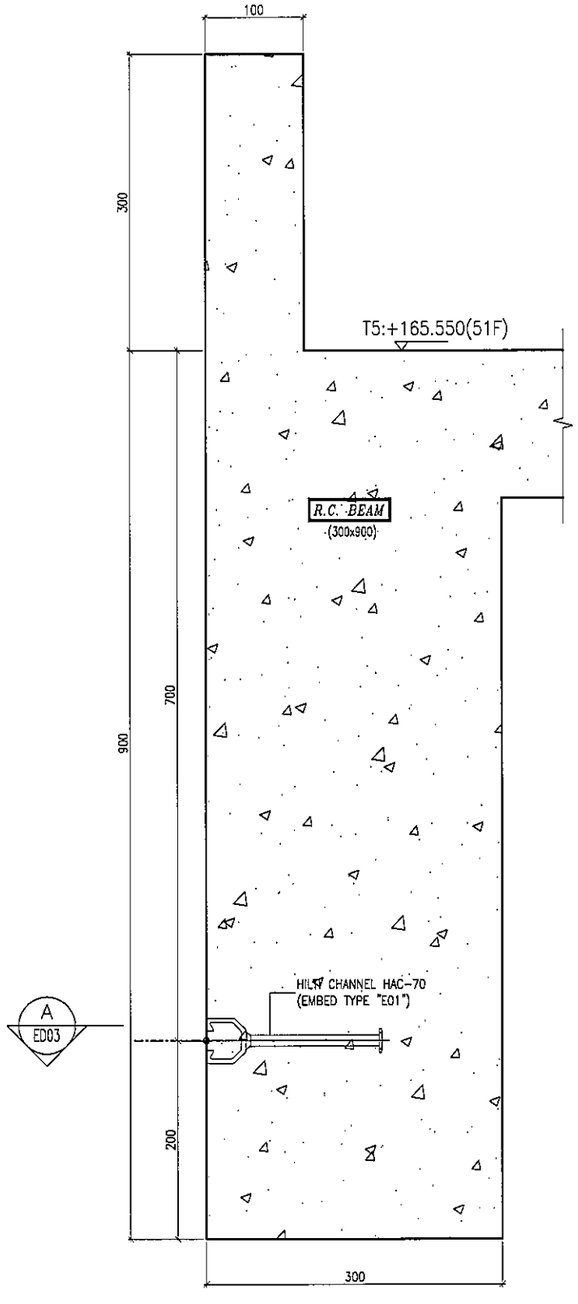

S44 – EMBED INSTALLATION DETAIL
SECTION TYPE "S44"

B.D. REF :

CLIENT :
信和置業有限公司
Sino Land Company Limited

ARCHITECT :
WONG TUNG & PARTNERS LIMITED
ARCHITECTS & PLANNERS

MAIN CONTRACTOR :
CR Construction Company Limited

STRUCTURAL ENGINEER :
AECOM

FACADE CONSULTANT:
AECOM

NOTE :
1. ALL DIMENSIONS ARE IN mm.
2. ALL ELEVATIONS ARE VIEWED FROM OUTSIDE.
3. ALL DIMENSIONS TO BE VERIFIED ON SITE BEFORE FABRICATION.

LEGEND :
X1 / X001 — DETAIL MARK NO. / REFER SHEET NO.
1. F.F.L. --FINISHED FLOOR LEVEL
2. S.F.L. --STRUCTURAL FLOOR LEVEL
3. /R --REVERSED DETAIL

NO.	DATE	REVISED	BY

JOB NO. : J-837

PROJECT :
URA KWUN TONG TOWN CENTRE REDEVELOPMENT (AREA 2 & 3) AT NKIL 6514, KWUN TONG, KWLOON

TITLE :
EMBED TYPICAL DETAILS FOR CURTAIN WALL

DATE : 24-JUN-19	SCALE : 1:3 (A1)
DRAWN BY : Asing	CHECKED BY : -

美特鋁質有限公司
MIDI ALUMINIUM FABRICATOR LTD.
Units 6-8, Sunray Industrial Centre, 1/F
610 Cha Kwo Ling Road, Kowloon
Tel:23489211-4 Fax:(852)27727666

DWG NO. : J837-CW-ED18 | REV. : -

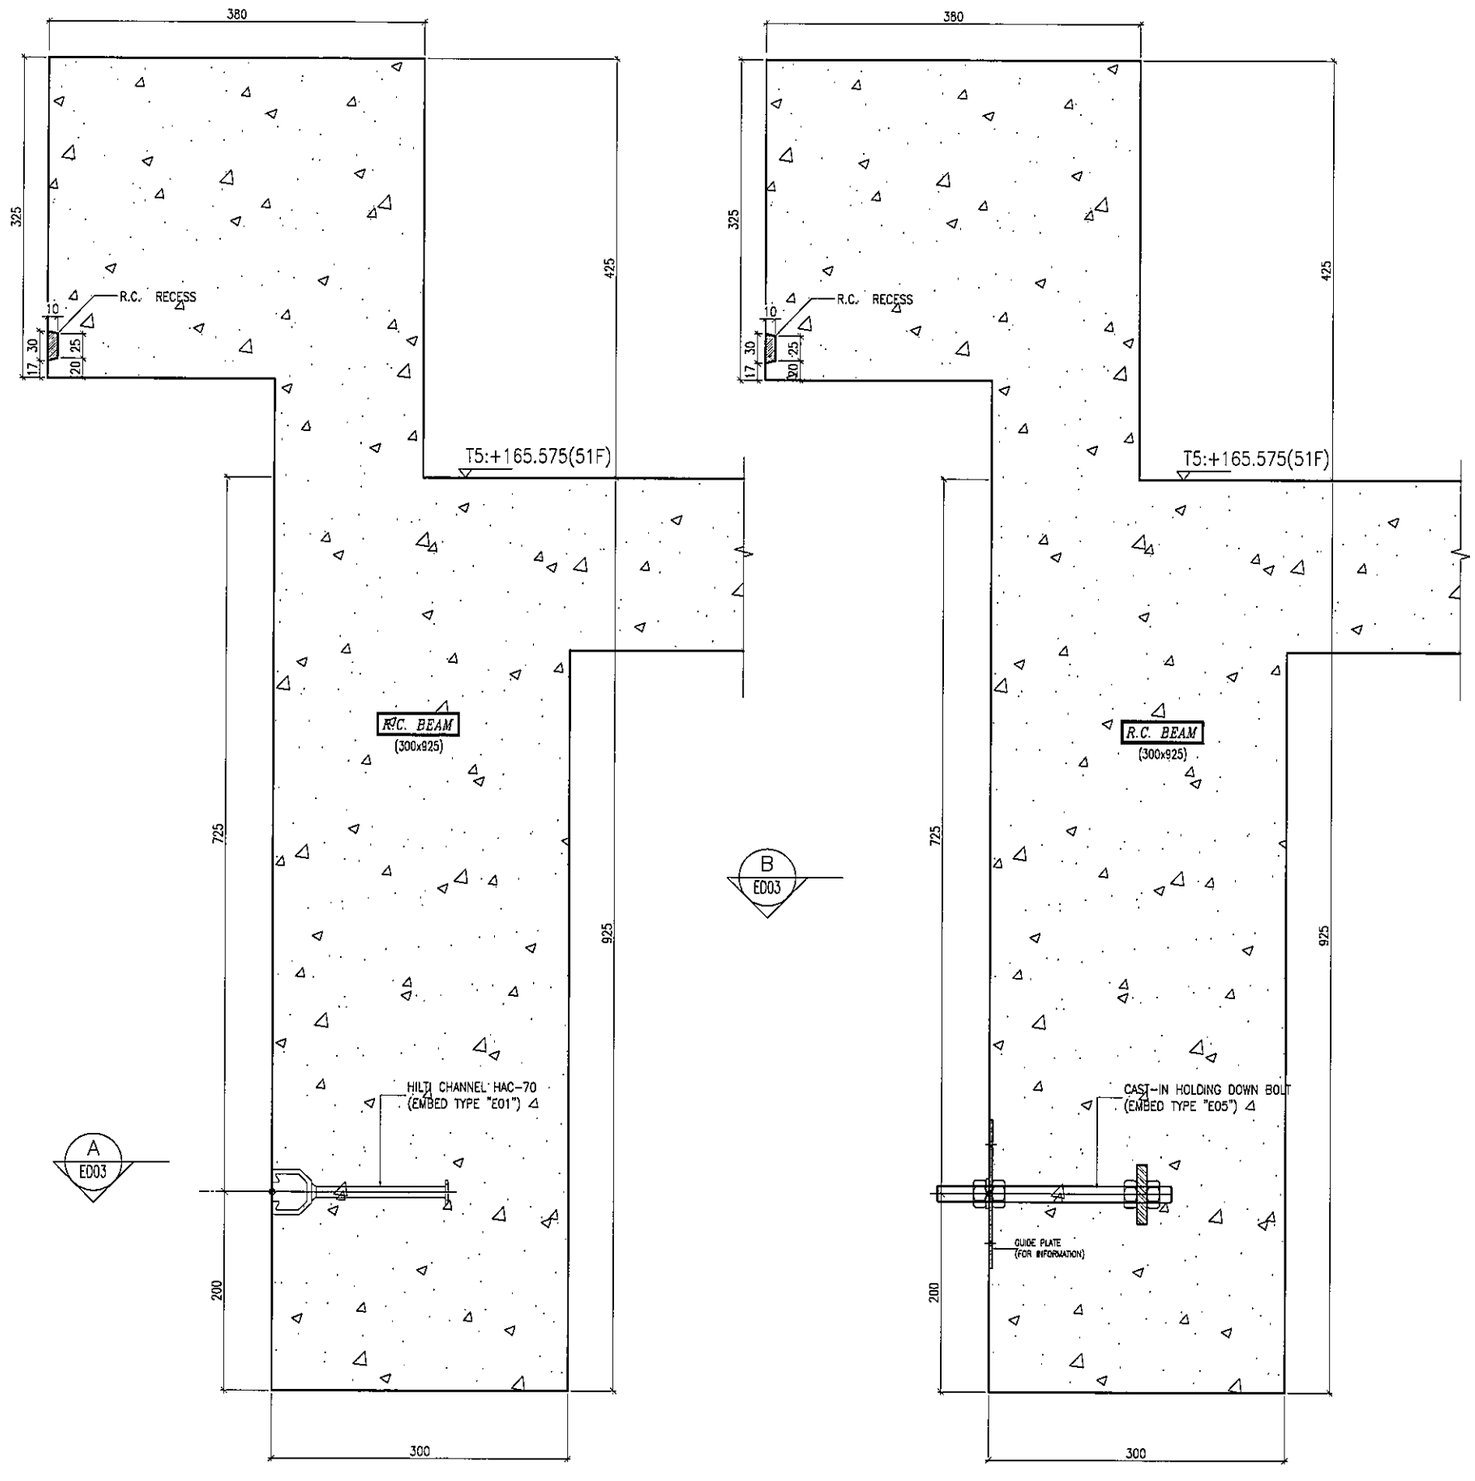

S45 / – EMBED INSTALLATION DETAIL
SECTION TYPE "S45"

S46 / – EMBED INSTALLATION DETAIL
SECTION TYPE "S46"

B.D. REF :

CLIENT :
信和置業有限公司
Sino Land Company Limited

ARCHITECT :
WONG TUNG & PARTNERS LIMITED
ARCHITECTS & PLANNERS

MAIN CONTRACTOR :
CR Construction Company Limited

STRUCTURAL ENGINEER :
AECOM

FACADE CONSULTANT:
AECOM

NOTE :
1. ALL DIMENSIONS ARE IN mm.
2. ALL ELEVATIONS ARE VIEWED FROM OUTSIDE.
3. ALL DIMENSIONS TO BE VERIFIED ON SITE BEFORE FABRICATION.

LEGEND :
X1 / X001 — DETAIL MARK NO. / REFER SHEET NO.
1. F.F.L. --FINISHED FLOOR LEVEL
2. S.F.L. --STRUCTURAL FLOOR LEVEL
3. /R --REVERSED DETAIL

NO.	DATE	REVISED	BY

JOB NO. : J-837

PROJECT :
URA KWUN TONG TOWN CENTRE REDEVELOPMENT (AREA 2 & 3) AT NKIL 6514, KWUN TONG, KWLOON

TITLE :
EMBED TYPICAL DETAILS FOR CURTAIN WALL

DATE : 24-JUN-19 | SCALE : 1:3 (A1)

DRAWN BY : Asing | CHECKED BY : –

美特鋁質有限公司
MIDI ALUMINIUM FABRICATOR LTD.
Units 6-8, Sunray Industrial Centre, 1/F
610 Cha Kwo Ling Road, Kowloon
Tel:23489211-4 Fax:(852)27727666

DWG NO. : J837-CW-ED19 | REV. : –

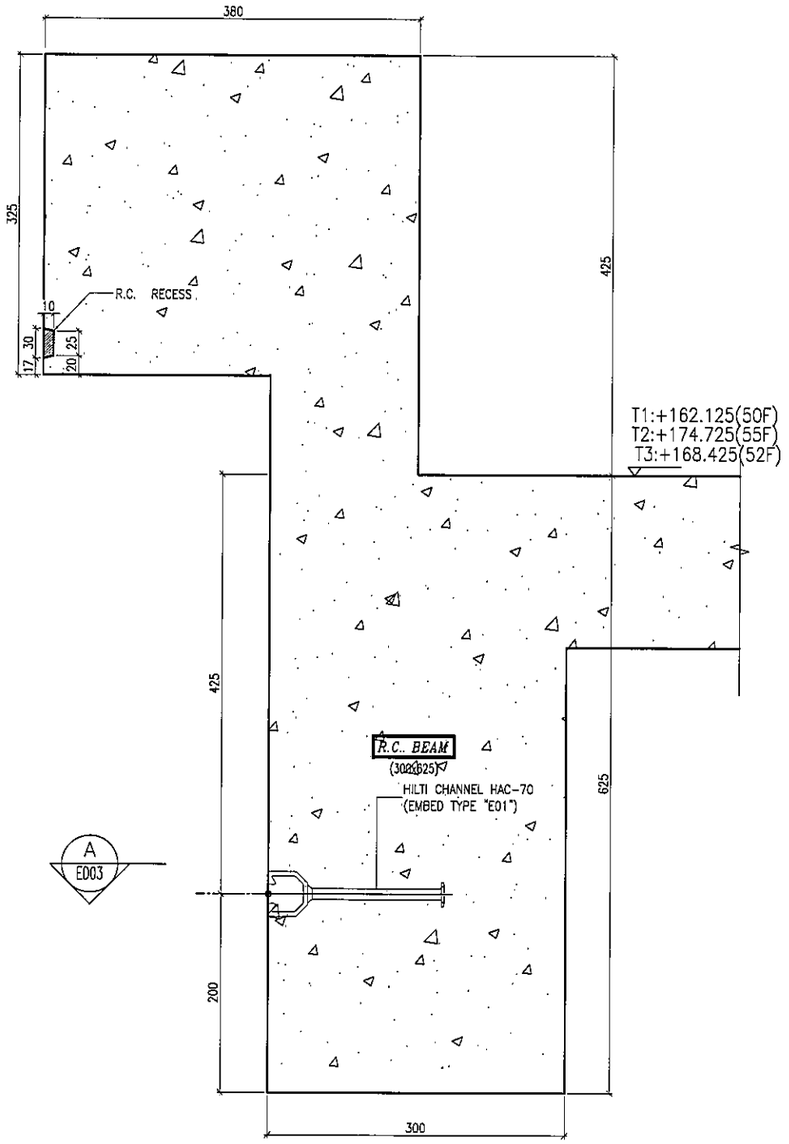

S47 – EMBED INSTALLATION DETAIL SECTION TYPE "S47"

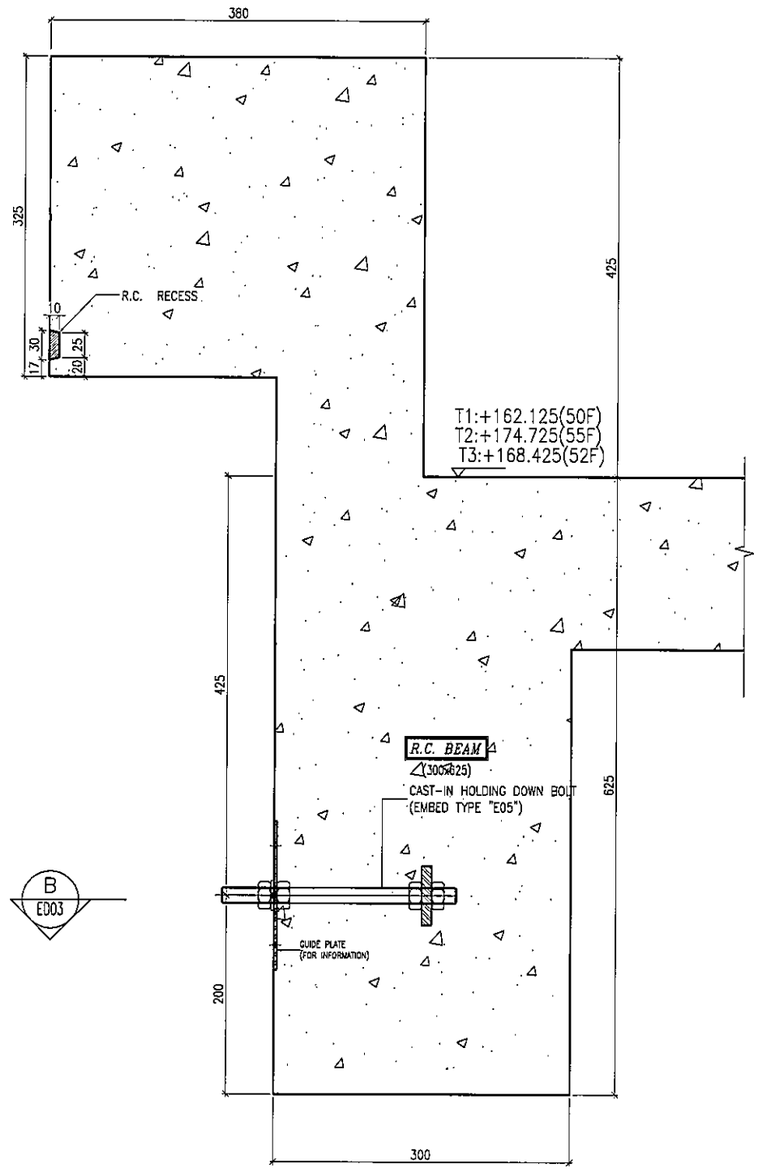

S48 – EMBED INSTALLATION DETAIL SECTION TYPE "S48"

B.D. REF :

CLIENT :
信和置業有限公司
Sino Land Company Limited

ARCHITECT :
WONG TUNG & PARTNERS LIMITED
ARCHITECTS & PLANNERS

MAIN CONTRACTOR :
CR Construction Company Limited

STRUCTURAL ENGINEER :
AECOM

FACADE CONSULTANT:
AECOM

NOTE :
1. ALL DIMENSIONS ARE IN mm.
2. ALL ELEVATIONS ARE VIEWED FROM OUTSIDE.
3. ALL DIMENSIONS TO BE VERIFIED ON SITE BEFORE FABRICATION.

LEGEND :
- X1 / XDG1 — DETAIL MARK NO. / REFER SHEET NO.
1. F.F.L. --FINISHED FLOOR LEVEL
2. S.F.L. --STRUCTURAL FLOOR LEVEL
3. /R --REVERSED DETAIL

NO.	DATE	REVISED	BY

JOB NO. : J-837

PROJECT :
URA KWUN TONG TOWN CENTRE REDEVELOPMENT (AREA 2 & 3) AT NKIL 6514, KWUN TONG, KWLOON

TITLE :
EMBED TYPICAL DETAILS FOR CURTAIN WALL

DATE : 24-JUN-19 | SCALE : 1:3 (A1)

DRAWN BY : Asing | CHECKED BY : -

美特鋁質有限公司
MIDI ALUMINIUM FABRICATOR LTD.
Units 6-8, Sunray Industrial Centre, 1/F
610 Cha Kwo Ling Road, Kowloon
Tel:23489211-4 Fax:(852)27727666

DWG NO. : J837-CW-ED20 | REV. : -

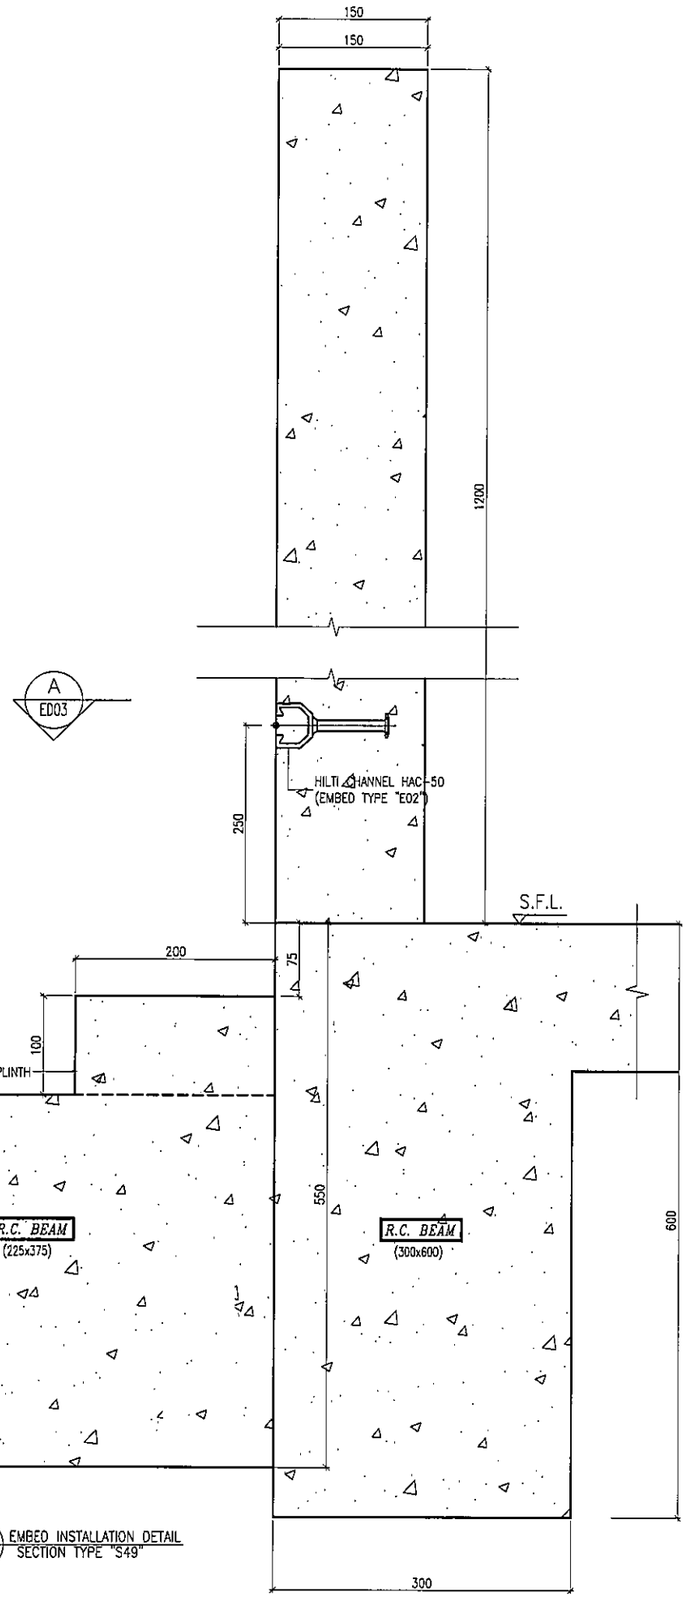

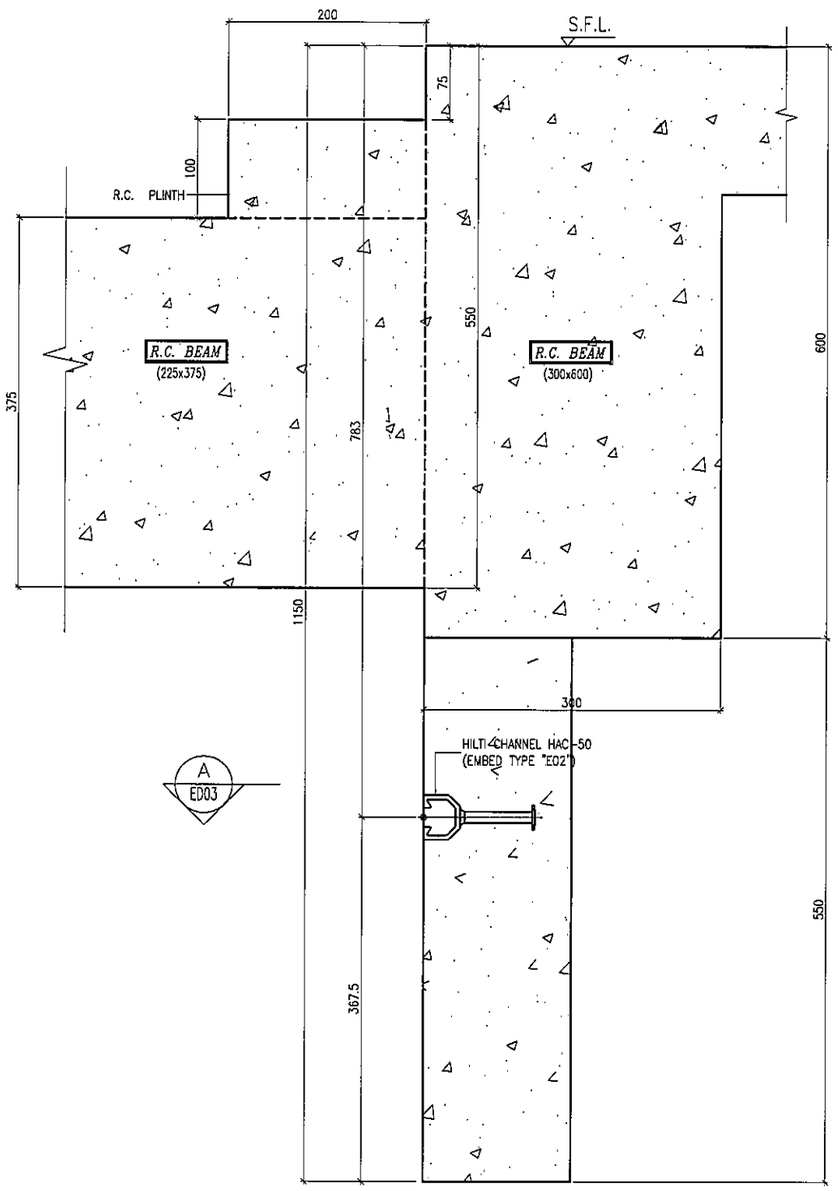

B.D. REF :

CLIENT :
信和置業有限公司
Sino Land Company Limited

ARCHITECT :
WONG TUNG & PARTNERS LIMITED
ARCHITECTS & PLANNERS

MAIN CONTRACTOR :
CR Construction Company Limited

STRUCTURAL ENGINEER :
AECOM

FACADE CONSULTANT:
AECOM

NOTE :
1. ALL DIMENSIONS ARE IN mm.
2. ALL ELEVATIONS ARE VIEWED FROM OUTSIDE.
3. ALL DIMENSIONS TO BE VERIFIED ON SITE BEFORE FABRICATION.

LEGEND :
X1 / X001 — DETAIL MARK NO. / REFER SHEET NO.
1. F.F.L. --FINISHED FLOOR LEVEL
2. S.F.L. --STRUCTURAL FLOOR LEVEL
3. /R --REVERSED DETAIL

NO.	DATE	REVISED	BY

JOB NO. : J-837

PROJECT :
URA KWUN TONG TOWN CENTRE REDEVELOPMENT (AREA 2 & 3) AT NKIL 6514, KWUN TONG, KWLOON

TITLE :
EMBED TYPICAL DETAILS FOR CURTAIN WALL

DATE : 18-AUG-19	SCALE : 1:3 (A1)
DRAWN BY : Asing	CHECKED BY : -

美特鋁質有限公司
MIDI ALUMINIUM FABRICATOR LTD.
Units 6-8, Sunray Industrial Centre, 1/F
610 Cha Kwo Ling Road, Kowloon
Tel:23489211-4 Fax:(852)27727666

DWG NO. : J837-CW-ED21 | REV. : -

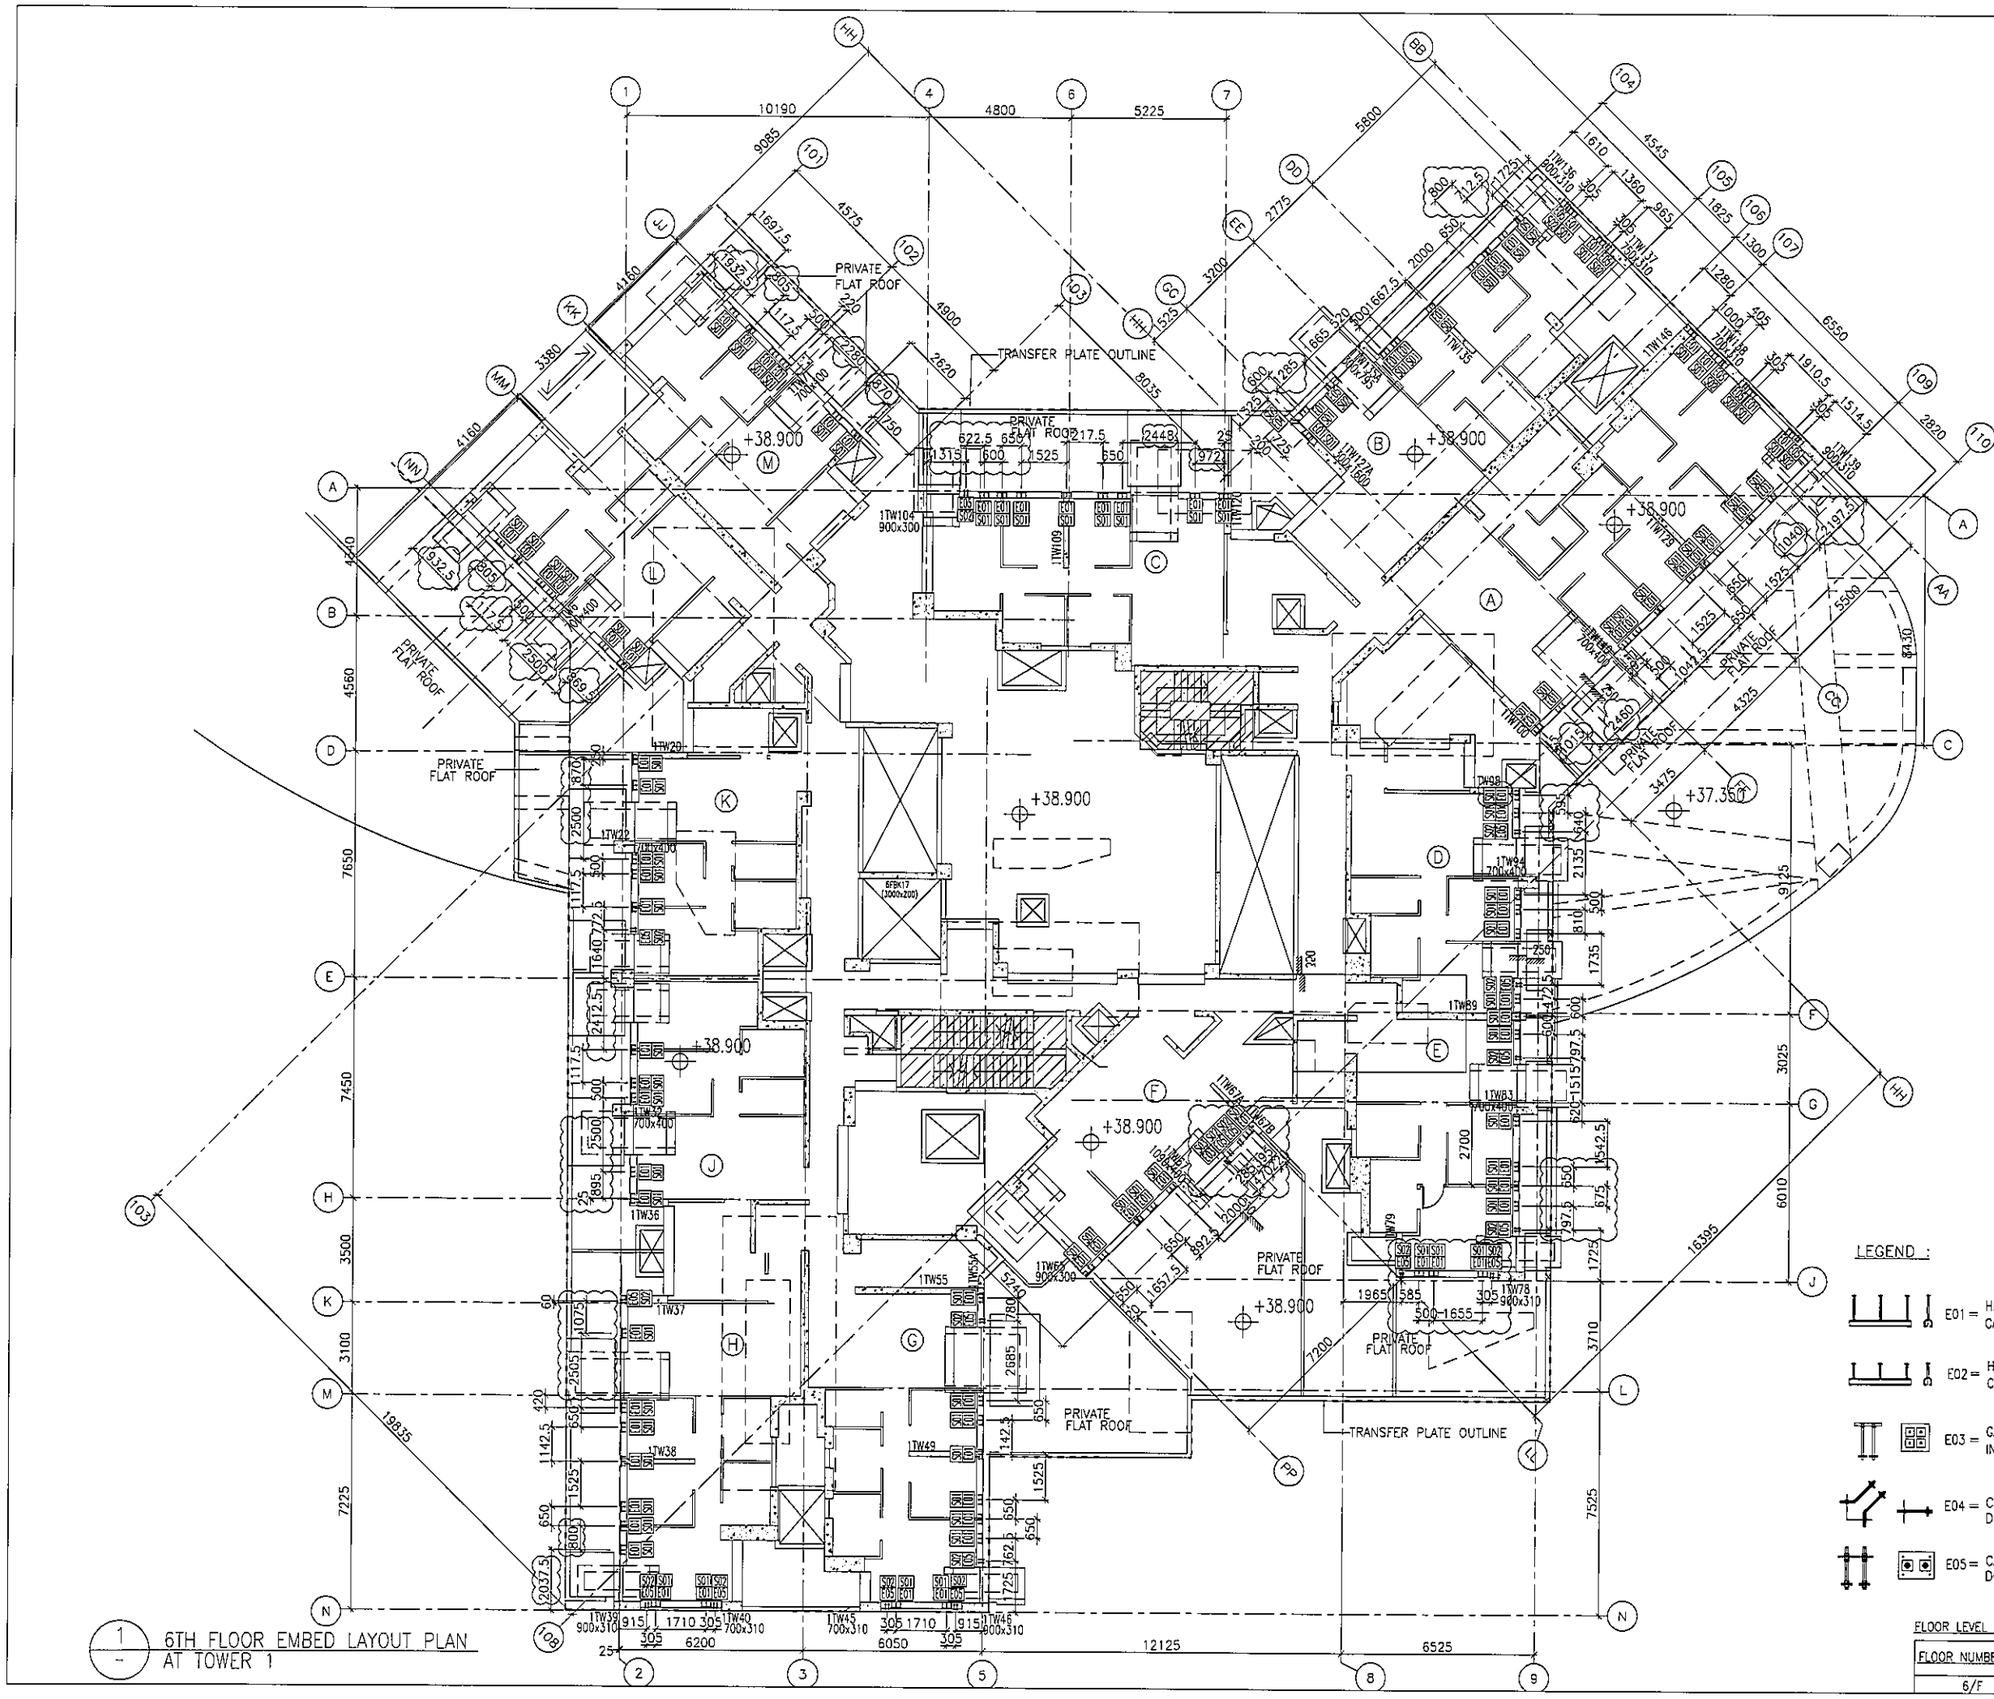
PRIVATE FLAT ROOF
TRANSFER PLATE OUTLINE
+38.900
+37.350
10190
4800
5225
9085
4575
4900
2620
8035
5800
3200
2775
4160
3380
4560
7650
7450
3500
3100
7225
19835
12125
6525
6200
6050
16395
7525
6010
3025
9125
4325
5500
7200
3710
2700
1TW104 900x300
1TW45 700x310
1TW46 900x310
1TW39 900x310
1TW40 700x310
1TW45A 900x310
1TW78 900x310
1TW94 700x410
1TW98 700x400
1TW99 700x400
1TW100 700x400
1TW127A 900x310
1TW127B 900x310
1TW128 900x310
1TW129 900x310
1TW135 900x310
1TW136 900x310
1TW137 900x310
1TW138 900x310
1TW146 900x310
1TW147 900x310
LEGEND :

- E01 = HILIT , HAC-70 CAST IN CHANNEL
- E02 = HILIT , HAC-50 CAST IN CHANNEL
- E03 = GAL. MILD STEEL CAST IN EMBED
- E04 = CAST-IN HOLDING DOWN BOLT
- E05 = CAST-IN HOLDING DOWN BOLT

USED ONLY ON THE 7TH BOTTOM

USED ONLY ON THE 7TH BOTTOM


FLOOR LEVEL (S.F.L.)(T1)

FLOOR NUMBERING	LEVEL (mPD)
9F	48.700
10F	51.850
11F	55.000
12F	58.150
15F	61.300
16F	64.450
17F	67.600
18F	70.750
19F	73.900
20F	77.050
21F	80.200
22F	83.350
23F	86.500
25F	89.650
26F	92.800
29F	102.250
30F	105.400
31F	108.550
32F	111.700
33F	114.850
35F	118.000
36F	121.150
37F	124.300
38F	127.450
39F	130.600
40F	133.750
41F	136.900
42F	140.050
43F	143.100
45F	146.350
46F	149.500
47F	152.650
48F	155.800
49F	158.950

B.D. REF :

CLIENT : 信和置業有限公司 Sino Land Company Limited

ARCHITECT : WONG TUNG & PARTNERS LIMITED ARCHITECTS & PLANNERS

MAIN CONTRACTOR : CR Construction Company Limited

STRUCTURAL ENGINEER : AECOM

FACADE CONSULTANT: AECOM

NOTE :
1. ALL DIMENSIONS ARE IN mm.
2. ALL ELEVATIONS ARE VIEWED FROM OUTSIDE.
3. ALL DIMENSIONS TO BE VERIFIED ON SITE BEFORE FABRICATION.

LEGEND :
- (X1 / X001) — DETAIL MARK NO. / REFER SHEET NO.

1. F.F.L. --FINISHED FLOOR LEVEL
2. S.F.L. --STRUCTURAL FLOOR LEVEL
3. (/R) --REVERSED DETAIL

NO.	DATE	REVISED	BY
L	18/08/2019	GENERAL REVISED	
K	16/07/2019	GENERAL REVISED	
J	07/04/2019	GENERAL REVISED	
I	28/01/2019	GENERAL REVISED	
H	19/01/2019	GENERAL REVISED	
G	22/12/2018	GENERAL REVISED	
F	01/12/2018	GENERAL REVISED	
E	08/11/2018	GENERAL REVISED	
D	13/10/2018	GENERAL REVISED	
C	14/9/2018	GENERAL REVISED	
B	23/8/2018	GENERAL REVISED	
A	31/7/2018	GENERAL REVISED	

JOB NO. : J-837

PROJECT : URA KWUN TONG TOWN CENTRE REDEVELOPMENT (AREA 2 & 3) AT NKIL 6514, KWUN TONG, KWLOON

TITLE : TYPICAL FLOOR EMBED LAYOUT PLAN OF CURTAIN WALL AT TOWER 1

DATE : 04-JUL-18 | SCALE : 1:100 (A1)

DRAWN BY : ASING | CHECKED BY : -

美特鋁製有限公司 MIDI ALUMINIUM FABRICATOR LTD.
Units 6-8, Sunray Industrial Centre, 1/F
610 Cha Kwo Ling Road, Kowloon
Tel:23489211-4 Fax:(852)27727666

DWG NO. : J837-CW-1102 | REV. : L

LEGEND :

- E01 = HILIT , HAC-70 CAST IN CHANNEL
- E02 = HILIT , HAC-50 CAST IN CHANNEL
- E03 = GAL. MILD STEEL CAST IN EMBED
- E04 = CAST-IN HOLDING DOWN BOLT
- E05 = CAST-IN HOLDING DOWN BOLT
- E06 = CAST-IN HOLDING DOWN BOLT
- E07 = CAST-IN HOLDING DOWN BOLT

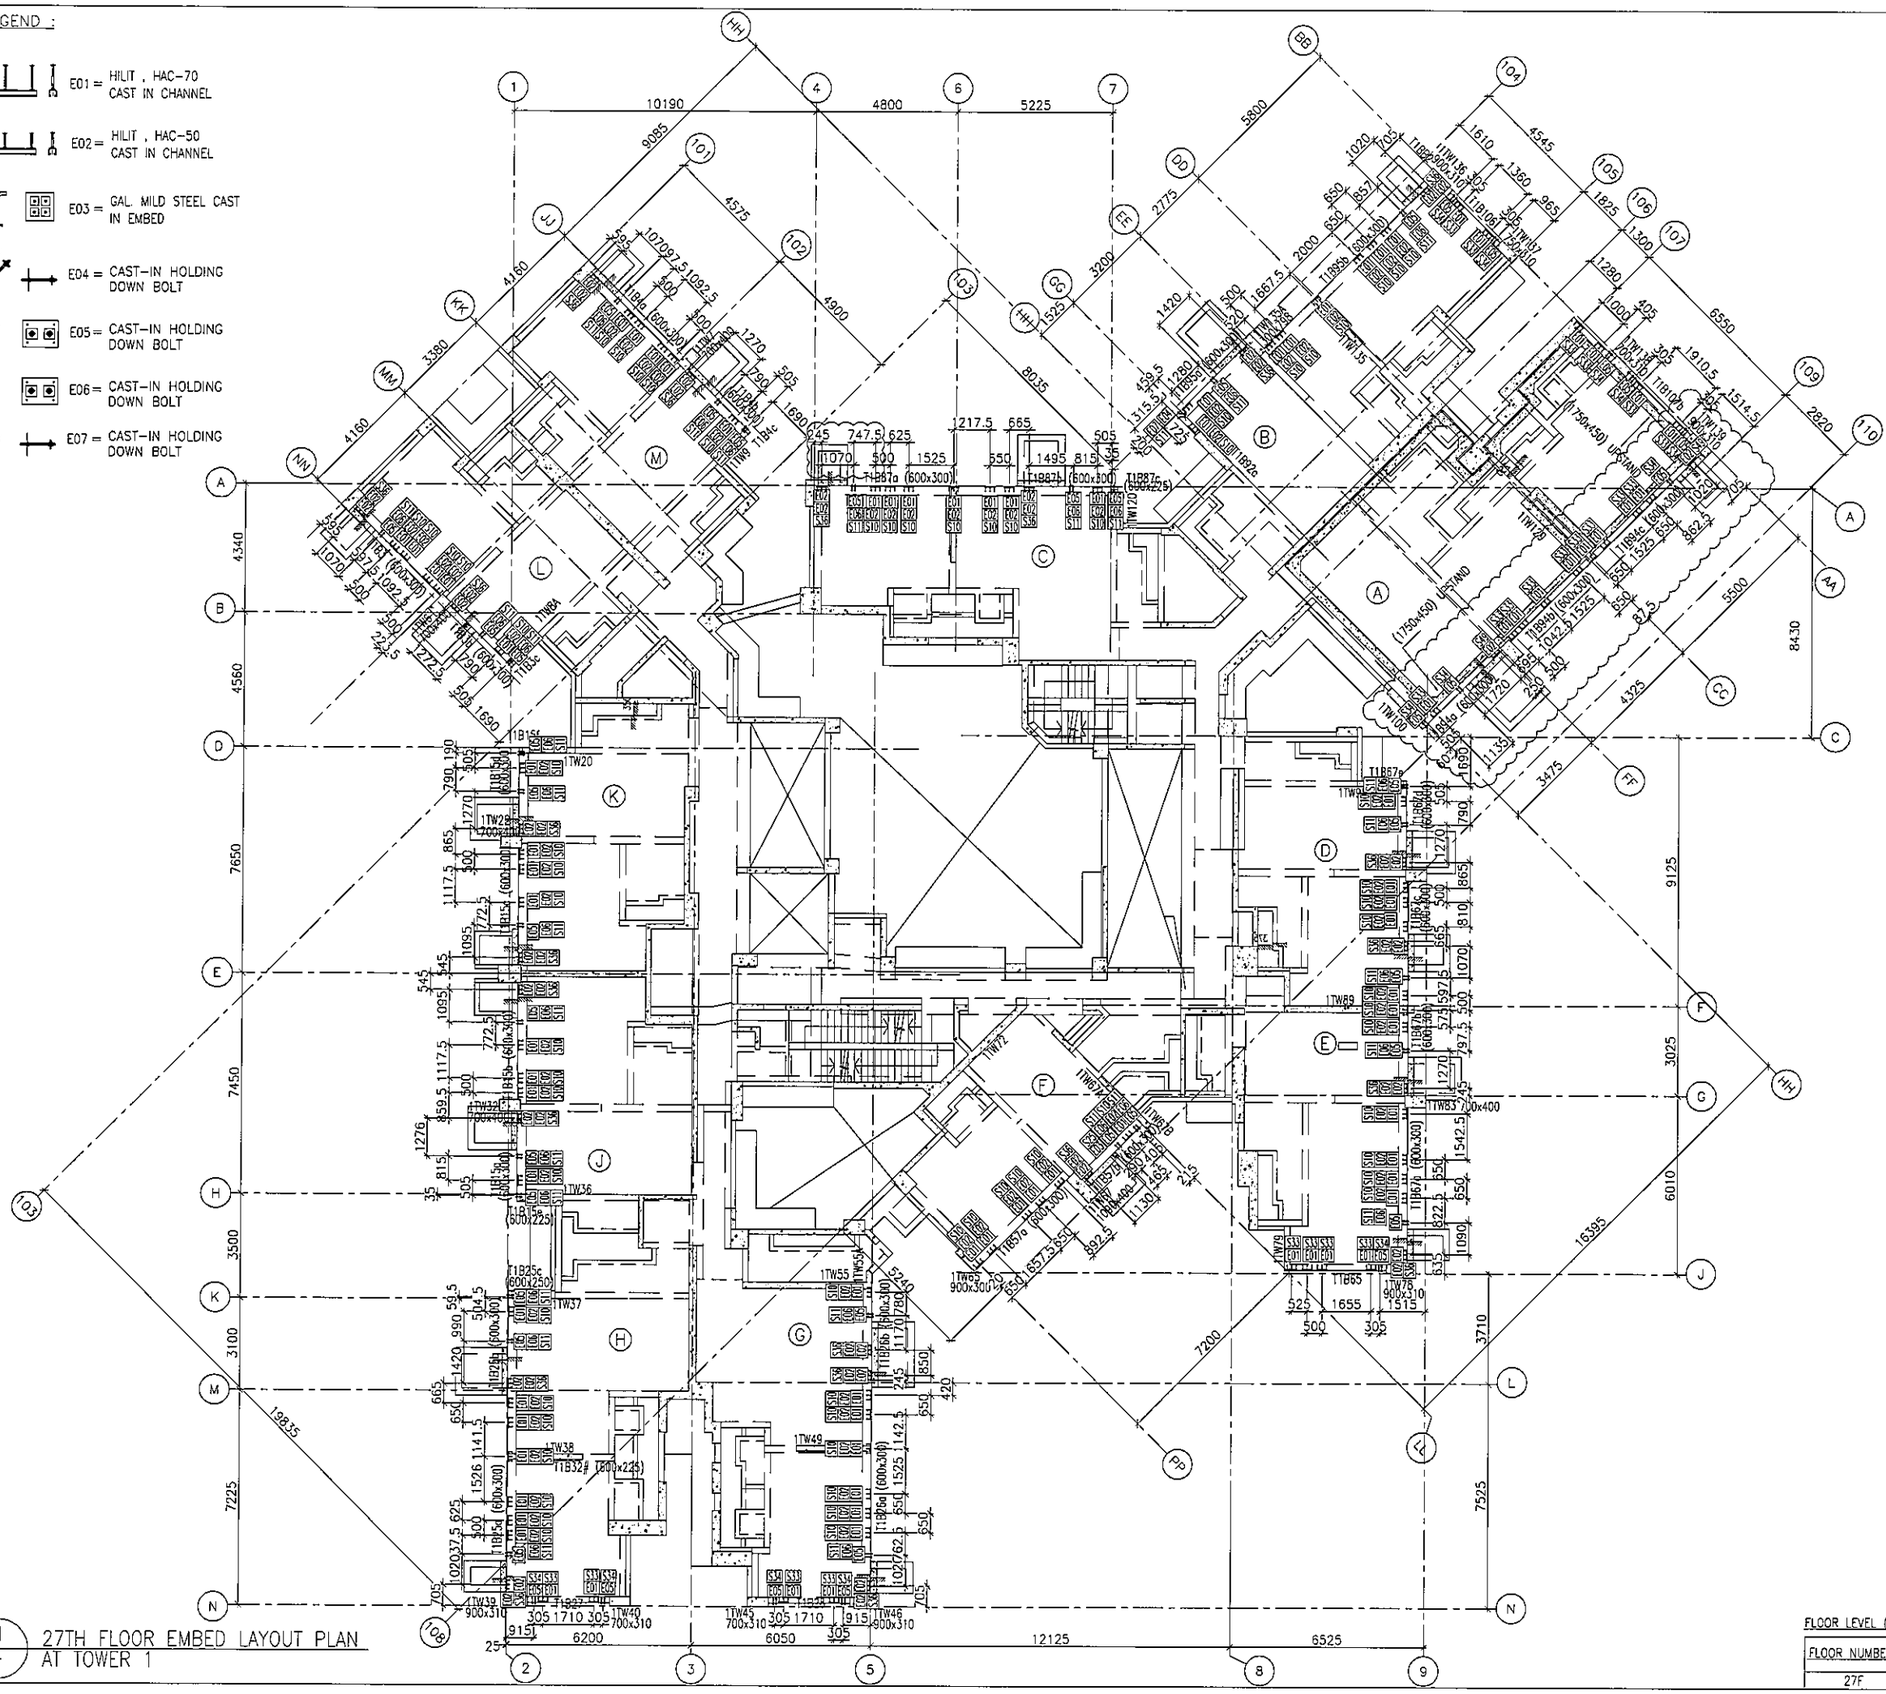

1/- 27TH FLOOR EMBED LAYOUT PLAN AT TOWER 1

FLOOR LEVEL (S.F.L.)(T1)

FLOOR NUMBERING	LEVEL (mPD)
27F	+95.95

B.D. REF :

CLIENT :
信和置業有限公司
Sino Land Company Limited

ARCHITECT :
WONG TUNG & PARTNERS LIMITED
ARCHITECTS & PLANNERS

MAIN CONTRACTOR :
CR Construction Company Limited

STRUCTURAL ENGINEER :
AECOM

FACADE CONSULTANT:
AECOM

NOTE :
1. ALL DIMENSIONS ARE IN mm.
2. ALL ELEVATIONS ARE VIEWED FROM OUTSIDE.
3. ALL DIMENSIONS TO BE VERIFIED ON SITE BEFORE FABRICATION.

LEGEND :
- X1 / X001 — DETAIL MARK NO. / REFER SHEET NO.

1. F.F.L. --FINISHED FLOOR LEVEL
2. S.F.L. --STRUCTURAL FLOOR LEVEL
3. /R --REVERSED DETAIL

NO.	DATE	REVISED	BY
J	18/08/2019	GENERAL REVISED	
I	07/04/2019	GENERAL REVISED	
H	21/02/2019	GENERAL REVISED	
G	19/01/2019	GENERAL REVISED	
F	22/12/2018	GENERAL REVISED	
E	01/12/2018	GENERAL REVISED	
D	08/11/2018	GENERAL REVISED	
C	13/10/2018	GENERAL REVISED	
B	14/9/2018	GENERAL REVISED	
A	07/9/2018	GENERAL REVISED	

JOB NO. : J-837

PROJECT :
URA KWUN TONG TOWN CENTRE REDEVELOPMENT (AREA 2 & 3) AT NKIL 6514, KWUN TONG, KWLOON

TITLE :
27TH FLOOR EMBED LAYOUT PLAN OF CURTAIN WALL AT TOWER 1

DATE : 10-SEP-18 | SCALE : 1:100 (A1)

DRAWN BY : ASING | CHECKED BY : -

美特鋁製有限公司
MIDI ALUMINIUM FABRICATOR LTD.
Units 6-8, Sunray Industrial Centre, 1/F
610 Cha Kwo Ling Road, Kowloon
Tel:23489211-4 Fax:(852)27727666

DWG NO. : J837-CW-1103 | REV. : J

LEGEND :

- E01 = HILIT , HAC-70 CAST IN CHANNEL
- E02 = HILIT , HAC-50 CAST IN CHANNEL
- E03 = GAL. MILD STEEL CAST IN EMBED
- E04 = CAST-IN HOLDING DOWN BOLT
- E05 = CAST-IN HOLDING DOWN BOLT

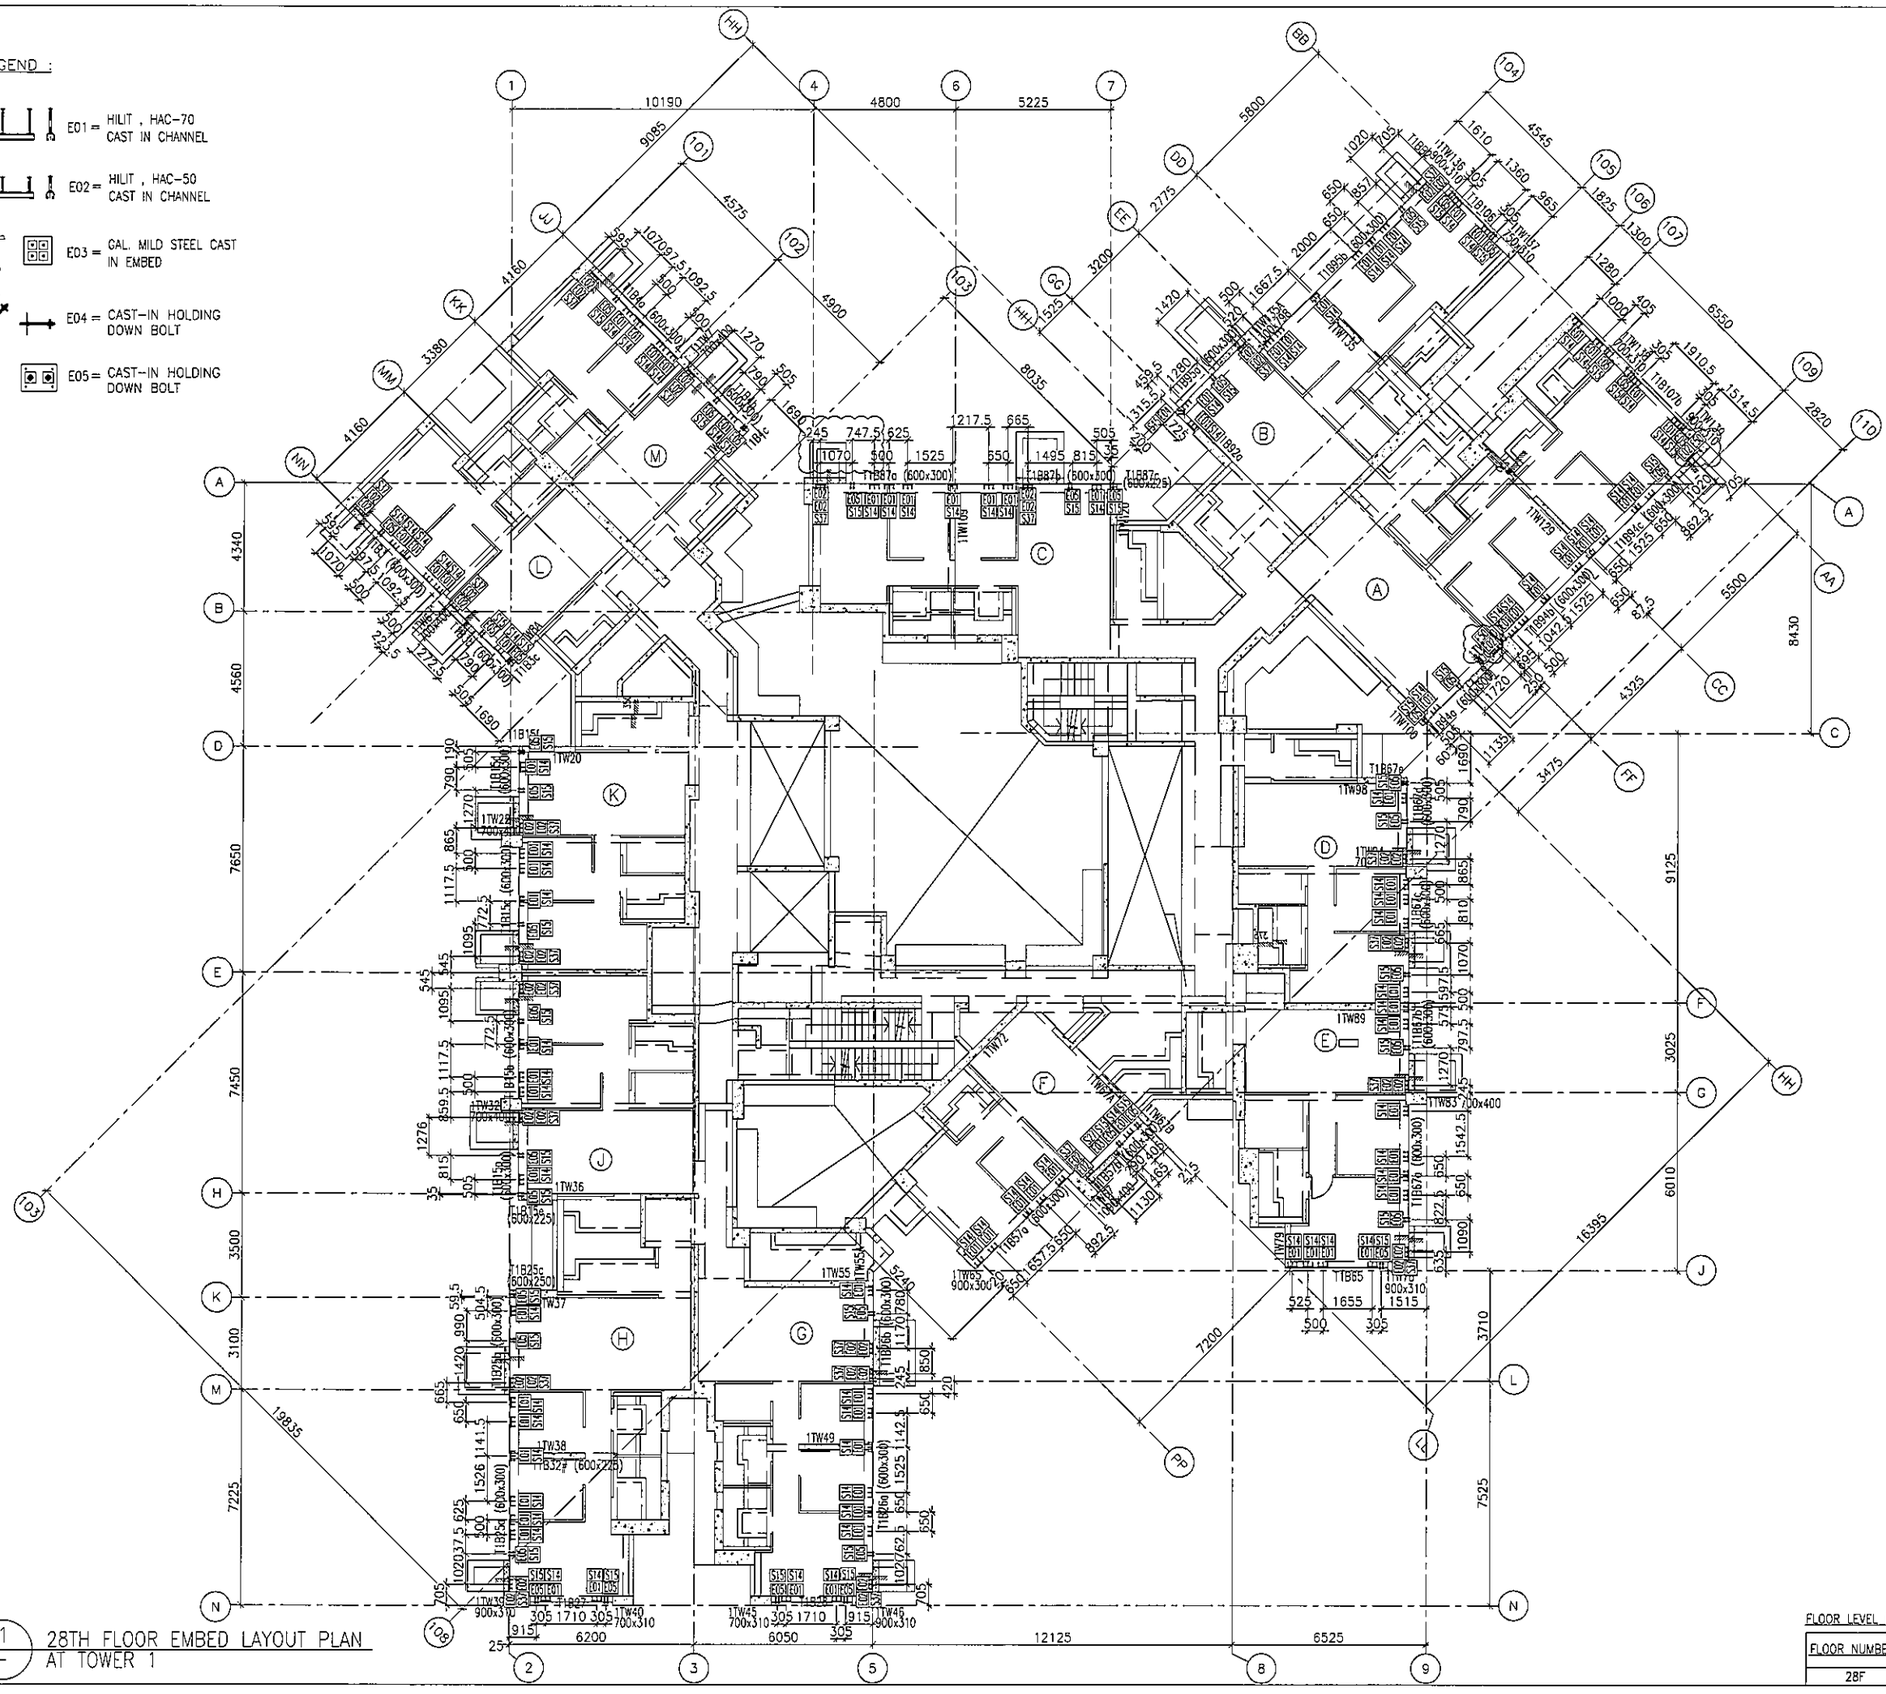

1/- 28TH FLOOR EMBED LAYOUT PLAN AT TOWER 1

FLOOR LEVEL (S.F.L)(T1)

FLOOR NUMBERING	LEVEL (mPD)
28F	+99.100

B.D. REF :

CLIENT : 信和置業有限公司 Sino Land Company Limited

ARCHITECT : WONG TUNG & PARTNERS LIMITED ARCHITECTS & PLANNERS

MAIN CONTRACTOR : CR Construction Company Limited

STRUCTURAL ENGINEER : AECOM

FACADE CONSULTANT: AECOM

NOTE :
1. ALL DIMENSIONS ARE IN mm.
2. ALL ELEVATIONS ARE VIEWED FROM OUTSIDE.
3. ALL DIMENSIONS TO BE VERIFIED ON SITE BEFORE FABRICATION.

LEGEND :
- X1 / X001 — DETAIL MARK NO. / REFER SHEET NO.
1. F.F.L. --FINISHED FLOOR LEVEL
2. S.F.L. --STRUCTURAL FLOOR LEVEL
3. /R --REVERSED DETAIL

NO.	DATE	REVISED	BY
I	18/08/2019	GENERAL REVISED	
H	07/04/2019	GENERAL REVISED	
G	21/02/2019	GENERAL REVISED	
F	19/01/2019	GENERAL REVISED	
E	22/12/2018	GENERAL REVISED	
D	01/12/2018	GENERAL REVISED	
C	08/11/2018	GENERAL REVISED	
B	13/10/2018	GENERAL REVISED	
A	14/9/2018	GENERAL REVISED	

JOB NO. : J-837

PROJECT : URA KWUN TONG TOWN CENTRE REDEVELOPMENT (AREA 2 & 3) AT NKIL 6514, KWUN TONG, KWLOON

TITLE : 28TH FLOOR EMBED LAYOUT PLAN OF CURTAIN WALL AT TOWER 1

DATE : 10-SEP-18 | SCALE : 1:100 (A1)

DRAWN BY : ASING | CHECKED BY : -

美特鋁質有限公司 MIDI ALUMINIUM FABRICATOR LTD.
Units 6-8, Sunray Industrial Centre, 1/F
610 Cha Kwo Ling Road, Kowloon
Tel:23489211-4 Fax:(852)27727666

DWG NO. : J837-CW-1104 | REV. : I

LEGEND :

- EO1 = HILIT , HAC-70 CAST IN CHANNEL
- EO2 = HILIT , HAC-50 CAST IN CHANNEL
- EO3 = GAL. MILD STEEL CAST IN EMBED
- EO4 = CAST-IN HOLDING DOWN BOLT
- EO5 = CAST-IN HOLDING DOWN BOLT

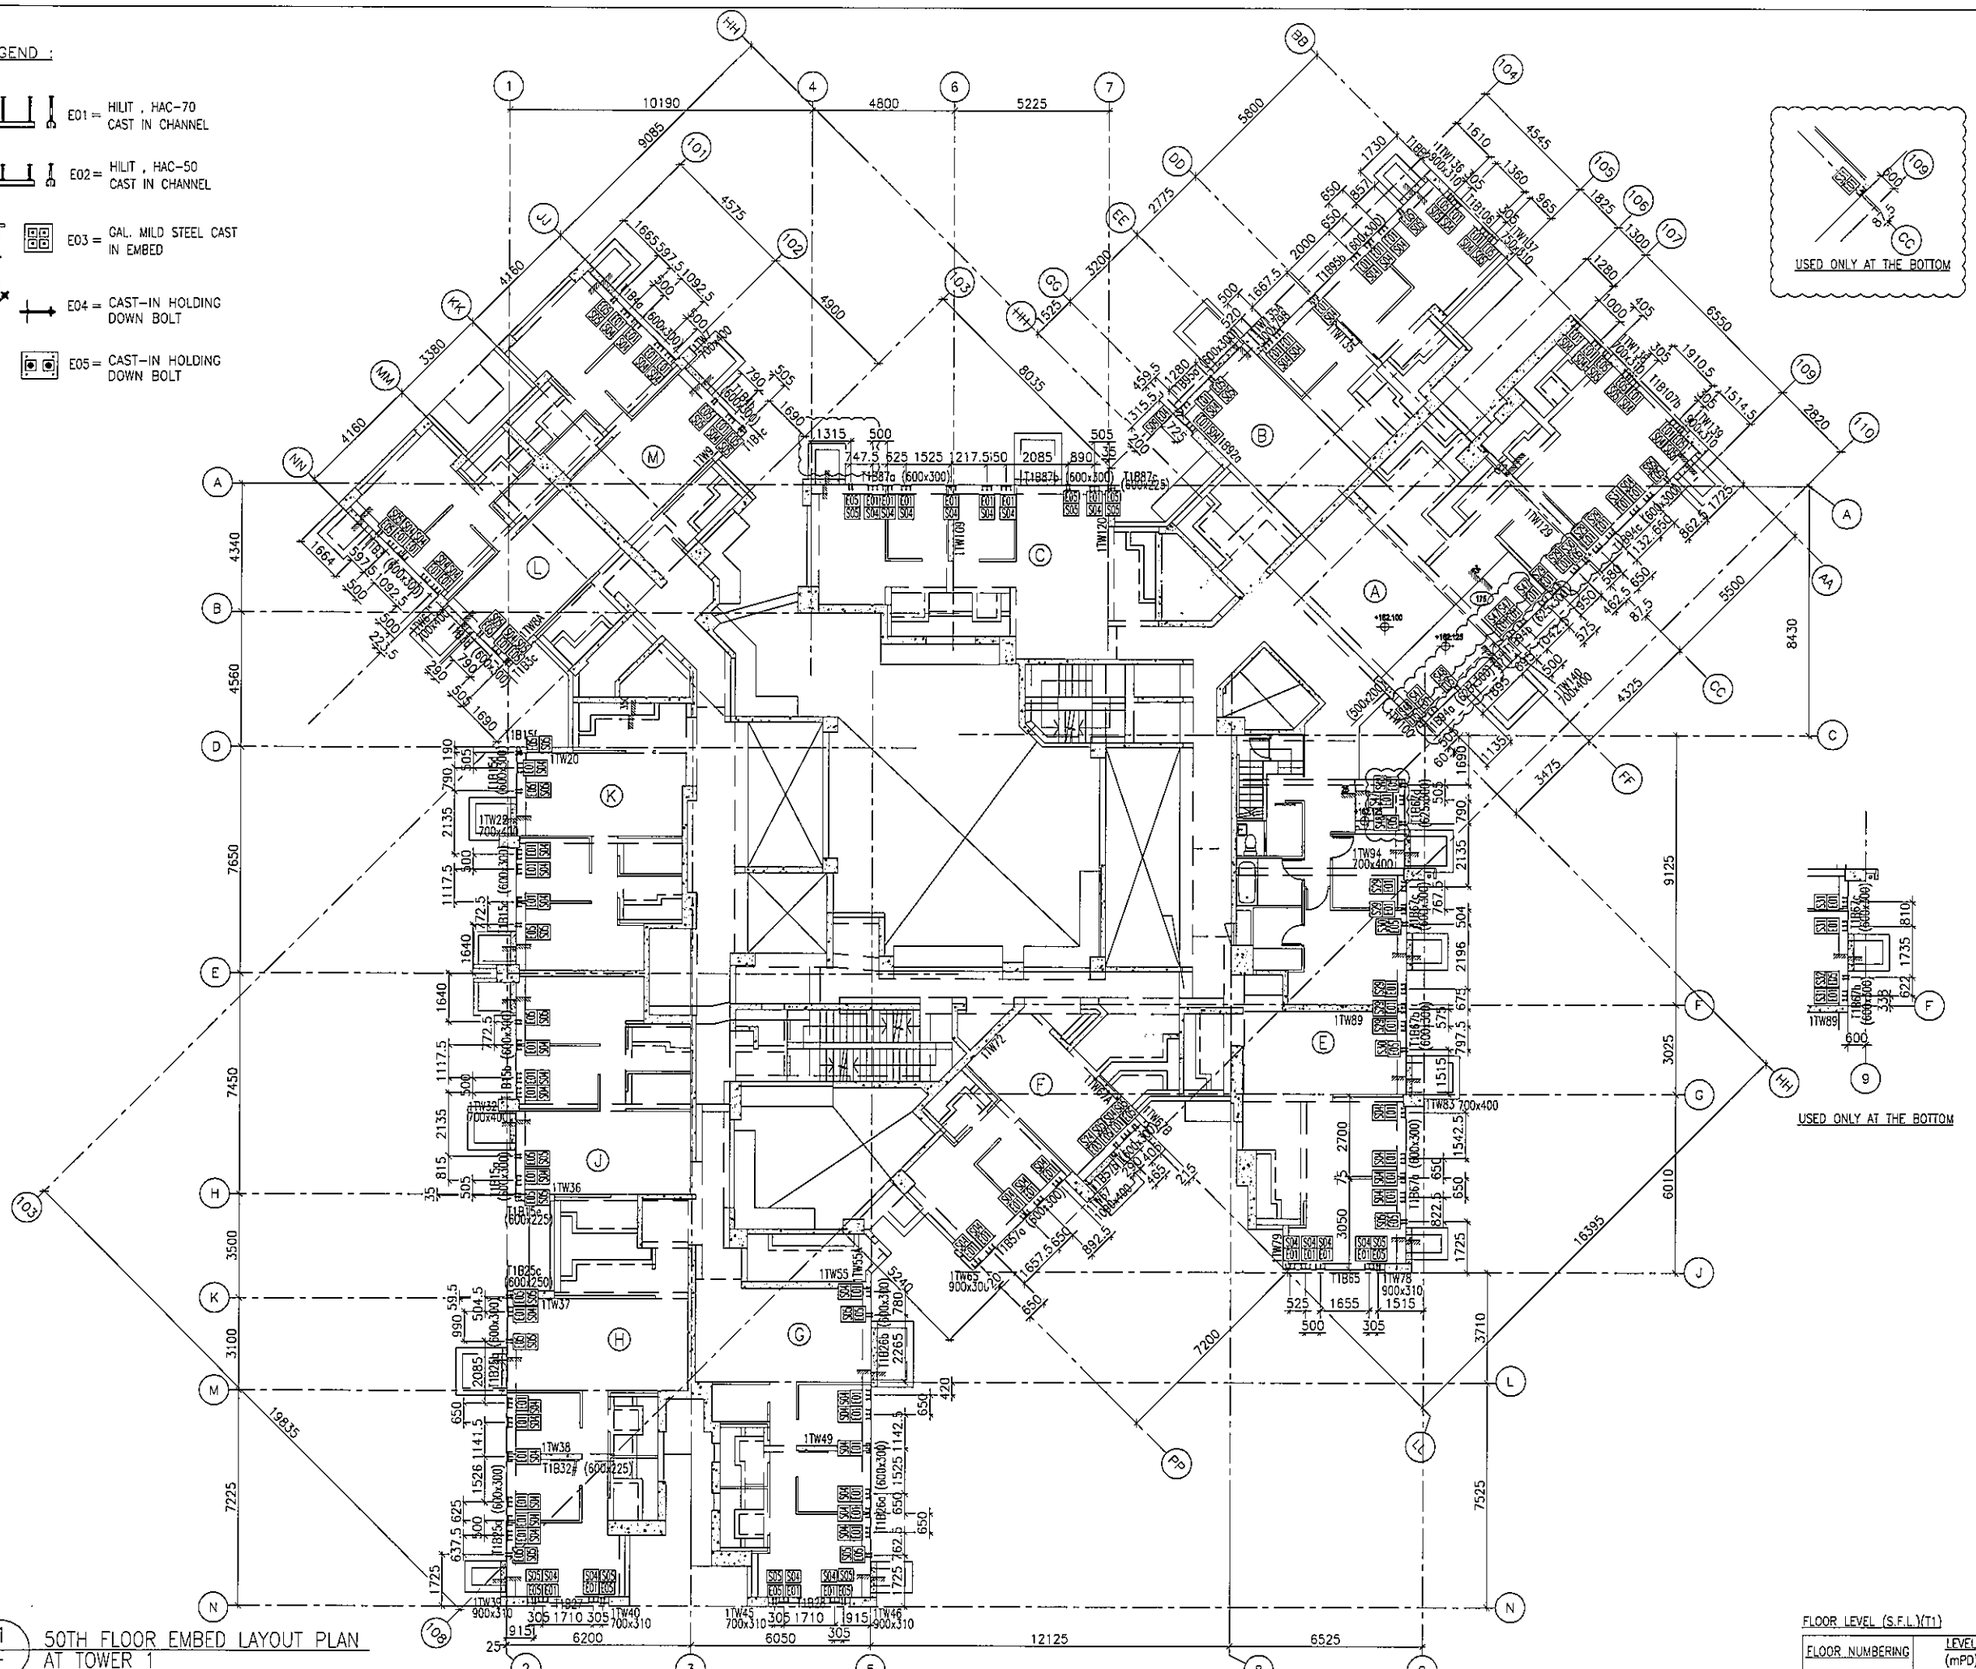

1 / - 50TH FLOOR EMBED LAYOUT PLAN AT TOWER 1

FLOOR LEVEL (S.F.L.)(T1)

FLOOR NUMBERING	LEVEL (mPD)
50F	+162.100

B.D. REF :

CLIENT : 信和置業有限公司 Sino Land Company Limited

ARCHITECT : WONG TUNG & PARTNERS LIMITED ARCHITECTS & PLANNERS

MAIN CONTRACTOR : CR Construction Company Limited

STRUCTURAL ENGINEER : AECOM

FACADE CONSULTANT: AECOM

NOTE :
1. ALL DIMENSIONS ARE IN mm.
2. ALL ELEVATIONS ARE VIEWED FROM OUTSIDE.
3. ALL DIMENSIONS TO BE VERIFIED ON SITE BEFORE FABRICATION.

LEGEND :
- X1 / X001 — DETAIL MARK NO. / REFER SHEET NO.
1. F.F.L. --FINISHED FLOOR LEVEL
2. S.F.L. --STRUCTURAL FLOOR LEVEL
3. /R --REVERSED DETAIL

NO.	DATE	REVISED	BY
J	03/06/2019	GENERAL REVISED	
I	07/04/2019	GENERAL REVISED	
H	28/01/2019	GENERAL REVISED	
G	19/01/2019	GENERAL REVISED	
F	13/01/2019	GENERAL REVISED	
E	22/12/2018	GENERAL REVISED	
D	01/12/2018	GENERAL REVISED	
C	08/11/2018	GENERAL REVISED	
B	13/10/2018	GENERAL REVISED	
A	14/9/2018	GENERAL REVISED	

JOB NO. : J-837

PROJECT : URA KWUN TONG TOWN CENTRE REDEVELOPMENT (AREA 2 & 3) AT NKIL 6514, KWUN TONG, KWLOON

TITLE : 50TH FLOOR EMBED LAYOUT PLAN OF CURTAIN WALL AT TOWER 1

DATE : 10-SEP-18 | SCALE : 1:100 (A1)

DRAWN BY : ASING | CHECKED BY : -

美特鋁質有限公司 MIDI ALUMINIUM FABRICATOR LTD.
Units 6-8, Sunray Industrial Centre, 1/F
610 Cha Kwo Ling Road, Kowloon
Tel:23489211-4 Fax:(852)27727666

DWG NO. : J837-CW-1105 | REV. : J

LEGEND :

- E01 = HILIT , HAC-70 CAST IN CHANNEL
- E02 = HILIT , HAC-50 CAST IN CHANNEL
- E04 = CAST-IN HOLDING DOWN BOLT
- E05 = CAST-IN HOLDING DOWN BOLT
- E06 = CAST-IN HOLDING DOWN BOLT
- E07 = CAST-IN HOLDING DOWN BOLT

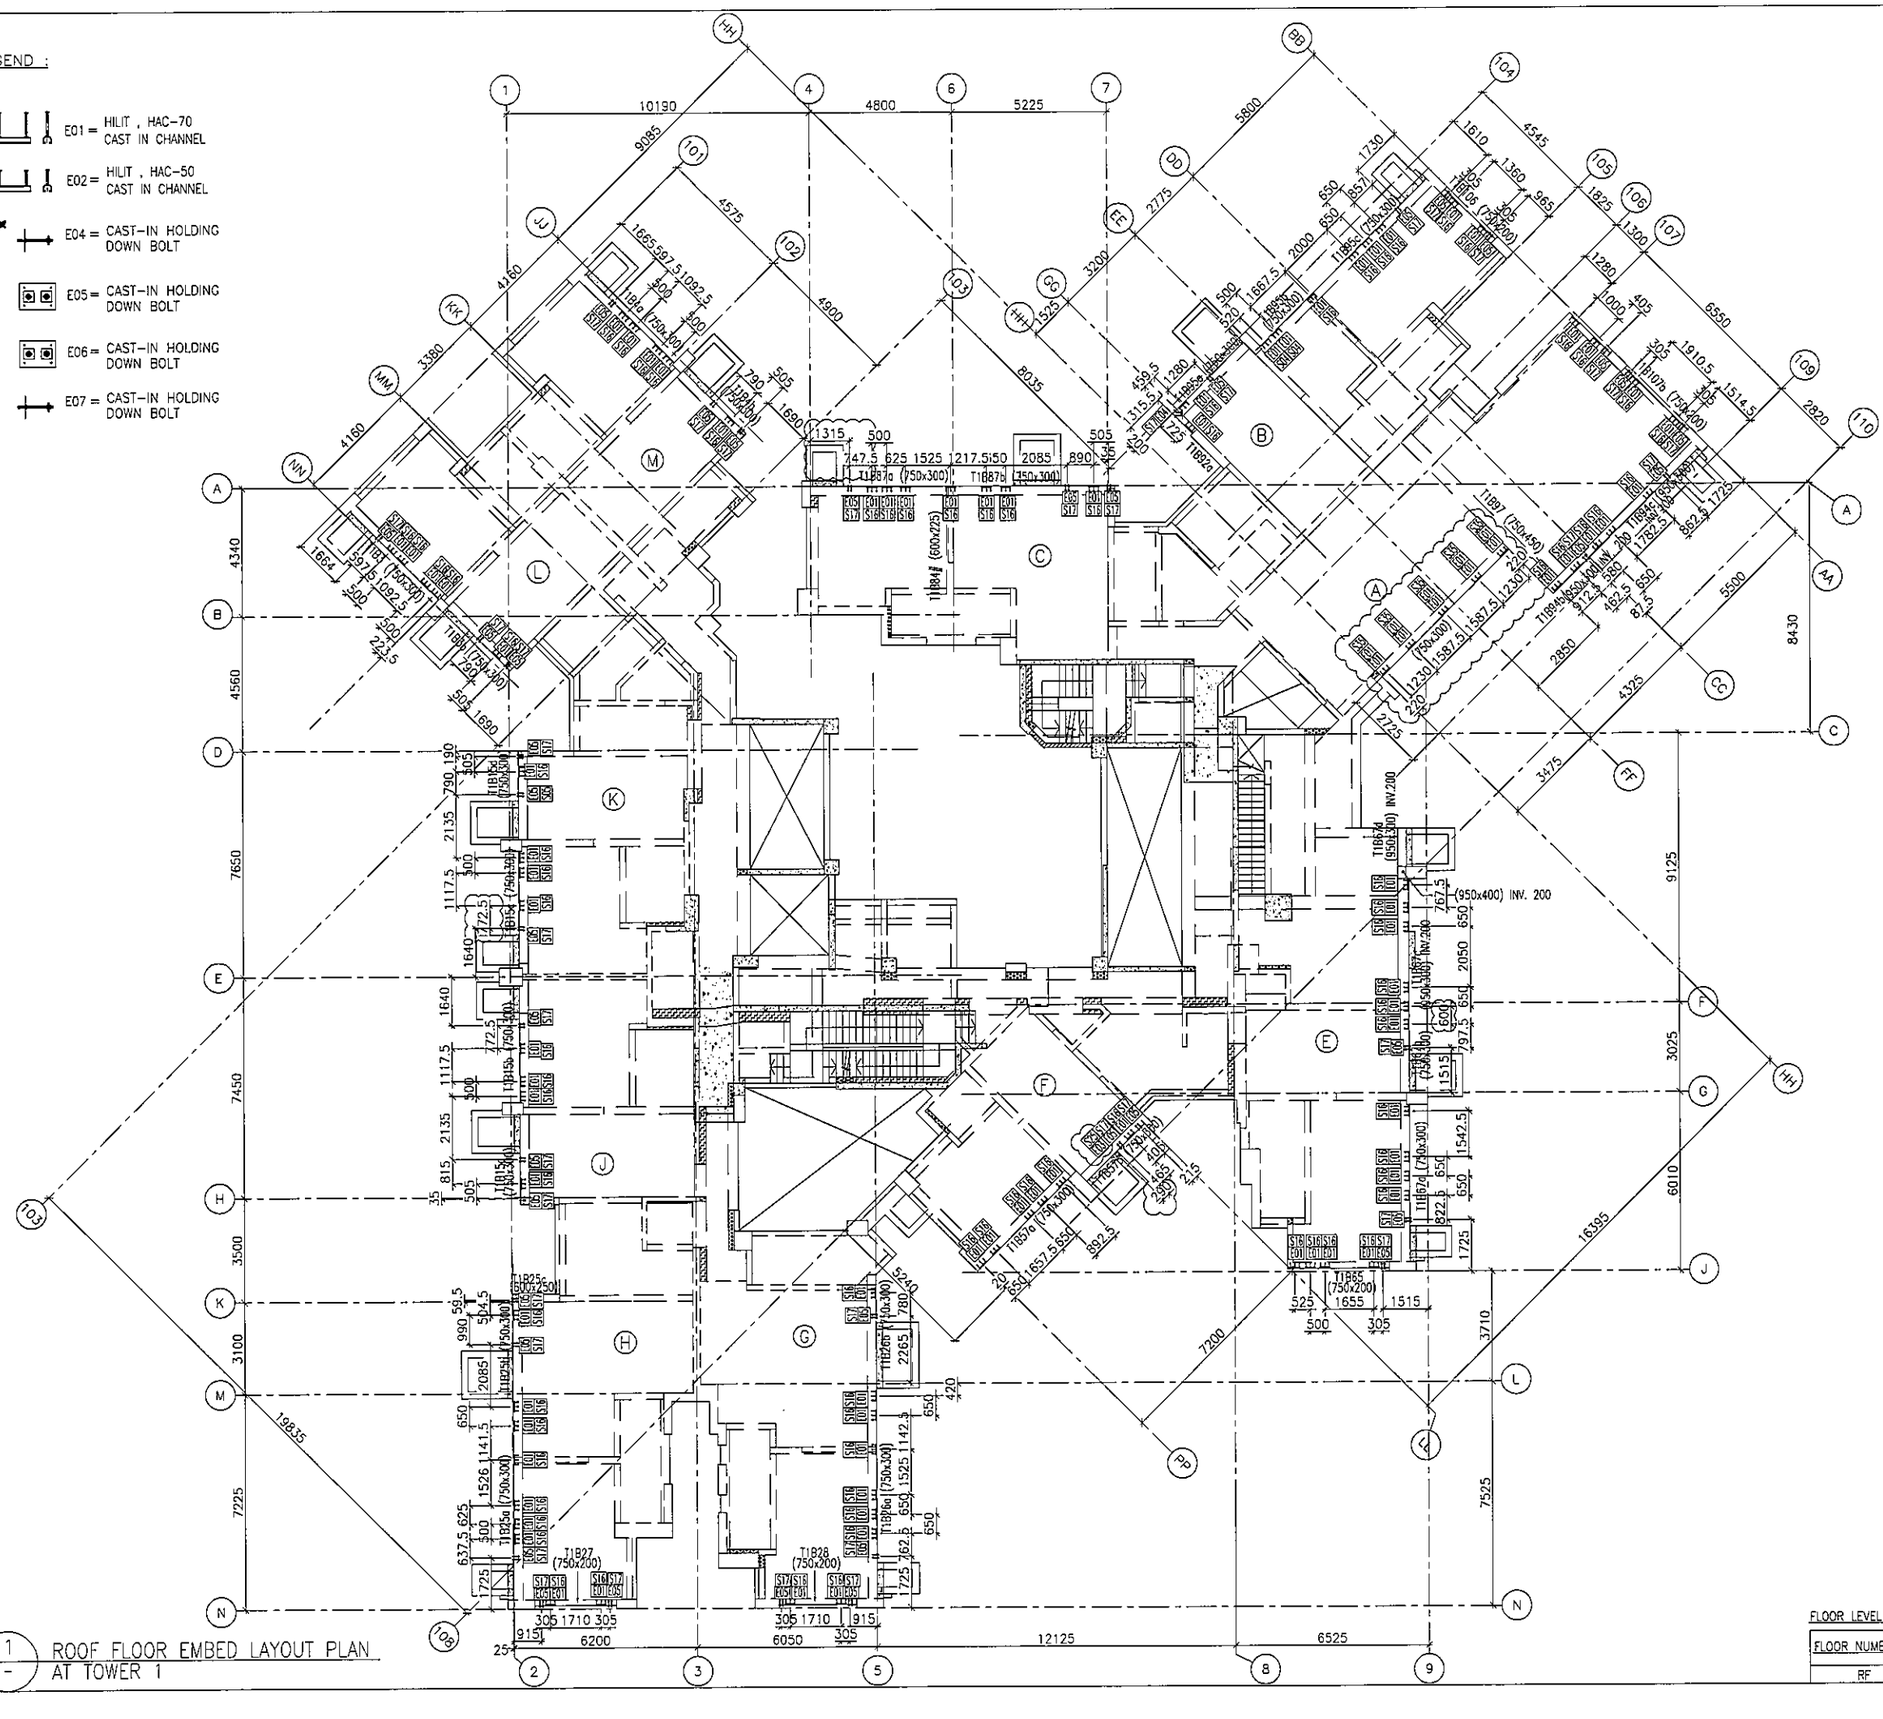

1 / - ROOF FLOOR EMBED LAYOUT PLAN AT TOWER 1

FLOOR LEVEL (S.F.L.)(T1)

FLOOR NUMBERING	LEVEL (mPD)
RF	+165.400

B.D. REF :

CLIENT : 信和置業有限公司 Sino Land Company Limited

ARCHITECT : WONG TUNG & PARTNERS LIMITED ARCHITECTS & PLANNERS

MAIN CONTRACTOR : CR Construction Company Limited

STRUCTURAL ENGINEER : AECOM

FACADE CONSULTANT: AECOM

NOTE :
1. ALL DIMENSIONS ARE IN mm.
2. ALL ELEVATIONS ARE VIEWED FROM OUTSIDE.
3. ALL DIMENSIONS TO BE VERIFIED ON SITE BEFORE FABRICATION.

LEGEND :
- X1 / X001 — DETAIL MARK NO. / REFER SHEET NO.
1. F.F.L. --- FINISHED FLOOR LEVEL
2. S.F.L. --- STRUCTURAL FLOOR LEVEL
3. (R) --- REVERSED DETAIL

NO.	DATE	REVISED	BY
J	20/05/2019	GENERAL REVISED	
I	03/05/2019	GENERAL REVISED	
H	07/04/2019	GENERAL REVISED	
G	21/02/2019	GENERAL REVISED	
F	28/01/2019	GENERAL REVISED	
E	19/01/2019	GENERAL REVISED	
D	22/12/2018	GENERAL REVISED	
C	01/12/2018	GENERAL REVISED	
B	08/11/2018	GENERAL REVISED	
A	13/10/2018	GENERAL REVISED	

JOB NO. : J-837

PROJECT : URA KWUN TONG TOWN CENTRE REDEVELOPMENT (AREA 2 & 3) AT NKIL 6514, KWUN TONG, KWLOON

TITLE : ROOF FLOOR EMBED LAYOUT PLAN OF CURTAIN WALL AT TOWER 1

DATE : 10-SEP-18 | SCALE : 1:100 (A1)

DRAWN BY : ASING | CHECKED BY : -

美特鋁質有限公司 MIDI ALUMINIUM FABRICATOR LTD.
Units 6-8, Sunray Industrial Centre, 1/F
610 Cha Kwo Ling Road, Kowloon
Tel:23489211-4 Fax:(852)27727666

DWG NO. : J837--CW-1106 | REV. : J

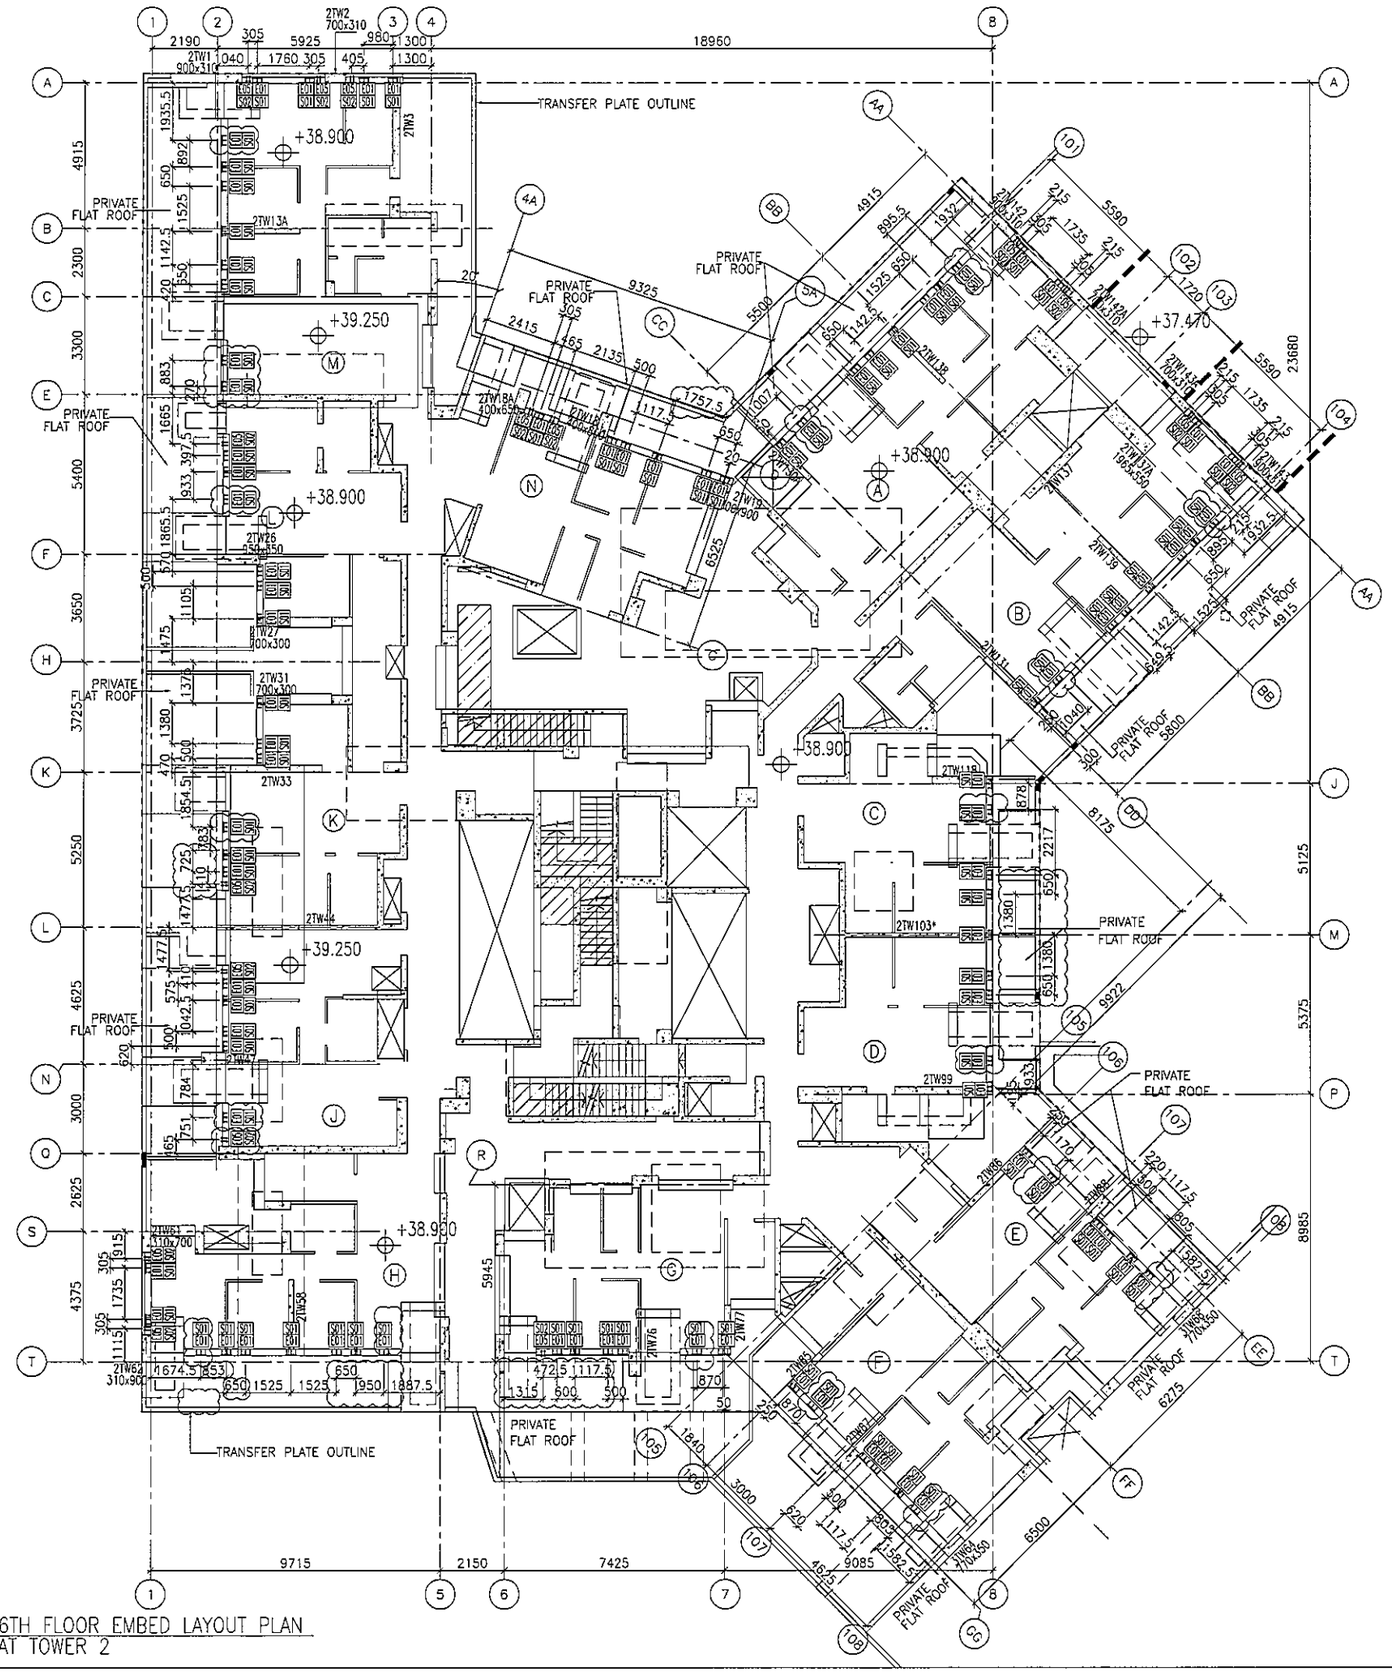
TRANSFER PLATE OUTLINE
PRIVATE FLAT ROOF
+38.900
+39.250
+37.470
+38.900
+38.900
+39.250
+38.900
+38.900
TRANSFER PLATE OUTLINE
PRIVATE FLAT ROOF
2TW1
2TW2 700x310
2TW3
2TW3A

LEGEND :

- E01 = HILIT , HAC-70 CAST IN CHANNEL
- E02 = HILIT , HAC-50 CAST IN CHANNEL
- E04 = CAST-IN HOLDING DOWN BOLT
- E05 = CAST-IN HOLDING DOWN BOLT

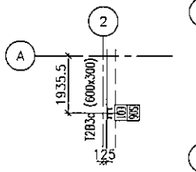

USED ONLY ON THE 7TH BOTTOM

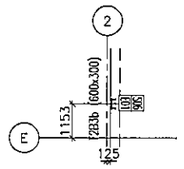


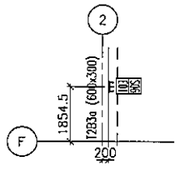


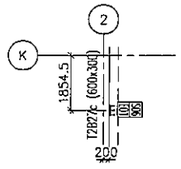


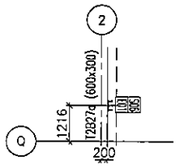


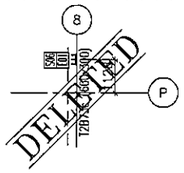


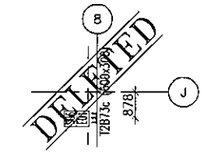


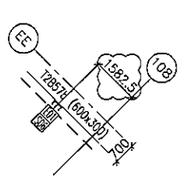


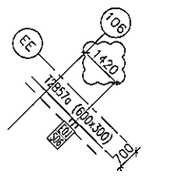

USED ONLY ON THE 7TH BOTTOM

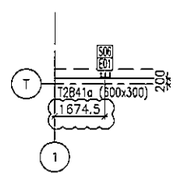

USED ONLY ON THE 7TH BOTTOM

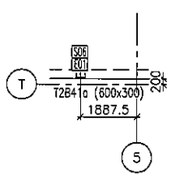

USED ONLY ON THE 7TH BOTTOM

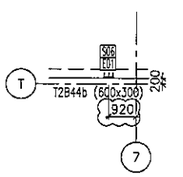

USED ONLY ON THE 7TH BOTTOM

1 / - TYPICAL FLOOR EMBED LAYOUT PLAN AT TOWER 2

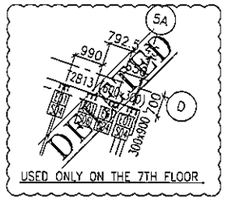

USED ONLY ON THE 7TH FLOOR

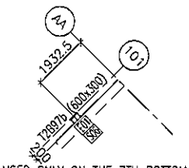

USED ONLY ON THE 7TH BOTTOM

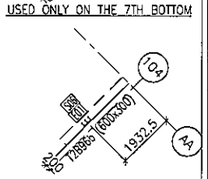

USED ONLY ON THE 7TH BOTTOM

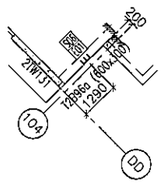

USED ONLY ON THE 7TH BOTTOM

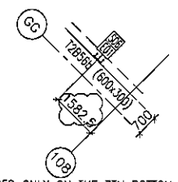

USED ONLY ON THE 7TH BOTTOM

FLOOR LEVEL (S.F.L.)(T2)

FLOOR NUMBERING	LEVEL (mPD)
7F	42.400
8F	45.550
9F	48.700
10F	51.850
11F	55.000
12F	58.150
15F	61.300
16F	64.450
17F	67.600
18F	70.750
19F	73.900
20F	77.050
21F	80.200
22F	83.350
23F	86.500
25F	89.650
26F	92.800
29F	102.250
30F	105.400
31F	108.550
32F	111.700
33F	114.850
35F	118.000
36F	121.150
37F	124.300
38F	127.450
39F	130.600
40F	133.750
41F	136.900
42F	140.050
43F	143.100
45F	146.350
46F	149.500
47F	152.650
48F	155.800
49F	158.950
50F	162.100
51F	165.250
52F	168.400
53F	171.550

B.D. REF :

CLIENT : 信和置業有限公司 Sino Land Company Limited

ARCHITECT : WONG TUNG & PARTNERS LIMITED ARCHITECTS & PLANNERS

MAIN CONTRACTOR : CR Construction Company Limited

STRUCTURAL ENGINEER : AECOM

FACADE CONSULTANT: AECOM

NOTE :
1. ALL DIMENSIONS ARE IN mm.
2. ALL ELEVATIONS ARE VIEWED FROM OUTSIDE.
3. ALL DIMENSIONS TO BE VERIFIED ON SITE BEFORE FABRICATION.

LEGEND :
- X1 / X001 — DETAIL MARK NO. / REFER SHEET NO.
1. F.F.L. --- FINISHED FLOOR LEVEL
2. S.F.L. --- STRUCTURAL FLOOR LEVEL
3. /R --- REVERSED DETAIL

NO.	DATE	REVISED	BY
K	18/08/2019	GENERAL REVISED	
J	16/07/2019	GENERAL REVISED	
I	28/01/2019	GENERAL REVISED	
H	19/01/2019	GENERAL REVISED	
G	08/11/2018	GENERAL REVISED	
F	8/10/2018	GENERAL REVISED	
E	28/9/2018	GENERAL REVISED	
D	04/9/2018	GENERAL REVISED	
C	23/8/2018	GENERAL REVISED	
B	11/8/2018	GENERAL REVISED	
A	4/8/2018	GENERAL REVISED	

JOB NO. : J-837

PROJECT : URA KWUN TONG TOWN CENTRE REDEVELOPMENT (AREA 2 & 3) AT NKIL 6514, KWUN TONG, KWLOON

TITLE : TYPICAL FLOOR EMBED LAYOUT PLAN OF CURTAIN WALL AT TOWER 2

DATE : 04-JUL-18 | SCALE : 1:100 (A1)

DRAWN BY : ASING | CHECKED BY : -

美特鋁質有限公司 MIDI ALUMINIUM FABRICATOR LTD.
Units 6-8, Sunray Industrial Centre, 1/F
610 Cho Kwo Ling Road, Kowloon
Tel:23489211-4 Fax:(852)27727666

DWG NO. : J837-CW-1202 | REV. : K

LEGEND :

- E01 = HILIT , HAC-70 CAST IN CHANNEL
- E02 = HILIT , HAC-50 CAST IN CHANNEL
- E04 = CAST-IN HOLDING DOWN BOLT
- E05 = CAST-IN HOLDING DOWN BOLT
- E06 = CAST-IN HOLDING DOWN BOLT
- E07 = CAST-IN HOLDING DOWN BOLT

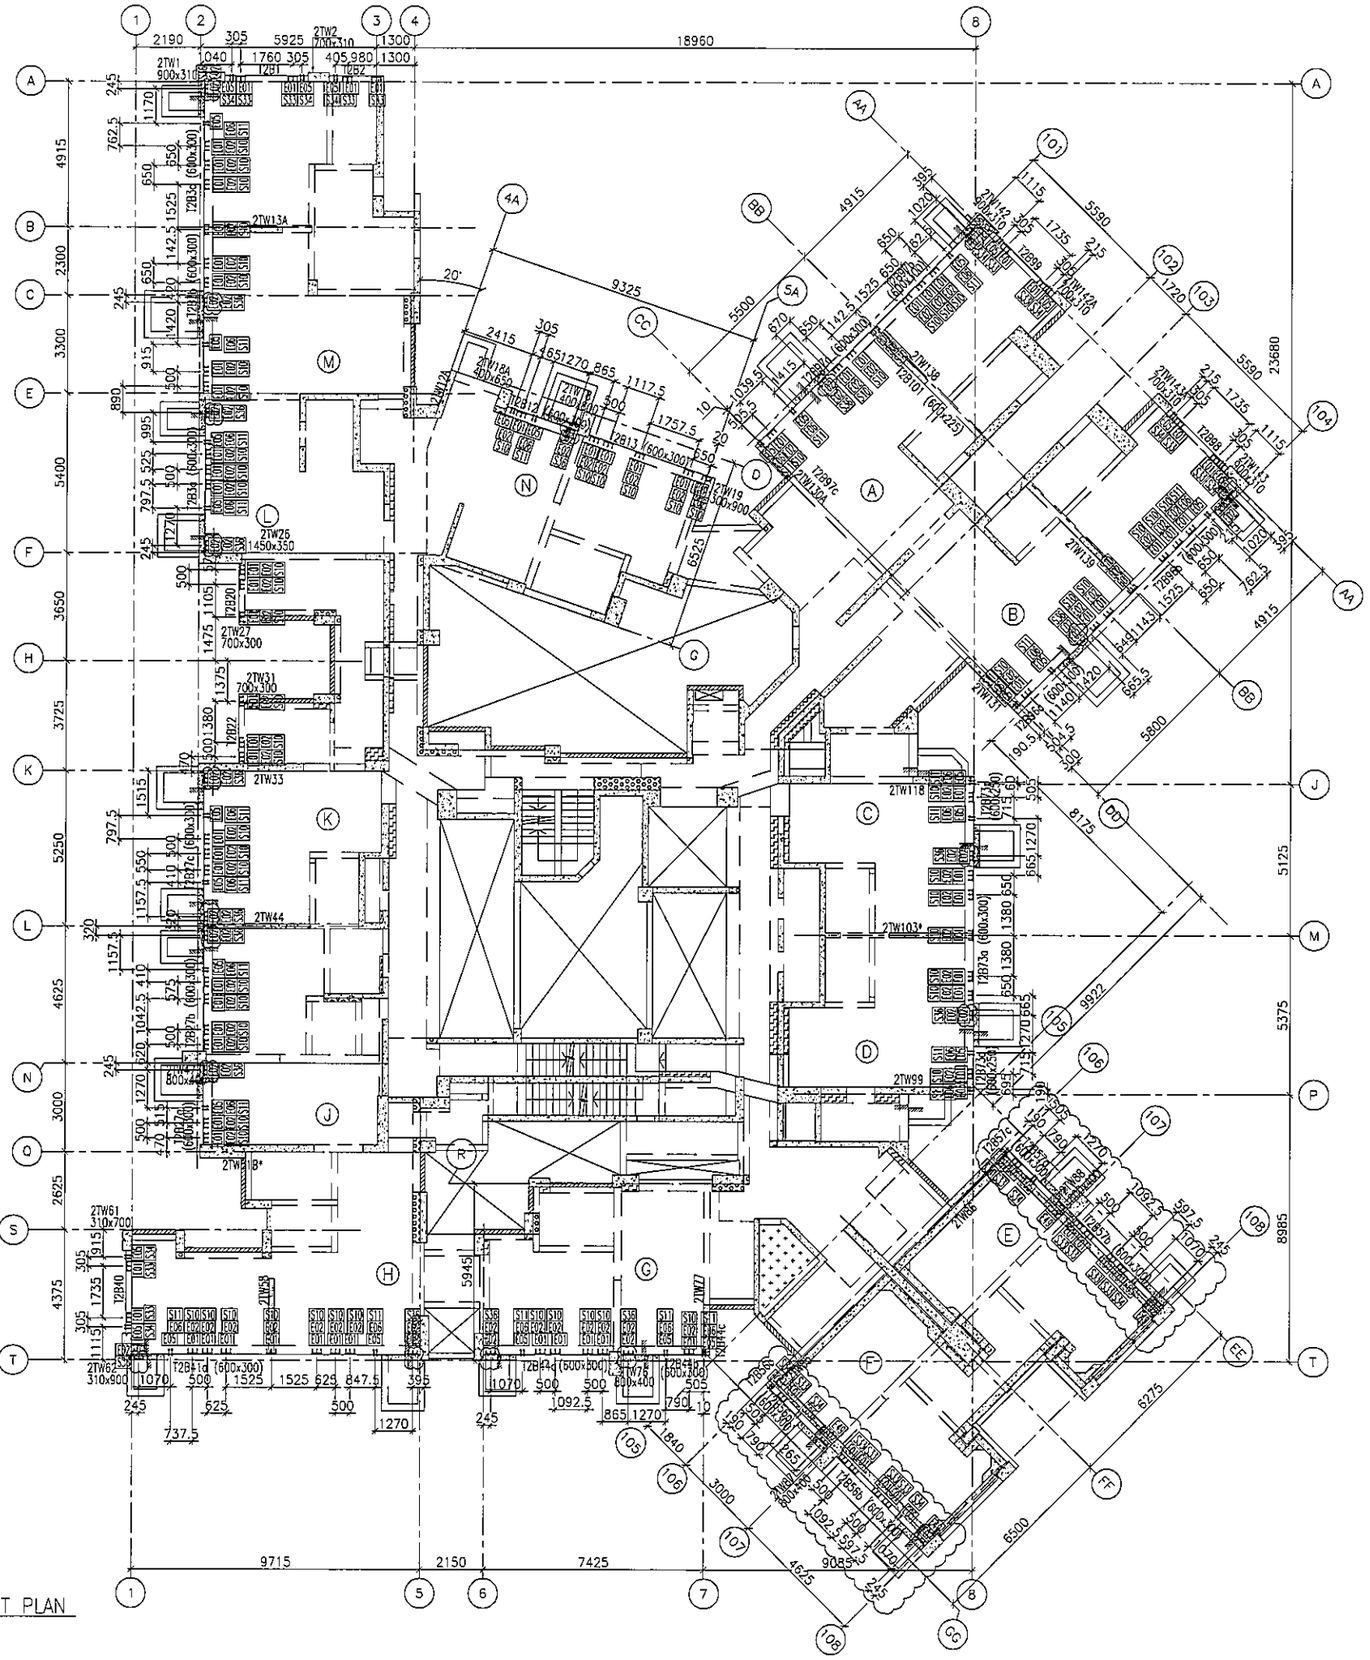

1 / - 27TH FLOOR EMBED LAYOUT PLAN AT TOWER 2

FLOOR LEVEL (S.F.L.)(T2)

FLOOR NUMBERING	LEVEL (mPD)
27F	+95.95

B.D. REF :

CLIENT : 信和置業有限公司 Sino Land Company Limited

ARCHITECT : WONG TUNG & PARTNERS LIMITED ARCHITECTS & PLANNERS

MAIN CONTRACTOR : CR Construction Company Limited

STRUCTURAL ENGINEER : AECOM

FACADE CONSULTANT: AECOM

NOTE :
1. ALL DIMENSIONS ARE IN mm.
2. ALL ELEVATIONS ARE VIEWED FROM OUTSIDE.
3. ALL DIMENSIONS TO BE VERIFIED ON SITE BEFORE FABRICATION.

LEGEND :
- X1 / X001 — DETAIL MARK NO. / REFER SHEET NO.
1. F.F.L. --FINISHED FLOOR LEVEL
2. S.F.L. --STRUCTURAL FLOOR LEVEL
3. /R --REVERSED DETAIL

NO.	DATE	REVISED	BY
G	18/08/2019	GENERAL REVISED	
F	21/02/2019	GENERAL REVISED	
E	19/01/2019	GENERAL REVISED	
D	08/11/2018	GENERAL REVISED	
C	8/10/2018	GENERAL REVISED	
B	28/9/2018	GENERAL REVISED	
A	07/9/2018	GENERAL REVISED	

JOB NO. : J-837

PROJECT : URA KWUN TONG TOWN CENTRE REDEVELOPMENT (AREA 2 & 3) AT NKIL 6514, KWUN TONG, KWLOON

TITLE : 27TH FLOOR EMBED LAYOUT PLAN OF CURTAIN WALL AT TOWER 2

DATE : 10-SEP-18 | SCALE : 1:100 (A1)

DRAWN BY : ASING | CHECKED BY : -

美特鋁質有限公司 MIDI ALUMINIUM FABRICATOR LTD.
Units 6-8, Sunray Industrial Centre, 1/F
610 Cha Kwo Ling Road, Kowloon
Tel:23489211-4 Fax:(852)27727666

DWG NO. : J837-CW-1203 | REV. : G

LEGEND :

- E01 = HILIT , HAC-70 CAST IN CHANNEL
- E02 = HILIT , HAC-50 CAST IN CHANNEL
- E04 = CAST-IN HOLDING DOWN BOLT
- E05 = CAST-IN HOLDING DOWN BOLT

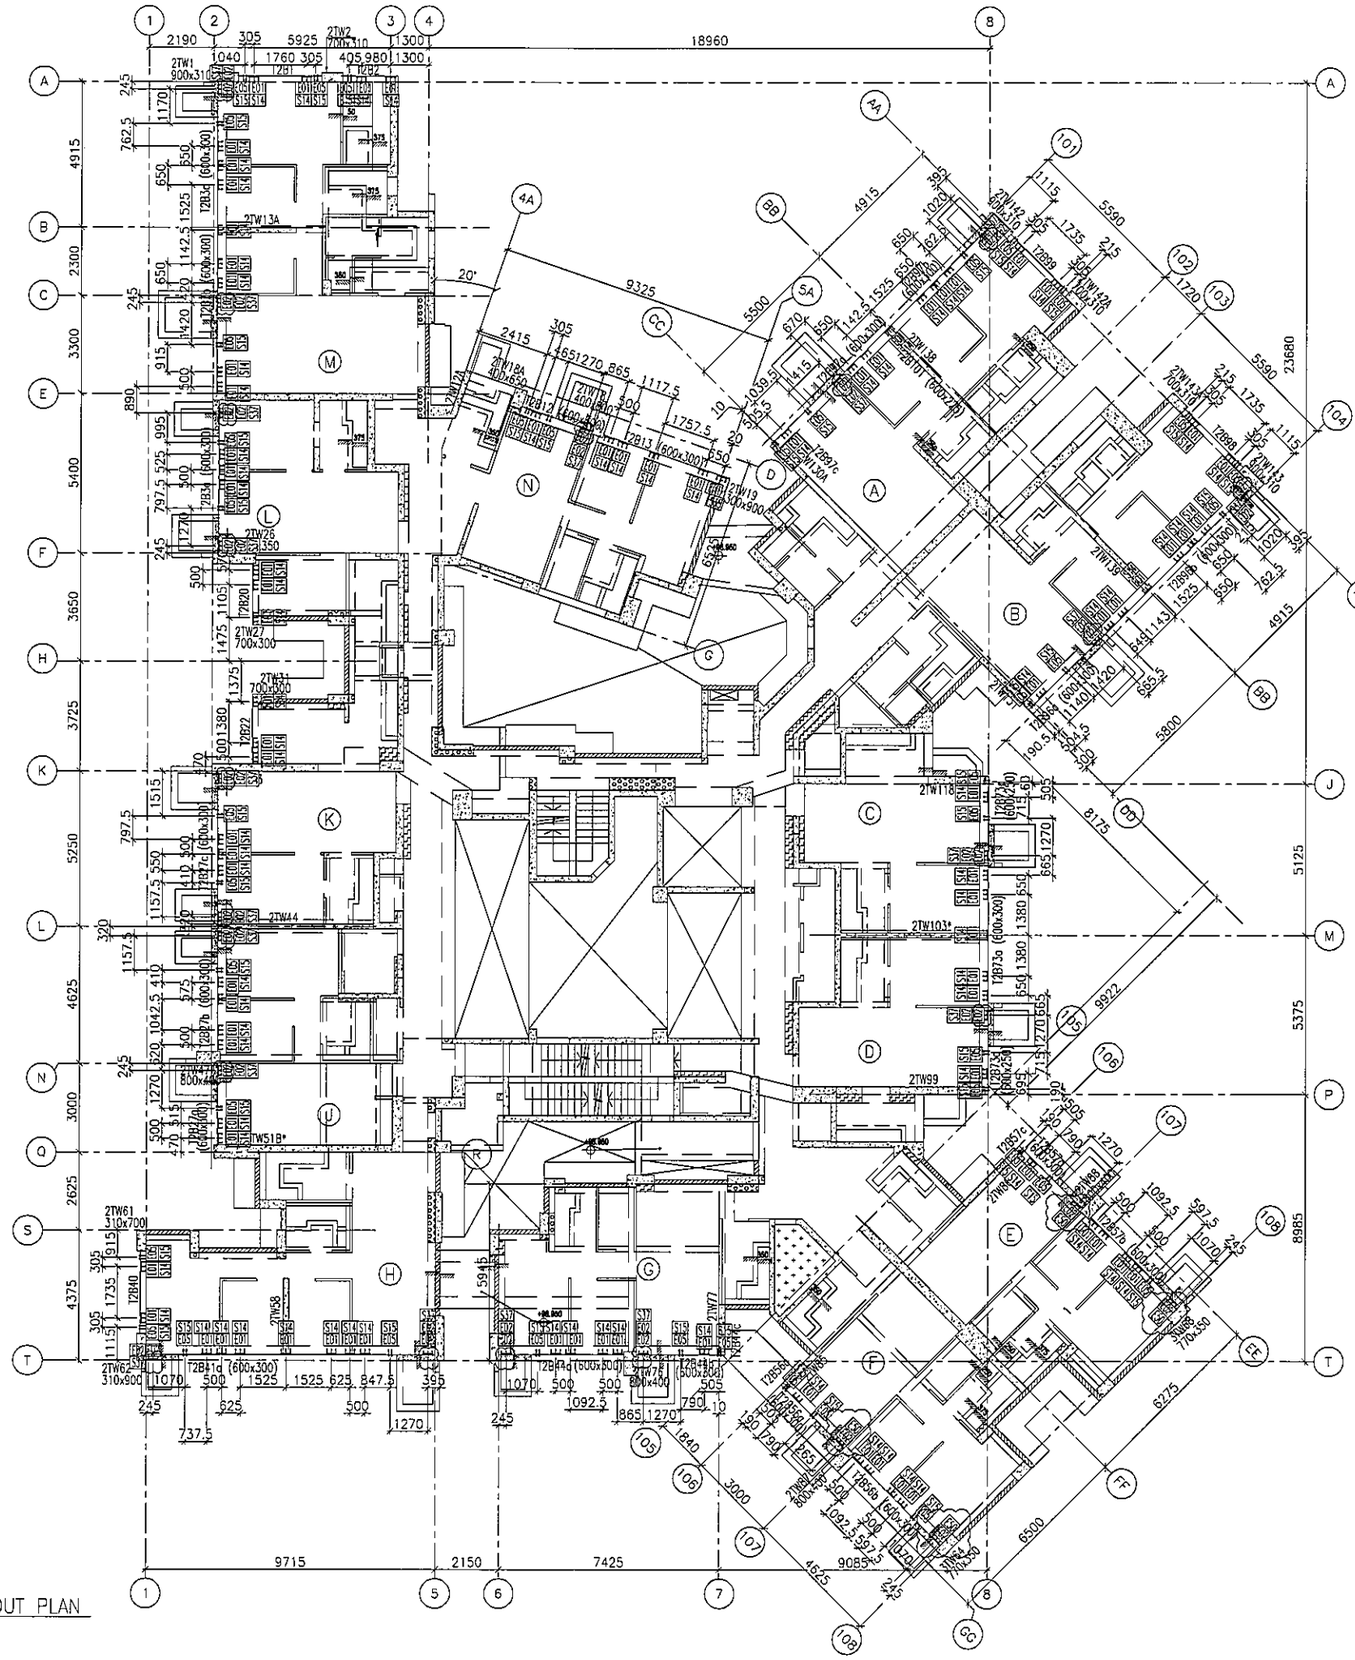

1 / - 28TH FLOOR EMBED LAYOUT PLAN AT TOWER 2

FLOOR LEVEL (S.F.L.)(T2)

FLOOR NUMBERING	LEVEL (mPD)
28F	+99.100

B.D. REF :

CLIENT : 信和置業有限公司 Sino Land Company Limited

ARCHITECT : WONG TUNG & PARTNERS LIMITED ARCHITECTS & PLANNERS

MAIN CONTRACTOR : CR Construction Company Limited

STRUCTURAL ENGINEER : AECOM

FACADE CONSULTANT: AECOM

NOTE :
1. ALL DIMENSIONS ARE IN mm.
2. ALL ELEVATIONS ARE VIEWED FROM OUTSIDE.
3. ALL DIMENSIONS TO BE VERIFIED ON SITE BEFORE FABRICATION.

LEGEND :
- X1 / X001 — DETAIL MARK NO. / REFER SHEET NO.
1. F.F.L. --FINISHED FLOOR LEVEL
2. S.F.L. --STRUCTURAL FLOOR LEVEL
3. /R --REVERSED DETAIL

NO.	DATE	REMARK	BY
F	18/08/2019	GENERAL REVISED	
E	21/02/2019	GENERAL REVISED	
D	19/01/2019	GENERAL REVISED	
C	08/11/2018	GENERAL REVISED	
B	8/10/2018	GENERAL REVISED	
A	28/9/2018	GENERAL REVISED	

JOB NO. : J-837

PROJECT : URA KWUN TONG TOWN CENTRE REDEVELOPMENT (AREA 2 & 3) AT NKIL 6514, KWUN TONG, KWLOON

TITLE : 28TH FLOOR EMBED LAYOUT PLAN OF CURTAIN WALL AT TOWER 2

DATE : 10-SEP-18 | SCALE : 1:100 (A1)

DRAWN BY : ASING | CHECKED BY : -

美特鋁質有限公司 MIDI ALUMINIUM FABRICATOR LTD.
Units 6-8, Sunray Industrial Centre, 1/F
610 Cha Kwo Ling Road, Kowloon
Tel:23489211-4 Fax:(852)27727666

DWG NO. : J837-CW-1204 | REV. : F

LEGEND :

- E01 = HILIT , HAC-70 CAST IN CHANNEL
- E02 = HILIT , HAC-50 CAST IN CHANNEL
- E03 = GAL. MILD STEEL CAST IN EMBED
- E04 = CAST-IN HOLDING DOWN BOLT
- E05 = CAST-IN HOLDING DOWN BOLT

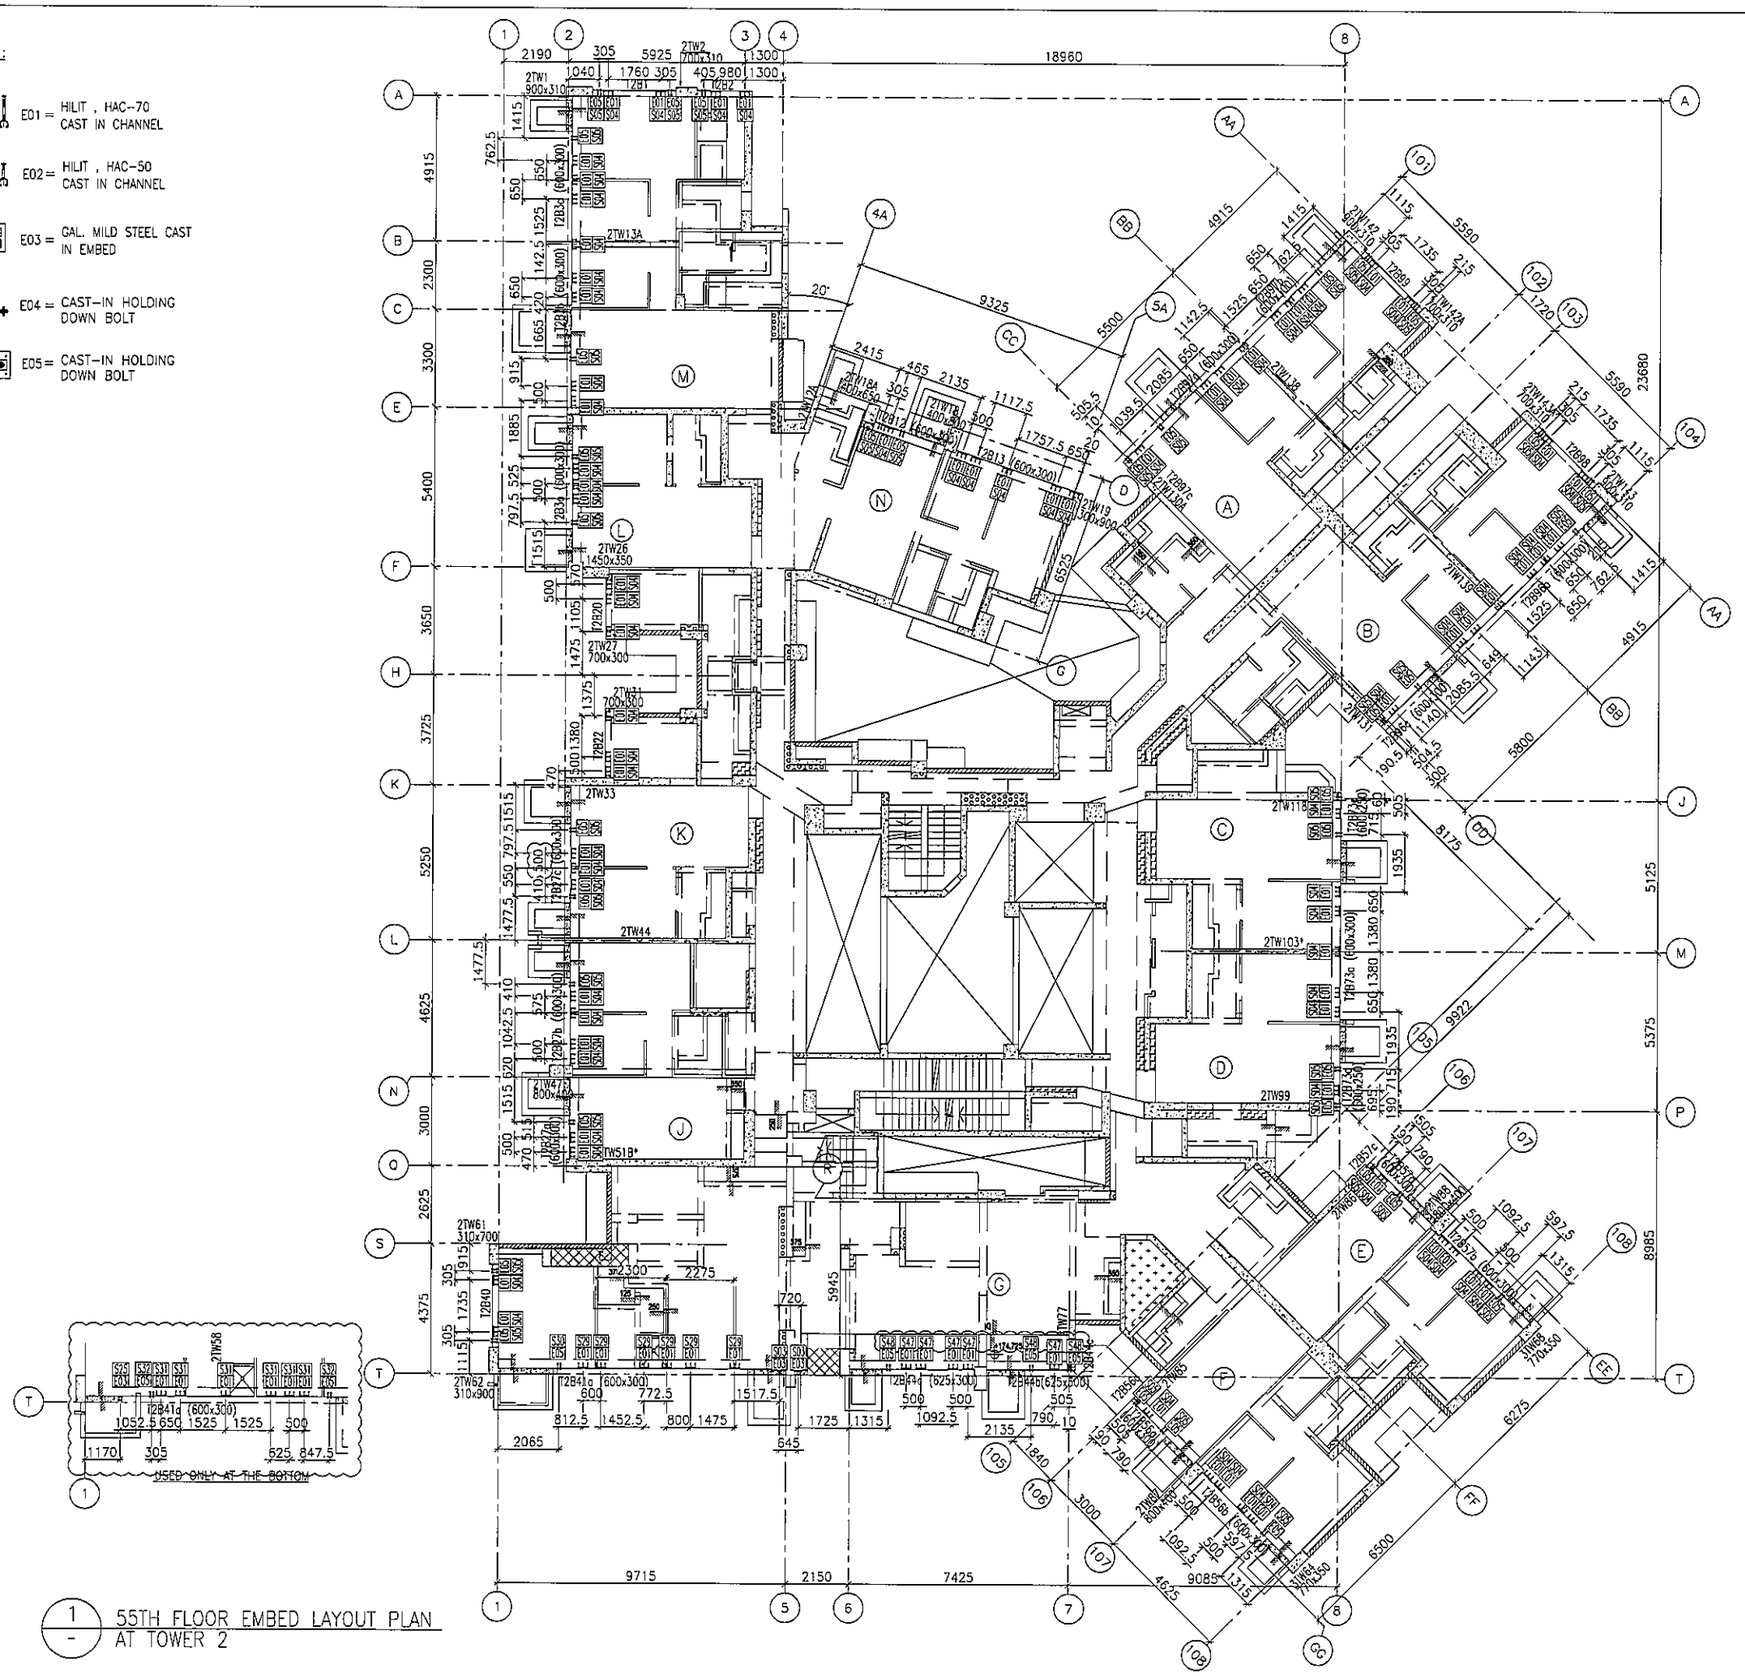
2190
305
5925
1300
18960
1040
1760
980
2TW1 900x310
2TW2 700x310
2TW13A
2TW26 1450x350
2TW27 700x300
2TW33
2TW44
2TW61 310x700
2TW62 310x900
2TW58
2TW99
2TW103*
2TW118
2TW51B*
2TW77
2TW19 300x300
2TW13BGT 600x300
2TW13BGU 600x300
2TW13BGV 600x300
2TW13BGW 600x300
2TW13BGX 600x300
2TW13BGY 600x300
2TW13BGZ

LEGEND :

- E01 = HILIT , HAC-70 CAST IN CHANNEL
- E02 = HILIT , HAC-50 CAST IN CHANNEL
- E04 = CAST-IN HOLDING DOWN BOLT
- E05 = CAST-IN HOLDING DOWN BOLT
- E06 = CAST-IN HOLDING DOWN BOLT
- E07 = CAST-IN HOLDING DOWN BOLT

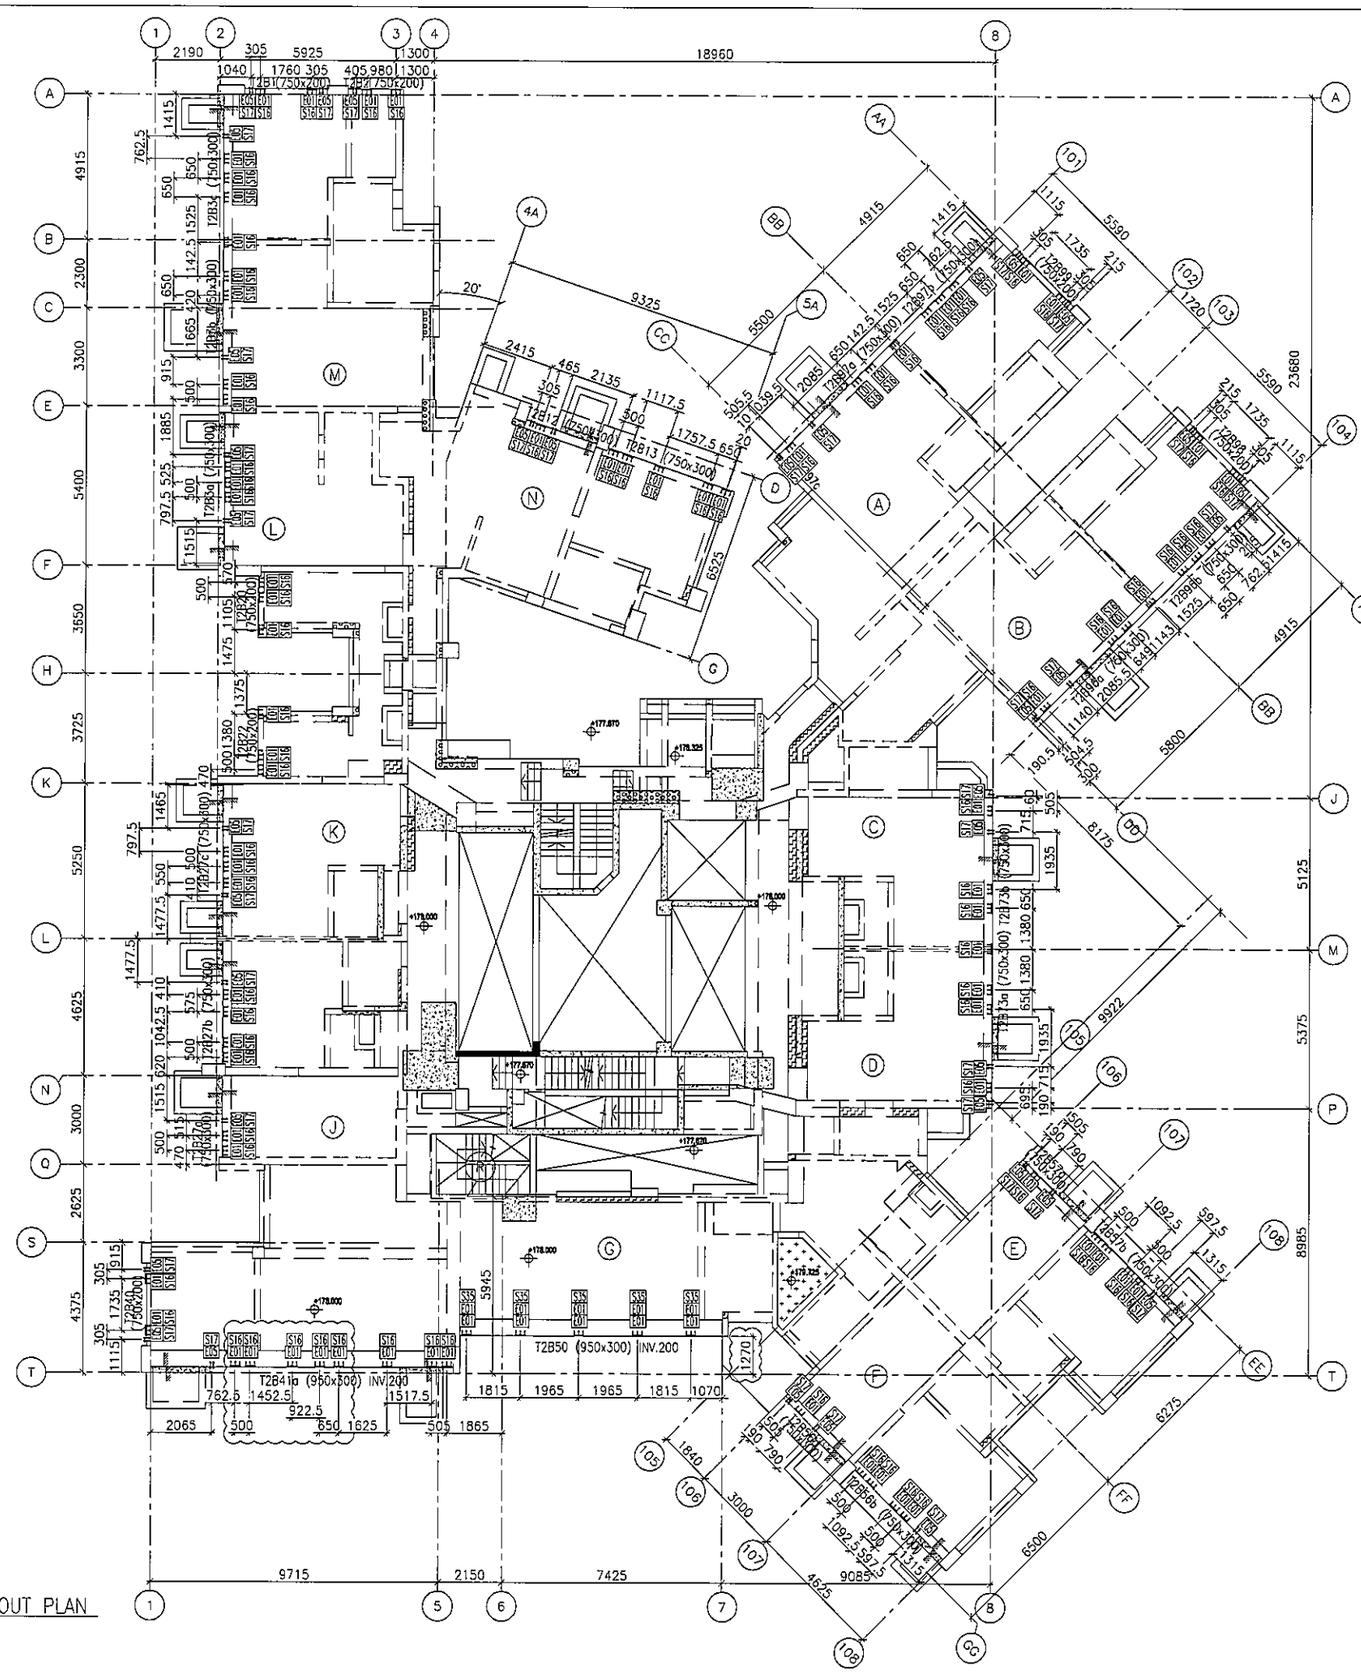
T2B1(750x200)

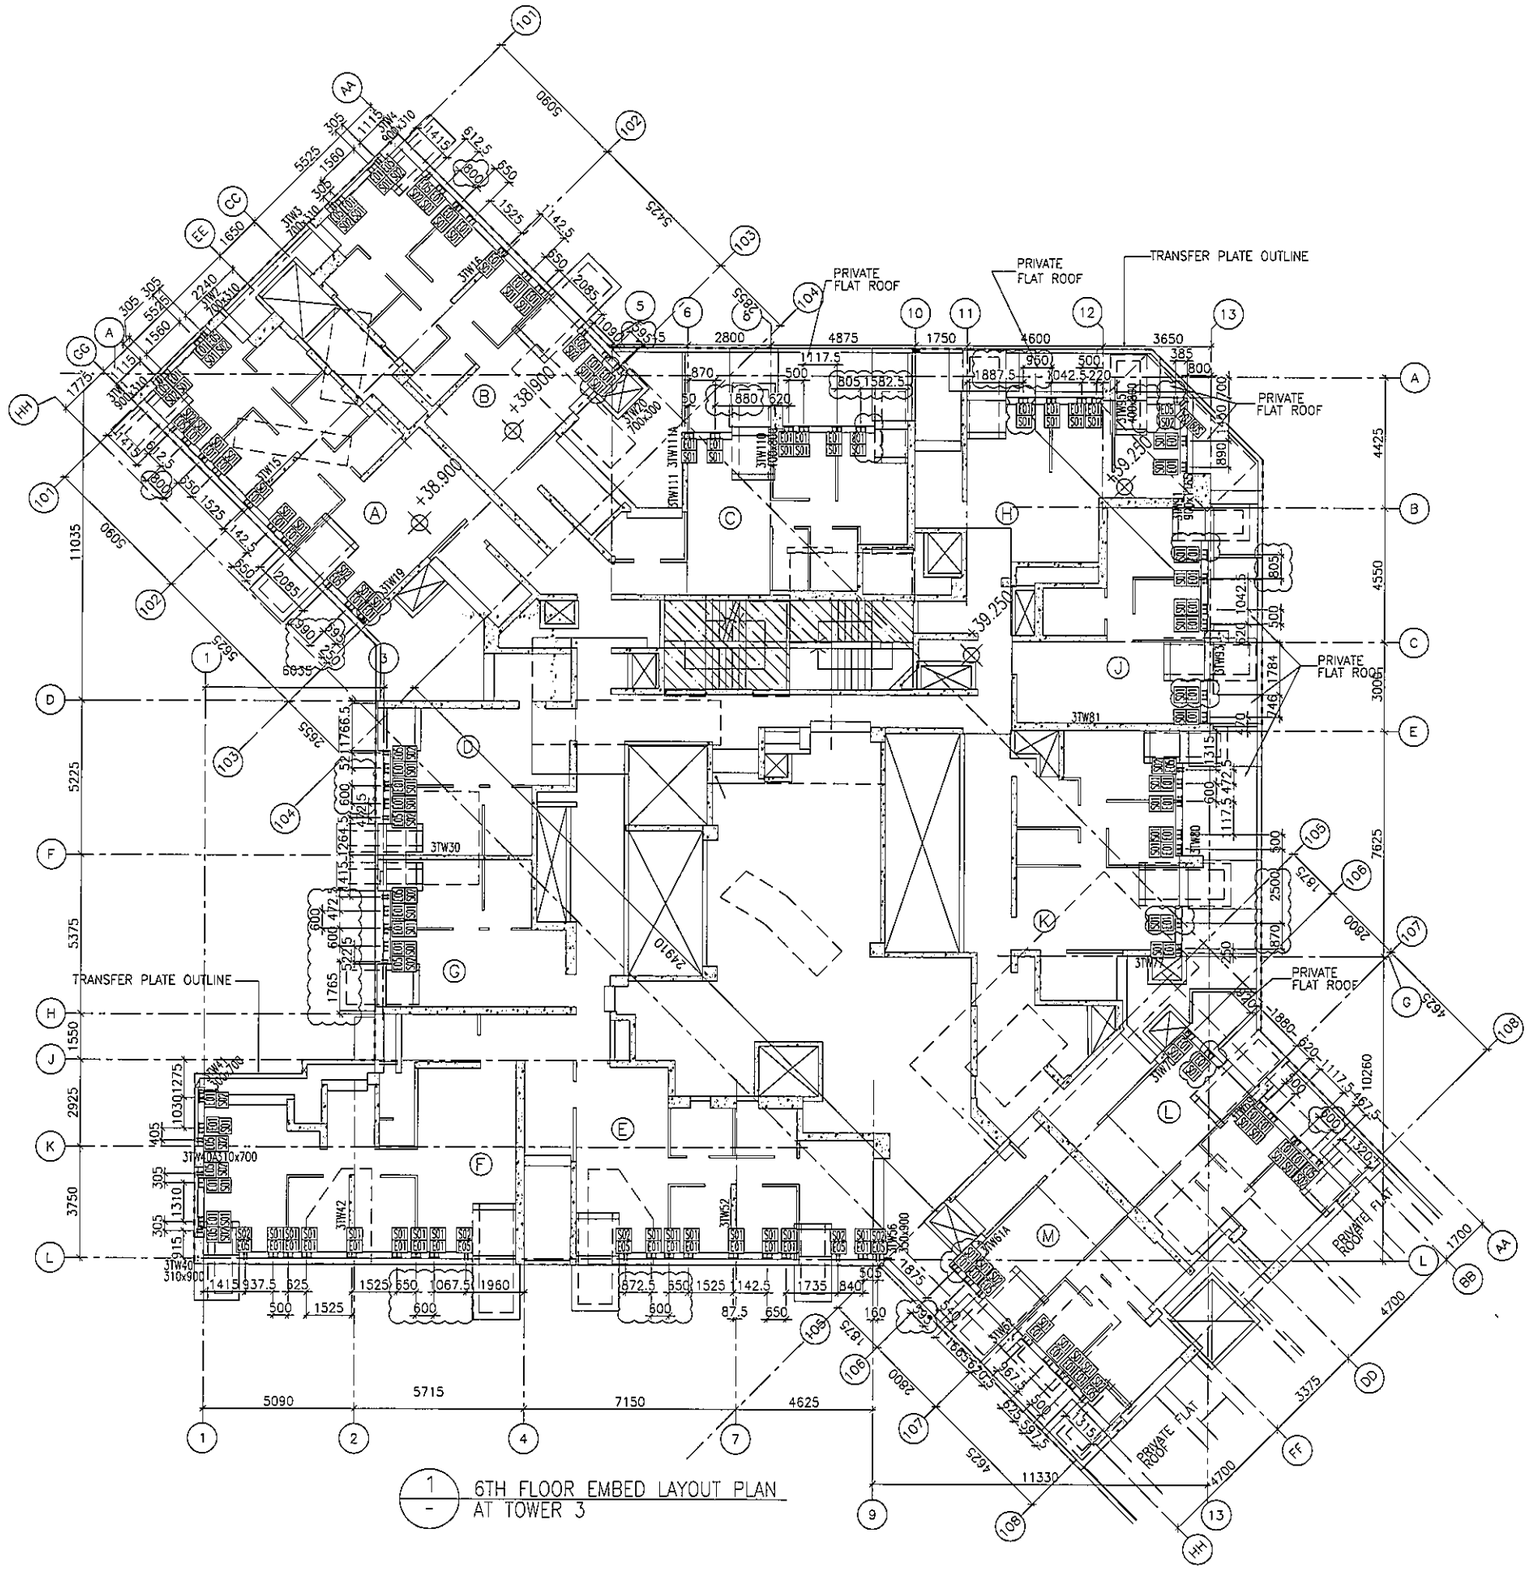

1 / - 6TH FLOOR EMBED LAYOUT PLAN AT TOWER 3

FLOOR LEVEL (S.F.L.)(T3)

FLOOR NUMBERING	LEVEL (mPD)
6/F	+38.900

B.D. REF :

CLIENT :
信和置業有限公司
Sino Land Company Limited

ARCHITECT :
WONG TUNG & PARTNERS LIMITED
ARCHITECTS & PLANNERS

MAIN CONTRACTOR :
CR Construction Company Limited

STRUCTURAL ENGINEER :
AECOM

FACADE CONSULTANT:
AECOM

NOTE :
1. ALL DIMENSIONS ARE IN mm.
2. ALL ELEVATIONS ARE VIEWED FROM OUTSIDE.
3. ALL DIMENSIONS TO BE VERIFIED ON SITE BEFORE FABRICATION.

LEGEND :
X1 — DETAIL MARK NO.
X001 — REFER SHEET NO.

1. F.F.L. --FINISHED FLOOR LEVEL
2. S.F.L. --STRUCTURAL FLOOR LEVEL
3. /R --REVERSED DETAIL

NO.	DATE	REVISED	BY
J	18/08/2019	GENERAL REVISED	
I	16/07/2019	GENERAL REVISED	
H	28/01/2019	GENERAL REVISED	
G	08/11/2018	GENERAL REVISED	
F	11/10/2018	GENERAL REVISED	
E	26/9/2018	GENERAL REVISED	
D	14/9/2018	GENERAL REVISED	
C	04/9/2018	GENERAL REVISED	
B	24/8/2018	GENERAL REVISED	
A	31/7/2018	GENERAL REVISED	

JOB NO. : J-837

PROJECT :
URA KWUN TONG TOWN CENTRE REDEVELOPMENT (AREA 2 & 3) AT NKIL 6514, KWUN TONG, KWLOON

TITLE :
6TH FLOOR EMBED LAYOUT PLAN OF CURTAIN WALL AT TOWER 3

DATE : 04-JUL-18	SCALE : 1:100 (A1)
DRAWN BY : ASING	CHECKED BY : -

美特鋁質有限公司
MIDI ALUMINIUM FABRICATOR LTD.
Units 6-8, Sunray Industrial Centre, 1/F
610 Cha Kwo Ling Road, Kowloon
Tel:23489211-4 Fax:(852)27727666

DWG NO. : J837-CW-1301 REV. : J

LEGEND :

- EO1 = HILIT , HAC-70 CAST IN CHANNEL
- EO2 = HILIT , HAC-50 CAST IN CHANNEL
- EO3 = GAL. MILD STEEL CAST IN EMBED
- EO4 = CAST-IN HOLDING DOWN BOLT
- EO5 = CAST-IN HOLDING DOWN BOLT

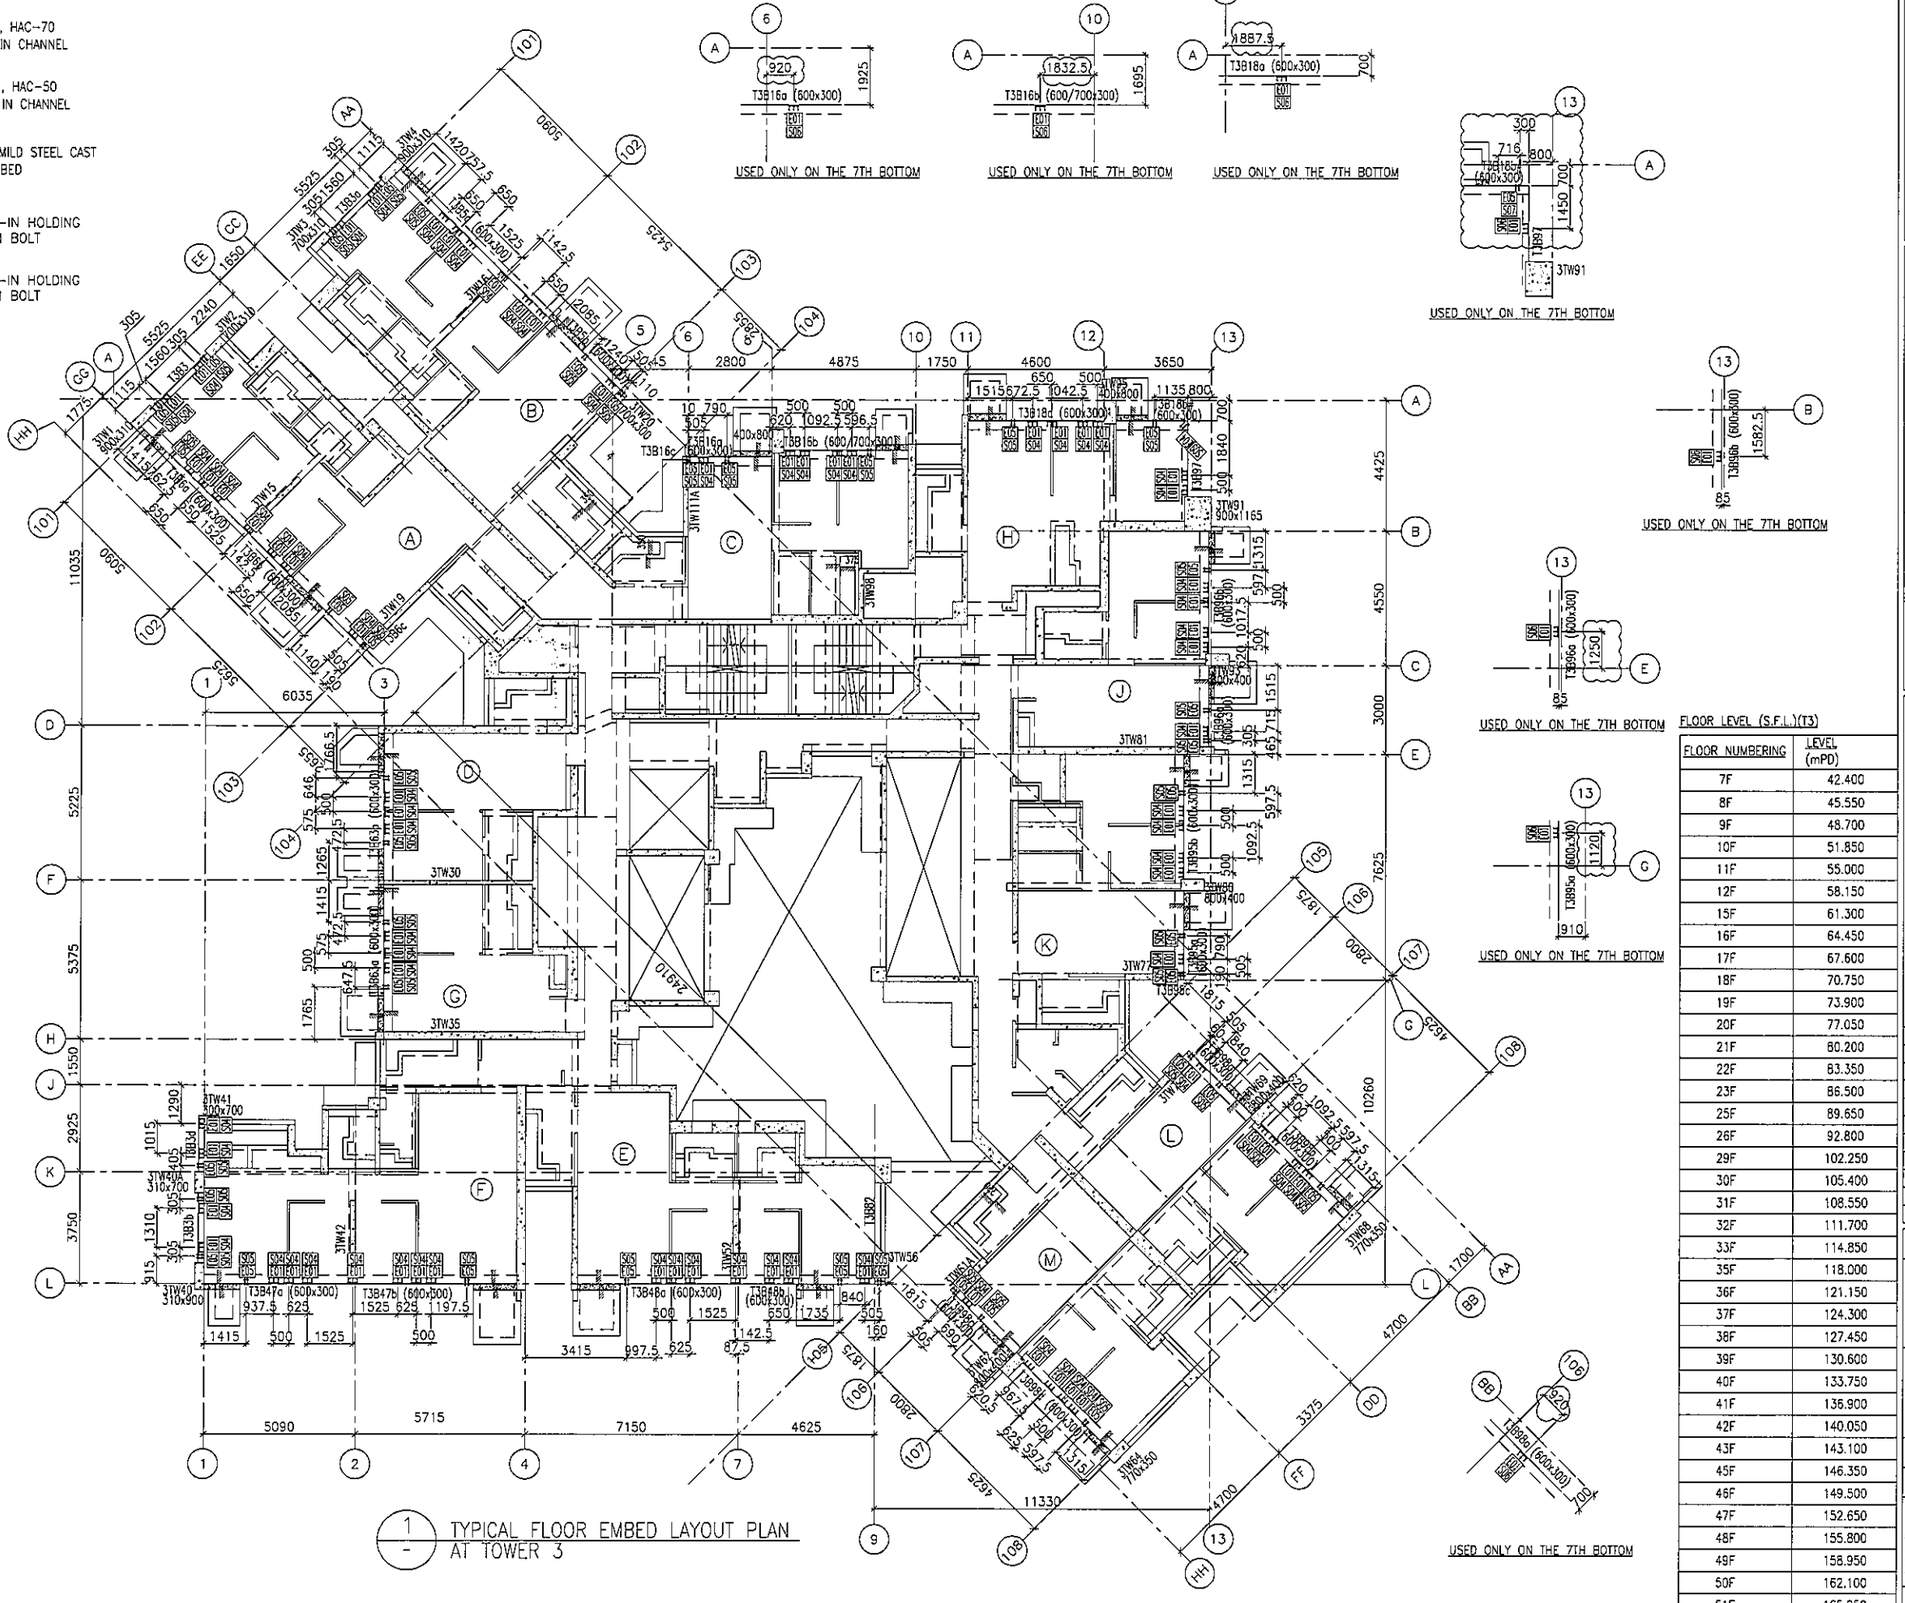

FLOOR NUMBERING	LEVEL (mPD)
7F	42.400
8F	45.550
9F	48.700
10F	51.850
11F	55.000
12F	58.150
15F	61.300
16F	64.450
17F	67.600
18F	70.750
19F	73.900
20F	77.050
21F	80.200
22F	83.350
23F	86.500
25F	89.650
26F	92.800
29F	102.250
30F	105.400
31F	108.550
32F	111.700
33F	114.850
35F	118.000
36F	121.150
37F	124.300
38F	127.450
39F	130.600
40F	133.750
41F	136.900
42F	140.050
43F	143.100
45F	146.350
46F	149.500
47F	152.650
48F	155.800
49F	158.950
50F	162.100
51F	165.250

1 / - TYPICAL FLOOR EMBED LAYOUT PLAN AT TOWER 3

B.D. REF :

CLIENT : 信和置業有限公司 Sino Land Company Limited

ARCHITECT : WONG TUNG & PARTNERS LIMITED ARCHITECTS & PLANNERS

MAIN CONTRACTOR : CR Construction Company Limited

STRUCTURAL ENGINEER : AECOM

FACADE CONSULTANT: AECOM

NOTE :
1. ALL DIMENSIONS ARE IN mm.
2. ALL ELEVATIONS ARE VIEWED FROM OUTSIDE.
3. ALL DIMENSIONS TO BE VERIFIED ON SITE BEFORE FABRICATION.

LEGEND :
- X1 / XD01 — DETAIL MARK NO. / REFER SHEET NO.
1. F.F.L. --FINISHED FLOOR LEVEL
2. S.F.L. --STRUCTURAL FLOOR LEVEL
3. /R --REVERSED DETAIL

NO.	DATE	REVISED	BY
J	18/08/2019	GENERAL REVISED	
I	16/07/2019	GENERAL REVISED	
H	28/01/2019	GENERAL REVISED	
G	08/11/2018	GENERAL REVISED	
F	17/10/2018	GENERAL REVISED	
E	11/10/2018	GENERAL REVISED	
D	14/9/2018	GENERAL REVISED	
C	04/9/2018	GENERAL REVISED	
B	24/8/2018	GENERAL REVISED	
A	31/7/2018	GENERAL REVISED	

JOB NO. : J-837

PROJECT : URA KWUN TONG TOWN CENTRE REDEVELOPMENT (AREA 2 & 3) AT NKIL 6514, KWUN TONG, KWLOON

TITLE : TYPICAL FLOOR EMBED LAYOUT PLAN OF CURTAIN WALL AT TOWER 3

DATE : 04-JUL-18 | SCALE : 1:100 (A1)

DRAWN BY : ASING | CHECKED BY : -

美特鋁質有限公司 MIDI ALUMINIUM FABRICATOR LTD.
Units 6-8, Sunray Industrial Centre, 1/F
610 Cha Kwo Ling Road, Kowloon
Tel:23489211-4 Fax:(852)27727666

DWG NO. : J837-CW-1302 | REV. : J

LEGEND :

- E01 = HILIT , HAC-70 CAST IN CHANNEL
- E02 = HILIT , HAC-50 CAST IN CHANNEL
- E03 = GAL. MILD STEEL CAST IN EMBED
- E04 = CAST-IN HOLDING DOWN BOLT
- E05 = CAST-IN HOLDING DOWN BOLT
- E06 = CAST-IN HOLDING DOWN BOLT
- E07 = CAST-IN HOLDING DOWN BOLT

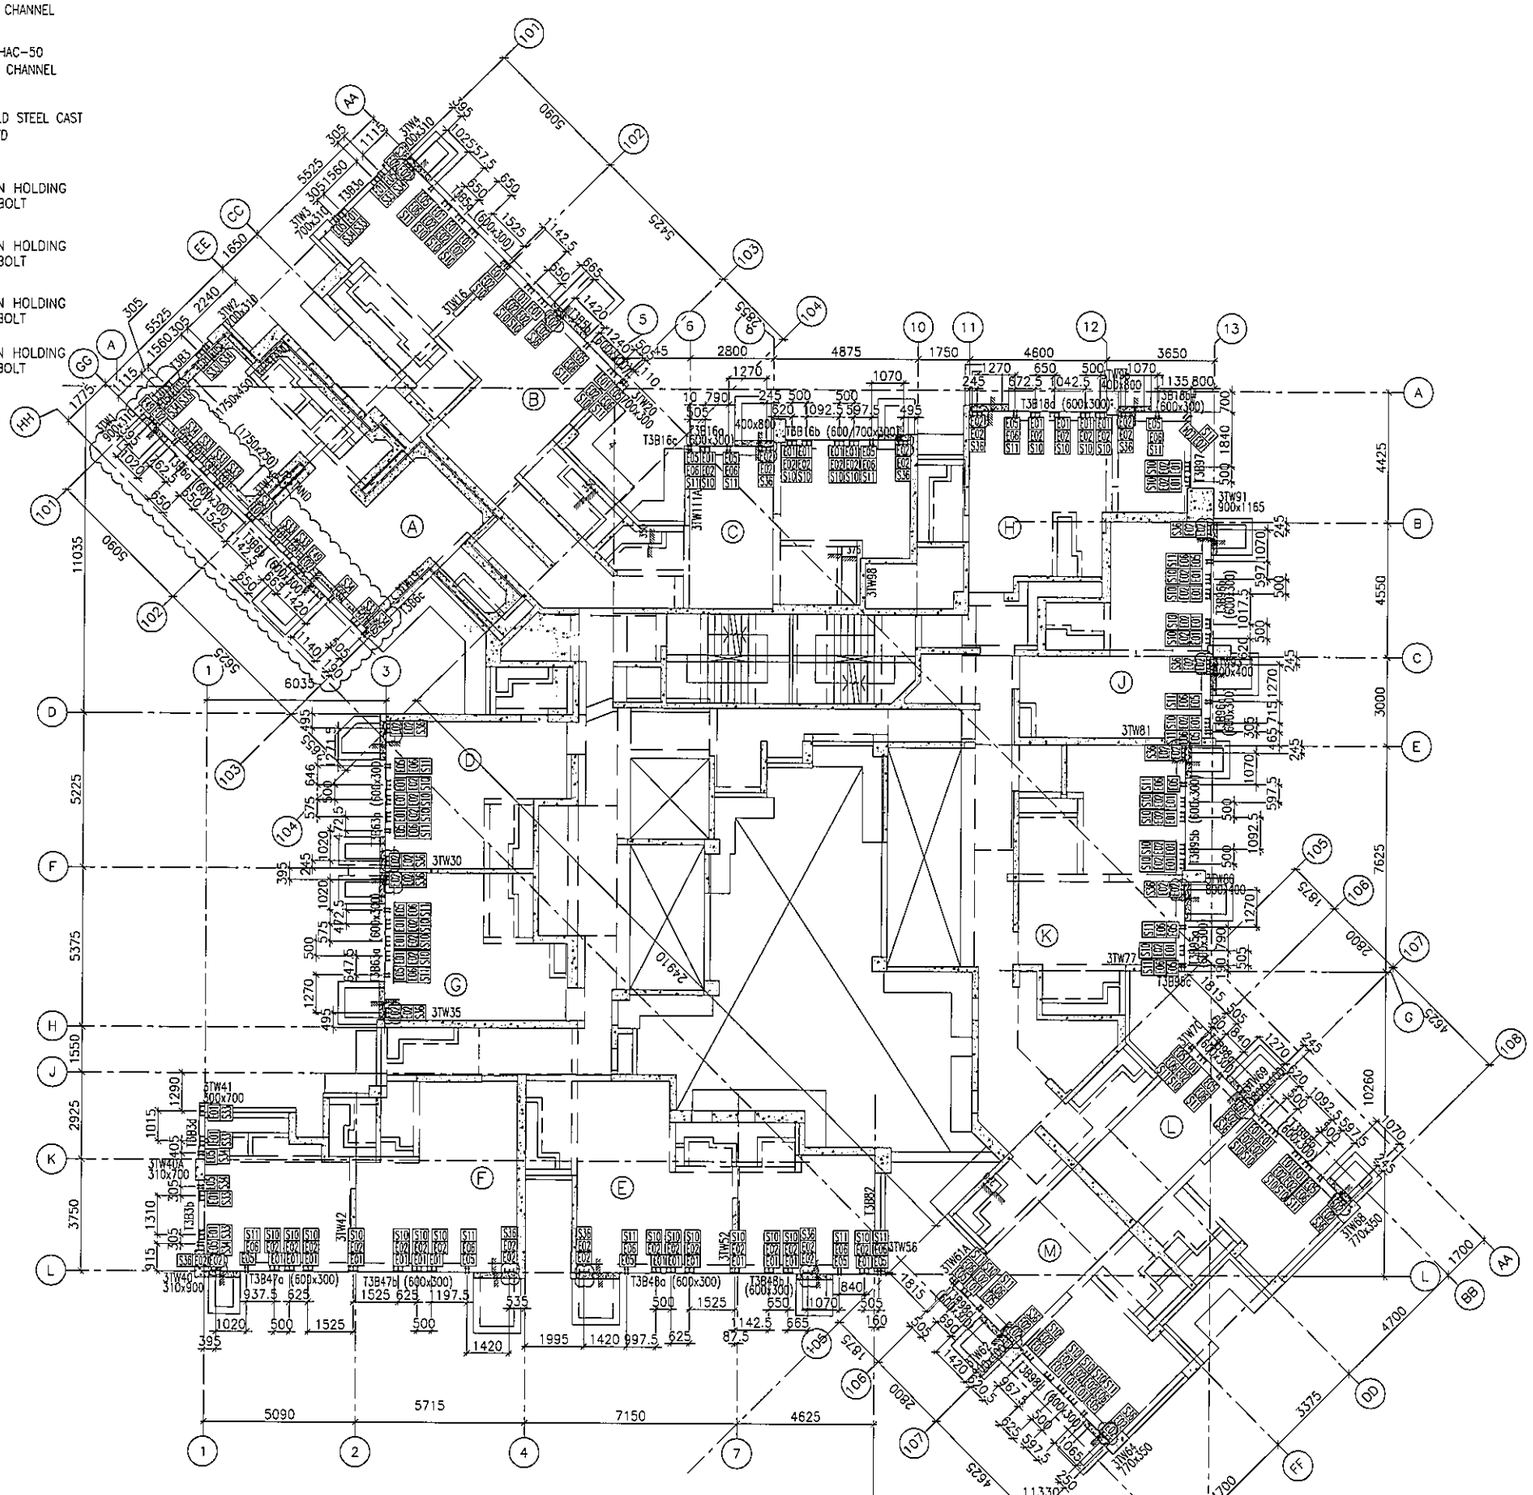

1 / - 27TH FLOOR EMBED LAYOUT PLAN AT TOWER 3

FLOOR LEVEL (S.F.L)(T3)

FLOOR NUMBERING	LEVEL (mPD)
27F	+95.95

B.D. REF :

CLIENT : 信和置業有限公司 Sino Land Company Limited

ARCHITECT : WONG TUNG & PARTNERS LIMITED ARCHITECTS & PLANNERS

MAIN CONTRACTOR : CR Construction Company Limited

STRUCTURAL ENGINEER : AECOM

FACADE CONSULTANT: AECOM

NOTE :
1. ALL DIMENSIONS ARE IN mm.
2. ALL ELEVATIONS ARE VIEWED FROM OUTSIDE.
3. ALL DIMENSIONS TO BE VERIFIED ON SITE BEFORE FABRICATION.

LEGEND :
- X1 / X001 — DETAIL MARK NO. / REFER SHEET NO.
1. F.F.L. --FINISHED FLOOR LEVEL
2. S.F.L. --STRUCTURAL FLOOR LEVEL
3. /R --REVERSED DETAIL

NO.	DATE	REVISED	BY
H	18/08/2019	GENERAL REVISED	
G	21/02/2019	GENERAL REVISED	
F	19/01/2019	GENERAL REVISED	
E	08/11/2018	GENERAL REVISED	
D	17/10/2018	GENERAL REVISED	
C	11/10/2018	GENERAL REVISED	
B	14/9/2018	GENERAL REVISED	
A	07/9/2018	GENERAL REVISED	

JOB NO. : J-837

PROJECT : URA KWUN TONG TOWN CENTRE REDEVELOPMENT (AREA 2 & 3) AT NKIL 6514, KWUN TONG, KWLOON

TITLE : 27TH FLOOR EMBED LAYOUT PLAN OF CURTAIN WALL AT TOWER 3

DATE : 10-SEP-18	SCALE : 1:100 (A1)
DRAWN BY : ASING	CHECKED BY : -

美特鋁質有限公司 MIDI ALUMINIUM FABRICATOR LTD.
Units 6-8, Sunray Industrial Centre, 1/F
610 Cha Kwo Ling Road, Kowloon
Tel:23489211-4 Fax:(852)27727666

DWG NO. : J837-CW-1303 REV. : H

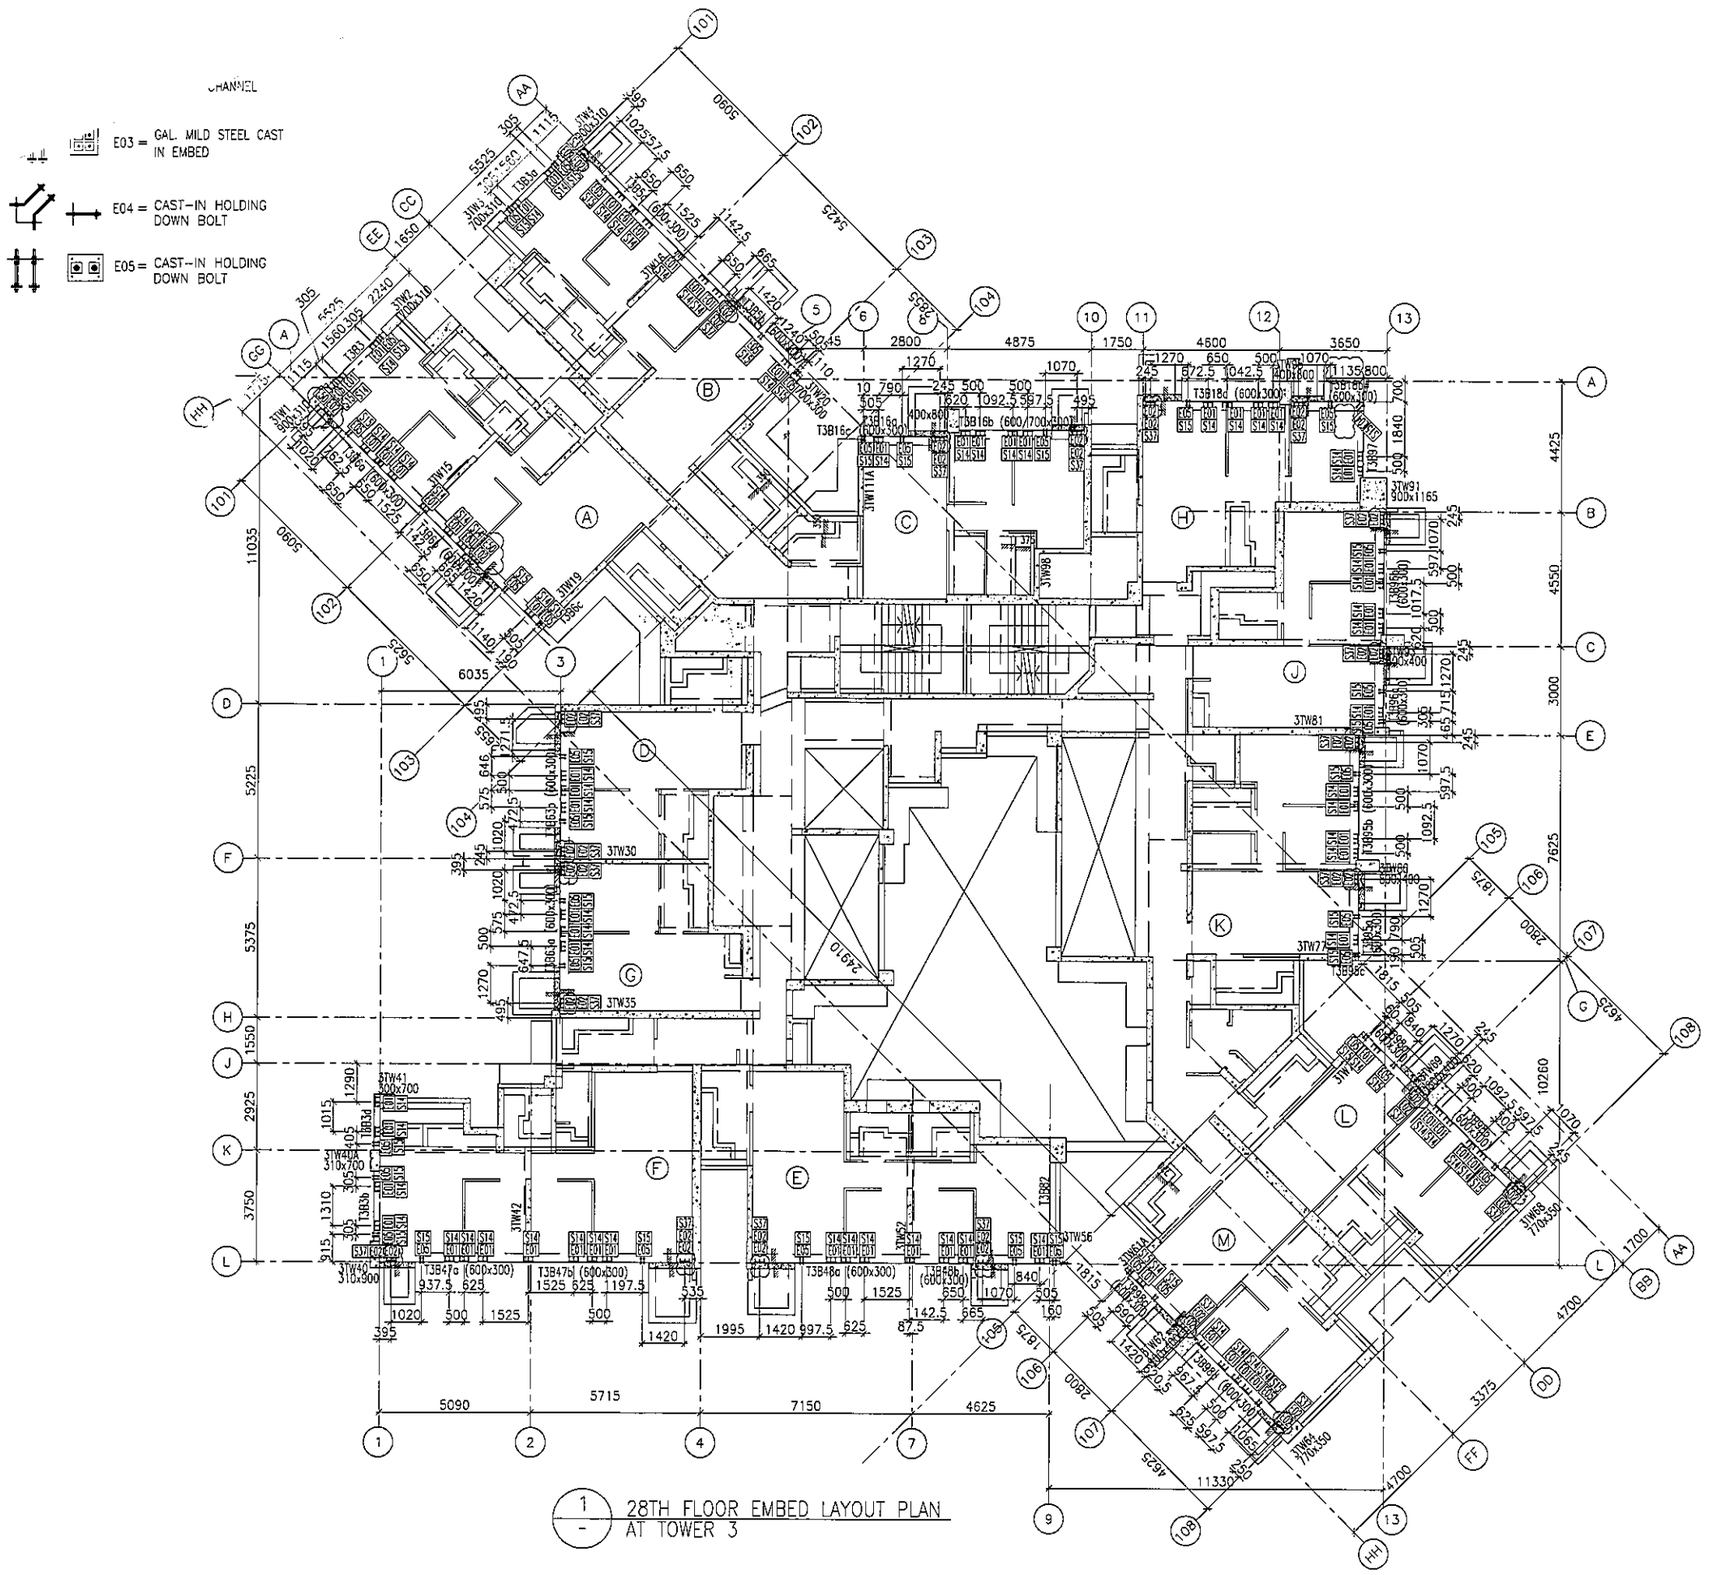

1 / - 28TH FLOOR EMBED LAYOUT PLAN AT TOWER 3

FLOOR LEVEL (S.F.L.)(T3)

FLOOR NUMBERING	LEVEL (mPD)
28F	+99.100

B.D. REF :

CLIENT :
信和置業有限公司
Sino Land Company Limited

ARCHITECT :
WONG TUNG & PARTNERS LIMITED
ARCHITECTS & PLANNERS

MAIN CONTRACTOR :
CR Construction Company Limited

STRUCTURAL ENGINEER :
AECOM

FACADE CONSULTANT:
AECOM

NOTE :
1. ALL DIMENSIONS ARE IN mm.
2. ALL ELEVATIONS ARE VIEWED FROM OUTSIDE.
3. ALL DIMENSIONS TO BE VERIFIED ON SITE BEFORE FABRICATION.

LEGEND :
X1 — DETAIL MARK NO.
X001 — REFER SHEET NO.

1. F.F.L. -- FINISHED FLOOR LEVEL
2. S.F.L. -- STRUCTURAL FLOOR LEVEL
3. (R) -- REVERSED DETAIL

NO.	DATE	REVISED	BY
E	18/08/2019	GENERAL REVISED	
D	21/02/2019	GENERAL REVISED	
C	17/10/2018	GENERAL REVISED	
B	11/10/2018	GENERAL REVISED	
A	14/9/2018	GENERAL REVISED	

JOB NO. : J-837

PROJECT :
URA KWUN TONG TOWN CENTRE REDEVELOPMENT (AREA 2 & 3) AT NKIL 6514, KWUN TONG, KWLOON

TITLE :
28TH FLOOR EMBED LAYOUT PLAN OF CURTAIN WALL AT TOWER 3

DATE : 10-SEP-18 | SCALE : 1:100 (A1)

DRAWN BY : ASING | CHECKED BY : -

美特鋁質有限公司
MIDI ALUMINIUM FABRICATOR LTD.
Units 6-8, Sunray Industrial Centre, 1/F
610 Cha Kwo Ling Road, Kowloon
Tel:23489211-4 Fax:(852)27727666

DWG NO. : J837-CW-1304 | REV. : E

LEGEND :

- E01 = HILIT , HAC-70 CAST IN CHANNEL
- E02 = HILIT , HAC-50 CAST IN CHANNEL
- E03 = GAL. MILD STEEL CAST IN EMBED
- E04 = CAST-IN HOLDING DOWN BOLT
- E05 = CAST-IN HOLDING DOWN BOLT

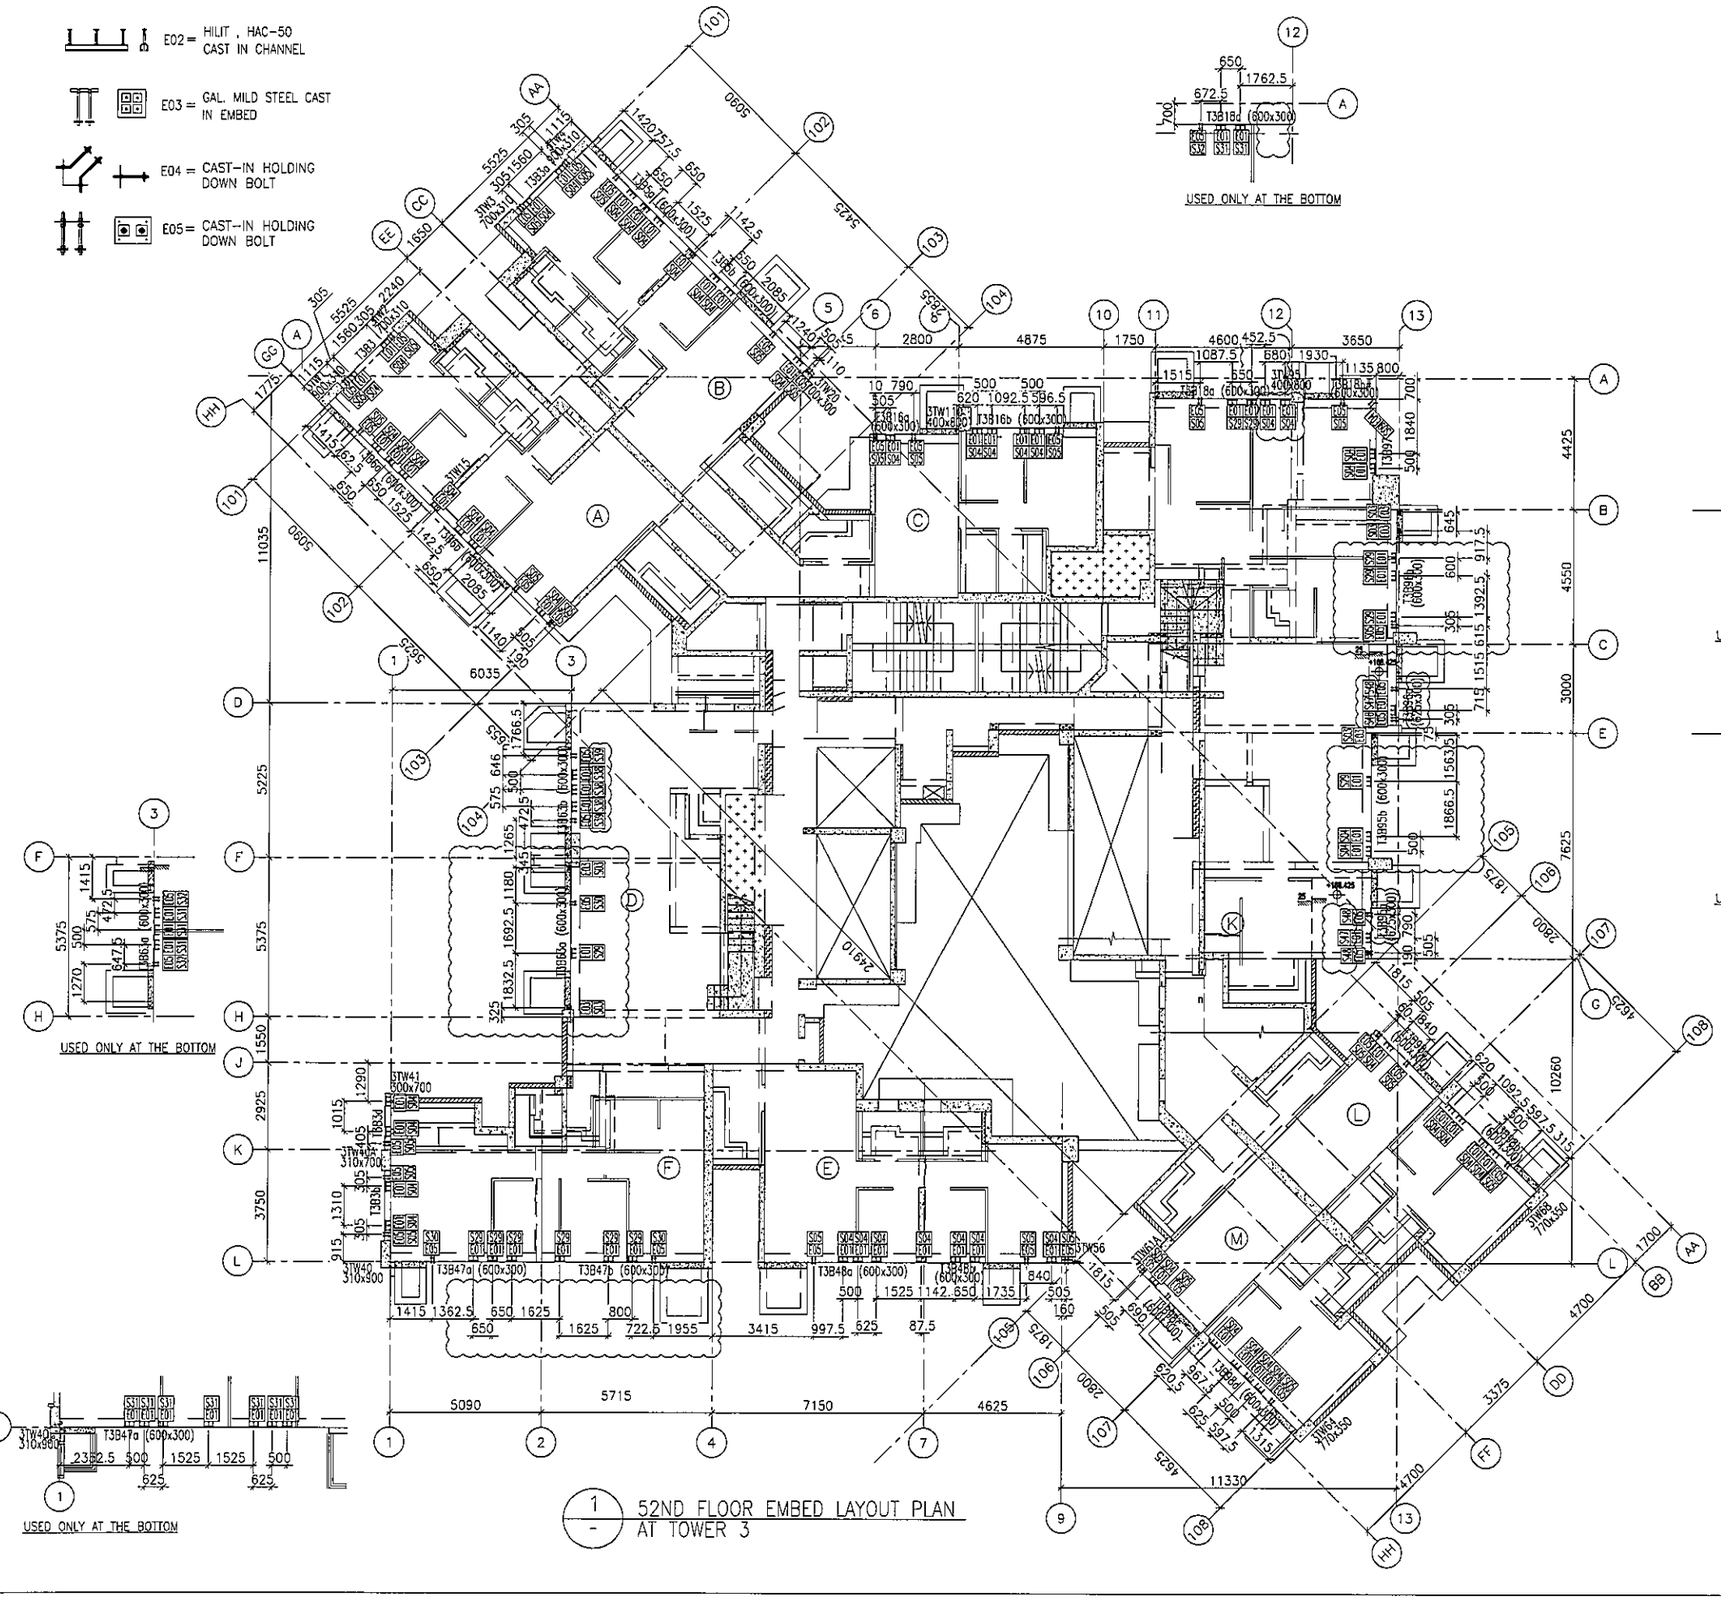

1 / - 52ND FLOOR EMBED LAYOUT PLAN AT TOWER 3

FLOOR LEVEL (S.F.L.)(T3)

FLOOR NUMBERING	LEVEL (mPD)
52F	+168.400

B.D. REF :

CLIENT : 信和置業有限公司 Sino Land Company Limited

ARCHITECT : WONG TUNG & PARTNERS LIMITED ARCHITECTS & PLANNERS

MAIN CONTRACTOR : CR Construction Company Limited

STRUCTURAL ENGINEER : AECOM

FACADE CONSULTANT: AECOM

NOTE :
1. ALL DIMENSIONS ARE IN mm.
2. ALL ELEVATIONS ARE VIEWED FROM OUTSIDE.
3. ALL DIMENSIONS TO BE VERIFIED ON SITE BEFORE FABRICATION.

LEGEND :
- X1 / X001 — DETAIL MARK NO. / REFER SHEET NO.
1. F.F.L. --- FINISHED FLOOR LEVEL
2. S.F.L. --- STRUCTURAL FLOOR LEVEL
3. /R --- REVERSED DETAIL

NO.	DATE	REVISED	BY
I	20/06/2019	GENERAL REVISED	
H	03/06/2019	GENERAL REVISED	
G	22/05/2019	GENERAL REVISED	
F	19/05/2019	GENERAL REVISED	
E	07/04/2019	GENERAL REVISED	
D	13/01/2019	GENERAL REVISED	
C	22/12/2018	GENERAL REVISED	
B	17/10/2018	GENERAL REVISED	
A	11/10/2018	GENERAL REVISED	

JOB NO. : J-837

PROJECT : URA KWUN TONG TOWN CENTRE REDEVELOPMENT (AREA 2 & 3) AT NKIL 6514, KWUN TONG, KWLOON

TITLE : 52ND FLOOR EMBED LAYOUT PLAN OF CURTAIN WALL AT TOWER 3

DATE : 10-SEP-18 | SCALE : 1:100 (A1)

DRAWN BY : ASING | CHECKED BY : -

美特鋁製有限公司 MIDI ALUMINIUM FABRICATOR LTD.
Units 6-8, Sunray Industrial Centre, 1/F
610 Cha Kwo Ling Road, Kowloon
Tel:23489211-4 Fax:(852)27727666

DWG NO. : J837-CW-1305 | REV. : I

LEGEND :

- E01 = HILIT , HAC-70 CAST IN CHANNEL
- E02 = HILIT , HAC-50 CAST IN CHANNEL
- E04 = CAST-IN HOLDING DOWN BOLT
- E05 = CAST-IN HOLDING DOWN BOLT

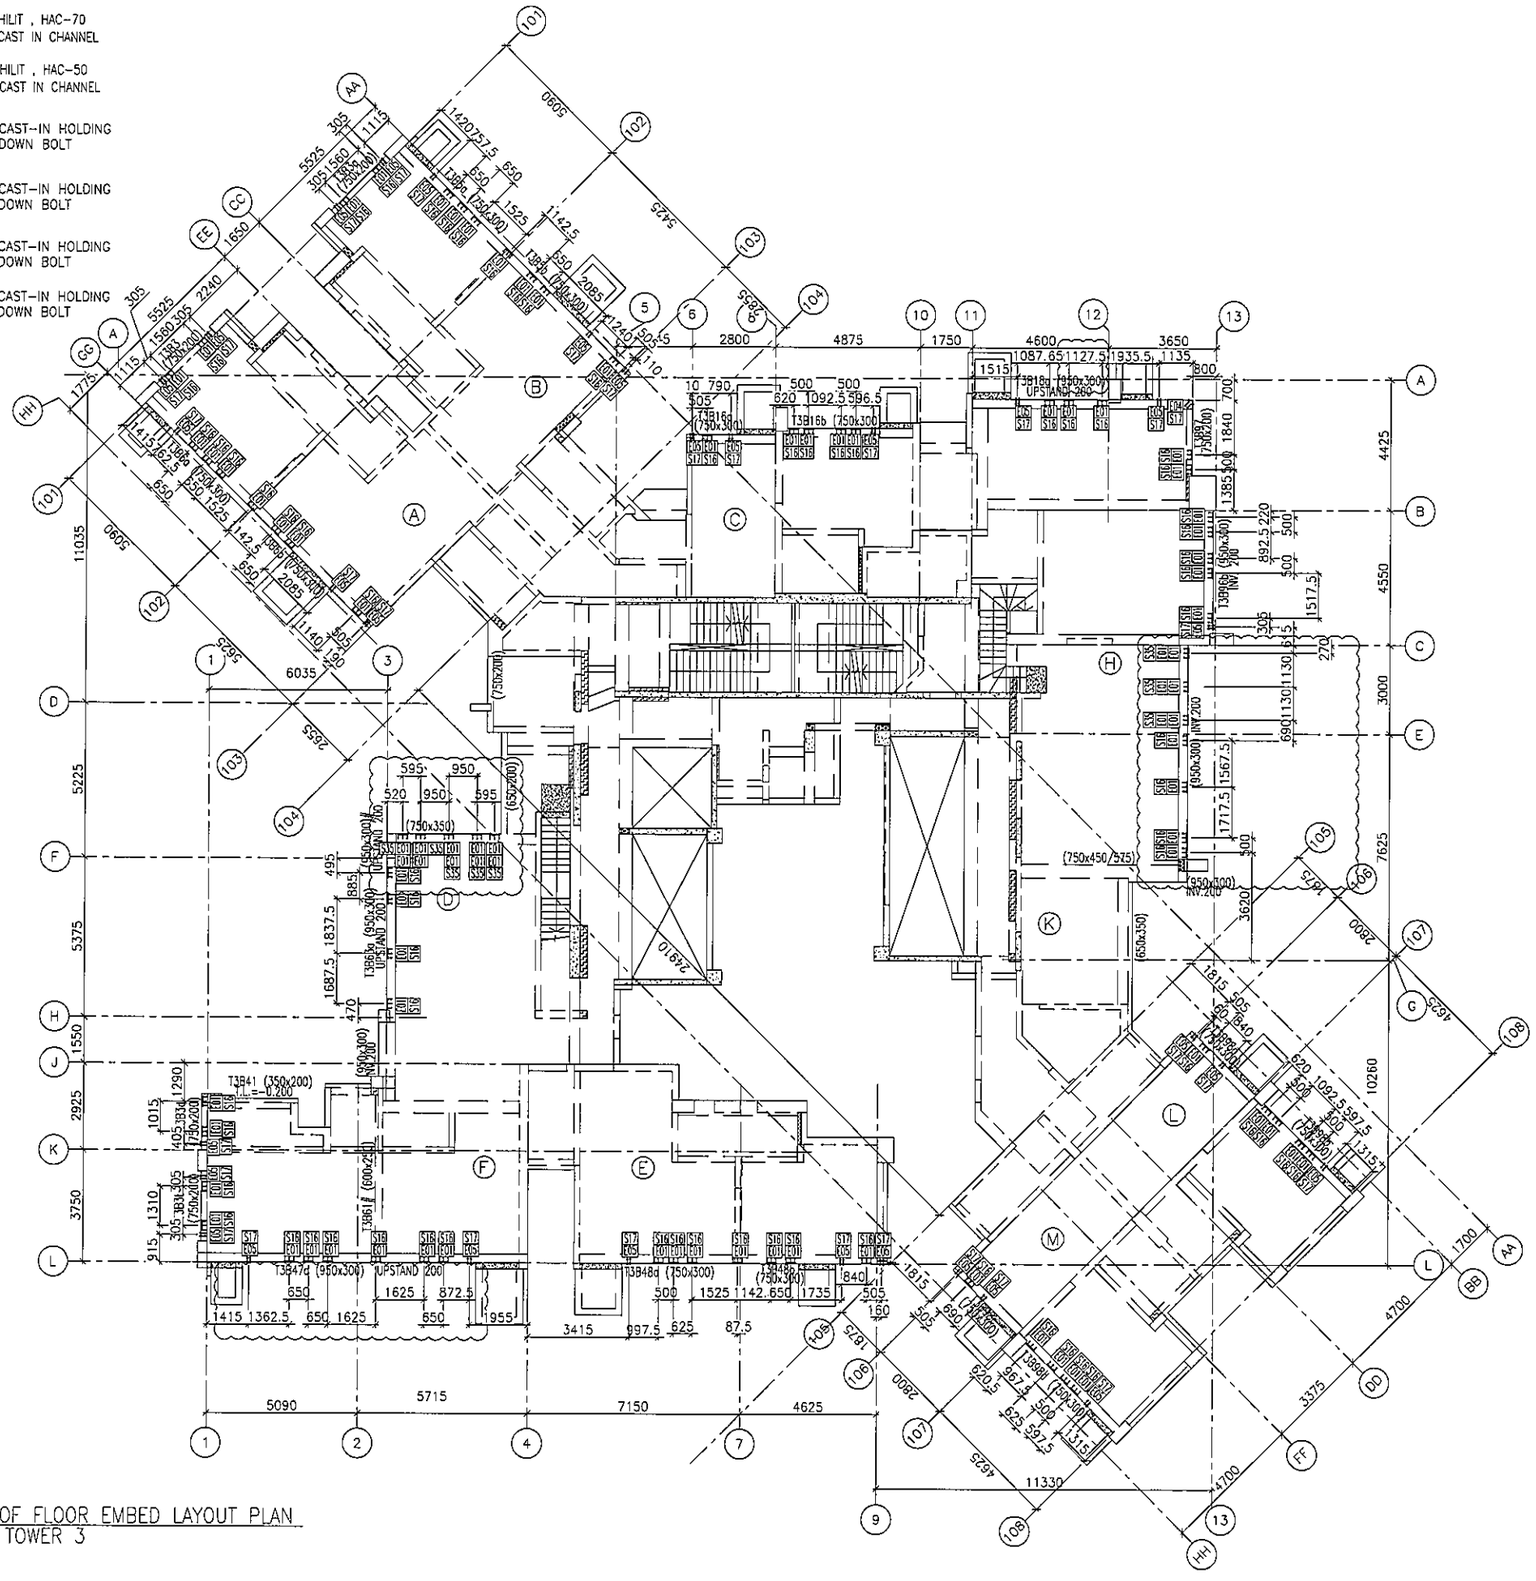

1 / - ROOF FLOOR EMBED LAYOUT PLAN AT TOWER 3

FLOOR LEVEL (S.F.L.)(T3)

FLOOR NUMBERING	LEVEL (mPD)
RF	+171.700

B.D. REF :

CLIENT : 信和置業有限公司 Sino Land Company Limited

ARCHITECT : WONG TUNG & PARTNERS LIMITED ARCHITECTS & PLANNERS

MAIN CONTRACTOR : CR Construction Company Limited

STRUCTURAL ENGINEER : AECOM

FACADE CONSULTANT: AECOM

NOTE :
1. ALL DIMENSIONS ARE IN mm.
2. ALL ELEVATIONS ARE VIEWED FROM OUTSIDE.
3. ALL DIMENSIONS TO BE VERIFIED ON SITE BEFORE FABRICATION.

LEGEND :
- X1 / X001 — DETAIL MARK NO. / REFER SHEET NO.
1. F.F.L. --FINISHED FLOOR LEVEL
2. S.F.L. --STRUCTURAL FLOOR LEVEL
3. /R --REVERSED DETAIL

NO.	DATE	REVISED	BY
G	20/06/2019	GENERAL REVISED	
F	03/06/2019	GENERAL REVISED	
E	22/05/2019	GENERAL REVISED	
D	19/05/2019	GENERAL REVISED	
C	07/04/2019	GENERAL REVISED	
B	22/12/2018	GENERAL REVISED	
A	11/10/2018	GENERAL REVISED	

JOB NO. : J-837

PROJECT : URA KWUN TONG TOWN CENTRE REDEVELOPMENT (AREA 2 & 3) AT NKIL 6514, KWUN TONG, KWLOON

TITLE : ROOF FLOOR EMBED LAYOUT PLAN OF CURTAIN WALL AT TOWER 3

DATE : 10-SEP-18 | SCALE : 1:100 (A1)

DRAWN BY : ASING | CHECKED BY : -

美特鋁質有限公司 MIDI ALUMINIUM FABRICATOR LTD.
Units 6-8, Sunray Industrial Centre, 1/F
610 Cha Kwo Ling Road, Kowloon
Tel:23489211-4 Fax:(852)27727666

DWG NO. : J837-CW-1306 | REV. : G

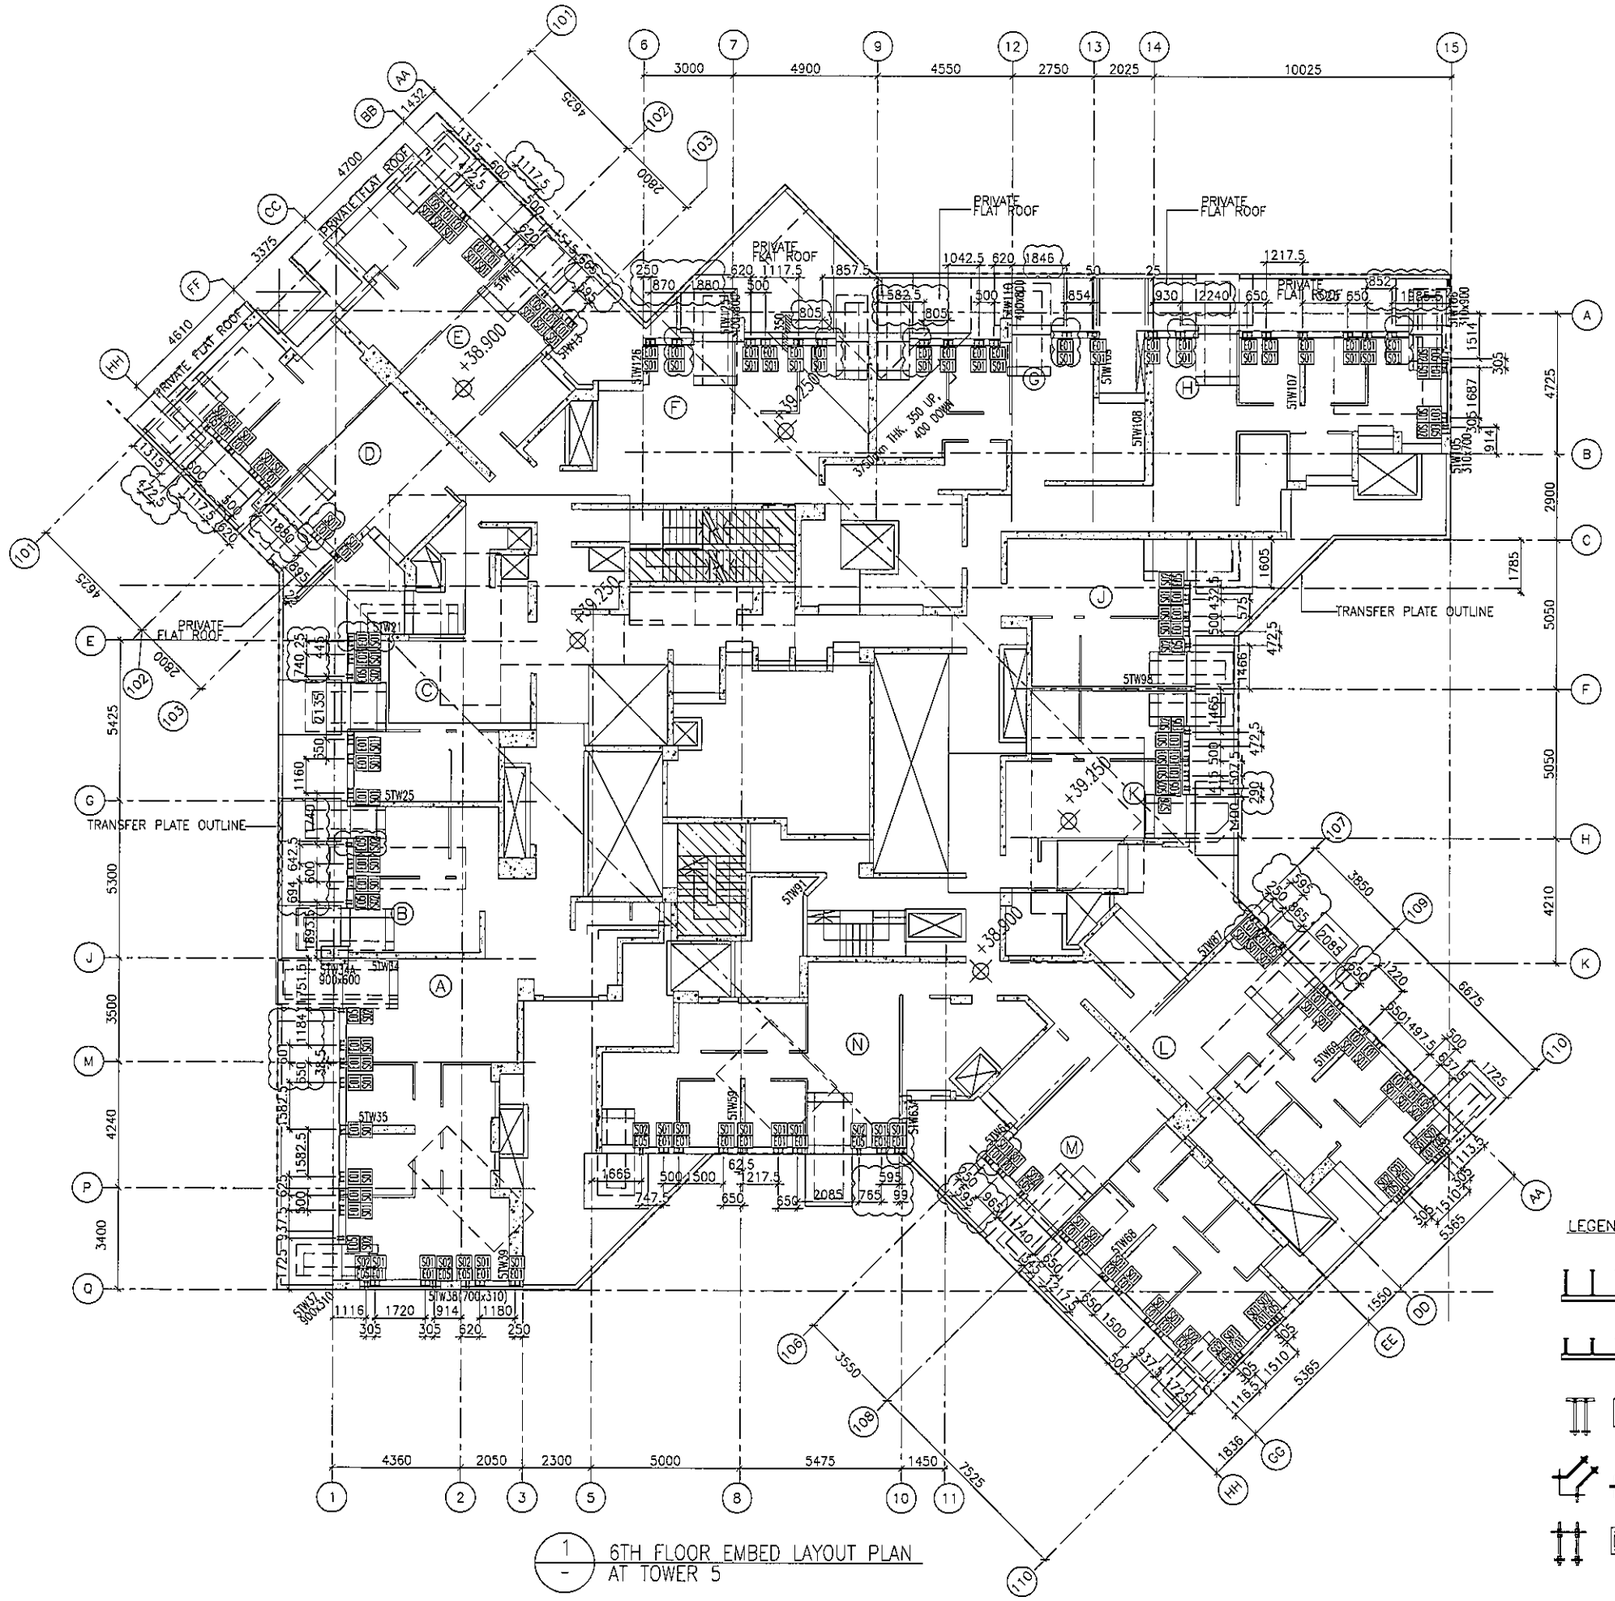
PRIVATE FLAT ROOF
TRANSFER PLATE OUTLINE
+38.900
+39.150
+39.250
3 3.5mm THK. 350 UP, 400 DOWN
5TW25
5TW35
5TW39
5TW91
5TW92
5TW95
5TW98
5TW107
5TW108
LEGEND :

- E01 = HILIT , HAC-70 CAST IN CHANNEL
- E02 = HILIT , HAC-50 CAST IN CHANNEL
- E03 = GAL. MILD STEEL CAST IN EMBED
- E04 = CAST-IN HOLDING DOWN BOLT
- E05 = CAST-IN HOLDING DOWN BOLT

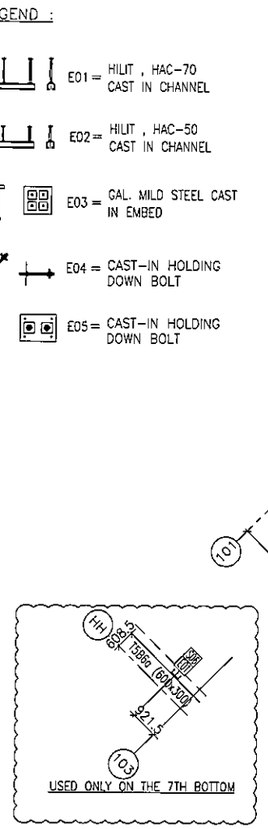

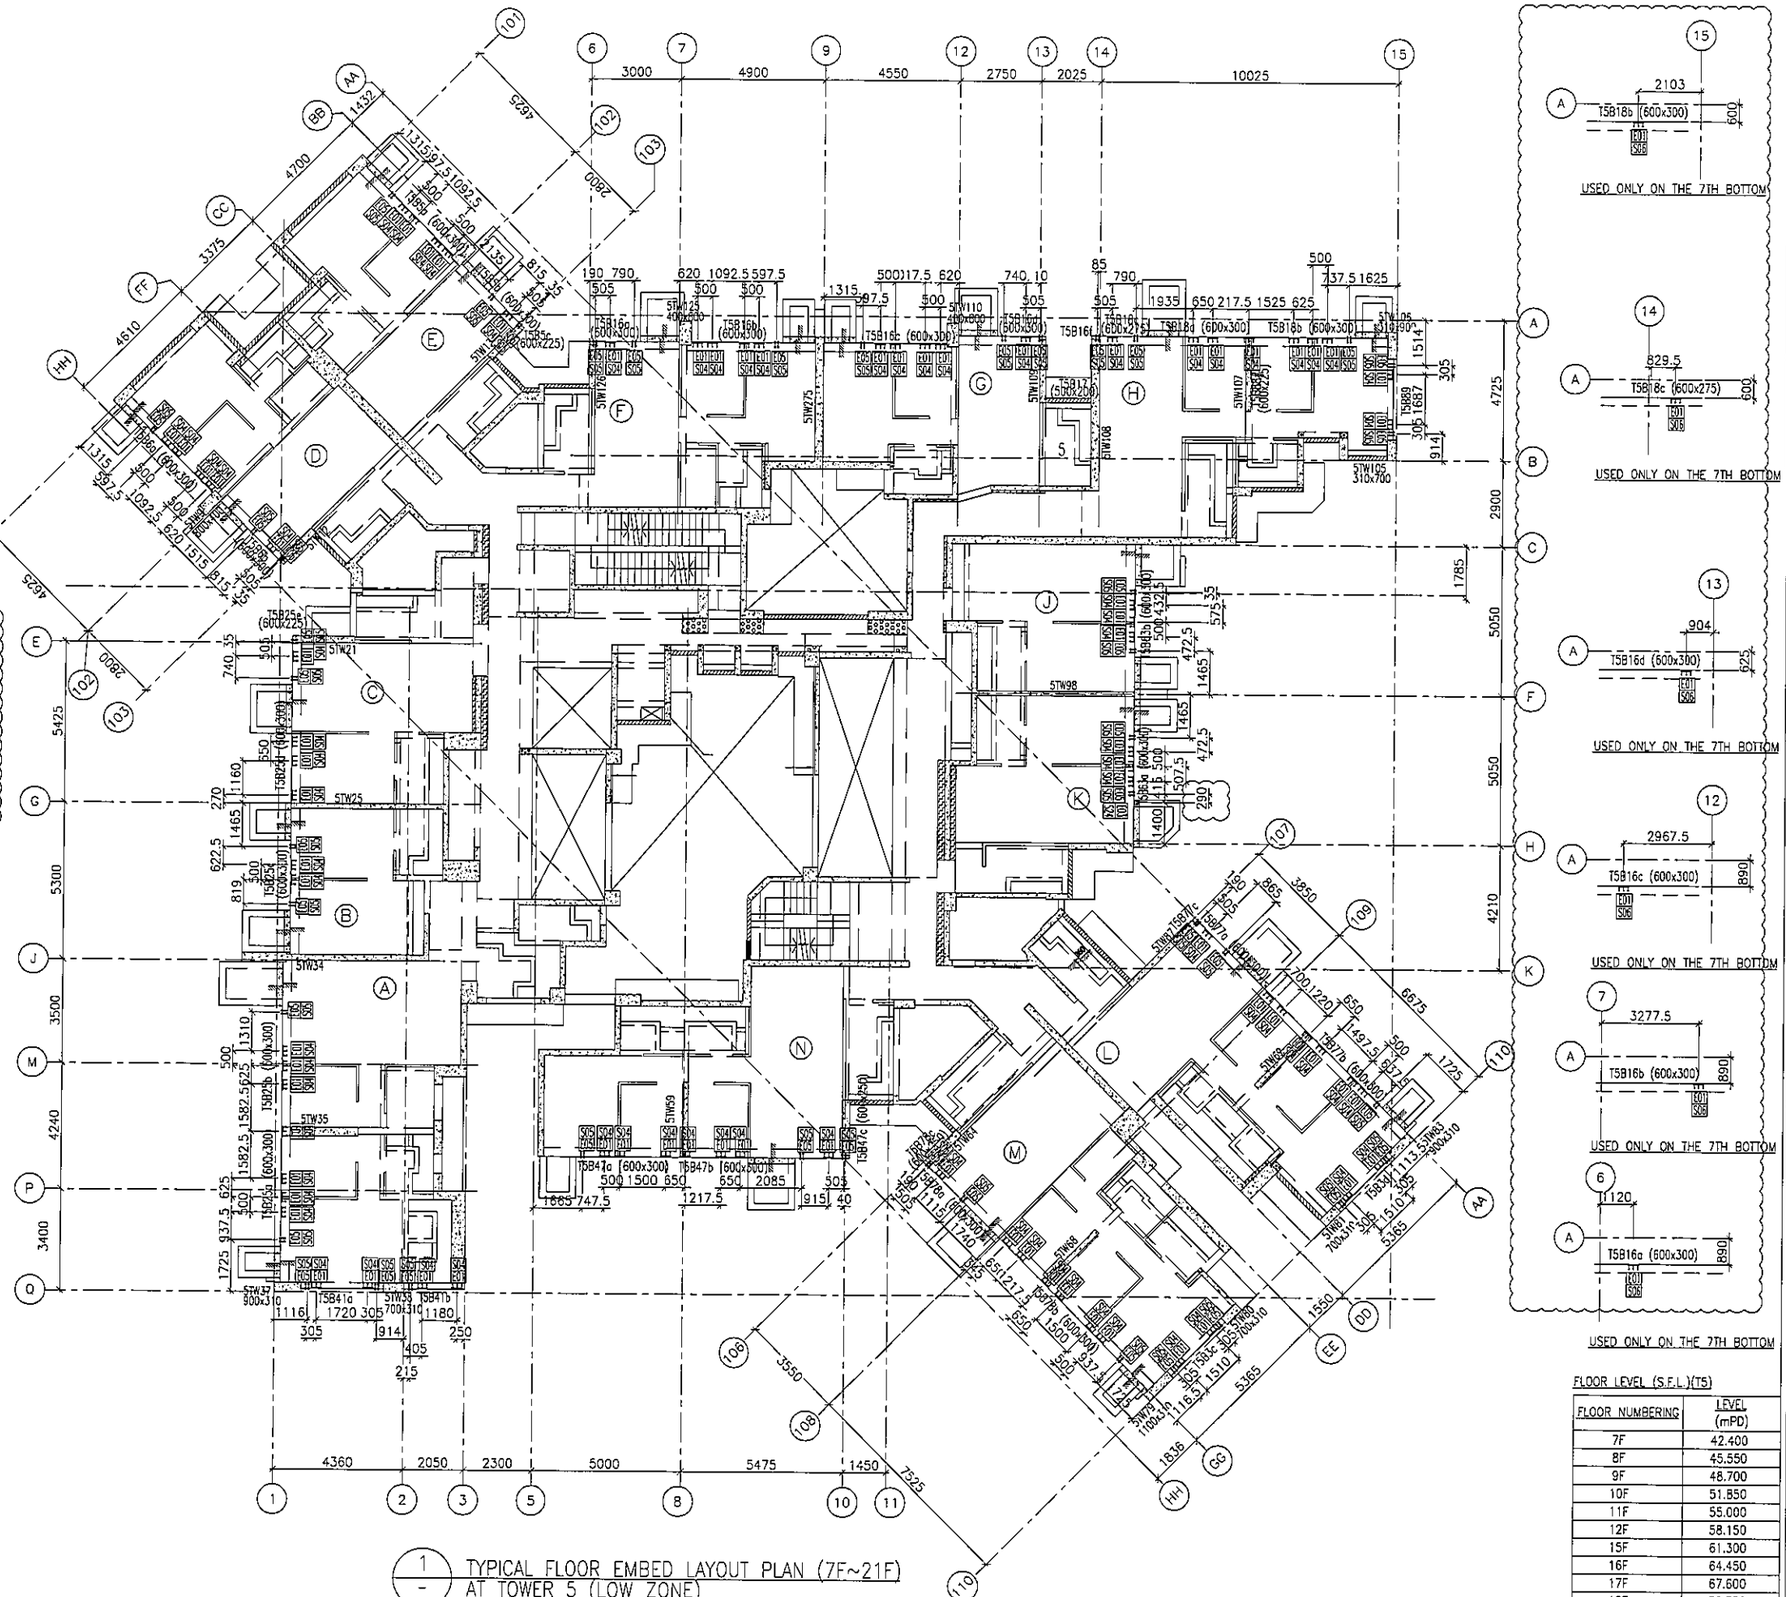

1 / - TYPICAL FLOOR EMBED LAYOUT PLAN (7F~21F) AT TOWER 5 (LOW ZONE)

FLOOR LEVEL (S.F.L.)(T5)

FLOOR NUMBERING	LEVEL (mPD)
7F	42.400
8F	45.550
9F	48.700
10F	51.850
11F	55.000
12F	58.150
15F	61.300
16F	64.450
17F	67.600
18F	70.750
19F	73.900
20F	77.050
21F	80.200

B.D. REF :

CLIENT : 信和置業有限公司 Sino Land Company Limited

ARCHITECT : WONG TUNG & PARTNERS LIMITED ARCHITECTS & PLANNERS

MAIN CONTRACTOR : CR Construction Company Limited

STRUCTURAL ENGINEER : AECOM

FACADE CONSULTANT: AECOM

NOTE :
1. ALL DIMENSIONS ARE IN mm.
2. ALL ELEVATIONS ARE VIEWED FROM OUTSIDE.
3. ALL DIMENSIONS TO BE VERIFIED ON SITE BEFORE FABRICATION.

LEGEND :
- (X1 / X001) — DETAIL MARK NO. / REFER SHEET NO.
1. F.F.L. --FINISHED FLOOR LEVEL
2. S.F.L. --STRUCTURAL FLOOR LEVEL
3. (/R) --REVERSED DETAIL

NO.	DATE	REVISED	BY
L	18/08/2019	GENERAL REVISED	
K	16/07/2019	GENERAL REVISED	
J	28/01/2019	GENERAL REVISED	
I	19/01/2019	GENERAL REVISED	
H	22/12/2018	GENERAL REVISED	
G	08/11/2018	GENERAL REVISED	
F	11/10/2018	GENERAL REVISED	
E	8/10/2018	GENERAL REVISED	
D	14/9/2018	GENERAL REVISED	
C	04/9/2018	GENERAL REVISED	
B	24/8/2018	GENERAL REVISED	
A	11/8/2018	GENERAL REVISED	

JOB NO. : J-837

PROJECT : URA KWUN TONG TOWN CENTRE REDEVELOPMENT (AREA 2 & 3) AT NKIL 6514, KWUN TONG, KWLOON

TITLE : TYPICAL FLOOR EMBED LAYOUT PLAN (7F~26F) OF CURTAIN WALL AT TOWER 5

DATE : 04-JUL-18 | SCALE : 1:100 (A1)

DRAWN BY : ASING | CHECKED BY : -

美特鋁質有限公司 MIDI ALUMINIUM FABRICATOR LTD.
Units 6-8, Sunray Industrial Centre, 1/F
610 Cha Kwo Ling Road, Kowloon
Tel:23489211-4 Fax:(852)27727666

DWG NO. : J837-CW-1502 | REV. : L

LEGEND :

- E01 = HILIT , HAC-70 CAST IN CHANNEL
- E02 = HILIT , HAC-50 CAST IN CHANNEL
- E03 = GAL. MILD STEEL CAST IN EMBED
- E04 = CAST-IN HOLDING DOWN BOLT
- E05 = CAST-IN HOLDING DOWN BOLT

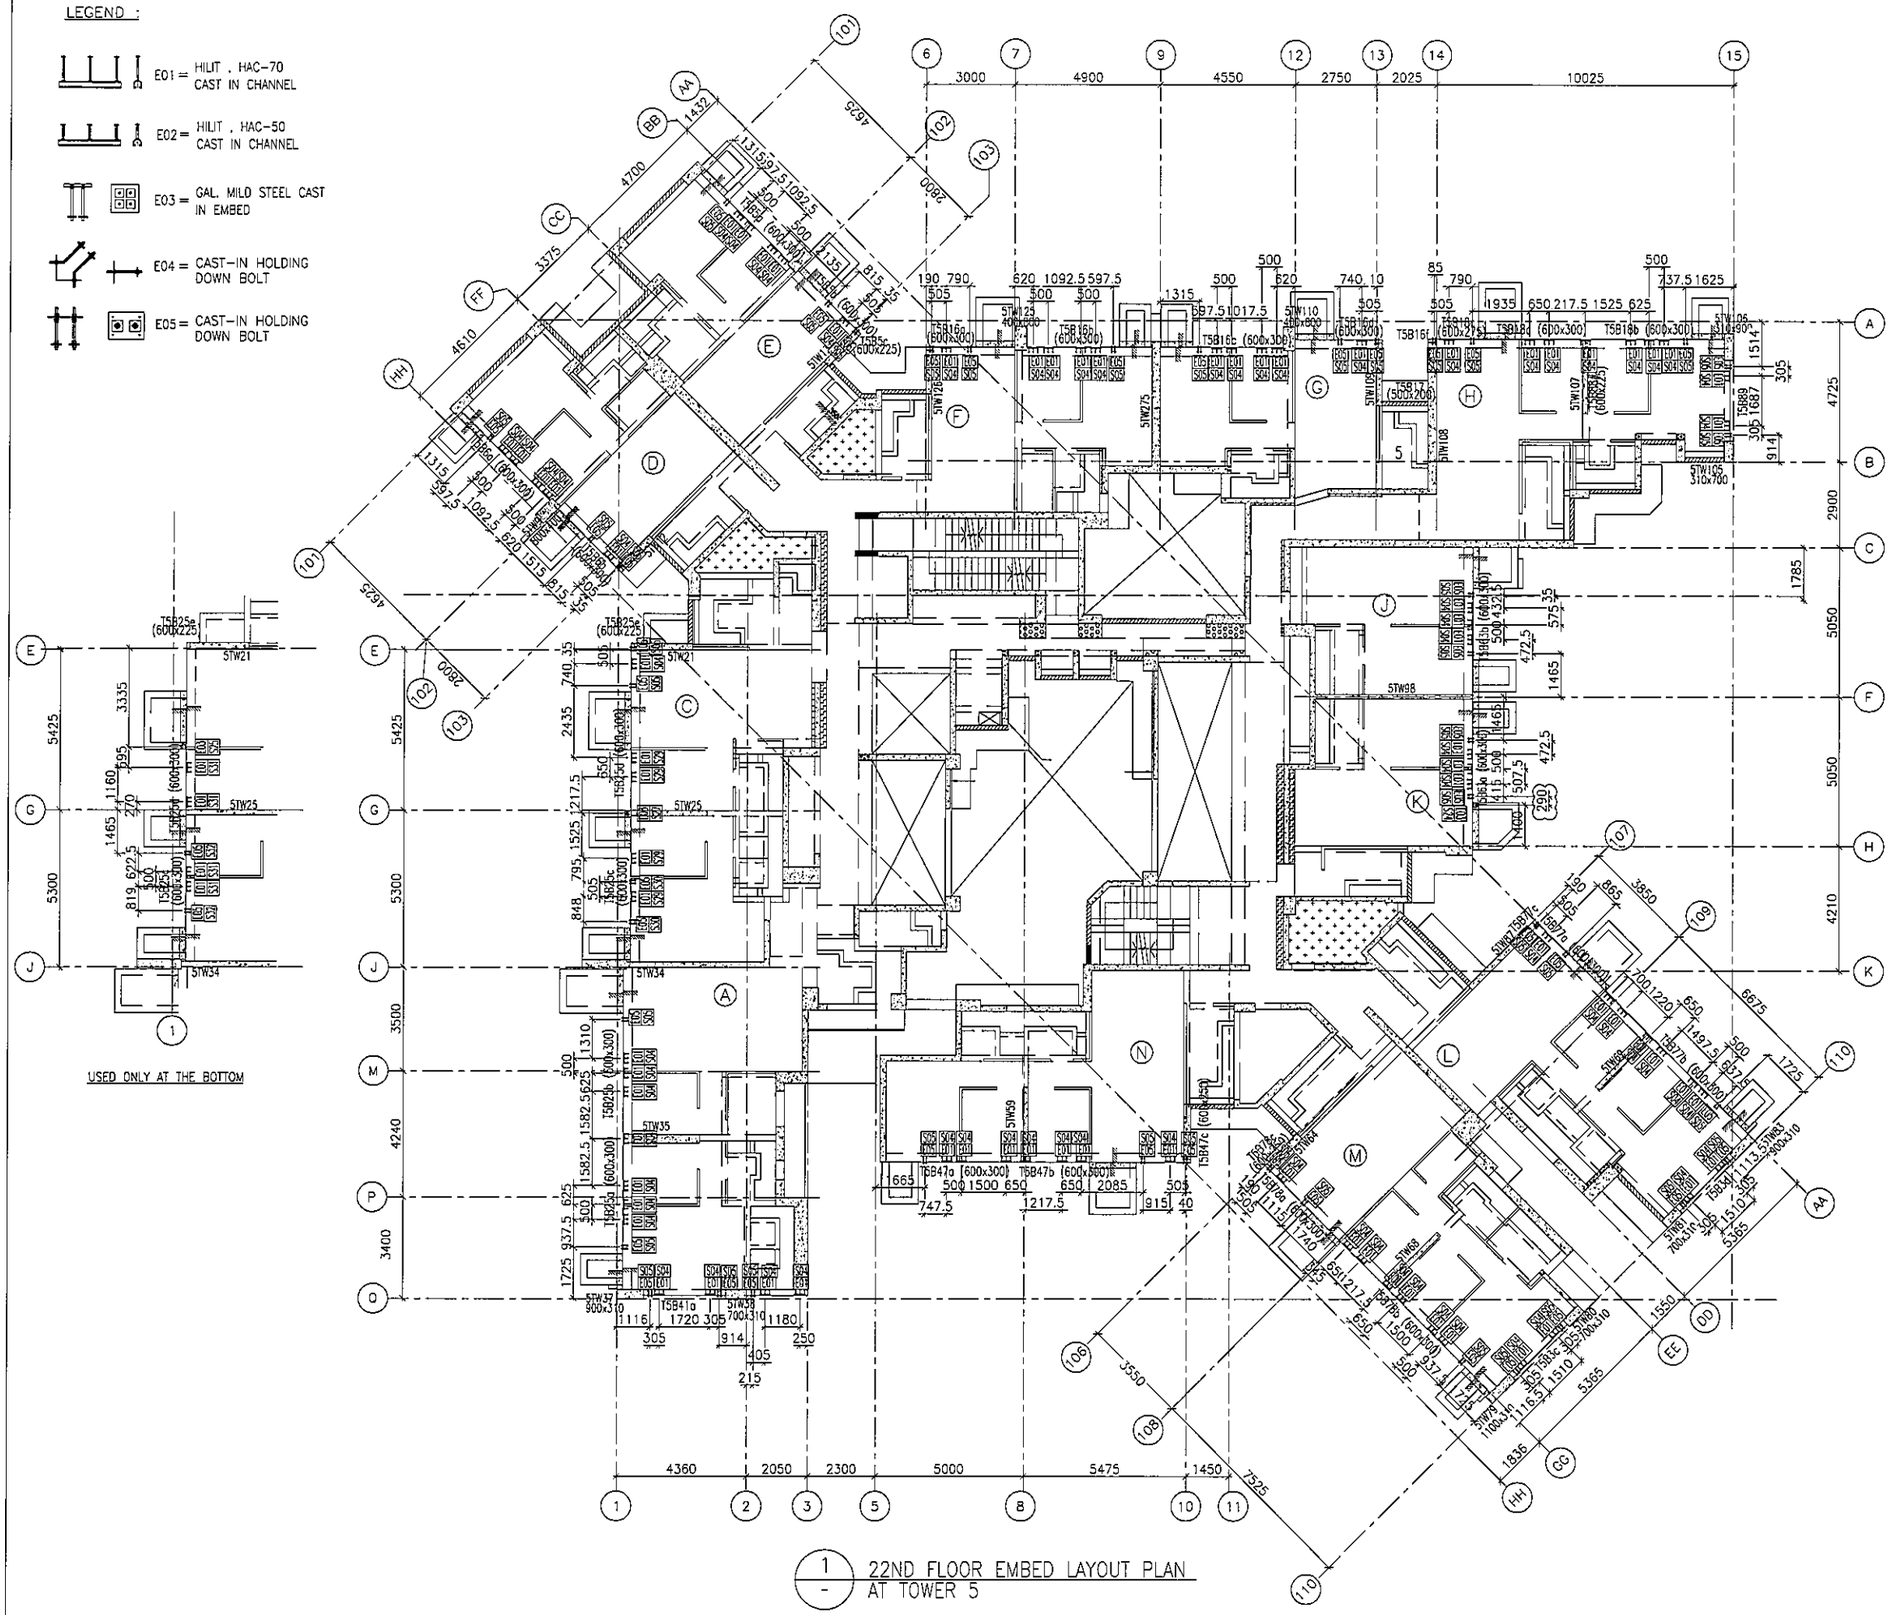
6 7 9 12 13 14 15
3000 4900 4550 2750 2025 10025
101 102 103 106 107 108 109 110
A B C D E F G H J K L M N P Q
1 2 3 5 8 10 11
4360 2050 2300 5000 5475 1450
T5B25a (600x225)
5TW21
5TW25
5TW34
T5B25b (600x225)
T5B16a (600x300)
T5B16b (600x300)
T5B16c (600x300)
T5B16d (600x300)
T5B16e (600x300)
T5B16f (600x300)
T5B16g (600x300)
T5B16h (600x300)
T5B17 (500x206)
T5B18a (600x225)
T5B18b (600x300)
T5B47a (600x300)
T5B47b (600x300)
T5B47c (600x300)
T5B41a
T5B42vb (600x300)

LEGEND :

- E01 = HILIT , HAC-70 CAST IN CHANNEL
- E02 = HILIT , HAC-50 CAST IN CHANNEL
- E03 = GAL. MILD STEEL CAST IN EMBED
- E04 = CAST-IN HOLDING DOWN BOLT
- E05 = CAST-IN HOLDING DOWN BOLT

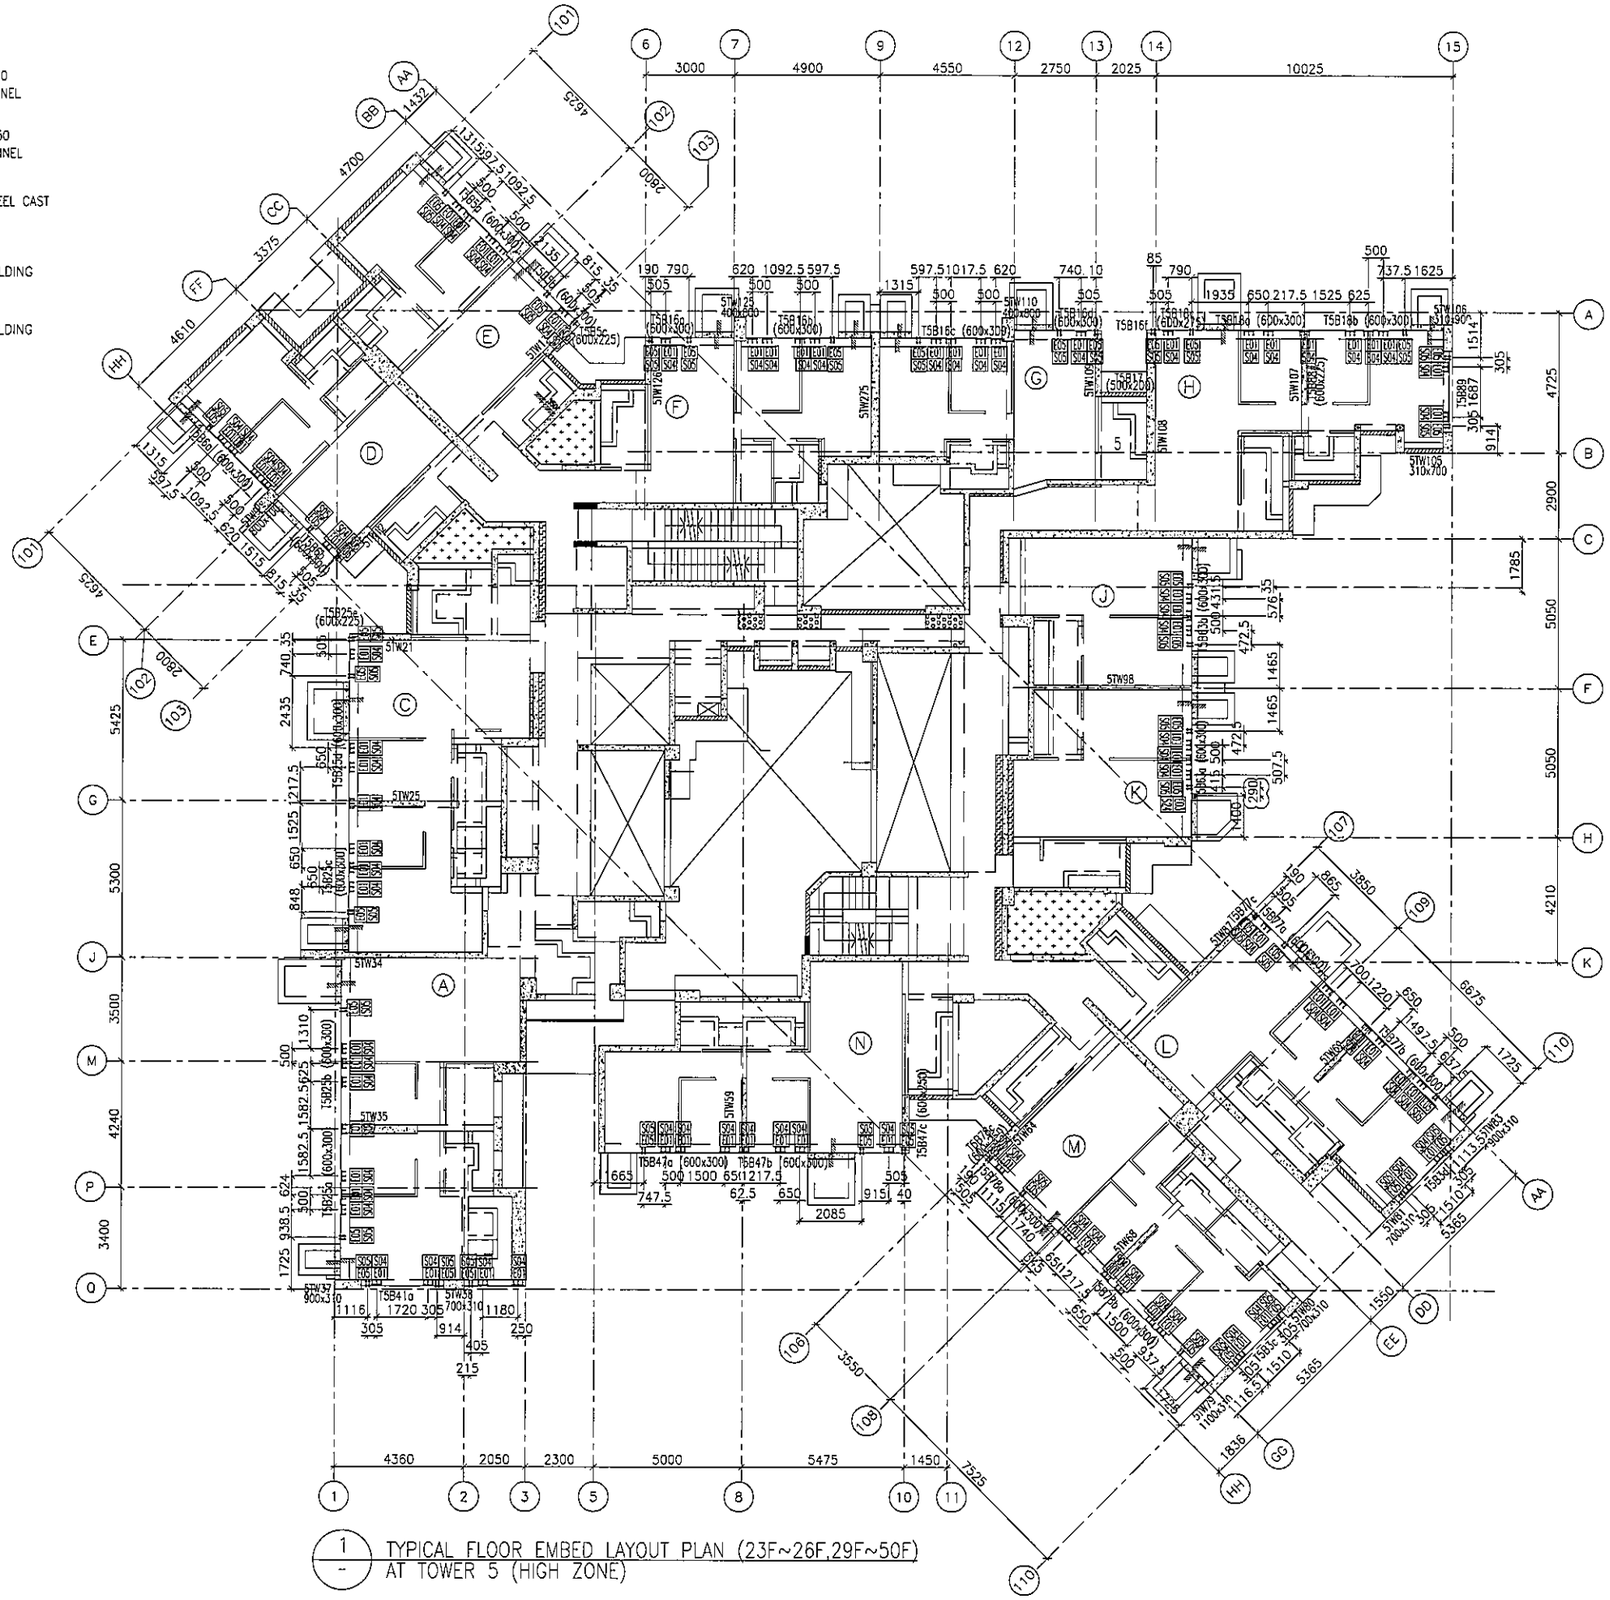

1/- TYPICAL FLOOR EMBED LAYOUT PLAN (23F~26F,29F~50F) AT TOWER 5 (HIGH ZONE)

FLOOR LEVEL (S.F.L.)(TS)

FLOOR NUMBERING	LEVEL (mPD)
23F	86.500
25F	89.650
26F	92.800
29F	102.250
30F	105.400
31F	108.550
32F	111.700
33F	114.850
35F	118.000
36F	121.150
37F	124.300
38F	127.450
39F	130.600
40F	133.750
41F	136.900
42F	140.050
43F	143.100
45F	146.350
46F	149.500
47F	152.650
48F	155.800
49F	158.950
50F	162.100

B.D. REF :

CLIENT : 信和置業有限公司 Sino Land Company Limited

ARCHITECT : WONG TUNG & PARTNERS LIMITED ARCHITECTS & PLANNERS

MAIN CONTRACTOR : CR Construction Company Limited

STRUCTURAL ENGINEER : AECOM

FACADE CONSULTANT: AECOM

NOTE :
1. ALL DIMENSIONS ARE IN mm.
2. ALL ELEVATIONS ARE VIEWED FROM OUTSIDE.
3. ALL DIMENSIONS TO BE VERIFIED ON SITE BEFORE FABRICATION.

LEGEND :
- X1 / X001 — DETAIL MARK NO. / REFER SHEET NO.
1. F.F.L. --FINISHED FLOOR LEVEL
2. S.F.L. --STRUCTURAL FLOOR LEVEL
3. (/R) --REVERSED DETAIL

NO.	DATE	REVISED	BY
F	19/01/2019	GENERAL REVISED	
E	22/12/2018	GENERAL REVISED	
D	08/11/2018	GENERAL REVISED	
C	11/10/2018	GENERAL REVISED	
B	8/10/2018	GENERAL REVISED	
A	14/9/2018	GENERAL REVISED	

JOB NO. : J-837

PROJECT : URA KWUN TONG TOWN CENTRE REDEVELOPMENT (AREA 2 & 3) AT NKIL 6514, KWUN TONG, KWLOON

TITLE : TYPICAL FLOOR EMBED LAYOUT PLAN (22F~26F,28F~50F) OF CURTAIN WALL AT TOWER 5

DATE : 10-SEP-18 | SCALE : 1:100 (A1)

DRAWN BY : ASING | CHECKED BY : -

美特鋁質有限公司 MIDI ALUMINIUM FABRICATOR LTD.
Units 6-8, Sunray Industrial Centre, 1/F
610 Cha Kwo Ling Road, Kowloon
Tel:23489211-4 Fax:(852)27727655

DWG NO. : J837-CW-1504 | REV. : F

LEGEND :

- E01 = HILIT , HAC-70 CAST IN CHANNEL
- E02 = HILIT , HAC-50 CAST IN CHANNEL
- E03 = GAL. MILD STEEL CAST IN EMBED
- E04 = CAST-IN HOLDING DOWN BOLT
- E05 = CAST-IN HOLDING DOWN BOLT
- E06 = CAST-IN HOLDING DOWN BOLT
- E07 = CAST-IN HOLDING DOWN BOLT

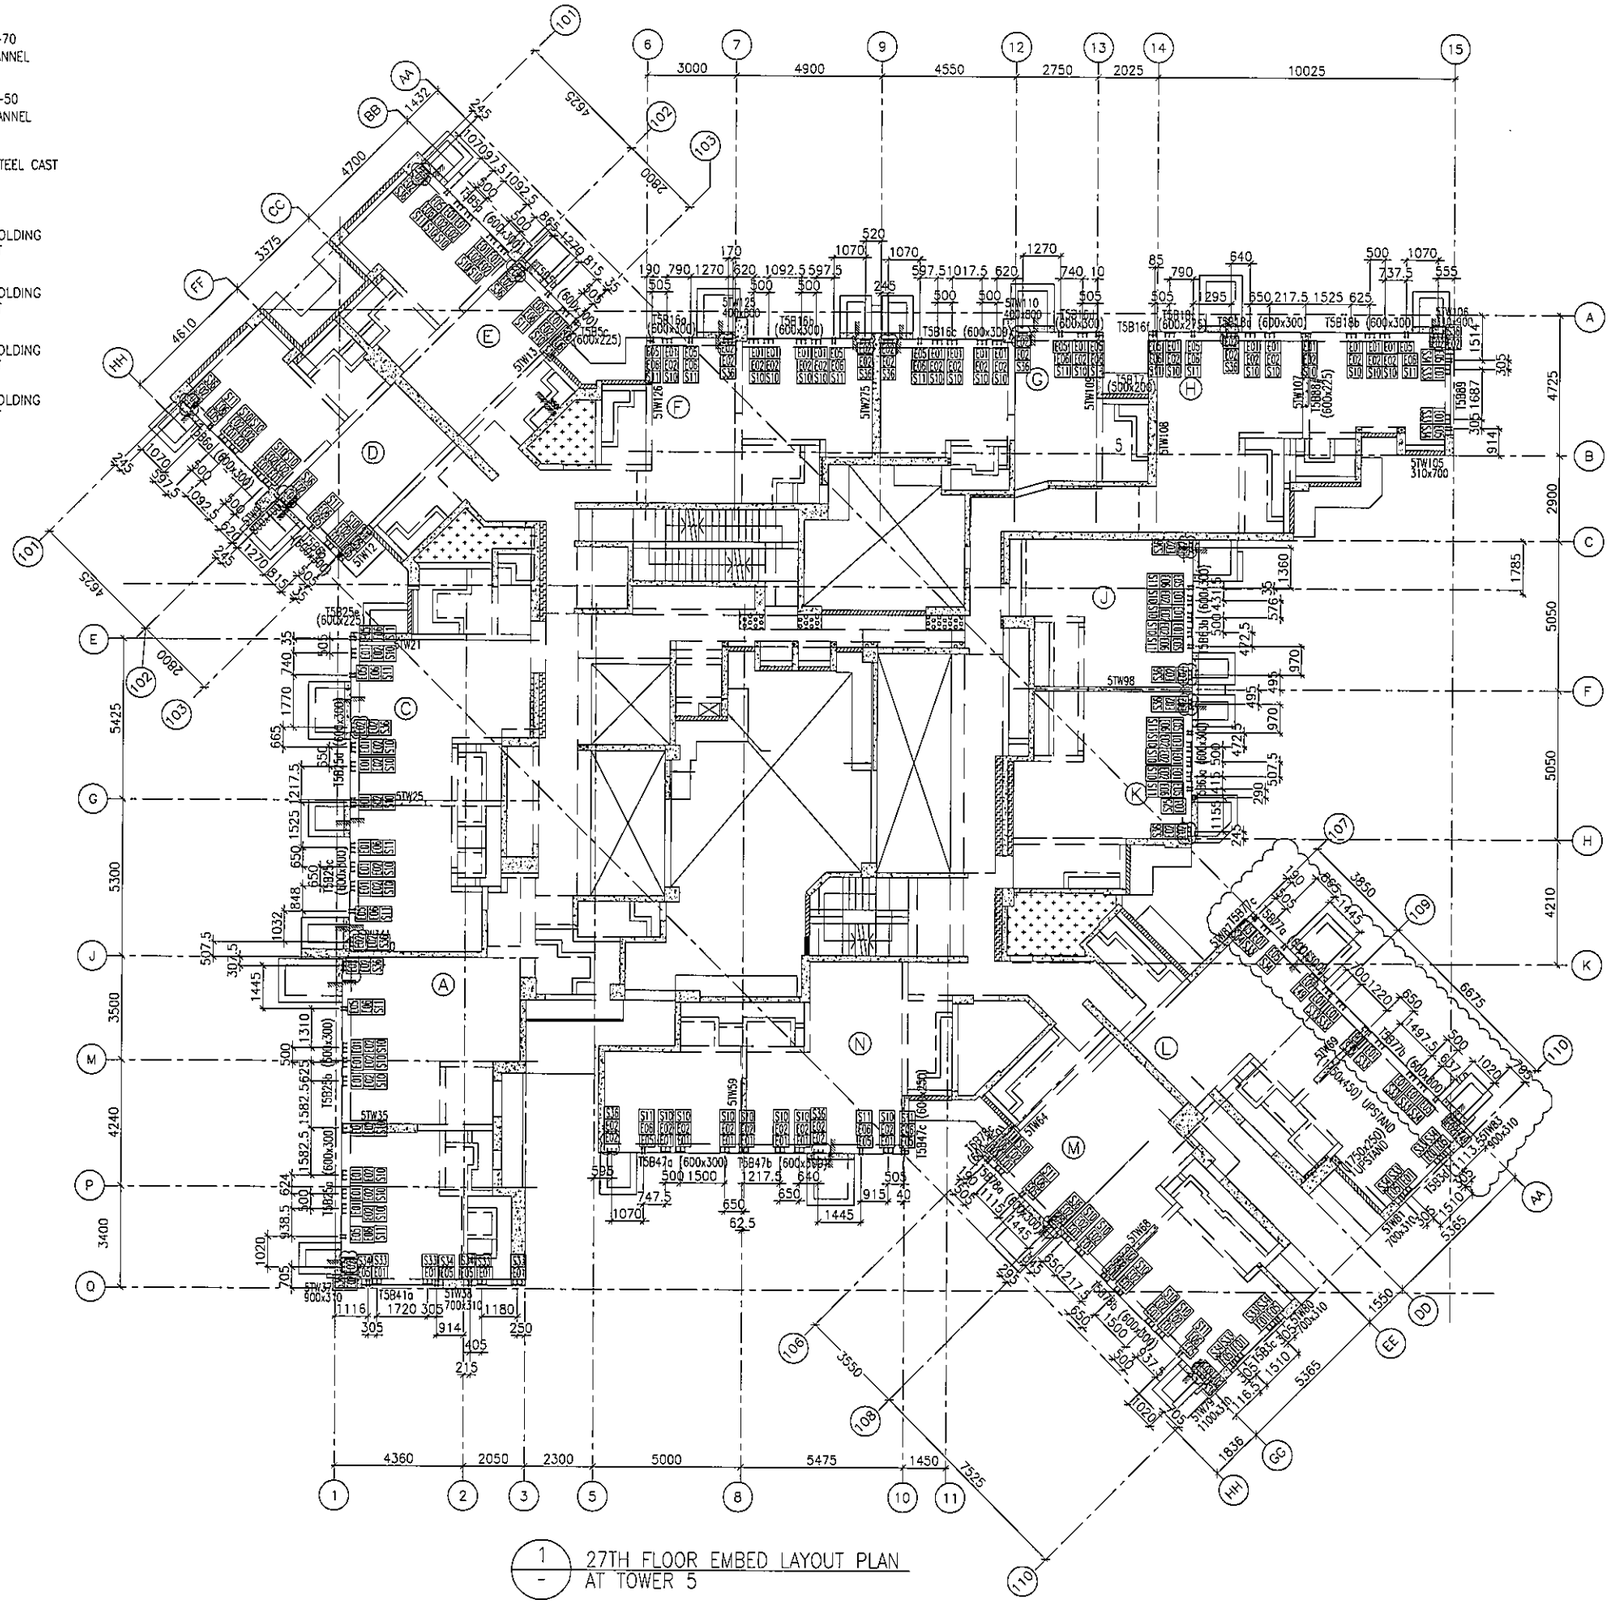

1 / - 27TH FLOOR EMBED LAYOUT PLAN AT TOWER 5

FLOOR LEVEL (S.F.L.)(T5)

FLOOR NUMBERING	LEVEL (mPD)
27F	+95.95

B.D. REF :

CLIENT : 信和置業有限公司 Sino Land Company Limited

ARCHITECT : WONG TUNG & PARTNERS LIMITED ARCHITECTS & PLANNERS

MAIN CONTRACTOR : CR Construction Company Limited

STRUCTURAL ENGINEER : AECOM

FACADE CONSULTANT: AECOM

NOTE :
1. ALL DIMENSIONS ARE IN mm.
2. ALL ELEVATIONS ARE VIEWED FROM OUTSIDE.
3. ALL DIMENSIONS TO BE VERIFIED ON SITE BEFORE FABRICATION.

LEGEND :
- X1 / X001 — DETAIL MARK NO. / REFER SHEET NO.
1. F.F.L. --FINISHED FLOOR LEVEL
2. S.F.L. --STRUCTURAL FLOOR LEVEL
3. /R --REVERSED DETAIL

NO.	DATE	REMARKS	BY
H	18/08/2019	GENERAL REVISED	
G	21/02/2019	GENERAL REVISED	
F	19/01/2019	GENERAL REVISED	
E	22/12/2018	GENERAL REVISED	
D	08/11/2018	GENERAL REVISED	
C	11/10/2018	GENERAL REVISED	
B	8/10/2018	GENERAL REVISED	
A	14/9/2018	GENERAL REVISED	

JOB NO. : J-837

PROJECT : URA KWUN TONG TOWN CENTRE REDEVELOPMENT (AREA 2 & 3) AT NKIL 6514, KWUN TONG, KWLOON

TITLE : 27TH FLOOR EMBED LAYOUT PLAN OF CURTAIN WALL AT TOWER 5

DATE : 10-SEP-18 | SCALE : 1:100 (A1)

DRAWN BY : ASING | CHECKED BY : -

美特鋁質有限公司 MIDI ALUMINIUM FABRICATOR LTD.
Units 6-8, Sunray Industrial Centre, 1/F
610 Cha Kwo Ling Road, Kowloon
Tel:23489211-4 Fax:(852)27727686

DWG NO. : J837-CW-1505 | REV. : H

LEGEND :

- E01 = HILIT , HAC-70 CAST IN CHANNEL
- E02 = HILIT , HAC-50 CAST IN CHANNEL
- E03 = GAL. MILD STEEL CAST IN EMBED
- E04 = CAST-IN HOLDING DOWN BOLT
- E05 = CAST-IN HOLDING DOWN BOLT

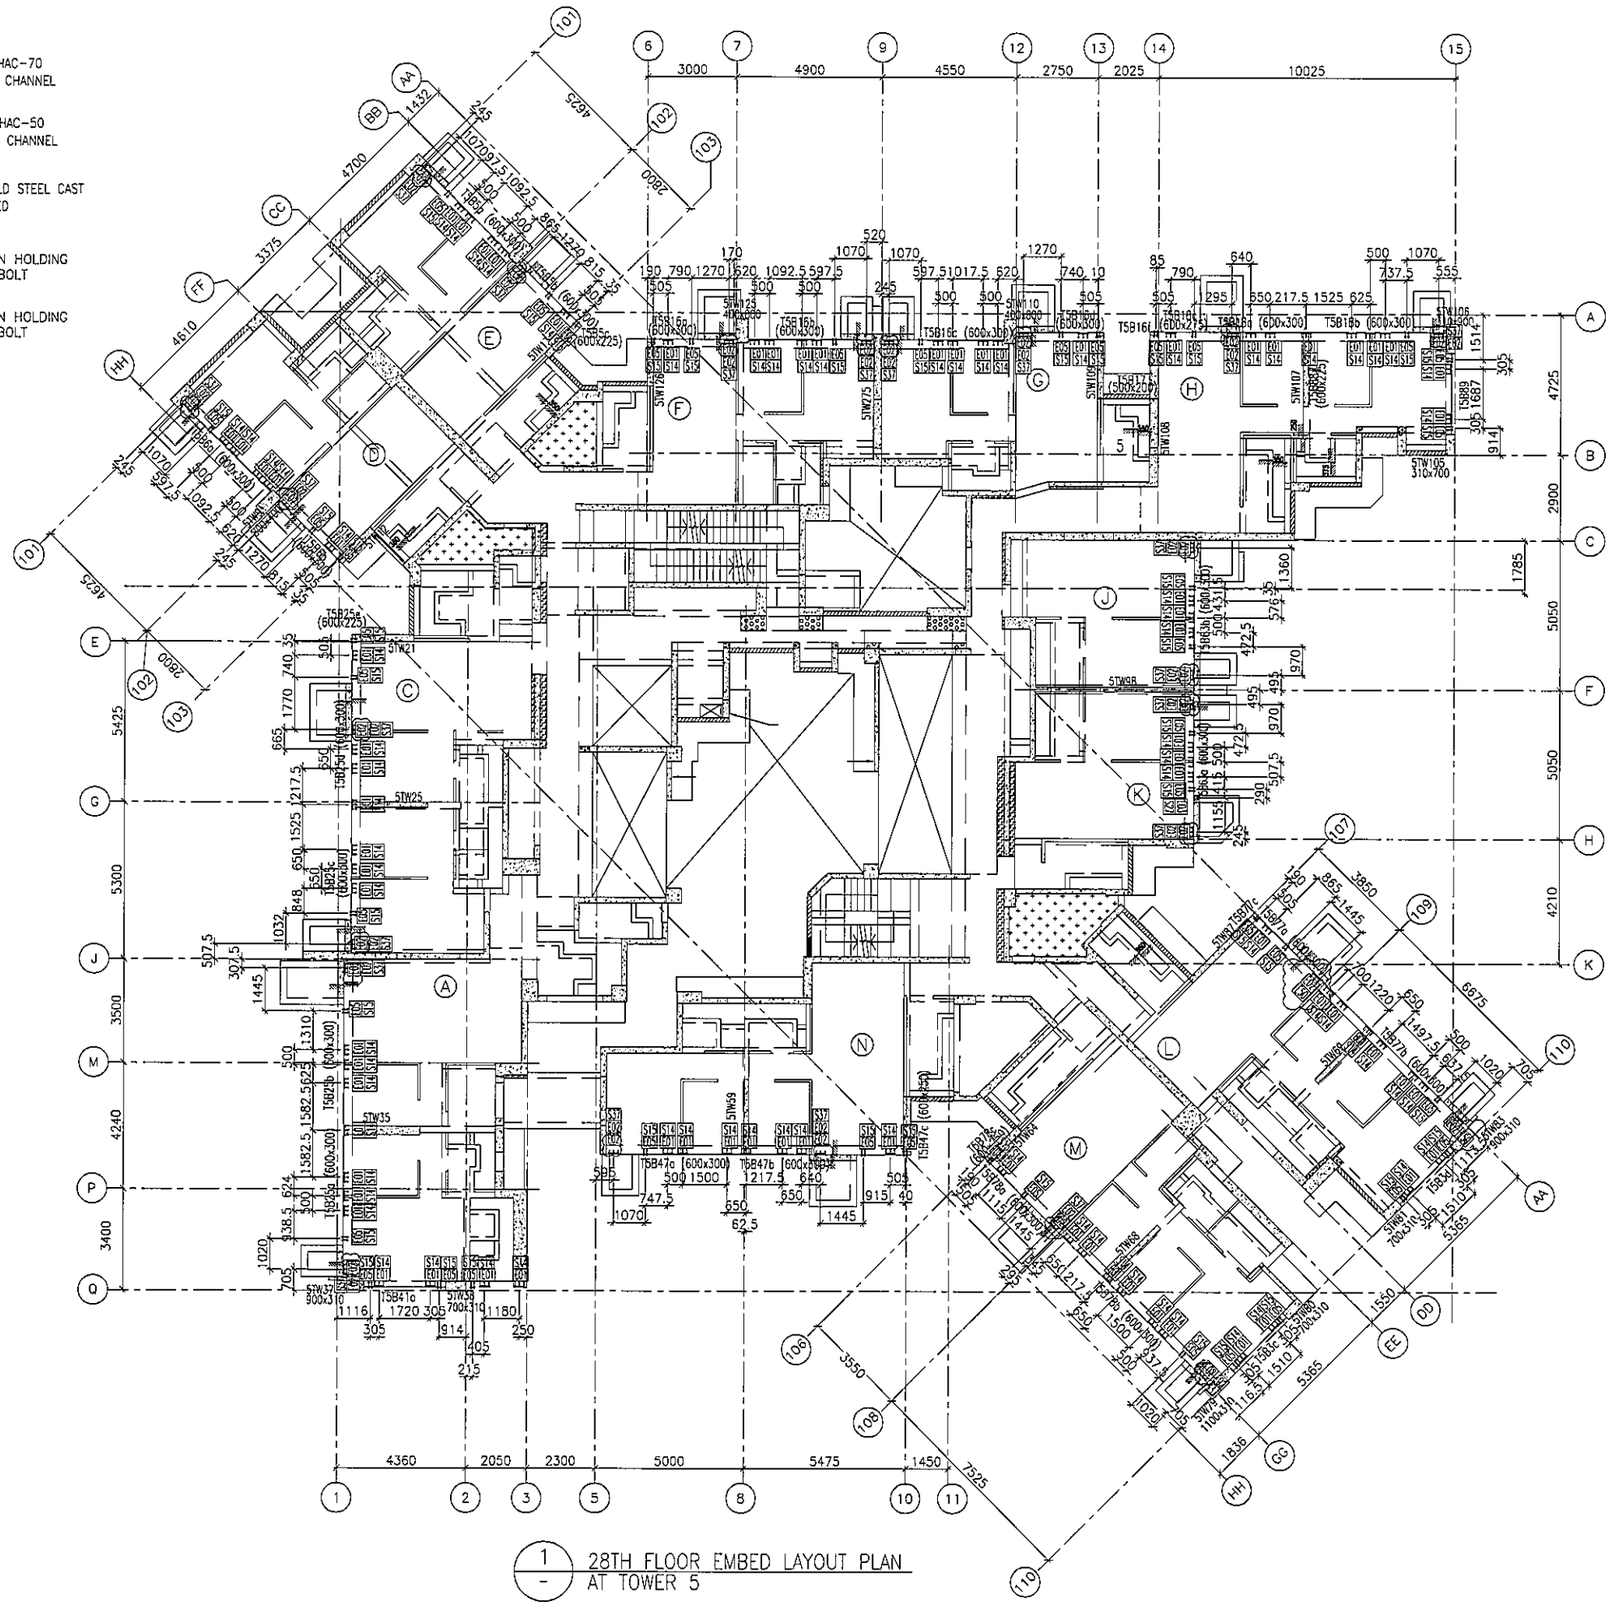

1 / - 28TH FLOOR EMBED LAYOUT PLAN AT TOWER 5

FLOOR LEVEL (S.F.L.)(TS)

FLOOR NUMBERING	LEVEL (mPD)
28F	+99.100

B.D. REF :

CLIENT : 信和置業有限公司 Sino Land Company Limited

ARCHITECT : WONG TUNG & PARTNERS LIMITED ARCHITECTS & PLANNERS

MAIN CONTRACTOR : CR Construction Company Limited

STRUCTURAL ENGINEER : AECOM

FACADE CONSULTANT: AECOM

NOTE :
1. ALL DIMENSIONS ARE IN mm.
2. ALL ELEVATIONS ARE VIEWED FROM OUTSIDE.
3. ALL DIMENSIONS TO BE VERIFIED ON SITE BEFORE FABRICATION.

LEGEND :
- X1 / X001 — DETAIL MARK NO. / REFER SHEET NO.
1. F.F.L. --FINISHED FLOOR LEVEL
2. S.F.L. --STRUCTURAL FLOOR LEVEL
3. (VR) --REVERSED DETAIL

NO.	DATE	REVISED	BY
H	18/08/2019	GENERAL REVISED	
G	21/02/2019	GENERAL REVISED	
F	19/01/2019	GENERAL REVISED	
E	22/12/2018	GENERAL REVISED	
D	08/11/2018	GENERAL REVISED	
C	11/10/2018	GENERAL REVISED	
B	8/10/2018	GENERAL REVISED	
A	14/9/2018	GENERAL REVISED	

JOB NO. : J-837

PROJECT : URA KWUN TONG TOWN CENTRE REDEVELOPMENT (AREA 2 & 3) AT NKIL 6514, KWUN TONG, KWLOON

TITLE : 28TH FLOOR EMBED LAYOUT PLAN OF CURTAIN WALL AT TOWER 5

DATE : 10-SEP-18 | SCALE : 1:100 (A1)

DRAWN BY : ASING | CHECKED BY : -

美特鋁質有限公司 MIDI ALUMINIUM FABRICATOR LTD.
Units 6-8, Sunray Industrial Centre, 1/F
610 Cha Kwo Ling Road, Kowloon
Tel:23489211-4 Fax:(852)27727666

DWG NO. : J837-CW-1506 | REV. : H

LEGEND :

EO1 = HILIT , HAC-70 CAST IN CHANNEL

EO2 = HILIT , HAC-50 CAST IN CHANNEL

EO3 = GAL. MILD STEEL CAST IN EMBED

EO4 = CAST-IN HOLDING DOWN BOLT

EO5 = CAST-IN HOLDING DOWN BOLT

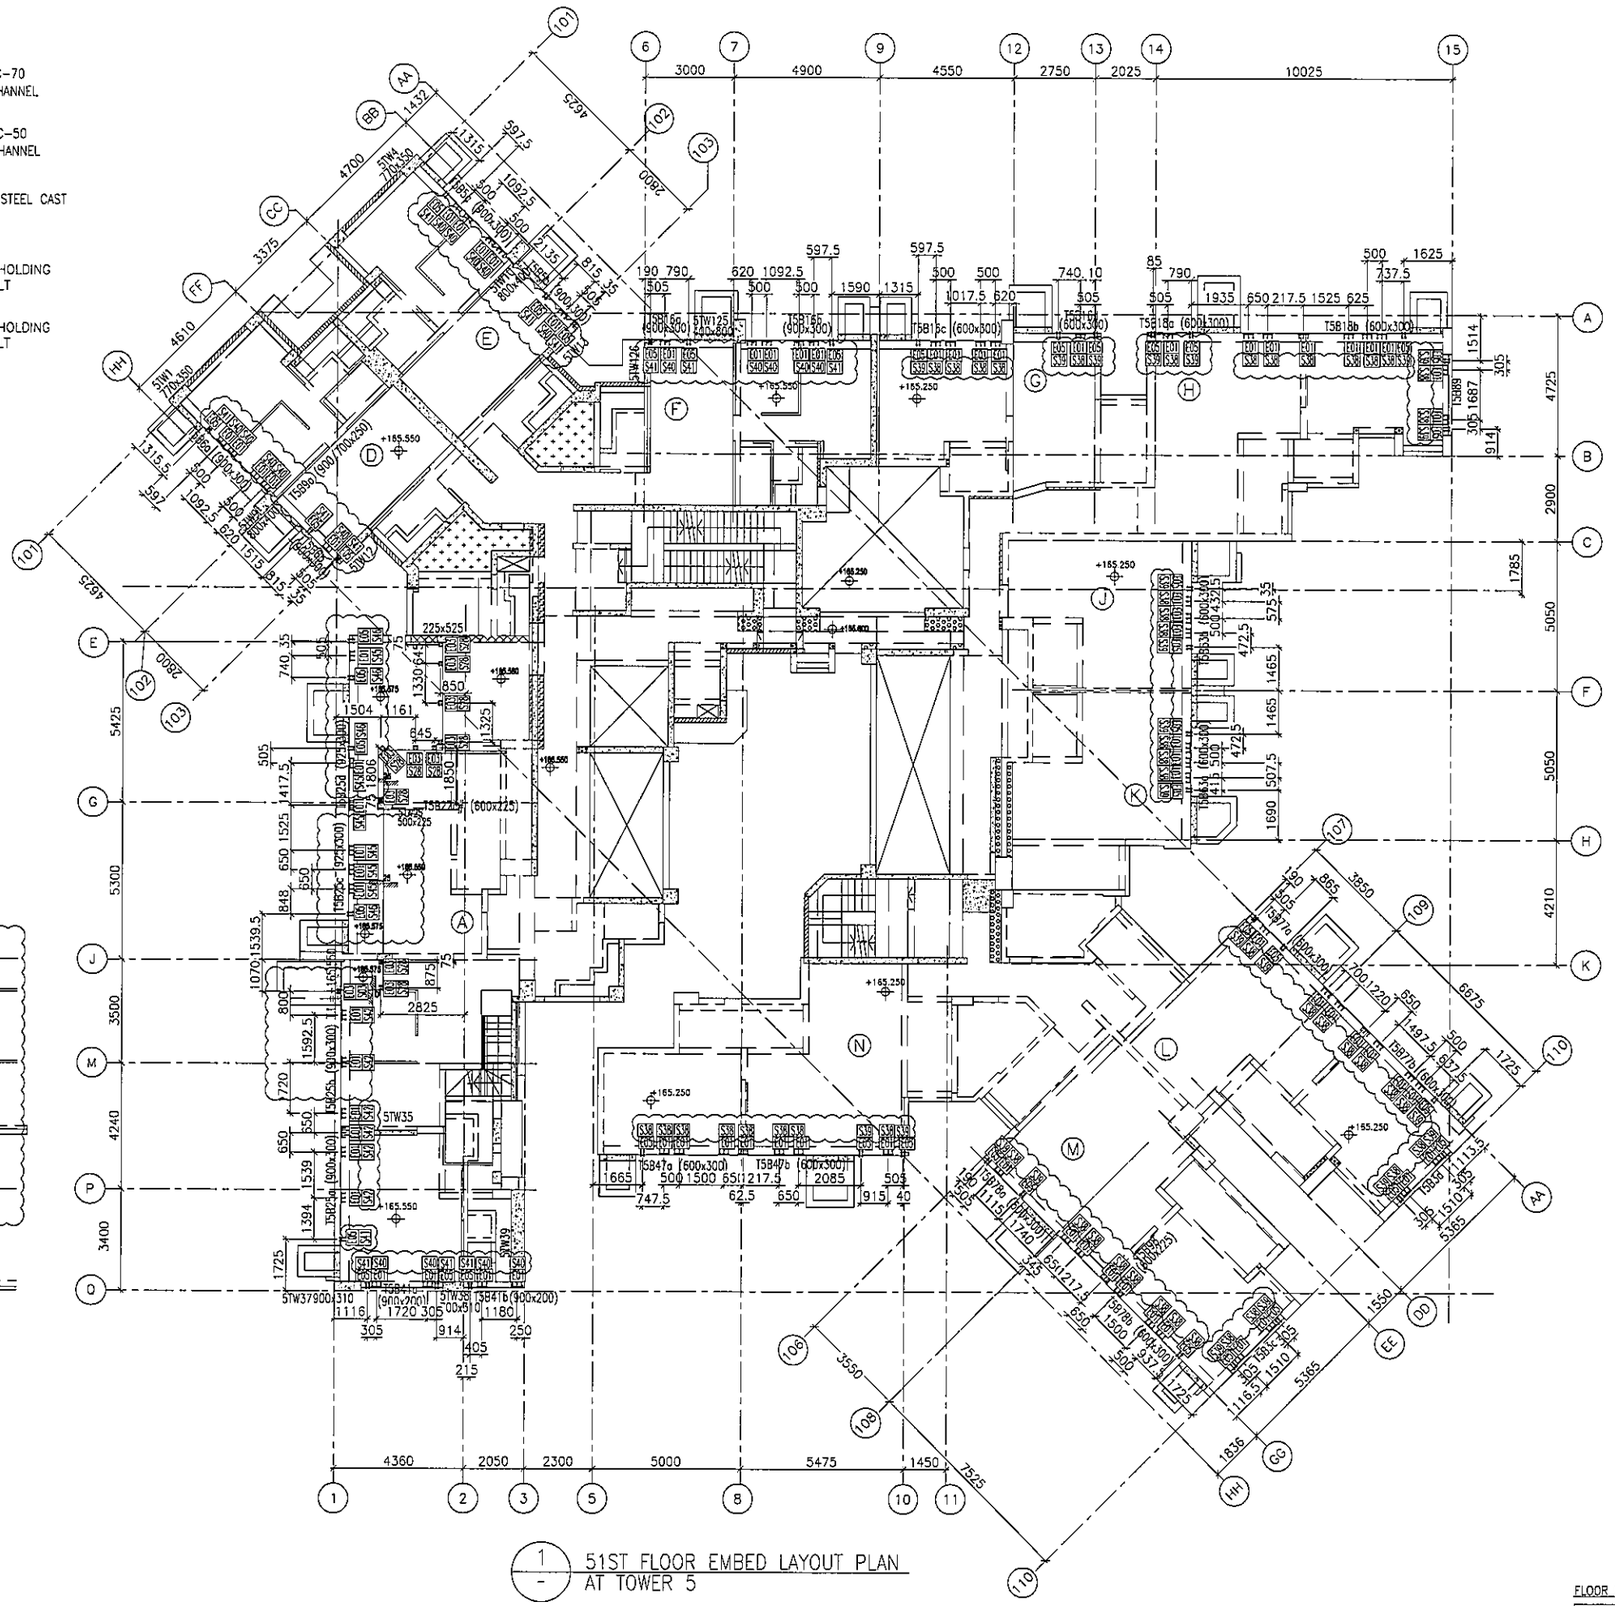

1 / - 51ST FLOOR EMBED LAYOUT PLAN AT TOWER 5

FLOOR LEVEL (S.F.L)(T3)

FLOOR NUMBERING	LEVEL (mPD)
51F	+165.250/+165.550

B.D. REF :

CLIENT : 信和置業有限公司 Sino Land Company Limited

ARCHITECT : WONG TUNG & PARTNERS LIMITED ARCHITECTS & PLANNERS

MAIN CONTRACTOR : CR Construction Company Limited

STRUCTURAL ENGINEER : AECOM

FACADE CONSULTANT: AECOM

NOTE :
1. ALL DIMENSIONS ARE IN mm.
2. ALL ELEVATIONS ARE VIEWED FROM OUTSIDE.
3. ALL DIMENSIONS TO BE VERIFIED ON SITE BEFORE FABRICATION.

LEGEND :
X1 — DETAIL MARK NO.
X001 — REFER SHEET NO.

1. F.F.L. --FINISHED FLOOR LEVEL
2. S.F.L. --STRUCTURAL FLOOR LEVEL
3. (R) --REVERSED DETAIL

NO.	DATE	REVISED	BY
K	20/06/2019	GENERAL REVISED	
J	03/06/2019	GENERAL REVISED	
I	24/05/2019	GENERAL REVISED	
H	07/04/2019	GENERAL REVISED	
G	19/01/2019	GENERAL REVISED	
F	13/01/2019	GENERAL REVISED	
E	22/12/2018	GENERAL REVISED	
D	08/11/2018	GENERAL REVISED	
C	11/10/2018	GENERAL REVISED	
B	8/10/2018	GENERAL REVISED	
A	14/9/2018	GENERAL REVISED	

JOB NO. : J-837

PROJECT : URA KWUN TONG TOWN CENTRE REDEVELOPMENT (AREA 2 & 3) AT NKIL 6514, KWUN TONG, KWLOON

TITLE : 51ST FLOOR EMBED LAYOUT PLAN OF CURTAIN WALL AT TOWER 5

DATE : 10-SEP-18 | SCALE : 1:100 (A1)

DRAWN BY : ASING | CHECKED BY : -

美特鋁質有限公司 MIDI ALUMINUM FABRICATOR LTD.
Units 6-8, Sunray Industrial Centre, 1/F
610 Cha Kwo Ling Road, Kowloon
Tel:23489211-4 Fax:(852)27727666

DWG NO. : J837-CW-1507 | REV. : K

LEGEND :

- E01 = HILIT , HAC-70 CAST IN CHANNEL
- E02 = HILIT , HAC-50 CAST IN CHANNEL
- E04 = CAST-IN HOLDING DOWN BOLT
- E05 = CAST-IN HOLDING DOWN BOLT
- E06 = CAST-IN HOLDING DOWN BOLT
- E07 = CAST-IN HOLDING DOWN BOLT

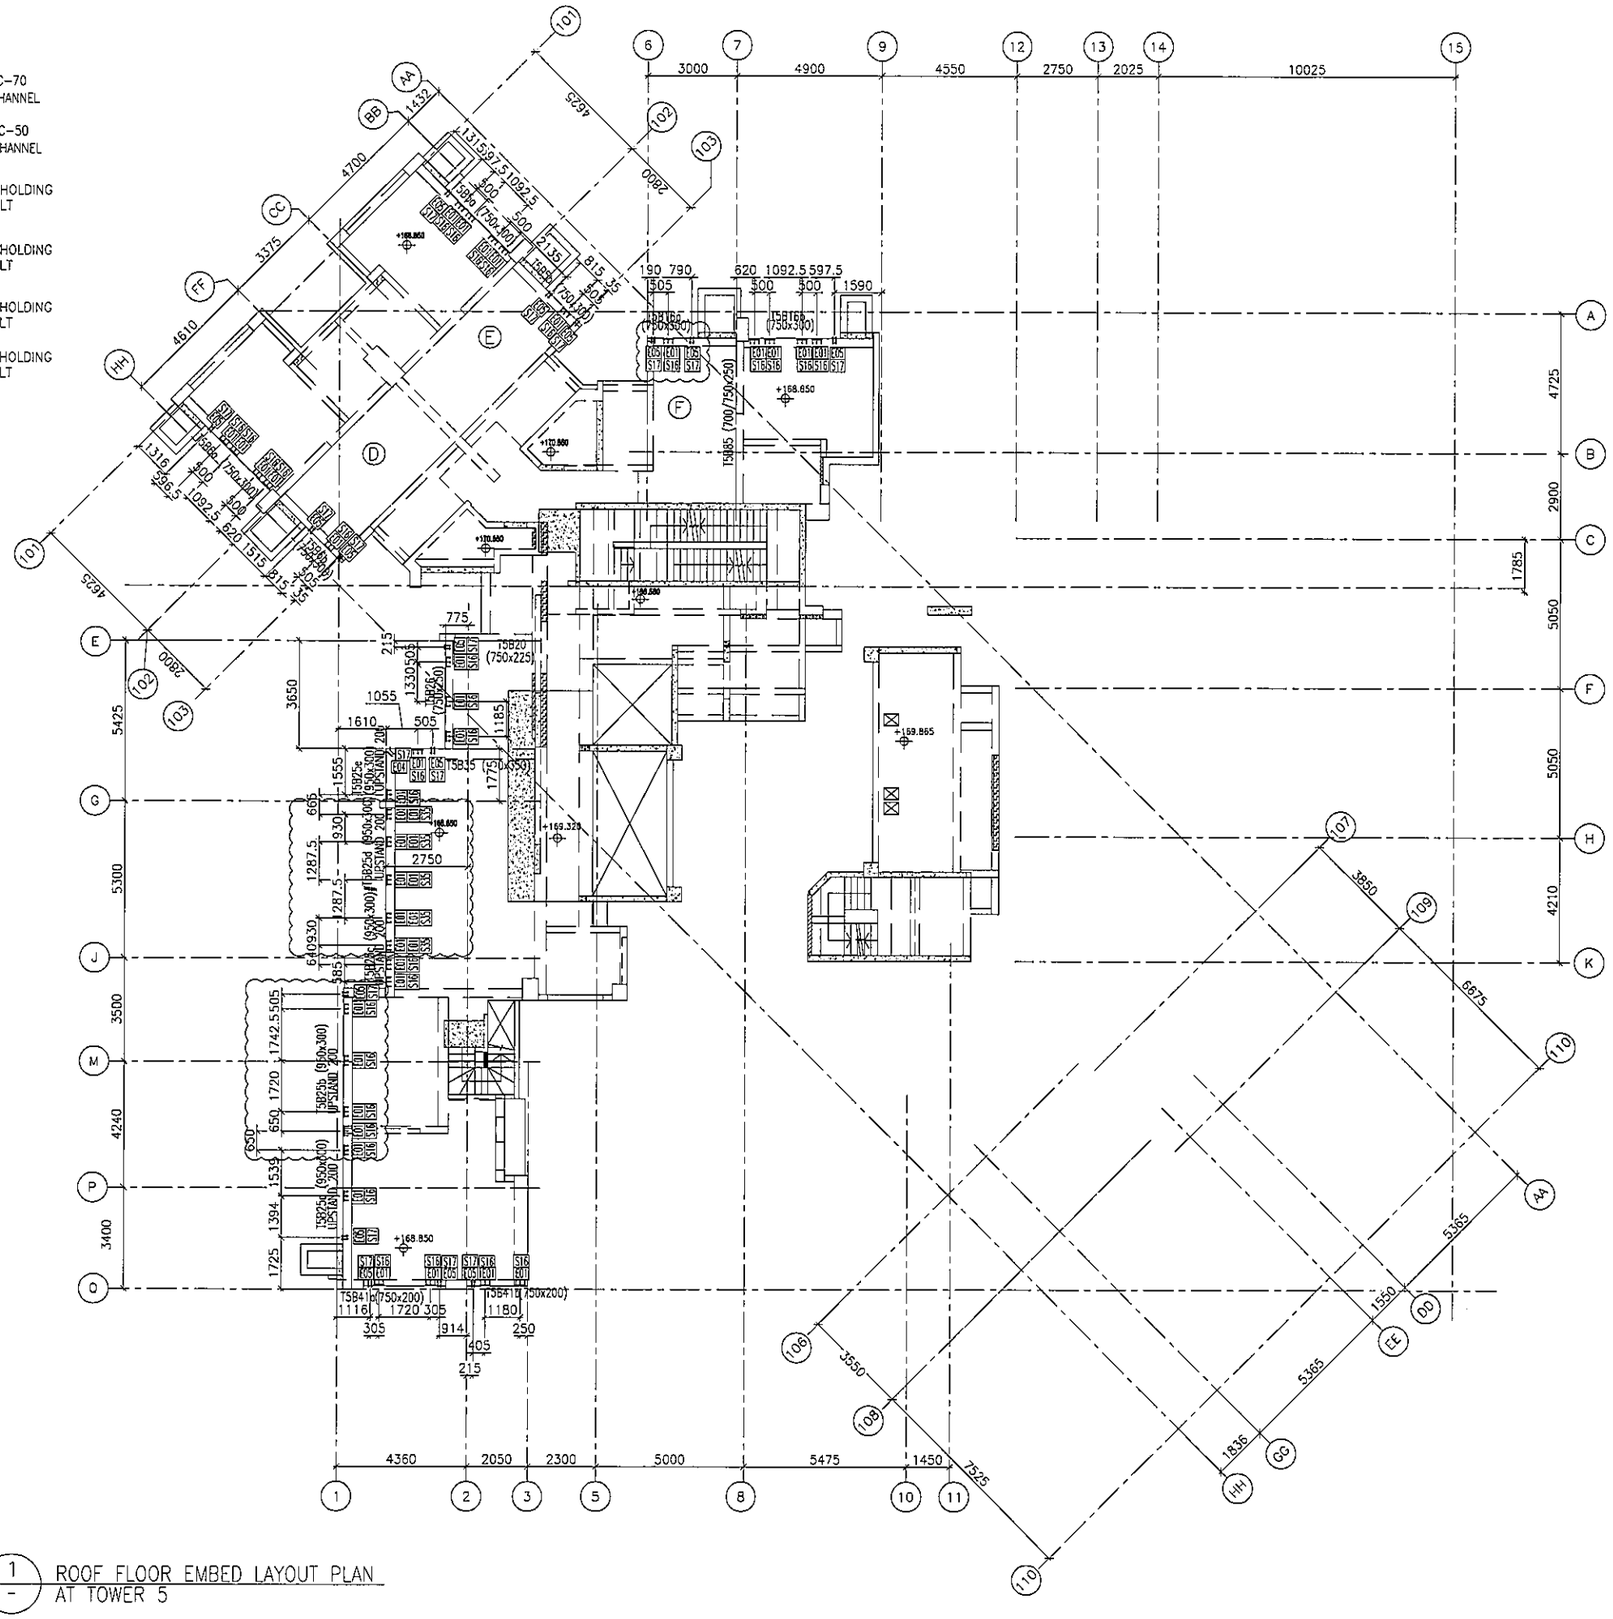

1 / - ROOF FLOOR EMBED LAYOUT PLAN AT TOWER 5

FLOOR LEVEL (S.F.L.)(T3)

FLOOR NUMBERING	LEVEL (mPD)
RF	+168.850

B.D. REF :

CLIENT : 信和置業有限公司 Sino Land Company Limited

ARCHITECT : WONG TUNG & PARTNERS LIMITED ARCHITECTS & PLANNERS

MAIN CONTRACTOR : CR Construction Company Limited

STRUCTURAL ENGINEER : AECOM

FACADE CONSULTANT: AECOM

NOTE :
1. ALL DIMENSIONS ARE IN mm.
2. ALL ELEVATIONS ARE VIEWED FROM OUTSIDE.
3. ALL DIMENSIONS TO BE VERIFIED ON SITE BEFORE FABRICATION.

LEGEND :
- X1 / XOD1 — DETAIL MARK NO. / REFER SHEET NO.
1. F.F.L. --FINISHED FLOOR LEVEL
2. S.F.L. --STRUCTURAL FLOOR LEVEL
3. /R --REVERSED DETAIL

NO.	DATE	REVISED	BY
E	20/06/2019	GENERAL REVISED	
D	03/06/2019	GENERAL REVISED	
C	23/05/2019	GENERAL REVISED	
B	07/04/2019	GENERAL REVISED	
A	22/12/2018	GENERAL REVISED	

JOB NO. : J-837

PROJECT : URA KWUN TONG TOWN CENTRE REDEVELOPMENT (AREA 2 & 3) AT NKIL 6514, KWUN TONG, KWLOON

TITLE : ROOF FLOOR EMBED LAYOUT PLAN OF CURTAIN WALL AT TOWER 5

DATE : 10-SEP-18 | SCALE : 1:100 (A1)

DRAWN BY : ASING | CHECKED BY : -

美特鋁質有限公司 MIDI ALUMINIUM FABRICATOR LTD.
Units 6-8, Sunray Industrial Centre, 1/F
610 Cha Kwo Ling Road, Kowloon
Tel:23489211-4 Fax:(852)27727666

DWG NO. : J837-CW-1508 | REV. : E

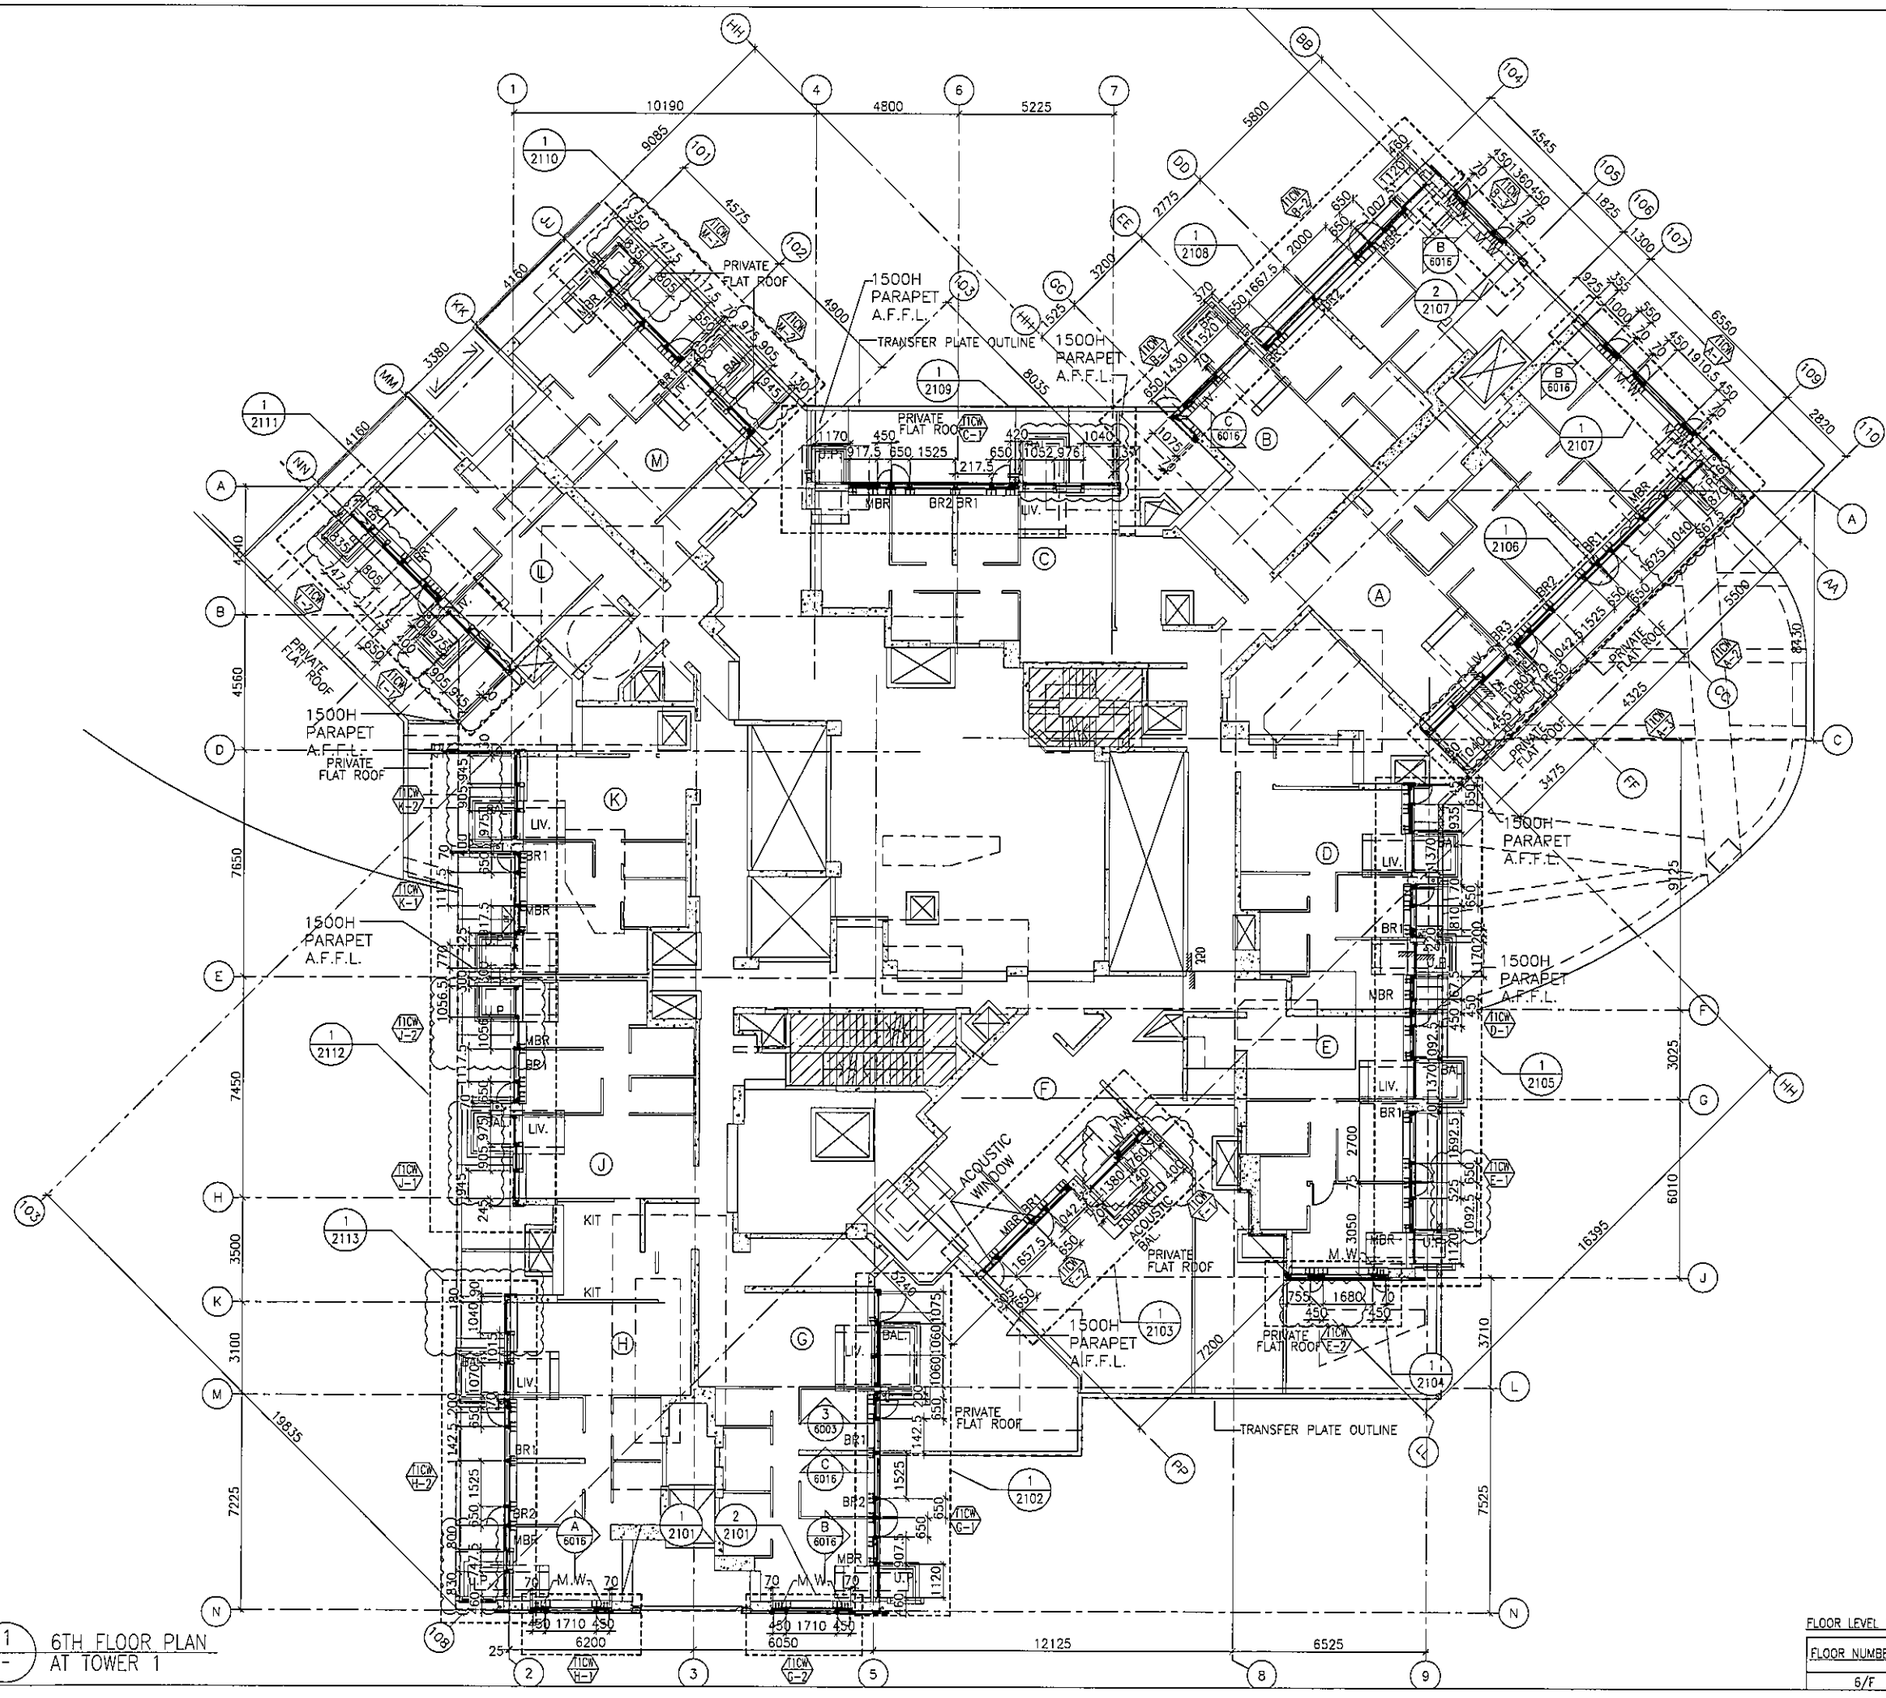

B.D. REF :

CLIENT :
信和置業有限公司
Sino Land Company Limited

ARCHITECT :
WONG TUNG & PARTNERS LIMITED
ARCHITECTS & PLANNERS

MAIN CONTRACTOR :
CR Construction Company Limited

STRUCTURAL ENGINEER :
AECOM

FACADE CONSULTANT:
AECOM

NOTE :
1. ALL DIMENSIONS ARE IN mm.
2. ALL ELEVATIONS ARE VIEWED FROM OUTSIDE.
3. ALL DIMENSIONS TO BE VERIFIED ON SITE BEFORE FABRICATION.

LEGEND :
- (X1) — DETAIL MARK NO.
- (X001) — REFER SHEET NO.

1. F.F.L. --FINISHED FLOOR LEVEL
2. S.F.L. --STRUCTURAL FLOOR LEVEL
3. (/R) --REVERSED DETAIL

NO.	DATE	REVISED	BY
J	18/08/2019	GENERAL REVISED	
I	26/05/2019	GENERAL REVISED	
H	07/04/2019	GENERAL REVISED	
G	19/01/2019	GENERAL REVISED	
F	22/12/2018	GENERAL REVISED	
E	01/12/2018	GENERAL REVISED	
D	24/11/2018	GENERAL REVISED	
C	11/10/2018	GENERAL REVISED	
B	28/9/2018	GENERAL REVISED	
A	10/9/2018	GENERAL REVISED	

JOB NO. : J-837

PROJECT :
URA KWUN TONG TOWN CENTRE REDEVELOPMENT (AREA 2 & 3) AT NKIL 6514, KWUN TONG, KWLOON

TITLE :
6TH FLOOR PLAN
OF CURTAIN WALL
AT TOWER 1

DATE : 04-JUL-18 | SCALE : 1:100 (A1)

DRAWN BY : ASING | CHECKED BY : -

FLOOR LEVEL (S.F.L.)(T1)

FLOOR NUMBERING	LEVEL (mPD)
6/F	+38.900

美特鋁製有限公司
MIDI ALUMINIUM FABRICATOR LTD.
Units 6-8, Sunray Industrial Centre, 1/F
610 Cha Kwo Ling Road, Kowloon
Tel:23489211-4 Fax:(852)27727666

DWG NO. : J837-CW-3101 | REV. : J

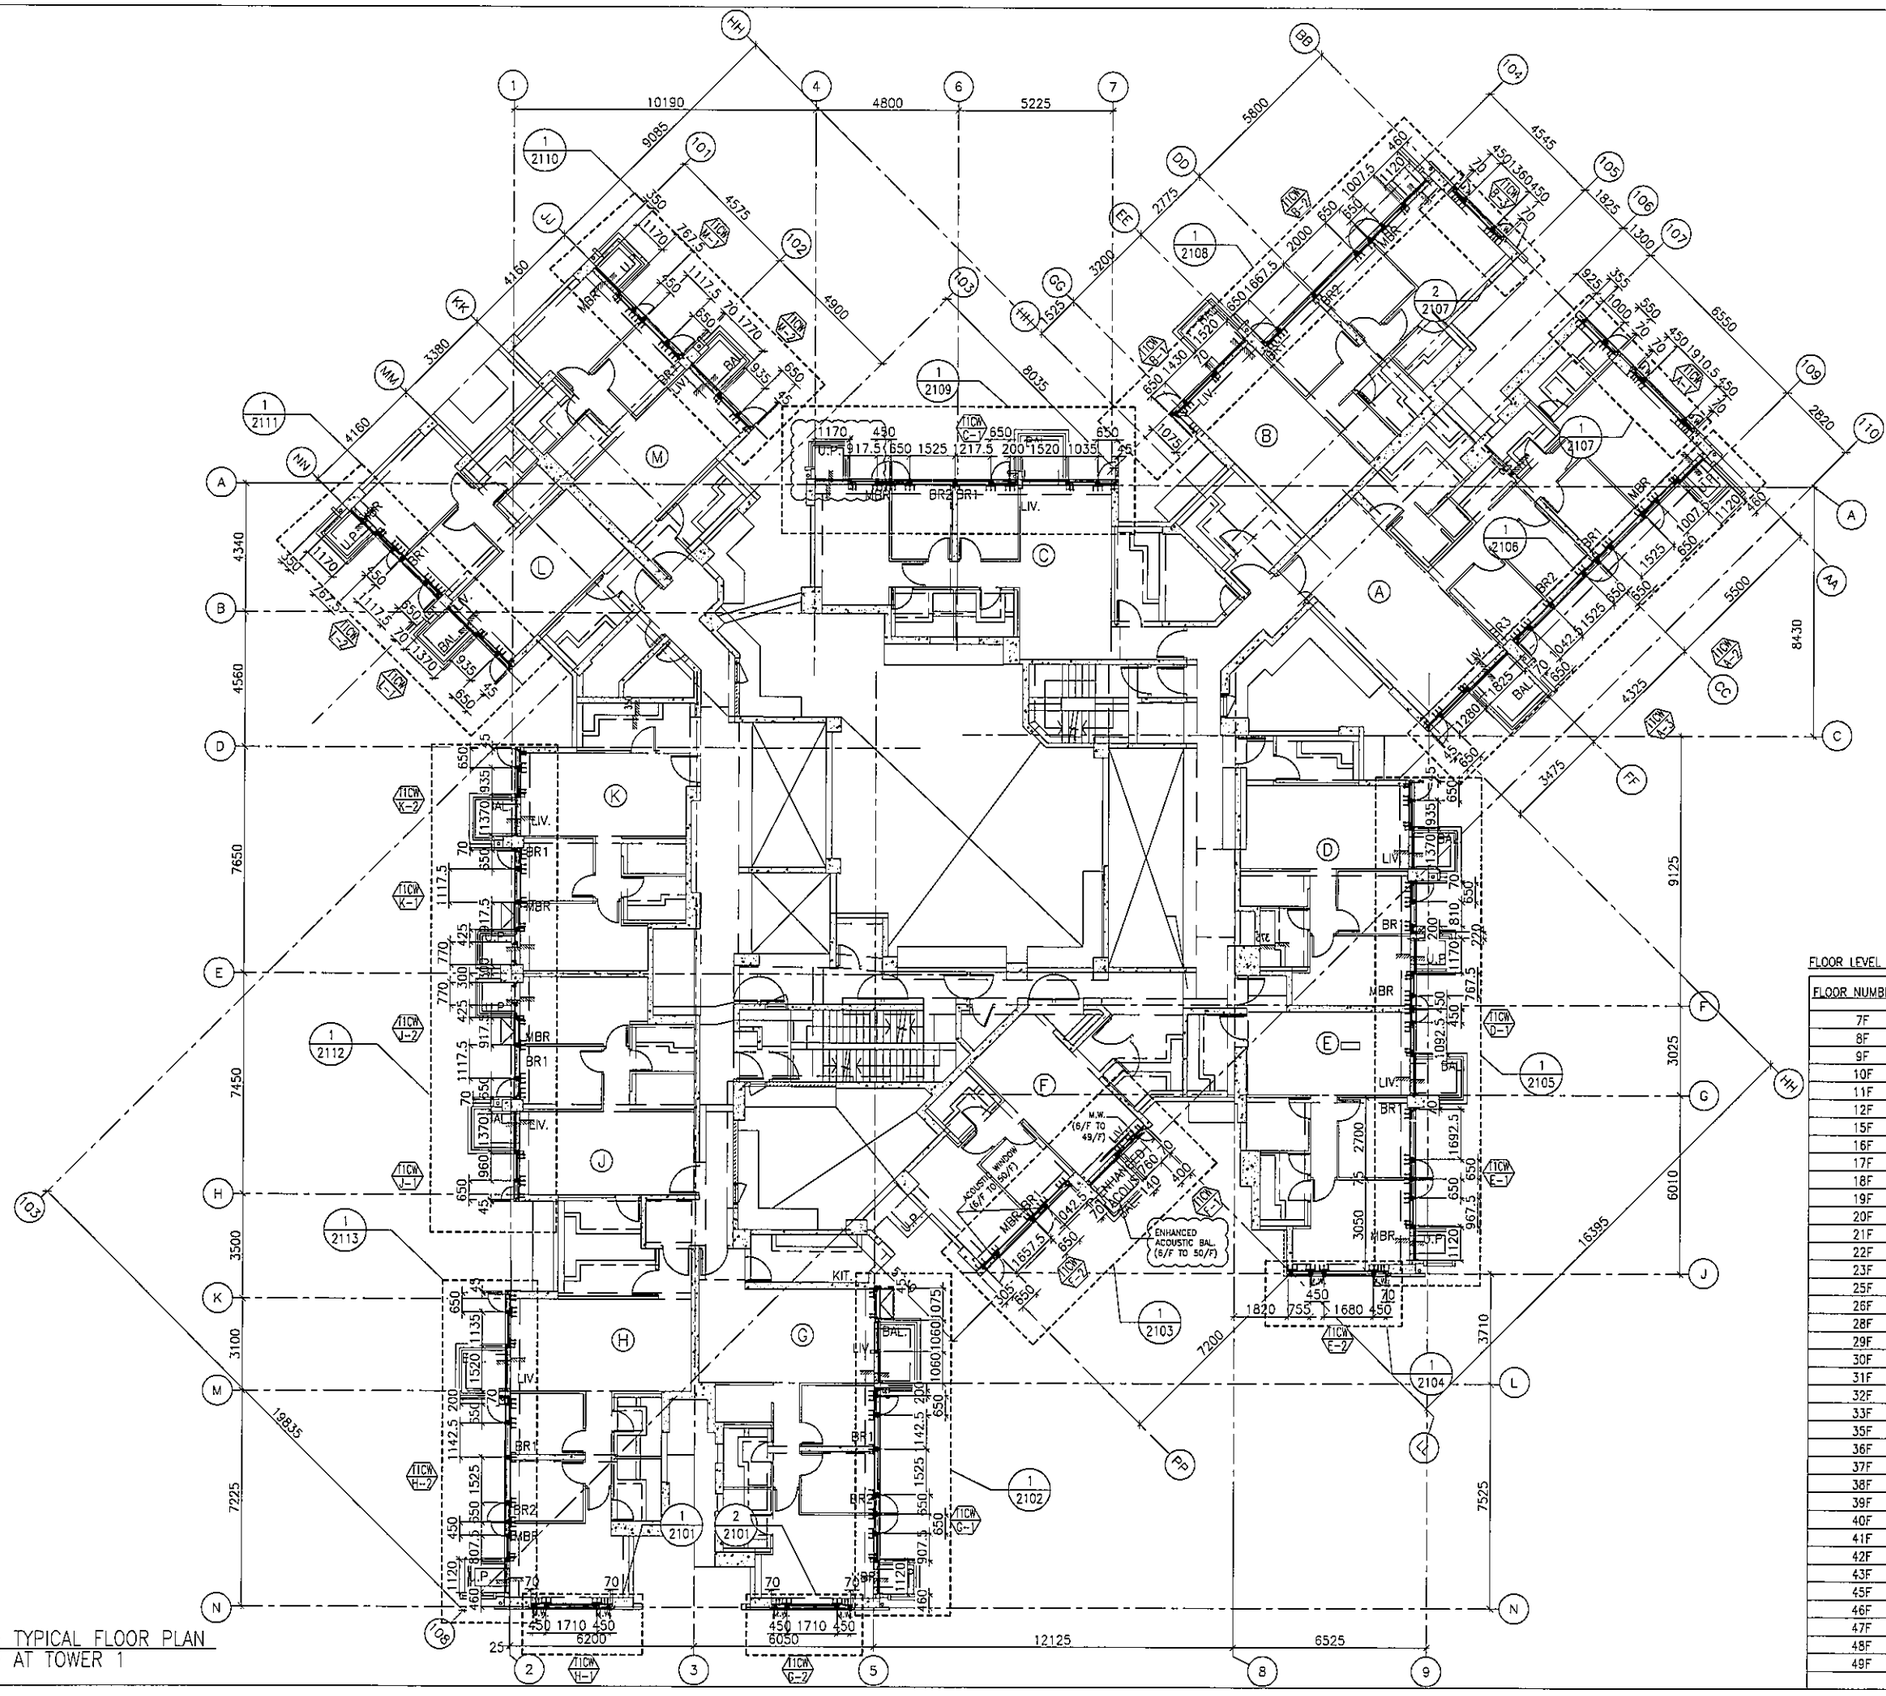

1 / - TYPICAL FLOOR PLAN AT TOWER 1

FLOOR LEVEL (S.F.L.)(T1)

FLOOR NUMBERING	LEVEL (mPD)
7F	42.400
8F	45.550
9F	48.700
10F	51.850
11F	55.000
12F	58.150
15F	61.300
16F	64.450
17F	67.600
18F	70.750
19F	73.900
20F	77.050
21F	80.200
22F	83.350
23F	86.500
25F	89.650
26F	92.800
28F	99.250
29F	102.250
30F	105.400
31F	108.550
32F	111.700
33F	114.850
35F	118.000
36F	121.150
37F	124.300
38F	127.450
39F	130.600
40F	133.750
41F	136.900
42F	140.050
43F	143.100
45F	146.350
46F	149.500
47F	152.650
48F	155.800
49F	158.950

B.D. REF :

CLIENT :
信和置業有限公司
Sino Land Company Limited

ARCHITECT :
WONG TUNG & PARTNERS LIMITED
ARCHITECTS & PLANNERS

MAIN CONTRACTOR :
CR Construction Company Limited

STRUCTURAL ENGINEER :
AECOM

FACADE CONSULTANT:
AECOM

NOTE :
1. ALL DIMENSIONS ARE IN mm.
2. ALL ELEVATIONS ARE VIEWED FROM OUTSIDE.
3. ALL DIMENSIONS TO BE VERIFIED ON SITE BEFORE FABRICATION.

LEGEND :
X1 / XD01 — DETAIL MARK NO. / REFER SHEET NO.
1. F.F.L. --FINISHED FLOOR LEVEL
2. S.F.L. --STRUCTURAL FLOOR LEVEL
3. /R --REVERSED DETAIL

NO.	DATE	REVISED	BY
G	07/04/2019	GENERAL REVISED	
F	19/01/2019	GENERAL REVISED	
E	22/12/2018	GENERAL REVISED	
D	01/12/2018	GENERAL REVISED	
C	24/11/2018	GENERAL REVISED	
B	11/10/2018	GENERAL REVISED	
A	10/9/2018	GENERAL REVISED	

JOB NO. : J-837

PROJECT :
URA KWUN TONG TOWN CENTRE REDEVELOPMENT (AREA 2 & 3) AT NKIL 6514, KWUN TONG, KWLOON

TITLE :
TYPICAL FLOOR PLAN OF CURTAIN WALL AT TOWER 1

DATE : 04-JUL-18 | SCALE : 1:100 (A1)

DRAWN BY : ASING | CHECKED BY : -

美特鋁質有限公司
MIDI ALUMINIUM FABRICATOR LTD.
Units 6-8, Sunray Industrial Centre, 1/F
610 Cha Kwo Ling Road, Kowloon
Tel:23489211-4 Fax:(852)27727666

DWG NO. : J837-CW-3102 | REV. : G

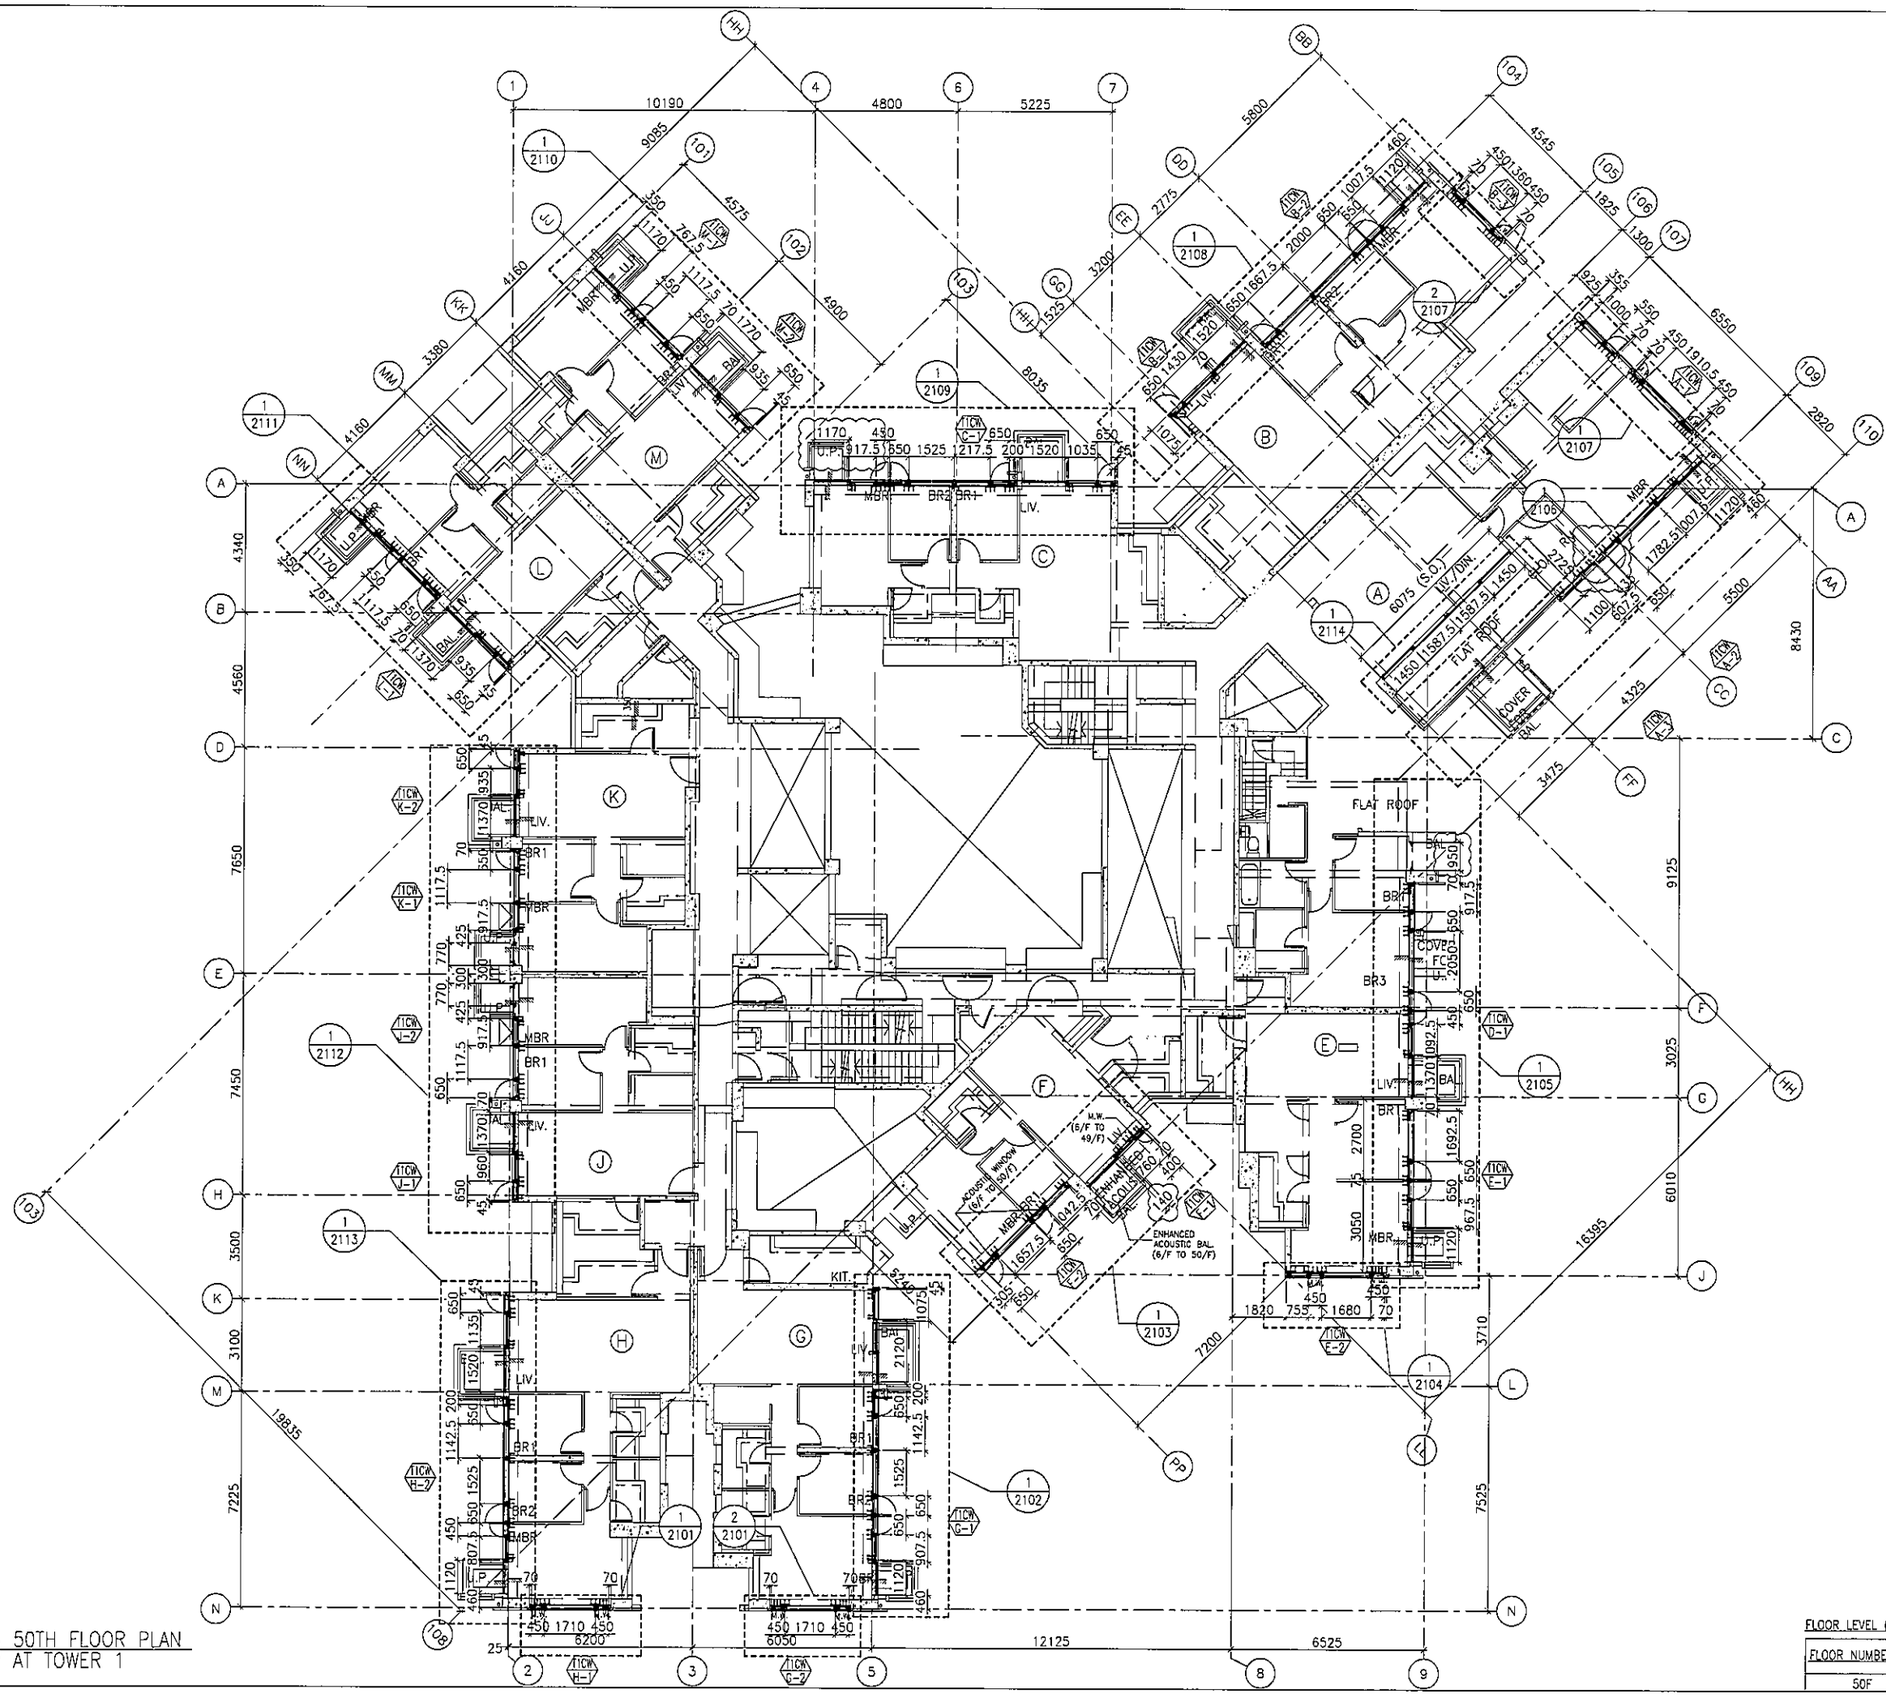

B.D. REF :

CLIENT :
信和置業有限公司
Sino Land Company Limited

ARCHITECT :
WONG TUNG & PARTNERS LIMITED
ARCHITECTS & PLANNERS

MAIN CONTRACTOR :
CR Construction Company Limited

STRUCTURAL ENGINEER :
AECOM

FACADE CONSULTANT:
AECOM

NOTE :
1. ALL DIMENSIONS ARE IN mm.
2. ALL ELEVATIONS ARE VIEWED FROM OUTSIDE.
3. ALL DIMENSIONS TO BE VERIFIED ON SITE BEFORE FABRICATION.

LEGEND :
- X1 / XOO1 — DETAIL MARK NO. / REFER SHEET NO.
1. F.F.L. --FINISHED FLOOR LEVEL
2. S.F.L. --STRUCTURAL FLOOR LEVEL
3. (/R) --REVERSED DETAIL

NO.	DATE	REVISED	BY
I	03/06/2019	GENERAL REVISED	
H	07/04/2019	GENERAL REVISED	
G	21/02/2019	GENERAL REVISED	
F	28/01/2019	GENERAL REVISED	
E	19/01/2019	GENERAL REVISED	
D	22/12/2018	GENERAL REVISED	
C	01/12/2018	GENERAL REVISED	
B	24/11/2018	GENERAL REVISED	
A	11/10/2018	GENERAL REVISED	

JOB NO. : J-837

PROJECT :
URA KWUN TONG TOWN CENTRE REDEVELOPMENT (AREA 2 & 3) AT NKIL 6514, KWUN TONG, KWLOON

TITLE :
50TH FLOOR PLAN
OF CURTAIN WALL
AT TOWER 1

DATE : 10-SEP-18 | SCALE : 1:100 (A1)

DRAWN BY : ASING | CHECKED BY : -

美特鋁質有限公司
MIDI ALUMINIUM FABRICATOR LTD.
Units 6-8, Sunray Industrial Centre, 1/F
610 Cha Kwo Ling Road, Kowloon
Tel:23489211-4 Fax:(852)27727666

DWG NO. : J837-CW-3103 | REV. : I

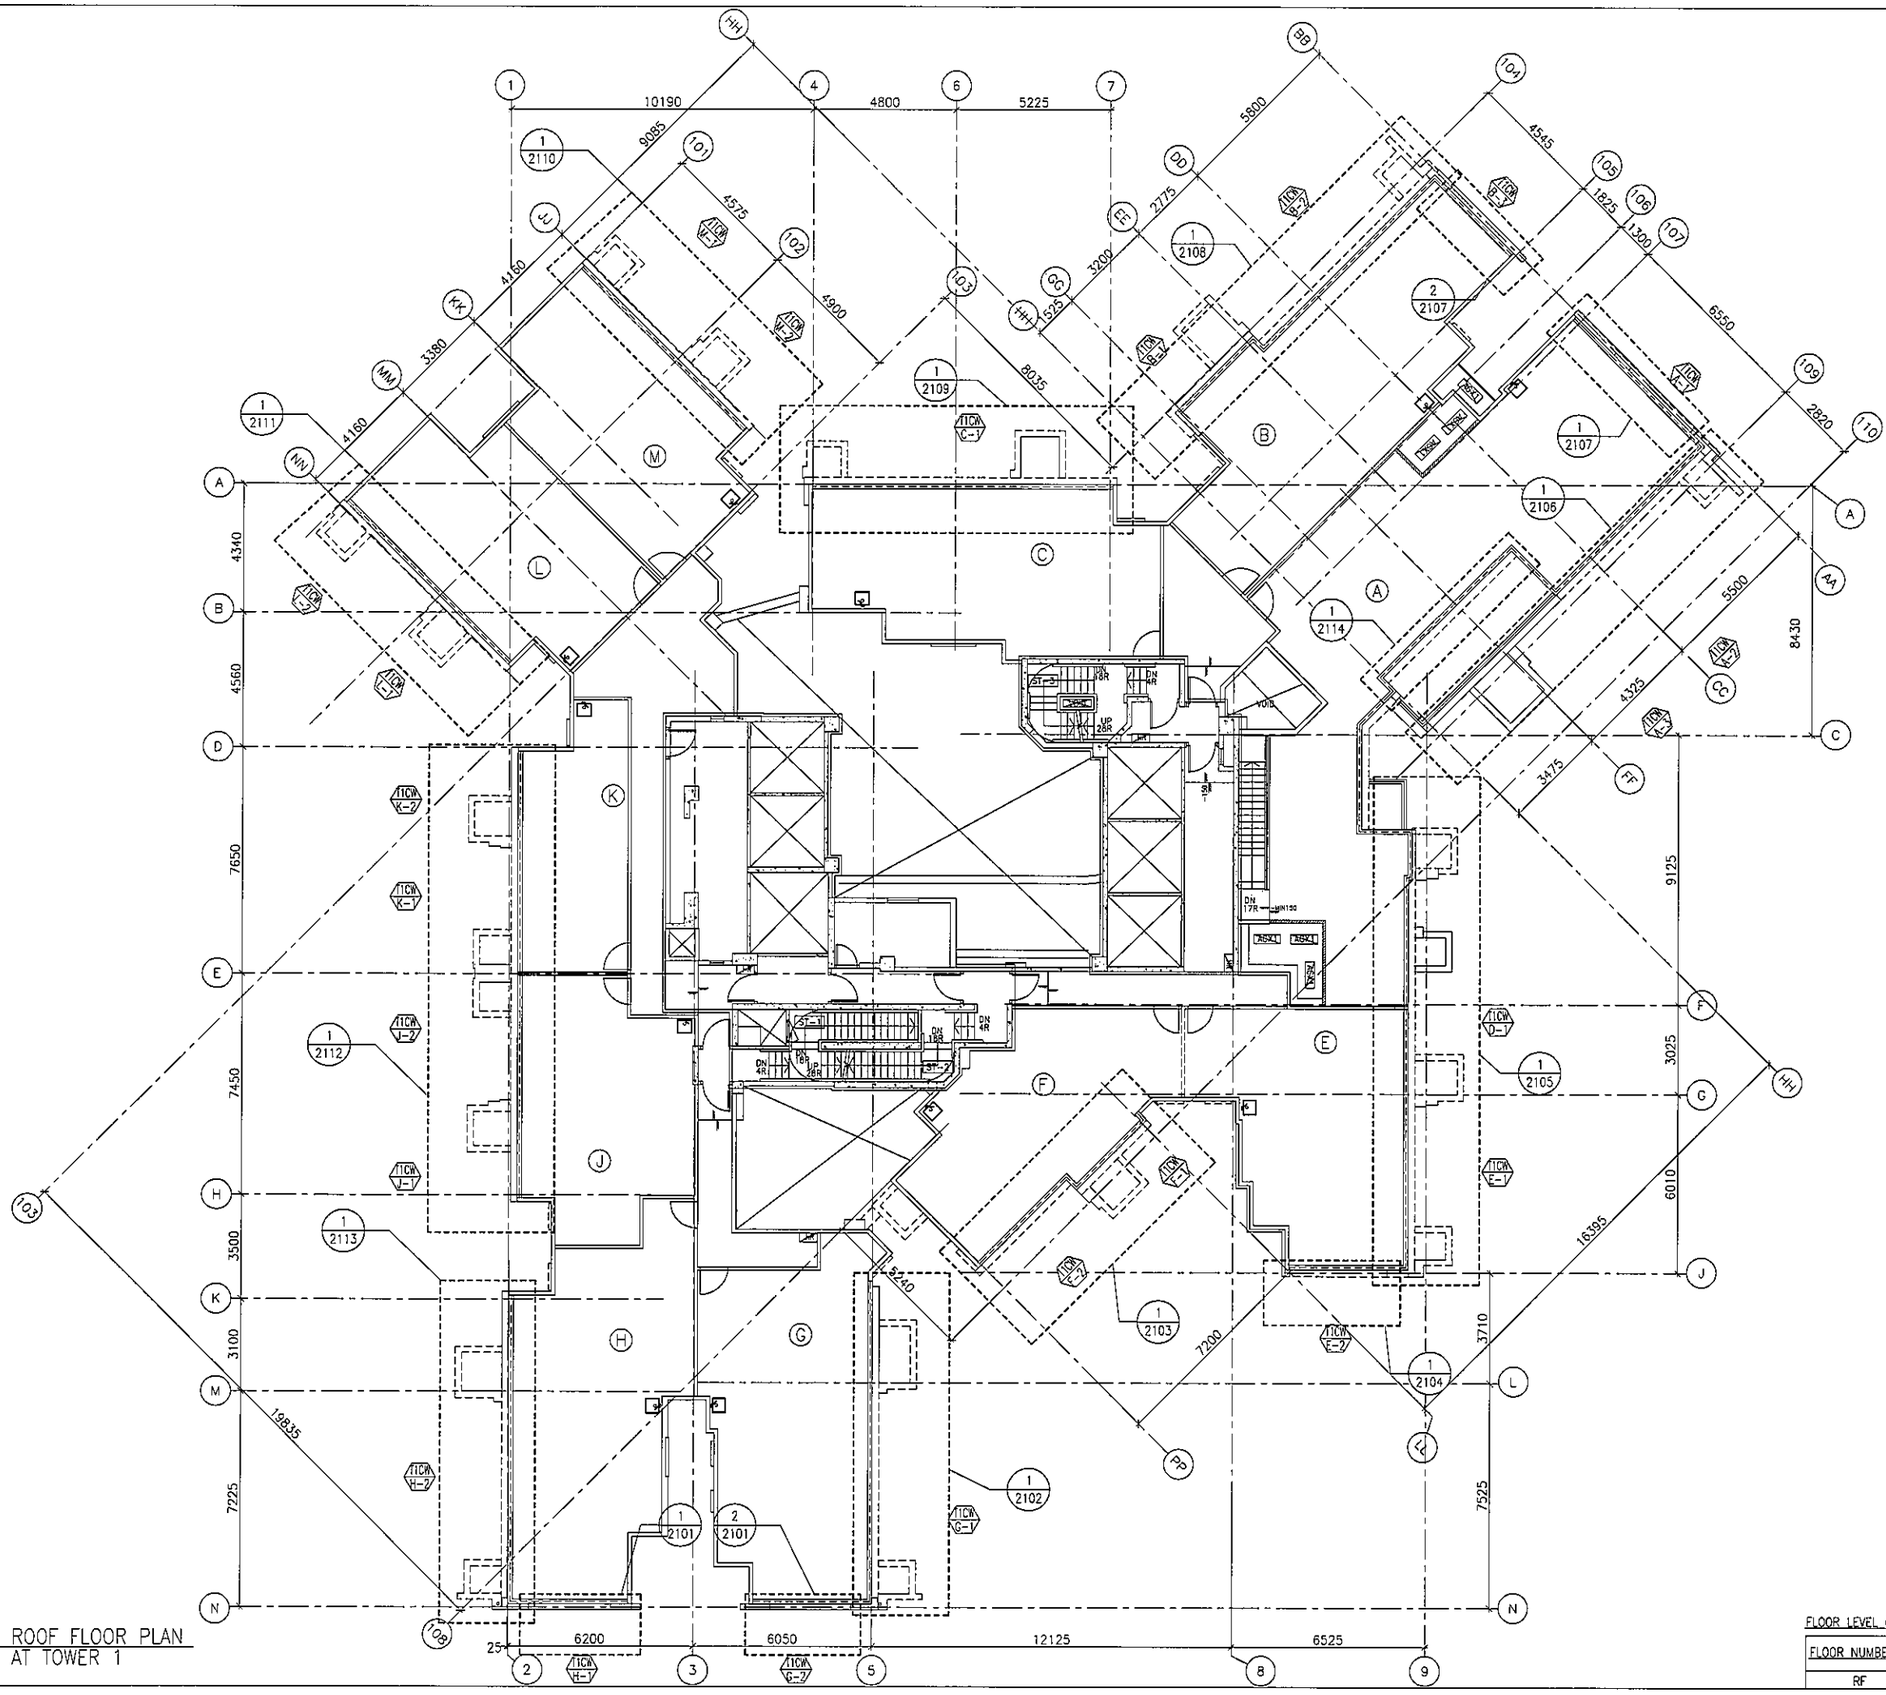

1 / - ROOF FLOOR PLAN AT TOWER 1

FLOOR LEVEL (S.F.L.)(T1)

FLOOR NUMBERING	LEVEL (mPD)
RF	+165.400

B.D. REF :

CLIENT :
信和置業有限公司
Sino Land Company Limited

ARCHITECT :
WONG TUNG & PARTNERS LIMITED
ARCHITECTS & PLANNERS

MAIN CONTRACTOR :
CR Construction Company Limited

STRUCTURAL ENGINEER :
AECOM

FACADE CONSULTANT:
AECOM

NOTE :
1. ALL DIMENSIONS ARE IN mm.
2. ALL ELEVATIONS ARE VIEWED FROM OUTSIDE.
3. ALL DIMENSIONS TO BE VERIFIED ON SITE BEFORE FABRICATION.

LEGEND :
X1 — DETAIL MARK NO.
X001 — REFER SHEET NO.

1. F.F.L. --FINISHED FLOOR LEVEL
2. S.F.L. --STRUCTURAL FLOOR LEVEL
3. /R --REVERSED DETAIL

NO.	DATE	REVISED	BY
C	16/07/2019	GENERAL REVISED	
B	21/02/2019	GENERAL REVISED	
A	28/01/2019	GENERAL REVISED	

JOB NO. : J-837

PROJECT :
URA KWUN TONG TOWN CENTRE REDEVELOPMENT (AREA 2 & 3) AT NKIL 6514, KWUN TONG, KWLOON

TITLE :
ROOF FLOOR PLAN OF CURTAIN WALL AT TOWER 1

DATE : 10-SEP-18 | SCALE : 1:100 (A1)

DRAWN BY : ASING | CHECKED BY : -

美特鋁質有限公司
MIDI ALUMINIUM FABRICATOR LTD.
Units 6-8, Sunray Industrial Centre, 1/F
610 Cha Kwo Ling Road, Kowloon
Tel:23489211-4 Fax:(852)27727666

DWG NO. : J837-CW-3104 | REV. : C

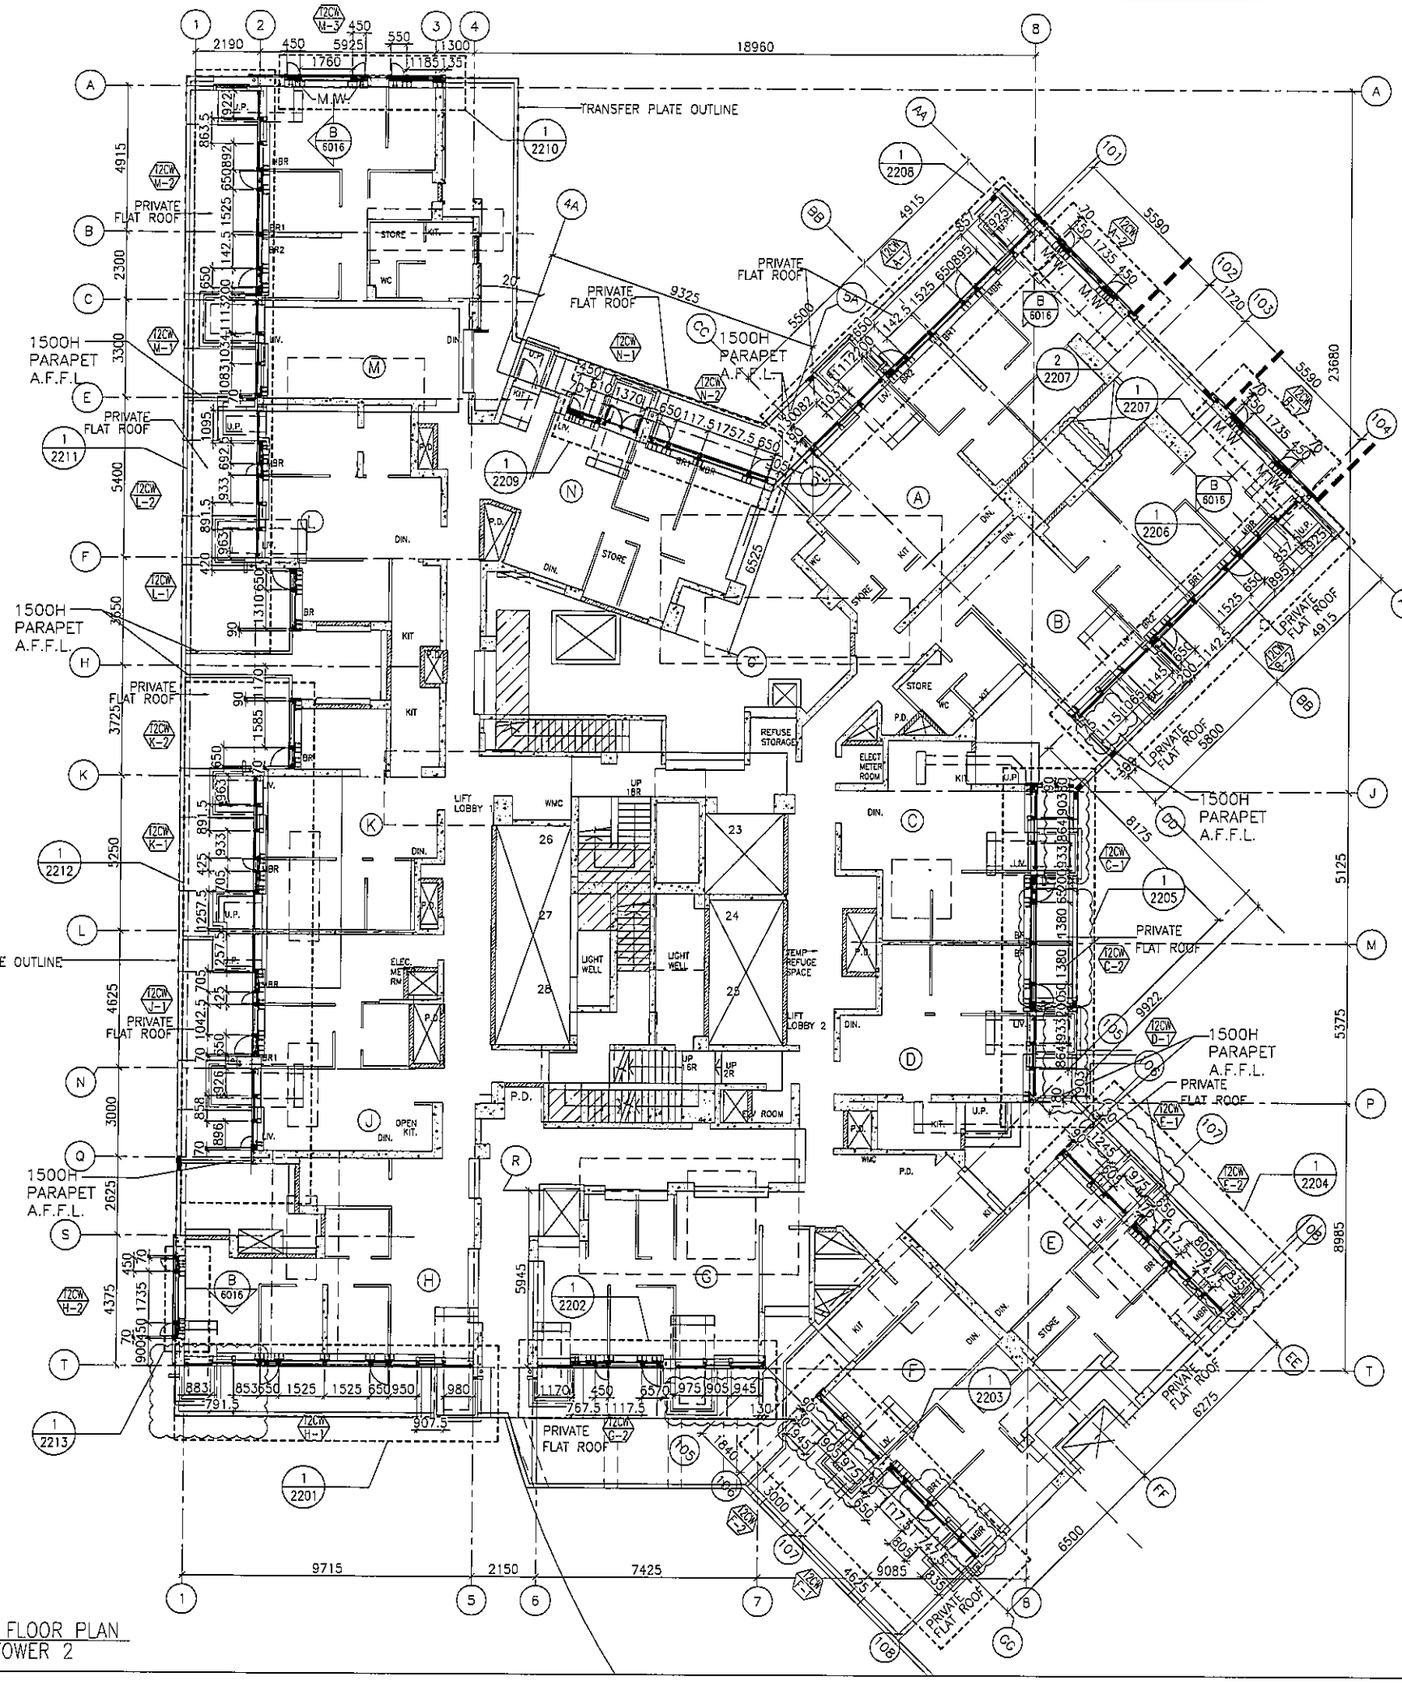

1 6TH FLOOR PLAN
- AT TOWER 2

FLOOR LEVEL (S.F.L.)(T2)

FLOOR NUMBERING	LEVEL (mPD)
6/F	+38.900

B.D. REF :

CLIENT :
信和置業有限公司
Sino Land Company Limited

ARCHITECT : WONG TUNG & PARTNERS LIMITED
ARCHITECTS & PLANNERS

MAIN CONTRACTOR :
CR Construction Company Limited

STRUCTURAL ENGINEER :
AECOM

FACADE CONSULTANT:
AECOM

NOTE :
1. ALL DIMENSIONS ARE IN mm.
2. ALL ELEVATIONS ARE VIEWED FROM OUTSIDE.
3. ALL DIMENSIONS TO BE VERIFIED ON SITE BEFORE FABRICATION.

LEGEND :
- X1 / XCD1 — DETAIL MARK NO. / REFER SHEET NO.
1. F.F.L. --FINISHED FLOOR LEVEL
2. S.F.L. --STRUCTURAL FLOOR LEVEL
3. /R --REVERSED DETAIL

NO.	DATE	REVISED	BY
H	18/08/2019	GENERAL REVISED	
G	26/05/2019	GENERAL REVISED	
F	19/01/2019	GENERAL REVISED	
E	22/12/2018	GENERAL REVISED	
D	24/11/2018	GENERAL REVISED	
C	8/10/2018	GENERAL REVISED	
B	28/9/2018	GENERAL REVISED	
A	10/9/2018	GENERAL REVISED	

JOB NO. : J-837

PROJECT :
URA KWUN TONG TOWN CENTRE REDEVELOPMENT (AREA 2 & 3) AT NKIL 6514, KWUN TONG, KWLOON

TITLE :
6TH FLOOR PLAN OF CURTAIN WALL AT TOWER 2

DATE : 04-JUL-18 | SCALE : 1:100 (A1)

DRAWN BY : ASING | CHECKED BY : -

美特鋁質有限公司
MIDI ALUMINIUM FABRICATOR LTD.
Units 6-8, Sunray Industrial Centre, 1/F
610 Cha Kwo Ling Road, Kowloon
Tel:23489211-4 Fax:(852)27727666

DWG NO. : J837-CW-3201 | REV. : H

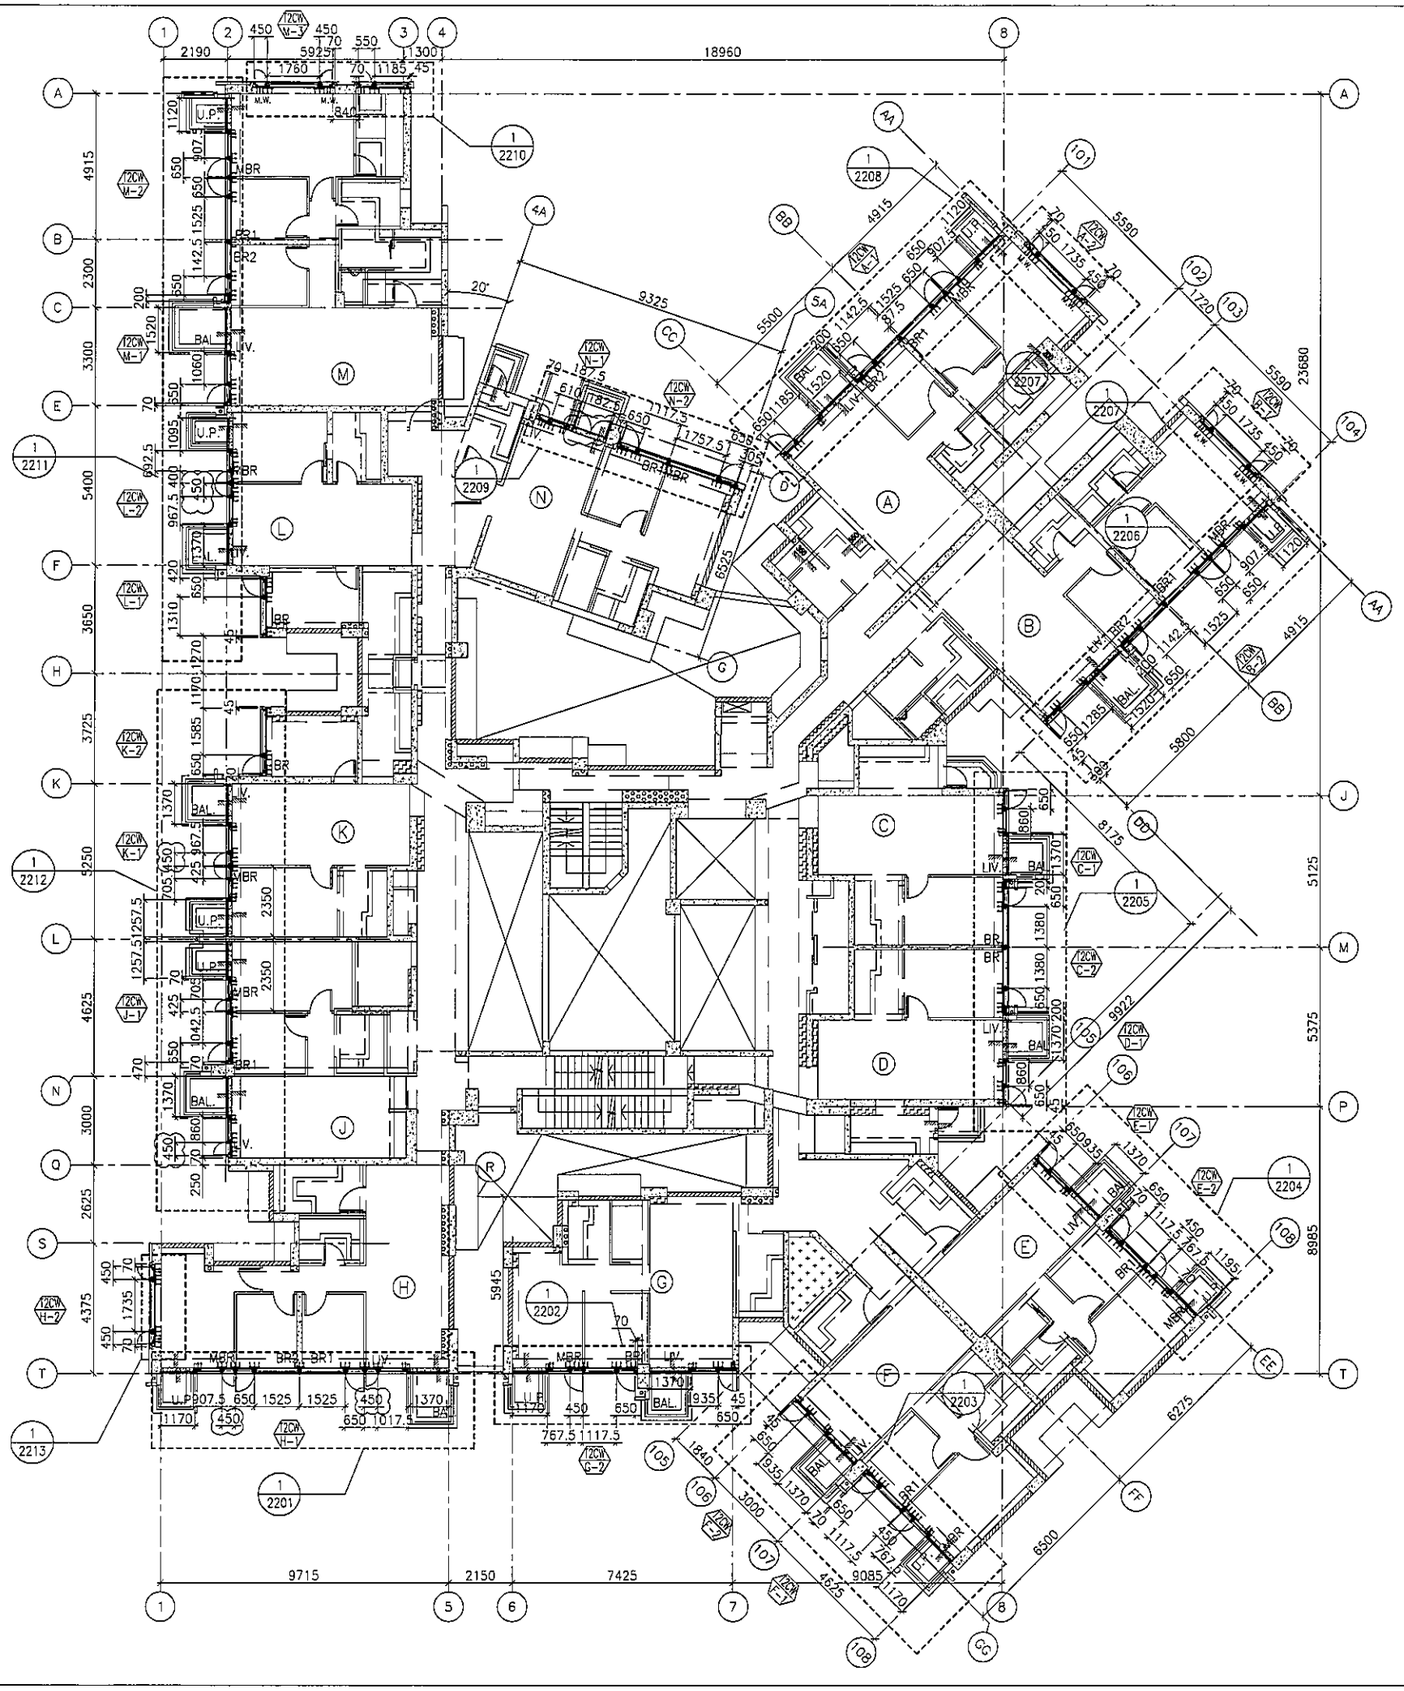

1 / - TYPICAL FLOOR PLAN AT TOWER 2

FLOOR LEVEL (S.F.L.)(T2)

FLOOR NUMBERING	LEVEL (mPD)
7F	42.400
8F	45.550
9F	48.700
10F	51.850
11F	55.000
12F	58.150
15F	61.300
16F	64.450
17F	67.600
18F	70.750
19F	73.900
20F	77.050
21F	80.200
22F	83.350
23F	86.500
25F	89.650
26F	92.800
28F	99.250
29F	102.250
30F	105.400
31F	108.550
32F	111.700
33F	114.850
35F	118.000
36F	121.150
37F	124.300
38F	127.450
39F	130.600
40F	133.750
41F	136.900
42F	140.050
43F	143.100
45F	146.350
46F	149.500
47F	152.650
48F	155.800
49F	158.950
50F	162.100
51F	165.250
52F	168.400
53F	171.550

B.D. REF :

CLIENT :
信和置業有限公司
Sino Land Company Limited

ARCHITECT :
WONG TUNG & PARTNERS LIMITED
ARCHITECTS & PLANNERS

MAIN CONTRACTOR :
CR Construction Company Limited

STRUCTURAL ENGINEER :
AECOM

FACADE CONSULTANT:
AECOM

NOTE :
1. ALL DIMENSIONS ARE IN mm.
2. ALL ELEVATIONS ARE VIEWED FROM OUTSIDE.
3. ALL DIMENSIONS TO BE VERIFIED ON SITE BEFORE FABRICATION.

LEGEND :
X1 — DETAIL MARK NO.
XC01 — REFER SHEET NO.

1. F.F.L. --FINISHED FLOOR LEVEL
2. S.F.L. --STRUCTURAL FLOOR LEVEL
3. /R --REVERSED DETAIL

NO.	DATE	REVISED	BY
E	19/01/2019	GENERAL REVISED	
D	22/12/2018	GENERAL REVISED	
C	24/11/2018	GENERAL REVISED	
B	8/10/2018	GENERAL REVISED	
A	10/9/2018	GENERAL REVISED	

JOB NO. : J-837

PROJECT :
URA KWUN TONG TOWN CENTRE REDEVELOPMENT (AREA 2 & 3) AT NKIL 6514, KWUN TONG, KWLOON

TITLE :
TYPICAL FLOOR PLAN OF CURTAIN WALL AT TOWER 2

DATE : 04-JUL-18 | SCALE : 1:100 (A1)

DRAWN BY : ASING | CHECKED BY : -

美特鋁質有限公司
MIDI ALUMINIUM FABRICATOR LTD.
Units 6-8, Sunray Industrial Centre, 1/F
610 Cha Kwo Ling Road, Kowloon
Tel:23489211-4 Fax:(852)27727666

DWG NO. : J837-CW-3202 | REV. : E

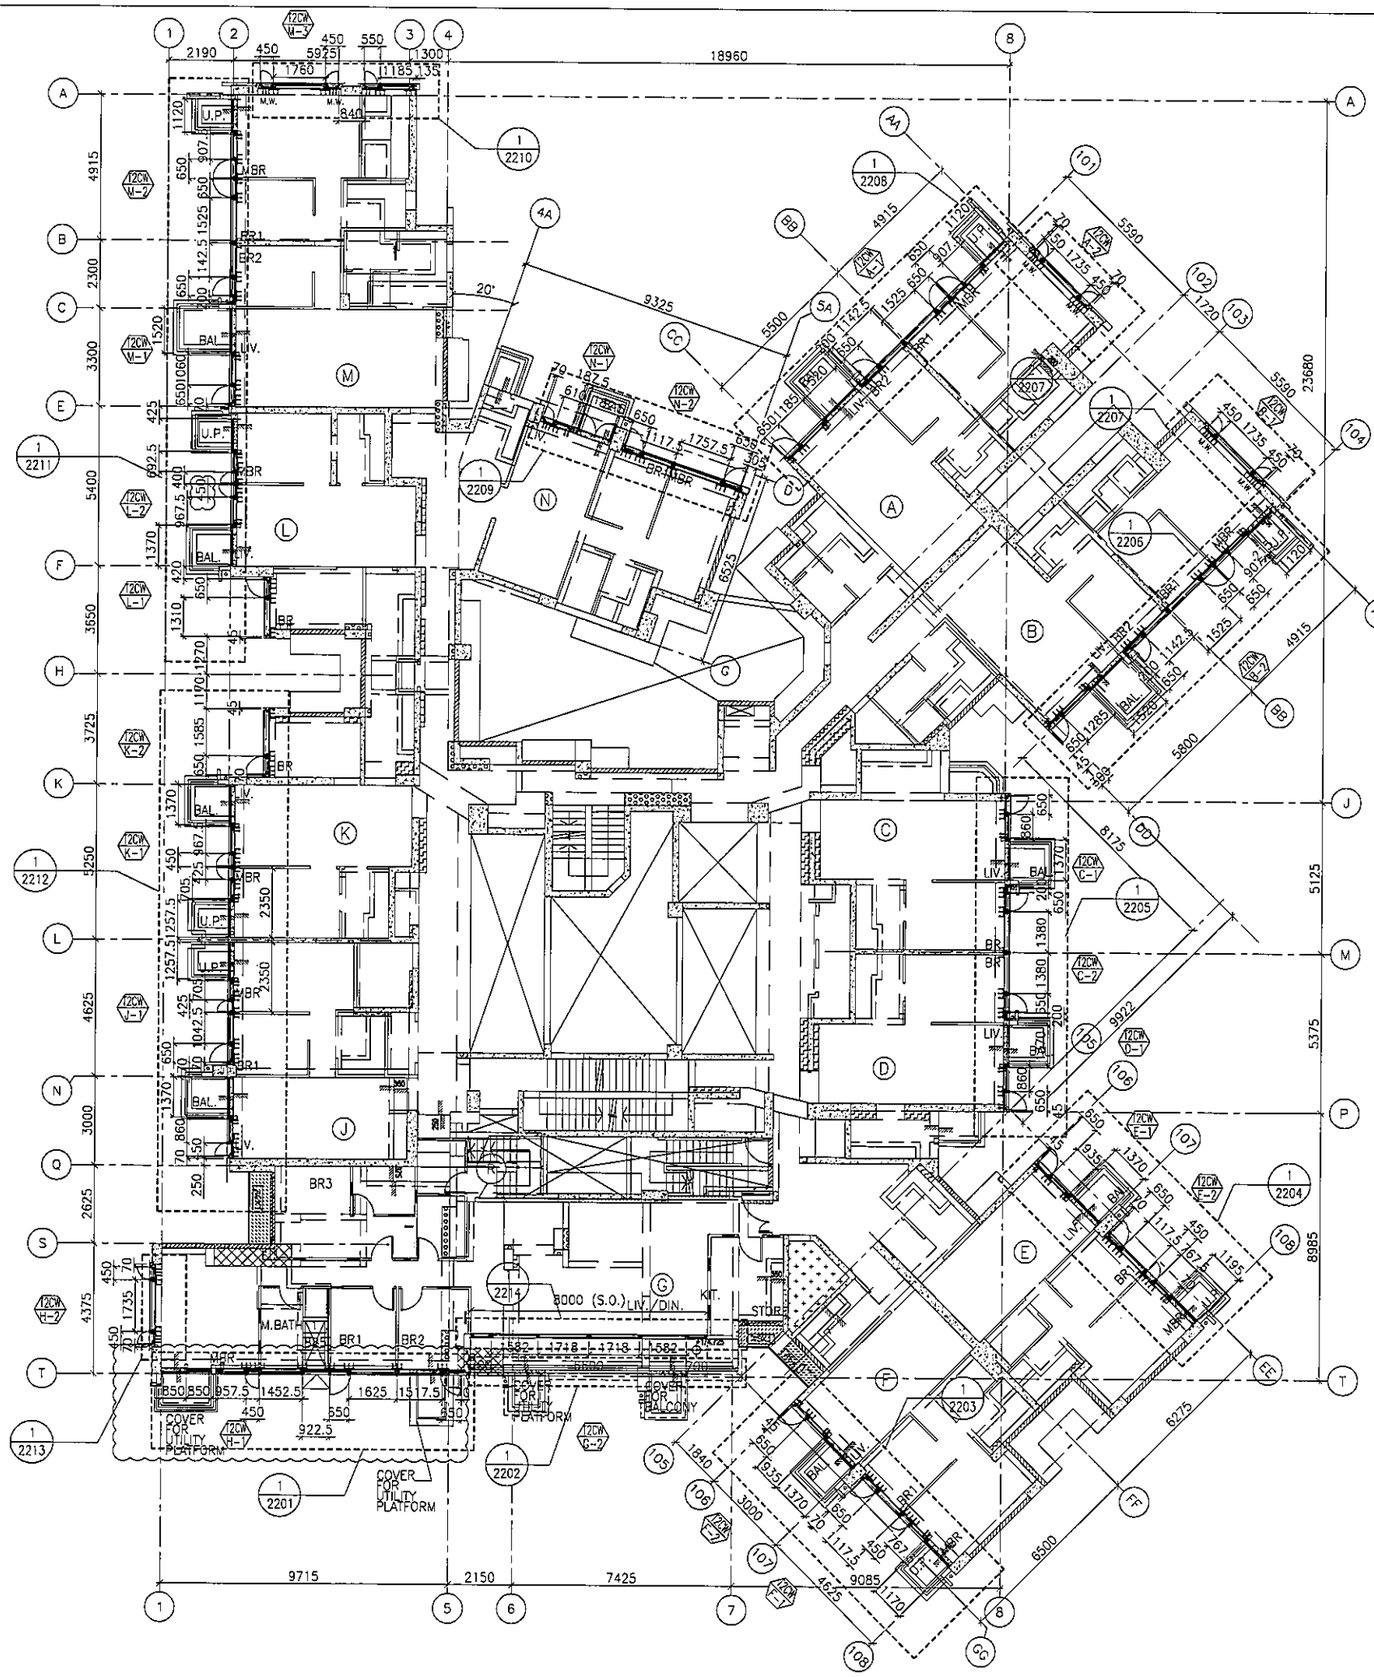

1 / - 55TH FLOOR PLAN AT TOWER 2

FLOOR LEVEL (S.F.L.)(T2)

FLOOR NUMBERING	LEVEL (mPD)
55F	+174.700

B.D. REF :

CLIENT :
信和置業有限公司
Sino Land Company Limited

ARCHITECT : WONG TUNG & PARTNERS LIMITED ARCHITECTS & PLANNERS

MAIN CONTRACTOR :
CR Construction Company Limited

STRUCTURAL ENGINEER : AECOM

FACADE CONSULTANT: AECOM

NOTE :
1. ALL DIMENSIONS ARE IN mm.
2. ALL ELEVATIONS ARE VIEWED FROM OUTSIDE.
3. ALL DIMENSIONS TO BE VERIFIED ON SITE BEFORE FABRICATION.

LEGEND :
- X1 / XG01 — DETAIL MARK NO. / REFER SHEET NO.
1. F.F.L. --FINISHED FLOOR LEVEL
2. S.F.L. --STRUCTURAL FLOOR LEVEL
3. (/R) --REVERSED DETAIL

NO.	DATE	REVISED	BY
H	02/08/2019	GENERAL REVISED	
G	09/07/2019	GENERAL REVISED	
F	03/06/2019	GENERAL REVISED	
E	07/04/2019	GENERAL REVISED	
D	21/02/2019	GENERAL REVISED	
C	19/01/2019	GENERAL REVISED	
B	22/12/2018	GENERAL REVISED	
A	24/11/2018	GENERAL REVISED	

JOB NO. : J-837

PROJECT :
URA KWUN TONG TOWN CENTRE REDEVELOPMENT (AREA 2 & 3) AT NKIL 6514, KWUN TONG, KWLOON

TITLE :
55TH FLOOR PLAN OF CURTAIN WALL AT TOWER 2

DATE : 10-SEP-18 | SCALE : 1:100 (A1)

DRAWN BY : ASING | CHECKED BY : --

美特鋁質有限公司
MIDI ALUMINIUM FABRICATOR LTD.
Units 6-8, Sunray Industrial Centre, 1/F
610 Cha Kwo Ling Road, Kowloon
Tel:23489211-4 Fax:(852)27727666

DWG NO. : J837-CW-3203 | REV. : H

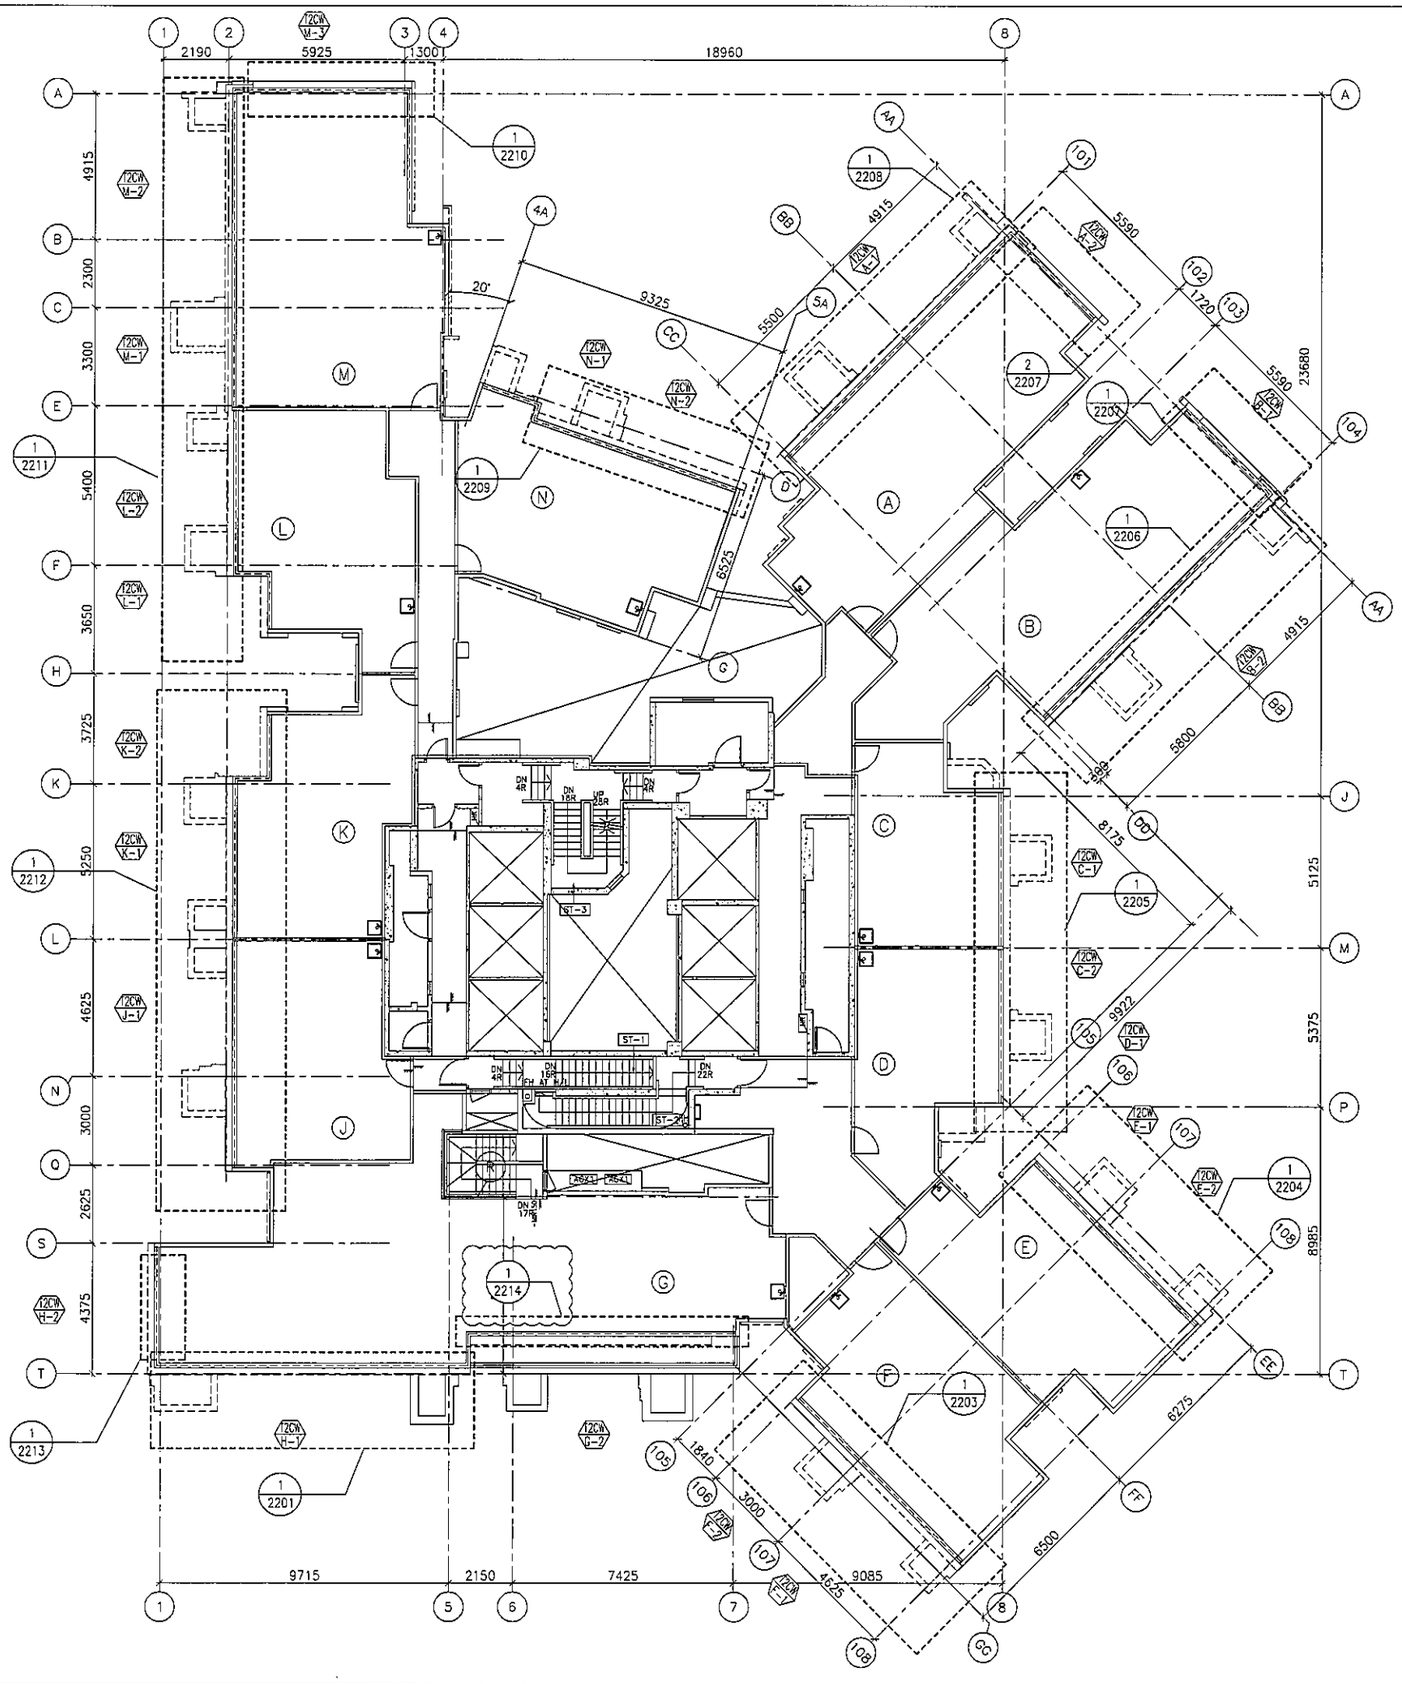

1 / - ROOF FLOOR PLAN AT TOWER 2

FLOOR LEVEL (S.F.L.)(T2)

FLOOR NUMBERING	LEVEL (mPD)
RF	+178.000

B.D. REF :

CLIENT :
信和置業有限公司
Sino Land Company Limited

ARCHITECT :
WONG TUNG & PARTNERS LIMITED
ARCHITECTS & PLANNERS

MAIN CONTRACTOR :
CR Construction Company Limited

STRUCTURAL ENGINEER :
AECOM

FACADE CONSULTANT:
AECOM

NOTE :
1. ALL DIMENSIONS ARE IN mm.
2. ALL ELEVATIONS ARE VIEWED FROM OUTSIDE.
3. ALL DIMENSIONS TO BE VERIFIED ON SITE BEFORE FABRICATION.

LEGEND :
X1 / X001 — DETAIL MARK NO. / REFER SHEET NO.
1. F.F.L. --- FINISHED FLOOR LEVEL
2. S.F.L. --- STRUCTURAL FLOOR LEVEL
3. /R --- REVERSED DETAIL

NO.	DATE	REVISED	BY
C	16/07/2019	GENERAL REVISED	
B	21/02/2019	GENERAL REVISED	
A	22/12/2018	GENERAL REVISED	

JOB NO. : J-837

PROJECT :
URA KWUN TONG TOWN CENTRE REDEVELOPMENT (AREA 2 & 3) AT NKIL 6514, KWUN TONG, KWLOON

TITLE :
ROOF FLOOR PLAN OF CURTAIN WALL AT TOWER 2

DATE : 10-SEP-18 | SCALE : 1:100 (A1)

DRAWN BY : ASING | CHECKED BY : -

美特鋁質有限公司
MIDI ALUMINIUM FABRICATOR LTD.
Units 6-8, Sunray Industrial Centre, 1/F
610 Cha Kwo Ling Road, Kowloon
Tel:23489211-4 Fax:(852)27727666

DWG NO. : J837-CW-3204 | REV. : C

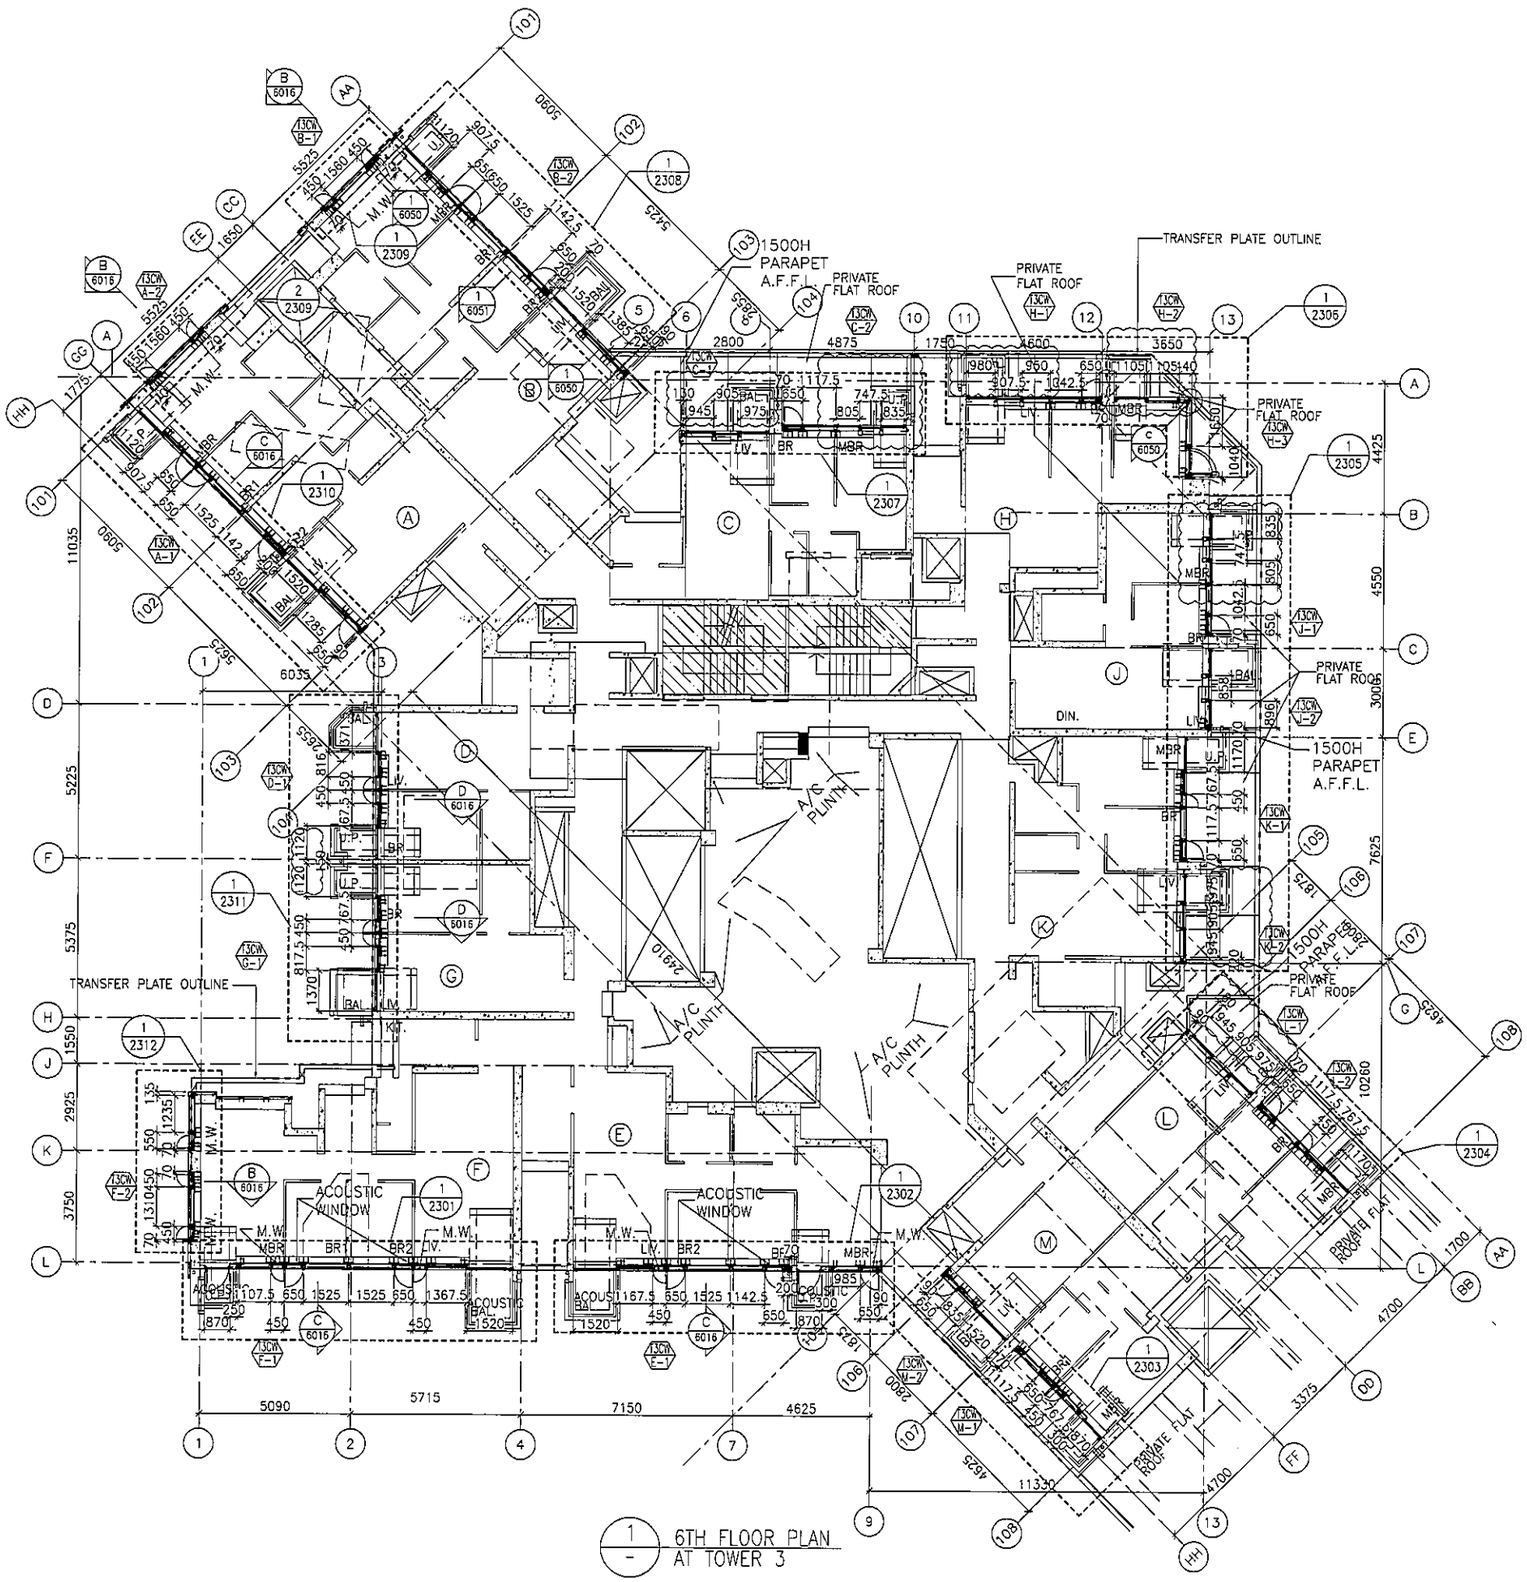

1 / - 6TH FLOOR PLAN AT TOWER 3

FLOOR LEVEL (S.F.L.)(T3)

FLOOR NUMBERING	LEVEL (mPD)
6/F	+38.900

B.D. REF :

CLIENT :
信和置業有限公司
Sino Land Company Limited

ARCHITECT :
WONG TUNG & PARTNERS LIMITED
ARCHITECTS & PLANNERS

MAIN CONTRACTOR :
CR Construction Company Limited

STRUCTURAL ENGINEER :
AECOM

FACADE CONSULTANT:
AECOM

NOTE :
1. ALL DIMENSIONS ARE IN mm.
2. ALL ELEVATIONS ARE VIEWED FROM OUTSIDE.
3. ALL DIMENSIONS TO BE VERIFIED ON SITE BEFORE FABRICATION.

LEGEND :
X1 — DETAIL MARK NO.
X001 — REFER SHEET NO.

1. F.F.L. --FINISHED FLOOR LEVEL
2. S.F.L. --STRUCTURAL FLOOR LEVEL
3. (/R) --REVERSED DETAIL

NO.	DATE	REVISED	BY
F	18/08/2019	GENERAL REVISED	
E	26/05/2019	GENERAL REVISED	
D	19/01/2019	GENERAL REVISED	
C	24/11/2018	GENERAL REVISED	
B	28/9/2018	GENERAL REVISED	
A	10/9/2018	GENERAL REVISED	

JOB NO. : J-837

PROJECT :
URA KWUN TONG TOWN CENTRE REDEVELOPMENT (AREA 2 & 3) AT NKIL 6514, KWUN TONG, KWLOON

TITLE :
6TH FLOOR PLAN OF CURTAIN WALL AT TOWER 3

DATE : 04-JUL-18 | SCALE : 1:100 (A1)

DRAWN BY : ASING | CHECKED BY : -

美特鋁質有限公司
MIDI ALUMINIUM FABRICATOR LTD.
Units 6-8, Sunray Industrial Centre, 1/F
610 Cha Kwo Ling Road, Kowloon
Tel:23489211-4 Fax:(852)27727666

DWG NO. : J837-CW-3301 | REV. : F

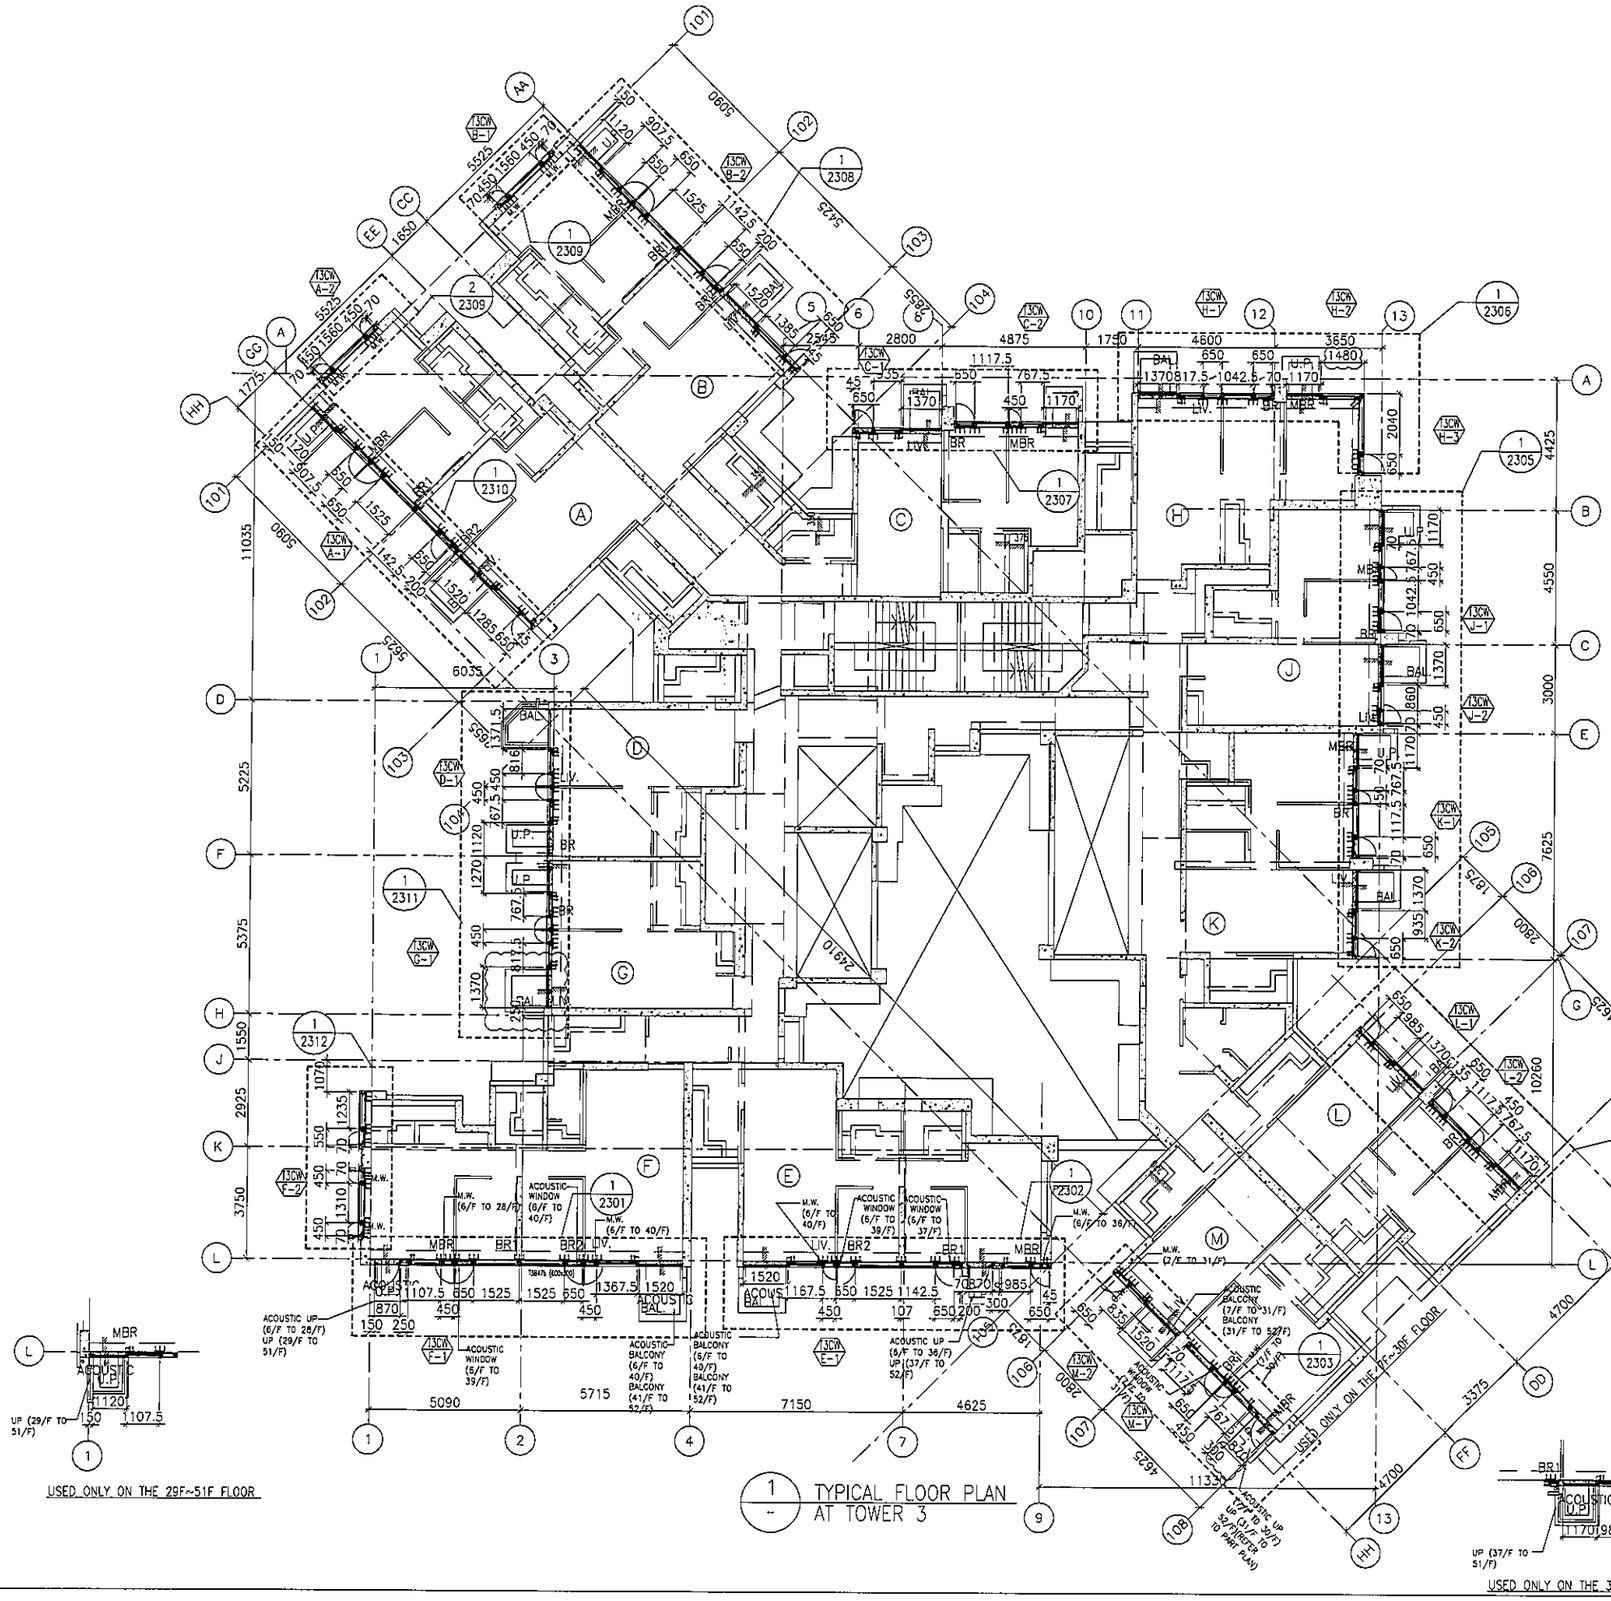

FLOOR LEVEL (S.F.L.)(T3)

FLOOR NUMBERING	LEVEL (mPD)
7F	42.400
8F	45.550
9F	48.700
10F	51.850
11F	55.000
12F	58.150
15F	61.300
16F	64.450
17F	67.600
18F	70.750
19F	73.900
20F	77.050
21F	80.200
22F	83.350
23F	86.500
25F	89.650
26F	92.800
28F	99.250
29F	102.250
30F	105.400
31F	108.550
32F	111.700
33F	114.850
35F	118.000
36F	121.150
37F	124.300
38F	127.450
39F	130.600
40F	133.750
41F	136.900
42F	140.050
43F	143.100
45F	146.350
46F	149.500
47F	152.650
48F	155.800
49F	158.950
50F	162.100
51F	165.250

B.D. REF :

CLIENT :
信和置業有限公司
Sino Land Company Limited

ARCHITECT :
WONG TUNG & PARTNERS LIMITED
ARCHITECTS & PLANNERS

MAIN CONTRACTOR :
CR Construction Company Limited

STRUCTURAL ENGINEER :
AECOM

FACADE CONSULTANT:
AECOM

NOTE :
1. ALL DIMENSIONS ARE IN mm.
2. ALL ELEVATIONS ARE VIEWED FROM OUTSIDE.
3. ALL DIMENSIONS TO BE VERIFIED ON SITE BEFORE FABRICATION.

LEGEND :
X1 — DETAIL MARK NO.
X/D1 — REFER SHEET NO.

1. F.F.L. --FINISHED FLOOR LEVEL
2. S.F.L. --STRUCTURAL FLOOR LEVEL
3. (R) --REVERSED DETAIL

NO.	DATE	REVISED	BY
C	24/11/2018	GENERAL REVISED	
B	11/10/2018	GENERAL REVISED	
A	10/9/2018	GENERAL REVISED	

JOB NO. : J-837

PROJECT :
URA KWUN TONG TOWN CENTRE
REDEVELOPMENT (AREA 2 & 3) AT
NKIL 6514, KWUN TONG, KWLOON

TITLE :
TYPICAL FLOOR PLAN
OF CURTAIN WALL
AT TOWER 3

DATE : 04-JUL-18 | SCALE : 1:100 (A1)

DRAWN BY : ASING | CHECKED BY : -

美特鋁質有限公司
MIDI ALUMINIUM FABRICATOR LTD.
Units 6-8, Sunray Industrial Centre, 1/F
610 Cha Kwo Ling Road, Kowloon
Tel:23489211-4 Fax:(852)27727666

DWG NO. : J837-CW-3302 | REV. : C

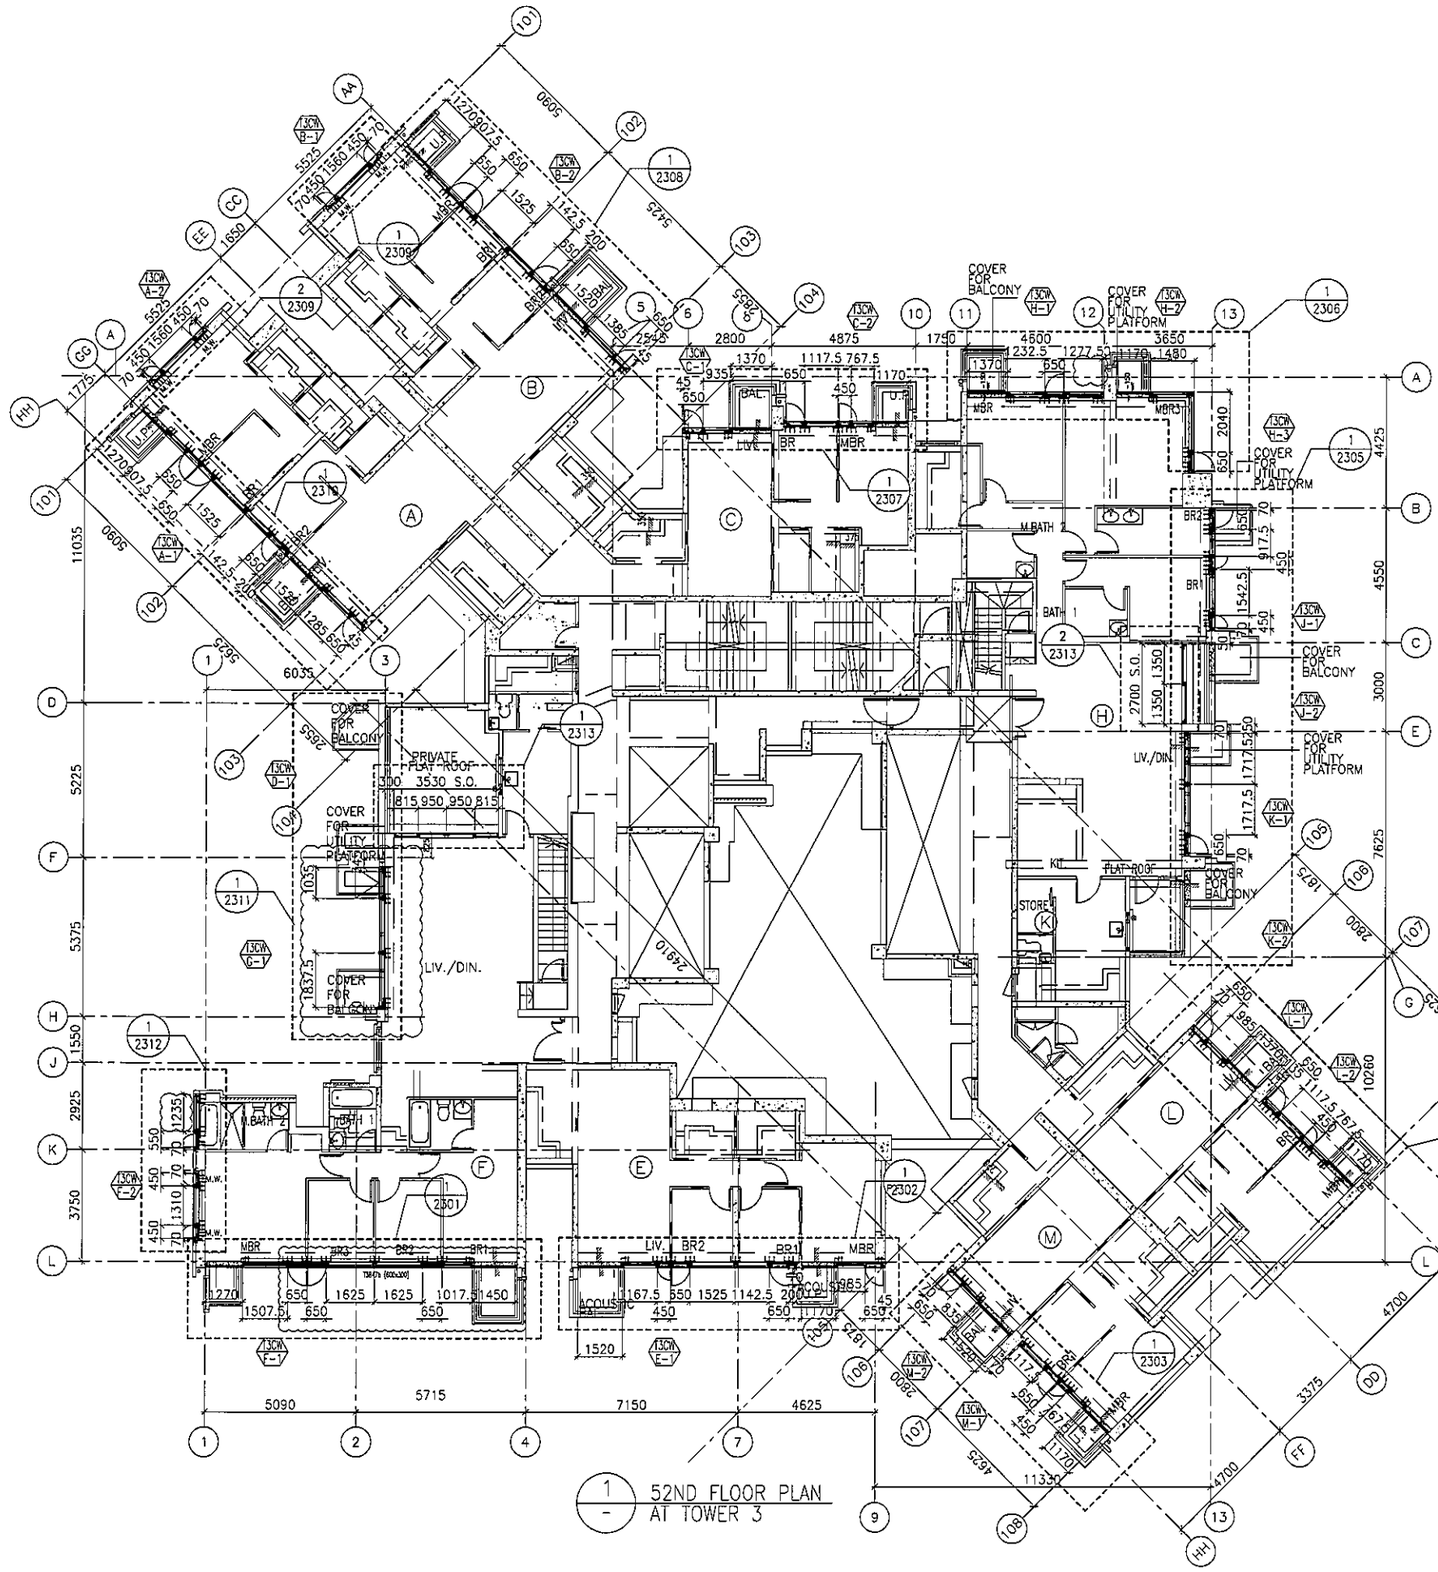

FLOOR LEVEL (S.F.L.)(T3)

FLOOR NUMBERING	LEVEL (mPD)
52F	+168.400

B.D. REF :

CLIENT :
信和置業有限公司
Sino Land Company Limited

ARCHITECT :
WONG TUNG & PARTNERS LIMITED
ARCHITECTS & PLANNERS

MAIN CONTRACTOR :
CR Construction Company Limited

STRUCTURAL ENGINEER :
AECOM

FACADE CONSULTANT:
AECOM

NOTE :
1. ALL DIMENSIONS ARE IN mm.
2. ALL ELEVATIONS ARE VIEWED FROM OUTSIDE.
3. ALL DIMENSIONS TO BE VERIFIED ON SITE BEFORE FABRICATION.

LEGEND :
X1 — DETAIL MARK NO.
X001 — REFER SHEET NO.
1. F.F.L. --FINISHED FLOOR LEVEL
2. S.F.L. --STRUCTURAL FLOOR LEVEL
3. /R --REVERSED DETAIL

NO.	DATE	REVISED	BY
F	03/06/2019	GENERAL REVISED	
E	19/5/2019	GENERAL REVISED	
D	7/4/2019	GENERAL REVISED	
C	22/12/2018	GENERAL REVISED	
B	24/11/2018	GENERAL REVISED	
A	11/10/2018	GENERAL REVISED	

JOB NO. : J-837

PROJECT :
URA KWUN TONG TOWN CENTRE REDEVELOPMENT (AREA 2 & 3) AT NKIL 6514, KWUN TONG, KWLOON

TITLE :
52ND FLOOR PLAN OF CURTAIN WALL AT TOWER 3

DATE : 10-SEP-18 | SCALE : 1:100 (A1)

DRAWN BY : ASING | CHECKED BY : -

美特鋁質有限公司
MIDI ALUMINIUM FABRICATOR LTD.
Units 6-8, Sunray Industrial Centre, 1/F
610 Cho Kwo Ling Road, Kowloon
Tel:23489211-4 Fax:(852)27727666

DWG NO. : J837-CW-3303 | REV. : F

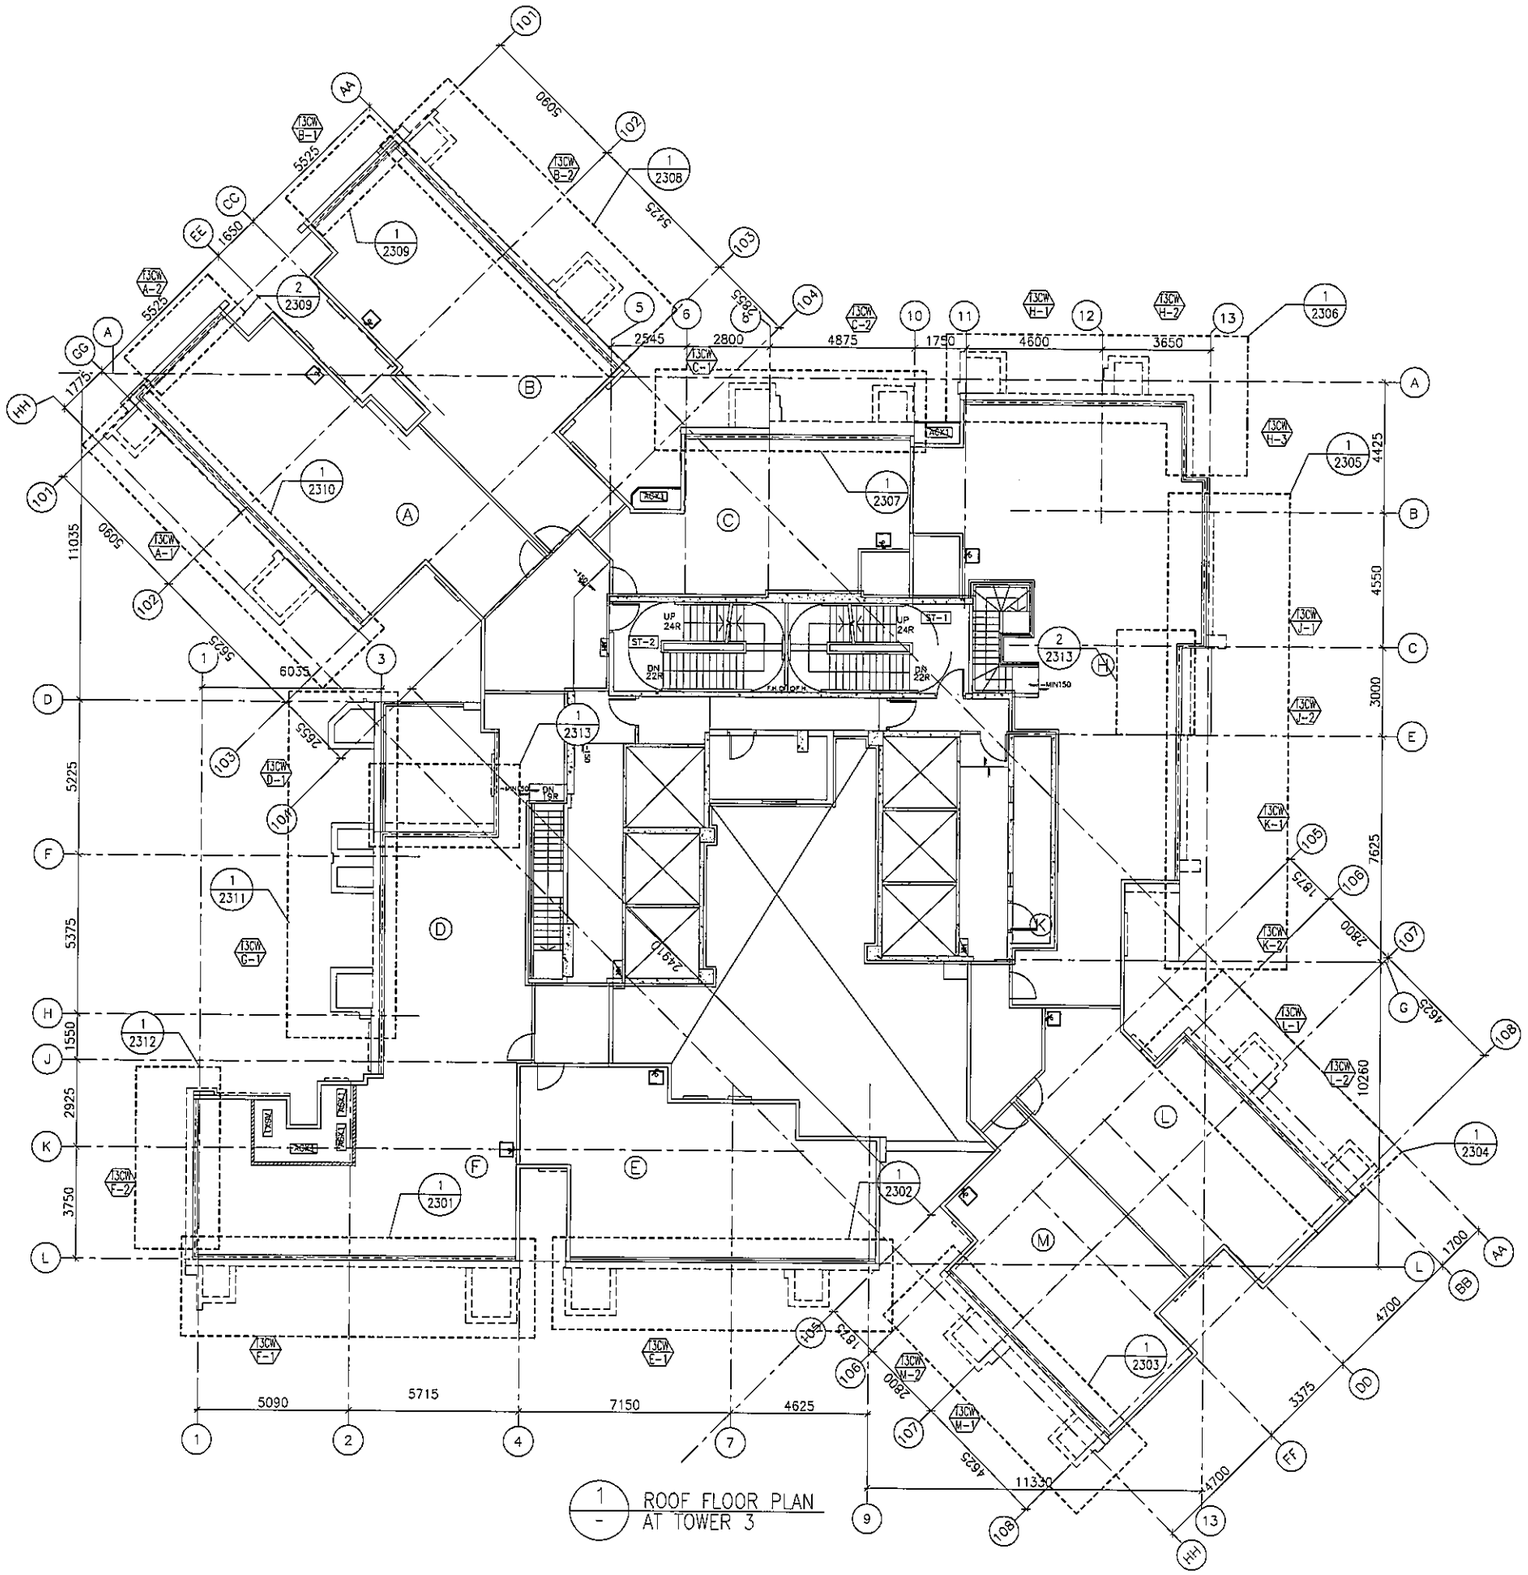

1 / - ROOF FLOOR PLAN AT TOWER 3

FLOOR LEVEL (S.F.L.)(T3)

FLOOR NUMBERING	LEVEL (mPD)
RF	+171.700

B.D. REF :

CLIENT :
信和置業有限公司
Sino Land Company Limited

ARCHITECT : WONG TUNG & PARTNERS LIMITED ARCHITECTS & PLANNERS

MAIN CONTRACTOR :
CR Construction Company Limited

STRUCTURAL ENGINEER :
AECOM

FACADE CONSULTANT:
AECOM

NOTE :
1. ALL DIMENSIONS ARE IN mm.
2. ALL ELEVATIONS ARE VIEWED FROM OUTSIDE.
3. ALL DIMENSIONS TO BE VERIFIED ON SITE BEFORE FABRICATION.

LEGEND :
X1 — DETAIL MARK NO.
X001 — REFER SHEET NO.

1. F.F.L. --FINISHED FLOOR LEVEL
2. S.F.L. --STRUCTURAL FLOOR LEVEL
3. /R --REVERSED DETAIL

NO.	DATE	REVISED	BY
A	16/07/2019	GENERAL REVISED	

JOB NO. : J-837

PROJECT :
URA KWUN TONG TOWN CENTRE REDEVELOPMENT (AREA 2 & 3) AT NKIL 6514, KWUN TONG, KWLOON

TITLE :
ROOF FLOOR PLAN OF CURTAIN WALL AT TOWER 3

DATE : 10-SEP-18 | SCALE : 1:100 (A1)

DRAWN BY : ASING | CHECKED BY : -

美特鋁製有限公司
MIDI ALUMINIUM FABRICATOR LTD.
Units 6-8, Sunray Industrial Centre, 1/F
610 Cha Kwo Ling Road, Kowloon
Tel:23489211-4 Fax:(852)27727666

DWG NO. : J837-CW-3304 | REV. : A

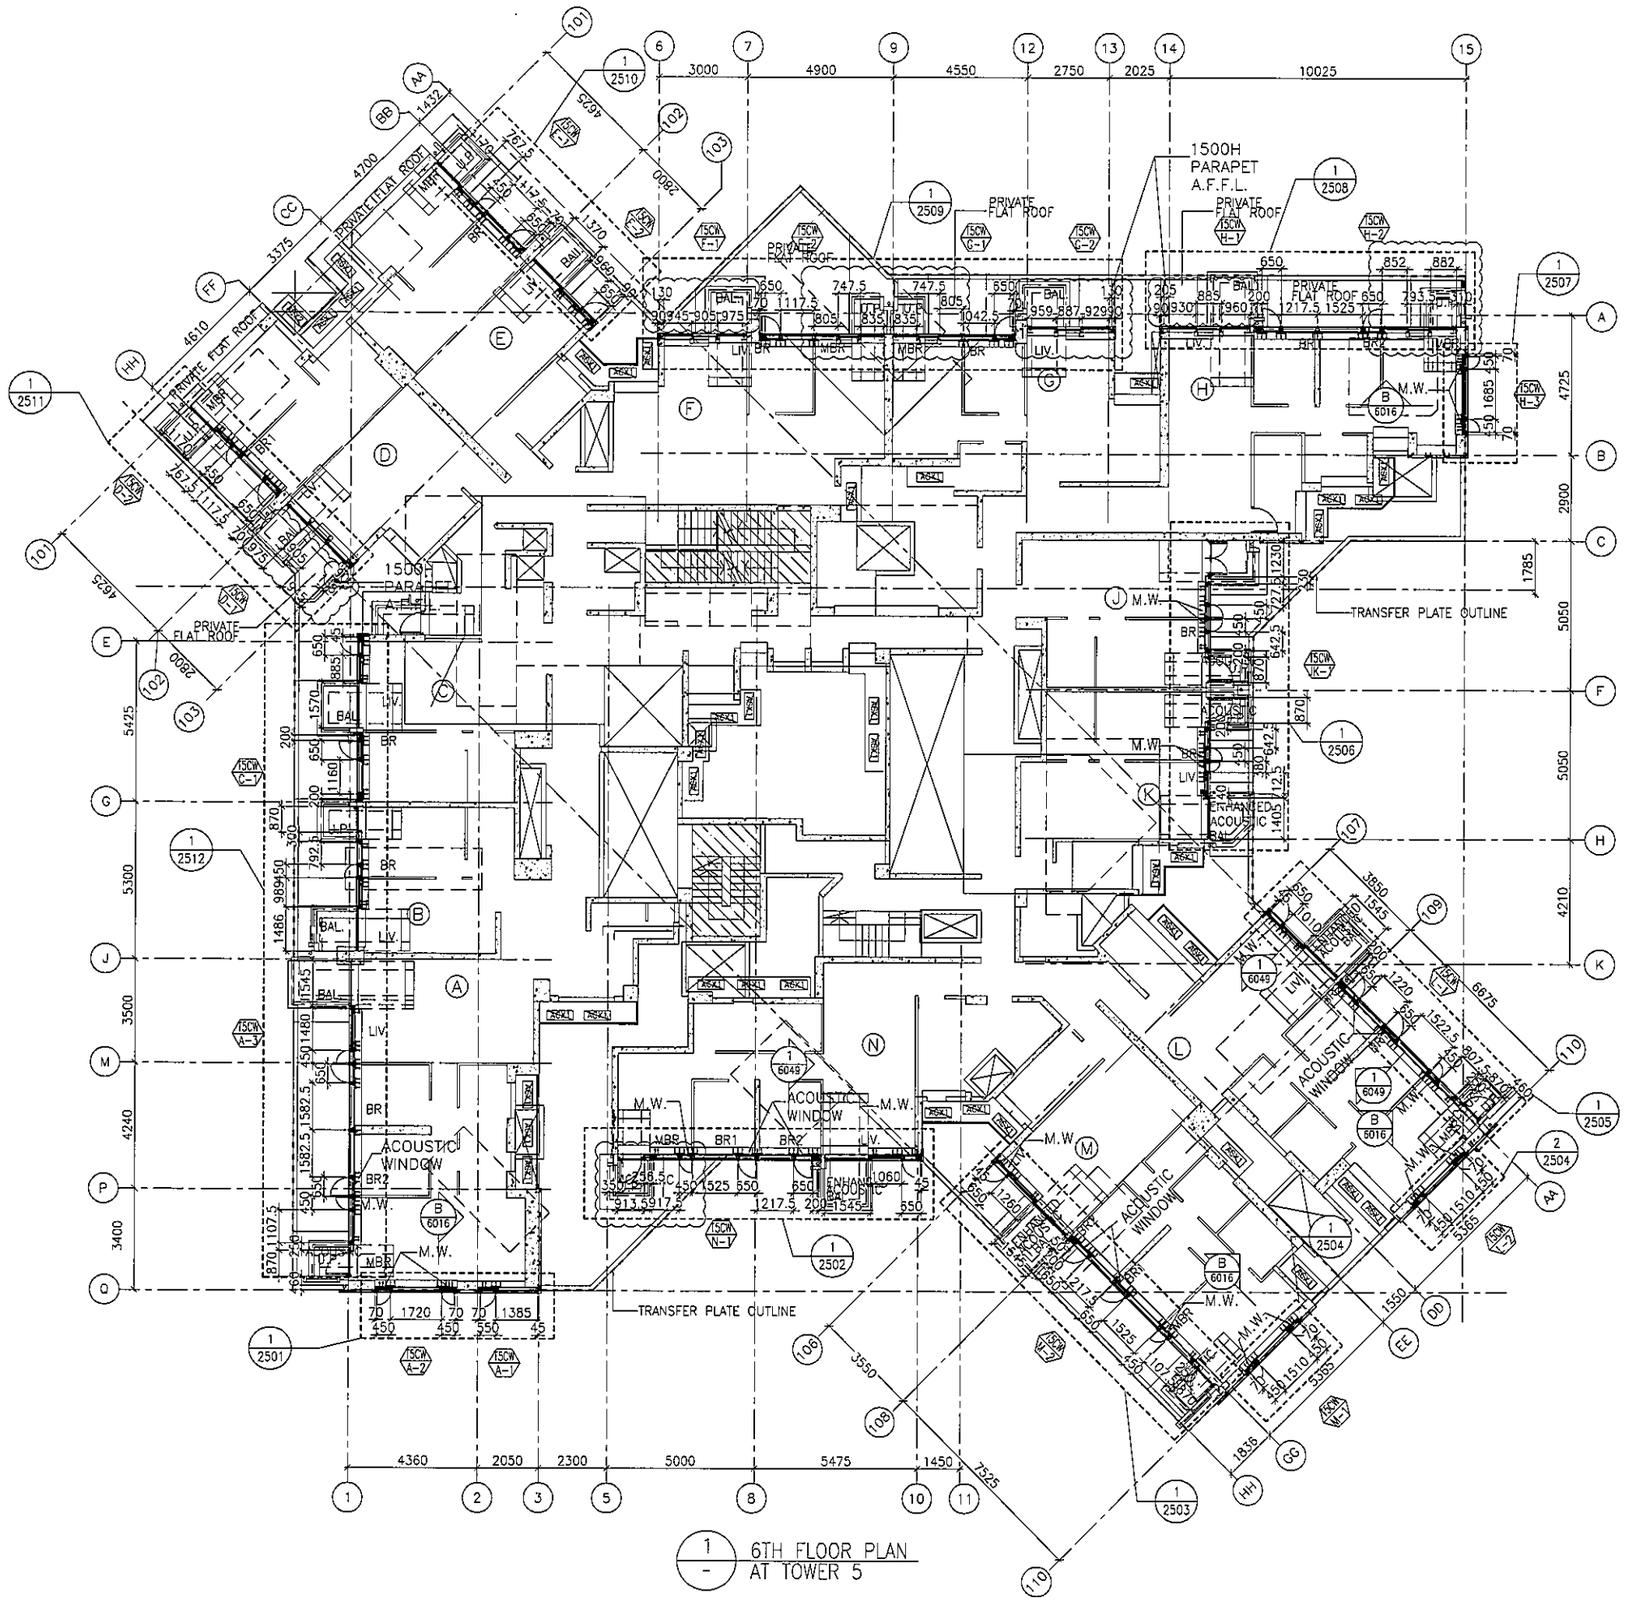

FLOOR LEVEL (S.F.L.)(T3)

FLOOR NUMBERING	LEVEL (mPD)
6/F	+38.900

B.D. REF :

CLIENT :
信和置業有限公司
Sino Land Company Limited

ARCHITECT :
WONG TUNG & PARTNERS LIMITED
ARCHITECTS & PLANNERS

MAIN CONTRACTOR :
CR Construction Company Limited

STRUCTURAL ENGINEER :
AECOM

FACADE CONSULTANT:
AECOM

NOTE :
1. ALL DIMENSIONS ARE IN mm.
2. ALL ELEVATIONS ARE VIEWED FROM OUTSIDE.
3. ALL DIMENSIONS TO BE VERIFIED ON SITE BEFORE FABRICATION.

LEGEND :
X1 — DETAIL MARK NO.
X001 — REFER SHEET NO.

1. F.F.L. --FINISHED FLOOR LEVEL
2. S.F.L. --STRUCTURAL FLOOR LEVEL
3. /R --REVERSED DETAIL

NO.	DATE	REVISED	BY
I	18/08/2019	GENERAL REVISED	
H	26/05/2019	GENERAL REVISED	
G	19/01/2019	GENERAL REVISED	
F	22/12/2018	GENERAL REVISED	
E	24/11/2018	GENERAL REVISED	
D	11/10/2018	GENERAL REVISED	
C	8/10/2018	GENERAL REVISED	
B	28/9/2018	GENERAL REVISED	
A	10/9/2018	GENERAL REVISED	

JOB NO. : J-837

PROJECT :
URA KWUN TONG TOWN CENTRE REDEVELOPMENT (AREA 2 & 3) AT NKIL 6514, KWUN TONG, KWLOON

TITLE :
6TH FLOOR PLAN OF CURTAIN WALL AT TOWER 5

DATE : 04-JUL-18 | SCALE : 1:100 (A1)

DRAWN BY : ASING | CHECKED BY : -

美特鋁質有限公司
MIDI ALUMINIUM FABRICATOR LTD.
Units 6-8, Sunray Industrial Centre, 1/F
610 Cha Kwo Ling Road, Kowloon
Tel:23489211-4 Fax:(852)27727666

DWG NO. : J837-CW-3501 | REV. : I

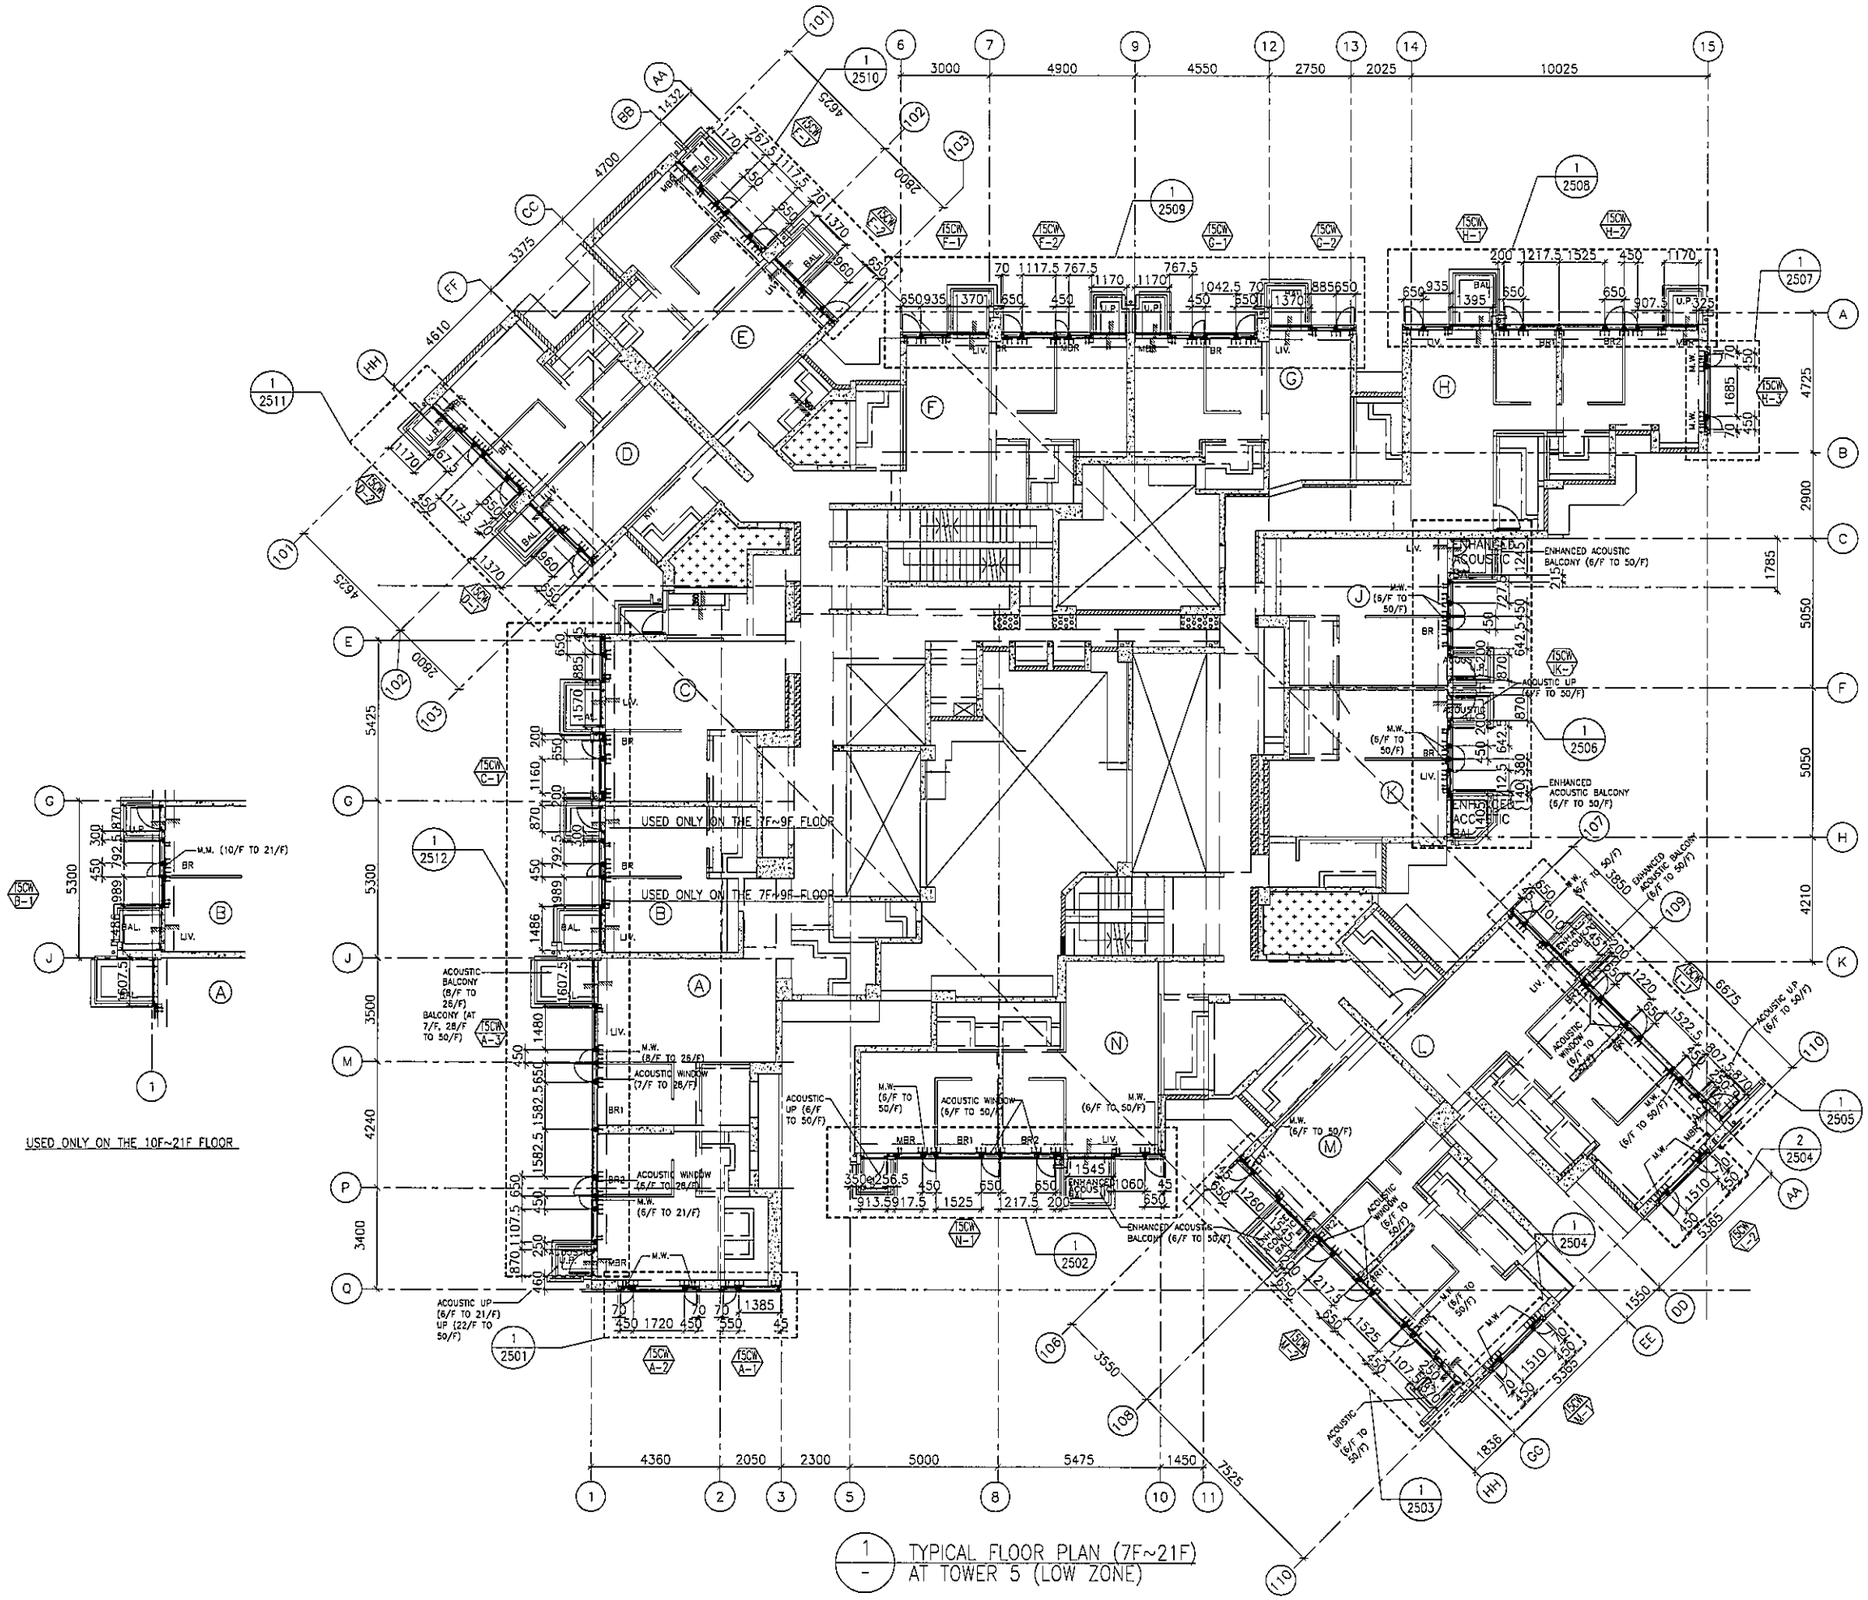
USED ONLY ON THE 7F~9F FLOOR
USED ONLY ON THE 7F~9F FLOOR
USED ONLY ON THE 10F~21F FLOOR
ENHANCED ACOUSTIC BALCONY (6/F TO 50/F)
ENHANCED ACOUSTIC BALCONY (6/F TO 50/F)
ACOUSTIC BALCONY (6/F TO 26/F) BALCONY (AT 7/F, 28/F TO 50/F)
ACOUSTIC UP (6/F TO 21/F) UP (22/F TO 50/F)
ACOUSTIC UP (6/F TO 50/F)
ACOUSTIC WINDOW (7/F TO 26/F)
ACOUSTIC WINDOW (6/F TO 21/F)
M.W. (10/F TO 21/F)
M.W. (6/F TO 26/F)
M.W. (6/F TO 21/F)
M.W. (6/F TO 50/F)
ENHANCED ACOUSTIC BALCONY (6/F TO 50/F)
ENHANCED ACOUSTIC BALCONY (6/F TO 50/F)
ACOUSTIC UP (6/F TO 50/F)
ACOUSTIC WINDOW (6/F TO 50/F)
ENHANCED ACOUSTIC BALCONY (6/F TO 50/F)
ACOUSTIC UP (6/F TO 50/F)
ACOUSTIC WINDOW (6/F TO 50/F)
ACOUSTIC UP (6/F TO 50/F)
ENHANCED ACOUSTIC BALCONY (6/F TO 50/F)
ACOUSTIC UP (6/F TO 50/F)
ACOUSTIC WINDOW

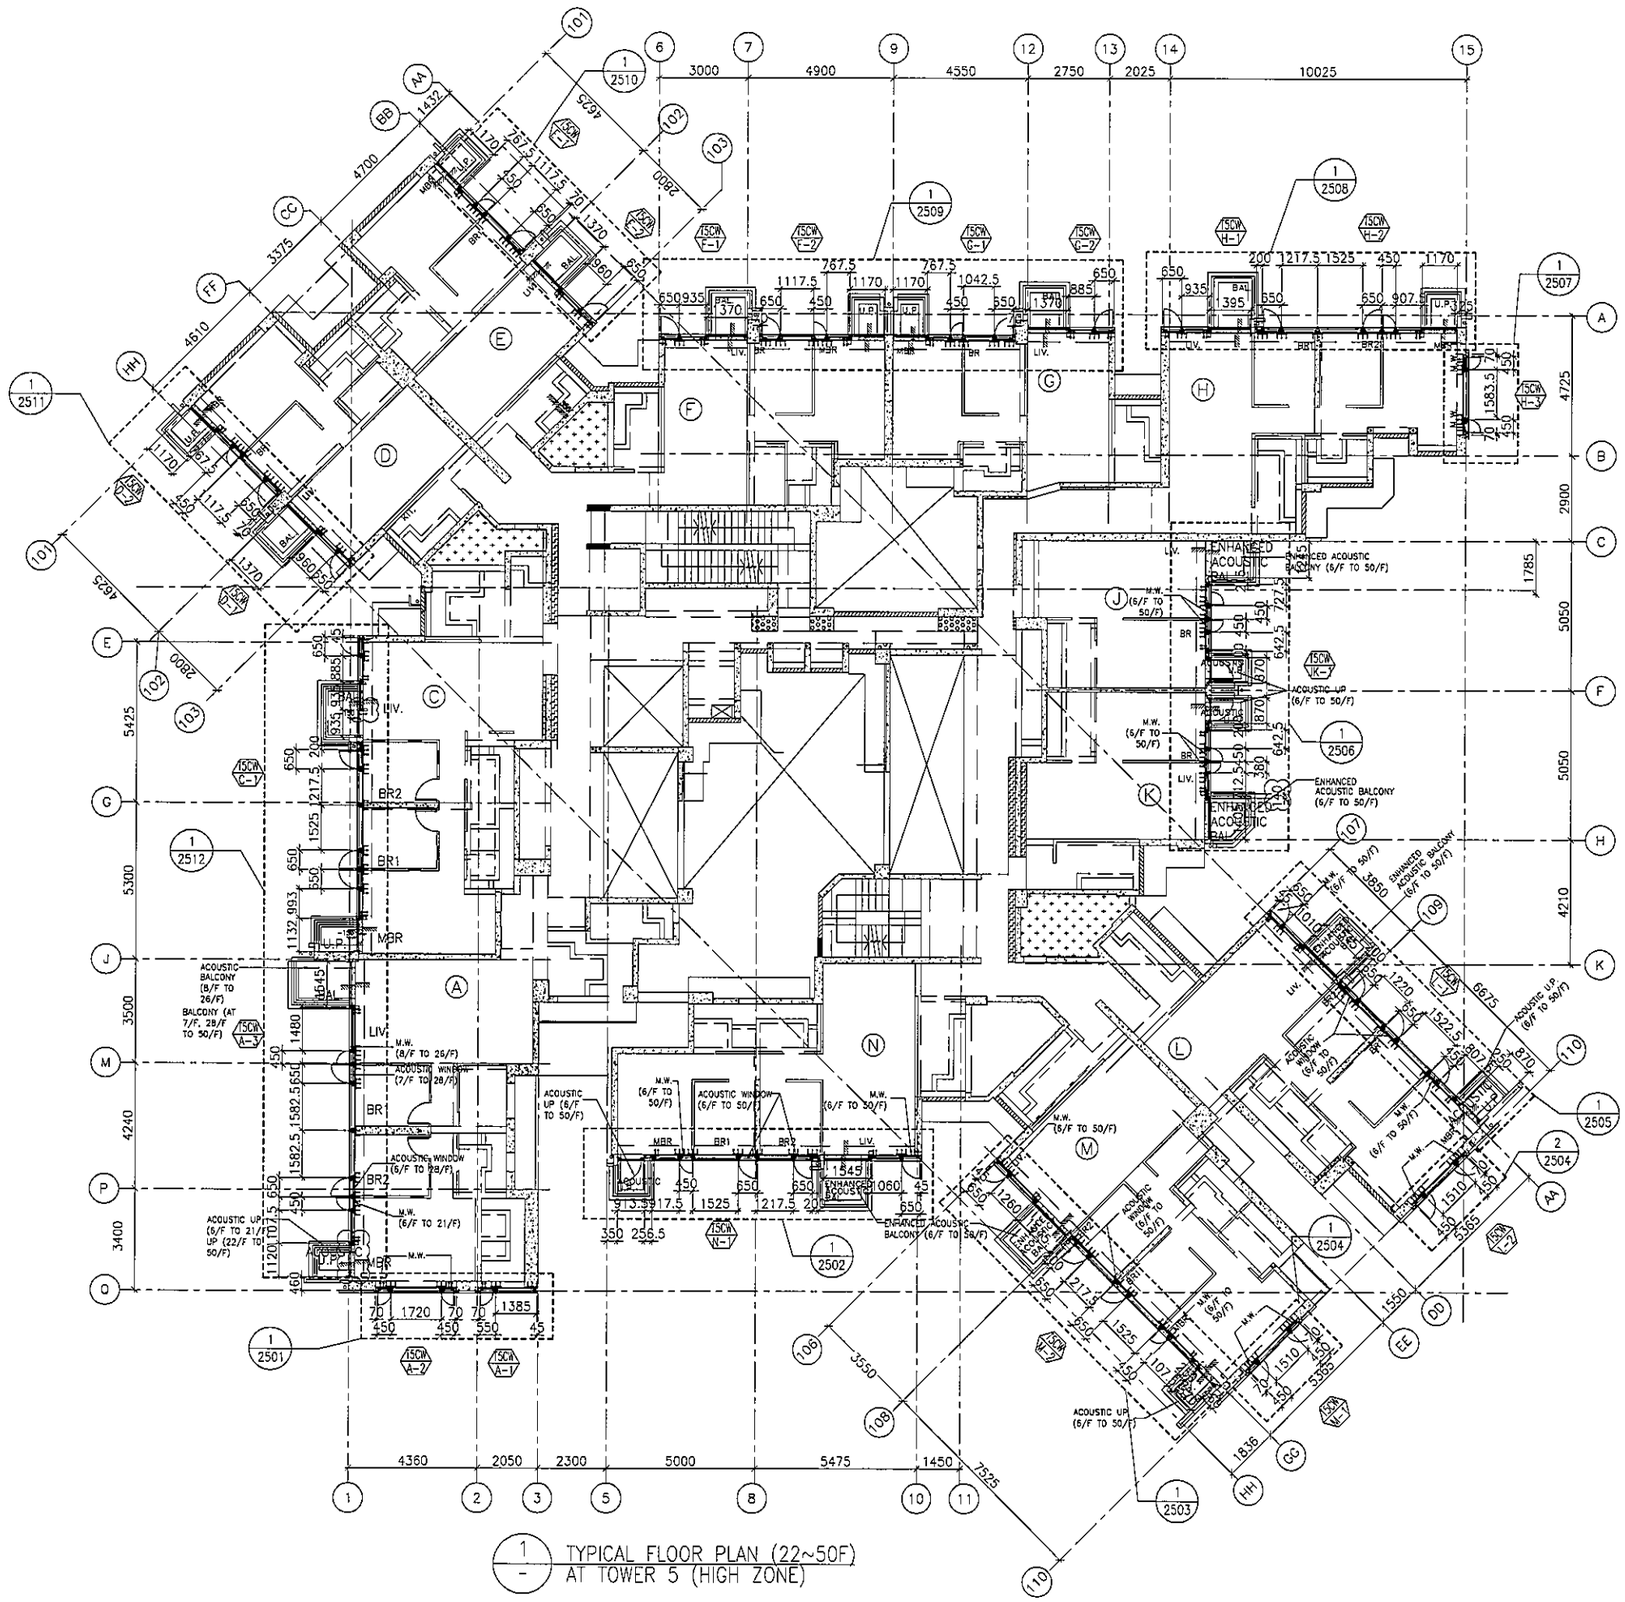

1 / - TYPICAL FLOOR PLAN (22~50F) AT TOWER 5 (HIGH ZONE)

FLOOR LEVEL (S.F.L.)(T5)

FLOOR NUMBERING	LEVEL (mPD)
22F	83.350
23F	86.500
25F	89.650
26F	92.800
28F	99.250
29F	102.250
30F	105.400
31F	108.550
32F	111.700
33F	114.850
35F	118.000
36F	121.150
37F	124.300
38F	127.450
39F	130.600
40F	133.750
41F	136.900
42F	140.050
43F	143.100
45F	146.350
46F	149.500
47F	152.650
48F	155.800
49F	158.950
50F	162.100

B.D. REF :

CLIENT :
信和置業有限公司
Sino Land Company Limited

ARCHITECT :
WONG TUNG & PARTNERS LIMITED
ARCHITECTS & PLANNERS

MAIN CONTRACTOR :
CR Construction Company Limited

STRUCTURAL ENGINEER :
AECOM

FACADE CONSULTANT:
AECOM

NOTE :
1. ALL DIMENSIONS ARE IN mm.
2. ALL ELEVATIONS ARE VIEWED FROM OUTSIDE.
3. ALL DIMENSIONS TO BE VERIFIED ON SITE BEFORE FABRICATION.

LEGEND :
X1 — DETAIL MARK NO.
X00 / — REFER SHEET NO.

1. F.F.L. --FINISHED FLOOR LEVEL
2. S.F.L. --STRUCTURAL FLOOR LEVEL
3. /R --REVERSED DETAIL

NO.	DATE	REVISED	BY
E	19/01/2019	GENERAL REVISED	
D	22/12/2018	GENERAL REVISED	
C	24/11/2018	GENERAL REVISED	
B	11/10/2018	GENERAL REVISED	
A	8/10/2018	GENERAL REVISED	

JOB NO. : J-837

PROJECT :
URA KWUN TONG TOWN CENTRE REDEVELOPMENT (AREA 2 & 3) AT NKIL 6514, KWUN TONG, KWLOON

TITLE :
TYPICAL FLOOR PLAN (22~50F) OF CURTAIN WALL AT TOWER 5

DATE : 10-SEP-18 | SCALE : 1:100 (A1)

DRAWN BY : ASING | CHECKED BY : -

美特鋁質有限公司
MIDI ALUMINIUM FABRICATOR LTD.
Units 6-8, Sunray Industrial Centre, 1/F
610 Cha Kwo Ling Road, Kowloon
Tel:23489211-4 Fax:(852)27727666

DWG NO. : J837-CW-3503 | REV. : E

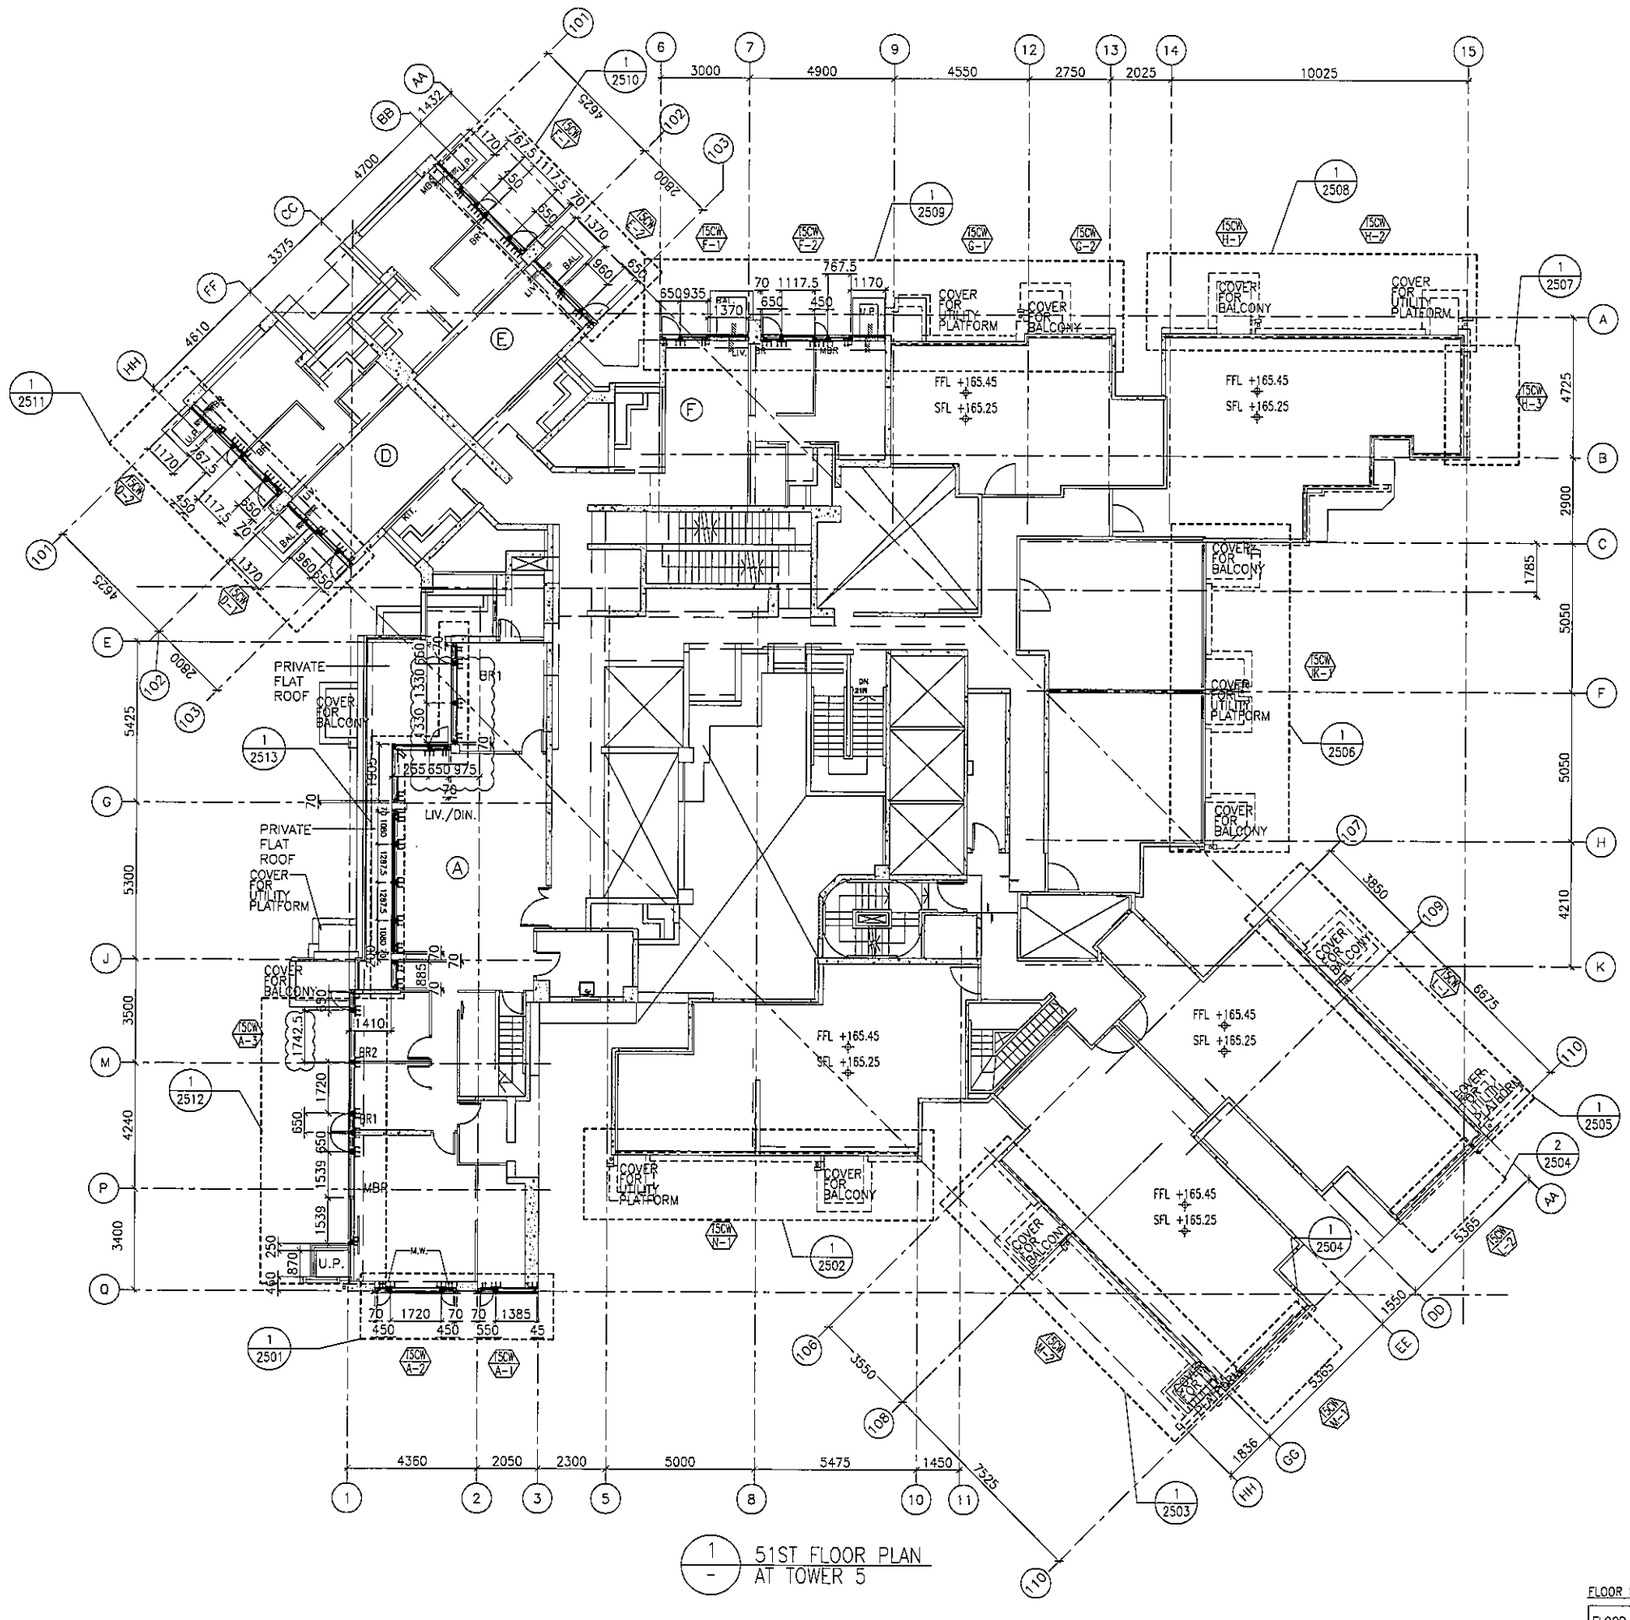

1 / - 51ST FLOOR PLAN AT TOWER 5

FLOOR LEVEL (S.F.L.)(T3)

FLOOR NUMBERING	LEVEL (mPD)
51F	+165.250/+165.550

B.D. REF :

CLIENT :
信和置業有限公司
Sino Land Company Limited

ARCHITECT :
WONG TUNG & PARTNERS LIMITED
ARCHITECTS & PLANNERS

MAIN CONTRACTOR :
CR Construction Company Limited

STRUCTURAL ENGINEER :
AECOM

FACADE CONSULTANT:
AECOM

NOTE :
1. ALL DIMENSIONS ARE IN mm.
2. ALL ELEVATIONS ARE VIEWED FROM OUTSIDE.
3. ALL DIMENSIONS TO BE VERIFIED ON SITE BEFORE FABRICATION.

LEGEND :
- X1 / XD01 — DETAIL MARK NO. / REFER SHEET NO.
1. F.F.L. --FINISHED FLOOR LEVEL
2. S.F.L. --STRUCTURAL FLOOR LEVEL
3. /R --REVERSED DETAIL

NO.	DATE	REVISED	BY
D	03/06/2019	GENERAL REVISED	
C	23/05/2019	GENERAL REVISED	
B	07/04/2019	GENERAL REVISED	
A	22/12/2018	GENERAL REVISED	

JOB NO. : J-837

PROJECT :
URA KWUN TONG TOWN CENTRE REDEVELOPMENT (AREA 2 & 3) AT NKIL 6514, KWUN TONG, KWLOON

TITLE :
51ST FLOOR PLAN OF CURTAIN WALL AT TOWER 5

DATE : 10-SEP-18 | SCALE : 1:100 (A1)

DRAWN BY : ASING | CHECKED BY : -

美特鋁質有限公司
MIDI ALUMINIUM FABRICATOR LTD.
Units 6-8, Sunray Industrial Centre, 1/F
610 Cha Kwo Ling Road, Kowloon
Tel:23489211-4 Fax:(852)27727666

DWG NO. : J837--CW-3504 | REV. : D

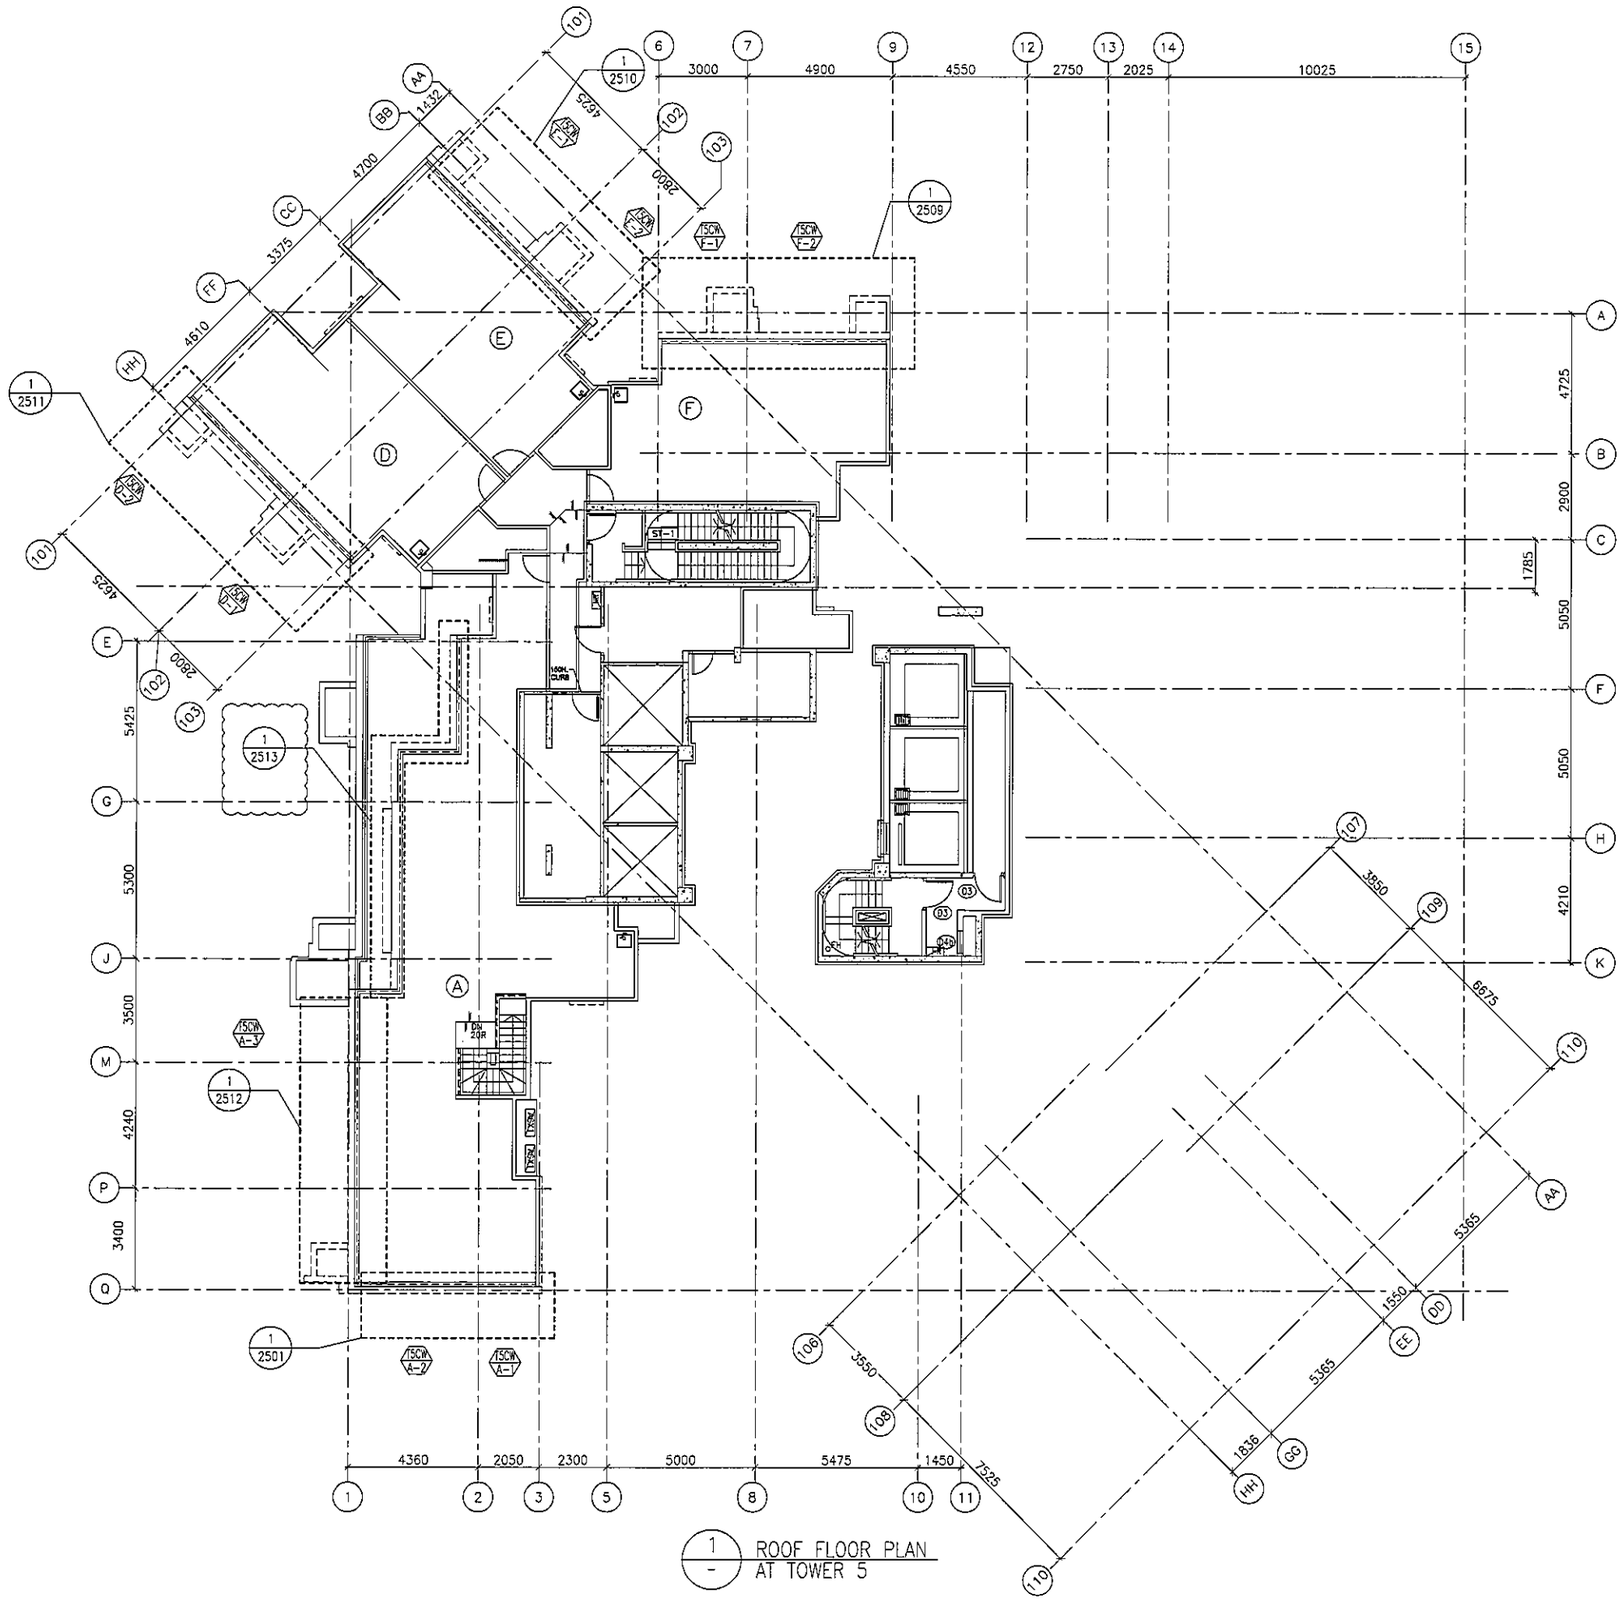

FLOOR LEVEL (S.F.L.)(T3)

FLOOR NUMBERING	LEVEL (mPD)
RF	+168.850

B.D. REF :

CLIENT :
信和置業有限公司
Sino Land Company Limited

ARCHITECT :
WONG TUNG & PARTNERS LIMITED
ARCHITECTS & PLANNERS

MAIN CONTRACTOR :
CR Construction Company Limited

STRUCTURAL ENGINEER :
AECOM

FACADE CONSULTANT:
AECOM

NOTE :
1. ALL DIMENSIONS ARE IN mm.
2. ALL ELEVATIONS ARE VIEWED FROM OUTSIDE.
3. ALL DIMENSIONS TO BE VERIFIED ON SITE BEFORE FABRICATION.

LEGEND :
X1 / X001 — DETAIL MARK NO. / REFER SHEET NO.
1. F.F.L. --FINISHED FLOOR LEVEL
2. S.F.L. --STRUCTURAL FLOOR LEVEL
3. /R --REVERSED DETAIL

NO.	DATE	REVISED	BY
B	16/07/2019	GENERAL REVISED	
A	22/12/2018	GENERAL REVISED	

JOB NO. : J-837

PROJECT :
URA KWUN TONG TOWN CENTRE REDEVELOPMENT (AREA 2 & 3) AT NKIL 6514, KWUN TONG, KWLOON

TITLE :
ROOF FLOOR PLAN OF CURTAIN WALL AT TOWER 5

DATE : 10-SEP-18	SCALE : 1:100 (A1)
DRAWN BY : ASING	CHECKED BY : -

美特鋁質有限公司
MIDI ALUMINIUM FABRICATOR LTD.
Units 6-8, Sunray Industrial Centre, 1/F
610 Cha Kwo Ling Road, Kowloon
Tel:23489211-4 Fax:(852)27727666

DWG NO. : J837-CW-3505 REV. : B

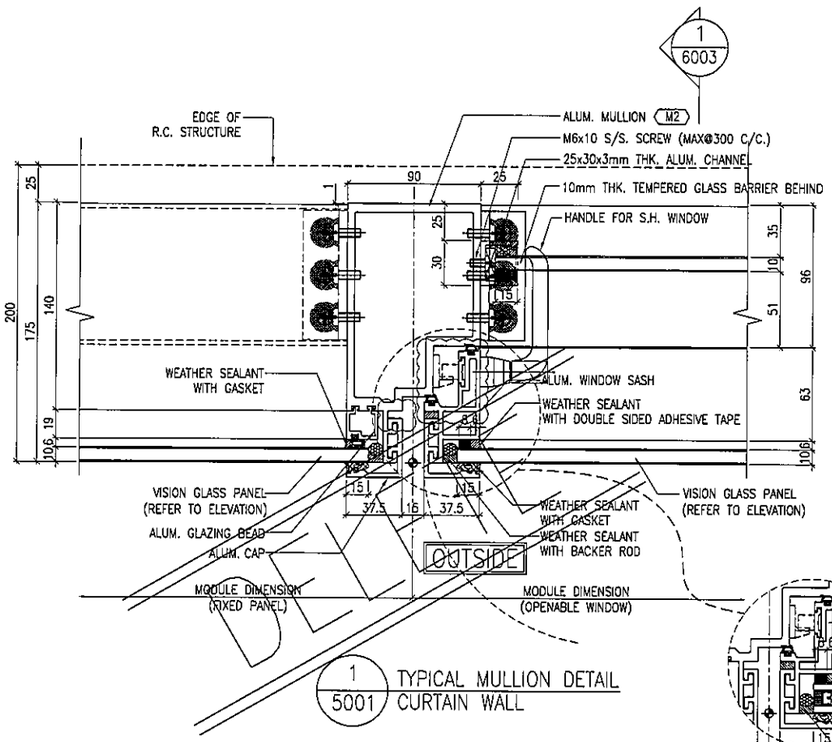

1 / 6003

1 / 5001 TYPICAL MULLION DETAIL CURTAIN WALL

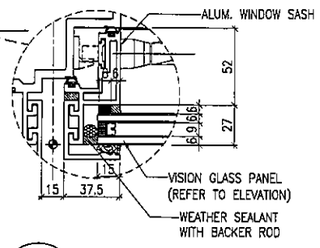

1A / 5001 TYPICAL MULLION DETAIL CURTAIN WALL

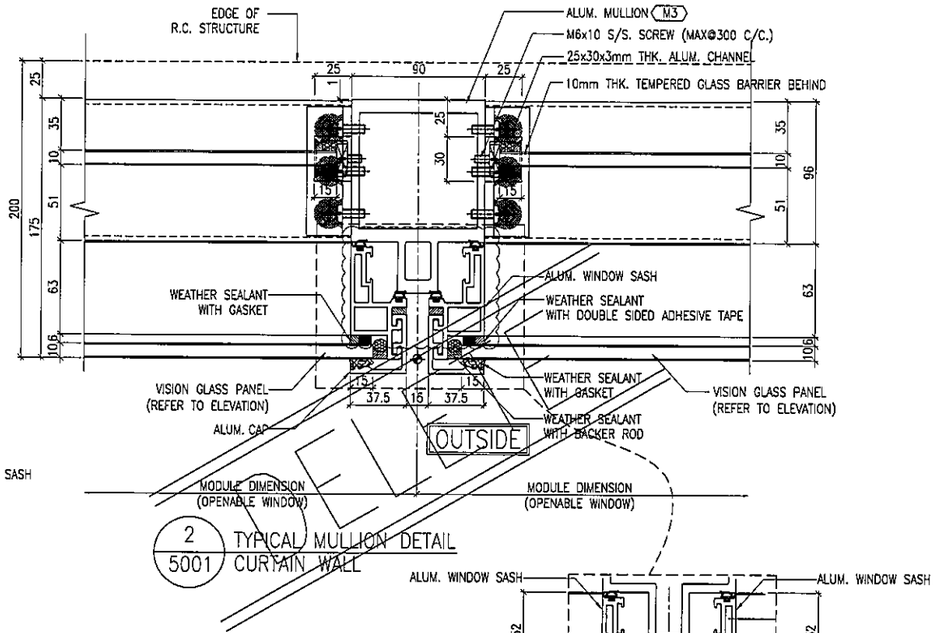

2 / 5001 TYPICAL MULLION DETAIL CURTAIN WALL

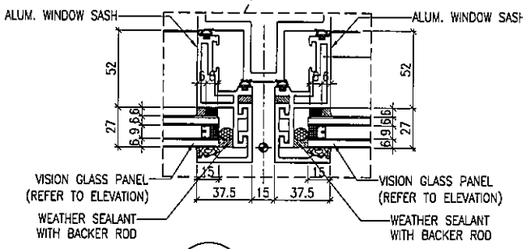

2A / 5001 TYPICAL MULLION DETAIL CURTAIN WALL

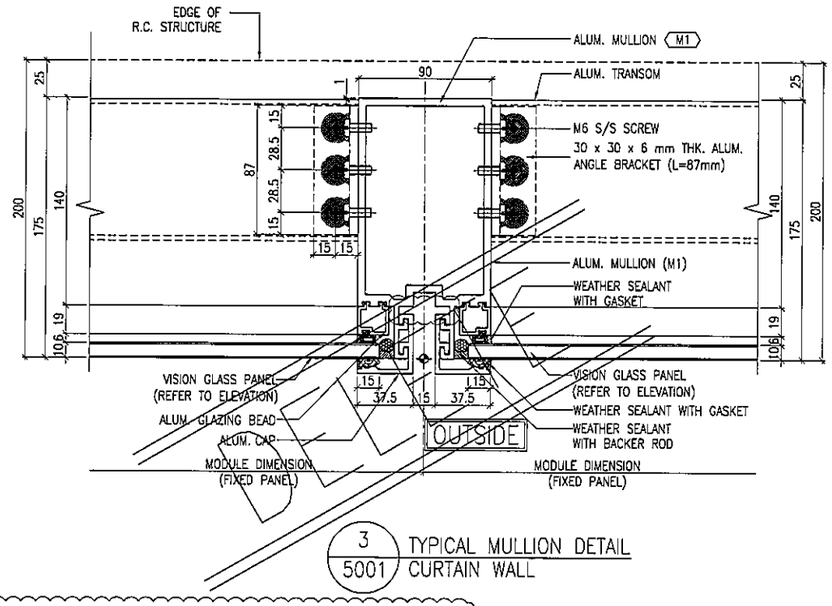

3 / 5001 TYPICAL MULLION DETAIL CURTAIN WALL

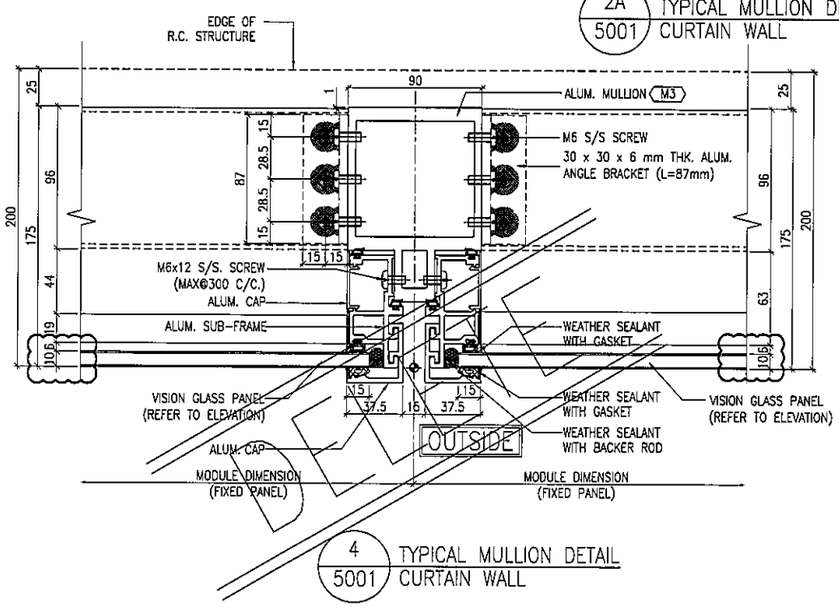

4 / 5001 TYPICAL MULLION DETAIL CURTAIN WALL

THOSE DETAILS WILL SAME AS 5002, BECAUSE GLASS WILL CHANGE TO IGU GLASS.

B.D. REF :

CLIENT :
信和置業有限公司
Sino Land Company Limited

ARCHITECT :
WONG TUNG & PARTNERS LIMITED
ARCHITECTS & PLANNERS

MAIN CONTRACTOR :
CR Construction Company Limited

STRUCTURAL ENGINEER :
AECOM

FACADE CONSULTANT:
AECOM

NOTE :
1. ALL DIMENSIONS ARE IN mm.
2. ALL ELEVATIONS ARE VIEWED FROM OUTSIDE.
3. ALL DIMENSIONS TO BE VERIFIED ON SITE BEFORE FABRICATION.

LEGEND :
X1 / X001 — DETAIL MARK NO. / REFER SHEET NO.
1. F.F.L. --FINISHED FLOOR LEVEL
2. S.F.L. --STRUCTURAL FLOOR LEVEL
3. (R) --REVERSED DETAIL

NO.	DATE	REVISED	BY
B	24/11/2018	GENERAL REVISED	
A	10/9/2018	GENERAL REVISED	

JOB NO. : J-837

PROJECT :
URA KWUN TONG TOWN CENTRE REDEVELOPMENT (AREA 2 & 3) AT NKIL 6514, KWUN TONG, KWLOON

TITLE :
TYPICAL MULLION DETAIL FOR CURTAIN WALL

DATE : 13-JUL-18 | SCALE : 1:2 (A1)

DRAWN BY : ASING | CHECKED BY : -

美特鋁質有限公司
MIDI ALUMINIUM FABRICATOR LTD.
Units 6-8, Sunray Industrial Centre, 1/F
610 Cha Kwo Ling Road, Kowloon
Tel:23489211-4 Fax:(852)27727666

DWG NO. : J837-CW-5001 | REV. : B

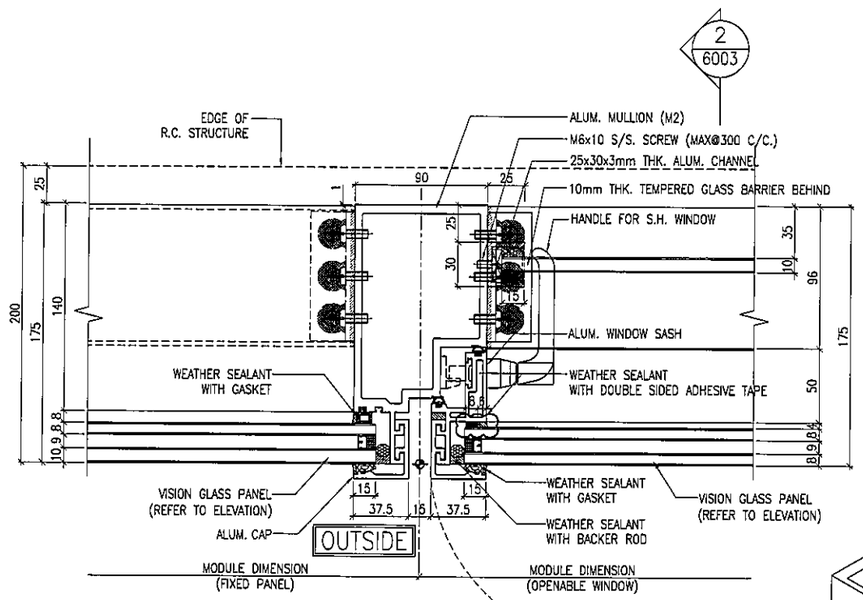

1 / 5002 TYPICAL MULLION DETAIL CURTAIN WALL

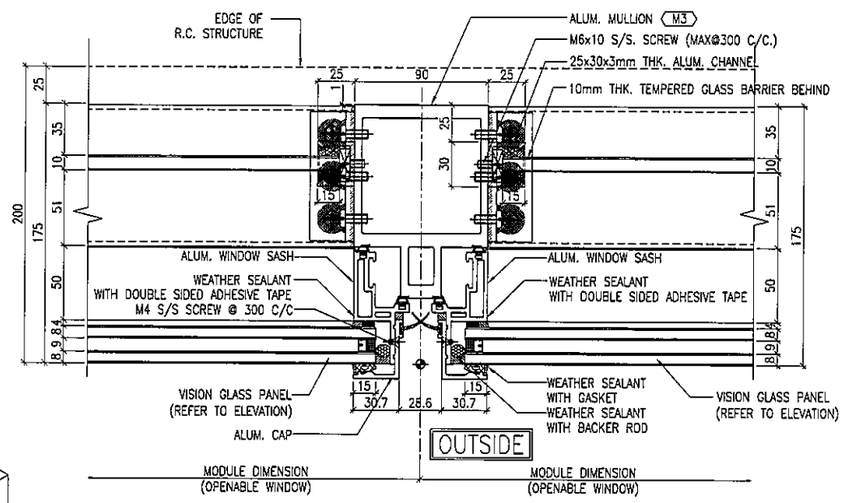

2 / 5002 TYPICAL MULLION DETAIL CURTAIN WALL

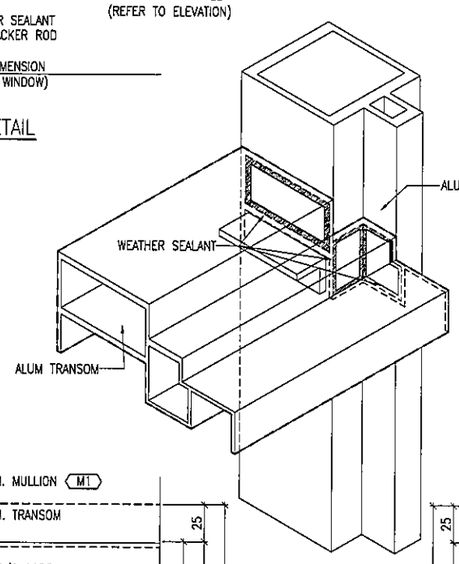

CONNETION BETWEEN MULLION AND TRAMSOM
WITH WEATHER SEALANT.(APPLY ON ALL MULLION
AND TRANSOM CONNETION)

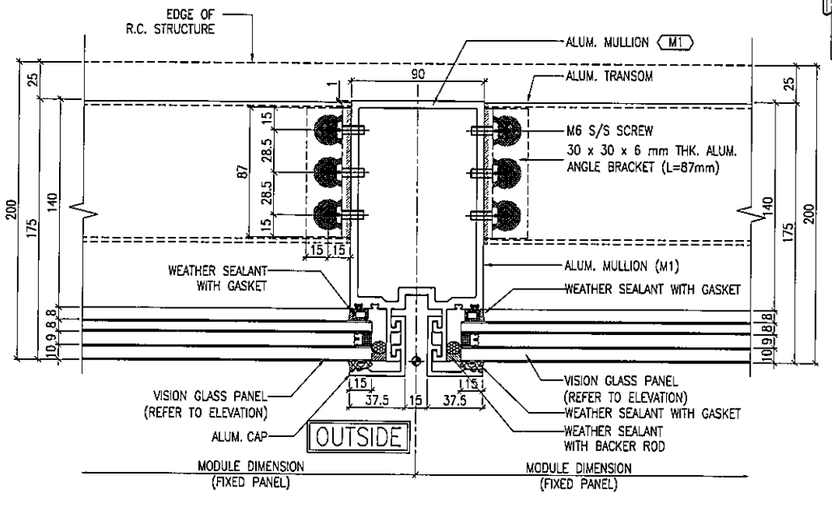

3 / 5002 TYPICAL MULLION DETAIL CURTAIN WALL

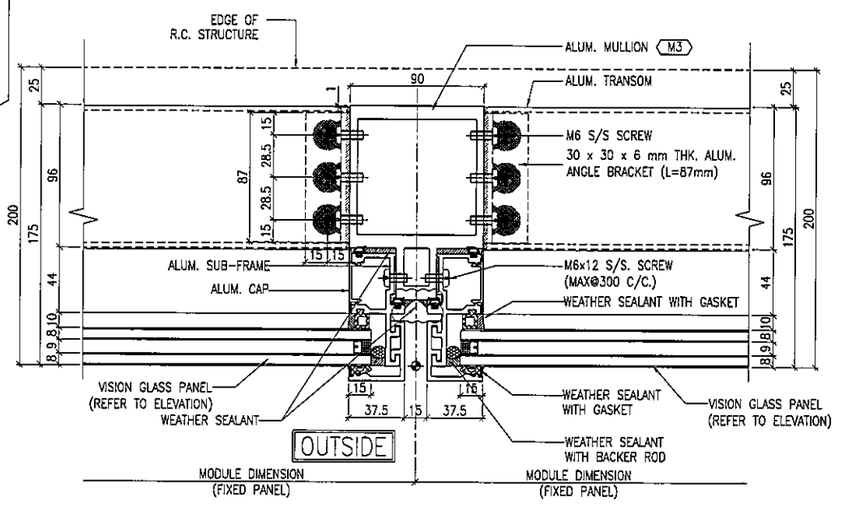

4 / 5002 TYPICAL MULLION DETAIL CURTAIN WALL

B.O. REF :

CLIENT :
信和置業有限公司
Sino Land Company Limited

ARCHITECT :
WONG TUNG & PARTNERS LIMITED
ARCHITECTS & PLANNERS

MAIN CONTRACTOR :
CR Construction Company Limited

STRUCTURAL ENGINEER :
AECOM

FACADE CONSULTANT:
AECOM

NOTE :
1. ALL DIMENSIONS ARE IN mm.
2. ALL ELEVATIONS ARE VIEWED FROM OUTSIDE.
3. ALL DIMENSIONS TO BE VERIFIED ON SITE BEFORE FABRICATION.

LEGEND :
X1 — DETAIL MARK NO.
X001 — REFER SHEET NO.

1. F.F.L. --FINISHED FLOOR LEVEL
2. S.F.L. --STRUCTURAL FLOOR LEVEL
3. (R) --REVERSED DETAIL

NO.	DATE	REVISED	BY
D	15/8/2019	GENERAL REVISED	
C	22/12/2018	GENERAL REVISED	
B	24/11/2018	GENERAL REVISED	
A	10/9/2018	GENERAL REVISED	

JOB NO. : J-837

PROJECT :
URA KWUN TONG TOWN CENTRE
REDEVELOPMENT (AREA 2 & 3) AT
NKIL 6514, KWUN TONG, KWLOON

TITLE :
TYPICAL MULLION DETAIL
FOR CURTAIN WALL

DATE : 13-JUL-18 | SCALE : 1:2 (A1)

DRAWN BY : ASING | CHECKED BY : -

美特鋁製有限公司
MIDI ALUMINIUM FABRICATOR LTD.
Units 6-8, Sunray Industrial Centre, 1/F
610 Cha Kwo Ling Road, Kowloon
Tel:23489211-4 Fax:(852)27727666

DWG NO. : J837-CW-5002 | REV. : D

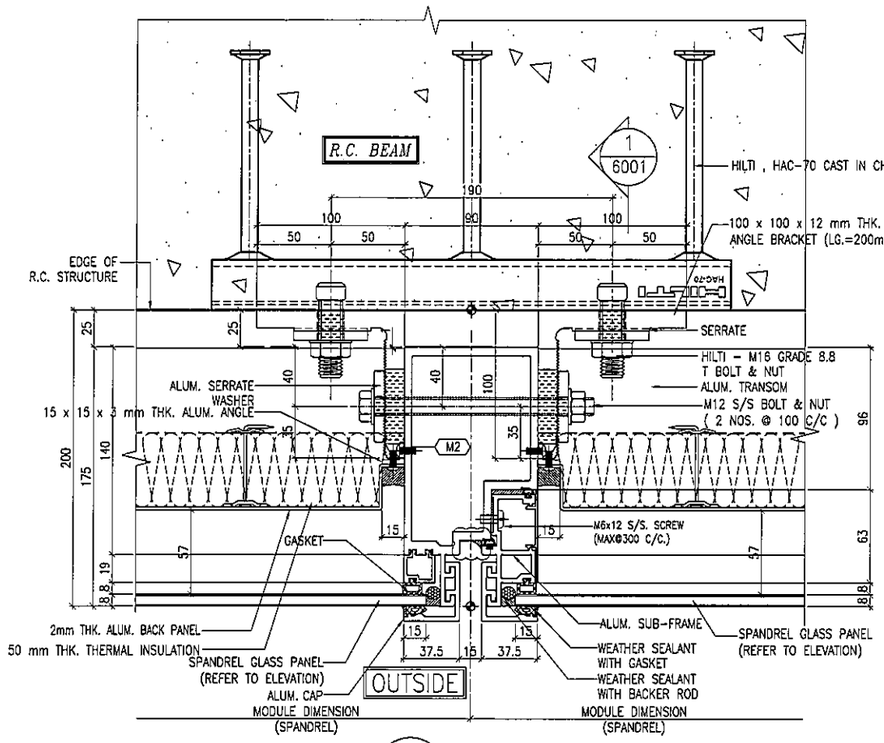

1 / 5003 TYPICAL MULLION DETAIL CURTAIN WALL

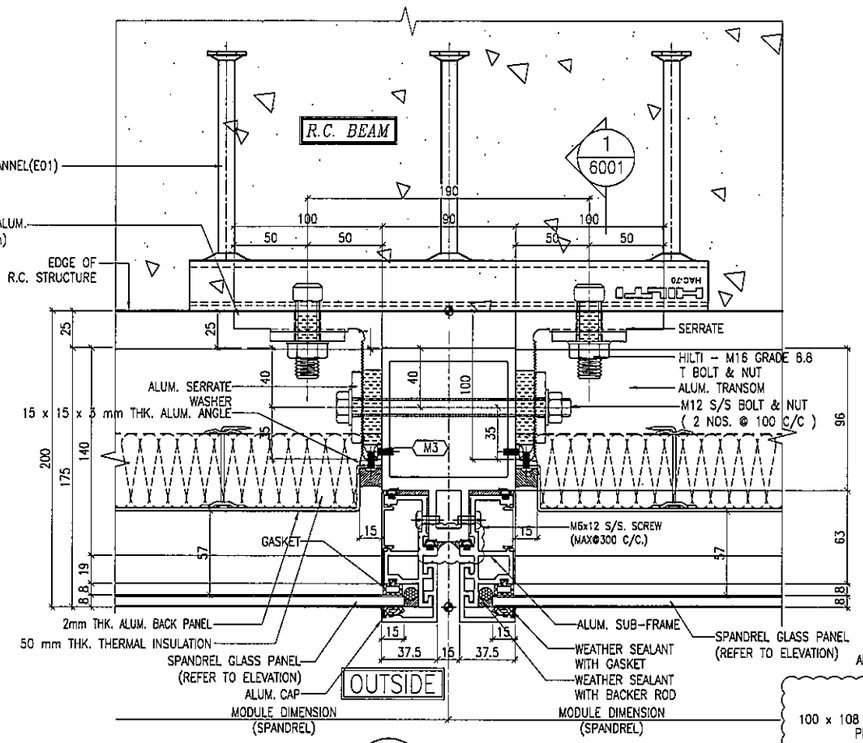

2 / 5003 TYPICAL MULLION DETAIL CURTAIN WALL

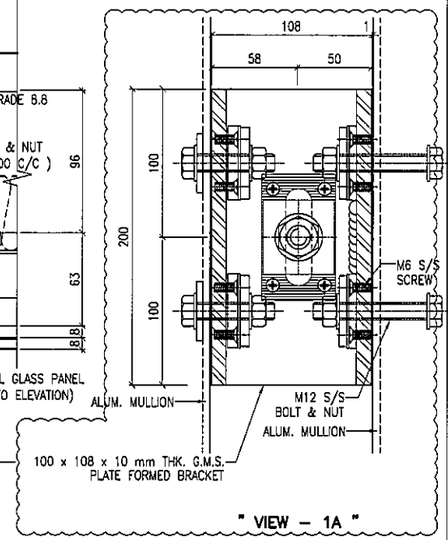

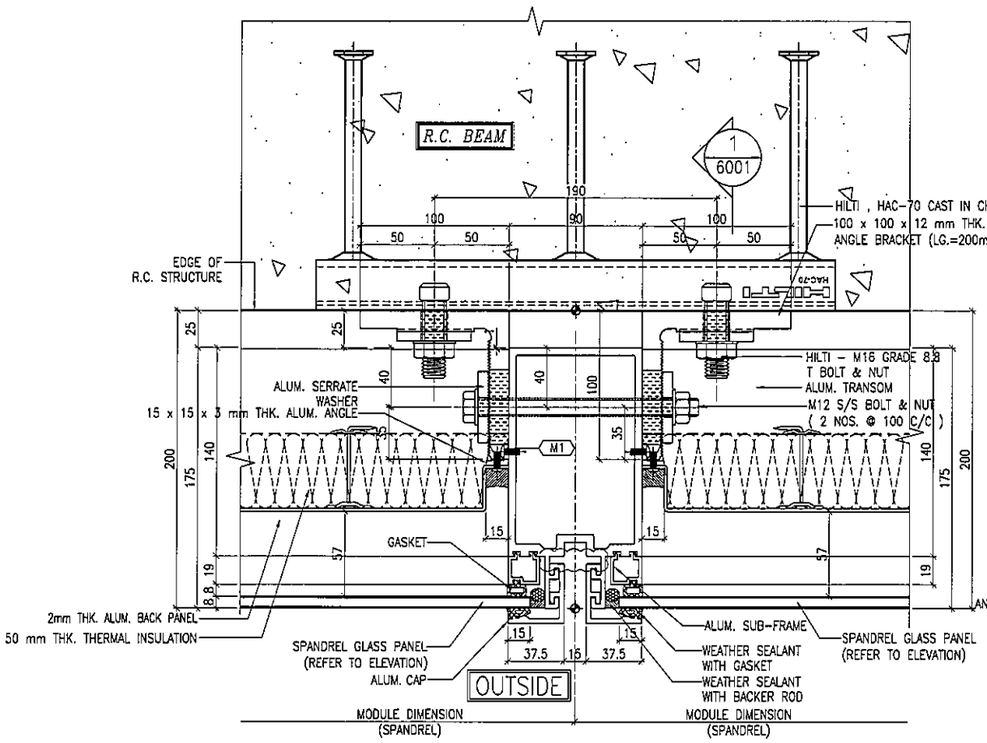

3 / 5003 TYPICAL MULLION DETAIL CURTAIN WALL

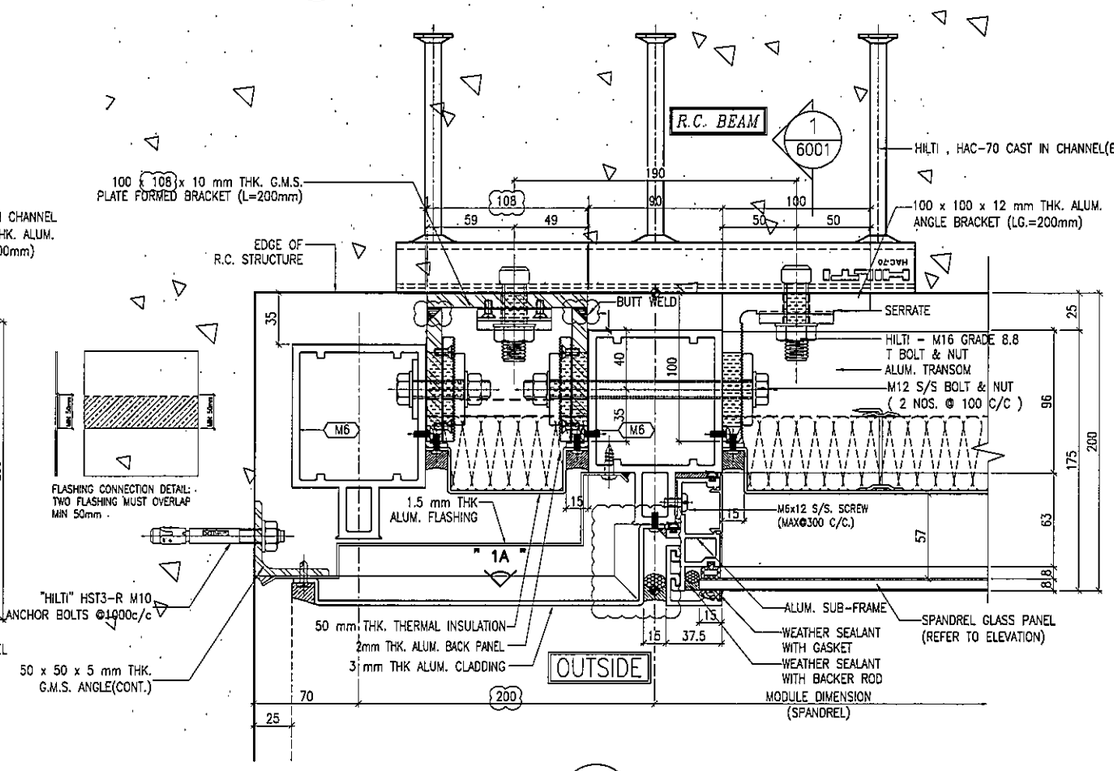

4 / 5003 TYPICAL MULLION DETAIL CURTAIN WALL

B.D. REF :

CLIENT : 信和置業有限公司 Sino Land Company Limited

ARCHITECT : WONG TUNG & PARTNERS LIMITED ARCHITECTS & PLANNERS

MAIN CONTRACTOR : CR Construction Company Limited

STRUCTURAL ENGINEER : AECOM

FACADE CONSULTANT: AECOM

NOTE :
1. ALL DIMENSIONS ARE IN mm.
2. ALL ELEVATIONS ARE VIEWED FROM OUTSIDE.
3. ALL DIMENSIONS TO BE VERIFIED ON SITE BEFORE FABRICATION.

LEGEND :

X1 / X001 — DETAIL MARK NO. / REFER SHEET NO.

1. F.F.L. --FINISHED FLOOR LEVEL
2. S.F.L. --STRUCTURAL FLOOR LEVEL
3. (R) --REVERSED DETAIL

NO.	DATE	REVISED	BY
C	19/05/2019	GENERAL REVISED	
B	24/11/2018	GENERAL REVISED	
A	10/9/2018	GENERAL REVISED	

JOB NO. : J-837

PROJECT : URA KWUN TONG TOWN CENTRE REDEVELOPMENT (AREA 2 & 3) AT NKIL 6514, KWUN TONG, KWLOON

TITLE : TYPICAL MULLION DETAIL FOR CURTAIN WALL

DATE : 13-JUL-18 | SCALE : 1:2 (A1)

DRAWN BY : ASING | CHECKED BY : -

美特鋁質有限公司 MIDI ALUMINIUM FABRICATOR LTD.
Units 6-8, Sunray Industrial Centre, 1/F
610 Cha Kwo Ling Road, Kowloon
Tel:23489211-4 Fax:(852)27727666

DWG NO. : J837-CW-5003 | REV. : C

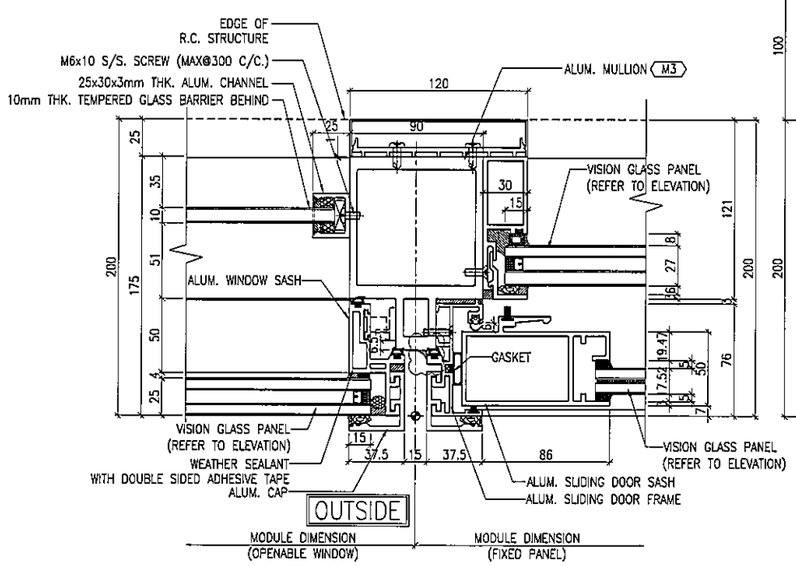

1 / 5004 TYPICAL MULLION DETAIL CURTAIN WALL

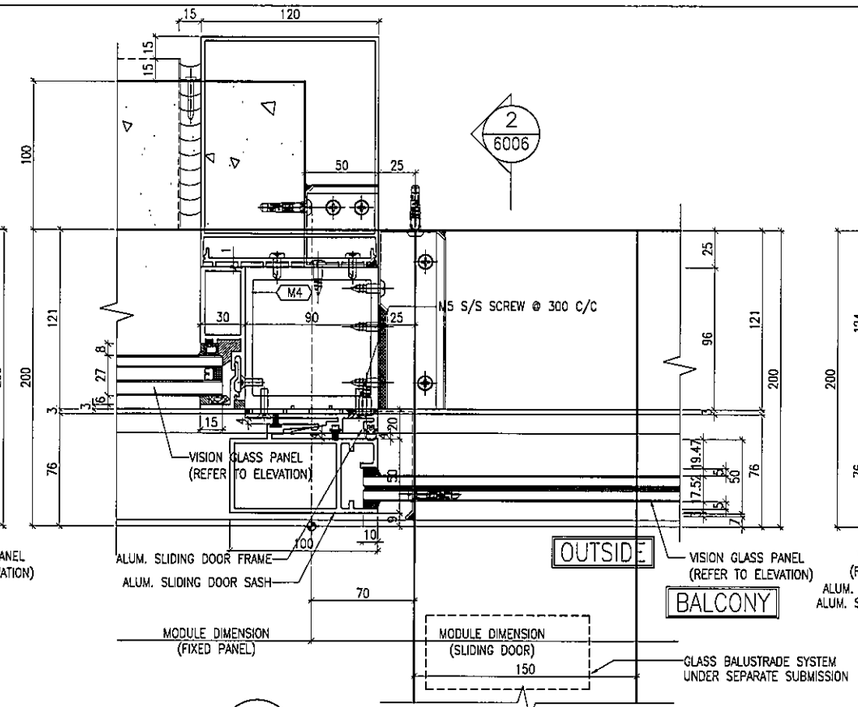

2 / 5004 TYPICAL MULLION DETAIL CURTAIN WALL

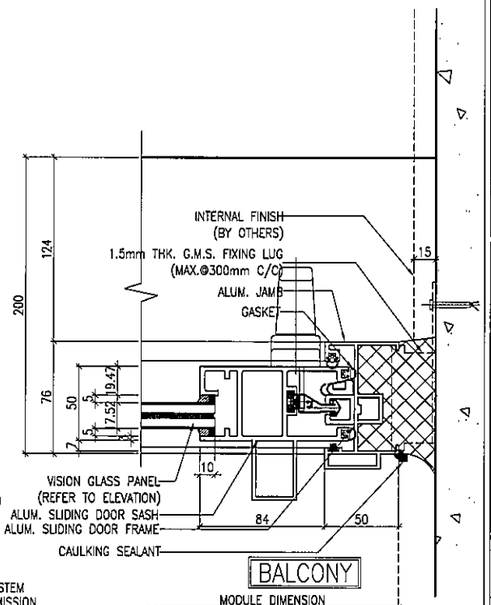

3 / 5004 TYPICAL MULLION DETAIL CURTAIN WALL

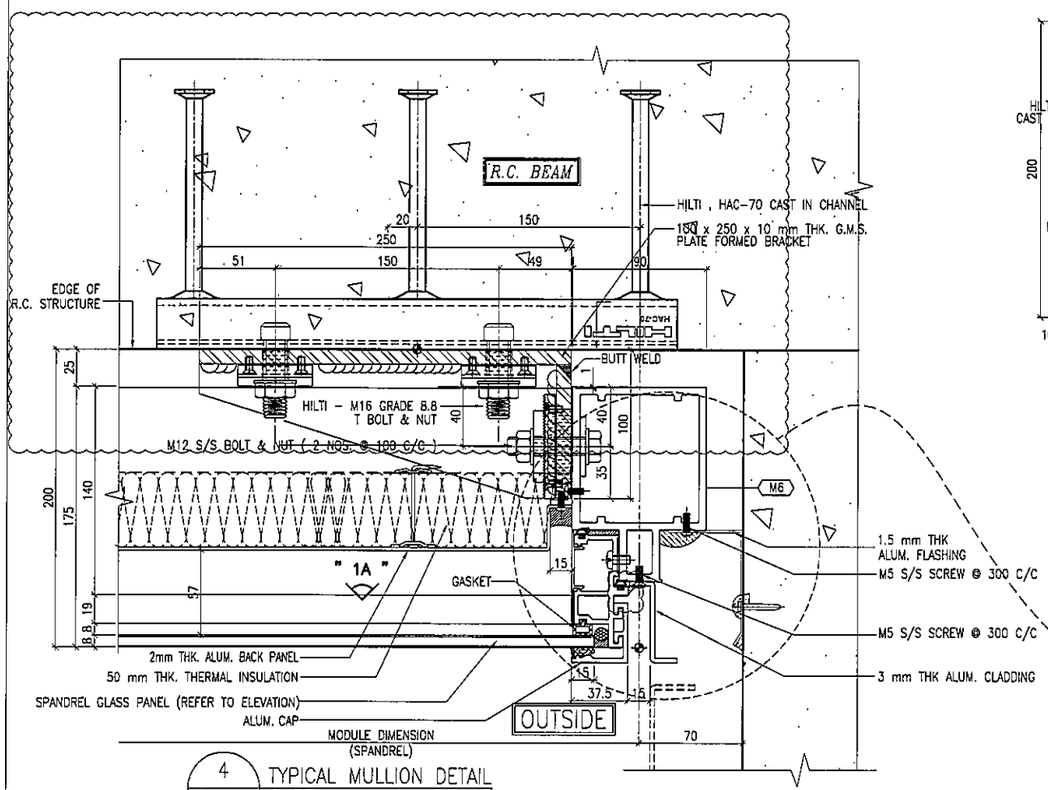

4 / 5004 TYPICAL MULLION DETAIL CURTAIN WALL

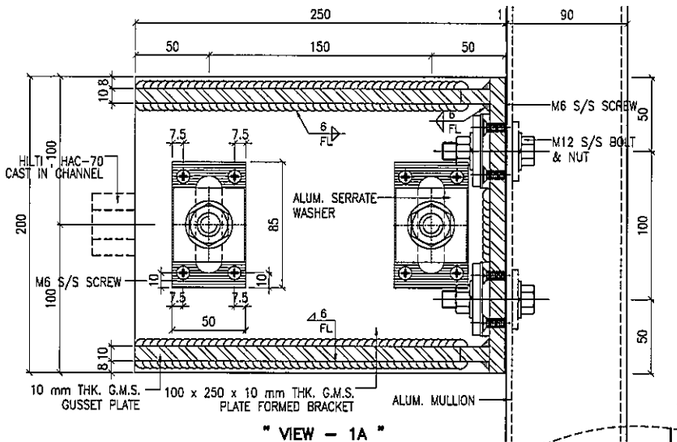

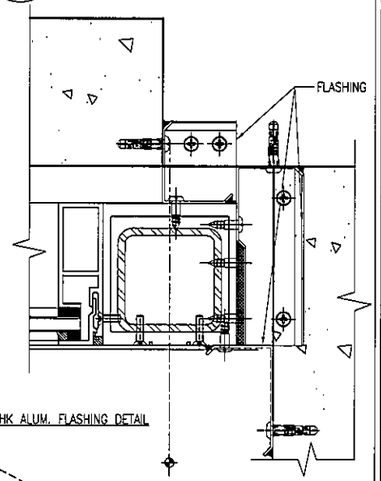

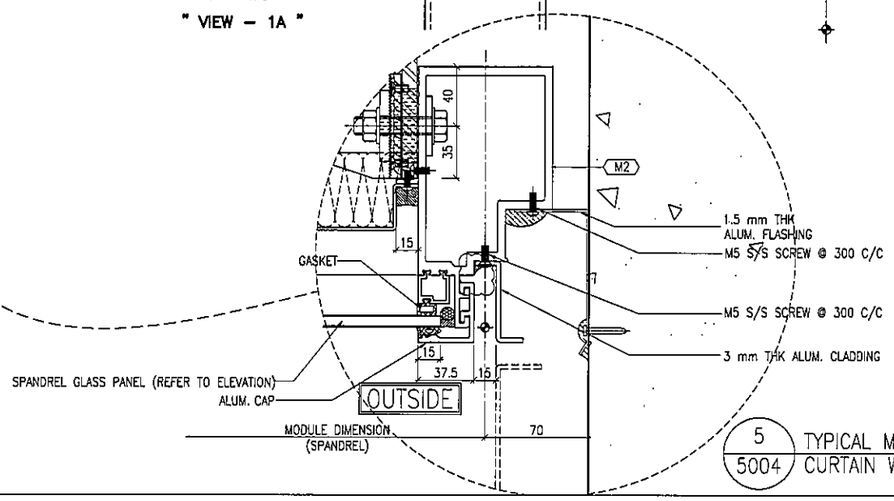

5 / 5004 TYPICAL MULLION DETAIL CURTAIN WALL

B.D. REF :

CLIENT : 信和置業有限公司 Sino Land Company Limited

ARCHITECT : WONG TUNG & PARTNERS LIMITED ARCHITECTS & PLANNERS

MAIN CONTRACTOR : CR Construction Company Limited

STRUCTURAL ENGINEER : AECOM

FACADE CONSULTANT: AECOM

NOTE :
1. ALL DIMENSIONS ARE IN mm.
2. ALL ELEVATIONS ARE VIEWED FROM OUTSIDE.
3. ALL DIMENSIONS TO BE VERIFIED ON SITE BEFORE FABRICATION.

LEGEND :
- X1 / X001 — DETAIL MARK NO. / REFER SHEET NO.
1. F.F.L. --FINISHED FLOOR LEVEL
2. S.F.L. --STRUCTURAL FLOOR LEVEL
3. /R --REVERSED DETAIL

NO.	DATE	REVISED	BY
E	31/01/2019	GENERAL REVISED	
D	22/12/2018	GENERAL REVISED	
C	04/12/2018	GENERAL REVISED	
B	24/11/2018	GENERAL REVISED	
A	10/9/2018	GENERAL REVISED	

JOB NO. : J-837

PROJECT : URA KWUN TONG TOWN CENTRE REDEVELOPMENT (AREA 2 & 3) AT NKIL 6514, KWUN TONG, KWLOON

TITLE : TYPICAL MULLION DETAIL FOR CURTAIN WALL

DATE : 13-JUL-18 | SCALE : 1:2 (A1)

DRAWN BY : ASING | CHECKED BY : -

美特鋁製有限公司 MIDI ALUMINIUM FABRICATOR LTD.
Units 6-8, Sunray Industrial Centre, 1/F
610 Cha Kwo Ling Road, Kowloon
Tel:23489211-4 Fax:(852)27727666

DWG NO. : J837-CW-5004 | REV. : E

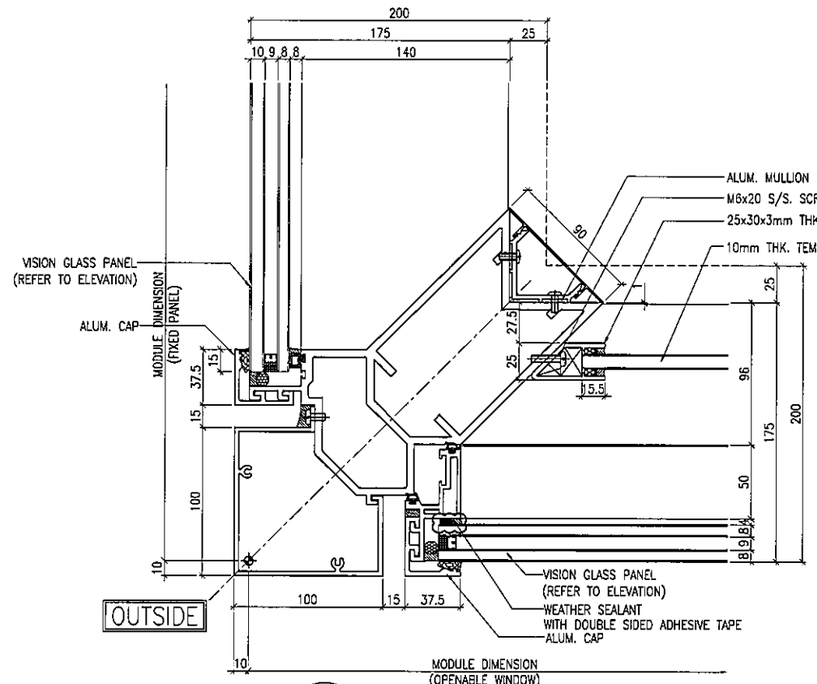

1 / 5005 TYPICAL MULLION DETAIL CURTAIN WALL

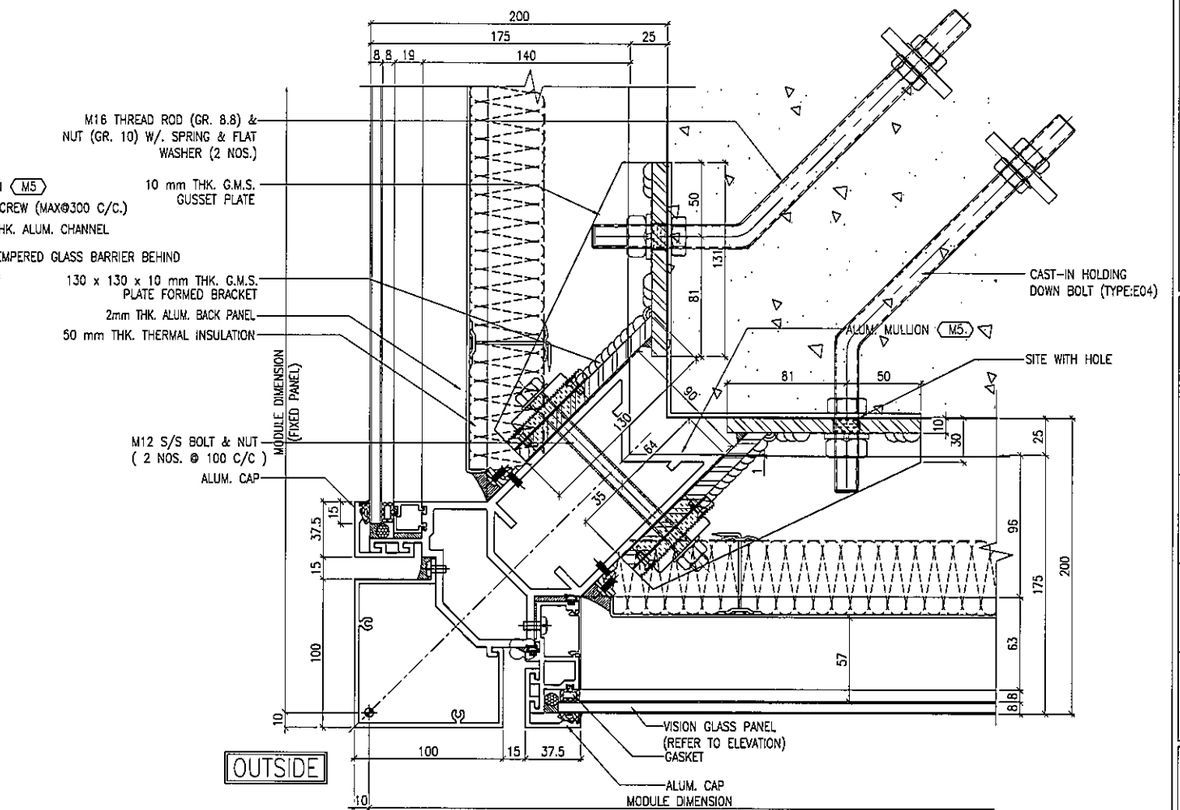

2 / 5005 TYPICAL MULLION DETAIL CURTAIN WALL

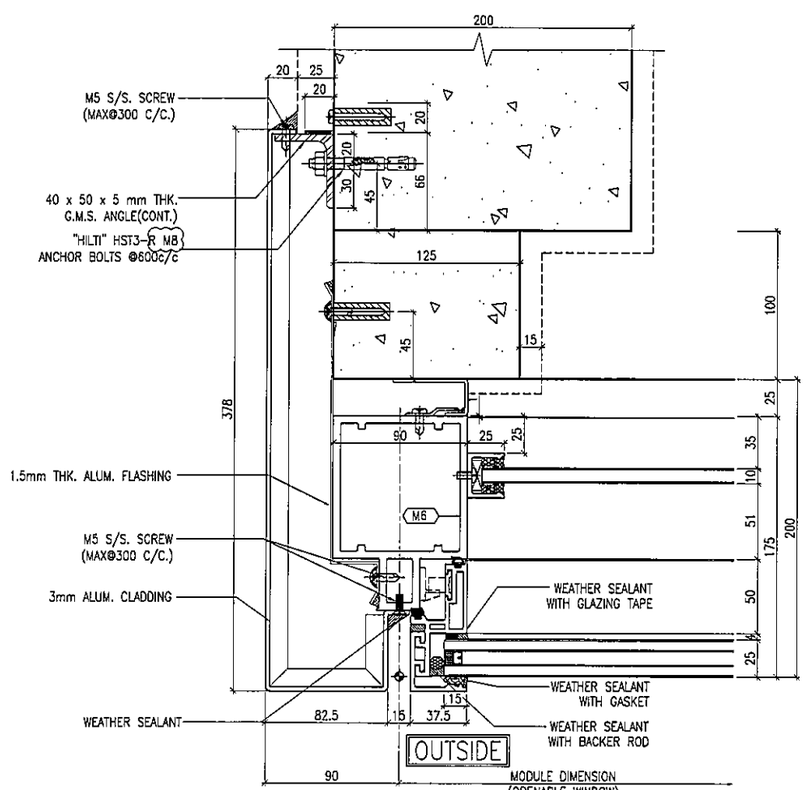

3 / 5005 TYPICAL MULLION DETAIL CURTAIN WALL

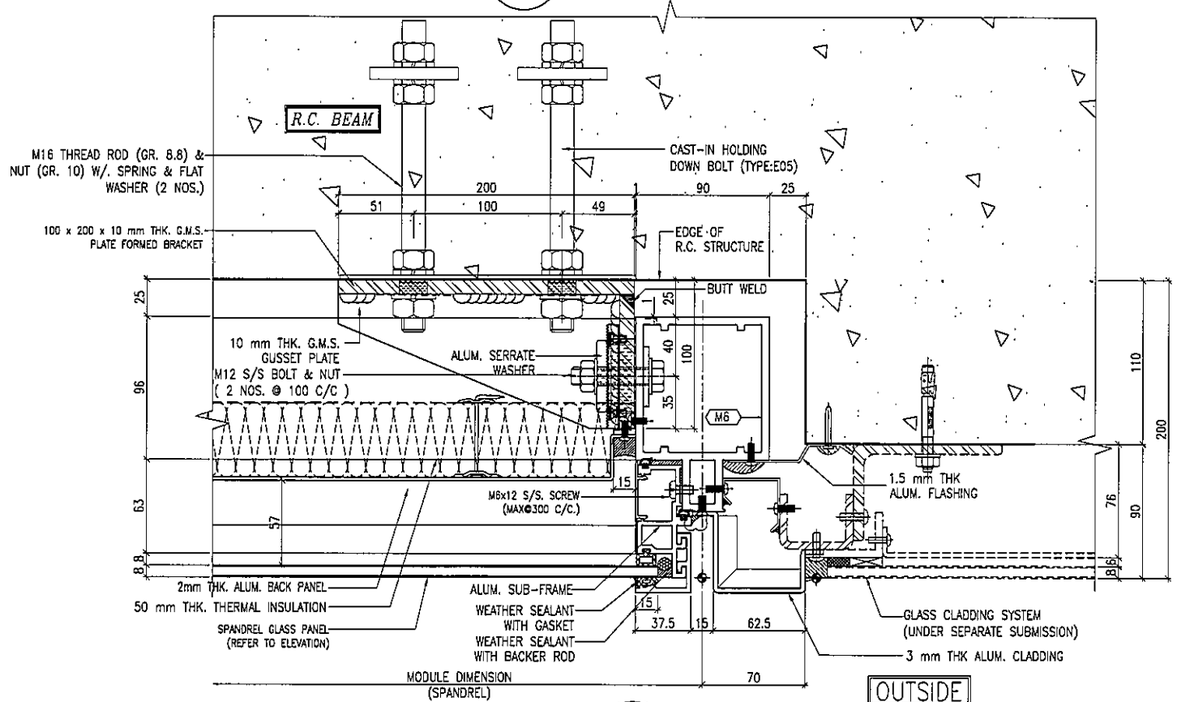

4 / 5005 TYPICAL MULLION DETAIL CURTAIN WALL

B.D. REF :

CLIENT :
信和置業有限公司
Sino Land Company Limited

ARCHITECT :
WONG TUNG & PARTNERS LIMITED
ARCHITECTS & PLANNERS

MAIN CONTRACTOR :
CR Construction Company Limited

STRUCTURAL ENGINEER :
AECOM

FACADE CONSULTANT:
AECOM

NOTE :
1. ALL DIMENSIONS ARE IN mm.
2. ALL ELEVATIONS ARE VIEWED FROM OUTSIDE.
3. ALL DIMENSIONS TO BE VERIFIED ON SITE BEFORE FABRICATION.

LEGEND :
X1 / X001 — DETAIL MARK NO. / REFER SHEET NO.
1. F.F.L. --FINISHED FLOOR LEVEL
2. S.F.L. --STRUCTURAL FLOOR LEVEL
3. (R) --REVERSED DETAIL

NO.	DATE	REVISED	BY
F	12/05/2019	GENERAL REVISED	
E	06/05/2019	GENERAL REVISED	
D	09/01/2019	GENERAL REVISED	
C	22/12/2018	GENERAL REVISED	
B	24/11/2018	GENERAL REVISED	
A	10/9/2018	GENERAL REVISED	

JOB NO. : J-837

PROJECT :
URA KWUN TONG TOWN CENTRE REDEVELOPMENT (AREA 2 & 3) AT NKIL 6514, KWUN TONG, KWLOON

TITLE :
TYPICAL MULLION DETAIL FOR CURTAIN WALL

DATE : 13-JUL-18 | SCALE : 1:2 (A1)

DRAWN BY : ASING | CHECKED BY : -

美特鋁製有限公司
MIDI ALUMINIUM FABRICATOR LTD.
Units 6-8, Sunray Industrial Centre, 1/F
610 Cha Kwo Ling Road, Kowloon
Tel:23489211-4 Fax:(852)27727686

DWG NO. : J837-CW-5005 | REV. : F

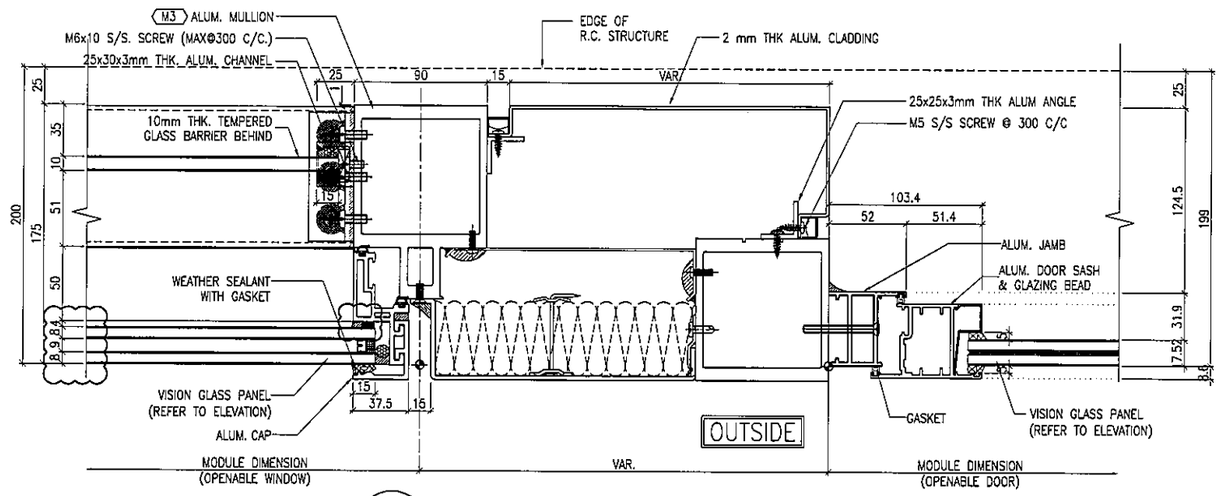

1 / 5006 TYPICAL MULLION DETAIL CURTAIN WALL

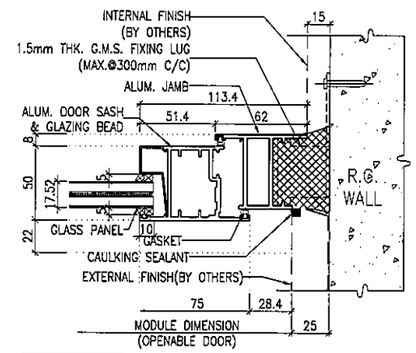

2 / 5006 TYPICAL MULLION DETAIL CURTAIN WALL

4 / 5006

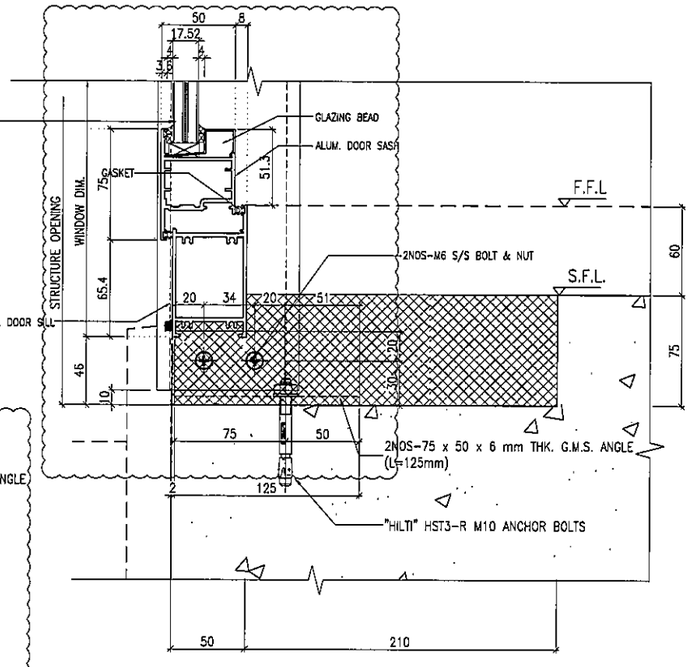

4 / 5006 TYPICAL TRANSOM DETAIL CURTAIN WALL

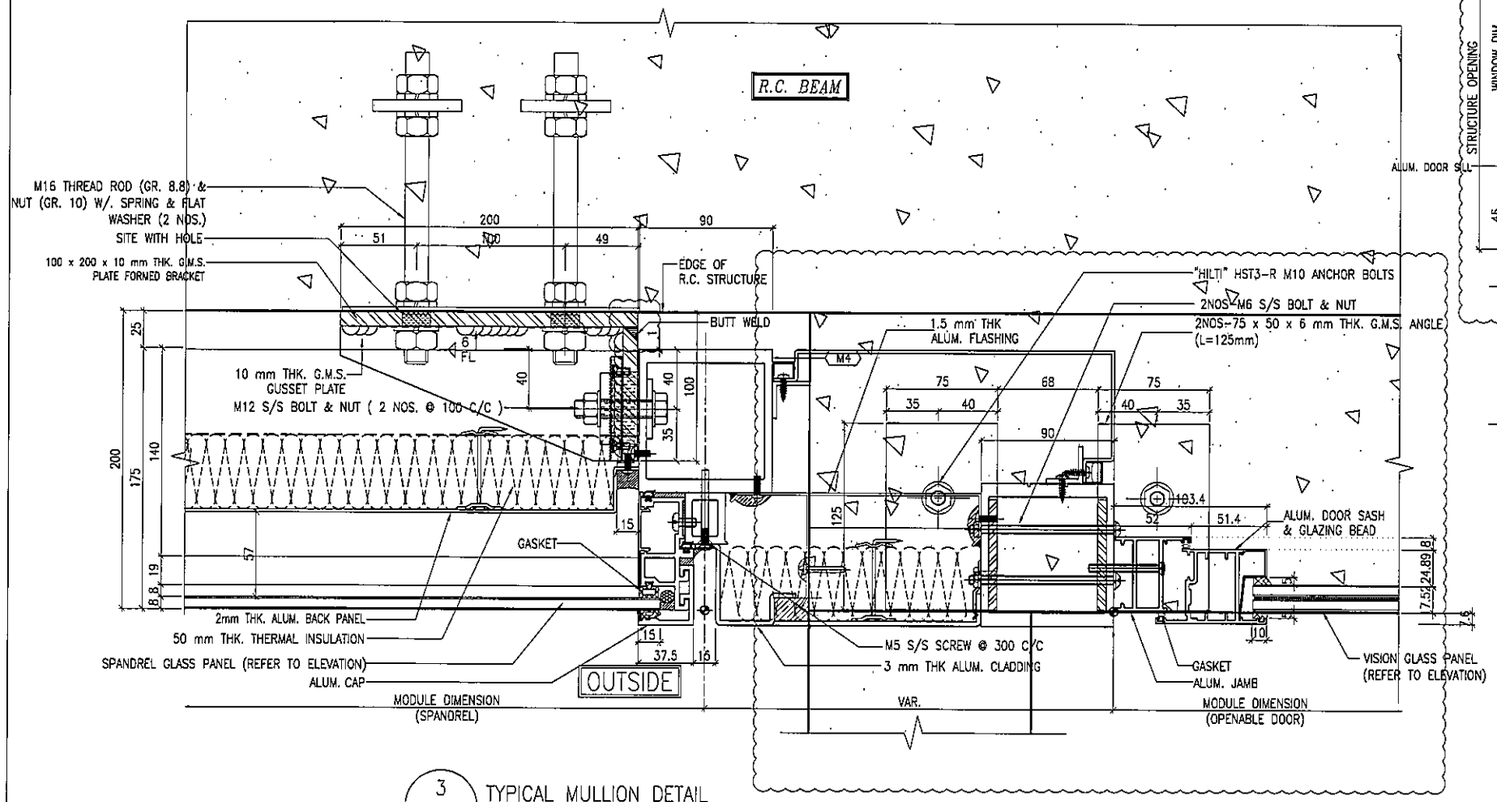

3 / 5006 TYPICAL MULLION DETAIL CURTAIN WALL

B.D. REF :

CLIENT :
信和置業有限公司
Sino Land Company Limited

ARCHITECT :
WONG TUNG & PARTNERS LIMITED
ARCHITECTS & PLANNERS

MAIN CONTRACTOR :
CR Construction Company Limited

STRUCTURAL ENGINEER :
AECOM

FACADE CONSULTANT:
AECOM

NOTE :
1. ALL DIMENSIONS ARE IN mm.
2. ALL ELEVATIONS ARE VIEWED FROM OUTSIDE.
3. ALL DIMENSIONS TO BE VERIFIED ON SITE BEFORE FABRICATION.

LEGEND :
(X1 / X001) — DETAIL MARK NO. / REFER SHEET NO.
1. F.F.L. --FINISHED FLOOR LEVEL
2. S.F.L. --STRUCTURAL FLOOR LEVEL
3. (/R) --REVERSED DETAIL

NO.	DATE	REVISED	BY
E	15/02/2019	GENERAL REVISED	
D	31/01/2019	GENERAL REVISED	
C	22/12/2018	GENERAL REVISED	
B	24/11/2018	GENERAL REVISED	
A	10/9/2018	GENERAL REVISED	

JOB NO. : J-837

PROJECT :
URA KWUN TONG TOWN CENTRE REDEVELOPMENT (AREA 2 & 3) AT NKIL 6514, KWUN TONG, KWLOON

TITLE :
TYPICAL MULLION DETAIL FOR CURTAIN WALL

DATE : 13-JUL-18 | SCALE : 1:2 (A1)

DRAWN BY : ASING | CHECKED BY : -

美特鋁製有限公司
MIDI ALUMINIUM FABRICATOR LTD.
Units 6-8, Sunray Industrial Centre, 1/F
610 Cha Kwo Ling Road, Kowloon
Tel:23489211-4 Fax:(852)27727666

DWG NO. : J837-CW-5006 | REV. : E

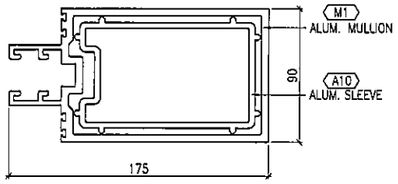

" VIEW – '1B "

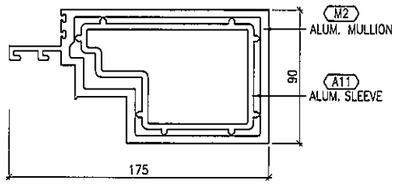

" VIEW – '2B "

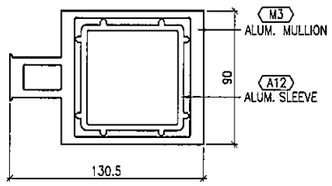

" VIEW – '3B "

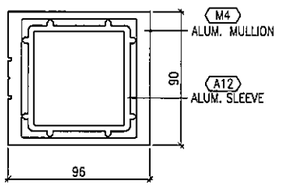

" VIEW – '4B "

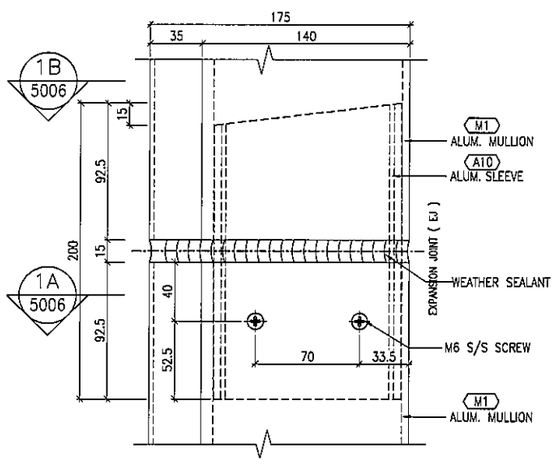

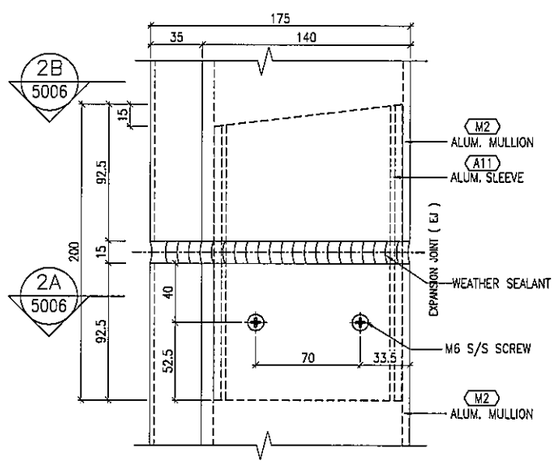

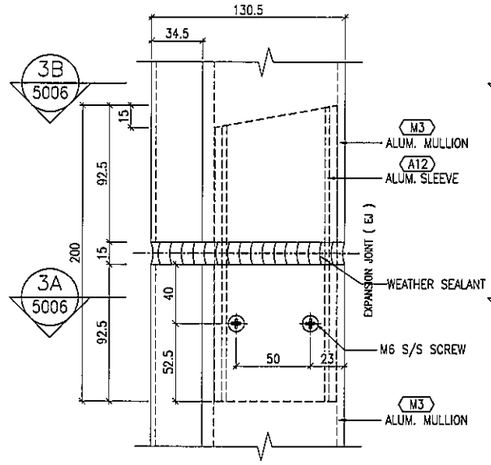

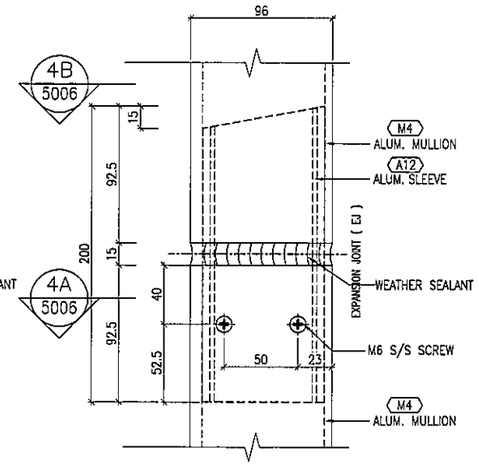

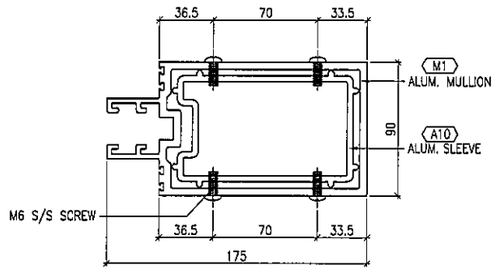

" VIEW – 1A "

" ALUMINIUM CURTAIN WALL SLEEVE "
– TYPICAL FIXING DETAIL

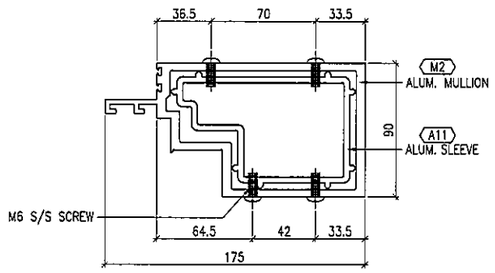

" VIEW – 2A "

" ALUMINIUM CURTAIN WALL SLEEVE "
– TYPICAL FIXING DETAIL

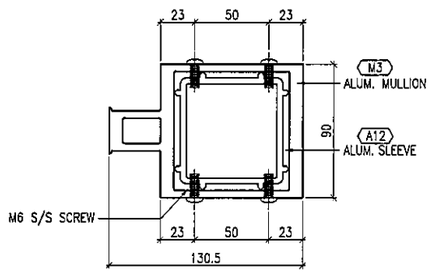

" VIEW – 3A "

" ALUMINIUM CURTAIN WALL SLEEVE "
– TYPICAL FIXING DETAIL

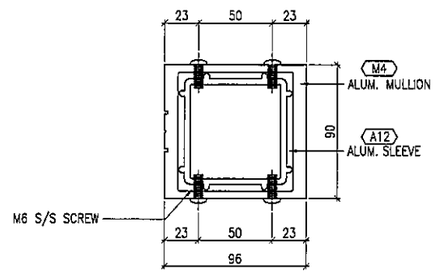

" VIEW – 4A "

" ALUMINIUM CURTAIN WALL SLEEVE "
– TYPICAL FIXING DETAIL

1 / 5007 TYPICAL MULLION DETAIL CURTAIN WALL

2 / 5007 TYPICAL MULLION DETAIL CURTAIN WALL

3 / 5007 TYPICAL MULLION DETAIL CURTAIN WALL

4 / 5007 TYPICAL MULLION DETAIL CURTAIN WALL

B.D. REF :

CLIENT :
信和置業有限公司
Sino Land Company Limited

ARCHITECT :
WONG TUNG & PARTNERS LIMITED
ARCHITECTS & PLANNERS

MAIN CONTRACTOR :
CR Construction Company Limited

STRUCTURAL ENGINEER :
AECOM

FACADE CONSULTANT:
AECOM

NOTE :
1. ALL DIMENSIONS ARE IN mm.
2. ALL ELEVATIONS ARE VIEWED FROM OUTSIDE.
3. ALL DIMENSIONS TO BE VERIFIED ON SITE BEFORE FABRICATION.

LEGEND :
X1 / X001 — DETAIL MARK NO. / REFER SHEET NO.
1. F.F.L. --FINISHED FLOOR LEVEL
2. S.F.L. --STRUCTURAL FLOOR LEVEL
3. /R --REVERSED DETAIL

NO.	DATE	REVISED	BY

JOB NO. : J-837

PROJECT :
URA KWUN TONG TOWN CENTRE REDEVELOPMENT (AREA 2 & 3) AT NKIL 6514, KWUN TONG, KWLOON

TITLE :
TYPICAL MULLION DETAIL FOR CURTAIN WALL

DATE : 13-JUL-18 | SCALE : 1:2 (A1)

DRAWN BY : ASING | CHECKED BY : –

美特鋁製有限公司
MIDI ALUMINIUM FABRICATOR LTD.
Units 6-8, Sunray Industrial Centre, 1/F
610 Cha Kwo Ling Road, Kowloon
Tel:23489211-4 Fax:(852)27727666

DWG NO. : J837-CW-5007 | REV. : –

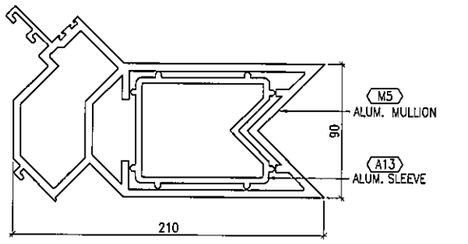

" VIEW – '1B "

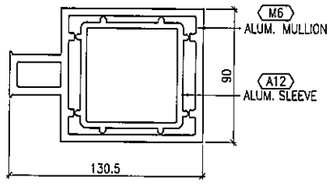

" VIEW – '2B "

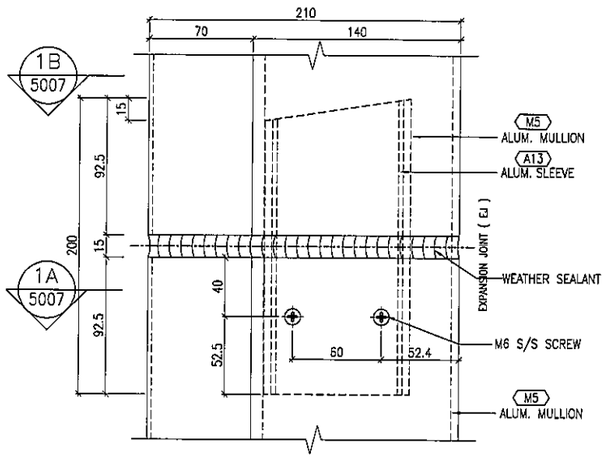

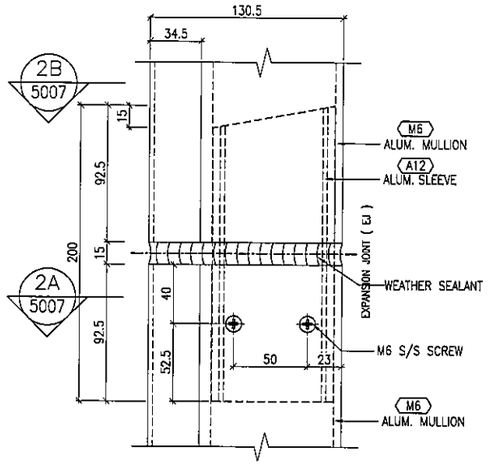

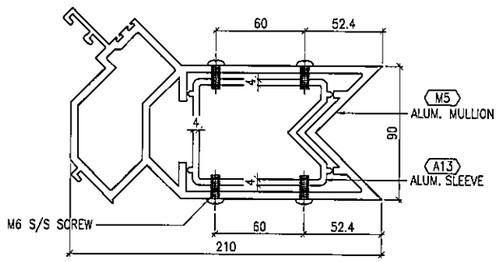

" VIEW – 1A "

" ALUMINIUM CURTAIN WALL SLEEVE "
– TYPICAL FIXING DETAIL

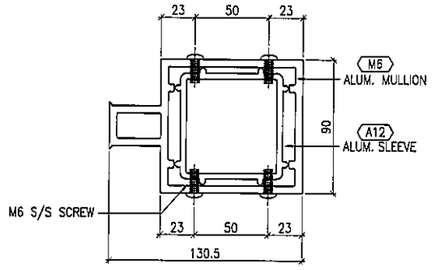

" VIEW – 2A "

" ALUMINIUM CURTAIN WALL SLEEVE "
– TYPICAL FIXING DETAIL

1 / 5008 TYPICAL MULLION DETAIL
CURTAIN WALL

2 / 5008 TYPICAL MULLION DETAIL
CURTAIN WALL

B.D. REF :

CLIENT :
信和置業有限公司
Sino Land Company Limited

ARCHITECT :
WONG TUNG & PARTNERS LIMITED
ARCHITECTS & PLANNERS

MAIN CONTRACTOR :
CR Construction Company Limited

STRUCTURAL ENGINEER :
AECOM

FACADE CONSULTANT:
AECOM

NOTE :
1. ALL DIMENSIONS ARE IN mm.
2. ALL ELEVATIONS ARE VIEWED FROM OUTSIDE.
3. ALL DIMENSIONS TO BE VERIFIED ON SITE BEFORE FABRICATION.

LEGEND :
X1 / XXXX — DETAIL MARK NO. / REFER SHEET NO.
1. F.F.L. --FINISHED FLOOR LEVEL
2. S.F.L. --STRUCTURAL FLOOR LEVEL
3. /R --REVERSED DETAIL

NO.	DATE	REVISED	BY

JOB NO. : J-837

PROJECT :
URA KWUN TONG TOWN CENTRE
REDEVELOPMENT (AREA 2 & 3) AT
NKIL 6514, KWUN TONG, KWLOON

TITLE :
TYPICAL MULLION DETAIL
FOR CURTAIN WALL

DATE : 13-JUL-18 | SCALE : 1:2 (A1)

DRAWN BY : ASING | CHECKED BY : –

美特鋁質有限公司
MIDI ALUMINIUM FABRICATOR LTD.
Units 6-8, Sunray Industrial Centre, 1/F
610 Cha Kwo Ling Road, Kowloon
Tel:23489211-4 Fax:(852)27727666

DWG NO. : J837-CW-5008 | REV. : –

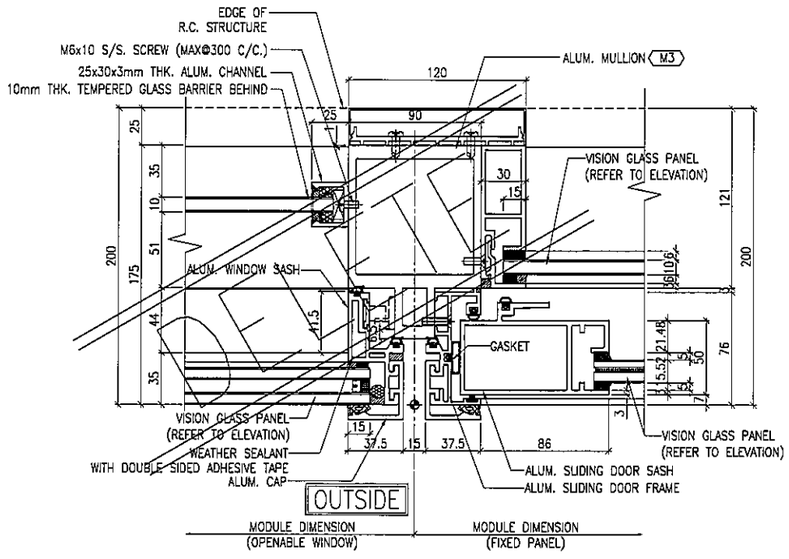

1 / 5009 TYPICAL MULLION DETAIL CURTAIN WALL

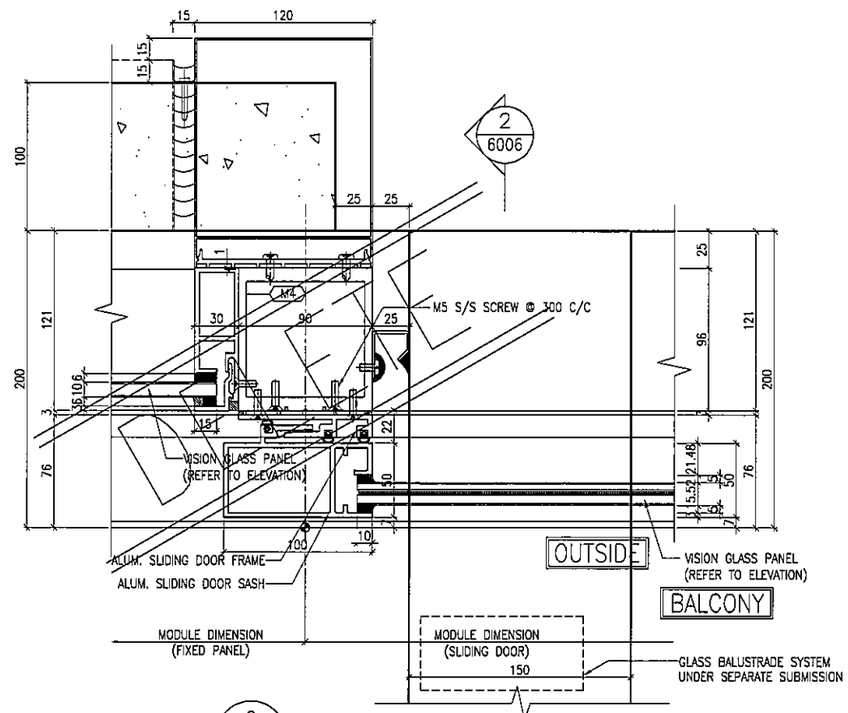

2 / 5009 TYPICAL MULLION DETAIL CURTAIN WALL

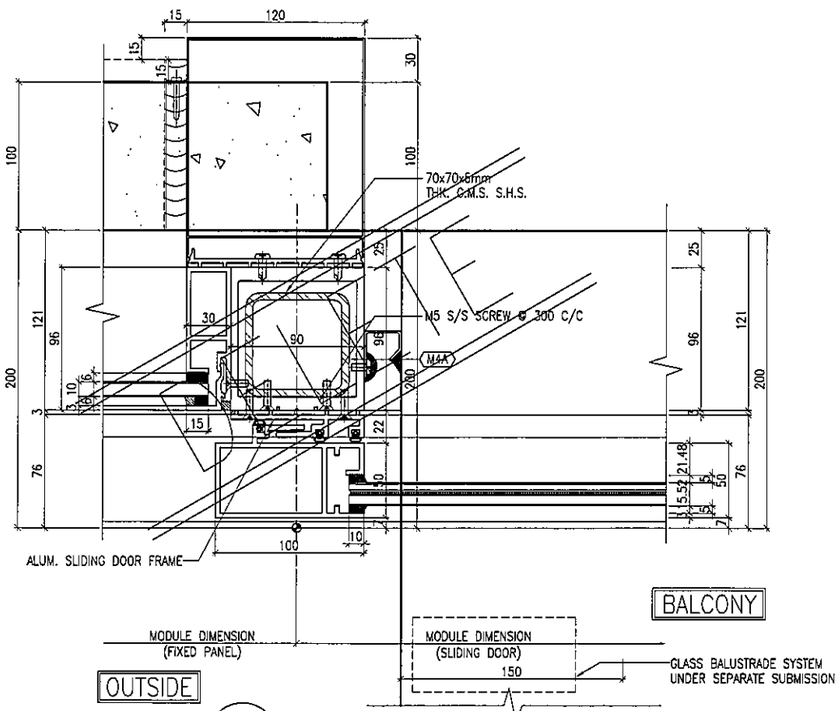

3 / 5009 TYPICAL MULLION DETAIL CURTAIN WALL

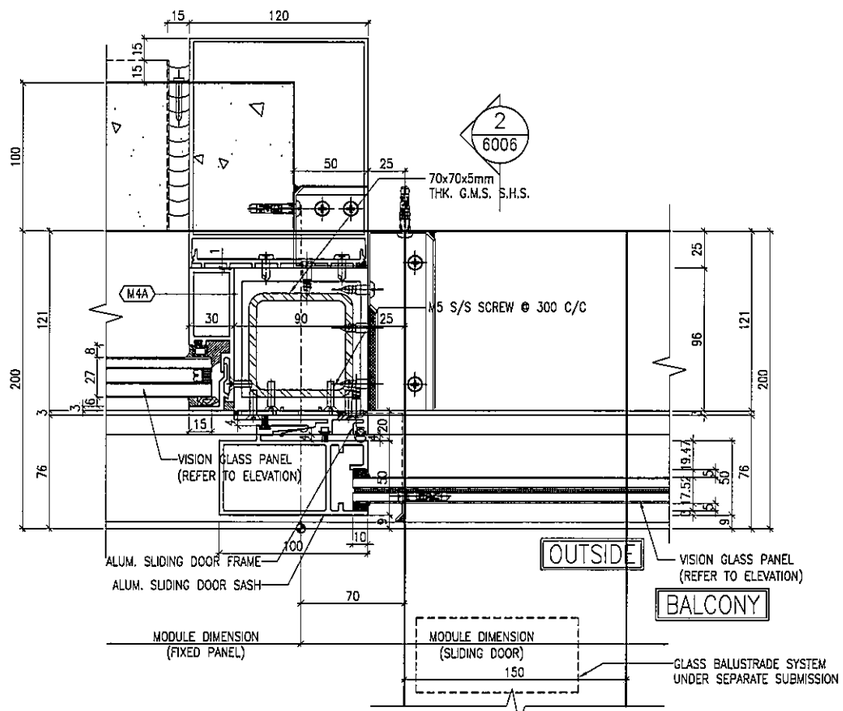

4 / 5009 TYPICAL MULLION DETAIL CURTAIN WALL

B.D. REF :

CLIENT :
信和置業有限公司
Sino Land Company Limited

ARCHITECT :
WONG TUNG & PARTNERS LIMITED
ARCHITECTS & PLANNERS

MAIN CONTRACTOR :
CR Construction Company Limited

STRUCTURAL ENGINEER :
AECOM

FACADE CONSULTANT:
AECOM

NOTE :
1. ALL DIMENSIONS ARE IN mm.
2. ALL ELEVATIONS ARE VIEWED FROM OUTSIDE.
3. ALL DIMENSIONS TO BE VERIFIED ON SITE BEFORE FABRICATION.

LEGEND :
X1 / X001 — DETAIL MARK NO. / REFER SHEET NO.
1. F.F.L. --FINISHED FLOOR LEVEL
2. S.F.L. --STRUCTURAL FLOOR LEVEL
3. /R --REVERSED DETAIL

NO.	DATE	REVISED	BY
B	04/12/2018	GENERAL REVISED	
A	24/11/2018	GENERAL REVISED	

JOB NO. : J-837

PROJECT :
URA KWUN TONG TOWN CENTRE REDEVELOPMENT (AREA 2 & 3) AT NKIL 6514, KWUN TONG, KWLOON

TITLE :
TYPICAL MULLION DETAIL FOR CURTAIN WALL

DATE : 13-JUL-18 | SCALE : 1:2 (A1)

DRAWN BY : ASING | CHECKED BY : -

美特鋁質有限公司
MIDI ALUMINIUM FABRICATOR LTD.
Units 6-8, Sunray Industrial Centre, 1/F
610 Cha Kwo Ling Road, Kowloon
Tel:23489211-4 Fax:(852)27727666

DWG NO. : J837-CW-5009 | REV. : B

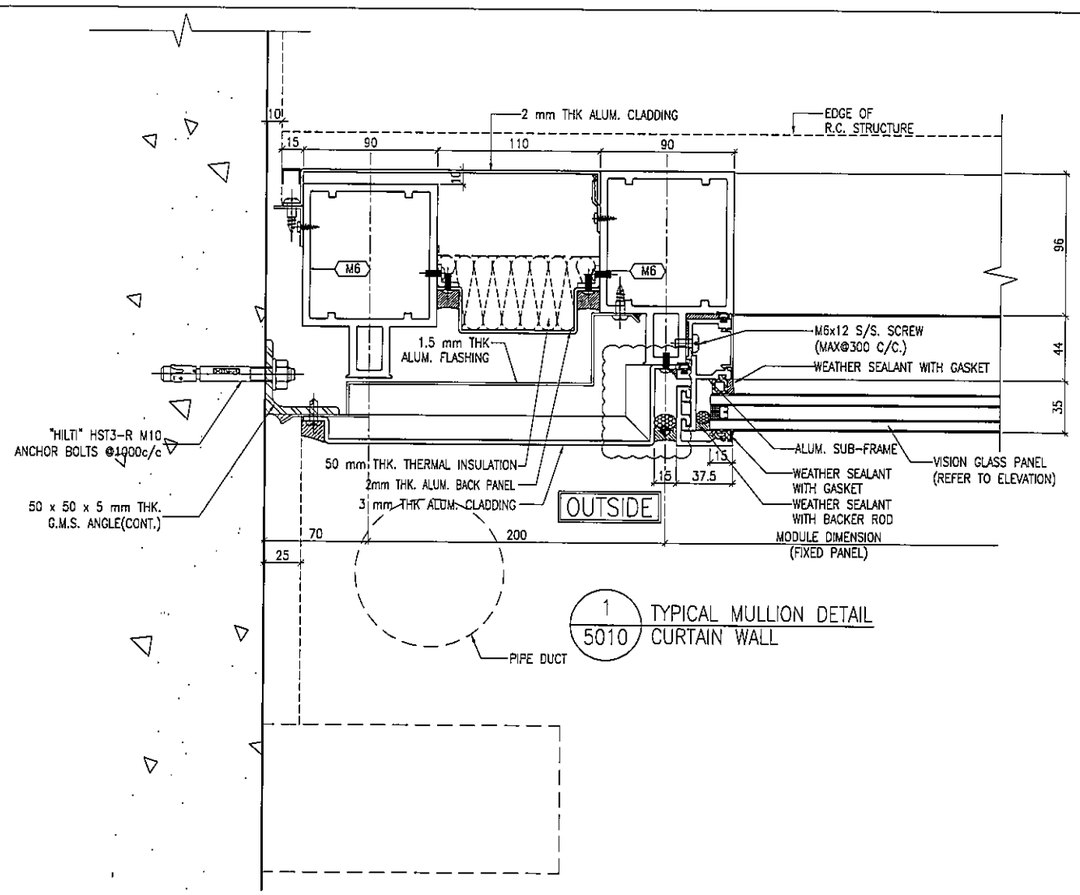

1 / 5010 TYPICAL MULLION DETAIL CURTAIN WALL

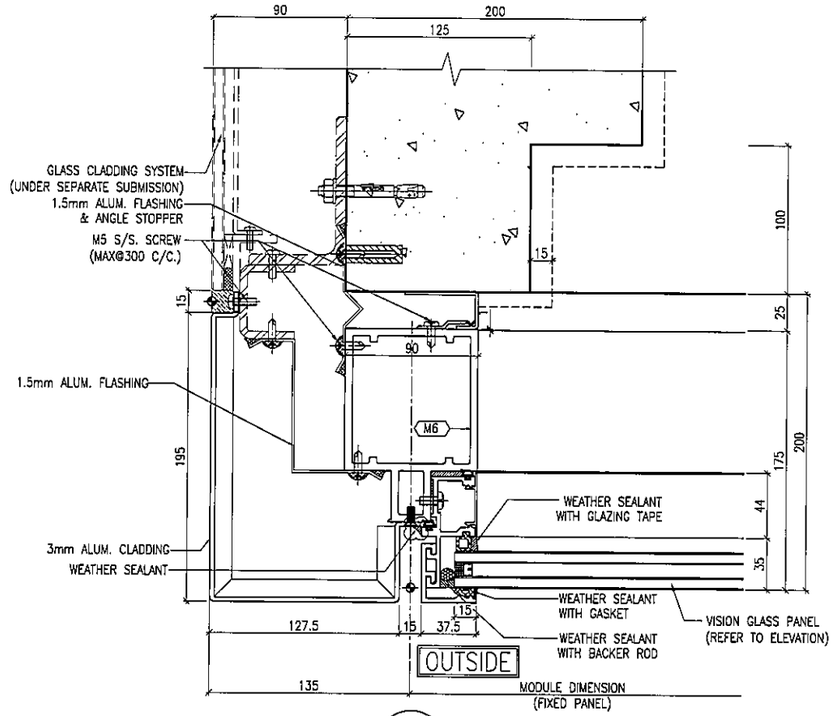

2 / 5010 TYPICAL MULLION DETAIL CURTAIN WALL

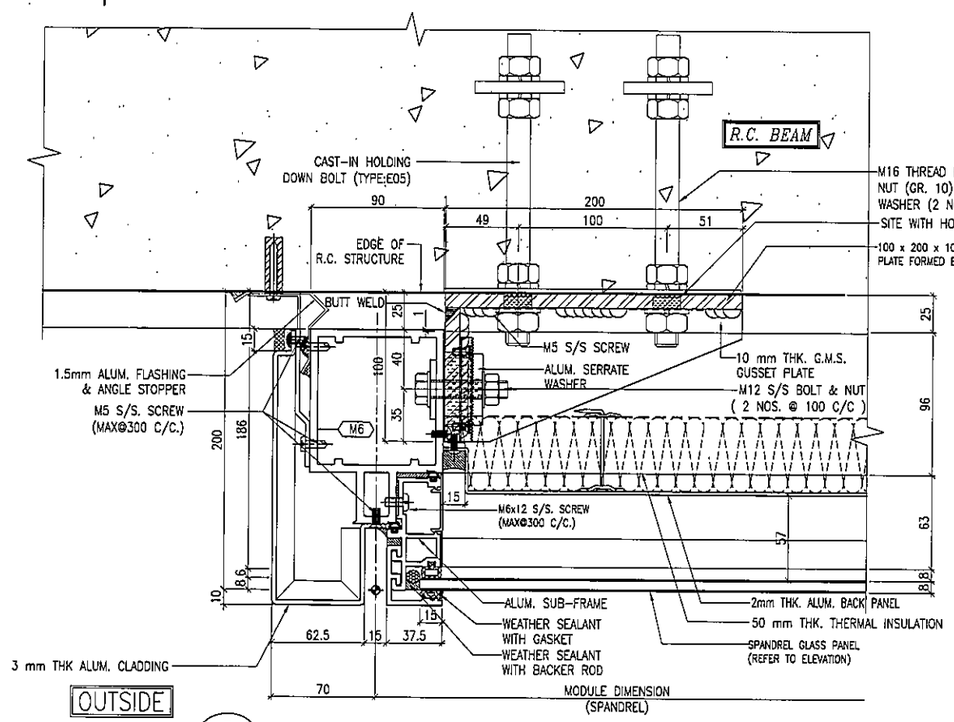

3 / 5010 TYPICAL MULLION DETAIL CURTAIN WALL

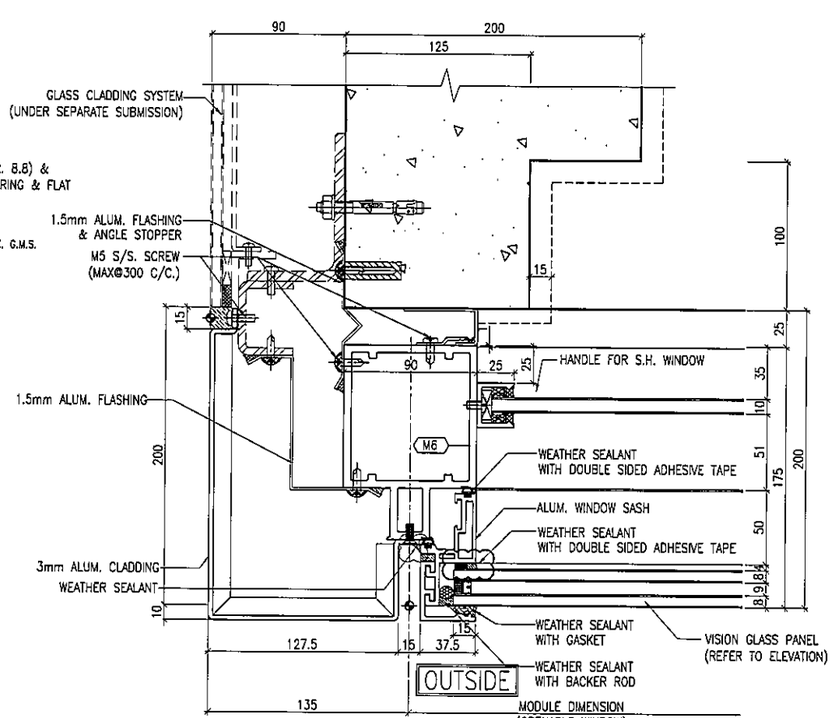

4 / 5010 TYPICAL MULLION DETAIL CURTAIN WALL

B.D. REF :

CLIENT :
信和置業有限公司
Sino Land Company Limited

ARCHITECT :
WONG TUNG & PARTNERS LIMITED
ARCHITECTS & PLANNERS

MAIN CONTRACTOR :
CR Construction Company Limited

STRUCTURAL ENGINEER :
AECOM

FACADE CONSULTANT:
AECOM

NOTE :
1. ALL DIMENSIONS ARE IN mm.
2. ALL ELEVATIONS ARE VIEWED FROM OUTSIDE.
3. ALL DIMENSIONS TO BE VERIFIED ON SITE BEFORE FABRICATION.

LEGEND :
- X1 / X001 — DETAIL MARK NO. / REFER SHEET NO.
1. F.F.L. --FINISHED FLOOR LEVEL
2. S.F.L. --STRUCTURAL FLOOR LEVEL
3. (R) --REVERSED DETAIL

NO.	DATE	REVISED	BY
B	22/12/2018	GENERAL REVISED	
A	24/11/2018	GENERAL REVISED	

JOB NO. : J-837

PROJECT :
URA KWUN TONG TOWN CENTRE REDEVELOPMENT (AREA 2 & 3) AT NKIL 6514, KWUN TONG, KWLOON

TITLE :
TYPICAL MULLION DETAIL FOR CURTAIN WALL

DATE : 13-JUL-18 | SCALE : 1:2 (A1)

DRAWN BY : ASING | CHECKED BY : -

美特鋁質有限公司
MIDI ALUMINIUM FABRICATOR LTD.
Units 6-8, Sunray Industrial Centre, 1/F
610 Cha Kwo Ling Road, Kowloon
Tel:23489211-4 Fax:(852)27727666

DWG NO. : J837-CW-5010 | REV. : B

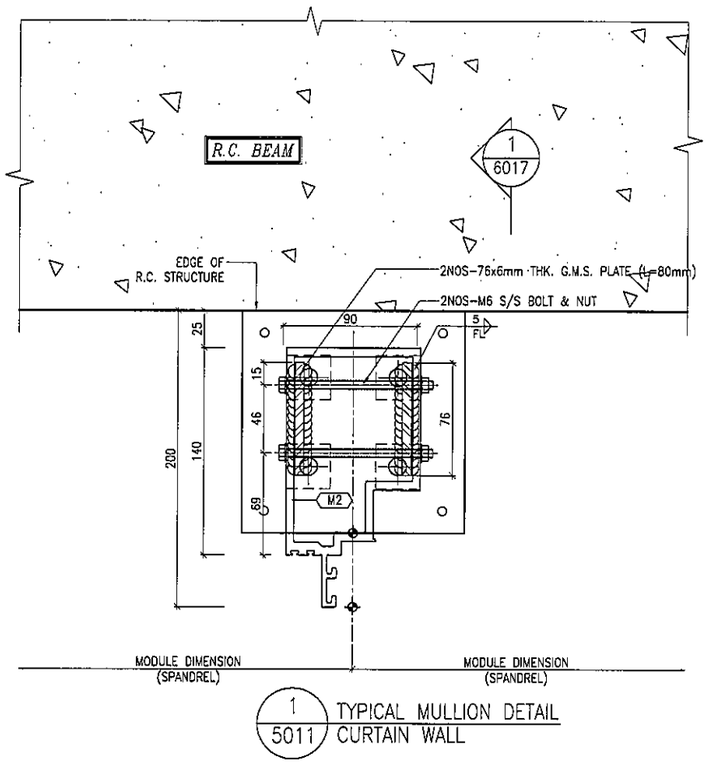

1 / 5011 TYPICAL MULLION DETAIL CURTAIN WALL

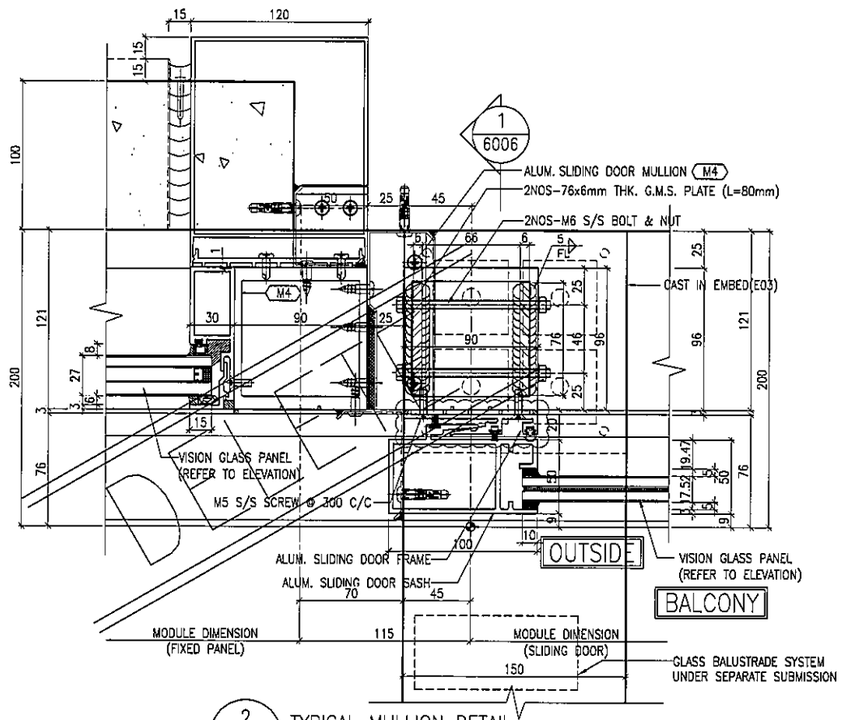

2 / 5011 TYPICAL MULLION DETAIL CURTAIN WALL

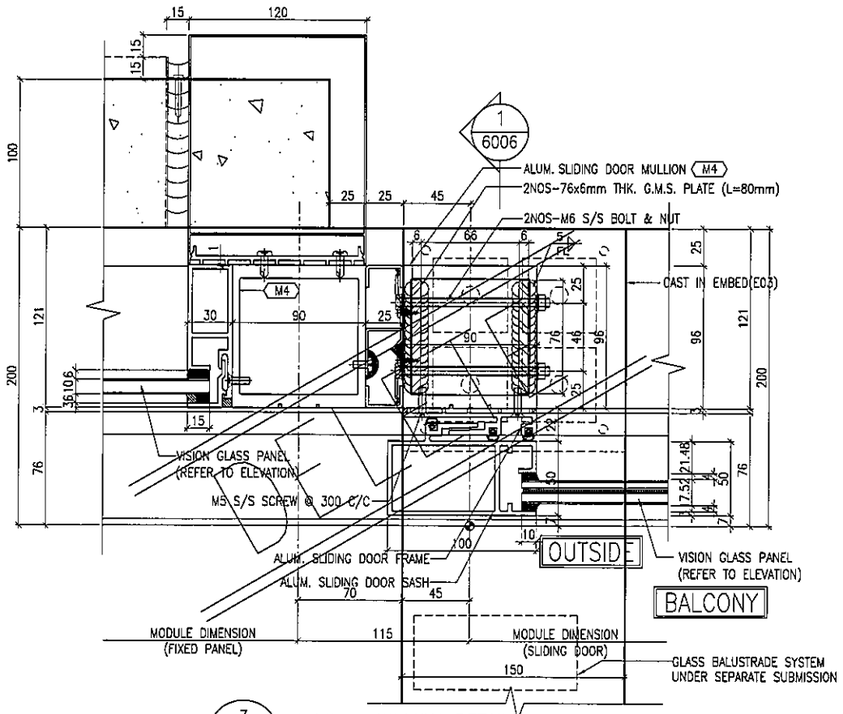

3 / 5011 TYPICAL MULLION DETAIL CURTAIN WALL

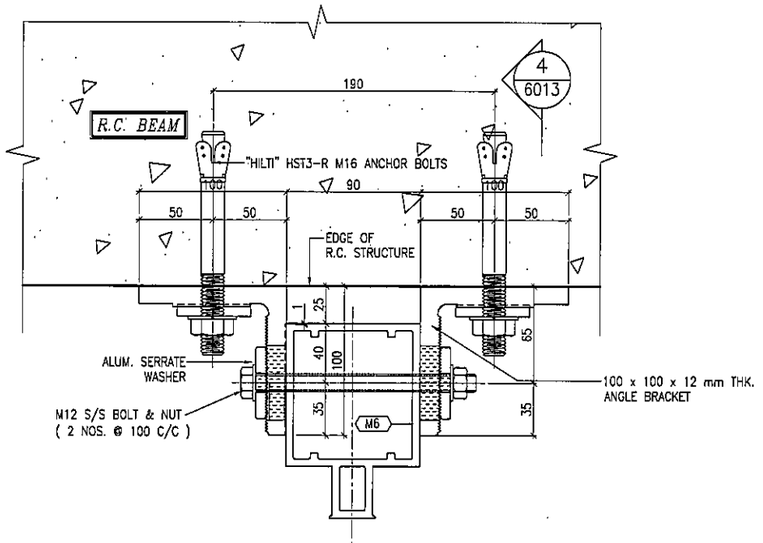

4 / 5011 TYPICAL MULLION DETAIL CURTAIN WALL

B.D. REF :

CLIENT :
信和置業有限公司
Sino Land Company Limited

ARCHITECT :
WONG TUNG & PARTNERS LIMITED
ARCHITECTS & PLANNERS

MAIN CONTRACTOR :
CR Construction Company Limited

STRUCTURAL ENGINEER :
AECOM

FACADE CONSULTANT:
AECOM

NOTE :
1. ALL DIMENSIONS ARE IN mm.
2. ALL ELEVATIONS ARE VIEWED FROM OUTSIDE.
3. ALL DIMENSIONS TO BE VERIFIED ON SITE BEFORE FABRICATION.

LEGEND :
- X1 / X001 — DETAIL MARK NO. / REFER SHEET NO.
1. F.F.L. --FINISHED FLOOR LEVEL
2. S.F.L. --STRUCTURAL FLOOR LEVEL
3. (/R) --REVERSED DETAIL

NO.	DATE	REMARK	BY
B	04/12/2018	GENERAL REVISED	
A	24/11/2018	GENERAL REVISED	

JOB NO. : J-837

PROJECT :
URA KWUN TONG TOWN CENTRE REDEVELOPMENT (AREA 2 & 3) AT NKIL 6514, KWUN TONG, KWLOON

TITLE :
TYPICAL MULLION DETAIL FOR CURTAIN WALL

DATE : 13-JUL-18 | SCALE : 1:2 (A1)

DRAWN BY : ASING | CHECKED BY : -

美特鋁質有限公司
MIDI ALUMINIUM FABRICATOR LTD.
Units 6-8, Sunray Industrial Centre, 1/F
610 Cha Kwo Ling Road, Kowloon
Tel:23489211-4 Fax:(852)27727666

DWG NO. : J837-CW-5011 | REV. : B

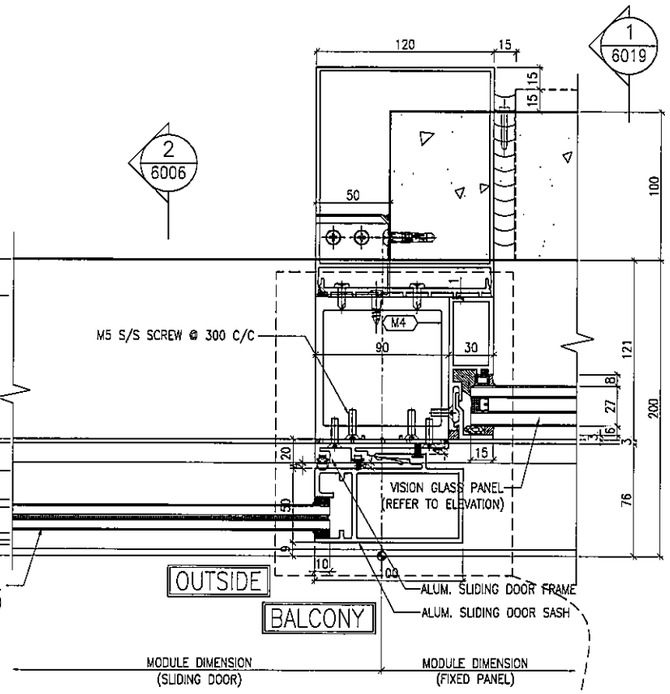

1 / 5012 TYPICAL MULLION DETAIL CURTAIN WALL

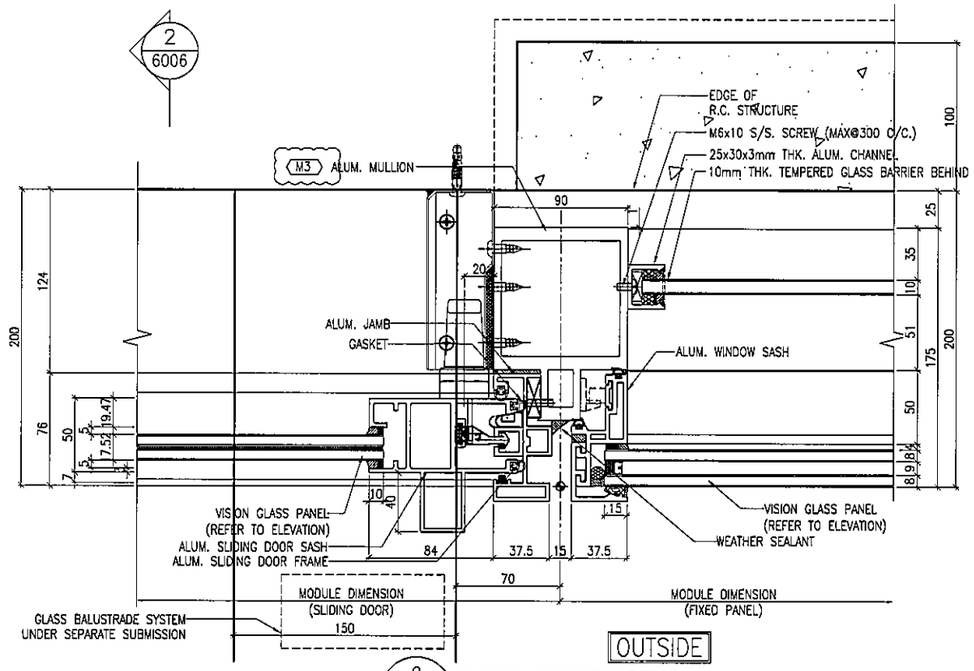

2 / 5012 TYPICAL MULLION DETAIL CURTAIN WALL

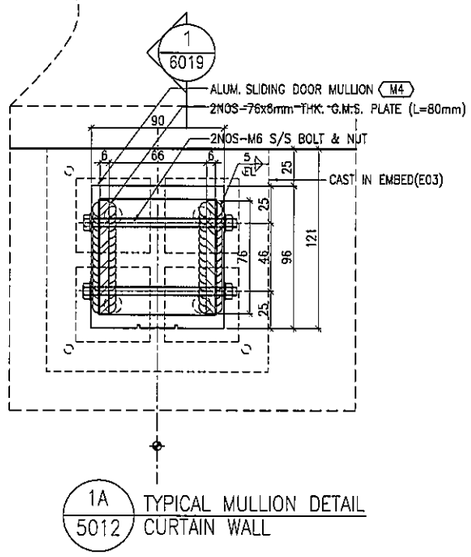

1A / 5012 TYPICAL MULLION DETAIL CURTAIN WALL

B.D. REF :

CLIENT :
信和置業有限公司
Sino Land Company Limited

ARCHITECT :
WONG TUNG & PARTNERS LIMITED
ARCHITECTS & PLANNERS

MAIN CONTRACTOR :
CR Construction Company Limited

STRUCTURAL ENGINEER :
AECOM

FACADE CONSULTANT:
AECOM

NOTE :
1. ALL DIMENSIONS ARE IN mm.
2. ALL ELEVATIONS ARE VIEWED FROM OUTSIDE.
3. ALL DIMENSIONS TO BE VERIFIED ON SITE BEFORE FABRICATION.

LEGEND :
X1 / X001 — DETAIL MARK NO. / REFER SHEET NO.
1. F.F.L. --FINISHED FLOOR LEVEL
2. S.F.L. --STRUCTURAL FLOOR LEVEL
3. (R) --REVERSED DETAIL

NO.	DATE	REVISED	BY
C	19/05/2019	GENERAL REVISED	
B	22/12/2018	GENERAL REVISED	
A	04/12/2018	GENERAL REVISED	

JOB NO. : J-837

PROJECT :
URA KWUN TONG TOWN CENTRE REDEVELOPMENT (AREA 2 & 3) AT NKIL 6514, KWUN TONG, KWLOON

TITLE :
TYPICAL MULLION DETAIL FOR CURTAIN WALL

DATE : 24-NOV-18 | SCALE : 1:2 (A1)

DRAWN BY : ASING | CHECKED BY : -

美特鋁質有限公司
MIDI ALUMINIUM FABRICATOR LTD.
Units 6-8, Sunray Industrial Centre, 1/F
610 Cha Kwo Ling Road, Kowloon
Tel:23489211-4 Fax:(852)27727666

DWG NO. : J837-CW-5012 | REV. : C

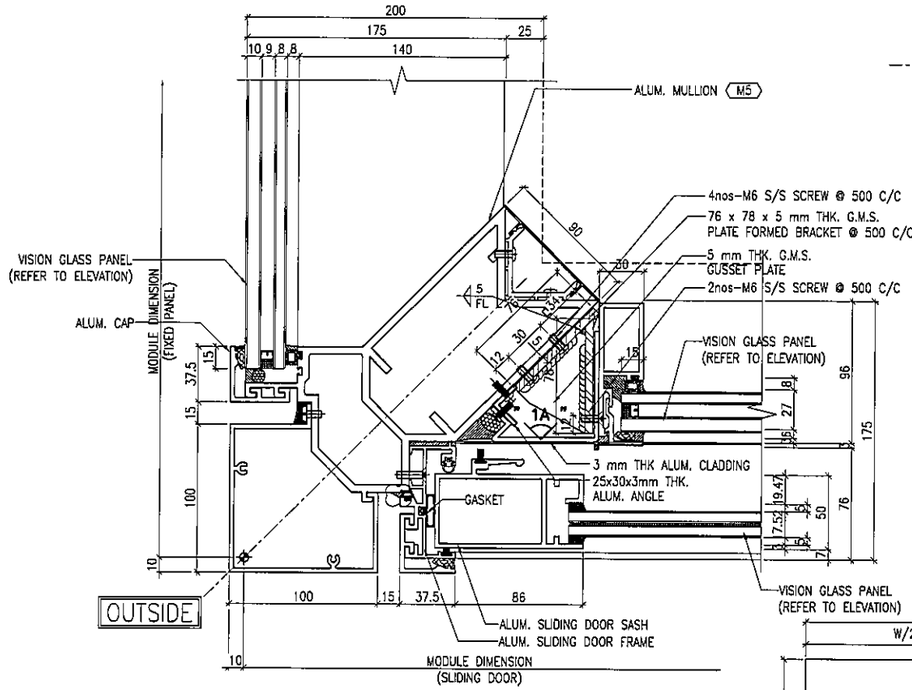

1 / 5013 TYPICAL MULLION DETAIL CURTAIN WALL

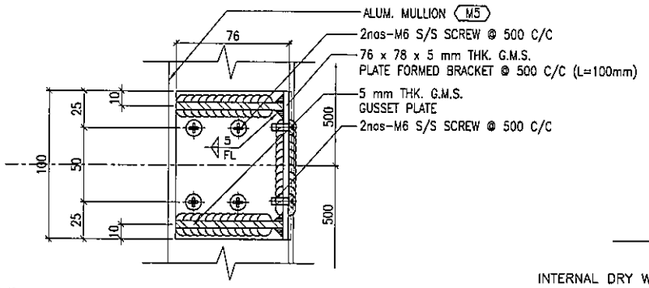

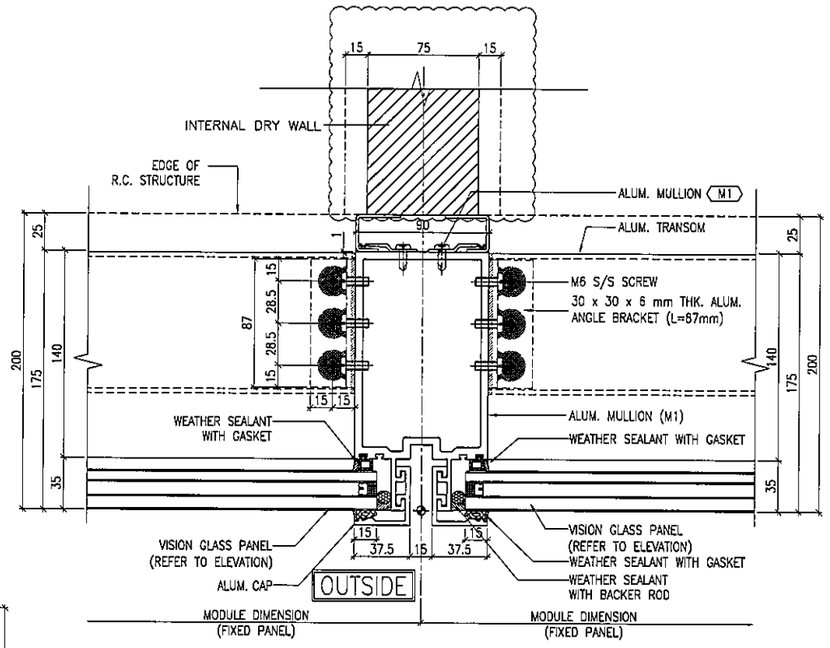

2 / 5013 TYPICAL MULLION DETAIL CURTAIN WALL

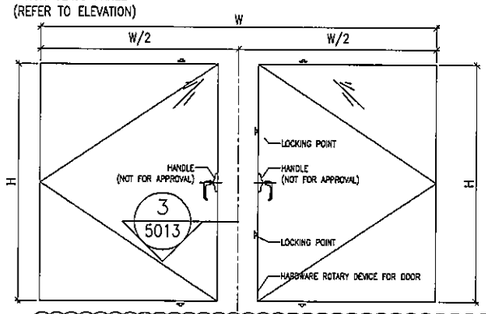

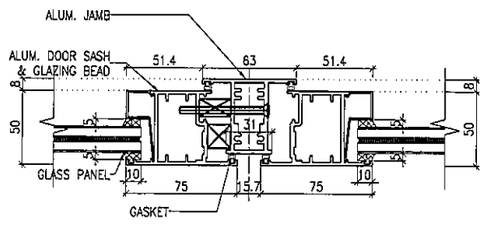

3 / 5013 TYPICAL MULLION DETAIL CURTAIN WALL

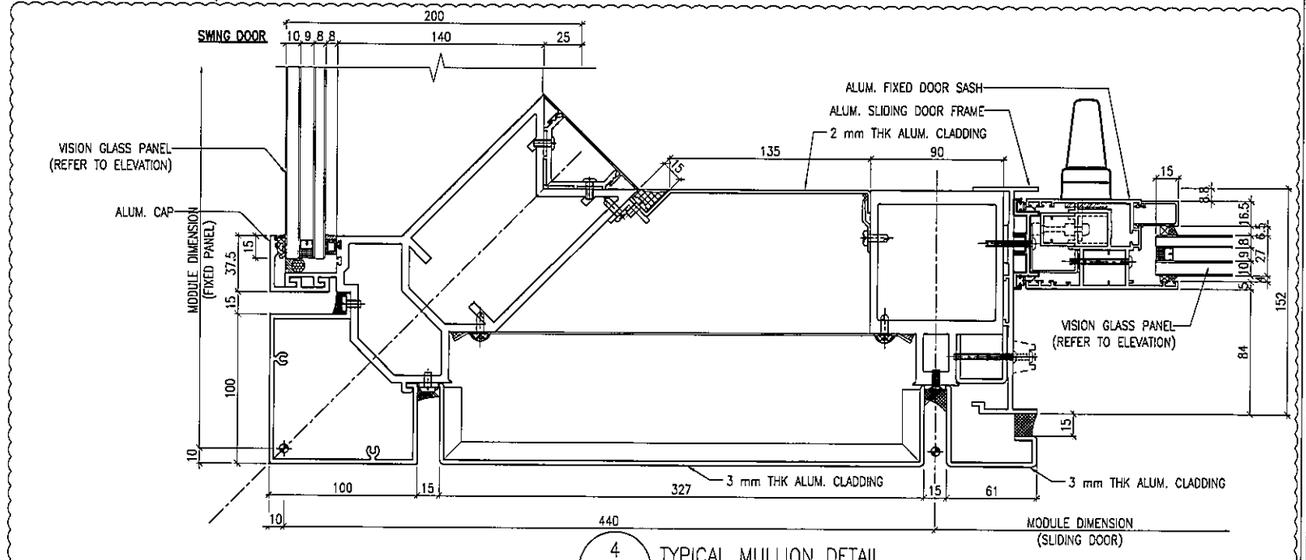

4 / 5013 TYPICAL MULLION DETAIL CURTAIN WALL (FOR T3–H 6F)

B.D. REF :

CLIENT :
信和置業有限公司
Sino Land Company Limited

ARCHITECT :
WONG TUNG & PARTNERS LIMITED
ARCHITECTS & PLANNERS

MAIN CONTRACTOR :
CR Construction Company Limited

STRUCTURAL ENGINEER :
AECOM

FACADE CONSULTANT:
AECOM

NOTE :
1. ALL DIMENSIONS ARE IN mm.
2. ALL ELEVATIONS ARE VIEWED FROM OUTSIDE.
3. ALL DIMENSIONS TO BE VERIFIED ON SITE BEFORE FABRICATION.

LEGEND :
X1 / X001 — DETAIL MARK NO. / REFER SHEET NO.
1. F.F.L. --FINISHED FLOOR LEVEL
2. S.F.L. --STRUCTURAL FLOOR LEVEL
3. /R --REVERSED DETAIL

NO.	DATE	REVISED	BY
B	20/8/2019	GENERAL REVISED	
A	22/12/2018	GENERAL REVISED	

JOB NO. : J-837

PROJECT :
URA KWUN TONG TOWN CENTRE REDEVELOPMENT (AREA 2 & 3) AT NKIL 6514, KWUN TONG, KWLOON

TITLE :
TYPICAL MULLION DETAIL FOR CURTAIN WALL

DATE : 24-NOV-18 | SCALE : 1:2 (A1)

DRAWN BY : ASING | CHECKED BY : –

美特鋁質有限公司
MIDI ALUMINIUM FABRICATOR LTD.
Units 6-8, Sunray Industrial Centre, 1/F
610 Cha Kwo Ling Road, Kowloon
Tel:23489211-4 Fax:(852)27727666

DWG NO. : J837-CW-5013 | REV. : B

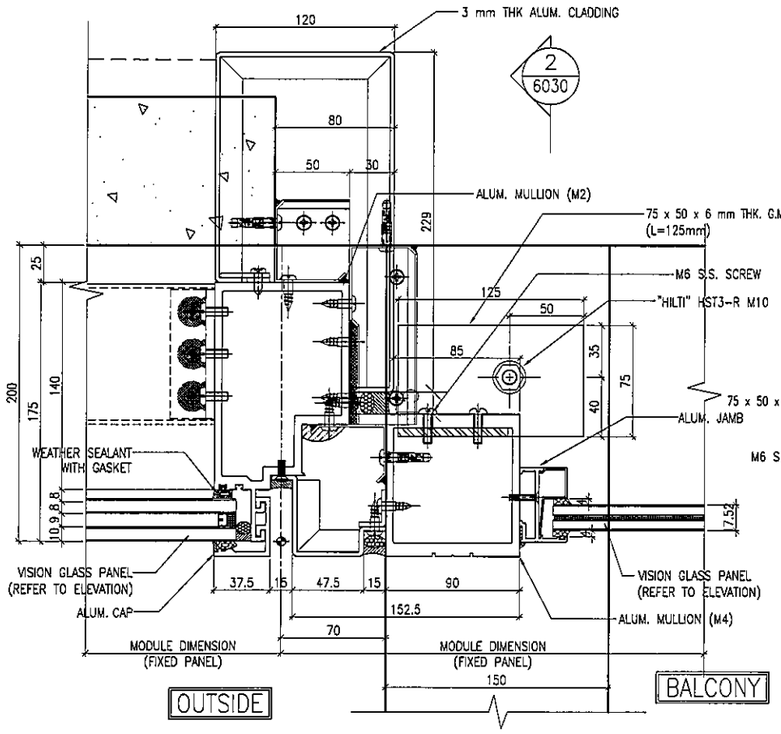

1/5014 TYPICAL MULLION DETAIL CURTAIN WALL

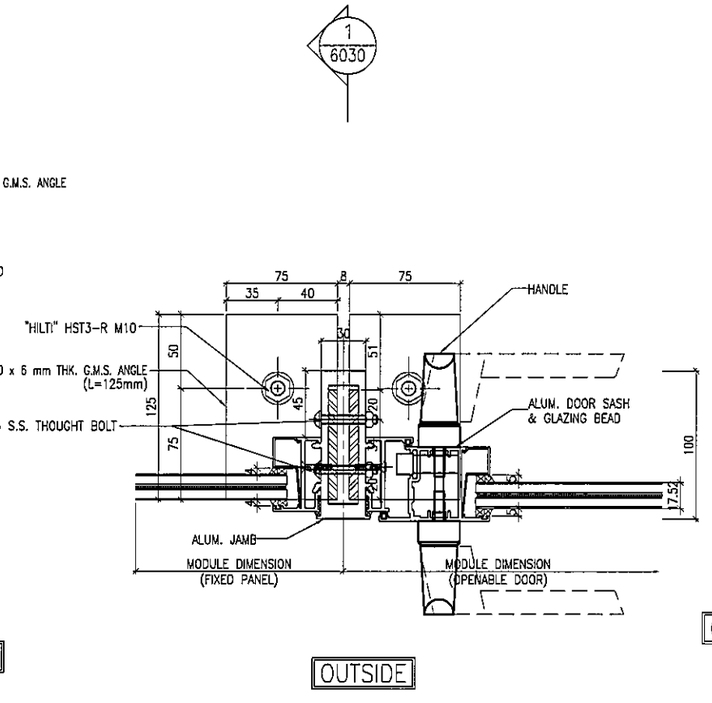

2/5014 TYPICAL MULLION DETAIL CURTAIN WALL

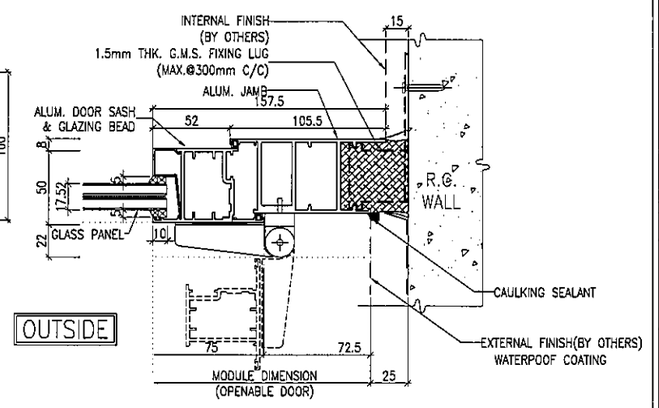

3/5014 TYPICAL MULLION DETAIL CURTAIN WALL

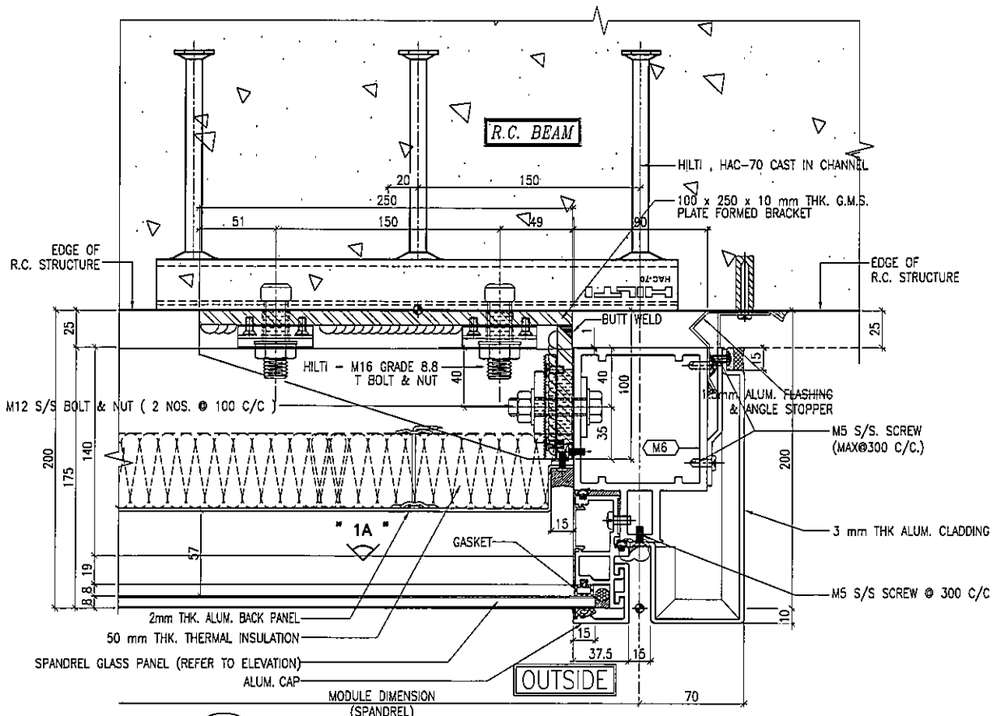

4/5014 TYPICAL MULLION DETAIL CURTAIN WALL

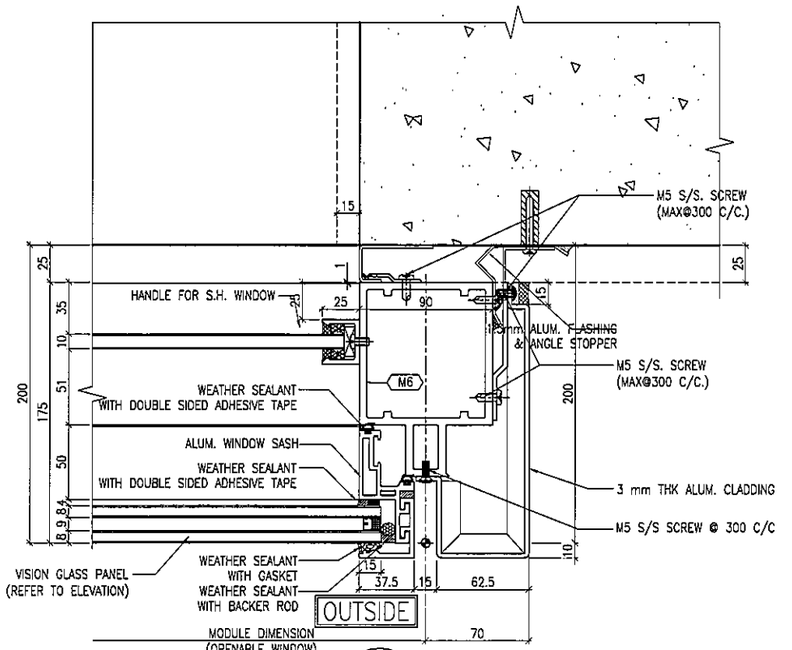

5/5014 TYPICAL MULLION DETAIL CURTAIN WALL

B.D. REF :

CLIENT :
信和置業有限公司
Sino Land Company Limited

ARCHITECT :
WONG TUNG & PARTNERS LIMITED
ARCHITECTS & PLANNERS

MAIN CONTRACTOR :
CR Construction Company Limited

STRUCTURAL ENGINEER :
AECOM

FACADE CONSULTANT:
AECOM

NOTE :
1. ALL DIMENSIONS ARE IN mm.
2. ALL ELEVATIONS ARE VIEWED FROM OUTSIDE.
3. ALL DIMENSIONS TO BE VERIFIED ON SITE BEFORE FABRICATION.

LEGEND :
X1 / X001 — DETAIL MARK NO. / REFER SHEET NO.
1. F.F.L. --FINISHED FLOOR LEVEL
2. S.F.L. --STRUCTURAL FLOOR LEVEL
3. /R --REVERSED DETAIL

NO.	DATE	REVISED	BY
A	15/02/2019	GENERAL REVISED	

JOB NO. : J-837

PROJECT :
URA KWUN TONG TOWN CENTRE REDEVELOPMENT (AREA 2 & 3) AT NKIL 6514, KWUN TONG, KWLOON

TITLE :
TYPICAL MULLION DETAIL FOR CURTAIN WALL

DATE : 22-DEC-18 | SCALE : 1:2 (A1)

DRAWN BY : ASING | CHECKED BY : -

美特鋁製有限公司
MIDI ALUMINIUM FABRICATOR LTD.
Units 6-8, Sunray Industrial Centre, 1/F
610 Cha Kwo Ling Road, Kowloon
Tel:23489211-4 Fax:(852)27727666

DWG NO. : J837-CW-5014 | REV. : A

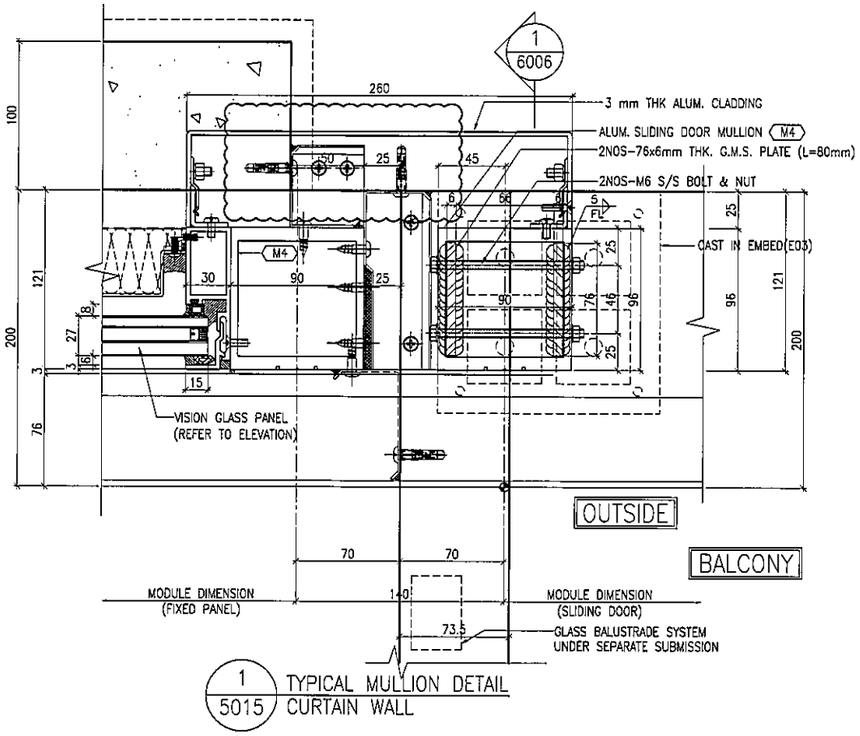

1 / 5015 TYPICAL MULLION DETAIL CURTAIN WALL

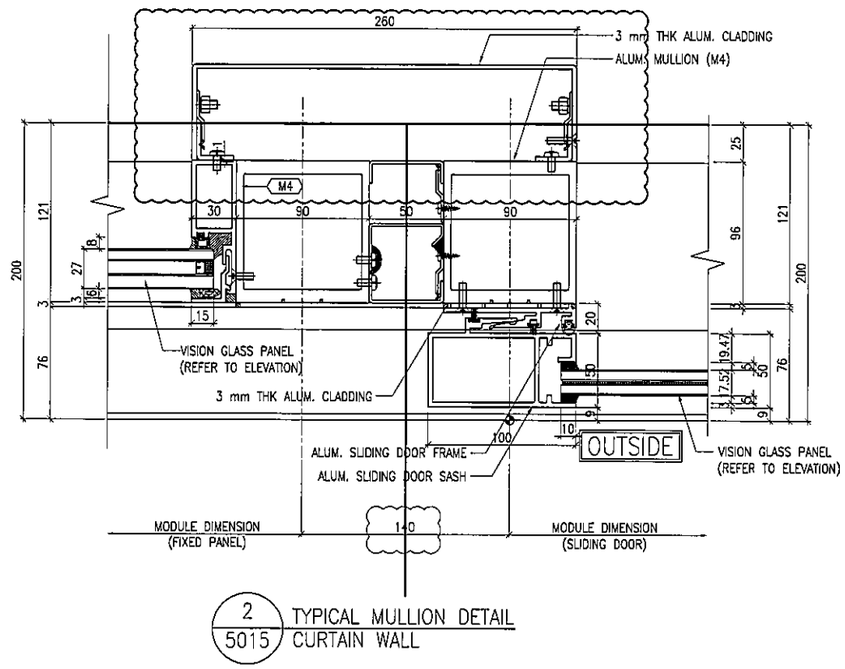

2 / 5015 TYPICAL MULLION DETAIL CURTAIN WALL

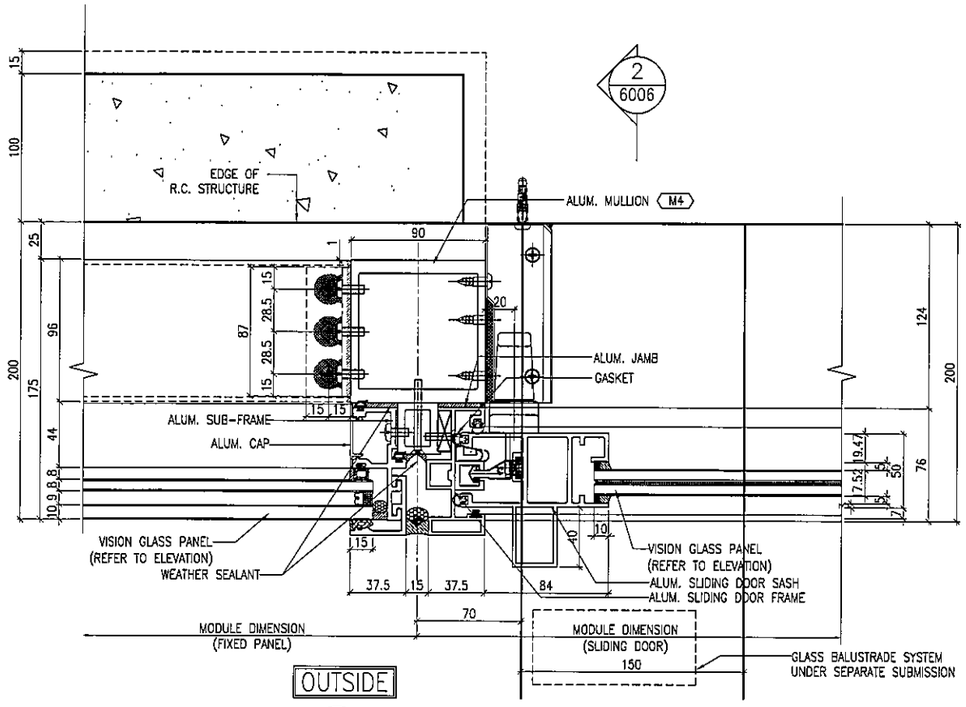

3 / 5015 TYPICAL MULLION DETAIL CURTAIN WALL

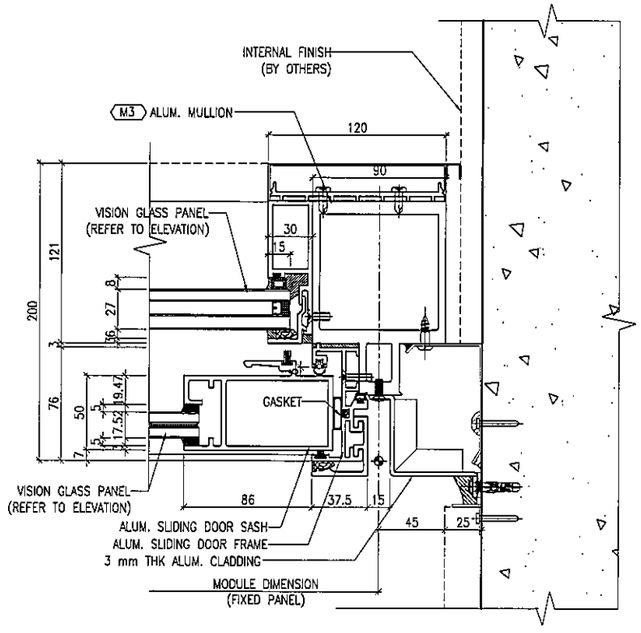

4 / 5015 TYPICAL MULLION DETAIL CURTAIN WALL

B.D. REF :

CLIENT :
信和置業有限公司
Sino Land Company Limited

ARCHITECT :
WONG TUNG & PARTNERS LIMITED
ARCHITECTS & PLANNERS

MAIN CONTRACTOR :
CR Construction Company Limited

STRUCTURAL ENGINEER :
AECOM

FACADE CONSULTANT:
AECOM

NOTE :
1. ALL DIMENSIONS ARE IN mm.
2. ALL ELEVATIONS ARE VIEWED FROM OUTSIDE.
3. ALL DIMENSIONS TO BE VERIFIED ON SITE BEFORE FABRICATION.

LEGEND :
X1 / XOO1 — DETAIL MARK NO. / REFER SHEET NO.
1. F.F.L. --FINISHED FLOOR LEVEL
2. S.F.L. --STRUCTURAL FLOOR LEVEL
3. (R) --REVERSED DETAIL

NO.	DATE	REVISED	BY
B	26/5/2019	GENERAL REVISED	
A	6/3/2019	GENERAL REVISED	

JOB NO. : J-837

PROJECT :
URA KWUN TONG TOWN CENTRE
REDEVELOPMENT (AREA 2 & 3) AT
NKIL 6514, KWUN TONG, KWLOON

TITLE :
TYPICAL MULLION DETAIL
FOR CURTAIN WALL

DATE : 28-JAN-19 | SCALE : 1:2 (A1)

DRAWN BY : ASING | CHECKED BY : -

美特鋁質有限公司
MIDI ALUMINUM FABRICATOR LTD.
Units 6-8, Sunray Industrial Centre, 1/F
610 Cha Kwo Ling Road, Kowloon
Tel:23489211-4 Fax:(852)27727666

DWG NO. : J837-CW-5015 | REV. : B

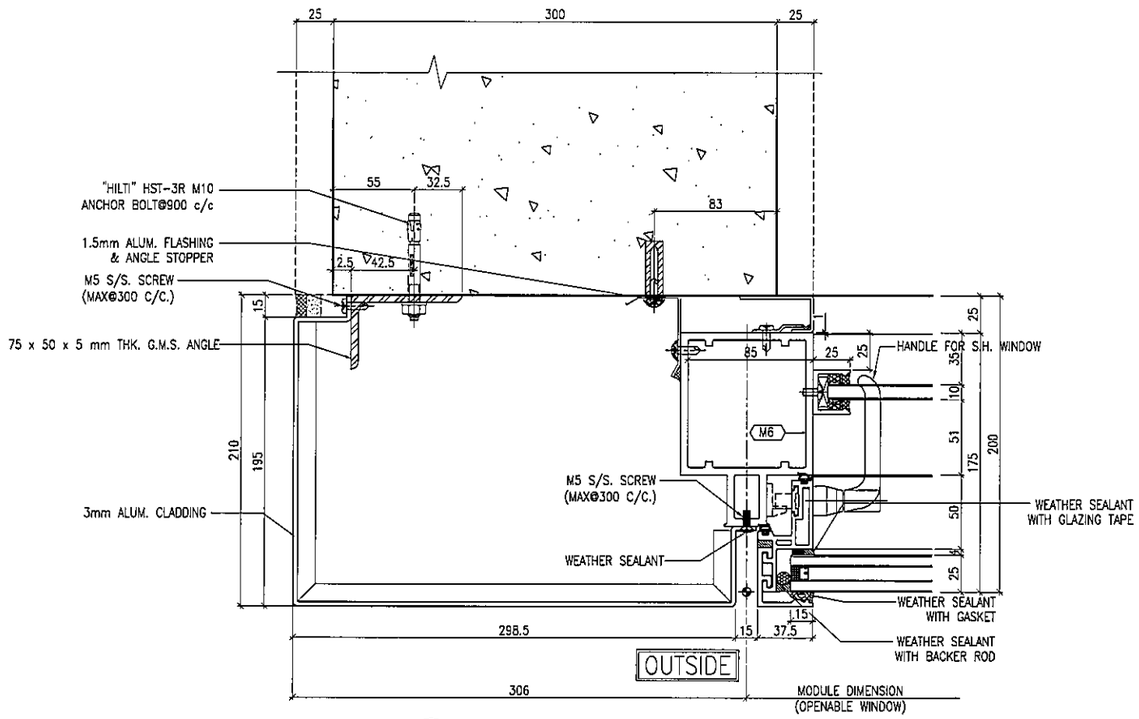

1 / 5016 TYPICAL MULLION DETAIL(FOR T1F/T2N) CURTAIN WALL

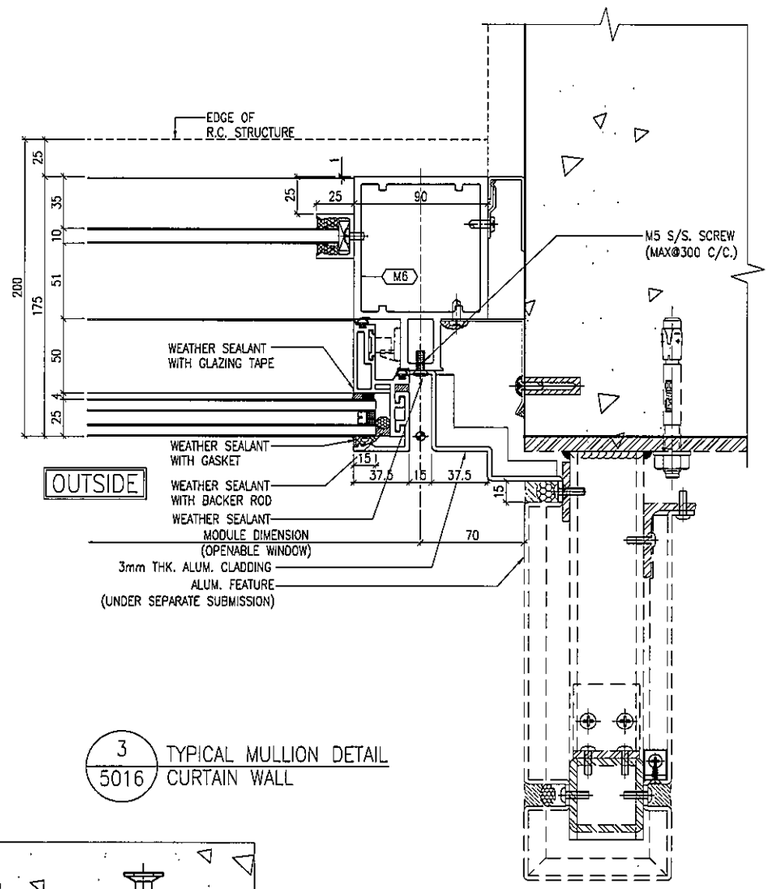

3 / 5016 TYPICAL MULLION DETAIL CURTAIN WALL

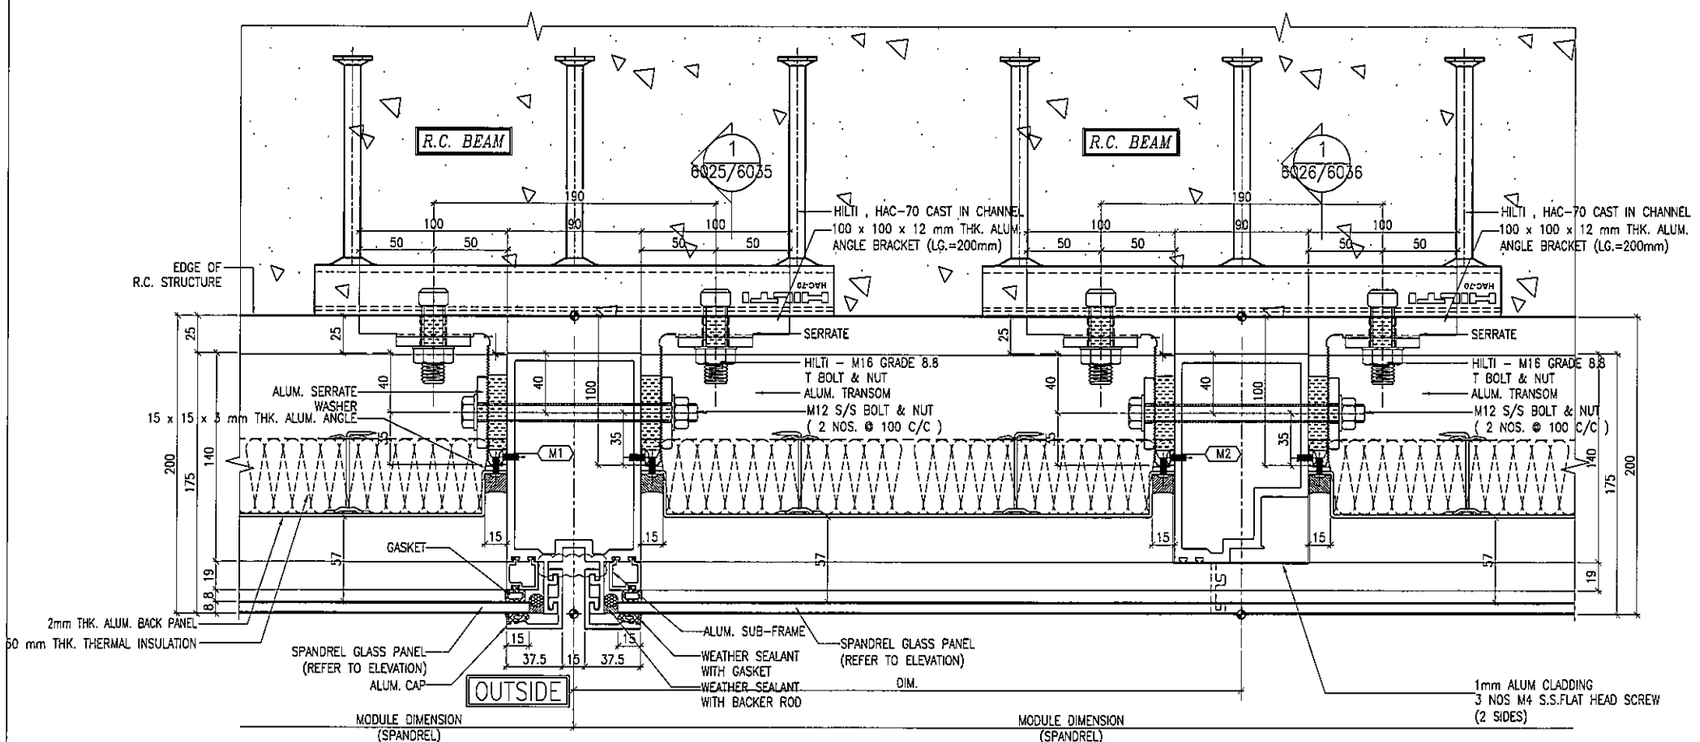

2 / 5016 TYPICAL MULLION DETAIL CURTAIN WALL

B.D. REF :

CLIENT :
信和置業有限公司
Sino Land Company Limited

ARCHITECT :
WONG TUNG & PARTNERS LIMITED
ARCHITECTS & PLANNERS

MAIN CONTRACTOR :
CR Construction Company Limited

STRUCTURAL ENGINEER :
AECOM

FACADE CONSULTANT:
AECOM

NOTE :
1. ALL DIMENSIONS ARE IN mm.
2. ALL ELEVATIONS ARE VIEWED FROM OUTSIDE.
3. ALL DIMENSIONS TO BE VERIFIED ON SITE BEFORE FABRICATION.

LEGEND :
X1 / XG01 — DETAIL MARK NO. / REFER SHEET NO.
1. F.F.L. --FINISHED FLOOR LEVEL
2. S.F.L. --STRUCTURAL FLOOR LEVEL
3. (R) --REVERSED DETAIL

NO.	DATE	REVISED	BY

JOB NO. : J-837

PROJECT :
URA KWUN TONG TOWN CENTRE
REDEVELOPMENT (AREA 2 & 3) AT
NKIL 6514, KWUN TONG, KWLOON

TITLE :
TYPICAL MULLION DETAIL
FOR CURTAIN WALL

DATE : 28-JAN-19 | SCALE : 1:2 (A1)

DRAWN BY : ASING | CHECKED BY : -

美特鋁質有限公司
MIDI ALUMINIUM FABRICATOR LTD.
Units 6-8, Sunray Industrial Centre, 1/F
610 Cha Kwo Ling Road, Kowloon
Tel:23489211-4 Fax:(852)27727666

DWG NO. : J837-CW-5015 | REV. : -

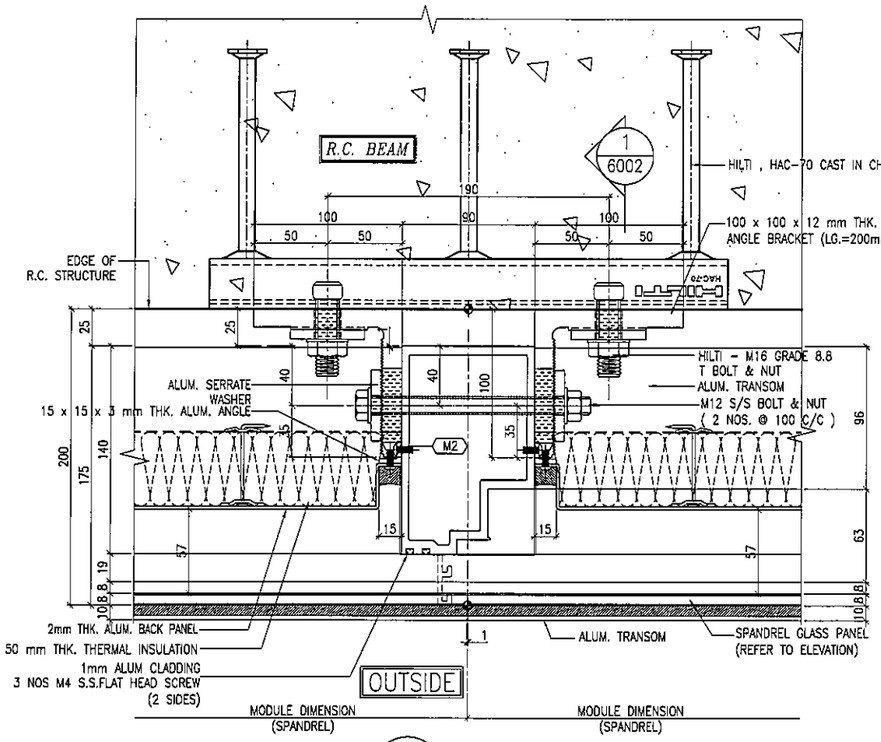

1 / 5017 TYPICAL MULLION DETAIL CURTAIN WALL

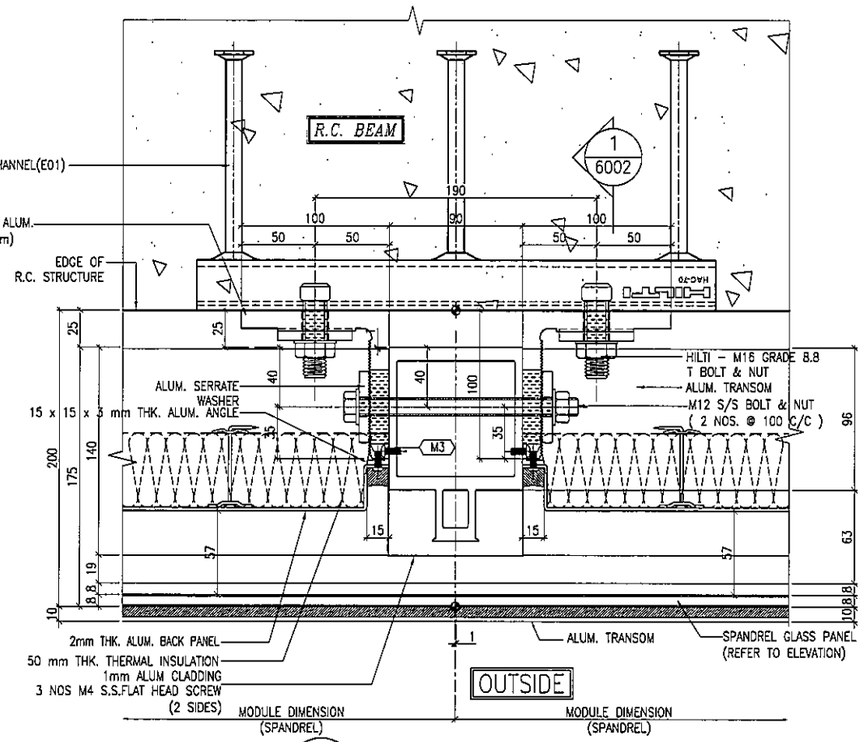

2 / 5017 TYPICAL MULLION DETAIL CURTAIN WALL

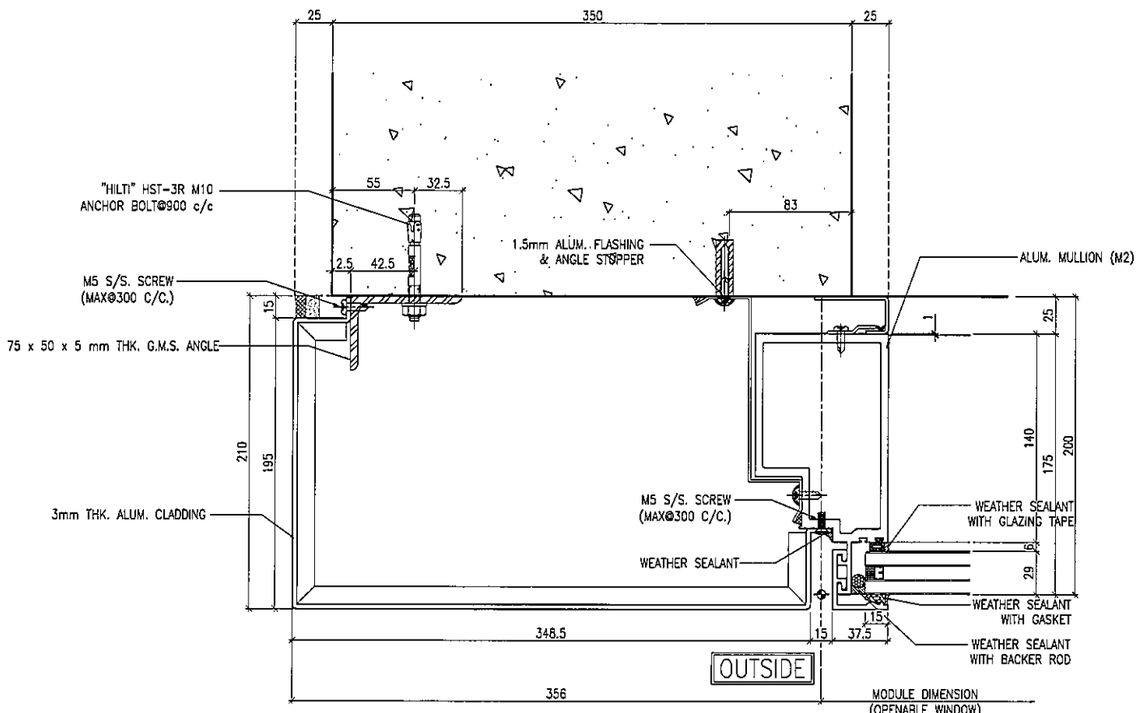

3 / 5017 TYPICAL MULLION DETAIL(for T1A only) CURTAIN WALL

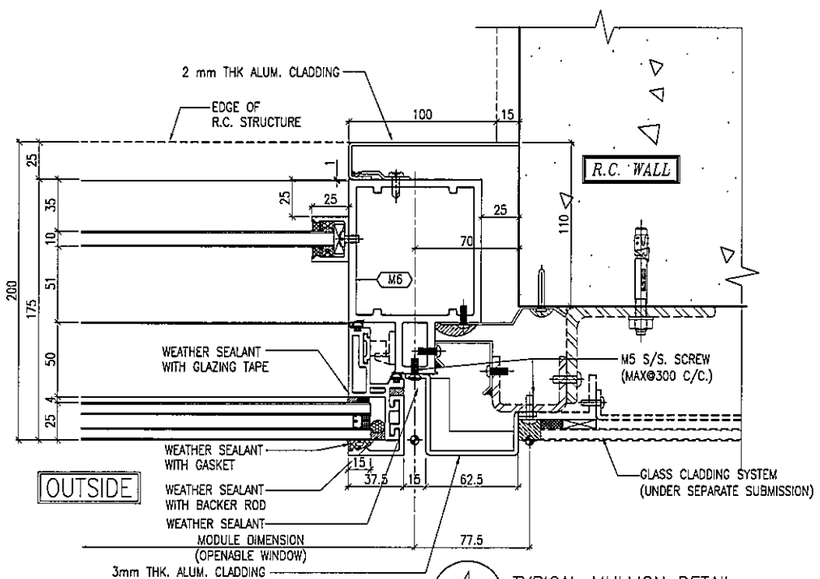

4 / 5017 TYPICAL MULLION DETAIL CURTAIN WALL

B.D. REF :

CLIENT :
信和置業有限公司
Sino Land Company Limited

ARCHITECT :
WONG TUNG & PARTNERS LIMITED
ARCHITECTS & PLANNERS

MAIN CONTRACTOR :
CR Construction Company Limited

STRUCTURAL ENGINEER :
AECOM

FACADE CONSULTANT:
AECOM

NOTE :
1. ALL DIMENSIONS ARE IN mm.
2. ALL ELEVATIONS ARE VIEWED FROM OUTSIDE.
3. ALL DIMENSIONS TO BE VERIFIED ON SITE BEFORE FABRICATION.

LEGEND :
- X1 / X001 — DETAIL MARK NO. / REFER SHEET NO.
1. F.F.L. --FINISHED FLOOR LEVEL
2. S.F.L. --STRUCTURAL FLOOR LEVEL
3. (/R) --REVERSED DETAIL

NO.	DATE	REVISED	BY

JOB NO. : J-837

PROJECT :
URA KWUN TONG TOWN CENTRE REDEVELOPMENT (AREA 2 & 3) AT NKIL 6514, KWUN TONG, KWLOON

TITLE :
TYPICAL MULLION DETAIL FOR CURTAIN WALL

DATE : 28-JAN-19 | SCALE : 1:2 (A1)

DRAWN BY : ASING | CHECKED BY : -

美特鋁質有限公司
MIDI ALUMINIUM FABRICATOR LTD.
Units 6-8, Sunray Industrial Centre, 1/F
610 Cha Kwo Ling Road, Kowloon
Tel:23489211-4 Fax:(852)27727666

DWG NO. : J837-CW-5017 | REV. : -

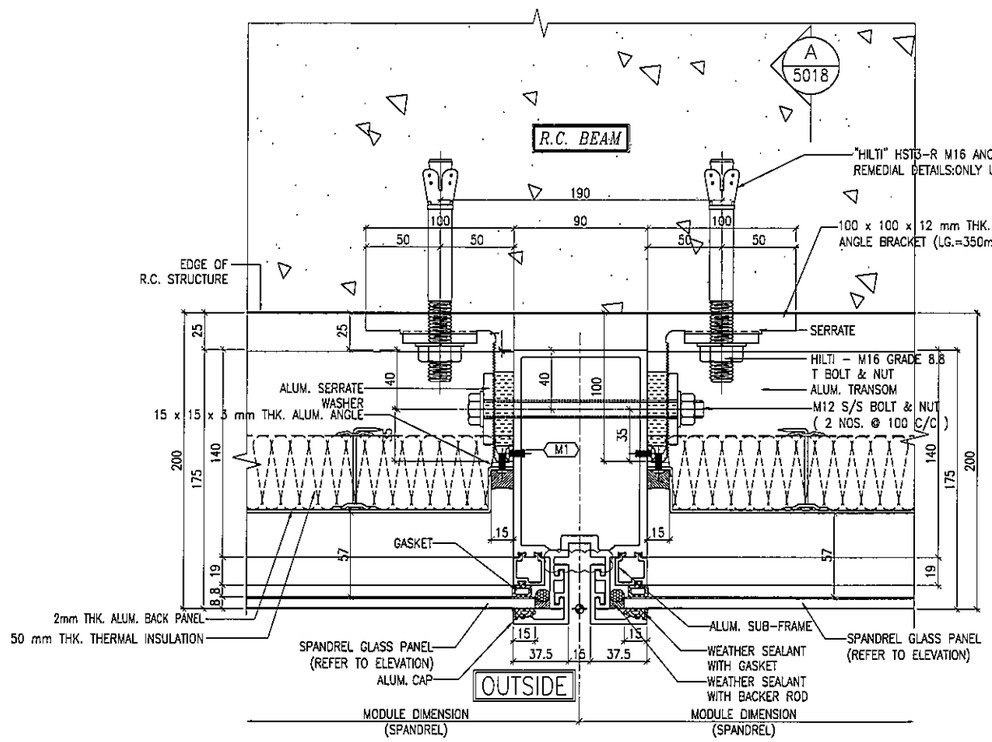

1 / 5018 REMEDIAL DETAILS CURTAIN WALL

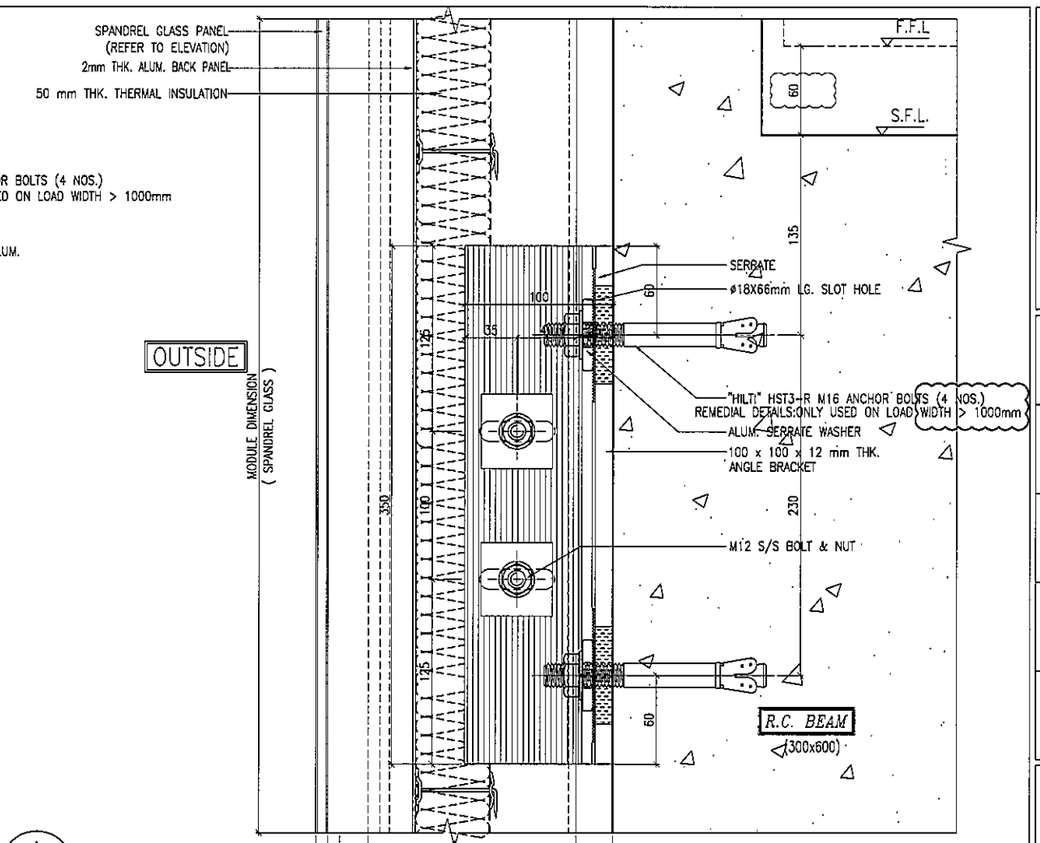

A / 5018 REMEDIAL DETAILS CURTAIN WALL

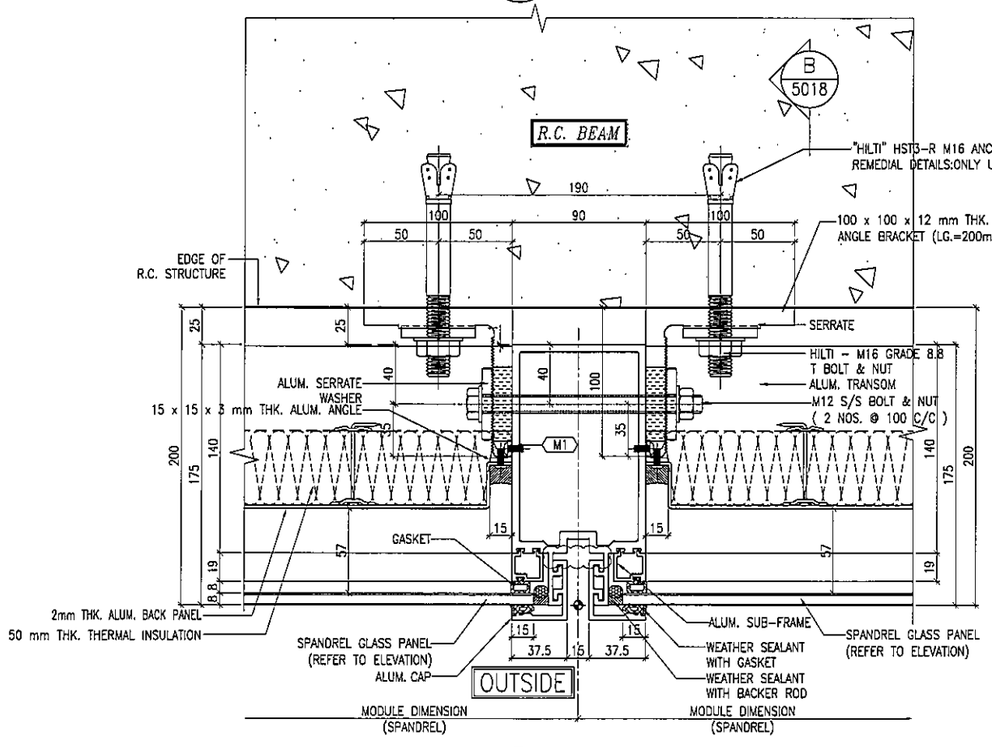

2 / 5018 REMEDIAL DETAILS CURTAIN WALL

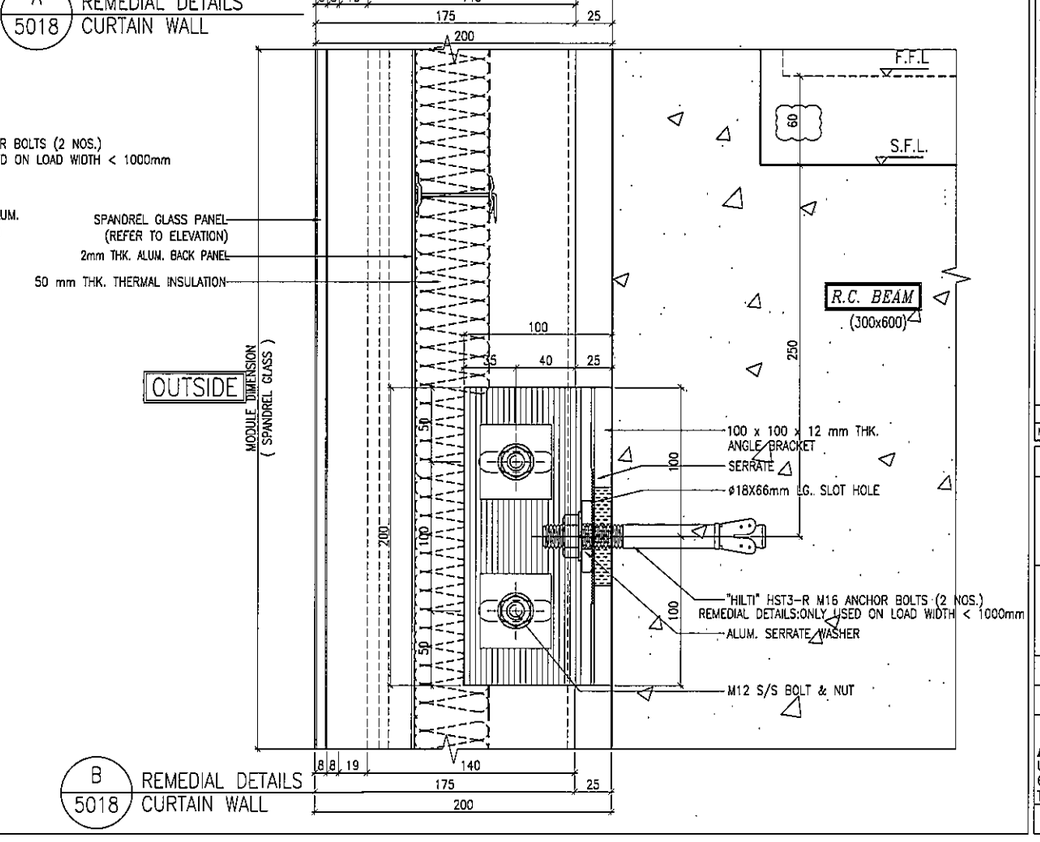

B / 5018 REMEDIAL DETAILS CURTAIN WALL

B.D. REF :

CLIENT :
信和置業有限公司
Sino Land Company Limited

ARCHITECT :
WONG TUNG & PARTNERS LIMITED
ARCHITECTS & PLANNERS

MAIN CONTRACTOR :
CR Construction Company Limited

STRUCTURAL ENGINEER :
AECOM

FACADE CONSULTANT:
AECOM

NOTE :
1. ALL DIMENSIONS ARE IN mm.
2. ALL ELEVATIONS ARE VIEWED FROM OUTSIDE.
3. ALL DIMENSIONS TO BE VERIFIED ON SITE BEFORE FABRICATION.

LEGEND :
X1 / X001 — DETAIL MARK NO. / REFER SHEET NO.
1. F.F.L. --FINISHED FLOOR LEVEL
2. S.F.L. --STRUCTURAL FLOOR LEVEL
3. (R) --REVERSED DETAIL

NO.	DATE	REVISED	BY
A	15/02/2019	GENERAL REVISED	

JOB NO. : J-837

PROJECT :
URA KWUN TONG TOWN CENTRE
REDEVELOPMENT (AREA 2 & 3) AT
NKIL 6514, KWUN TONG, KWLOON

TITLE :
REMEDIAL DETAILS
FOR CURTAIN WALL

DATE : 28-JAN-19 | SCALE : 1:2 (A1)

DRAWN BY : ASING | CHECKED BY : --

美特鋁製有限公司
MIDI ALUMINIUM FABRICATOR LTD.
Units 6-8, Sunray Industrial Centre, 1/F
610 Cha Kwo Ling Road, Kowloon
Tel:23489211-4 Fax:(852)27727666

DWG NO. : J837-CW-5018 | REV. : A

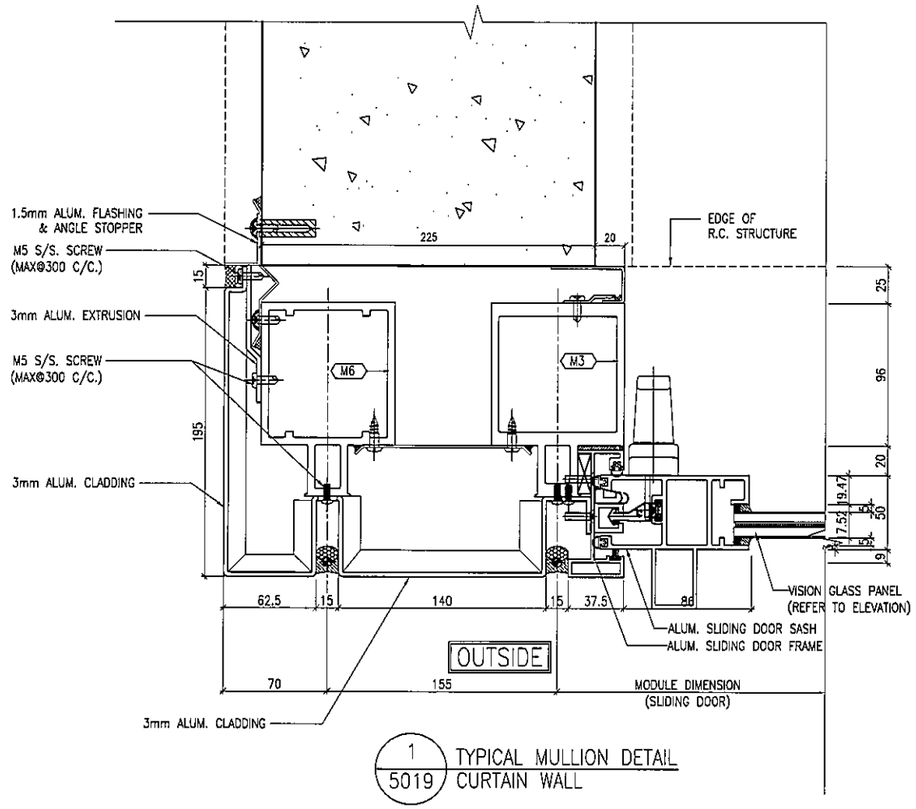

1 / 5019 TYPICAL MULLION DETAIL CURTAIN WALL

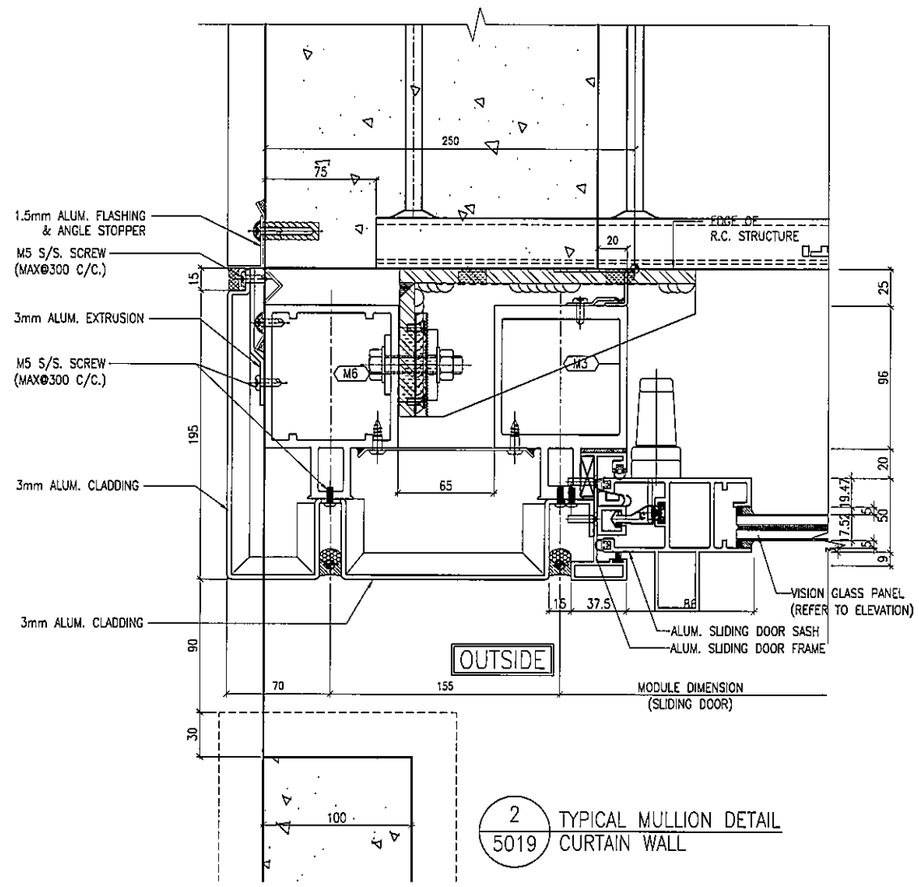

2 / 5019 TYPICAL MULLION DETAIL CURTAIN WALL

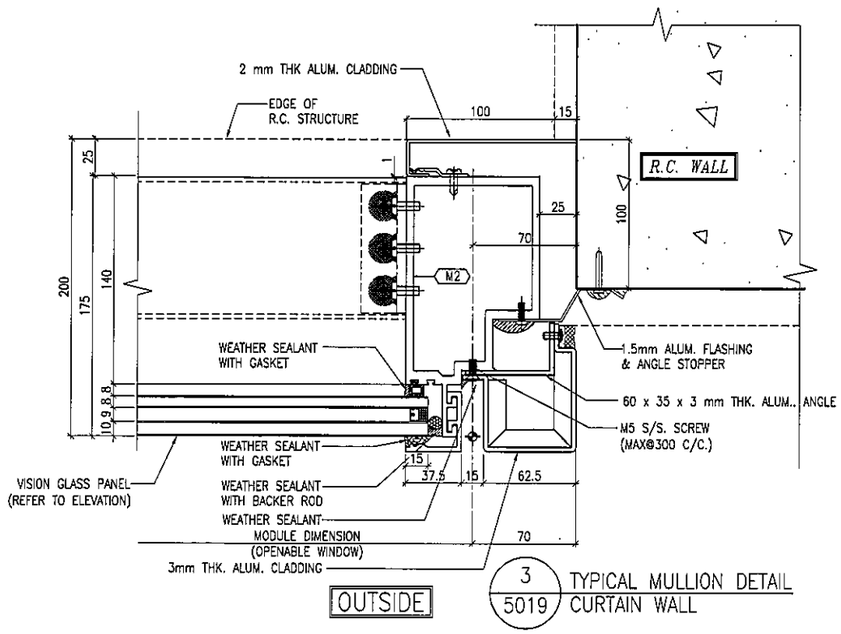

3 / 5019 TYPICAL MULLION DETAIL CURTAIN WALL

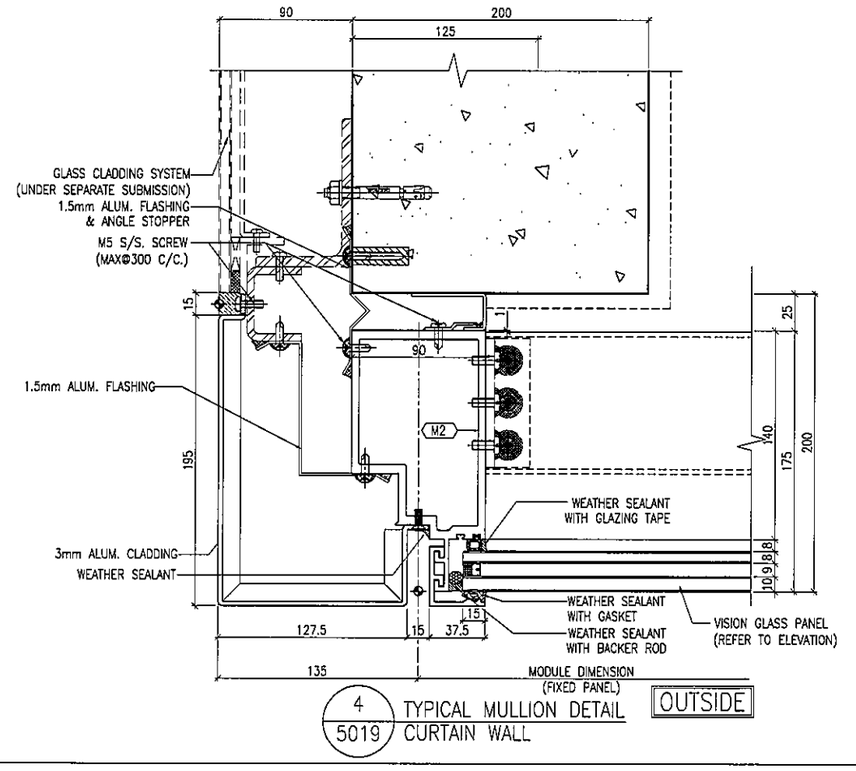

4 / 5019 TYPICAL MULLION DETAIL CURTAIN WALL

B.D. REF :

CLIENT :
信和置業有限公司
Sino Land Company Limited

ARCHITECT :
WONG TUNG & PARTNERS LIMITED
ARCHITECTS & PLANNERS

MAIN CONTRACTOR :
CR Construction Company Limited

STRUCTURAL ENGINEER :
AECOM

FACADE CONSULTANT:
AECOM

NOTE :
1. ALL DIMENSIONS ARE IN mm.
2. ALL ELEVATIONS ARE VIEWED FROM OUTSIDE.
3. ALL DIMENSIONS TO BE VERIFIED ON SITE BEFORE FABRICATION.

LEGEND :
- X1 / X001 — DETAIL MARK NO. / REFER SHEET NO.
1. F.F.L. --FINISHED FLOOR LEVEL
2. S.F.L. --STRUCTURAL FLOOR LEVEL
3. (/R) --REVERSED DETAIL

NO.	DATE	REVISED	BY

JOB NO. : J-837

PROJECT :
URA KWUN TONG TOWN CENTRE REDEVELOPMENT (AREA 2 & 3) AT NKIL 6514, KWUN TONG, KWLOON

TITLE :
TYPICAL MULLION DETAIL FOR CURTAIN WALL

DATE : 28-JAN-19	SCALE : 1:2 (A1)
DRAWN BY : ASING	CHECKED BY : -

美特鋁質有限公司
MIDI ALUMINIUM FABRICATOR LTD.
Units 6-8, Sunray Industrial Centre, 1/F
610 Cha Kwo Ling Road, Kowloon
Tel:23489211-4 Fax:(852)27727666

DWG NO. : J837-CW-5019 | REV. : -

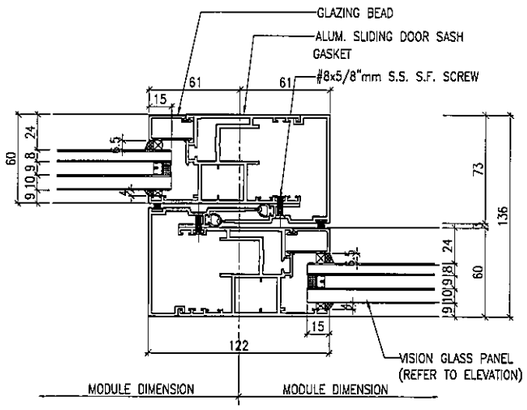

1 / 5020 TYPICAL MULLION DETAIL CURTAIN WALL

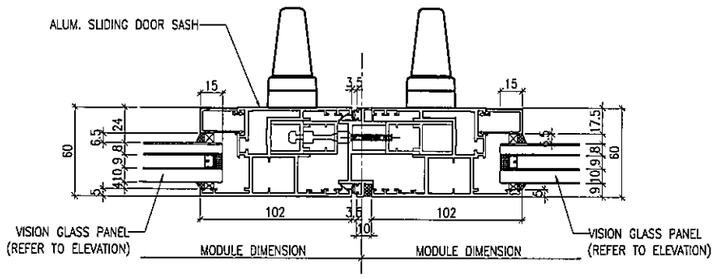

2 / 5020 TYPICAL MULLION DETAIL CURTAIN WALL

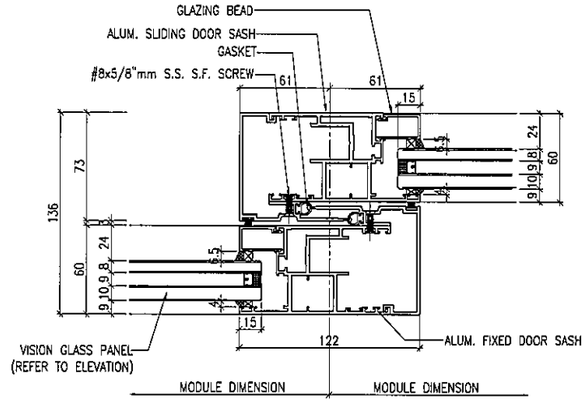

3 / 5020 TYPICAL MULLION DETAIL CURTAIN WALL

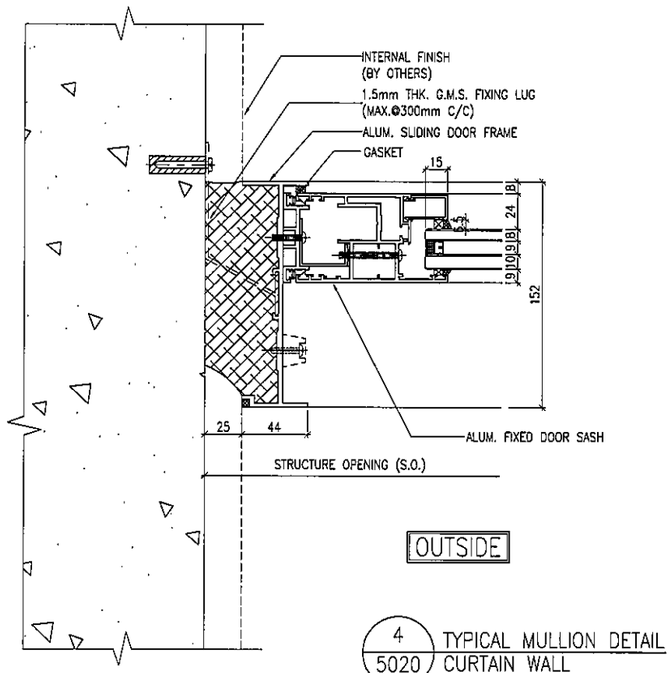

4 / 5020 TYPICAL MULLION DETAIL CURTAIN WALL

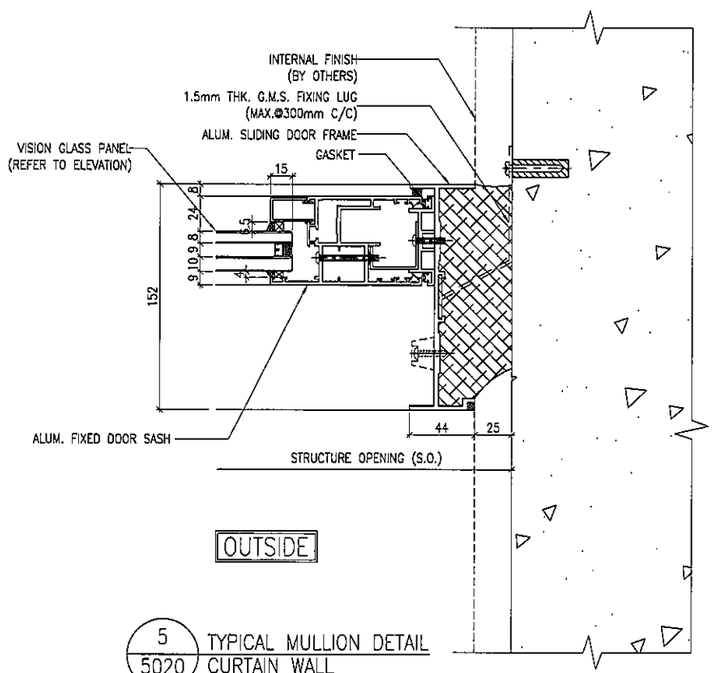

5 / 5020 TYPICAL MULLION DETAIL CURTAIN WALL

B.D. REF :

CLIENT :
信和置業有限公司
Sino Land Company Limited

ARCHITECT :
WONG TUNG & PARTNERS LIMITED
ARCHITECTS & PLANNERS

MAIN CONTRACTOR :
CR Construction Company Limited

STRUCTURAL ENGINEER :
AECOM

FACADE CONSULTANT:
AECOM

NOTE :
1. ALL DIMENSIONS ARE IN mm.
2. ALL ELEVATIONS ARE VIEWED FROM OUTSIDE.
3. ALL DIMENSIONS TO BE VERIFIED ON SITE BEFORE FABRICATION.

LEGEND :
X1 / X001 — DETAIL MARK NO. / REFER SHEET NO.
1. F.F.L. --FINISHED FLOOR LEVEL
2. S.F.L. --STRUCTURAL FLOOR LEVEL
3. /R --REVERSED DETAIL

NO.	DATE	REVISED	BY

JOB NO. : J-837

PROJECT :
URA KWUN TONG TOWN CENTRE REDEVELOPMENT (AREA 2 & 3) AT NKIL 6514, KWUN TONG, KWLOON

TITLE :
TYPICAL MULLION DETAIL FOR CURTAIN WALL

DATE : 28-JAN-19 | SCALE : 1:2 (A1)

DRAWN BY : ASING | CHECKED BY : --

美特鋁質有限公司
MIDI ALUMINIUM FABRICATOR LTD.
Units 6-8, Sunray Industrial Centre, 1/F
610 Cha Kwo Ling Road, Kowloon
Tel:23489211-4 Fax:(852)27727666

DWG NO. : J837-CW-5020 | REV. : --

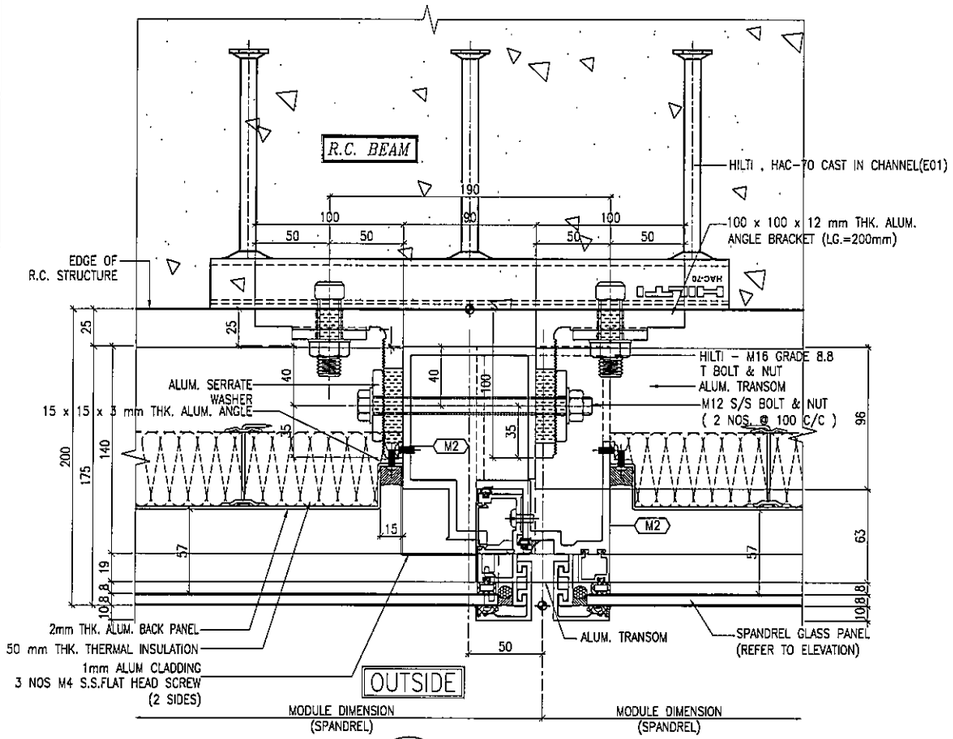

1 / 5021 TYPICAL MULLION DETAIL CURTAIN WALL

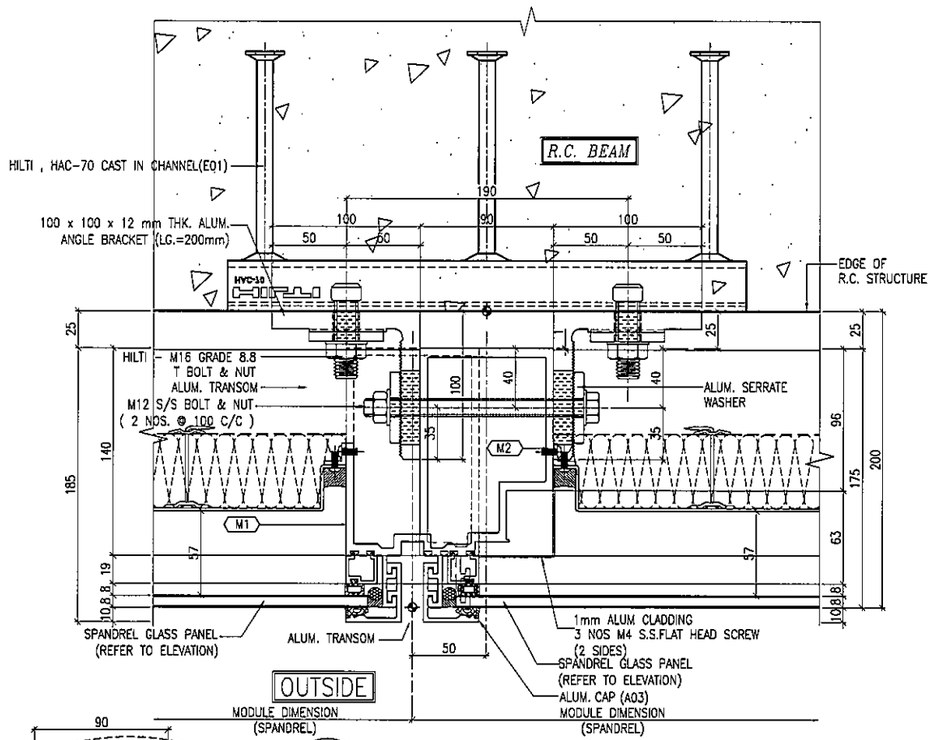

2 / 5021 TYPICAL MULLION DETAIL CURTAIN WALL

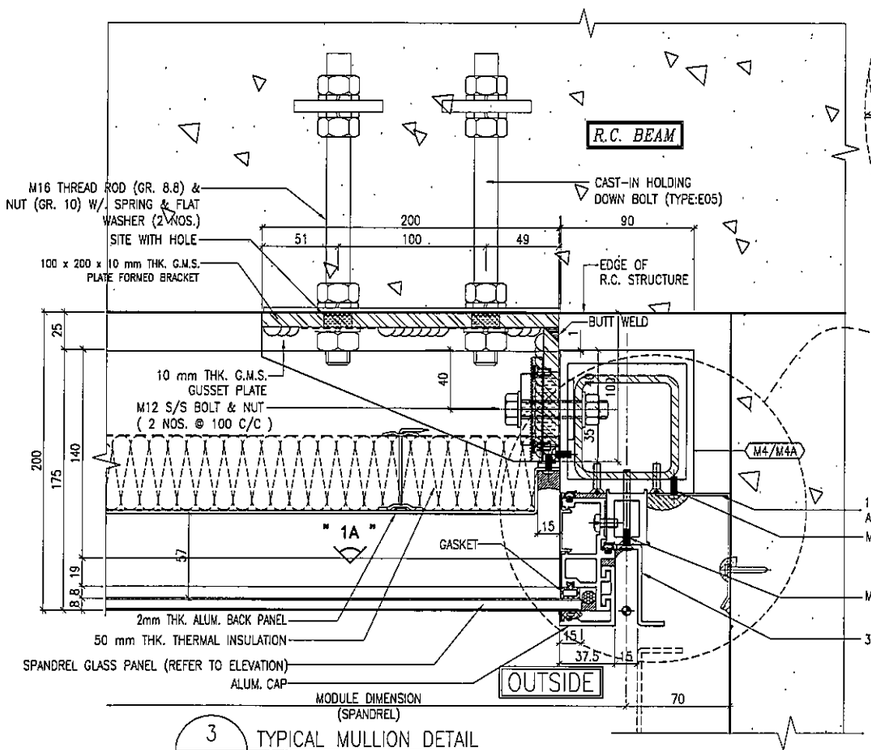

3 / 5021 TYPICAL MULLION DETAIL CURTAIN WALL

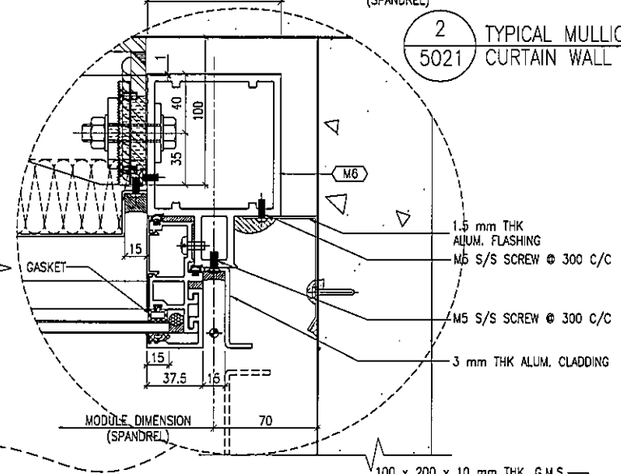

4 / 5021 TYPICAL MULLION DETAIL CURTAIN WALL

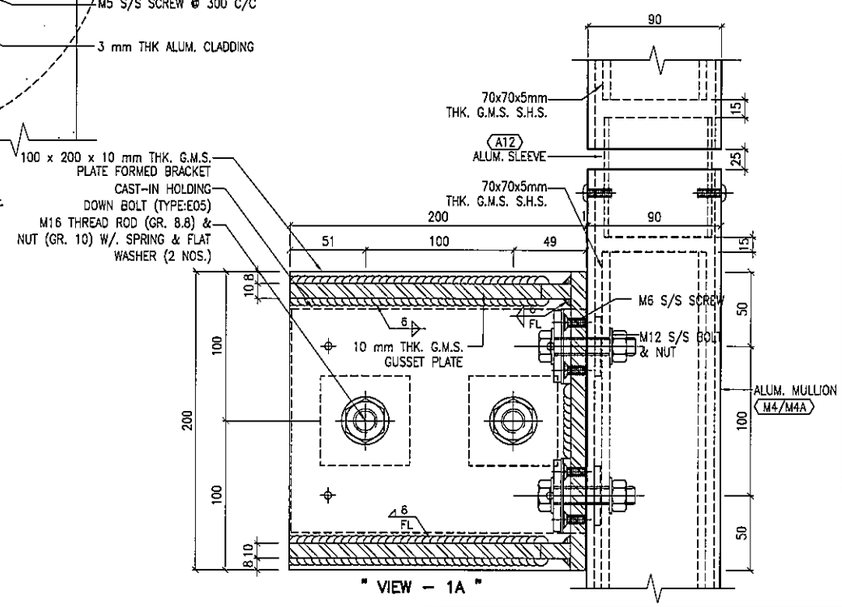

B.D. REF :

CLIENT :
信和置業有限公司
Sino Land Company Limited

ARCHITECT :
WONG TUNG & PARTNERS LIMITED
ARCHITECTS & PLANNERS

MAIN CONTRACTOR :
CR Construction Company Limited

STRUCTURAL ENGINEER :
AECOM

FACADE CONSULTANT:
AECOM

NOTE :
1. ALL DIMENSIONS ARE IN mm.
2. ALL ELEVATIONS ARE VIEWED FROM OUTSIDE.
3. ALL DIMENSIONS TO BE VERIFIED ON SITE BEFORE FABRICATION.

LEGEND :
X1 / X001 — DETAIL MARK NO. / REFER SHEET NO.
1. F.F.L. --FINISHED FLOOR LEVEL
2. S.F.L. --STRUCTURAL FLOOR LEVEL
3. /R --REVERSED DETAIL

NO.	DATE	REVISED	BY

JOB NO. : J-837

PROJECT :
URA KWUN TONG TOWN CENTRE REDEVELOPMENT (AREA 2 & 3) AT NKIL 6514, KWUN TONG, KWLOON

TITLE :
TYPICAL MULLION DETAIL FOR CURTAIN WALL

DATE : 28-JAN-19 | SCALE : 1:2 (A1)

DRAWN BY : ASING | CHECKED BY : -

美特鋁質有限公司
MIDI ALUMINIUM FABRICATOR LTD.
Units 6-8, Sunray Industrial Centre, 1/F
610 Cha Kwo Ling Road, Kowloon
Tel:23489211-4 Fax:(852)27727666

DWG NO. : J837-CW-5021 | REV. : -

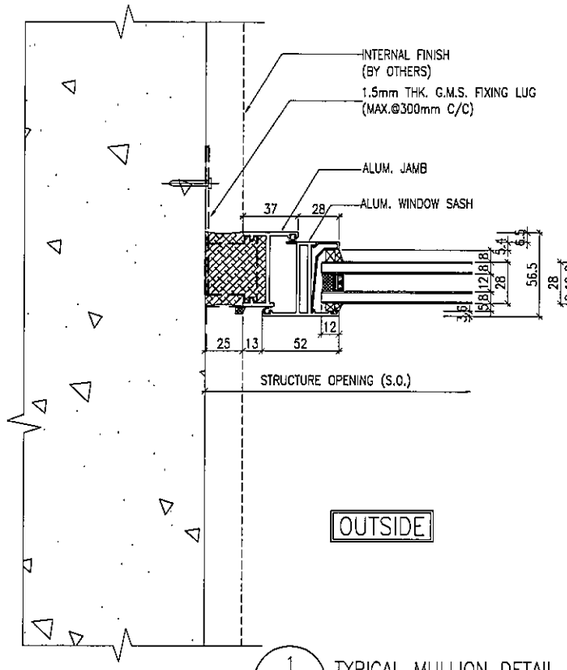

1 / 5022 TYPICAL MULLION DETAIL CURTAIN WALL

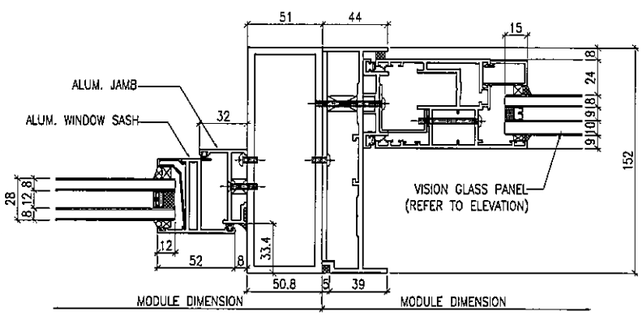

2 / 5022 TYPICAL MULLION DETAIL CURTAIN WALL

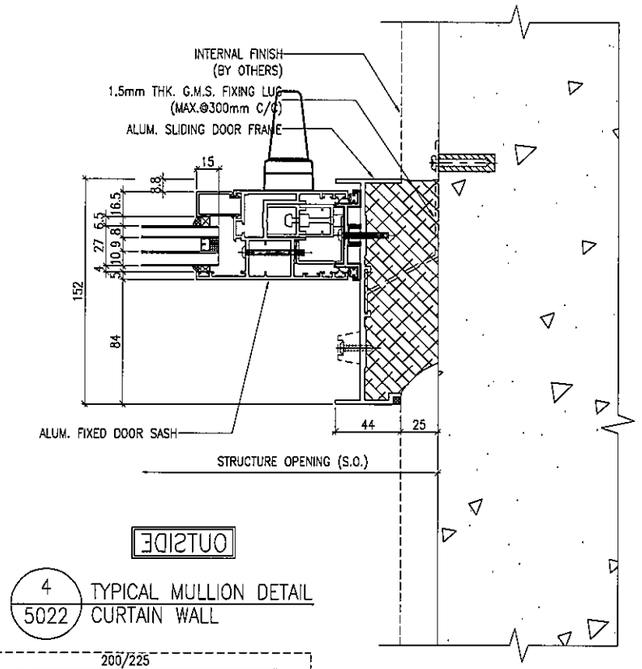

4 / 5022 TYPICAL MULLION DETAIL CURTAIN WALL

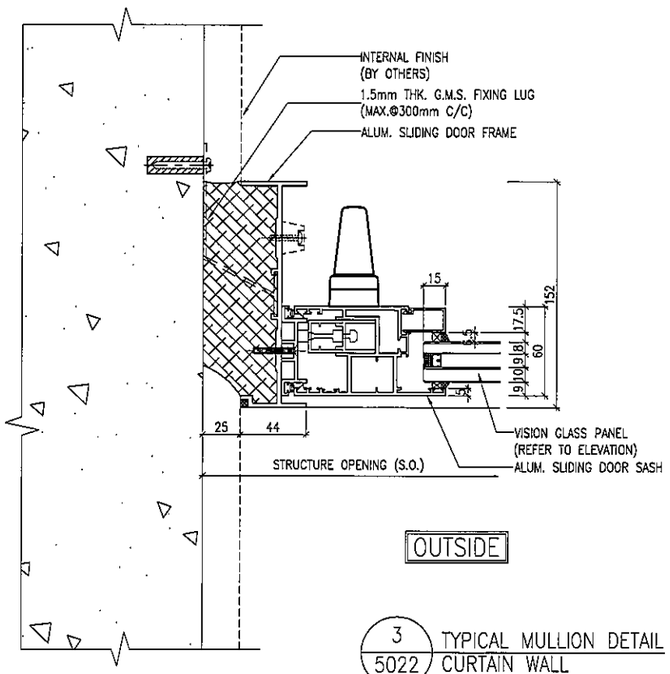

3 / 5022 TYPICAL MULLION DETAIL CURTAIN WALL

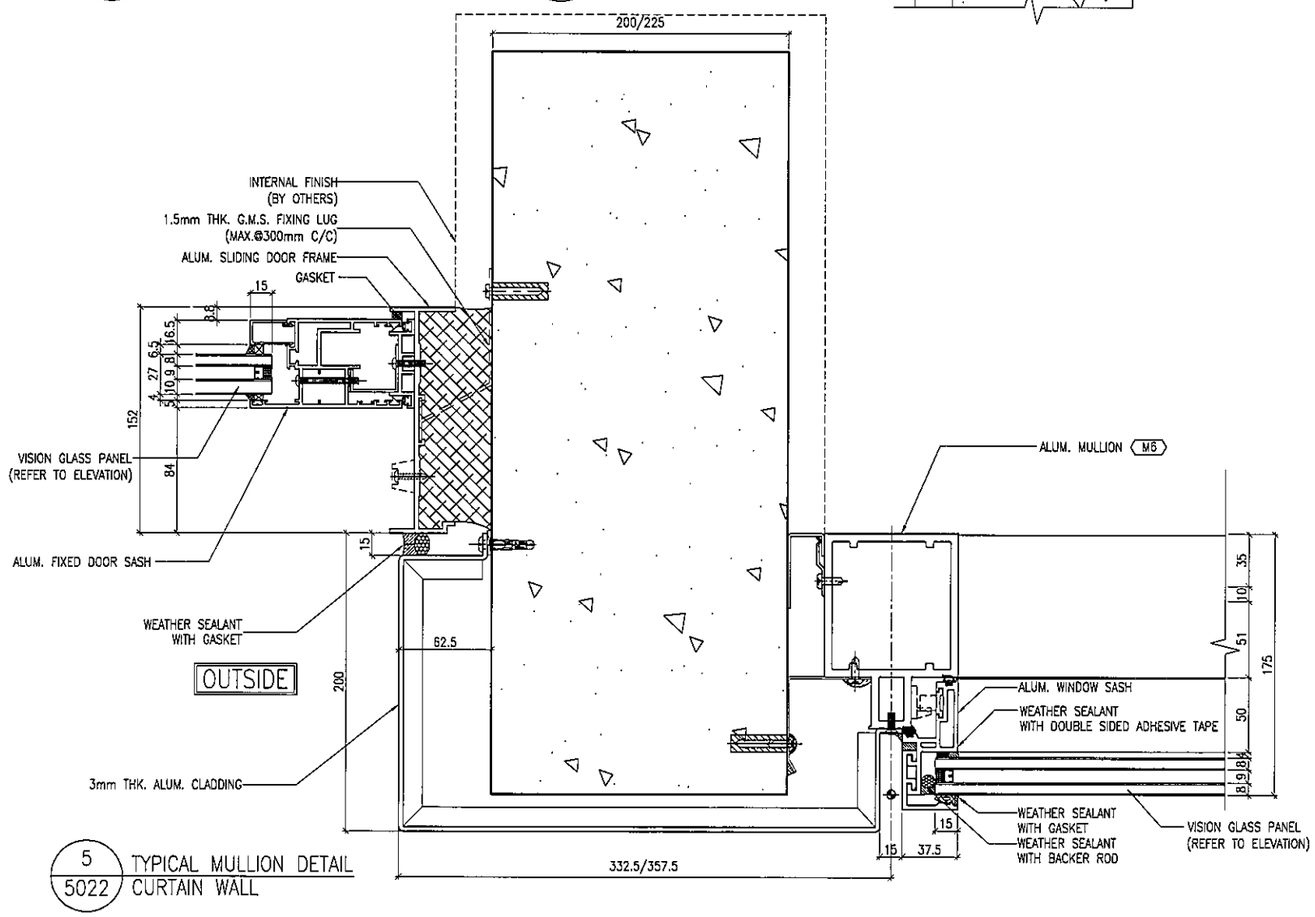

5 / 5022 TYPICAL MULLION DETAIL CURTAIN WALL

B.D. REF :

CLIENT :
信和置業有限公司
Sino Land Company Limited

ARCHITECT :
WONG TUNG & PARTNERS LIMITED
ARCHITECTS & PLANNERS

MAIN CONTRACTOR :
CR Construction Company Limited

STRUCTURAL ENGINEER :
AECOM

FACADE CONSULTANT:
AECOM

NOTE :
1. ALL DIMENSIONS ARE IN mm.
2. ALL ELEVATIONS ARE VIEWED FROM OUTSIDE.
3. ALL DIMENSIONS TO BE VERIFIED ON SITE BEFORE FABRICATION.

LEGEND :
X1 / X091 — DETAIL MARK NO. / REFER SHEET NO.
1. F.F.L. --FINISHED FLOOR LEVEL
2. S.F.L. --STRUCTURAL FLOOR LEVEL
3. /R --REVERSED DETAIL

NO.	DATE	REVISED	BY

JOB NO. : J-837

PROJECT :
URA KWUN TONG TOWN CENTRE
REDEVELOPMENT (AREA 2 & 3) AT
NKIL 6514, KWUN TONG, KWLOON

TITLE :
TYPICAL MULLION DETAIL
FOR CURTAIN WALL

DATE : 16-JUL-19	SCALE : 1:2 (A1)
DRAWN BY : ASING	CHECKED BY : -

美特鋁質有限公司
MIDI ALUMINIUM FABRICATOR LTD.
Units 6-8, Sunray Industrial Centre, 1/F
610 Cha Kwo Ling Road, Kowloon
Tel:23489211-4 Fax:(852)27727666

DWG NO. : J837-CW-5022 | REV. : -

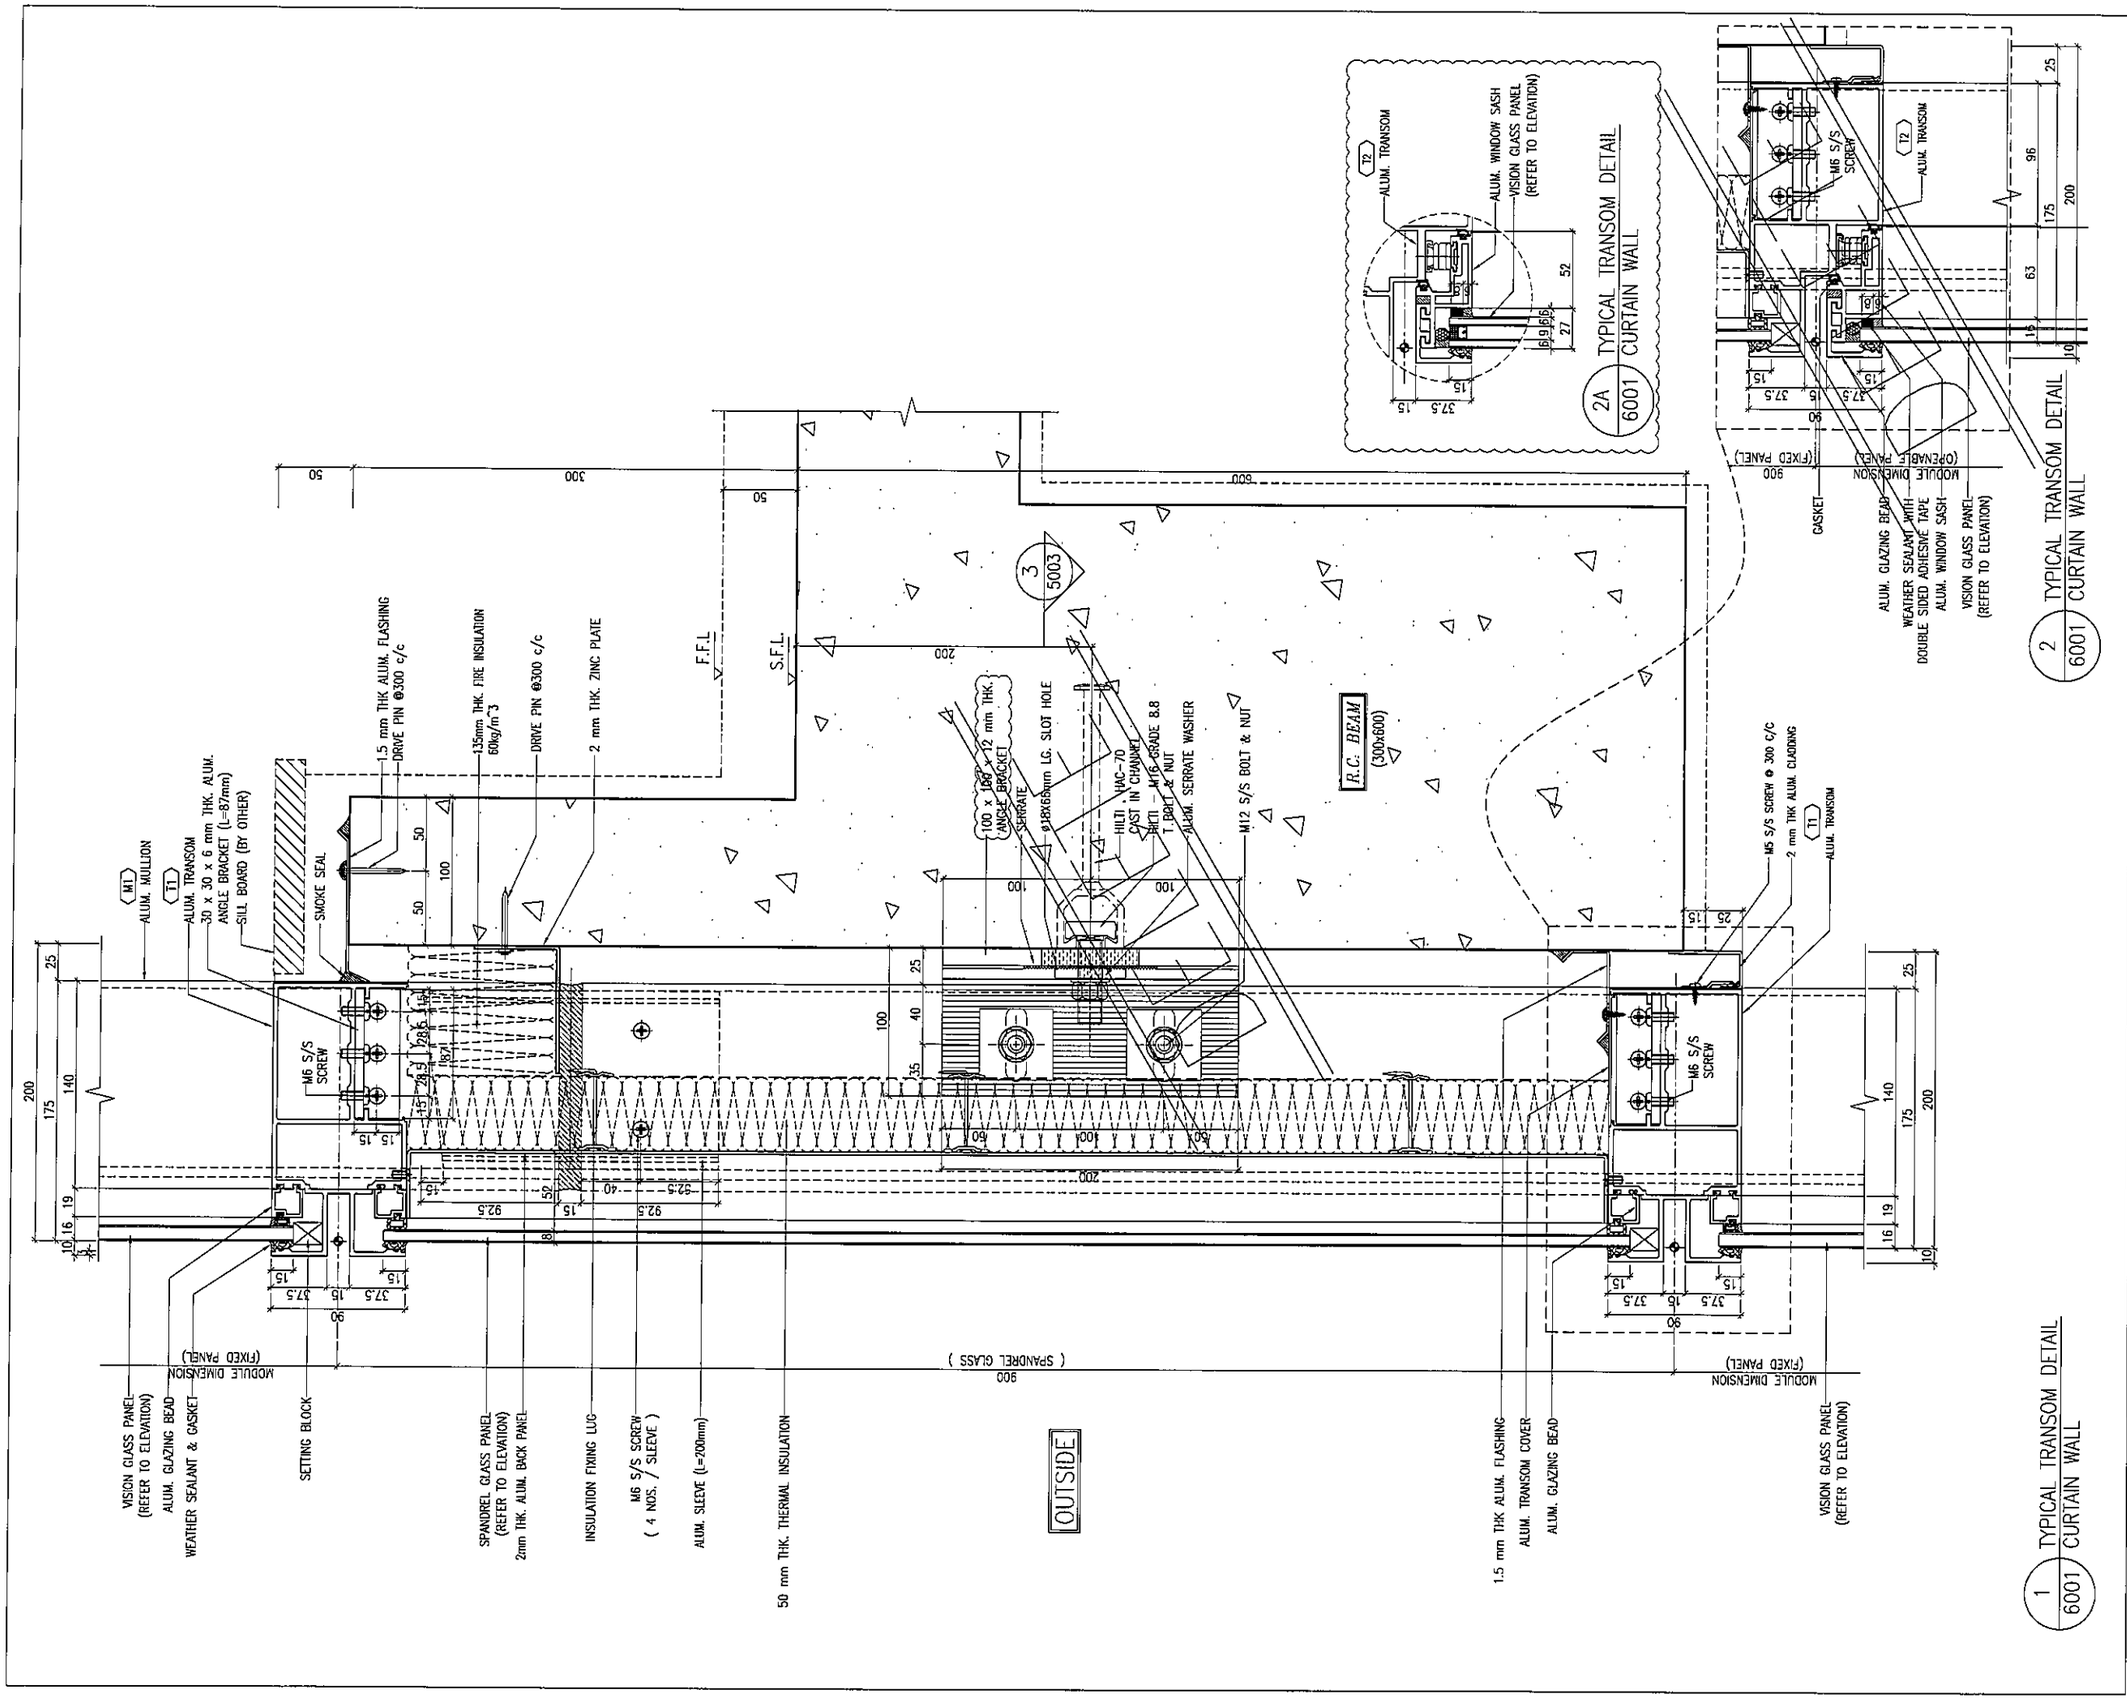

B.D. REF :

CLIENT :
信和置業有限公司
Sino Land Company Limited

ARCHITECT :
WONG TUNG & PARTNERS LIMITED
ARCHITECTS & PLANNERS

MAIN CONTRACTOR :
CR Construction Company Limited

STRUCTURAL ENGINEER :
AECOM

FACADE CONSULTANT:
AECOM

NOTE :
1. ALL DIMENSIONS ARE IN mm.
2. ALL ELEVATIONS ARE VIEWED FROM OUTSIDE.
3. ALL DIMENSIONS TO BE VERIFIED ON SITE BEFORE FABRICATION.

LEGEND :
X1 / X001 — DETAIL MARK NO. / REFER SHEET NO.
1. F.F.L. --FINISHED FLOOR LEVEL
2. S.F.L. --STRUCTURAL FLOOR LEVEL
3. /R --REVERSED DETAIL

NO.	DATE	REVISED	BY
B	24/11/2018	GENERAL REVISED	
A	10/9/2018	GENERAL REVISED	

JOB NO. : J-837

PROJECT :
URA KWUN TONG TOWN CENTRE REDEVELOPMENT (AREA 2 & 3) AT NKIL 6514, KWUN TONG, KWLOON

TITLE :
TYPICAL TRANSOM DETAIL FOR CURTAIN WALL

DATE : 13-JUL-18 | SCALE : 1:2 (A1)

DRAWN BY : ASING | CHECKED BY : -

美特鋁質有限公司
MIDI ALUMINIUM FABRICATOR LTD.
Units 6-8, Sunray Industrial Centre, 1/F
610 Cha Kwo Ling Road, Kowloon
Tel:23489211-4 Fax:(852)27727666

DWG NO. : J837-CW-6001 | REV. : B

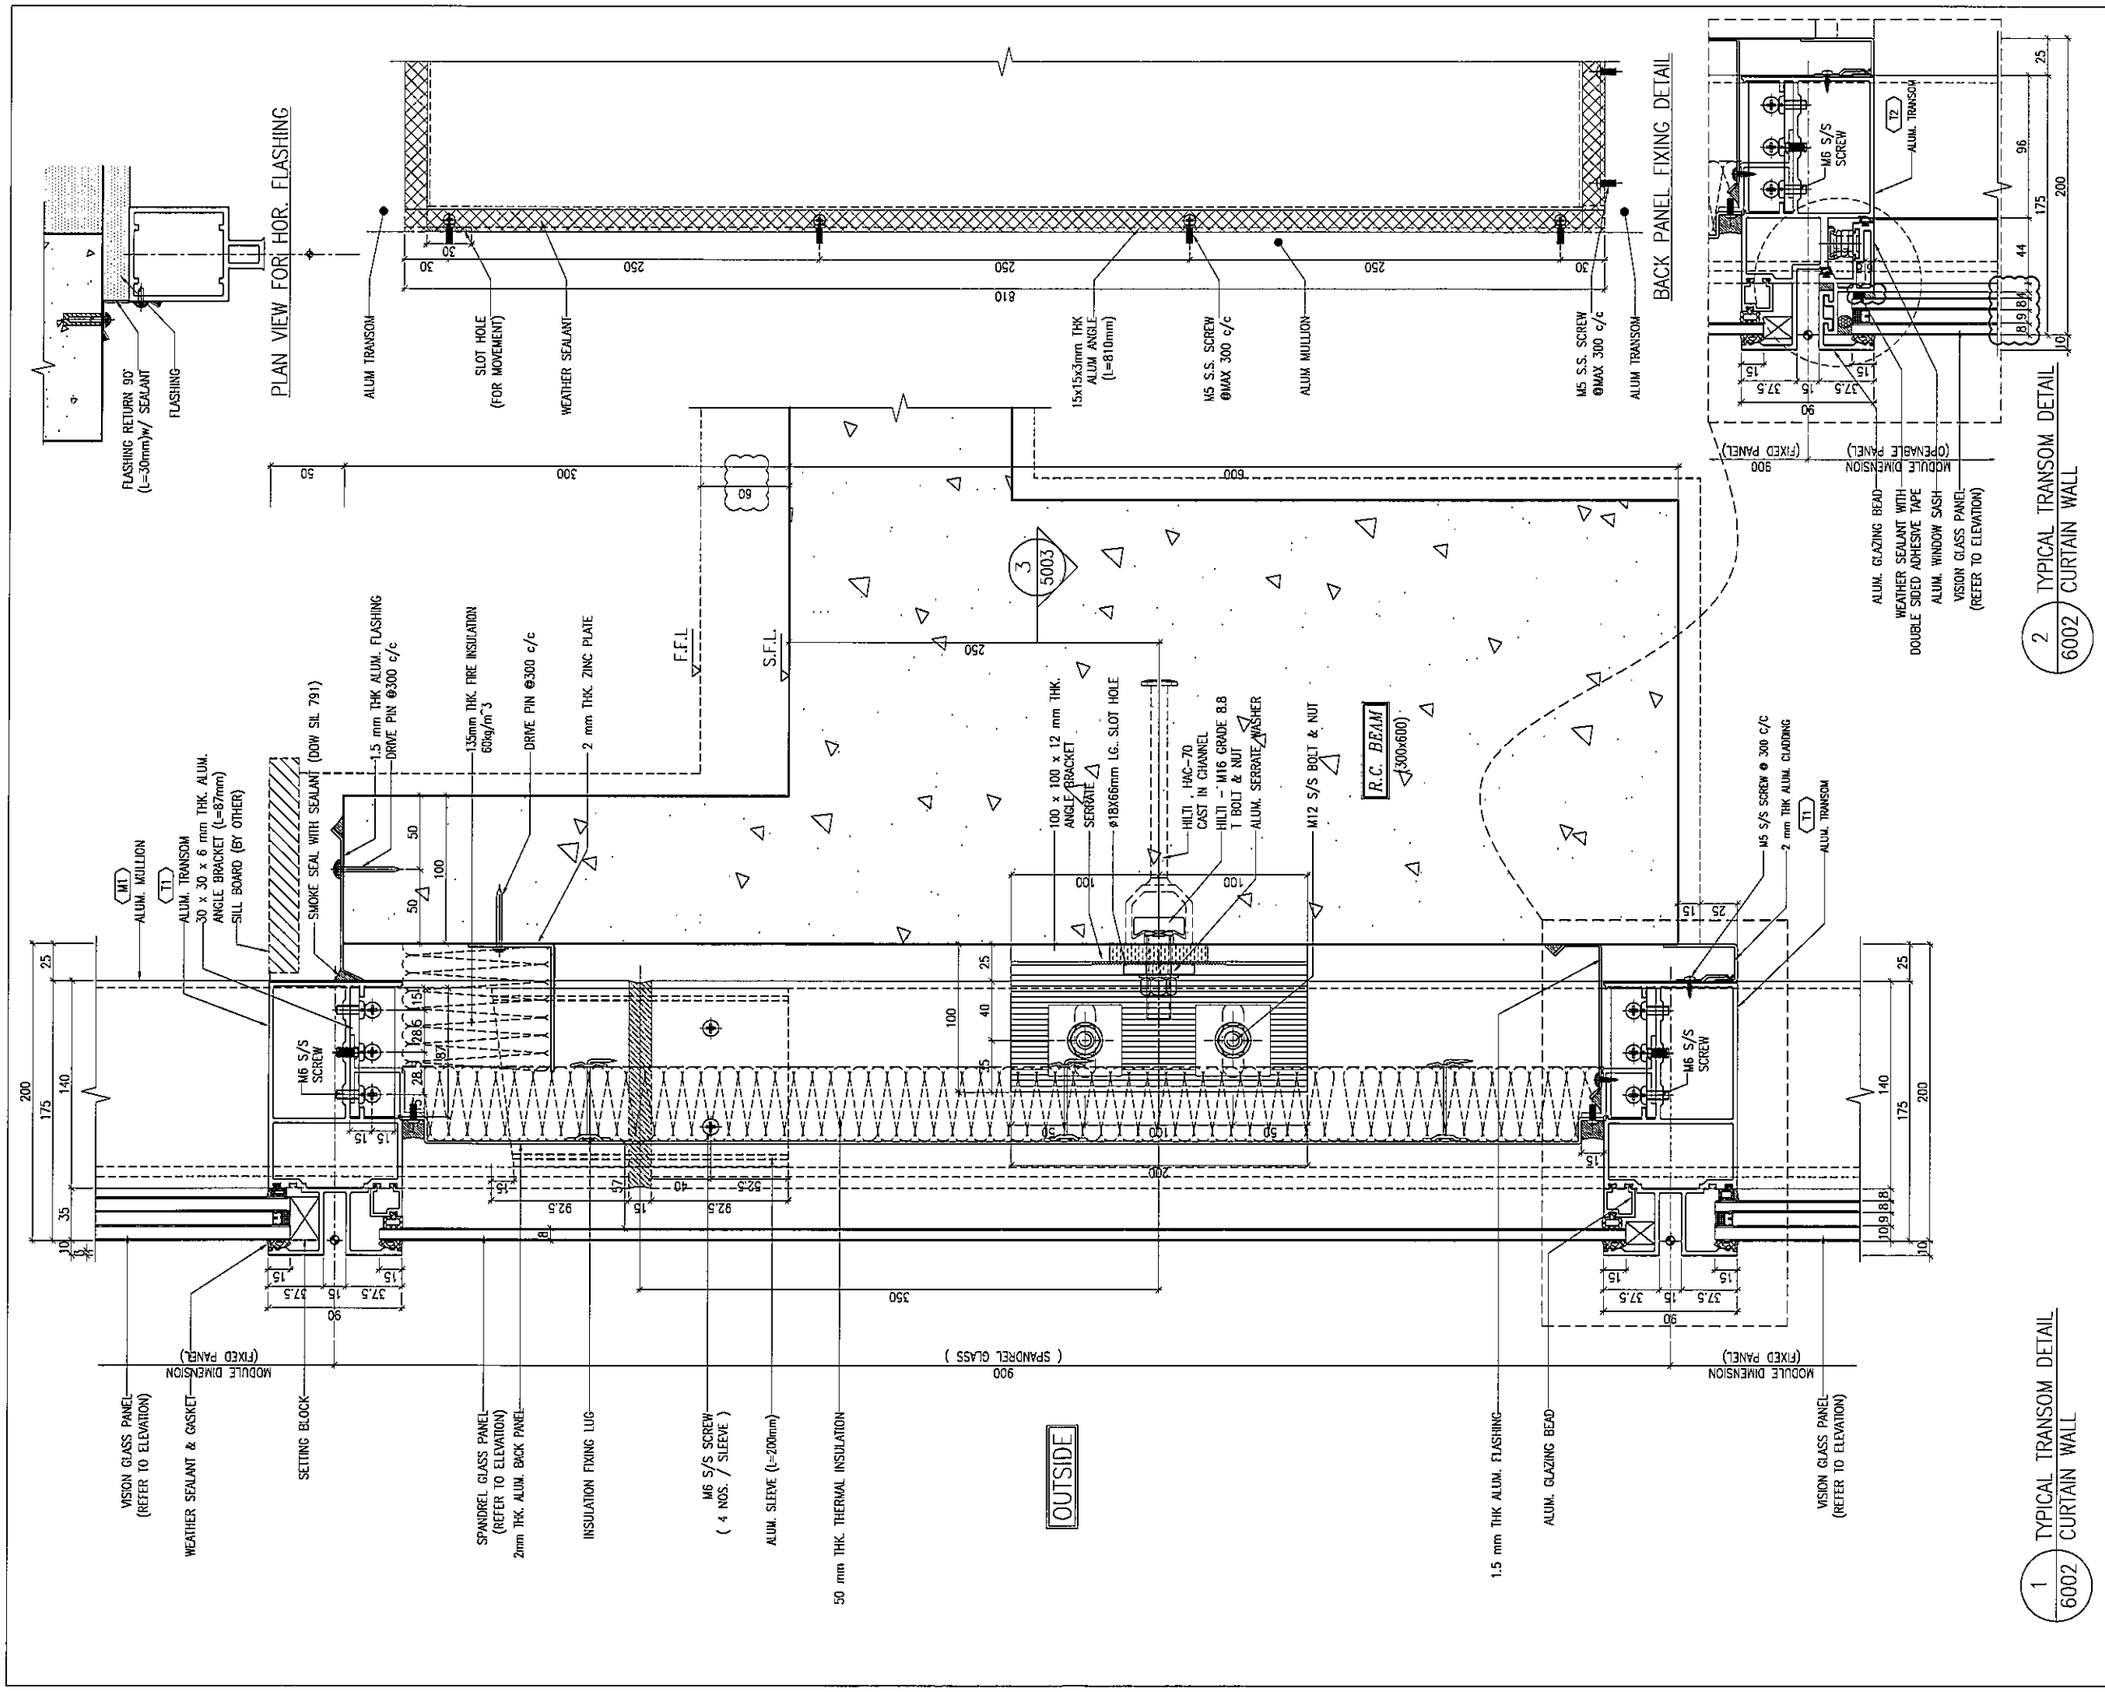

B.D. REF :

CLIENT :
信和置業有限公司
Sino Land Company Limited

ARCHITECT :
WONG TUNG & PARTNERS LIMITED
ARCHITECTS & PLANNERS

MAIN CONTRACTOR :
CR Construction Company Limited

STRUCTURAL ENGINEER :
AECOM

FACADE CONSULTANT:
AECOM

NOTE :
1. ALL DIMENSIONS ARE IN mm.
2. ALL ELEVATIONS ARE VIEWED FROM OUTSIDE.
3. ALL DIMENSIONS TO BE VERIFIED ON SITE BEFORE FABRICATION.

LEGEND :
X1 — DETAIL MARK NO.
X001 — REFER SHEET NO.
1. F.F.L. --FINISHED FLOOR LEVEL
2. S.F.L. --STRUCTURAL FLOOR LEVEL
3. (R) --REVERSED DETAIL

NO.	DATE	REVISED	BY
E	15/02/2019	GENERAL REVISED	
D	22/12/2018	GENERAL REVISED	
C	04/12/2018	GENERAL REVISED	
B	24/11/2018	GENERAL REVISED	
A	10/9/2018	GENERAL REVISED	

JOB NO. : J-837

PROJECT :
URA KWUN TONG TOWN CENTRE REDEVELOPMENT (AREA 2 & 3) AT NKIL 6514, KWUN TONG, KWLOON

TITLE :
TYPICAL TRANSOM DETAIL FOR CURTAIN WALL

DATE : 13-JUL-18 | SCALE : 1:2 (A1)

DRAWN BY : ASING | CHECKED BY : -

美特鋁製有限公司
MIDI ALUMINIUM FABRICATOR LTD.
Units 6-8, Sunray Industrial Centre, 1/F
610 Cha Kwo Ling Road, Kowloon
Tel:23489211-4 Fax:(852)27727666

DWG NO. : J837-CW-6002 | REV. : E

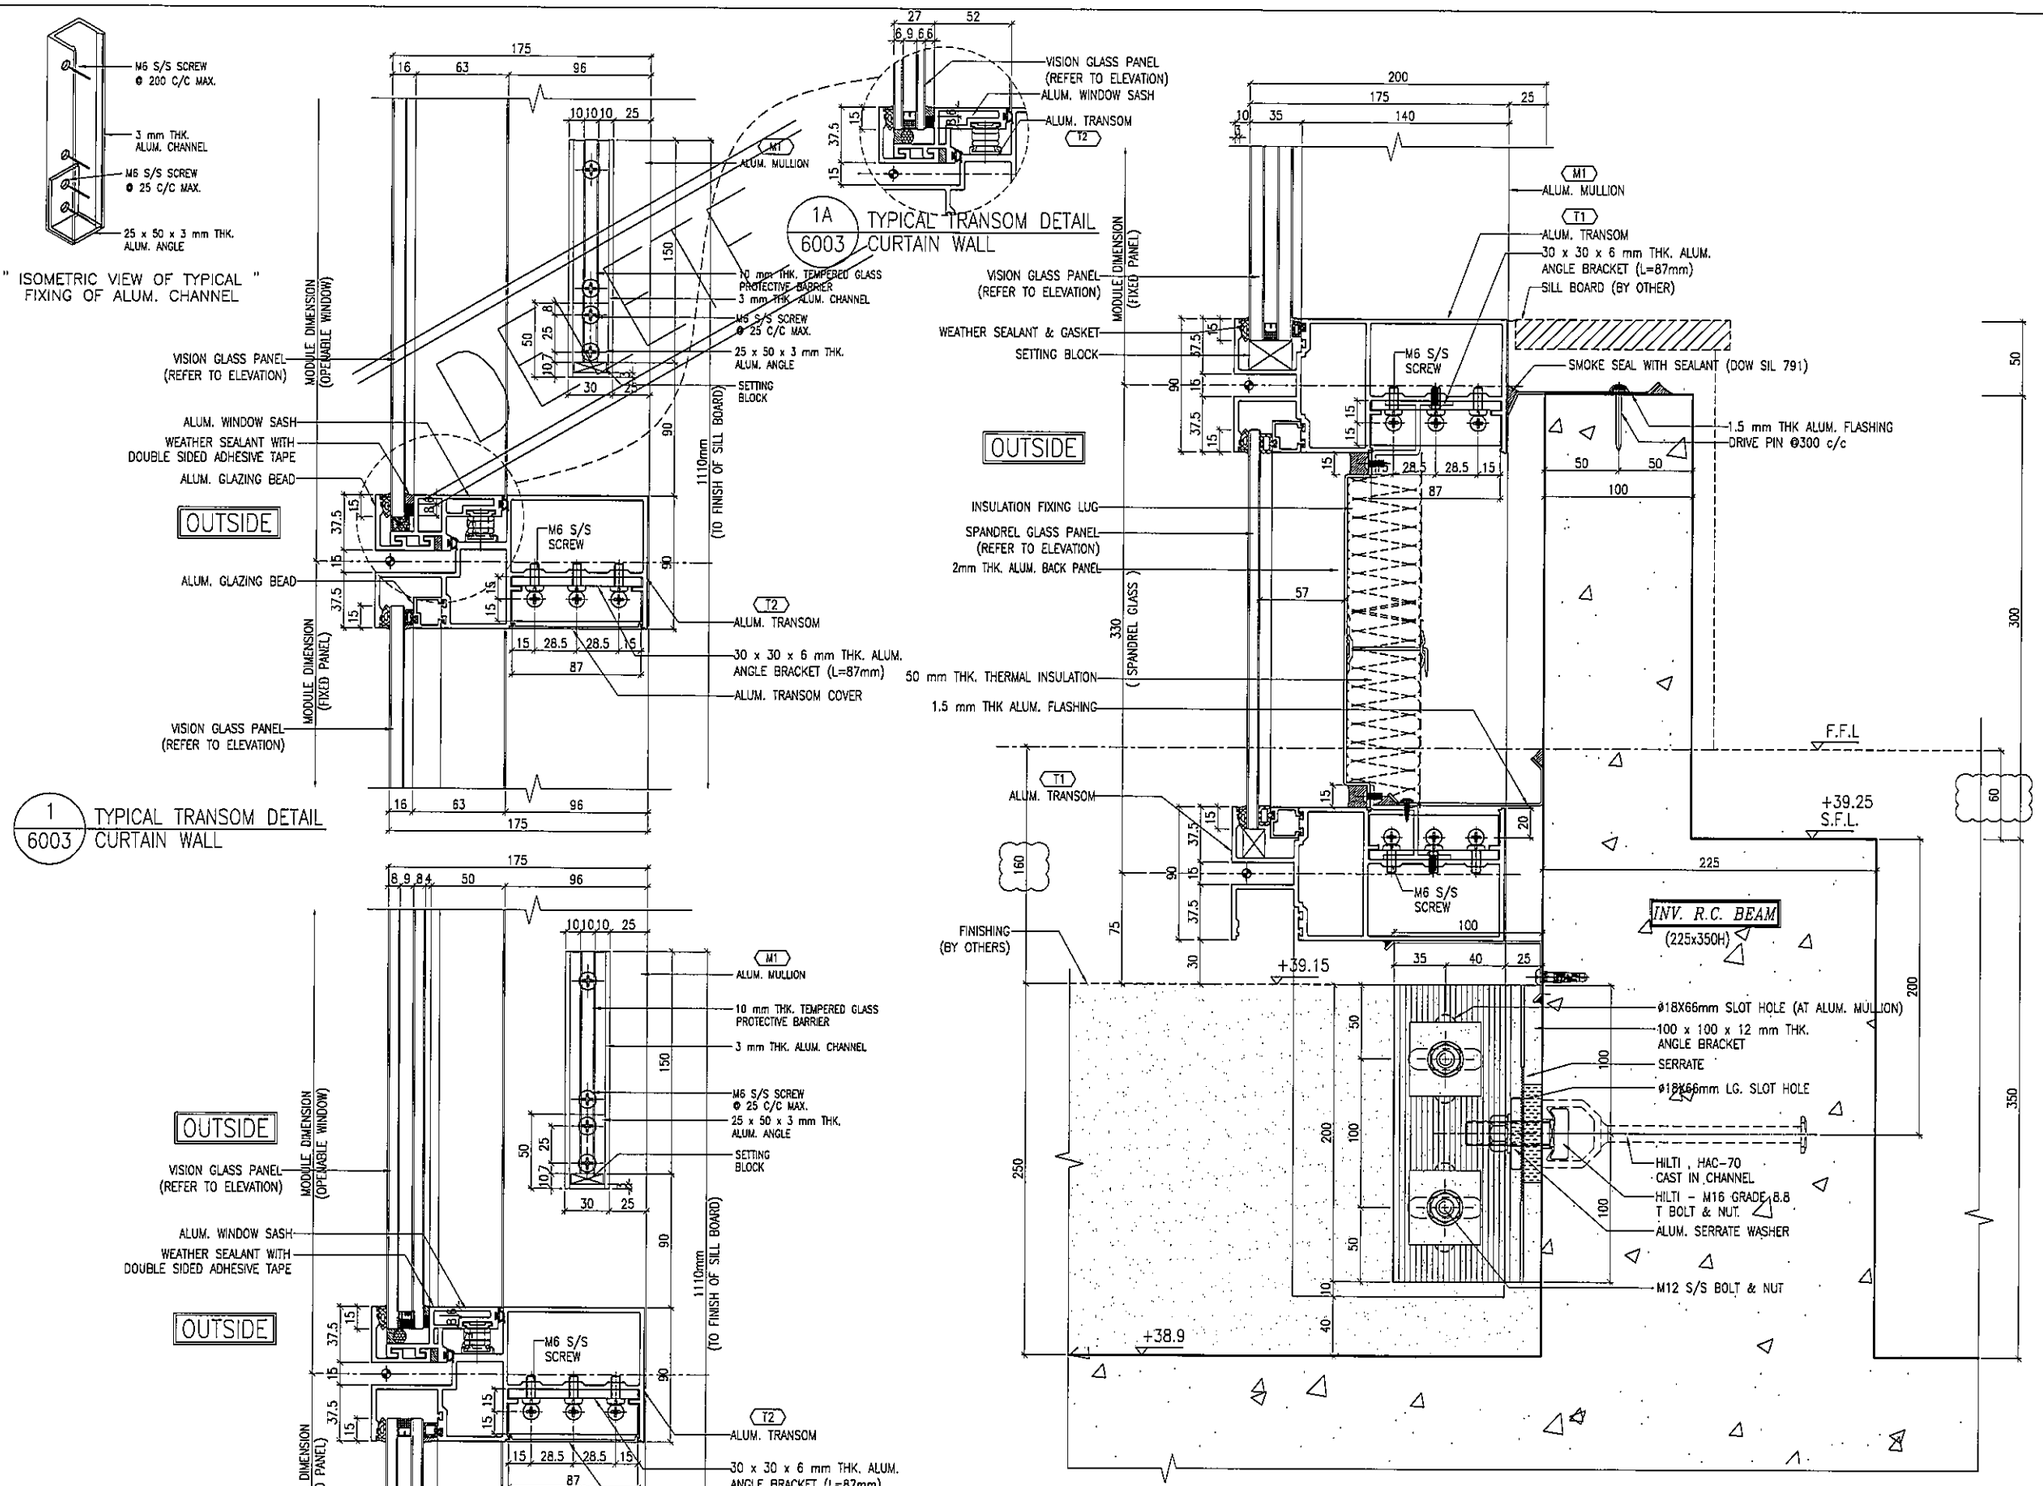

B.D. REF :

CLIENT :
信和置業有限公司
Sino Land Company Limited

ARCHITECT :
WONG TUNG & PARTNERS LIMITED
ARCHITECTS & PLANNERS

MAIN CONTRACTOR :
CR Construction Company Limited

STRUCTURAL ENGINEER :
AECOM

FACADE CONSULTANT:
AECOM

NOTE :
1. ALL DIMENSIONS ARE IN mm.
2. ALL ELEVATIONS ARE VIEWED FROM OUTSIDE.
3. ALL DIMENSIONS TO BE VERIFIED ON SITE BEFORE FABRICATION.

LEGEND :
X1 / X001 — DETAIL MARK NO. / REFER SHEET NO.
1. F.F.L. --FINISHED FLOOR LEVEL
2. S.F.L. --STRUCTURAL FLOOR LEVEL
3. /R --REVERSED DETAIL

NO.	DATE	REVISED	BY
D	15/02/2019	GENERAL REVISED	
C	22/12/2018	GENERAL REVISED	
B	24/11/2018	GENERAL REVISED	
A	10/9/2018	GENERAL REVISED	

JOB NO. : J-837

PROJECT :
URA KWUN TONG TOWN CENTRE REDEVELOPMENT (AREA 2 & 3) AT NKIL 6514, KWUN TONG, KWLOON

TITLE :
TYPICAL TRANSOM DETAIL FOR CURTAIN WALL

DATE : 13-JUL-18 | SCALE : 1:2 (A1)
DRAWN BY : Asing | CHECKED BY : -

美特鋁質有限公司
MIDI ALUMINIUM FABRICATOR LTD.
Units 6-8, Sunray Industrial Centre, 1/F
610 Cha Kwo Ling Road, Kowloon
Tel:23489211-4 Fax:(852)27727666

DWG NO. : J837-CW-6003 | REV. : D

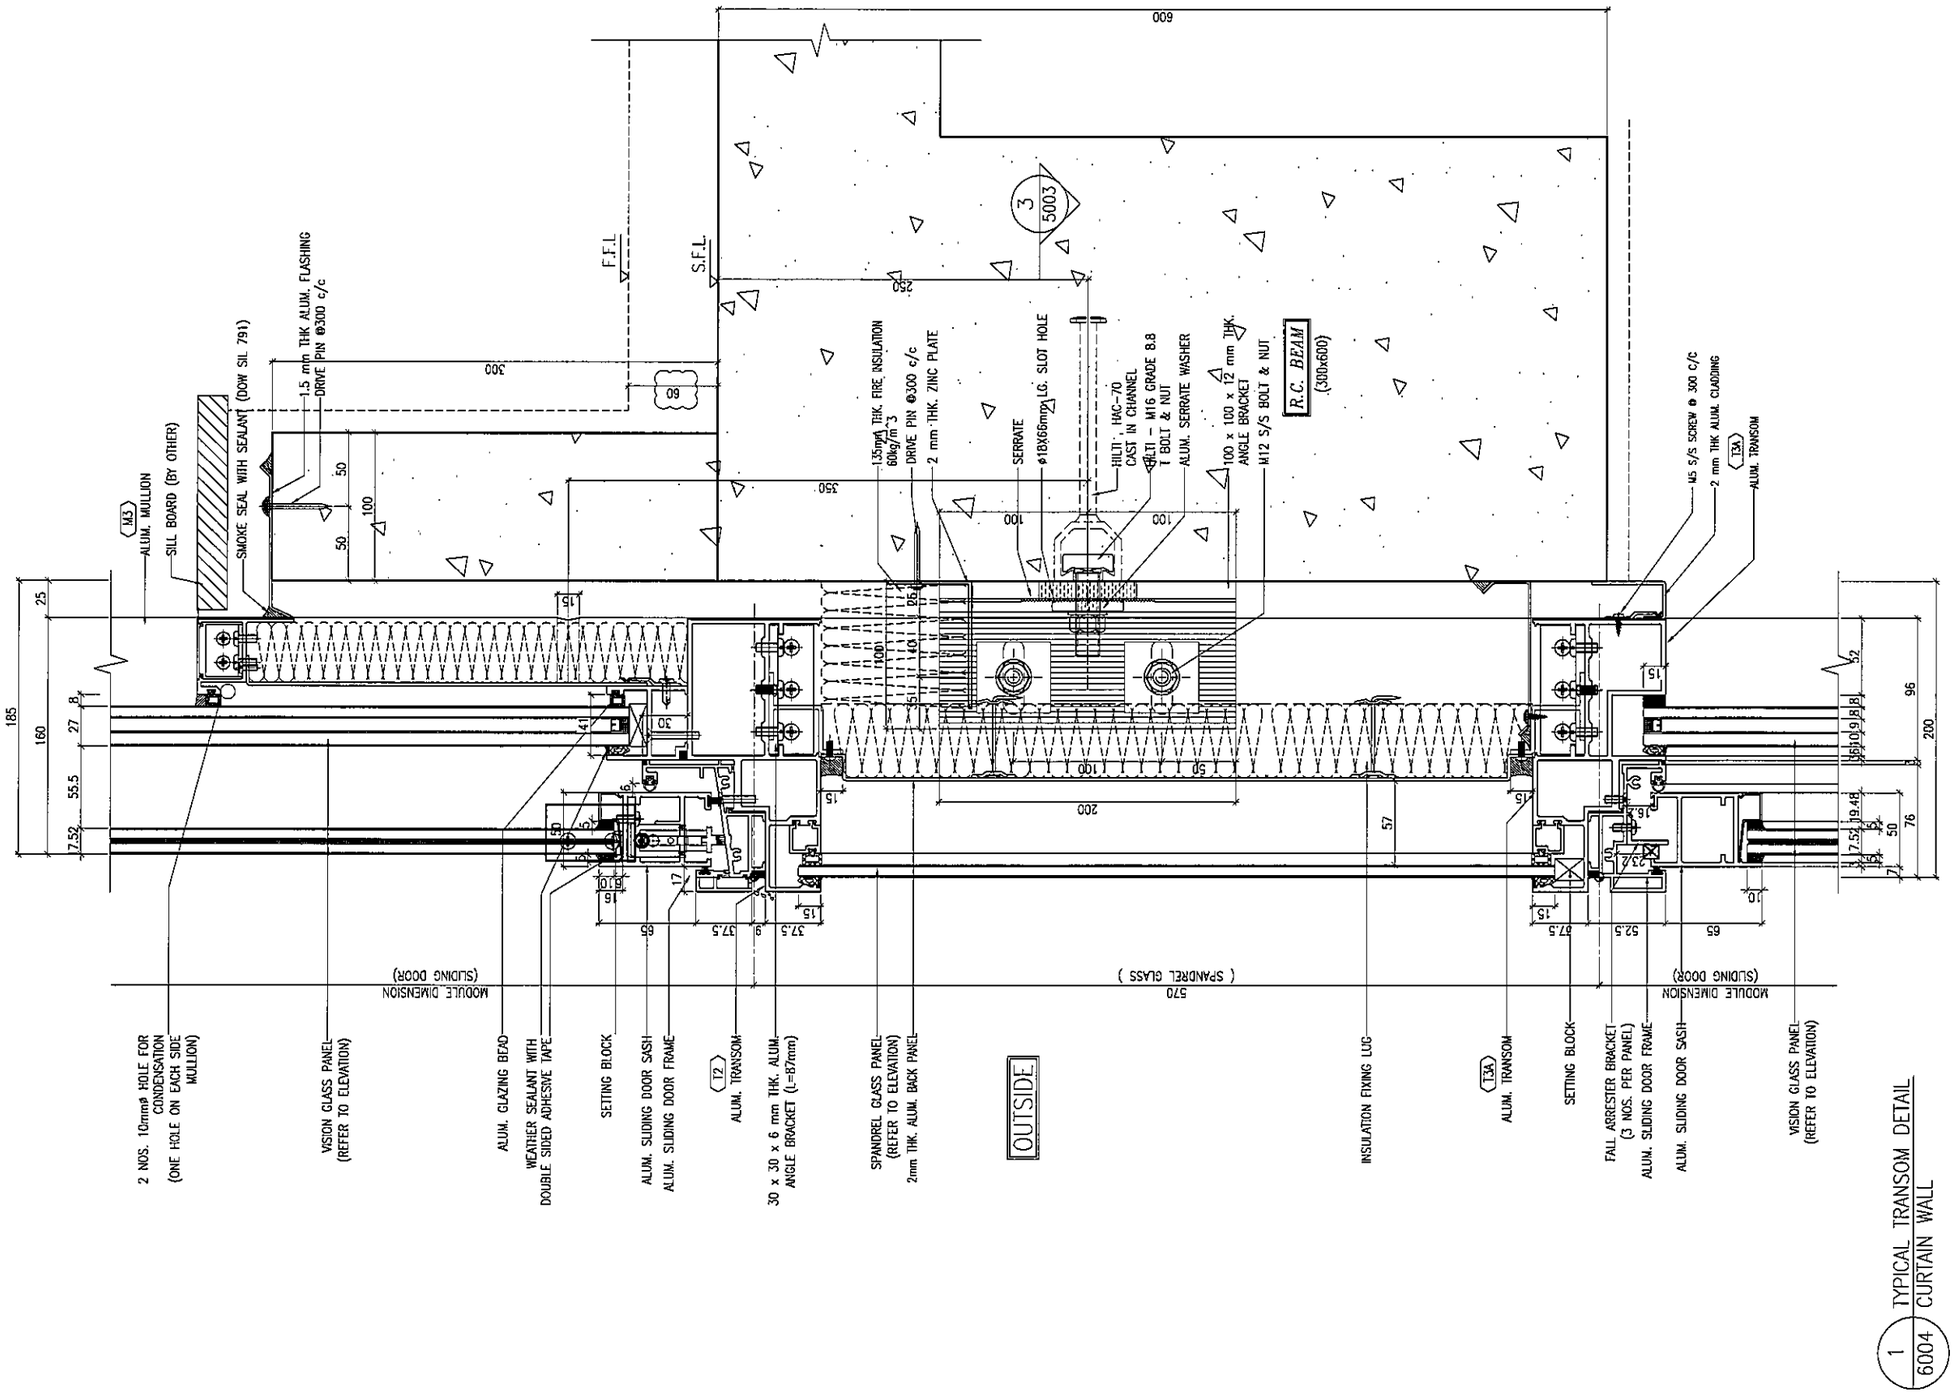

1 / 6004 TYPICAL TRANSOM DETAIL CURTAIN WALL

B.D. REF :

CLIENT :
信和置業有限公司
Sino Land Company Limited

ARCHITECT :
WONG TUNG & PARTNERS LIMITED
ARCHITECTS & PLANNERS

MAIN CONTRACTOR :
CR Construction Company Limited

STRUCTURAL ENGINEER :
AECOM

FACADE CONSULTANT:
AECOM

NOTE :
1. ALL DIMENSIONS ARE IN mm.
2. ALL ELEVATIONS ARE VIEWED FROM OUTSIDE.
3. ALL DIMENSIONS TO BE VERIFIED ON SITE BEFORE FABRICATION.

LEGEND :
- X1 / X001 — DETAIL MARK NO. / REFER SHEET NO.
1. F.F.L. --FINISHED FLOOR LEVEL
2. S.F.L. --STRUCTURAL FLOOR LEVEL
3. /R --REVERSED DETAIL

NO.	DATE	REVISED	BY
D	15/02/2019	GENERAL REVISED	
C	04/12/2018	GENERAL REVISED	
B	24/11/2018	GENERAL REVISED	
A	10/9/2018	GENERAL REVISED	

JOB NO. : J-837

PROJECT :
URA KWUN TONG TOWN CENTRE REDEVELOPMENT (AREA 2 & 3) AT NKIL 6514, KWUN TONG, KWLOON

TITLE :
TYPICAL TRANSOM DETAIL FOR CURTAIN WALL

DATE : 13-JUL-18 | SCALE : 1:2 (A1)

DRAWN BY : ASING | CHECKED BY : --

美特鋁製有限公司
MIDI ALUMINIUM FABRICATOR LTD.
Units 6-8, Sunray Industrial Centre, 1/F
610 Cha Kwo Ling Road, Kowloon
Tel:23489211-4 Fax:(852)27727666

DWG NO. : JB37-CW-6004 | REV. : D

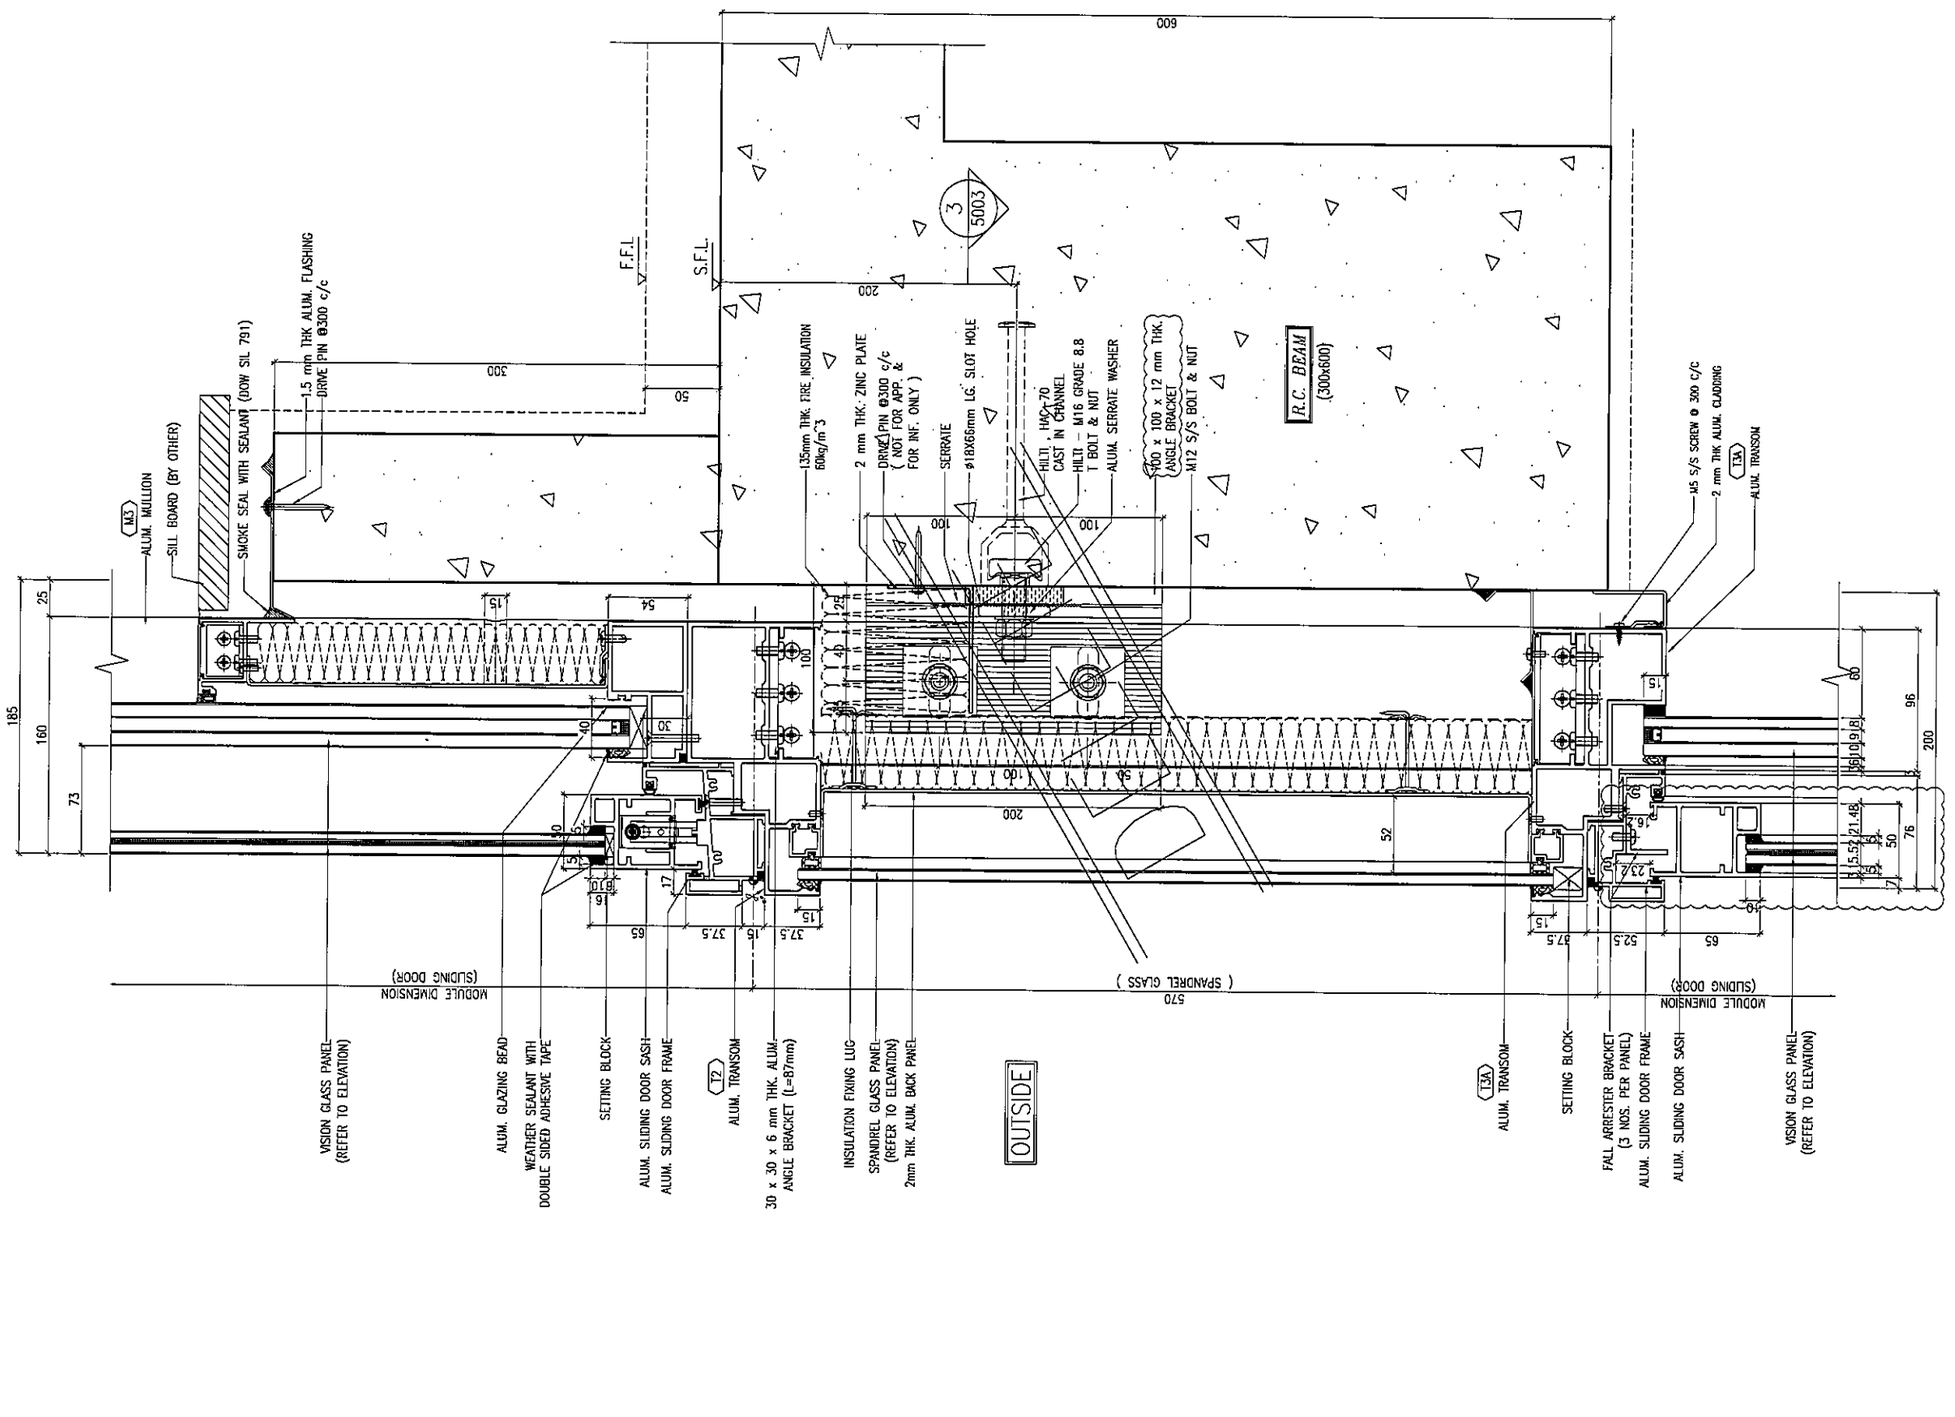

1 / 6005 TYPICAL TRANSOM DETAIL CURTAIN WALL

B.D. REF :

CLIENT :
信和置業有限公司
Sino Land Company Limited

ARCHITECT :
WONG TUNG & PARTNERS LIMITED
ARCHITECTS & PLANNERS

MAIN CONTRACTOR :
CR Construction Company Limited

STRUCTURAL ENGINEER :
AECOM

FACADE CONSULTANT:
AECOM

NOTE :
1. ALL DIMENSIONS ARE IN mm.
2. ALL ELEVATIONS ARE VIEWED FROM OUTSIDE.
3. ALL DIMENSIONS TO BE VERIFIED ON SITE BEFORE FABRICATION.

LEGEND :
X1 — DETAIL MARK NO.
X001 — REFER SHEET NO.

1. F.F.L. --FINISHED FLOOR LEVEL
2. S.F.L. --STRUCTURAL FLOOR LEVEL
3. (VR) --REVERSED DETAIL

NO.	DATE	REVISED	BY
B	24/11/2018	GENERAL REVISED	
A	10/9/2018	GENERAL REVISED	

JOB NO. : J-837

PROJECT :
URA KWUN TONG TOWN CENTRE REDEVELOPMENT (AREA 2 & 3) AT NKIL 6514, KWUN TONG, KWLOON

TITLE :
TYPICAL TRANSOM DETAIL FOR CURTAIN WALL

DATE : 13-JUL-18 | SCALE : 1:2 (A1)

DRAWN BY : ASING | CHECKED BY : –

美特鋁質有限公司
MIDI ALUMINIUM FABRICATOR LTD.
Units 6-8, Sunray Industrial Centre, 1/F
610 Cha Kwo Ling Road, Kowloon
Tel:23489211-4 Fax:(852)27727666

DWG NO. : J837-CW-6005 | REV. : B

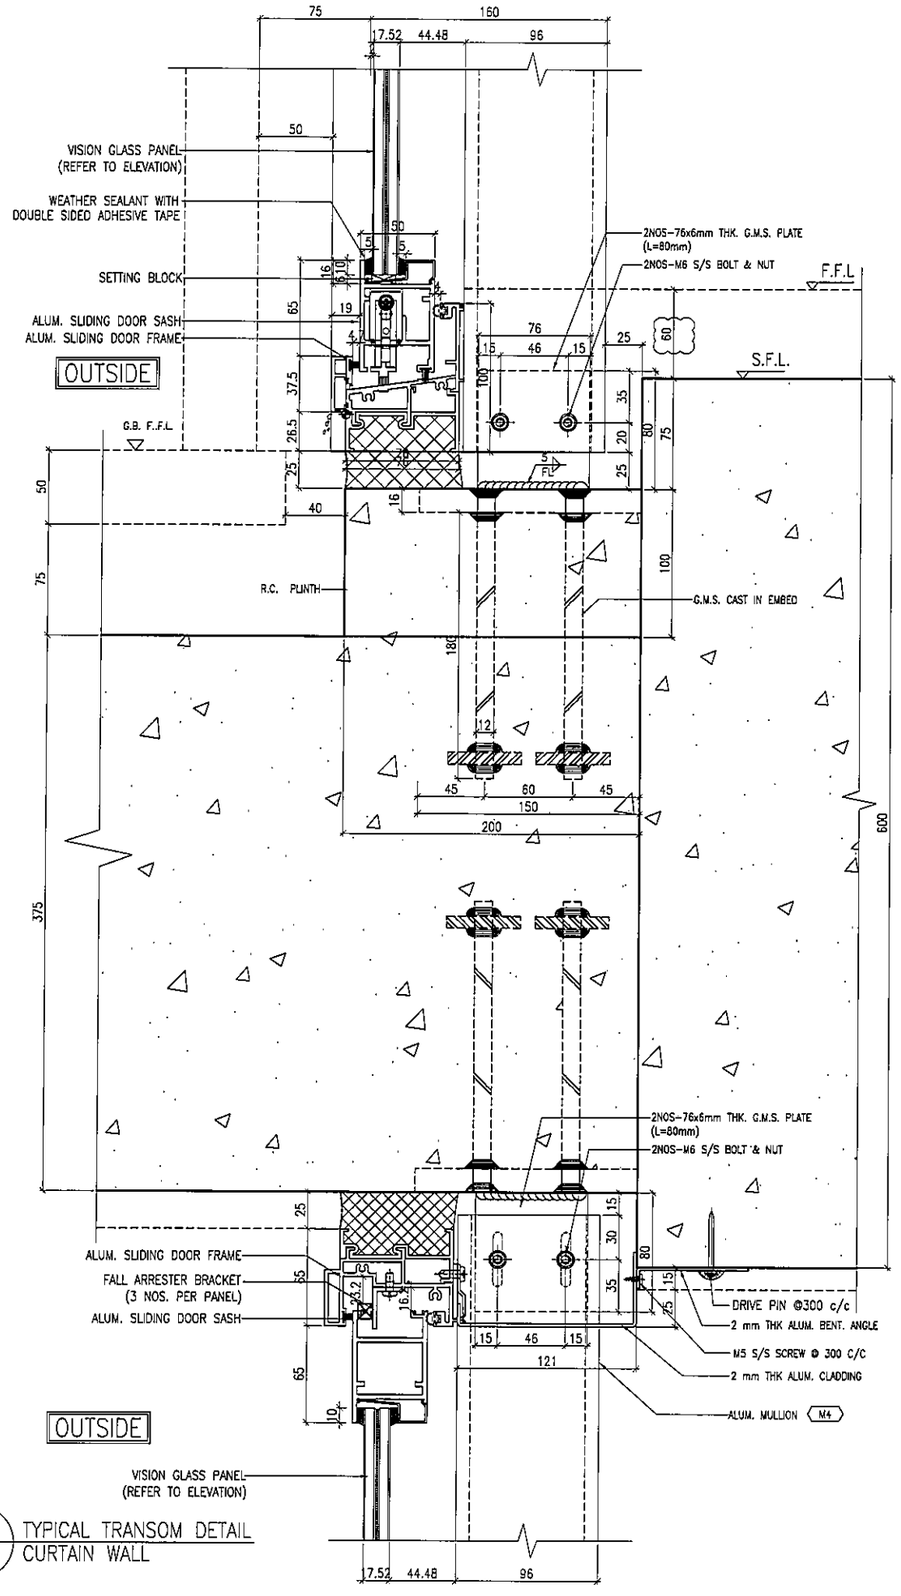

1 / 6006 TYPICAL TRANSOM DETAIL CURTAIN WALL

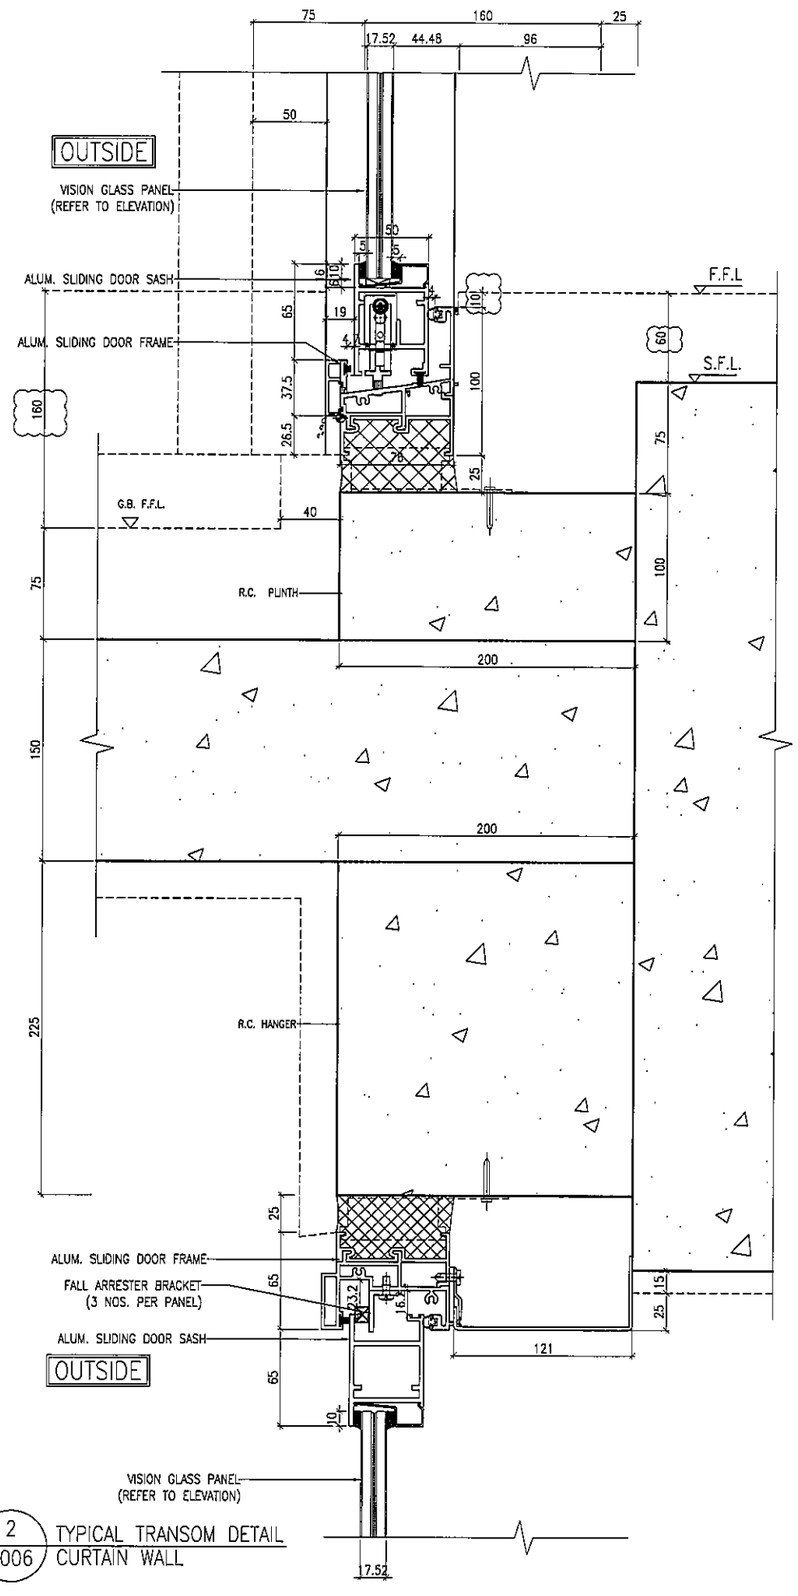

2 / 6006 TYPICAL TRANSOM DETAIL CURTAIN WALL

B.D. REF :

CLIENT :
信和置業有限公司
Sino Land Company Limited

ARCHITECT : WONG TUNG & PARTNERS LIMITED ARCHITECTS & PLANNERS

MAIN CONTRACTOR :
CR Construction Company Limited

STRUCTURAL ENGINEER : AECOM

FACADE CONSULTANT: AECOM

NOTE :
1. ALL DIMENSIONS ARE IN mm.
2. ALL ELEVATIONS ARE VIEWED FROM OUTSIDE.
3. ALL DIMENSIONS TO BE VERIFIED ON SITE BEFORE FABRICATION.

LEGEND :
X1 / X001 — DETAIL MARK NO. / REFER SHEET NO.
1. F.F.L. --FINISHED FLOOR LEVEL
2. S.F.L. --STRUCTURAL FLOOR LEVEL
3. (R) --REVERSED DETAIL

NO.	DATE	REVISED	BY
D	15/02/2019	GENERAL REVISED	
C	04/12/2018	GENERAL REVISED	
B	24/11/2018	GENERAL REVISED	
A	10/9/2018	GENERAL REVISED	

JOB NO. : J-837

PROJECT :
URA KWUN TONG TOWN CENTRE REDEVELOPMENT (AREA 2 & 3) AT NKIL 6514, KWUN TONG, KWLOON

TITLE :
TYPICAL TRANSOM DETAIL FOR CURTAIN WALL

DATE : 13-JUL-18 | SCALE : 1:2 (A1)

DRAWN BY : ASING | CHECKED BY : -

美特鋁質有限公司
MIDI ALUMINIUM FABRICATOR LTD.
Units 6-8, Sunray Industrial Centre, 1/F
610 Cha Kwo Ling Road, Kowloon
Tel:23489211-4 Fax:(852)27727666

DWG NO. : J837-CW-6006 | REV. : D

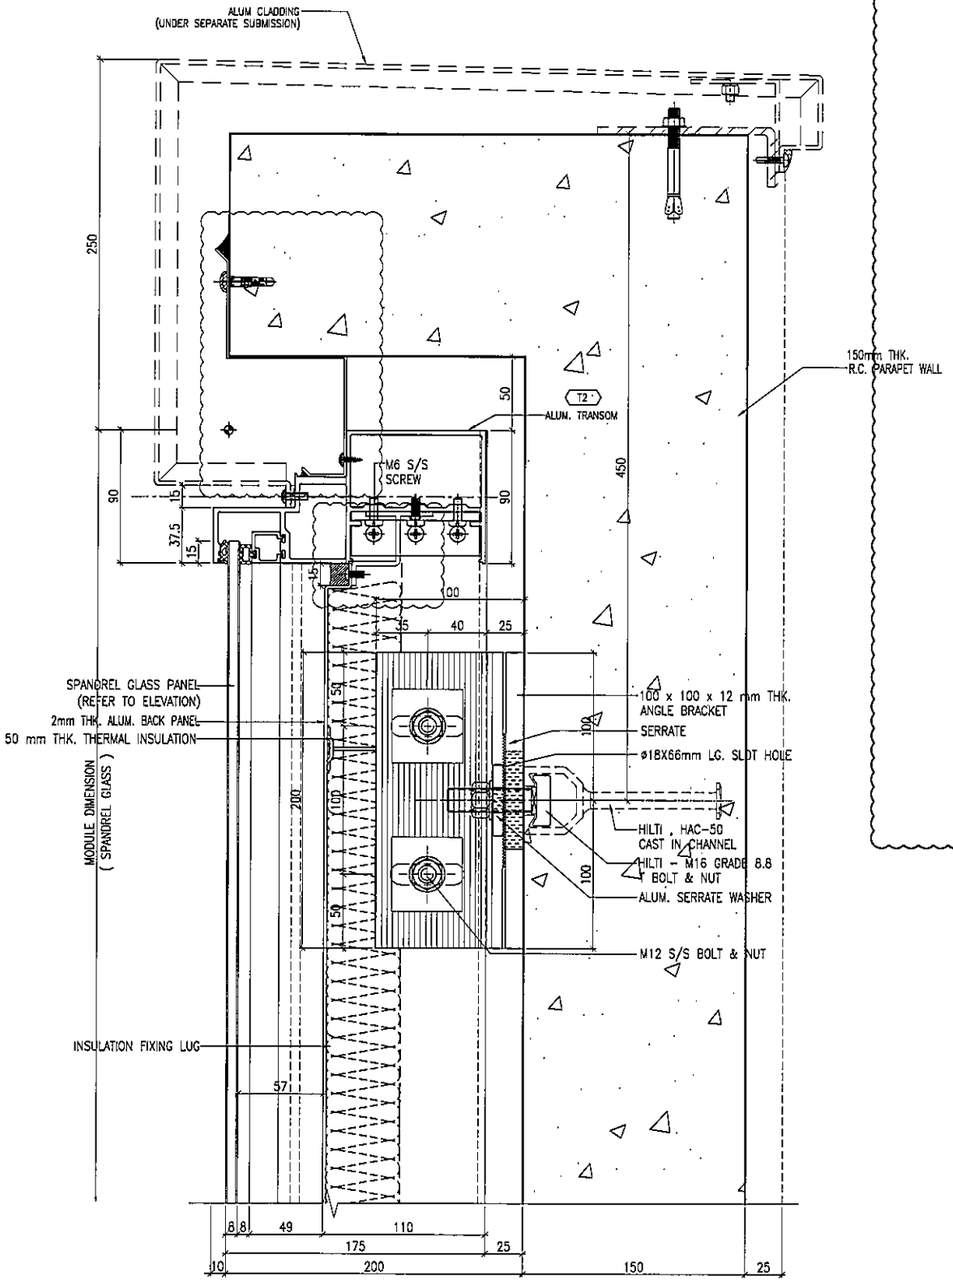

1 / 6007 TYPICAL TRANSOM DETAIL
CURTAIN WALL

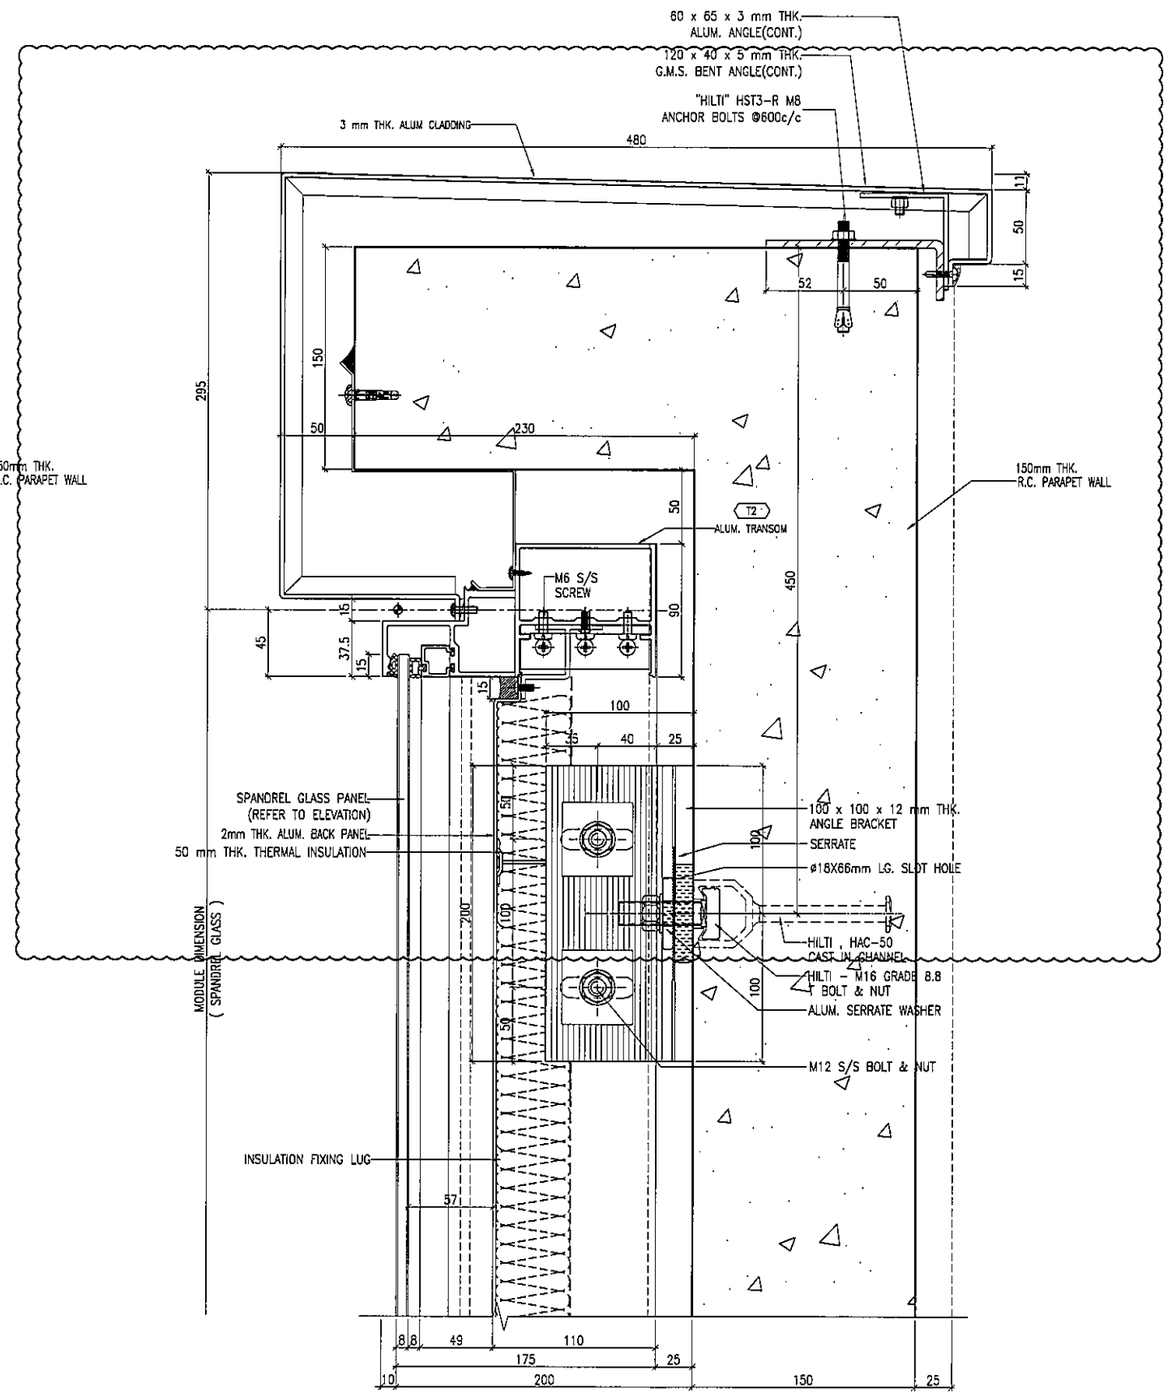

2 / 6007 TYPICAL TRANSOM DETAIL
CURTAIN WALL

B.D. REF :

CLIENT :
信和置業有限公司
Sino Land Company Limited

ARCHITECT :
WONG TUNG & PARTNERS LIMITED
ARCHITECTS & PLANNERS

MAIN CONTRACTOR :
CR Construction Company Limited

STRUCTURAL ENGINEER :
AECOM

FACADE CONSULTANT:
AECOM

NOTE :
1. ALL DIMENSIONS ARE IN mm.
2. ALL ELEVATIONS ARE VIEWED FROM OUTSIDE.
3. ALL DIMENSIONS TO BE VERIFIED ON SITE BEFORE FABRICATION.

LEGEND :
X1 / X@@1 — DETAIL MARK NO. / REFER SHEET NO.
1. F.F.L. --FINISHED FLOOR LEVEL
2. S.F.L. --STRUCTURAL FLOOR LEVEL
3. /R --REVERSED DETAIL

NO.	DATE	REVISED	BY
C	22/12/2018	GENERAL REVISED	
B	24/11/2018	GENERAL REVISED	
A	10/9/2018	GENERAL REVISED	

JOB NO. : J-837

PROJECT :
URA KWUN TONG TOWN CENTRE
REDEVELOPMENT (AREA 2 & 3) AT
NKIL 6514, KWUN TONG, KWLOON

TITLE :
TYPICAL TRANSOM DETAIL
FOR CURTAIN WALL

DATE : 13-JUL-18 | SCALE : 1:2 (A1)

DRAWN BY : ASING | CHECKED BY : --

美特鋁質有限公司
MIDI ALUMINIUM FABRICATOR LTD.
Units 6-8, Sunray Industrial Centre, 1/F
610 Cha Kwo Ling Road, Kowloon
Tel:23489211-4 Fax:(852)27727666

DWG NO. : J837-CW-6007 | REV. : C

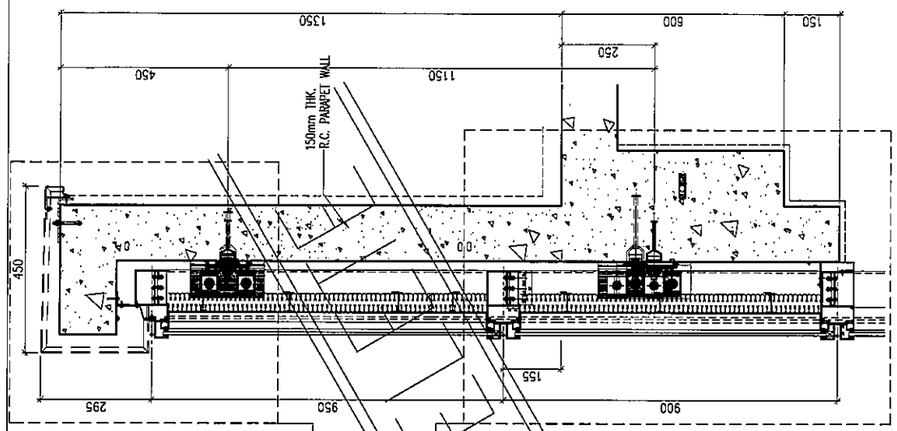

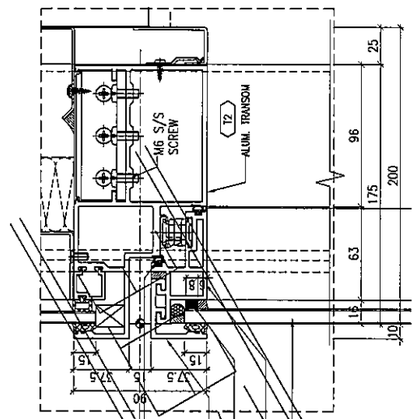

2 6008 TYPICAL TRANSOM DETAIL CURTAIN WALL

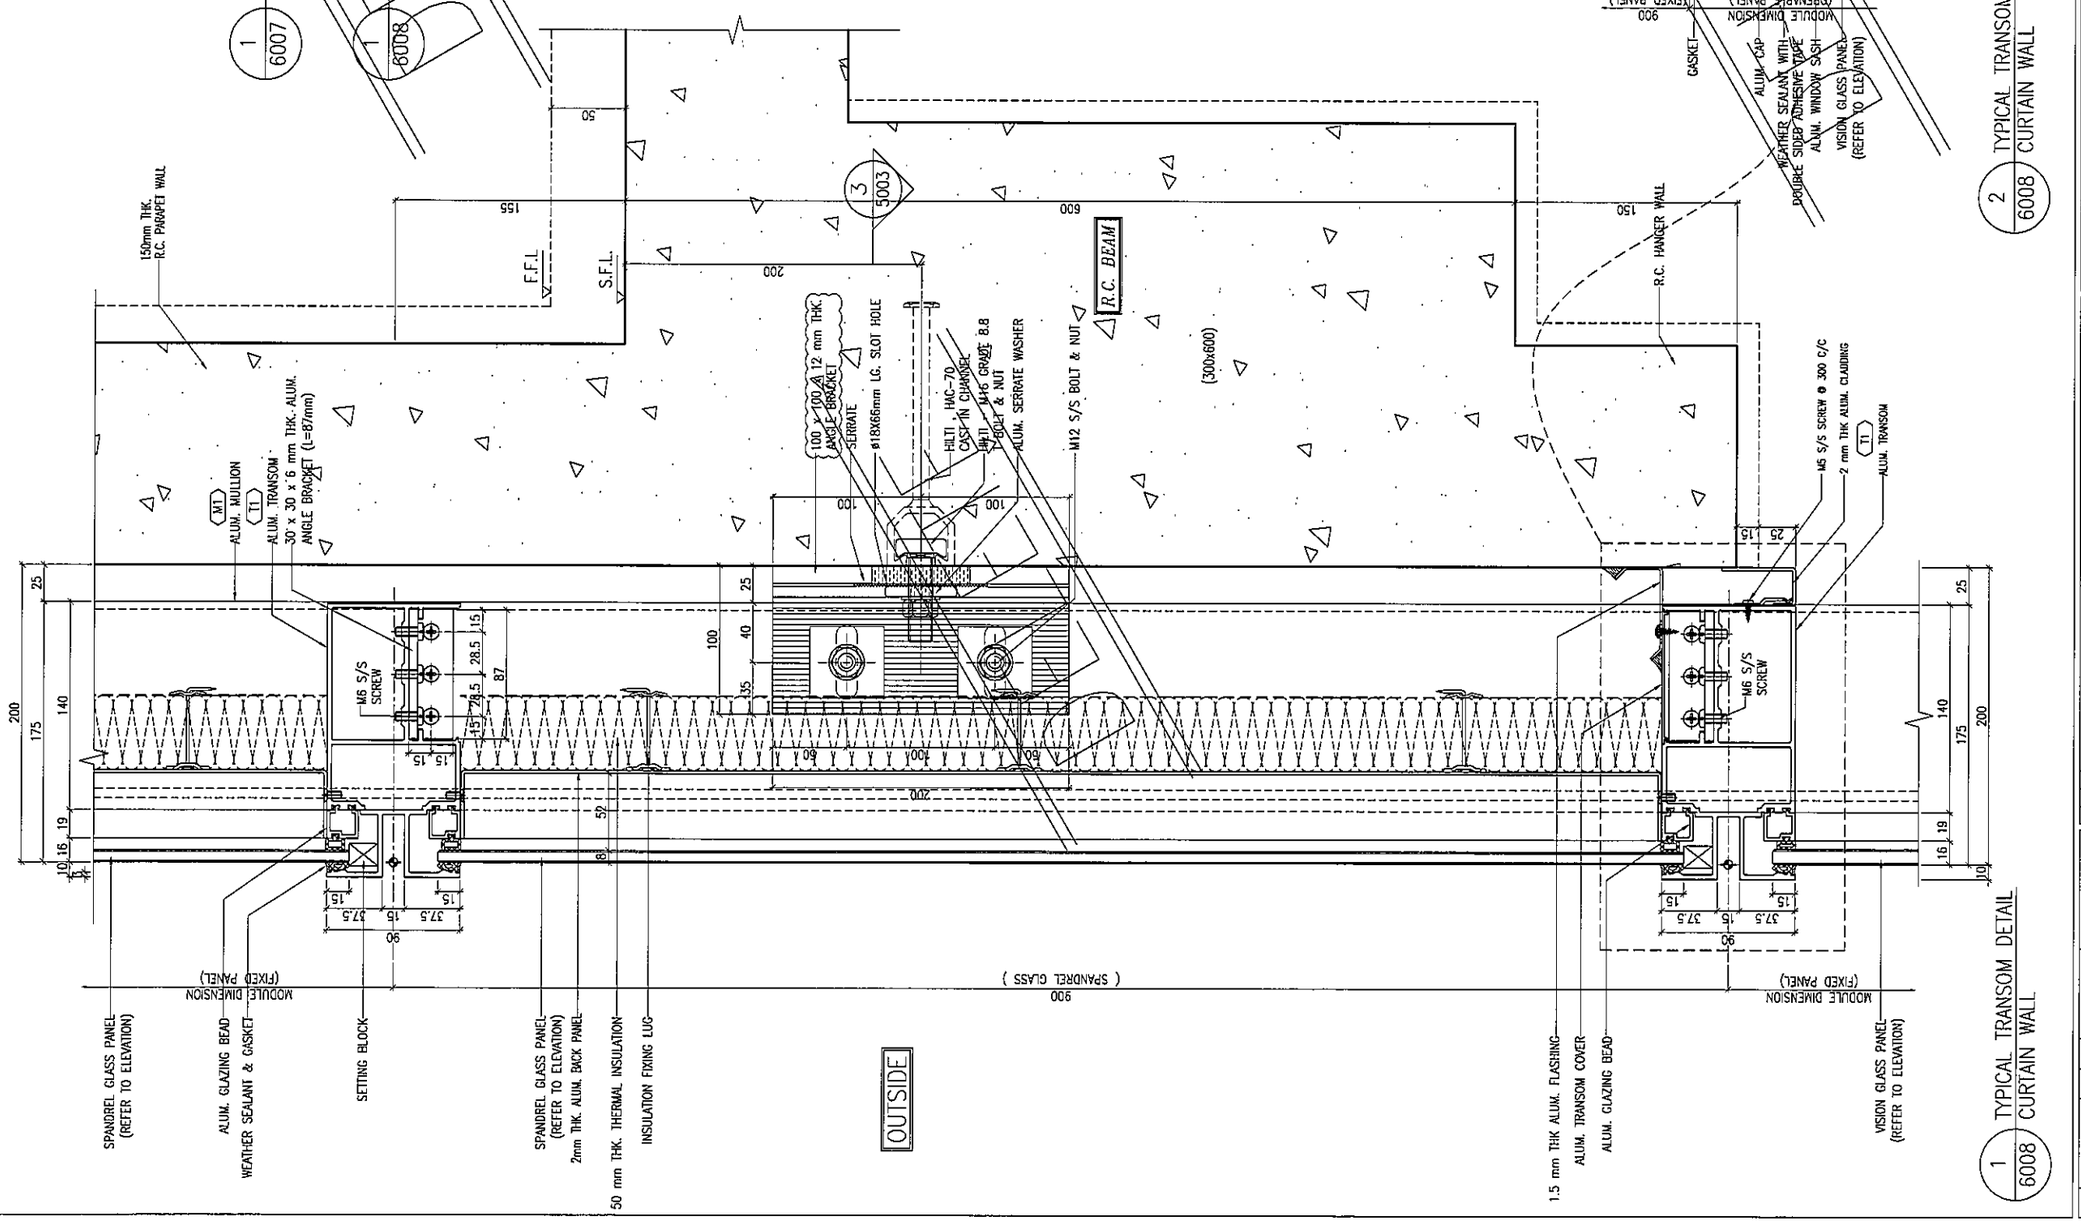

1 6008 TYPICAL TRANSOM DETAIL CURTAIN WALL

B.D. REF :

CLIENT :
信和置業有限公司
Sino Land Company Limited

ARCHITECT :
WONG TUNG & PARTNERS LIMITED
ARCHITECTS & PLANNERS

MAIN CONTRACTOR :
CR Construction Company Limited

STRUCTURAL ENGINEER :
AECOM

FACADE CONSULTANT:
AECOM

NOTE :
1. ALL DIMENSIONS ARE IN mm.
2. ALL ELEVATIONS ARE VIEWED FROM OUTSIDE.
3. ALL DIMENSIONS TO BE VERIFIED ON SITE BEFORE FABRICATION.

LEGEND :
X1 — DETAIL MARK NO.
XXX1 — REFER SHEET NO.

1. F.F.L. --FINISHED FLOOR LEVEL
2. S.F.L. --STRUCTURAL FLOOR LEVEL
3. (R) --REVERSED DETAIL

NO.	DATE	REVISED	BY
B	24/11/2018	GENERAL REVISED	
A	10/9/2018	GENERAL REVISED	

JOB NO. : J-837

PROJECT :
URA KWUN TONG TOWN CENTRE REDEVELOPMENT (AREA 2 & 3) AT NKIL 6514, KWUN TONG, KWLOON

TITLE :
TYPICAL TRANSOM DETAIL FOR CURTAIN WALL

DATE : 13-JUL-18 | SCALE : 1:2 (A1)

DRAWN BY : ASING | CHECKED BY : -

美特鋁質有限公司
MIDI ALUMINIUM FABRICATOR LTD.
Units 6-8, Sunray Industrial Centre, 1/F
610 Cha Kwo Ling Road, Kowloon
Tel:23489211-4 Fax:(852)27727666

DWG NO. : J837-CW-6008 | REV. : B

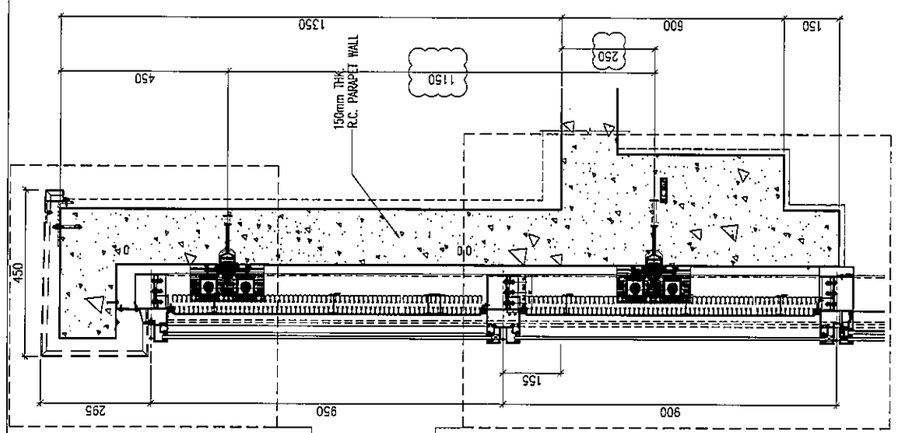

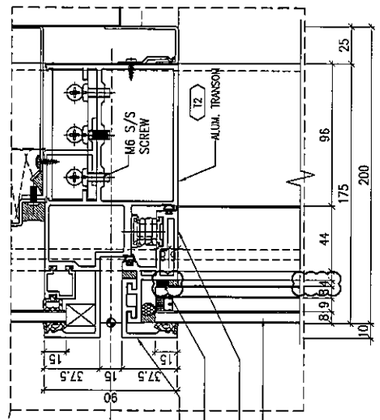

2 6009 TYPICAL TRANSOM DETAIL CURTAIN WALL

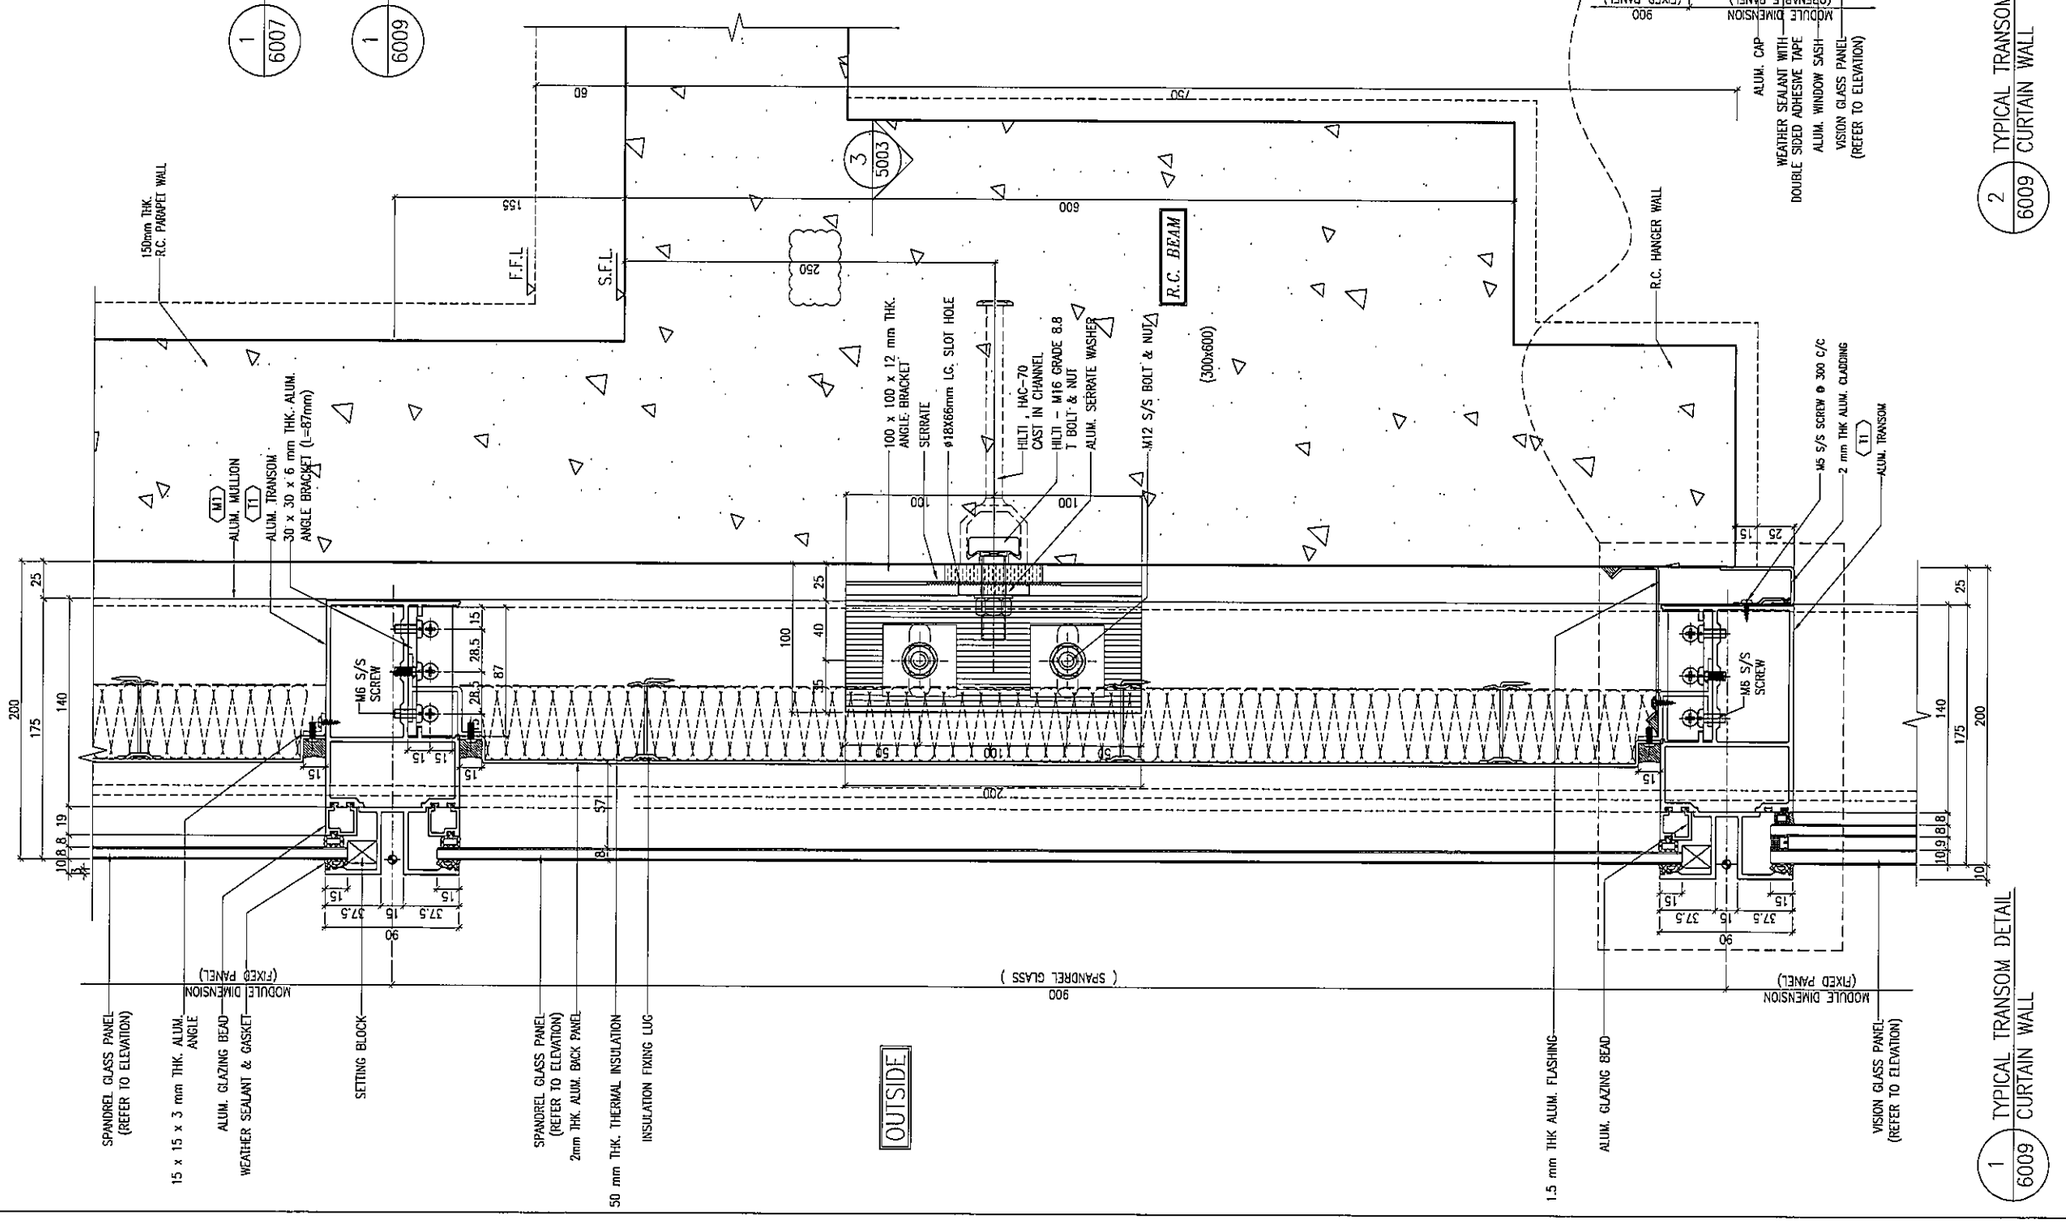

1 6009 TYPICAL TRANSOM DETAIL CURTAIN WALL

B.D. REF :

CLIENT :
信和置業有限公司
Sino Land Company Limited

ARCHITECT :
WONG TUNG & PARTNERS LIMITED
ARCHITECTS & PLANNERS

MAIN CONTRACTOR :
CR Construction Company Limited

STRUCTURAL ENGINEER :
AECOM

FACADE CONSULTANT:
AECOM

NOTE :
1. ALL DIMENSIONS ARE IN mm.
2. ALL ELEVATIONS ARE VIEWED FROM OUTSIDE.
3. ALL DIMENSIONS TO BE VERIFIED ON SITE BEFORE FABRICATION.

LEGEND :
X1 — DETAIL MARK NO.
X001 — REFER SHEET NO.

1. F.F.L. --FINISHED FLOOR LEVEL
2. S.F.L. --STRUCTURAL FLOOR LEVEL
3. (R) --REVERSED DETAIL

NO.	DATE	REVISED	BY
E	26/05/2019	GENERAL REVISED	
D	15/02/2019	GENERAL REVISED	
C	22/12/2018	GENERAL REVISED	
B	24/11/2018	GENERAL REVISED	
A	10/9/2018	GENERAL REVISED	

JOB NO. : J-837

PROJECT :
URA KWUN TONG TOWN CENTRE REDEVELOPMENT (AREA 2 & 3) AT NKIL 6514, KWUN TONG, KWLOON

TITLE :
TYPICAL TRANSOM DETAIL FOR CURTAIN WALL

DATE : 13-JUL-18 | SCALE : 1:2 (A1)

DRAWN BY : ASING | CHECKED BY : -

美特鋁質有限公司
MIDI ALUMINIUM FABRICATOR LTD.
Units 6-8, Sunray Industrial Centre, 1/F
610 Cha Kwo Ling Road, Kowloon
Tel:23489211-4 Fax:(852)27727666

DWG NO. : J837-CW-6009 | REV. : E

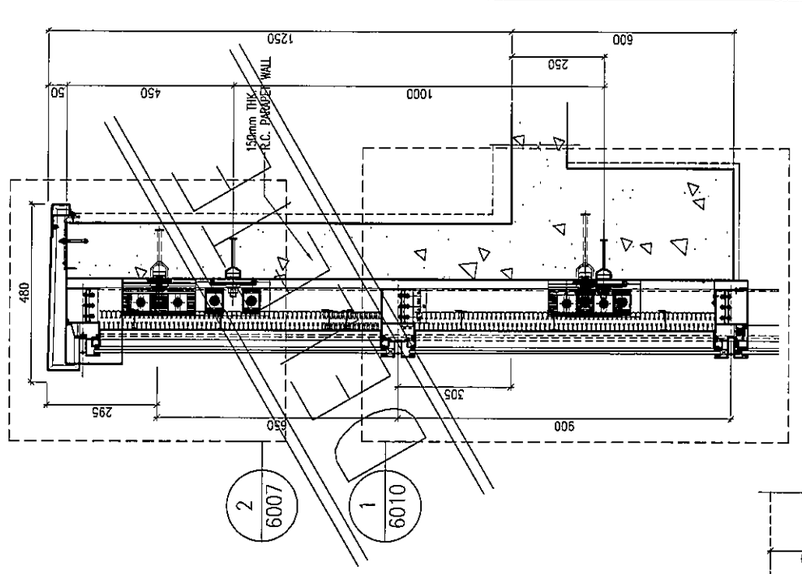

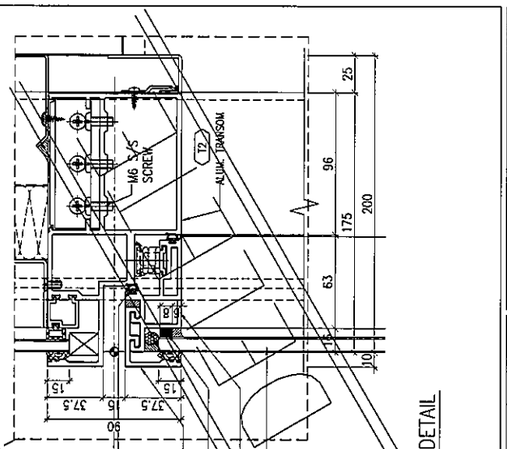

2 / 6010 TYPICAL TRANSOM DETAIL CURTAIN WALL

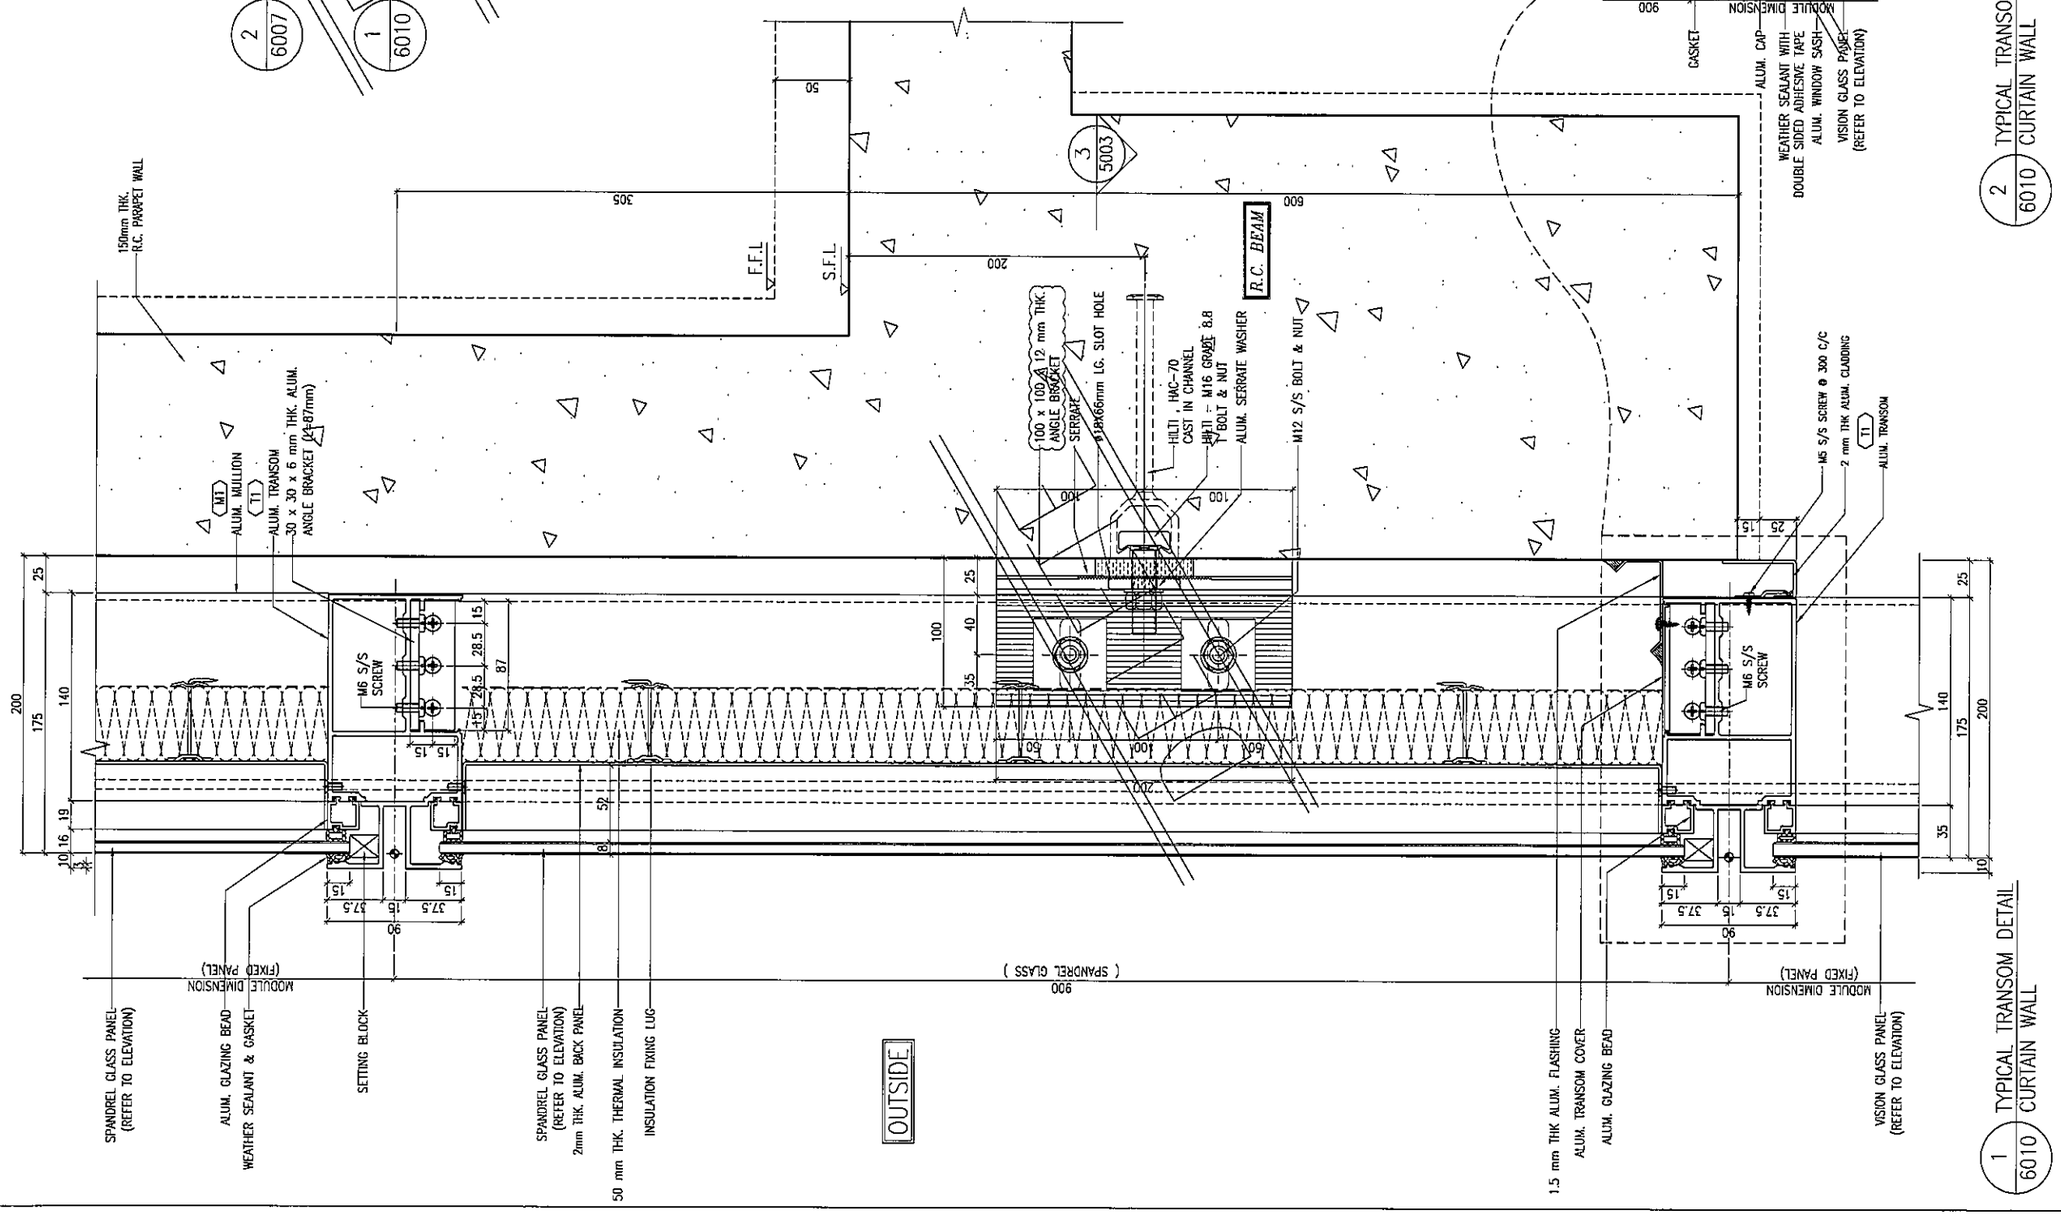

1 / 6010 TYPICAL TRANSOM DETAIL CURTAIN WALL

B.D. REF :

CLIENT :
信和置業有限公司
Sino Land Company Limited

ARCHITECT :
WONG TUNG & PARTNERS LIMITED
ARCHITECTS & PLANNERS

MAIN CONTRACTOR :
CR Construction Company Limited

STRUCTURAL ENGINEER :
AECOM

FACADE CONSULTANT:
AECOM

NOTE :
1. ALL DIMENSIONS ARE IN mm.
2. ALL ELEVATIONS ARE VIEWED FROM OUTSIDE.
3. ALL DIMENSIONS TO BE VERIFIED ON SITE BEFORE FABRICATION.

LEGEND :
- X1 / X001 — DETAIL MARK NO. / REFER SHEET NO.
1. F.F.L. --FINISHED FLOOR LEVEL
2. S.F.L. --STRUCTURAL FLOOR LEVEL
3. /R --REVERSED DETAIL

NO.	DATE	REVISED	BY
B	24/11/2018	GENERAL REVISED	
A	10/9/2018	GENERAL REVISED	

JOB NO. : J-837

PROJECT :
URA KWUN TONG TOWN CENTRE REDEVELOPMENT (AREA 2 & 3) AT NKIL 6514, KWUN TONG, KWLOON

TITLE :
TYPICAL TRANSOM DETAIL FOR CURTAIN WALL

DATE : 13-JUL-18 | SCALE : 1:2 (A1)

DRAWN BY : ASING | CHECKED BY : –

美特鋁質有限公司
MIDI ALUMINIUM FABRICATOR LTD.
Units 6-8, Sunray Industrial Centre, 1/F
610 Cha Kwo Ling Road, Kowloon
Tel:23489211-4 Fax:(852)27727686

DWG NO. : J837-CW-6010 | REV. : B

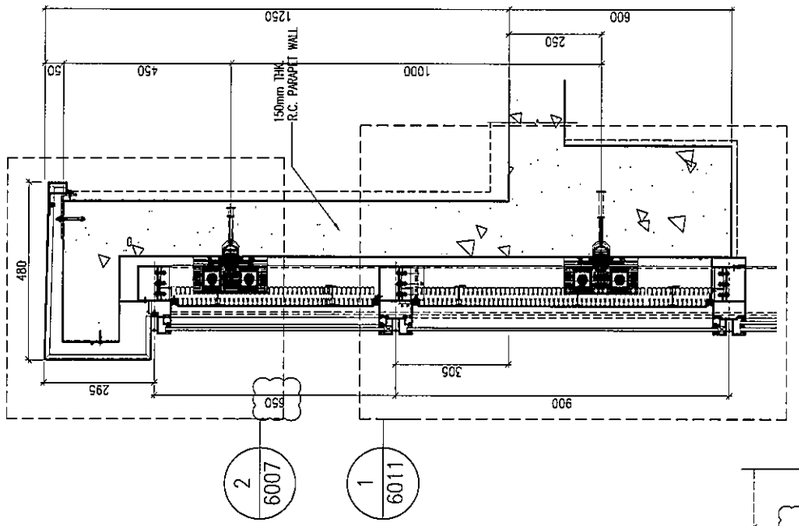

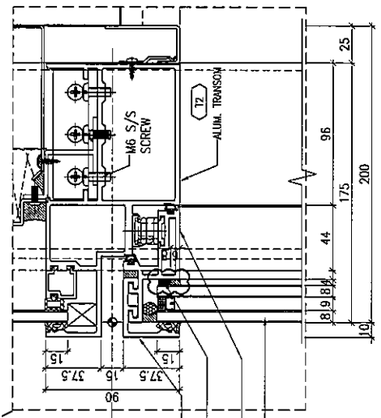

2 / 6011 TYPICAL TRANSOM DETAIL CURTAIN WALL

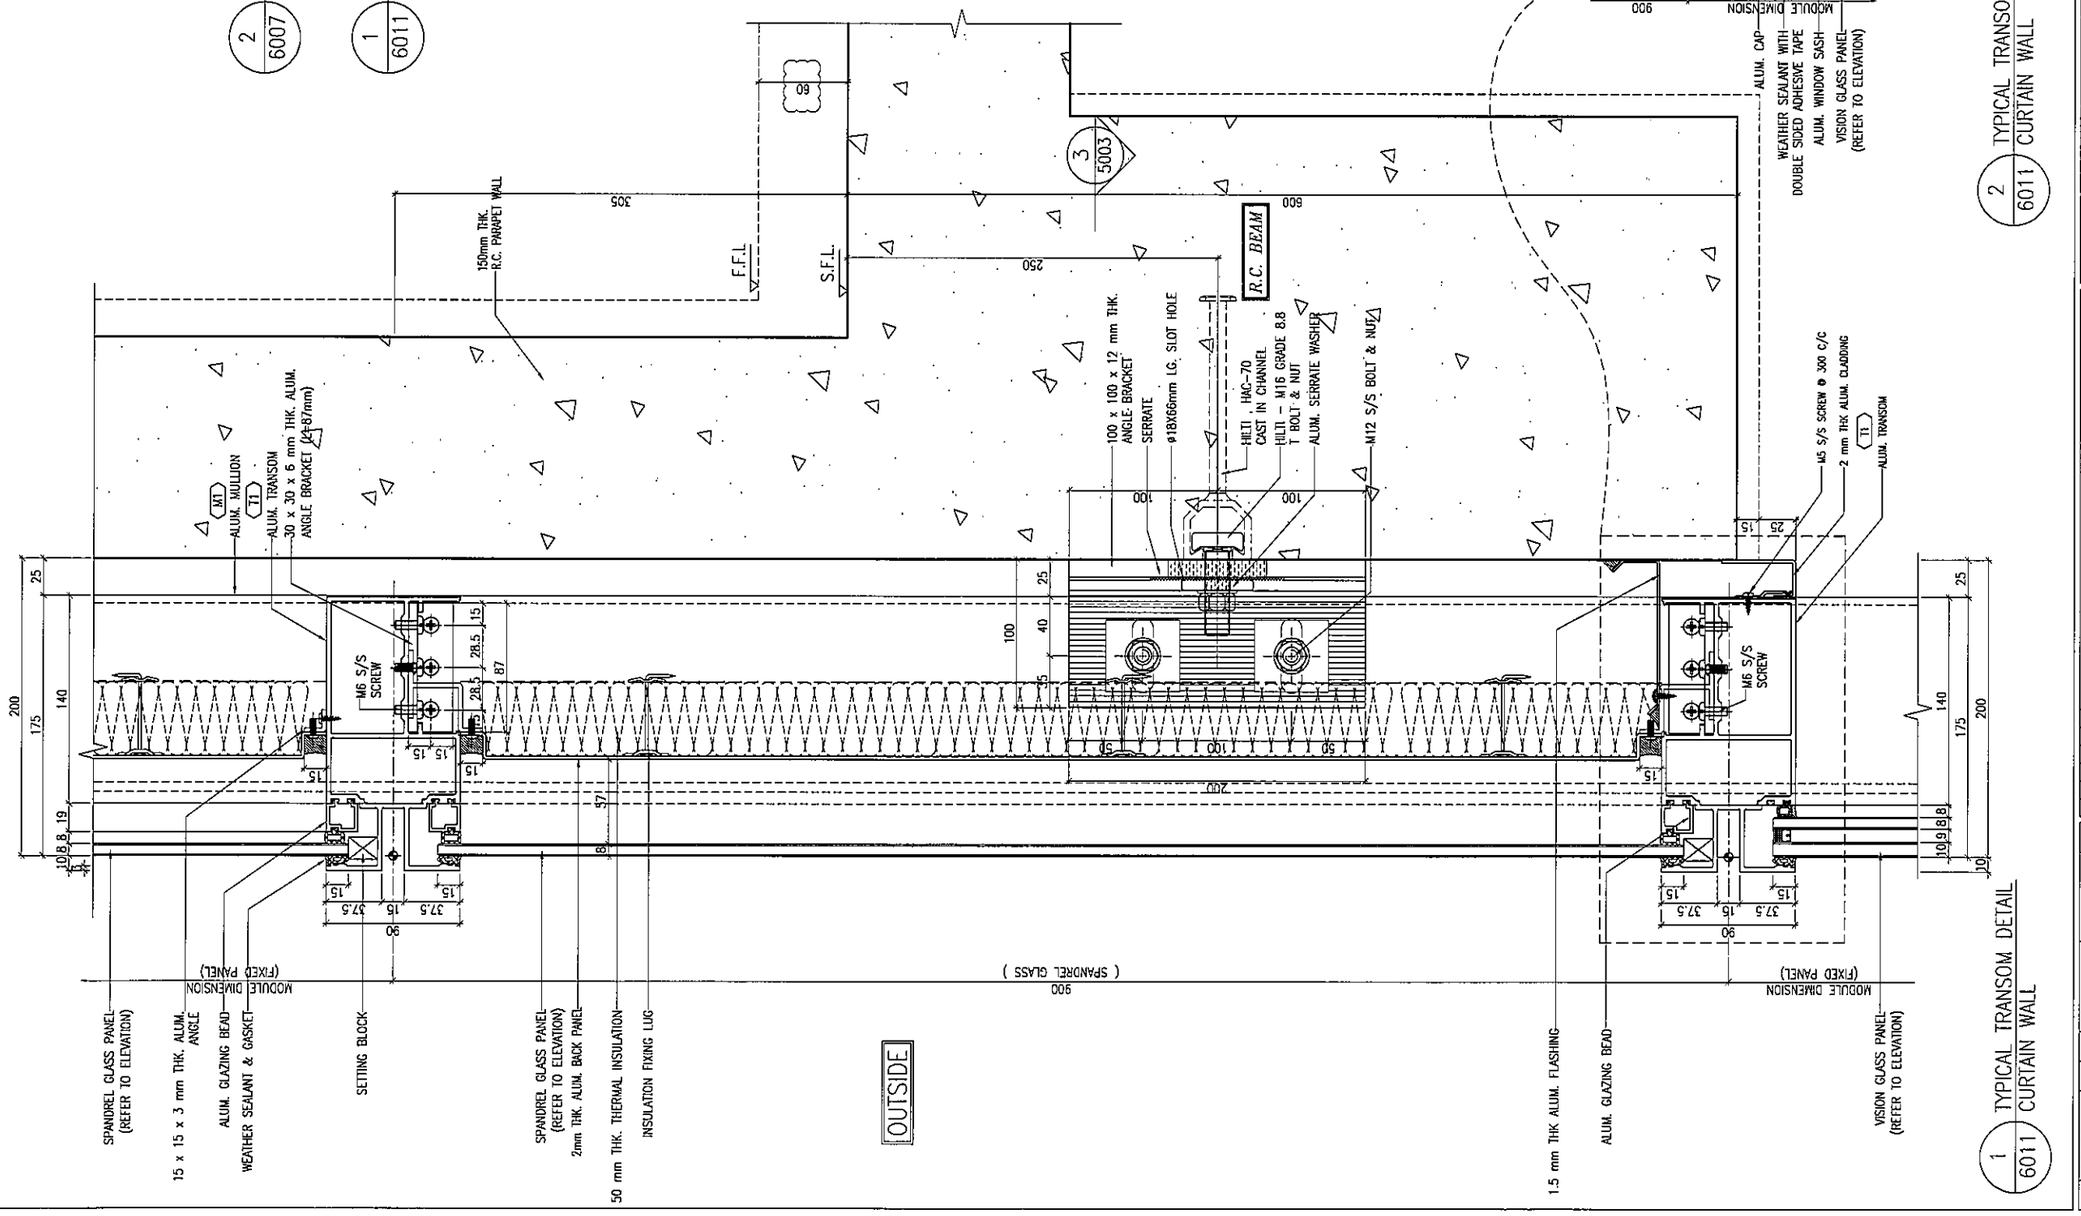

1 / 6011 TYPICAL TRANSOM DETAIL CURTAIN WALL

B.D. REF :

CLIENT :
信和置業有限公司
Sino Land Company Limited

ARCHITECT :
WONG TUNG & PARTNERS LIMITED
ARCHITECTS & PLANNERS

MAIN CONTRACTOR :
CR Construction Company Limited

STRUCTURAL ENGINEER :
AECOM

FACADE CONSULTANT:
AECOM

NOTE :
1. ALL DIMENSIONS ARE IN mm.
2. ALL ELEVATIONS ARE VIEWED FROM OUTSIDE.
3. ALL DIMENSIONS TO BE VERIFIED ON SITE BEFORE FABRICATION.

LEGEND :
X1 / X001 — DETAIL MARK NO. / REFER SHEET NO.
1. F.F.L. --FINISHED FLOOR LEVEL
2. S.F.L. --STRUCTURAL FLOOR LEVEL
3. /R --REVERSED DETAIL

NO	DATE	REVISED	BY
E	15/02/2019	GENERAL REVISED	
D	09/01/2019	GENERAL REVISED	
C	22/12/2018	GENERAL REVISED	
B	24/11/2018	GENERAL REVISED	
A	10/9/2018	GENERAL REVISED	

JOB NO. : J-837

PROJECT :
URA KWUN TONG TOWN CENTRE REDEVELOPMENT (AREA 2 & 3) AT NKIL 6514, KWUN TONG, KWLOON

TITLE :
TYPICAL TRANSOM DETAIL FOR CURTAIN WALL

DATE : 13-JUL-18 | SCALE : 1:2 (A1)

DRAWN BY : ASING | CHECKED BY : -

美特鋁製有限公司
MIDI ALUMINIUM FABRICATOR LTD.
Units 6-8, Sunray Industrial Centre, 1/F
610 Cha Kwo Ling Road, Kowloon
Tel:23489211-4 Fax:(852)27727666

DWG NO. : JB37-CW-6011 | REV. : E

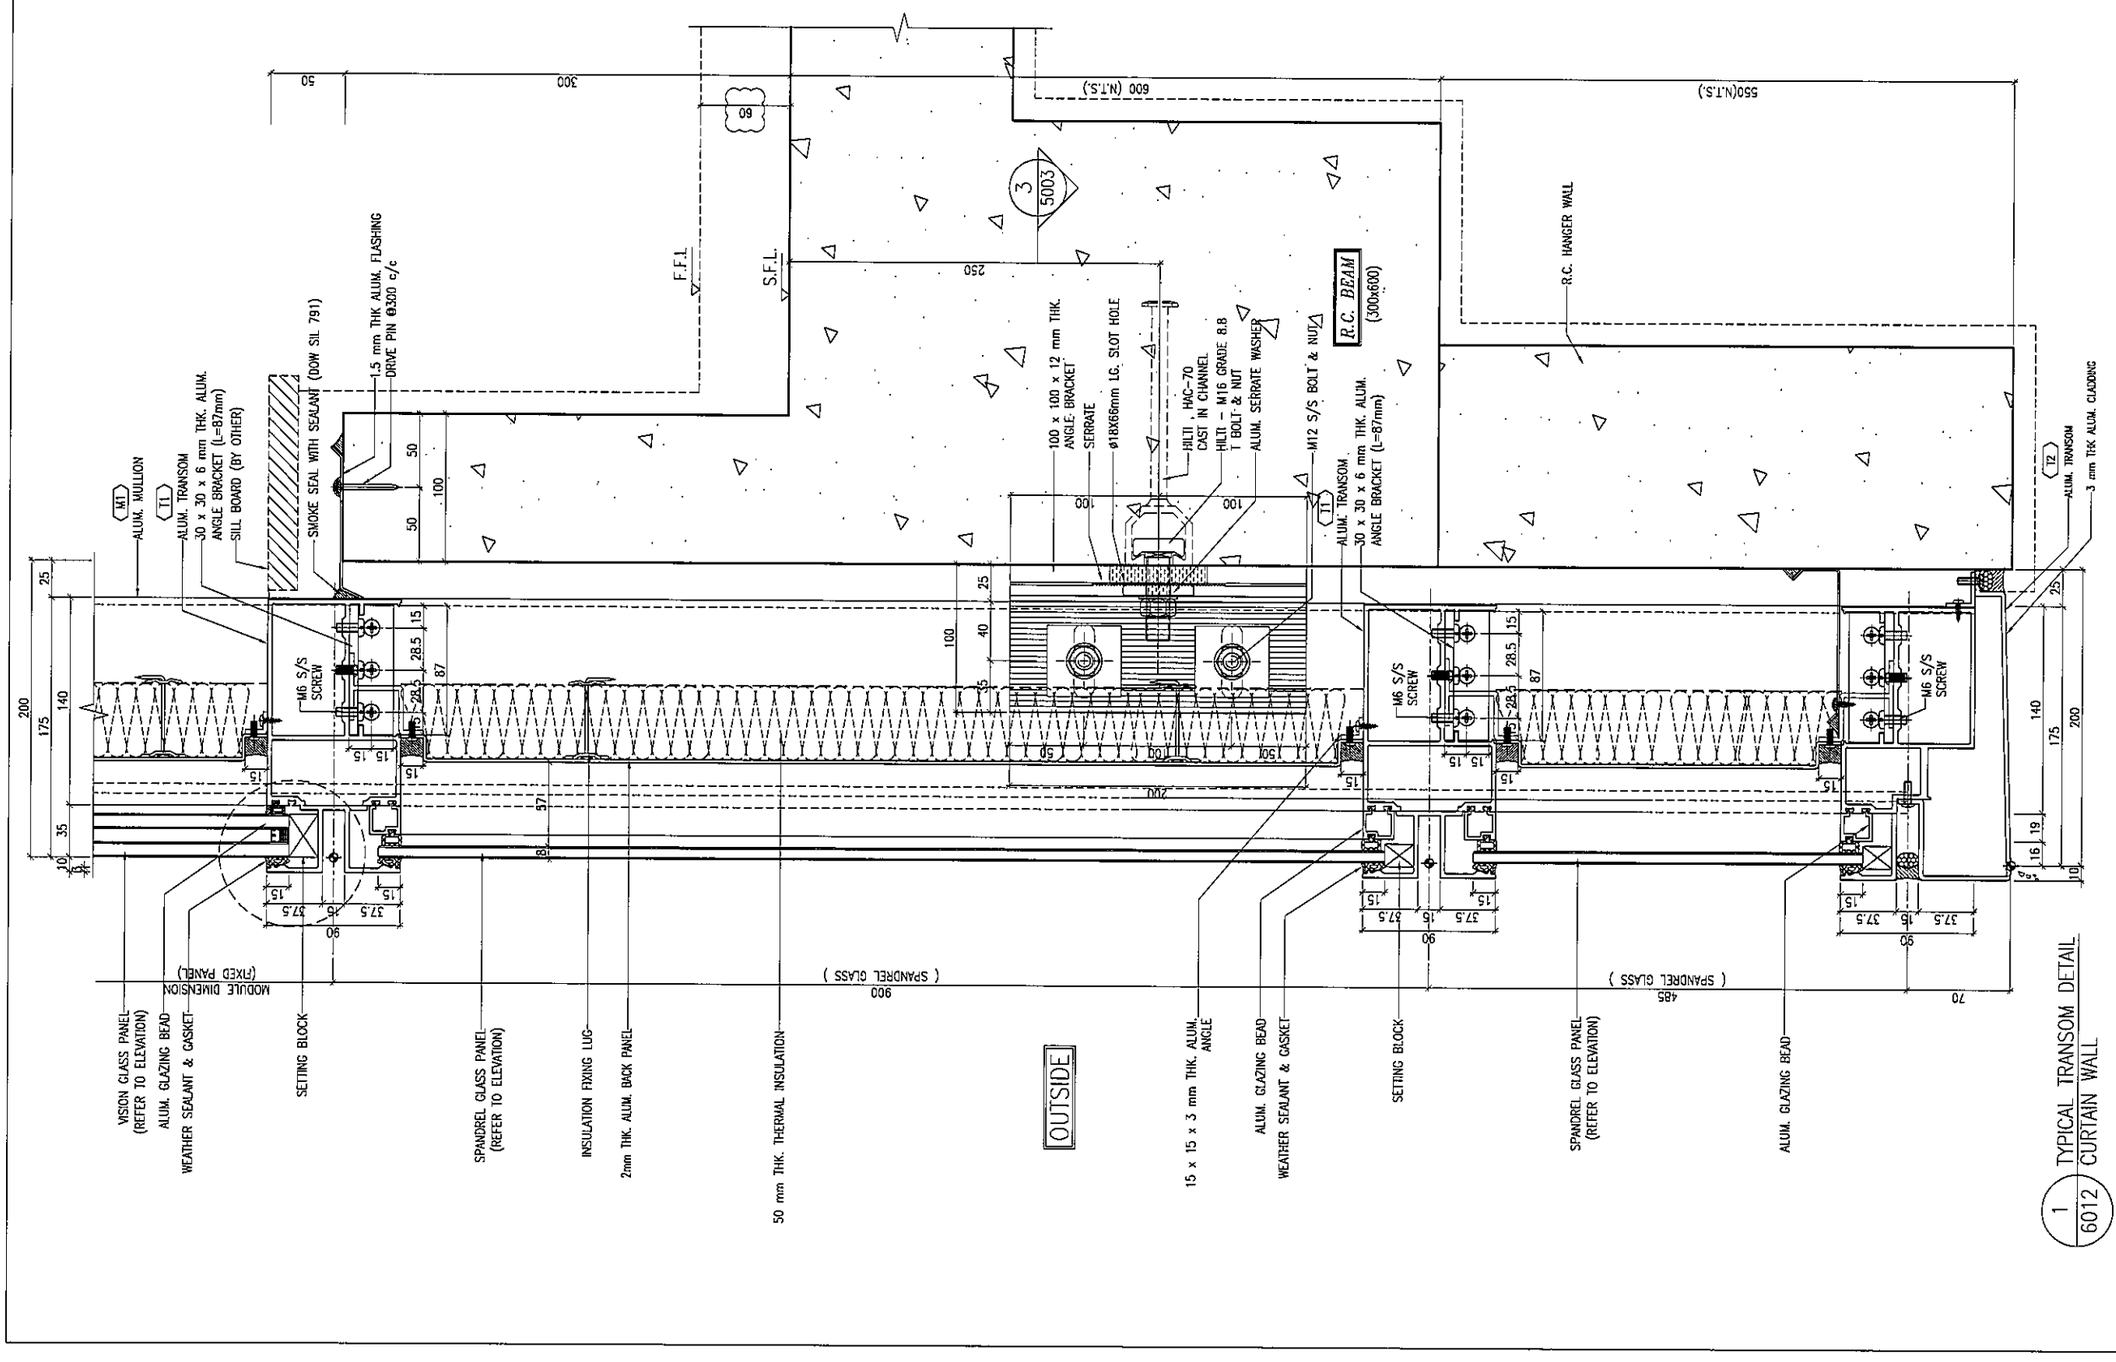

1 6012 TYPICAL TRANSOM DETAIL CURTAIN WALL

B.D. REF :

CLIENT :
信和置業有限公司
Sino Land Company Limited

ARCHITECT : WONG TUNG & PARTNERS LIMITED ARCHITECTS & PLANNERS

MAIN CONTRACTOR :
CR Construction Company Limited

STRUCTURAL ENGINEER :
AECOM

FACADE CONSULTANT:
AECOM

NOTE :
1. ALL DIMENSIONS ARE IN mm.
2. ALL ELEVATIONS ARE VIEWED FROM OUTSIDE.
3. ALL DIMENSIONS TO BE VERIFIED ON SITE BEFORE FABRICATION.

LEGEND :
X1 — DETAIL MARK NO.
X001 — REFER SHEET NO.

1. F.F.L. --FINISHED FLOOR LEVEL
2. S.F.L. --STRUCTURAL FLOOR LEVEL
3. (R) --REVERSED DETAIL

NO.	DATE	REVISED	BY
E	15/02/2019	GENERAL REVISED	
D	22/12/2018	GENERAL REVISED	
C	04/12/2018	GENERAL REVISED	
B	24/11/2018	GENERAL REVISED	
A	10/9/2018	GENERAL REVISED	

JOB NO. : J-837

PROJECT :
URA KWUN TONG TOWN CENTRE REDEVELOPMENT (AREA 2 & 3) AT NKIL 6514, KWUN TONG, KWLOON

TITLE :
TYPICAL TRANSOM DETAIL FOR CURTAIN WALL

DATE : 13-JUL-18 | SCALE : 1:2 (A1)

DRAWN BY : ASING | CHECKED BY : -

美特鋁質有限公司
MIDI ALUMINIUM FABRICATOR LTD.
Units 6-8, Sunray Industrial Centre, 1/F
610 Cha Kwo Ling Road, Kowloon
Tel:23489211-4 Fax:(852)27727666

DWG NO. : J837-CW-6012 | REV. : E

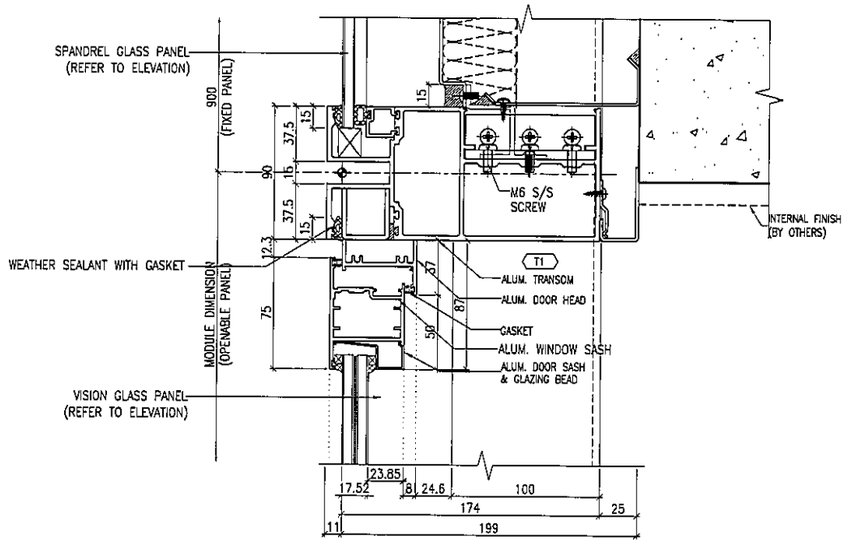

1 / 6013 TYPICAL TRANSOM DETAIL CURTAIN WALL

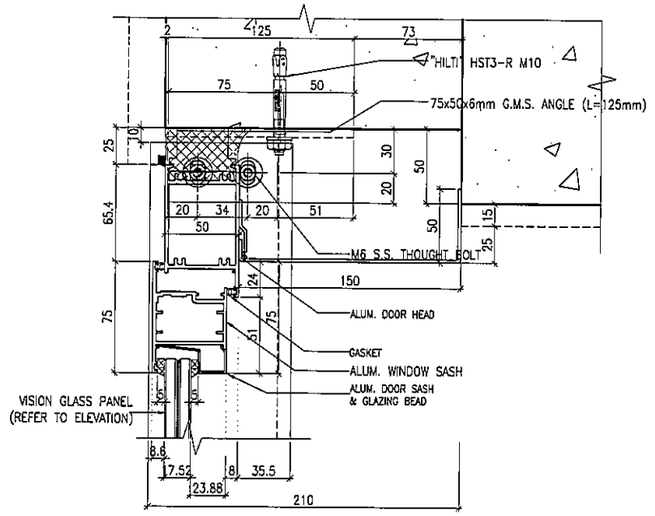

3 / 6013 TYPICAL TRANSOM DETAIL CURTAIN WALL

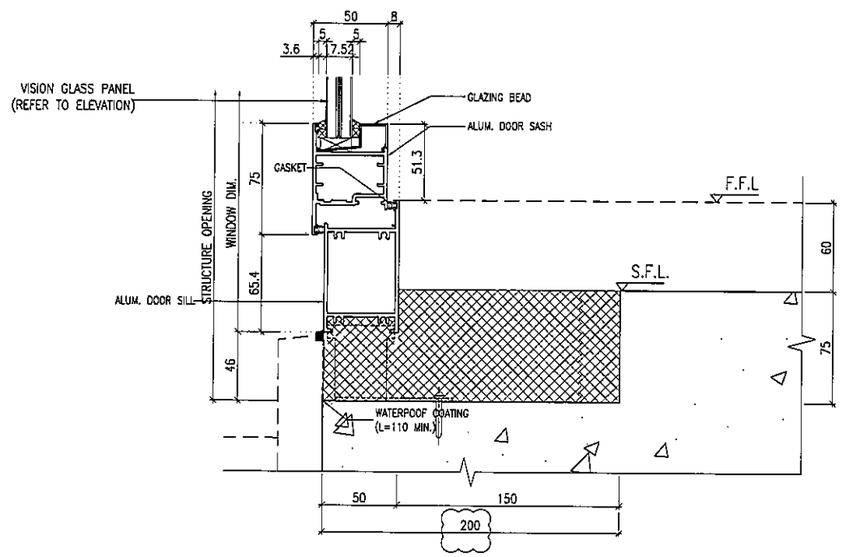

2 / 6013 TYPICAL TRANSOM DETAIL CURTAIN WALL

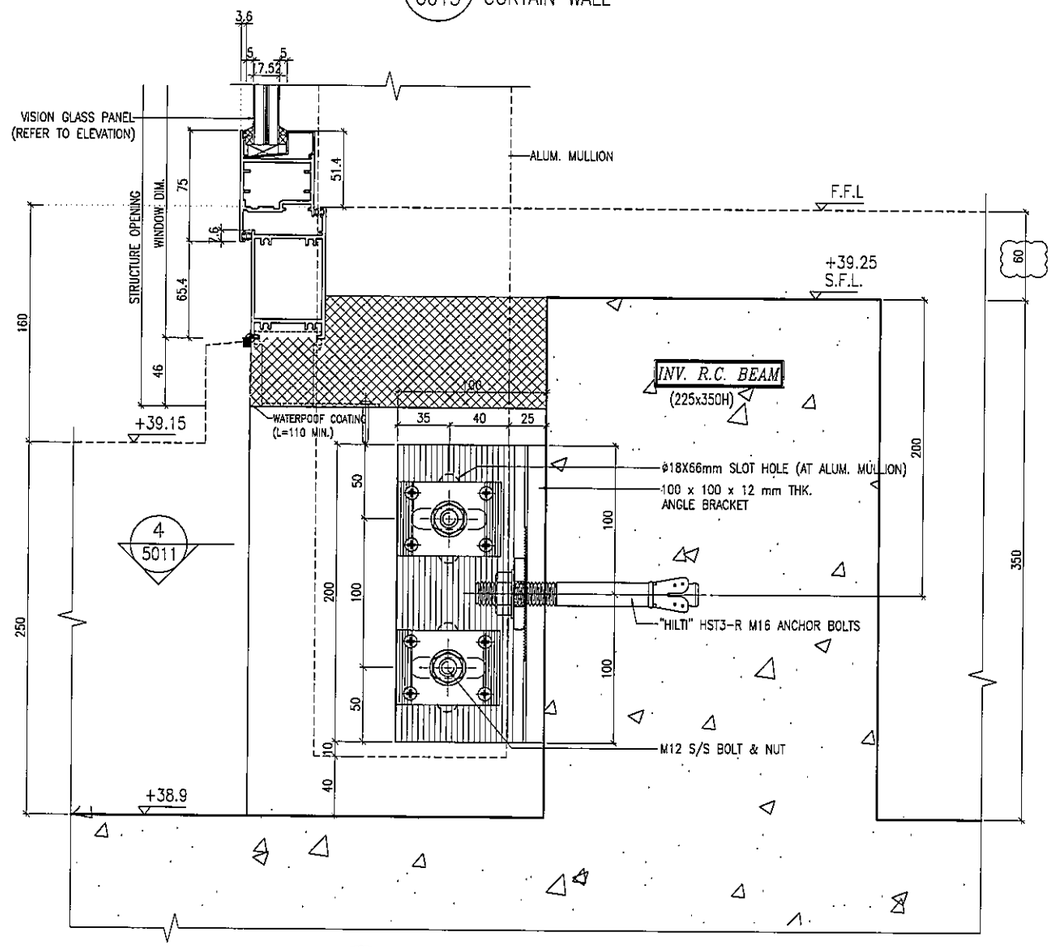

4 / 6013 TYPICAL TRANSOM DETAIL CURTAIN WALL

B.D. REF :

CLIENT :
信和置業有限公司
Sino Land Company Limited

ARCHITECT : WONG TUNG & PARTNERS LIMITED
ARCHITECTS & PLANNERS

MAIN CONTRACTOR :
CR Construction Company Limited

STRUCTURAL ENGINEER :
AECOM

FACADE CONSULTANT:
AECOM

NOTE :
1. ALL DIMENSIONS ARE IN mm.
2. ALL ELEVATIONS ARE VIEWED FROM OUTSIDE.
3. ALL DIMENSIONS TO BE VERIFIED ON SITE BEFORE FABRICATION.

LEGEND :
X1 / W001 — DETAIL MARK NO. / REFER SHEET NO.
1. F.F.L. --FINISHED FLOOR LEVEL
2. S.F.L. --STRUCTURAL FLOOR LEVEL
3. /R --REVERSED DETAIL

NO.	DATE	REVISED	BY
D	26/05/2019	GENERAL REVISED	
C	15/02/2019	GENERAL REVISED	
B	24/11/2018	GENERAL REVISED	
A	10/9/2018	GENERAL REVISED	

JOB NO. : J-837

PROJECT :
URA KWUN TONG TOWN CENTRE REDEVELOPMENT (AREA 2 & 3) AT NKIL 6514, KWUN TONG, KWLOON

TITLE :
TYPICAL TRANSOM DETAIL FOR CURTAIN WALL

DATE : 13-JUL-18 | SCALE : 1:2 (A1)

DRAWN BY : ASING | CHECKED BY : -

美特鋁質有限公司
MIDI ALUMINIUM FABRICATOR LTD.
Units 6-8, Sunray Industrial Centre, 1/F
610 Cha Kwo Ling Road, Kowloon
Tel:23489211-4 Fax:(852)27727666

DWG NO. : J837-CW-6013 | REV. : D

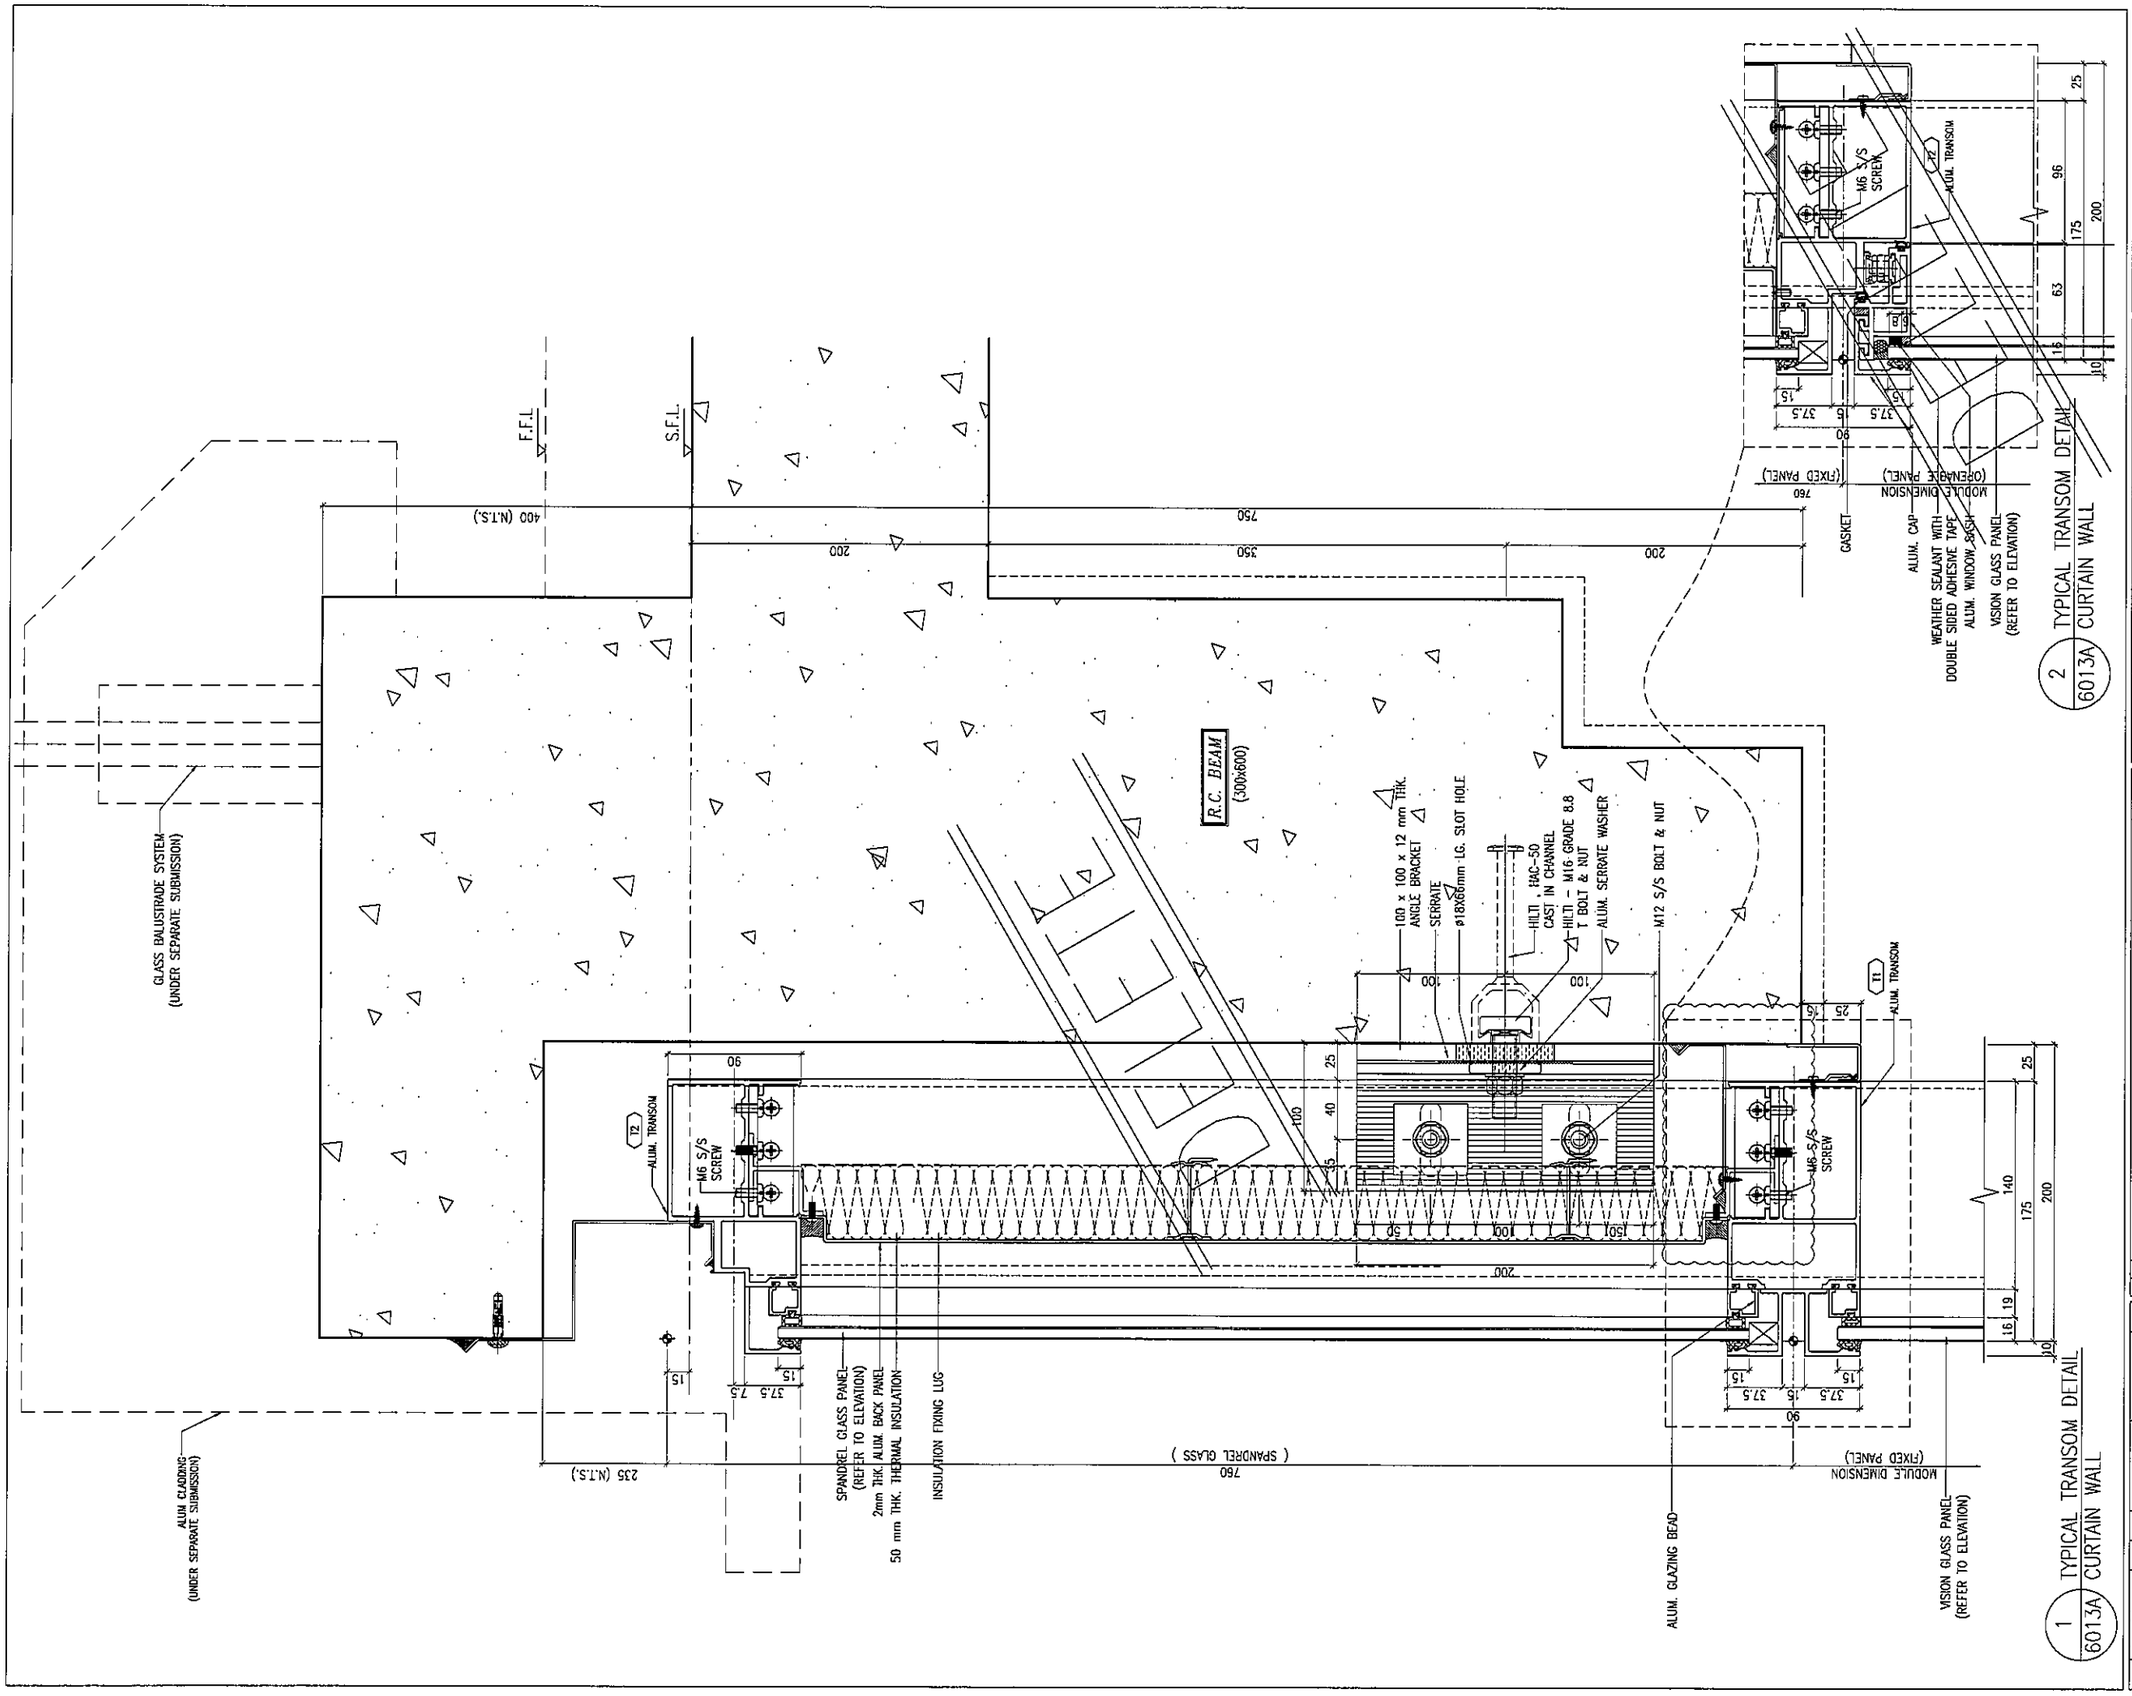

B.D. REF :

CLIENT :
信和置業有限公司
Sino Land Company Limited

ARCHITECT :
WONG TUNG & PARTNERS LIMITED
ARCHITECTS & PLANNERS

MAIN CONTRACTOR :
CR Construction Company Limited

STRUCTURAL ENGINEER :
AECOM

FACADE CONSULTANT:
AECOM

NOTE :
1. ALL DIMENSIONS ARE IN mm.
2. ALL ELEVATIONS ARE VIEWED FROM OUTSIDE.
3. ALL DIMENSIONS TO BE VERIFIED ON SITE BEFORE FABRICATION.

LEGEND :
- X1 / X001 — DETAIL MARK NO. / REFER SHEET NO.
1. F.F.L. --FINISHED FLOOR LEVEL
2. S.F.L. --STRUCTURAL FLOOR LEVEL
3. (/R) --REVERSED DETAIL

NO.	DATE	REVISED	BY
A	24/11/2018	GENERAL REVISED	

JOB NO. : J-837

PROJECT :
URA KWUN TONG TOWN CENTRE
REDEVELOPMENT (AREA 2 & 3) AT
NKIL 6514, KWUN TONG, KWLOON

TITLE :
TYPICAL TRANSOM DETAIL
FOR CURTAIN WALL

DATE : 13-JUL-18	SCALE : 1:2 (A1)
DRAWN BY : ASING	CHECKED BY : -

美特鋁質有限公司
MIDI ALUMINIUM FABRICATOR LTD.
Units 6-8, Sunray Industrial Centre, 1/F
610 Cha Kwo Ling Road, Kowloon
Tel:23489211-4 Fax:(852)27727666

DWG NO. : J837-CW-6013A | REV. : A

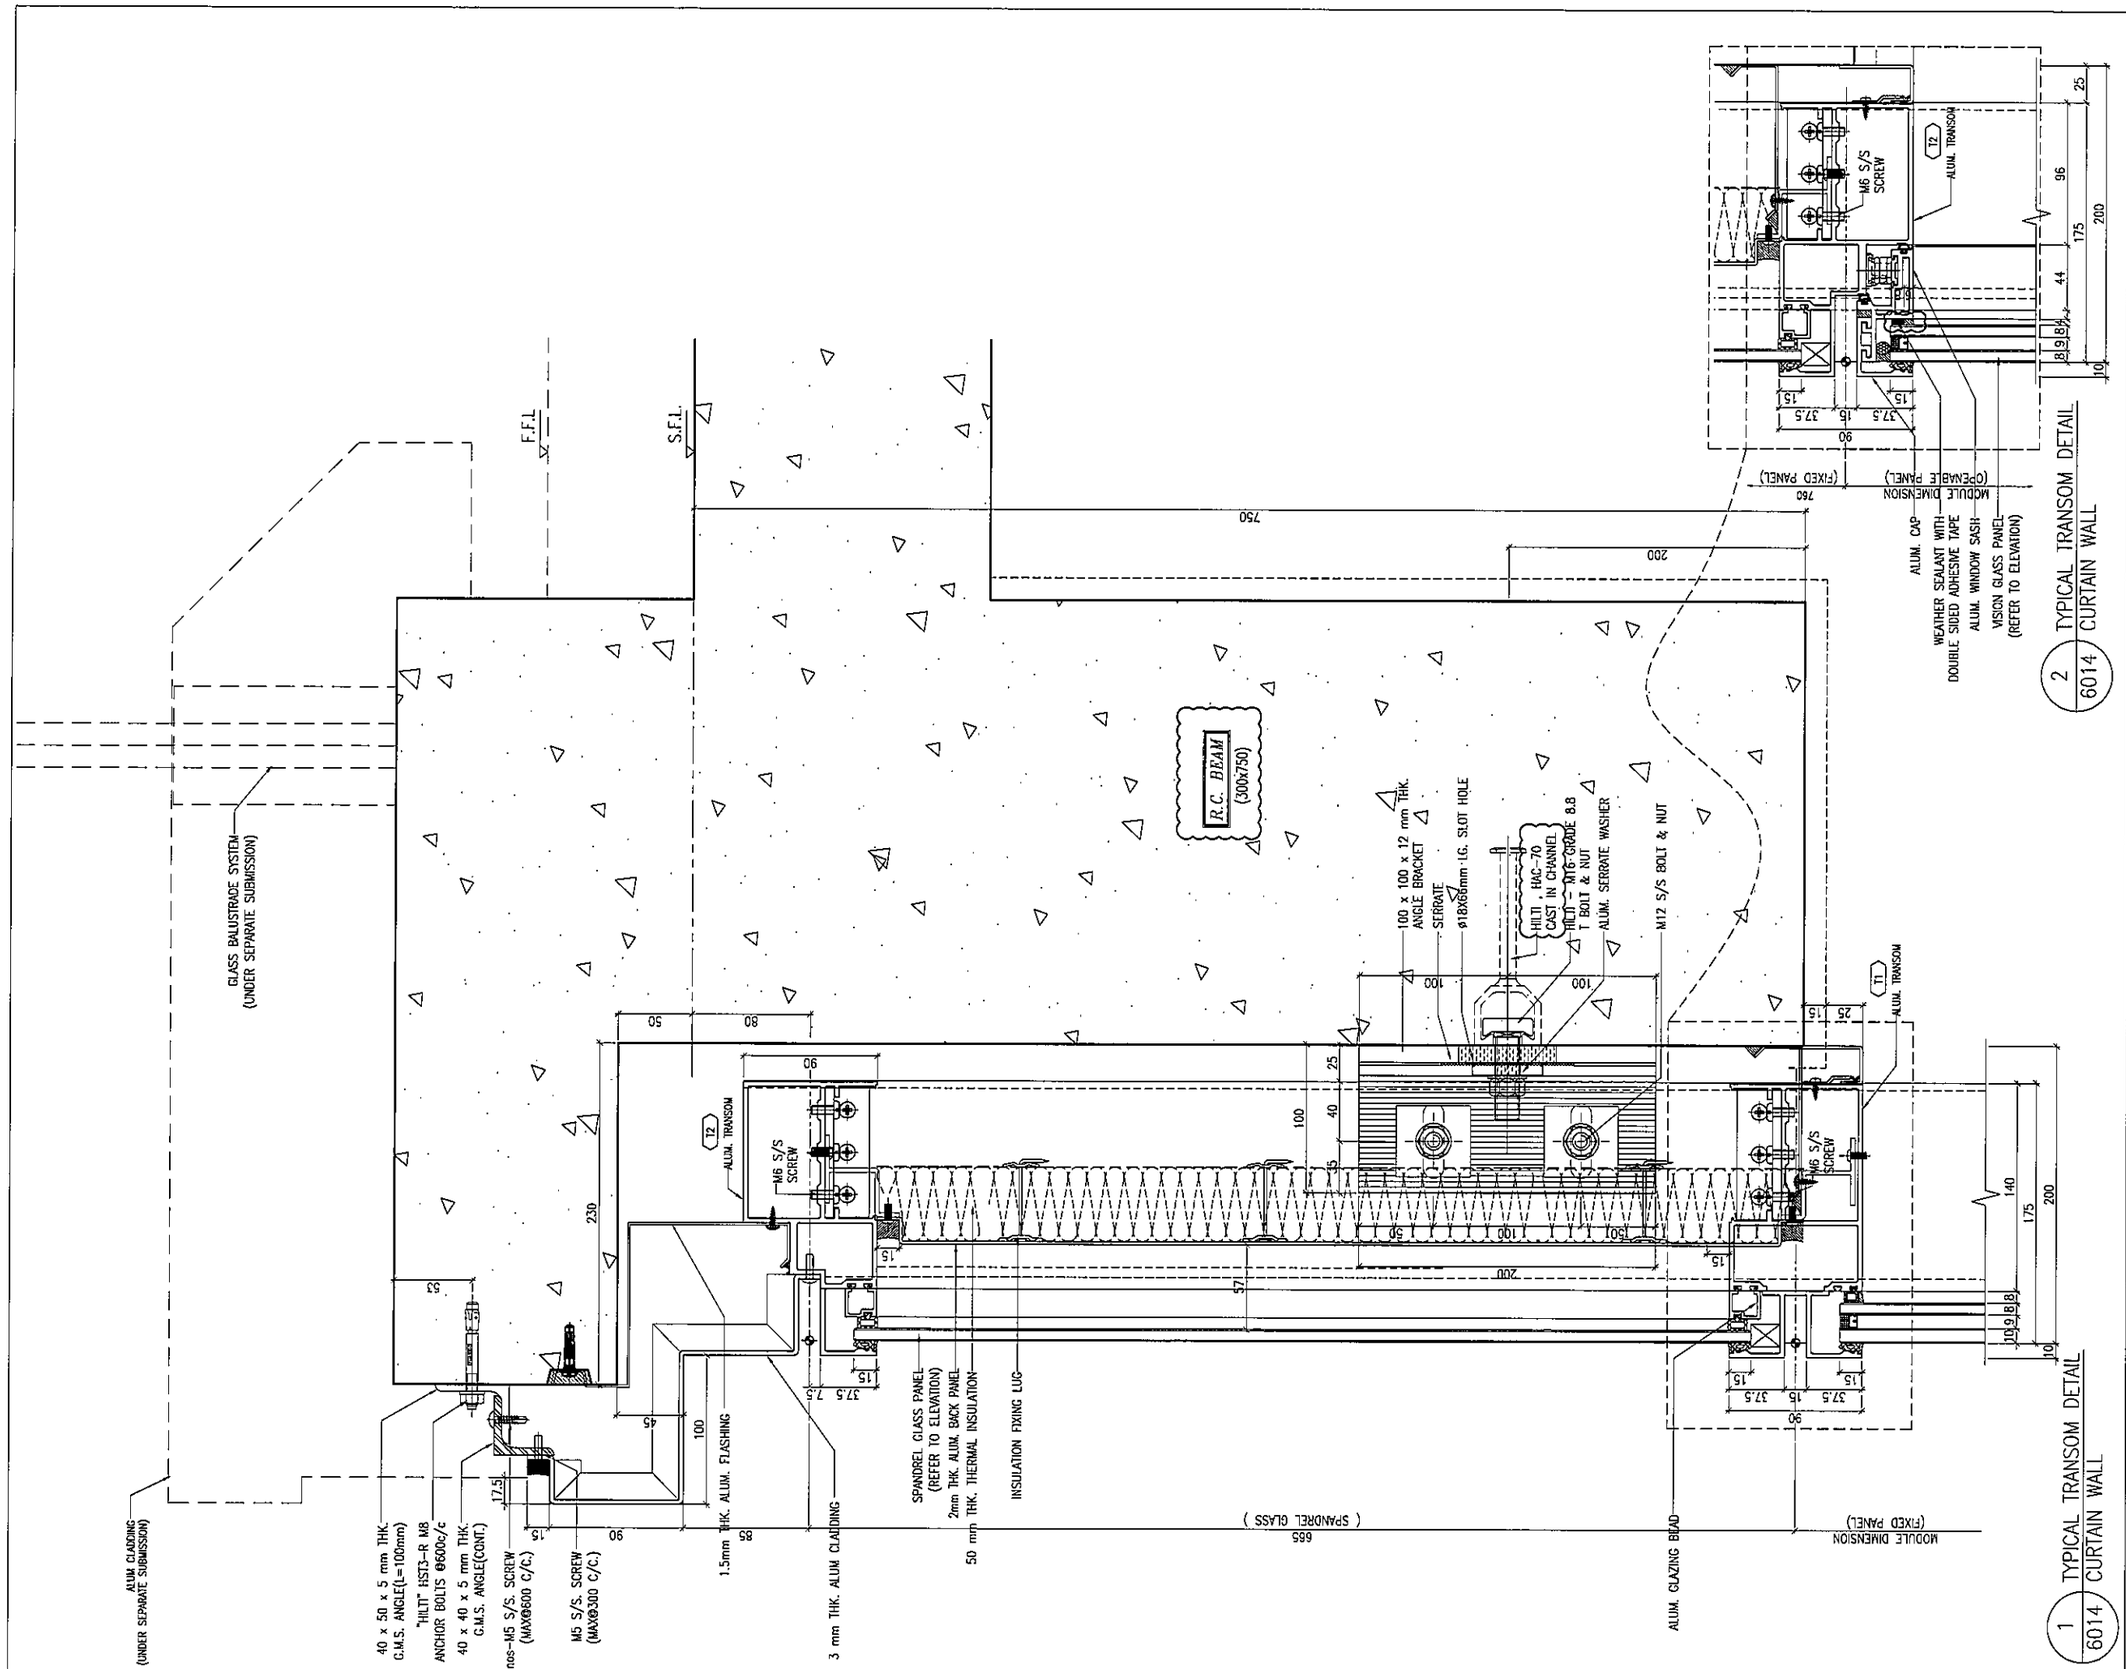

B.D. REF :

CLIENT :
信和置業有限公司
Sino Land Company Limited

ARCHITECT :
WONG TUNG & PARTNERS LIMITED
ARCHITECTS & PLANNERS

MAIN CONTRACTOR :
CR Construction Company Limited

STRUCTURAL ENGINEER :
AECOM

FACADE CONSULTANT:
AECOM

NOTE :
1. ALL DIMENSIONS ARE IN mm.
2. ALL ELEVATIONS ARE VIEWED FROM OUTSIDE.
3. ALL DIMENSIONS TO BE VERIFIED ON SITE BEFORE FABRICATION.

LEGEND :
- X1 / X001 — DETAIL MARK NO. / REFER SHEET NO.
1. F.F.L. --FINISHED FLOOR LEVEL
2. S.F.L. --STRUCTURAL FLOOR LEVEL
3. (R) --REVERSED DETAIL

NO.	DATE	REVISED	BY
B	22/12/2018	GENERAL REVISED	
A	24/11/2018	GENERAL REVISED	

JOB NO. : J-837

PROJECT :
URA KWUN TONG TOWN CENTRE REDEVELOPMENT (AREA 2 & 3) AT NKIL 6514, KWUN TONG, KWLOON

TITLE :
TYPICAL TRANSOM DETAIL FOR CURTAIN WALL

DATE : 13-JUL-18 | SCALE : 1:2 (A1)

DRAWN BY : ASING | CHECKED BY : -

美特鋁質有限公司
MIDI ALUMINIUM FABRICATOR LTD.
Units 6-8, Sunray Industrial Centre, 1/F
610 Cha Kwo Ling Road, Kowloon
Tel:23489211-4 Fax:(852)27727666

DWG NO. : J837-CW-6014 | REV. : B

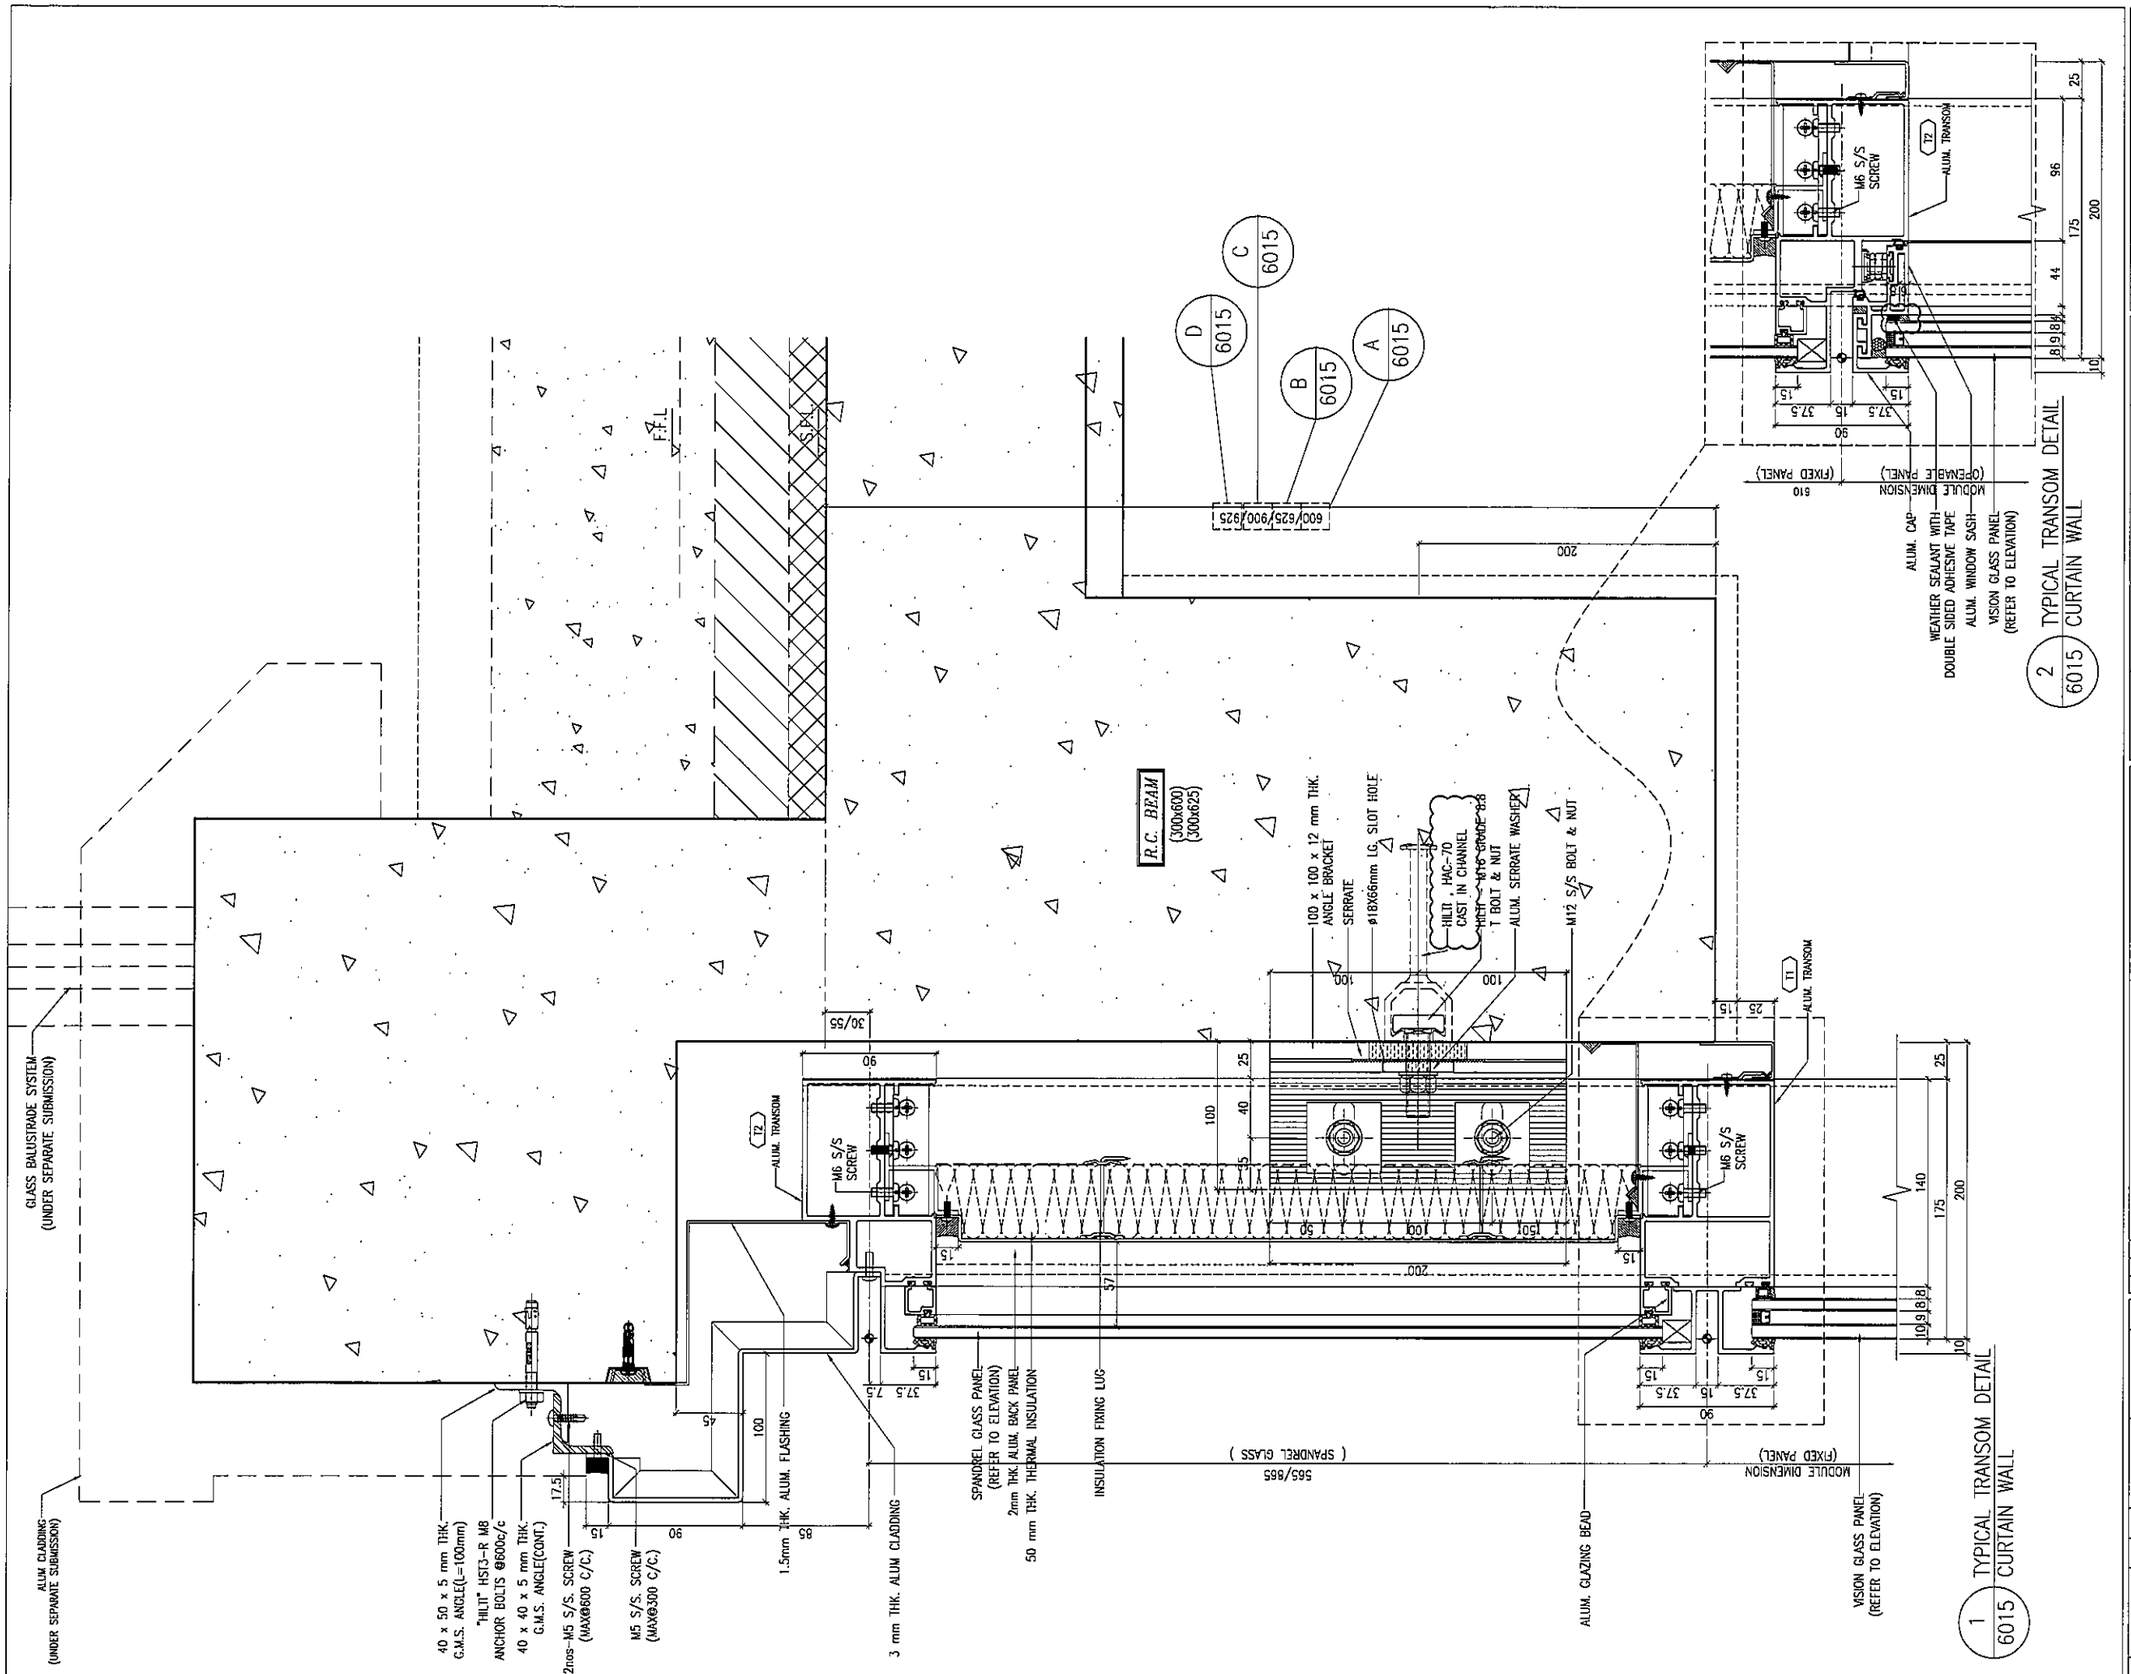

B.D. REF :

CLIENT :
信和置業有限公司
Sino Land Company Limited

ARCHITECT :
WONG TUNG & PARTNERS LIMITED
ARCHITECTS & PLANNERS

MAIN CONTRACTOR :
CR Construction Company Limited

STRUCTURAL ENGINEER :
AECOM

FACADE CONSULTANT:
AECOM

NOTE :
1. ALL DIMENSIONS ARE IN mm.
2. ALL ELEVATIONS ARE VIEWED FROM OUTSIDE.
3. ALL DIMENSIONS TO BE VERIFIED ON SITE BEFORE FABRICATION.

LEGEND :
X1 — DETAIL MARK NO.
X001 — REFER SHEET NO.

1. F.F.L. --FINISHED FLOOR LEVEL
2. S.F.L. --STRUCTURAL FLOOR LEVEL
3. /R --REVERSED DETAIL

NO.	DATE	REVISED	BY
B	22/12/2018	GENERAL REVISED	
A	24/11/2018	GENERAL REVISED	

JOB NO. : J-837

PROJECT :
URA KWUN TONG TOWN CENTRE REDEVELOPMENT (AREA 2 & 3) AT NKIL 6514, KWUN TONG, KWLOON

TITLE :
TYPICAL TRANSOM DETAIL FOR CURTAIN WALL

DATE : 13-JUL-18 | SCALE : 1:2 (A1)

DRAWN BY : ASING | CHECKED BY : -

美特鋁質有限公司
MIDI ALUMINIUM FABRICATOR LTD.
Units 6-8, Sunray Industrial Centre, 1/F
610 Cha Kwo Ling Road, Kowloon
Tel:23489211-4 Fax:(852)27727666

DWG NO. : J837-CW-6015 | REV. : B

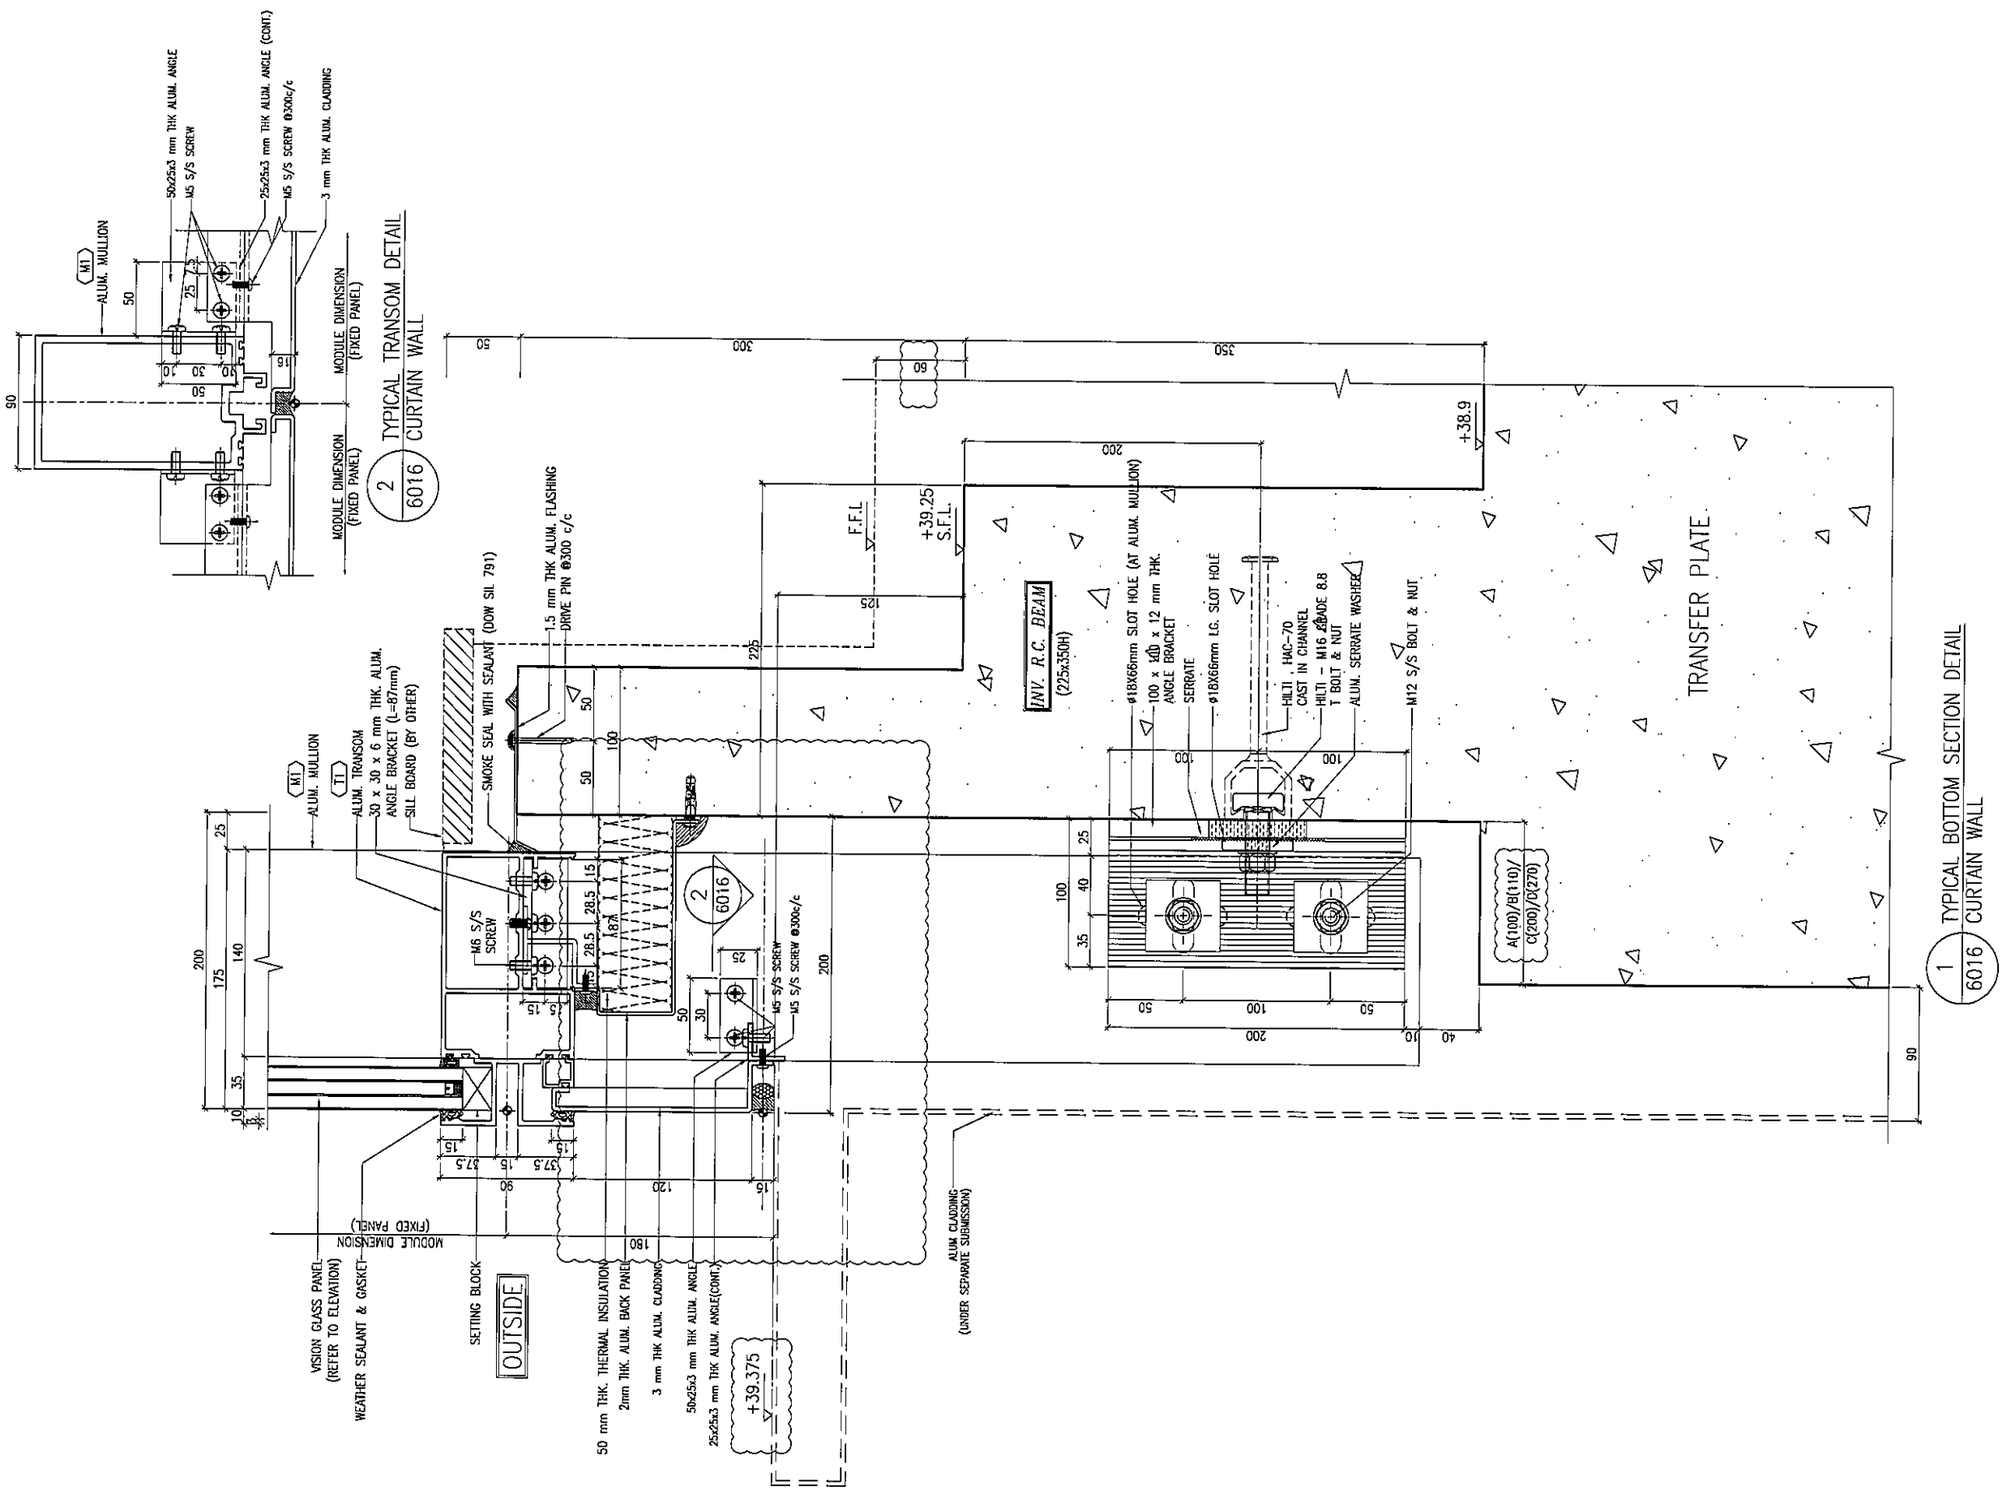

B.D. REF :

CLIENT :
信和置業有限公司
Sino Land Company Limited

ARCHITECT :
WONG TUNG & PARTNERS LIMITED
ARCHITECTS & PLANNERS

MAIN CONTRACTOR :
CR Construction Company Limited

STRUCTURAL ENGINEER :
AECOM

FACADE CONSULTANT:
AECOM

NOTE :
1. ALL DIMENSIONS ARE IN mm.
2. ALL ELEVATIONS ARE VIEWED FROM OUTSIDE.
3. ALL DIMENSIONS TO BE VERIFIED ON SITE BEFORE FABRICATION.

LEGEND :
X1 / X001 — DETAIL MARK NO. / REFER SHEET NO.
1. F.F.L. --FINISHED FLOOR LEVEL
2. S.F.L. --STRUCTURAL FLOOR LEVEL
3. /R --REVERSED DETAIL

NO.	DATE	REVISED	BY
B	15/02/2019	GENERAL REVISED	
A	24/11/2018	GENERAL REVISED	

JOB NO. : J-837

PROJECT :
URA KWUN TONG TOWN CENTRE REDEVELOPMENT (AREA 2 & 3) AT NKIL 6514, KWUN TONG, KWLOON

TITLE :
TYPICAL TRANSOM DETAIL FOR CURTAIN WALL

DATE : 13-JUL-18 | SCALE : 1:2 (A1)

DRAWN BY : Asing | CHECKED BY : -

美特鋁製有限公司
MIDI ALUMINIUM FABRICATOR LTD.
Units 6-8, Sunray Industrial Centre, 1/F
610 Cha Kwo Ling Road, Kowloon
Tel:23489211-4 Fax:(852)27727666

DWG NO. : J837-CW-6016 | REV. : B

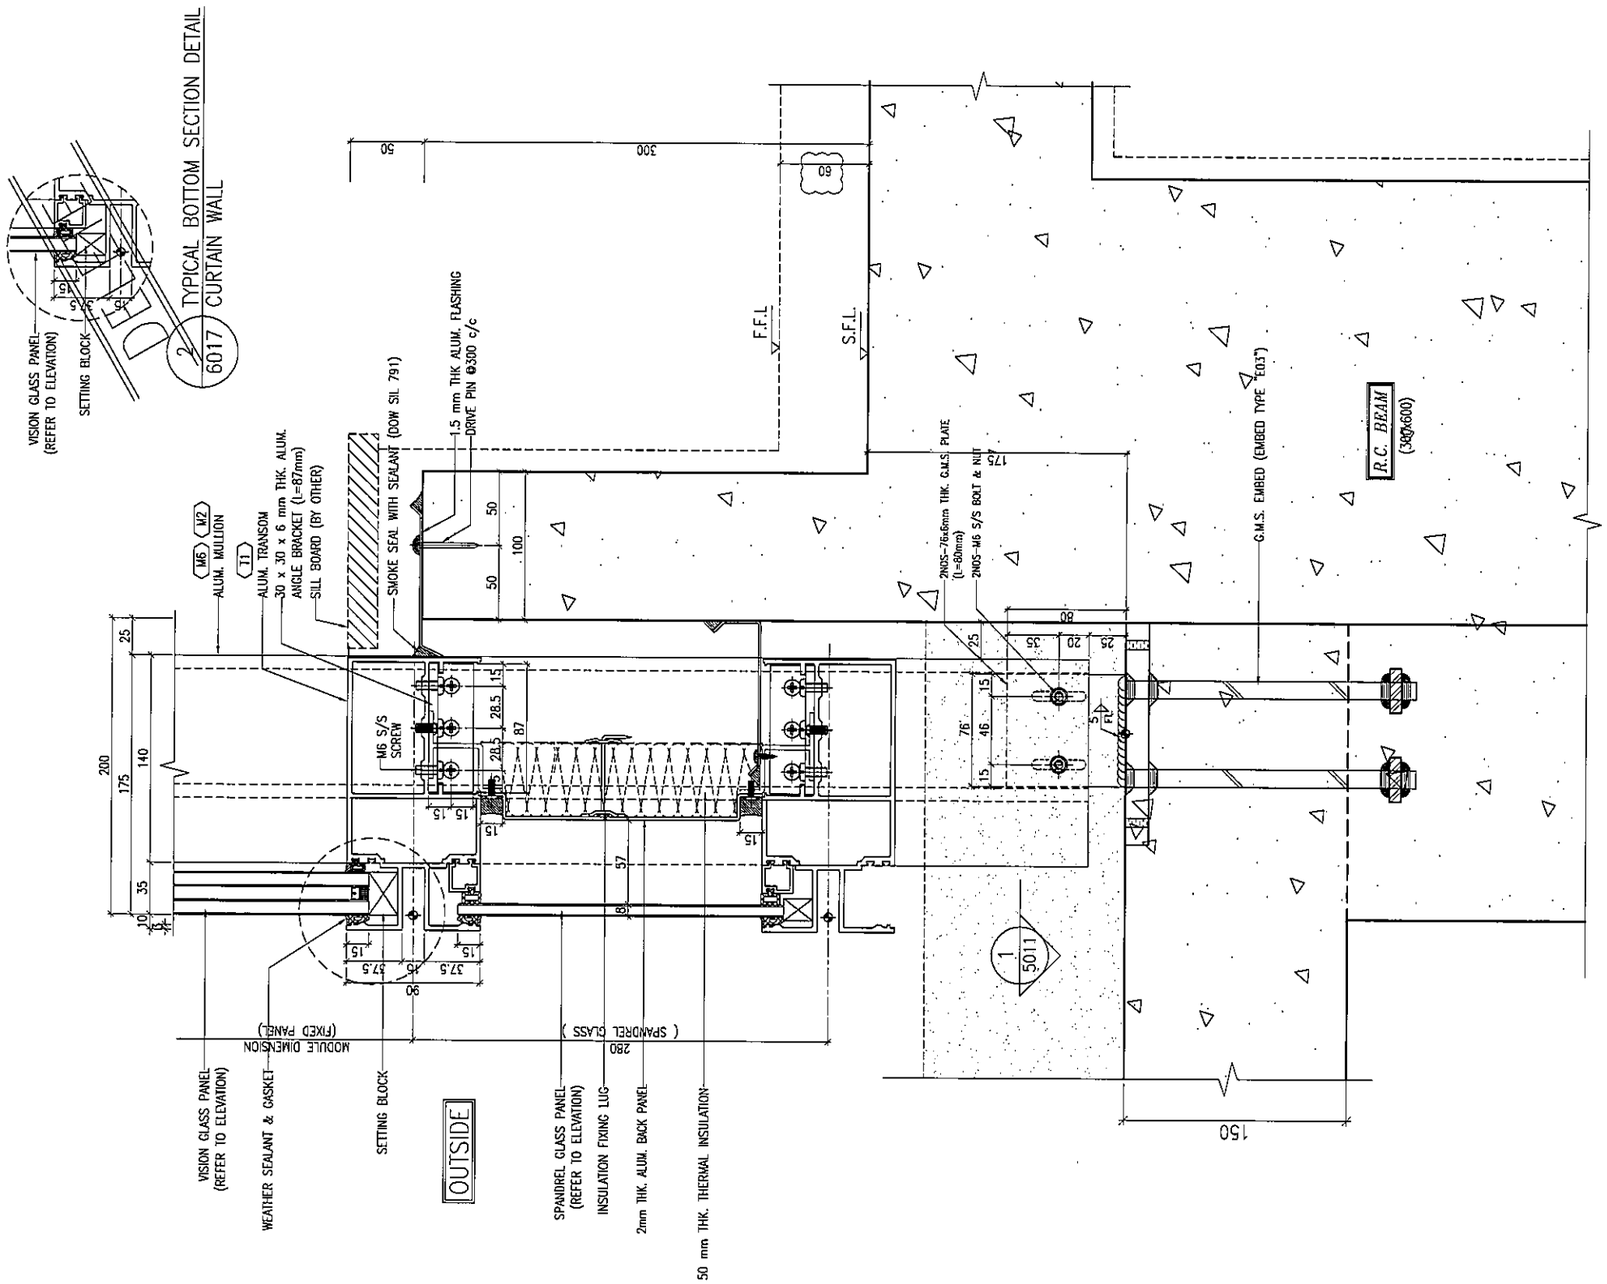

B.D. REF :

CLIENT :
信和置業有限公司
Sino Land Company Limited

ARCHITECT :
WONG TUNG & PARTNERS LIMITED
ARCHITECTS & PLANNERS

MAIN CONTRACTOR :
CR Construction Company Limited

STRUCTURAL ENGINEER :
AECOM

FACADE CONSULTANT:
AECOM

NOTE :
1. ALL DIMENSIONS ARE IN mm.
2. ALL ELEVATIONS ARE VIEWED FROM OUTSIDE.
3. ALL DIMENSIONS TO BE VERIFIED ON SITE BEFORE FABRICATION.

LEGEND :
- X1 / X001 — DETAIL MARK NO. / REFER SHEET NO.
1. F.F.L. --FINISHED FLOOR LEVEL
2. S.F.L. --STRUCTURAL FLOOR LEVEL
3. /R --REVERSED DETAIL

NO.	DATE	REVISED	BY
B	15/02/2019	GENERAL REVISED	
A	24/11/2018	GENERAL REVISED	

JOB NO. : J-837

PROJECT :
URA KWUN TONG TOWN CENTRE REDEVELOPMENT (AREA 2 & 3) AT NKIL 6514, KWUN TONG, KWLOON

TITLE :
TYPICAL TRANSOM DETAIL FOR CURTAIN WALL

DATE : 13-JUL-18 | SCALE : 1:2 (A1)

DRAWN BY : Asing | CHECKED BY : -

美特鋁質有限公司
MIDI ALUMINIUM FABRICATOR LTD.
Units 6-8, Sunray Industrial Centre, 1/F
610 Cha Kwo Ling Road, Kowloon
Tel:23489211-4 Fax:(852)27727666

DWG NO. : J837-CW-6017 | REV. : B

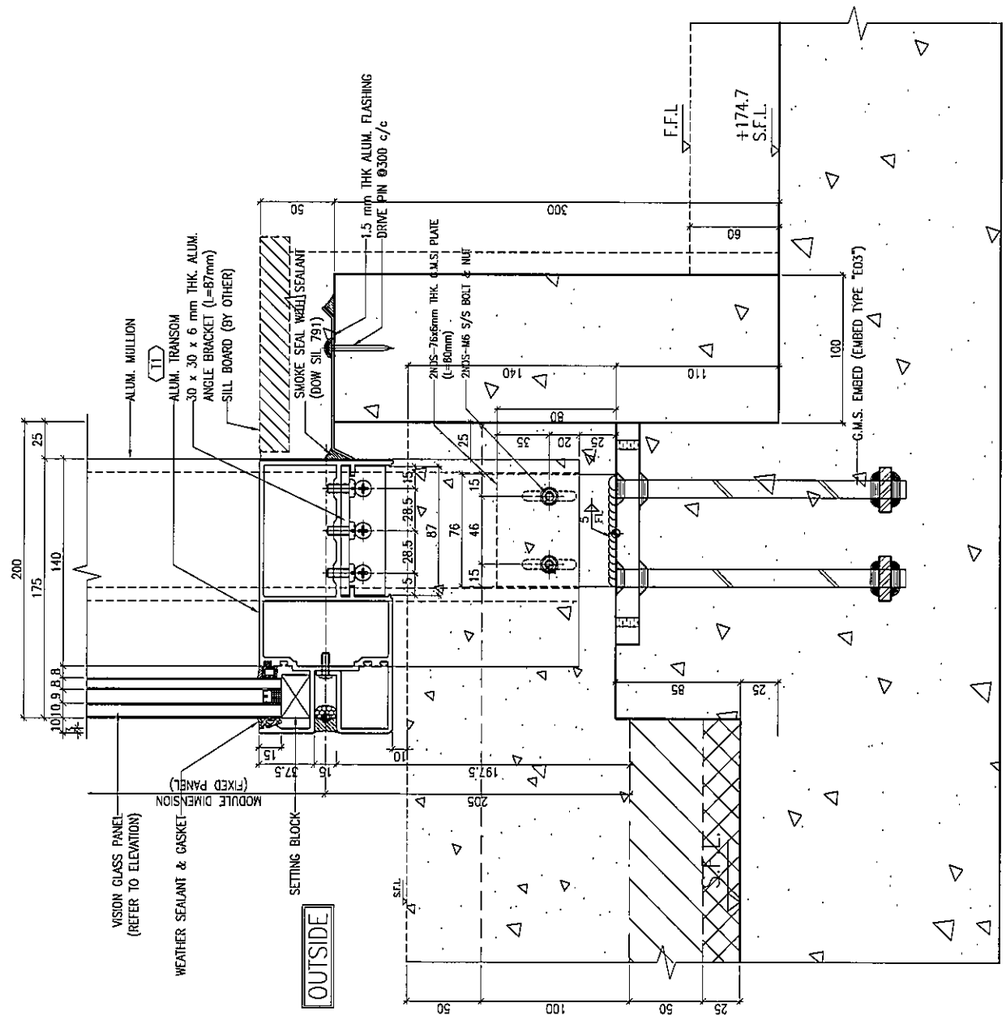

1 / 6018 TYPICAL TRANSOM DETAIL CURTAIN WALL

REFER TO J837-CW-2513

B.D. REF :

CLIENT :
信和置業有限公司
Sino Land Company Limited

ARCHITECT :
WONG TUNG & PARTNERS LIMITED
ARCHITECTS & PLANNERS

MAIN CONTRACTOR :
CR Construction Company Limited

STRUCTURAL ENGINEER :
AECOM

FACADE CONSULTANT:
AECOM

NOTE :
1. ALL DIMENSIONS ARE IN mm.
2. ALL ELEVATIONS ARE VIEWED FROM OUTSIDE.
3. ALL DIMENSIONS TO BE VERIFIED ON SITE BEFORE FABRICATION.

LEGEND :
- X1 / X001 — DETAIL MARK NO. / REFER SHEET NO.
1. F.F.L. --FINISHED FLOOR LEVEL
2. S.F.L. --STRUCTURAL FLOOR LEVEL
3. /R --REVERSED DETAIL

NO.	DATE	REVISED	BY
B	15/02/2019	GENERAL REVISED	
A	24/11/2018	GENERAL REVISED	

JOB NO. : J-837

PROJECT :
URA KWUN TONG TOWN CENTRE REDEVELOPMENT (AREA 2 & 3) AT NKIL 6514, KWUN TONG, KWLOON

TITLE :
TYPICAL TRANSOM DETAIL FOR CURTAIN WALL

DATE : 13-JUL-18 | SCALE : 1:2 (A1)

DRAWN BY : Asing | CHECKED BY : -

美特鋁質有限公司
MIDI ALUMINIUM FABRICATOR LTD.
Units 6-8, Sunray Industrial Centre, 1/F
610 Cha Kwo Ling Road, Kowloon
Tel:23489211-4 Fax:(852)27727666

DWG NO. : J837-CW-6018 | REV. : B

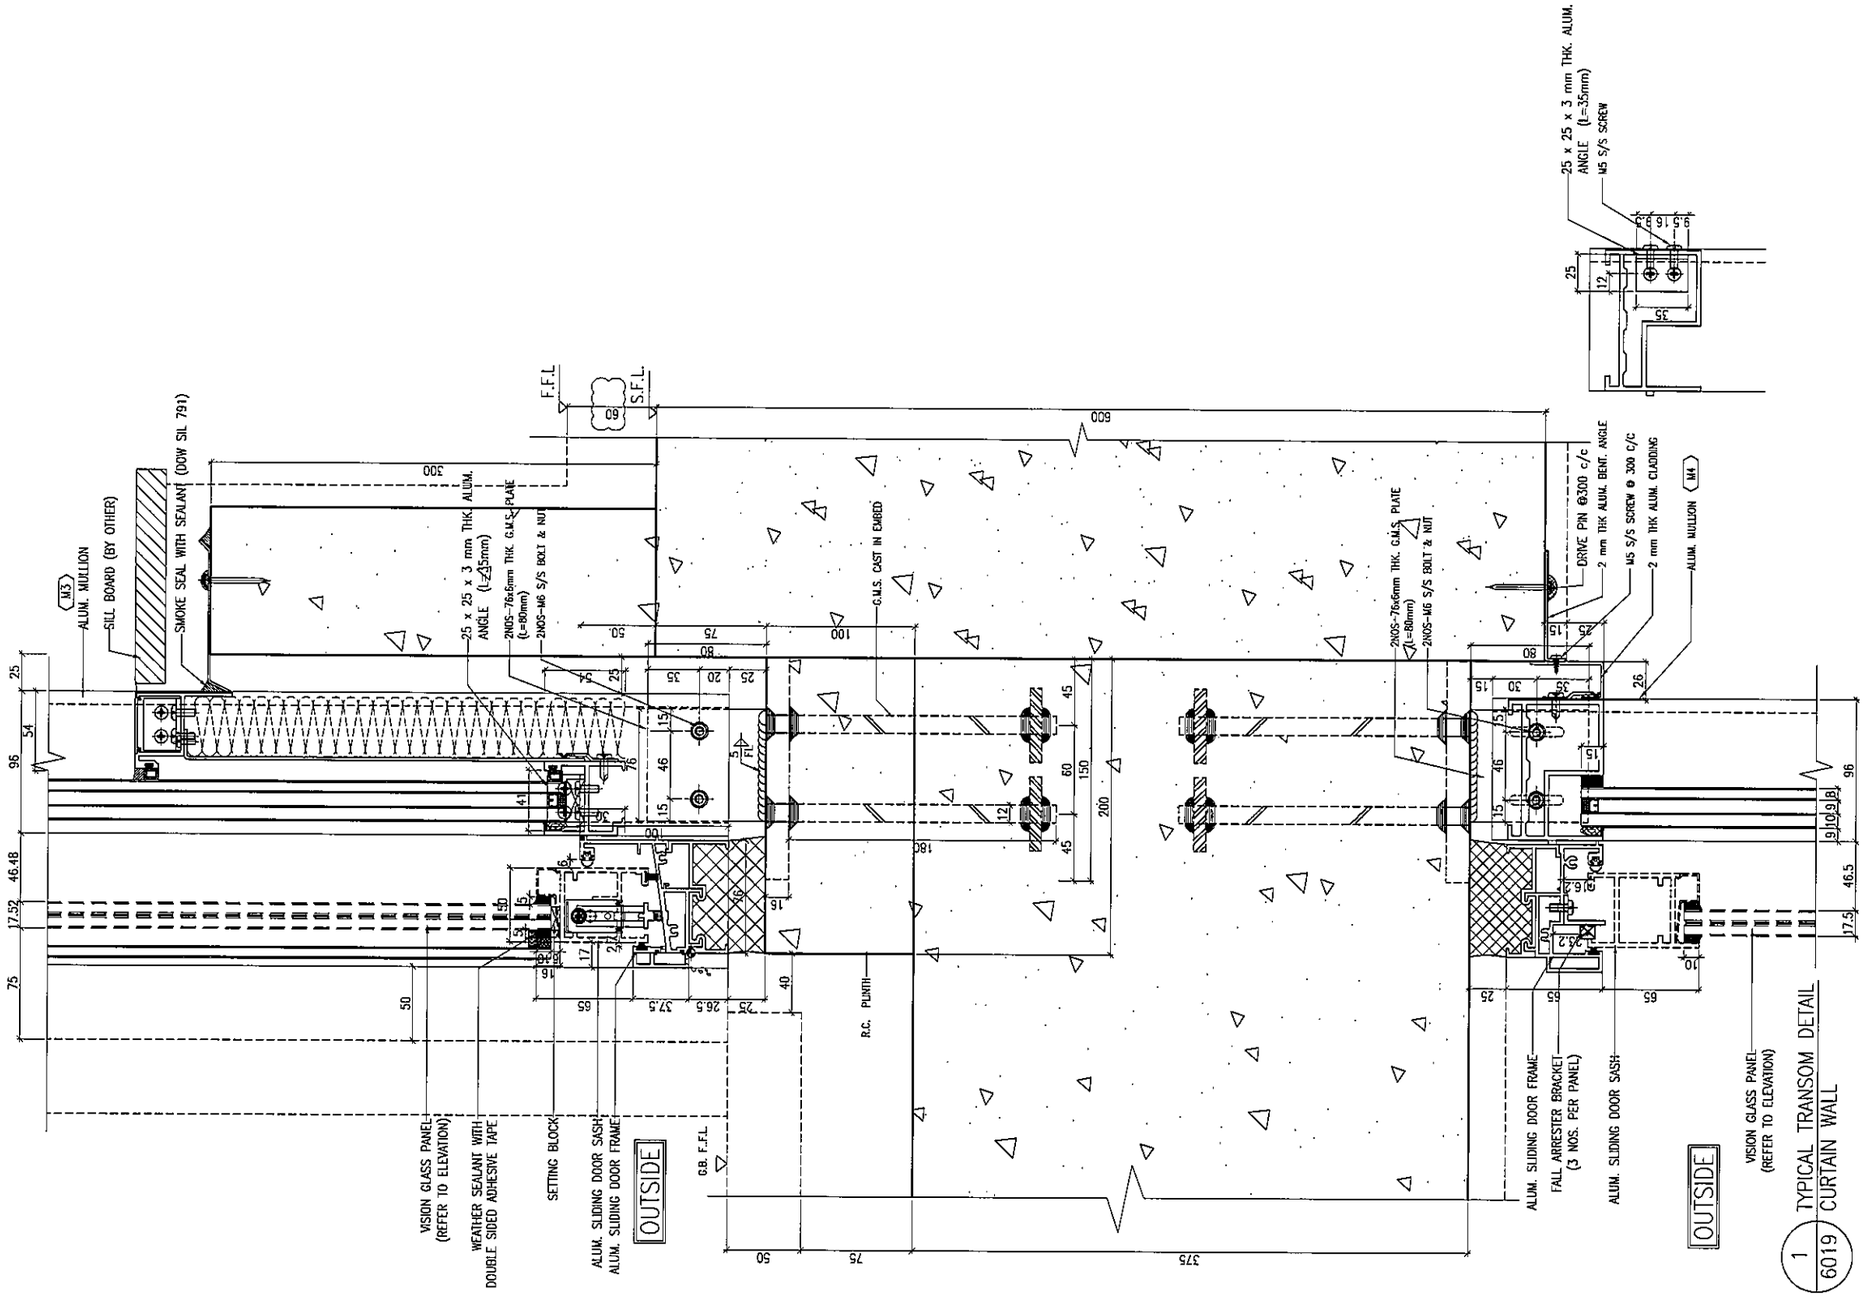

1 / 6019 TYPICAL TRANSOM DETAIL CURTAIN WALL

B.D. REF :

CLIENT :
信和置業有限公司
Sino Land Company Limited

ARCHITECT :
WONG TUNG & PARTNERS LIMITED
ARCHITECTS & PLANNERS

MAIN CONTRACTOR :
CR Construction Company Limited

STRUCTURAL ENGINEER :
AECOM

FACADE CONSULTANT:
AECOM

NOTE :
1. ALL DIMENSIONS ARE IN mm.
2. ALL ELEVATIONS ARE VIEWED FROM OUTSIDE.
3. ALL DIMENSIONS TO BE VERIFIED ON SITE BEFORE FABRICATION.

LEGEND :
X1 — DETAIL MARK NO.
X001 — REFER SHEET NO.

1. F.F.L. --FINISHED FLOOR LEVEL
2. S.F.L. --STRUCTURAL FLOOR LEVEL
3. /R --REVERSED DETAIL

NO.	DATE	REVISED	BY
B	15/02/2019	GENERAL REVISED	
A	04/12/2018	GENERAL REVISED	

JOB NO. : J-837

PROJECT :
URA KWUN TONG TOWN CENTRE REDEVELOPMENT (AREA 2 & 3) AT NKIL 6514, KWUN TONG, KWLOON

TITLE :
TYPICAL TRANSOM DETAIL FOR CURTAIN WALL

DATE : 24-NOV-18 | SCALE : 1:2 (A1)

DRAWN BY : Asing | CHECKED BY : -

美特鋁質有限公司
MIDI ALUMINIUM FABRICATOR LTD.
Units 6-8, Sunray Industrial Centre, 1/F
610 Cha Kwo Ling Road, Kowloon
Tel:23489211-4 Fax:(852)27727666

DWG NO. : J837-CW-6019 | REV. : B

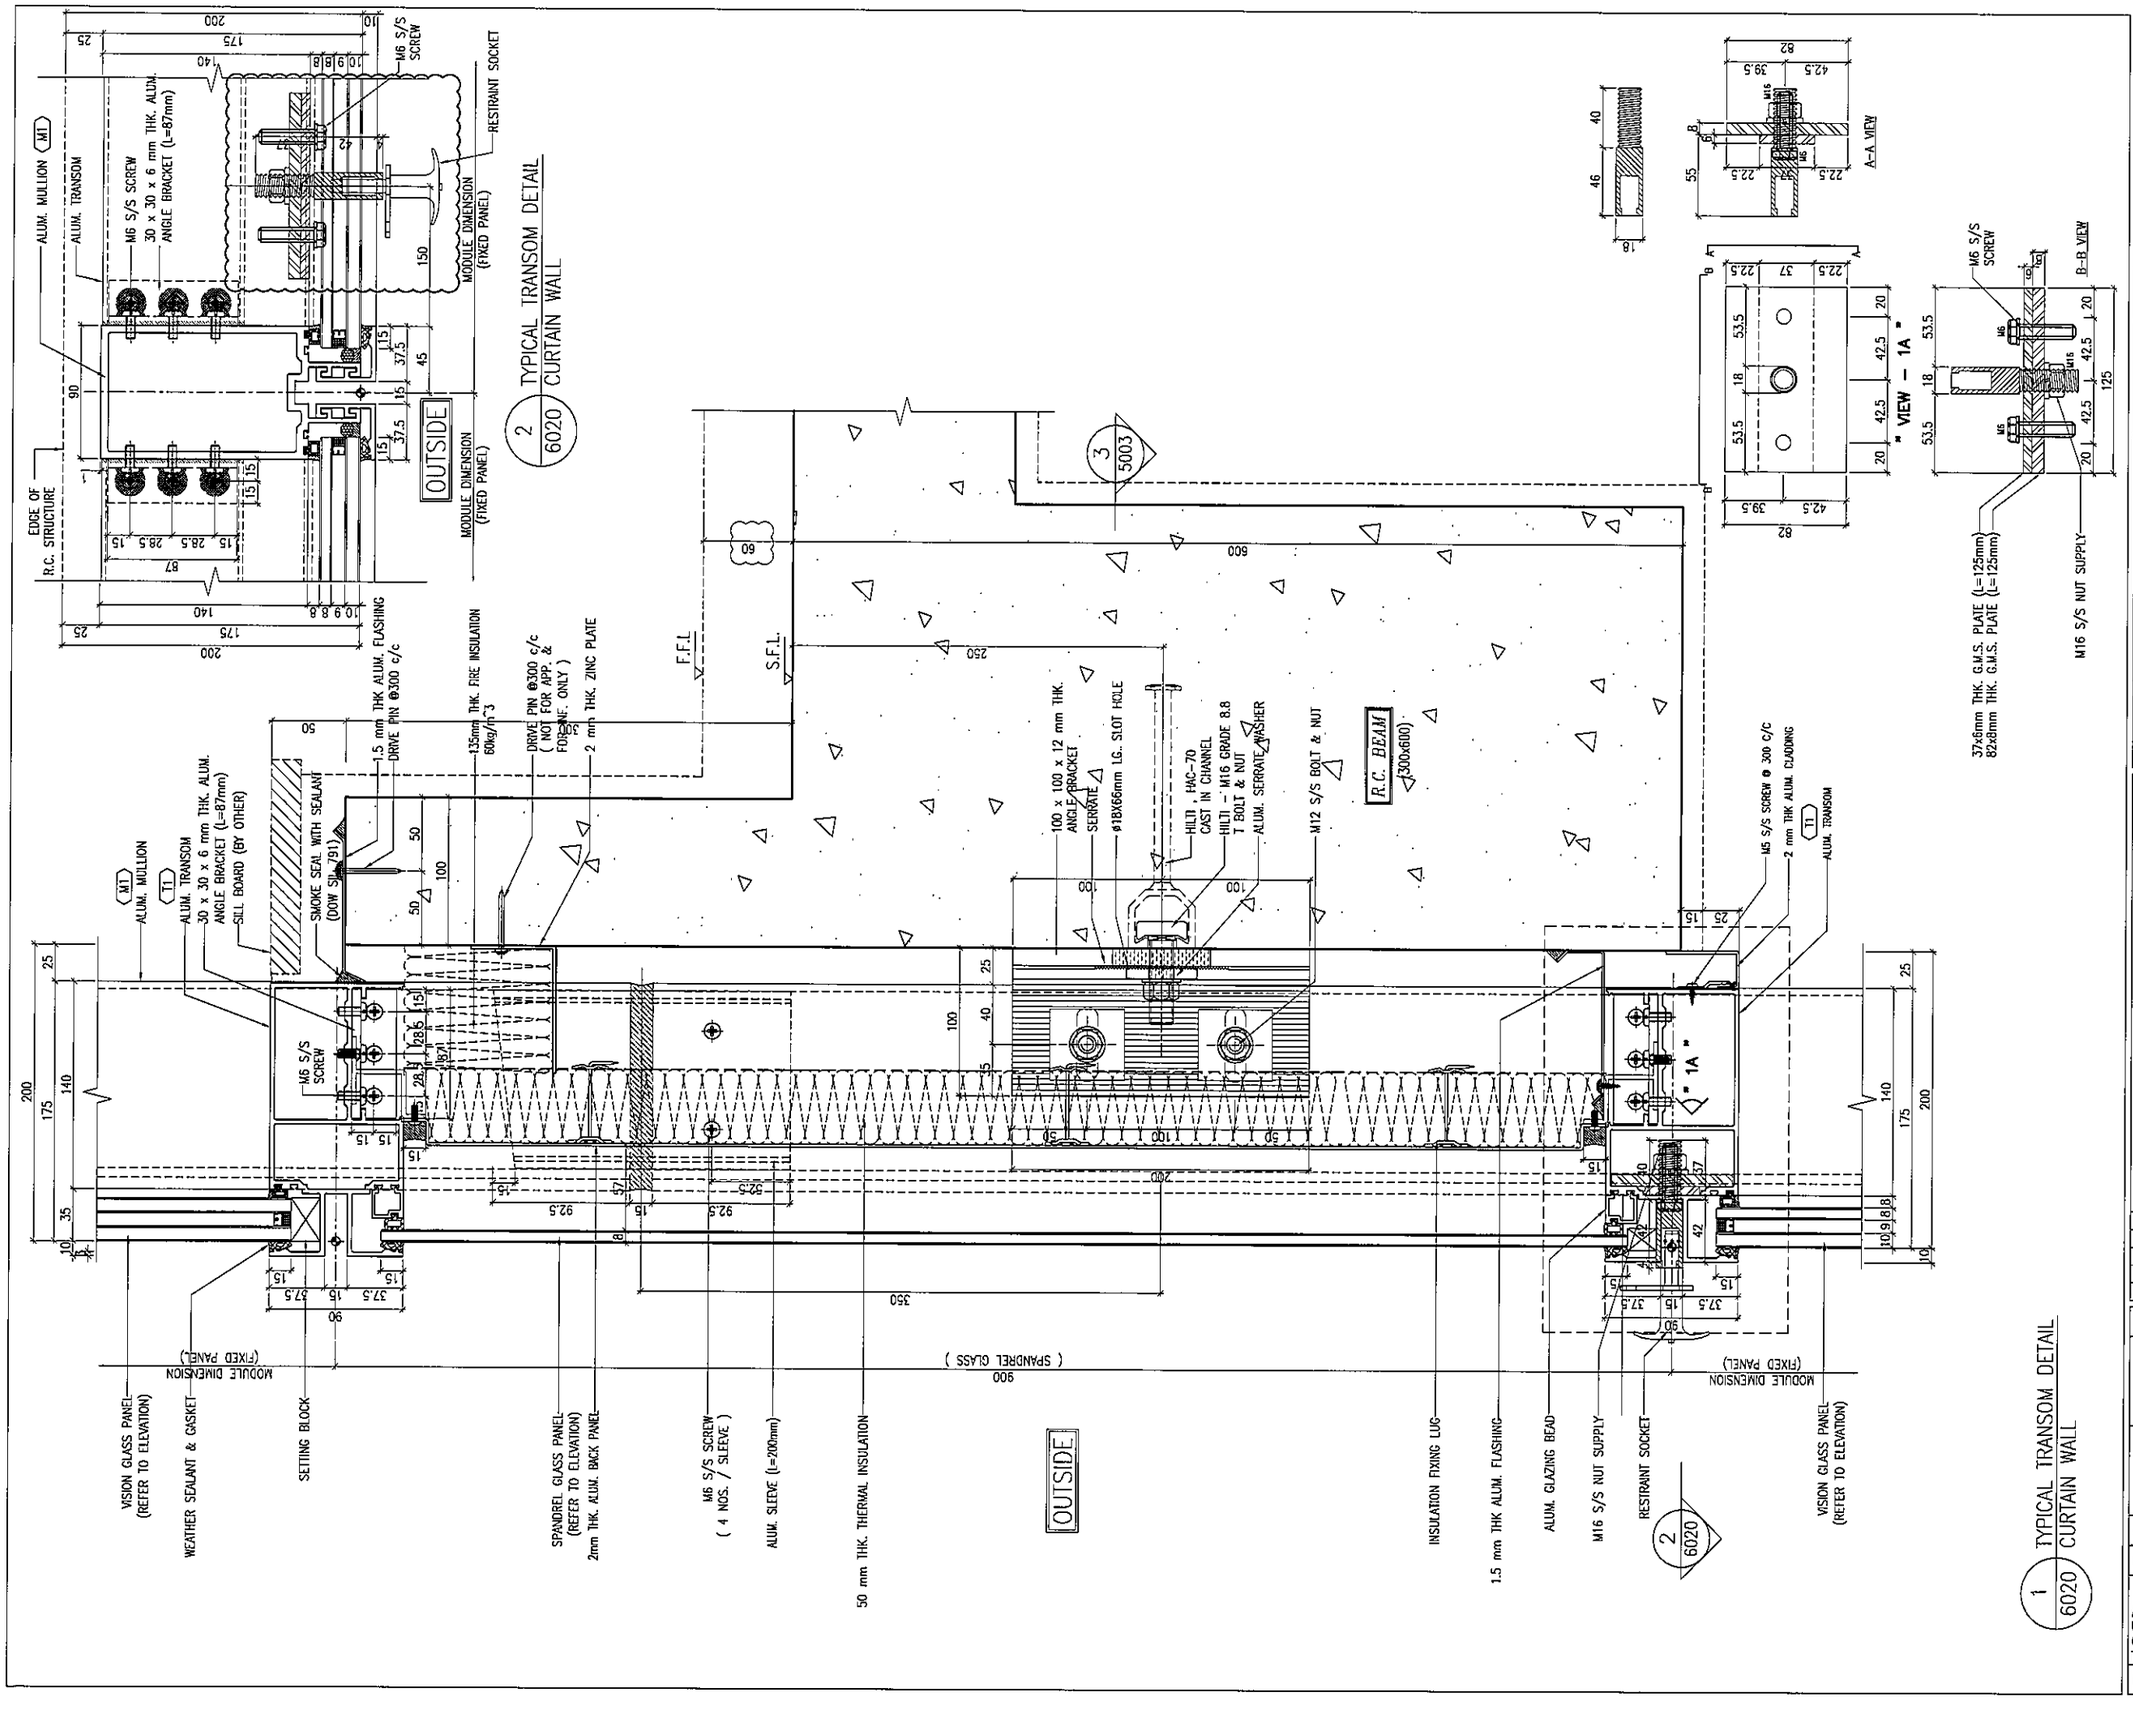

B.D. REF :

CLIENT :
信和置業有限公司
Sino Land Company Limited

ARCHITECT :
WONG TUNG & PARTNERS LIMITED
ARCHITECTS & PLANNERS

MAIN CONTRACTOR :
CR Construction Company Limited

STRUCTURAL ENGINEER :
AECOM

FACADE CONSULTANT:
AECOM

NOTE :
1. ALL DIMENSIONS ARE IN mm.
2. ALL ELEVATIONS ARE VIEWED FROM OUTSIDE.
3. ALL DIMENSIONS TO BE VERIFIED ON SITE BEFORE FABRICATION.

LEGEND :
X1 / X001 — DETAIL MARK NO. / REFER SHEET NO.
1. F.F.L. --FINISHED FLOOR LEVEL
2. S.F.L. --STRUCTURAL FLOOR LEVEL
3. /R --REVERSED DETAIL

NO.	DATE	REVISED	BY
D	15/02/2019	GENERAL REVISED	
C	04/01/2019	GENERAL REVISED	
B	22/12/2018	GENERAL REVISED	
A	04/12/2018	GENERAL REVISED	

JOB NO. : J-837

PROJECT :
URA KWUN TONG TOWN CENTRE REDEVELOPMENT (AREA 2 & 3) AT NKIL 6514, KWUN TONG, KWLOON

TITLE :
TYPICAL TRANSOM DETAIL FOR CURTAIN WALL

DATE : 24-NOV-18 | SCALE : 1:2 (A1)

DRAWN BY : ASING | CHECKED BY : -

美特鋁質有限公司
MIDI ALUMINIUM FABRICATOR LTD.
Units 6-8, Sunray Industrial Centre, 1/F
610 Cha Kwo Ling Road, Kowloon
Tel:23489211-4 Fax:(852)27727866

DWG NO. : J837-CW-6020 | REV. : D

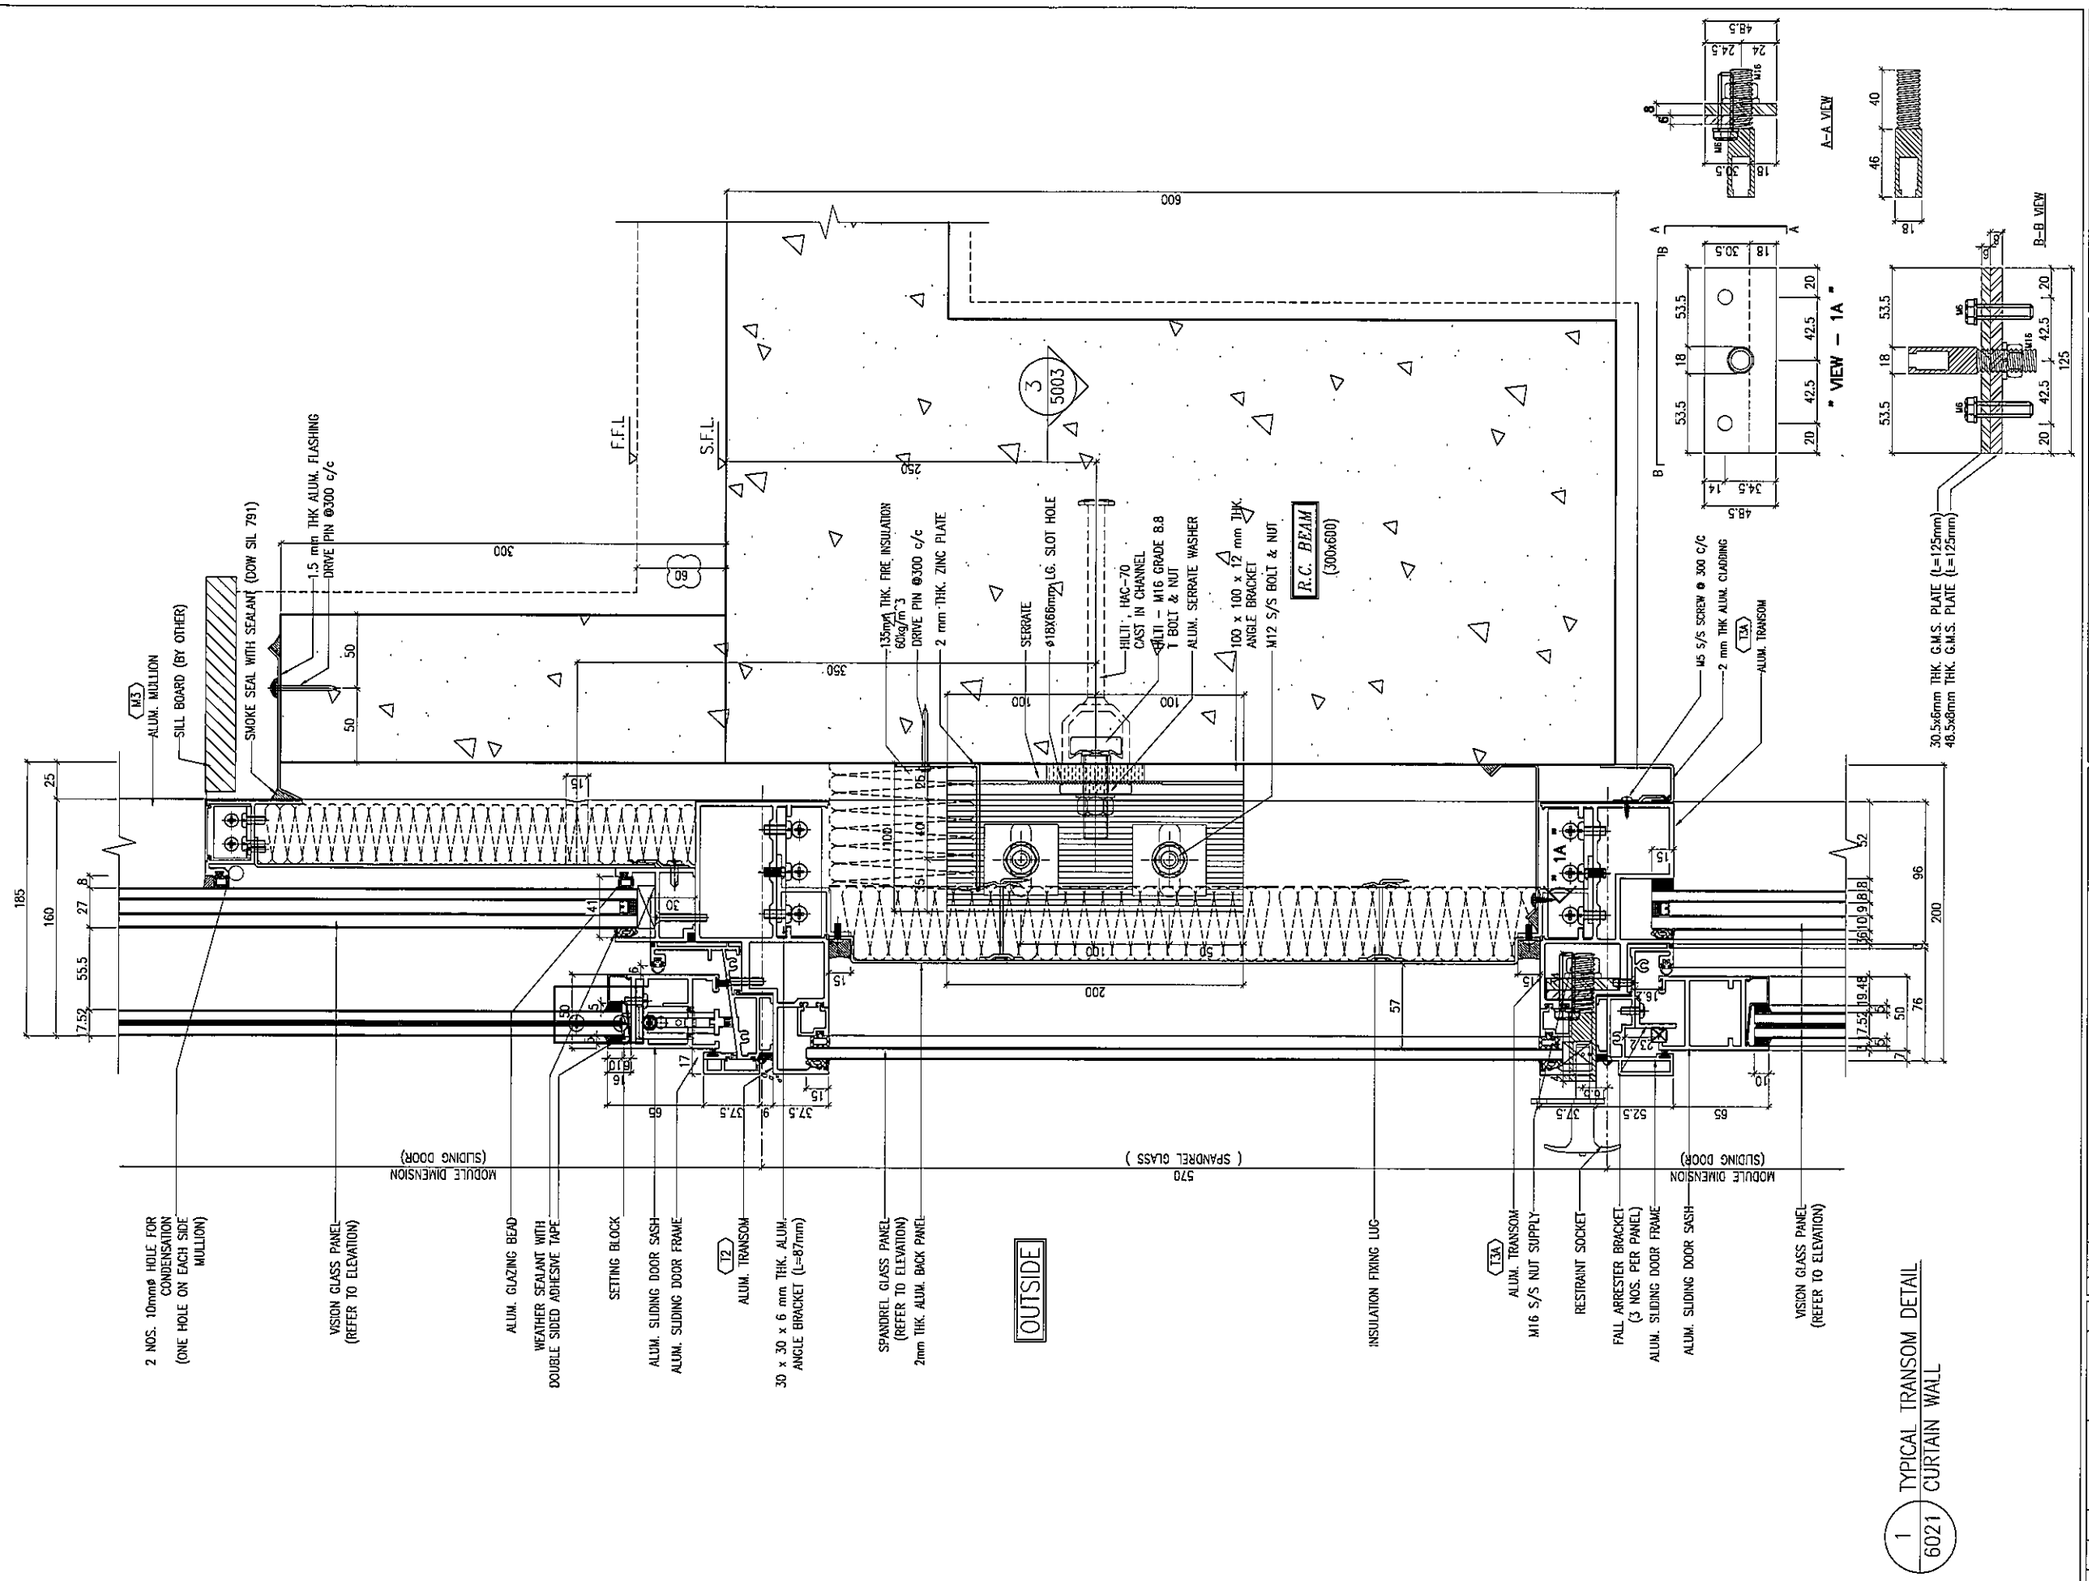

1 / 6021 TYPICAL TRANSOM DETAIL CURTAIN WALL

B.D. REF :

CLIENT :
信和置業有限公司
Sino Land Company Limited

ARCHITECT :
WONG TUNG & PARTNERS LIMITED
ARCHITECTS & PLANNERS

MAIN CONTRACTOR :
CR Construction Company Limited

STRUCTURAL ENGINEER :
AECOM

FACADE CONSULTANT:
AECOM

NOTE :
1. ALL DIMENSIONS ARE IN mm.
2. ALL ELEVATIONS ARE VIEWED FROM OUTSIDE.
3. ALL DIMENSIONS TO BE VERIFIED ON SITE BEFORE FABRICATION.

LEGEND :
X1 — DETAIL MARK NO.
X001 — REFER SHEET NO.

1. F.F.L. --FINISHED FLOOR LEVEL
2. S.F.L. --STRUCTURAL FLOOR LEVEL
3. /R --REVERSED DETAIL

NO.	DATE	REVISED	BY
C	15/02/2019	GENERAL REVISED	
B	04/01/2019	GENERAL REVISED	
A	22/12/2018	GENERAL REVISED	

JOB NO. : J-837

PROJECT :
URA KWUN TONG TOWN CENTRE REDEVELOPMENT (AREA 2 & 3) AT NKIL 6514, KWUN TONG, KWLOON

TITLE :
TYPICAL TRANSOM DETAIL FOR CURTAIN WALL

DATE : 22-DEC-18 | SCALE : 1:2 (A1)

DRAWN BY : ASING | CHECKED BY : -

美特鋁質有限公司
MIDI ALUMINIUM FABRICATOR LTD.
Units 6-8, Sunray Industrial Centre, 1/F
610 Cha Kwo Ling Road, Kowloon
Tel:23489211-4 Fax:(852)27727656

DWG NO. : J837-CW-6021 | REV. : C

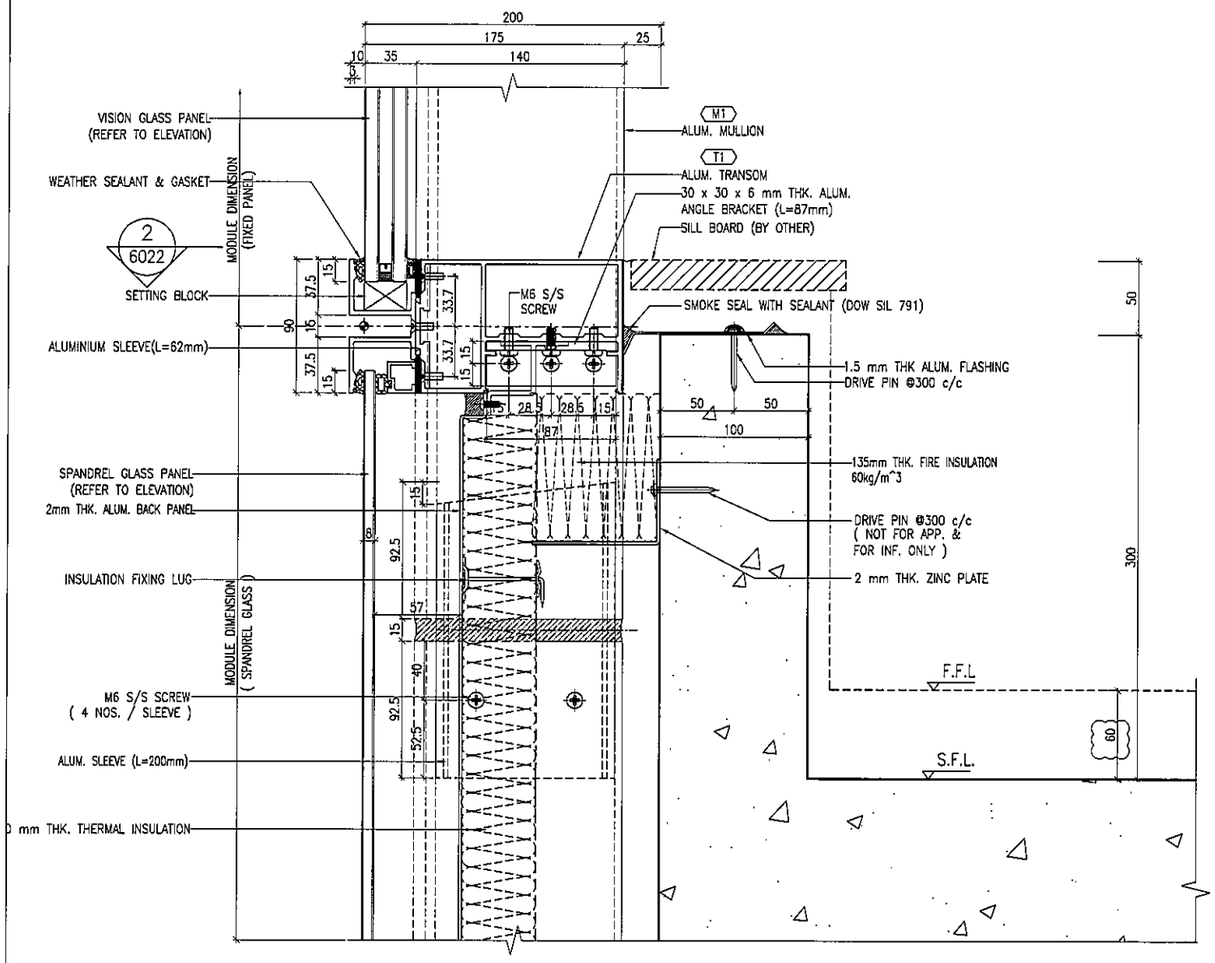

1 / 6022 TYPICAL TRANSOM DETAIL
CURTAIN WALL

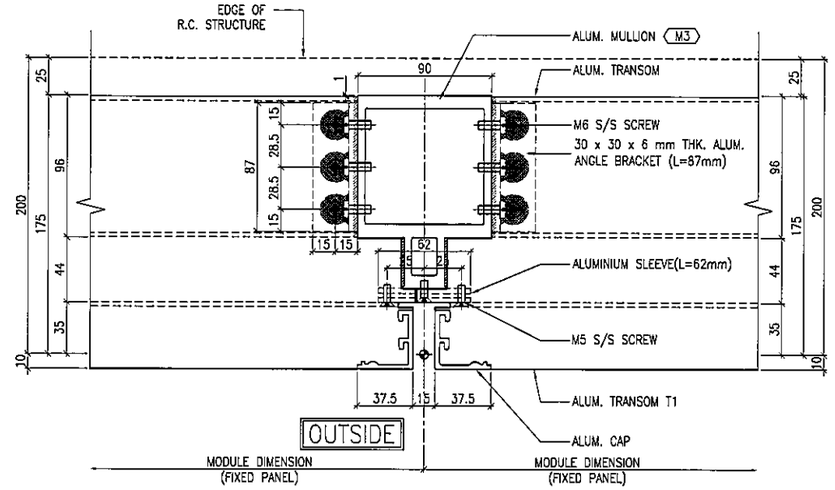

2 / 6022 TYPICAL MULLION DETAIL
CURTAIN WALL

B.D. REF :

CLIENT :
信和置業有限公司
Sino Land Company Limited

ARCHITECT :
WONG TUNG & PARTNERS LIMITED
ARCHITECTS & PLANNERS

MAIN CONTRACTOR :
CR Construction Company Limited

STRUCTURAL ENGINEER :
AECOM

FACADE CONSULTANT:
AECOM

NOTE :
1. ALL DIMENSIONS ARE IN mm.
2. ALL ELEVATIONS ARE VIEWED FROM OUTSIDE.
3. ALL DIMENSIONS TO BE VERIFIED ON SITE BEFORE FABRICATION.

LEGEND :
X1 / X001 — DETAIL MARK NO. / REFER SHEET NO.
1. F.F.L. --FINISHED FLOOR LEVEL
2. S.F.L. --STRUCTURAL FLOOR LEVEL
3. (R) --REVERSED DETAIL

NO.	DATE	REVISED	BY
A	15/02/2019	GENERAL REVISED	

JOB NO. : J-837

PROJECT :
URA KWUN TONG TOWN CENTRE
REDEVELOPMENT (AREA 2 & 3) AT
NKIL 6514, KWUN TONG, KWLOON

TITLE :
TYPICAL TRANSOM DETAIL
FOR CURTAIN WALL

DATE : 22-DEC-18 | SCALE : 1:2 (A1)

DRAWN BY : ASING | CHECKED BY : -

美特鋁質有限公司
MIDI ALUMINIUM FABRICATOR LTD.
Units 6-8, Sunray Industrial Centre, 1/F
610 Cha Kwo Ling Road, Kowloon
Tel:23489211-4 Fax:(852)27727666

DWG NO. : J837-CW-6022 | REV. : A

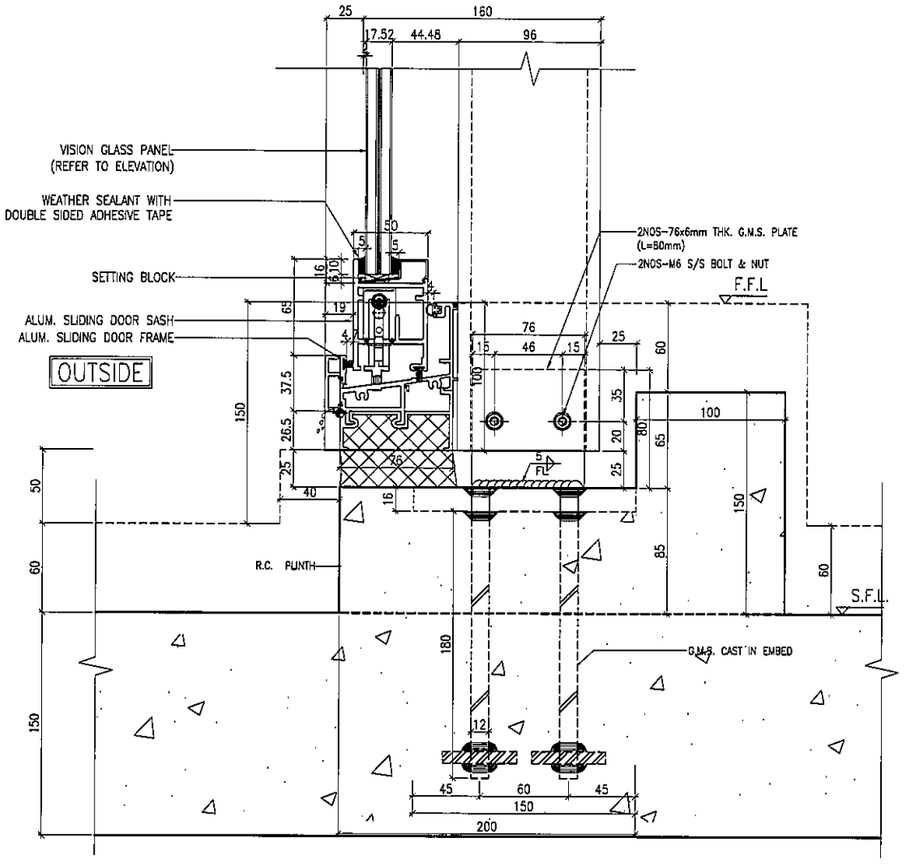

1 / 6023 TYPICAL TRANSOM DETAIL CURTAIN WALL

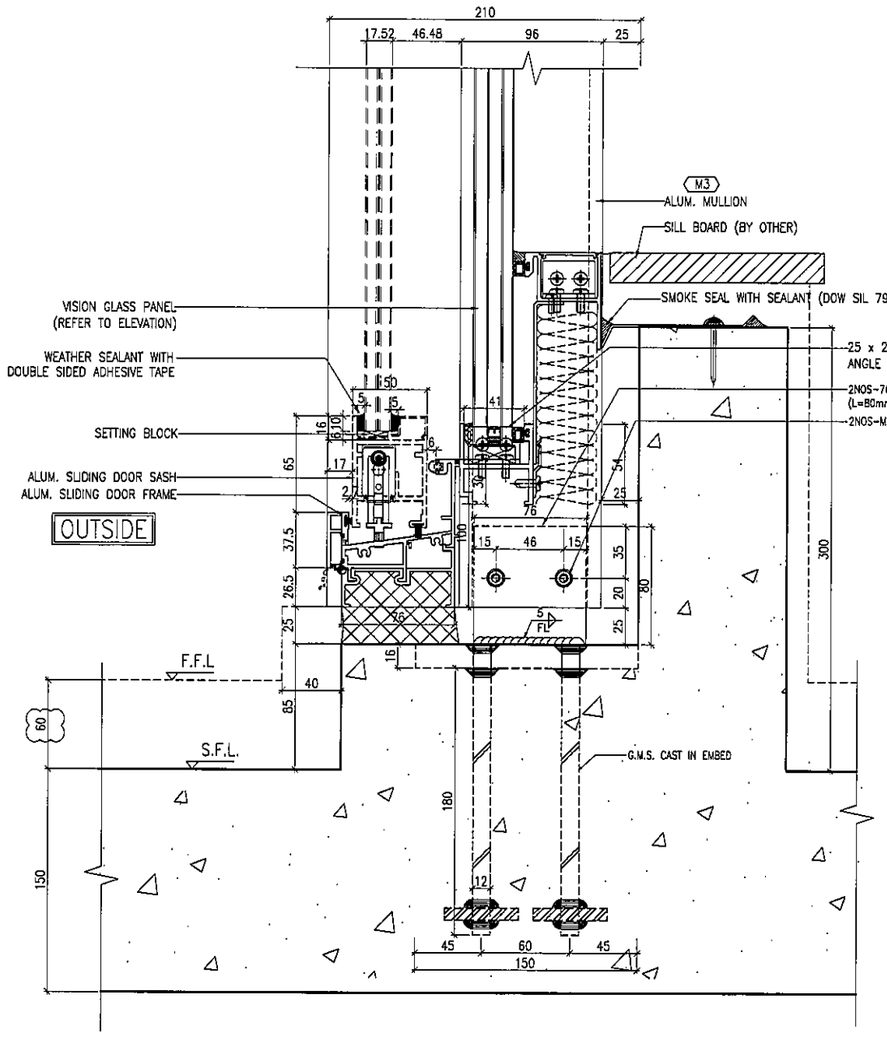

2 / 6023 TYPICAL TRANSOM DETAIL CURTAIN WALL

B.D. REF :

CLIENT :
信和置業有限公司
Sino Land Company Limited

ARCHITECT :
WONG TUNG & PARTNERS LIMITED
ARCHITECTS & PLANNERS

MAIN CONTRACTOR :
CR Construction Company Limited

STRUCTURAL ENGINEER :
AECOM

FACADE CONSULTANT:
AECOM

NOTE :
1. ALL DIMENSIONS ARE IN mm.
2. ALL ELEVATIONS ARE VIEWED FROM OUTSIDE.
3. ALL DIMENSIONS TO BE VERIFIED ON SITE BEFORE FABRICATION.

LEGEND :
X1 / X001 — DETAIL MARK NO. / REFER SHEET NO.
1. F.F.L. --FINISHED FLOOR LEVEL
2. S.F.L. --STRUCTURAL FLOOR LEVEL
3. /R --REVERSED DETAIL

NO.	DATE	REVISED	BY
A	15/02/2019	GENERAL REVISED	

JOB NO. : J-837

PROJECT :
URA KWUN TONG TOWN CENTRE
REDEVELOPMENT (AREA 2 & 3) AT
NKIL 6514, KWUN TONG, KWLOON

TITLE :
TYPICAL TRANSOM DETAIL
FOR CURTAIN WALL

DATE : 22-DEC-18 | SCALE : 1:2 (A1)

DRAWN BY : ASING | CHECKED BY : -

美特鋁質有限公司
MIDI ALUMINIUM FABRICATOR LTD.
Units 6-8, Sunray Industrial Centre, 1/F
610 Cha Kwo Ling Road, Kowloon
Tel:23489211-4 Fax:(852)27727666

DWG NO. : J837-CW-6023 | REV. : A

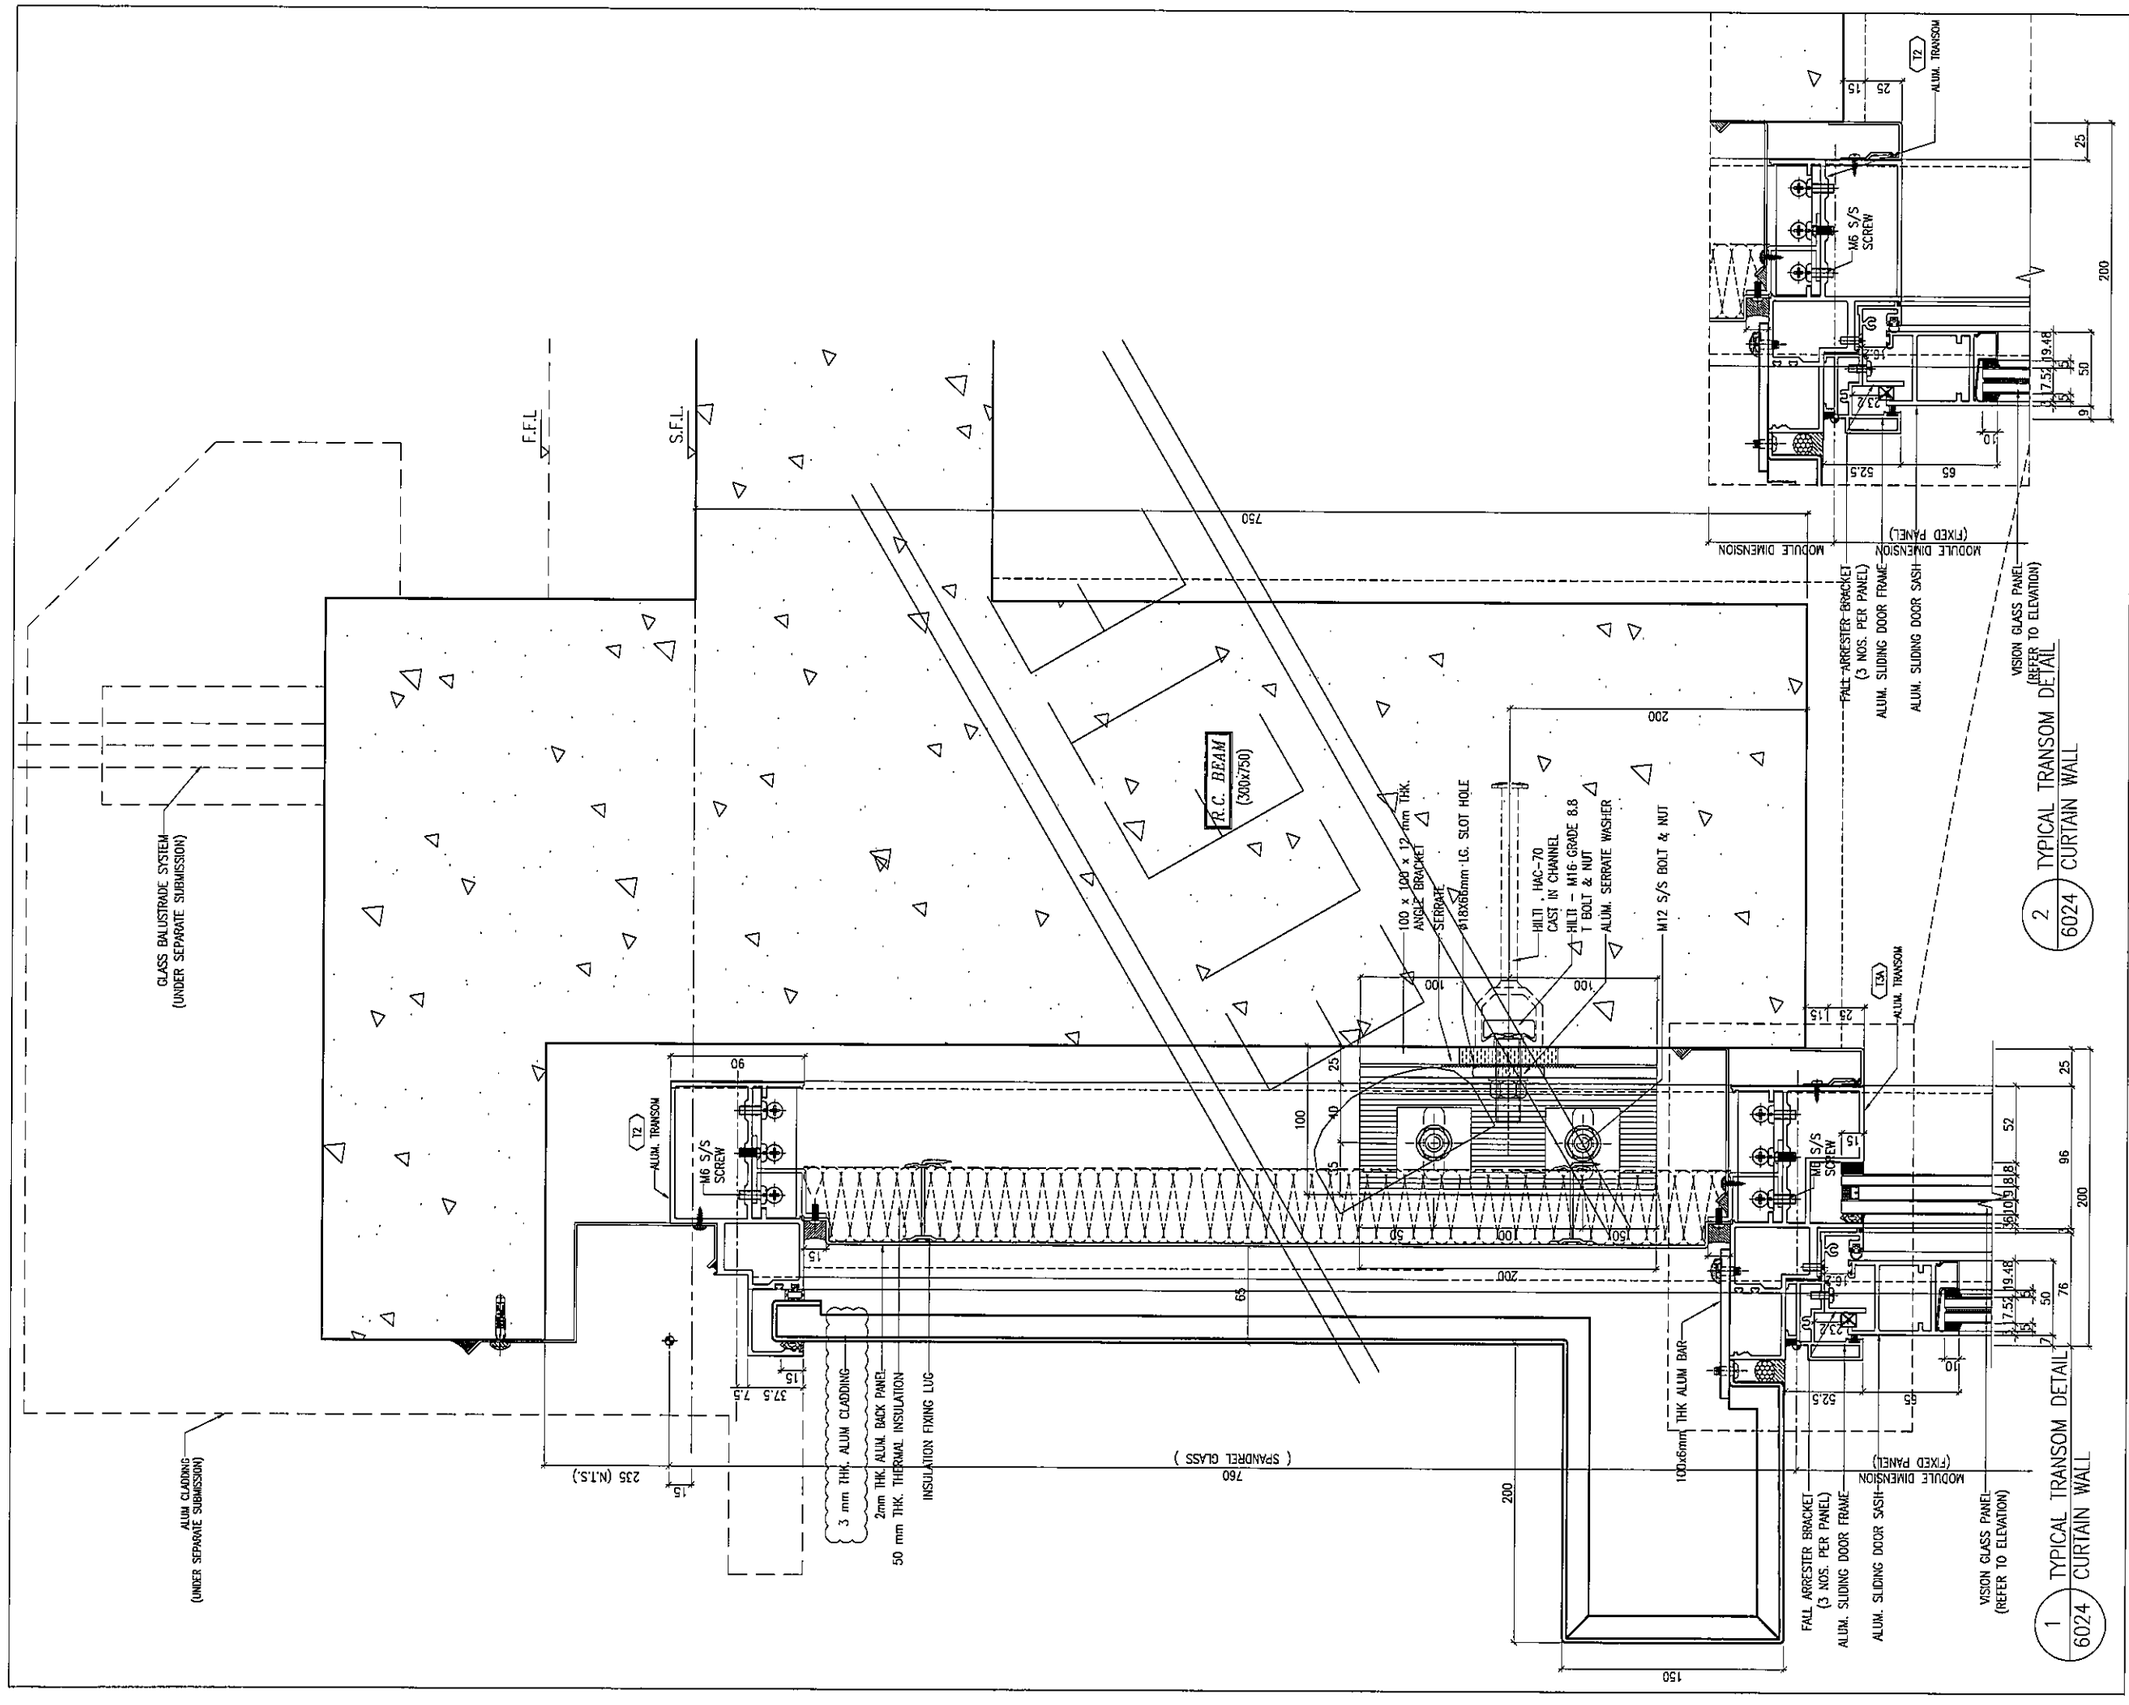

B.D. REF :

CLIENT :
信和置業有限公司
Sino Land Company Limited

ARCHITECT :
WONG TUNG & PARTNERS LIMITED
ARCHITECTS & PLANNERS

MAIN CONTRACTOR :
CR Construction Company Limited

STRUCTURAL ENGINEER :
AECOM

FACADE CONSULTANT:
AECOM

NOTE :
1. ALL DIMENSIONS ARE IN mm.
2. ALL ELEVATIONS ARE VIEWED FROM OUTSIDE.
3. ALL DIMENSIONS TO BE VERIFIED ON SITE BEFORE FABRICATION.

LEGEND :
X1 — DETAIL MARK NO.
X001 — REFER SHEET NO.

1. F.F.L. --FINISHED FLOOR LEVEL
2. S.F.L. --STRUCTURAL FLOOR LEVEL
3. /R --REVERSED DETAIL

NO.	DATE	REVISED	BY
A	16/06/2019	GENERAL REVISED	

JOB NO. : J-837

PROJECT :
URA KWUN TONG TOWN CENTRE REDEVELOPMENT (AREA 2 & 3) AT NKIL 6514, KWUN TONG, KWLOON

TITLE :
TYPICAL TRANSOM DETAIL FOR CURTAIN WALL

DATE : 22-DEC-18 | SCALE : 1:2 (A1)

DRAWN BY : ASING | CHECKED BY : -

美特鋁質有限公司
MIDI ALUMINIUM FABRICATOR LTD.
Units 6-8, Sunray Industrial Centre, 1/F
610 Cha Kwo Ling Road, Kowloon
Tel:23489211-4 Fax:(852)27727666

DWG NO. : J837-CW-6024 | REV. : A

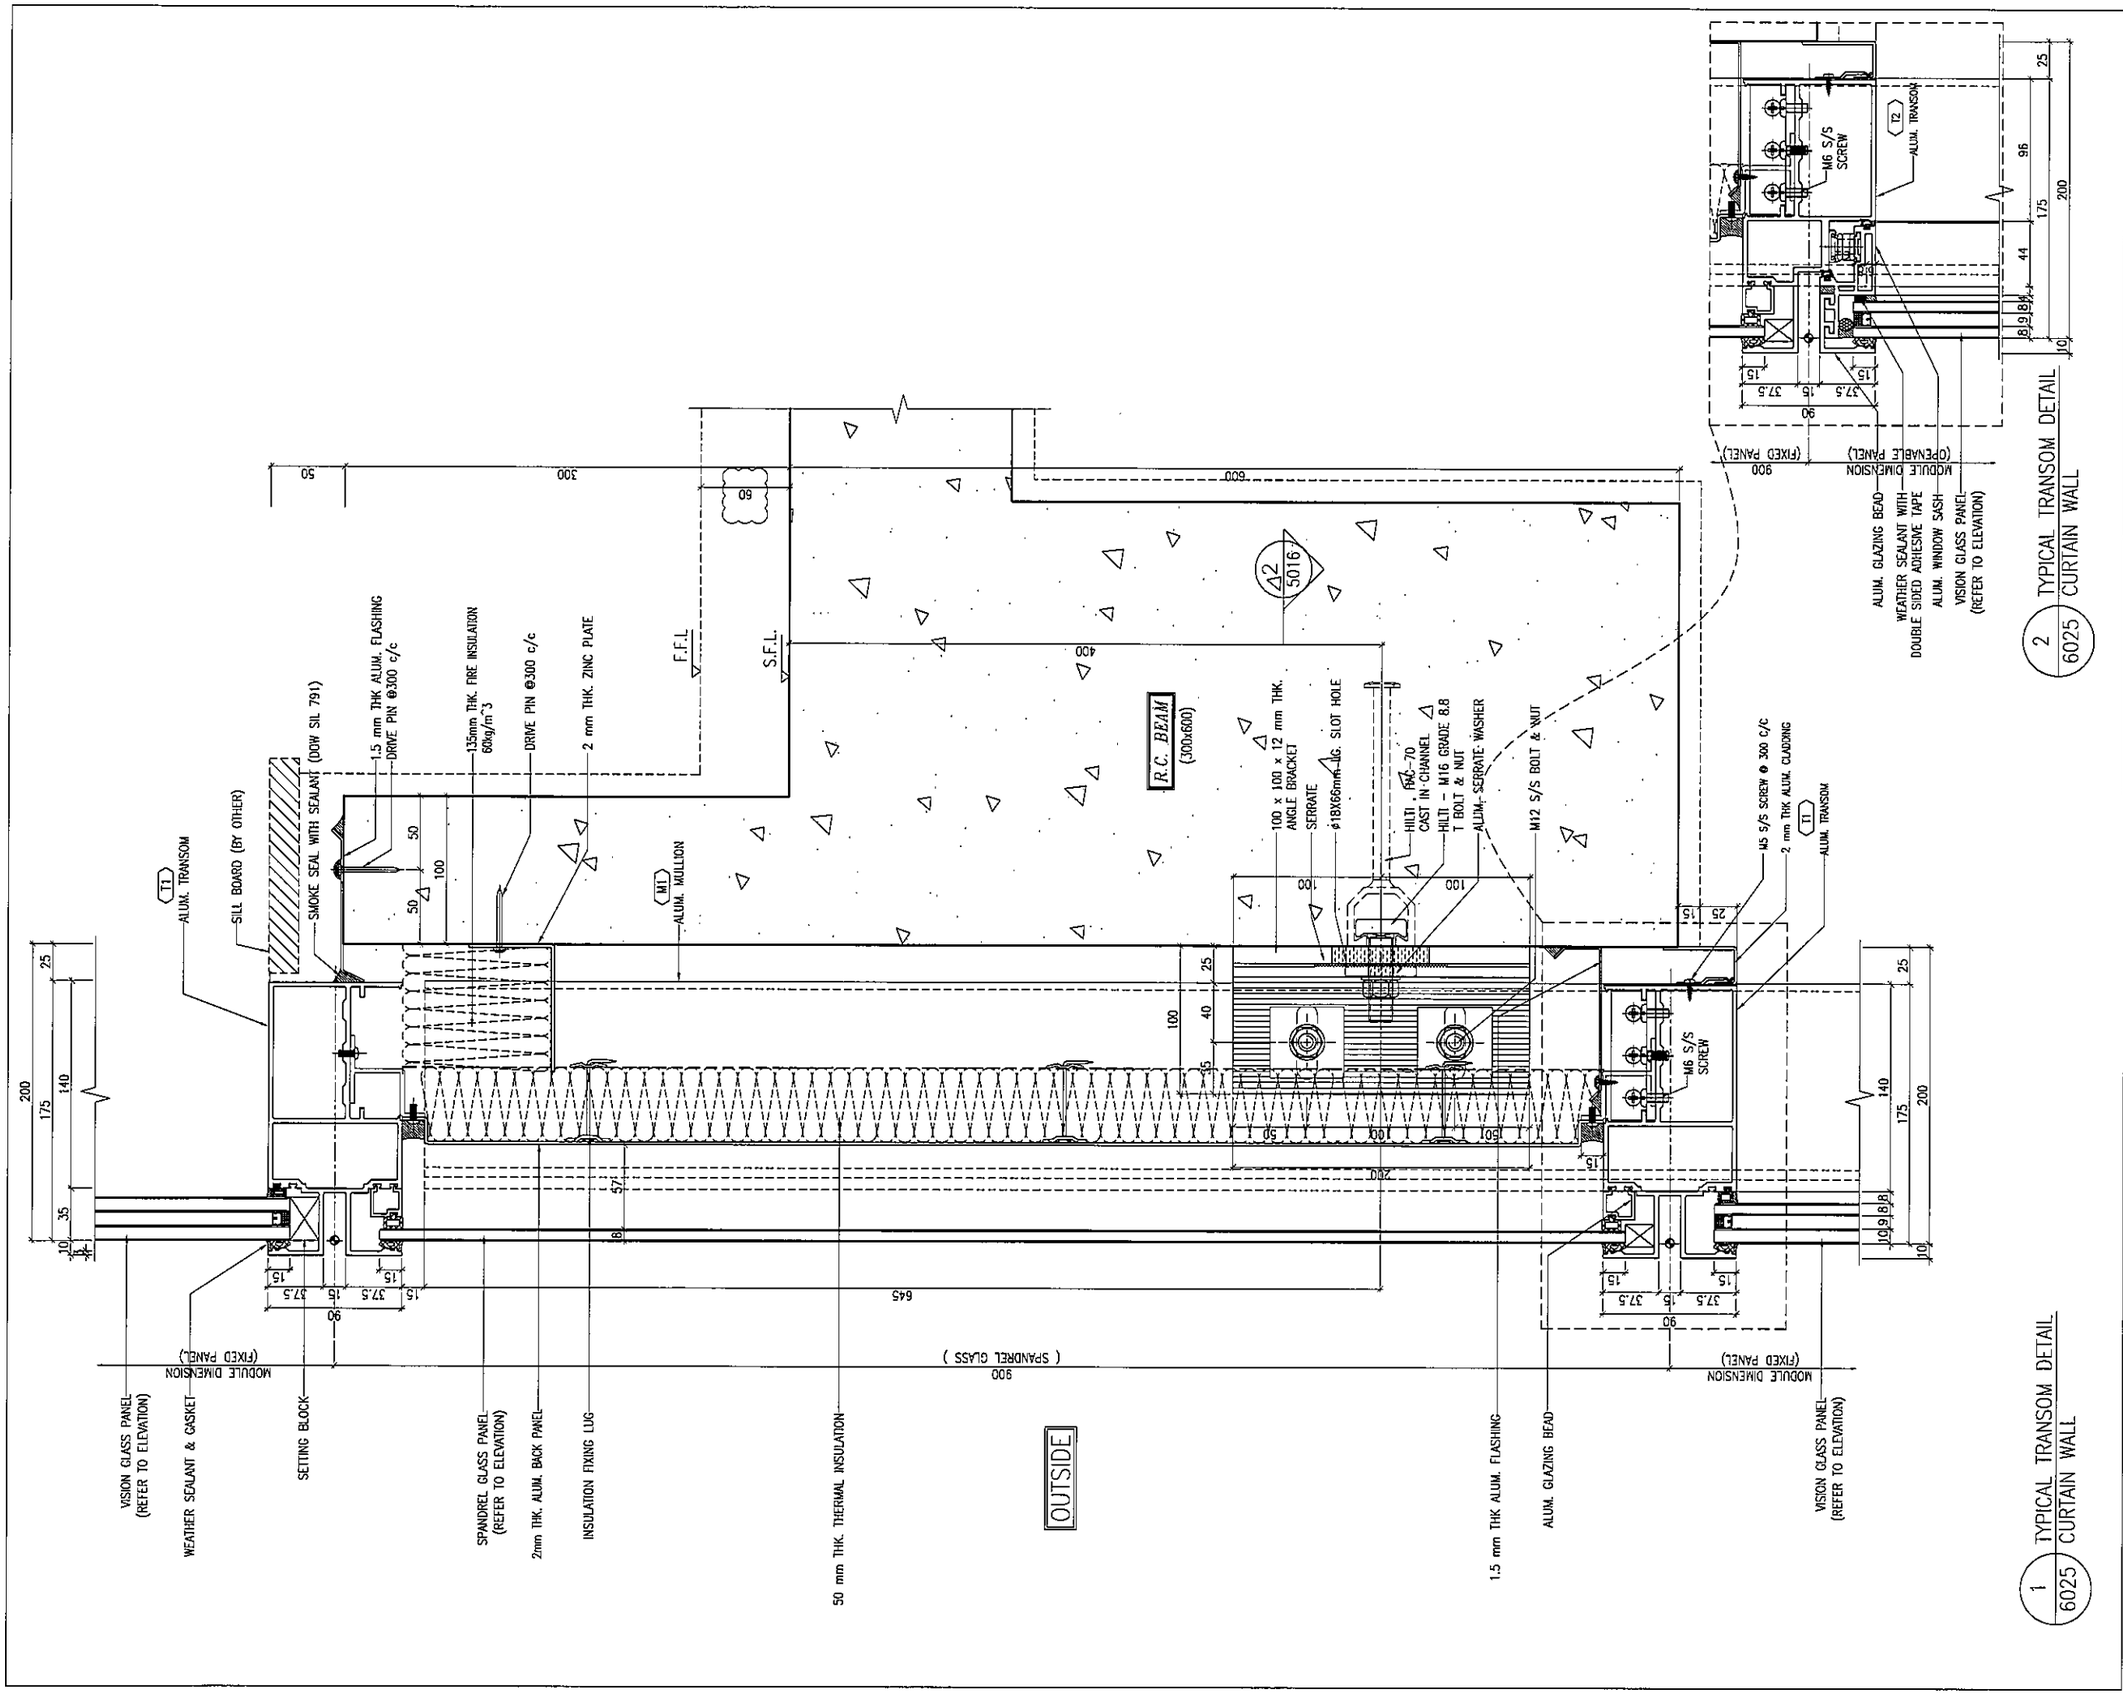

B.D. REF :

CLIENT :
信和置業有限公司
Sino Land Company Limited

ARCHITECT :
WONG TUNG & PARTNERS LIMITED
ARCHITECTS & PLANNERS

MAIN CONTRACTOR :
CR Construction Company Limited

STRUCTURAL ENGINEER :
AECOM

FACADE CONSULTANT:
AECOM

NOTE :
1. ALL DIMENSIONS ARE IN mm.
2. ALL ELEVATIONS ARE VIEWED FROM OUTSIDE.
3. ALL DIMENSIONS TO BE VERIFIED ON SITE BEFORE FABRICATION.

LEGEND :
X1 — DETAIL MARK NO.
X001 — REFER SHEET NO.

1. F.F.L. --FINISHED FLOOR LEVEL
2. S.F.L. --STRUCTURAL FLOOR LEVEL
3. /R --REVERSED DETAIL

NO.	DATE	REVISED	BY
A	15/02/2019	GENERAL REVISED	

JOB NO. : J-837

PROJECT :
URA KWUN TONG TOWN CENTRE REDEVELOPMENT (AREA 2 & 3) AT NKIL 6514, KWUN TONG, KWLOON

TITLE :
TYPICAL TRANSOM DETAIL FOR CURTAIN WALL

DATE : 28-JAN-19 | SCALE : 1:2 (A1)

DRAWN BY : ASING | CHECKED BY : --

美特鋁質有限公司
MIDI ALUMINIUM FABRICATOR LTD.
Units 6-8, Sunray Industrial Centre, 1/F
610 Cha Kwo Ling Road, Kowloon
Tel:23489211-4 Fax:(852)27727666

DWG NO. : J837-CW-6025 | REV. : A

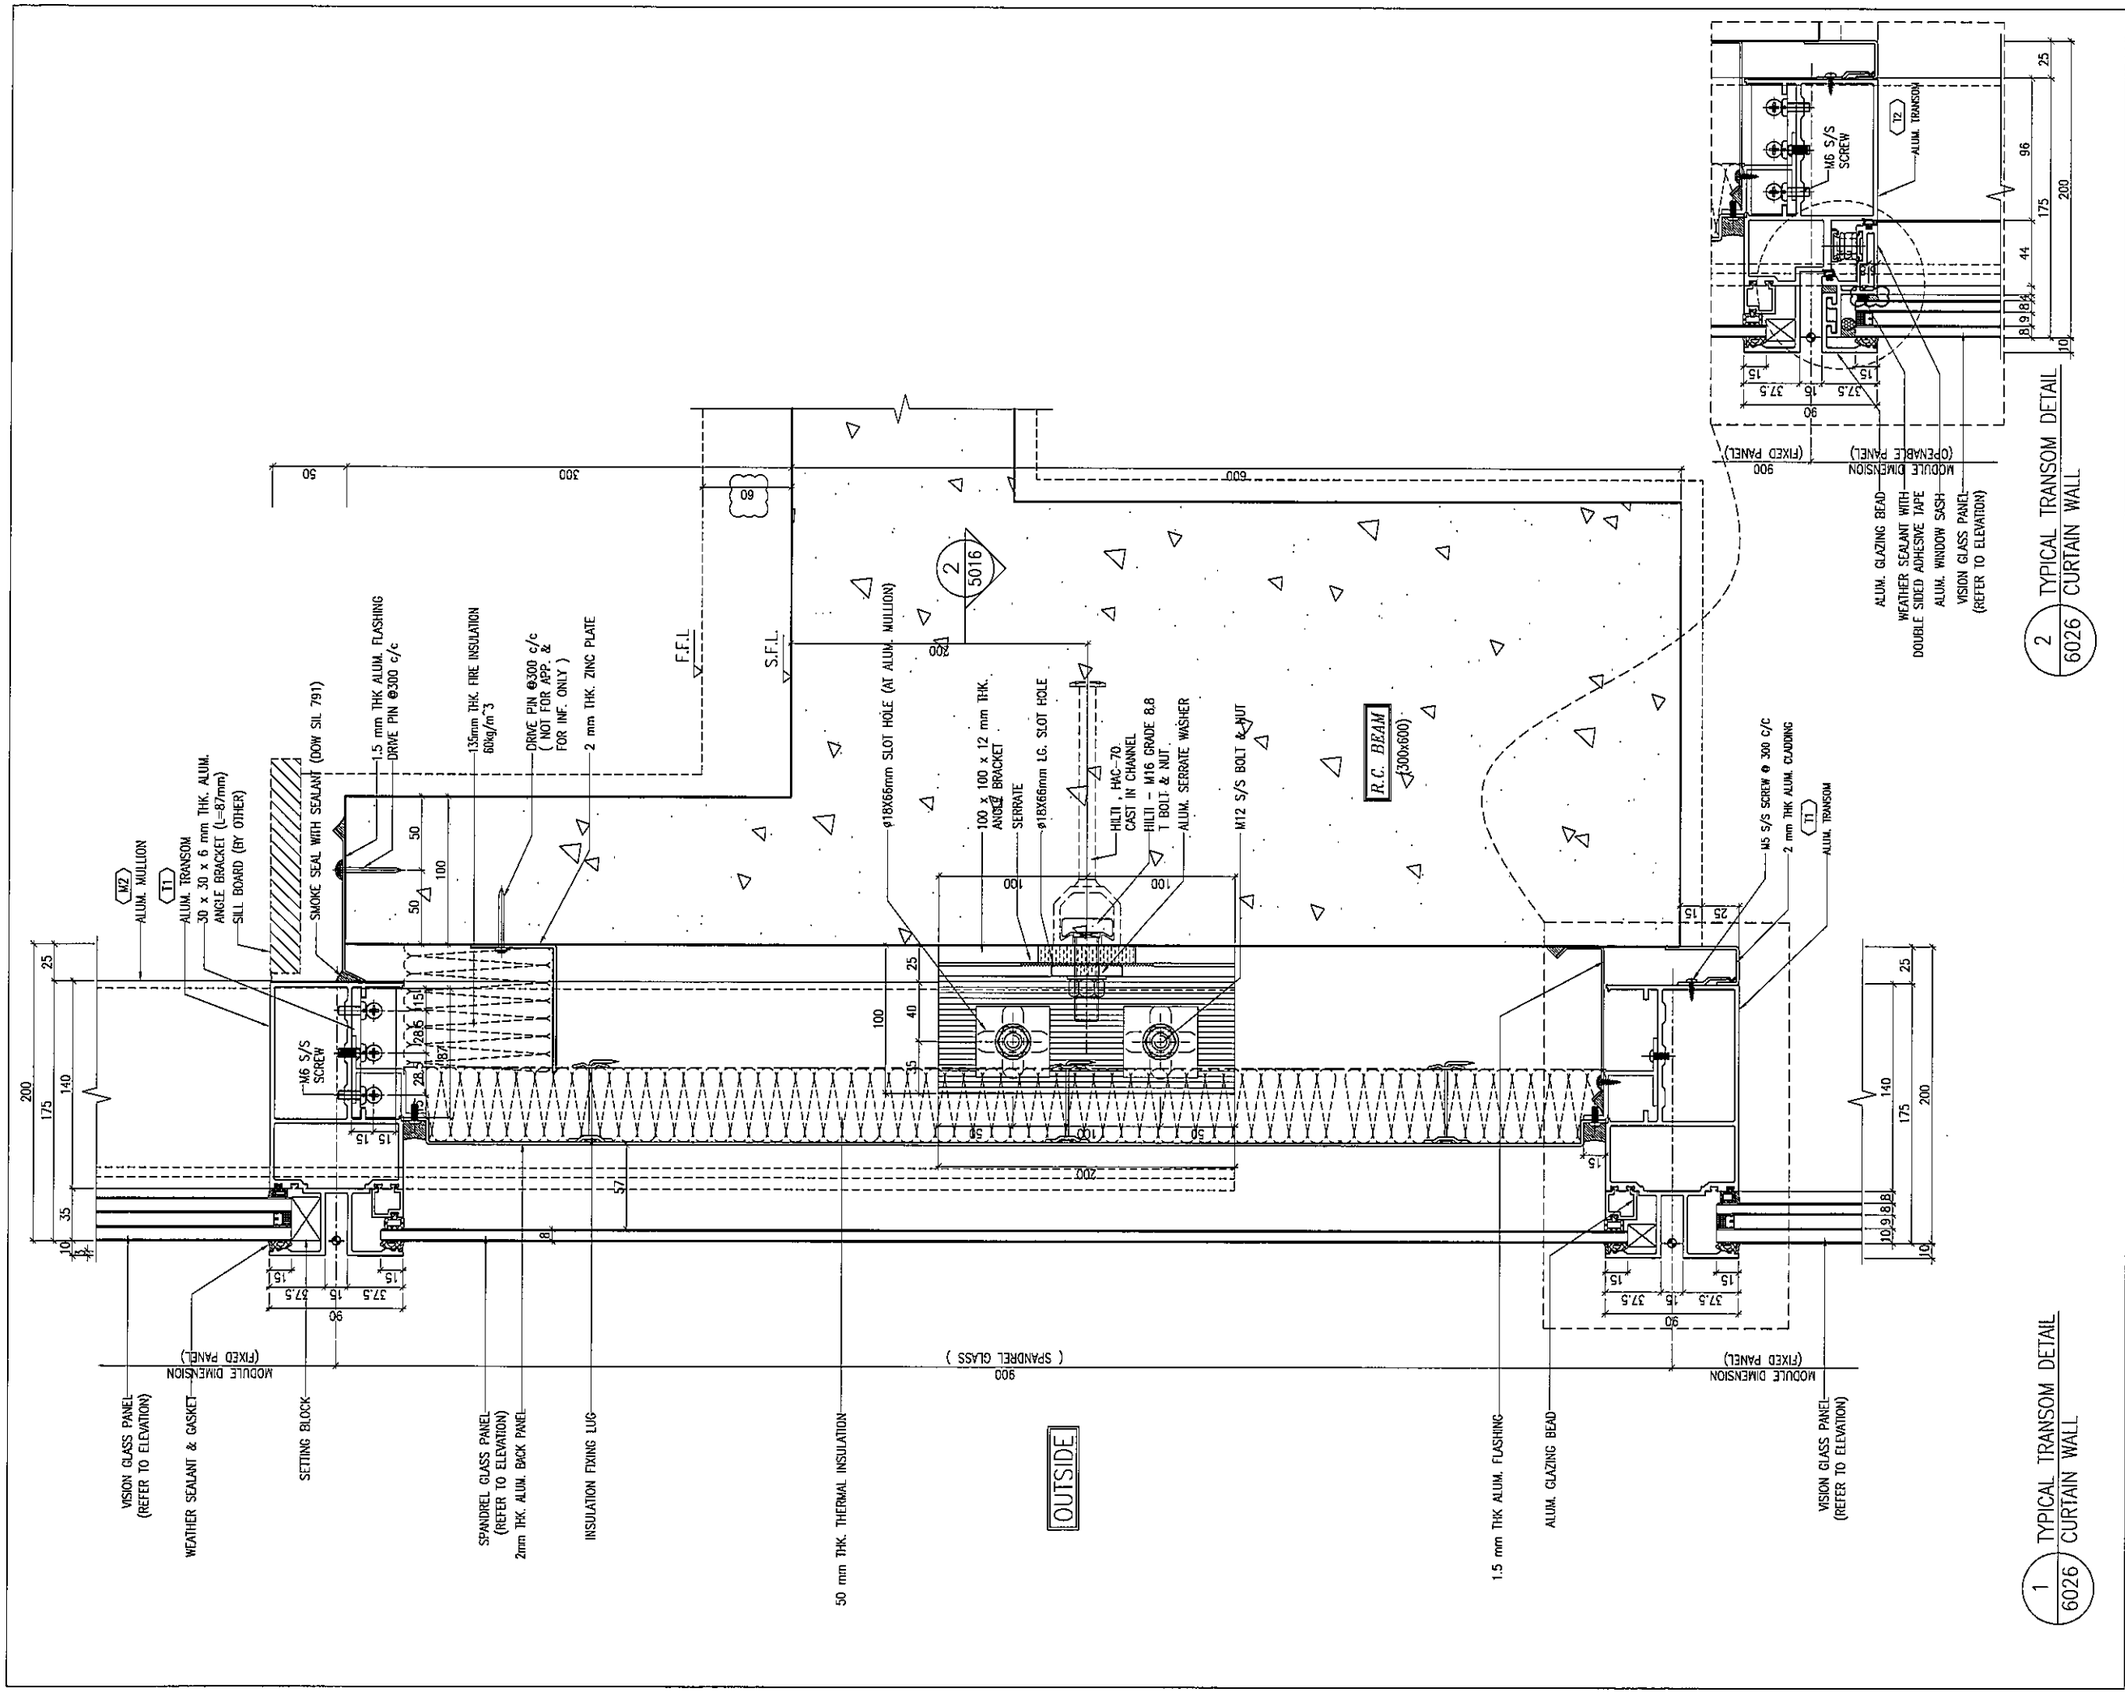

B.D. REF :

CLIENT :
信和置業有限公司
Sino Land Company Limited

ARCHITECT :
WONG TUNG & PARTNERS LIMITED
ARCHITECTS & PLANNERS

MAIN CONTRACTOR :
CR Construction Company Limited

STRUCTURAL ENGINEER :
AECOM

FACADE CONSULTANT:
AECOM

NOTE :
1. ALL DIMENSIONS ARE IN mm.
2. ALL ELEVATIONS ARE VIEWED FROM OUTSIDE.
3. ALL DIMENSIONS TO BE VERIFIED ON SITE BEFORE FABRICATION.

LEGEND :
X1 — DETAIL MARK NO.
X001 — REFER SHEET NO.

1. F.F.L. --FINISHED FLOOR LEVEL
2. S.F.L. --STRUCTURAL FLOOR LEVEL
3. /R --REVERSED DETAIL

NO.	DATE	REVISED	BY
A	15/02/2019	GENERAL REVISED	

JOB NO. : J-837

PROJECT :
URA KWUN TONG TOWN CENTRE REDEVELOPMENT (AREA 2 & 3) AT NKIL 6514, KWUN TONG, KWLOON

TITLE :
TYPICAL TRANSOM DETAIL FOR CURTAIN WALL

DATE : 28-JAN-19 | SCALE : 1:2 (A1)

DRAWN BY : ASING | CHECKED BY : -

美特鋁質有限公司
MIDI ALUMINIUM FABRICATOR LTD.
Units 6-8, Sunray Industrial Centre, 1/F
610 Cha Kwo Ling Road, Kowloon
Tel:23489211~4 Fax:(852)27727666

DWG NO. : JB37-CW-6026 | REV. : A

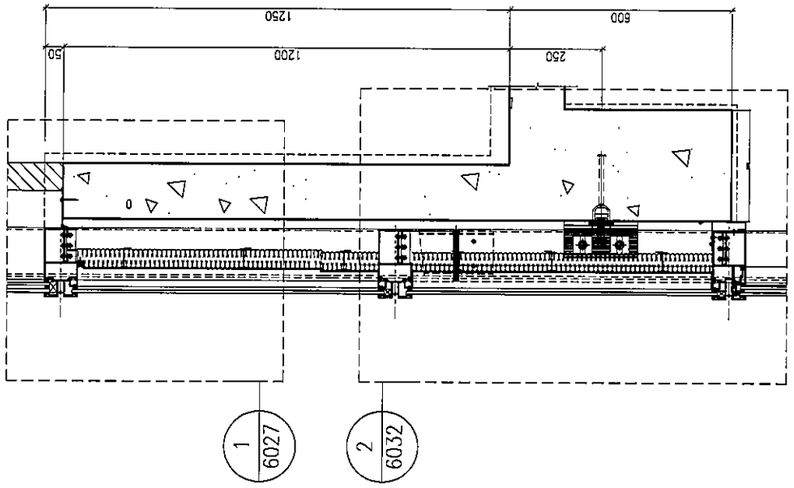

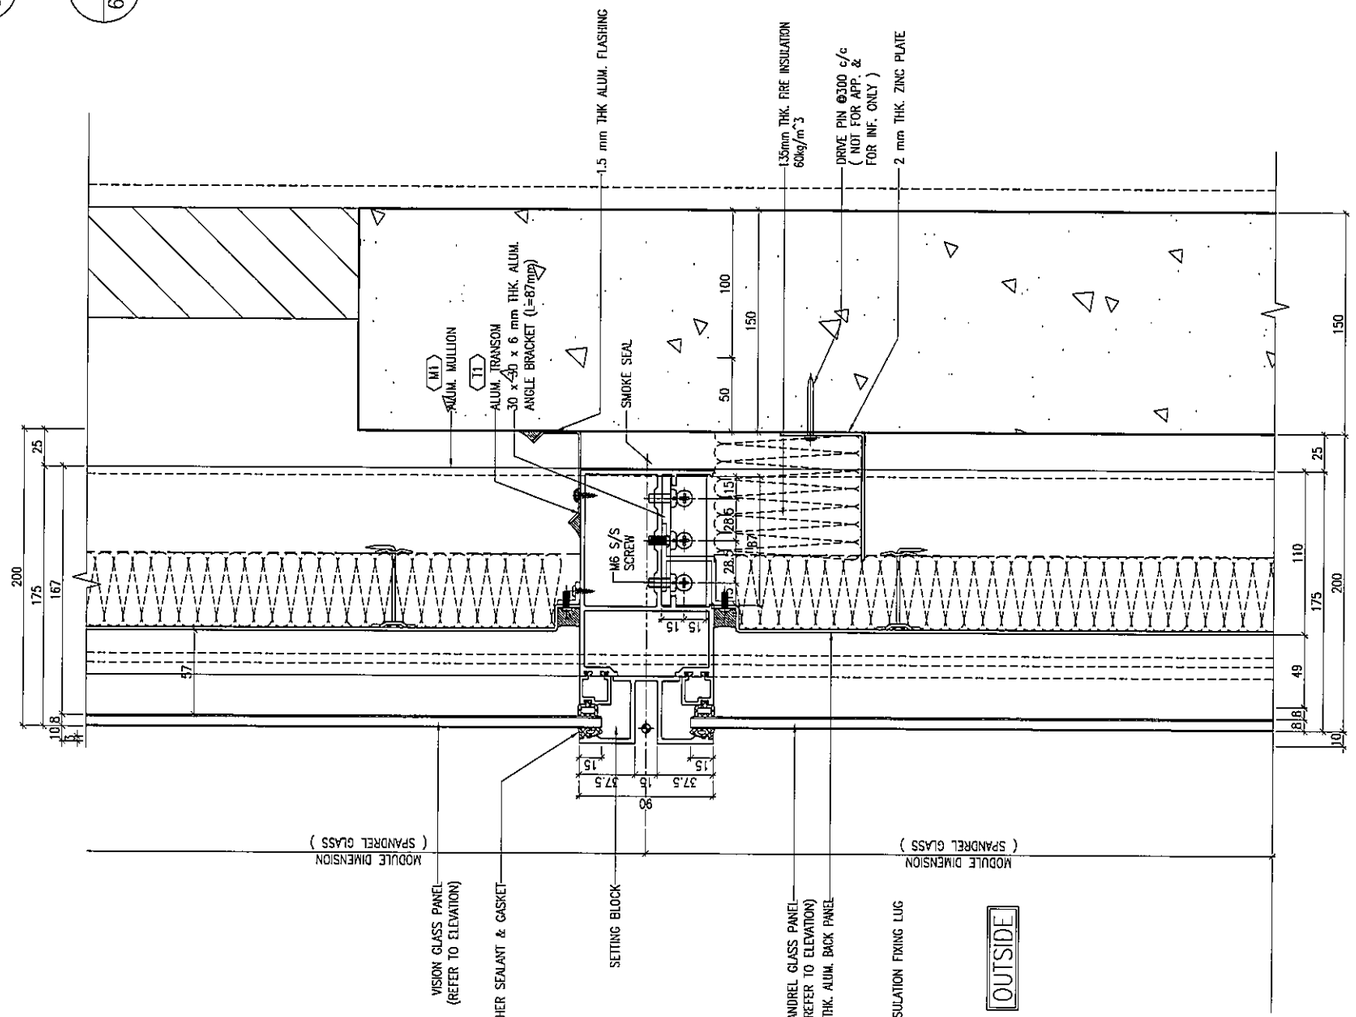

1 / 6027 TYPICAL TRANSOM DETAIL CURTAIN WALL

B.D. REF :

CLIENT :
信和置業有限公司
Sino Land Company Limited

ARCHITECT :
WONG TUNG & PARTNERS LIMITED
ARCHITECTS & PLANNERS

MAIN CONTRACTOR :
CR Construction Company Limited

STRUCTURAL ENGINEER :
AECOM

FACADE CONSULTANT:
AECOM

NOTE :
1. ALL DIMENSIONS ARE IN mm.
2. ALL ELEVATIONS ARE VIEWED FROM OUTSIDE.
3. ALL DIMENSIONS TO BE VERIFIED ON SITE BEFORE FABRICATION.

LEGEND :
X1 / XOO1 — DETAIL MARK NO. / REFER SHEET NO.
1. F.F.L. --FINISHED FLOOR LEVEL
2. S.F.L. --STRUCTURAL FLOOR LEVEL
3. /R --REVERSED DETAIL

NO.	DATE	REVISED	BY

JOB NO. : J-837

PROJECT :
URA KWUN TONG TOWN CENTRE REDEVELOPMENT (AREA 2 & 3) AT NKIL 6514, KWUN TONG, KWLOON

TITLE :
TYPICAL TRANSOM DETAIL FOR CURTAIN WALL

DATE : 28-JAN-19	SCALE : 1:2 (A1)
DRAWN BY : ASING	CHECKED BY : -

美特鋁質有限公司
MIDI ALUMINIUM FABRICATOR LTD.
Units 6-8, Sunray Industrial Centre, 1/F
610 Cha Kwo Ling Road, Kowloon
Tel:23489211-4 Fax:(852)27727666

DWG NO. : J837-CW-6027 REV. : -

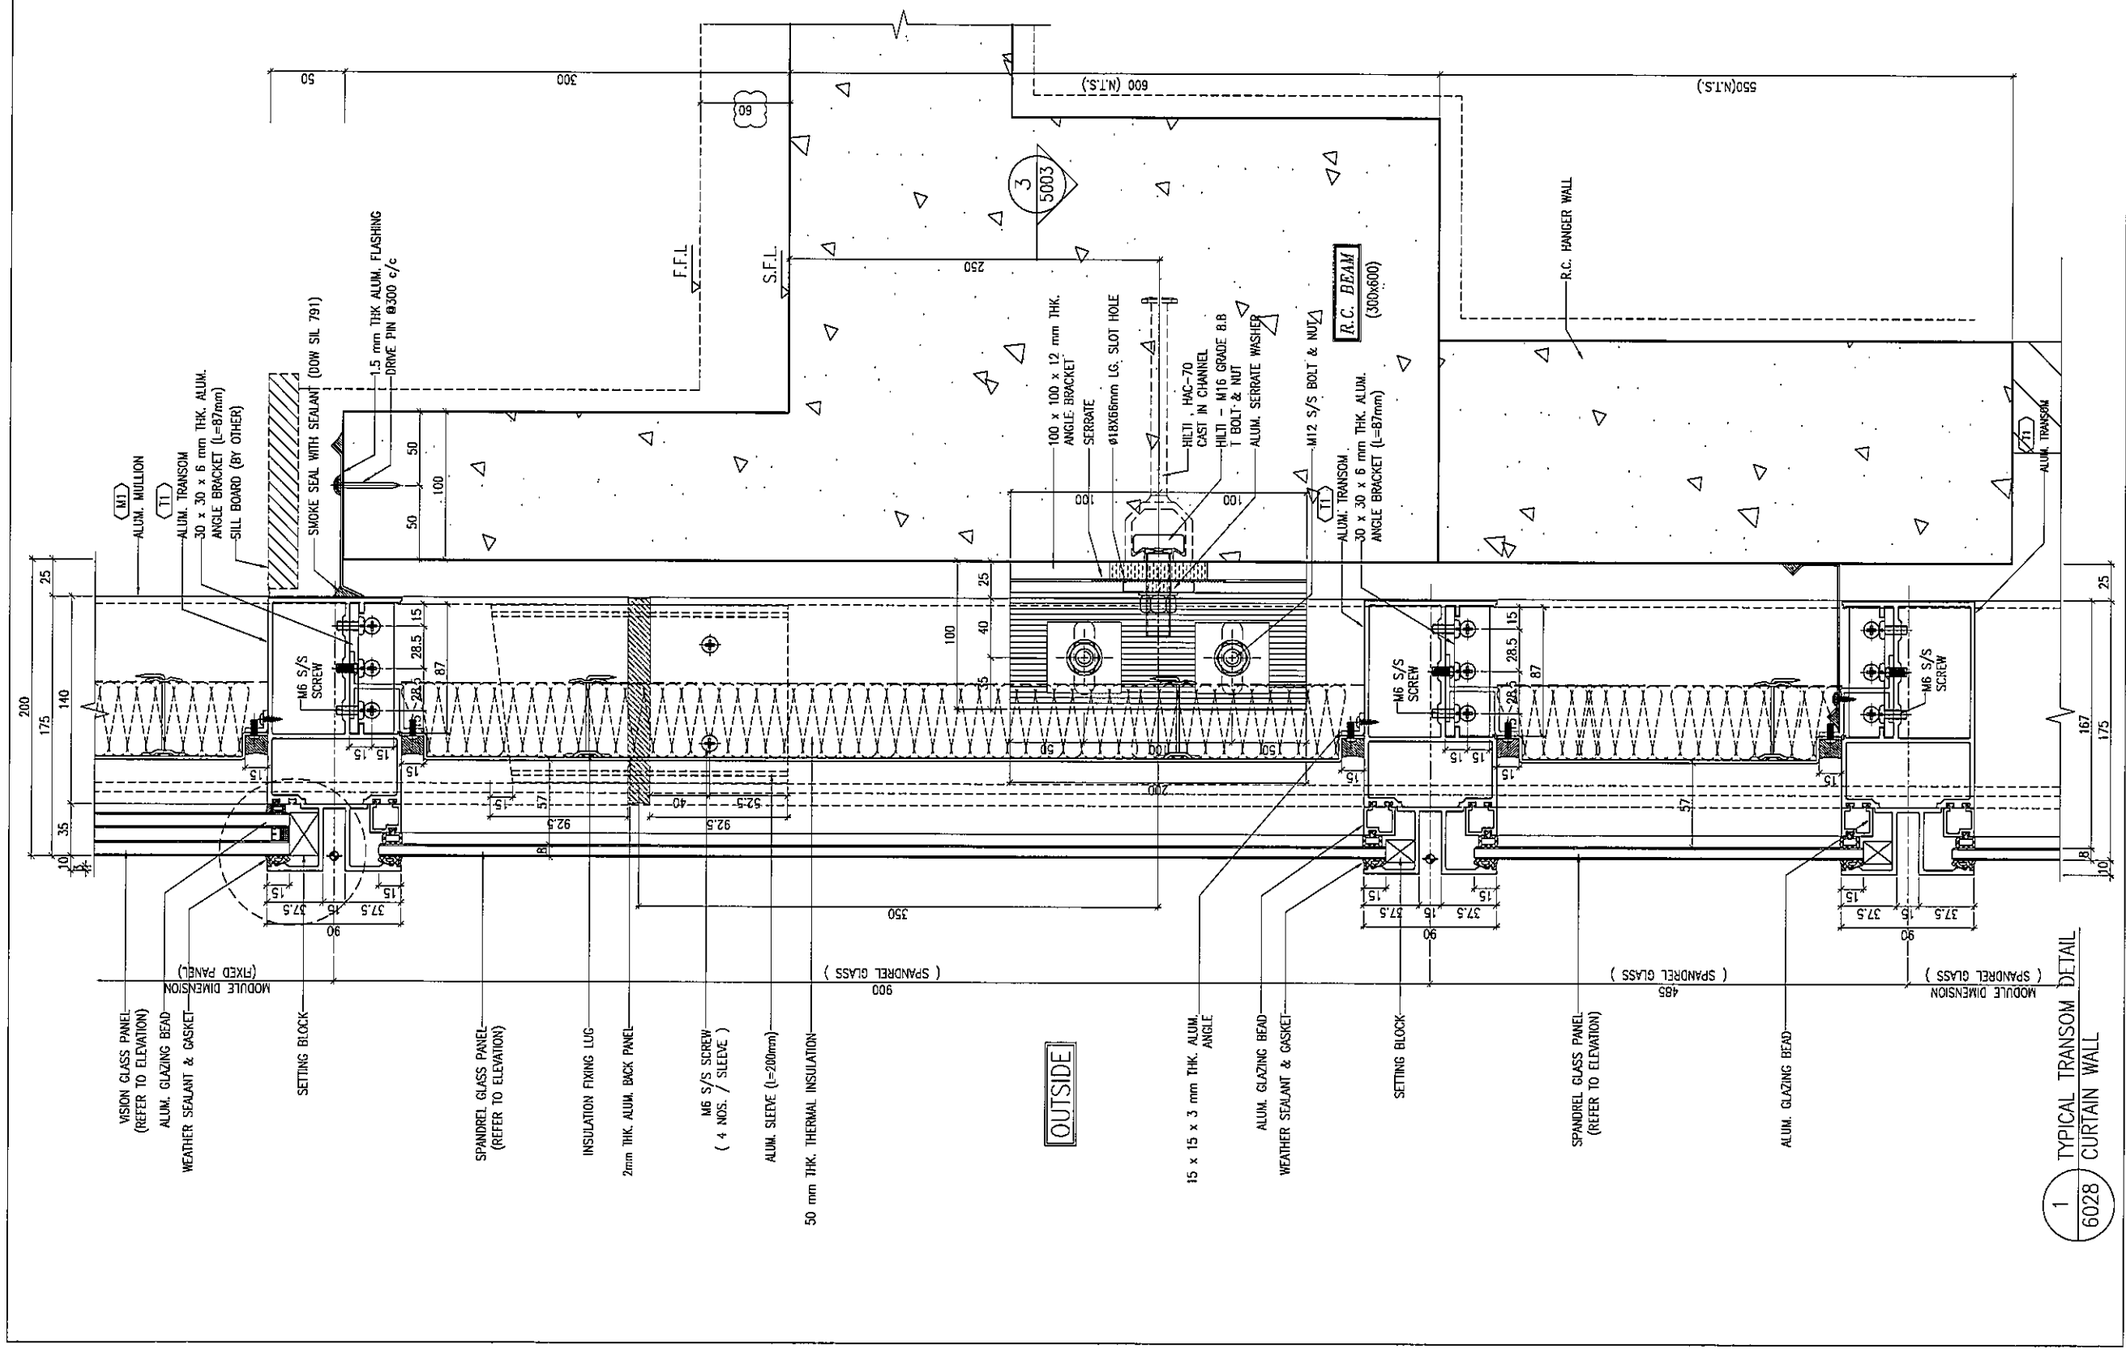

B.D. REF :

CLIENT :
信和置業有限公司
Sino Land Company Limited

ARCHITECT :
WONG TUNG & PARTNERS LIMITED
ARCHITECTS & PLANNERS

MAIN CONTRACTOR :
CR Construction Company Limited

STRUCTURAL ENGINEER :
AECOM

FACADE CONSULTANT:
AECOM

NOTE :
1. ALL DIMENSIONS ARE IN mm.
2. ALL ELEVATIONS ARE VIEWED FROM OUTSIDE.
3. ALL DIMENSIONS TO BE VERIFIED ON SITE BEFORE FABRICATION.

LEGEND :
X1 / XOO1 — DETAIL MARK NO. / REFER SHEET NO.
1. F.F.L. --FINISHED FLOOR LEVEL
2. S.F.L. --STRUCTURAL FLOOR LEVEL
3. /R --REVERSED DETAIL

NO.	DATE	REVISED	BY
A	15/02/2019	GENERAL REVISED	

JOB NO. : J-837

PROJECT :
URA KWUN TONG TOWN CENTRE REDEVELOPMENT (AREA 2 & 3) AT NKIL 6514, KWUN TONG, KWLOON

TITLE :
TYPICAL TRANSOM DETAIL FOR CURTAIN WALL

DATE : 28-JAN-19	SCALE : 1:2 (A1)
DRAWN BY : ASING	CHECKED BY : -

美特鋁質有限公司
MIDI ALUMINIUM FABRICATOR LTD.
Units 6-8, Sunray Industriol Centre, 1/F
610 Cha Kwo Ling Road, Kowloon
Tel:23489211-4 Fax:(852)27727666

DWG NO. : J837-CW-6028 | REV. : A

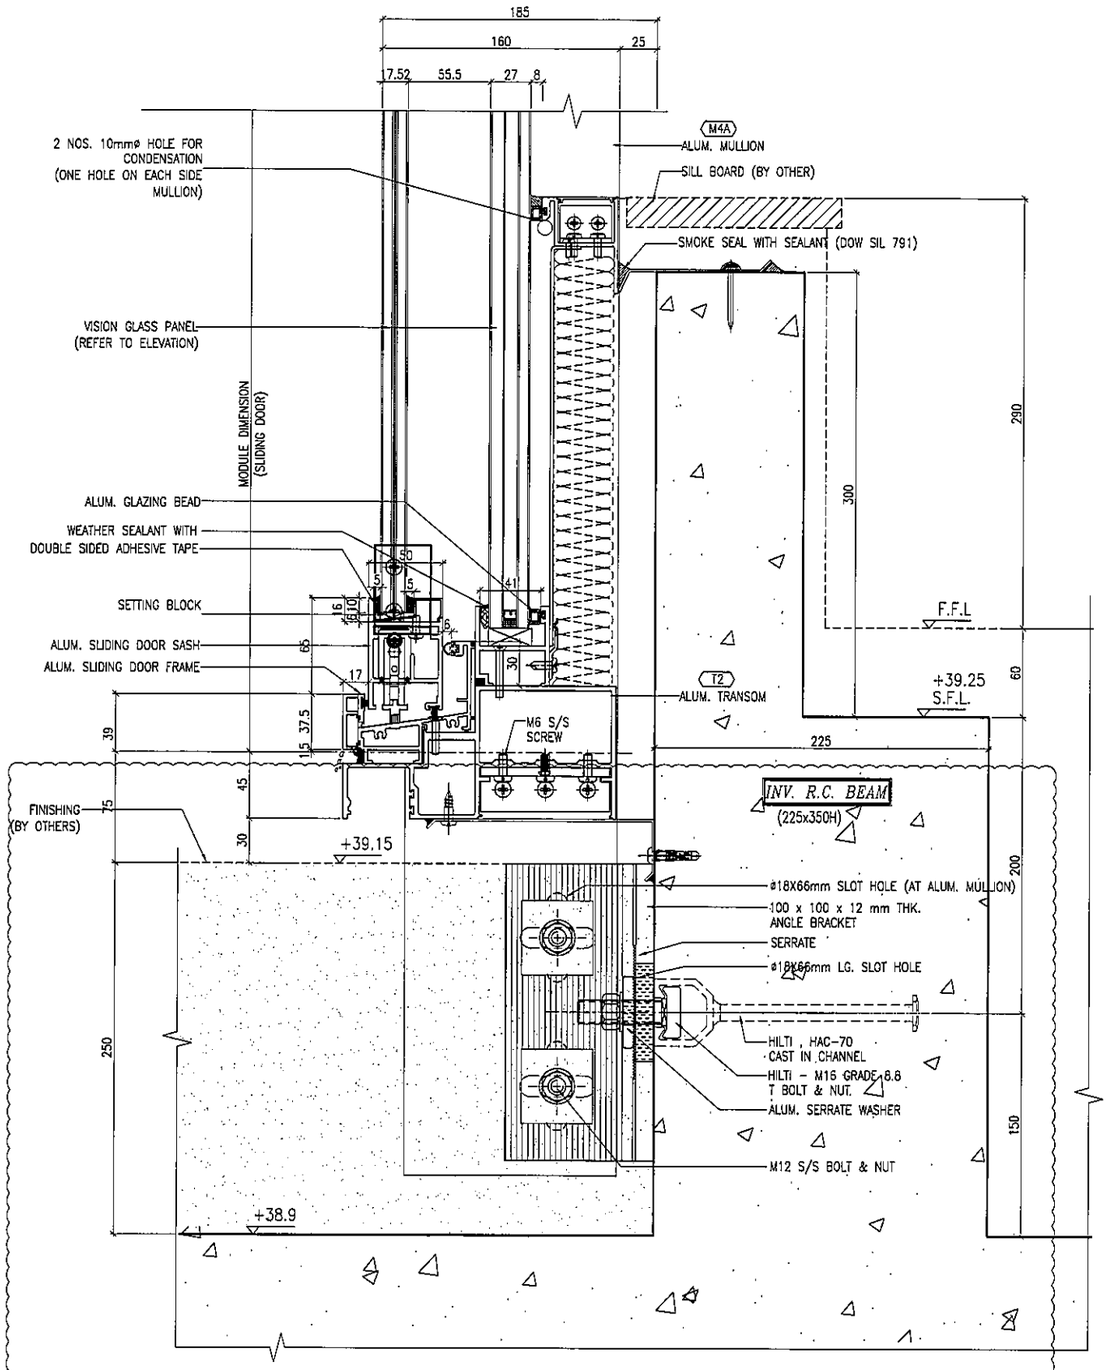

1 / 6029 TYPICAL BOTTOM SECTION DETAIL CURTAIN WALL

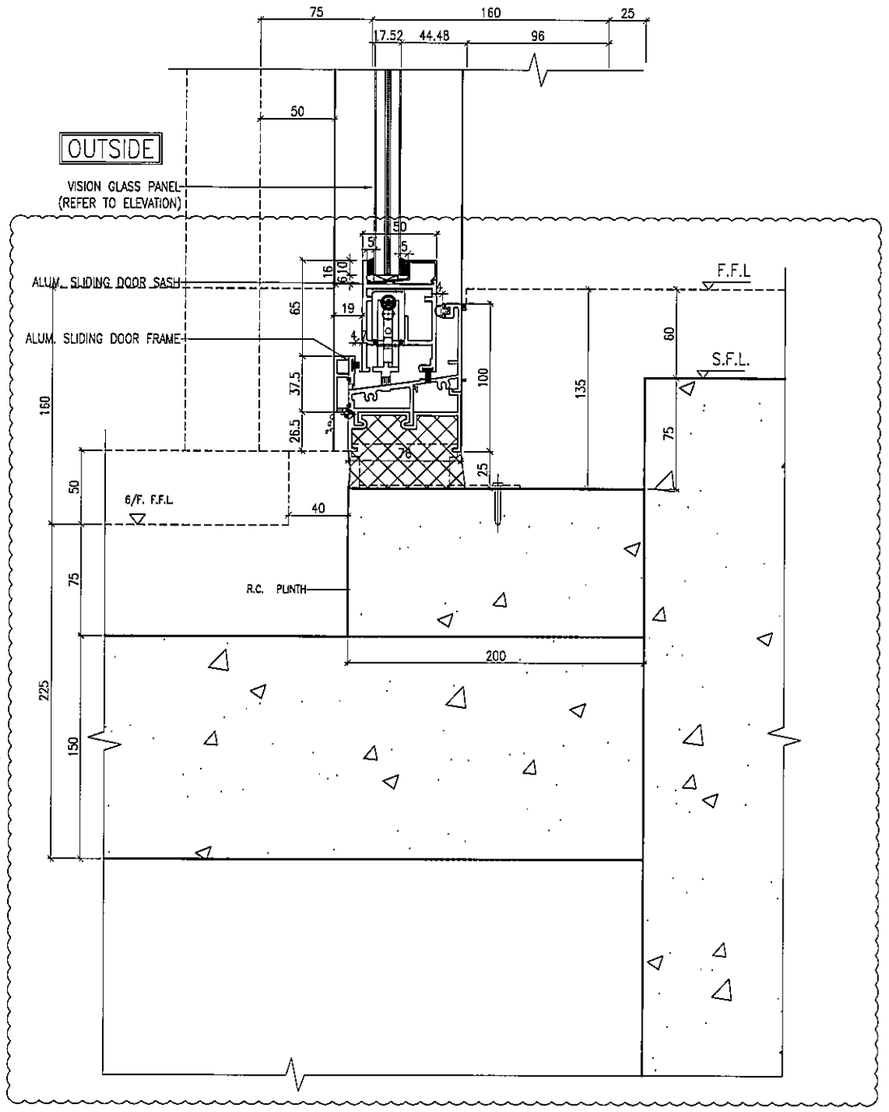

2 / 6029 TYPICAL BOTTOM SECTION DETAIL CURTAIN WALL

B.D. REF :

CLIENT :
信和置業有限公司
Sino Land Company Limited

ARCHITECT :
WONG TUNG & PARTNERS LIMITED
ARCHITECTS & PLANNERS

MAIN CONTRACTOR :
CR Construction Company Limited

STRUCTURAL ENGINEER :
AECOM

FACADE CONSULTANT:
AECOM

NOTE :
1. ALL DIMENSIONS ARE IN mm.
2. ALL ELEVATIONS ARE VIEWED FROM OUTSIDE.
3. ALL DIMENSIONS TO BE VERIFIED ON SITE BEFORE FABRICATION.

LEGEND :
X1 / X001 — DETAIL MARK NO. / REFER SHEET NO.
1. F.F.L. --FINISHED FLOOR LEVEL
2. S.F.L. --STRUCTURAL FLOOR LEVEL
3. /R --REVERSED DETAIL

NO.	DATE	REVISED	BY
B	16/06/2019	GENERAL REVISED	
A	15/02/2019	GENERAL REVISED	

JOB NO. : J-837

PROJECT :
URA KWUN TONG TOWN CENTRE REDEVELOPMENT (AREA 2 & 3) AT NKIL 6514, KWUN TONG, KWLOON

TITLE :
TYPICAL TRANSOM DETAIL FOR CURTAIN WALL

DATE : 28-JAN-19 | SCALE : 1:2 (A1)

DRAWN BY : ASING | CHECKED BY : -

美特鋁質有限公司
MIDI ALUMINIUM FABRICATOR LTD.
Units 6-8, Sunray Industrial Centre, 1/F
610 Cha Kwo Ling Road, Kowloon
Tel:23489211-4 Fax:(852)27727666

DWG NO. : J837-CW-6029 | REV. : B

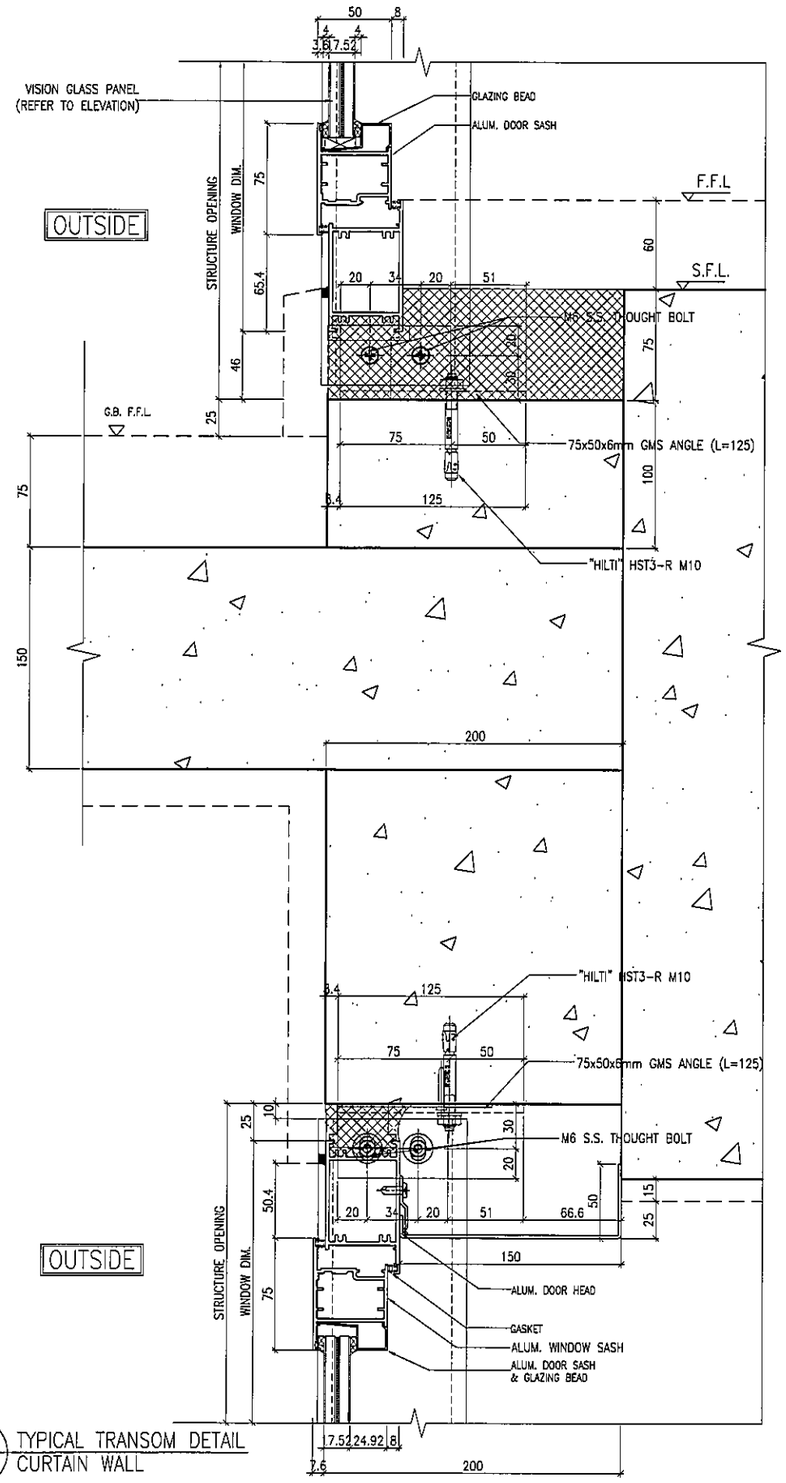

1 / 6030 TYPICAL TRANSOM DETAIL CURTAIN WALL

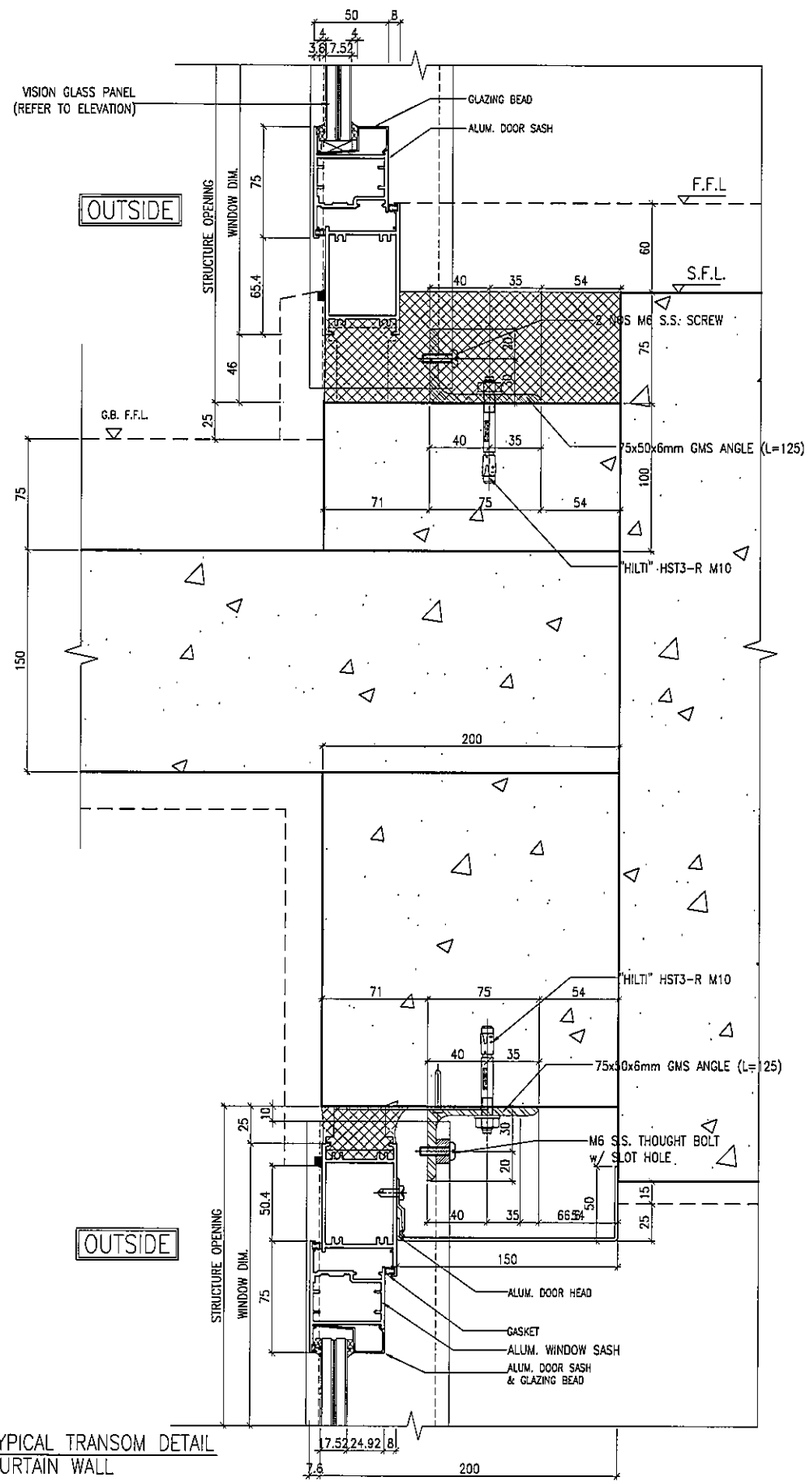

2 / 6030 TYPICAL TRANSOM DETAIL CURTAIN WALL

B.D. REF :

CLIENT :
信和置業有限公司
Sino Land Company Limited

ARCHITECT :
WONG TUNG & PARTNERS LIMITED
ARCHITECTS & PLANNERS

MAIN CONTRACTOR :
CR Construction Company Limited

STRUCTURAL ENGINEER :
AECOM

FACADE CONSULTANT:
AECOM

NOTE :
1. ALL DIMENSIONS ARE IN mm.
2. ALL ELEVATIONS ARE VIEWED FROM OUTSIDE.
3. ALL DIMENSIONS TO BE VERIFIED ON SITE BEFORE FABRICATION.

LEGEND :
X1 / X001 — DETAIL MARK NO. / REFER SHEET NO.
1. F.F.L. --FINISHED FLOOR LEVEL
2. S.F.L. --STRUCTURAL FLOOR LEVEL
3. /R --REVERSED DETAIL

NO.	DATE	REVISED	BY

JOB NO. : J-837

PROJECT :
URA KWUN TONG TOWN CENTRE REDEVELOPMENT (AREA 2 & 3) AT NKIL 6514, KWUN TONG, KWLOON

TITLE :
TYPICAL TRANSOM DETAIL FOR CURTAIN WALL

DATE : 15-FEB-19 | SCALE : 1:2 (A1)

DRAWN BY : ASING | CHECKED BY : -

美特鋁質有限公司
MIDI ALUMINIUM FABRICATOR LTD.
Units 6-8, Sunray Industrial Centre, 1/F
610 Cha Kwo Ling Road, Kowloon
Tel:23489211-4 Fax:(852)27727666

DWG NO. : J837-CW-6030 | REV. : -

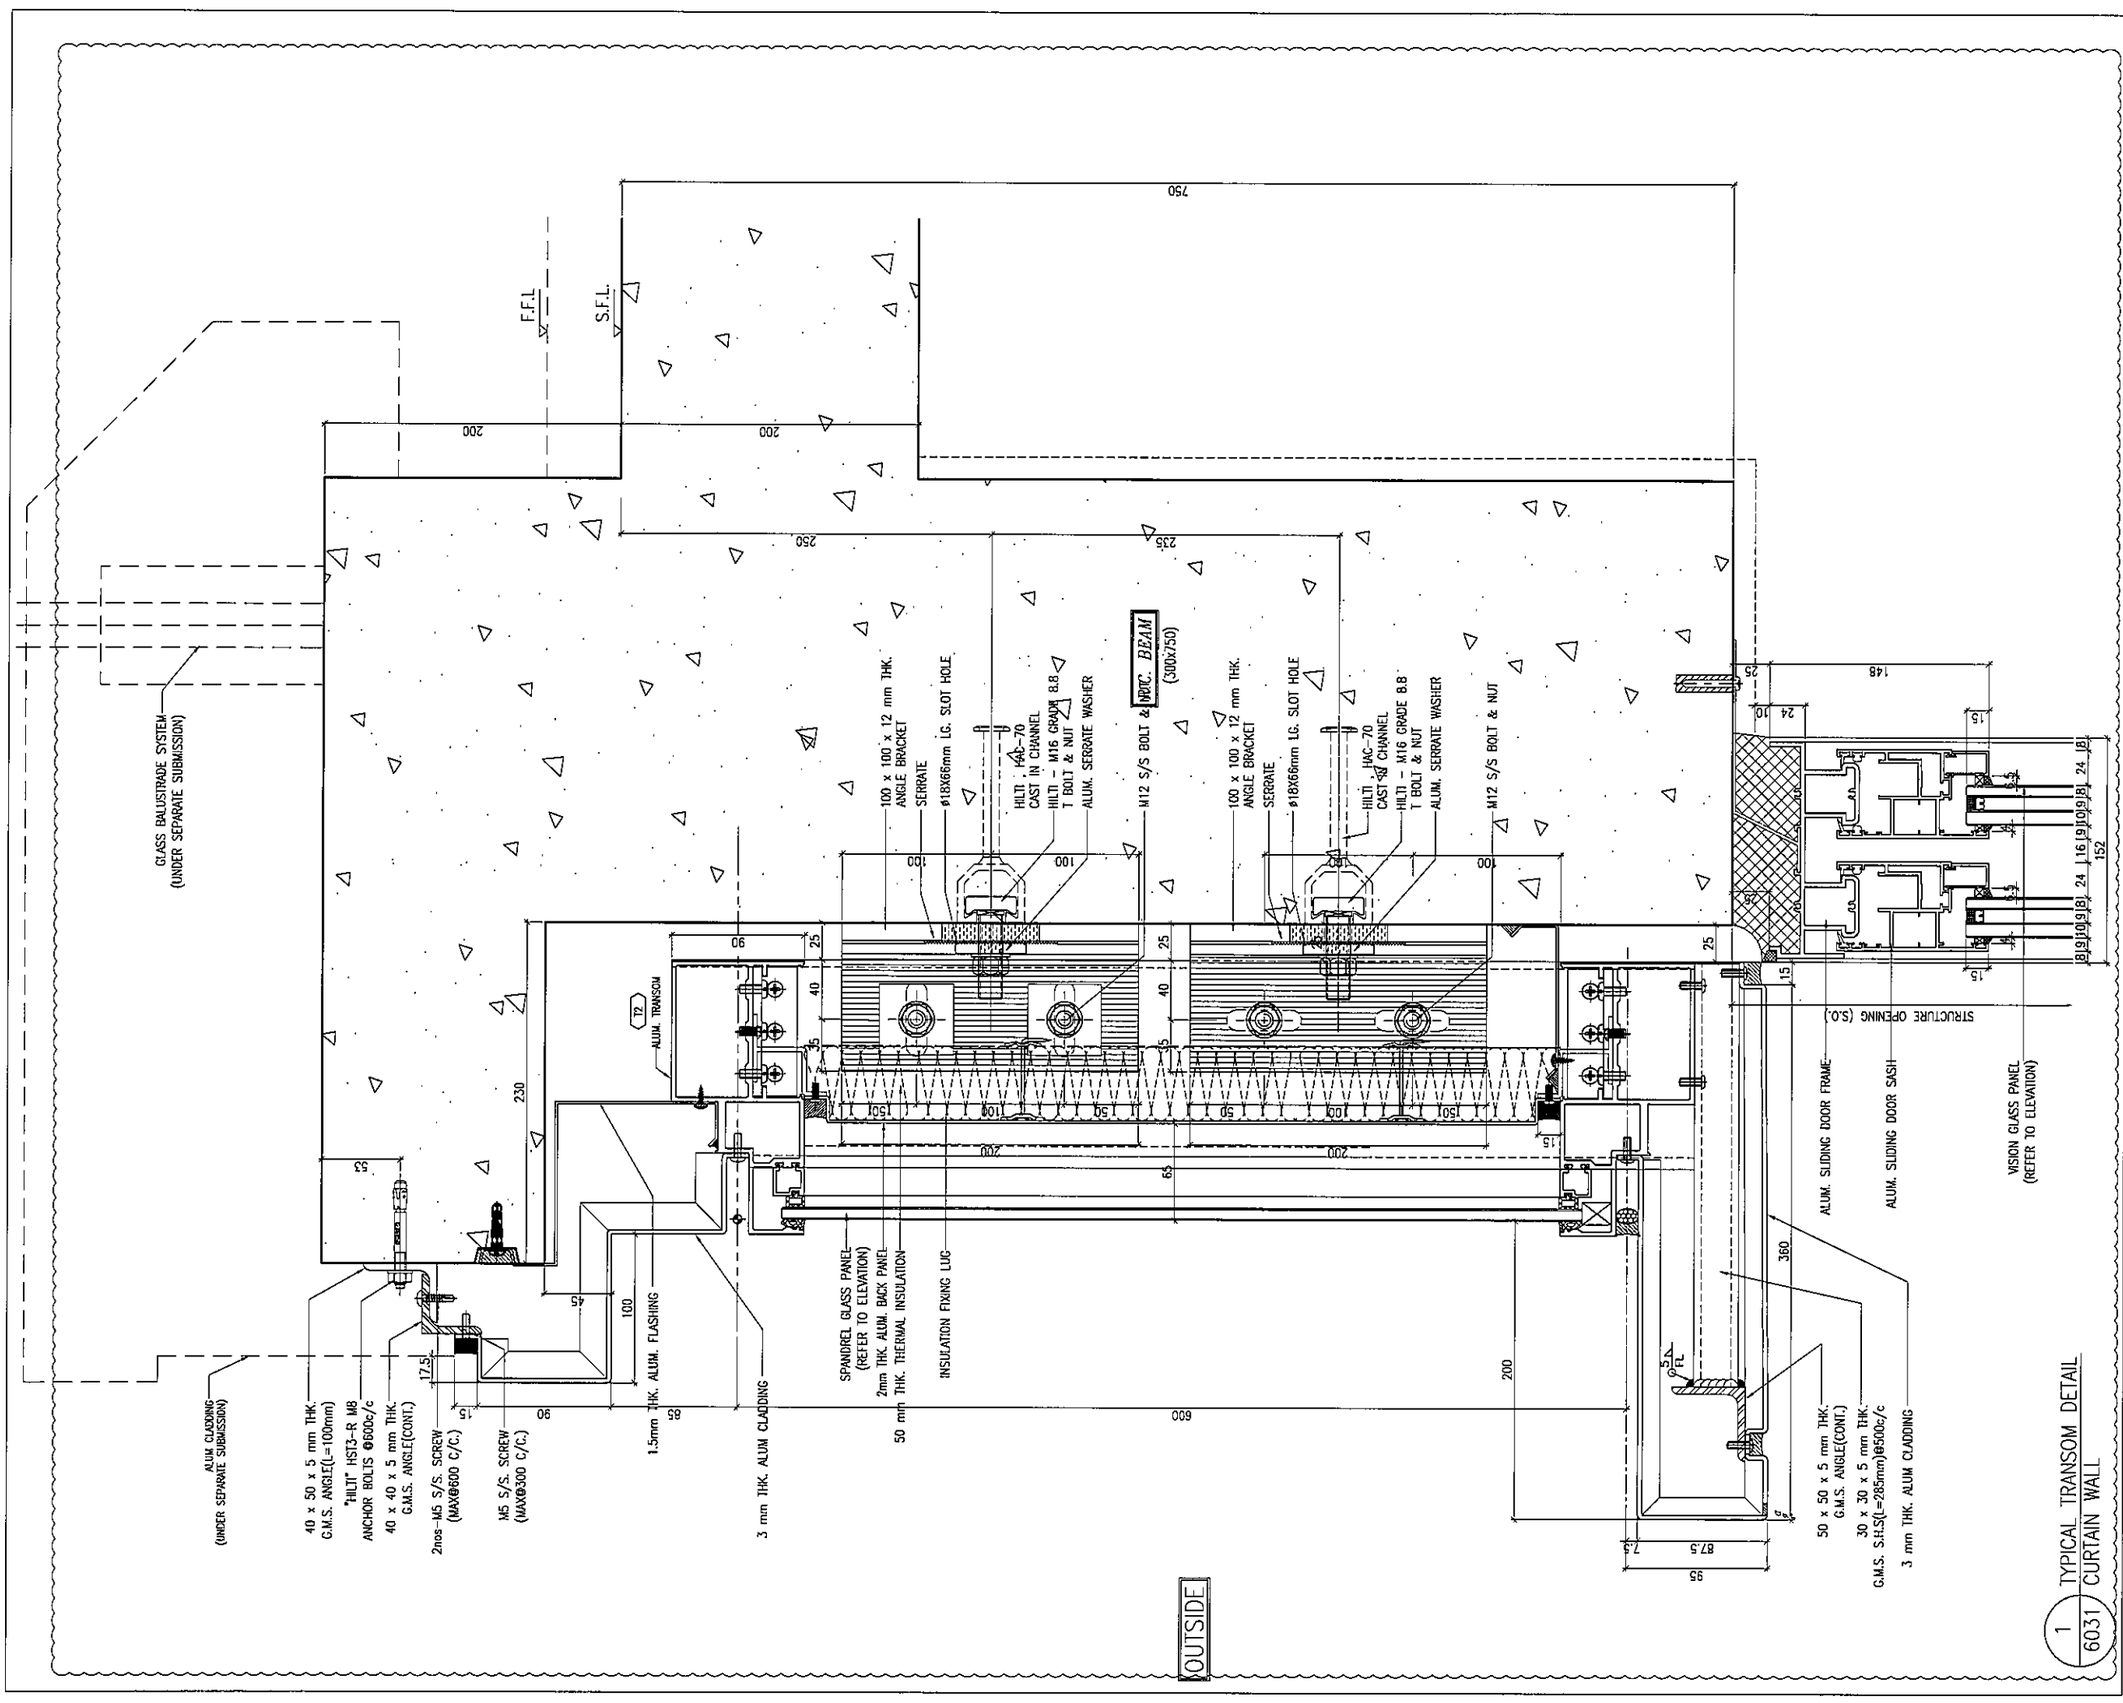

1 TYPICAL TRANSOM DETAIL
6031 CURTAIN WALL

B.D. REF :

CLIENT :
信和置業有限公司
Sino Land Company Limited

ARCHITECT :
WONG TUNG & PARTNERS LIMITED
ARCHITECTS & PLANNERS

MAIN CONTRACTOR :
CR Construction Company Limited

STRUCTURAL ENGINEER :
AECOM

FACADE CONSULTANT:
AECOM

NOTE :
1. ALL DIMENSIONS ARE IN mm.
2. ALL ELEVATIONS ARE VIEWED FROM OUTSIDE.
3. ALL DIMENSIONS TO BE VERIFIED ON SITE BEFORE FABRICATION.

LEGEND :
X1 — DETAIL MARK NO.
X001 — REFER SHEET NO.
1. F.F.L. --FINISHED FLOOR LEVEL
2. S.F.L. --STRUCTURAL FLOOR LEVEL
3. (R) --REVERSED DETAIL

NO.	DATE	REVISED	BY
A	16/06/2019	GENERAL REVISED	

JOB NO. : J-837

PROJECT :
URA KWUN TONG TOWN CENTRE
REDEVELOPMENT (AREA 2 & 3) AT
NKIL 6514, KWUN TONG, KWLOON

TITLE :
TYPICAL TRANSOM DETAIL
FOR CURTAIN WALL

DATE : 18-FEB-19 | SCALE : 1:2 (A1)

DRAWN BY : ASING | CHECKED BY : -

美特鋁製有限公司
MIDI ALUMINIUM FABRICATOR LTD.
Units 6-8, Sunray Industrial Centre, 1/F
610 Cha Kwo Ling Road, Kowloon
Tel:23489211-4 Fax:(852)27727666

DWG NO. : J837-CW-6031 | REV. : A

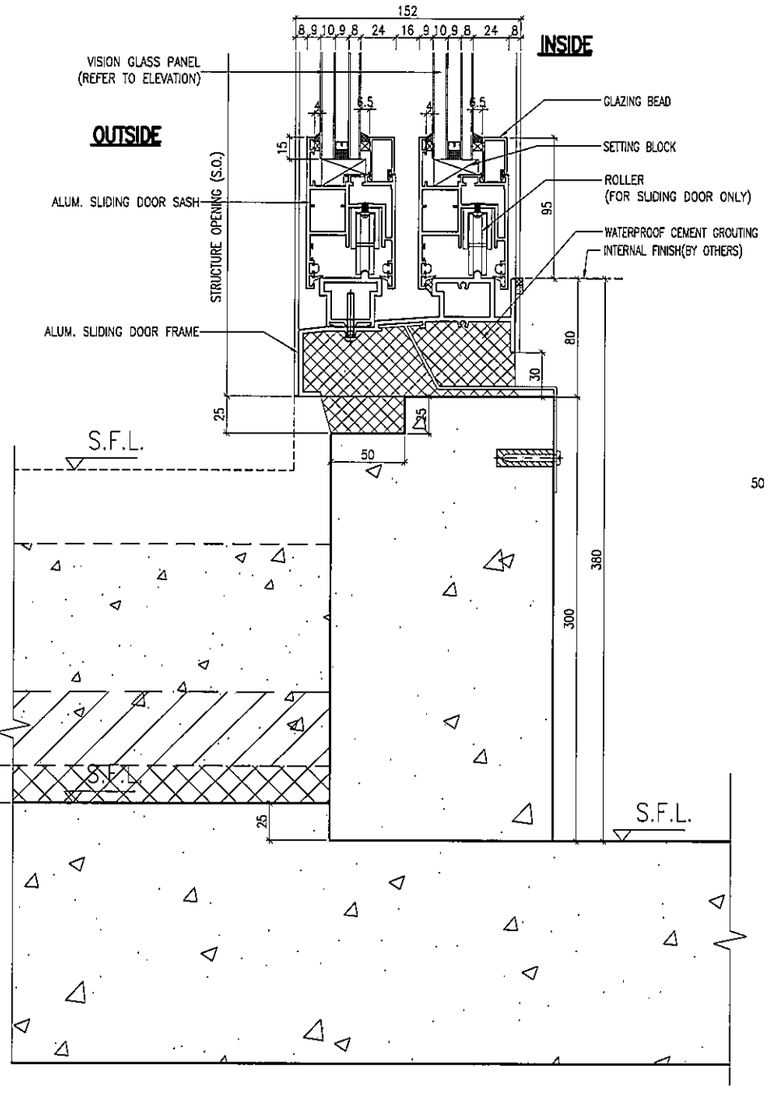

1 / 6032 TYPICAL TRANSOM DETAIL CURTAIN WALL

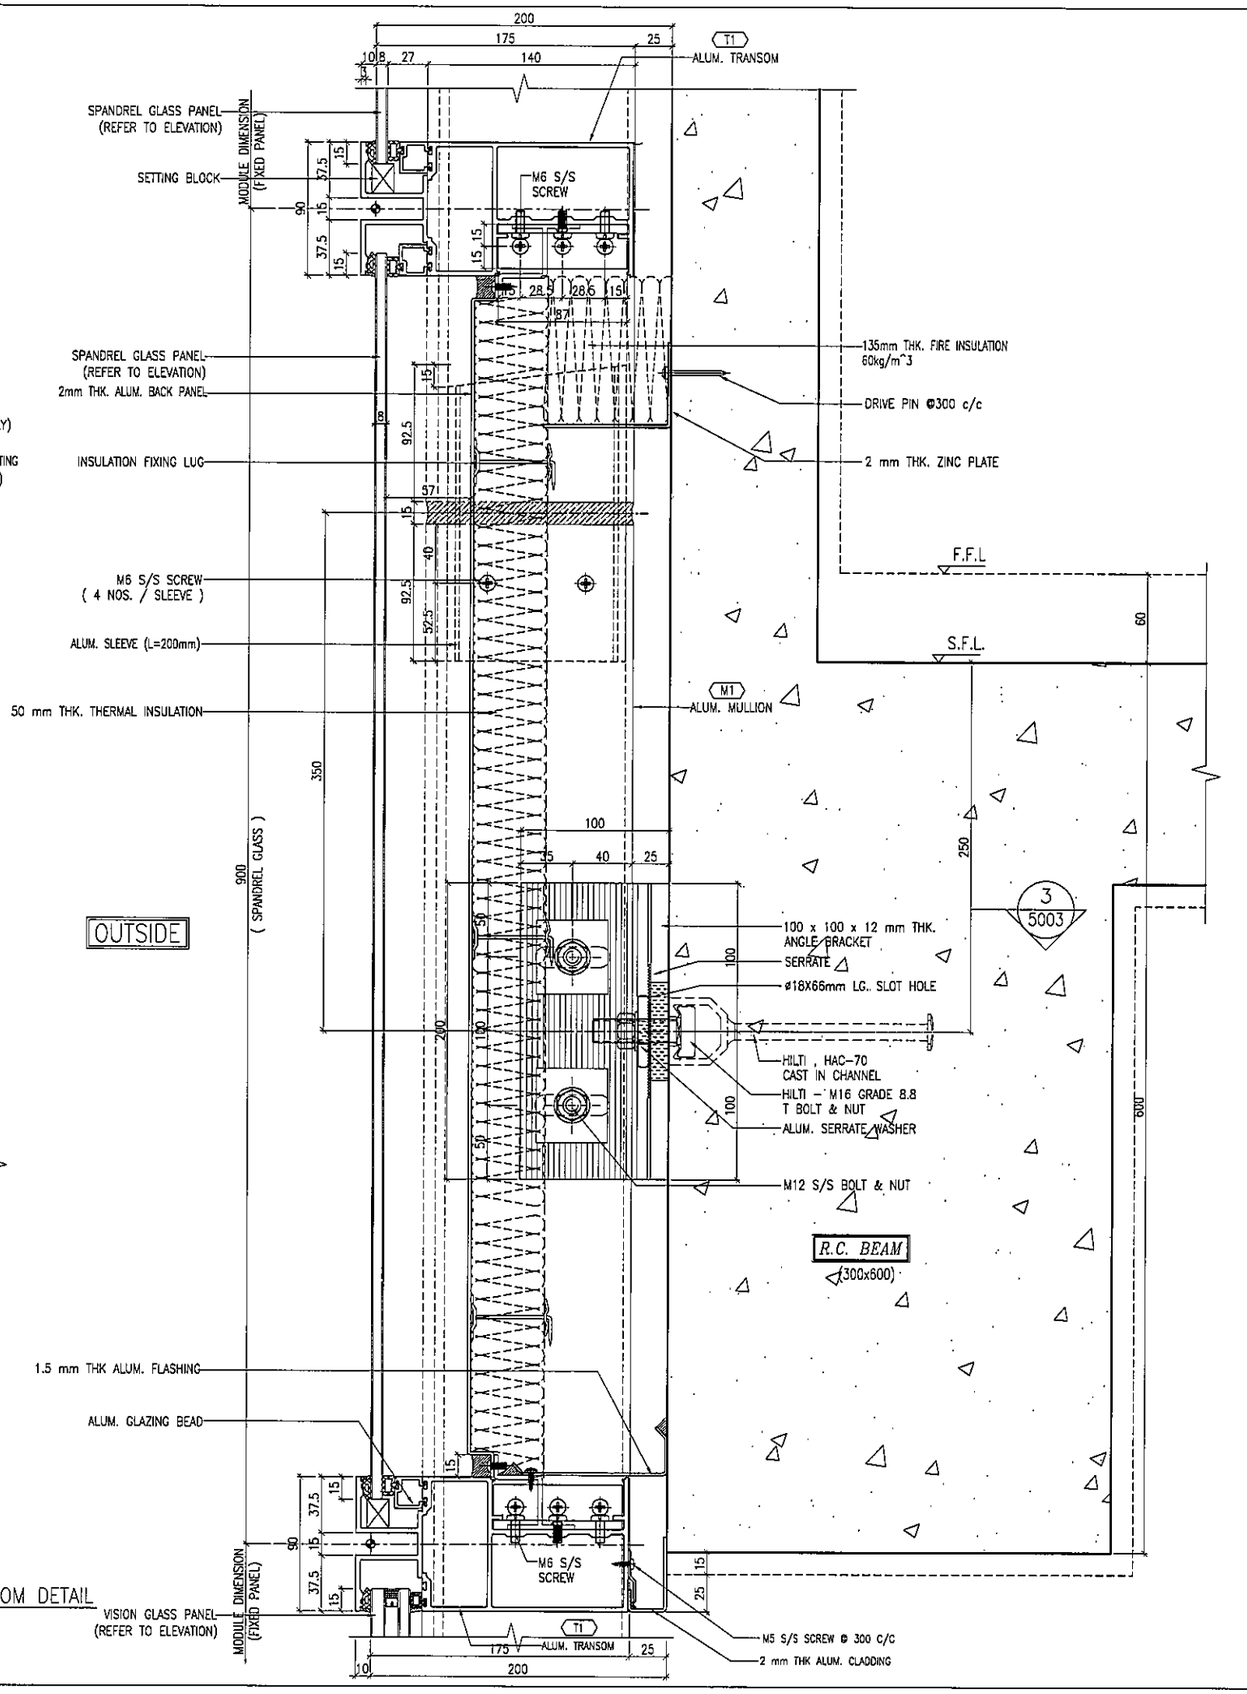

2 / 6032 TYPICAL TRANSOM DETAIL CURTAIN WALL

B.D. REF :

CLIENT :
信和置業有限公司
Sino Land Company Limited

ARCHITECT :
WONG TUNG & PARTNERS LIMITED
ARCHITECTS & PLANNERS

MAIN CONTRACTOR :
CR Construction Company Limited

STRUCTURAL ENGINEER :
AECOM

FACADE CONSULTANT:
AECOM

NOTE :
1. ALL DIMENSIONS ARE IN mm.
2. ALL ELEVATIONS ARE VIEWED FROM OUTSIDE.
3. ALL DIMENSIONS TO BE VERIFIED ON SITE BEFORE FABRICATION.

LEGEND :
X1 / X001 — DETAIL MARK NO. / REFER SHEET NO.
1. F.F.L. --FINISHED FLOOR LEVEL
2. S.F.L. --STRUCTURAL FLOOR LEVEL
3. (R) --REVERSED DETAIL

NO.	DATE	REVISED	BY

JOB NO. : J-837

PROJECT :
URA KWUN TONG TOWN CENTRE REDEVELOPMENT (AREA 2 & 3) AT NKIL 6514, KWUN TONG, KWLOON

TITLE :
TYPICAL TRANSOM DETAIL FOR CURTAIN WALL

DATE : 18-FEB-19 | SCALE : 1:2 (A1)

DRAWN BY : ASING | CHECKED BY : -

美特鋁質有限公司
MIDI ALUMINIUM FABRICATOR LTD.
Units 6-8, Sunray Industrial Centre, 1/F
610 Cha Kwo Ling Road, Kowloon
Tel:23489211-4 Fax:(852)27727666

DWG NO. : J837-CW-6032 | REV. : -

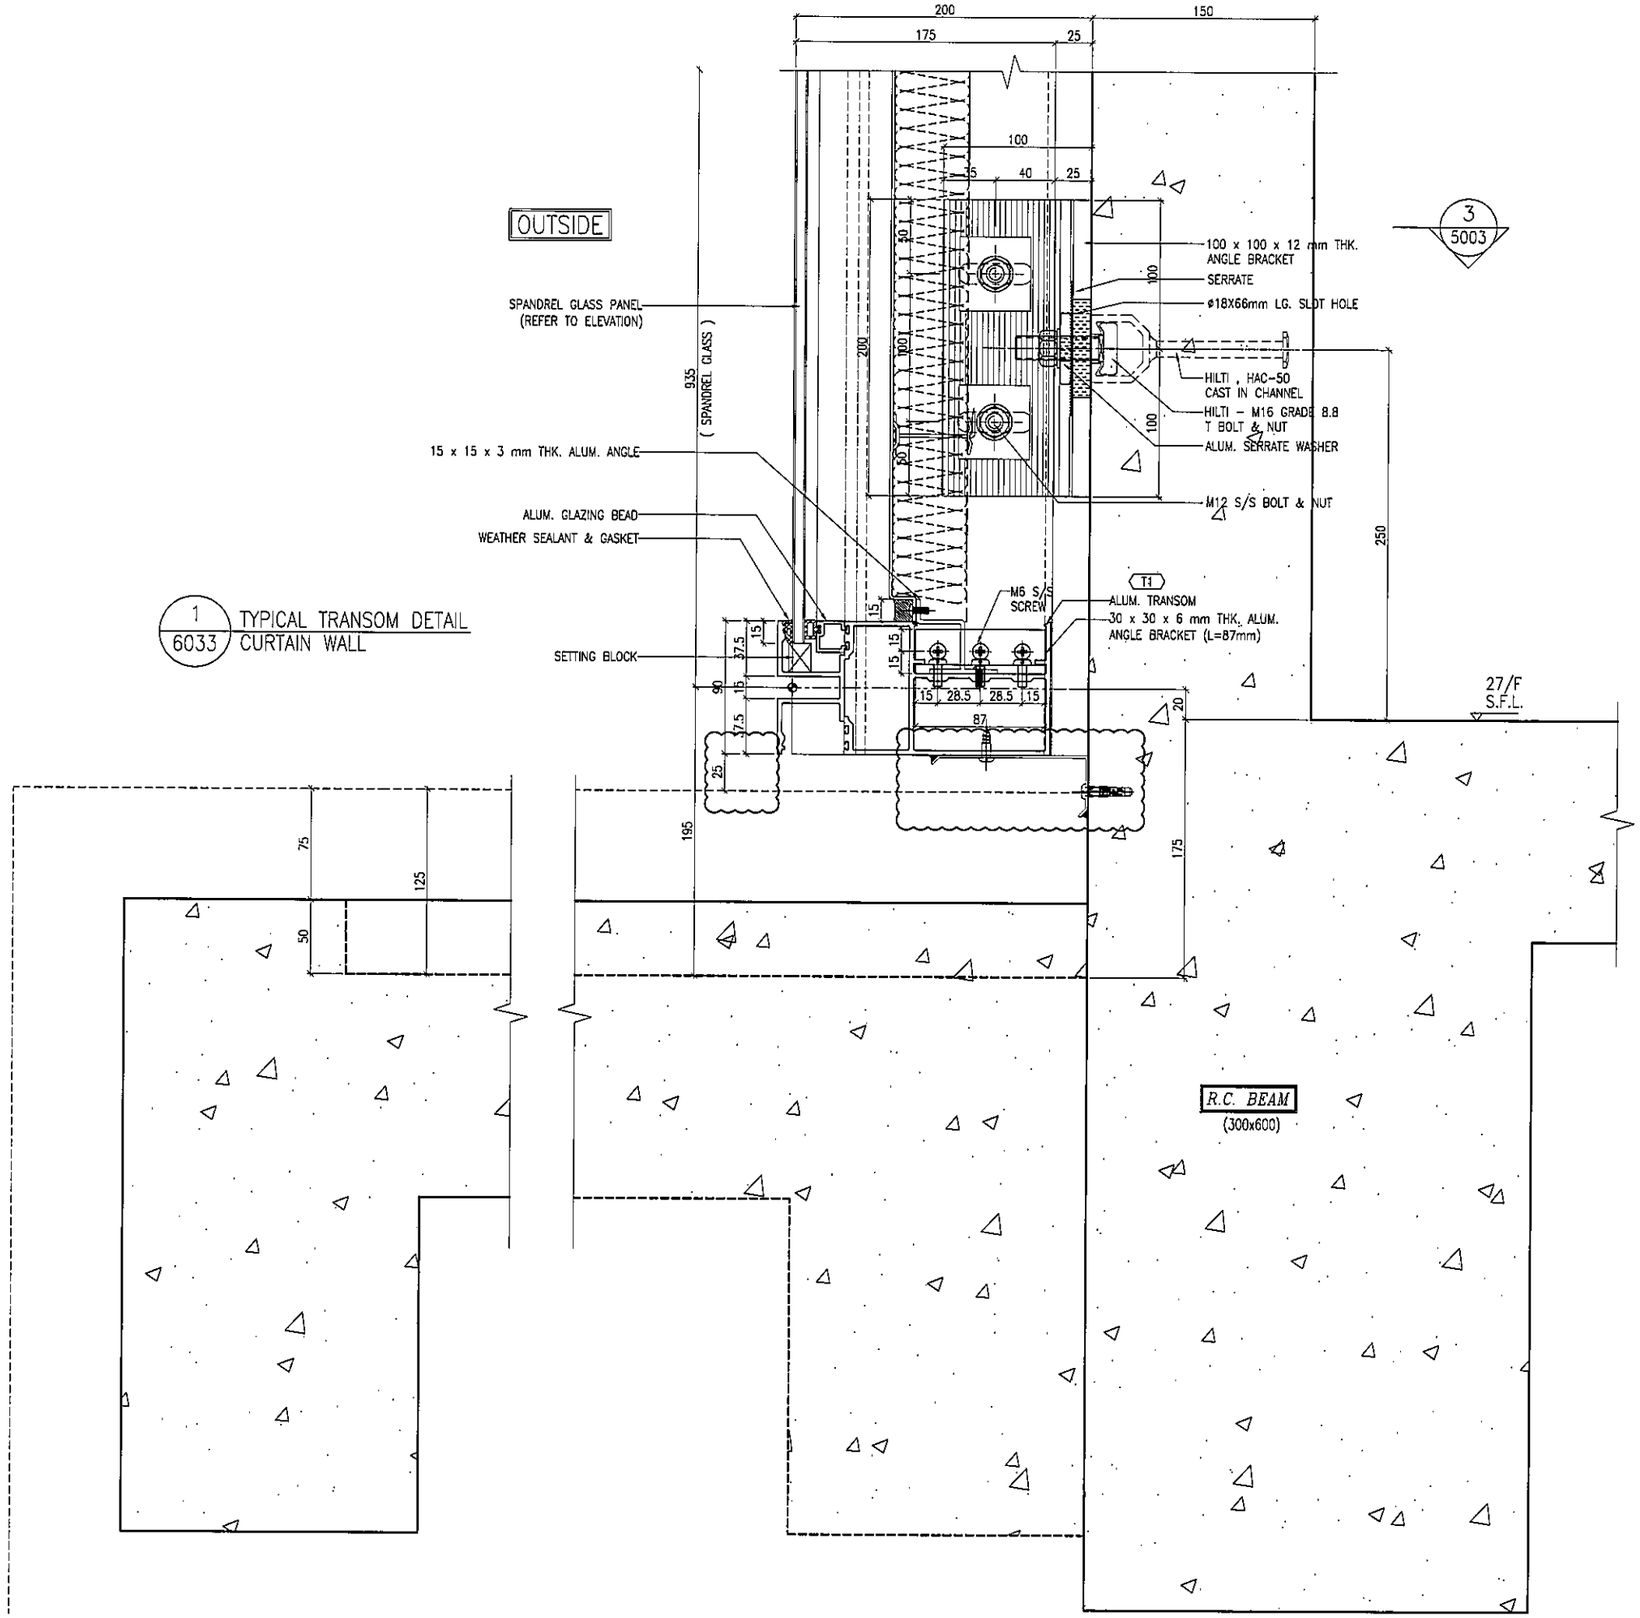

1 / 6033 TYPICAL TRANSOM DETAIL
CURTAIN WALL

B.D. REF :

CLIENT :
信和置業有限公司
Sino Land Company Limited

ARCHITECT :
WONG TUNG & PARTNERS LIMITED
ARCHITECTS & PLANNERS

MAIN CONTRACTOR :
CR Construction Company Limited

STRUCTURAL ENGINEER :
AECOM

FACADE CONSULTANT:
AECOM

NOTE :
1. ALL DIMENSIONS ARE IN mm.
2. ALL ELEVATIONS ARE VIEWED FROM OUTSIDE.
3. ALL DIMENSIONS TO BE VERIFIED ON SITE BEFORE FABRICATION.

LEGEND :
X1 / X001 — DETAIL MARK NO. / REFER SHEET NO.
1. F.F.L. --FINISHED FLOOR LEVEL
2. S.F.L. --STRUCTURAL FLOOR LEVEL
3. /R --REVERSED DETAIL

NO.	DATE	REVISED	BY
A	01/04/2019	GENERAL REVISED	

JOB NO. : J-837

PROJECT :
URA KWUN TONG TOWN CENTRE
REDEVELOPMENT (AREA 2 & 3) AT
NKIL 6514, KWUN TONG, KWLOON

TITLE :
TYPICAL TRANSOM DETAIL
FOR CURTAIN WALL

DATE : 13-JUL-18 | SCALE : 1:2 (A1)

DRAWN BY : ASING | CHECKED BY : -

美特鋁質有限公司
MIDI ALUMINIUM FABRICATOR LTD.
Units 6-8, Sunray Industrial Centre, 1/F
610 Cha Kwo Ling Road, Kowloon
Tel:23489211-4 Fax:(852)27727666

DWG NO. : J837-CW-6033 | REV. : A

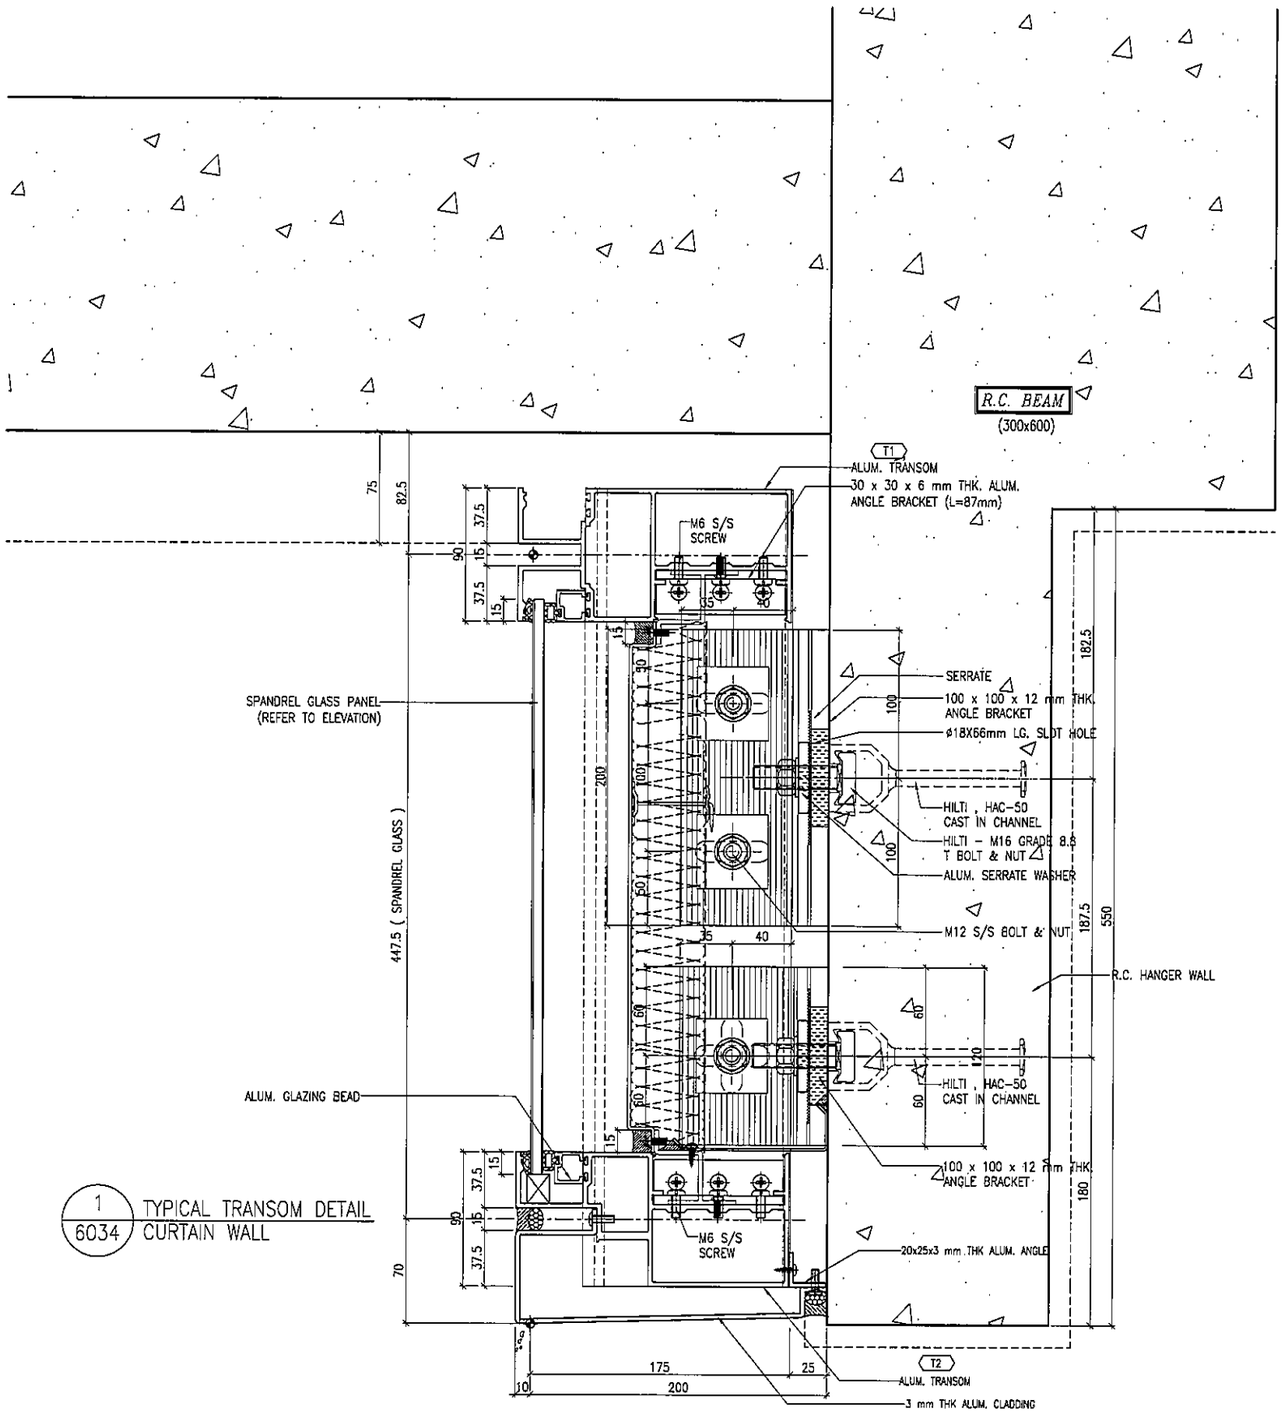

1/6034 TYPICAL TRANSOM DETAIL CURTAIN WALL

B.D. REF :

CLIENT :
信和置業有限公司
Sino Land Company Limited

ARCHITECT :
WONG TUNG & PARTNERS LIMITED
ARCHITECTS & PLANNERS

MAIN CONTRACTOR :
CR Construction Company Limited

STRUCTURAL ENGINEER :
AECOM

FACADE CONSULTANT:
AECOM

NOTE :
1. ALL DIMENSIONS ARE IN mm.
2. ALL ELEVATIONS ARE VIEWED FROM OUTSIDE.
3. ALL DIMENSIONS TO BE VERIFIED ON SITE BEFORE FABRICATION.

LEGEND :
X1 / X001 — DETAIL MARK NO. / REFER SHEET NO.
1. F.F.L. --FINISHED FLOOR LEVEL
2. S.F.L. --STRUCTURAL FLOOR LEVEL
3. (R) --REVERSED DETAIL

NO.	DATE	REVISED	BY

JOB NO. : J-837

PROJECT :
URA KWUN TONG TOWN CENTRE
REDEVELOPMENT (AREA 2 & 3) AT
NKIL 6514, KWUN TONG, KWLOON

TITLE :
TYPICAL TRANSOM DETAIL
FOR CURTAIN WALL

DATE : 13-JUL-18 | SCALE : 1:2 (A1)

DRAWN BY : ASING | CHECKED BY : -

美特鋁質有限公司
MIDI ALUMINIUM FABRICATOR LTD.
Units 6-8, Sunray Industrial Centre, 1/F
610 Cha Kwo Ling Road, Kowloon
Tel:23489211-4 Fax:(852)27727686

DWG NO. : J837-CW-6034 | REV. : -

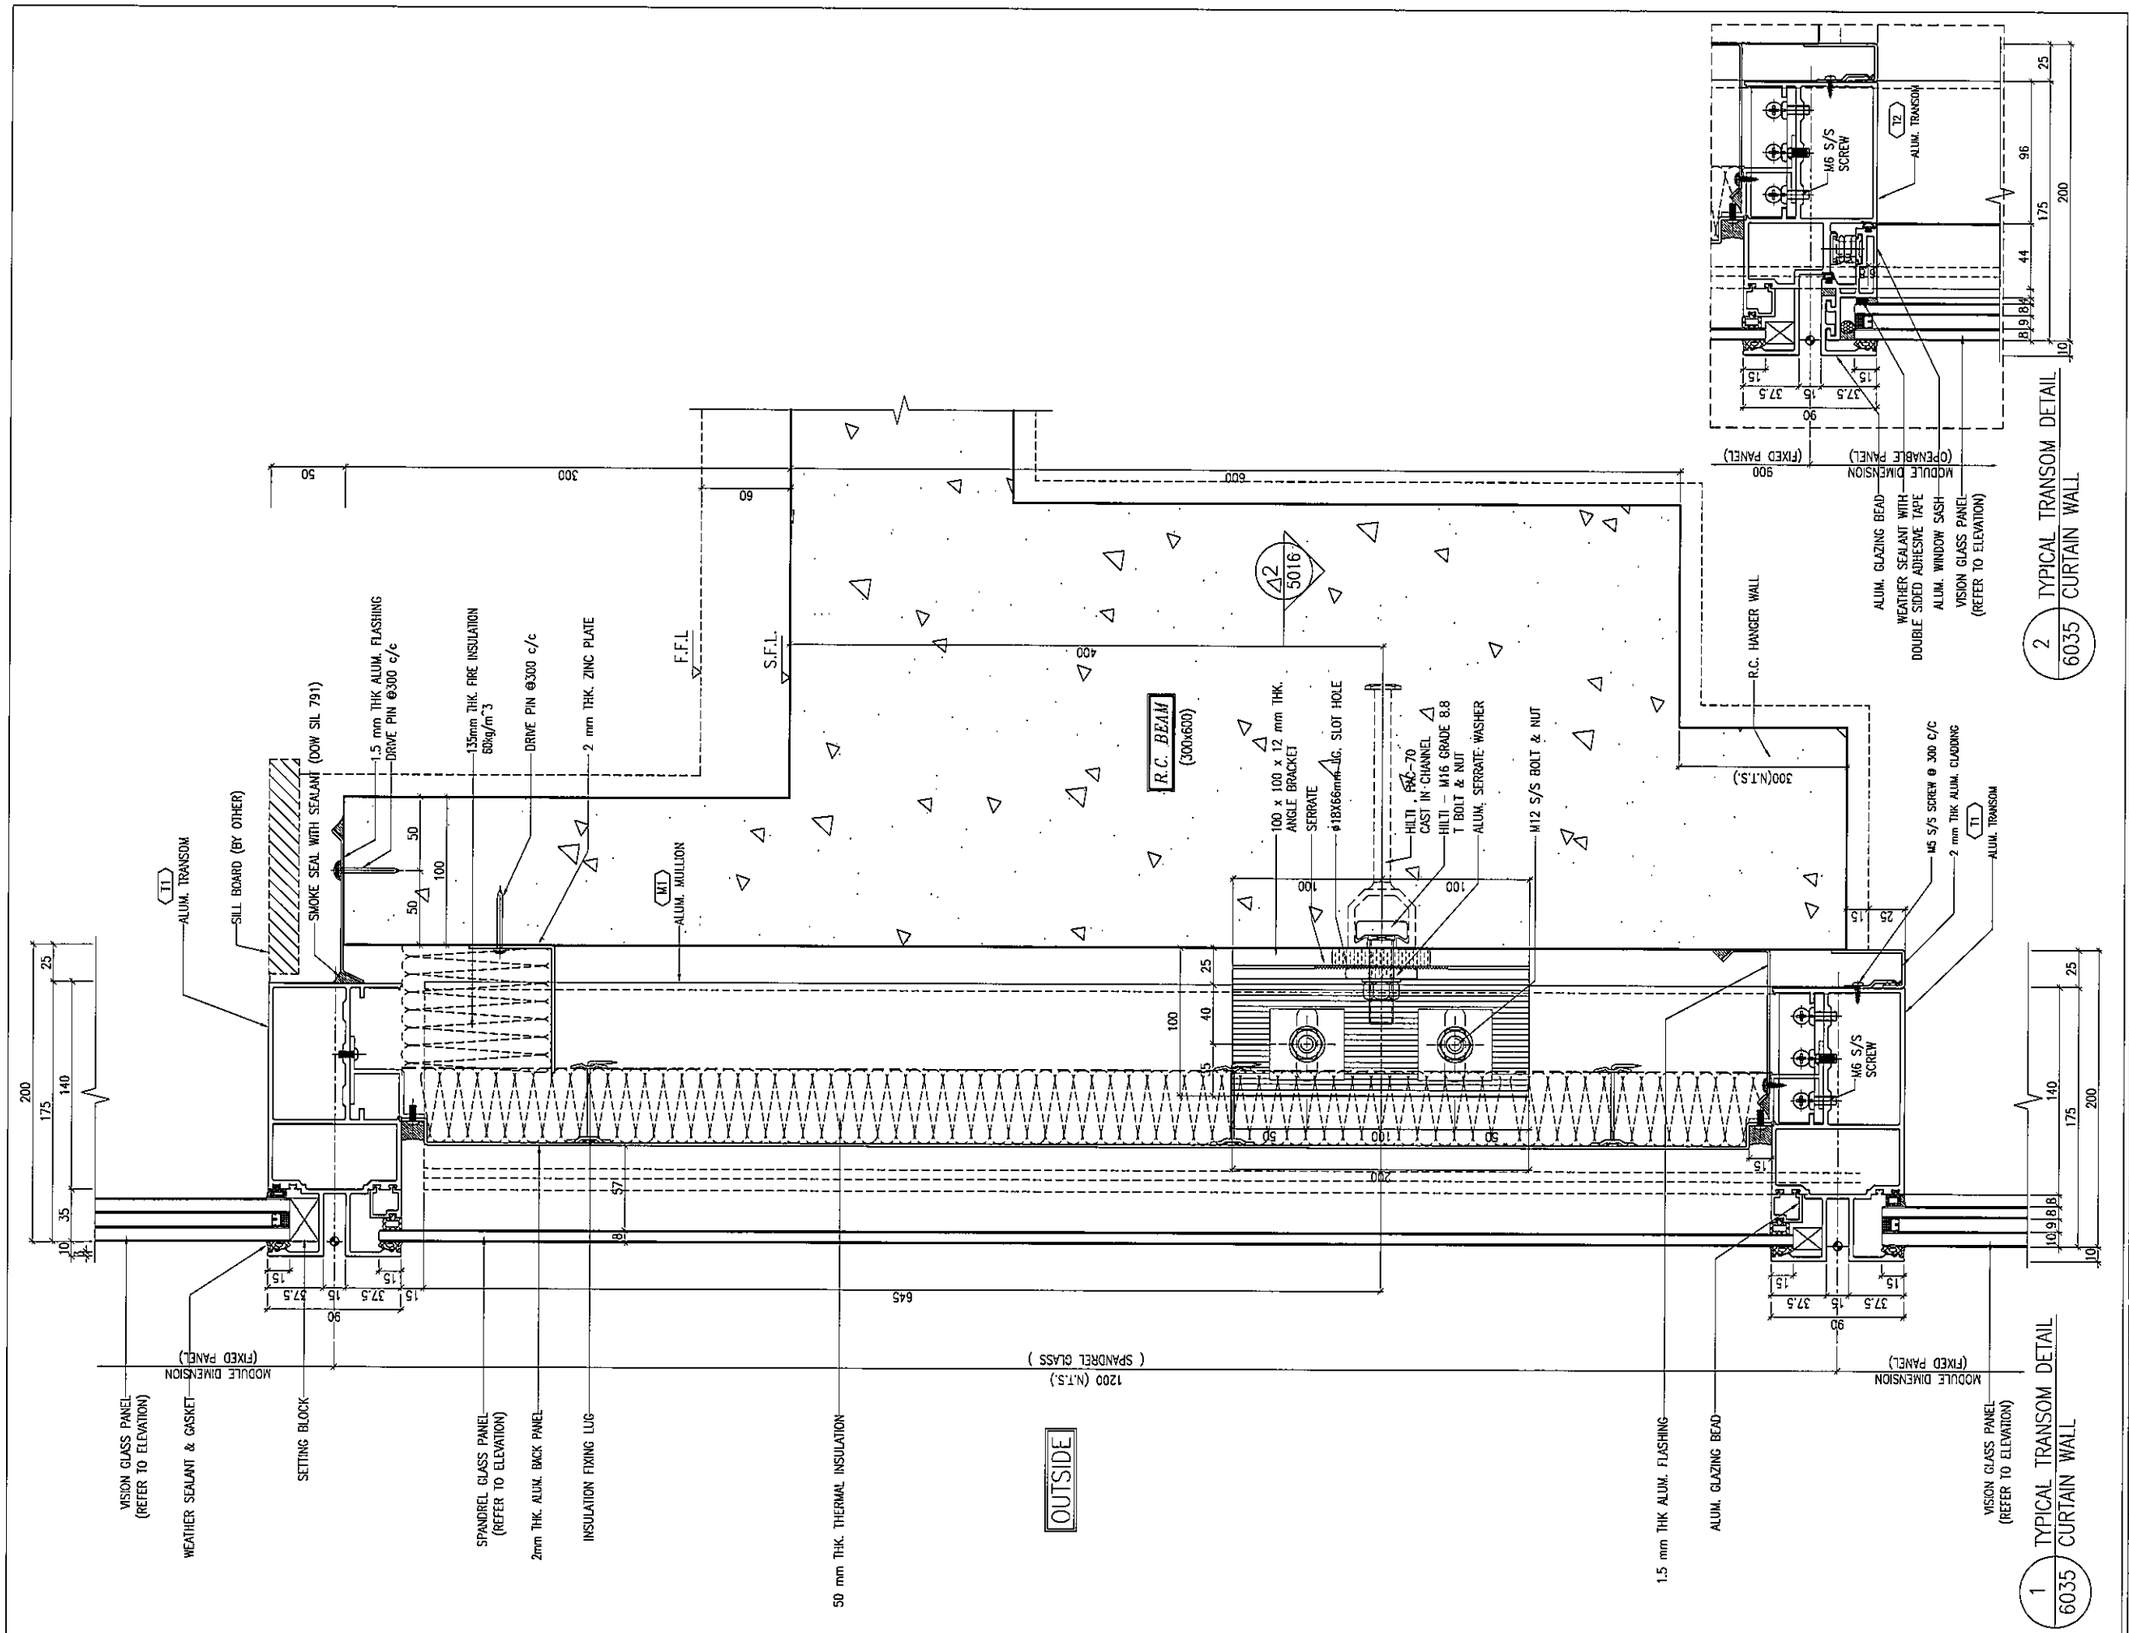

B.D. REF :

CLIENT :
信和置業有限公司
Sino Land Company Limited

ARCHITECT :
WONG TUNG & PARTNERS LIMITED
ARCHITECTS & PLANNERS

MAIN CONTRACTOR :
CR Construction Company Limited

STRUCTURAL ENGINEER :
AECOM

FACADE CONSULTANT:
AECOM

NOTE :
1. ALL DIMENSIONS ARE IN mm.
2. ALL ELEVATIONS ARE VIEWED FROM OUTSIDE.
3. ALL DIMENSIONS TO BE VERIFIED ON SITE BEFORE FABRICATION.

LEGEND :
- X1 / X001 — DETAIL MARK NO. / REFER SHEET NO.
1. F.F.L. --FINISHED FLOOR LEVEL
2. S.F.L. --STRUCTURAL FLOOR LEVEL
3. /R --REVERSED DETAIL

NO.	DATE	REVISED	BY

JOB NO. : J-837

PROJECT :
URA KWUN TONG TOWN CENTRE REDEVELOPMENT (AREA 2 & 3) AT NKIL 6514, KWUN TONG, KWLOON

TITLE :
TYPICAL TRANSOM DETAIL FOR CURTAIN WALL

DATE : 28-JAN-19	SCALE : 1:2 (A1)
DRAWN BY : ASING	CHECKED BY : -

美特鋁製有限公司
MIDI ALUMINIUM FABRICATOR LTD.
Units 6-8, Sunray Industrial Centre, 1/F
610 Cha Kwo Ling Road, Kowloon
Tel:23489211-4 Fax:(852)27727666

DWG NO. : J837-CW-6035 | REV. : -

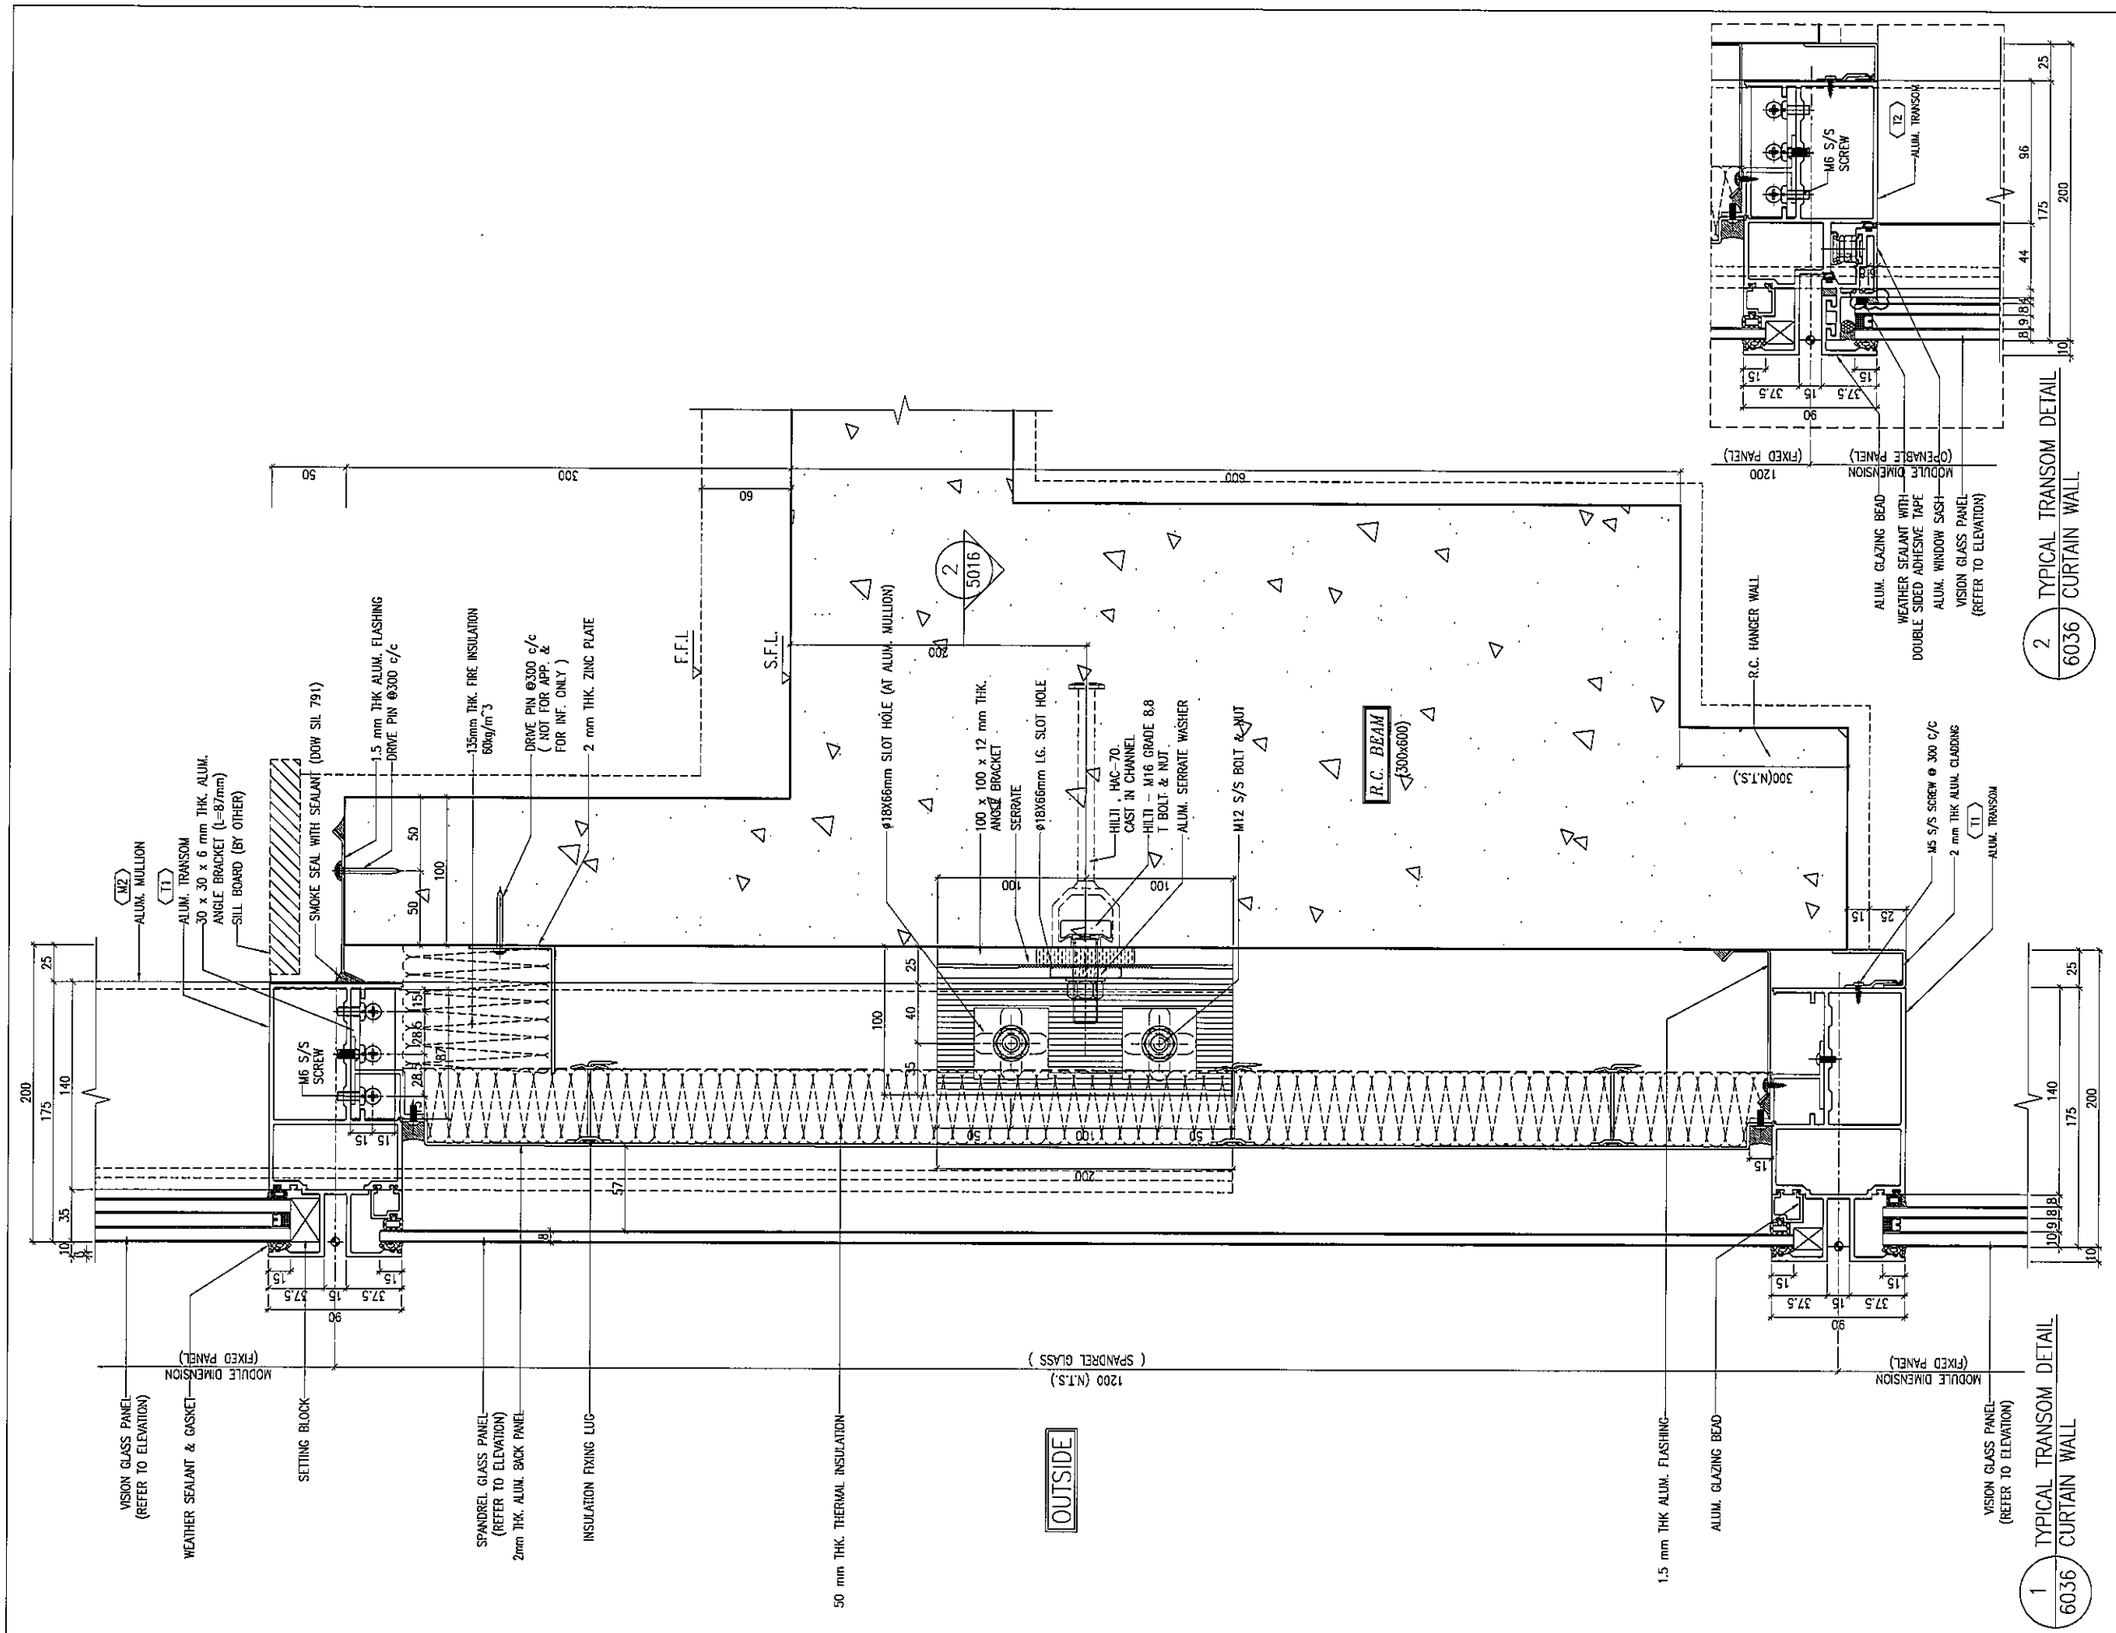

B.D. REF :

CLIENT :
信和置業有限公司
Sino Land Company Limited

ARCHITECT : WONG TUNG & PARTNERS LIMITED
ARCHITECTS & PLANNERS

MAIN CONTRACTOR :
CR Construction Company Limited

STRUCTURAL ENGINEER :
AECOM

FACADE CONSULTANT:
AECOM

NOTE :
1. ALL DIMENSIONS ARE IN mm.
2. ALL ELEVATIONS ARE VIEWED FROM OUTSIDE.
3. ALL DIMENSIONS TO BE VERIFIED ON SITE BEFORE FABRICATION.

LEGEND :
- (X1 / XD01) — DETAIL MARK NO. / REFER SHEET NO.
1. F.F.L. --FINISHED FLOOR LEVEL
2. S.F.L. --STRUCTURAL FLOOR LEVEL
3. (/R) --REVERSED DETAIL

NO.	DATE	REVISED	BY

JOB NO. : J-837

PROJECT :
URA KWUN TONG TOWN CENTRE REDEVELOPMENT (AREA 2 & 3) AT NKIL 6514, KWUN TONG, KWLOON

TITLE :
TYPICAL TRANSOM DETAIL FOR CURTAIN WALL

DATE : 28-JAN-19	SCALE : 1:2 (A1)
DRAWN BY : ASING	CHECKED BY : -

美特鋁質有限公司
MIDI ALUMINIUM FABRICATOR LTD.
Units 6-8, Sunray Industrial Centre, 1/F
610 Cha Kwo Ling Road, Kowloon
Tel:23489211-4 Fax:(852)27727666

DWG NO. : J837-CW-6036 | REV. : -

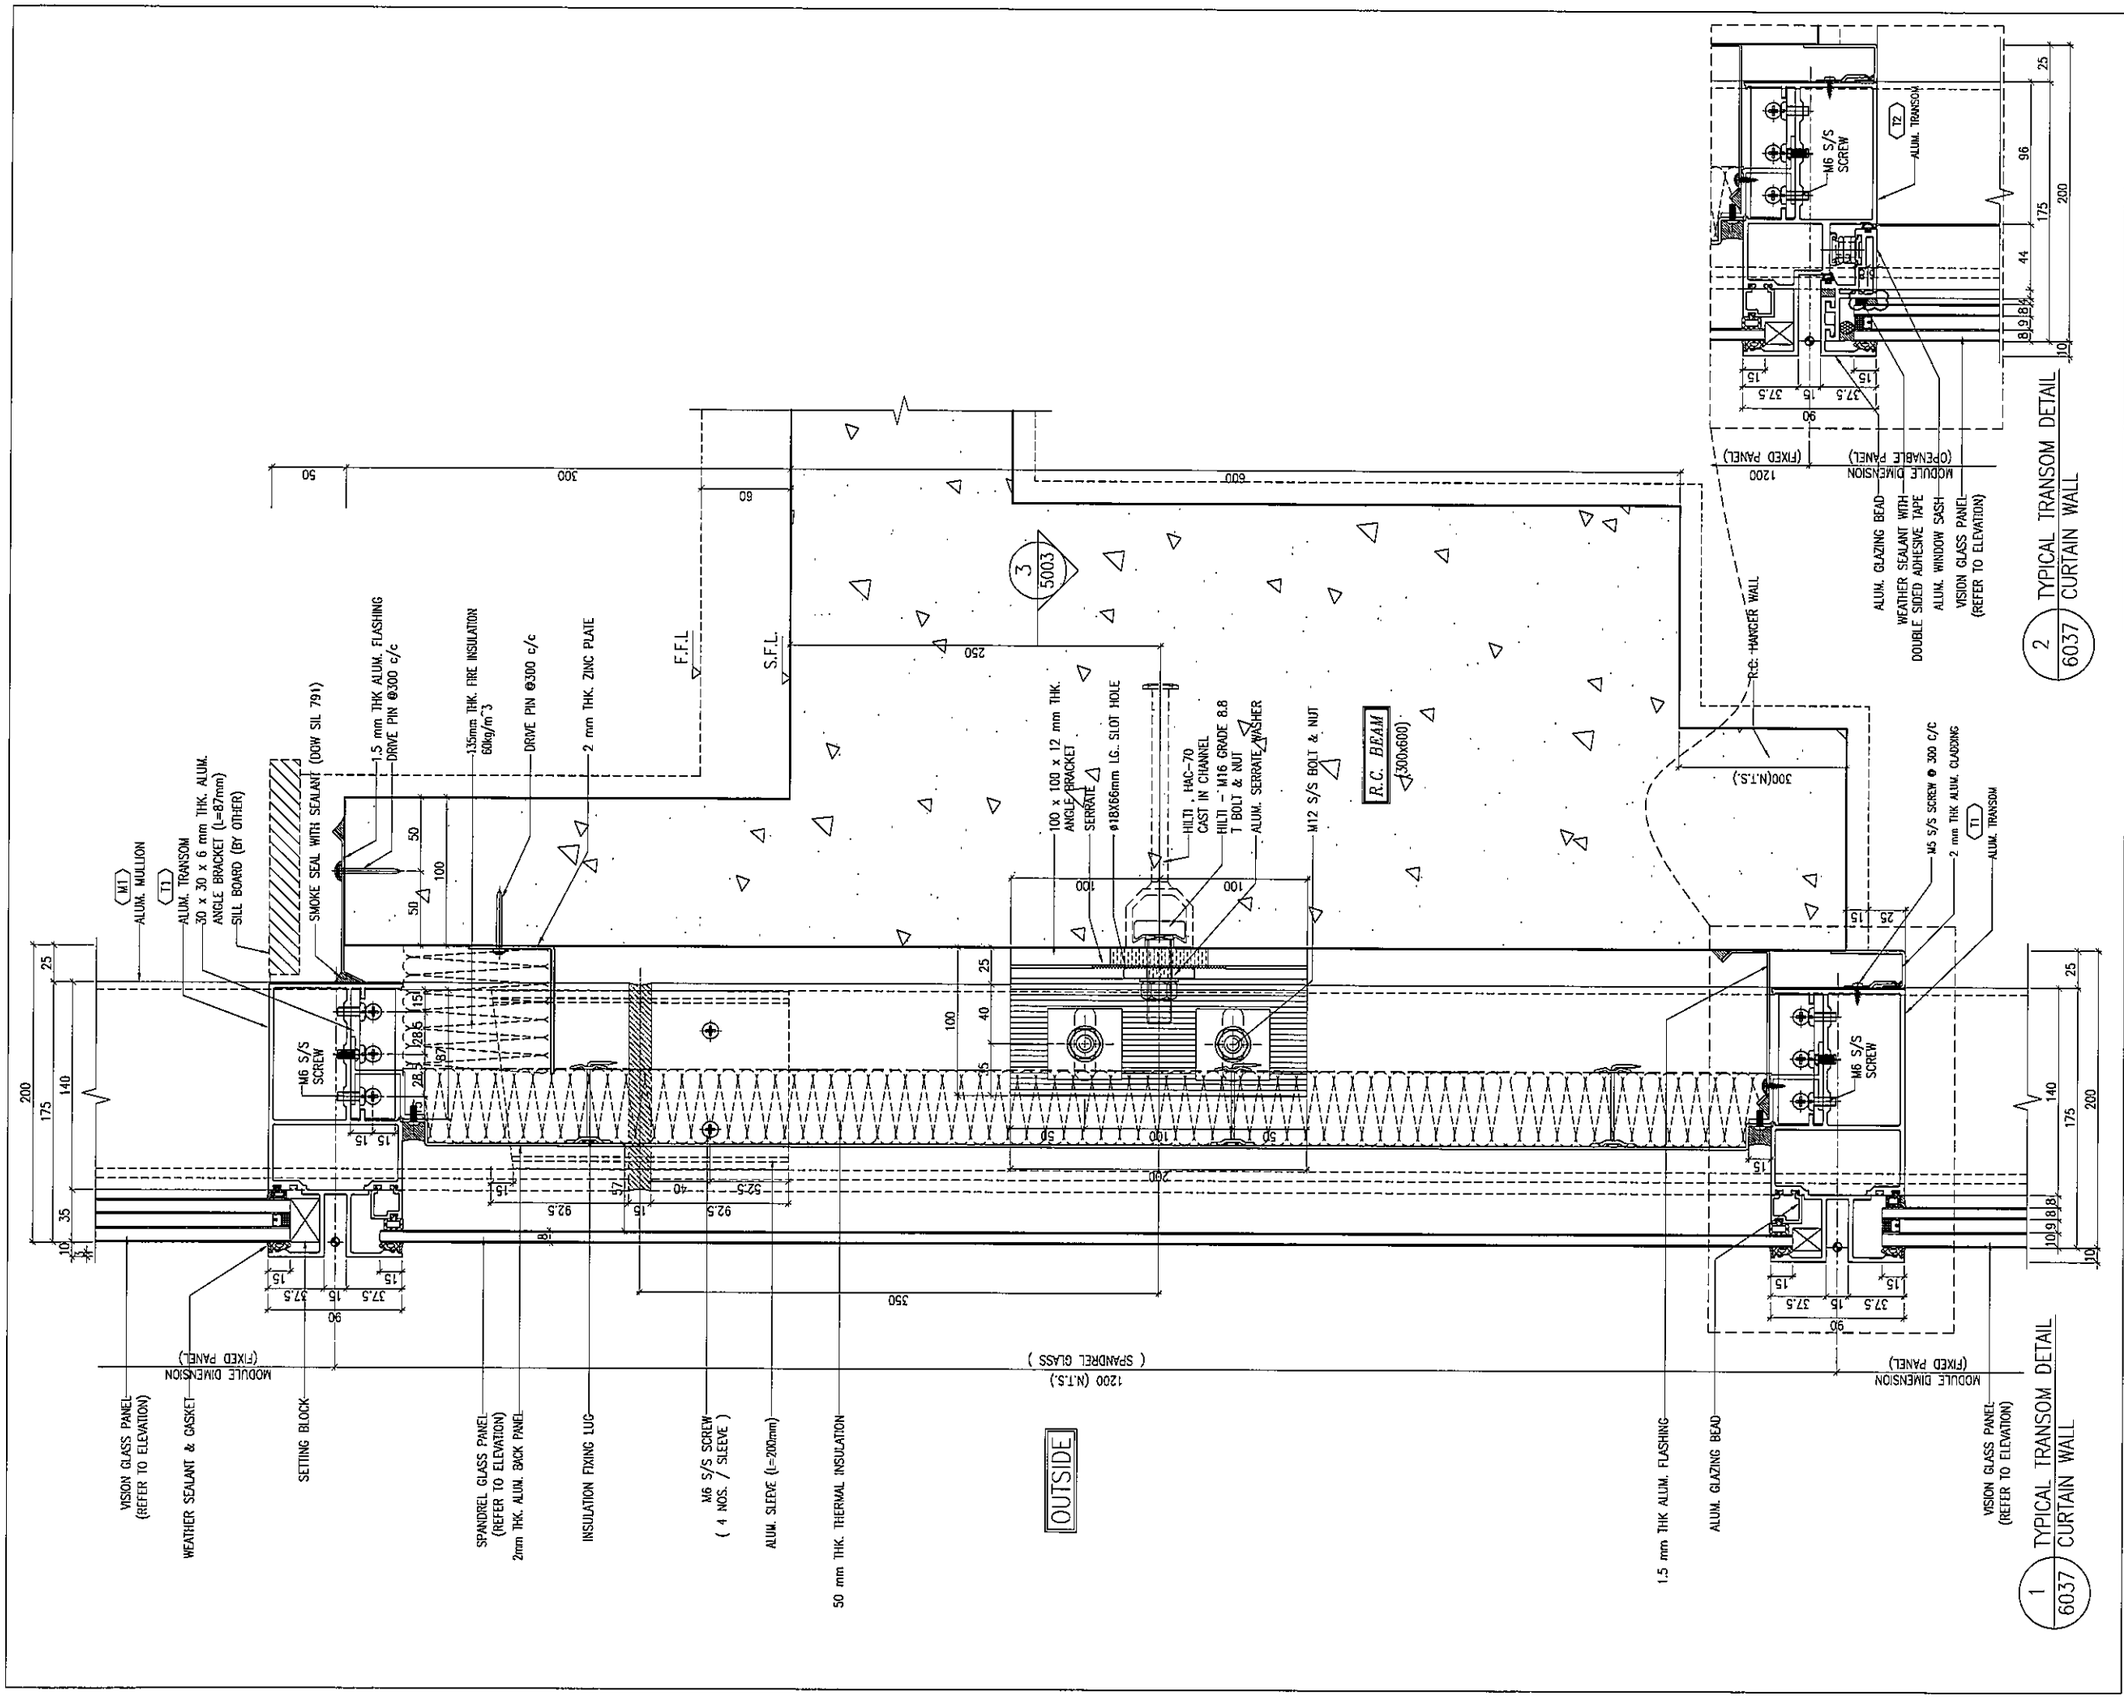

B.D. REF :

CLIENT :
信和置業有限公司
Sino Land Company Limited

ARCHITECT :
WONG TUNG & PARTNERS LIMITED
ARCHITECTS & PLANNERS

MAIN CONTRACTOR :
CR Construction Company Limited

STRUCTURAL ENGINEER :
AECOM

FACADE CONSULTANT:
AECOM

NOTE :
1. ALL DIMENSIONS ARE IN mm.
2. ALL ELEVATIONS ARE VIEWED FROM OUTSIDE.
3. ALL DIMENSIONS TO BE VERIFIED ON SITE BEFORE FABRICATION.

LEGEND :
- (X1) / (XG01) — DETAIL MARK NO. / REFER SHEET NO.
1. F.F.L. --FINISHED FLOOR LEVEL
2. S.F.L. --STRUCTURAL FLOOR LEVEL
3. (/R) --REVERSED DETAIL

NO.	DATE	REVISED	BY

JOB NO. : J-837

PROJECT :
URA KWUN TONG TOWN CENTRE REDEVELOPMENT (AREA 2 & 3) AT NKIL 6514, KWUN TONG, KWLOON

TITLE :
TYPICAL TRANSOM DETAIL FOR CURTAIN WALL

DATE : 13-JUL-18	SCALE : 1:2 (A1)
DRAWN BY : ASING	CHECKED BY : -

美特鋁質有限公司
MIDI ALUMINIUM FABRICATOR LTD.
Units 6-8, Sunray Industrial Centre, 1/F
610 Cha Kwo Ling Road, Kowloon
Tel:23489211-4 Fax:(852)27727666

DWG NO. : J837-CW-6037 | REV. : -

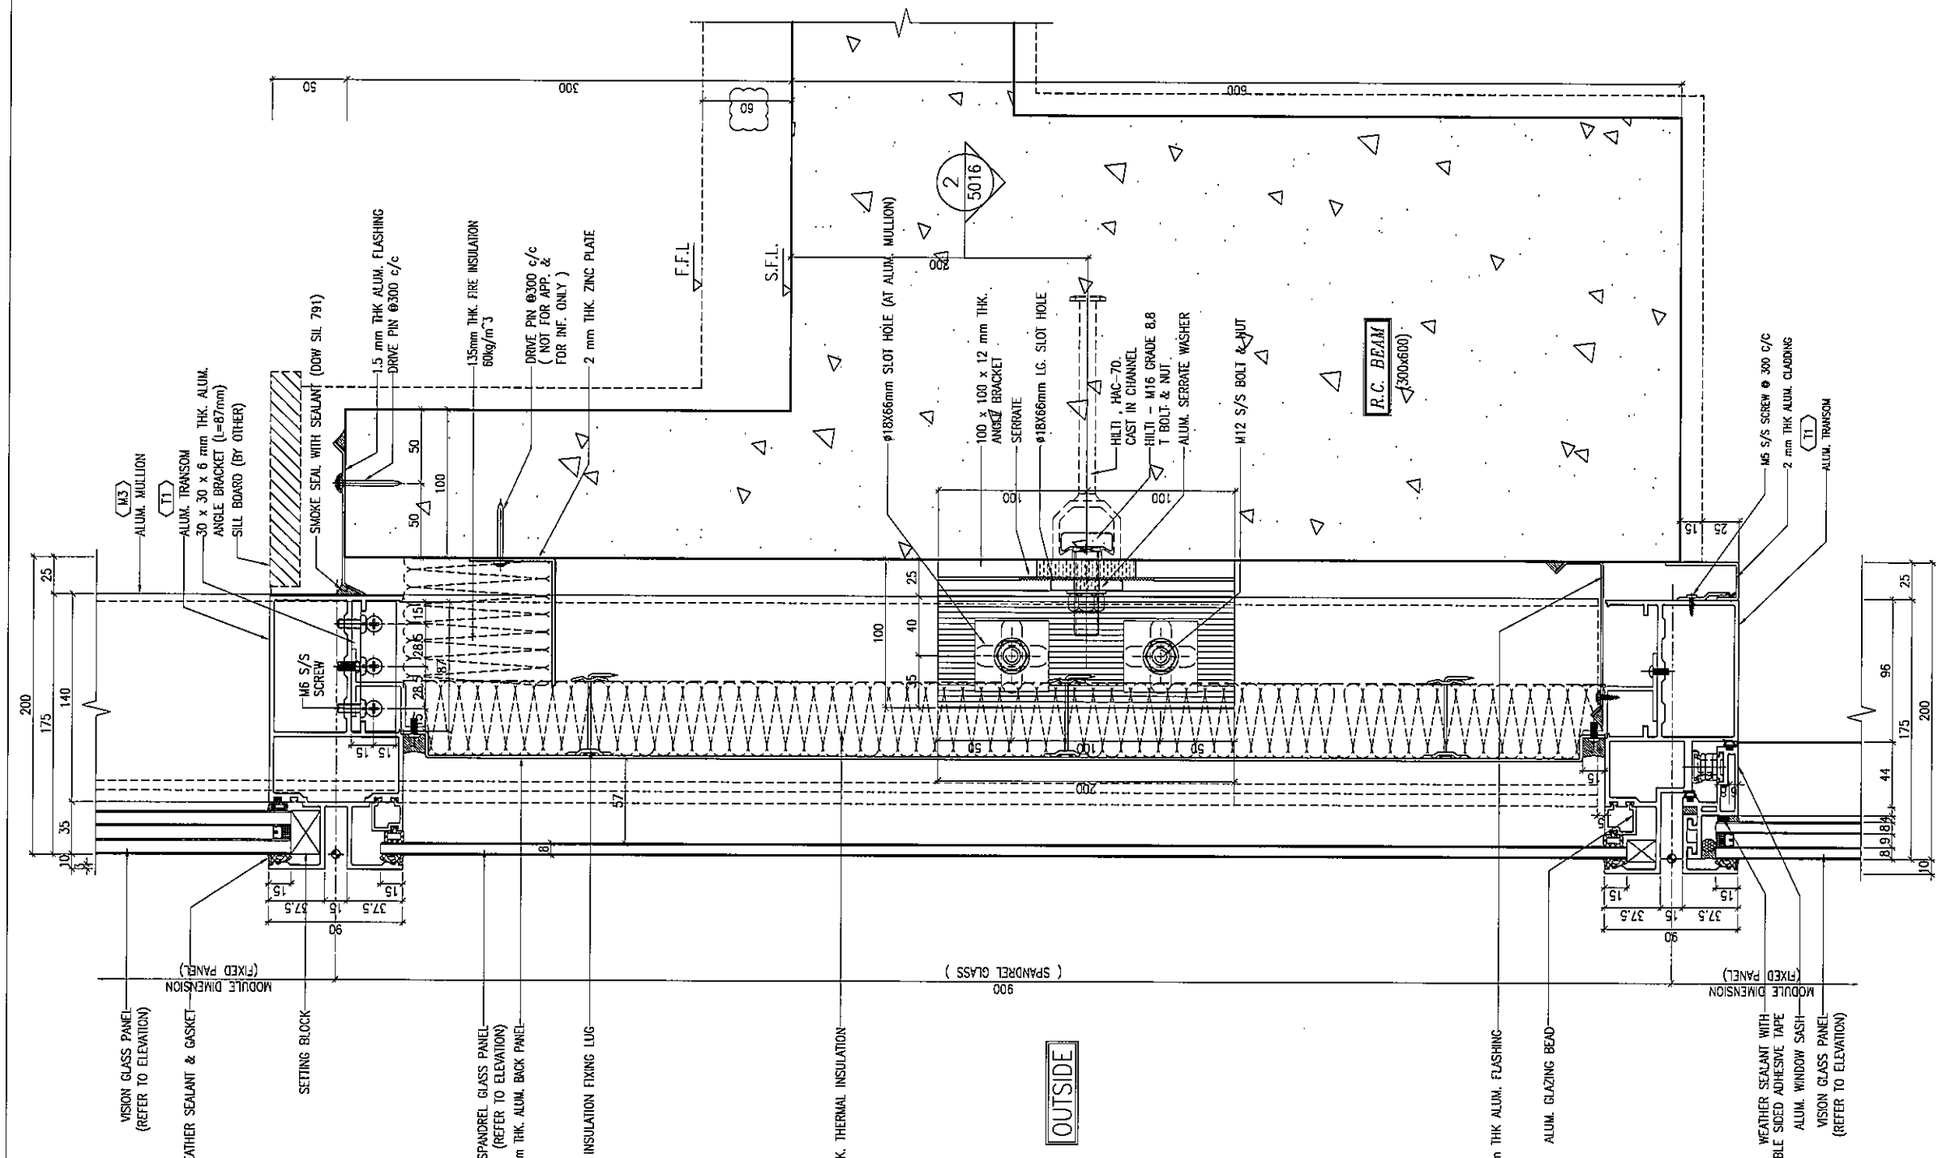

1 / 6026 TYPICAL TRANSOM DETAIL CURTAIN WALL

B.D. REF :

CLIENT :
信和置業有限公司
Sino Land Company Limited

ARCHITECT :
WONG TUNG & PARTNERS LIMITED
ARCHITECTS & PLANNERS

MAIN CONTRACTOR :
CR Construction Company Limited

STRUCTURAL ENGINEER :
AECOM

FACADE CONSULTANT:
AECOM

NOTE :
1. ALL DIMENSIONS ARE IN mm.
2. ALL ELEVATIONS ARE VIEWED FROM OUTSIDE.
3. ALL DIMENSIONS TO BE VERIFIED ON SITE BEFORE FABRICATION.

LEGEND :
X1 / XOD1 — DETAIL MARK NO. / REFER SHEET NO.
1. F.F.L. --FINISHED FLOOR LEVEL
2. S.F.L. --STRUCTURAL FLOOR LEVEL
3. /R --REVERSED DETAIL

NO.	DATE	REVISED	BY

JOB NO. : J-837

PROJECT :
URA KWUN TONG TOWN CENTRE REDEVELOPMENT (AREA 2 & 3) AT NKIL 6514, KWUN TONG, KWLOON

TITLE :
TYPICAL TRANSOM DETAIL FOR CURTAIN WALL

DATE : 24-MAR-19	SCALE : 1:2 (A1)
DRAWN BY : ASING	CHECKED BY : -

美特鋁質有限公司
MIDI ALUMINIUM FABRICATOR LTD.
Units 6-8, Sunray Industrial Centre, 1/F
610 Cha Kwo Ling Road, Kowloon
Tel:23489211-4 Fax:(852)27727666

DWG NO. : J837-CW-6038 REV. : -

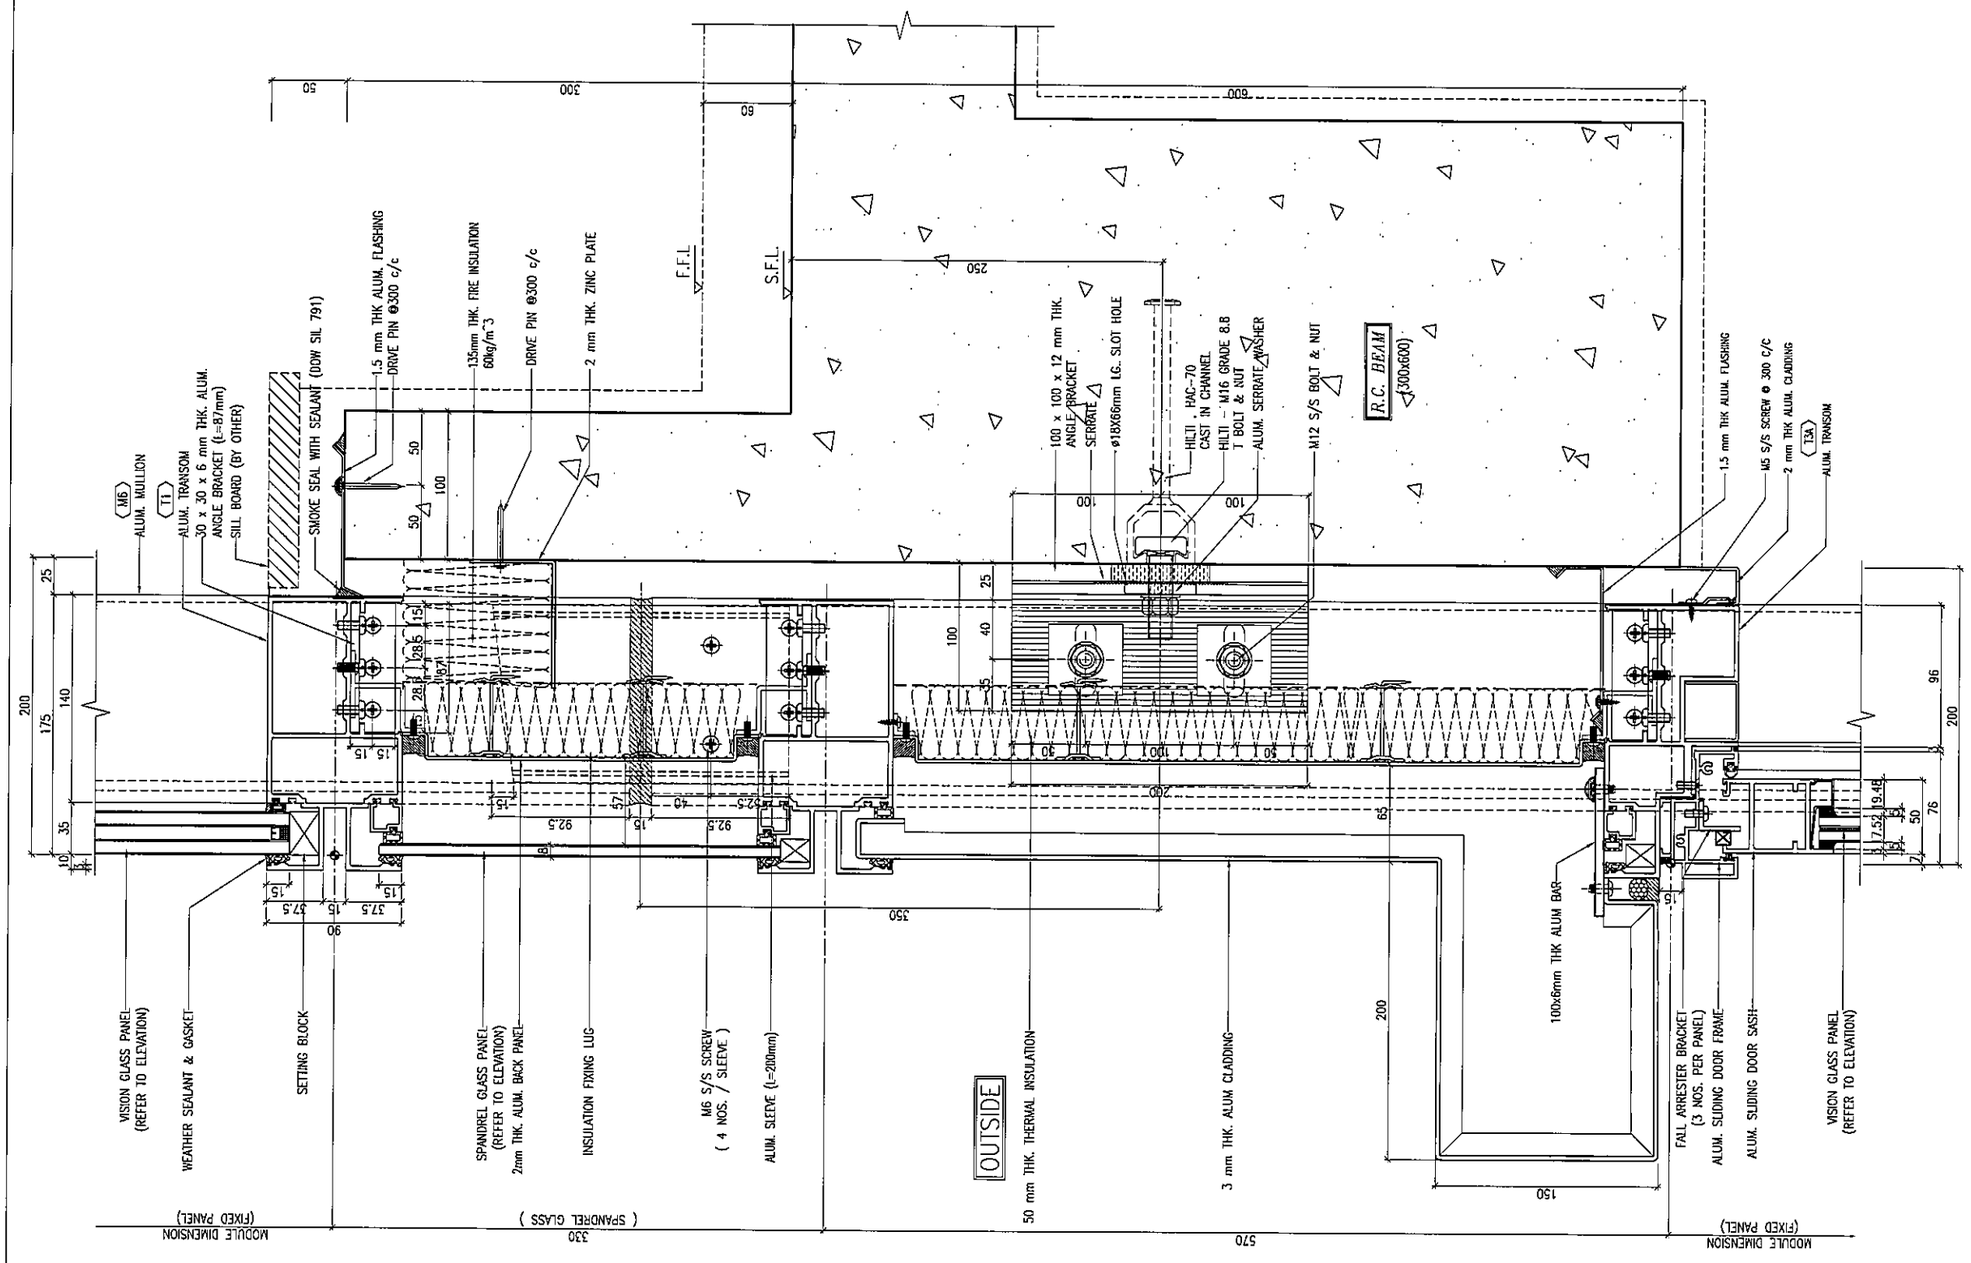

1 / 6039 TYPICAL TRANSOM DETAIL CURTAIN WALL

B.D. REF :

CLIENT :
信和置業有限公司
Sino Land Company Limited

ARCHITECT :
WONG TUNG & PARTNERS LIMITED
ARCHITECTS & PLANNERS

MAIN CONTRACTOR :
CR Construction Company Limited

STRUCTURAL ENGINEER :
AECOM

FACADE CONSULTANT:
AECOM

NOTE :
1. ALL DIMENSIONS ARE IN mm.
2. ALL ELEVATIONS ARE VIEWED FROM OUTSIDE.
3. ALL DIMENSIONS TO BE VERIFIED ON SITE BEFORE FABRICATION.

LEGEND :
X1 / X001 — DETAIL MARK NO. / REFER SHEET NO.
1. F.F.L. --FINISHED FLOOR LEVEL
2. S.F.L. --STRUCTURAL FLOOR LEVEL
3. /R --REVERSED DETAIL

NO.	DATE	REVISED	BY

JOB NO. : J-837

PROJECT :
URA KWUN TONG TOWN CENTRE REDEVELOPMENT (AREA 2 & 3) AT NKIL 6514, KWUN TONG, KWLOON

TITLE :
TYPICAL TRANSOM DETAIL FOR CURTAIN WALL

DATE : 13-JUN-19 | SCALE : 1:2 (A1)

DRAWN BY : ASING | CHECKED BY : -

美特鋁質有限公司
MIDI ALUMINIUM FABRICATOR LTD.
Units 6-8, Sunray Industrial Centre, 1/F
610 Cha Kwo Ling Road, Kowloon
Tel:23489211-4 Fax:(852)27727666

DWG NO. : J837-CW-6039 | REV. : -

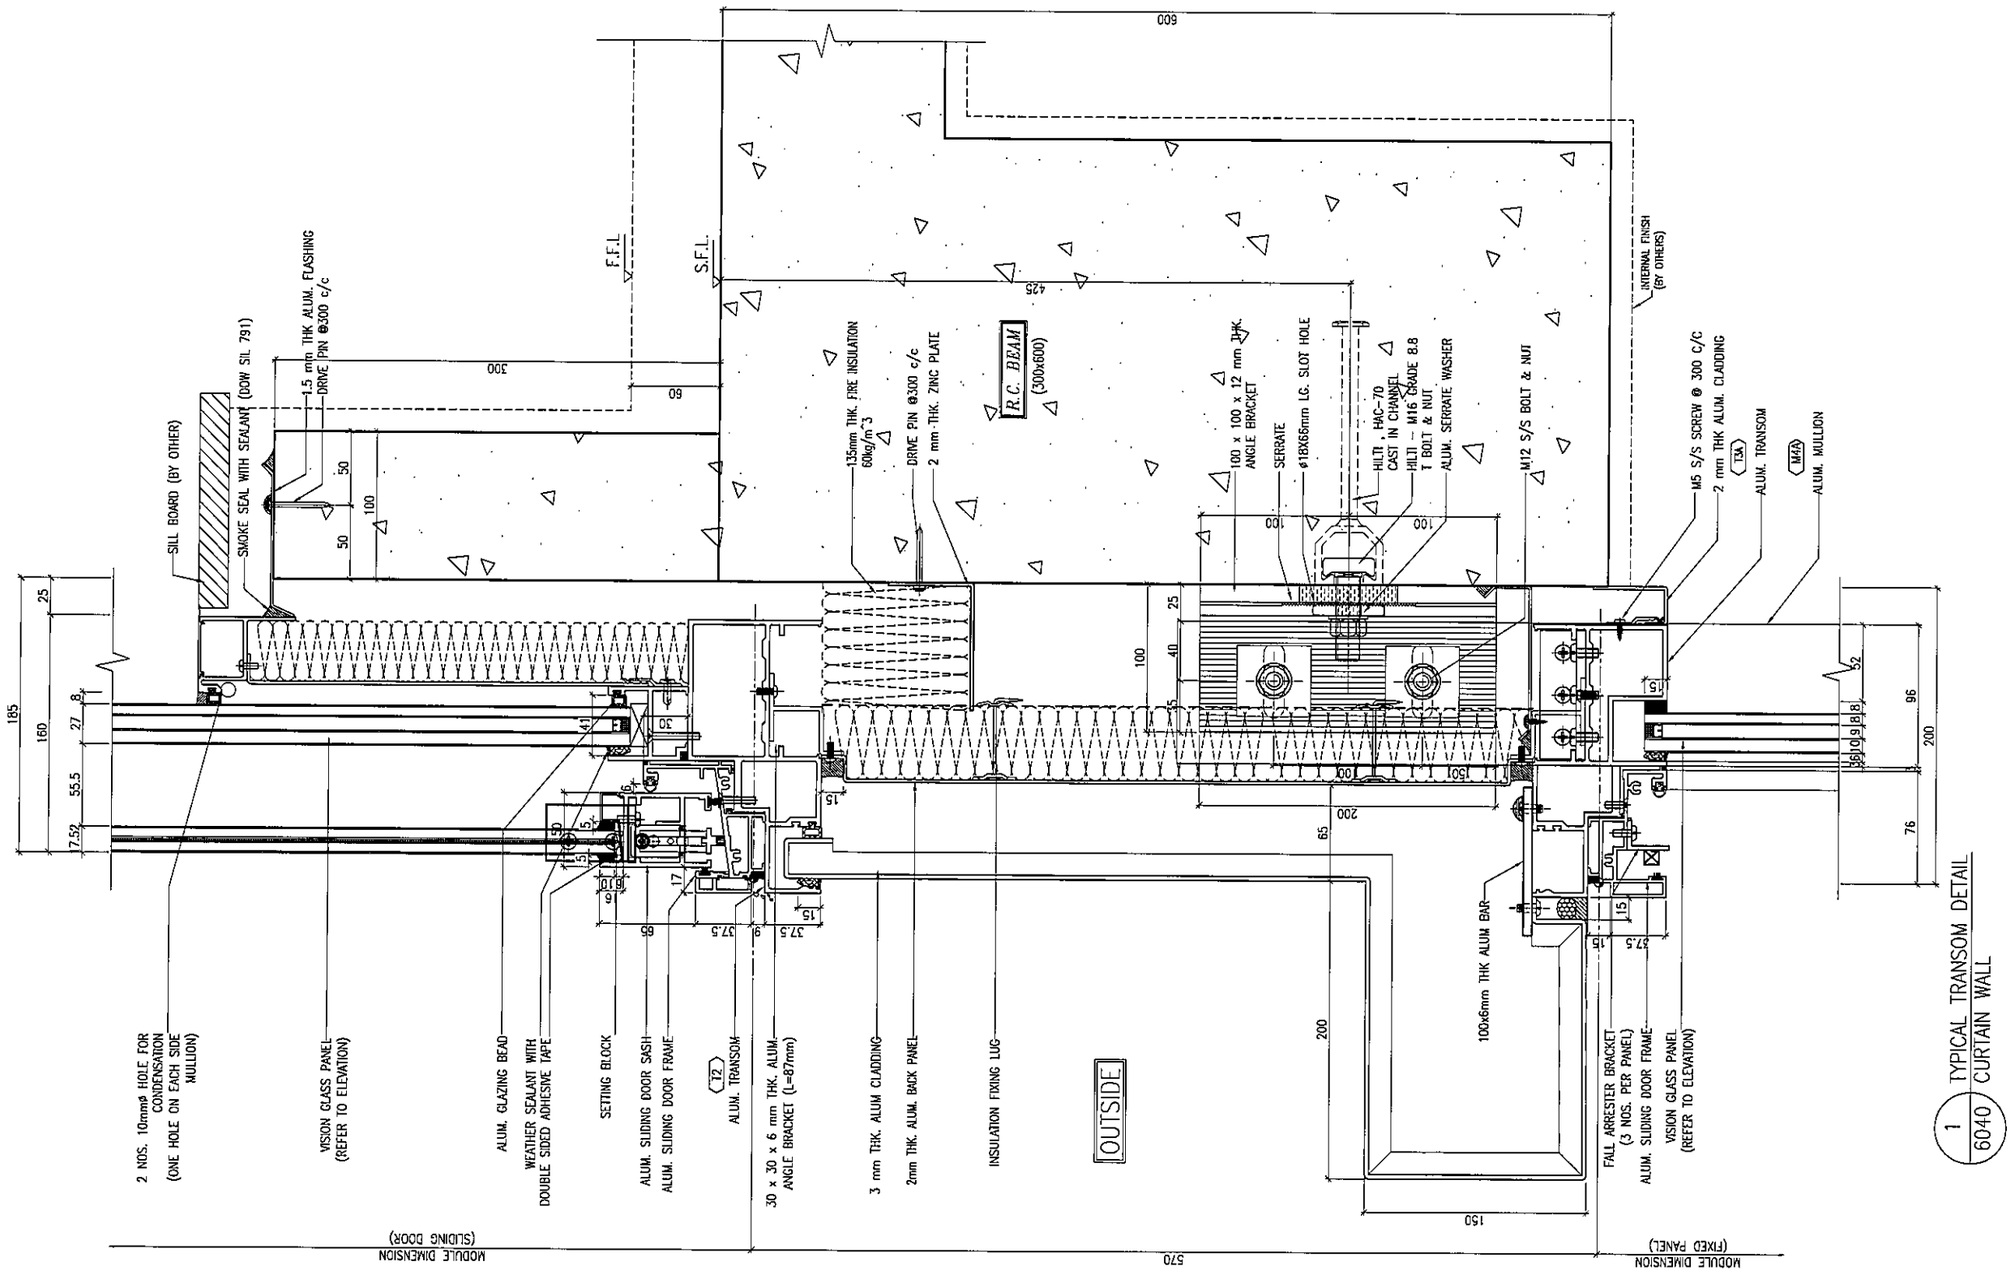

1/6040 TYPICAL TRANSOM DETAIL CURTAIN WALL

B.D. REF :

CLIENT :
信和置業有限公司
Sino Land Company Limited

ARCHITECT :
WONG TUNG & PARTNERS LIMITED
ARCHITECTS & PLANNERS

MAIN CONTRACTOR :
CR Construction Company Limited

STRUCTURAL ENGINEER :
AECOM

FACADE CONSULTANT:
AECOM

NOTE :
1. ALL DIMENSIONS ARE IN mm.
2. ALL ELEVATIONS ARE VIEWED FROM OUTSIDE.
3. ALL DIMENSIONS TO BE VERIFIED ON SITE BEFORE FABRICATION.

LEGEND :
X1 — DETAIL MARK NO.
X001 — REFER SHEET NO.

1. F.F.L. --FINISHED FLOOR LEVEL
2. S.F.L. --STRUCTURAL FLOOR LEVEL
3. /R --REVERSED DETAIL

NO.	DATE	REVISED	BY

JOB NO. : J-837

PROJECT :
URA KWUN TONG TOWN CENTRE REDEVELOPMENT (AREA 2 & 3) AT NKIL 6514, KWUN TONG, KWLOON

TITLE :
TYPICAL TRANSOM DETAIL FOR CURTAIN WALL

DATE : 13-JUN-19 | SCALE : 1:2 (A1)

DRAWN BY : ASING | CHECKED BY : --

美特鋁質有限公司
MIDI ALUMINIUM FABRICATOR LTD.
Units 6-8, Sunray Industrial Centre, 1/F
610 Cha Kwo Ling Road, Kowloon
Tel:23489211-4 Fax:(852)27727666

DWG NO. : J837-CW-6040 | REV. : --

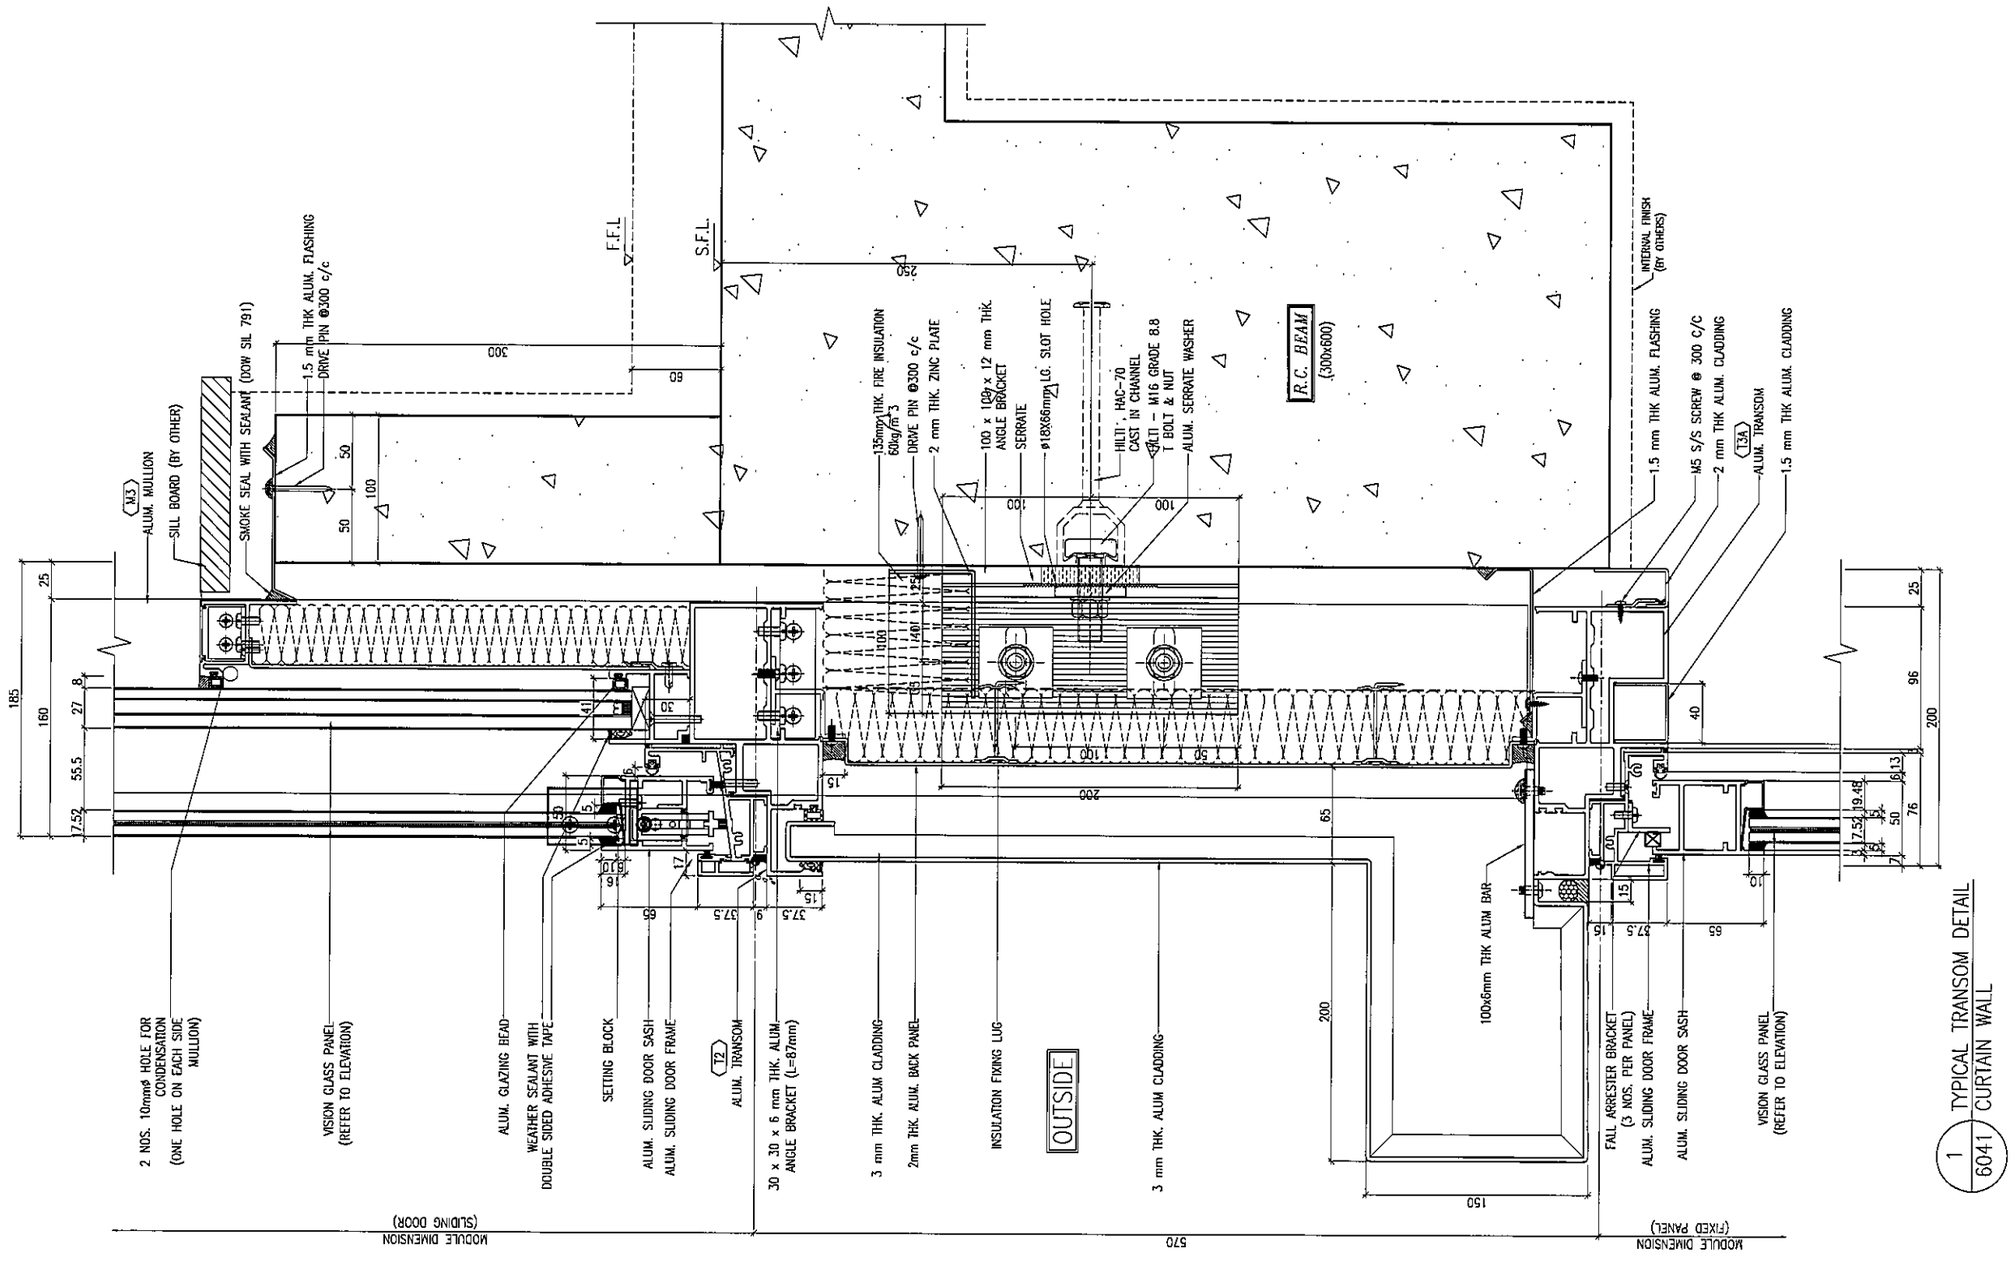

1 TYPICAL TRANSOM DETAIL
6041 CURTAIN WALL

B.D. REF :

CLIENT :
信和置業有限公司
Sino Land Company Limited

ARCHITECT :
WONG TUNG & PARTNERS LIMITED
ARCHITECTS & PLANNERS

MAIN CONTRACTOR :
CR Construction Company Limited

STRUCTURAL ENGINEER :
AECOM

FACADE CONSULTANT:
AECOM

NOTE :
1. ALL DIMENSIONS ARE IN mm.
2. ALL ELEVATIONS ARE VIEWED FROM OUTSIDE.
3. ALL DIMENSIONS TO BE VERIFIED ON SITE BEFORE FABRICATION.

LEGEND :
X1 — DETAIL MARK NO.
X001 — REFER SHEET NO.

1. F.F.L. --FINISHED FLOOR LEVEL
2. S.F.L. --STRUCTURAL FLOOR LEVEL
3. (R) --REVERSED DETAIL

NO.	DATE	REVISED	BY

JOB NO. : J-837

PROJECT :
URA KWUN TONG TOWN CENTRE REDEVELOPMENT (AREA 2 & 3) AT NKIL 6514, KWUN TONG, KWLOON

TITLE :
TYPICAL TRANSOM DETAIL FOR CURTAIN WALL

DATE : 13-JUN-19 | SCALE : 1:2 (A1)

DRAWN BY : ASING | CHECKED BY : -

美特鋁質有限公司
MIDI ALUMINIUM FABRICATOR LTD.
Units 6-8, Sunray Industrial Centre, 1/F
610 Cha Kwo Ling Road, Kowloon
Tel:23489211-4 Fax:(852)27727666

DWG NO. : J837-CW-6041 | REV. : -

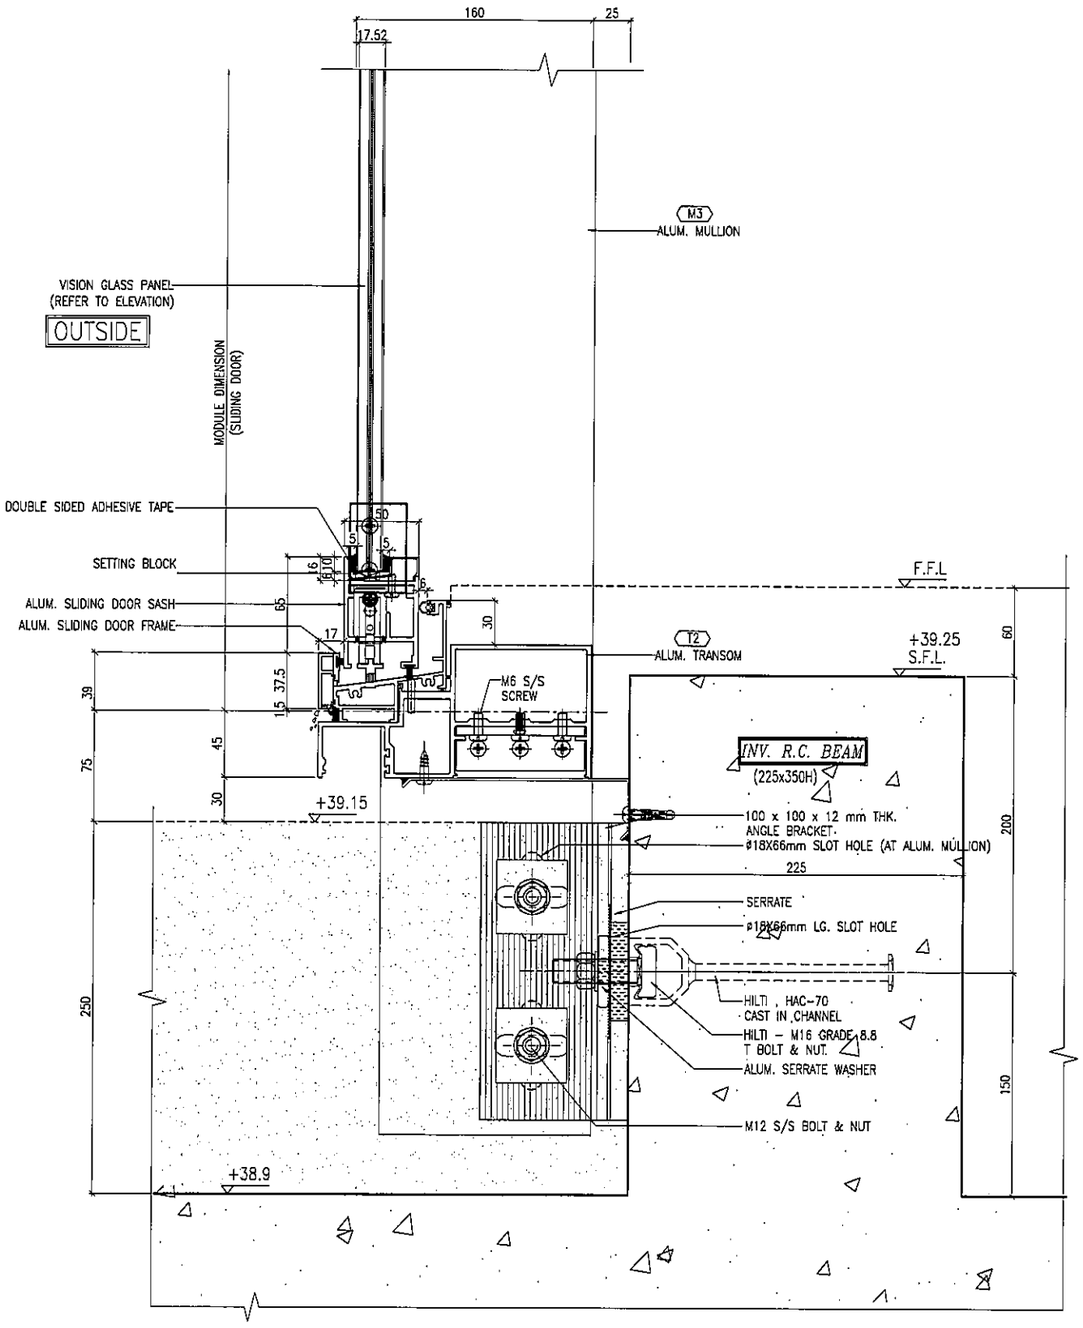

1 / 6042 TYPICAL TRANSOM DETAIL CURTAIN WALL

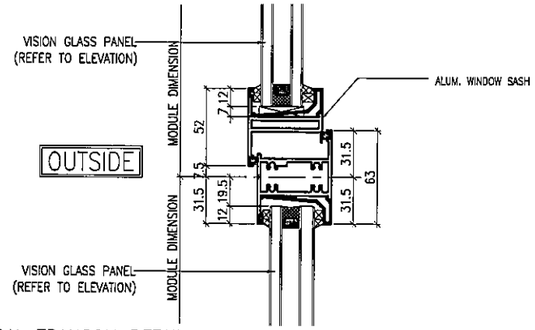

3 / 6042 TYPICAL TRANSOM DETAIL CURTAIN WALL

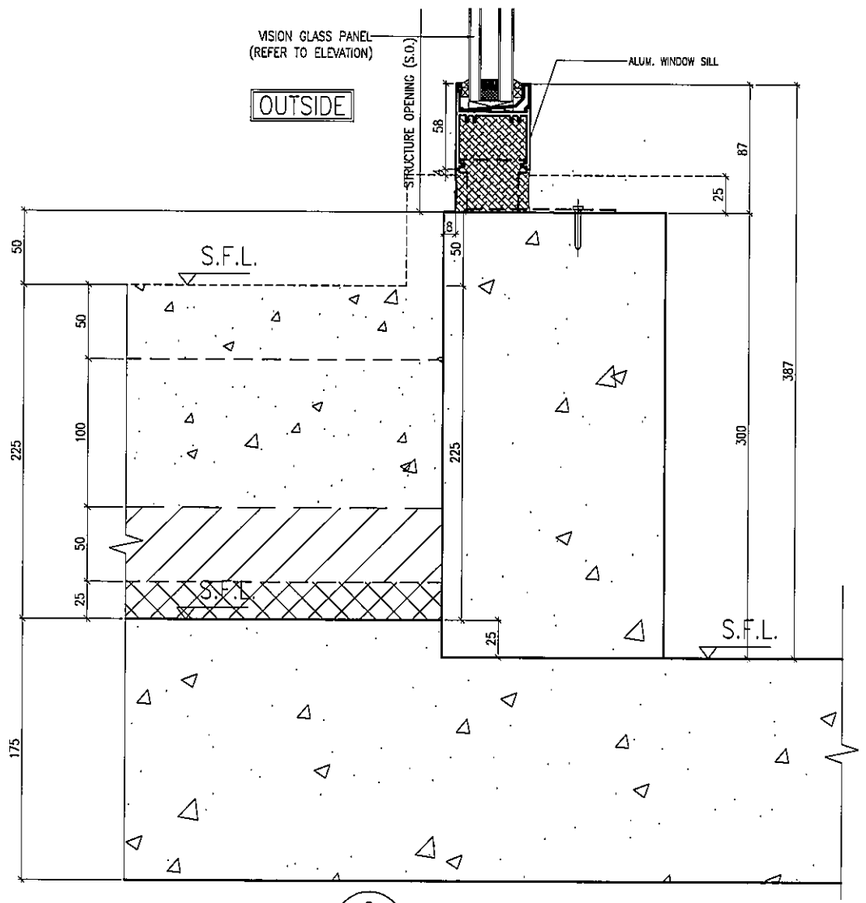

2 / 6042 TYPICAL TRANSOM DETAIL CURTAIN WALL

B.D. REF :

CLIENT :
信和置業有限公司
Sino Land Company Limited

ARCHITECT : WONG TUNG & PARTNERS LIMITED
ARCHITECTS & PLANNERS

MAIN CONTRACTOR :
CR Construction Company Limited

STRUCTURAL ENGINEER :
AECOM

FACADE CONSULTANT:
AECOM

NOTE :
1. ALL DIMENSIONS ARE IN mm.
2. ALL ELEVATIONS ARE VIEWED FROM OUTSIDE.
3. ALL DIMENSIONS TO BE VERIFIED ON SITE BEFORE FABRICATION.

LEGEND :
X1 / X001 — DETAIL MARK NO. / REFER SHEET NO.
1. F.F.L. --FINISHED FLOOR LEVEL
2. S.F.L. --STRUCTURAL FLOOR LEVEL
3. /R --REVERSED DETAIL

NO.	DATE	REVISED	BY

JOB NO. : J-837

PROJECT :
URA KWUN TONG TOWN CENTRE REDEVELOPMENT (AREA 2 & 3) AT NKIL 6514, KWUN TONG, KWLOON

TITLE :
TYPICAL TRANSOM DETAIL FOR CURTAIN WALL

DATE : 13-JUN-19	SCALE : 1:2 (A1)
DRAWN BY : ASING	CHECKED BY : -

美特鋁質有限公司
MIDI ALUMINIUM FABRICATOR LTD.
Units 6-8, Sunrey Industrial Centre, 1/F
610 Cha Kwo Ling Road, Kowloon
Tel:23489211-4 Fax:(852)27727666

DWG NO. : J837-CW-6042 REV. : -

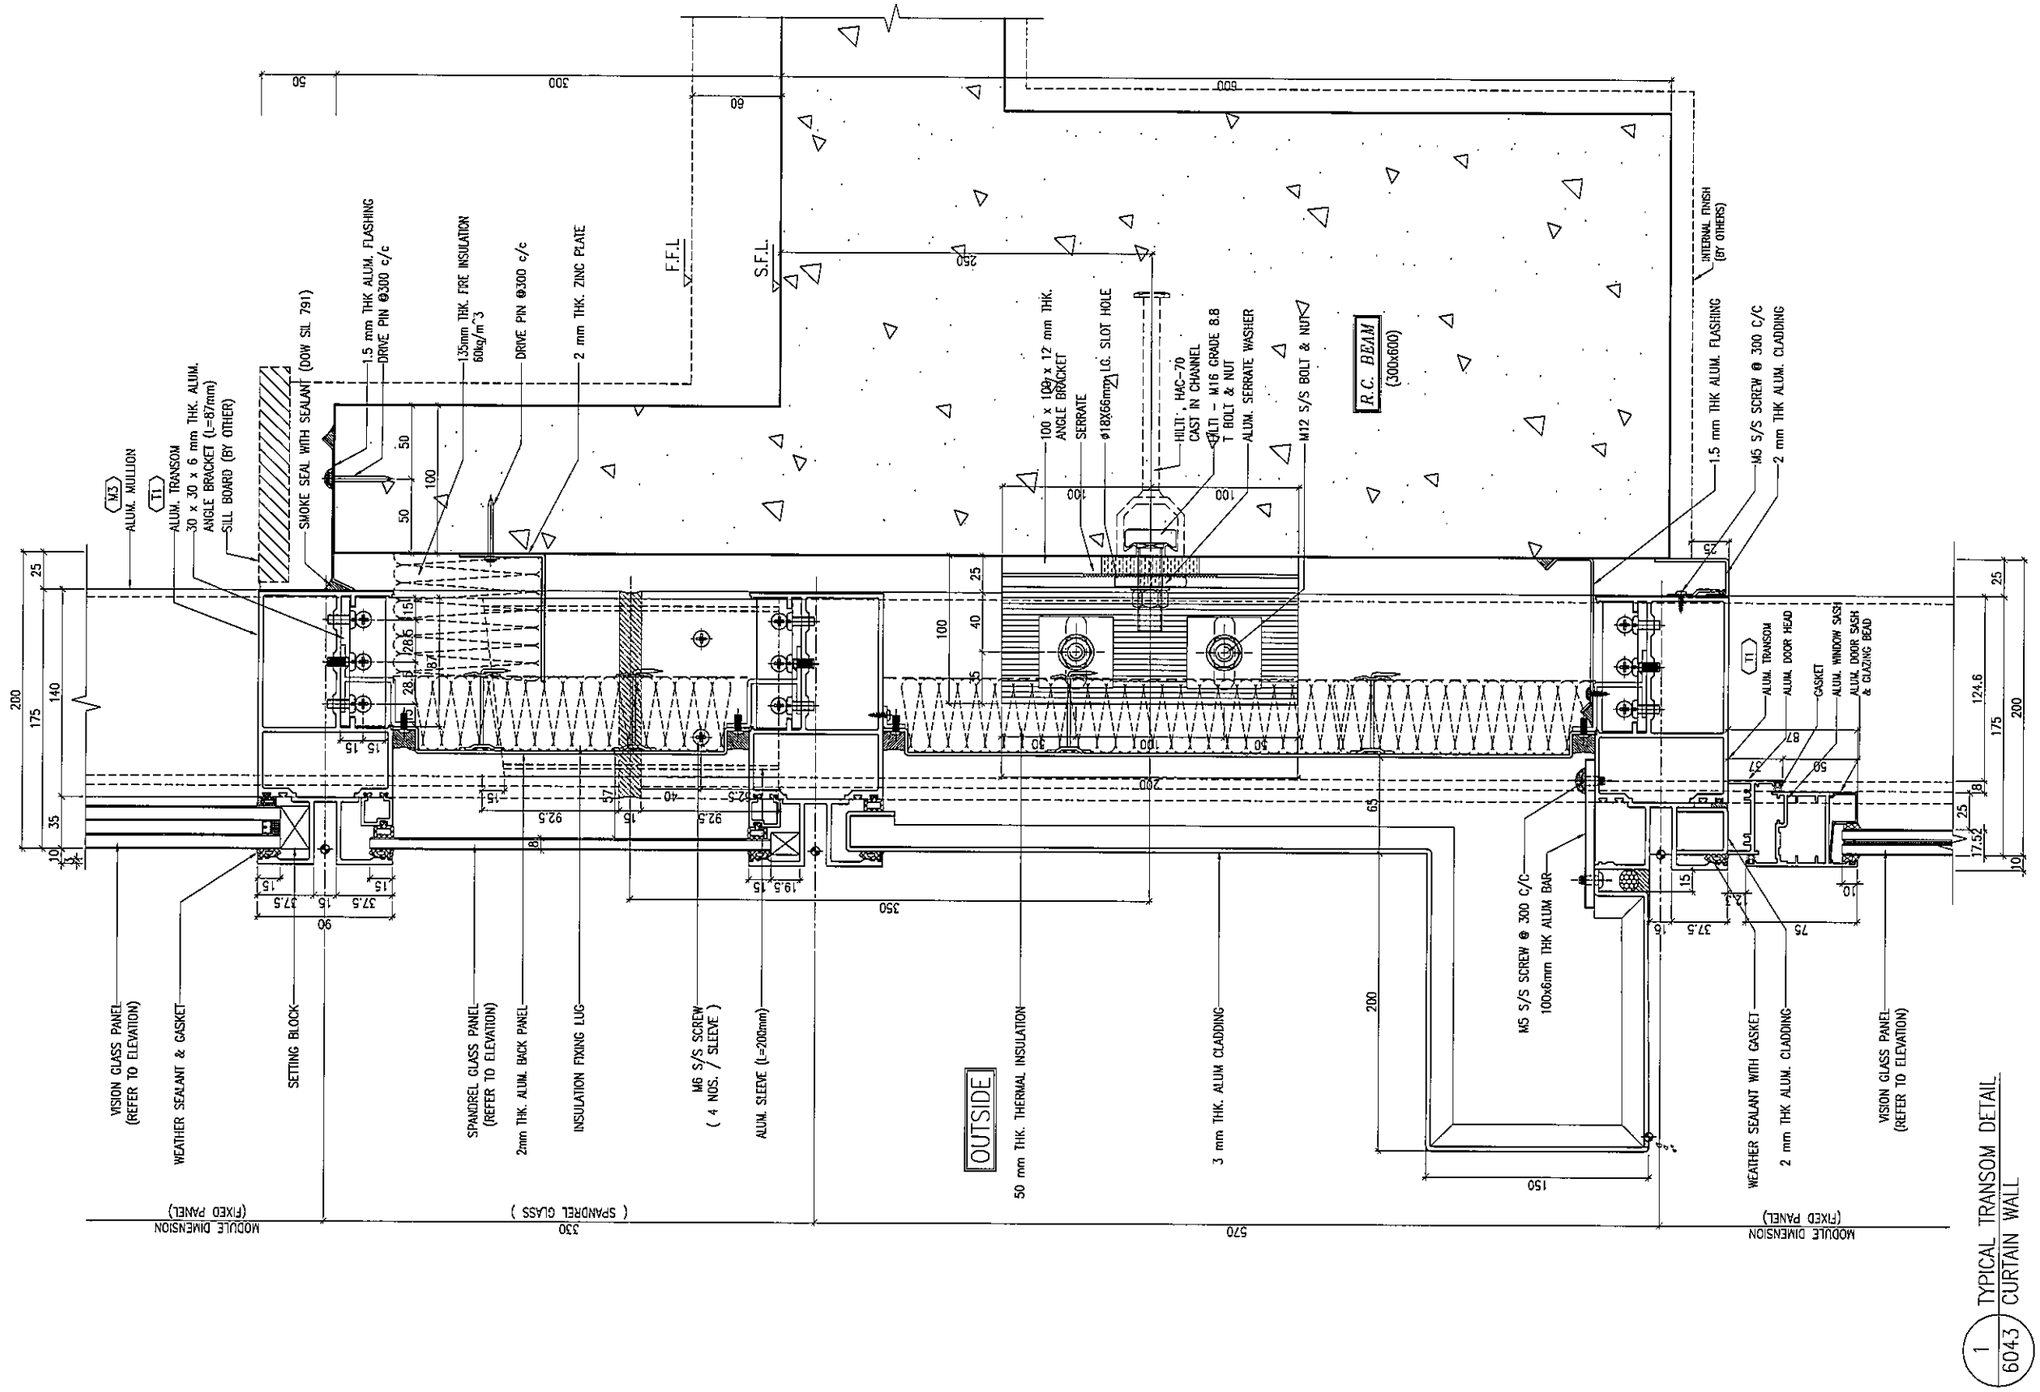

1 TYPICAL TRANSOM DETAIL 6043 CURTAIN WALL

B.D. REF :

CLIENT :
信和置業有限公司
Sino Land Company Limited

ARCHITECT : WONG TUNG & PARTNERS LIMITED ARCHITECTS & PLANNERS

MAIN CONTRACTOR :
CR Construction Company Limited

STRUCTURAL ENGINEER :
AECOM

FACADE CONSULTANT:
AECOM

NOTE :
1. ALL DIMENSIONS ARE IN mm.
2. ALL ELEVATIONS ARE VIEWED FROM OUTSIDE.
3. ALL DIMENSIONS TO BE VERIFIED ON SITE BEFORE FABRICATION.

LEGEND :
X1 — DETAIL MARK NO.
XG01 — REFER SHEET NO.

1. F.F.L. --FINISHED FLOOR LEVEL
2. S.F.L. --STRUCTURAL FLOOR LEVEL
3. /R --REVERSED DETAIL

NO.	DATE	REVISED	BY

JOB NO. : J-837

PROJECT :
URA KWUN TONG TOWN CENTRE REDEVELOPMENT (AREA 2 & 3) AT NKIL 6514, KWUN TONG, KWLOON

TITLE :
TYPICAL TRANSOM DETAIL FOR CURTAIN WALL

DATE : 13-JUN-19 | SCALE : 1:2 (A1)

DRAWN BY : ASING | CHECKED BY : -

美特鋁製有限公司
MIDI ALUMINIUM FABRICATOR LTD.
Units 6-8, Sunray Industrial Centre, 1/F
610 Cha Kwo Ling Road, Kowloon
Tel:23489211-4 Fax:(852)27727666

DWG NO. : J837-CW-6043 | REV. : -

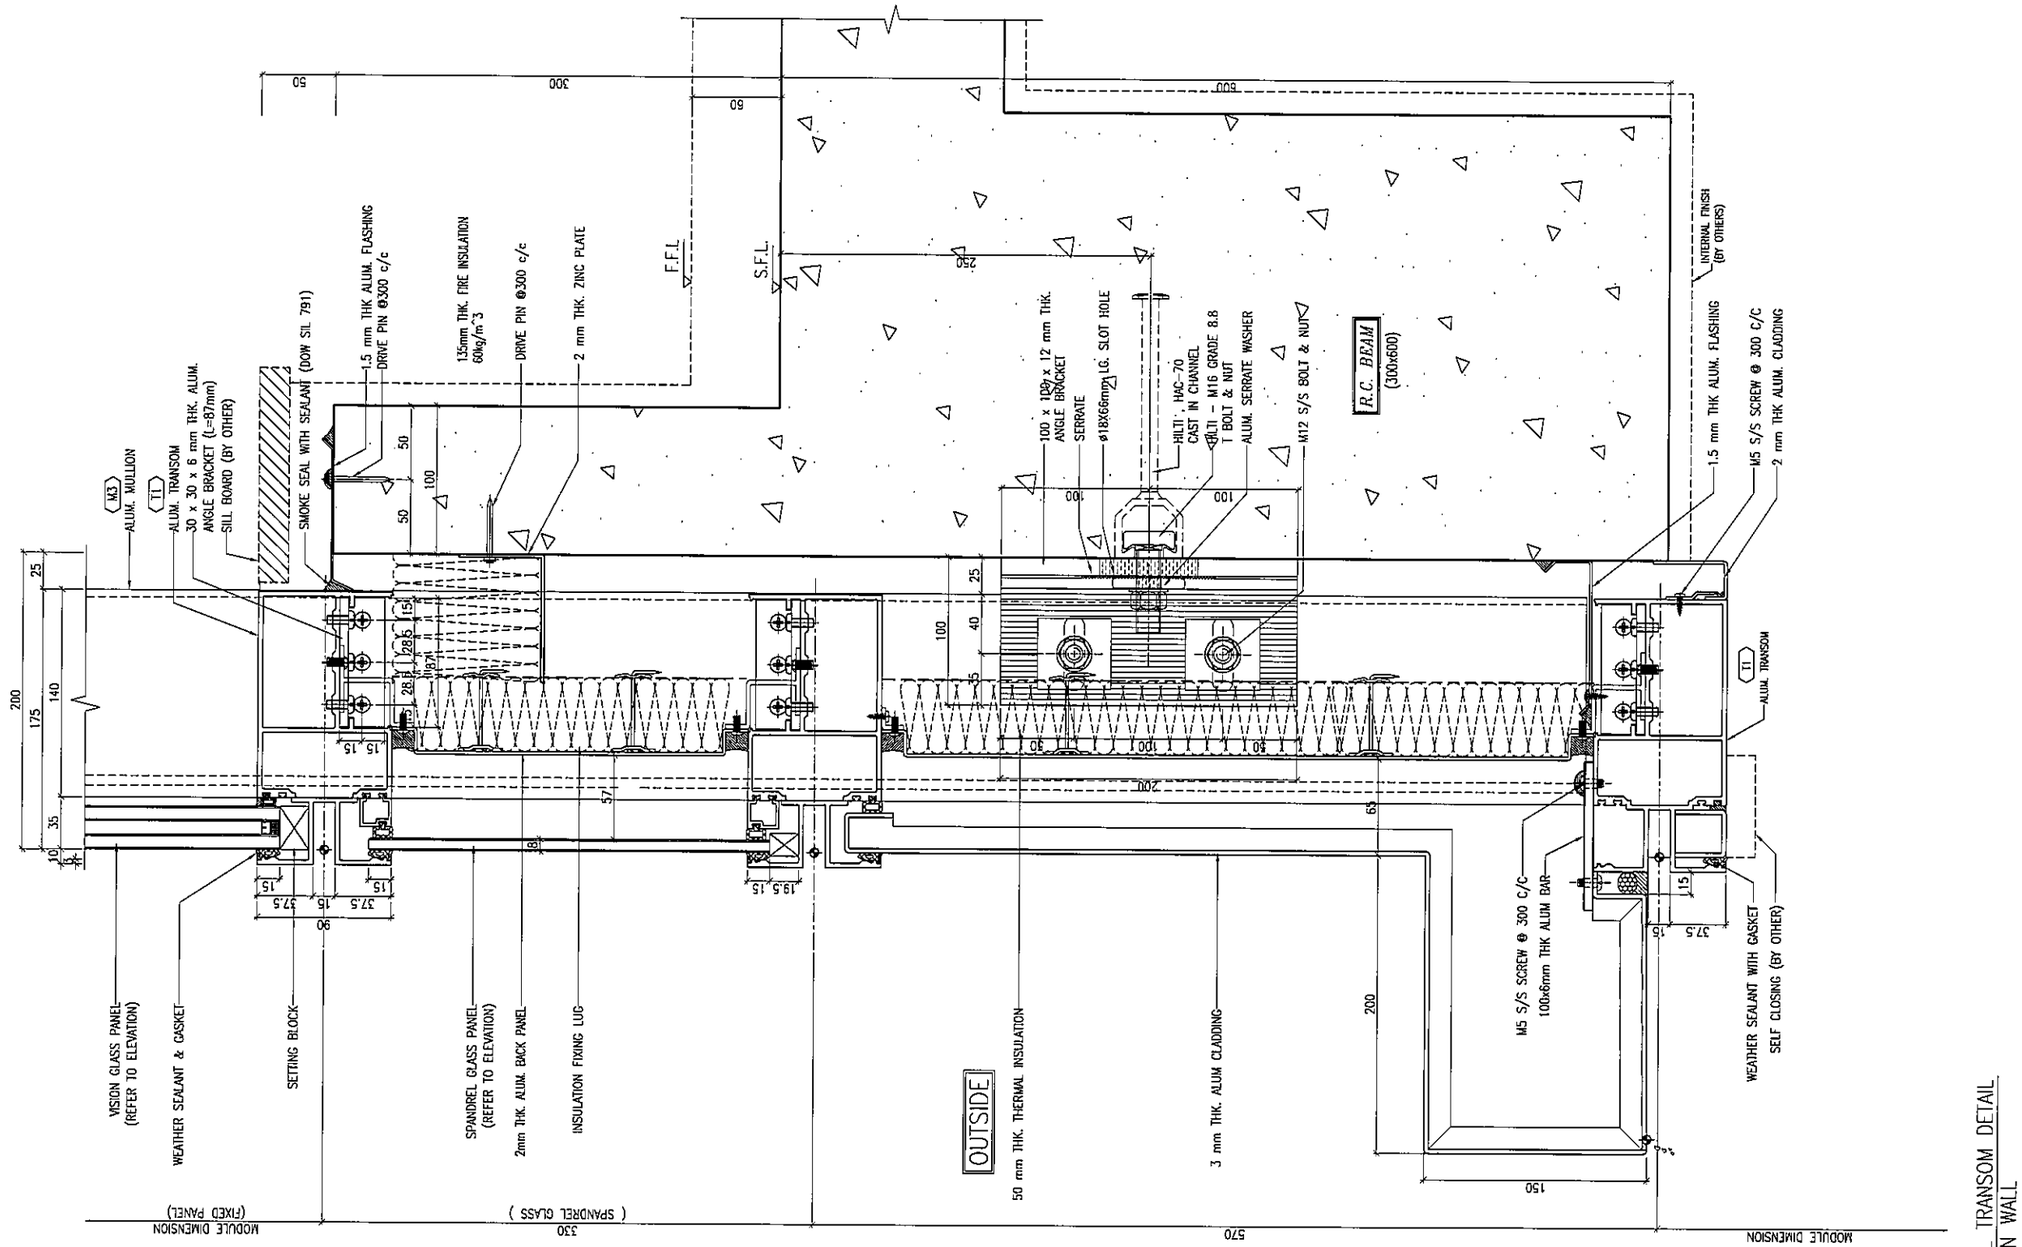

1 TYPICAL TRANSOM DETAIL CURTAIN WALL
6044

B.D. REF :

CLIENT :
信和置業有限公司
Sino Land Company Limited

ARCHITECT :
WONG TUNG & PARTNERS LIMITED
ARCHITECTS & PLANNERS

MAIN CONTRACTOR :
CR Construction Company Limited

STRUCTURAL ENGINEER :
AECOM

FACADE CONSULTANT:
AECOM

NOTE :
1. ALL DIMENSIONS ARE IN mm.
2. ALL ELEVATIONS ARE VIEWED FROM OUTSIDE.
3. ALL DIMENSIONS TO BE VERIFIED ON SITE BEFORE FABRICATION.

LEGEND :
X1 — DETAIL MARK NO.
X001 — REFER SHEET NO.

1. F.F.L. --FINISHED FLOOR LEVEL
2. S.F.L. --STRUCTURAL FLOOR LEVEL
3. /R --REVERSED DETAIL

NO.	DATE	REVISED	BY

JOB NO. : J-837

PROJECT :
URA KWUN TONG TOWN CENTRE REDEVELOPMENT (AREA 2 & 3) AT NKIL 6514, KWUN TONG, KWLOON

TITLE :
TYPICAL TRANSOM DETAIL FOR CURTAIN WALL

DATE : 13-JUN-19 | SCALE : 1:2 (A1)

DRAWN BY : ASING | CHECKED BY : -

美特鋁質有限公司
MIDI ALUMINIUM FABRICATOR LTD.
Units 6-8, Sunray Industrial Centre, 1/F
610 Cha Kwo Ling Road, Kowloon
Tel:23489211-4 Fax:(852)27727686

DWG NO. : J837-CW-6044 | REV. : -

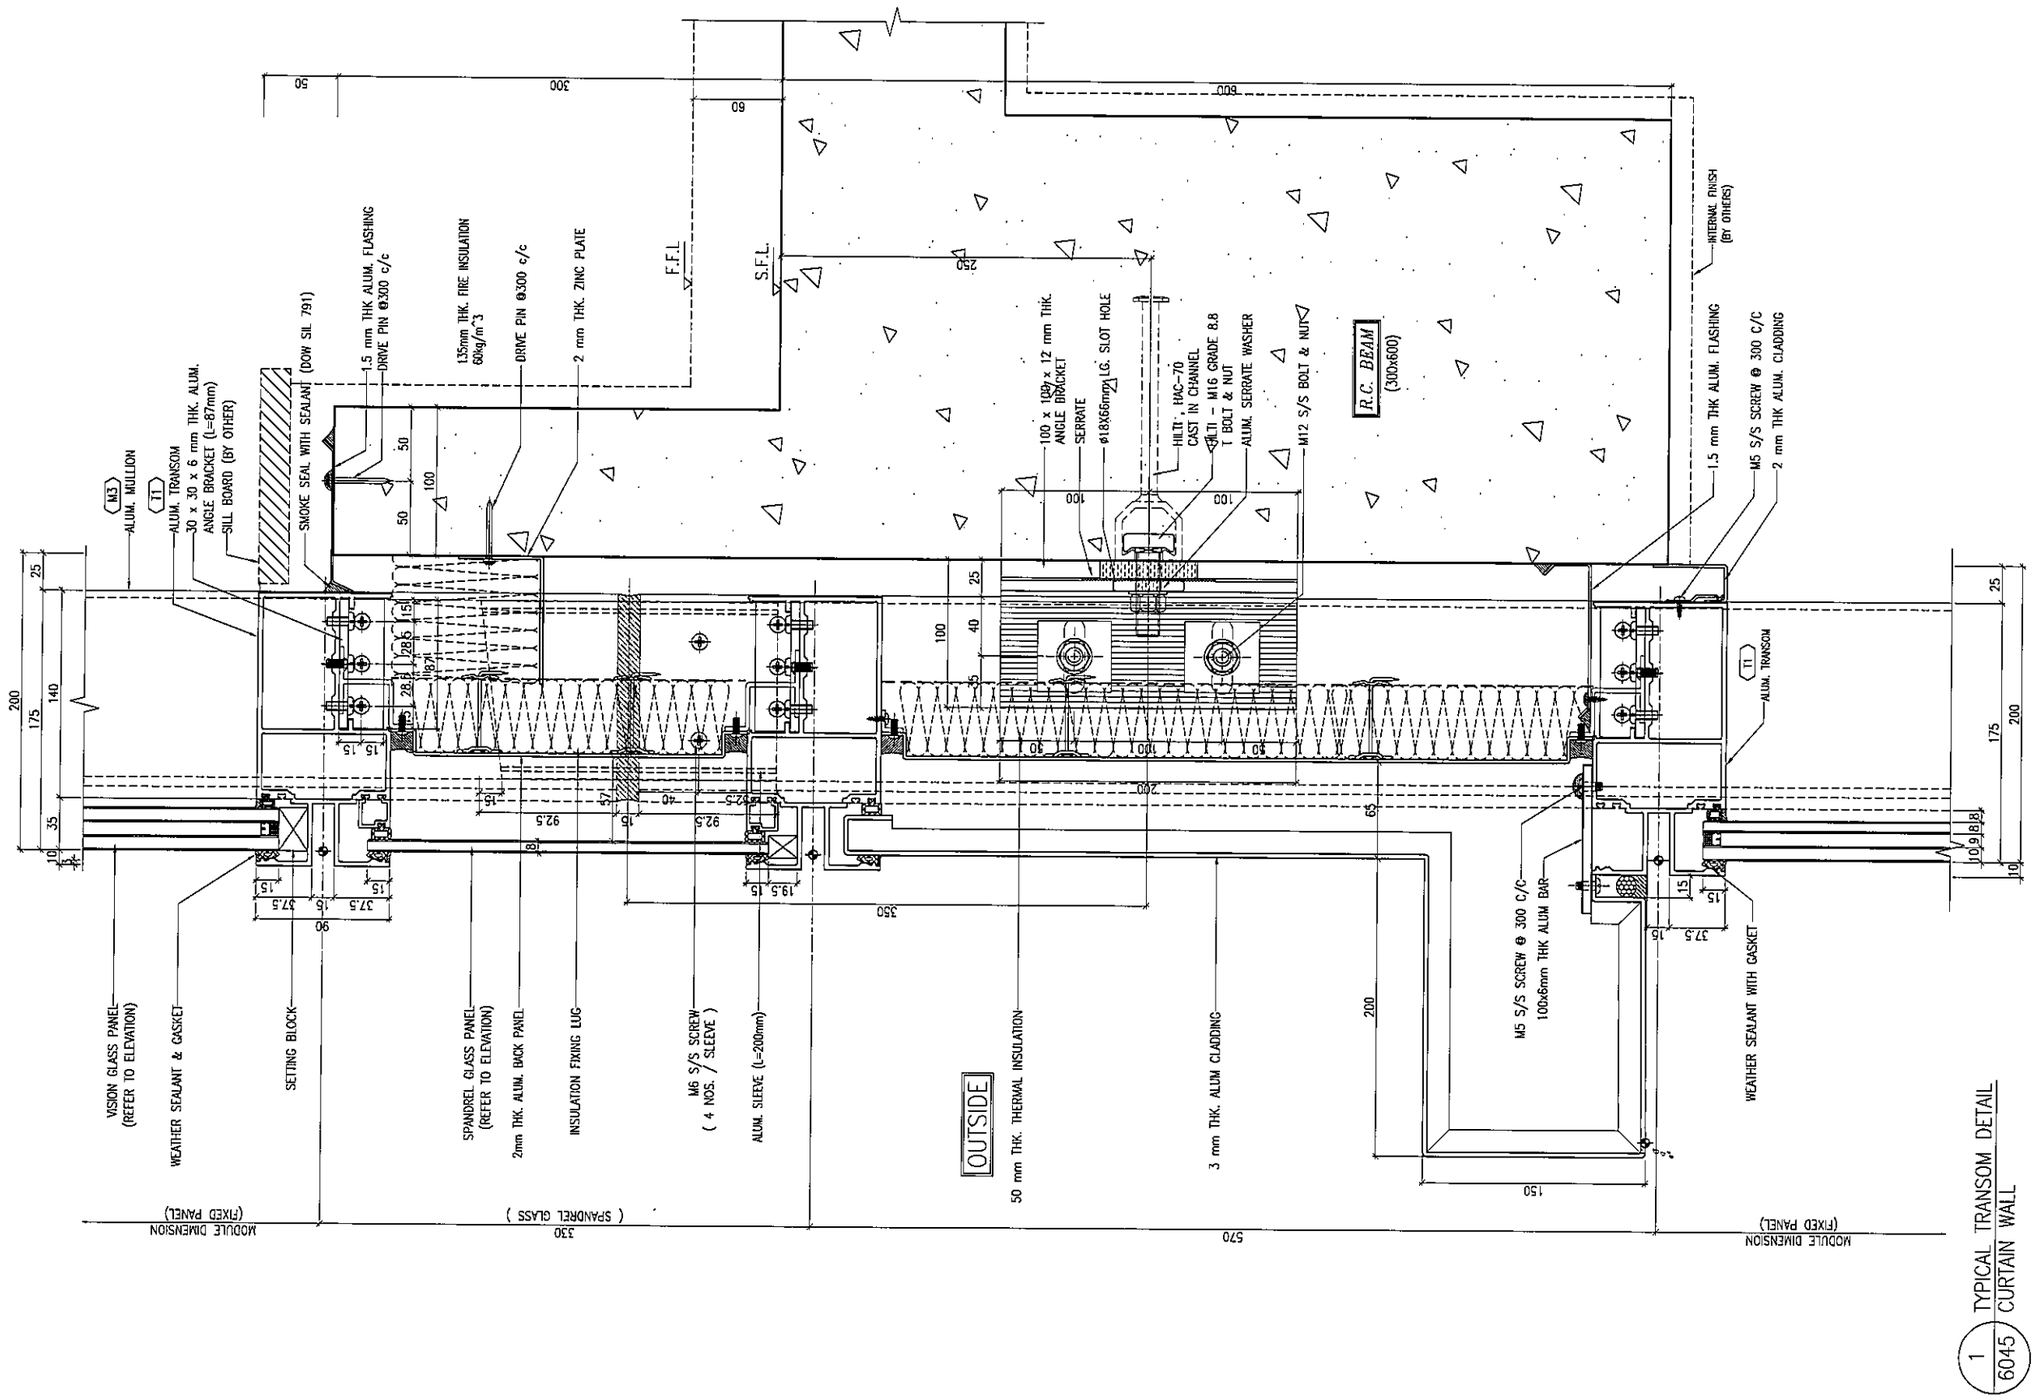

1 / 6045 TYPICAL TRANSOM DETAIL CURTAIN WALL

B.D. REF :

CLIENT :
信和置業有限公司
Sino Land Company Limited

ARCHITECT :
WONG TUNG & PARTNERS LIMITED
ARCHITECTS & PLANNERS

MAIN CONTRACTOR :
CR Construction Company Limited

STRUCTURAL ENGINEER :
AECOM

FACADE CONSULTANT:
AECOM

NOTE :
1. ALL DIMENSIONS ARE IN mm.
2. ALL ELEVATIONS ARE VIEWED FROM OUTSIDE.
3. ALL DIMENSIONS TO BE VERIFIED ON SITE BEFORE FABRICATION.

LEGEND :
X1 / X001 — DETAIL MARK NO. / REFER SHEET NO.
1. F.F.L. --FINISHED FLOOR LEVEL
2. S.F.L. --STRUCTURAL FLOOR LEVEL
3. /R --REVERSED DETAIL

NO.	DATE	REVISED	BY

JOB NO. : J-837

PROJECT :
URA KWUN TONG TOWN CENTRE REDEVELOPMENT (AREA 2 & 3) AT NKIL 6514, KWUN TONG, KWLOON

TITLE :
TYPICAL TRANSOM DETAIL FOR CURTAIN WALL

DATE : 13-JUN-19 | SCALE : 1:2 (A1)

DRAWN BY : ASING | CHECKED BY : —

美特鋁質有限公司
MIDI ALUMINIUM FABRICATOR LTD.
Units 6-8, Sunray Industrial Centre, 1/F
610 Cha Kwo Ling Road, Kowloon
Tel:23489211-4 Fax:(852)27727666

DWG NO. : J837-CW-6045 | REV. : —

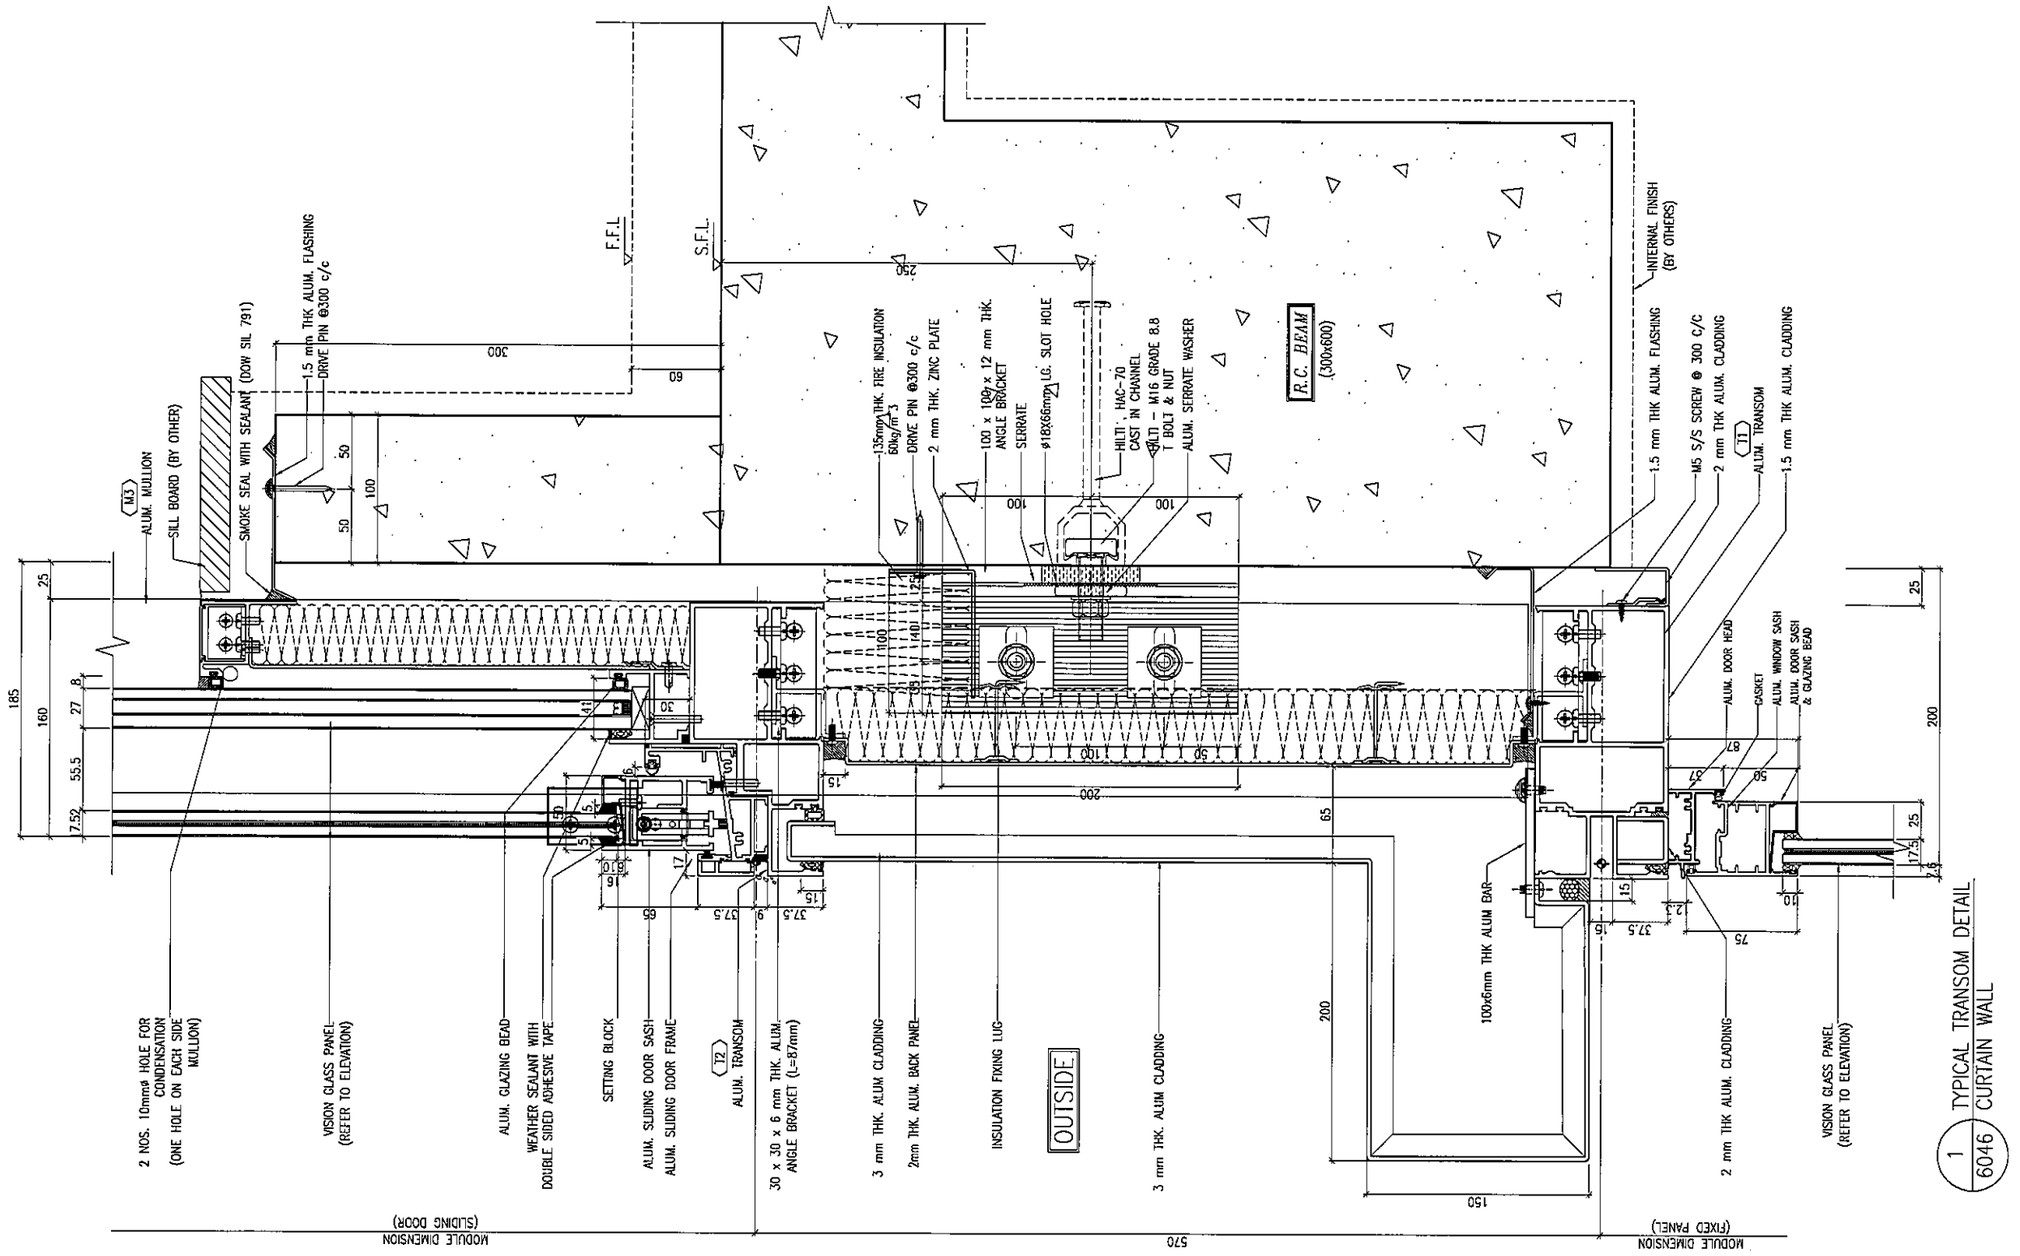

1 / 6046 TYPICAL TRANSOM DETAIL CURTAIN WALL

B.D. REF :

CLIENT :
信和置業有限公司
Sino Land Company Limited

ARCHITECT :
WONG TUNG & PARTNERS LIMITED
ARCHITECTS & PLANNERS

MAIN CONTRACTOR :
CR Construction Company Limited

STRUCTURAL ENGINEER :
AECOM

FACADE CONSULTANT:
AECOM

NOTE :
1. ALL DIMENSIONS ARE IN mm.
2. ALL ELEVATIONS ARE VIEWED FROM OUTSIDE.
3. ALL DIMENSIONS TO BE VERIFIED ON SITE BEFORE FABRICATION.

LEGEND :
- X1 / X001 — DETAIL MARK NO. / REFER SHEET NO.
1. F.F.L. --FINISHED FLOOR LEVEL
2. S.F.L. --STRUCTURAL FLOOR LEVEL
3. /R --REVERSED DETAIL

NO.	DATE	REVISED	BY

JOB NO. : J-837

PROJECT :
URA KWUN TONG TOWN CENTRE REDEVELOPMENT (AREA 2 & 3) AT NKIL 6514, KWUN TONG, KWLOON

TITLE :
TYPICAL TRANSOM DETAIL FOR CURTAIN WALL

DATE : 13-JUN-19 | SCALE : 1:2 (A1)

DRAWN BY : ASING | CHECKED BY : -

美特鋁質有限公司
MIDI ALUMINIUM FABRICATOR LTD.
Units 6-8, Sunray Industrial Centre, 1/F
610 Cha Kwo Ling Road, Kowloon
Tel:23489211-4 Fax:(852)27727666

DWG NO. : J837-CW-6046 | REV. : -

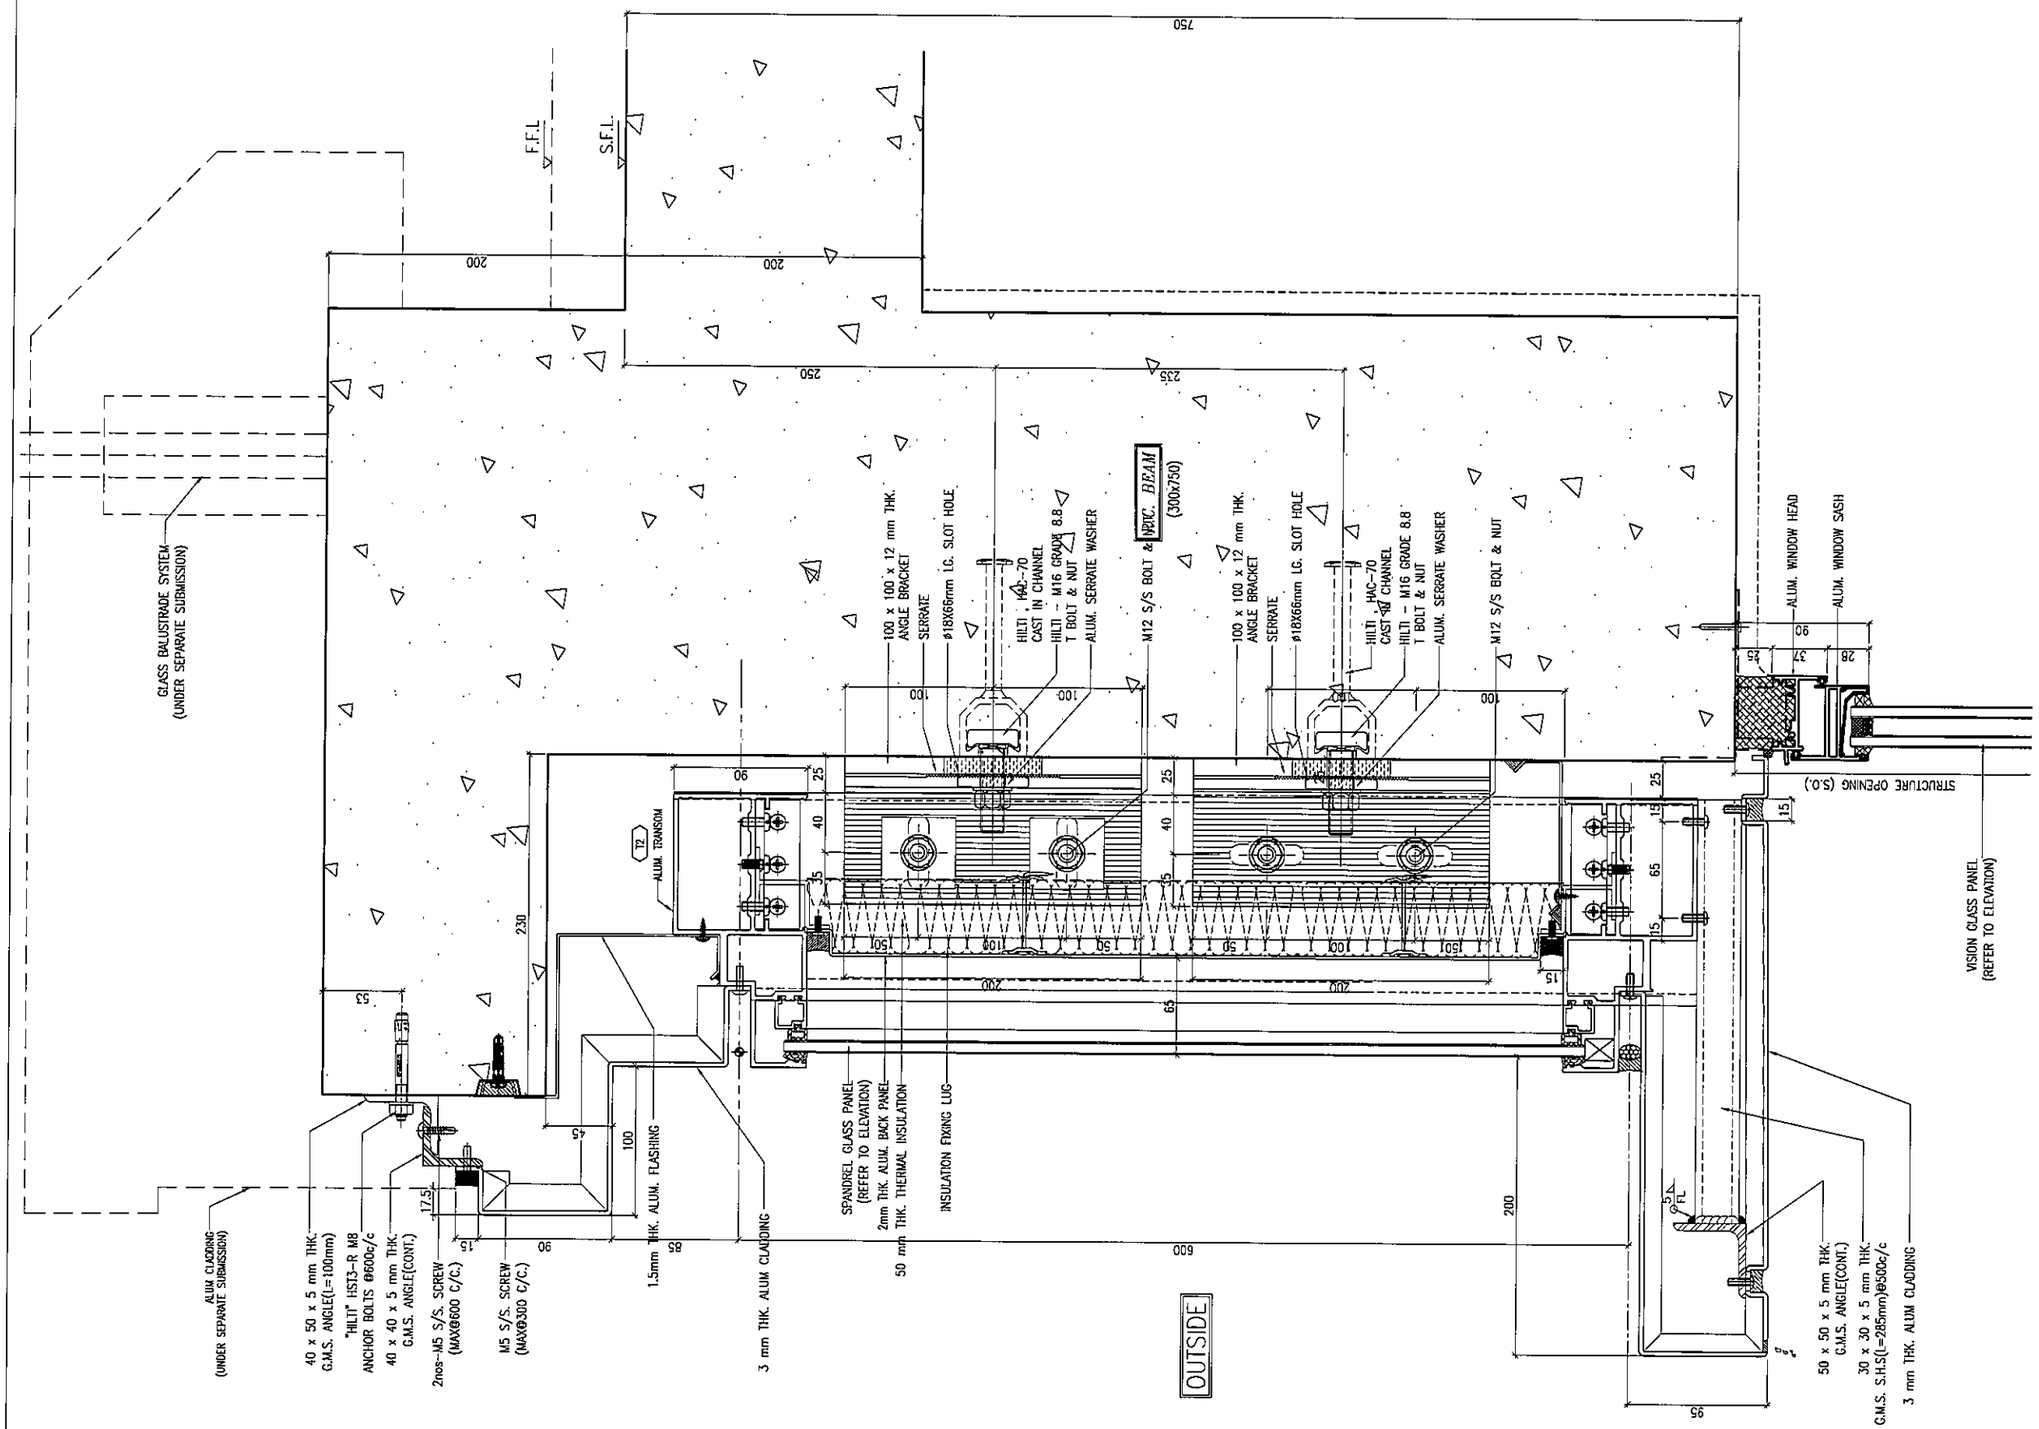

1 TYPICAL TRANSOM DETAIL
6047 CURTAIN WALL

B.D. REF :

CLIENT :
信和置業有限公司
Sino Land Company Limited

ARCHITECT :
WONG TUNG & PARTNERS LIMITED
ARCHITECTS & PLANNERS

MAIN CONTRACTOR :
CR Construction Company Limited

STRUCTURAL ENGINEER :
AECOM

FACADE CONSULTANT:
AECOM

NOTE :
1. ALL DIMENSIONS ARE IN mm.
2. ALL ELEVATIONS ARE VIEWED FROM OUTSIDE.
3. ALL DIMENSIONS TO BE VERIFIED ON SITE BEFORE FABRICATION.

LEGEND :
X1 — DETAIL MARK NO.
X001 — REFER SHEET NO.

1. F.F.L. --FINISHED FLOOR LEVEL
2. S.F.L. --STRUCTURAL FLOOR LEVEL
3. /R --REVERSED DETAIL

NO.	DATE	REVISED	BY

JOB NO. : J-837

PROJECT :
URA KWUN TONG TOWN CENTRE
REDEVELOPMENT (AREA 2 & 3) AT
NKIL 6514, KWUN TONG, KWLOON

TITLE :
TYPICAL TRANSOM DETAIL
FOR CURTAIN WALL

DATE : 16-JUL-19 | SCALE : 1:2 (A1)

DRAWN BY : ASING | CHECKED BY : -

美特鋁製有限公司
MIDI ALUMINIUM FABRICATOR LTD.
Units 6-8, Sunray Industrial Centre, 1/F
610 Cha Kwo Ling Road, Kowloon
Tel:23489211-4 Fax:(852)27727666

DWG NO. : J837-CW-6047 | REV. : -

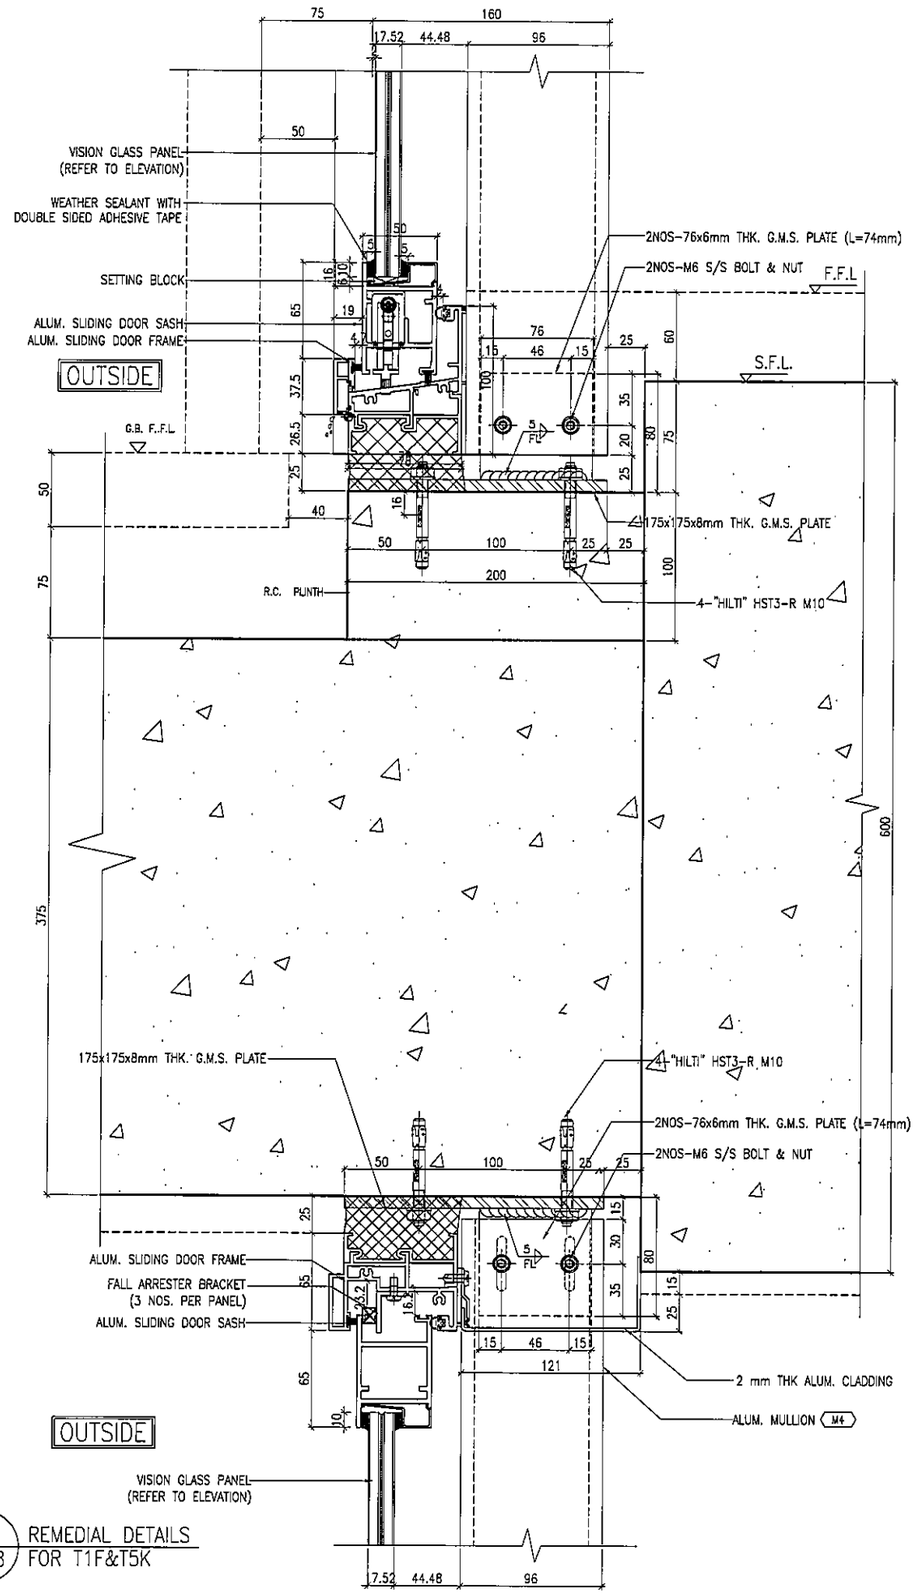

1 / 6048 REMEDIAL DETAILS FOR T1F&T5K

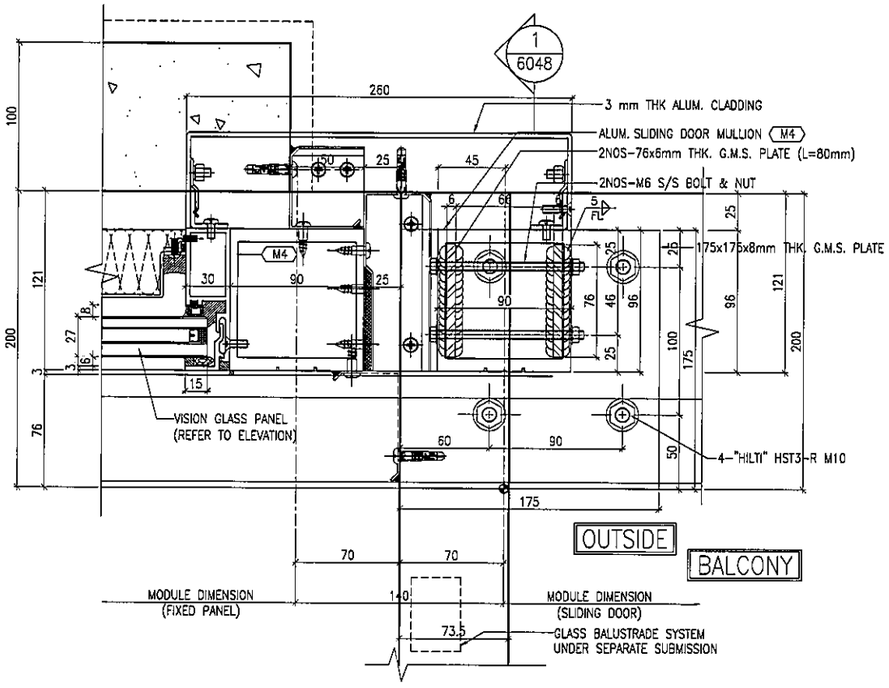

2 / 6048 REMEDIAL DETAILS FOR T1F&T5K

B.D. REF :

CLIENT :
信和置業有限公司
Sino Land Company Limited

ARCHITECT :
WONG TUNG & PARTNERS LIMITED
ARCHITECTS & PLANNERS

MAIN CONTRACTOR :
CR Construction Company Limited

STRUCTURAL ENGINEER :
AECOM

FACADE CONSULTANT:
AECOM

NOTE :
1. ALL DIMENSIONS ARE IN mm.
2. ALL ELEVATIONS ARE VIEWED FROM OUTSIDE.
3. ALL DIMENSIONS TO BE VERIFIED ON SITE BEFORE FABRICATION.

LEGEND :
X1 / XG01 — DETAIL MARK NO. / REFER SHEET NO.
1. F.F.L. --FINISHED FLOOR LEVEL
2. S.F.L. --STRUCTURAL FLOOR LEVEL
3. /R --REVERSED DETAIL

NO.	DATE	REVISED	BY

JOB NO. : J-837

PROJECT :
URA KWUN TONG TOWN CENTRE REDEVELOPMENT (AREA 2 & 3) AT NKIL 6514, KWUN TONG, KWLOON

TITLE :
REMEDIAL DETAILS
FOR CURTAIN WALL

DATE : 11-JUL-19 | SCALE : 1:2 (A1)

DRAWN BY : ASING | CHECKED BY : -

美特鋁製有限公司
MIDI ALUMINIUM FABRICATOR LTD.
Units 6-8, Sunray Industrial Centre, 1/F
610 Cha Kwo Ling Road, Kowloon
Tel:23489211-4 Fax:(852)27727666

DWG NO. : J837-CW-6048 | REV. : -

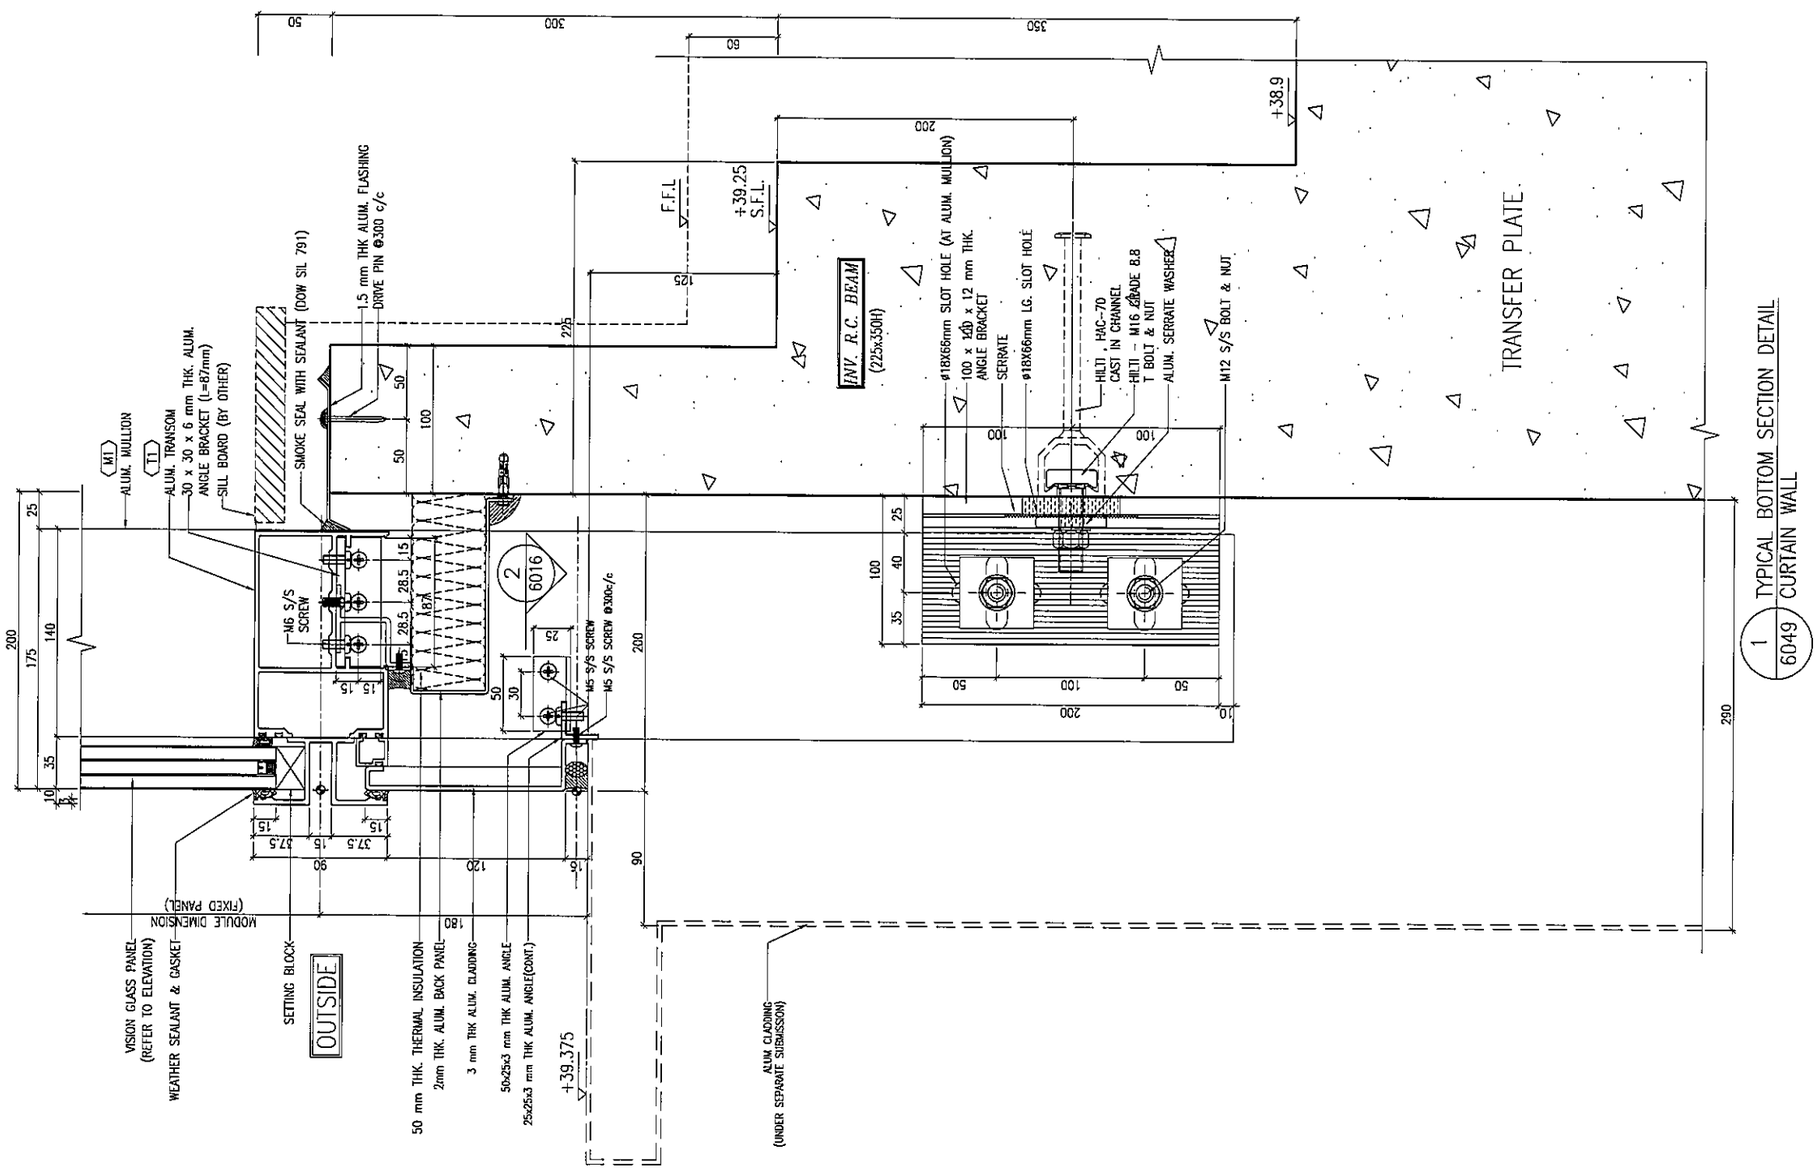

B.D. REF :

CLIENT :
信和置業有限公司
Sino Land Company Limited

ARCHITECT :
WONG TUNG & PARTNERS LIMITED
ARCHITECTS & PLANNERS

MAIN CONTRACTOR :
CR Construction Company Limited

STRUCTURAL ENGINEER :
AECOM

FACADE CONSULTANT:
AECOM

NOTE :
1. ALL DIMENSIONS ARE IN mm.
2. ALL ELEVATIONS ARE VIEWED FROM OUTSIDE.
3. ALL DIMENSIONS TO BE VERIFIED ON SITE BEFORE FABRICATION.

LEGEND :
X1 — DETAIL MARK NO.
X001 — REFER SHEET NO.
1. F.F.L. --FINISHED FLOOR LEVEL
2. S.F.L. --STRUCTURAL FLOOR LEVEL
3. /R --REVERSED DETAIL

NO.	DATE	REVISED	BY
B	15/02/2019	GENERAL REVISED	
A	24/11/2018	GENERAL REVISED	

JOB NO. : J-837

PROJECT :
URA KWUN TONG TOWN CENTRE REDEVELOPMENT (AREA 2 & 3) AT NKIL 6514, KWUN TONG, KWLOON

TITLE :
TYPICAL TRANSOM DETAIL FOR CURTAIN WALL

DATE : 18-AUG-19 | SCALE : 1:2 (A1)

DRAWN BY : Asing | CHECKED BY : -

美特鋁質有限公司
MIDI ALUMINIUM FABRICATOR LTD.
Units 6-8, Sunray Industrial Centre, 1/F
610 Cha Kwo Ling Road, Kowloon
Tel:23489211-4 Fax:(852)27727666

DWG NO. : J837-CW-6049 | REV. : -

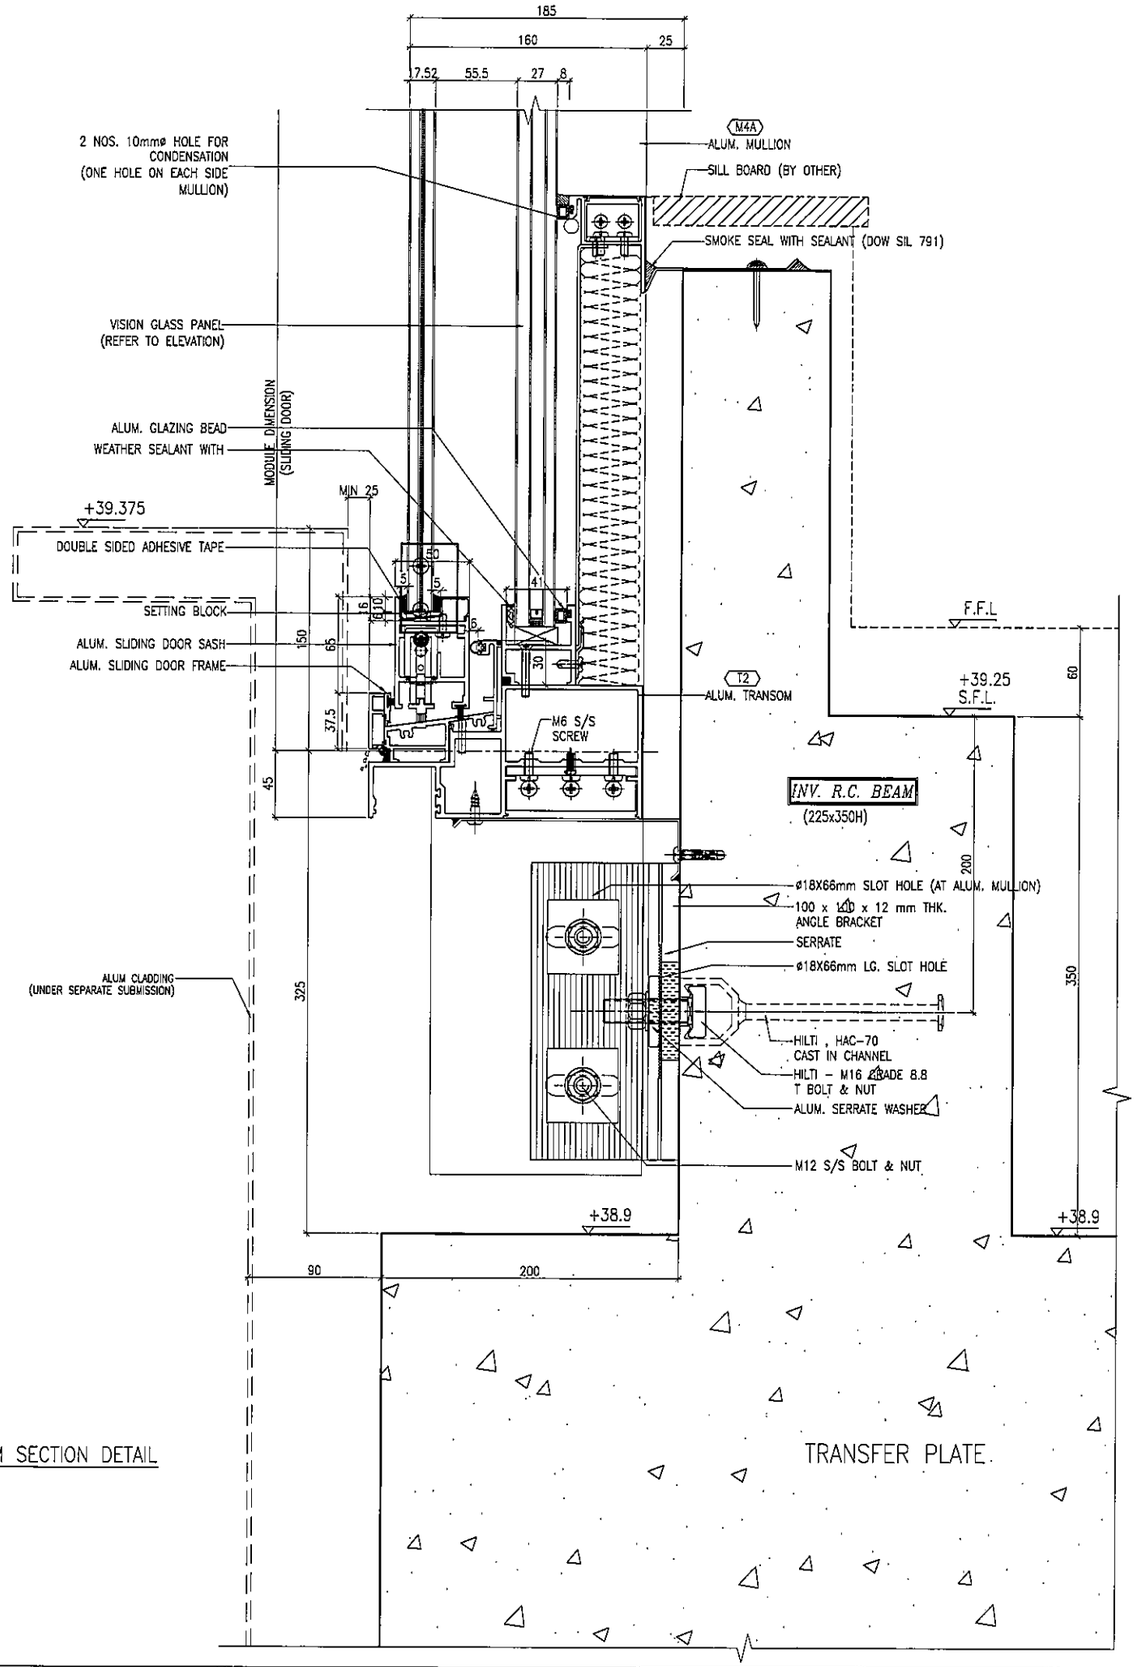

1 / 6050 TYPICAL BOTTOM SECTION DETAIL CURTAIN WALL

REFER TO J837-CW-2308

B.D. REF :

CLIENT :
信和置業有限公司
Sino Land Company Limited

ARCHITECT :
WONG TUNG & PARTNERS LIMITED
ARCHITECTS & PLANNERS

MAIN CONTRACTOR :
CR Construction Company Limited

STRUCTURAL ENGINEER :
AECOM

FACADE CONSULTANT:
AECOM

NOTE :
1. ALL DIMENSIONS ARE IN mm.
2. ALL ELEVATIONS ARE VIEWED FROM OUTSIDE.
3. ALL DIMENSIONS TO BE VERIFIED ON SITE BEFORE FABRICATION.

LEGEND :
X1 / X001 — DETAIL MARK NO. / REFER SHEET NO.
1. F.F.L. --FINISHED FLOOR LEVEL
2. S.F.L. --STRUCTURAL FLOOR LEVEL
3. /R --REVERSED DETAIL

NO.	DATE	REVISED	BY

JOB NO. : J-837

PROJECT :
URA KWUN TONG TOWN CENTRE REDEVELOPMENT (AREA 2 & 3) AT NKIL 6514, KWUN TONG, KWLOON

TITLE :
TYPICAL TRANSOM DETAIL FOR CURTAIN WALL

DATE : 18-AUG-19	SCALE : 1:2 (A1)
DRAWN BY : ASING	CHECKED BY : -

美特鋁質有限公司
MIDI ALUMINIUM FABRICATOR LTD.
Units 6-8, Sunray Industrial Centre, 1/F
610 Cha Kwo Ling Road, Kowloon
Tel:23489211-4 Fax:(852)27727666

DWG NO. : J837-CW-6050 REV. : -

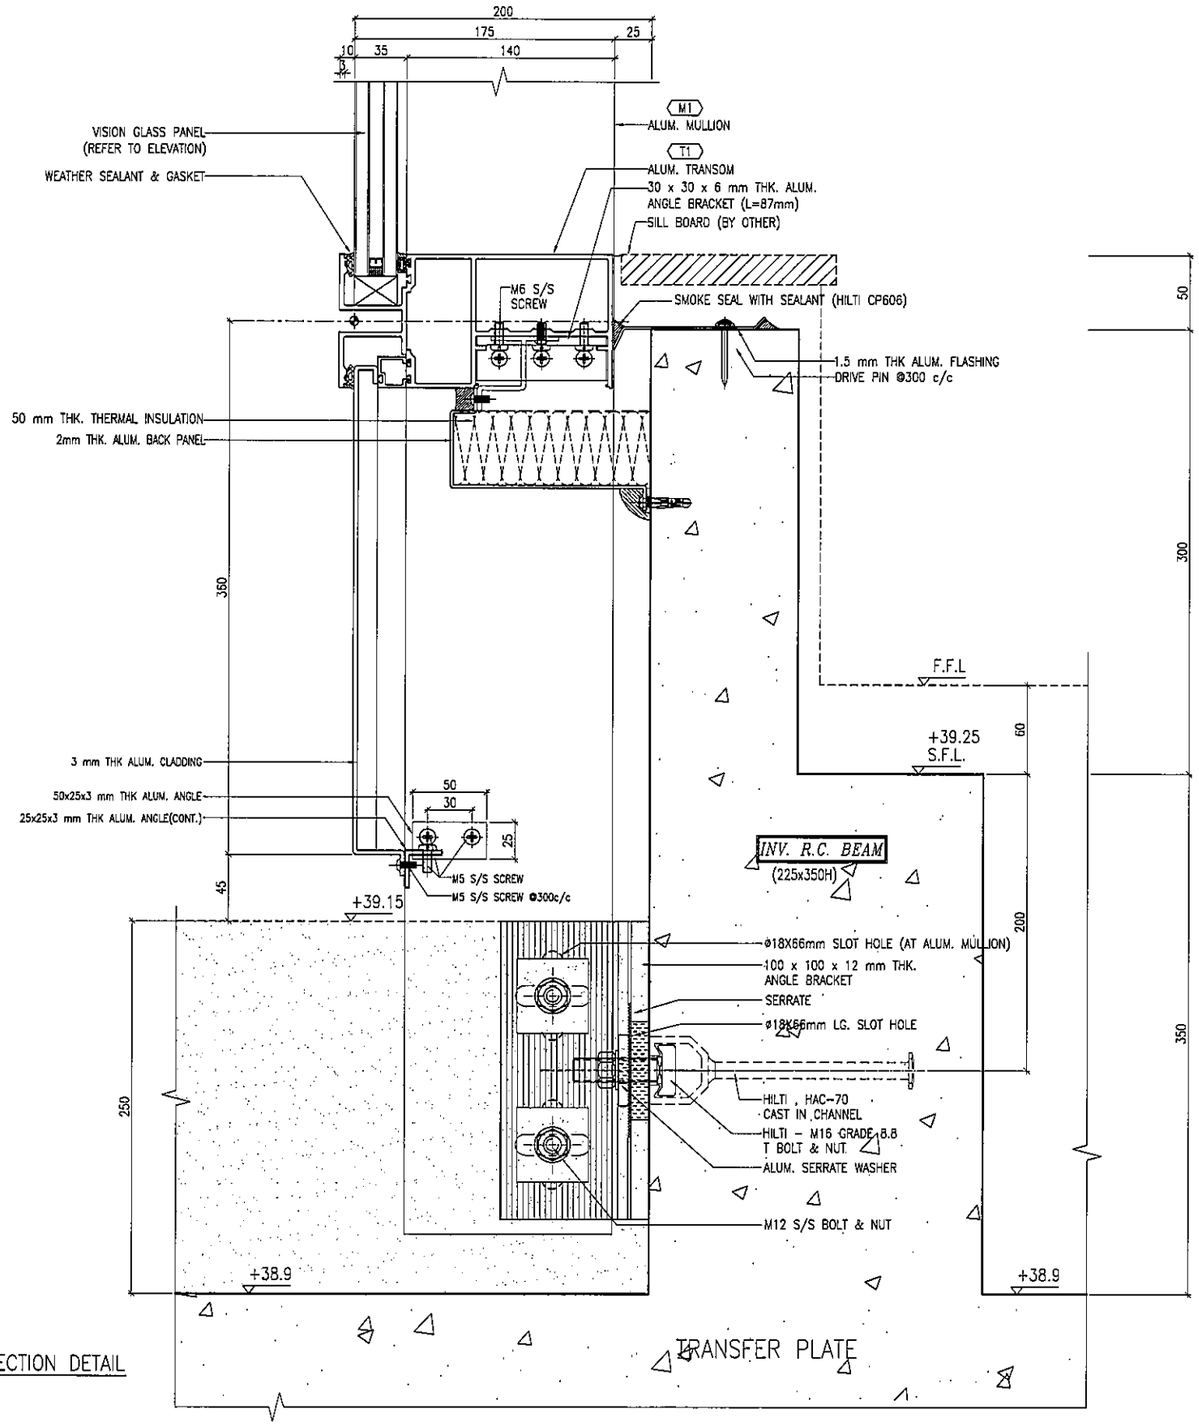

1 / 6051 TYPICAL BOTTOM SECTION DETAIL
CURTAIN WALL

REFER TO J837-CW-2308

B.D. REF :

CLIENT :
信和置業有限公司
Sino Land Company Limited

ARCHITECT :
WONG TUNG & PARTNERS LIMITED
ARCHITECTS & PLANNERS

MAIN CONTRACTOR :
CR Construction Company Limited

STRUCTURAL ENGINEER :
AECOM

FACADE CONSULTANT:
AECOM

NOTE :
1. ALL DIMENSIONS ARE IN mm.
2. ALL ELEVATIONS ARE VIEWED FROM OUTSIDE.
3. ALL DIMENSIONS TO BE VERIFIED ON SITE BEFORE FABRICATION.

LEGEND :
X1 / X001 — DETAIL MARK NO. / REFER SHEET NO.
1. F.F.L. --FINISHED FLOOR LEVEL
2. S.F.L. --STRUCTURAL FLOOR LEVEL
3. /R --REVERSED DETAIL

NO.	DATE	REVISED	BY

JOB NO. : J-837

PROJECT :
URA KWUN TONG TOWN CENTRE
REDEVELOPMENT (AREA 2 & 3) AT
NKIL 6514, KWUN TONG, KWLOON

TITLE :
TYPICAL TRANSOM DETAIL
FOR CURTAIN WALL

DATE : 18-AUG-19	SCALE : 1:2 (A1)
DRAWN BY : ASING	CHECKED BY : -

美特鋁製有限公司
MIDI ALUMINIUM FABRICATOR LTD.
Units 6-8, Sunray Industrial Centre, 1/F
610 Cha Kwo Ling Road, Kowloon
Tel:23489211-4 Fax:(852)27727666

DWG NO. : J837-CW-6051 REV. : -