



工程指示 / 要求簡箋(E.I.)

工程指示編號：EI / 0395 / 19

修改版次：-

工程編號：J - 837

工程名稱：觀塘裕民坊

工程項目：趟門 玻璃 BM(趟門梗) (T3)(大貨)

收件人：Maggie/ 生統 / 永林

發件人：Eric Liu

日期：28/03/2019

□要求提供 / □確認 事項：

- | | | |
|------------------------------------|-------------------------------------|-------------------------------|
| <input type="checkbox"/> 初步鋁料 B.M. | <input type="checkbox"/> 加工拆圖，然後生產 | <input type="checkbox"/> 尺寸表 |
| <input type="checkbox"/> 正式鋁料 B.M. | <input type="checkbox"/> 技術上資料 / 指示 | <input type="checkbox"/> 報價 |
| <input type="checkbox"/> 配件 B.M. | <input type="checkbox"/> 樣辦或貨品說明書 | <input type="checkbox"/> 分判合約 |
| <input type="checkbox"/> 其他：_____ | | |

內容：

請按 BM 訂購玻璃送地盤安裝用(T3) (趟門梗位)

請留意: 1) 此 BM 按 EI9536I 版本計算(第 4 份大圖修改版)

2) 此 BM 已計算 7、27/F、特色層，未計算 6,8/F，
趟門玉及 FD 門另外 EI 出

3) 需分 MO 出貨，已在 BM 表分(共 5 個 MO)

4) 包裝要分座及分層，玻璃要做熱浸

(熱浸次序: (1) 跟 MO (2) 分座次序: T2,T5,T3,T1)

5) B.M.表已分出大玻璃(未能入沙機)，需另外分箱包裝

6) IGU 膠用 DC983 結構膠

7) 玻璃包箱分類: (1) 趟門死牆梗 (2) 趟門大梗

8) 出貨次序: (1) 先出死牆梗玻璃，(2) 趟門大梗再通知

9) 出貨期(按後頁):

MO1 (5 月頭到地盤)、MO2 (5 月中至尾)、MO3(6 月中至尾)、MO4(7 月頭至中)、
MO5(8 月頭至中)

10) 請留意玻璃加工時不要固定的鋼化及熱浸標籤，室內外要做保護膠紙

11) 玻璃出貨時需加上 "可移除" 標籤，

單片:標籤在室外面(注明半鋼化/鋼化)、IGU: 標籤在室內面(注明半鋼化/鋼化)

12) 青哥: 請安排最少兩名 QC 人員駐三鑫廠，包食及住宿，驗玻璃

13) 維修: 請安排 T1 上三鑫睇熱浸測試

謝謝!

14) 已與判源求，大玻璃款，可不分層，只分 MO 和合拉膠箱 (表把說明)

請在 2019/ 05/ 01 前完成上列要求。

(大玻璃 = 要用針打)

附: 1頁排期, 4頁加工圖, 2頁死牆梗玻璃BM, 2頁趟門梗玻璃BM, 10頁估價

以上項目為:

原合約工程包

原合約工程加 / 減賬

新工程報價

原因 :- _____

分發東莞各部門 :

- () 生產技術總監 連附件 () 技術部 連附件 () 生產部 連附件 () 機械設計部 連附件
() 採購部 連附件 () 生產統籌部 連附件
() 質檢部 連附件 () 會計部 連附件 () 報關組 連附件 () 其他 楊榮輝 連附件

分發香港各部門 :

- () 行政部 連附件 () 會計部 連附件 () 統籌部 連附件 () 工程部地盤科文 連附件
() 採購部 連附件 () QS 部 連附件 () 維修部 連附件 () 其他 _____ 連附件

傳遞編號 :

HK0770/19

發件人簽署 :

項目經理簽署 :

J837 - CW

玻璃


		Heat Soak	到貨	安裝		
T2	44	55/F	29/07/2019	28/08/2019	11/09/2019	
	43	53/F	29/07/2019	28/08/2019	11/09/2019	
T3	42	52/F	29/07/2019	28/08/2019	11/09/2019	
狗比架	T5	41	51/F	15/07/2019	14/08/2019	25/09/2019
	T1	40	50/F	15/07/2019	14/08/2019	25/09/2019
	39	49/F	15/07/2019	14/08/2019	25/09/2019	
	38	48/F	15/07/2019	14/08/2019	09/10/2019	
狗比架		37	47/F	15/07/2019	14/08/2019	09/10/2019
M05		36	46/F	01/07/2019	31/07/2019	09/10/2019
		35	45/F	01/07/2019	31/07/2019	09/10/2019
		34	43/F	01/07/2019	31/07/2019	09/10/2019
		33	42/F	01/07/2019	31/07/2019	23/10/2019
狗比架		32	41/F	01/07/2019	31/07/2019	23/10/2019
		31	40/F	17/06/2019	17/07/2019	23/10/2019
M04		30	39/F	17/06/2019	17/07/2019	23/10/2019
		29	38/F	17/06/2019	17/07/2019	23/10/2019
狗比架		28	37/F	17/06/2019	17/07/2019	06/11/2019
		27	36/F	17/06/2019	17/07/2019	06/11/2019
		26	35/F	03/06/2019	03/07/2019	06/11/2019
		25	33/F	03/06/2019	03/07/2019	06/11/2019
		24	32/F	03/06/2019	03/07/2019	06/11/2019
狗比架		23	31/F	03/06/2019	03/07/2019	20/11/2019
M03		22	30/F	03/06/2019	03/07/2019	20/11/2019
隔火層		21	29/F	20/05/2019	19/06/2019	20/11/2019
		20	28/F	20/05/2019	19/06/2019	20/11/2019
		19	27/F	20/05/2019	19/06/2019	20/11/2019
狗比架		18	26/F	20/05/2019	19/06/2019	04/12/2019
		17	25/F	20/05/2019	19/06/2019	04/12/2019
		16	23/F	06/05/2019	05/06/2019	04/12/2019
M02		15	22/F	06/05/2019	05/06/2019	04/12/2019
		14	21/F	06/05/2019	05/06/2019	04/12/2019
狗比架		13	20/F	06/05/2019	05/06/2019	18/12/2019
		12	19/F	06/05/2019	05/06/2019	18/12/2019
		11	18/F	22/04/2019	22/05/2019	18/12/2019
		10	17/F	22/04/2019	22/05/2019	18/12/2019
		9	16/F	22/04/2019	22/05/2019	18/12/2019
狗比架		8	15/F	22/04/2019	22/05/2019	02/01/2020
		7	12/F	22/04/2019	22/05/2019	02/01/2020
M01		6	11/F	08/04/2019	08/05/2019	02/01/2020
		5	10/F	08/04/2019	08/05/2019	02/01/2020
狗比架		4	9/F	08/04/2019	08/05/2019	02/01/2020
		3	8/F	08/04/2019	08/05/2019	16/01/2020
		2	7/F	08/04/2019	08/05/2019	16/01/2020
		1	6/F	29/07/2019	28/08/2019	16/01/2020

7月中平頂
9月頭拆秤
9月中拆棚

Start	08/04/2019	08/05/2019	11/09/2019
End	29/07/2019	28/08/2019	16/01/2020
日數	112	112	127
	預180-200爐		預 2wk完5層

以玻璃廠為準 以地盆要求為準

 美特鋁質有限公司 MIDI Aluminium Fabricator Ltd.				類別	物料號		
				制圖 陳俊樺	2019.3.17	圖號 G1	
修改				復核		數量	見BOM表
日期				批准		位置	

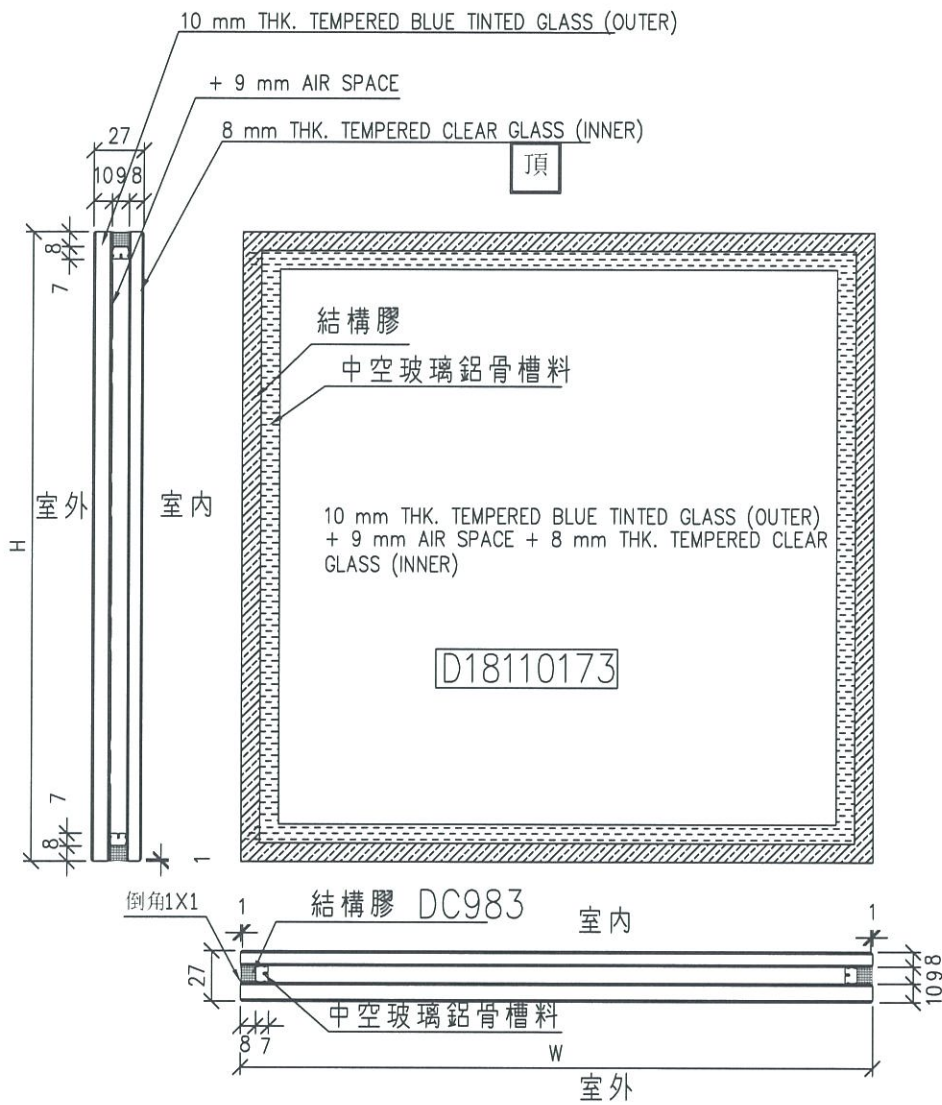


工程號	J-837	地盤	觀塘裕民坊	附 件	①
名稱	玻璃加工圖		採用		
材料			地盤		
顏色	10BLUE T+9A+8T中空玻璃		工廠		




美特鋁質有限公司
MIDI Aluminium Fabricator Ltd.

類別		物料號	
制圖	陳俊樺	2019.3.17	圖號 G3
修改		復核	數量 見BOM表
日期		批准	位置

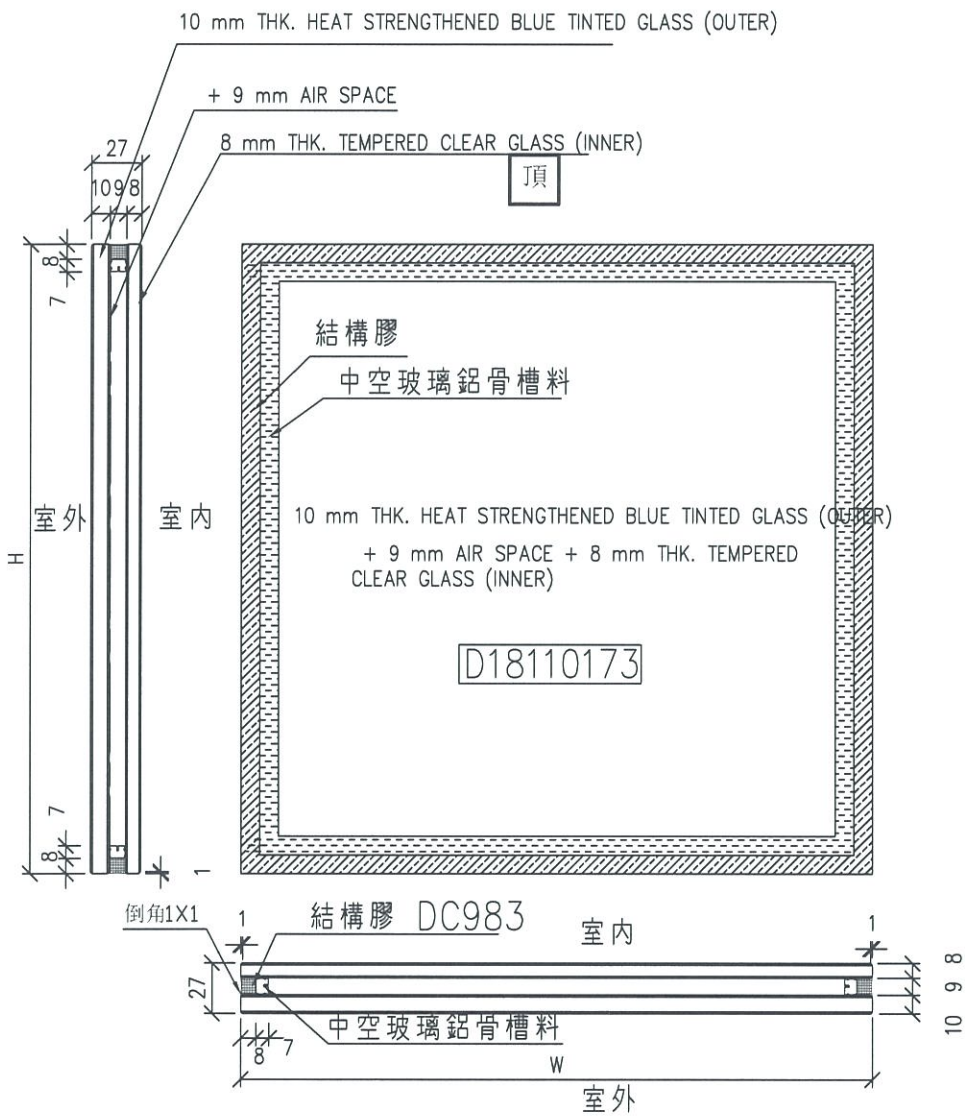


工程號	J-837	地盤	觀塘裕民坊	附 件	③
名稱	玻璃加工圖		採用		
材料			地盤		
顏色	10BLUE HS+9A+8T中空玻璃		工廠		

 美特鋁質有限公司 MIDI Aluminium Fabricator Ltd.				類別		物料號	
				制圖	陳俊樺	2019.3.17	圖號 G4
修改				復核			數量 見BOM表
日期				批准			位置

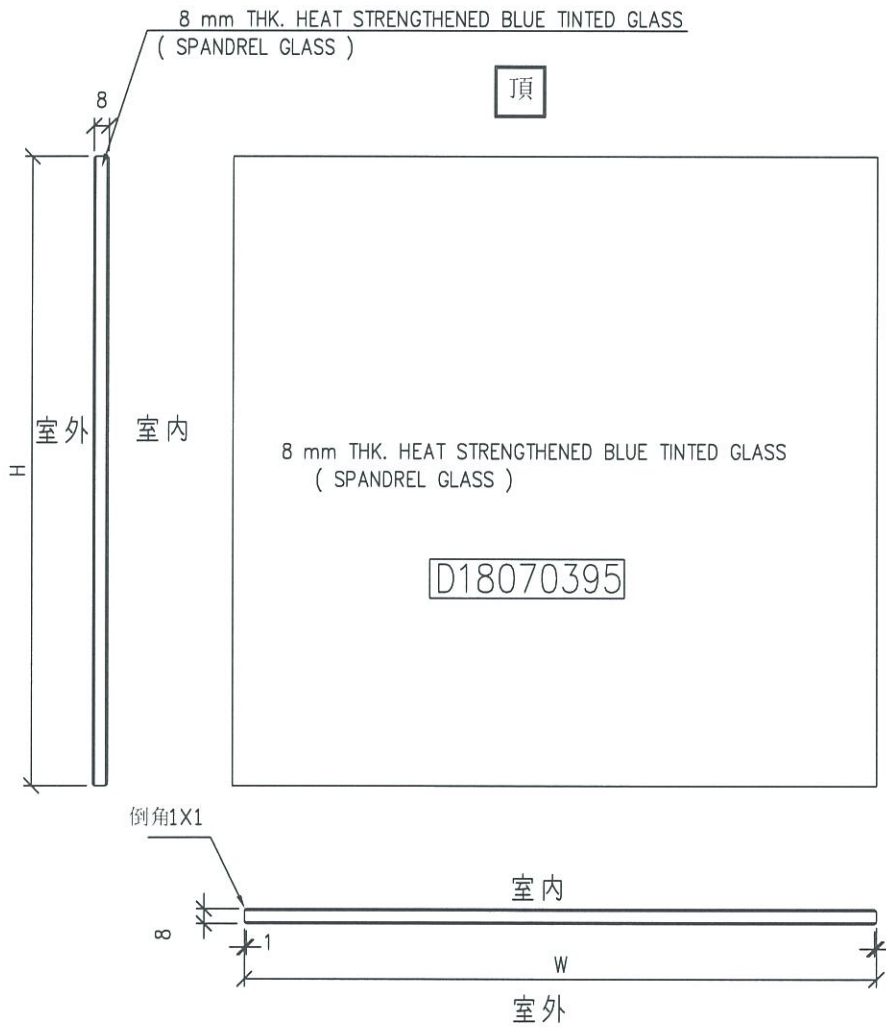

工程號	J-837	地盤	觀塘裕民坊	附 件	④
名稱	玻璃加工圖		採用		
材料	8 mm THK. HEAT STRENGTHENED BLUE	地盤			
顏色	TINTED GLASS (SPANDREL GLASS)	工廠			

 美特鋁質有限公司 MIDI Aluminium Fabricator Ltd.				類別		物料號	
				制圖	陳俊樺	2019.3.17	圖號 G6
修改				復核			數量 見BOM表
日期				批准			位置

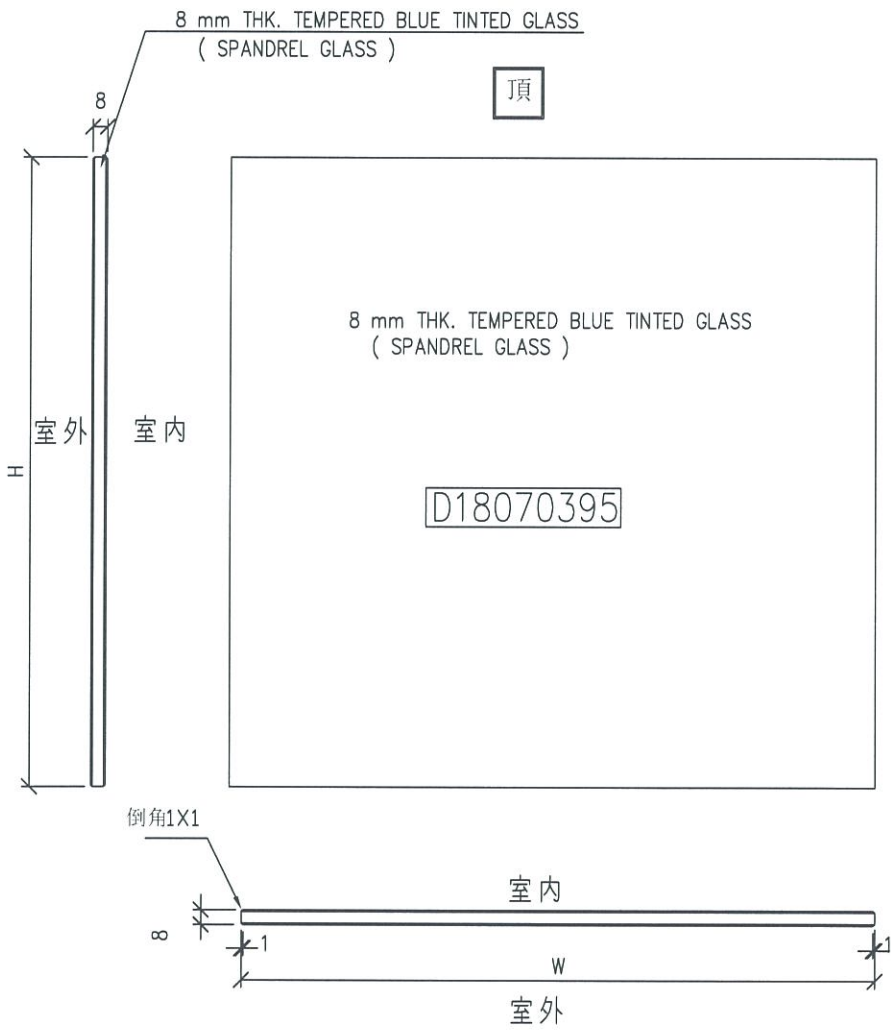

工程號	J-837	地盤	觀塘裕民坊	附 件	6
名稱	玻璃加工圖		採用		
材料	8 mm THK. TEMPERED BLUE TINTED GLASS		地盤		
顏色	(SPANDREL GLASS)		工廠		


工程號:	J837	計算:	陈俊桦	日期:	2019.3.9	送呈:	胡哥
地盤名稱:	觀塘裕民坊	核對:	謝永林/利春媚	日期:	2019.3.17	副本:	
項目類別:	T3座大貨SD門	批准:	趙門頂死牆	A/C Code:		計算參考數值/所屬位置 分格	
BM編號:J837-SL-M01-S-GP02	修改版次:	總計玻璃面積(平方米):	388	此BM依據第四版施工圖計算			

註明:分M0參考數據:(M0:570分格沒有7F-(5層), (M03:900分格有26层)

序號	修改內容	玻璃圖號	顏色與類型	厚度(mm)	玻璃尺寸		數量(塊)	總面積(平方米)	使用位置	單位	樓層	分屬類型	分格寬度	分格高度	MO1:	MO2:	MO3:	MO4:	MO5:	合計	每层
					7F,9-12F,15F(6層)	16F-23F(8層)									25-26F,28-32F(7層)	33F,35-41F(8層)	42F-48F以上不等				

以下玻璃尺寸全部為細玻璃(可入沙機)

120		G4-SD-303	G4	8.00	775.0	506.0	37	14.51	T3CWM-2	M	9F-25F/27F-51F	趙門梗頂死牆	835.0	570.0	5	8	7	8	9	37	1
121		G4-SD-303a	G4	8.00	775.0	836.0	1	0.65	T3CWM-2	M	26F	趙門梗頂死牆	835.0	900.0			1				
122		G4-SD-304	G4	8.00	707.5	506.0	37	13.25	T3CWL-2	L	9F-25F/27F-51F	趙門梗頂死牆	767.5	570.0	5	8	7	8	9	37	1
123		G4-SD-304a	G4	8.00	707.5	836.0	1	0.59	T3CWL-2	L	26F	趙門梗頂死牆	767.5	900.0			1				
124		G4-SD-307	G4	8.00	707.5	506.0	36	12.89	T3CWK-1	K	9F-25F/27F-50F	趙門梗頂死牆	767.5	570.0	5	8	7	8	8	36	1
125		G4-SD-307a	G4	8.00	707.5	836.0	1	0.59	T3CWK-1	K	26F	趙門梗頂死牆	767.5	900.0			1				
126		G4-SD-308	G4	8.00	800.0	506.0	36	14.57	T3CWJ-2	J	9F-25F/27F-50F	趙門梗頂死牆	860.0	570.0	5	8	7	8	8	36	1
127		G4-SD-308a	G4	8.00	800.0	836.0	1	0.67	T3CWJ-2	J	26F	趙門梗頂死牆	860.0	900.0			1				
128		G4-SD-309	G4	8.00	707.5	506.0	36	12.89	T3CWJ-1	J	9F-25F/27F-50F	趙門梗頂死牆	767.5	570.0	5	8	7	8	8	36	1
129		G4-SD-309a	G4	8.00	707.5	836.0	1	0.59	T3CWJ-1	J	26F	趙門梗頂死牆	767.5	900.0			1				
130		G4-SD-311	G4	8.00	757.5	506.0	36	13.80	T3CWH-1	H	9F-25F/27F-50F	趙門梗頂死牆	817.5	570.0	5	8	7	8	8	36	1
131		G4-SD-311a	G4	8.00	757.5	836.0	1	0.63	T3CWH-1	H	26F	趙門梗頂死牆	817.5	900.0			1				
132		G4-SD-312	G4	8.00	707.5	506.0	37	13.25	T3CWC-2	C	9F-25F/27F-51F	趙門梗頂死牆	767.5	570.0	5	8	7	8	9	37	1
133		G4-SD-312a	G4	8.00	707.5	836.0	1	0.59	T3CWC-2	C	26F	趙門梗頂死牆	767.5	900.0			1				
134		G4-SD-318	G4	8.00	756.0	506.0	36	13.77	T3CWD-1左	D	9F-25F/27F-50F	趙門梗頂死牆	816.0	570.0	5	8	7	8	8	36	1
135		G4-SD-318a	G4	8.00	756.0	836.0	1	0.63	T3CWD-1左	D	26F	趙門梗頂死牆	816.0	900.0			1				
136		G4-SD-319	G4	8.00	707.5	506.0	36	12.89	T3CWD-1右	D	9F-25F/27F-50F	趙門梗頂死牆	767.5	570.0	5	8	7	8	8	36	1
137		G4-SD-319a	G4	8.00	707.5	836.0	1	0.59	T3CWD-1右	D	26F	趙門梗頂死牆	767.5	900.0			1				
138		G4-SD-320	G4	8.00	707.5	506.0	36	12.89	T3CWG-1左	G	9F-25F/27F-50F	趙門梗頂死牆	767.5	570.0	5	8	7	8	8	36	1
139		G4-SD-320a	G4	8.00	707.5	836.0	1	0.59	T3CWG-1左	G	26F	趙門梗頂死牆	767.5	900.0			1				
140		G4-SD-321	G4	8.00	757.5	506.0	36	13.80	T3CWG-1右	G	9F-25F/27F-50F	趙門梗頂死牆	817.5	570.0	5	8	7	8	8	36	1
141		G4-SD-321a	G4	8.00	757.5	836.0	1	0.63	T3CWG-1右	G	26F	趙門梗頂死牆	817.5	900.0			1				
142		G4-SD-324	G4	8.00	707.5	506.0	20	7.16	T3CWM-1	M	30F-51F	趙門梗頂死牆	767.5	570.0	0	0	3	8	9	20	1
157							合計	430	162.42												
227		G6-SD-315	G4	8.00	847.5	506.0	37	15.87	T3CWB-2右	B	9F-25F/27F-51F	趙門梗頂死牆	907.5	570.0	5	8	7	8	9	37.0	1
229		G6-SD-316	G4	8.00	847.5	506.0	37	15.87	T3CWA-1左	A	9F-25F/27F-51F	趙門梗頂死牆	907.5	570.0	5	8	7	8	9	37.0	1
228		G6-SD-315a	G4	8.00	847.5	836.0	1	0.71	T3CWB-2右	B	26F	趙門梗頂死牆	907.5	900.0			1				
230		G6-SD-316a	G4	8.00	847.5	836.0	1	0.71	T3CWA-1左	A	26F	趙門梗頂死牆	907.5	900.0			1				


 美特鋁質有限公司 MIDI Aluminium Fabricator Ltd.		工程號:	J837	計算:	陈俊桦	日期:	2019.3.9	送呈:	胡哥	計算參考數值/所屬位置 分格					註明:分MO參考數據:(MO: 570分格沒有 7F-(5層), (MO3: 900分格有26层)						
		地盤名稱:	觀塘裕民坊	核對:	謝永林/利春媚	日期:	2019.3.17	副本:													
		項目類別:	T3座大貨SD門	批准:	趙門頂死牆	A/C Code:															
BM編號:J837-SL-M01-S-GP02		修改版次:	總計玻璃面積(平方米):			388	此BM依據第四版施工圖計算														
序號	修改內容	玻璃圖號	顏色與類型	厚度(mm)	玻璃尺寸		數量(塊)	總面積(平方米)	使用位置	單位	樓層	分屬類型	分格寬度	分格高度	MO1:	MO2:	MO3:	MO4:	MO5:	合計	每层
					7F,9-12F,15F(6層)	16F-23F(8層)									25-26F,28-32F(7層)	33F,35-41F(8層)	42F-48F以上不等	寬度(W mm)	高度(H mm)		
219		G6-SD-306	G4	8.00	875.0	506.0	36	15.94	T3CWK-2	K	9F-25F/27F-50F	趙門梗頂死牆	935.0	570.0	5	8	7	8	8	36.0	1
223		G6-SD-313	G4	8.00	875.0	506.0	37	16.38	T3CWC-1	C	9F-25F/27F-51F	趙門梗頂死牆	935.0	570.0	5	8	7	8	9	37.0	1
220		G6-SD-306a	G4	8.00	875.0	836.0	1	0.73	T3CWK-2	K	26F	趙門梗頂死牆	935.0	900.0			1				
224		G6-SD-313a	G4	8.00	875.0	836.0	1	0.73	T3CWC-1	C	26F	趙門梗頂死牆	935.0	900.0			1				
234		G6-SD-323	G4	8.00	925.0	506.0	15	7.02	T3CWE-1	E	36F-51F	趙門梗頂死牆	985.0	570.0	0	0	0	6	9	15.0	1
217		G6-SD-305	G4	8.00	925.0	506.0	37	17.32	T3CWL-1	L	9F-25F/27F-51F	趙門梗頂死牆	985.0	570.0	5	8	7	8	9	37.0	1
218		G6-SD-305a	G4	8.00	925.0	836.0	1	0.77	T3CWL-1	L	26F	趙門梗頂死牆	985.0	900.0			1				
233		G6-SD-322	G4	8.00	1047.5	506.0	22	11.66	T3CWF-1	F	28F-51F	趙門梗頂死牆	1107.5	570.0	0	0	5	8	9	22.0	1
215		G6-SD-302	G4	8.00	1107.5	506.0	37	20.73	T3CWE-1	E	9F-25F/27F-51F	趙門梗頂死牆	1167.5	570.0	5	8	7	8	9	37.0	1
216		G6-SD-302a	G4	8.00	1107.5	836.0	1	0.93	T3CWE-1	E	26F	趙門梗頂死牆	1167.5	900.0			1				
231		G6-SD-317	G4	8.00	1225.0	506.0	37	22.93	T3CWA-1右	A	9F-25F/27F-51F	趙門梗頂死牆	1285.0	570.0	5	8	7	8	9	37.0	1
232		G6-SD-317a	G4	8.00	1225.0	836.0	1	1.02	T3CWA-1右	A	26F	趙門梗頂死牆	1285.0	900.0			1				
213		G6-SD-301	G4	8.00	1307.5	506.0	36	23.82	T3CWF-1	F	9F-25F/27F-50F	趙門梗頂死牆	1367.5	570.0	5	8	7	8	8	36.0	1
214		G6-SD-301a	G4	8.00	1307.5	836.0	1	1.09	T3CWF-1	F	26F	趙門梗頂死牆	1367.5	900.0			1				
221		G6-SD-310	G4	8.00	1322.4	506.0	37	24.76	T3CWH-2	H	9F-25F/27F-51F	趙門梗頂死牆	1480.0	570.0	5	8	7	8	9	37.0	1
222		G6-SD-310a	G4	8.00	1322.4	836.0	1	1.11	T3CWH-2	H	26F	趙門梗頂死牆	1480.0	900.0			1				
225		G6-SD-314	G4	8.00	1325.0	506.0	37	24.81	T3CWB-2左	B	9F-25F/27F-51F	趙門梗頂死牆	1385.0	570.0	5	8	7	8	9	37.0	1
226		G6-SD-314a	G4	8.00	1325.0	836.0	1	1.11	T3CWB-2左	B	26F	趙門梗頂死牆	1385.0	900.0			1				
258							合計	415	226.01												
347							总计	845	388												
加工注意事項/玻璃類型描述:		1).本表中之清片玻璃是 信義 原片, 藍片玻璃是藍欣原片																			
		2).本表中所有玻璃對角線尺寸偏差要求不超過負2mm。																			
		3).本表中所有玻璃成品均需做雙面保護, 用透明靜電膠紙加四周一寸FK白膠紙做雙面加固保護處理。																			
		4).本表中所有玻璃成品均需注明室內外及其玻璃編號/使用位置/樓層, 以便識別。																			
		5) 請留意各座樓層不包括: MO1: 6F,13,14/F, 24/F, MO3: 27/F(只有死牆位置有計算), MO4: 34/F, MO5:44/F																			
		(G1)10 mm THK. TEMPERED BLUE GLASS (OUTER)+ 9 mm AIR SPACE + 8 mm THK. CLEAR TEMPERED GLASS (INNER) --- (D18110173)																			
		(G3)- 10 mm THK. Heat Strengthen BLUE GLASS (OUTER)+ 9 mm AIR SPACE + 8 mm THK. TEMPERED GLASS (INNER) --- (D18110173)																			
(G4)- 8 mm THK. HEAT STRENGTHENED BLUE TINTED GLASS (SPANDREL GLASS) --- (D18070395)																					
(G6)- 8 mm THK. TEMPERED BLUE TINTED GLASS (SPANDREL GLASS) --- (D18070395)																					
(G7) 8 mm THK. BLUE GLASS (OUTER)+1.52PVB + 8 mm THK. HEAT STRENGTHENED BLUE TINTED GLASS (INNER)--- (D18110174)																					

 地盤用玻璃B.M.表	工程號:	J837	計算:	陈俊桦	日期:	2019.3.9	送呈:	胡哥	計算參考數值/所屬位置 分格	註明: 分MO參考數據: (MO: 570分格沒有7F-(5層), (MO3: 900分格有26层)
	地盤名稱:	觀塘裕民坊	核對:	謝永林/利春媚	日期:	2019.3.17	副本:			
	項目類別:	T3座大貨SD門	批准:	趙門大梗	A/C Code:					
BM編號: J837-SL-M01-S-GP02	修改版次:	總計玻璃面積 (平方米):			1769	此BM依據第四版施工圖計算				

序號	修改內容	玻璃圖號	顏色與類型	厚度 (mm)	玻璃尺寸		數量 (塊)	總面積 (平方米)	使用位置	單位	樓層	分屬類型	分格寬度	分格高度	MO1:	MO2:	MO3:	MO4:	MO5:	合計	每層
					寬度 (W mm)	高度 (H mm)									7F,9-12F,15F (6層)	16F-23F(8層)	25-26F,28-32F (7層)	33F,35-41F (8層)	42F-48F 以上不等		

以下玻璃尺寸為細玻璃(可入沙機)

81		G3-SD-324	G3	27.00	647.5	2466.0	20	31.93	T3CWM-1	M	31F-52F	SD梗	767.5	2580.0	0	0	2	8	10	20	1
72		G3-SD-307	G3	27.00	647.5	2466.0	38	60.68	T3CWK-1	K	7F,9F-26F,28F-51F	SD梗	767.5	2580.0	6	8	7	8	9	38	1
74		G3-SD-309	G3	27.00	647.5	2466.0	38	60.68	T3CWJ-1	J	7F,9F-26F,28F-51F	SD梗	767.5	2580.0	6	8	7	8	9	38	1
78		G3-SD-319	G3	27.00	647.5	2466.0	38	60.68	T3CWD-1右	D	7F,9F-26F,28F-51F	SD梗	767.5	2580.0	6	8	7	8	9	38	1
79		G3-SD-320	G3	27.00	647.5	2466.0	38	60.68	T3CWG-1左	G	7F,9F-26F,28F-51F	SD梗	767.5	2580.0	6	8	7	8	9	38	1
71		G3-SD-304	G3	27.00	647.5	2466.0	39	62.27	T3CWL-2	L	7F,9F-26F,28F-52F	SD梗	767.5	2580.0	6	8	7	8	10	39	1
76		G3-SD-312	G3	27.00	647.5	2466.0	39	62.27	T3CWC-2	C	7F,9F-26F,28F-52F	SD梗	767.5	2580.0	6	8	7	8	10	39	1
77		G3-SD-318	G3	27.00	696.0	2466.0	38	65.22	T3CWD-1左	D	7F,9F-26F,28F-51F	SD梗	816.0	2580.0	6	8	7	8	9	38	1
75		G3-SD-311	G3	27.00	697.5	2466.0	38	65.36	T3CWH-1	H	7F,9F-26F,28F-51F	SD梗	817.5	2580.0	6	8	7	8	9	38	1
80		G3-SD-321	G3	27.00	697.5	2466.0	38	65.36	T3CWG-1右	G	7F,9F-26F,28F-51F	SD梗	817.5	2580.0	6	8	7	8	9	38	1
70		G3-SD-303	G3	27.00	715.0	2466.0	39	68.76	T3CWM-2	M	7F,9F-26F,28F-52F	SD梗	835.0	2580.0	6	8	7	8	10	39	1
73		G3-SD-308	G3	27.00	740.0	2466.0	38	69.34	T3CWJ-2	J	7F,9F-26F,28F-51F	SD梗	860.0	2580.0	6	8	7	8	9	38	1
36		G1-SD-315	G1	27.00	787.5	2466.0	39	75.74	T3CWB-2右	B	7F,9F-26F,28F-52F	SD梗	907.5	2580.0	6	8	7	8	10	39	1
37		G1-SD-316	G1	27.00	787.5	2466.0	39	75.74	T3CWA-1左	A	7F,9F-26F,28F-52F	SD梗	907.5	2580.0	6	8	7	8	10	39	1
32		G1-SD-306	G1	27.00	815.0	2466.0	38	76.37	T3CWK-2	K	7F,9F-26F,28F-51F	SD梗	935.0	2580.0	6	8	7	8	9	38	1
34		G1-SD-313	G1	27.00	815.0	2466.0	39	78.38	T3CWC-1	C	7F,9F-26F,28F-52F	SD梗	935.0	2580.0	6	8	7	8	10	39	1
40		G1-SD-323	G1	27.00	865.0	2466.0	15	32.00	T3CWE-1	E	37F-52F	SD梗	985.0	2580.0	0	0	0	5	10	15	1
31		G1-SD-305	G1	27.00	865.0	2466.0	39	83.19	T3CWL-1	L	7F,9F-26F,28F-52F	SD梗	985.0	2580.0	6	8	7	8	10	39	1
39		G1-SD-322	G1	27.00	987.5	2466.0	21	51.14	T3CWF-1	F	29F-51F	SD梗	1107.5	2580.0	0	0	4	8	9	21	1
30		G1-SD-302	G1	27.00	1047.5	2466.0	39	100.74	T3CWE-1	E	7F,9F-26F,28F-52F	SD梗	1167.5	2580.0	6	8	7	8	10	39	1
54							合計	710	1307												

 美特鋁質 有限公司 MIDI Aluminium Fabricator Ltd. 地盤用玻璃B.M.表	工程號:	J837	計算:	陳俊梓	日期: 2019.3.9	送呈:	胡哥	計算參考數值/所屬位置 分格	註明: 分MO參考數據: (MO: 570分格沒有7F-(5層), (MO3: 900分格有26层)
	地盤名稱:	觀塘裕民坊	核對:	謝永林/利春媚	日期: 2019.3.17	副本:			
	項目類別:	T3座大貨SD門	批准:	趙門大梗		A/C Code:			
BM編號: J837-SL-M01-S-GP02	修改版次:	總計玻璃面積 (平方米):			1769	此BM依據第四版施工圖計算			

序號	修改內容	玻璃圖號	顏色與類型	厚度 (mm)	玻璃尺寸		數量 (塊)	總面積 (平方米)	使用位置	單位	樓層	分屬類型	分格寬度	分格高度	MO1:	MO2:	MO3:	MO4:	MO5:	合計	每層
					7F,9-12F,15F (6層)	16F-23F(8層)									25-26F,28-32F (7層)	33F,35-41F (8層)	42F-48F 以上不等				


請注意: 以下尺寸為大玻璃，需另外分箱包裝，以下玻璃不用分層，只跟MO及分單位

38		G1-SD-317	G1	27.00	1165.0	2466.0	39	112.04	T3CWA-1右	A	7F,9F-26F,28F-52F	SD梗	1285.0	2580.0	6	8	7	8	10	39	1
33		G1-SD-310	G1	27.00	1166.5	2466.0	39	112.19	T3CWH-2	H	7F,9F-26F,28F-52F	SD梗	1480.0	2580.0	6	8	7	8	10	39	1
29		G1-SD-301	G1	27.00	1247.5	2466.0	38	116.90	T3CWF-1	F	7F,9F-26F,28F-51F	SD梗	1367.5	2580.0	6	8	7	8	9	38	1
35		G1-SD-314	G1	27.00	1265.0	2466.0	39	121.66	T3CWB-2左	B	7F,9F-26F,28F-52F	SD梗	1385.0	2580.0	6	8	7	8	10	39	1
258						合計	155	463													
347						总计	865	1769													



加工注意 事項/玻 璃類型描 述:	1).本表中之清片玻璃是 信義 原片，藍片玻璃是藍欣原片
	2).本表中所有玻璃對角線尺寸偏差要求不超過負2mm。
	3).本表中所有玻璃成品均需做雙面保護，用透明靜電膠紙加四周一寸FK白膠紙做雙面加固保護處理。
	4).本表中所有玻璃成品均需注明室內外及其玻璃編號/使用位置/樓層，以便識別。
	5) 請留意各座樓層不包括: MO1: 6/F,13,14/F，24/F，MO3: 27/F(只有死牆位置有計算)，MO4: 34/F，MO5:44/F
	(G1)10 mm THK. TEMPERED BLUE GLASS (OUTER)+ 9 mm AIR SPACE + 8 mm THK. CLEAR TEMPERED GLASS (INNER) --- (D18110173)
	(G3)- 10 mm THK. Heat Strengthen BLUE GLASS (OUTER)+ 9 mm AIR SPACE + 8 mm THK. TEMPERED GLASS (INNER) --- (D18110173)
(G4)- 8 mm THK. HEAT STRENGTHENED BLUE TINTED GLASS (SPANDREL GLASS) --- (D18070395)	
(G6)- 8 mm THK. TEMPERED BLUE TINTED GLASS (SPANDREL GLASS) --- (D18070395)	
(G7) 8 mm THK. BLUE GLASS (OUTER)+1.52PVB + 8 mm THK. HEAT STRENGTHENED BLUE TINTED GLASS (INNER)--- (D818110174)	

*請用A3紙打印

B.D. REF :

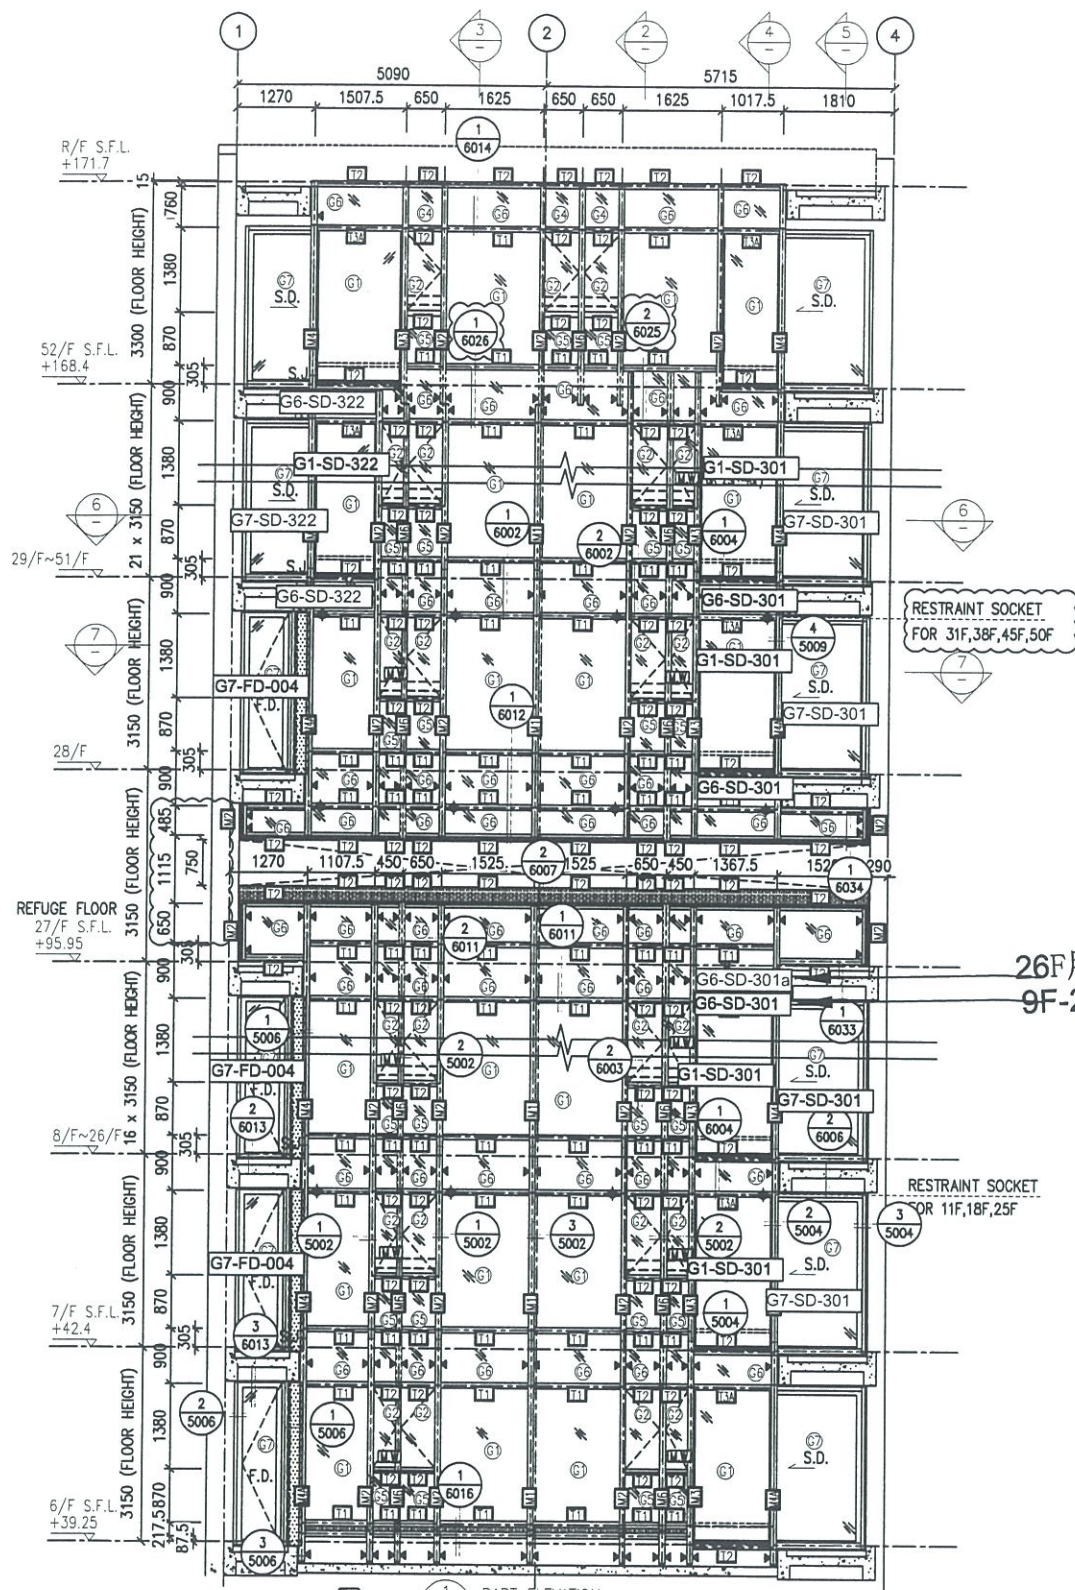

26F用900分格
9F-25F用570分格

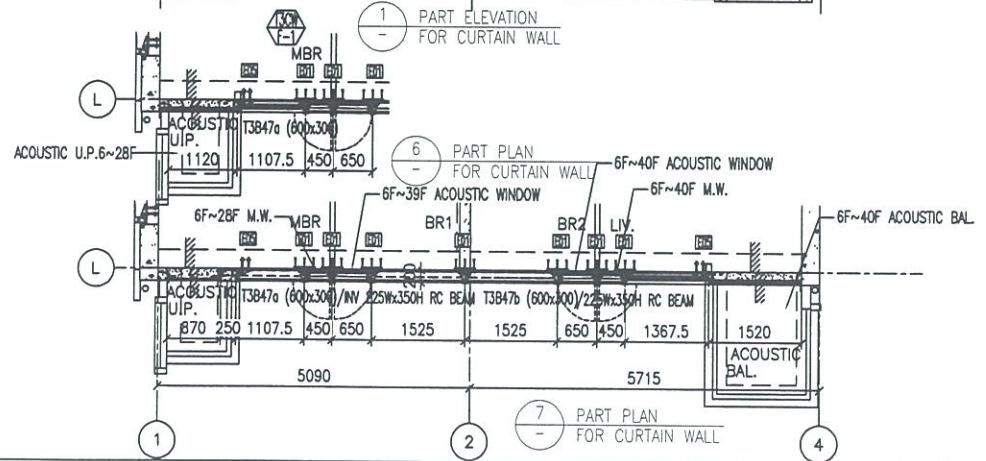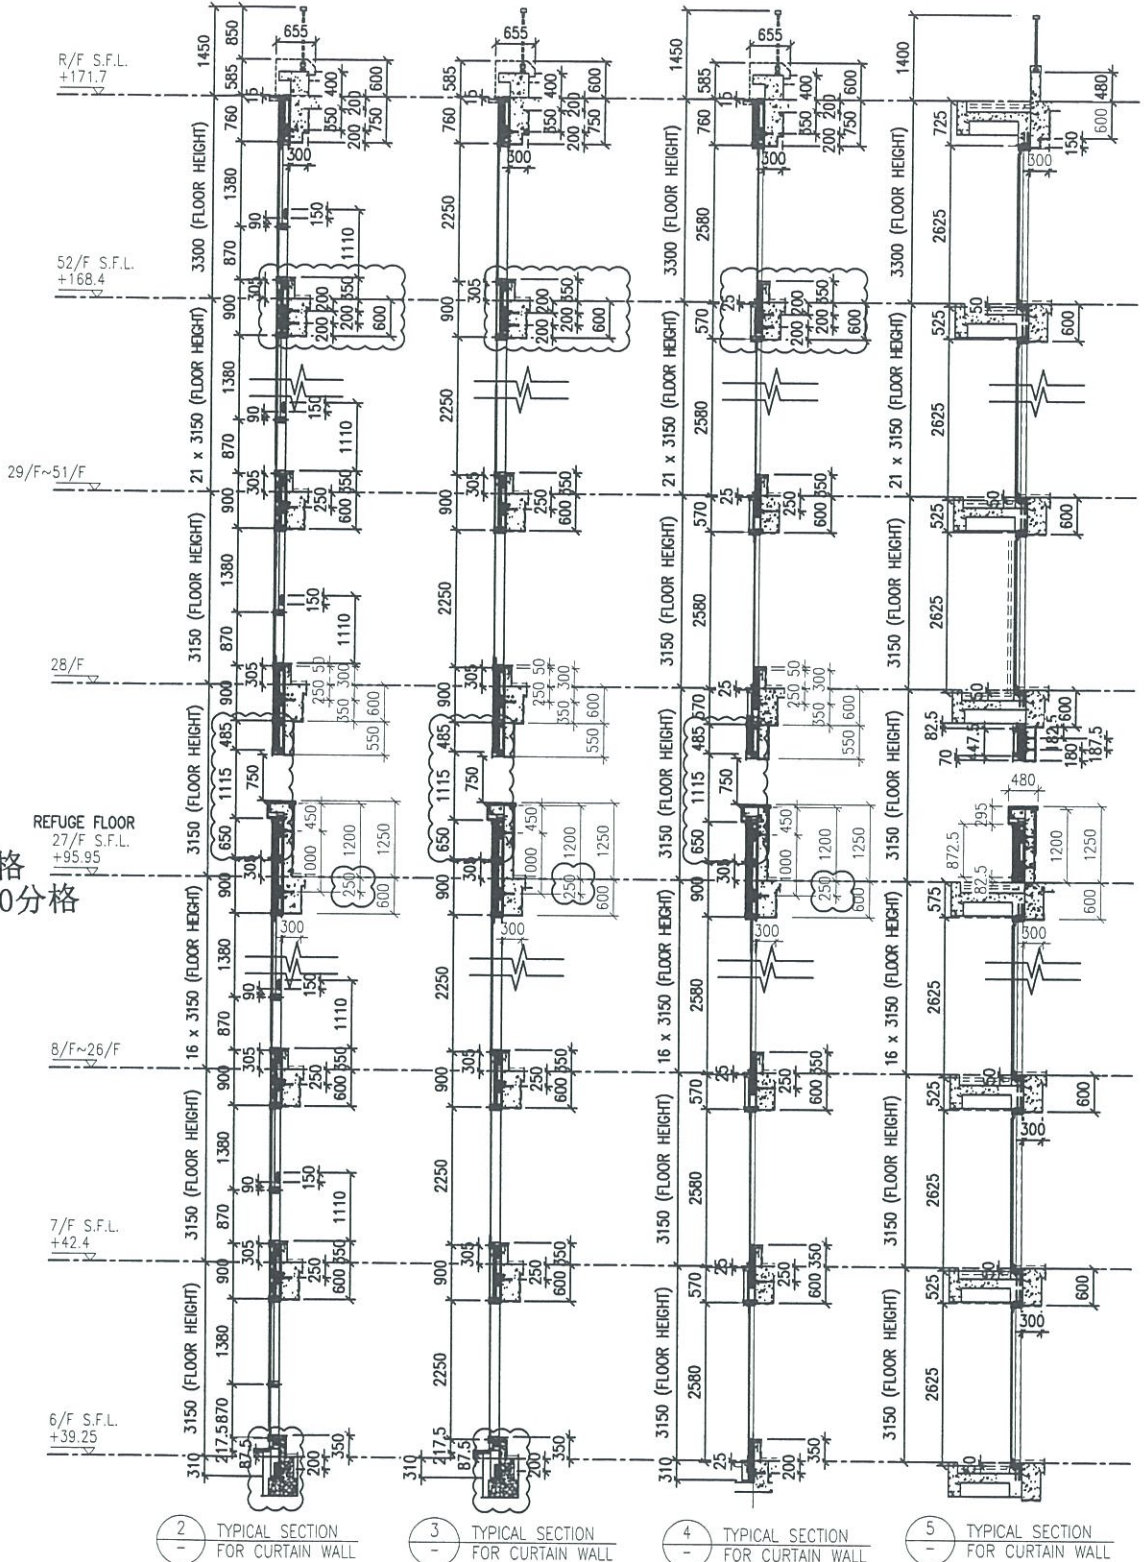

- LEGEND:**
- 10 mm THK. TEMPERED BLUE TINTED GLASS (OUTER) + 9 mm AIR SPACE + 8 mm THK. TEMPERED CLEAR GLASS (INNER)
 - 8 mm THK. HEAT STRENGTHENED TINTED GLASS (OUTER) + 9 mm AIR SPACE + 8 mm THK. HEAT STRENGTHENED CLEAR GLASS (INNER)
 - 10 mm THK. HEAT STRENGTHENED BLUE TINTED GLASS (OUTER) + 9 mm AIR SPACE + 8 mm THK. TEMPERED CLEAR GLASS (INNER)
 - 8 mm THK. HEAT STRENGTHENED BLUE TINTED GLASS (SPANDREL GLASS)
 - 8 mm THK. HEAT STRENGTHENED BLUE TINTED GLASS (OUTER) + 9 mm AIR SPACE + 8 mm THK. TEMPERED CLEAR GLASS (INNER)
 - 8 mm THK. TEMPERED BLUE TINTED GLASS (SPANDREL GLASS)
 - 8 mm THK. HEAT STRENGTHENED TINTED GLASS (OUTER) + 1.52PVB + 8 mm THK. HEAT STRENGTHENED CLEAR LAMINATED GLASS (INNER)
 - 10 mm THK. TEMPERED GLASS (INTERNAL PROTECTIVE BARRIER)
 - 3 mm THK. ALUM. CLADDING
 - M.W. - MAINTENANCE WINDOW
 - S.J. - STACK JOINT
 - AL-01 - ALUM. EXTRUSION DIE NO.
 - SUPPORT POINT
 - RESTRAINT SOCKET

CLIENT :
 信和置業有限公司
Sino Land Company Limited

ARCHITECT :
 WONG TUNG & PARTNERS LIMITED
ARCHITECTS & PLANNERS

MAIN CONTRACTOR :
 CR Construction Company Limited

STRUCTURAL ENGINEER :
 AECOM

FAÇADE CONSULTANT:
 AECOM

NOTE :
1. ALL DIMENSIONS ARE IN mm.
2. ALL ELEVATIONS ARE VIEWED FROM OUTSIDE.
3. ALL DIMENSIONS TO BE VERIFIED ON SITE BEFORE FABRICATION.

LEGEND :
 X1 - DETAIL MARK NO.
 X001 - REFER SHEET NO.
1. F.F.L. --- FINISHED FLOOR LEVEL
2. S.F.L. --- STRUCTURAL FLOOR LEVEL
3. (R) --- REVERSED DETAIL

NO.	DATE	REVISED	BY
E	17/01/2019	GENERAL REVISED	
D	22/12/2018	GENERAL REVISED	
C	04/12/2018	GENERAL REVISED	
B	24/11/2018	GENERAL REVISED	
A	10/9/2018	GENERAL REVISED	

JOB NO. : J-837
PROJECT :
URA KWUN TONG TOWN CENTRE
REDEVELOPMENT (AREA 2 & 3) AT
NKIL 6514, KWUN TONG, KWLOON

TITLE :
PART ELEVATION
OF CURTAIN WALL
AT TOWER 3

DATE : 04-JUL-18 SCALE : 1:60 (A1)
DRAWN BY : ASING CHECKED BY : -

美特鋁質有限公司
MIDI ALUMINIUM FABRICATOR LTD.
Units 6-8, Sunray Industrial Centre, 1/F
610 Cho Kwo Ling Road, Kowloon
Tel: 23489211-4 Fax: (852) 27727666
DWG NO. : J837-CW-2301 REV. : E

*請用A3紙打印


B.D. REF :
 CLIENT :
 信和置業有限公司
 Sino Land Company Limited
 ARCHITECT :
 WONG TUNG & PARTNERS LIMITED
 ARCHITECTS & PLANNERS
 MAIN CONTRACTOR :
 CR Construction Company Limited
 STRUCTURAL ENGINEER :
 AECOM
 FACADE CONSULTANT:
 AECOM

NOTE :
 1. ALL DIMENSIONS ARE IN mm.
 2. ALL ELEVATIONS ARE VIEWED FROM OUTSIDE.
 3. ALL DIMENSIONS TO BE VERIFIED ON SITE BEFORE FABRICATION.
 LEGEND :
 X1 -- DETAIL MARK NO.
 X001 -- REFER SHEET NO.
 1. F.F.L. --- FINISHED FLOOR LEVEL
 2. S.F.L. --- STRUCTURAL FLOOR LEVEL
 3. (R) --- REVERSED DETAIL

NO.	DATE	REVISED	BY
E	17/01/2019	GENERAL REVISED	
D	22/12/2018	GENERAL REVISED	
C	04/12/2018	GENERAL REVISED	
B	24/11/2018	GENERAL REVISED	
A	10/9/2018	GENERAL REVISED	

JOB NO. : J-837
 PROJECT :
 URA KWUN TONG TOWN CENTRE
 REDEVELOPMENT (AREA 2 & 3) AT
 NKIL 6514, KWUN TONG, KWLOON

TITLE :
 PART ELEVATION
 OF CURTAIN WALL
 AT TOWER 3
 DATE : 04-JUL-18 SCALE : 1:60 (A1)
 DRAWN BY : ASING CHECKED BY :
 美特鋁質有限公司
 MIDI ALUMINIUM FABRICATOR LTD.
 Units 6-8, Sunray Industrial Centre, 1/F
 610 Cho Kwo Ling Road, Kowloon
 Tel:23489211-4 Fax:(852)27727666
 DWG NO. : JB37-CW-2302 REV. : E

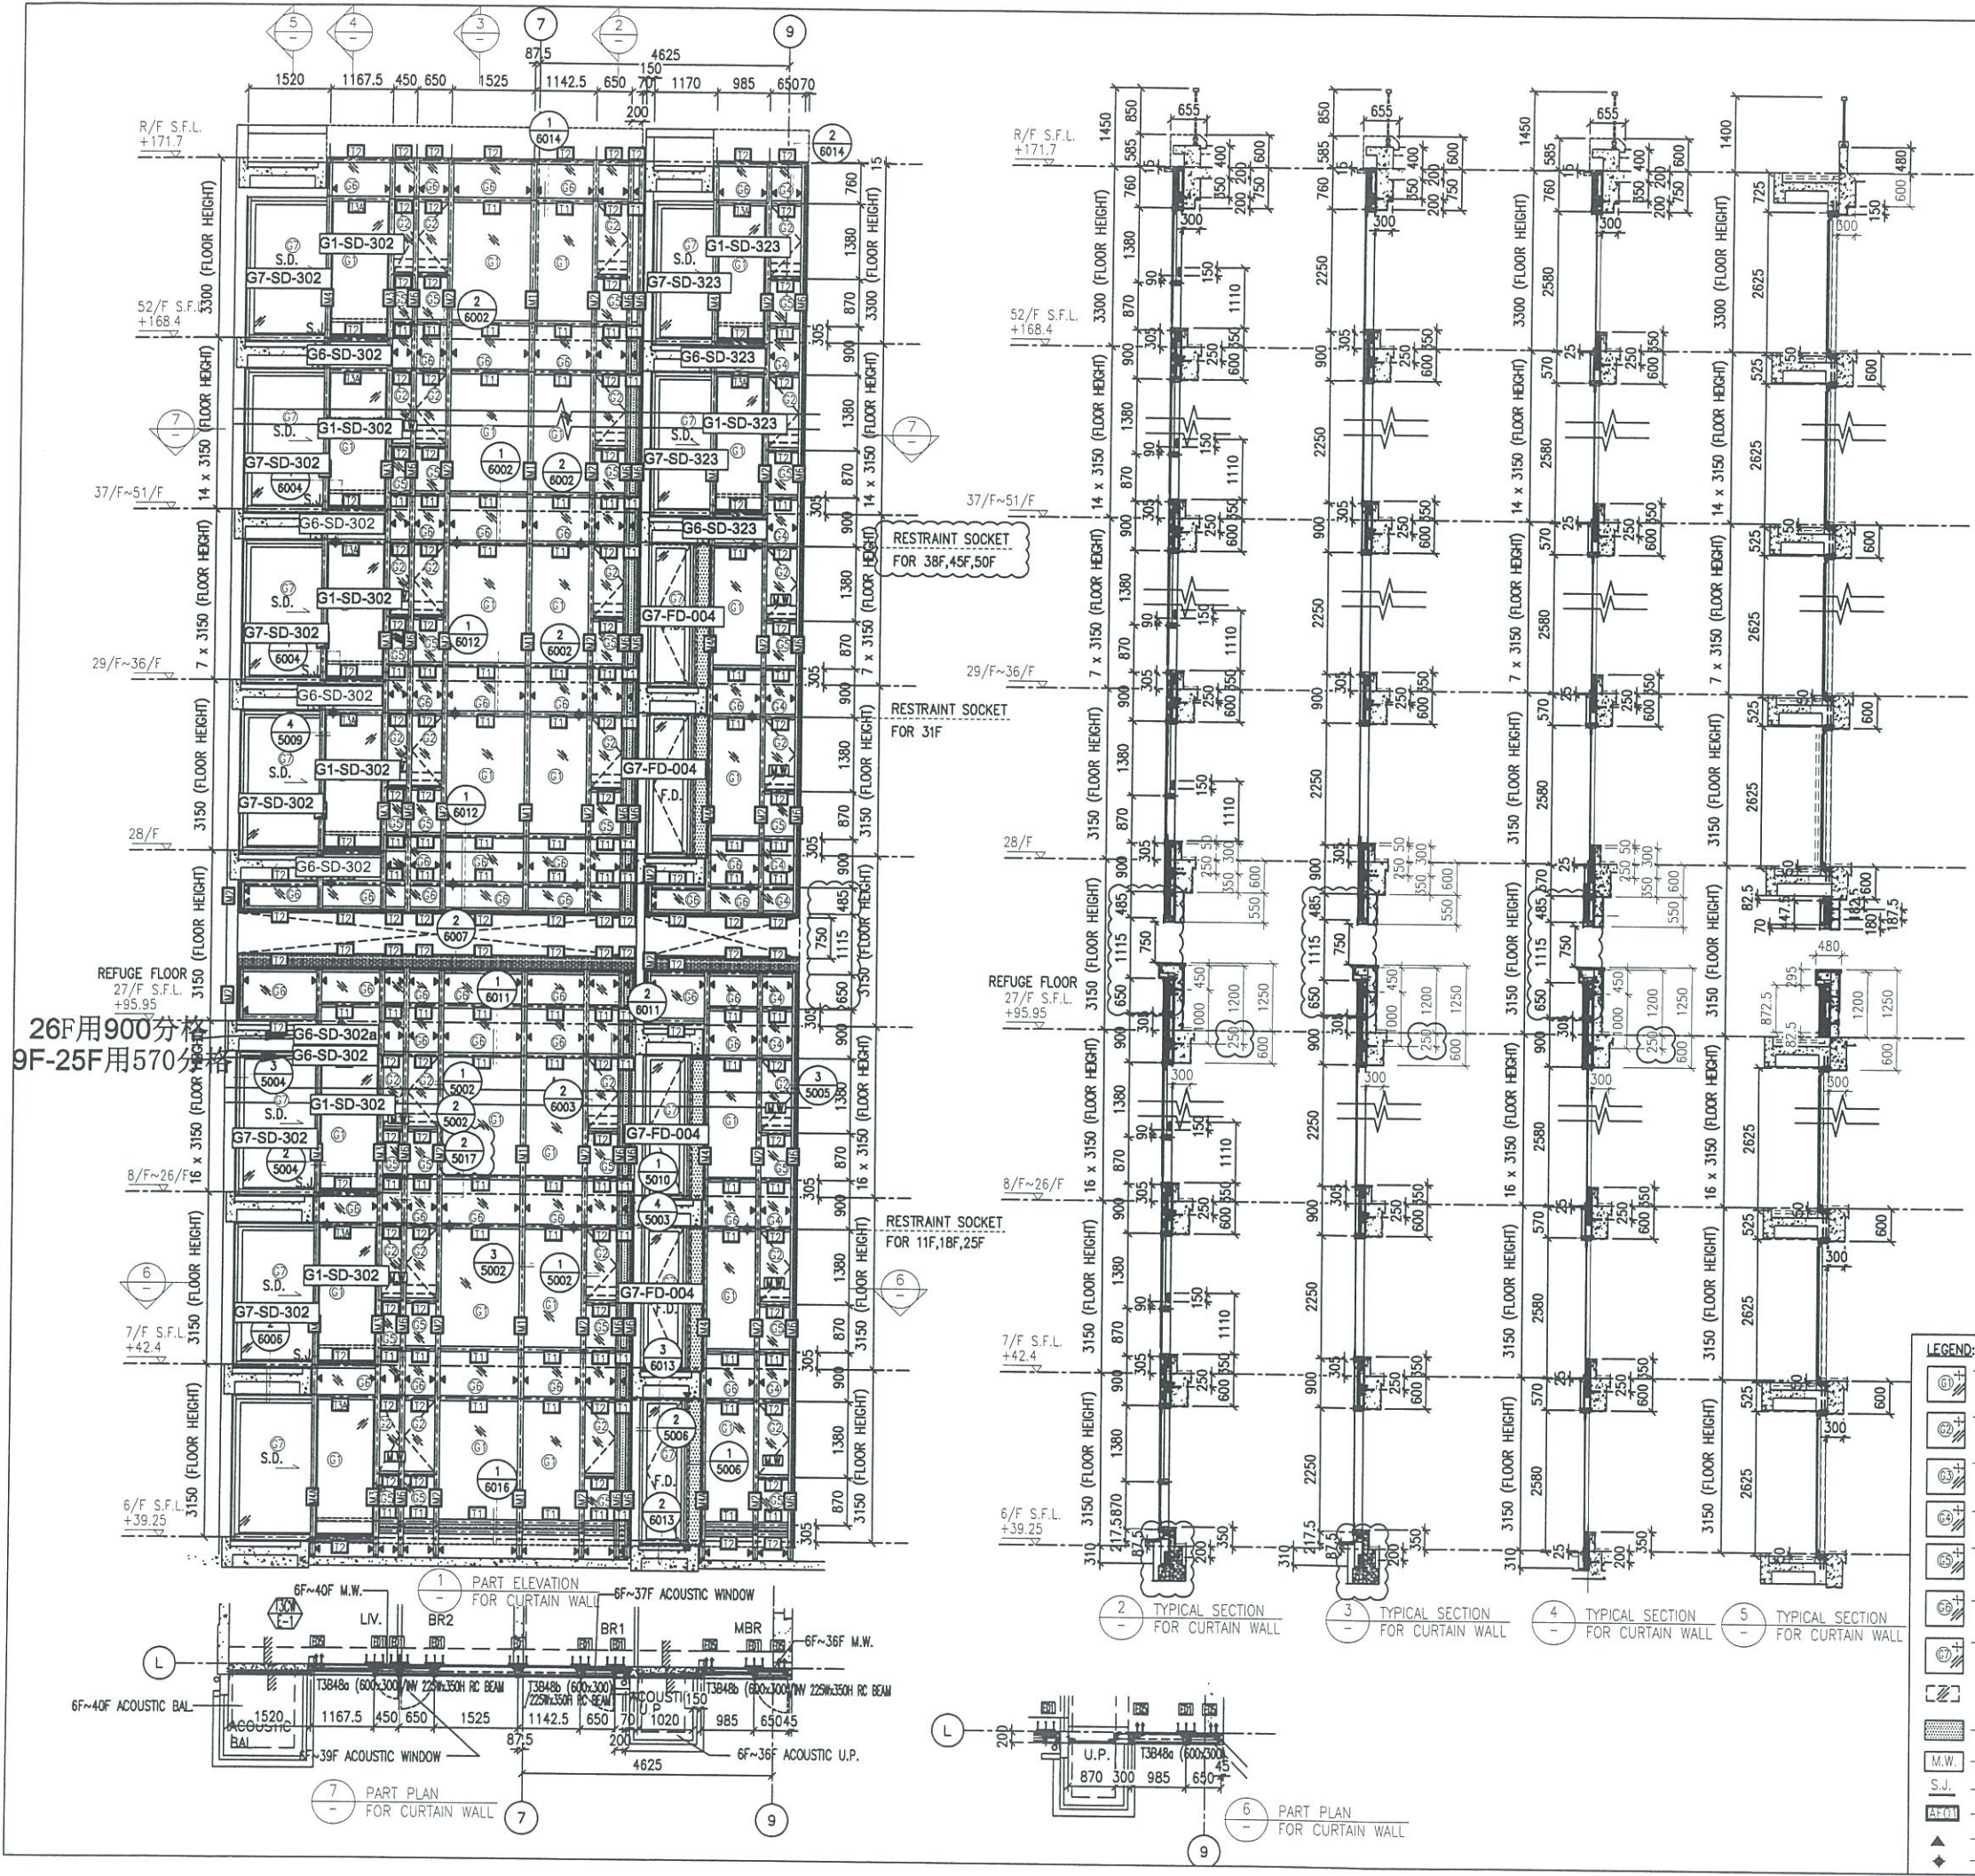

- LEGEND:
- 10 mm THK. TEMPERED BLUE TINTED GLASS (OUTER) + 9 mm AIR SPACE + 8 mm THK. TEMPERED CLEAR GLASS (INNER)
 - 8 mm THK. HEAT STRENGTHENED TINTED GLASS (OUTER) + 9 mm AIR SPACE + 8 mm THK. HEAT STRENGTHENED CLEAR GLASS (INNER)
 - 10 mm THK. HEAT STRENGTHENED BLUE TINTED GLASS (OUTER) + 9 mm AIR SPACE + 8 mm THK. TEMPERED CLEAR GLASS (INNER)
 - 8 mm THK. HEAT STRENGTHENED BLUE TINTED GLASS (SPANDREL GLASS)
 - 8 mm THK. HEAT STRENGTHENED BLUE TINTED GLASS (OUTER) + 1.52PVB + 8 mm THK. HEAT STRENGTHENED CLEAR LAMINATED GLASS (INNER)
 - 10 mm THK. TEMPERED GLASS (INTERNAL PROTECTIVE BARRIER)
 - 3 mm THK. ALUM. CLADDING
 - M.W. - MAINTENANCE WINDOW
 - S.J. - STACK JOINT
 - ALUM. EXTRUSION DIE NO.
 - SUPPORT POINT
 - RESTRAINT SOCKET

*請用A3紙打印

B.D. REF :

CLIENT :
 信和置業有限公司
 Sino Land Company Limited

ARCHITECT :
 WONG TUNG & PARTNERS LIMITED
 ARCHITECTS & PLANNERS

MAIN CONTRACTOR :
 CR Construction Company Limited

STRUCTURAL ENGINEER :
 AECOM

FAÇADE CONSULTANT:
 AECOM

NOTE:
 1. ALL DIMENSIONS ARE IN mm.
 2. ALL ELEVATIONS ARE VIEWED FROM OUTSIDE.
 3. ALL DIMENSIONS TO BE VERIFIED ON SITE BEFORE FABRICATION.

LEGEND:
 X1 -- DETAIL MARK NO.
 X001 -- REFER SHEET NO.

1. F.F.L. -- FINISHED FLOOR LEVEL
 2. S.F.L. -- STRUCTURAL FLOOR LEVEL
 3. (R) -- REVERSED DETAIL

NO.	DATE	REVISION	BY
E	17/01/2019	GENERAL REVISED	
D	22/12/2018	GENERAL REVISED	
C	04/12/2018	GENERAL REVISED	
B	24/11/2018	GENERAL REVISED	
A	10/9/2018	GENERAL REVISED	





JOB NO. : J-837
 PROJECT :
 URA KWUN TONG TOWN CENTRE
 REDEVELOPMENT (AREA 2 & 3) AT
 NKIL 6514, KWUN TONG, KWLOON









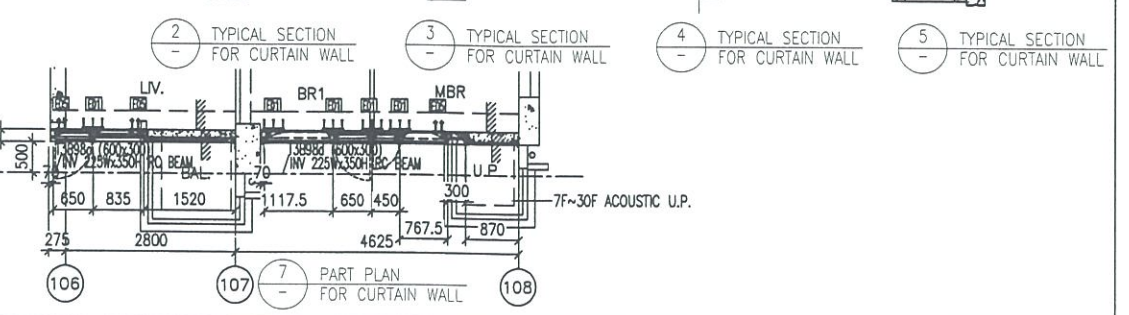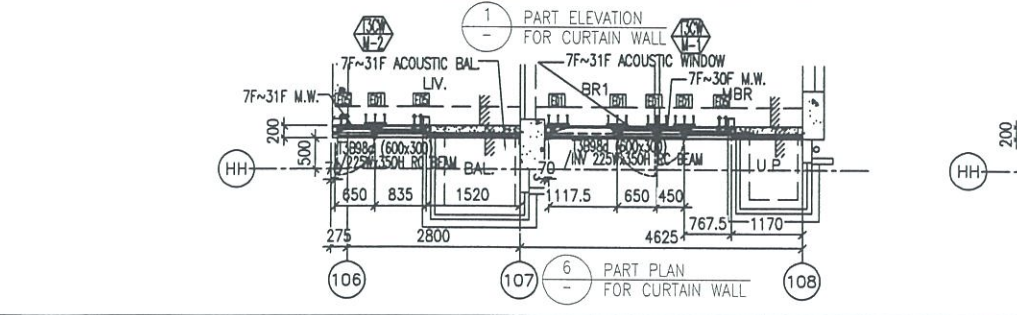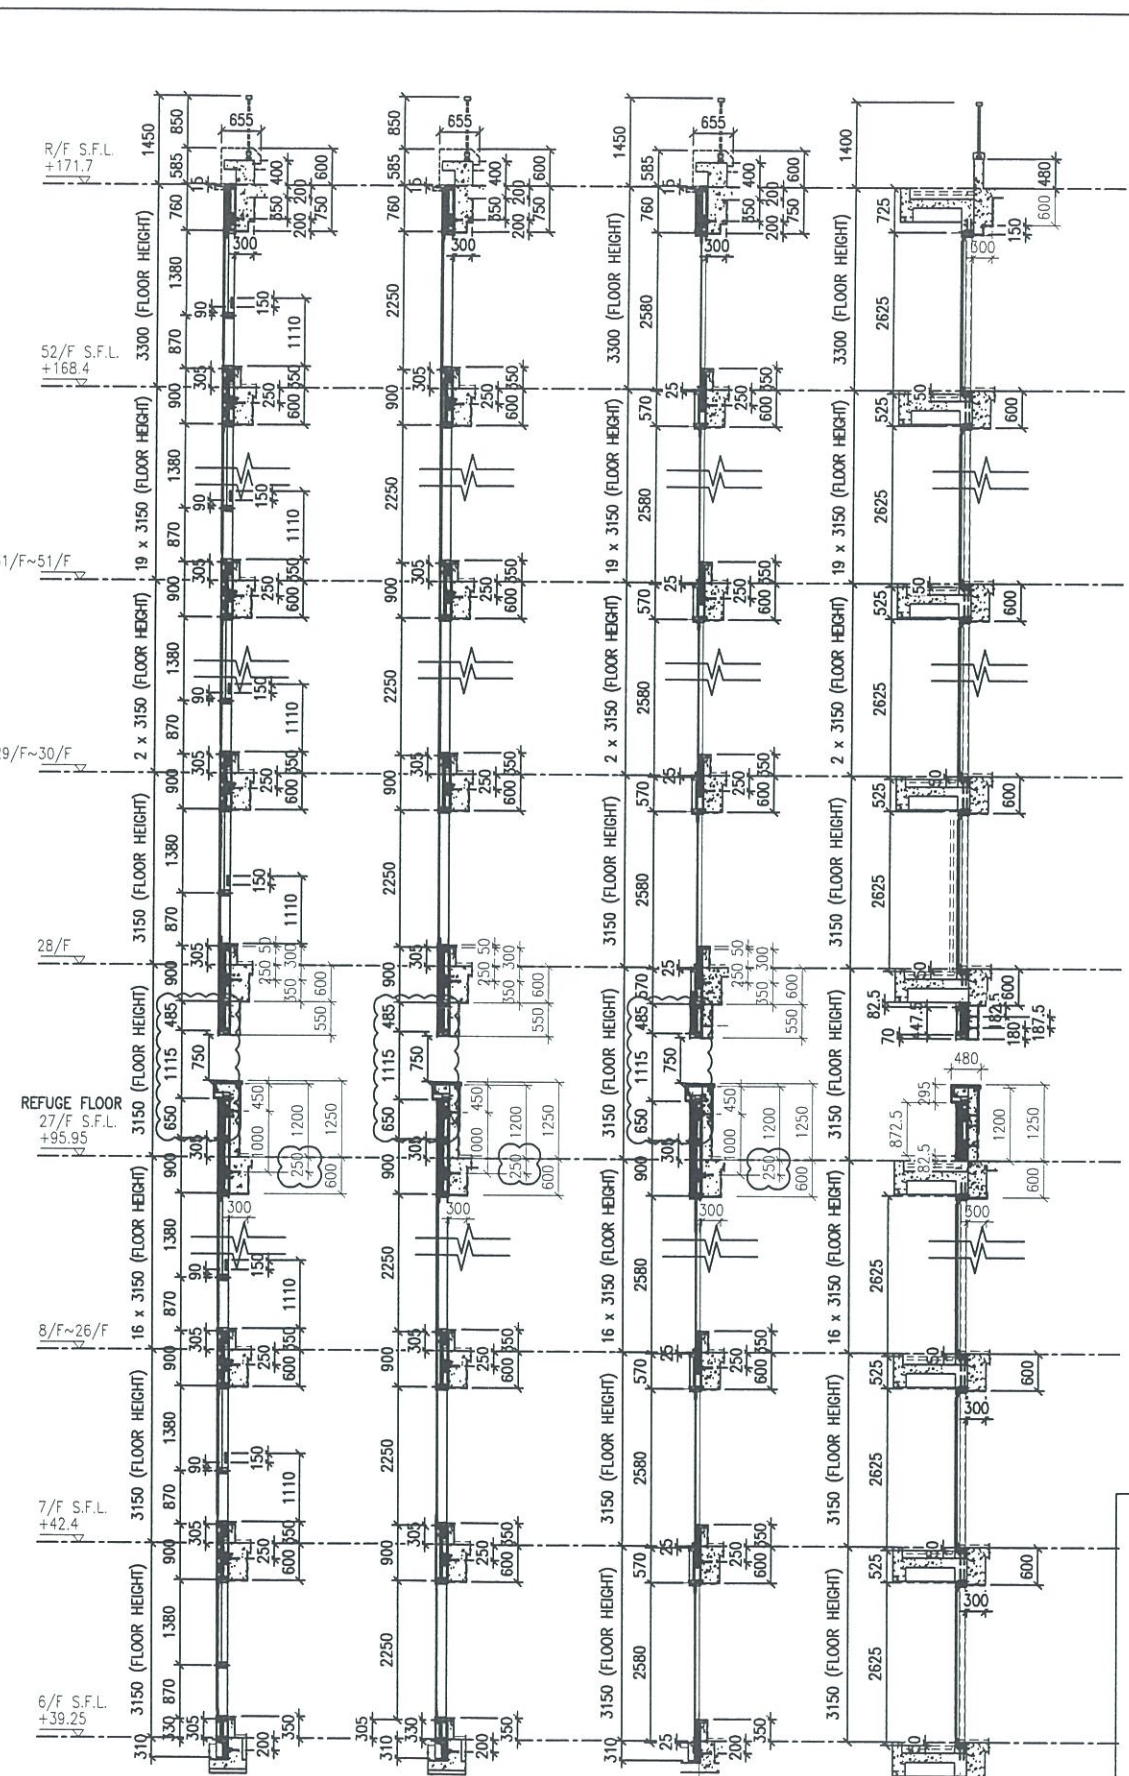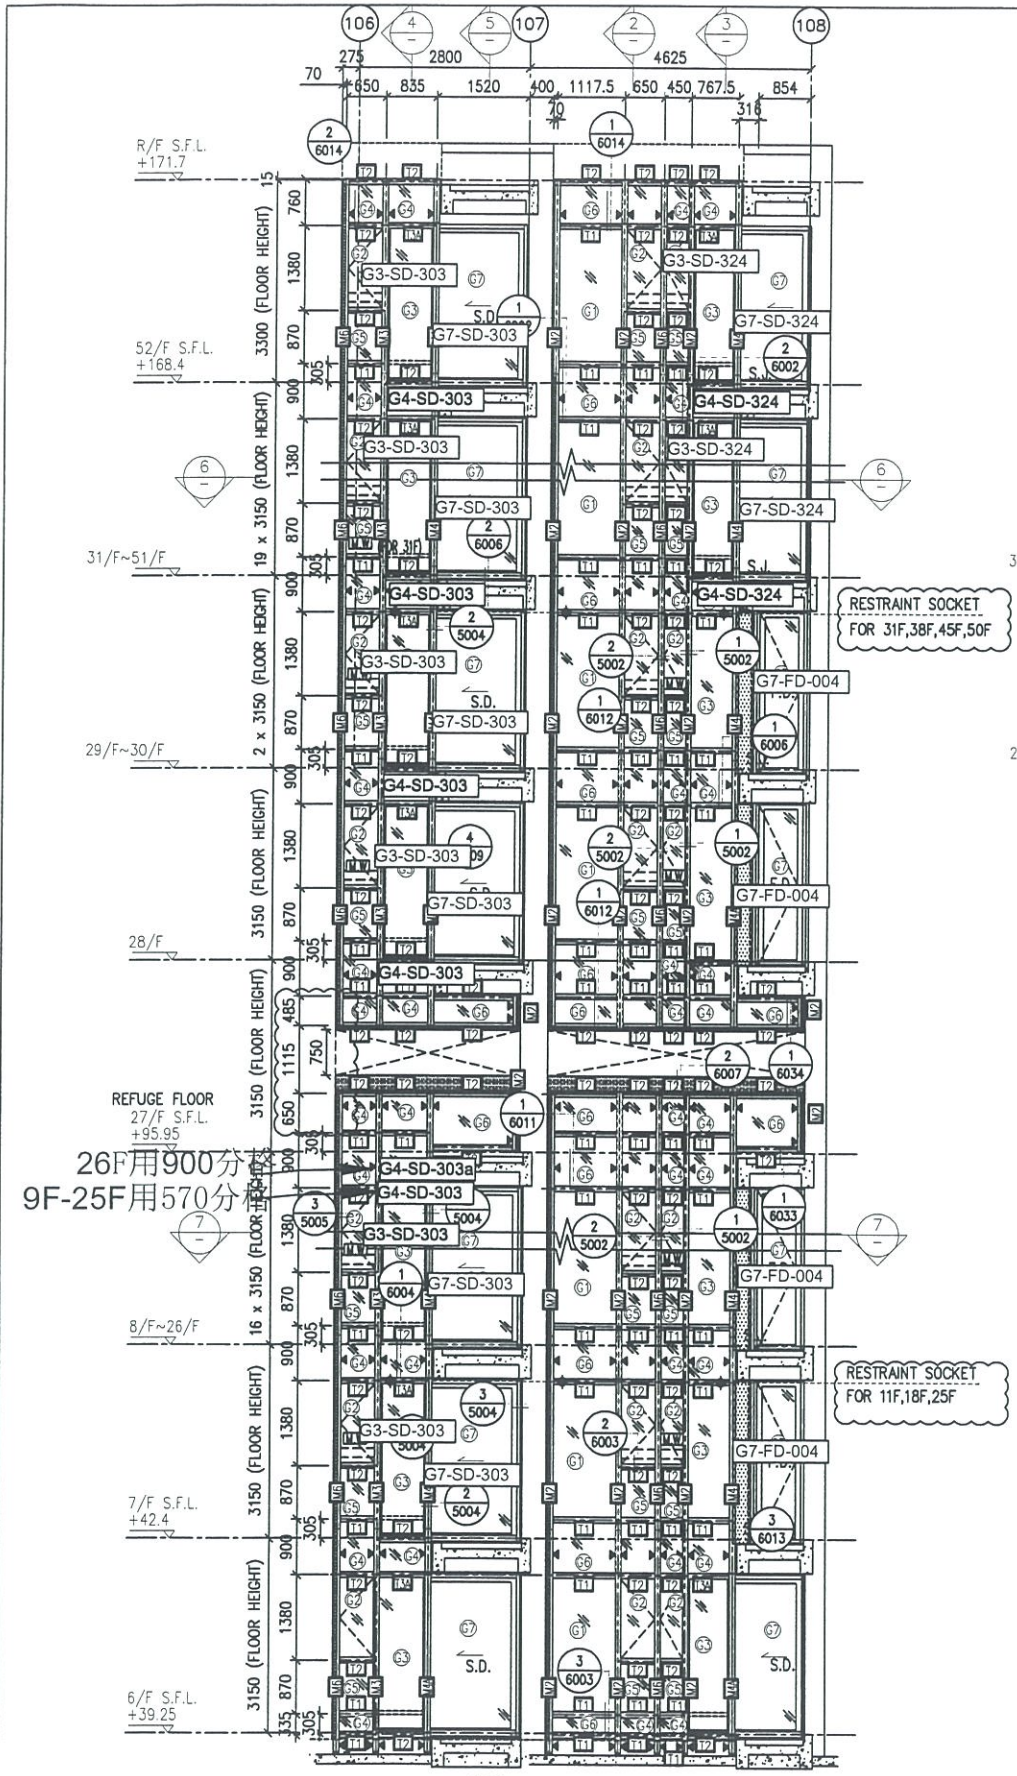




TITLE :
 PART ELEVATION
 OF CURTAIN WALL
 AT TOWER 3

DATE : 04-JUL-18 SCALE : 1:60 (A1)
 DRAWN BY : ASING CHECKED BY : -


 美特鋁質有限公司
 MIDI ALUMINUM FABRICATOR LTD.
 Units 6-8, Sunray Industrial Centre, 1/F
 610 Cha Kwo Ling Road, Kowloon
 Tel: 23489211-4 Fax: (852) 2727666

DWG NO. : J837-CW-2303 REV. : E

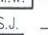


- LEGEND:
-  - 10 mm THK. TEMPERED BLUE TINTED GLASS (OUTER) + 9 mm AIR SPACE + 8 mm THK. TEMPERED CLEAR GLASS (INNER)
 -  - 8 mm THK. HEAT STRENGTHENED TINTED GLASS (OUTER) + 9 mm AIR SPACE + 8 mm THK. HEAT STRENGTHENED CLEAR GLASS (INNER)
 -  - 10 mm THK. HEAT STRENGTHENED BLUE TINTED GLASS (OUTER) + 9 mm AIR SPACE + 8 mm THK. TEMPERED CLEAR GLASS (INNER)
 -  - 8 mm THK. HEAT STRENGTHENED BLUE TINTED GLASS (SPANDREL GLASS)
 -  - 8 mm THK. HEAT STRENGTHENED BLUE TINTED GLASS (OUTER) + 9 mm AIR SPACE + 8 mm THK. TEMPERED CLEAR GLASS (INNER)
 -  - 8 mm THK. HEAT STRENGTHENED TINTED GLASS (OUTER) + 1.52PVB + 8 mm THK. HEAT STRENGTHENED CLEAR LAMINATED GLASS (INNER)
 -  - 10 mm THK. TEMPERED GLASS (INTERNAL PROTECTIVE BARRIER)
 -  - 3 mm THK. ALUM. CLADDING
 -  M.W. - MAINTENANCE WINDOW
 -  S.J. - STACK JOINT
 -  ALUM. - ALUM. EXTRUSION DIE NO.
 -  - SUPPORT POINT
 -  - RESTRAINT SOCKET

*請用A3紙打印

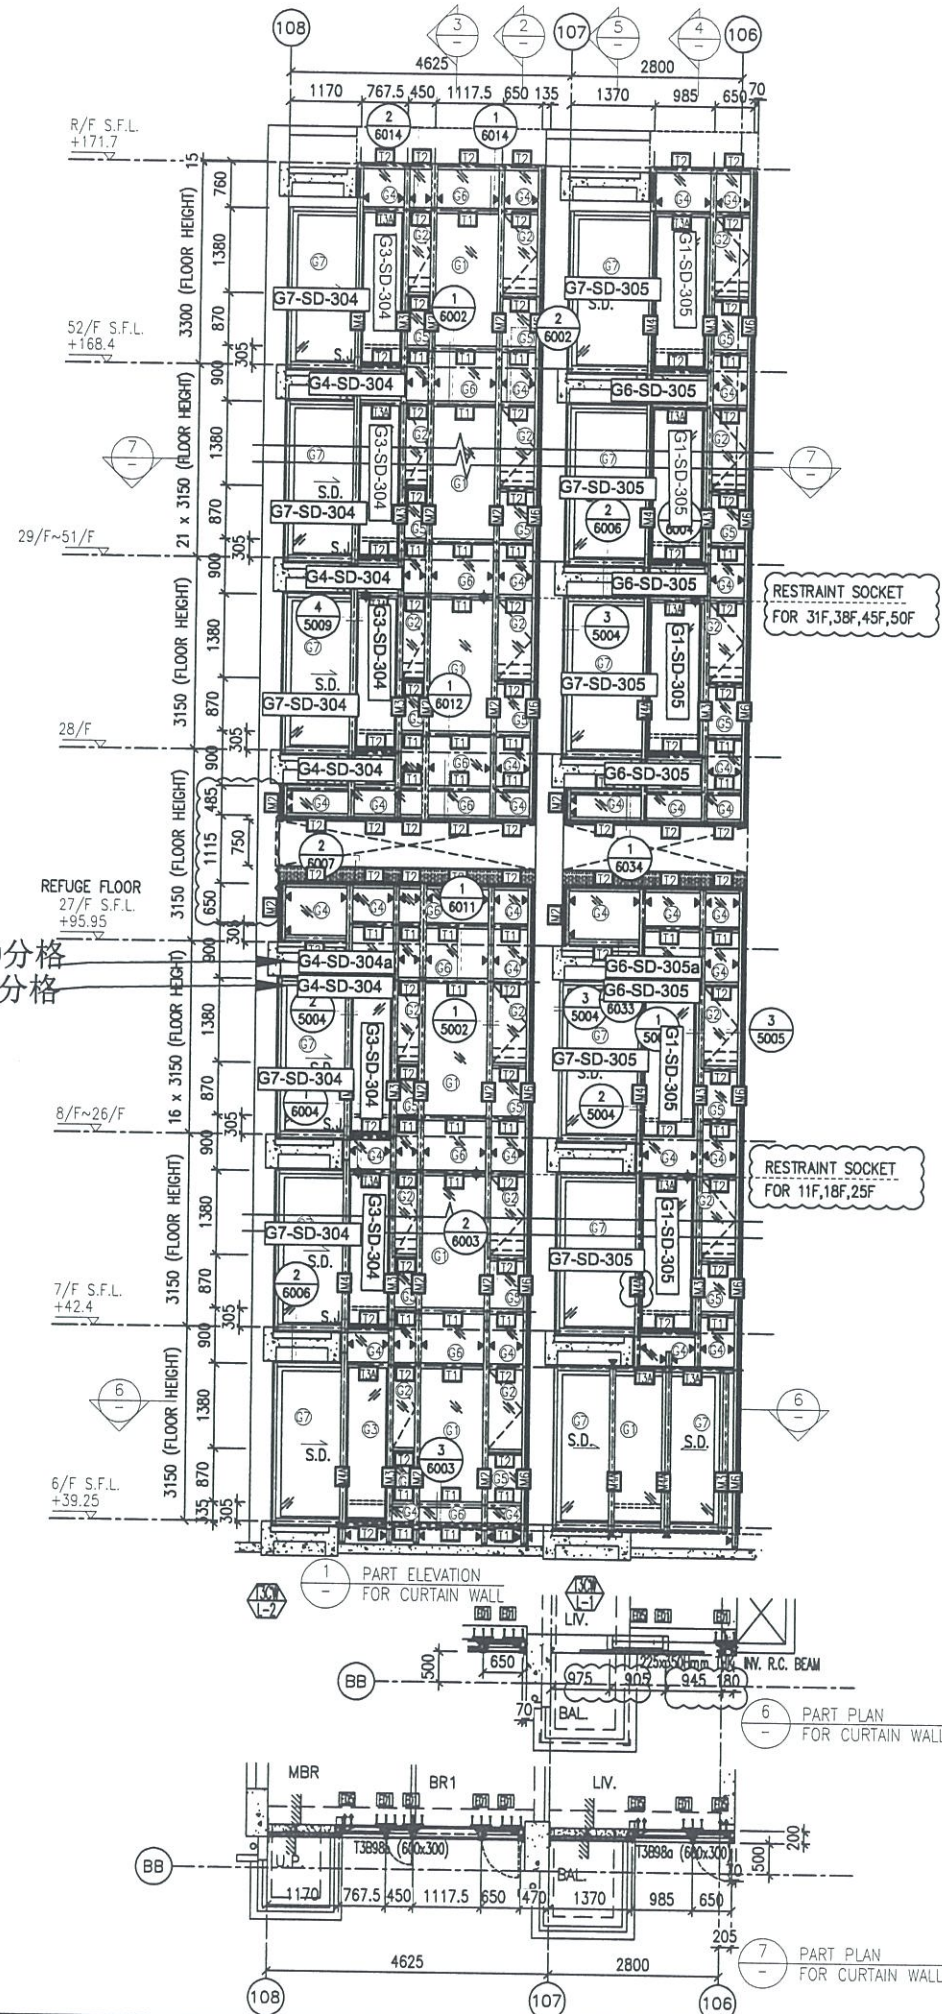

26F用900分格
9F-25F用570分格

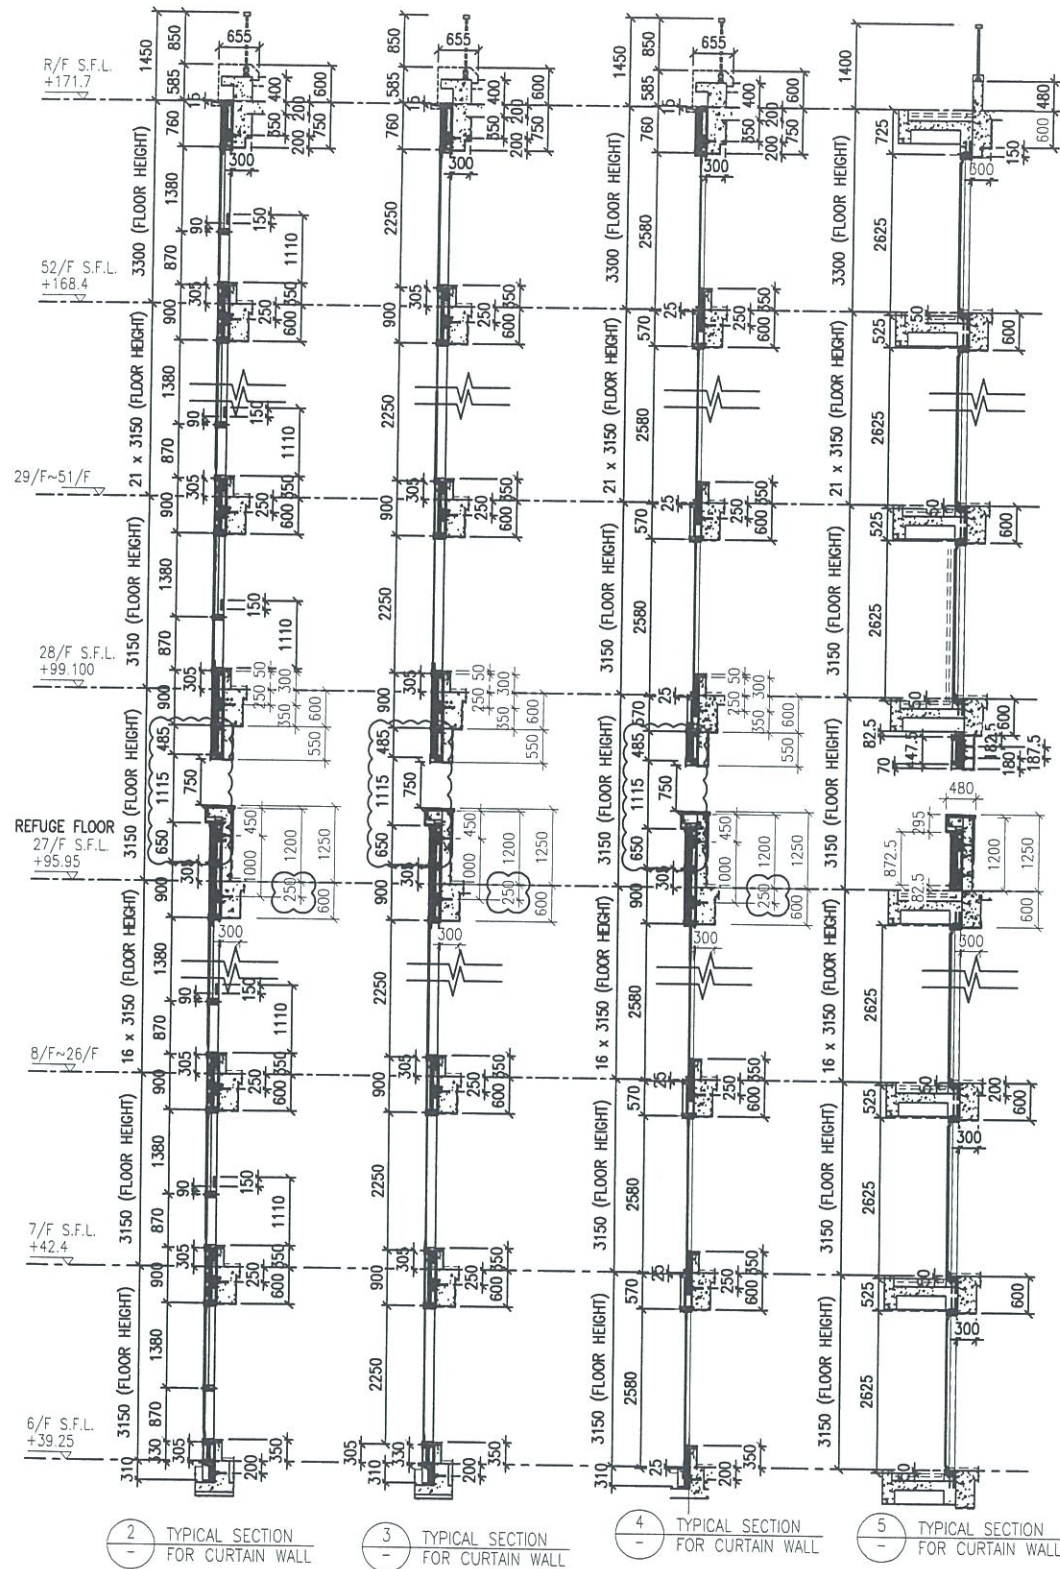

LEGEND:

- 10 mm THK. TEMPERED BLUE TINTED GLASS (OUTER) + 9 mm AIR SPACE + 8 mm THK. TEMPERED CLEAR GLASS (INNER)
- 8 mm THK. HEAT STRENGTHENED TINTED GLASS (OUTER) + 9 mm AIR SPACE + 8 mm THK. HEAT STRENGTHENED CLEAR GLASS (INNER)
- 10 mm THK. HEAT STRENGTHENED BLUE TINTED GLASS (OUTER) + 9 mm AIR SPACE + 8 mm THK. TEMPERED CLEAR GLASS (INNER)
- 8 mm THK. HEAT STRENGTHENED BLUE TINTED GLASS (SPANDREL GLASS)
- 8 mm THK. HEAT STRENGTHENED TINTED GLASS (OUTER) + 1.52PVB + 8 mm THK. HEAT STRENGTHENED CLEAR LAMINATED GLASS (INNER)
- 10 mm THK. TEMPERED GLASS (INTERNAL PROTECTIVE BARRIER)
- 3 mm THK. ALUM. CLADDING
- M.W. - MAINTENANCE WINDOW
- S.J. - STACK JOINT
- ALUM. EXTRUSION DIE NO.
- SUPPORT POINT
- RESTRAINT SOCKET

B.D. REF :

CLIENT :

信和置業有限公司
Sino Land Company Limited

ARCHITECT :
WONG TUNG & PARTNERS LIMITED
ARCHITECTS & PLANNERS



MAIN CONTRACTOR :

CR Construction Company Limited

STRUCTURAL ENGINEER :

AECOM

FAÇADE CONSULTANT:

AECOM

NOTE :

1. ALL DIMENSIONS ARE IN mm.
2. ALL ELEVATIONS ARE VIEWED FROM OUTSIDE.
3. ALL DIMENSIONS TO BE VERIFIED ON SITE BEFORE FABRICATION.

LEGEND :

- DETAIL MARK NO.
- REFER SHEET NO.

1. F.F.L. -- FINISHED FLOOR LEVEL
2. S.F.L. -- STRUCTURAL FLOOR LEVEL
3. (R) -- REVERSED DETAIL

NO.	DATE	REVISED	BY
E	17/01/2019	GENERAL REVISED	
D	22/12/2018	GENERAL REVISED	
C	04/12/2018	GENERAL REVISED	
B	24/11/2018	GENERAL REVISED	
A	10/9/2018	GENERAL REVISED	

JOB NO. : J-837
PROJECT :
URA KWUN TONG TOWN CENTRE
REDEVELOPMENT (AREA 2 & 3) AT
NKIL 6514, KWUN TONG, KWLOON

TITLE :
PART ELEVATION
OF CURTAIN WALL
AT TOWER 3

DATE : 04-JUL-18 SCALE : 1:60 (A1)


DRAWN BY : ASING CHECKED BY : -

美特鋁質有限公司
MIDI ALUMINIUM FABRICATOR LTD.
Units 6-8, Sunray Industrial Centre, 1/F
610 Cha Kwo Ling Road, Kowloon
Tel: 23489211-4 Fax: (852) 2727666

DWG NO. : JB37-CW-2304 REV. : E

*請用A3紙打印

B.D. REF :

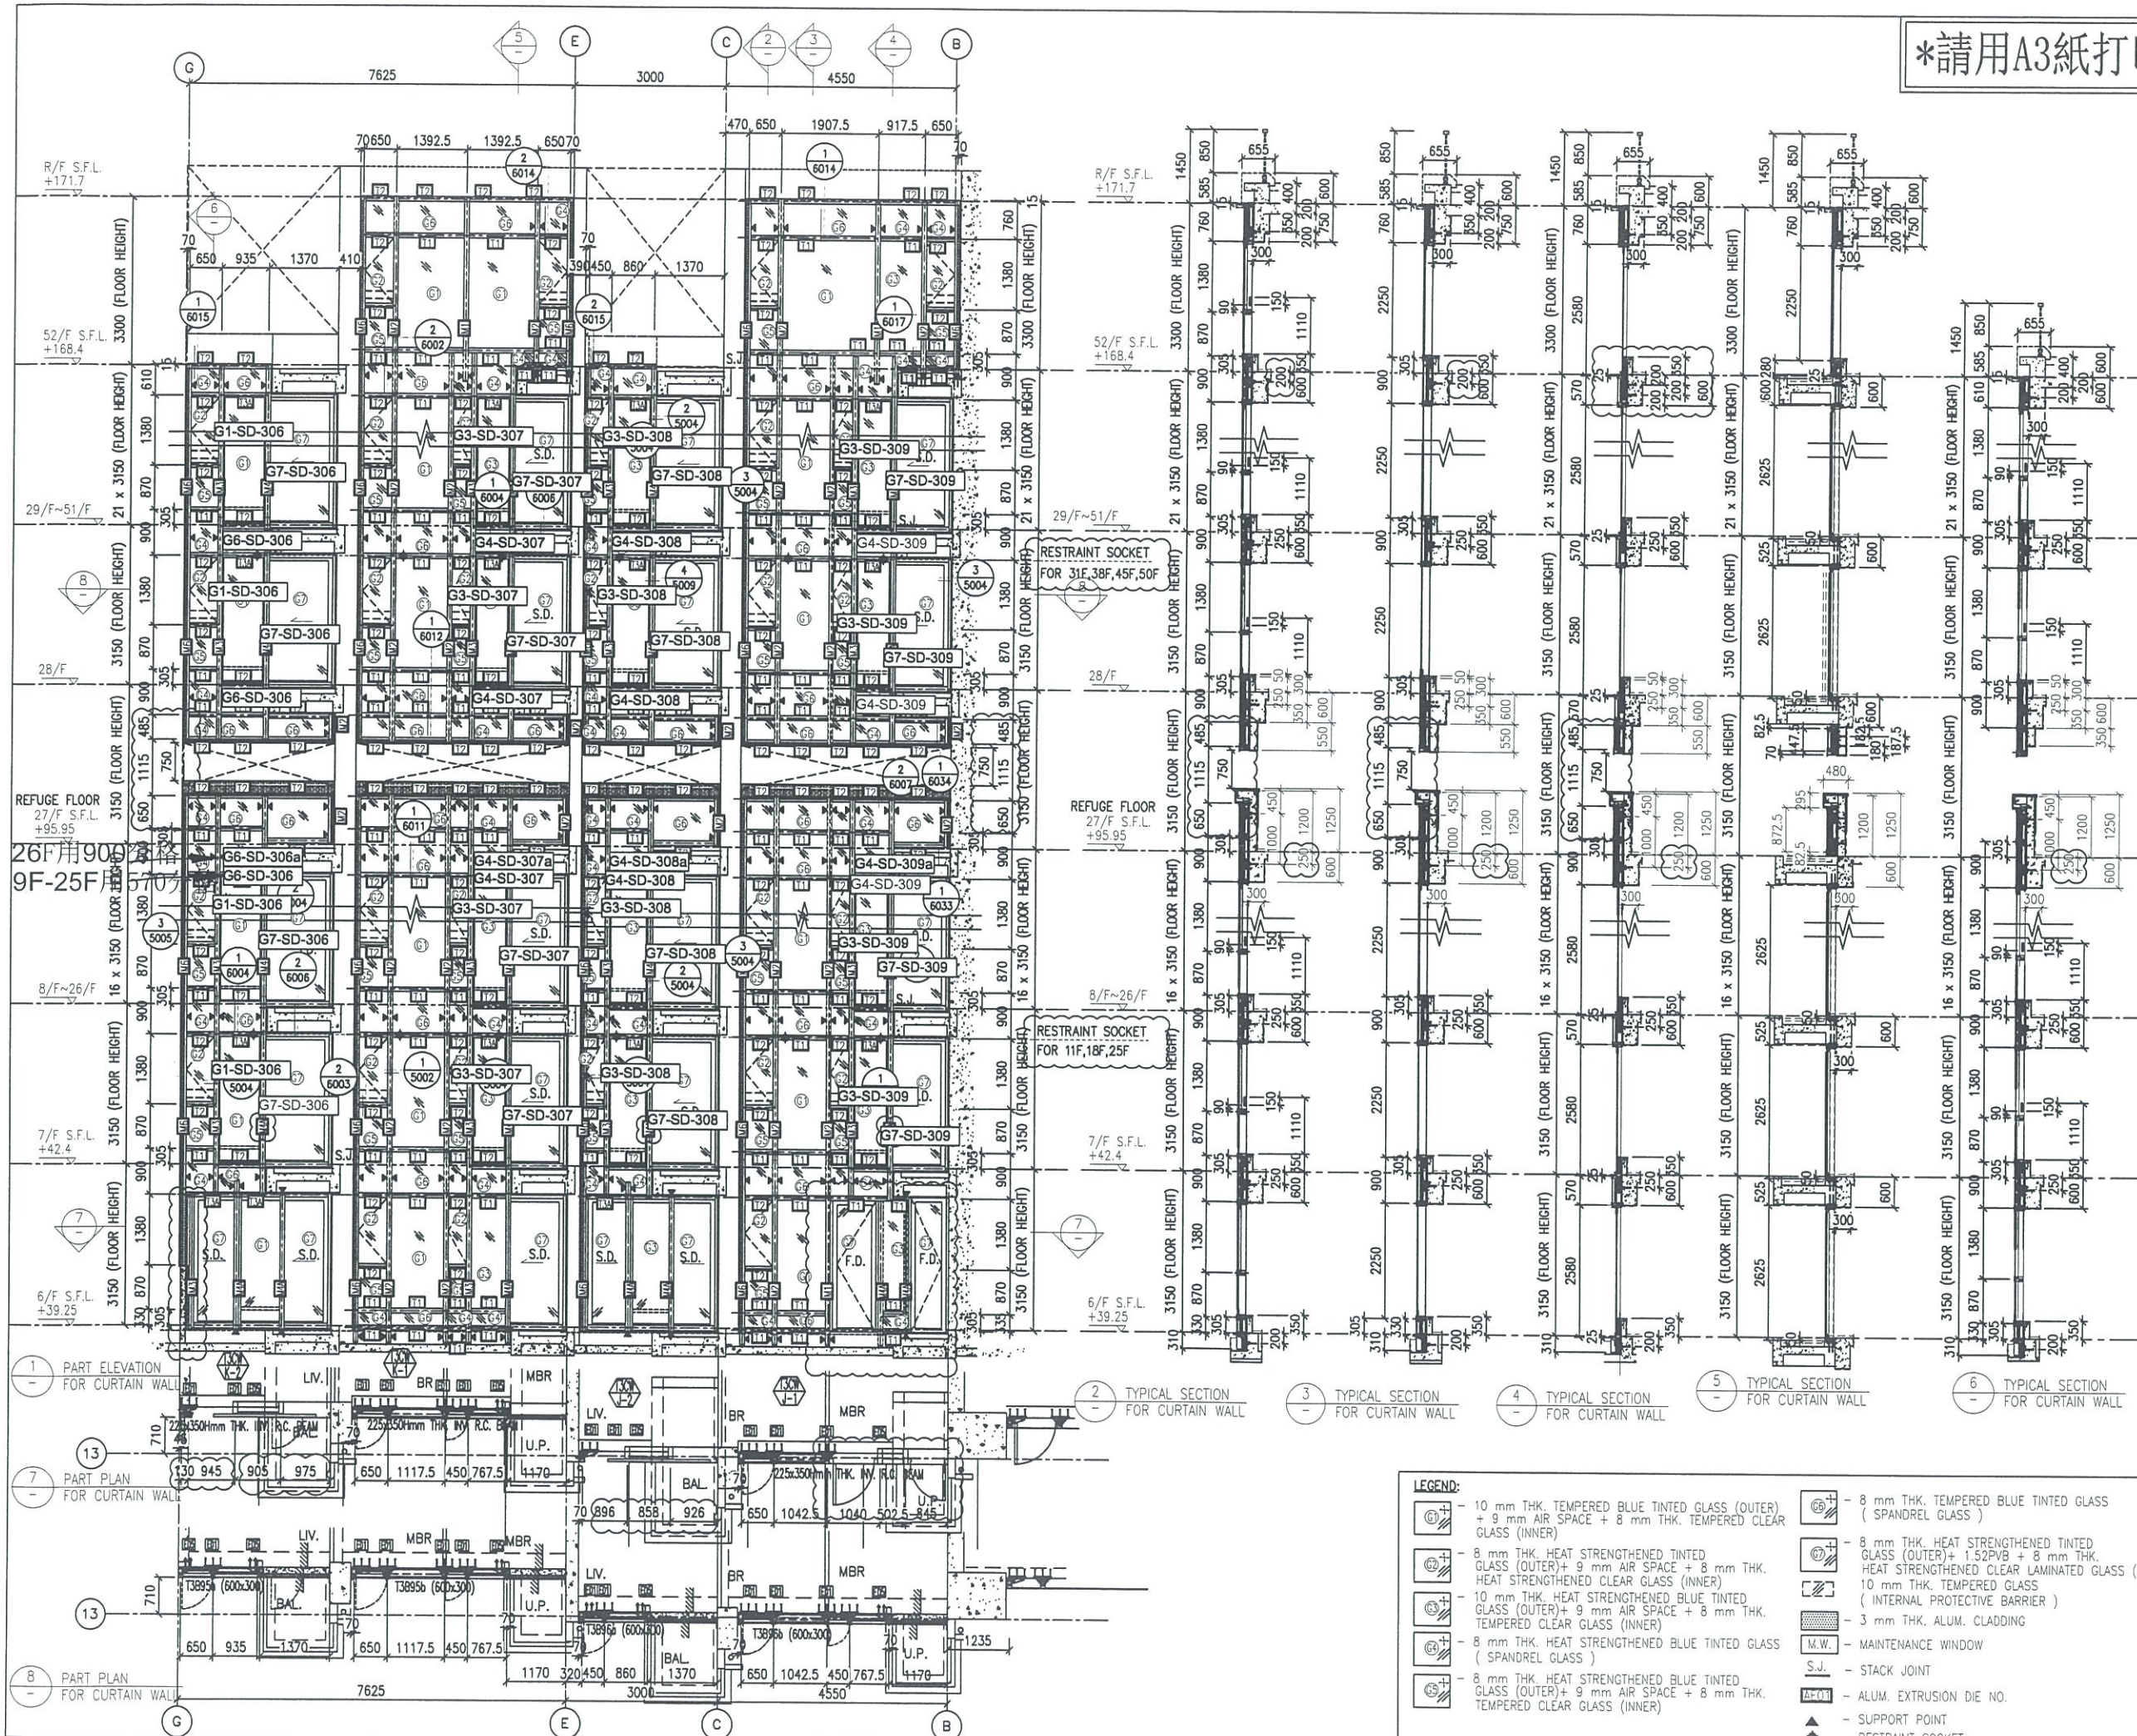

CLIENT :
 信和置業有限公司
 Sino Land Company Limited

ARCHITECT :
 WONG TUNG & PARTNERS LIMITED
 ARCHITECTS & PLANNERS

MAIN CONTRACTOR :
 CR Construction Company Limited

STRUCTURAL ENGINEER :
 AECOM

FACADE CONSULTANT :
 AECOM

NOTE :
 1. ALL DIMENSIONS ARE IN mm.
 2. ALL ELEVATIONS ARE VIEWED FROM OUTSIDE.
 3. ALL DIMENSIONS TO BE VERIFIED ON SITE BEFORE FABRICATION.

LEGEND :
 X1 --- DETAIL MARK NO.
 X001 --- REFER SHEET NO.
 1. F.F.L --- FINISHED FLOOR LEVEL
 2. S.F.L --- STRUCTURAL FLOOR LEVEL
 3. (R) --- REVERSED DETAIL

NO.	DATE	REVISED	BY
E	17/01/2019	GENERAL REVISED	
D	22/12/2018	GENERAL REVISED	
C	04/12/2018	GENERAL REVISED	
B	24/11/2018	GENERAL REVISED	
A	10/9/2018	GENERAL REVISED	

JOB NO. : J-837
 PROJECT :
 URA KWUN TONG TOWN CENTRE
 REDEVELOPMENT (AREA 2 & 3) AT
 NKIL 6514, KWUN TONG, KWLOON

TITLE :
 PART ELEVATION
 OF CURTAIN WALL
 AT TOWER 3





DATE : 04-JUL-18 SCALE : 1:60 (A1)
 DRAWN BY : ASING CHECKED BY : -

美特鋁質有限公司
 MIDI ALUMINIUM FABRICATOR LTD.
 Units 6-8, Sunray Industrial Centre, 1/F
 610 Cho Kwo Ling Road, Kowloon
 Tel: 23489211-4 Fax: (852) 2727666

DWG NO. : JB37-CW-2305 REV. : E

- LEGEND:
- 10 mm THK. TEMPERED BLUE TINTED GLASS (OUTER) + 9 mm AIR SPACE + 8 mm THK. TEMPERED CLEAR GLASS (INNER)
 - 8 mm THK. HEAT STRENGTHENED TINTED GLASS (OUTER) + 9 mm AIR SPACE + 8 mm THK. HEAT STRENGTHENED CLEAR LAMINATED GLASS (INNER)
 - 10 mm THK. HEAT STRENGTHENED BLUE TINTED GLASS (OUTER) + 9 mm AIR SPACE + 8 mm THK. TEMPERED CLEAR GLASS (INNER)
 - 8 mm THK. HEAT STRENGTHENED BLUE TINTED GLASS (SPANDREL GLASS)
 - 8 mm THK. HEAT STRENGTHENED BLUE TINTED GLASS (OUTER) + 9 mm AIR SPACE + 8 mm THK. TEMPERED CLEAR GLASS (INNER)
 - 8 mm THK. TEMPERED BLUE TINTED GLASS (SPANDREL GLASS)
 - 8 mm THK. HEAT STRENGTHENED TINTED GLASS (OUTER) + 1.52PVB + 8 mm THK. HEAT STRENGTHENED CLEAR LAMINATED GLASS (INNER)
 - 10 mm THK. TEMPERED GLASS (INTERNAL PROTECTIVE BARRIER)
 - 3 mm THK. ALUM. CLADDING
 - M.W. --- MAINTENANCE WINDOW
 - S.J. --- STACK JOINT
 - ALUM. EXTRUSION DIE NO.
 - SUPPORT POINT
 - RESTRAINT SOCKET

*請用A3紙打印

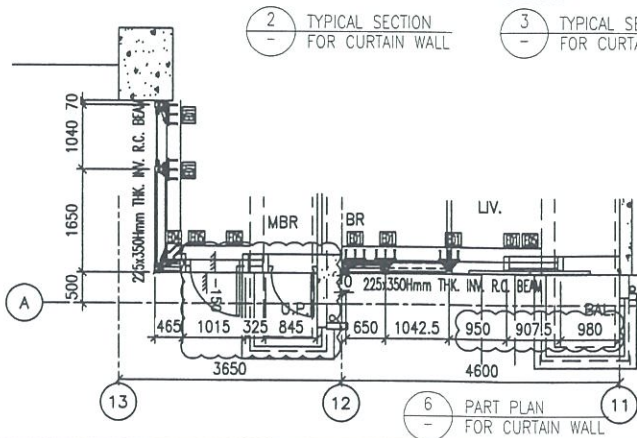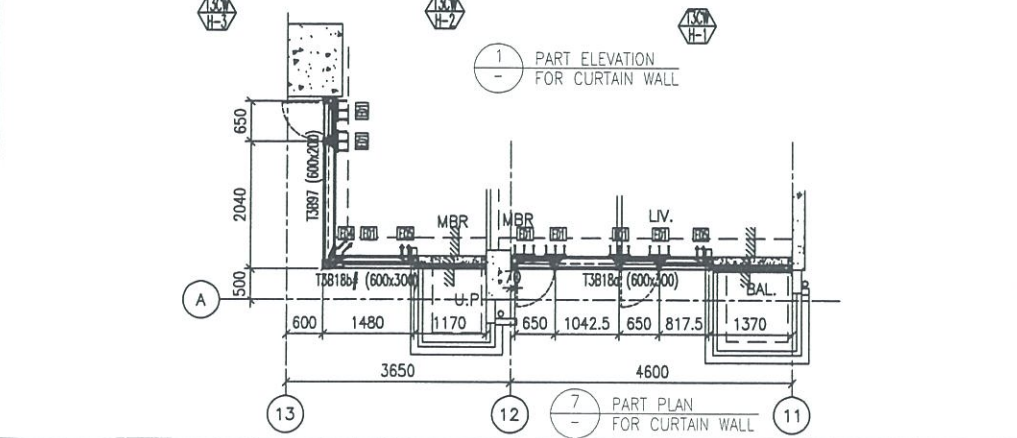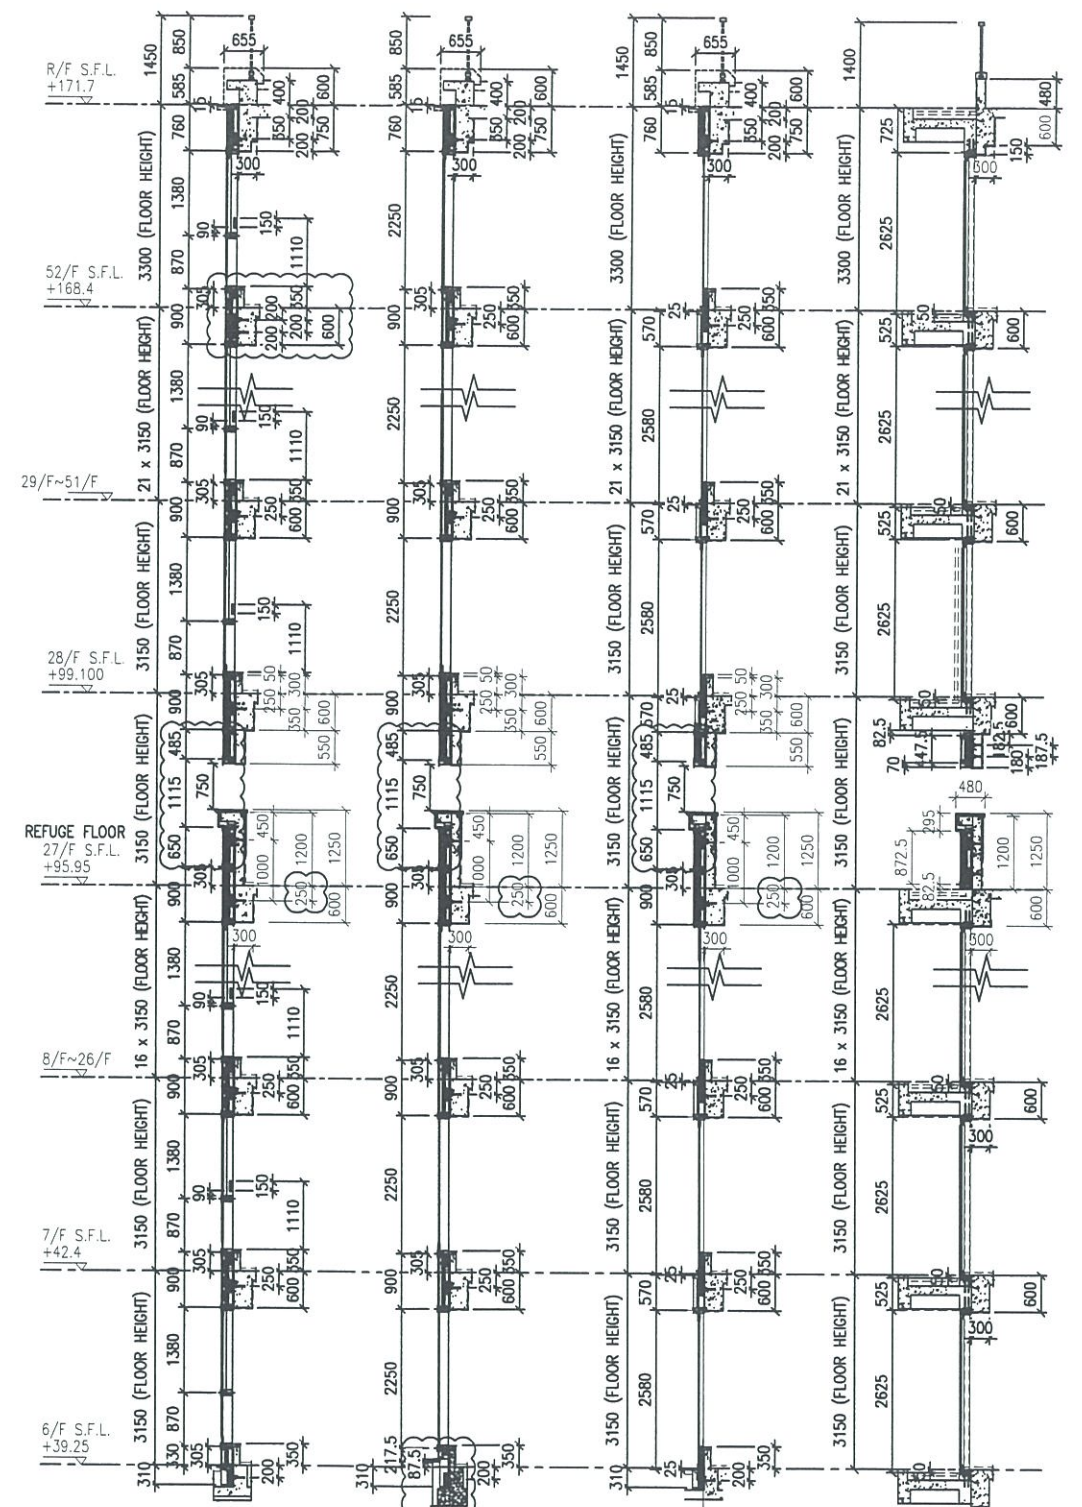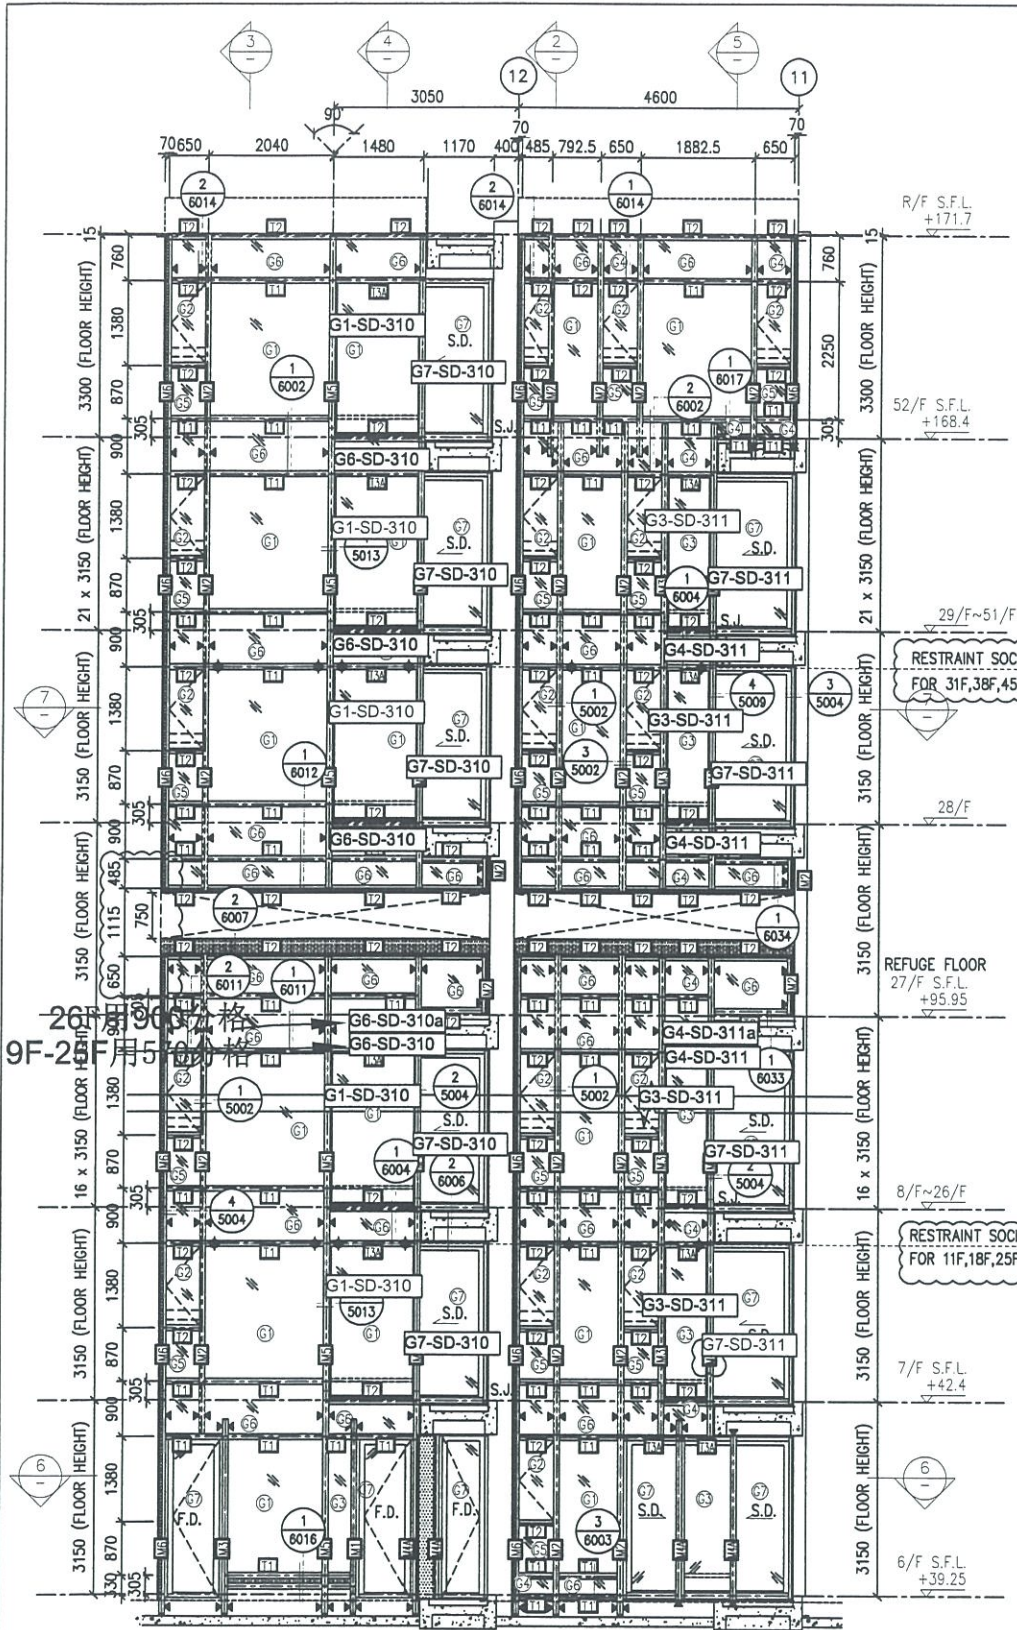

- LEGEND:**
- 10 mm THK. TEMPERED BLUE TINTED GLASS (OUTER) + 9 mm AIR SPACE + 8 mm THK. TEMPERED CLEAR GLASS (INNER)
 - 8 mm THK. HEAT STRENGTHENED TINTED GLASS (OUTER) + 9 mm AIR SPACE + 8 mm THK. HEAT STRENGTHENED CLEAR GLASS (INNER)
 - 10 mm THK. HEAT STRENGTHENED BLUE TINTED GLASS (OUTER) + 9 mm AIR SPACE + 8 mm THK. TEMPERED CLEAR GLASS (INNER)
 - 8 mm THK. HEAT STRENGTHENED BLUE TINTED GLASS (SPANDREL GLASS)
 - 8 mm THK. HEAT STRENGTHENED BLUE TINTED GLASS (OUTER) + 9 mm AIR SPACE + 8 mm THK. TEMPERED CLEAR GLASS (INNER)
 - 8 mm THK. TEMPERED BLUE TINTED GLASS (SPANDREL GLASS)
 - 8 mm THK. HEAT STRENGTHENED TINTED GLASS (OUTER) + 1.52PVB + 8 mm THK. HEAT STRENGTHENED CLEAR LAMINATED GLASS (INNER)
 - 10 mm THK. TEMPERED GLASS (INTERNAL PROTECTIVE BARRIER)
 - 3 mm THK. ALUM. CLADDING
 - MAINTENANCE WINDOW
 - STACK JOINT
 - ALUM. EXTRUSION DIE NO. A-01
 - SUPPORT POINT
 - RESTRAINT SOCKET

B.D. REF :

CLIENT :
 信和置業有限公司
 Sino Land Company Limited

ARCHITECT :
 WONG TUNG & PARTNERS LIMITED
 ARCHITECTS & PLANNERS

MAIN CONTRACTOR :
 CR Construction Company Limited

STRUCTURAL ENGINEER :
 AECOM

FACADE CONSULTANT:
 AECOM

NOTE:
 1. ALL DIMENSIONS ARE IN mm.
 2. ALL ELEVATIONS ARE VIEWED FROM OUTSIDE.
 3. ALL DIMENSIONS TO BE VERIFIED ON SITE BEFORE FABRICATION.

LEGEND:
 - DETAIL MARK NO. X1
 - REFER SHEET NO. X001
 1. F.F.L. --- FINISHED FLOOR LEVEL
 2. S.F.L. --- STRUCTURAL FLOOR LEVEL
 3. (R) --- REVERSED DETAIL

NO.	DATE	REVISED	BY
E	22/12/2018	GENERAL REVISED	
D	22/12/2018	GENERAL REVISED	
C	04/12/2018	GENERAL REVISED	
B	24/11/2018	GENERAL REVISED	
A	10/9/2018	GENERAL REVISED	



JOB NO. : J-837
 PROJECT :
 URA KWUN TONG TOWN CENTRE
 REDEVELOPMENT (AREA 2 & 3) AT
 NKIL 6514, KWUN TONG, KWLOON

TITLE :
 PART ELEVATION
 OF CURTAIN WALL
 AT TOWER 3

DATE : 04-JUL-18 SCALE : 1:60 (A1)
 DRAWN BY : ASING CHECKED BY : -

美特鋁質有限公司
 MIDI ALUMINIUM FABRICATOR LTD.
 Units 6-8, Sunray Industrial Centre, 1/F
 610 Cha Kwo Ling Road, Kowloon
 Tel: 23489211-4 Fax: (852) 27727666
 DWG NO. : J837-CW-2306 REV. : E

*請用A3紙打印

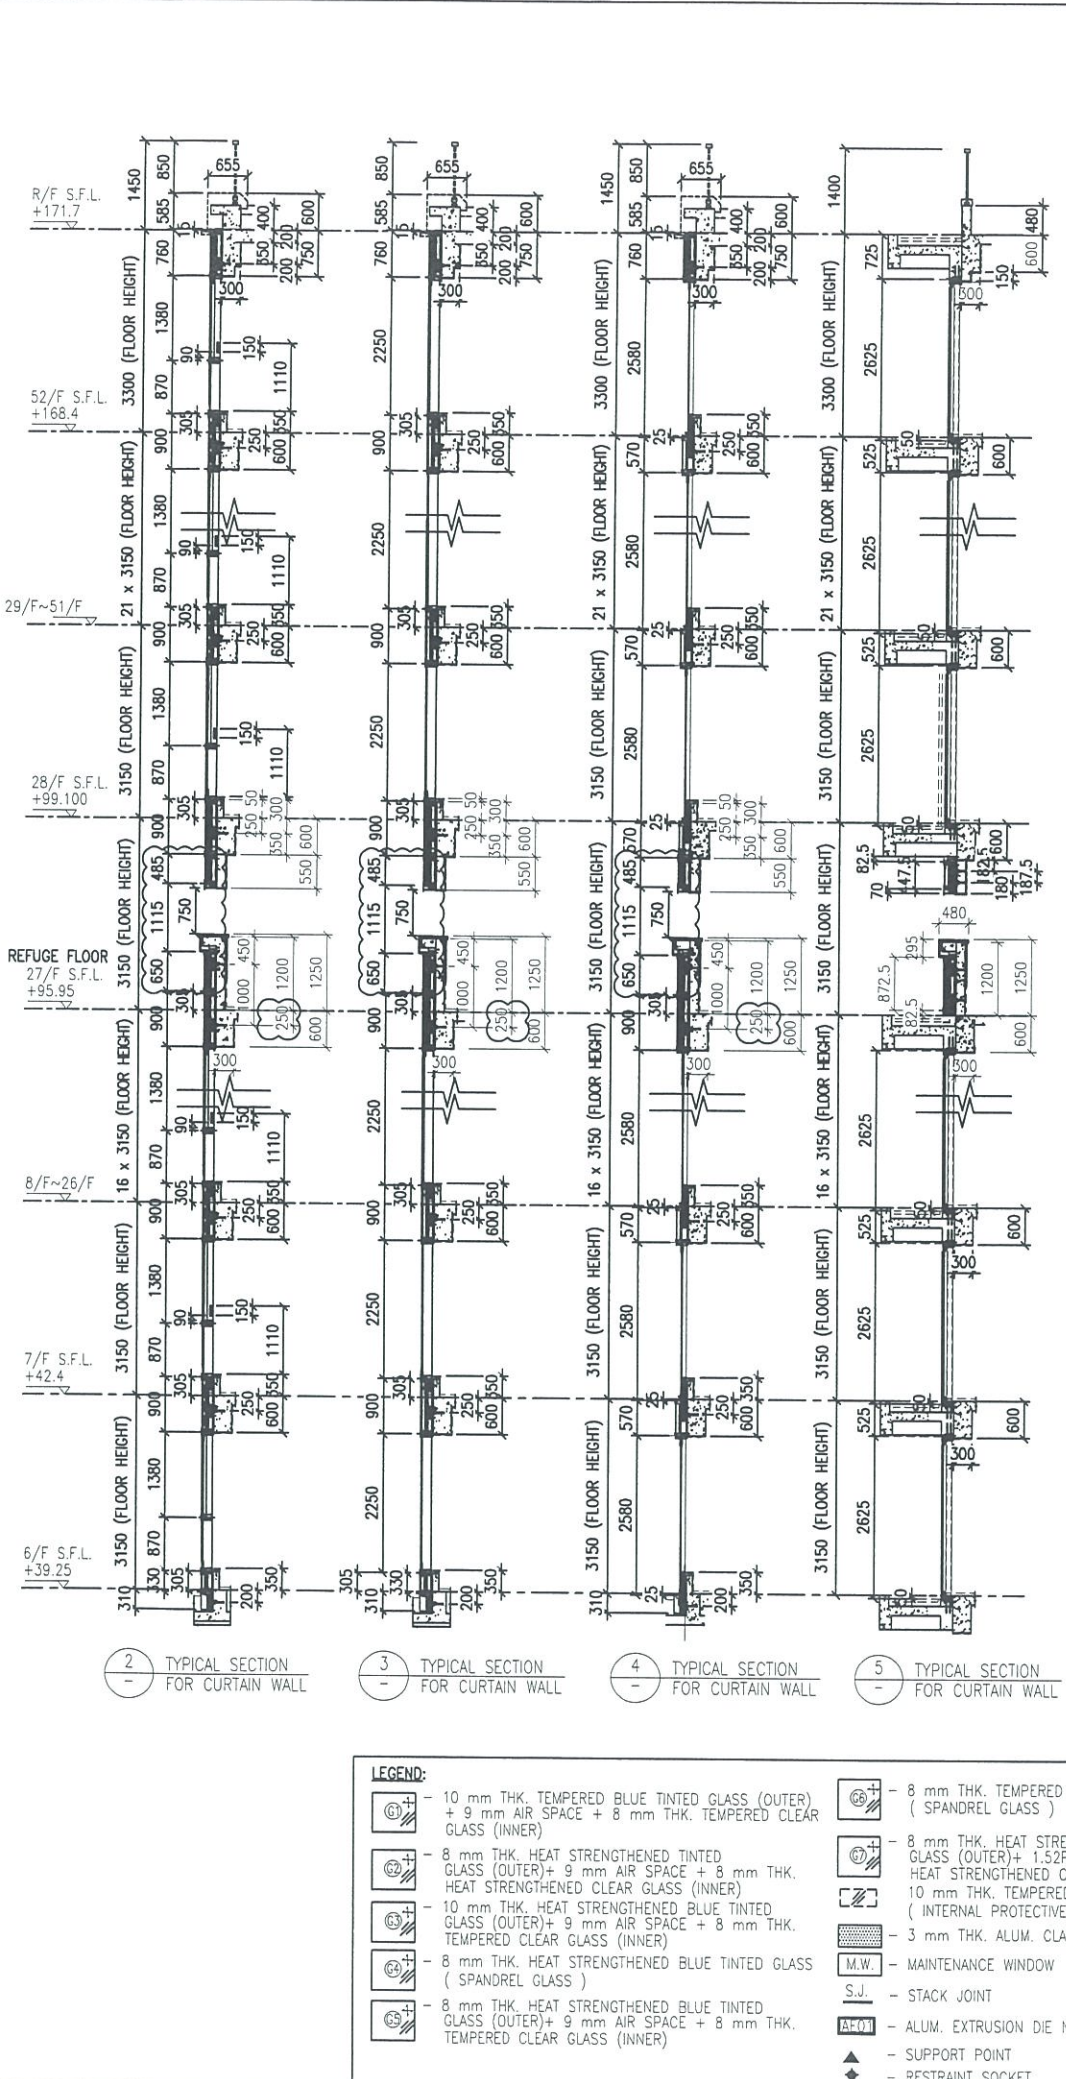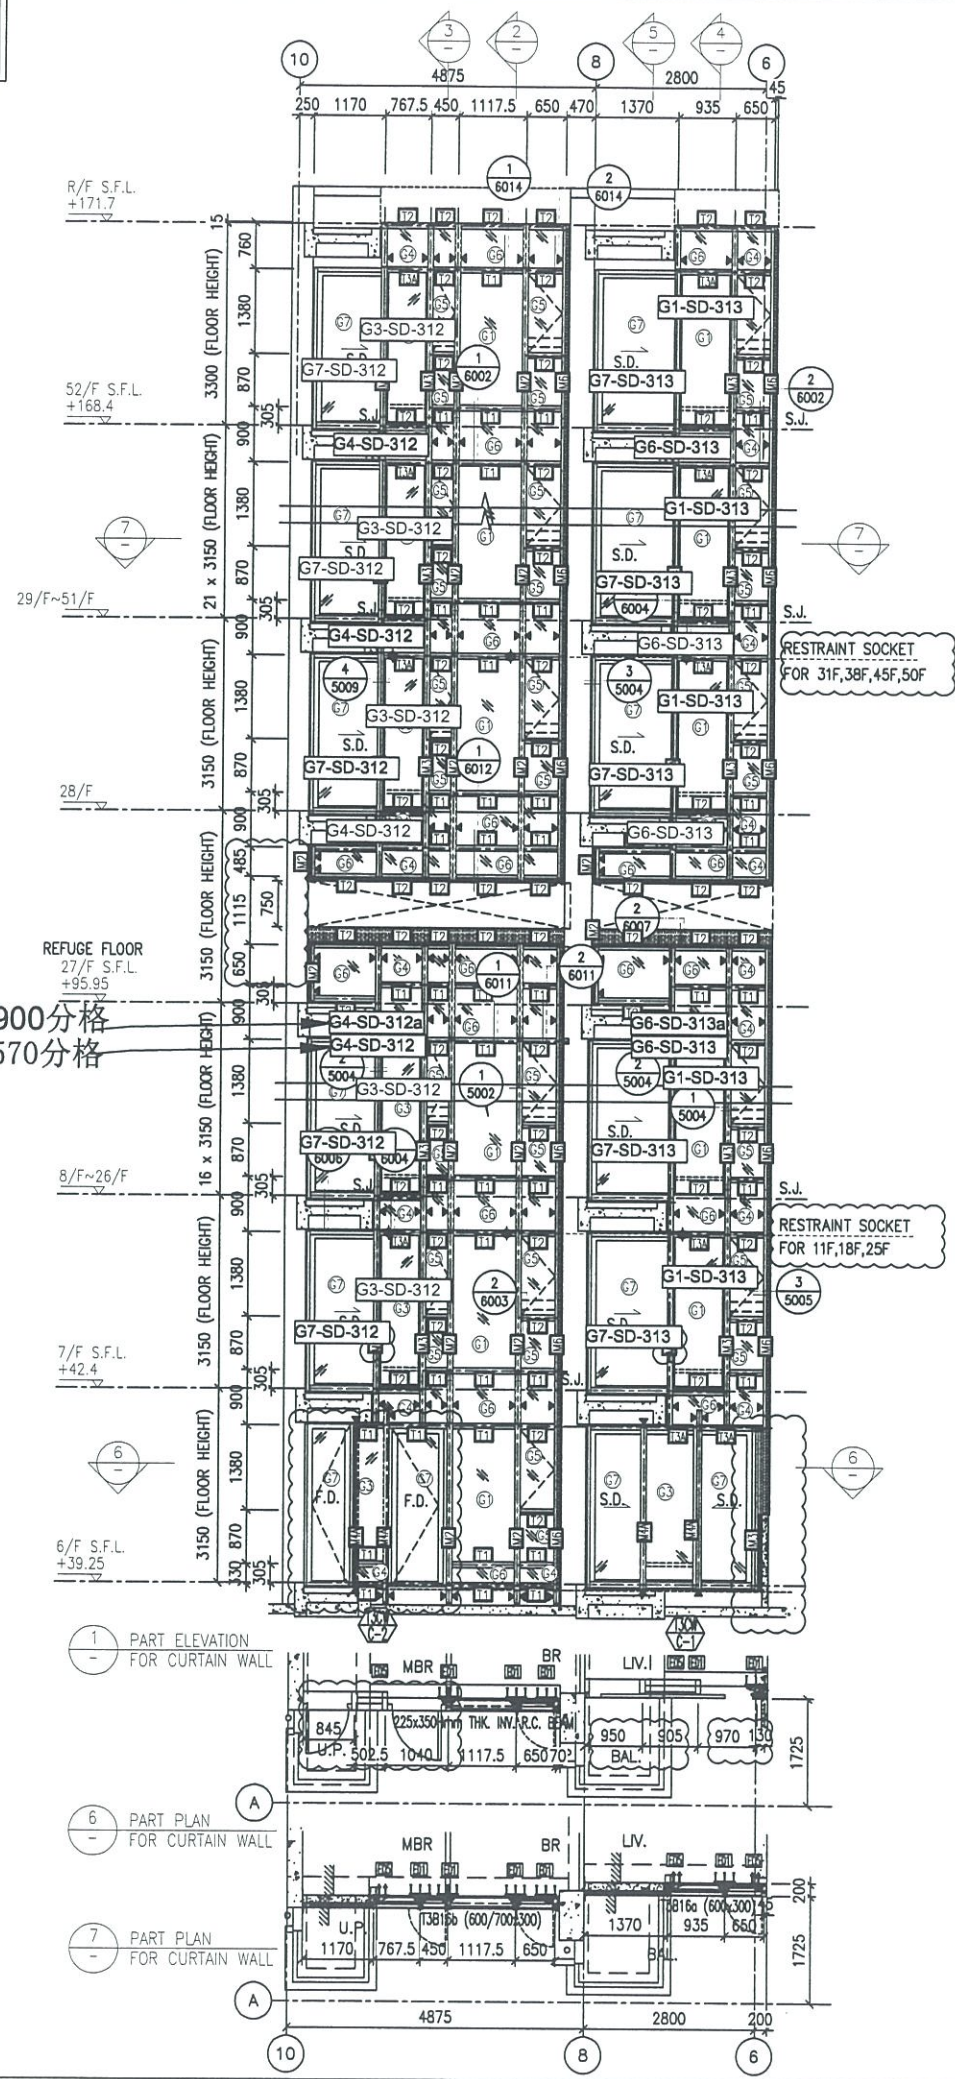

- LEGEND:**
- 10 mm THK. TEMPERED BLUE TINTED GLASS (OUTER) + 9 mm AIR SPACE + 8 mm THK. TEMPERED CLEAR GLASS (INNER)
 - 8 mm THK. HEAT STRENGTHENED TINTED GLASS (OUTER) + 9 mm AIR SPACE + 8 mm THK. HEAT STRENGTHENED CLEAR GLASS (INNER)
 - 10 mm THK. HEAT STRENGTHENED BLUE TINTED GLASS (OUTER) + 9 mm AIR SPACE + 8 mm THK. TEMPERED CLEAR GLASS (INNER)
 - 8 mm THK. HEAT STRENGTHENED BLUE TINTED GLASS (OUTER) + 9 mm AIR SPACE + 8 mm THK. TEMPERED CLEAR GLASS (INNER)
 - 8 mm THK. TEMPERED BLUE TINTED GLASS (SPANDREL GLASS)
 - 8 mm THK. HEAT STRENGTHENED TINTED GLASS (OUTER) + 1.52PVB + 8 mm THK. HEAT STRENGTHENED CLEAR LAMINATED GLASS (INNER)
 - 10 mm THK. TEMPERED GLASS (INTERNAL PROTECTIVE BARRIER)
 - 3 mm THK. ALUM. CLADDING
 - M.W. - MAINTENANCE WINDOW
 - S.J. - STACK JOINT
 - ALUM. EXTRUSION DIE NO. (A-1)
 - SUPPORT POINT
 - RESTRAINT SOCKET

B.D. REF :

CLIENT :
 信和置業有限公司
 Sino Land Company Limited

ARCHITECT :
 WONG TUNG & PARTNERS LIMITED
 ARCHITECTS & PLANNERS

MAIN CONTRACTOR :
 CR Construction Company Limited

STRUCTURAL ENGINEER :
 AECOM

FACADE CONSULTANT:
 AECOM

NOTE :
 1. ALL DIMENSIONS ARE IN mm.
 2. ALL ELEVATIONS ARE VIEWED FROM OUTSIDE.
 3. ALL DIMENSIONS TO BE VERIFIED ON SITE BEFORE FABRICATION.

LEGEND :
 - DETAIL MARK NO.
 - REFER SHEET NO.

1. F.F.L. -- FINISHED FLOOR LEVEL
 2. S.F.L. -- STRUCTURAL FLOOR LEVEL
 3. (7) -- REVERSED DETAIL

NO.	DATE	REVISED	BY
E	17/01/2019	GENERAL REVISED	
D	22/12/2018	GENERAL REVISED	
C	04/12/2018	GENERAL REVISED	
B	24/11/2018	GENERAL REVISED	
A	10/9/2018	GENERAL REVISED	

JOB NO. : J-837

PROJECT :
 URA KWUN TONG TOWN CENTRE
 REDEVELOPMENT (AREA 2 & 3) AT
 NKIL 6514, KWUN TONG, KWLOON

TITLE :
 PART ELEVATION
 OF CURTAIN WALL
 AT TOWER 3




DATE : 04-JUL-18 SCALE : 1:60 (A1)

DRAWN BY : ASING CHECKED BY : -

美特鋁質有限公司
 MIDI ALUMINUM FABRICATOR LTD.
 Units 6-8, Sunray Industrial Centre, 1/F
 610 Cho Kwo Ling Road, Kowloon
 Tel:23489211-4 Fax:(852)2727666

DWG NO. : J837-CW-2307 REV. : E

*請用A3紙打印

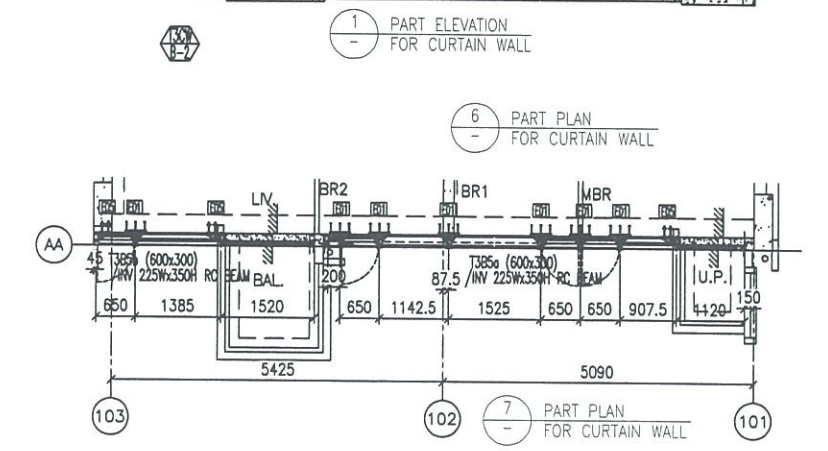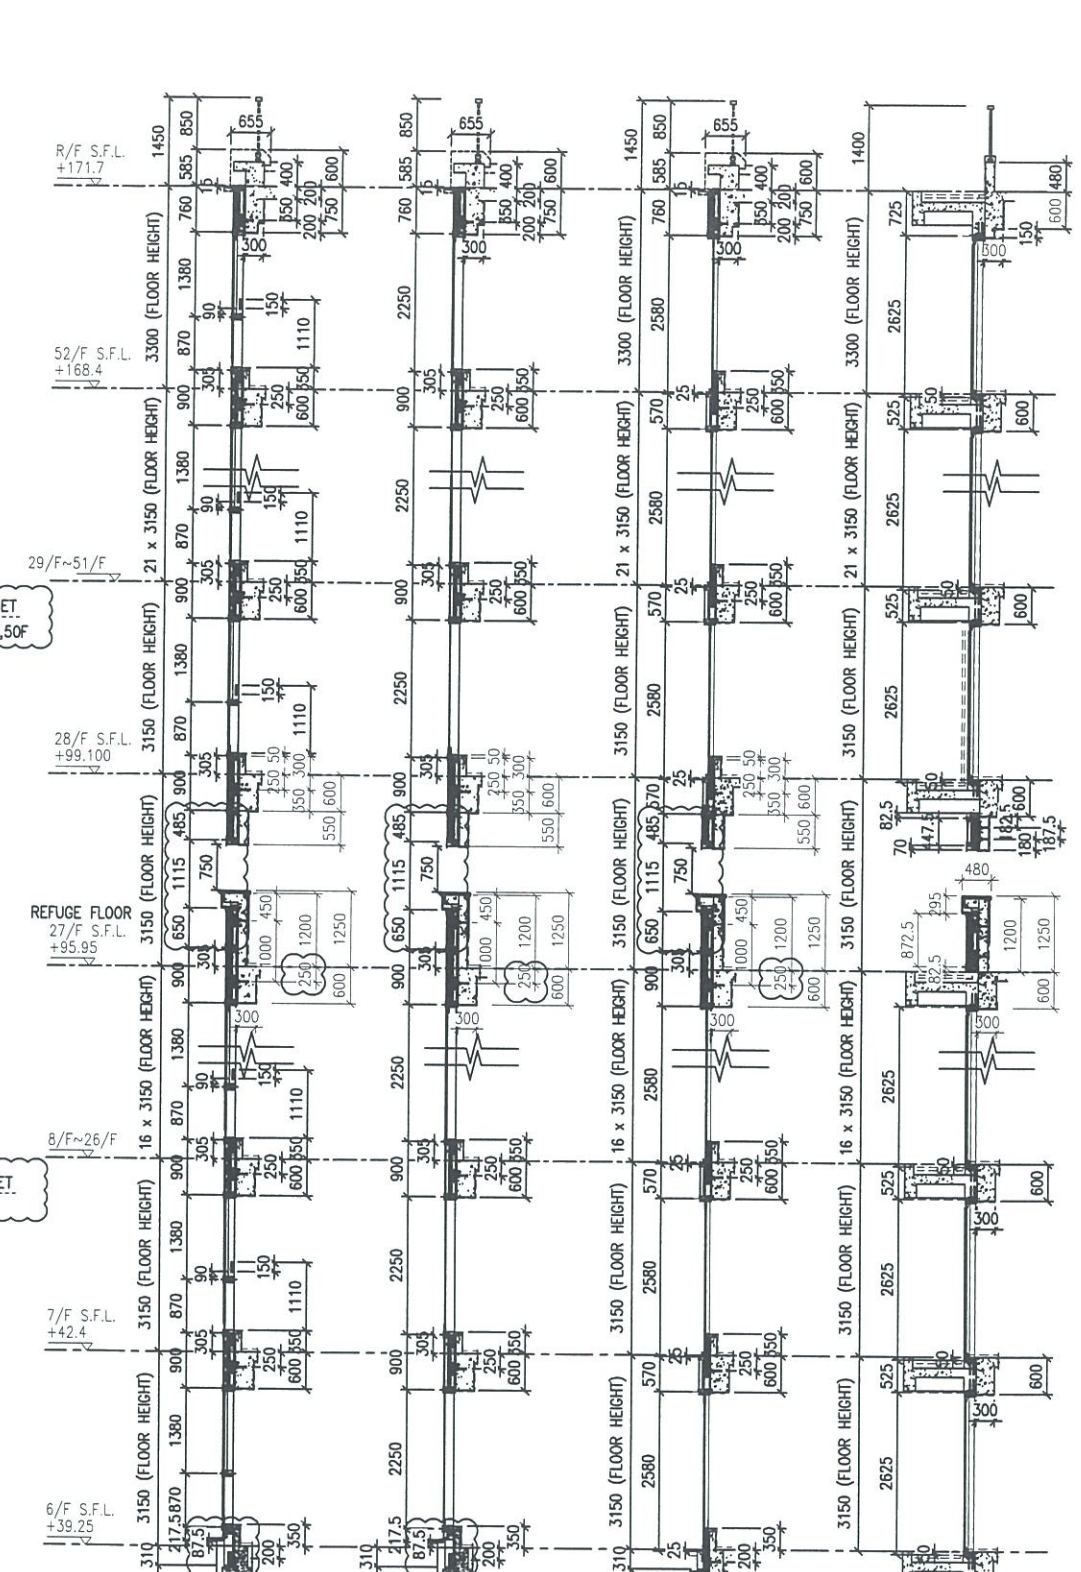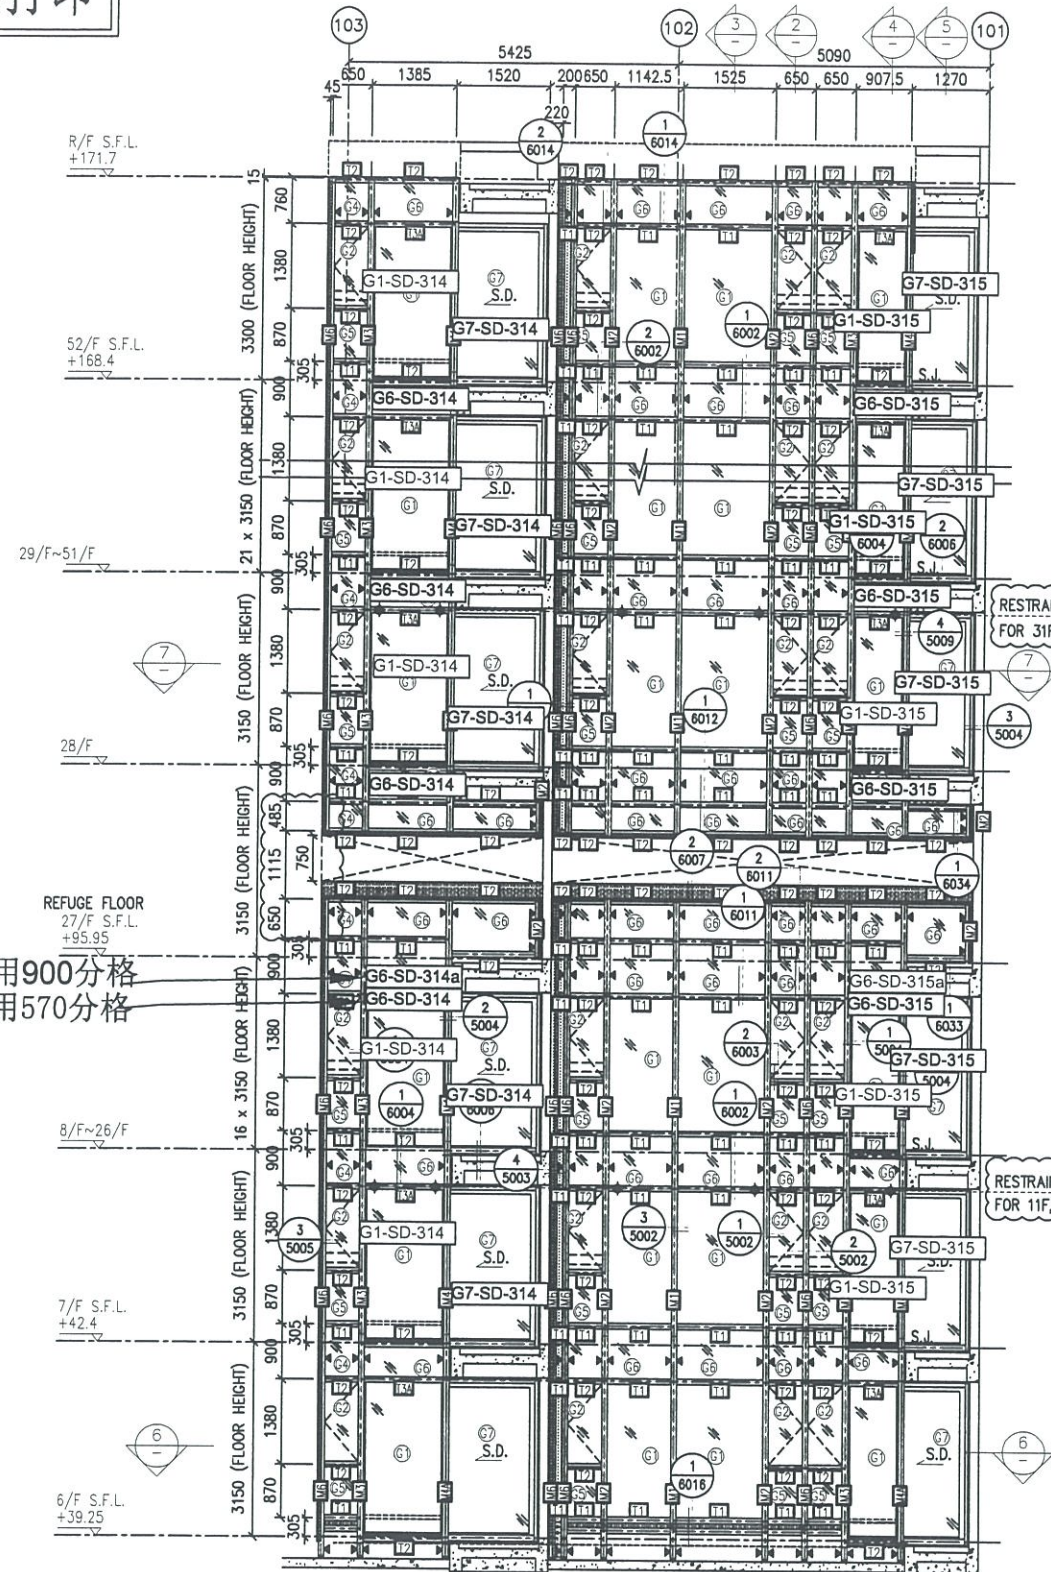

- LEGEND:**
- 10 mm THK. TEMPERED BLUE TINTED GLASS (OUTER) + 9 mm AIR SPACE + 8 mm THK. TEMPERED CLEAR GLASS (INNER)
 - 8 mm THK. HEAT STRENGTHENED TINTED GLASS (OUTER) + 9 mm AIR SPACE + 8 mm THK. HEAT STRENGTHENED CLEAR GLASS (INNER)
 - 10 mm THK. HEAT STRENGTHENED BLUE TINTED GLASS (OUTER) + 9 mm AIR SPACE + 8 mm THK. TEMPERED CLEAR GLASS (INNER)
 - 8 mm THK. HEAT STRENGTHENED BLUE TINTED GLASS (OUTER) + 9 mm AIR SPACE + 8 mm THK. TEMPERED CLEAR GLASS (INNER)
 - 8 mm THK. TEMPERED BLUE TINTED GLASS (SPANDREL GLASS)
 - 8 mm THK. HEAT STRENGTHENED TINTED GLASS (OUTER) + 1.52PVB + 8 mm THK. HEAT STRENGTHENED CLEAR LAMINATED GLASS (INNER)
 - 10 mm THK. TEMPERED GLASS (INTERNAL PROTECTIVE BARRIER)
 - 3 mm THK. ALUM. CLADDING
 - MAINTENANCE WINDOW
 - STACK JOINT
 - ALUM. EXTRUSION DIE NO.
 - SUPPORT POINT
 - RESTRAINT SOCKET

B.D. REF :

CLIENT :
 信和置業有限公司
 Sino Land Company Limited

ARCHITECT :
 WONG TUNG & PARTNERS LIMITED
 ARCHITECTS & PLANNERS

MAIN CONTRACTOR :
 CR Construction Company Limited

STRUCTURAL ENGINEER :
 AECOM

FACADE CONSULTANT:
 AECOM

NOTE :

- ALL DIMENSIONS ARE IN mm.
- ALL ELEVATIONS ARE VIEWED FROM OUTSIDE.
- ALL DIMENSIONS TO BE VERIFIED ON SITE BEFORE FABRICATION.

LEGEND :

- DETAIL MARK NO.
- REFER SHEET NO.

- F.L.L. -- FINISHED FLOOR LEVEL
- S.F.L. -- STRUCTURAL FLOOR LEVEL
- REVERSED DETAIL

NO.	DATE	REVISED	BY
E	17/01/2019	GENERAL REVISED	
D	22/12/2018	GENERAL REVISED	
C	04/12/2018	GENERAL REVISED	
B	24/11/2018	GENERAL REVISED	
A	10/9/2018	GENERAL REVISED	

JOB NO. : J-837
 PROJECT : URA KWUN TONG TOWN CENTRE REDEVELOPMENT (AREA 2 & 3) AT NKIL 6514, KWUN TONG, KWLOON


TITLE : PART ELEVATION OF CURTAIN WALL AT TOWER 3

DATE : 04-JUL-18 SCALE : 1:60 (A1)
 DRAWN BY : ASING CHECKED BY : -

美特鋁質有限公司
 MIDI ALUMINIUM FABRICATOR LTD.
 Units 6-8, Sunray Industrial Centre, 1/F
 610 Cho Kwo Ling Road, Kowloon
 Tel:23489211-4 Fax:(852)2727666

DWG NO. : J837-CW-230B REV. : E

*請用A3紙打印

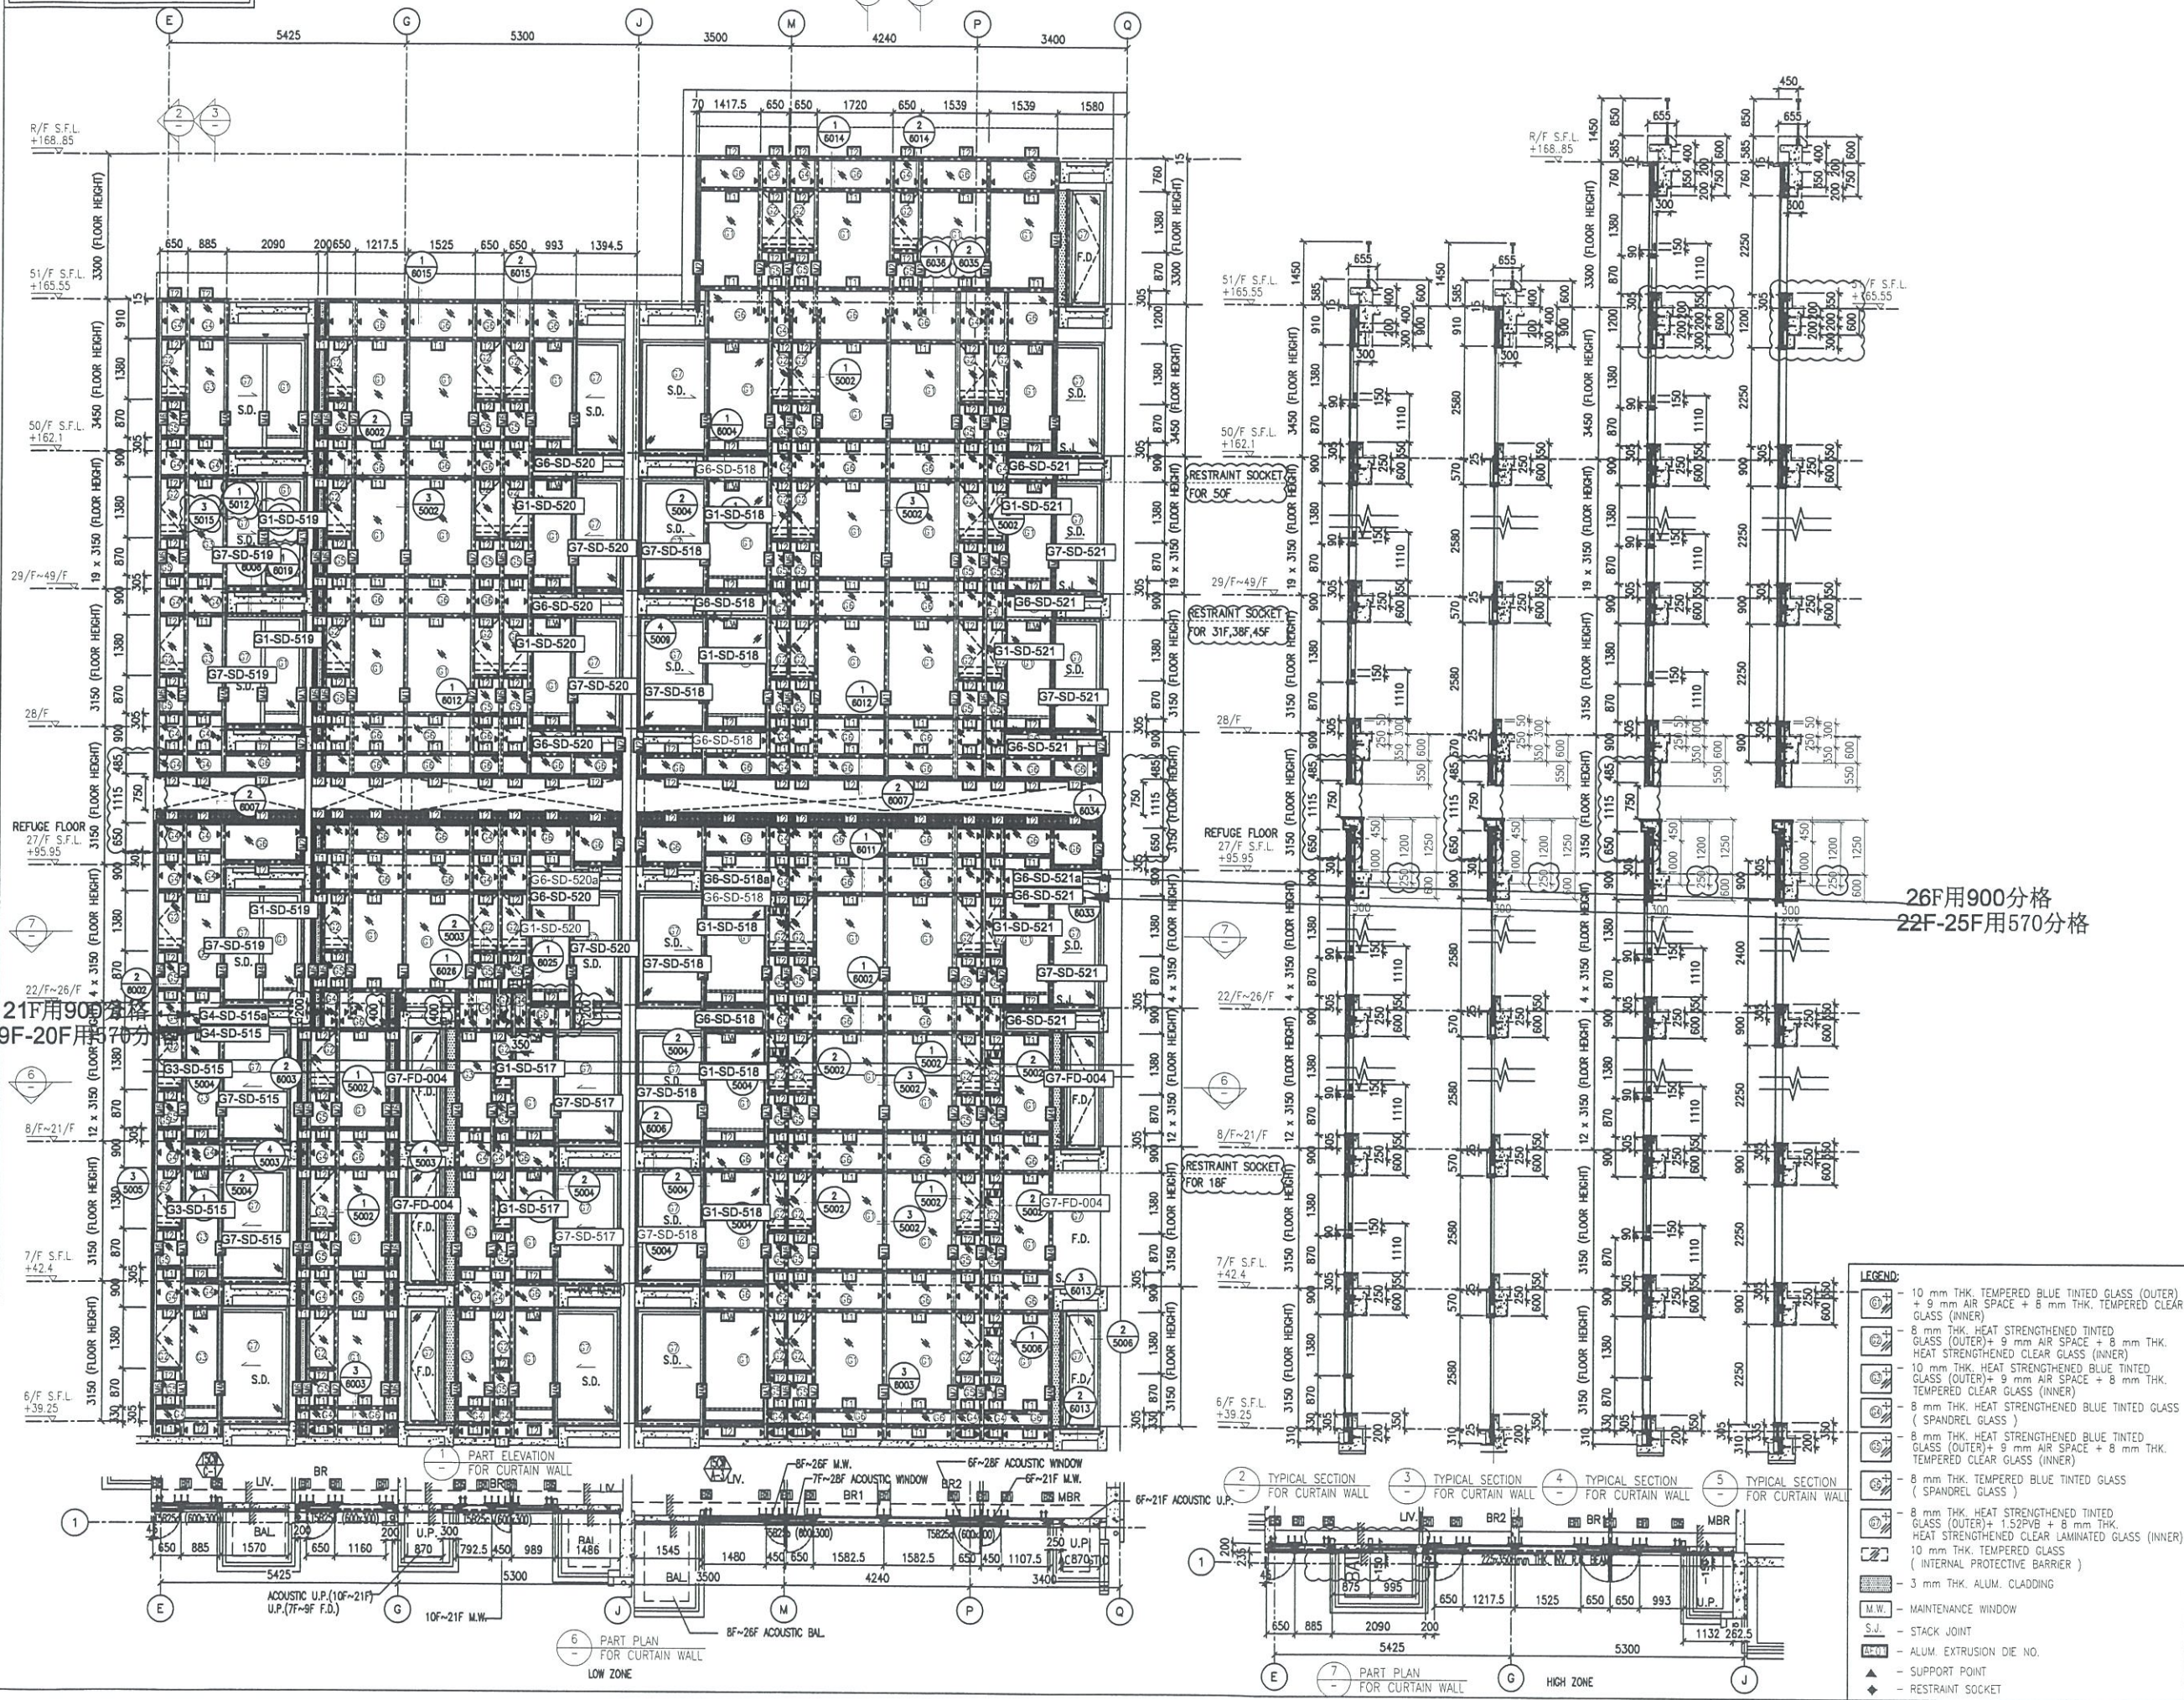

26F用900分格
22F-25F用570分格

- LEGEND:**
- ① - 10 mm THK. TEMPERED BLUE TINTED GLASS (OUTER) + 9 mm AIR SPACE + 6 mm THK. TEMPERED CLEAR GLASS (INNER)
 - ② - 8 mm THK. HEAT STRENGTHENED TINTED GLASS (OUTER) + 9 mm AIR SPACE + 8 mm THK. HEAT STRENGTHENED CLEAR GLASS (INNER)
 - ③ - 10 mm THK. HEAT STRENGTHENED BLUE TINTED GLASS (OUTER) + 9 mm AIR SPACE + 8 mm THK. TEMPERED CLEAR GLASS (INNER)
 - ④ - 8 mm THK. HEAT STRENGTHENED BLUE TINTED GLASS (SPANDREL GLASS)
 - ⑤ - 8 mm THK. HEAT STRENGTHENED BLUE TINTED GLASS (OUTER) + 9 mm AIR SPACE + 8 mm THK. TEMPERED CLEAR GLASS (INNER)
 - ⑥ - 8 mm THK. TEMPERED BLUE TINTED GLASS (SPANDREL GLASS)
 - ⑦ - 8 mm THK. HEAT STRENGTHENED TINTED GLASS (OUTER) + 1.52PVB + 8 mm THK. HEAT STRENGTHENED CLEAR LAMINATED GLASS (INNER)
 - ⑧ - 10 mm THK. TEMPERED GLASS (INTERNAL PROTECTIVE BARRIER)
 - ⑨ - 3 mm THK. ALUM. CLADDING
 - M.W. - MAINTENANCE WINDOW
 - S.J. - STACK JOINT
 - ALUM. - ALUM. EXTRUSION DIE NO.
 - ▲ - SUPPORT POINT
 - ◆ - RESTRAINT SOCKET

B.D. REF :

CLIENT :
 Sino Land Company Limited

ARCHITECT :
 WONG TUNG & PARTNERS LIMITED ARCHITECTS & PLANNERS

MAIN CONTRACTOR :
 CR Construction Company Limited

STRUCTURAL ENGINEER :
 AECOM

FAÇADE CONSULTANT:
 AECOM

NOTE :
 1. ALL DIMENSIONS ARE IN mm.
 2. ALL ELEVATIONS ARE VIEWED FROM OUTSIDE.
 3. ALL DIMENSIONS TO BE VERIFIED ON SITE BEFORE FABRICATION.

LEGEND :
 (X1) - DETAIL MARK NO.
 (X001) - REFER SHEET NO.

1. F.F.L. -- FINISHED FLOOR LEVEL
 2. S.F.L. -- STRUCTURAL FLOOR LEVEL
 3. (R) -- REVERSED DETAIL

NO.	DATE	REVISED	BY
E	17/01/2019	GENERAL REVISED	
D	22/12/2018	GENERAL REVISED	
C	04/12/2018	GENERAL REVISED	
B	24/11/2018	GENERAL REVISED	
A	10/9/2018	GENERAL REVISED	

JOB NO. : J-837

PROJECT :
 URA KWUN TONG TOWN CENTRE REDEVELOPMENT (AREA 2 & 3) AT NKIL 6514, KWUN TONG, KWLOON

TITLE :
 PART ELEVATION OF CURTAIN WALL AT TOWER 5

DATE : 04-JUL-18 SCALE : 1:60 (A1)

DRAWN BY : ASING CHECKED BY : -

美特鋁質有限公司
 MIDI ALUMINUM FABRICATOR LTD.
 Units 6-8, Sunray Industrial Centre, 1/F
 610 Cha Kwo Ling Road, Kowloon
 Tel: 23489211-4 Fax: (852) 2727666

DWG NO. : JB37-CW-2512 REV. : E