



工程指示 / 要求簡箋(E.I.)

工程指示編號：EI / 8966 / 18

修改版次：E

工程編號：J - 833

工程名稱：白石

工程項目：大樓標準層 企身收口(X85477)

收件人：生統

發件人：Eric Liu

日期：18/04/2018

要求提供 / 確認 事項：

- |                                    |                                     |                               |
|------------------------------------|-------------------------------------|-------------------------------|
| <input type="checkbox"/> 初步鋁料 B.M. | <input type="checkbox"/> 加工拆圖，然後生產  | <input type="checkbox"/> 尺寸表  |
| <input type="checkbox"/> 正式鋁料 B.M. | <input type="checkbox"/> 技術上資料 / 指示 | <input type="checkbox"/> 報價   |
| <input type="checkbox"/> 配件 B.M.   | <input type="checkbox"/> 樣辦或貨品說明書   | <input type="checkbox"/> 分判合約 |
| <input type="checkbox"/> 其他：_____  |                                     |                               |

內容：

請按加工圖生產企身收口(啲料款 X85477)，送地盤大樓標準層安裝  
E 版放行標準層最頂一條收口

謝謝！

請在 2018 / 04 / 27 前完成上列要求。

附：22 頁加工圖，<sup>24</sup>2 頁位置圖

以上項目為：

- 原合約工程包                       原合約工程加 / 減賬                       新工程報價

分發東莞各部門：

- ( ) 生產技術總監  連附件    ( ) 技術部  連附件    ( ) 生產部  連附件    ( ) 機械設計部  連附件  
( ) 採購部  連附件    ( ) 生產統籌部  連附件  
( ) 質檢部  連附件    ( ) 會計部  連附件    ( ) 報關組  連附件    ( ) 其他 湛哥  連附件

分發其他分判：

- ( ) 王禮秋  連附件

分發香港各部門：

- ( ) 行政部  連附件    ( ) 會計部  連附件    ( ) 統籌部  連附件    林哥  地盤科文  連附件    炳哥 / 祥哥  
( ) 採購部  連附件    ( ) QS 部  連附件    ( ) 維修部  連附件    ( ) 其他 \_\_\_\_\_  連附件


傳遞編號：

HK 0659 / 18

發件人簽署：

項目經理簽署：



# EG-DWG3

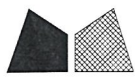

美特鋁質 有限公司  
MIDI Aluminium Fabricator Ltd.

工程號 J-833 地盤 白石

數量	位置
1	T1-CW2
1	T2-CW2
1	T3-CW2
1	T3-CW4
1	T5-CW2
1	T6-CW11

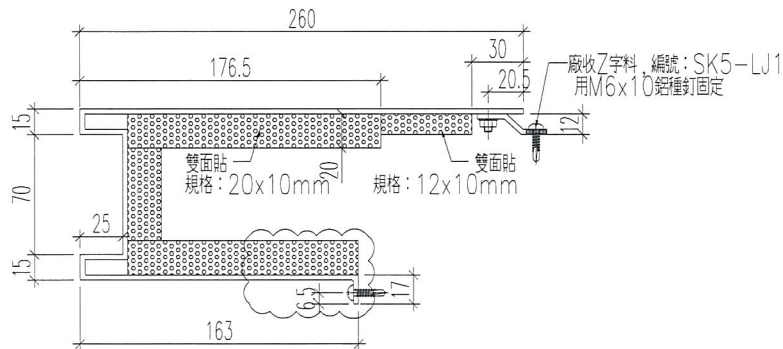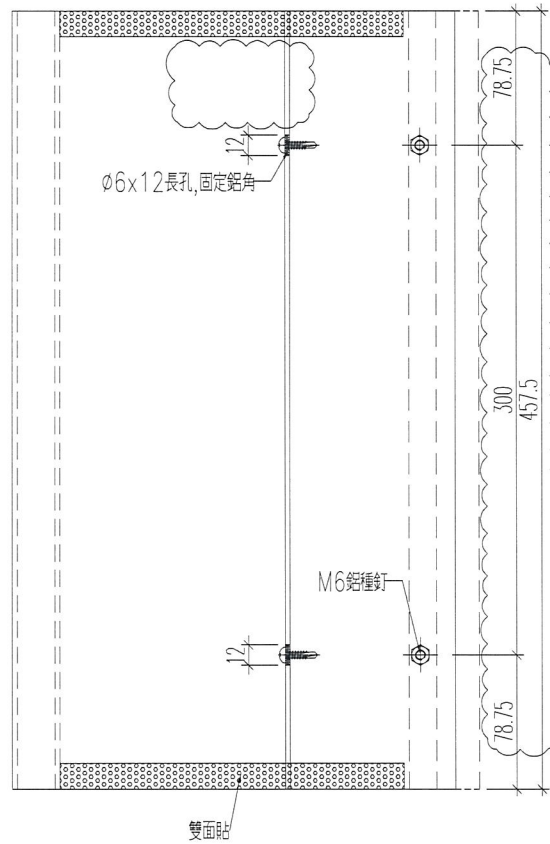

名稱	牆側收口件	制圖	黃漢卿	2017.12.13	修改	A		
材料	X85477	復核	王禮秋	2017.12.13	日期	2018.4.14		
顏色	TUC51595XL(RYA)-3(中灰)	批准			圖號	DL-SK5		





美特鋁質 有限公司  
MIDI Aluminium Fabricator Ltd.

工程號 J-833 地盤 白石

數量	位置
1	T1-CW2
1	T2-CW2
1	T3-CW2
1	T3-CW4
1	T5-CW2
1	T5-CW8
1	T6-CW11
1	T8-CW7
1	T8-CW12

取消此欄

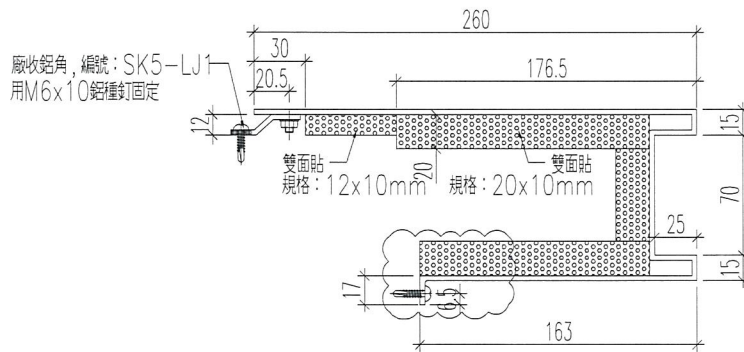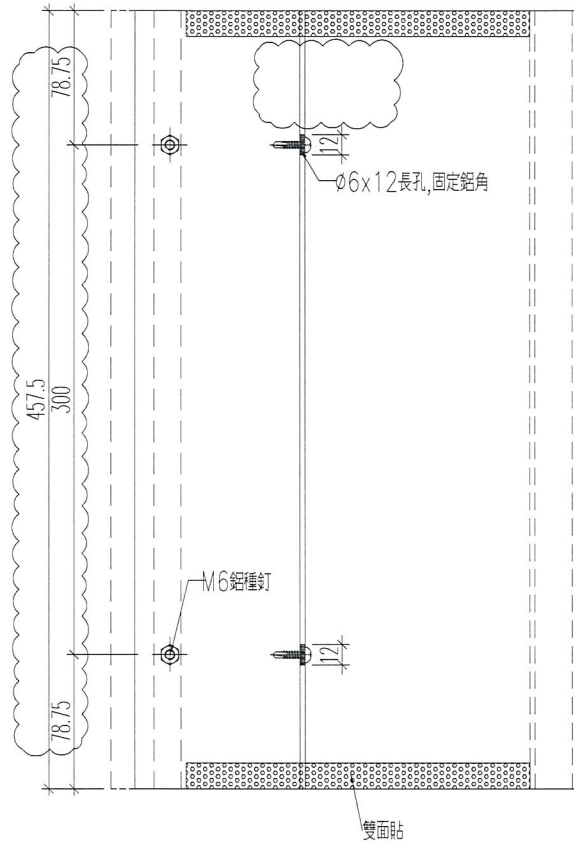

名稱	牆側收口件	制圖	黃漢瑯	2017.12.13	修改	A	
材料	X85477	復核	王禮秋	2017.12.13	日期	2018.4.14	
顏色	TUC51595XL(RYA)-3(中灰)	批准			圖號	DL-SK5R	


# EG-DWG3



美特鋁質 有限公司  
MIDI Aluminium Fabricator Ltd.

工程號 J-833 地盤 白石

數量	位置
1	T1-CW3
1	T7-CW3
1	T8-CW7
1	T8-CW14A

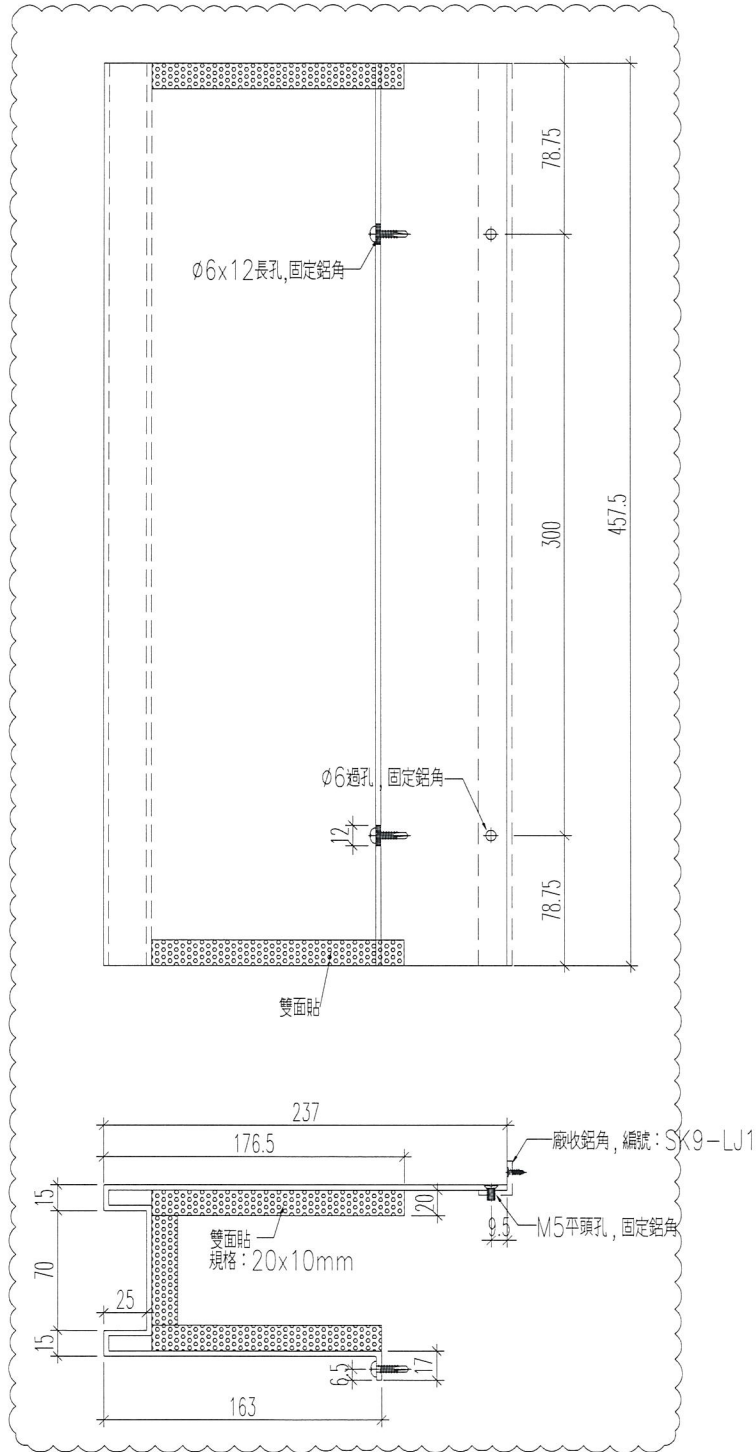

名稱	牆側收口件	制圖	黃漢卿	2017.12.13	修改	A	
材料	X85477	復核	王禮秋	2017.12.13	日期	2018.4.14	
顏色	TUC51595XL(RYA)-3(中灰)	批准			圖號	DL-SK9	


# EG-DWG3



美特鋁質 有限公司  
MIDI Aluminium Fabricator Ltd.

數量	位置
1	T2-CW3
1	T3-CW4

工程號	J-833	地盤	白石
-----	-------	----	----

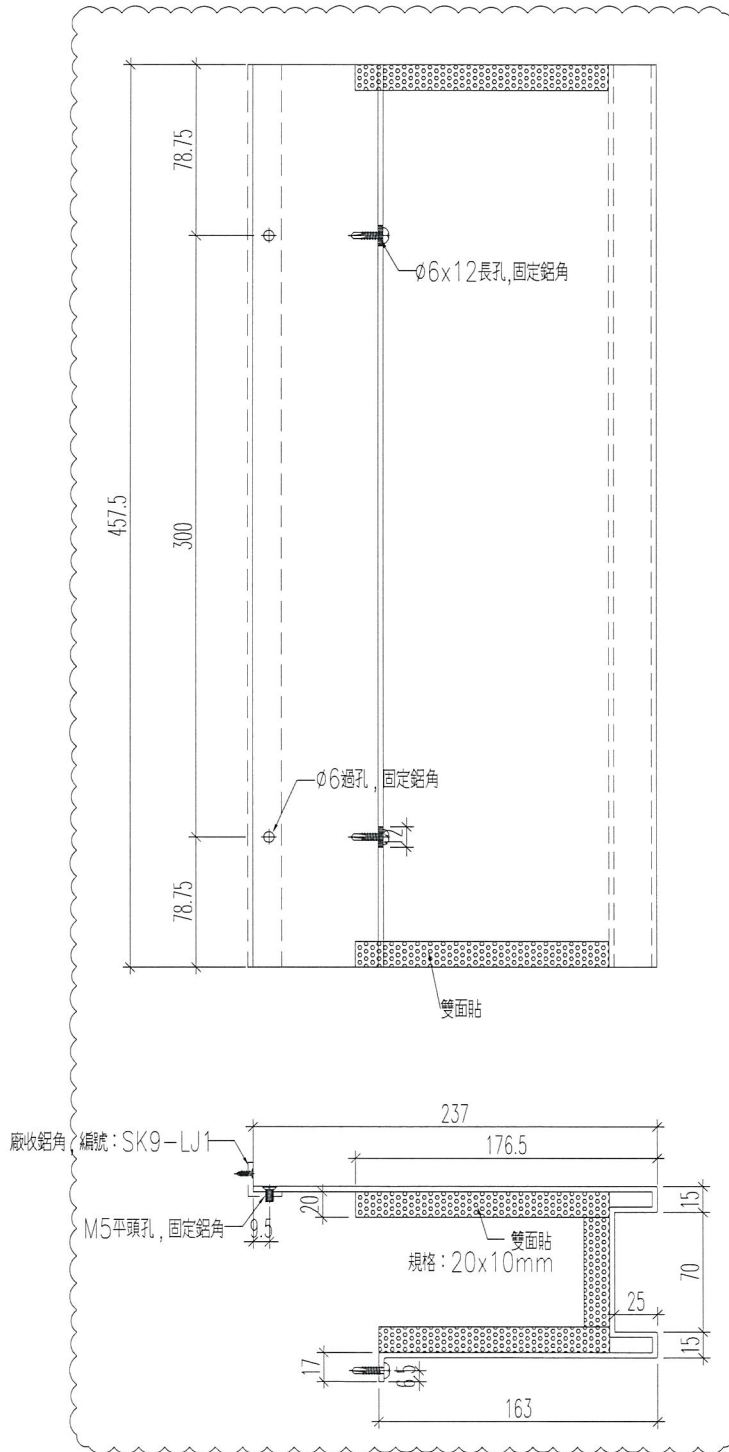

名稱	牆側收口件	制圖	黃漢卿	2017.12.13	修改	A	
材料	X85477	復核	王禮秋	2017.12.13	日期	2018.4.14	
顏色	TUC51595XL(RYA)-3(中灰)	批准			圖號	DL-SK9R	

# EG-DWG3





美特鋁質 有限公司  
MIDI Aluminium Fabricator Ltd.

物料編號	長度L	L1	數量	N	A	鉛角編號	使用位置
DL-SK13	3572.5	985	1	300 x 11	136.25	SK13-LJ1	T3-CW1 T4-CW1

工程號	J-833	地盤	白石
-----	-------	----	----

*Isca*

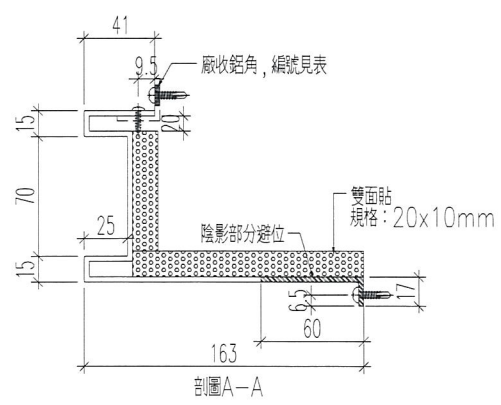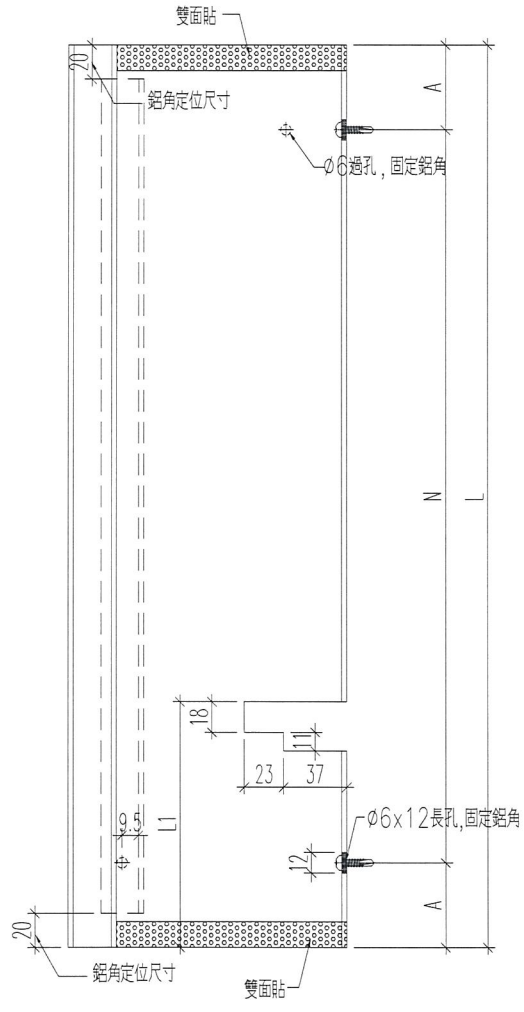

名稱	牆側收口件	制圖	黃漢卿	2017.9.7	修改	A	
材料	X85477	復核	王禮秋	2017.9.7	日期	2018.4.14	
顏色	TUC51595XL(RYA)-3(中灰)	批准			圖號	DL-SK13	

# EG-DWG3





美特鋁質 有限公司  
MIDI Aluminium Fabricator Ltd.

物料編號	長度L	L1	N	A	鋁角編號	數量	使用位置
DL-SK13R	3572.5	985	300 x 11	136.25	SK13-LJ1	1	T2-CW1
						1	T3-CW1
						1	T4-CW1R

工程號 J-833 地盤 白石

T3  
EWK

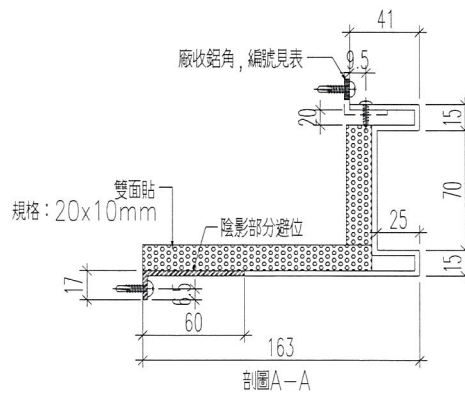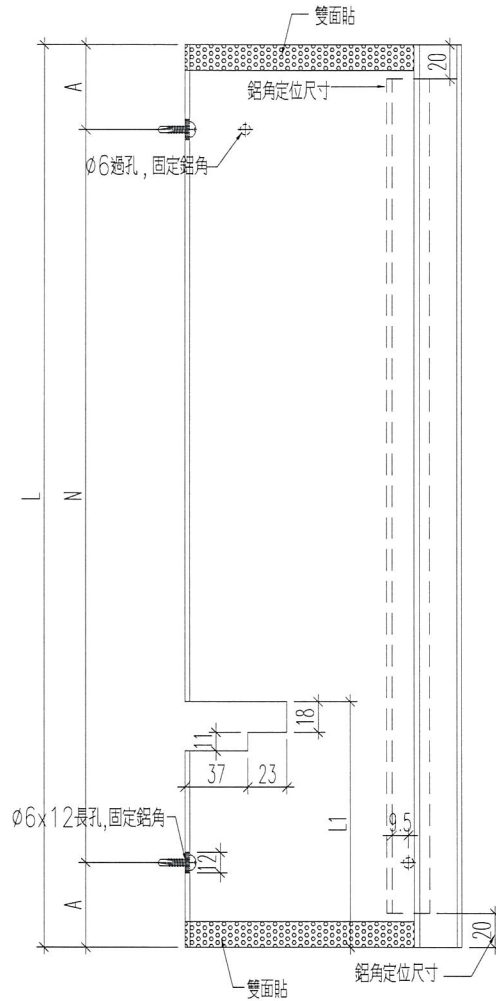

名稱	牆側收口件	制圖	黃漢卿	2017.9.7	修改	A	
材料	X85477	復核	王禮秋	2017.9.7	日期	2018.4.14	
顏色	TUC51595XL(RYA)-3(中灰)	批准			圖號	DL-SK13R	





# EG-DWG3



美特鋁質 有限公司  
MIDI Aluminium Fabricator Ltd.

數量	位置
1	T6-CW8
1	T8-CW7aR



工程號 J-833 地盤 白石

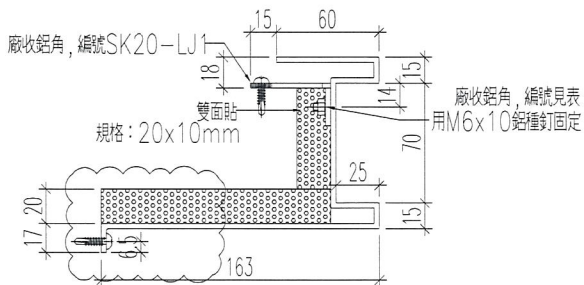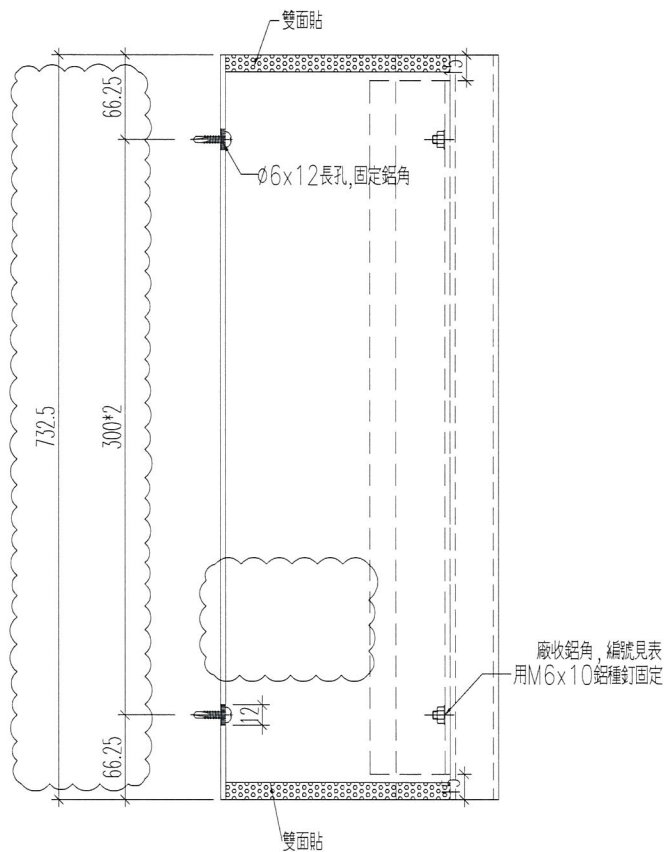

名稱	牆側收口件	制圖	黃漢卿	2017.12.13	修改	A	B
材料	X85477	復核	王禮秋	2017.12.13	日期	3.13	2018.4.14
顏色	TUC51595XL(RYA)-3(中灰)	批准			圖號	DL-SK20R	

數量	位置
1	T2-CW4

工程號	J-833	地盤	白石
-----	-------	----	----

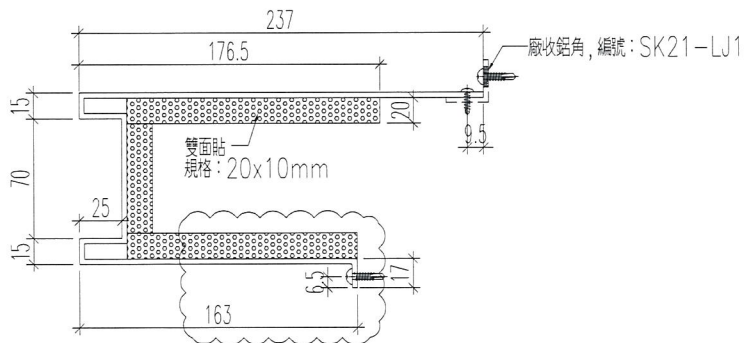
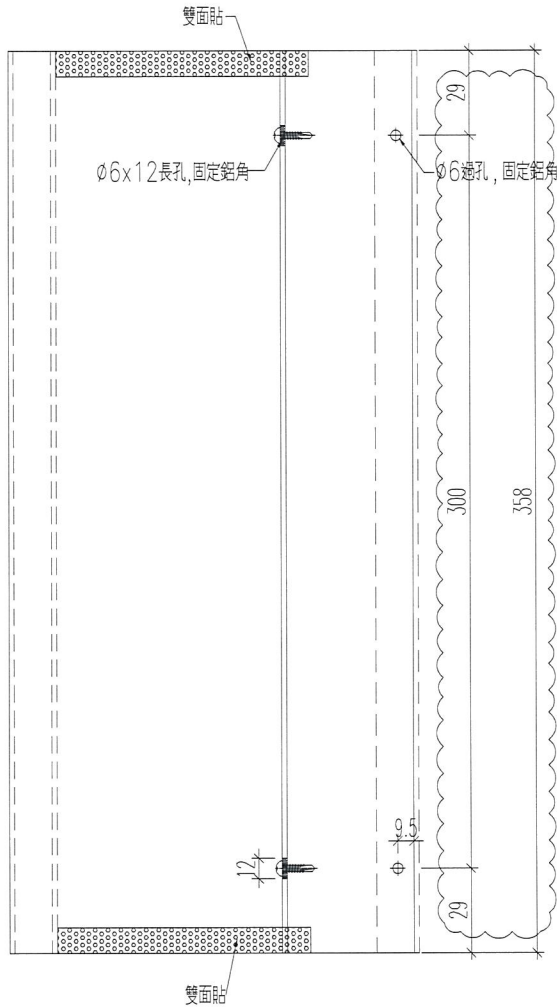


名稱	牆側收口件	制圖	黃漢卿	2017.12.13	修改	A	
材料	X85477	復核	王禮秋	2017.12.13	日期	2018.4.14	
顏色	TUC51595XL(RYA)-3(中灰)	批准			圖號	DL-SK21	



數量	位置
1	T8-CW3

工程號	J-833	地盤	白石
-----	-------	----	----

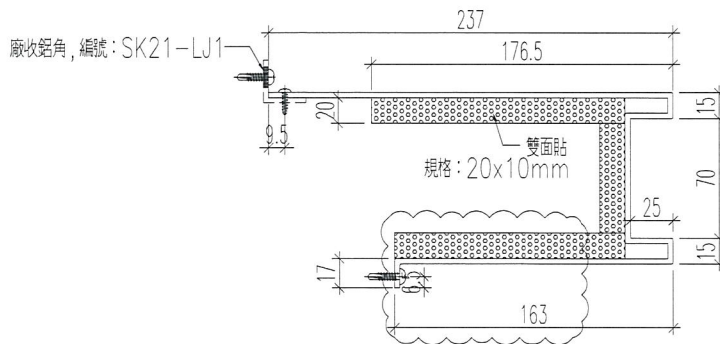
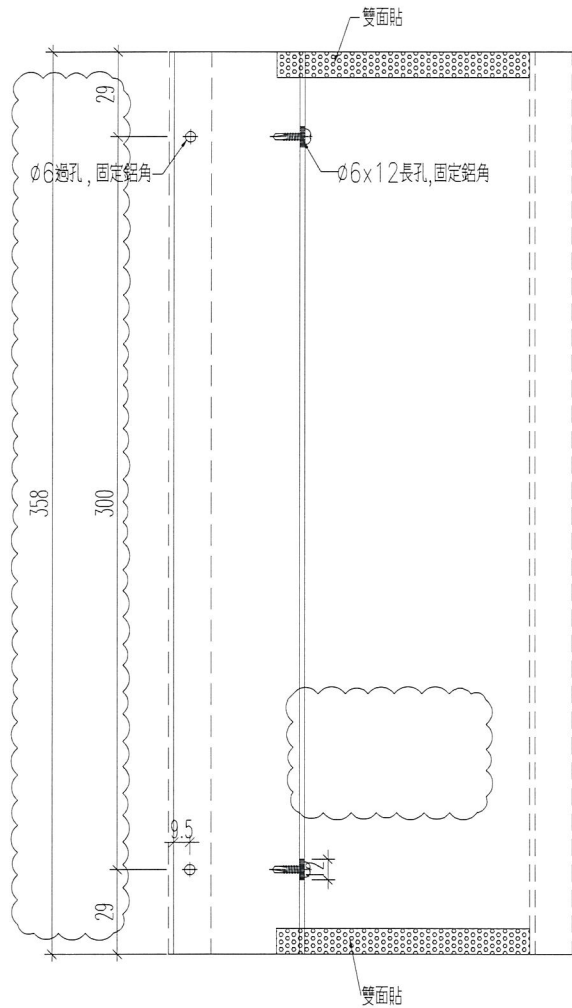


名稱	牆側收口件	制圖	黃漢卿	2017.12.13	修改	A		
材料	X85477	復核	王禮秋	2017.12.13	日期	2018.4.14		
顏色	TUC51595XL(RYA)-3(中灰)	批准			圖號	DL-SK21R		



數量	位置
1	T5-CW8

工程號	J-833	地盤	白石
-----	-------	----	----

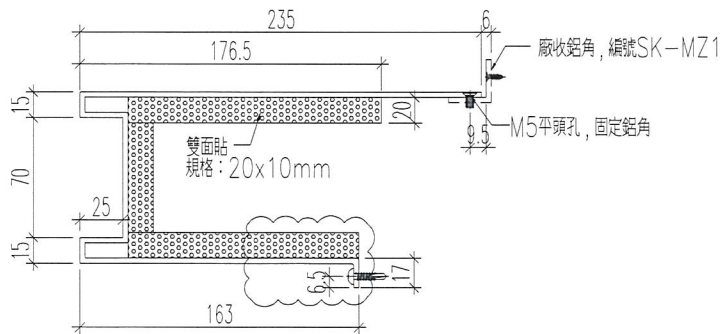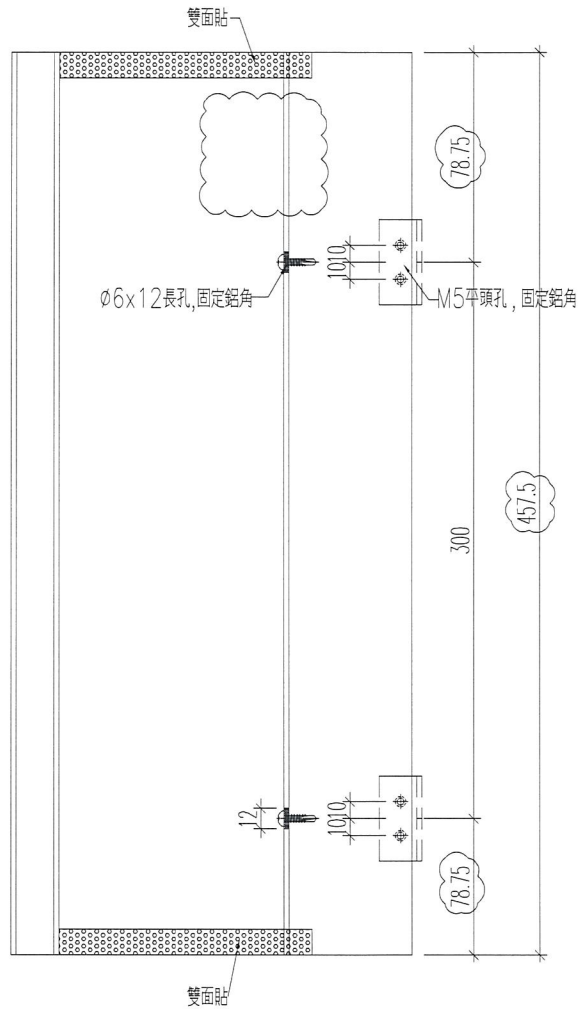

名稱	牆側收口件	制圖	黃漢卿	2017.12.13	修改	A	B
材料	X85477	復核	王禮秋	2017.12.13	日期	3.20	2018.4.14
顏色	TUC51595XL(RYA)-3(中灰)	批准			圖號	DL-SK33	



# EG-DWG3



美特鋁質 有限公司  
MIDI Aluminium Fabricator Ltd.

數量	位置
1	T6-CW9

工程號	J-833	地盤	白石
-----	-------	----	----

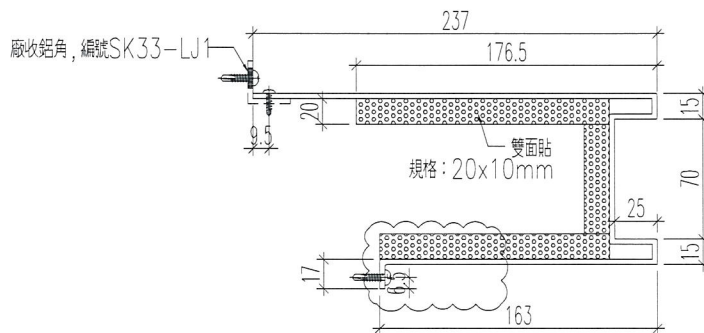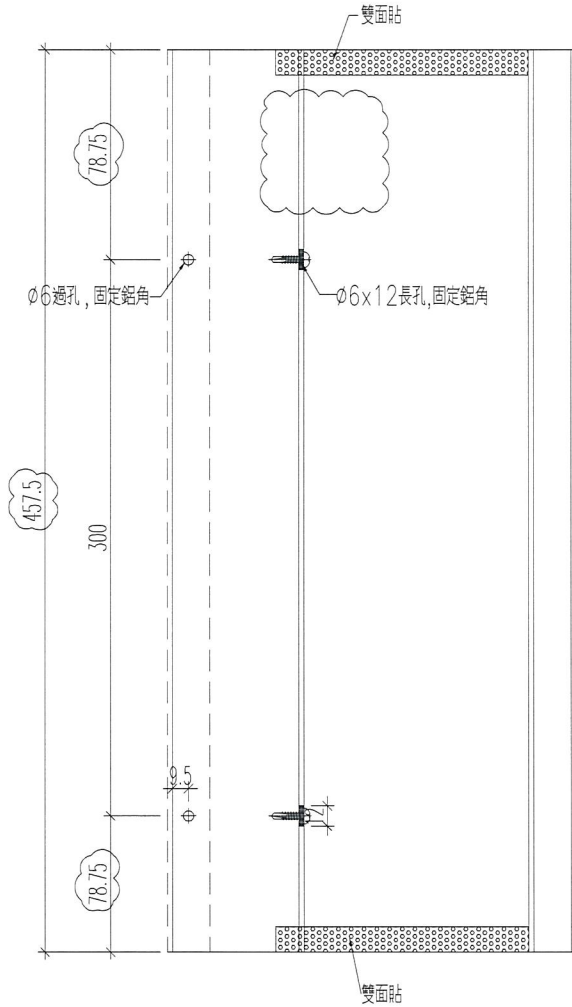

名稱	牆側收口件	制圖	黃漢卿	2017.12.13	修改	A	B	C
材料	X85477	復核	王禮秋	2017.12.13	日期	3.13	3.20	2018.4.14
顏色	TUC51595XL(RYA)-3(中灰)	批准			圖號	DL-SK33R		



# EG-DWG3



美特鋁質 有限公司  
MIDI Aluminium Fabricator Ltd.

數量	位置
1	T8-CW1

工程號	J-833	地盤	白石
-----	-------	----	----

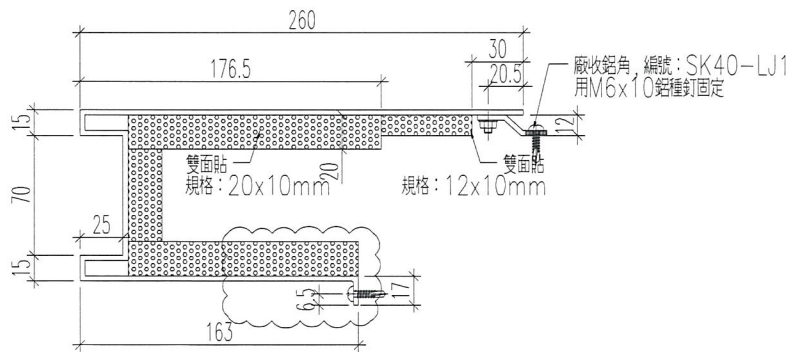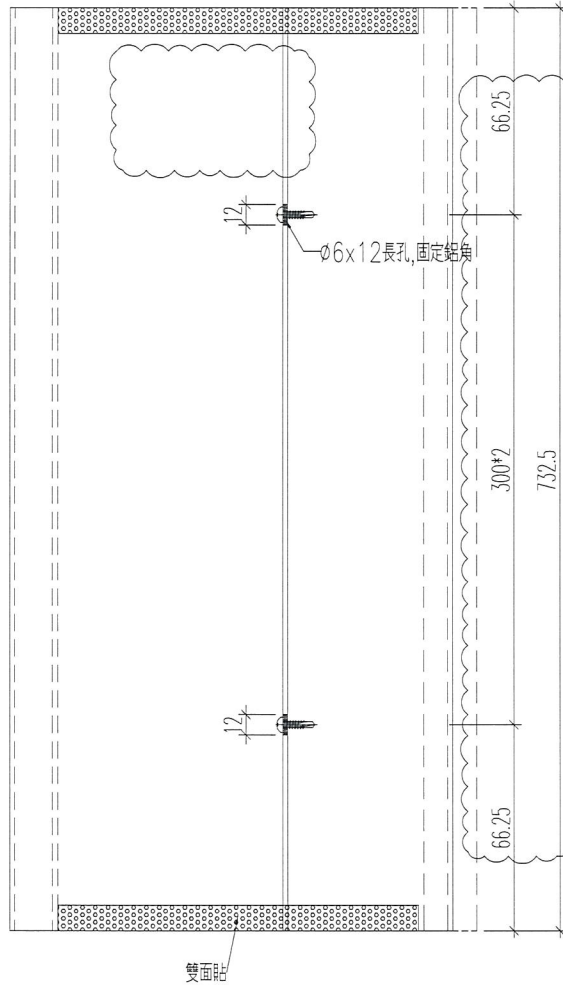

名稱	牆側收口件	制圖	黃漢卿	2017.12.13	修改	A	
材料	X85477	復核	王禮秋	2017.12.13	日期	2018.4.14	
顏色	TUC51595XL(RYA)-3(中灰)	批准			圖號	DL-SK40	



# EG-DWG3



美特鋁質 有限公司  
MIDI Aluminium Fabricator Ltd.

數量	位置
1	T7-CW1

工程號	J-833	地盤	白石
-----	-------	----	----

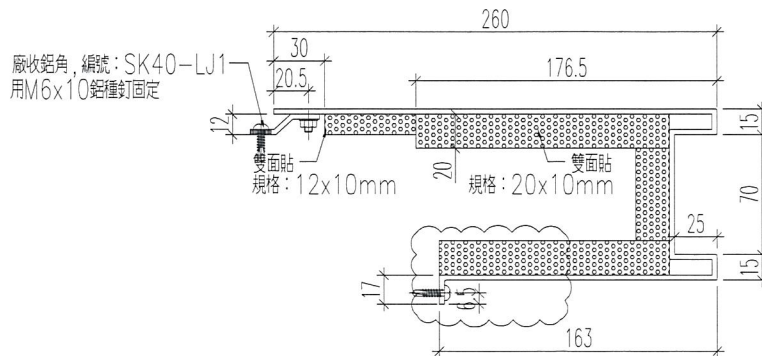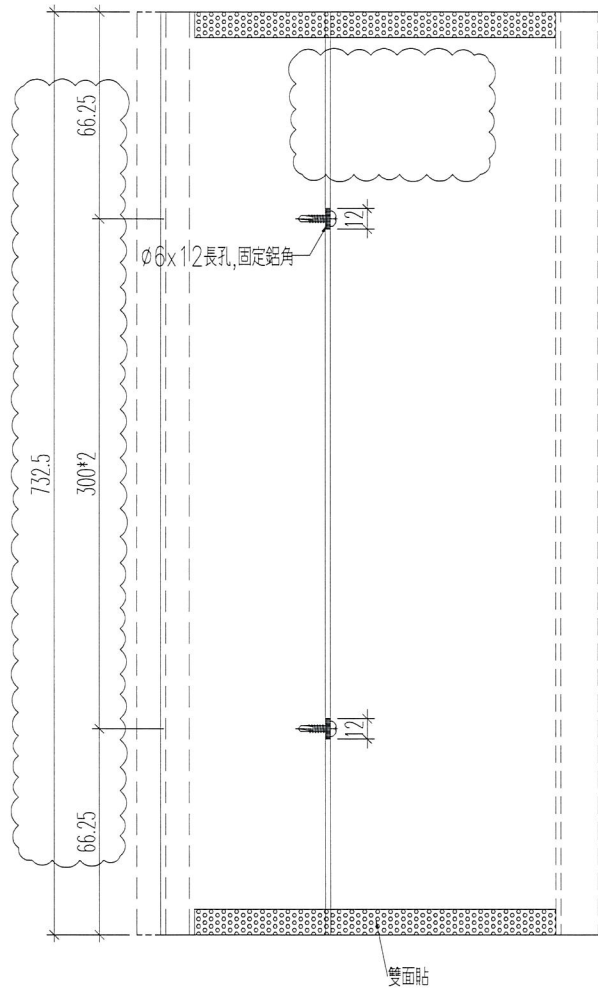


名稱	牆側收口件	制圖	黃漢卿	2017.12.13	修改	A	
材料	X85477	復核	王禮秋	2017.12.13	日期	2018.4.14	
顏色	TUC51595XL(RYA)-3(中灰)	批准			圖號	DL-SK40R	




數量	位置
1	T1-CW5
1	T8-CW14B

工程號	J-833	地盤	白石
-----	-------	----	----

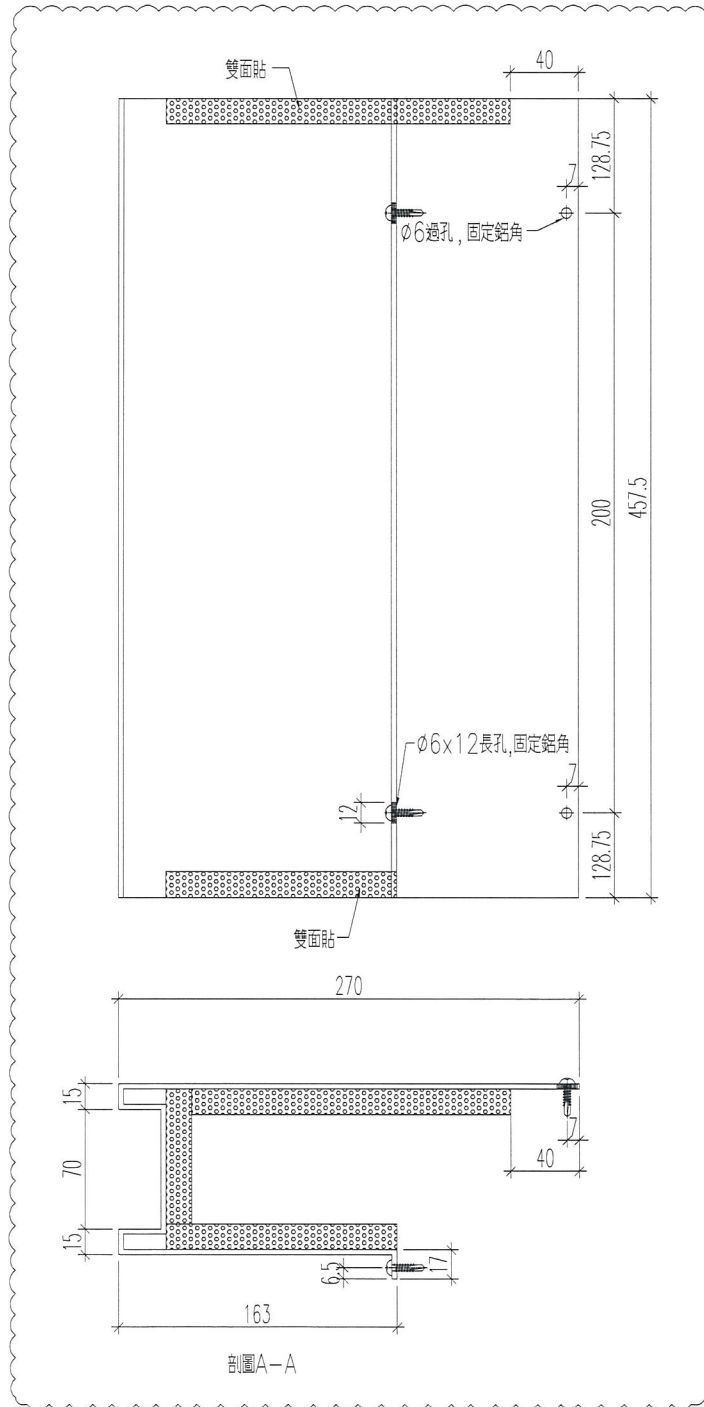


名稱	牆側收口件	制圖	黃漢卿	2017.9.7	修改	A		
材料	X85477	復核	王禮秋	2017.9.7	日期	2018.4.14		
顏色	TUC51595XL(RYA)-3(中灰)	批准			圖號	DL-SK45		

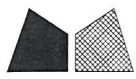

數量	位置
1	T2-CW5
1	T6-CW5
1	T7-CW14

工程號 J-833 地盤 白石

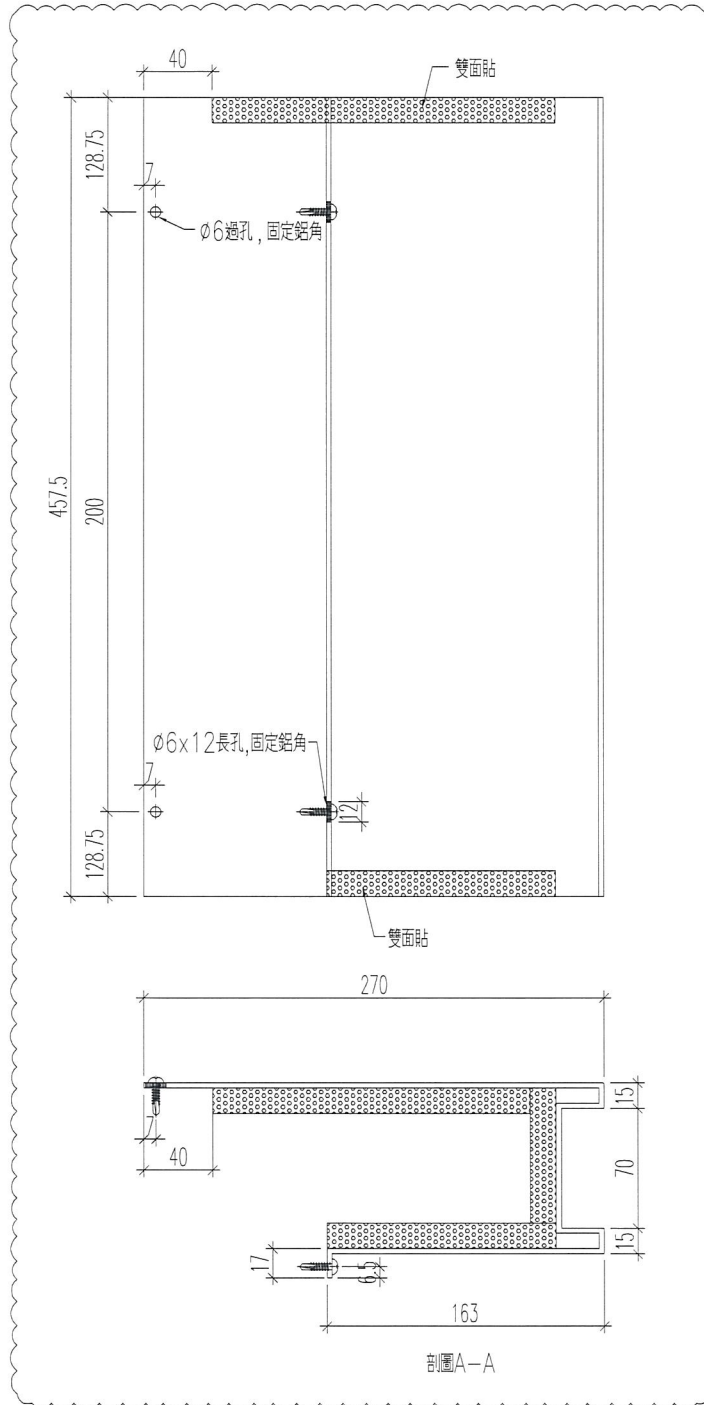


名稱	牆側收口件	制圖	黃漢卿	2017.9.7	修改	A	
材料	X85477	復核	王禮秋	2017.9.7	日期	2018.4.14	
顏色	TUC51595XL(RYA)-3(中灰)	批准			圖號	DL-SK45R	



數量	位置
1	T7-CW5
1	T8-CW5

工程號	J-833	地盤	白石
-----	-------	----	----

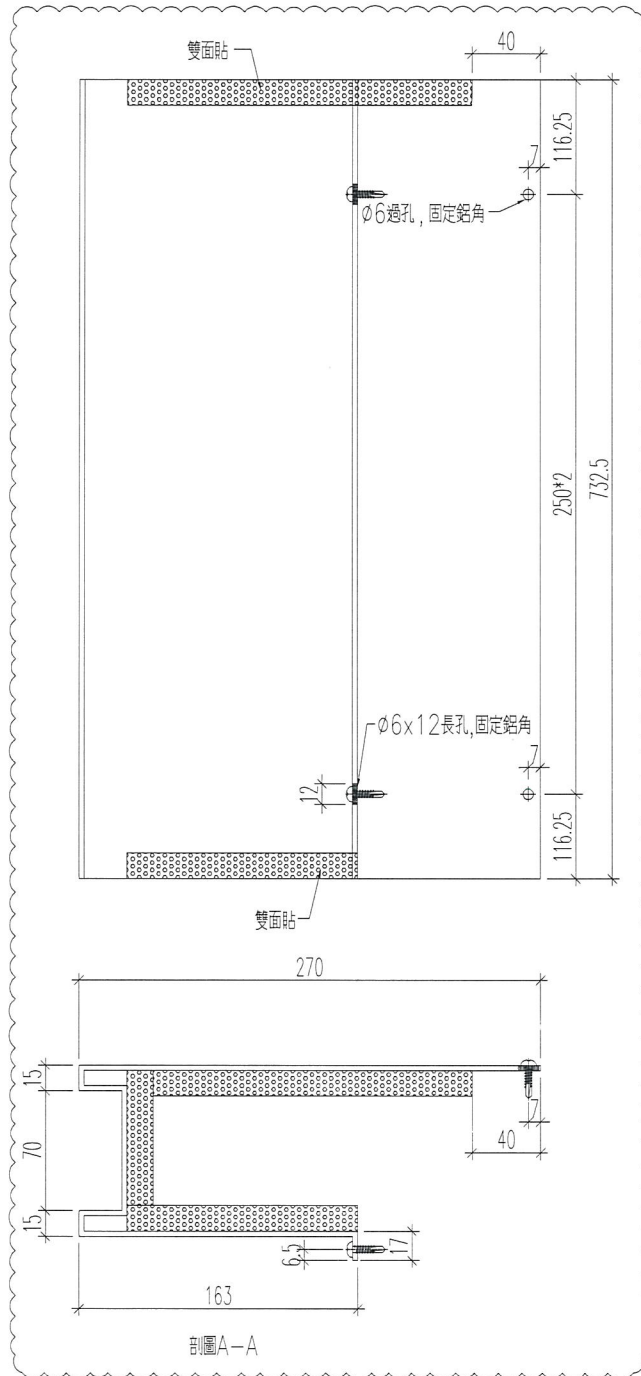

名稱	牆側收口件	制圖	黃漢卿	2017.9.7	修改	A	
材料	X85477	復核	王禮秋	2017.9.7	日期	2018.4.14	
顏色	TUC51595XL(RYA)-3(中灰)	批准			圖號	DL-SK48	



# EG-DWG3




美特鋁質 有限公司  
MIDI Aluminium Fabricator Ltd.

工程號 J-833 地盤 白石

數量	位置
1	T8-CW7a
1	T8-CW8

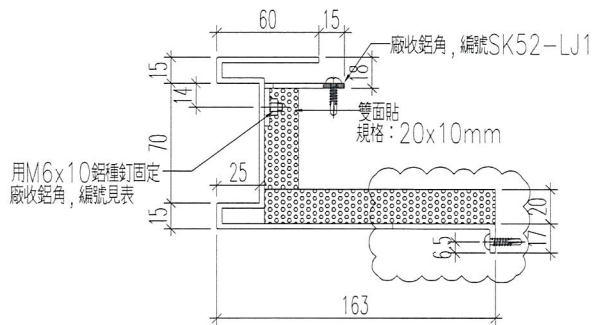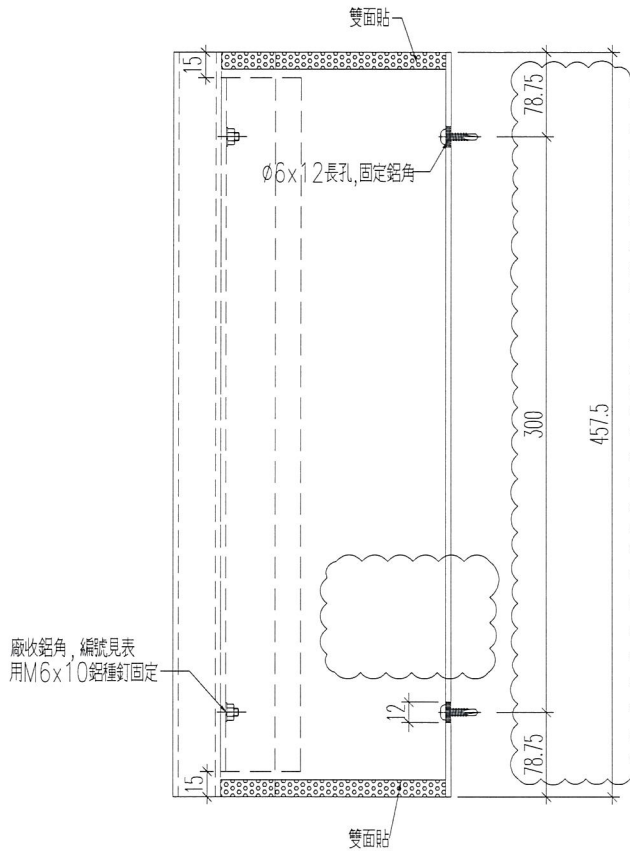

名稱	牆側收口件	制圖	黃漢卿	2017.12.13	修改	A	B
材料	X85477	復核	王禮秋	2017.12.13	日期	3.13	2018.4.14
顏色	TUC51595XL(RYA)-3(中灰)	批准			圖號	DL-SK52	

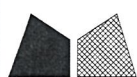



工程號

J-833

地盤


白石

加工數量：4預多

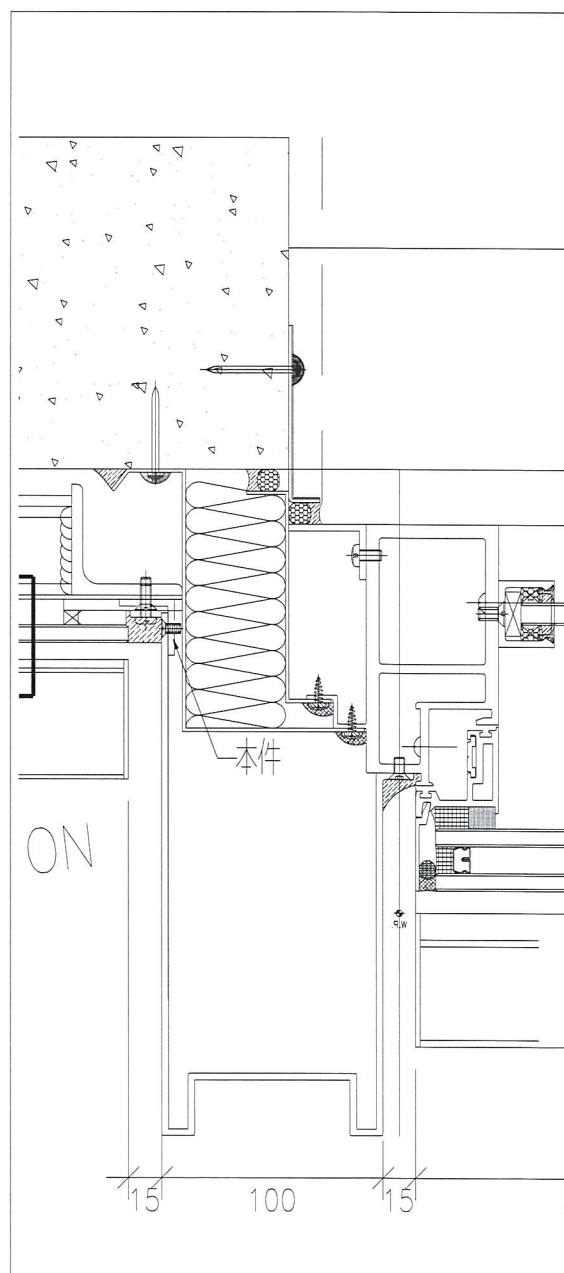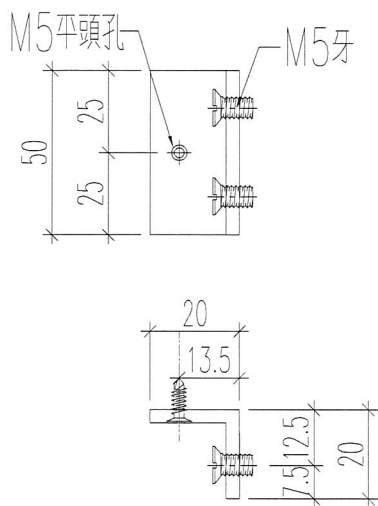

名稱	鋁角加工圖	制圖	吳禕瑜	2018.4.17	修改			
材料	20x20x3鋁角	復核			日期			
顏色	MILL	批准			圖號	SK-MZ1x		

# EG-DWG3


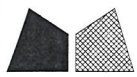


美特鋁質 有限公司  
MIDI Aluminium Fabricator Ltd.

物料編號	長度L	數量	N		A
SK20-LJ1	732.5	2	300	x 2	66.25
SK52-LJ1	457.5	2	300	x 1	78.75

工程號	J-833	地盤	白石
-----	-------	----	----


放行

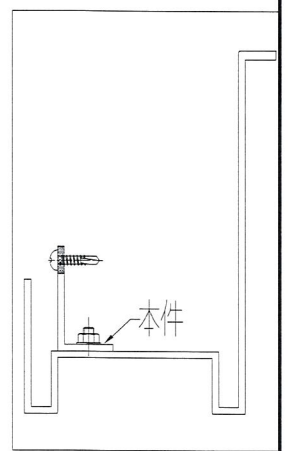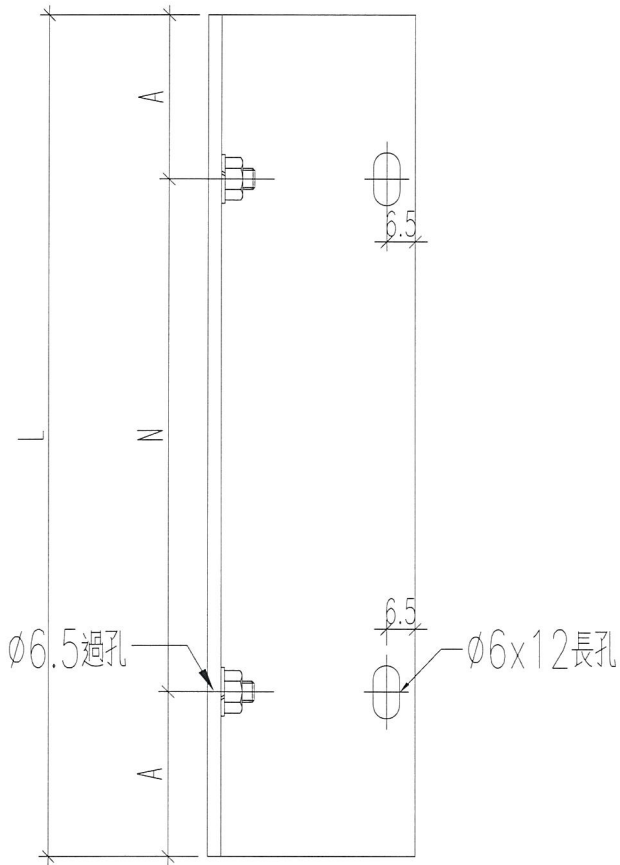

名稱	鋁角加工圖	制圖	吳禕瑜	2018.4.17	修改			
材料	47x25x3鋁角	復核			日期			
顏色	MILL	批准			圖號	SK20-LJ1		





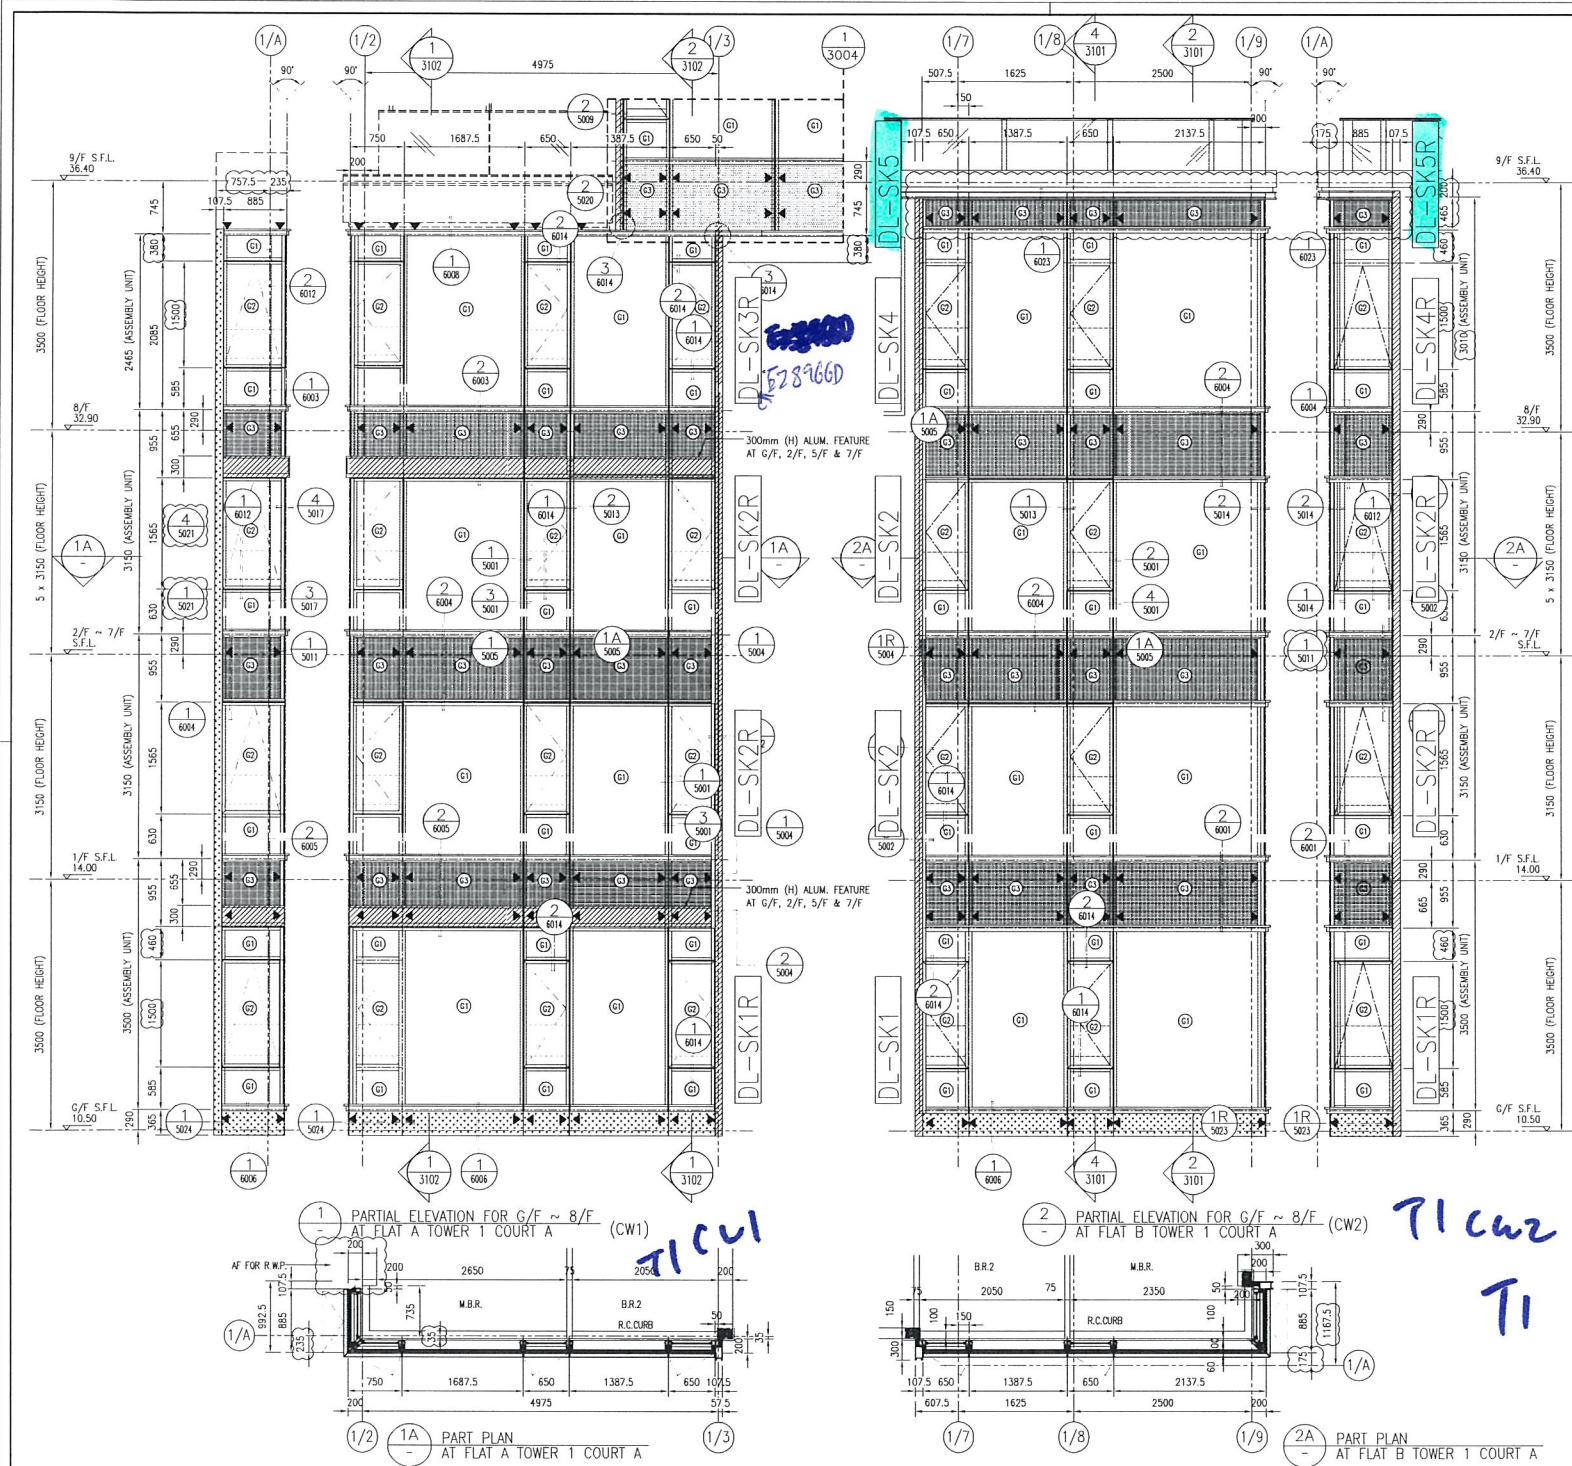

**LEGEND:**

- (G1) IGU (8mm THK. HEAT STRENGTHENED GLASS+12mm THK. AIR +10mm THK. TEMPERED GLASS)
- (G2) 10mm THK HEAT STRENGTHENED GLASS W/ 2mm THICK ALUM. BACK PANEL
- (G3) IGU SIDE HUNG WINDOW (8mm THK. HEAT STRENGTHENED GLASS+12mm THK. AIR +8mm THK. TEMPERED GLASS) W/ 10mm THK. TEMPERED GLASS BARRIER BEHIND
- (G4) IGU TOP HUNG WINDOW (8mm THK. HEAT STRENGTHENED GLASS+12mm THK. AIR +8mm THK. TEMPERED GLASS) W/ 10mm THK. TEMPERED GLASS BARRIER BEHIND
- ALUM. FEATURE
- 3mm THK. ALUM. CLADDING
- SUPPORT POINT

B.D. REF :  
 F.S.D. REF :  
 Note :  
 1. All dimensions are in mm.  
 2. All elevations are viewed from outside.  
 3. All dimensions to be verified on site before fabrication.

**GENERAL NOTES**

1. F.F.L.--- Finished Floor Level
2. S.F.L.--- Structural Floor Level
3. --- Reversed Detail

(X) --- DETAIL MARK NO.  
 (K) --- REFER SHEET NO.

REV	AMENDMENTS	DATE
A	GENERAL REVISED	27/11/2016
B	GENERAL REVISED	21/12/2016
C	GENERAL REVISED	3/6/2017

CLIENT:  
**GOOD ASSETS LTD.**

PROJECT ARCHITECT:  
**SUN HUNG KAI**  
 ARCHITECTS AND ENGINEERS LIMITED

DESIGN ARCHITECT:  
**RONALD LU & PARTNERS**

STRUCTURAL ENGINEER:  
**PARSONS BRINCKERHOFF**

FAÇADE CONSULTANT:  
**ALPHA CONSULTING LIMITED**  
 Steel Structure & Façade Specialist


MAIN CONTRACTOR:  
**YEE FAI CONSTRUCTION CO. LTD.**

**美特鋁質有限公司**  
**MIDI ALUMINIUM FABRICATOR LTD.**  
 Units 6-8, Sunray Industrial Centre, 1/F  
 610 Cha Kwo Ling Road, Kowloon  
 Tel: 23489211-4 Fax: (852) 2727666

PROJECT TITLE:  
 PROPOSED RESIDENTIAL DEVELOPMENT, AT STLL 581, YIU SHA ROAD, WHITEHEAD, MA ON SHAN, NEW TERRITORIES

DRAWING TITLE:  
 CURTAIN WALL  
 TOWER 1 COURT A

DRAWN : Asing	DATE 08-07-16
DESIGNED :	SCALE 1:35(A1)
CHECKED :	PROJECT NO: J-833
DRAWING NO: JB33-TCW-3001	REV C

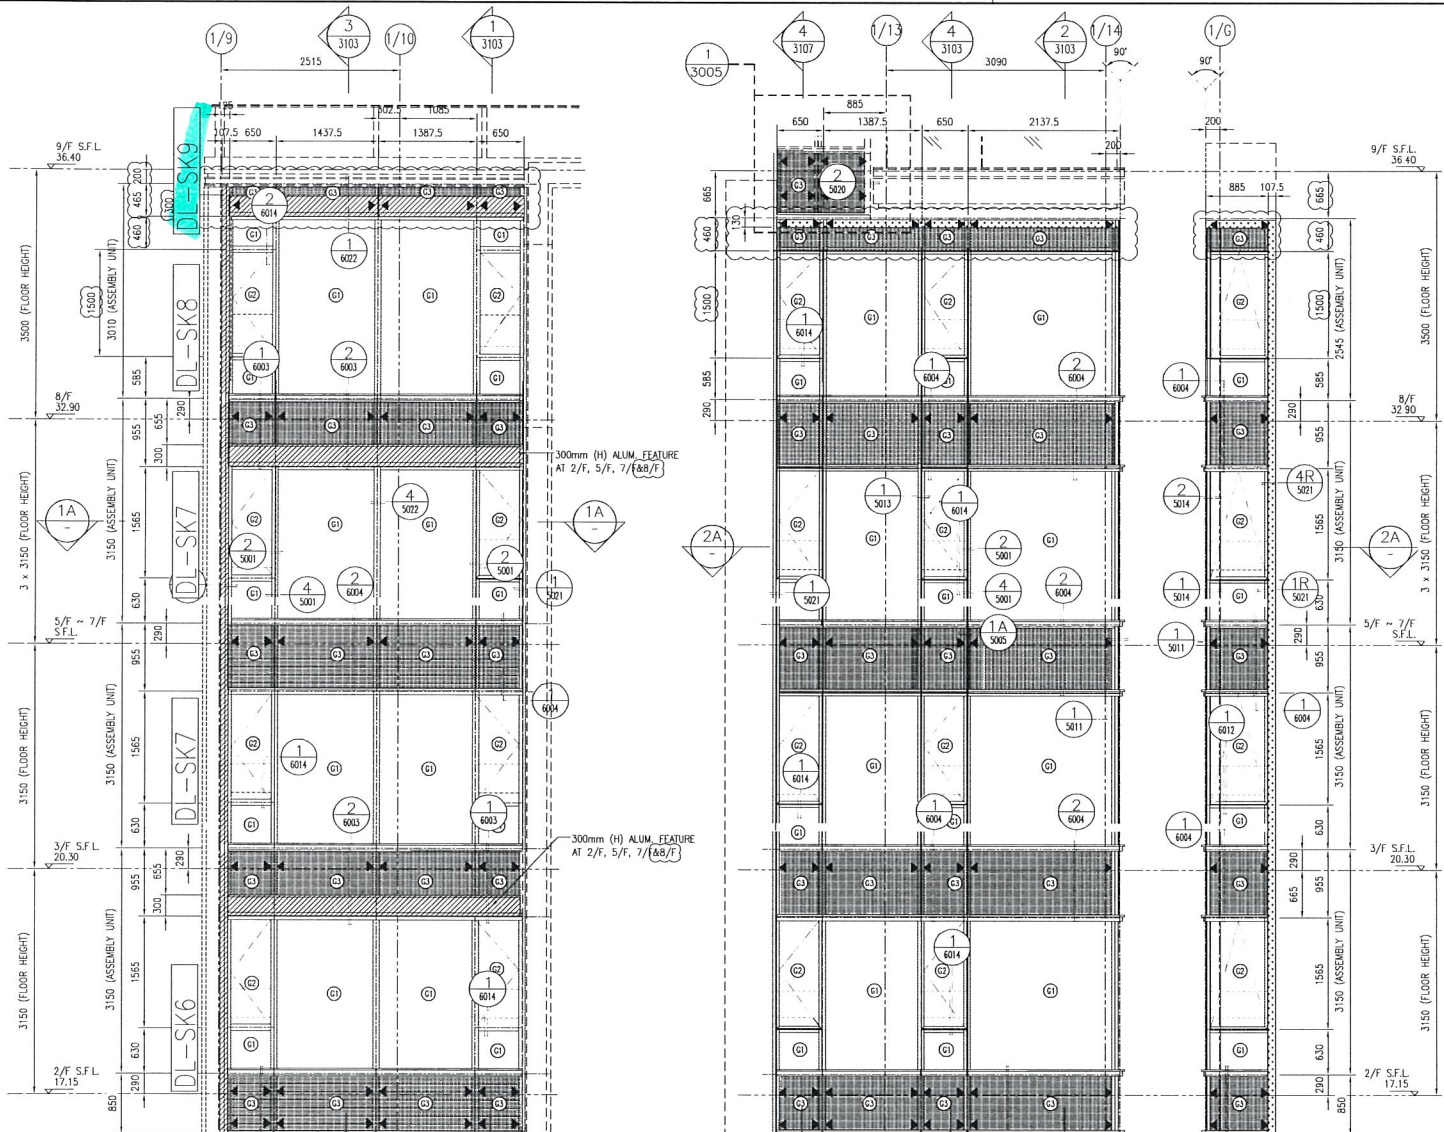

**LEGEND:**

- (G1) IGU (8mm THK. HEAT STRENGTHENED GLASS+12mm THK. AIR +10mm THK. TEMPERED GLASS)
- (G2) 10mm THK. HEAT STRENGTHENED GLASS W/ 2mm THICK ALUM. BACK PANEL
- (G3) IGU SIDE HUNG WINDOW (8mm THK. HEAT STRENGTHENED GLASS+12mm THK. AIR +8mm THK. TEMPERED GLASS) W/ 10mm THK. TEMPERED GLASS BARRIER BEHIND
- (G4) IGU TOP HUNG WINDOW (8mm THK. HEAT STRENGTHENED GLASS+12mm THK. AIR +8mm THK. TEMPERED GLASS) W/ 10mm THK. TEMPERED GLASS BARRIER BEHIND
- (A) ALUM. FEATURE
- (C) 3mm THK. ALUM. CLADDING
- (S) SUPPORT POINT

B.D. REF :  
F.S.D. REF :  
Note:  
1. All dimensions are in mm.  
2. All elevations are viewed from outside.  
3. All dimensions to be verified on site before fabrication.

**GENERAL NOTES**

**Legend**

- F.F.L. --- Finished Floor Level
- S.F.L. --- Structural Floor Level
- --- Reversed Detail

x --- DETAIL MARK NO.  
x/D --- REFER SHEET NO.

REV	AMENDMENTS	DATE
A	GENERAL REVISED	27/11/2016
B	GENERAL REVISED	21/12/2016
C	GENERAL REVISED	3/6/2017

CLIENT:  
**GOOD ASSETS LTD.**

PROJECT ARCHITECT:  
**SUN HUNG KAI**  
ARCHITECTS AND ENGINEERS LIMITED

DESIGN ARCHITECT:  
**RONALD LU & PARTNERS**

STRUCTURAL ENGINEER:  
**PARSONS BRINCKERHOFF**

FACADE CONSULTANT:  
**ALPHA CONSULTING LIMITED**  
Steel Structure & Façade Specialist S.

MAIN CONTRACTOR:  
YEE FAI CONSTRUCTION CO. LTD.

**美特鋁質有限公司**  
MIDI ALUMINIUM FABRICATOR LTD.  
Units 6-8, Sunray Industrial Centre, 1/F  
610 Cha Kwo Ling Road, Kowloon  
Tel:23489211-4 Fax:(852)2727666

PROJECT TITLE:  
PROPOSED RESIDENTIAL DEVELOPMENT, AT STLL 581, YIU SHA ROAD, WHITEHEAD, MA ON SHAN, NEW TERRITORIES

DRAWING TITLE:  
ELEVATION FOR TOWER CURTAIN WALL TOWER 1 COURT A

DRAWN :	Asing	DATE	08-07-16
DESIGNED :		SCALE	1:35(A1)
CHECKED :		PROJECT NO.:	J-833
DRAWING NO.:	J833-TCW-3002	REV	C

*TLcw3*

*TLcw4a*


*T1*

1 PARTIAL ELEVATION FOR 2/F ~ 8/F (CW3) AT FLAT C TOWER 1 COURT A


2 PARTIAL ELEVATION FOR 2/F ~ 8/F (CW4a) AT FLAT E TOWER 1 COURT A

1A PART PLAN AT FLAT C TOWER 1 COURT A

2A PART PLAN AT FLAT E TOWER 1 COURT A

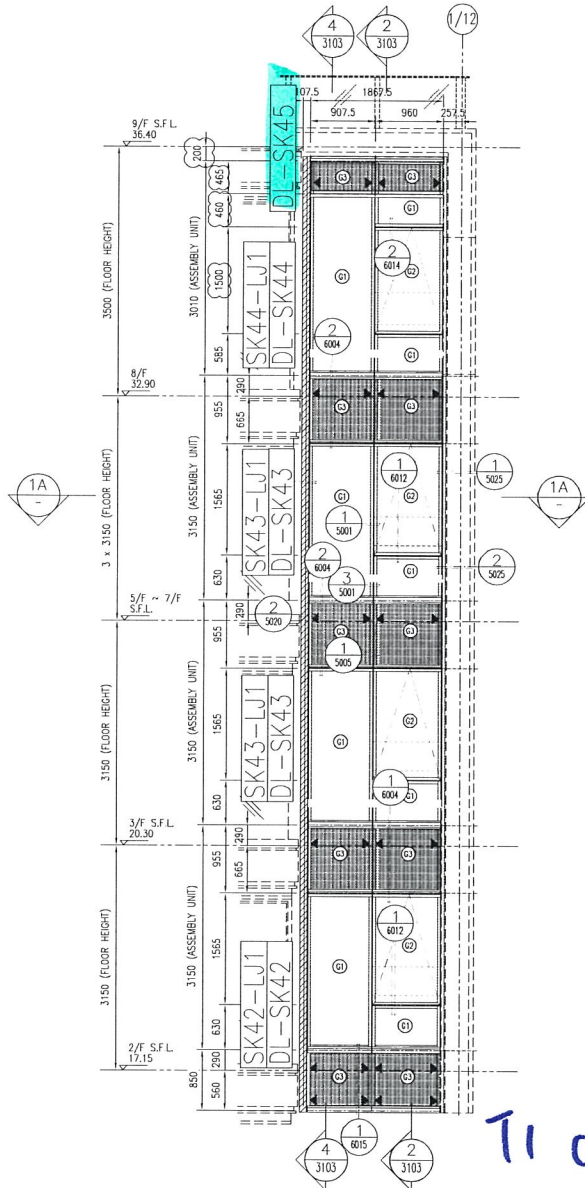

1 PARTIAL ELEVATION FOR 2/F ~ 8/F (CW5) AT FLAT D TOWER 1 COURT A

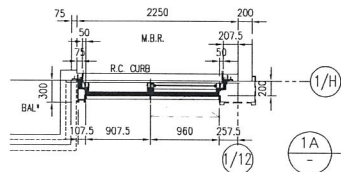

1A PART PLAN AT FLAT D TOWER 1 COURT A

*TI CW5*

*TI*

LEGEND:

- IGU (8mm THK. HEAT STRENGTHENED GLASS+12mm THK. AIR +10mm THK. TEMPERED GLASS)
- 10mm THK. HEAT STRENGTHENED GLASS W/ 2mm THICK ALUM. BACK PANEL
- IGU SIDE HUNG WINDOW (8mm THK. HEAT STRENGTHENED GLASS+12mm THK. AIR +8mm THK. TEMPERED GLASS) W/ 10mm THK. TEMPERED GLASS BARRIER BEHIND
- IGU TOP HUNG WINDOW (8mm THK. HEAT STRENGTHENED GLASS+12mm THK. AIR +8mm THK. TEMPERED GLASS) W/ 10mm THK. TEMPERED GLASS BARRIER BEHIND
- ALUM. FEATURE
- 3mm THK. ALUM. CLADDING
- SUPPORT POINT

B.D. REF.

F.S.D. REF :  
 Note :  
 1. All dimensions are in mm.  
 2. All elevations are viewed from outside.  
 3. All dimensions to be verified on site before fabrication.

GENERAL NOTES

- S.F.L. ---  
 1 F.F.L. --- Finished Floor Level  
 2. S.F.L. --- Structural Floor Level  
 3. --- Reversed Detail
- DETAIL MARK NO.  
 --- REFER SHEET NO.

REV	AMENDMENTS	DATE
A	GENERAL REVISED	27/11/2016
B	GENERAL REVISED	21/12/2016
C	GENERAL REVISED	3/6/2017

CLIENT:  
**GOOD ASSETS LTD.**

PROJECT ARCHITECT:  
**SUN HUNG KAI**  
 ARCHITECTS AND ENGINEERS LIMITED

DESIGN ARCHITECT:  
**RONALD LU & PARTNERS**

STRUCTURAL ENGINEER :  
**PARSONS BRINCKERHOFF**

FAÇADE CONSULTANT  
**ALPHA CONSULTING LIMITED**  
 (Steel Structure & Façade Specialist)


MAIN CONTRACTOR :  
 YEE FAI CONSTRUCTION CO. LTD.

**美特鋁質有限公司**  
 MIDI ALUMINIUM FABRICATOR LTD.  
 Units 6-8, Sunray Industrial Centre, 1/F  
 610 Cha Kwo Ling Road, Kowloon  
 Tel:23489211-4 Fax:(852)2727666

PROJECT TITLE :  
 PROPOSED RESIDENTIAL DEVELOPMENT, AT STTL 581, YIU SHA ROAD WHITEHEAD, MA ON SHAN, NEW TERRITORIES

DRAWING TITLE :  
 ELEVATION FOR TOWER CURTAIN WALL TOWER 1 COURT A

DRAWN : Aising	DATE : 08-07-16
DESIGNED :	SCALE : 1:35(A1)
CHECKED :	PROJECT NO. : J-833
DRAWING NO. : J833-TCW-3003	REV : C

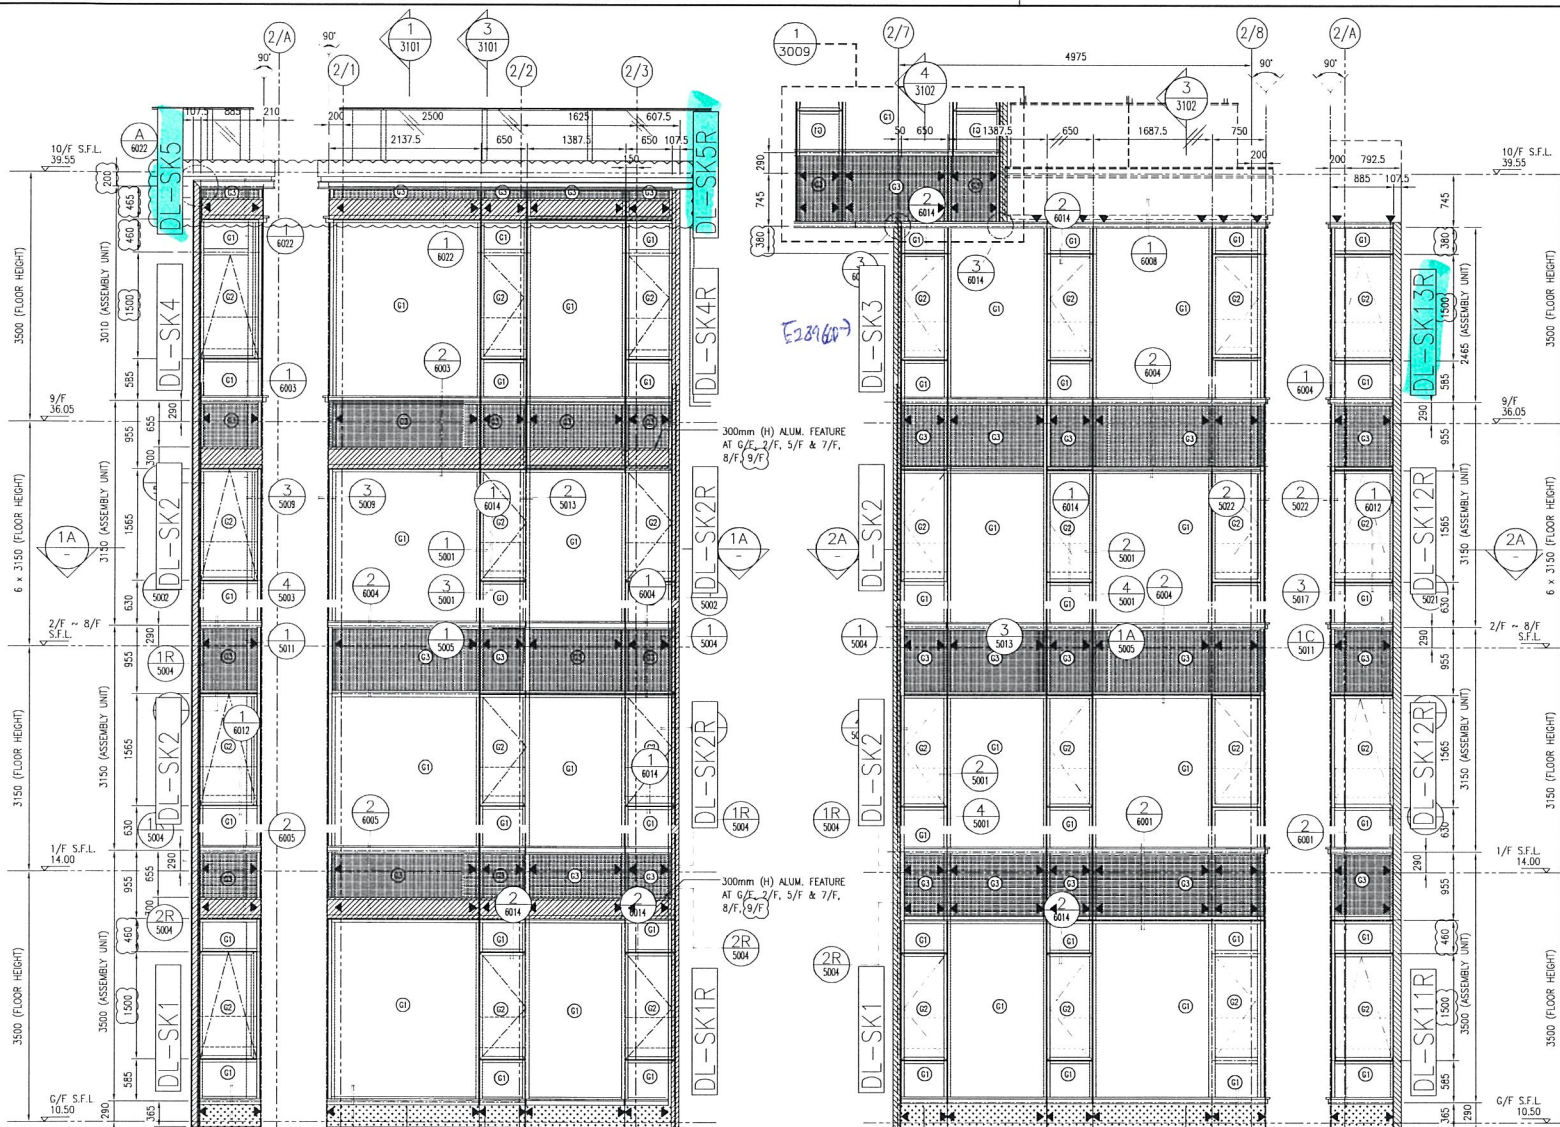

**LEGEND:**

- (G1) IGU (8mm THK. HEAT STRENGTHENED GLASS+12mm THK. AIR +10mm THK. TEMPERED GLASS)
- (G2) 10mm THK. HEAT STRENGTHENED GLASS W/ 2mm THICK ALUM. BACK PANEL
- (G3) IGU SIDE HUNG WINDOW (8mm THK. HEAT STRENGTHENED GLASS+12mm THK. AIR +8mm THK. TEMPERED GLASS) W/ 10mm THK. TEMPERED GLASS BARRIER BEHIND
- (G4) IGU TOP HUNG WINDOW (8mm THK. HEAT STRENGTHENED GLASS+12mm THK. AIR +8mm THK. TEMPERED GLASS) W/ 10mm THK. TEMPERED GLASS BARRIER BEHIND
- ALUM. FEATURE
- 3mm THK. ALUM. CLADDING
- ▲ SUPPORT POINT

B.D. REF :  
 F.S.D. REF :  
 Note:  
 1. All dimensions are in mm.  
 2. All elevations are viewed from outside.  
 3. All dimensions to be verified on site before fabrication.

**GENERAL NOTES**

1. F.F.L. --- Finished Floor Level  
 2. S.F.L. --- Structural Floor Level  
 3. --- Reversed Detail

X --- DETAIL MARK NO.  
 XCD --- REFER SHEET NO.

REV	AMENDMENTS	DATE
A	GENERAL REVISED	27/11/2016
B	GENERAL REVISED	21/12/2016
C	GENERAL REVISED	13/6/2017

CLIENT:  
**GOOD ASSETS LTD.**

PROJECT ARCHITECT:  
**SUN HUNG KAI**  
 ARCHITECTS AND ENGINEERS LIMITED

DESIGN ARCHITECT:  
**RONALD LU & PARTNERS**

STRUCTURAL ENGINEER:  
**PARSONS BRINCKERHOFF**

FAÇADE CONSULTANT:  
**ALPHA CONSULTING LIMITED**  
 Steel, Structure & Façade Specialist



MAIN CONTRACTOR:  
 YEE FAI CONSTRUCTION CO. LTD.

**美特鋁質有限公司**  
**MIDI ALUMINIUM FABRICATOR LTD.**  
 Units 6-8, Sunray Industrial Centre, 1/F  
 610 Cha Kwo Ling Road, Kowloon  
 Tel:23489211-4 Fax:(852)27272666

PROJECT TITLE:  
 PROPOSED RESIDENTIAL DEVELOPMENT, AT STLL 581, YIU SHA ROAD, WHITEHEAD, MA ON SHAN, NEW TERRITORIES

DRAWING TITLE:  
 ELEVATION FOR TOWER CURTAIN WALL TOWER 2 COURT A

DRAWN : Asing	DATE 08-07-16
DESIGNED	SCALE 1:35(A1)
CHECKED	PROJECT NO: J-833
DRAWING NO: J833-TCW-3006	REV C

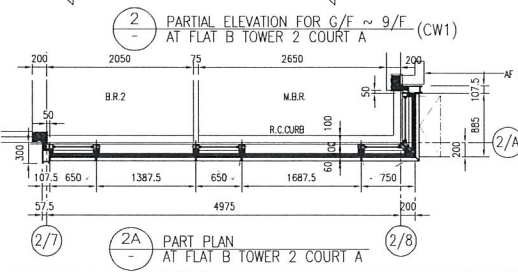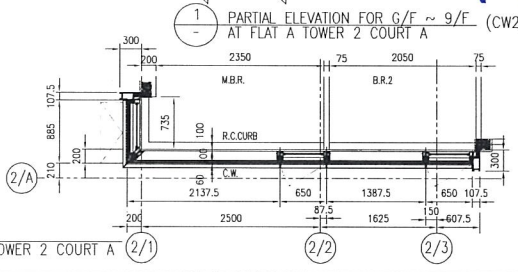

T2CW2


T2CW1

T2


1A - PART PLAN AT FLAT A TOWER 2 COURT A

2A - PART PLAN AT FLAT B TOWER 2 COURT A



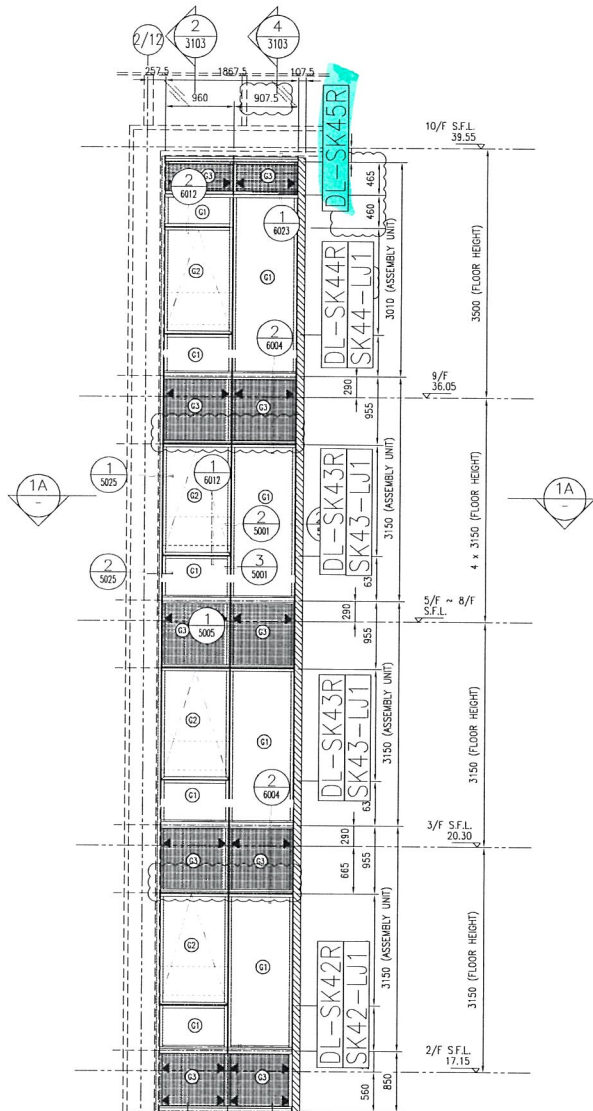

1 PARTIAL ELEVATION FOR 2/F ~ 9/F (CW5)  
AT FLAT D TOWER 2 COURT A

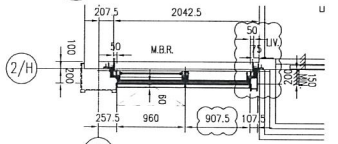

1A PART PLAN  
AT FLAT D TOWER 2 COURT A

*Trans*

**LEGEND:**

- IGU (8mm THK. HEAT STRENGTHENED GLASS+12mm THK. AIR +10mm THK. TEMPERED GLASS)
- 10mm THK. HEAT STRENGTHENED GLASS W/ 2mm THICK ALUM. BACK PANEL
- IGU SIDE HUNG WINDOW (8mm THK. HEAT STRENGTHENED GLASS+12mm THK. AIR +8mm THK. TEMPERED GLASS) W/ 10mm THK. TEMPERED GLASS BARRIER BEHIND
- IGU TOP HUNG WINDOW (8mm THK. HEAT STRENGTHENED GLASS+12mm THK. AIR +8mm THK. TEMPERED GLASS) W/ 10mm THK. TEMPERED GLASS BARRIER BEHIND
- ALUM. FEATURE
- 3mm THK. ALUM. CLADDING
- SUPPORT POINT

**B.D. REF:**  
F.S.D. REF:  
Note:  
1. All dimensions are in mm.  
2. All elevations are viewed from outside.  
3. All dimensions to be verified on site before fabrication.

**GENERAL NOTES**  
REFERENCE:  
1. F.F.L.-- Finished Floor Level  
2. S.F.L.-- Structural Floor Level  
3. (C) -- Reversed Detail  
 DETAIL MARK NO.  
 REFER SHEET NO.

REV	AMENDMENTS	DATE
A	GENERAL REVISED	27/11/2016
B	GENERAL REVISED	21/12/2016
C	GENERAL REVISED	3/6/2017

CLIENT:  
**GOOD ASSETS LTD.**

PROJECT ARCHITECT:  
**SUN HUNG KAI**  
ARCHITECTS AND ENGINEERS LIMITED

DESIGN ARCHITECT:  
**RONALD LU & PARTNERS**

STRUCTURAL ENGINEER:  
**PARSONS BRINCKERHOFF**

FAÇADE CONSULTANT:  
**ALPHA CONSULTING LIMITED**  
Steel Structures & Façade Systems

MAIN CONTRACTOR:  
YEE FAI CONSTRUCTION CO. LTD.


**美特鋁質有限公司**  
MIDI ALUMINIUM FABRICATOR LTD.  
Units 6-8, Sunray Industrial Centre, 1/F  
610 Cha Kwo Ling Road, Kowloon  
Tel:23489211-4 Fax:(852)27727666

PROJECT TITLE:  
PROPOSED RESIDENTIAL DEVELOPMENT, AT STTL 581, YIU SHA ROAD, WHITEHEAD, MA ON SHAN, NEW TERRITORIES

DRAWING TITLE:  
ELEVATION FOR TOWER CURTAIN WALL TOWER 2 COURT A

DRAWN:	Asing	DATE:	08-07-16
DESIGNED:		SCALE:	1:35(A1)
CHECKED:		PROJECT NO.:	J-833
DRAWING NO.:	J833-TCW-3008	REV:	C

*T2*

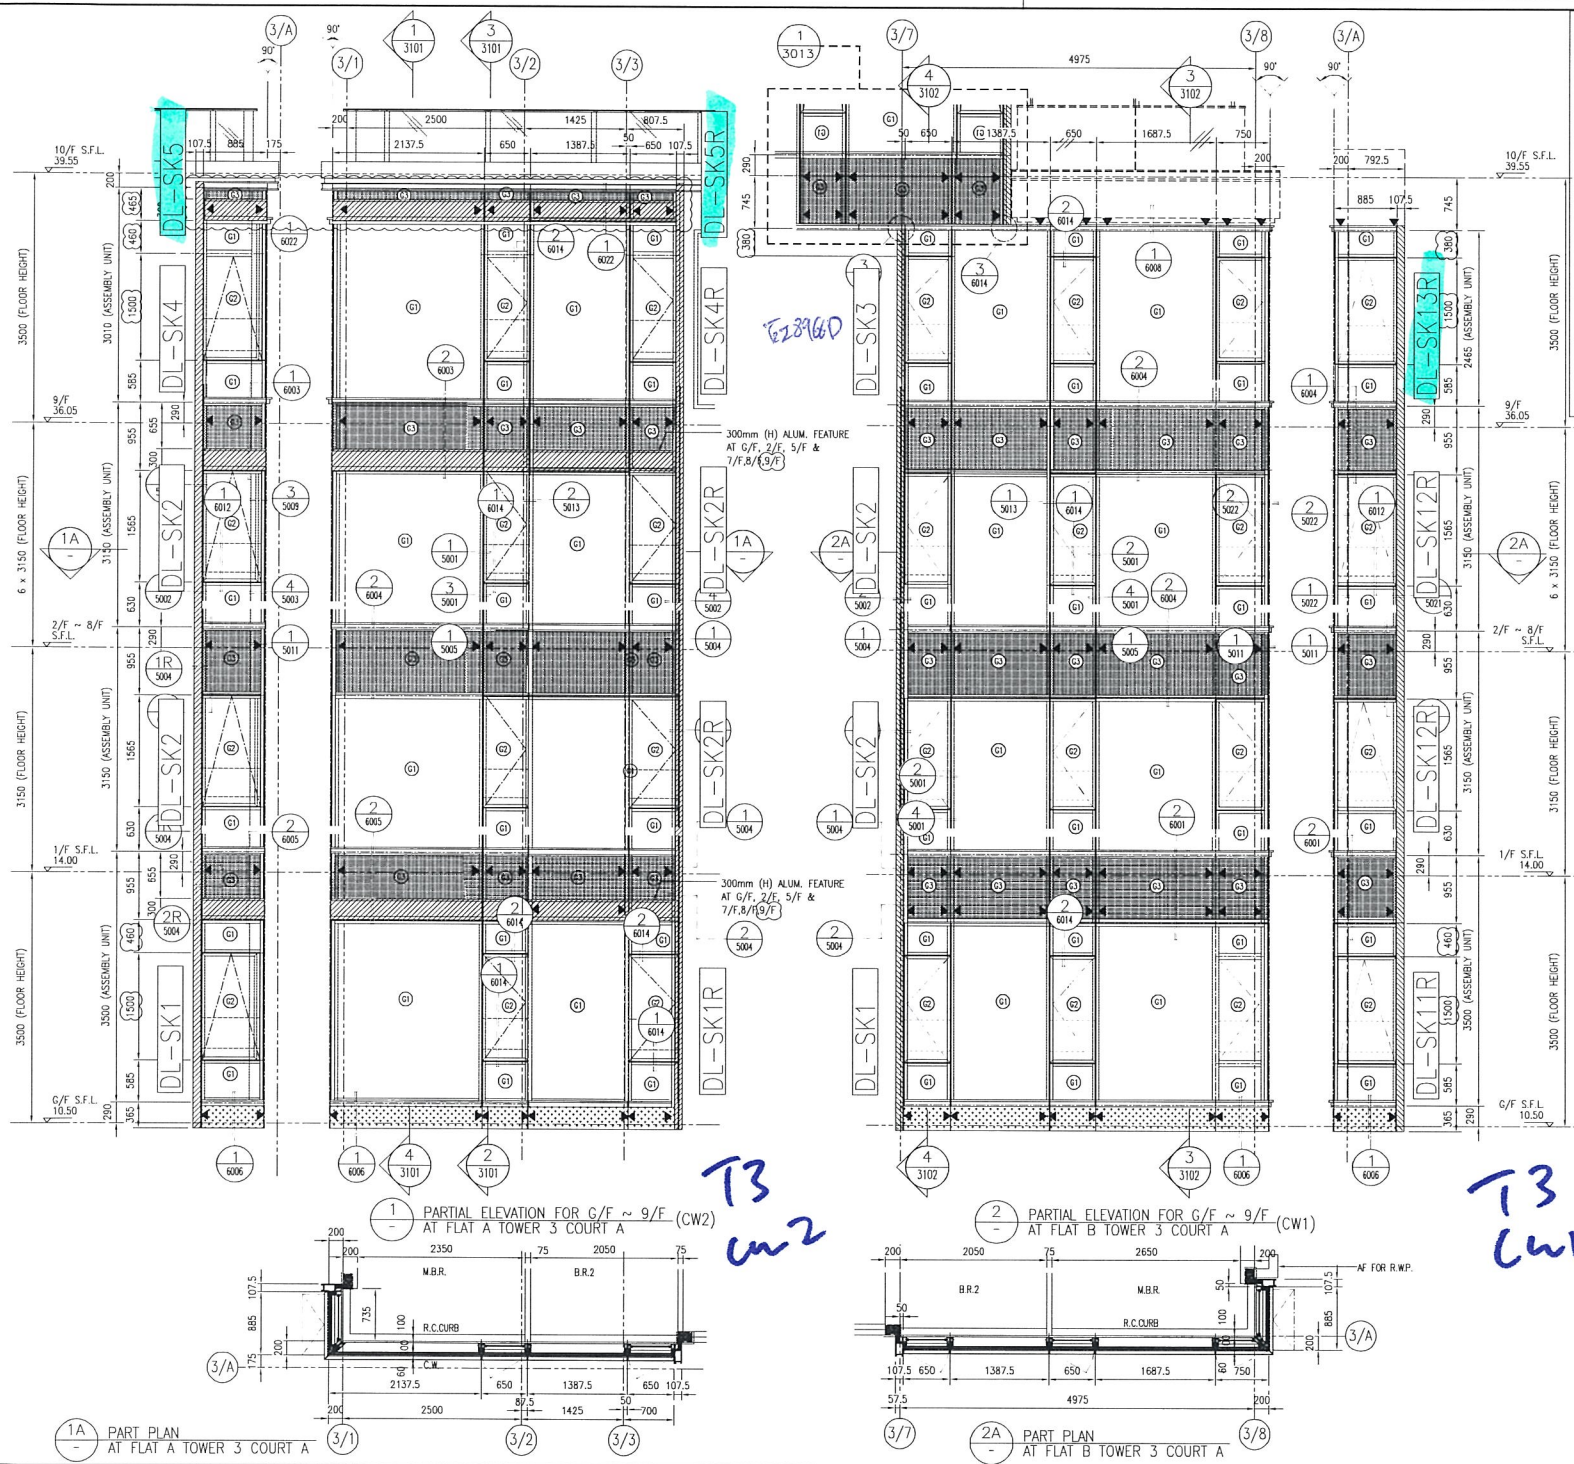

**LEGEND:**

- (G1) IGU (8mm THK. HEAT STRENGTHENED GLASS+12mm THK. AIR +10mm THK. TEMPERED GLASS)
- (G2) 10mm THK. HEAT STRENGTHENED GLASS W/ 2mm THICK ALUM. BACK PANEL
- (G3) IGU SIDE HUNG WINDOW (8mm THK. HEAT STRENGTHENED GLASS+12mm THK. AIR +8mm THK. TEMPERED GLASS) W/ 10mm THK. TEMPERED GLASS BARRIER BEHIND
- (G4) IGU TOP HUNG WINDOW (8mm THK. HEAT STRENGTHENED GLASS+12mm THK. AIR +8mm THK. TEMPERED GLASS) W/ 10mm THK. TEMPERED GLASS BARRIER BEHIND
- (A) ALUM. FEATURE
- (C) 3mm THK. ALUM. CLADDING
- (S) SUPPORT POINT

**B.D. REF.**  
**F.S.D. REF.:**  
 Note:  
 1. All dimensions are in mm.  
 2. All elevations are viewed from outside.  
 3. All dimensions to be verified on site before fabrication.

**GENERAL NOTES**

1. F.F.L. -- Finished Floor Level  
 2. S.F.L. -- Structural Floor Level  
 3. --- Reversed Detail

(X) -- DETAIL MARK NO.  
 (C) -- REFER SHEET NO.

REV	AMENDMENTS	DATE
A	GENERAL REVISED	27/11/2014
B	GENERAL REVISED	21/12/2014
C	GENERAL REVISED	3/6/2017

**CLIENT:**  
**GOOD ASSETS LTD.**

**PROJECT ARCHITECT:**  
**SUN HUNG KAI**  
 ARCHITECTS AND ENGINEERS LIMITED

**DESIGN ARCHITECT:**  
**RONALD LU & PARTNERS**

**STRUCTURAL ENGINEER:**  
**PARSONS BRINCKERHOFF**

**FAÇADE CONSULTANT:**  
**ALPHA CONSULTING LIMITED**  
 Steel, Structural & Façade Specialists Ltd.

**MAIN CONTRACTOR:**  
**YEE FAI CONSTRUCTION CO. LTD.**


**美特鋁質有限公司**  
**MIDI ALUMINIUM FABRICATOR LTD.**  
 Units 6-8, Sunray Industrial Centre, 1/F  
 610 Cha Kwo Ling Road, Kowloon  
 Tel:23489211-4 Fax:(852)2727666

**PROJECT TITLE:**  
 PROPOSED RESIDENTIAL DEVELOPMENT, AT STTL 581, YIU SHA ROAD, WHITEHEAD, MA ON SHAN, NEW TERRITORIES

**DRAWING TITLE:**  
 ELEVATION FOR TOWER CURTAIN WALL TOWER 3 COURT A

<b>DRAWN:</b> Asing	<b>DATE:</b> 08-07-16
<b>DESIGNED:</b>	<b>SCALE:</b> 1:35(A1)
<b>CHECKED:</b>	<b>PROJECT NO.:</b> J-833
<b>DRAWING NO.:</b> JB33-TCW-3011	<b>REV:</b> C

T3

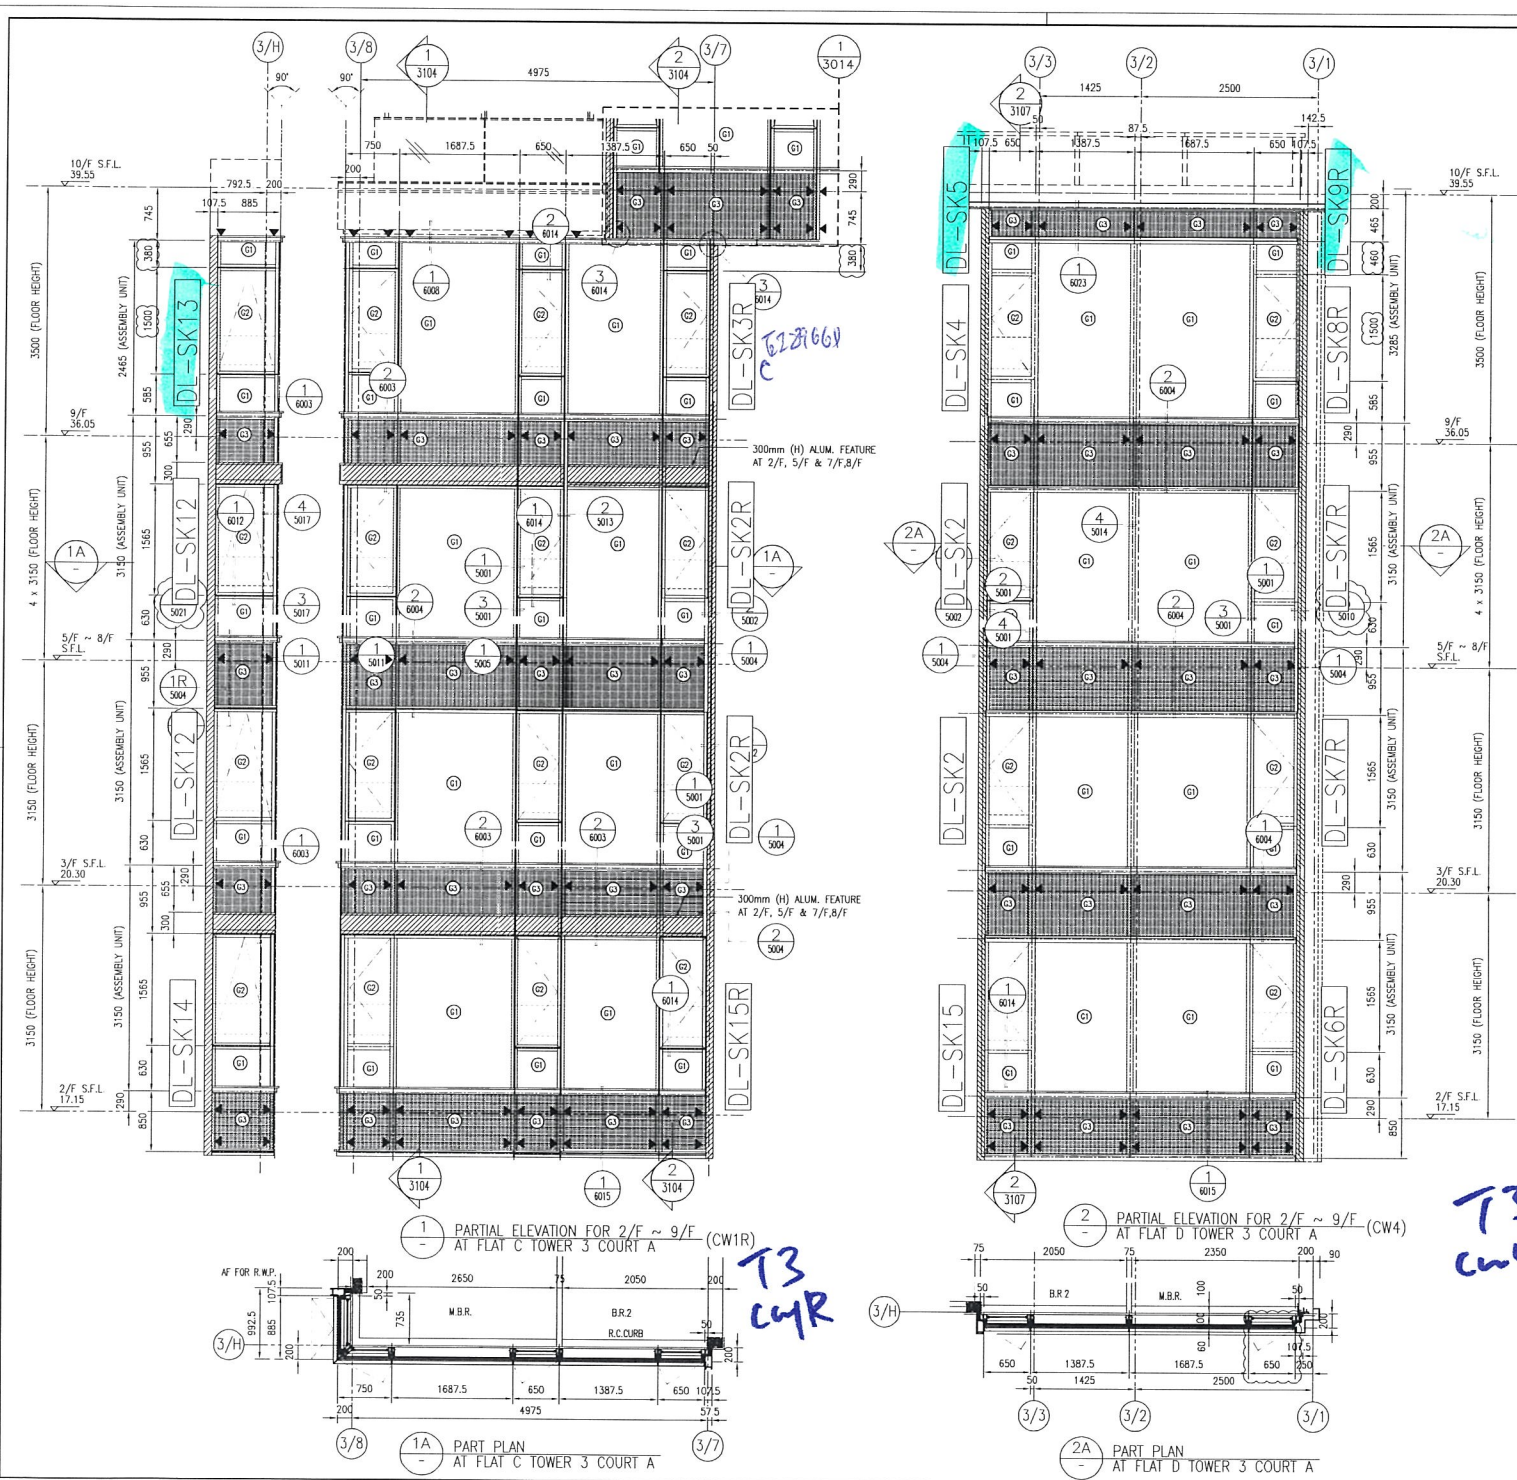

**LEGEND:**

- (G1) IGU (8mm THK. HEAT STRENGTHENED GLASS+12mm THK. AIR +10mm THK. TEMPERED GLASS)
- (G2) 10mm THK. HEAT STRENGTHENED GLASS W/ 2mm THICK ALUM. BACK PANEL
- (G3) IGU SIDE HUNG WINDOW (8mm THK. HEAT STRENGTHENED GLASS+12mm THK. AIR +8mm THK. TEMPERED GLASS) W/ 10mm THK. TEMPERED GLASS BARRIER BEHIND
- (G4) IGU TOP HUNG WINDOW (8mm THK. HEAT STRENGTHENED GLASS+12mm THK. AIR +8mm THK. TEMPERED GLASS) W/ 10mm THK. TEMPERED GLASS BARRIER BEHIND
- [Hatched Box] ALUM. FEATURE
- [Dotted Box] 3mm THK. ALUM. CLADDING
- ▲ SUPPORT POINT

B.D. REF.  
 F.S.D. REF :  
 Note :  
 1. All dimensions are in mm.  
 2. All elevations are viewed from outside.  
 3. All dimensions to be verified on site before fabrication.

**GENERAL NOTES**

— S.C. —  
 1. F.F.L. — Finished Floor Level  
 2. S.F.L. — Structural Floor Level  
 3. ○ — Reversed Detail

— X — — DETAIL MARK NO.  
 — (C) — REFER SHEET NO.

REV	AMENDMENTS	DATE
A	GENERAL REVISED	27/11/2016
B	GENERAL REVISED	21/12/2016
C	GENERAL REVISED	3/6/2017

CLIENT:  
**GOOD ASSETS LTD.**

PROJECT ARCHITECT:  
**SUN HUNG KAI**  
 ARCHITECTS AND ENGINEERS LIMITED

DESIGN ARCHITECT:  
**RONALD LU & PARTNERS**

STRUCTURAL ENGINEER:  
**PARSONS BRINCKERHOFF**

FAÇADE CONSULTANT:  
**ALPHA CONSULTING LIMITED**  
Structural & Façade Specialist

MAIN CONTRACTOR:  
 YEE FAI CONSTRUCTION CO. LTD.

**美特鋁質有限公司**  
**MIDI ALUMINIUM FABRICATOR LTD.**  
 Units 6-8, Sunray Industrial Centre, 1/F  
 610 Cha Kwo Ling Road, Kowloon  
 Tel: 23489211-4 Fax: (852) 27272666


PROJECT TITLE:  
 PROPOSED RESIDENTIAL DEVELOPMENT, AT STTL 581, YIU SHA ROAD, WHITEHEAD, MA ON SHAN, NEW TERRITORIES

DRAWING TITLE:  
 ELEVATION FOR TOWER CURTAIN WALL TOWER 3 COURT A

DRAWN : Asing	DATE 08-07-16
DESIGNED :	SCALE 1:35(A1)
CHECKED :	PROJECT NO. J-833
DRAWING NO. J833-TCW-3012	REV C

T3  
CW4

T3

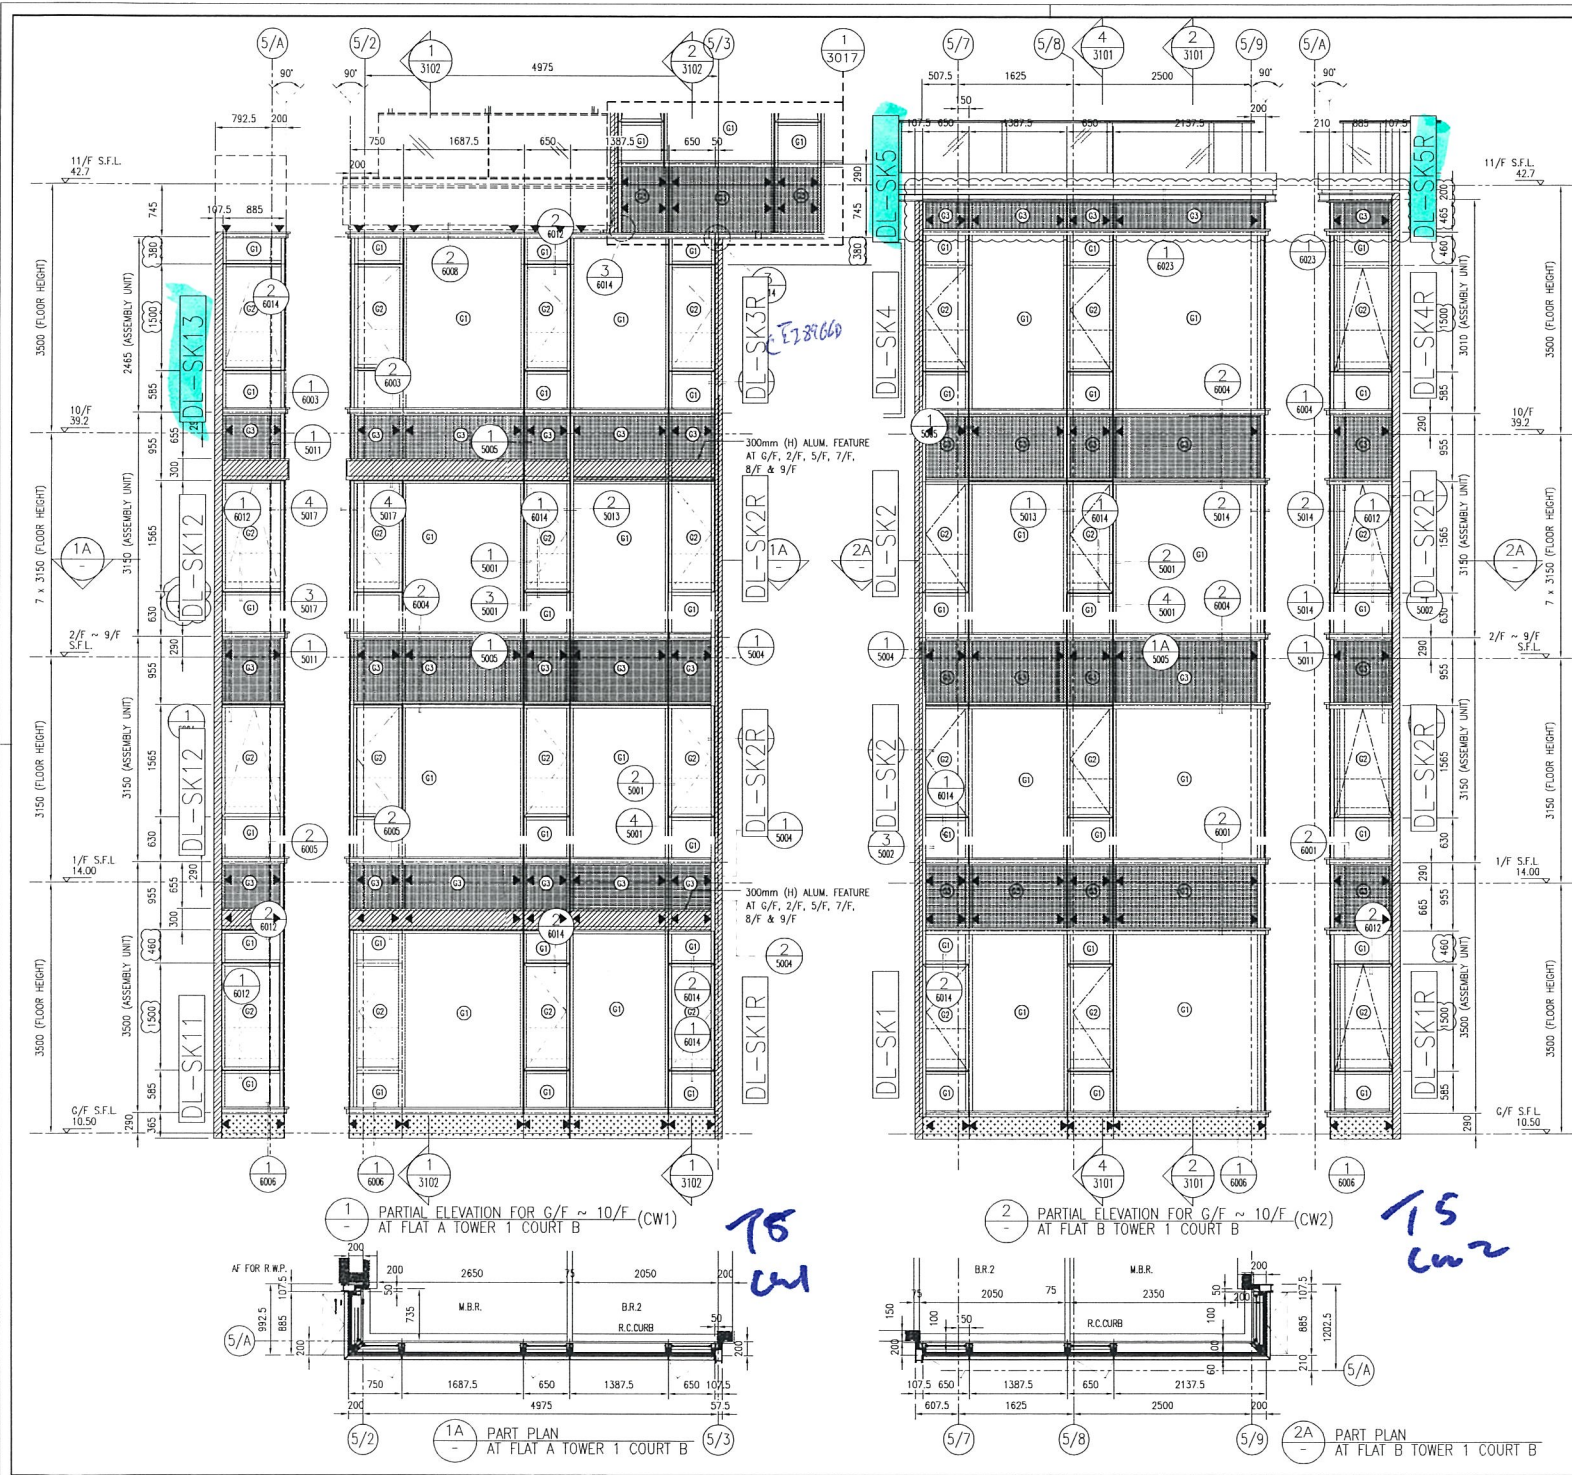

**LEGEND:**

- (G1) IGU (8mm THK. HEAT STRENGTHENED GLASS+12mm THK. AIR +10mm THK. TEMPERED GLASS)
- (G2) 10mm THK. HEAT STRENGTHENED GLASS W/ 2mm THK ALUM. BACK PANEL
- (G3) IGU SIDE HUNG WINDOW (8mm THK. HEAT STRENGTHENED GLASS+12mm THK. AIR +8mm THK. TEMPERED GLASS) W/ 10mm THK. TEMPERED GLASS BARRIER BEHIND
- (G4) IGU TOP HUNG WINDOW (8mm THK. HEAT STRENGTHENED GLASS+12mm THK. AIR +8mm THK. TEMPERED GLASS) W/ 10mm THK. TEMPERED GLASS BARRIER BEHIND
- ALUM. FEATURE
- 3mm THK. ALUM. CLADDING
- ▲ SUPPORT POINT

B.D. REF :  
 F.S.D. REF :  
 Note :  
 1. All dimensions are in mm.  
 2. All elevations are viewed from outside.  
 3. All dimensions to be verified on site before fabrication.

**GENERAL NOTES**

Legend:  
 1. F.F.L. --- Finished Floor Level  
 2. S.F.L. --- Structural Floor Level  
 3. --- Reversed Detail

Detail Mark No. ---  
 Refer Sheet No. ---

REV	AMENDMENTS	DATE
A	GENERAL REWISED	27/11/2016
B	GENERAL REWISED	21/12/2016
C	GENERAL REWISED	3/6/2017

CLIENT:  
**GOOD ASSETS LTD.**

PROJECT ARCHITECT:  
**SUN HUNG KAI**  
 ARCHITECTS AND ENGINEERS LIMITED

DESIGN ARCHITECT:  
**RONALD LU & PARTNERS**

STRUCTURAL ENGINEER:  
**PARSONS BRINCKERHOFF**

FACADE CONSULTANT:  
**ALPHA CONSULTING LIMITED**  
 (Struct. & Façade Spec.) Ltd.

MAIN CONTRACTOR:  
 YEE FAI CONSTRUCTION CO. LTD.





**美特鋁質有限公司**  
 MIDI ALUMINIUM FABRICATOR LTD.  
 Units 6-8, Sunray Industrial Centre, 1/F  
 610 Cha Kwo Ling Road, Kowloon  
 Tel: 23489211-4 Fax: (852) 2727666

PROJECT TITLE:  
 PROPOSED RESIDENTIAL DEVELOPMENT, AT STTL 581, YIU SHA ROAD, WHITEHEAD, MA ON SHAN, NEW TERRITORIES

DRAWING TITLE:  
 ELEVATION FOR TOWER CURTAIN WALL TOWER 1 COURT B

DRAWN : Asing	DATE 08-07-16
DESIGNED :	SCALE 1:35(A1)
CHECKED :	PROJECT NO.: J-833
DRAWING NO.: JB33-TCW-3015	REV. C

**75**

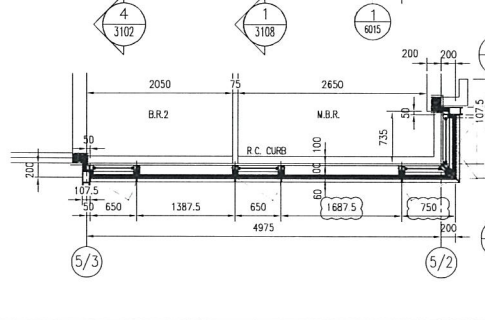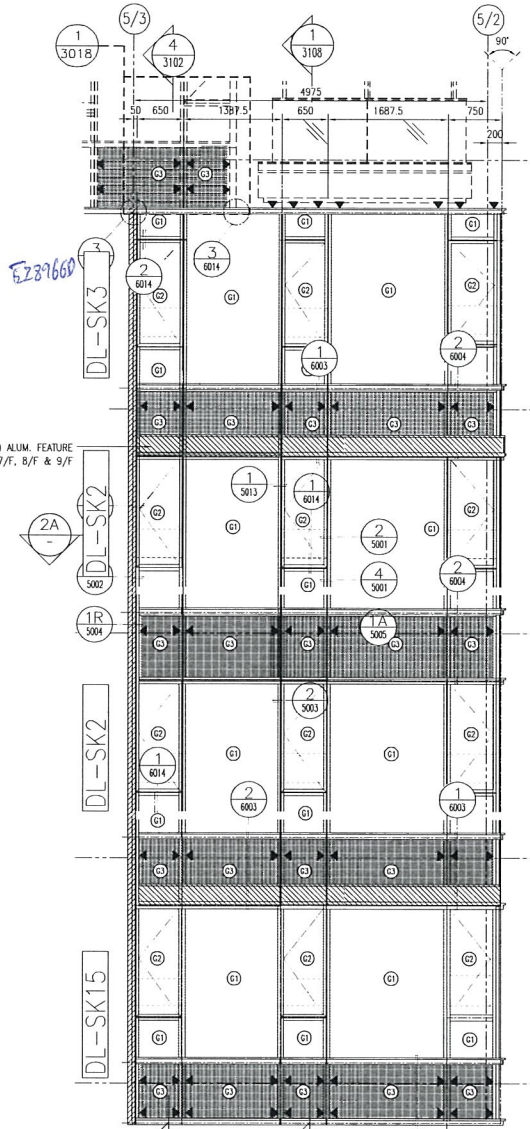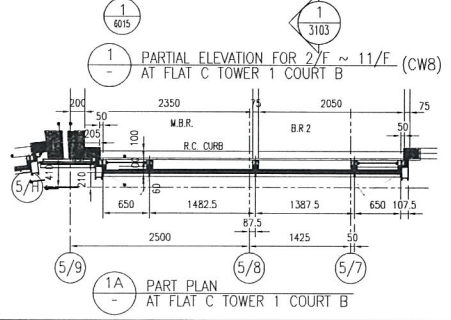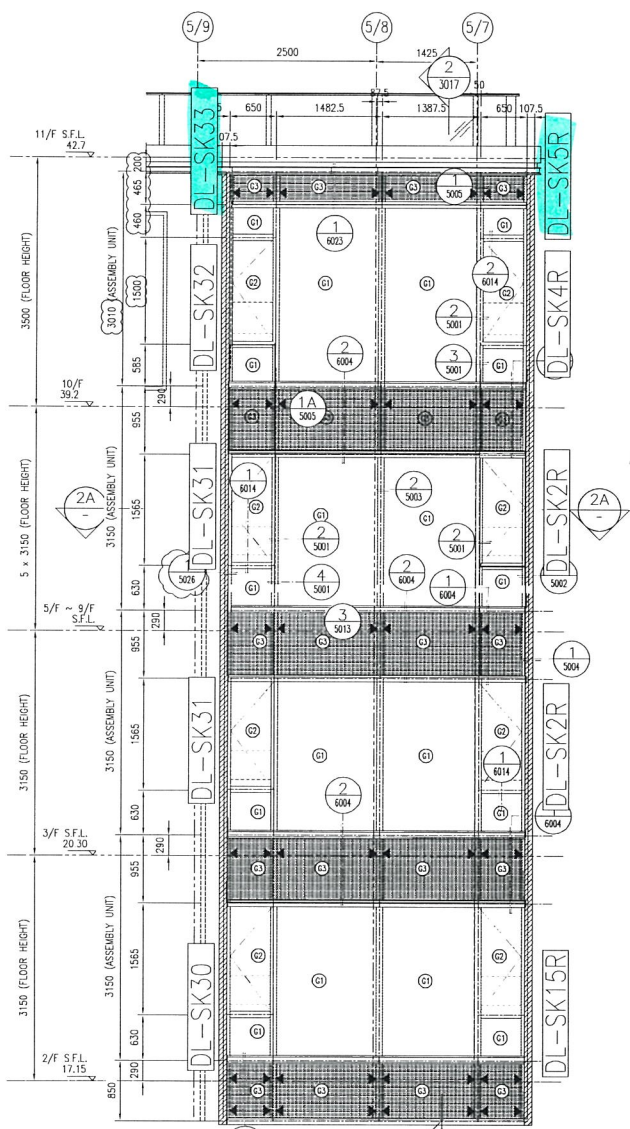

**LEGEND:**

- IGU (8mm THK. HEAT STRENGTHENED GLASS+12mm THK. AIR +10mm THK. TEMPERED GLASS)
- 10mm THK. HEAT STRENGTHENED GLASS W/ 2mm THICK ALUM. BACK PANEL
- IGU SIDE HUNG WINDOW (8mm THK. HEAT STRENGTHENED GLASS+12mm THK. AIR +8mm THK. TEMPERED GLASS) W/ 10mm THK. TEMPERED GLASS BARRIER BEHIND
- IGU TOP HUNG WINDOW (8mm THK. HEAT STRENGTHENED GLASS+12mm THK. AIR +8mm THK. TEMPERED GLASS) W/ 10mm THK. TEMPERED GLASS BARRIER BEHIND
- ALUM. FEATURE
- 3mm THK. ALUM. CLADDING
- SUPPORT POINT

B.D. REF :  
F.S.D. REF :  
Note :  
1. All dimensions are in mm.  
2. All elevations are viewed from outside.  
3. All dimensions to be verified on site before fabrication.

**GENERAL NOTES**

1. F.F.L. -- Finished Floor Level  
2. S.F.L. -- Structural Floor Level  
3. -- Reversed Detail

-- DETAIL MARK NO.  
 -- REFER SHEET NO.

REV	AMENDMENTS	DATE
A	GENERAL REVISED	27/11/2016
B	GENERAL REVISED	21/12/2016
C	GENERAL REVISED	3/6/2017

CLIENT:  
**GOOD ASSETS LTD.**

PROJECT ARCHITECT:  
**SUN HUNG KAI**  
ARCHITECTS AND ENGINEERS LIMITED

DESIGN ARCHITECT:  
**RONALD LU & PARTNERS**

STRUCTURAL ENGINEER :  
**PARSONS BRINCKERHOFF**

FAÇADE CONSULTANT:  
**ALPHA CONSULTING LIMITED**  
Steel Structure & Façade Specialist

MAIN CONTRACTOR :  
YEE FAI CONSTRUCTION CO. LTD.

**美特鋁質有限公司**  
MIDI ALUMINIUM FABRICATOR LTD.  
Units 6-8, Sunray Industrial Centre, 1/F  
610 Cha Kwo Ling Road, Kowloon  
Tel: 23489211-4 Fax: (852) 2727666

PROJECT TITLE :  
PROPOSED RESIDENTIAL DEVELOPMENT, AT STLL 581, YIU SHA ROAD, WHITEHEAD, MA ON SHAN, NEW TERRITORIES



DRAWING TITLE :  
ELEVATION FOR TOWER CURTAIN WALL TOWER 1 COURT B

DRAWN : Asing	DATE 08-07-16
DESIGNED :	SCALE 1:35(A1)
CHECKED :	PROJECT NO. J-833
DRAWING NO. J833-TCW-3016	REV C

*cn8*

*cn1R*

*T5*

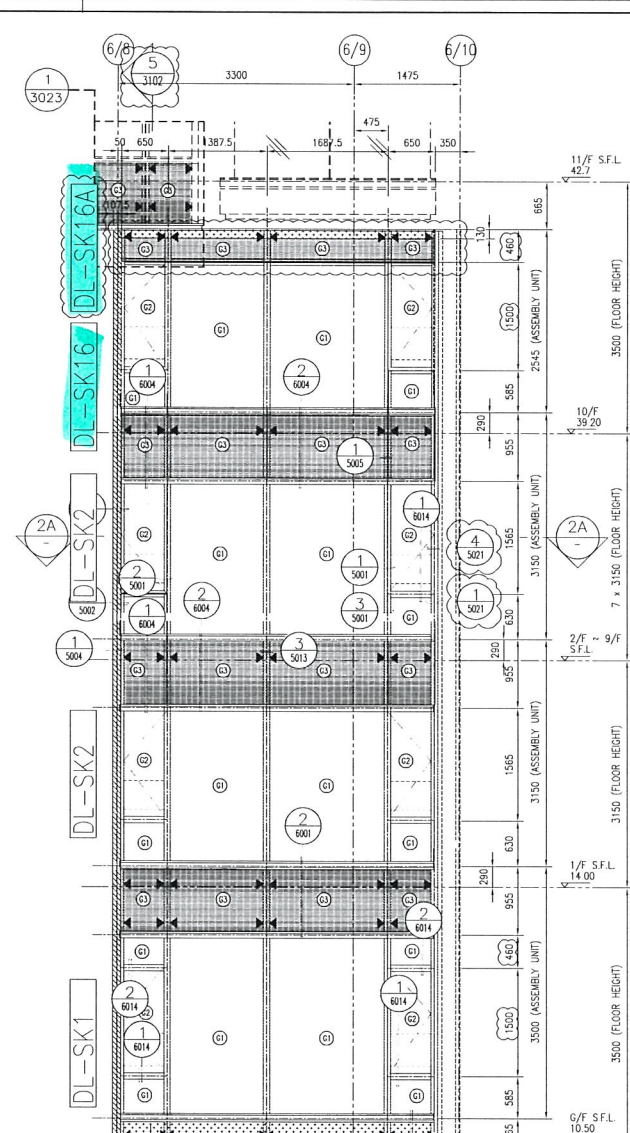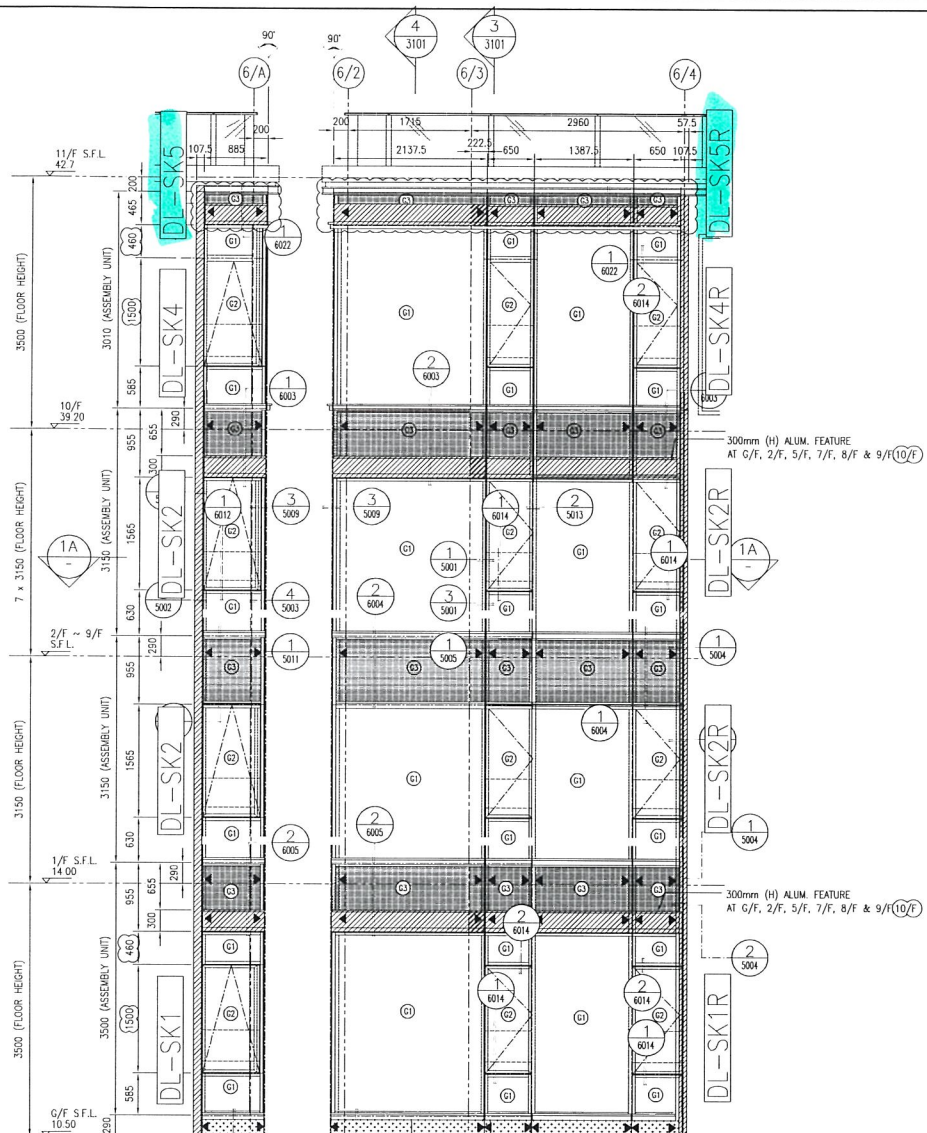

- LEGEND:**
- IGU (8mm THK. HEAT STRENGTHENED GLASS+12mm THK. AIR +10mm THK. TEMPERED GLASS)
  - 10mm THK. HEAT STRENGTHENED GLASS W/ 2mm THICK ALUM. BACK PANEL
  - IGU SIDE HUNG WINDOW (8mm THK. HEAT STRENGTHENED GLASS+12mm THK. AIR +8mm THK. TEMPERED GLASS) W/ 10mm THK. TEMPERED GLASS BARRIER BEHIND
  - IGU TOP HUNG WINDOW (8mm THK. HEAT STRENGTHENED GLASS+12mm THK. AIR +8mm THK. TEMPERED GLASS) W/ 10mm THK. TEMPERED GLASS BARRIER BEHIND
  - ALUM. FEATURE
  - 3mm THK ALUM. CLADDING
  - SUPPORT POINT

B.D. REF :  
 F.S.D. REF :  
 Note:  
 1 All dimensions are in mm.  
 2 All elevations are viewed from outside.  
 3 All dimensions to be verified on site before fabrication.

**GENERAL NOTES**

Level :  
 1. F.F.L -- Finished Floor Level  
 2. S.F.L -- Structural Floor Level  
 3. --- Reversed Detail

DETAIL MARK NO.  
 REFER SHEET NO.

REV	AMENDMENTS	DATE
A	GENERAL REWSED	27/11/2016
B	GENERAL REWSED	21/12/2016
C	GENERAL REWSED	5/6/2017

CLIENT:  
**GOOD ASSETS LTD.**

PROJECT ARCHITECT:  
**SUN HUNG KAI**  
 ARCHITECTS AND ENGINEERS LIMITED

DESIGN ARCHITECT:  
**RONALD LU & PARTNERS**

STRUCTURAL ENGINEER:  
**PARSONS BRINCKERHOFF**

FACADE CONSULTANT:  
**ALPHA CONSULTING LIMITED**  
 Fire Structure & Facade Specialist



MAIN CONTRACTOR:  
 YEE FAI CONSTRUCTION CO. LTD.

**美特鋁質有限公司**  
 MIDI ALUMINIUM FABRICATOR LTD.  
 Units 6-8, Sunray Industrial Centre, 1/F  
 610 Cha Kwo Ling Road, Kowloon  
 Tel:23489211-4 Fax:(852)2727666

PROJECT TITLE:  
 PROPOSED RESIDENTIAL DEVELOPMENT, AT STLL 581, YIU SHA ROAD, WHITEHEAD, MA ON SHAN, NEW TERRITORIES

DRAWING TITLE:  
 ELEVATION FOR TOWER CURTAIN WALL TOWER 2 COURT B

DRAWN : Asing	DATE 08-07-16
DESIGNED :	SCALE 1:35(A1)
CHECKED :	PROJECT NO: J-833
DRAWING NO. J833-TCW-3019	REV C

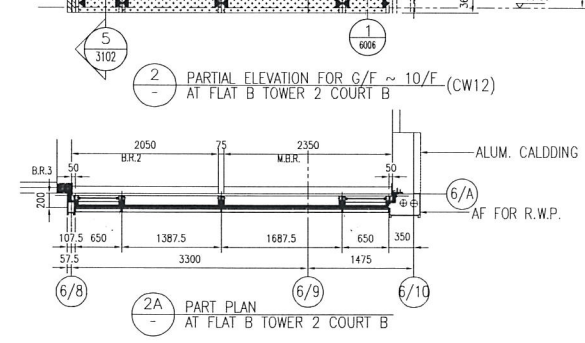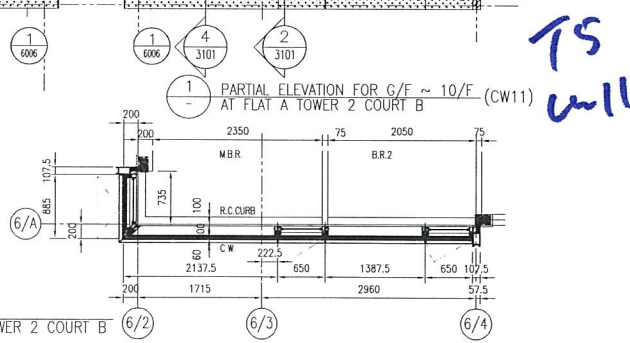

TS  
 will



Cur

T86



**LEGEND:**

	ALUM. FEATURE
	3mm THK ALUM. CLADDING
	SUPPORT POINT

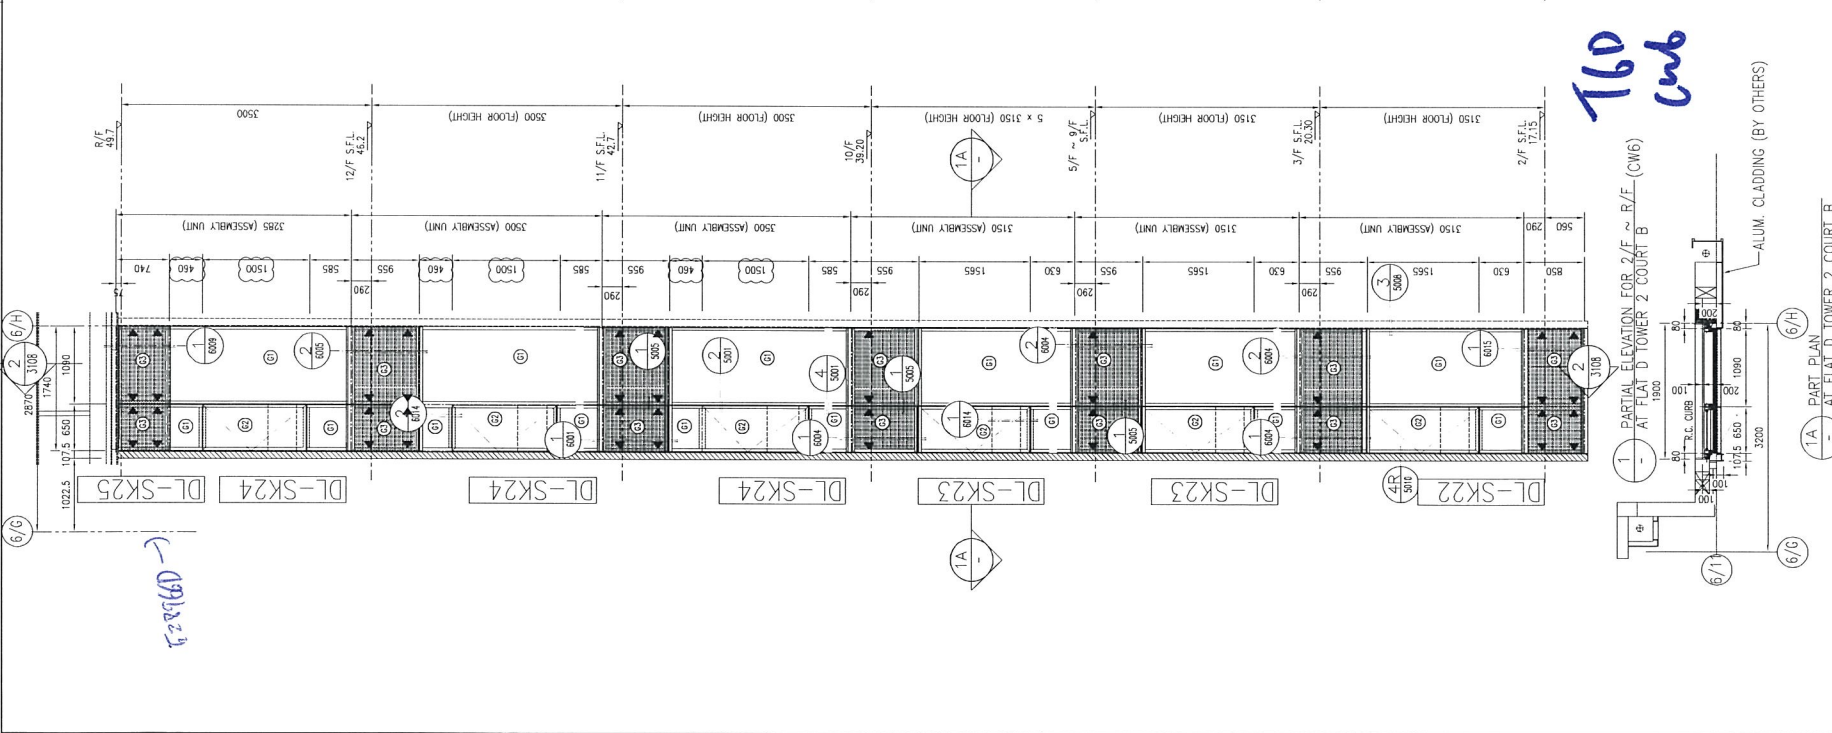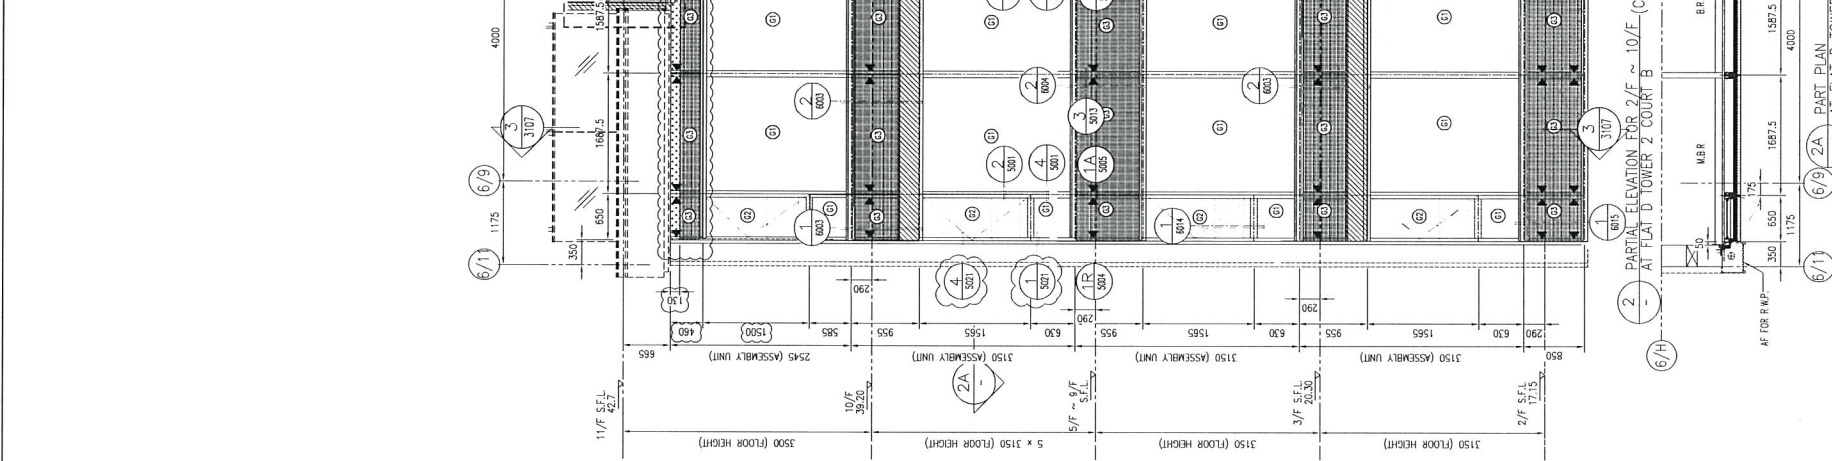

B.D. REF :		
F.S.D. REF :		
Note:		
1. All dimensions are in mm.		
2. All elevations are viewed from outside.		
3. All dimensions to be verified on site before fabrication.		
<b>GENERAL NOTES</b>		
Legend:		
1.	S.F.L.	Finished Floor Level
2.	S.F.L.	Structural Floor Level
3.	⊖	Reversed Detail
X		DETAIL MARK NO.
XC		REFER SHEET NO.
REV	AMENDMENTS	DATE
A	GENERAL REWISED	27/11/2016
B	GENERAL REWISED	21/12/2016
C	GENERAL REWISED	3/6/2017
CLIENT:		
<b>GOOD ASSETS LTD.</b>		
PROJECT ARCHITECT:		
<b>SUN HUNG KAI</b> ARCHITECTS AND ENGINEERS LIMITED		
DESIGN ARCHITECT:		
<b>RONALD LU &amp; PARTNERS</b>		
STRUCTURAL ENGINEER:		
<b>PARSONS BRINCKERHOFF</b>		
FACADE CONSULTANT		
<b>ALPHA CONSULTING LIMITED</b> Steel Structure & Façade Specialist		
MAIN CONTRACTOR:		
YEE FAI CONSTRUCTION CO. LTD.		
<b>美特鋁質有限公司</b> MIDI ALUMINUM FABRICATOR LTD. Units 6-8, Sunray Industrial Centre, 1/F 610 Cha Kwo Ling Road, Kowloon Tel: 23489211-4 Fax: (852) 2727666		
PROJECT TITLE:		
PROPOSED RESIDENTIAL DEVELOPMENT, AT STTL 581, YIU SHA ROAD, WHITEHEAD, MA ON SHAN, NEW TERRITORIES		
DRAWING TITLE:		
ELEVATION FOR TOWER CURTAIN WALL TOWER 2 COURT B		
DRAWN :	Asing	DATE 08-07-16
DESIGNED :		SCALE 1:35(A1)
CHECKED :		PROJECT NO: J-833
DRAWING NO: J833-TCW-3021		REV C





B.D. REF :  
 F.S.D. REF :  
 Note :  
 1. All dimensions are in mm.  
 2. All elevations are viewed from outside.  
 3. All dimensions to be verified on site before fabrication.

GENERAL NOTES

LEGEND  
 1. F.F.L. -- Finished Floor Level  
 2. S.F.L. -- Structural Floor Level  
 3. --- Reversed Detail

DETAIL MARK NO. ---  
 REFER SHEET NO. ---

REV	AMENDMENTS	DATE
A	GENERAL REWISED	27/11/2016
B	GENERAL REWISED	21/12/2016
C	GENERAL REWISED	3/6/2017

CLIENT:  
**GOOD ASSETS LTD.**

PROJECT ARCHITECT:  
**SUN HUNG KAI**  
 ARCHITECTS AND ENGINEERS LIMITED

DESIGN ARCHITECT:  
**RONALD LU & PARTNERS**

STRUCTURAL ENGINEER :  
**PARSONS BRINCKERHOFF**

FACADE CONSULTANT  
**ALPHA CONSULTING LIMITED**  
Steel Structure & Facade Specialist


MAIN CONTRACTOR :  
 YEE FAI CONSTRUCTION CO. LTD.

**美特鋁質有限公司**  
 MIDTI ALUMINIUM FABRICATOR LTD.  
 Units 6-8, Sunray Industrial Centre, 1/F  
 610 Cha Kwo Ling Road, Kowloon  
 Tel: 23489211-4 Fax: (852) 2727666



PROJECT TITLE :  
 PROPOSED RESIDENTIAL DEVELOPMENT, AT STTL 581, YIU SHA ROAD, WHITEHEAD, MA ON SHAN, NEW TERRITORIES

DRAWING TITLE :  
 ELEVATION FOR TOWER CURTAIN WALL TOWER 1 COURT C

DRAWN : Asing	DATE 08-07-16
DESIGNED	SCALE 1:35(A1)
CHECKED	PROJECT NO. J-833
DRAWING NO. JB833-TCW-3025	REV. C

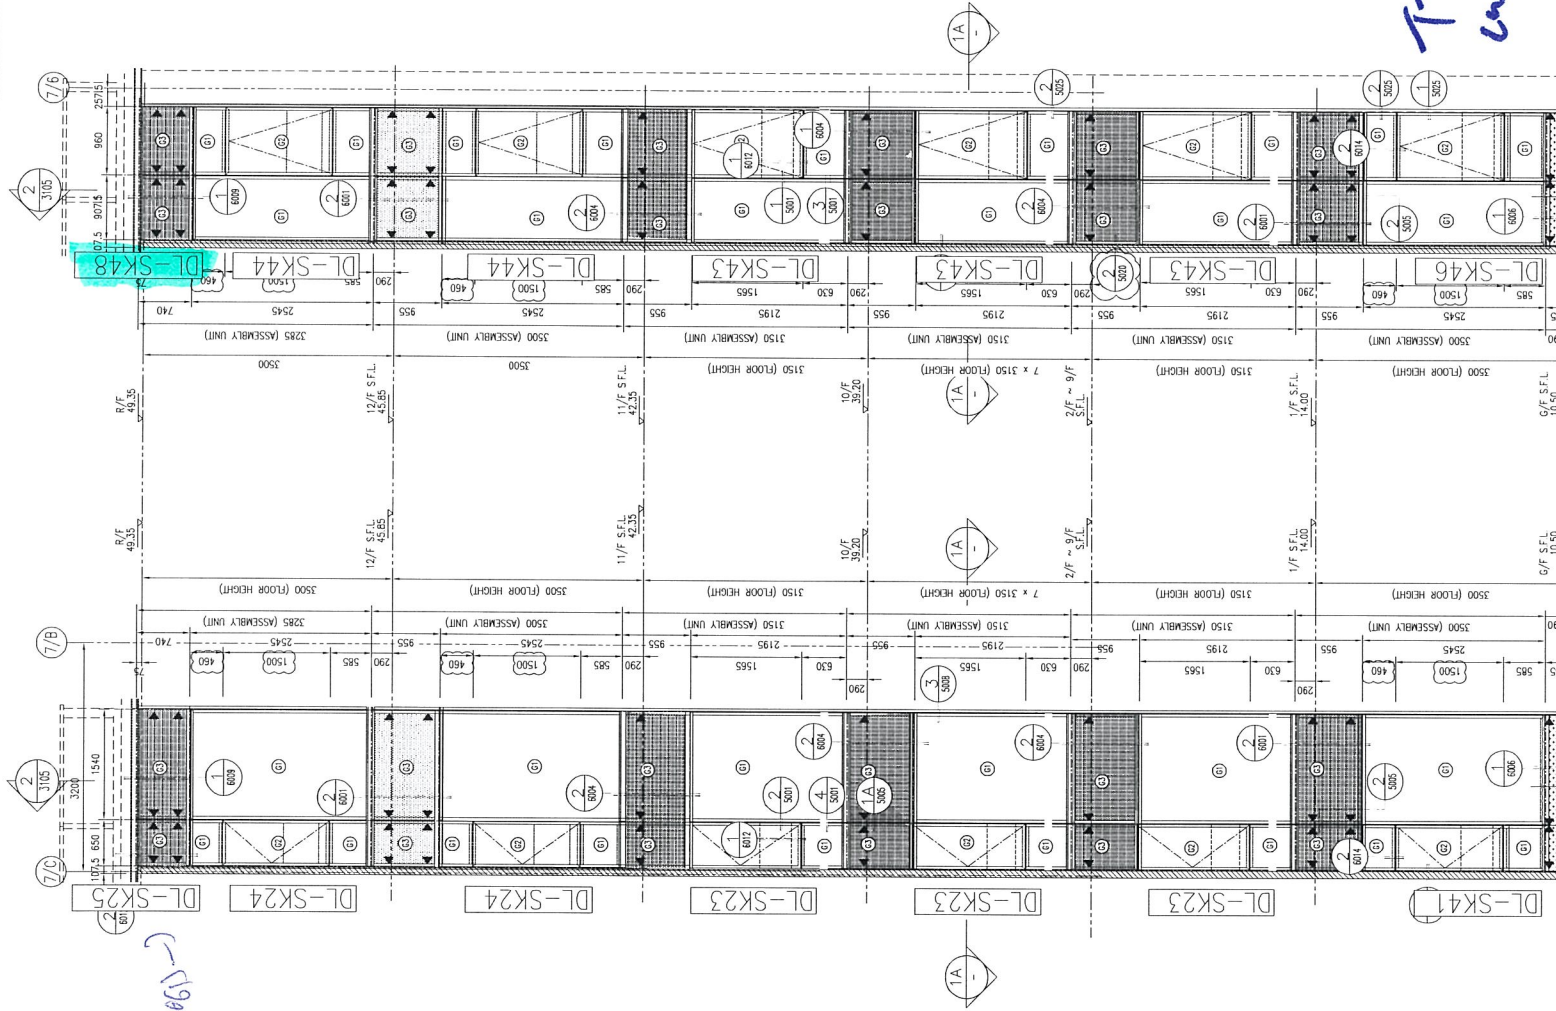

- LEGEND:**
- IGU (8mm THK. HEAT STRENGTHENED GLASS+12mm THK. AIR +10mm THK. TEMPERED GLASS)
  - IGU SIDE HUNG WINDOW (8mm THK. HEAT STRENGTHENED GLASS+12mm THK. AIR +8mm THK. TEMPERED GLASS) W/ 10mm THK. TEMPERED GLASS BARRIER BEHIND
  - IGU TOP HUNG WINDOW (8mm THK. HEAT STRENGTHENED GLASS+12mm THK. AIR +8mm THK. TEMPERED GLASS) W/ 10mm THK. TEMPERED GLASS BARRIER BEHIND
  - ALUM. FEATURE
  - 3mm THK. ALUM. CLADDING
  - SUPPORT POINT

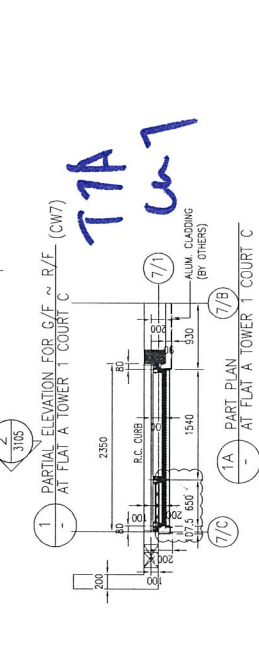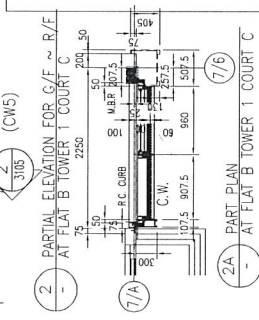

B.D. REF:  
F.S.D. REF:  
Note:  
1. All dimensions are in mm.  
2. All elevations are viewed from outside.  
3. All dimensions to be verified on site before fabrication.

**GENERAL NOTES**

1. F.F.L. --- Finished Floor Level  
2. S.F.L. --- Structural Floor Level  
3. (Circled arrow) --- Reversed Detail

(X) --- DETAIL MARK NO.  
(Circled arrow) --- REFER SHEET NO.

REV	AMENDMENTS	DATE
A	GENERAL REWISED	27/11/2016
B	GENERAL REWISED	21/12/2016
C	GENERAL REWISED	3/6/2017

CLIENT:  
**GOOD ASSETS LTD.**

PROJECT ARCHITECT:  
**SUN HUNG KAI**  
ARCHITECTS AND ENGINEERS LIMITED

DESIGN ARCHITECT:  
**RONALD LU & PARTNERS**

STRUCTURAL ENGINEER:  
**PARSONS BRINCKERHOFF**


FAÇADE CONSULTANT:  
**ALPHA CONSULTING LIMITED**  
(Steel Structure & Façade Specialist)

MAIN CONTRACTOR:  
**YEE FAI CONSTRUCTION CO. LTD.**

PROJECT TITLE:  
PROPOSED RESIDENTIAL DEVELOPMENT, AT STTL 581, YIU SHA ROAD, WHITEHEAD, MA ON SHAN, NEW TERRITORIES

DRAWING TITLE:  
ELEVATION FOR TOWER CURTAIN WALL TOWER 1 COURT C

DRAWN:	Asing	DATE:	08-07-16
DESIGNED:		SCALE:	1:35(A1)
CHECKED:		PROJECT NO.:	833
DRAWING NO.:	J833-TCW-3026	REV:	C

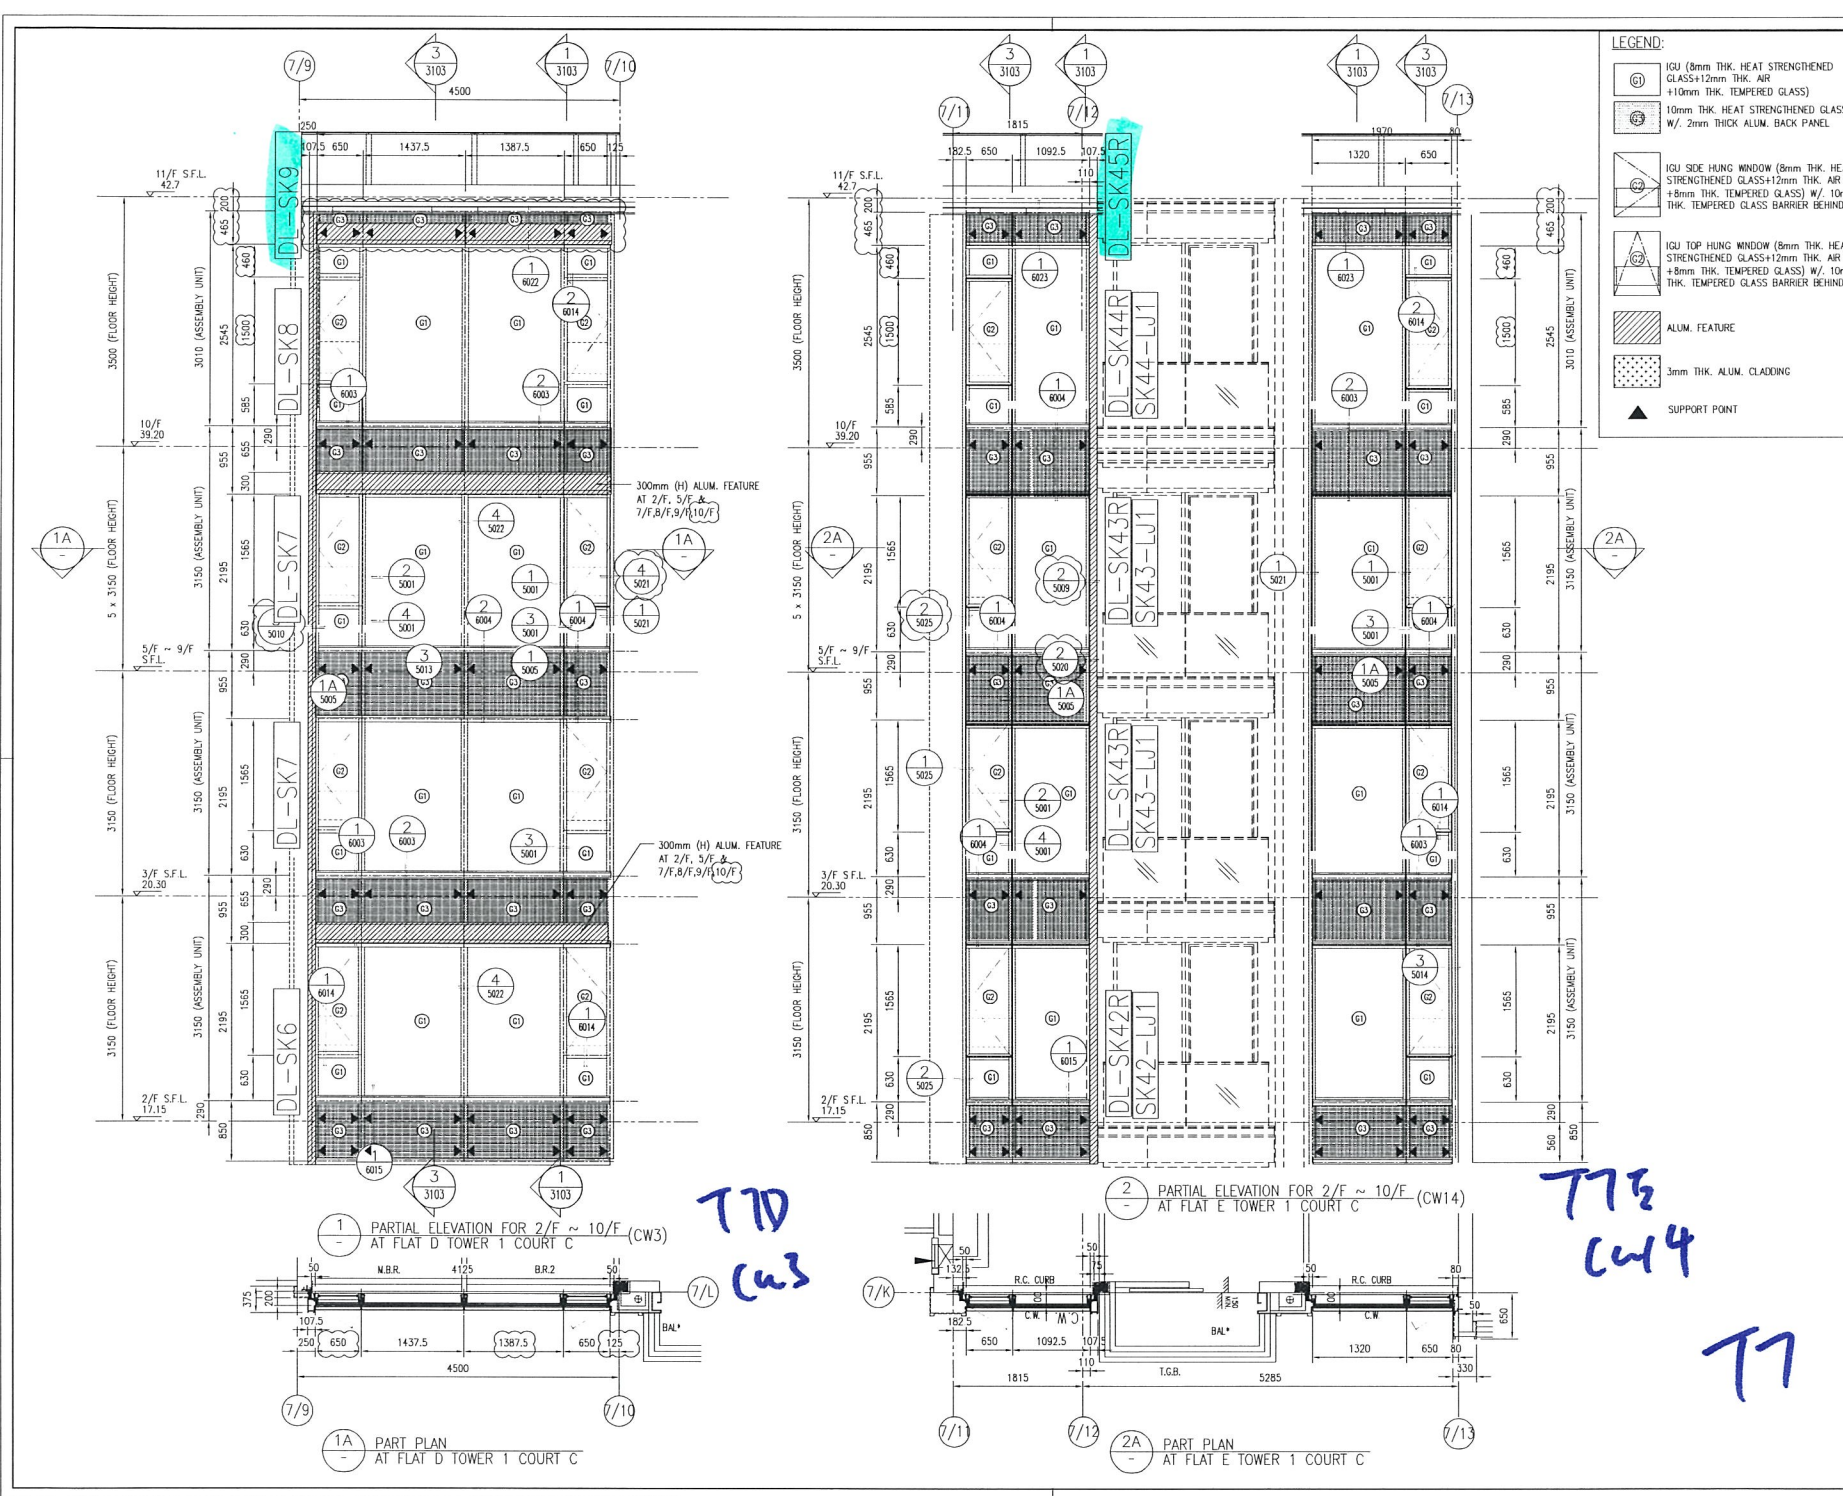

**LEGEND:**

- IGU (8mm THK. HEAT STRENGTHENED GLASS+12mm THK. AIR +10mm THK. TEMPERED GLASS)
- 10mm THK. HEAT STRENGTHENED GLASS W/ 2mm THICK ALUM. BACK PANEL
- IGU SIDE HUNG WINDOW (8mm THK. HEAT STRENGTHENED GLASS+12mm THK. AIR +8mm THK. TEMPERED GLASS) W/ 10mm THK. TEMPERED GLASS BARRIER BEHIND
- IGU TOP HUNG WINDOW (8mm THK. HEAT STRENGTHENED GLASS+12mm THK. AIR +8mm THK. TEMPERED GLASS) W/ 10mm THK. TEMPERED GLASS BARRIER BEHIND
- ALUM. FEATURE
- 3mm THK. ALUM. CLADDING
- SUPPORT POINT

B.D. REF :  
 F.S.D. REF :  
 Note:  
 1. All dimensions are in mm.  
 2. All elevations are viewed from outside.  
 3. All dimensions to be verified on site before fabrication.

**GENERAL NOTES**

-R.C.F.C. :  
 1. F.F.L. --- Finished Floor Level  
 2. S.F.L. --- Structural Floor Level  
 3. --- Reversed Detail

--- DETAIL MARK NO.  
 --- REFER SHEET NO.

REV	AMENDMENTS	DATE
A	GENERAL REWISED	27/11/2016
B	GENERAL REWISED	21/12/2016
C	GENERAL REWISED	3/6/2017

CLIENT:  
**GOOD ASSETS LTD.**

PROJECT ARCHITECT:  
**SUN HUNG KAI**  
 ARCHITECTS AND ENGINEERS LIMITED

DESIGN ARCHITECT:  
**RONALD LU & PARTNERS**

STRUCTURAL ENGINEER:  
**PARSONS BRINCKERHOFF**

FAÇADE CONSULTANT:  
**ALPHA CONSULTING LIMITED**  
 Steel Structure & Façade Specialist



MAIN CONTRACTOR:  
 YEE FAI CONSTRUCTION CO. LTD.

**美特鋁質有限公司**  
 MIDI ALUMINUM FABRICATOR LTD.  
 Units 6-8, Sunray Industrial Centre, 1/F  
 610 Cha Kwo Ling Road, Kowloon  
 Tel: 23489211-4 Fax: (852) 2727666

PROJECT TITLE:  
 PROPOSED RESIDENTIAL DEVELOPMENT, AT STTL 581, YIU SHA ROAD, WHITEHEAD, MA ON SHAN, NEW TERRITORIES

DRAWING TITLE:  
 ELEVATION FOR TOWER CURTAIN WALL TOWER 1 COURT C

DRAWN : Asing	DATE 08-07-16
DESIGNED	SCALE 1:35(A1)
CHECKED	PROJECT NO: J-833
DRAWING NO: J833-TCW-3027	REV C

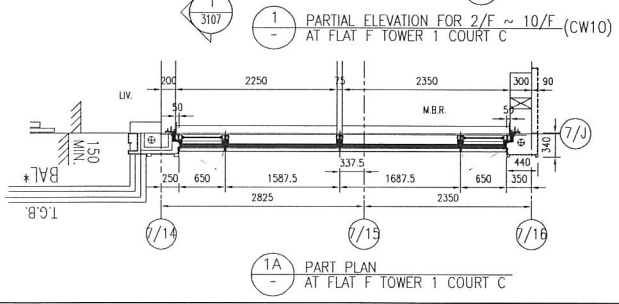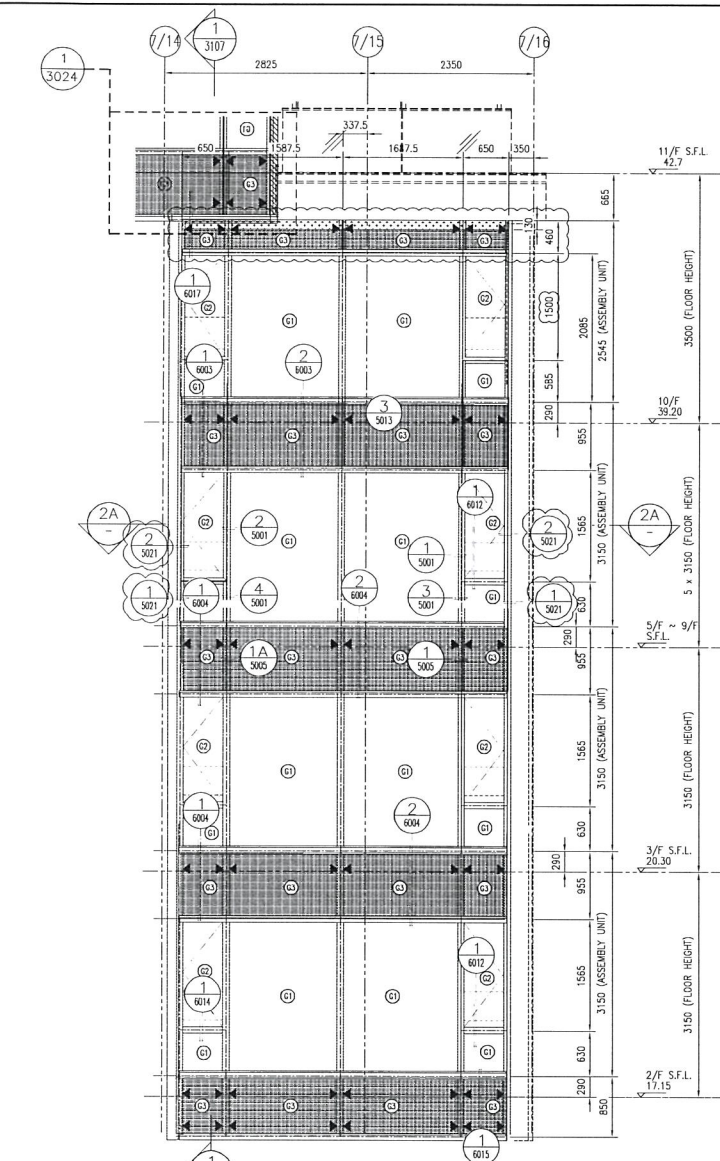

**LEGEND:**

- (C1) IGU (8mm THK. HEAT STRENGTHENED GLASS+12mm THK. AIR +10mm THK. TEMPERED GLASS)
- (C2) 10mm THK. HEAT STRENGTHENED GLASS W/ 2mm THICK ALUM. BACK PANEL
- (C3) IGU SIDE HUNG WINDOW (8mm THK. HEAT STRENGTHENED GLASS+12mm THK. AIR +8mm THK. TEMPERED GLASS) W/ 10mm THK. TEMPERED GLASS BARRIER BEHIND
- (C4) IGU TOP HUNG WINDOW (8mm THK. HEAT STRENGTHENED GLASS+12mm THK. AIR +8mm THK. TEMPERED GLASS) W/ 10mm THK. TEMPERED GLASS BARRIER BEHIND
- [Hatched Box] ALUM. FEATURE
- [Dotted Box] 3mm THK. ALUM. CLADDING
- ▲ SUPPORT POINT

B.D. REF :  
 F.S.D. REF :  
 Note :  
 1. All dimensions are in mm.  
 2. All elevations are viewed from outside.  
 3. All dimensions to be verified on site before fabrication.

**GENERAL NOTES**

1. F.F.L.-- Finished Floor Level  
 2. S.F.L.-- Structural Floor Level  
 3. --- Reversed Detail

(X) -- DETAIL MARK NO.  
 (C) -- REFER SHEET NO.

REV	AMENDMENTS	DATE
A	GENERAL REVISED	27/11/2016
B	GENERAL REVISED	21/12/2016
C	GENERAL REVISED	3/6/2017

CLIENT:  
**GOOD ASSETS LTD.**

PROJECT ARCHITECT:  
**SUN HUNG KAI**  
 ARCHITECTS AND ENGINEERS LIMITED

DESIGN ARCHITECT:  
**RONALD LU & PARTNERS**

STRUCTURAL ENGINEER :  
**PARSONS BRINCKERHOFF**

FACADE CONSULTANT  
**ALPHA CONSULTING LIMITED**  
 Steel Structure & Facade Specialist

MAIN CONTRACTOR :  
 YEE FAI CONSTRUCTION CO. LTD.

**美特鋁質有限公司**  
 MIDI ALUMINIUM FABRICATOR LTD.  
 Units 6-8, Sunray Industrial Centre, 1/F  
 610 Cha Kwo Ling Road, Kowloon  
 Tel:23489211-4 Fax:(852)2727666

PROJECT TITLE :  
 PROPOSED RESIDENTIAL DEVELOPMENT, AT ST11 581, YIU SHA ROAD, WHITEHEAD, MA ON SHAN, NEW TERRITORIES


DRAWING TITLE :  
 ELEVATION FOR TOWER CURTAIN WALL TOWER 1 COURT C

DRAWN : Asing	DATE 08-07-16
DESIGNED	SCALE 1:35(A1)
CHECKED	PROJECT NO: J-833
DRAWING NO: J833-TCW-3028	REV C


T7

**LEGEND:**

	IGU (6mm THK. HEAT STRENGTHENED GLASS+2mm THK. TEmPERED GLASS) W./ 2mm THK ALUM. BACK PANNEL
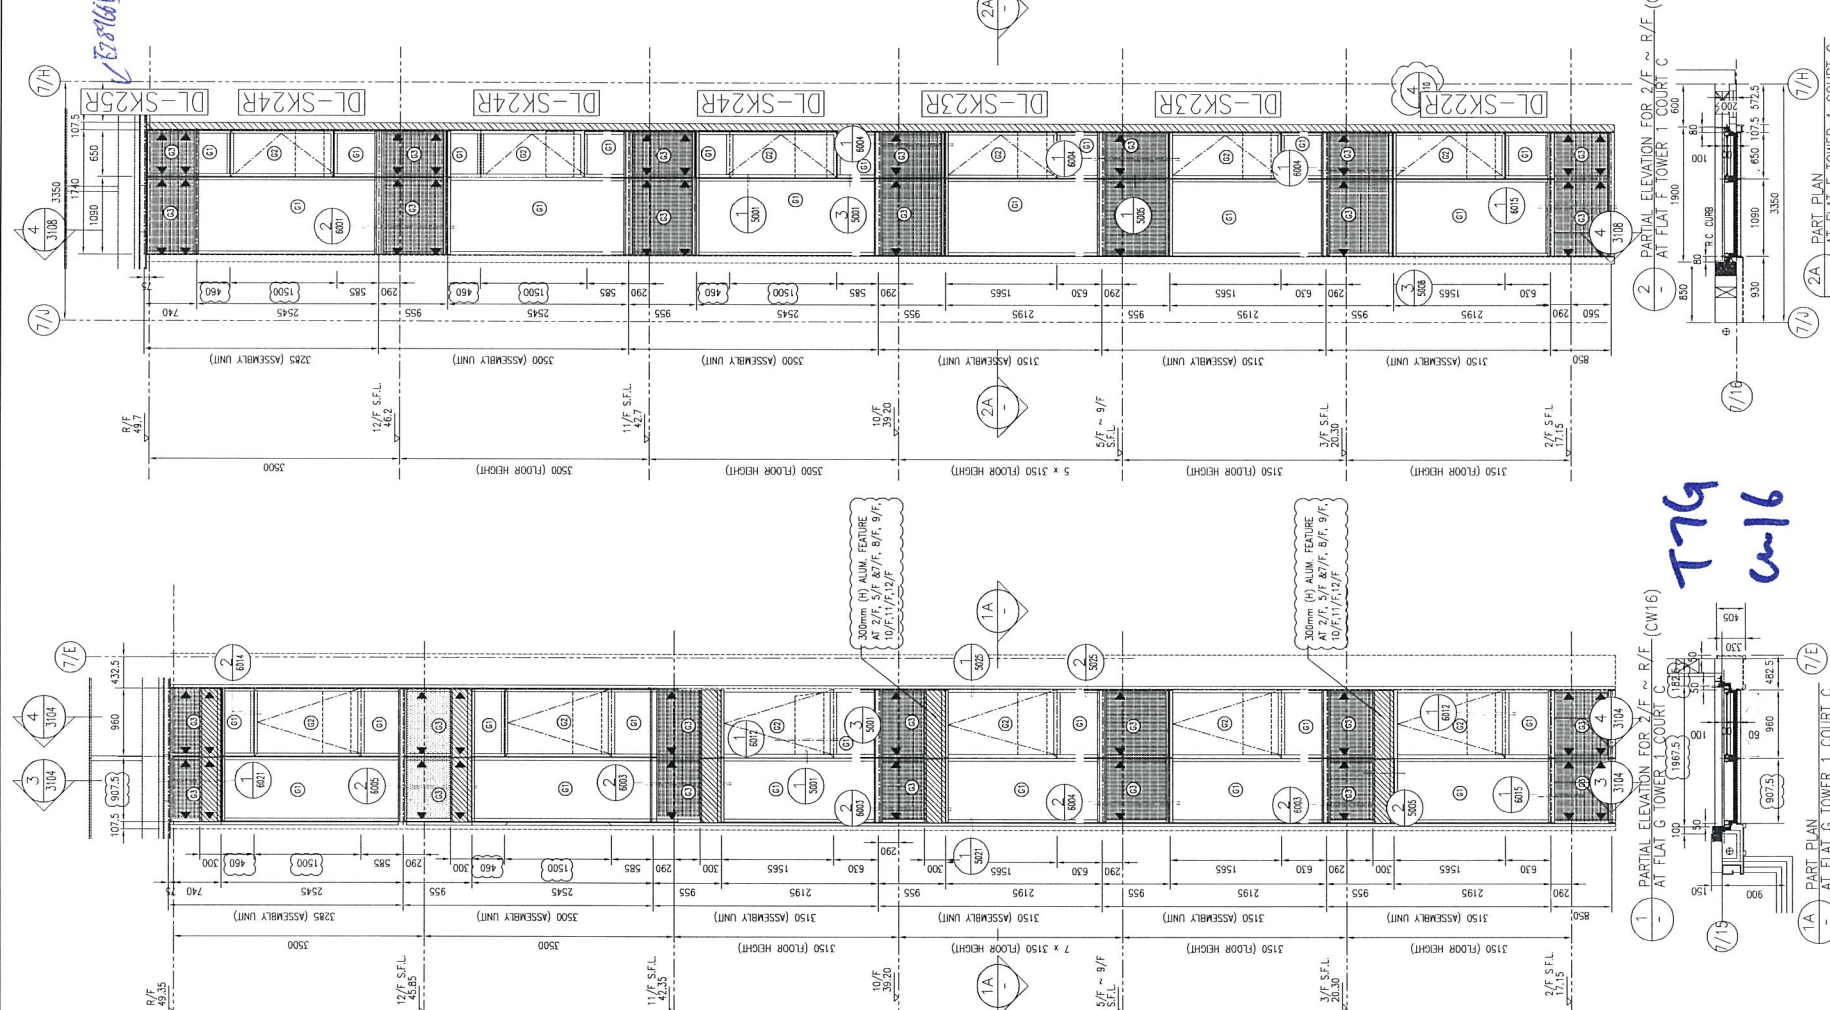

B.D. REF :		
F.S.D. REF :		
Note:		
1.All dimensions are in mm.		
2.All elevations are viewed from outside.		
3.All dimensions to be verified on site before fabrication.		
GENERAL NOTES		
LEGEND		
1 F.F.L. --- Finished Floor Level		
2 S.F.L. --- Structural Floor Level		
3. --- Reversed Detail		
	DETAIL MARK NO.	
	REFER SHEET NO.	
REV	AMENDMENTS	DATE
A	GENERAL REVISED	27/11/2016
B	GENERAL REVISED	21/12/2016
C	GENERAL REVISED	3/6/2017
CLIENT:		
GOOD ASSETS LTD.		
PROJECT ARCHITECT:		
DESIGN ARCHITECT:		
STRUCTURAL ENGINEER :		
FAOCD CONSULTANT		
MAIN CONTRACTOR :		
YEE FAI CONSTRUCTION CO. LTD.		
Units 6-8, Sunray Industrial Centre, 1/F 610 Cha Kwo Ling Road, Kowloon Tel:23489211-4 Fax:(852)2727666		
PROJECT TITLE :		
PROPOSED RESIDENTIAL DEVELOPMENT, AT STTL 581, YIU SHA ROAD, WHITEHEAD, MA ON SHAN, NEW TERRITORIES		
DRAWING TITLE :		
ELEVATION FOR TOWER CURTAIN WALL TOWER 1 COURT C		
DRAWN :	Asing	DATE 08-07-16
DESIGNED :		SCALE 1:35(A1)
CHECKED :		PROJECT NO: J-833
DRAWING NO: J833-TCW-3029		REV. C

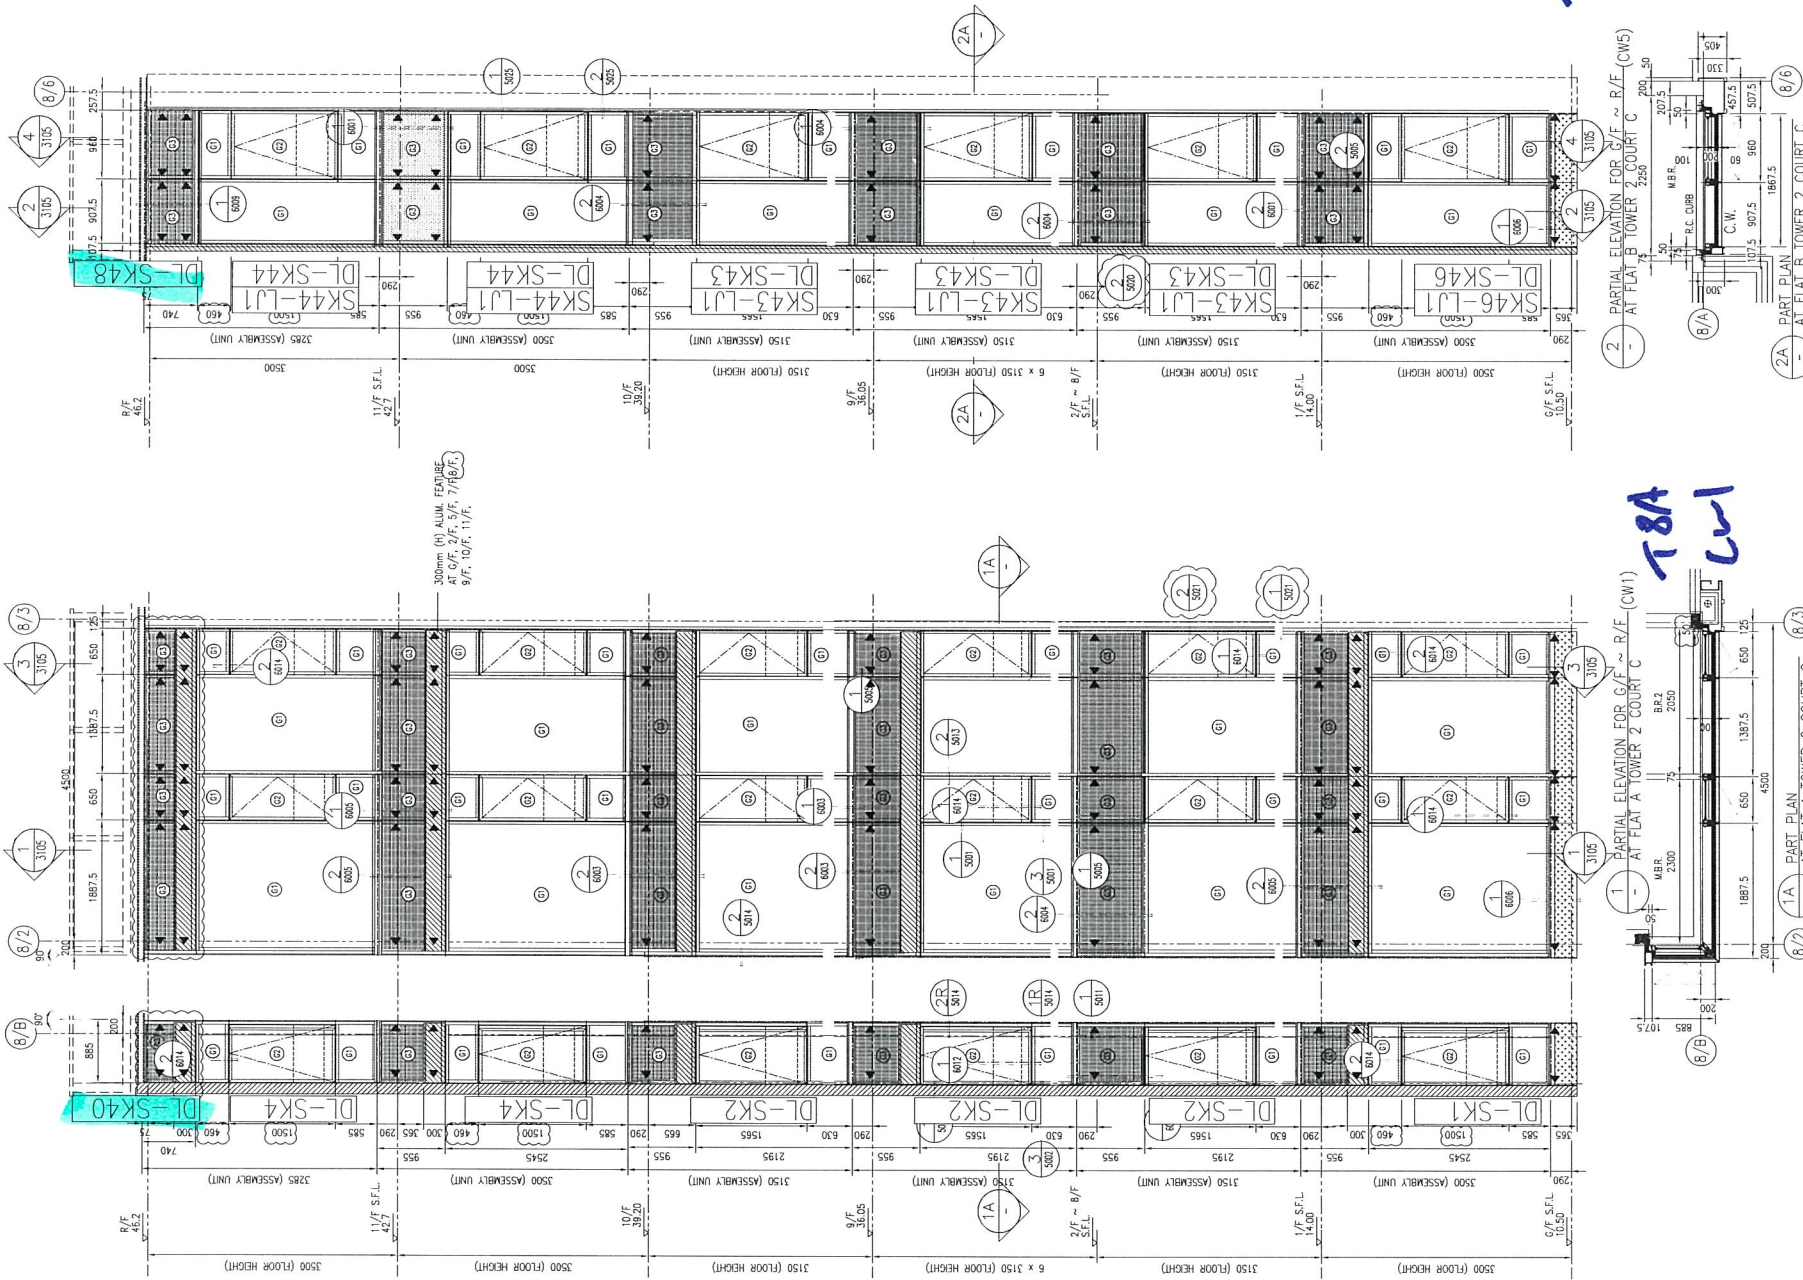

DL-SK48

DL-SK40

300mm (H) ALUM. FEATURE  
9/F, 10/F, 11/F.

T8B  
CW5  
T8

T8A  
CW1

B.D. REF :  
F.S.D. REF :

Note :  
1. All dimensions are in mm.  
2. All elevations are viewed from outside.  
3. All dimensions to be verified on site before fabrication.

GENERAL NOTES

SYMBOLS:  
1. F.F.L. --- Finished Floor Level  
2. S.F.L. --- Structural Floor Level  
3. --- Reversed Detail

DETAIL MARK NO. ---  
REFER SHEET NO. ---

REV	AMENDMENTS	DATE
A	GENERAL REVISED	27/11/2016
B	GENERAL REVISED	21/12/2016
C	GENERAL REVISED	3/6/2017

CLIENT:  
**GOOD ASSETS LTD.**

PROJECT ARCHITECT:  
**SUN HUNG KAI**  
ARCHITECTS AND ENGINEERS LIMITED

DESIGN ARCHITECT:  
**RONALD LU & PARTNERS**

STRUCTURAL ENGINEER:  
**PARSONS BRINCKERHOFF**

FAÇADE CONSULTANT:  
**ALPHA CONSULTING LIMITED**  
Steel Structure & Façade Specialist Ltd.


MAIN CONTRACTOR:  
YEE FAI CONSTRUCTION CO. LTD.

美特鋁質有限公司  
MTDI ALUMINIUM FABRICATOR LTD.  
Units 6-8, Sunray Industrial Centre, 1/F  
610 Cha Kwo Ling Road, Kowloon  
Tel: 23489211-4 Fax: (852) 2727666


PROJECT TITLE:  
PROPOSED RESIDENTIAL DEVELOPMENT, AT STLL 581, YIU SHA ROAD, WHITEHEAD, MA ON SHAN, NEW TERRITORIES

DRAWING TITLE:  
ELEVATION FOR TOWER CURTAIN WALL TOWER 2 COURT C


DRAWN : Asing	DATE 08-07-16
DESIGNED :	SCALE 1:35(A1)
CHECKED :	PROJECT NO: J-833
DRAWING NO: J833-TCW-3031	REV C

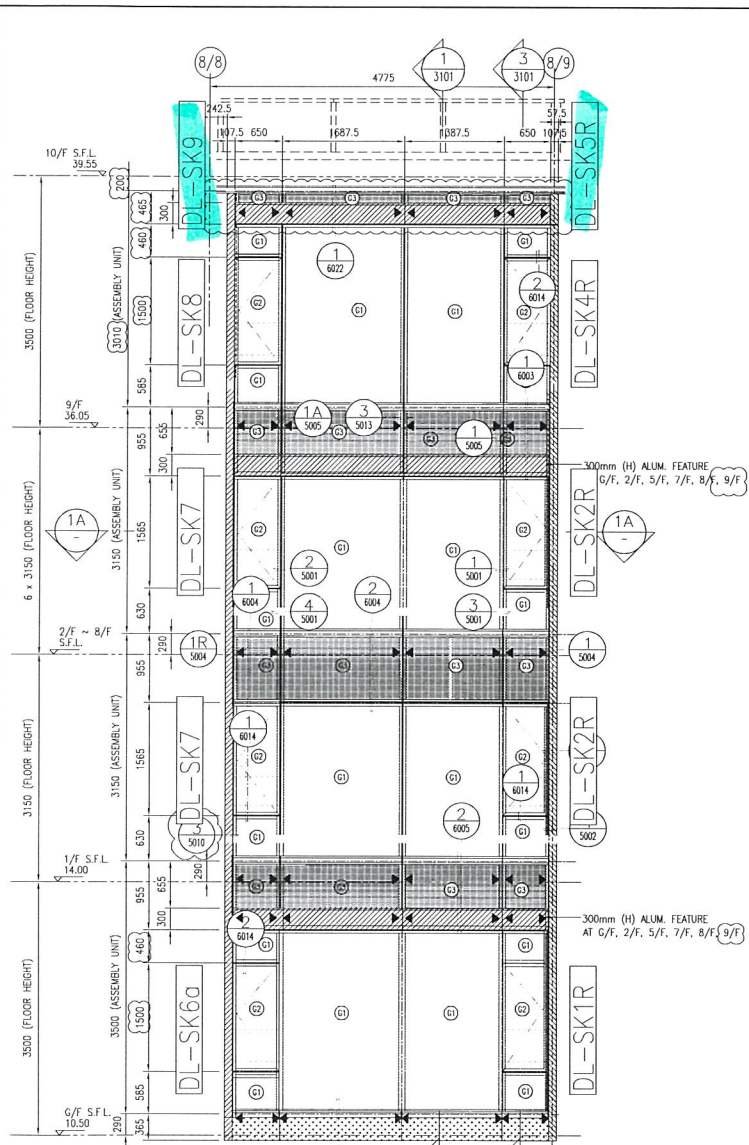


1 PARTIAL ELEVATION FOR G/F ~ R/F (CW7) AT FLAT C TOWER 2 COURT C

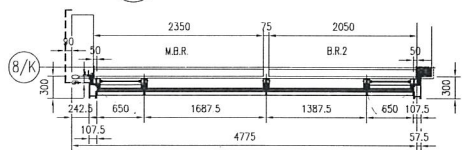

1A PART PLAN AT FLAT C TOWER 2 COURT C

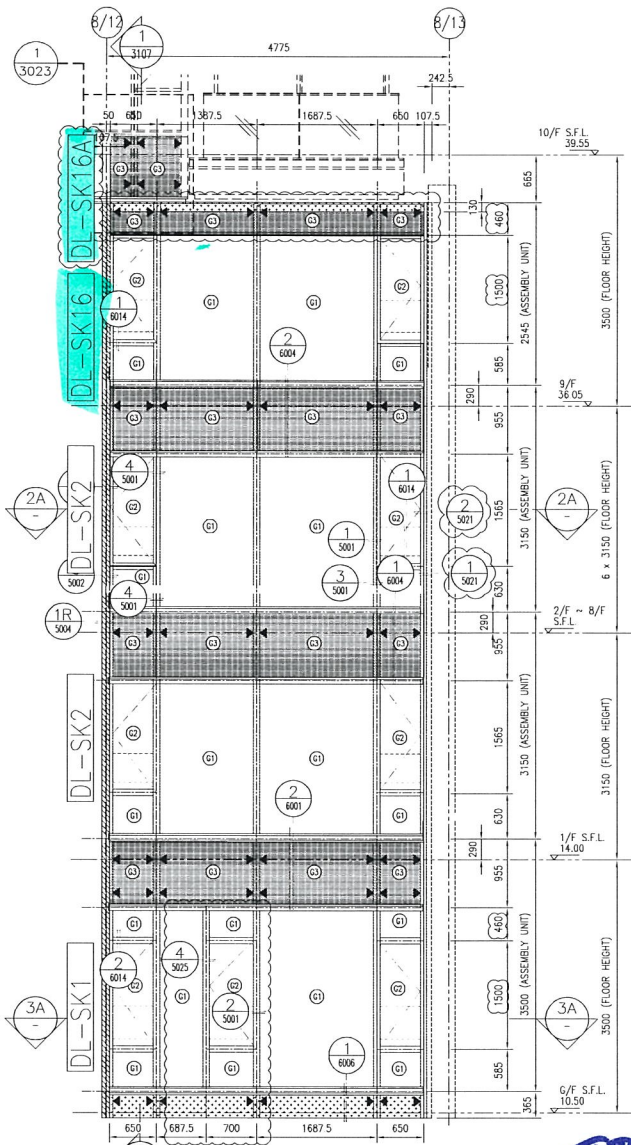


2 PARTIAL ELEVATION FOR G/F ~ 9/F (CW7R) AT FLAT D TOWER 2 COURT C

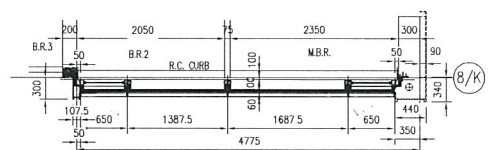

2A PART PLAN AT FLAT D TOWER 2 COURT C

TBD CW7R 78

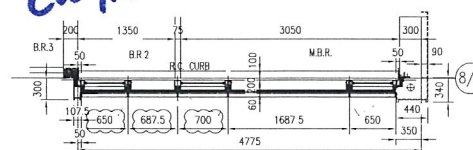

3A PART PLAN AT FLAT D TOWER 2 COURT C

**LEGEND:**

- (G1) IGU (8mm THK. HEAT STRENGTHENED GLASS+12mm THK. AIR +10mm THK. TEMPERED GLASS)
- (G2) 10mm THK. HEAT STRENGTHENED GLASS W/ 2mm THK ALUM. BACK PANEL
- (G3) IGU SIDE HUNG WINDOW (8mm THK. HEAT STRENGTHENED GLASS+12mm THK. AIR +8mm THK. TEMPERED GLASS) W/ 10mm THK. TEMPERED GLASS BARRIER BEHIND
- (G4) IGU TOP HUNG WINDOW (8mm THK. HEAT STRENGTHENED GLASS+12mm THK. AIR +8mm THK. TEMPERED GLASS) W/ 10mm THK. TEMPERED GLASS BARRIER BEHIND
- ALUM. FEATURE
- 3mm THK ALUM. CLADDING
- ▲ SUPPORT POINT

B.D. REF :  
F.S.D. REF :  
Note:  
1. All dimensions are in mm.  
2. All elevations are viewed from outside.  
3. All dimensions to be verified on site before fabrication.

**GENERAL NOTES**

Legend:  
1. F.F.L.-- Finished Floor Level  
2. S.F.L.-- Structural Floor Level  
3. --- Reversed Detail

○ --- DETAIL MARK NO.  
○ --- REFER SHEET NO.

REV	AMENDMENTS	DATE
A	GENERAL REWISED	27/11/2016
B	GENERAL REWISED	21/12/2016
C	GENERAL REWISED	3/6/2017

CLIENT:  
**GOOD ASSETS LTD.**

PROJECT ARCHITECT:  
**SUN HUNG KAI**  
ARCHITECTS AND ENGINEERS LIMITED

DESIGN ARCHITECT:  
**RONALD LU & PARTNERS**

STRUCTURAL ENGINEER:  
**PARSONS BRINCKERHOFF**

FAÇADE CONSULTANT:  
**ALPHA CONSULTING LIMITED**  
Steel Structure & Façade Specialist


MAIN CONTRACTOR:  
YEE FAI CONSTRUCTION CO. LTD.

**美特鋁質有限公司**  
MIDI ALUMINIUM FABRICATOR LTD.  
Units 6-8, Sunray Industrial Centre, 1/F  
610 Cha Kwo Ling Road, Kowloon  
Tel:23489211-4 Fax:(852)2727666



PROJECT TITLE:  
PROPOSED RESIDENTIAL DEVELOPMENT, AT STTL 581, YIU SHA ROAD, WHITEHEAD, MA ON SHAN, NEW TERRITORIES

DRAWING TITLE:  
ELEVATION FOR TOWER CURTAIN WALL TOWER 2 COURT C

DRAWN : Asing	DATE 08-07-16
DESIGNED :	SCALE 1:35(A1)
CHECKED :	PROJECT NO: J-833
DRAWING NO. J833-TCW-3032	REV. C


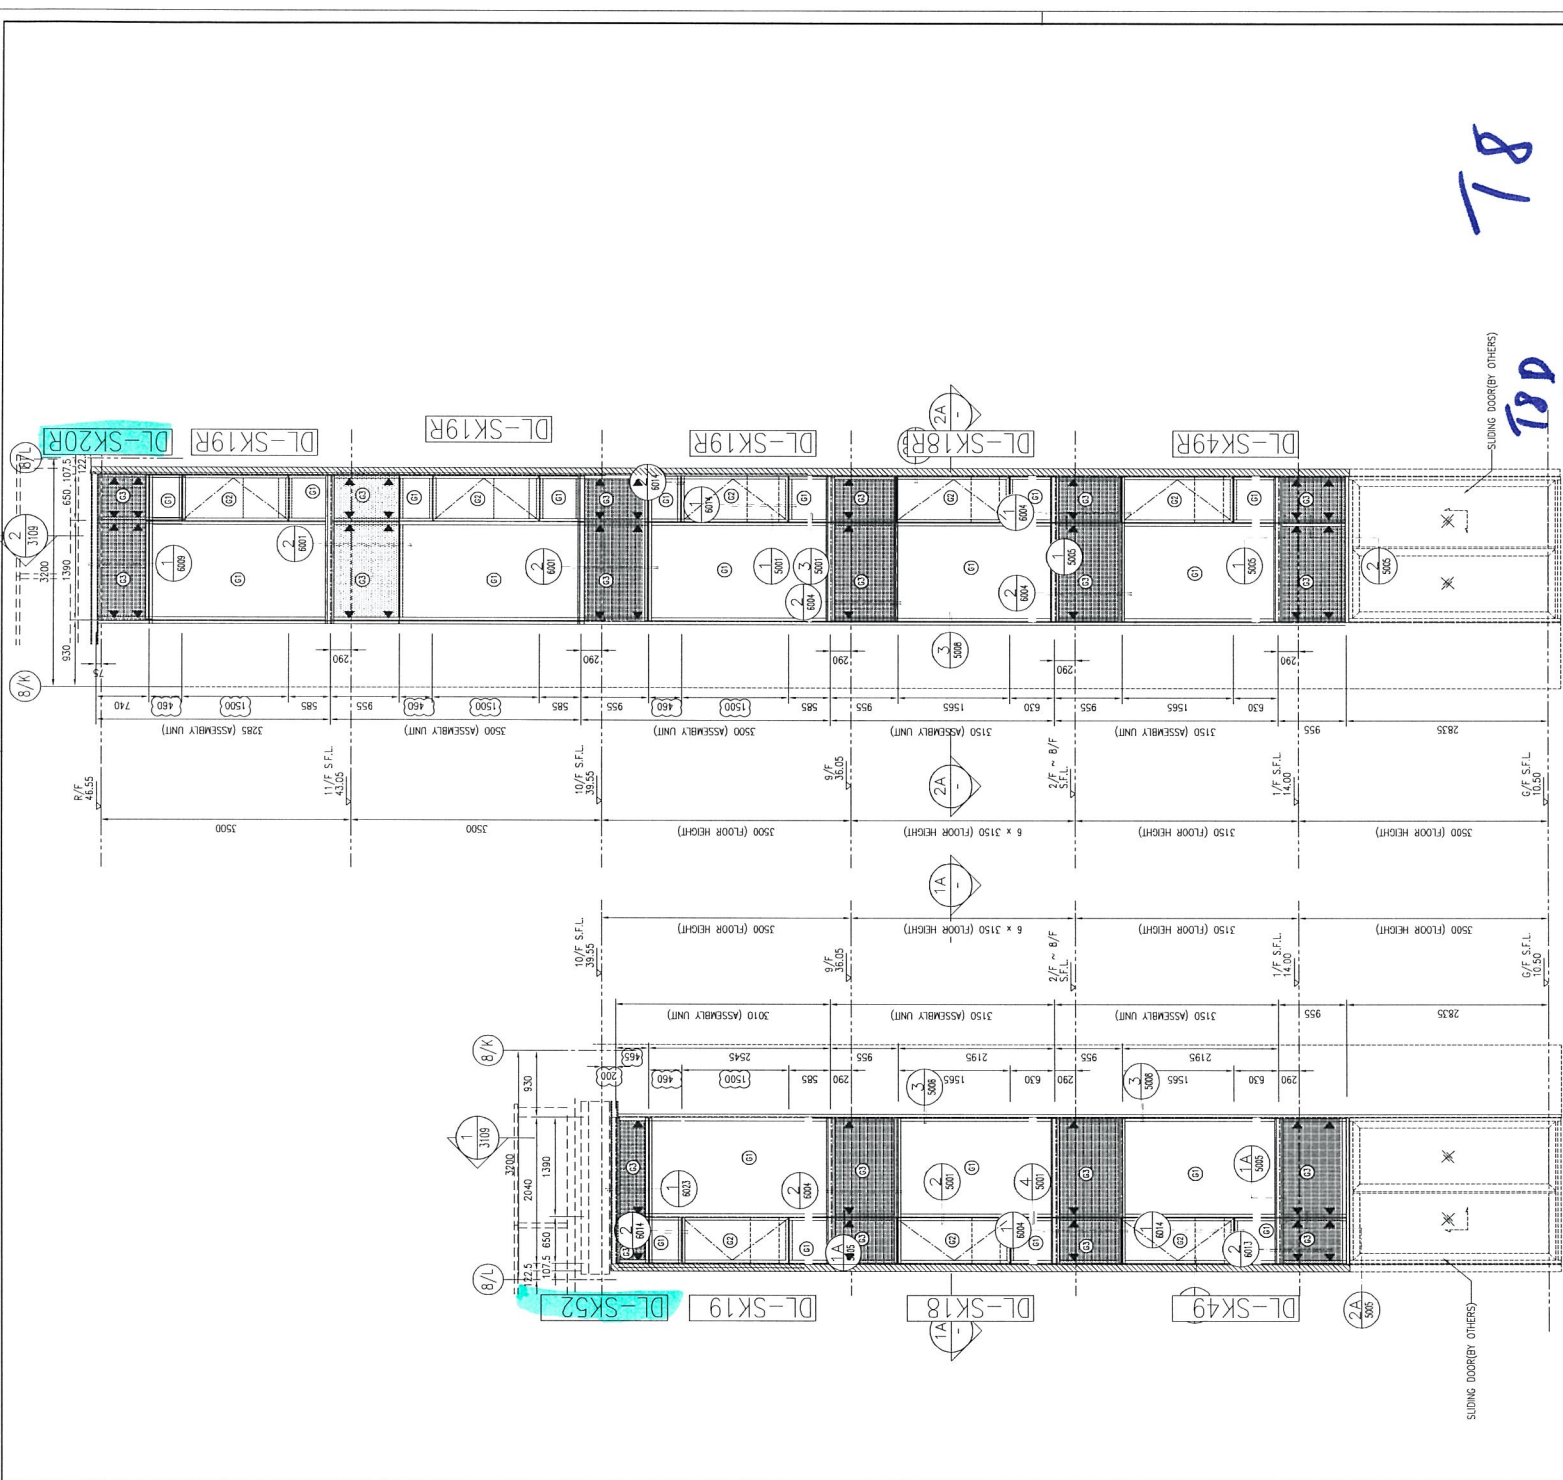


- LEGEND:**
- IGU (8mm THK. HEAT STRENGTHENED GLASS+12mm THK. AIR +10mm THK. TEMPERED GLASS)
  - 10mm THK. HEAT STRENGTHENED GLASS W/ 2mm THICK ALUM. BACK PANEL
  - IGU SIDE HUNG WINDOW (8mm THK. HEAT STRENGTHENED GLASS+12mm THK. AIR +8mm THK. TEMPERED GLASS) W/ 10mm THK. TEMPERED GLASS BARRIER BEHIND
  - IGU TOP HUNG WINDOW (8mm THK. HEAT STRENGTHENED GLASS+12mm THK. AIR +8mm THK. TEMPERED GLASS) W/ 10mm THK. TEMPERED GLASS BARRIER BEHIND
  - ALUM. FEATURE
  - 3mm THK. ALUM. CLADDING

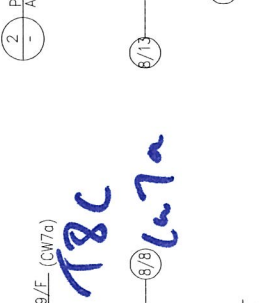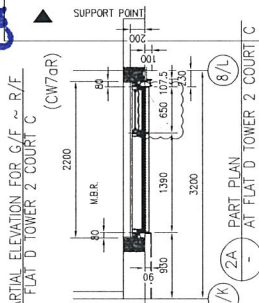

B.D. REF :		
F.S.D. REF :		
Note:		
1. All dimensions are in mm.		
2. All elevations are viewed from outside.		
3. All dimensions to be verified on site before fabrication.		
<b>GENERAL NOTES</b>		
1. F.F.L. -- Finished Floor Level		
2. S.F.L. -- Structural Floor Level		
3.  Reversed Detail		
	DETAIL MARK NO.	
	REFER SHEET NO.	
REV	AMENDMENTS	DATE
A	GENERAL REVISED	27/11/2016
B	GENERAL REVISED	27/11/2016
C	GENERAL REVISED	3/6/2017
CLIENT:		
<b>GOOD ASSETS LTD.</b>		
PROJECT ARCHITECT:		
<b>SUN HUNG KAI</b> ARCHITECTS AND ENGINEERS LIMITED		
DESIGN ARCHITECT:		
<b>RONALD LU &amp; PARTNERS</b>		
STRUCTURAL ENGINEER:		
<b>PARSONS BRINCKERHOFF</b>		
FACADE CONSULTANT:		
<b>ALPHA CONSULTING LIMITED</b> Steel Structure & Façade Specialist		
MAIN CONTRACTOR:		
YEE FAI CONSTRUCTION CO. LTD.		
CLIENT: <b>美特铝业有限公司</b> <b>MIDI ALUMINIUM FABRICATOR LTD.</b> Units 6-8, Sunray Industrial Centre, 1/F 610 Cha Kwo Ling Road, Kowloon Tel: 23489211-4 Fax: (852) 2727666		
PROJECT TITLE:		
PROPOSED RESIDENTIAL DEVELOPMENT, AT STTL 581, YIU SHA ROAD, WHITEHEAD, MA ON SHAN, NEW TERRITORIES		
DRAWING TITLE:		
ELEVATION FOR TOWER CURTAIN WALL TOWER 2 COURT C		
DRAWN :	Asing	DATE 08-07-16
DESIGNED :		SCALE 1:35(A1)
CHECKED :		PROJECT NO. J-833
DRAWING NO.:	J833-TCW-3033	REV. C



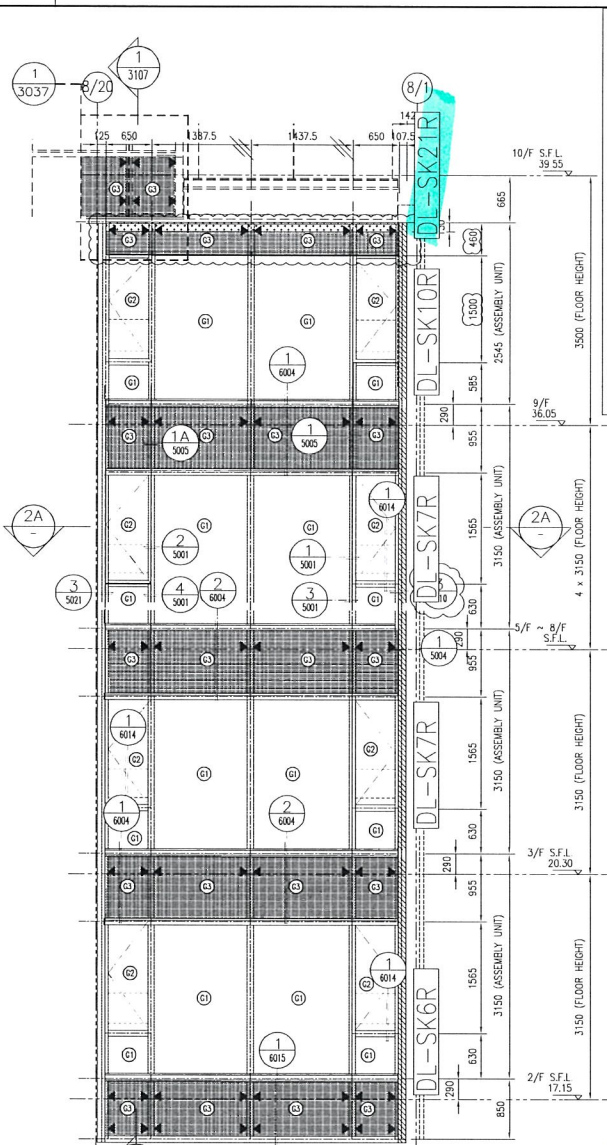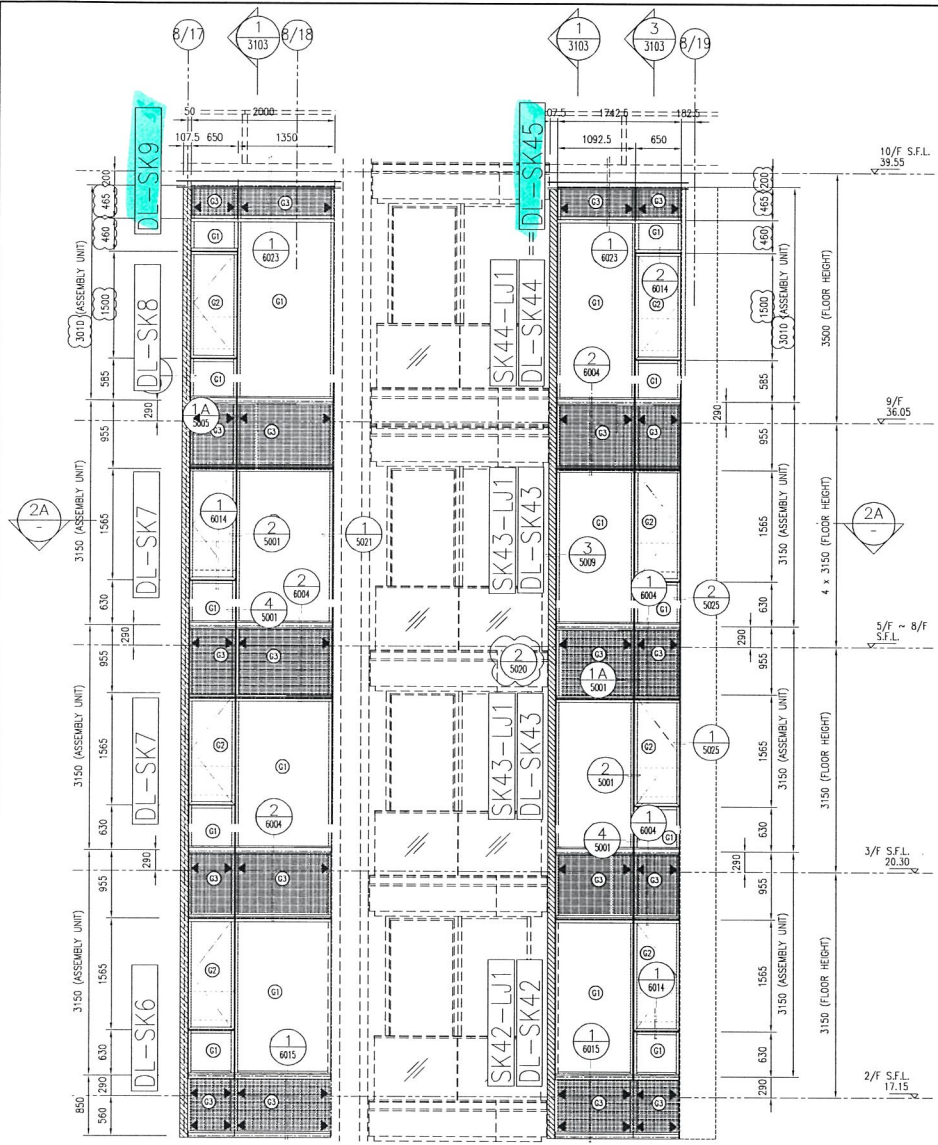

**LEGEND:**

- (G1) IGI (8mm THK. HEAT STRENGTHENED GLASS+12mm THK. AIR +10mm THK. TEMPERED GLASS)
- (G2) 10mm THK. HEAT STRENGTHENED GLASS W/ 2mm THICK ALUM. BACK PANEL
- (G3) IGI SIDE HUNG WINDOW (8mm THK. HEAT STRENGTHENED GLASS+12mm THK. AIR +8mm THK. TEMPERED GLASS) W/ 10mm THK. TEMPERED GLASS BARRIER BEHIND
- (G4) IGI TOP HUNG WINDOW (8mm THK. HEAT STRENGTHENED GLASS+12mm THK. AIR +8mm THK. TEMPERED GLASS) W/ 10mm THK. TEMPERED GLASS BARRIER BEHIND
- (A) ALUM. FEATURE
- (C) 3mm THK. ALUM. CLADDING
- (S) SUPPORT POINT

**B.D. REF:**

**F.S.D. REF:**

**Note:**

1. All dimensions are in mm.
2. All elevations are viewed from outside.
3. All dimensions to be verified on site before fabrication.

**GENERAL NOTES**

**ASSFC:**

1. F.F.L. --- Finished Floor Level
2. S.F.L. --- Structural Floor Level
3. --- Reversed Detail

(X) --- DETAIL MARK NO.  
(Y) --- REFER SHEET NO.

REV	AMENDMENTS	DATE
C	GENERAL REVISED	3/6/2017

**CLIENT:**

**GOOD ASSETS LTD.**

**PROJECT ARCHITECT:**

**SUN HUNG KAI ARCHITECTS AND ENGINEERS LIMITED**

**DESIGN ARCHITECT:**

**RONALD LU & PARTNERS**

**STRUCTURAL ENGINEER:**

**PARSONS BRINCKERHOFF**

**FAÇADE CONSULTANT:**

**ALPHA CONSULTING LIMITED**  
Steel, Structure & Façade Specialist

**MAIN CONTRACTOR:**

**YEE FAI CONSTRUCTION CO. LTD.**













**PROJECT TITLE:**

**PROPOSED RESIDENTIAL DEVELOPMENT, AT STLL 581, YIU SHA ROAD, WHITEHEAD, MA ON SHAN, NEW TERRITORIES**

**DRAWING TITLE:**

**ELEVATION FOR TOWER CURTAIN WALL TOWER 2 COURT C**

**DRAWN:** Asing **DATE:** 08-07-16

**DESIGNED:** **SCALE:** 1:35(A1)

**CHECKED:** **PROJECT NO.:** J-833

**DRAWING NO.:** J833-TCW-3035 **REV.:** C

