



美 特 鋁 質 有 限 公 司
MIDI ALUMINIUM FABRICATOR LTD.

工程指示 / 要求簡箋(E.I.)

工程指示編號：EI/1555 / 20

修改版次：J

工程編號：J851

工程名稱：青衣 明翹匯

工程項目：鋁料加工圖 (預制窗)

收件人：生統

發件人：Leung Hin Wai

日期：14/4-2020

要求提供 / 確認 事項：

- | | | |
|------------------------------------|-------------------------------------|-------------------------------|
| <input type="checkbox"/> 初步鋁料 B.M. | <input type="checkbox"/> 加工拆圍，然後生產 | <input type="checkbox"/> 尺寸表 |
| <input type="checkbox"/> 正式鋁料 B.M. | <input type="checkbox"/> 技術上資料 / 指示 | <input type="checkbox"/> 報價 |
| <input type="checkbox"/> 配件 B.M. | <input type="checkbox"/> 樣辦或貨品說明書 | <input type="checkbox"/> 分判合約 |
| <input type="checkbox"/> 其他：_____ | | |

內容：

請按附頁加工，送預制場。(重傳加工圖和將窗號尾字R改成MIR)

請在 16/4 前完成上列要求。

附：- 1+26頁

以上項目為：

- 原合約工程包 原合約工程加 / 減版 新工程報價

原因：-

分發東莞各部門：

- () 生產技術總監 連附件 () 技術部 連附件 () 生產部 連附件 () 機械設計部 連附件
 () 採購部 連附件 () 生產統籌部 連附件
 () 質檢部 連附件 () 會計部 連附件 () 報關組 連附件 () 其他 _____ 連附件

分發香港各部門：

- () 行政部 連附件 () 會計部 連附件 () 統籌部 連附件 () 工程部地盤科文 連附件
 () 採購部 連附件 () QS 部 連附件 () 維修部 連附件 () 其他 _____ 連附件

傳遞編號：

H/K 0559/20


發件人簽署：

[Signature]

項目經理簽署：

[Signature]

FABRICATION DRAWING

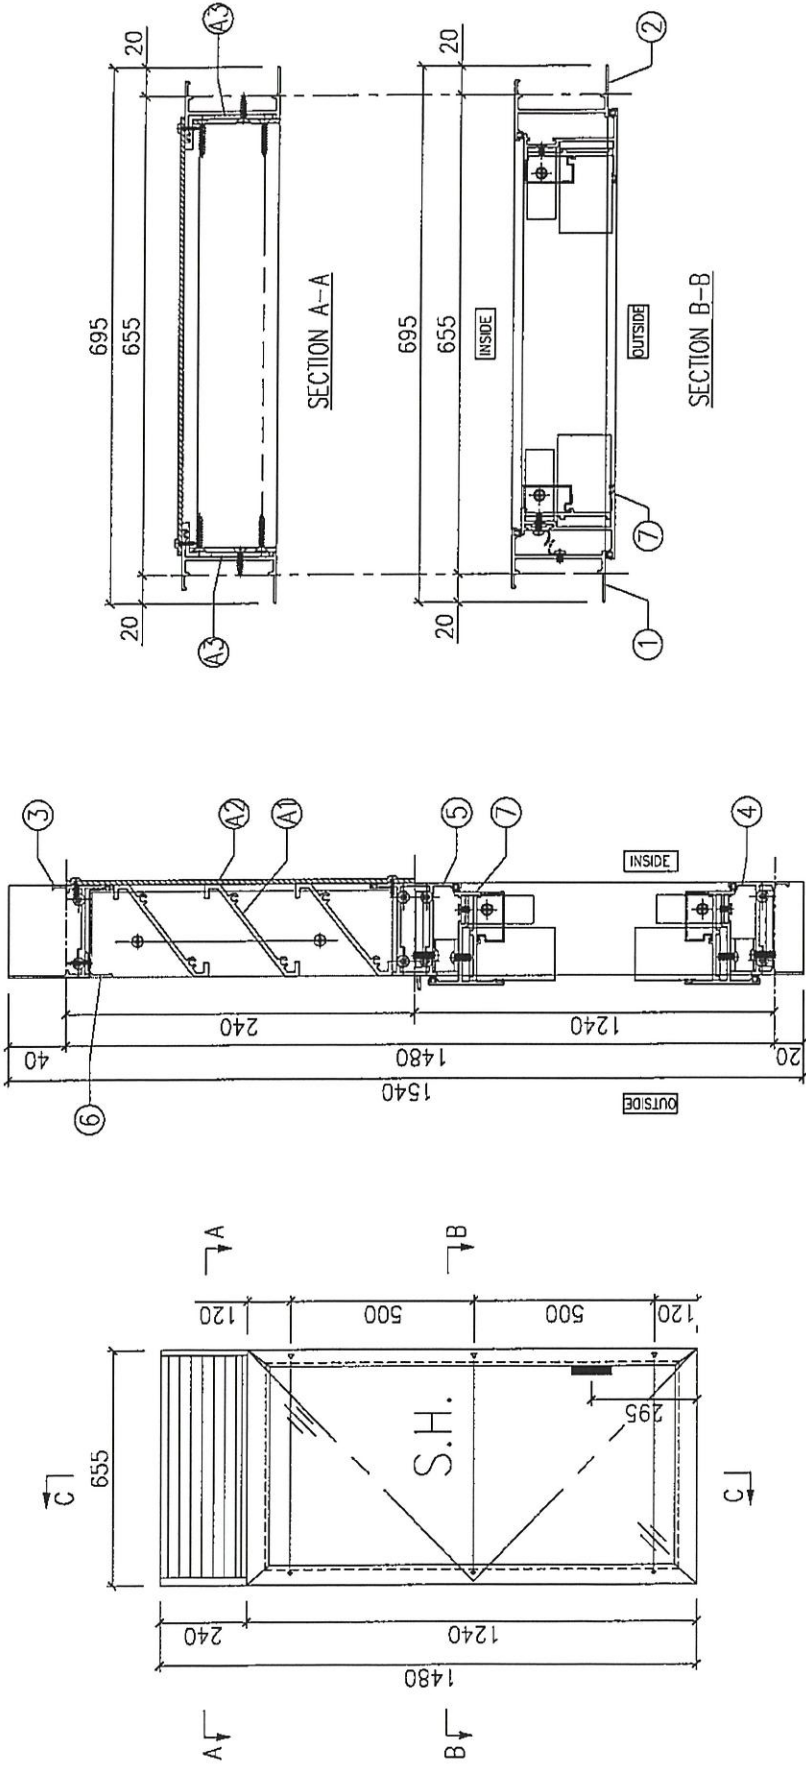

重傳

序号	加工图编号	材料名称	长度	支/幅
9	J851-LM06	不锈钢螺母	25	3
8	J851-LM05	不锈钢螺母	390	1
7	J851-SH17L	窗室小铝套	655x1220	1
6	X84489-01E	百叶滴水线	615	1
5	X85690-01LB	上生下垂中横	641	1
4	X85687-03LG	生底横	629	1
3	X85697-01E	百叶顶横	629	1
2	X85679-04RA	生边企	1540	1
1	X85679-05LA	生边企	1540	1

序号	加工图编号	材料名称	只/幅	说明
A3	J851-LM09	铝垫块	40x(0x3)	4 送佛
A2	LV-P01-05	百叶背板	626x240	1 沙场
A1	LV-S02-05	百叶玉	622x207.5	1

门窗组装修图

Project Name: 青衣190

Project No: J851

Shop Drawing No: PRE-CAST ALUM. WINDOW & LOUVRE

Remarks: T:\Jobs\J-851\7. 铝料、配件、玻璃、加工图纸\工. 预制窗\铝料加工图\20200302\J851预制窗组装修图.dwg

Checked: KEN

Date: 25-02-2020

Drawn: W.E.X

Project No: J851

Rev: -

Material: 25-02-2020

Finish: W.E.X

Date: 25-02-2020

Quantity: 27

Tolerance: ±0.5

Projection:







Delivery to: Rev. Date Amendments

Factory:

Site:

Assembly No: T1-W13

Rev: -

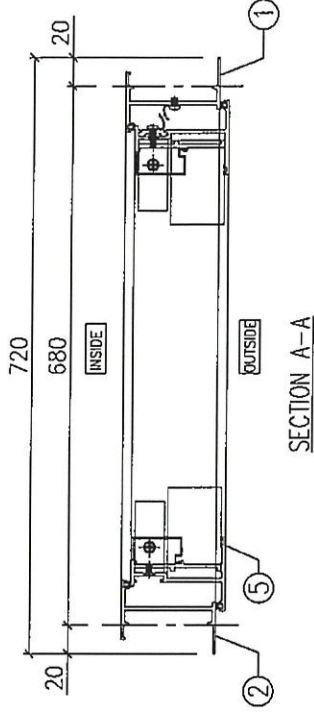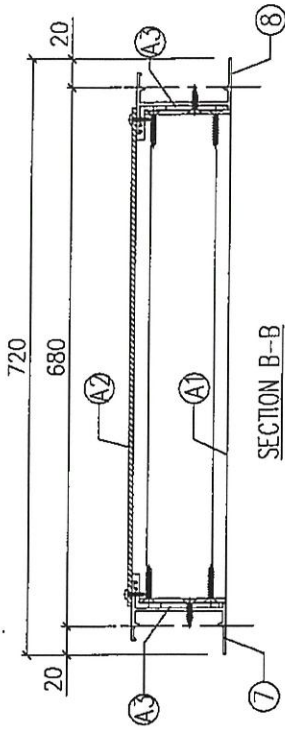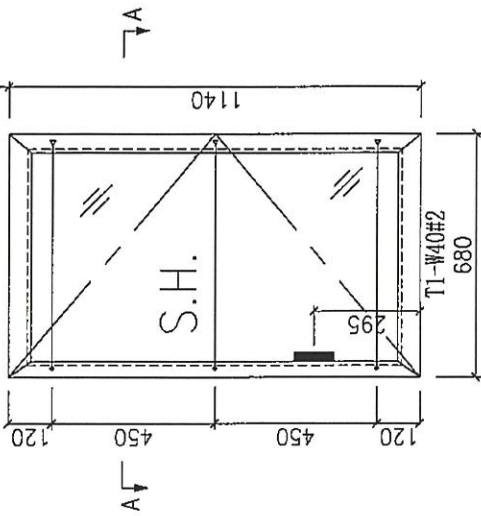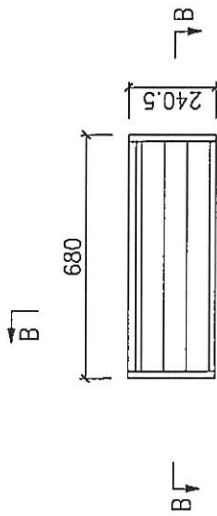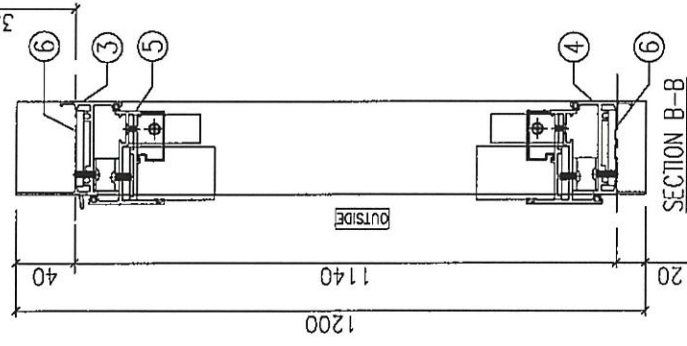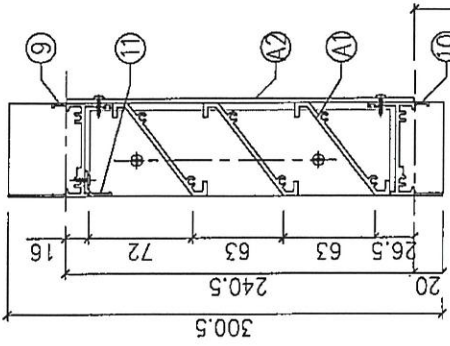

11	X84489-01D	百叶滴水线	640	1
10	X85687-06D	百叶底膜	654	1
9	X85697-01D	百叶顶膜	654	1
8	X85679-09R	生边盒	300.5	1
7	X85679-09L	生边盒	300.5	1

6	J851-LM06	不锈钢螺母	25	6
5	J851-SH16R	背玉小组装	660x1120	1
4	X85687-03RG	生底膜	654	1
3	X85685-01RJ	生顶膜	666	1
2	X85679-03LB	生边盒	1200	1
1	X85679-02RD	生边盒	1200	1

A3	J851-LM09	铝垫块 (10x10x3)	4	送佛
A2	LV-P01-04	百叶背板 65x240	1	沙场
A1	LV-S02-04	百叶玉托 207.5	1	只/幅说明

门窗组裝图

Checked: KEN
Date: 25-02-2020
Material: W.E.X
Drawn: W.E.X
Date: 25-02-2020

Project No. J851
Rev. -

Shop Drawing No. PRE-CAST ALUM. WINDOW & LOUVRE
T:\Jobs\J-851\資料、配件、玻璃、加工圖紙\1.預制窗\資料加工圖\20200302\J851預制窗組裝圖.dwg




UC534193SC-3

Site

Assembly No. T1-W40

Rev. -

MIDI Aluminium Fabricator Ltd.

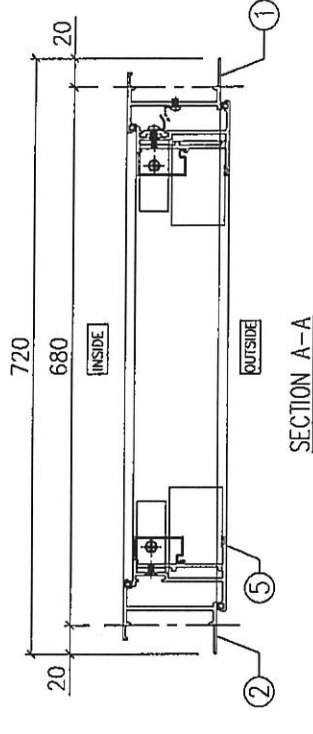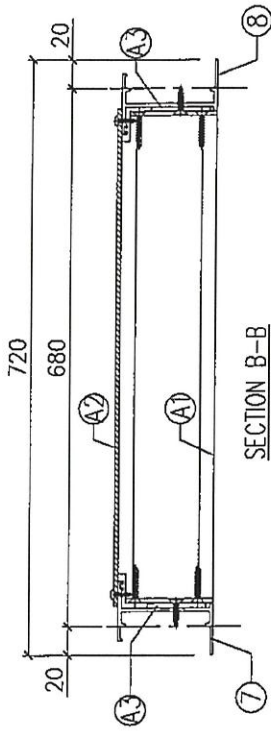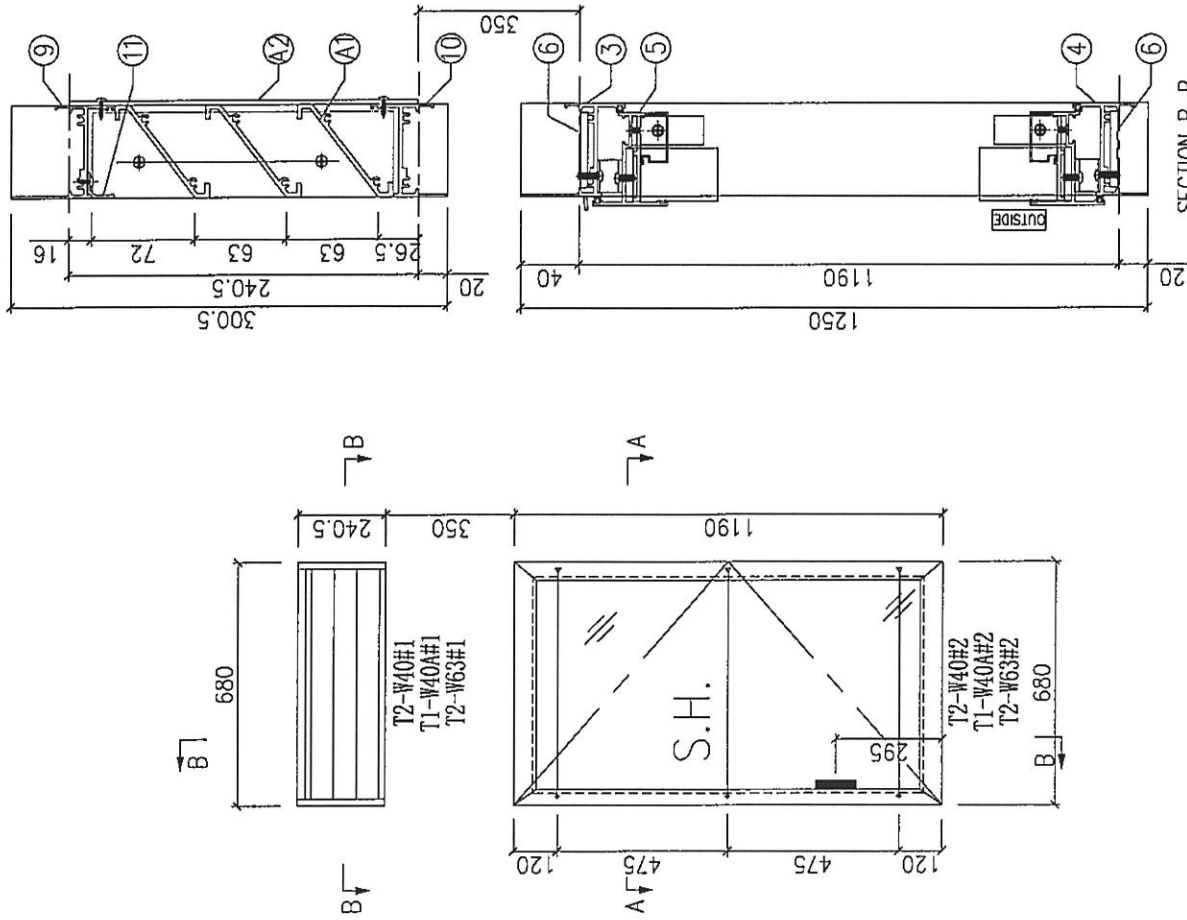

重停

11	X84489-01D	百叶滴水线	640	1
10	X85687-06D	百叶底横	654	1
9	X85697-01D	百叶顶横	654	1
8	X85679-09R	生边企	300.5	1
7	X85679-09L	生边企	300.5	1

6	J851-LM06	不锈钢丝母	25	6
5	J851-SH10R	碧玉小扭装	660x1170	1
4	X85687-03RG	生底横	654	1
3	X85685-01RJ	生顶横	666	1
2	X85679-03LA	生边企	1250	1
1	X85679-02RB	生边企	1250	1

A3	J851-LM09	铝垫块 (10x40x3)	4	送佛	
A2	LV-P01-04	百叶背板	651x240	1	沙场
A1	LV-S02-04	百叶至	647x207.5	1	说明

Remarks:

Checked: KEN
Date: 25-02-2020
Material: 1190
Drawn: W.E.X
Date: 25-02-2020
Finish: UCT534193SC-3


Project No. J851
Rev. --

Shop Drawing No. PRE-CAST ALUM. WINDOW & LOUVRE

Delivery to Rev. 1+1+2
Factory
Tolerance: ±0.5
Projection:

QTY: 1+1+2
Material Name: 只/隔 说明
Material Name: 材料名称
Drawing No. T1-W40A/T2-W40
Rev. 3
Assembly No. T1-W40A/T2-W40
Rev. 3

FABRICATION DRAWING

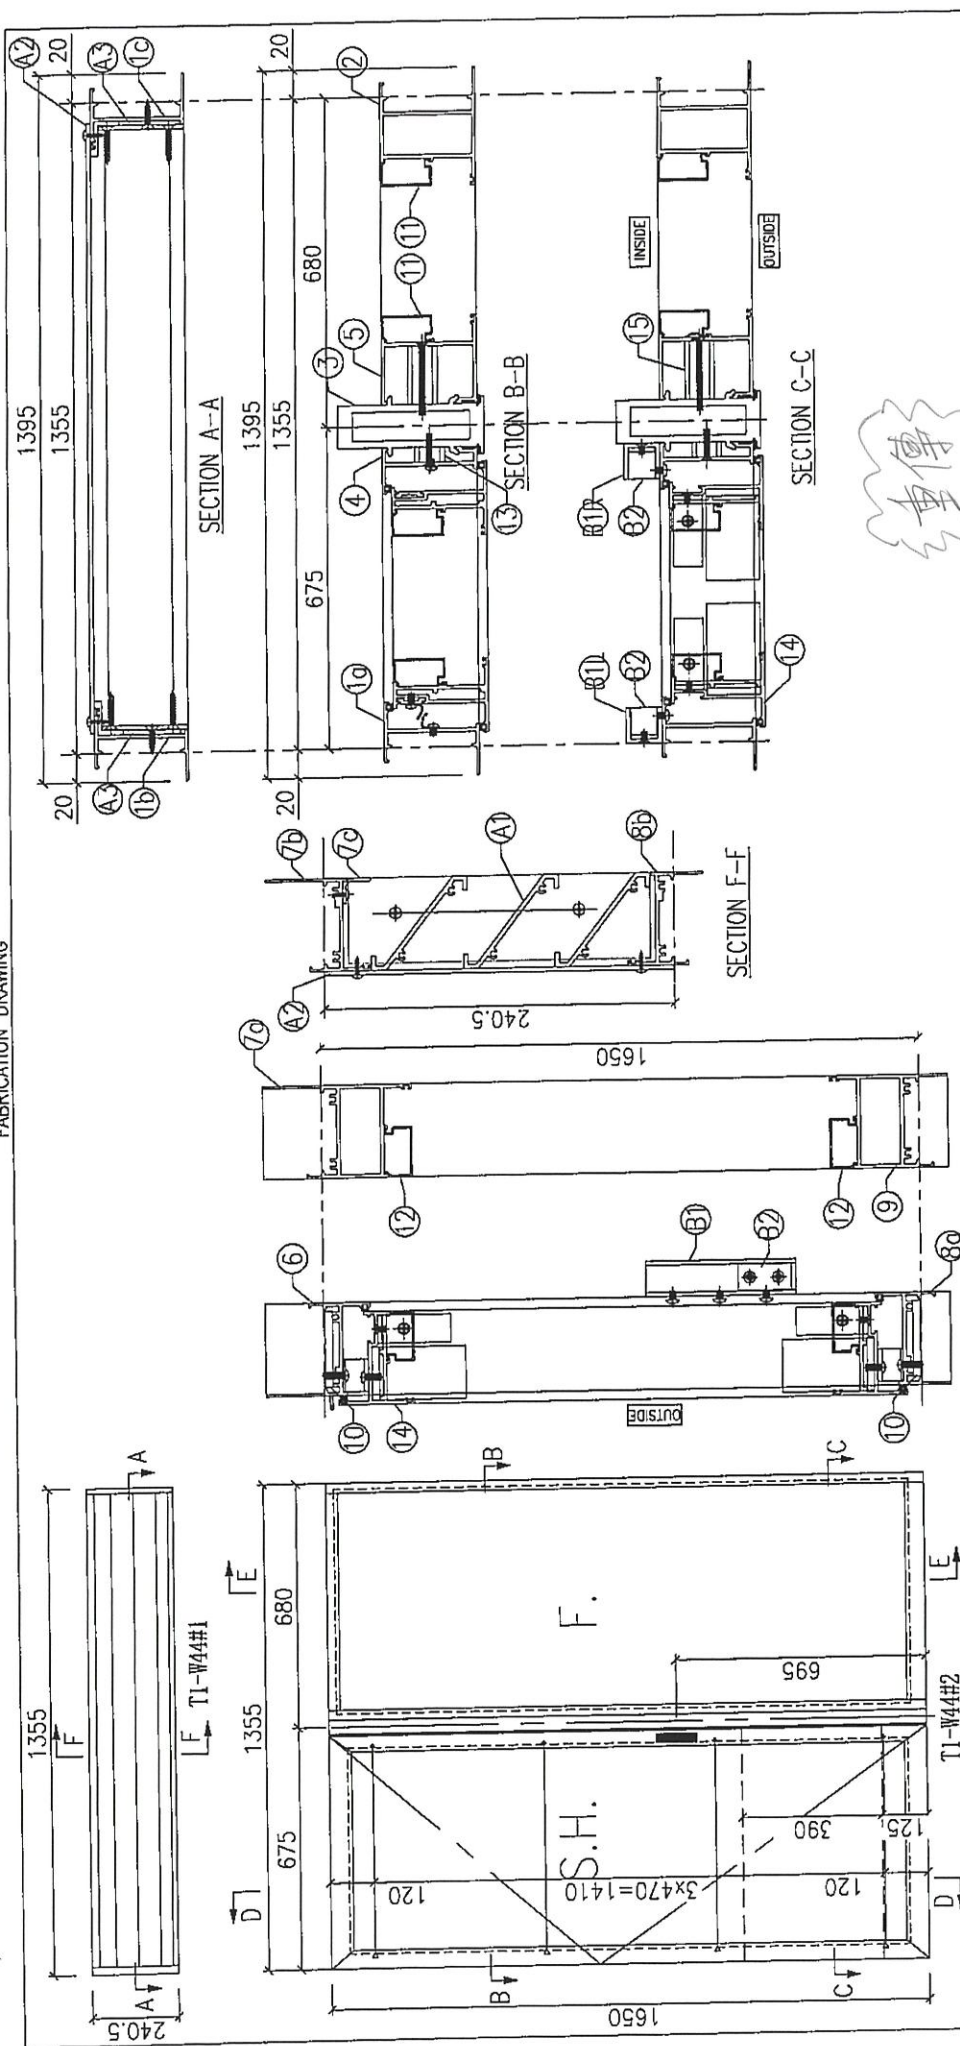


序号	加工图编号	材料名称	只/幅	说明
A3	J851-LM09	铝垫块(40x10x3)	4	送册
A2	LV-P01-07	百叶衬板(1326x240)	1	沙场
A1	LV-S02-02	百叶玉(1322x207.5)	1	

序号	加工图编号	材料名称	长度	支/幅
15	J851-LM10	铝垫通	40.5	6
14	J851-SH05L	铝玉小组装60x1630		1
13	J851-LM12	铝垫通	10.5	6
12	X856780	方玻璃线槽	540.5	2
11	X856780	方玻璃线金	1557.5	2
10	J851-LM06	不锈钢螺母	25	6

序号	加工图编号	材料名称	长度	支/幅
9	X85688-01B	侧底横	579	1
8b	X85687-06B	生底横	1329	1
8a	X85687-03LB	生底横	634	1
7c	X84489-01B	百叶滴水线	1315	1
7b	X85697-01B	百叶顶横	1329	1
7a	X85686-01B	侧顶横	579	1
6	X85685-01LB	生顶横	646	1

序号	加工图编号	材料名称	长度	支/幅
5	X85682-02LC	侧夹金	1710	1
4	X85683-02RC	生夹金	1710	1
3	X85684-02C	夹框通	1710	1
2	X85677-02RD	侧通金	1710	1
1c	X85679-09R	生通金	300.5	1
1b	X85679-09L	生通金	300.5	1
1a	X85679-02LF	生通金	1710	1


序号	加工图编号	材料名称	长度	支/幅
B2	J851-LM14	铝角	18	2
B1R	J851-LM13R	安全玻璃铝槽	401	1
B1L	J851-LM13L	安全玻璃铝槽	401	1

序号	加工图编号	材料名称	长度	支/幅	说明
B2	J851-LM14	铝角	18	2	粗接后
B1R	J851-LM13R	安全玻璃铝槽	401	1	选地量
B1L	J851-LM13L	安全玻璃铝槽	401	1	

门窗组装修图

Checked: KEN
Date: 25-02-2020
Material: W.E.X
Project No: J851
Rev: -
Shop Drawing No: 青衣190
PRE-CAST ALUM. WINDOW & LOUVRE
T:\Jobs\851V_铝料·配件·玻璃·加工图\铝料加工图\20200302\851预开窗组装修图.dwg

FABRICATION DRAWING

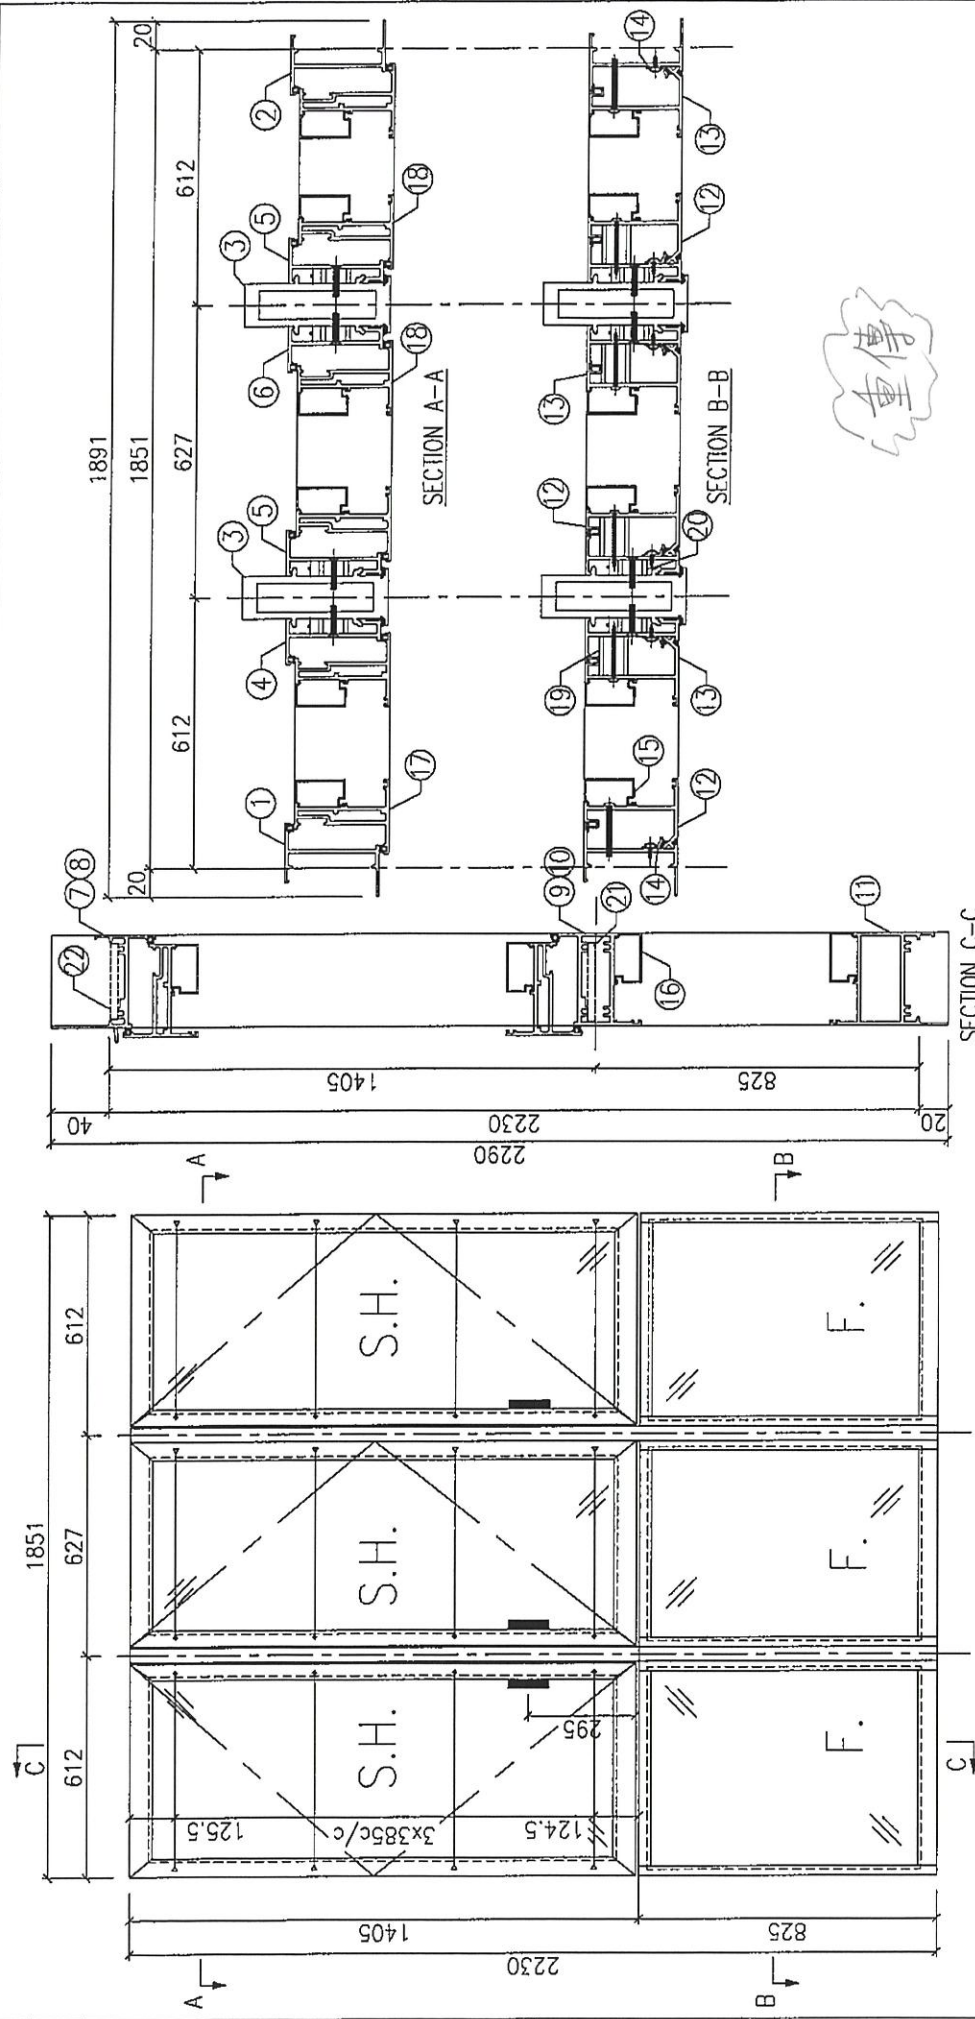

重傳

序号	加工图编号	材料名称	长度	支/幅
6	X85683-04RB	生夹企	2290	1
5	X85683-03LB	生夹企	2290	2
4	X85683-03RB	生夹企	2290	1
3	X85684-06B	夹框通	2290	2
2	X85679-06RB	生边企	2290	1
1	X85679-06LB	生边企	2290	1

序号	加工图编号	材料名称	长度	支/幅
12	X85681-01L	反拍线	762.5	3
11	X85688-02A	槽底球	571	3
10	X85689-01RA	上生下窗中横	571	2
9	X85689-01LA	上生下窗中横	571	1
8	X85685-01RD	生顶横	583	2
7	X85685-01LD	生顶横	583	1

序号	加工图编号	材料名称	长度	支/幅
18	J851-SH07R	塑玉小组球571x1385.5	1385.5	2
17	J851-SH07L	塑玉小组球571x1385.5	1385.5	1
16	X856780	方玻璃线球	472.5	6
15	X856780	方玻璃线企	763	6
14	X84545-01A	反拍线线胶剂	760.5	6
13	X85681-01R	反拍线	762.5	3

序号	加工图编号	材料名称	长度	支/幅
22	J851-LM06	不锈钢丝母巴	25	9
21	J851-LM05	不锈钢丝母巴	390	3
20	J851-LM12	铝漆通	10.5	32
19	J851-LM11	铝漆通	27.5	18



门窗组裝图

Checked: KEN Date: 25-02-2020

Project No: J851 Drawn: W.E.X

Project Name: 青衣190

Shop Drawing No: PRE-CAST ALUM. WINDOW & LOUVRE

Rev: --

Material: UCT534193SC-3

Finish: --

Quantity: 2

Tolerance: ±0.5


Projector: [Symbol]

Delivery to Rev: [] Date: []

Factory: []

Assembly No: T1-W45

Rev: []

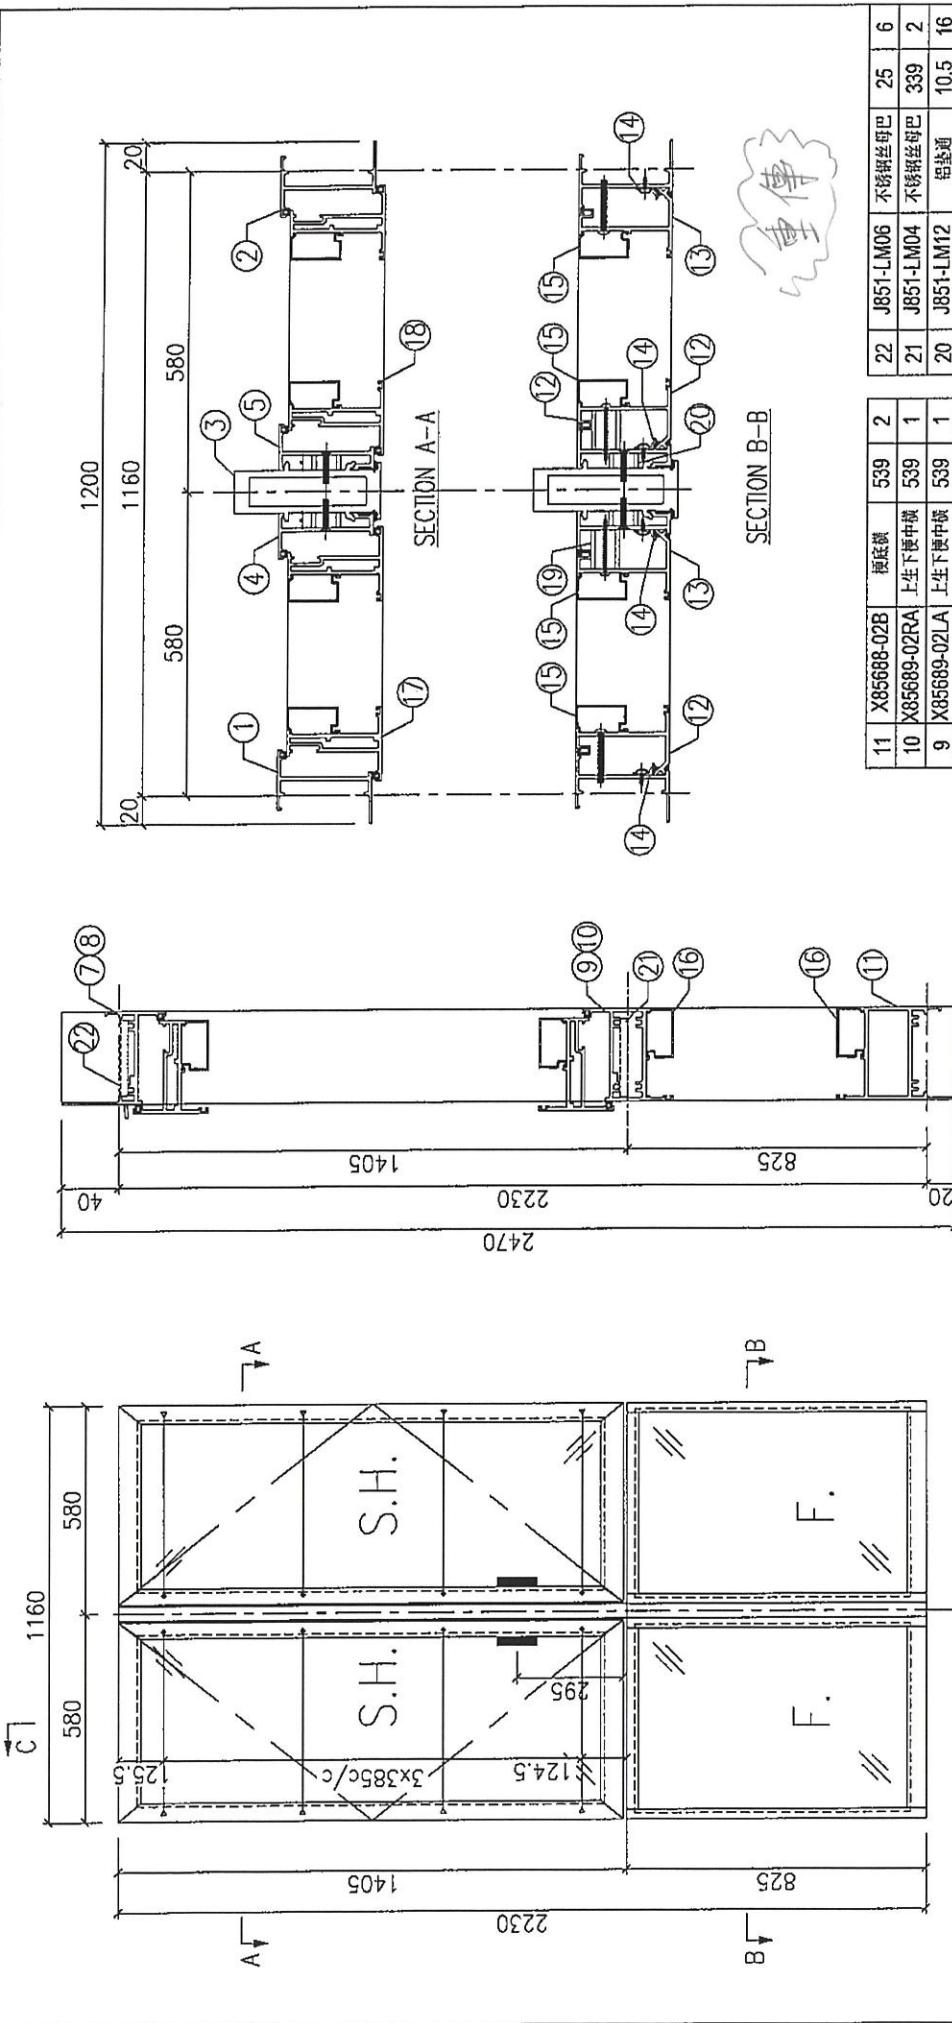

序号	加工图编号	材料名称	长度	支/幅
10	X85689-02RA	上生下滑中横	539	1
9	X85689-02LA	上生下滑中横	539	1
8	X85685-02RB	生顶横	551	1
7	X85685-02LB	生顶横	551	1
6	-	-	-	-
5	X85683-03LB	生夹企	2290	1
4	X85683-03RB	生夹企	2290	1
3	X85684-06B	夹框通	2290	1
2	X85679-06RB	生边企	2290	1
1	X85679-06LB	生边企	2290	1
22	J851-LM06	不锈钢丝母巴	25	6
21	J851-LM04	不锈钢丝母巴	339	2
20	J851-LM12	铝垫通	10.5	16
19	J851-LM11	铝垫通	27.5	12
18	J851-SH09R	窗玉小组装545x1385.5	1	1
17	J851-SH09L	窗玉小组装545x1385.5	1	1
16	X856780	方玻璃胶条	440.5	4
15	X856780	方玻璃胶条	763	4
14	X84545-01A	反扣铝胶条	760.5	4
13	X85681-01R	反扣胶条	762.5	2
12	X85681-01L	反扣胶条	762.5	2

Remarks:

Checked: KEN
 Date: 25-02-2020
 Drawn: W.E.X
 Date: 25-02-2020

Project Name: 青衣190
 Project No. J851
 Rev. -


Shop Drawing No. PRE-CAST ALUM. WINDOW & LOUVRE
 T:\JobsV-851V_铝料、配件、玻璃、加工图组\工.预组窗\铝料加工图\20200302\J851预组窗组装图.dwg

Description: 门窗组装图
 Material: 4+4
 Tolerance: ±0.5
 Finish: UCT534193SC-3

Delivery to	Rev.	Date	Amendments
Factory			
Site			

Assembly No. T1-W46/T2-W46
 Rev. -
 MIDJ Aluminium Fabricator Ltd.

FABRICATION DRAWING

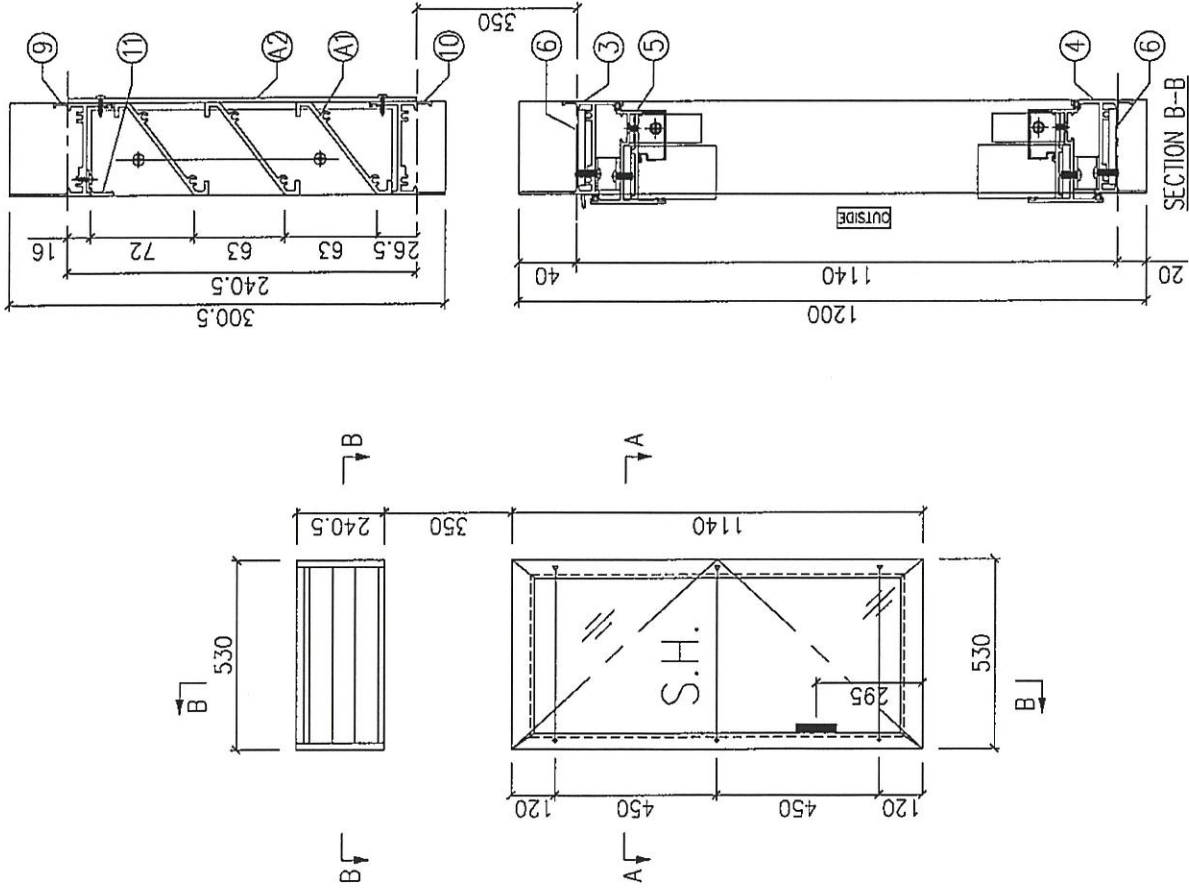

11	X84489-01G	百叶滴水线	490	1
10	X85687-06G	百叶底膜	504	1
9	X85697-01G	百叶顶膜	504	1
8	X85679-09R	生边企	300.5	1
7	X85679-09L	生边企	300.5	1

6	J851-LM06	不锈钢压母	25	6
5	J851-SH19R	碧玉小组装50x1120	1	1
4	X85687-04RE	生成膜	504	1
3	X85685-02RE	生成膜	516	1
2	X85679-03LB	生边企	1200	1
1	X85679-02RD	生边企	1200	1

A3	J851-LM09	铝垫块(10x10x3)	4	送佛
A2	LV-P01-09	百叶背板50Lx240	1	沙扬
A1	LV-S02-07	百叶至497x207.5	1	

重傳

Remarks:

Checked: KEN
Date: 25-02-2020
Project No. J851
Shop Drawing No. PRE-CAST ALUM. WINDOW & LOUVRE
T:\JobsV-851V. 铝料、配件、玻璃、加工圖紙\1. 预制窗\铝料加工圖\20200302\851预制窗铝料图.dwg




Description: 门窗组装图
Material: W.E.X
Date: 25-02-2020
Finish: UCT53419JSC-3

Quantity: 1
Tolerance: ±0.5
Projection:

Delivery to: 1
Factory:

Assembly No. T1-W38A
Rev. -

MIDI Aluminium Fabricator Ltd.

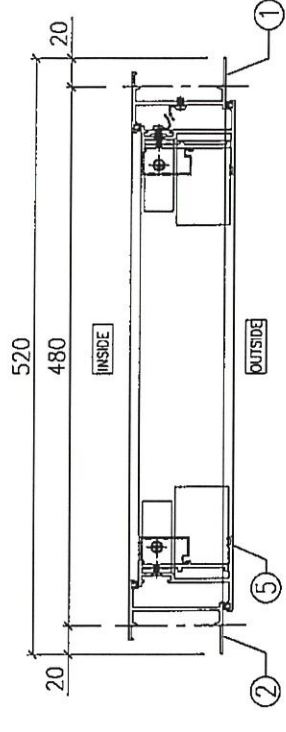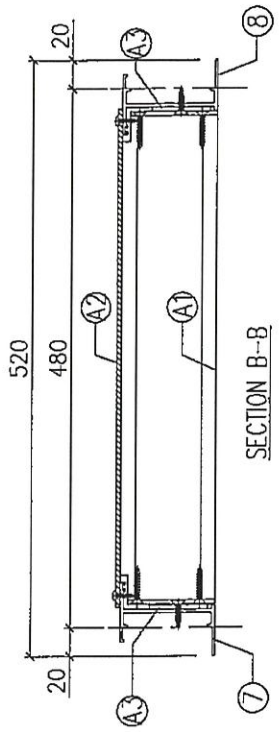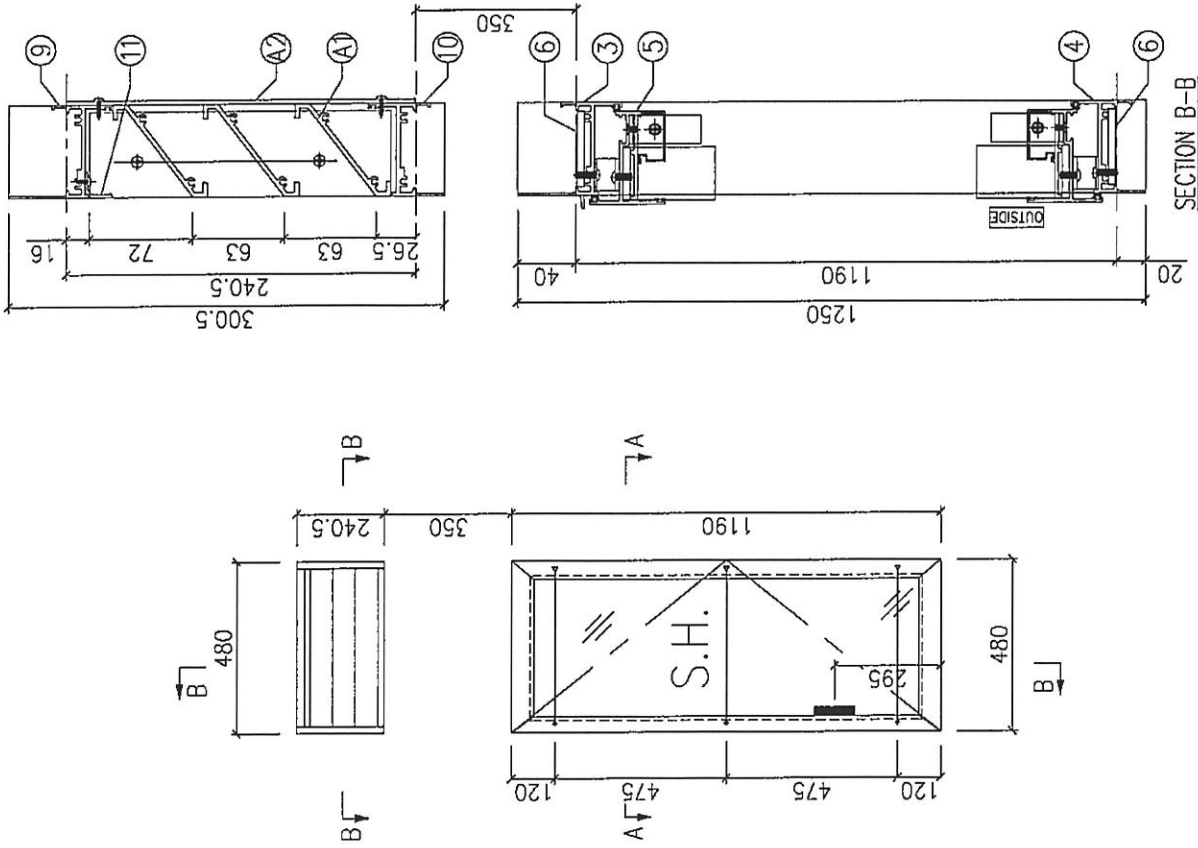

重傳

11	X84489-01F	百叶滴水线	440	1
10	X85687-06F	百叶底横	454	1
9	X85697-01F	百叶顶横	454	1
8	X85679-09R	生边企	300.5	1
7	X85679-09L	生边企	300.5	1

6	J851-LM06	不锈钢螺母巴	25	6
5	J851-SH11R	碧玉小组装60x1170		1
4	X85687-04RD	生边横	454	1
3	X85685-02RC	生顶横	466	1
2	X85679-03LA	生边企	1250	1
1	X85679-02RB	生边企	1250	1
序号	加工图编号	材料名称	长度	支/幅

A3	J851-LM09	铝垫块(10x10x3)	4	送牌
A2	LV-P01-08	百叶背板451x240	1	沙场
A1	LV-S02-06	百叶至447x207.5	1	
序号	加工图编号	材料名称	只/幅	说明

Remarks:

Checked: KEN
Date: 25-02-2020
Drawn: WEX
Date: 25-02-2020

Project No. J851
Rev. -

Shop Drawing No. PRE-CAST ALUM. WINDOW & LOUVRE
青衣190


Description: 门窗组装修图
Material: UCT5341935C-3
Finish: WEX

Quantity: 1+1+2
Tolerance: ±0.5
Projection:

Delivery to: Factory
Site

Assembly No. T1-W64/T1-W66/T2-W64
Rev. -

FABRICATION DRAWING

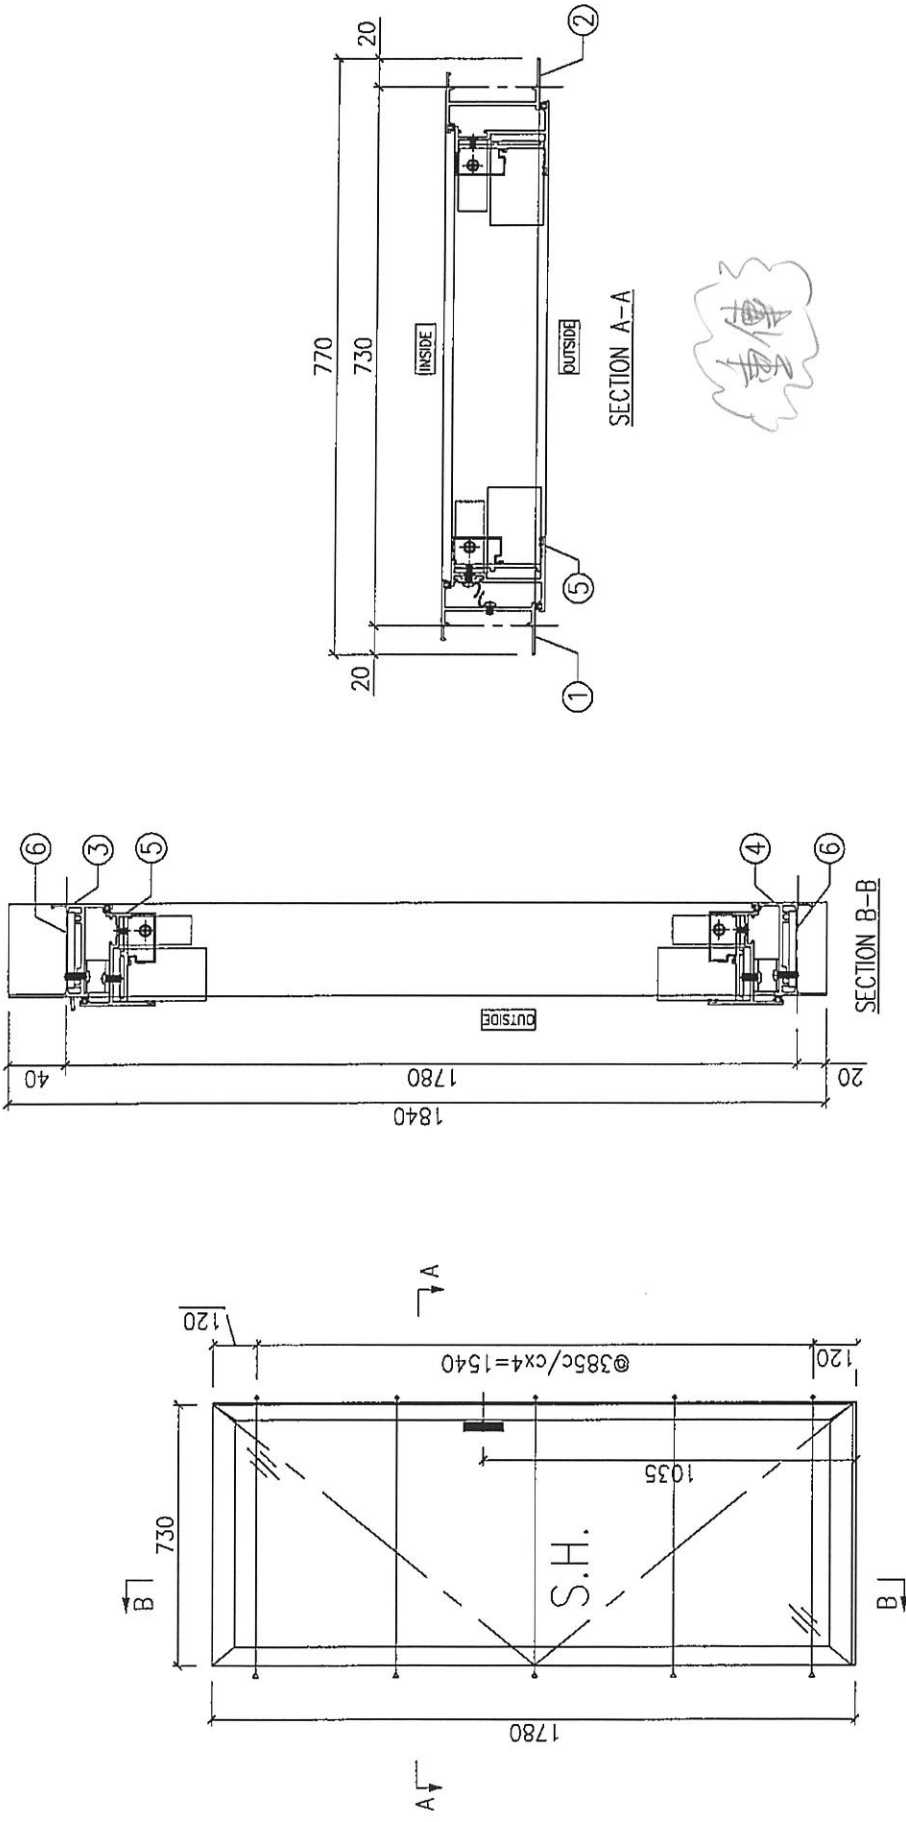


專傳


6	J851-LM06	不锈钢螺母	25	6
5	J851-SH18L	窗五小组套710x1780	1	1
4	X85687-03LH	生底横	704	1
3	X85685-01LK	生顶横	716	1
2	X85679-03RF	生边企	1840	1
1	X85679-02LJ	生边企	1840	1
序号	加工图编号	材料名称	长度	支/幅

Remarks:	Checked: KEN		Description:	Assembly No.
Project Name:	Project No. J851	Date: 25-02-2020	Material:	T2-W72/T2-W73A
Shop Drawing No. PRE-CAST ALUM. WINDOW & LOUVRE	Drawn: W.E.X	Date: 25-02-2020	Finish:	Rev. -
青衣190		门窗组裝图		Site
PRE-CAST ALUM. WINDOW & LOUVRE		Material:	Quantity: 27+2	Rev.
T:\Jobs\1-851Y-鋁料、配件、玻璃、加工圖紙\1.預制窗\鋁料加工圖\20200302\851預制窗組裝圖.dwg		Tolerance: ±0.5	Projection:	
		Finish:		
		Factory		
		Delivery to		
		Date		

FABRICATION DRAWING

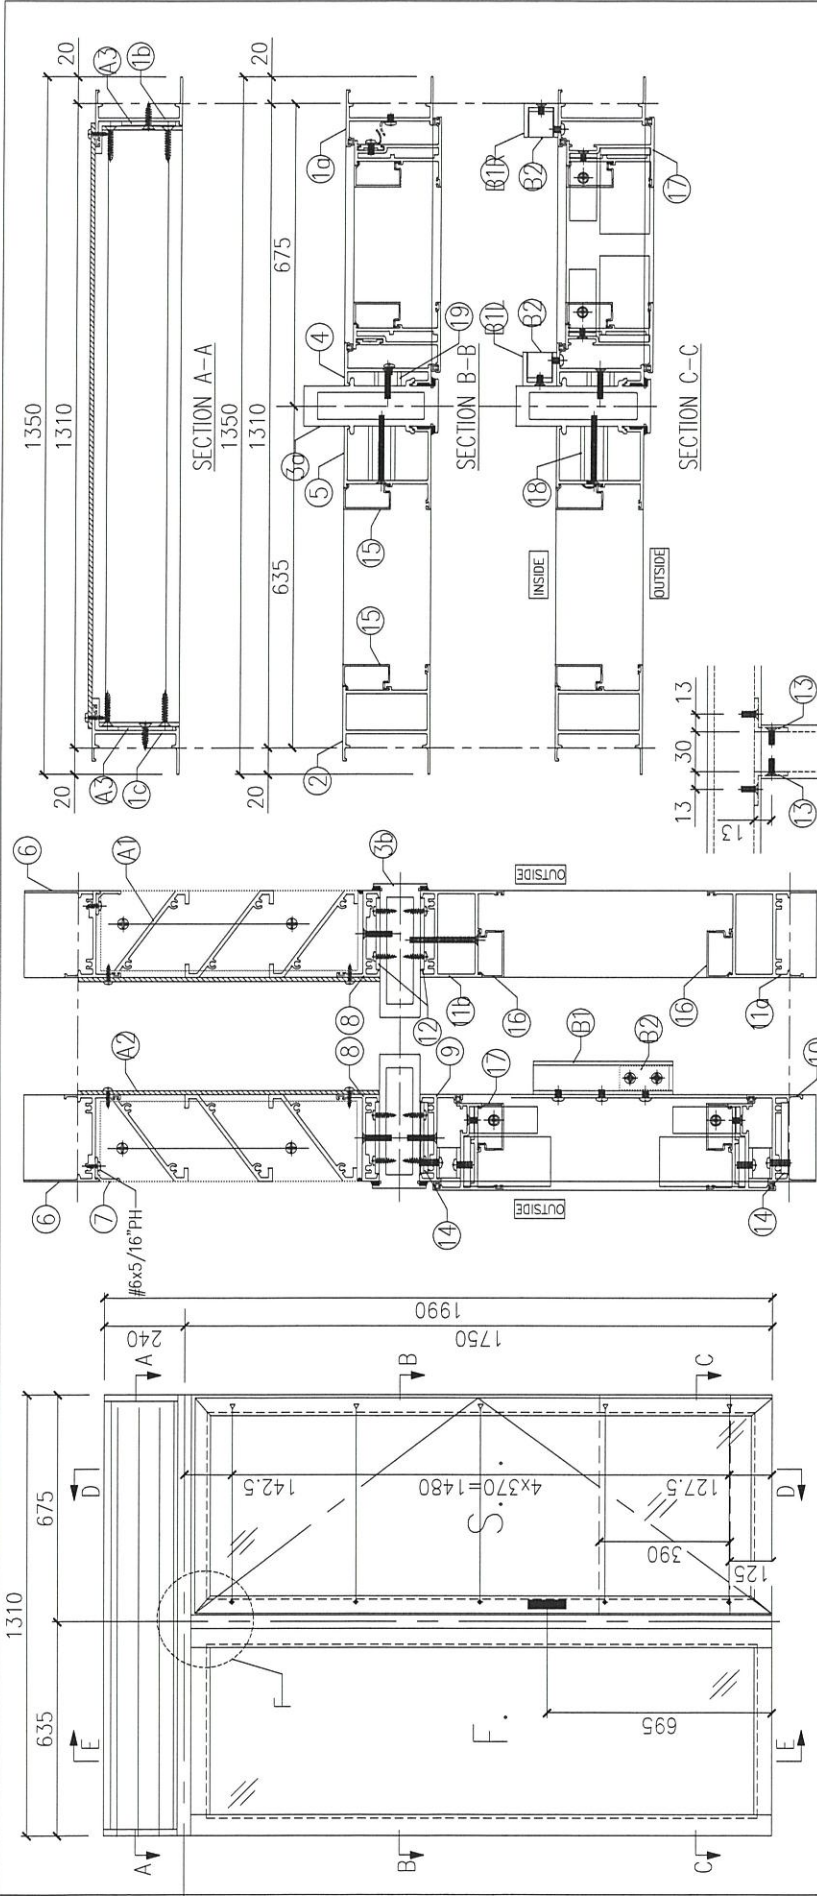

序号	加工图编号	材料名称	长度	支/幅
7	X84489-01A	百叶滴水线	1270	1
6	X85697-01A	百叶内槽	1284	1
5	X85682-01RA	榫夹企	1755	1
4	X85683-01LA	生夹企	1755	1
3b	X85684-03R	夹框通	1350	1
3a	X85684-01RA	夹框通	1755	1
2	X85677-01LA	榫边企	1755	1
1c	X85679-08L	生边企	265	1
1b	X85679-08R	生边企	265	1
1a	X85679-01RA	生边企	1755	1

序号	加工图编号	材料名称	长度	支/幅
15	X856780	方玻璃线企	1642.5	2
14	J851-LM06	不锈钢螺母	25	6
13	J851-LM16	组装铝角	53.5	2
12	J851-LM15	铝限位巴	53.5	8
11b	X85688-03A	榫底槽(顶)	534	1
11a	X85688-01A	榫底槽	534	1
10	X85687-03RB	生底槽	634	1
9	X85687-01RA	生底槽(顶)	634	1
8	X85687-02A	生底槽	1284	1

序号	加工图编号	材料名称	长度	支/幅
18	J851-LM10	铝垫通	40.5	6
17	J851-SH01R	留玉小组装(0x1715)	1	1
19	J851-LM12	铝垫通	10.5	6
16	X856780	方玻璃线企	495.5	2

序号	加工图编号	材料名称	长度	支/幅	说明
A3	J851-LM09	铝垫块(40x40x3)	4	4	送佛
A2	LV-P01-01	百叶背板(1281x225)	1	1	沙场
A1	LV-S01-01	百叶玉(127x192)	1	1	

序号	加工图编号	材料名称	长度	支/幅	说明
B2	J851-LM14	铝角	18	2	
B1R	J851-LM13R	安全玻璃铝槽	401	1	组装后送现场
B1L	J851-LM13L	安全玻璃铝槽	401	1	

Remarks:

Checked: KEN
Date: 25-02-2020
Material: 门窗组装机


Project No. J851
Shop Drawing No. 青衣190
PRE-CAST ALUM. WINDOW & LOUVRE

Delivery to Rev. 84+81
Factory
Tolerance: ±0.5
Projection:

Assembly No. T1-W2(MIR)/T2-W2(MIR)
Rev. -

MIDJ Aluminium Fabricator Ltd.

FABRICATION DRAWING

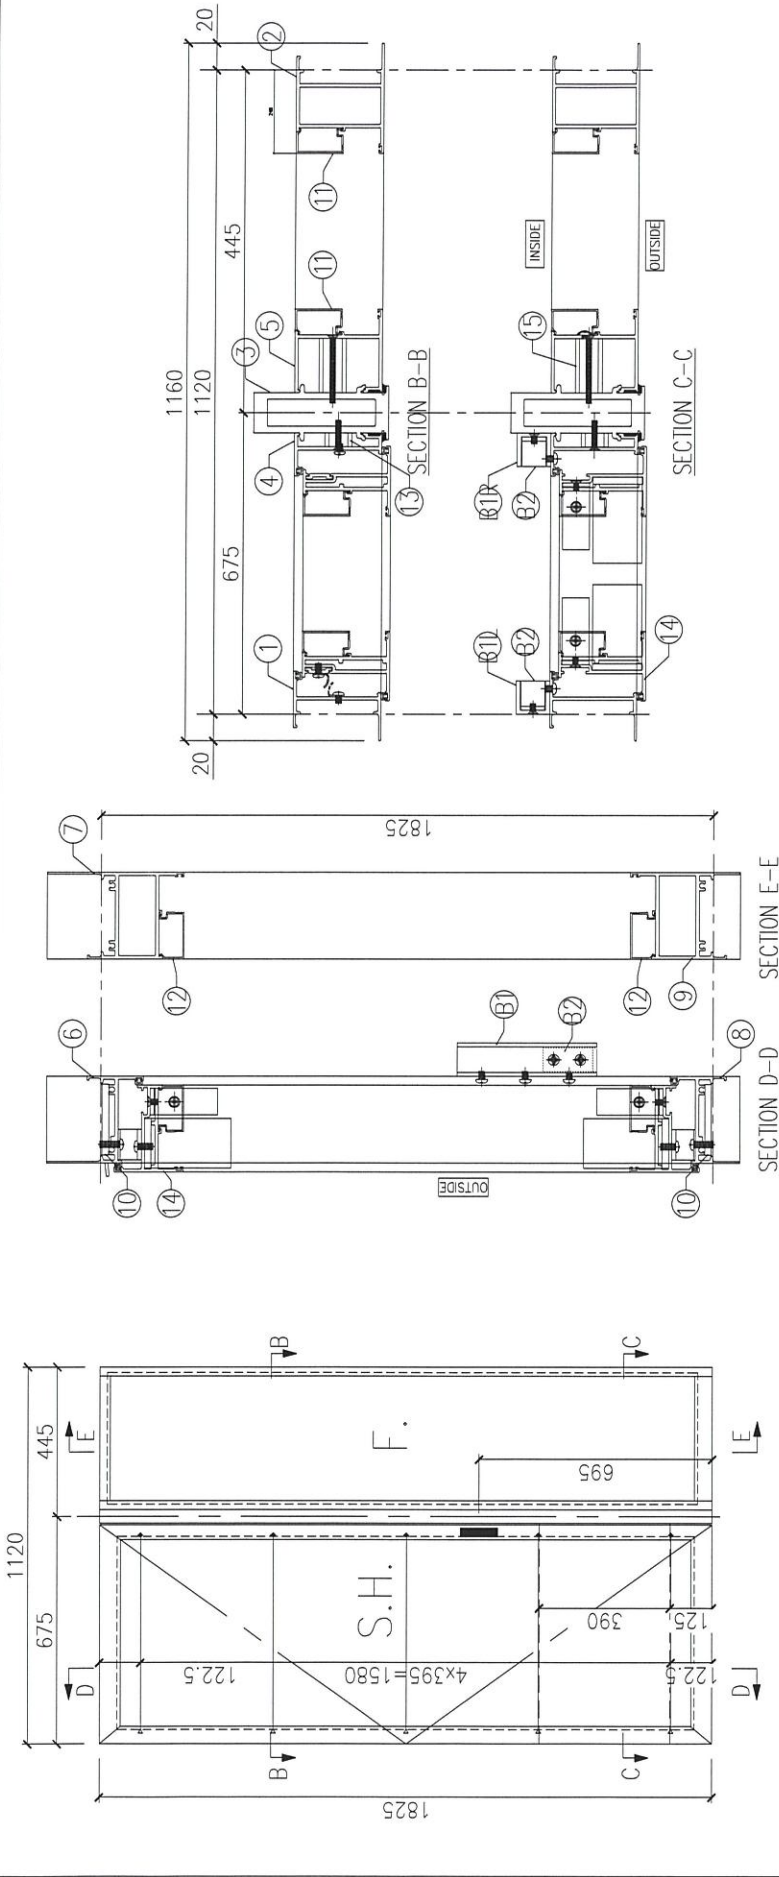

序号	加工图编号	材料名称	长度	支/幅
10	J851-LM06	不锈钢丝母巴	25	6
9	X85688-01D	框底横	344	1
8	X85687-03LB	生底横	634	1
7	X85686-01D	框顶横	344	1
6	X85685-01LB	生顶横	646	1
5	X85682-02LA	框夹企	1885	1
4	X85683-02RA	生夹企	1885	1
3	X85684-02A	夹框通	1885	1
2	X85677-02RA	框边企	1885	1
1	X85679-02LA	生边企	1885	1

序号	加工图编号	材料名称	长度	支/幅
15	J851-LM10	铝垫通	40.5	7
14	J851-SH03L	窗玉小组装60X1805	1	1
13	J851-LM12	铝垫通	10.5	7
12	X856780	方玻璃线横	305.5	2
11	X856780	方玻璃线企	1732.5	2

序号	加工图编号	材料名称	长度	支/幅	说明
B2	J851-LM14	铝角	18	2	框玻璃
B1R	J851-LM13R	安全玻璃铝槽	401	1	选槽垫
B1L	J851-LM13L	安全玻璃铝槽	401	1	

Remarks:

Checked: KEN Date: 25-02-2020

Project No. J851

Project Name: 青衣190

Shop Drawing No. PRE-CAST ALUM. WINDOW & LOUVRE

Description: 门窗组装修

Material: 25-02-2020

Drawn: W.E.X

Finish: UCT534193SC-3

Quantity: 27+2

Tolerance: ±0.5

Delivery to Rev. Date

Factory




Site

Assembly No. T2-W3(MIR)/T2-W33(MIR)

Rev.

MIDI-Aluminium Fabricator Ltd.

FABRICATION DRAWING

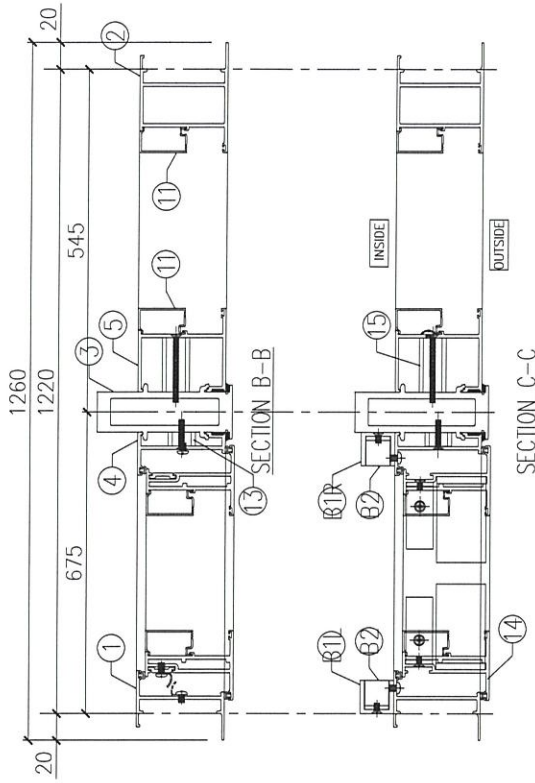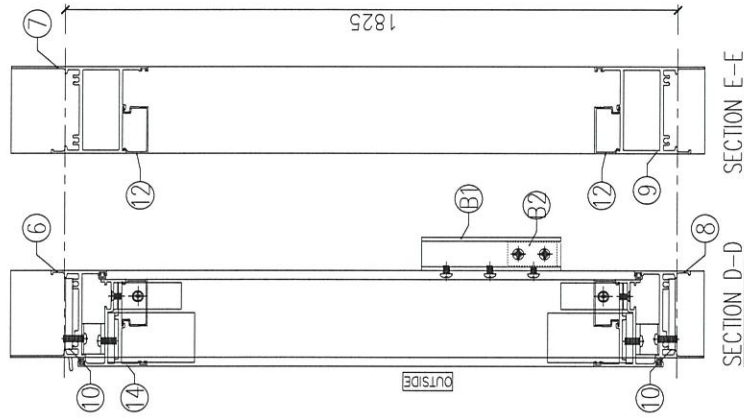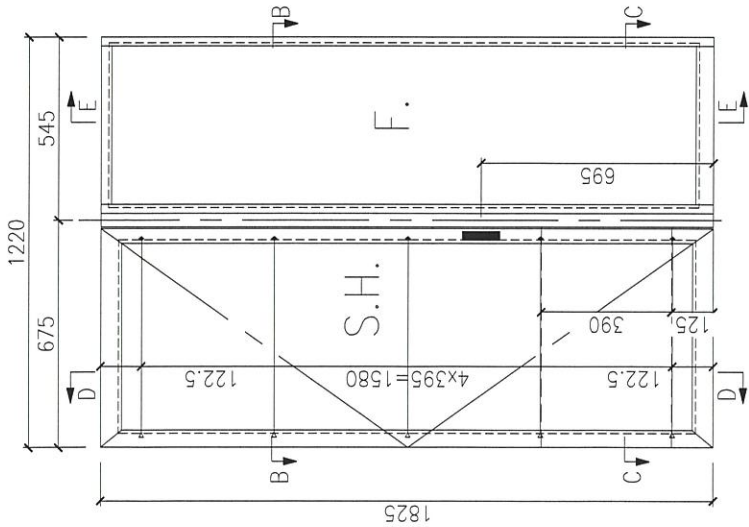

10	J851-LM06	不锈钢丝母巴	25	6
9	X85688-01G	衬底撑	444	1
8	X85687-03LB	生底撑	634	1
7	X85686-01G	衬顶横	444	1
6	X85685-01LB	生顶横	646	1
5	X85682-02LA	衬夹企	1885	1
4	X85683-02RA	生夹企	1885	1
3	X85684-02A	衬框通	1885	1
2	X85677-02RA	衬边企	1885	1
1	X85679-02LA	生边企	1885	1
序号	加工图编号	材料名称	长度	支/幅

15	J851-LM10	铝垫通	40.5	7
14	J851-SH03L	窗玉小组装扣(1805)		1
13	J851-LM12	铝垫通	10.5	7
12	X856780	方玻璃线横	405.5	2
11	X856780	方玻璃线企	1732.5	2
序号	加工图编号	材料名称	长度	支/幅

B2	J851-LM14	铝角	18	2
B/R	J851-LM13R	安全玻璃铝槽	401	1
B/L	J851-LM13L	安全玻璃铝槽	401	1
序号	加工图编号	材料名称	长度	支/幅

Remarks:

Project Name: 青衣190

Shop Drawing No. PRE-CAST ALUM. WINDOW & LOUVRE

Project No. J851

Rev. -

Checked: KEN

Date: 25-02-2020

Material: 27+2

Drawn: W.E.X

Tolerance: ±0.5

Finish: UCT534193SC-3

Projection:

Site:

Delivery to:

Date:

Amendments:

Assembly No. T2-W7(MIR)/T2-W37(MIR)

Rev. -

门窗组裝图

Description:

Material:

Finish:

Project No.:


Rev.:

Amendments:

Rev.:

T2-W7(MIR)/T2-W37(MIR)

FABRICATION DRAWING

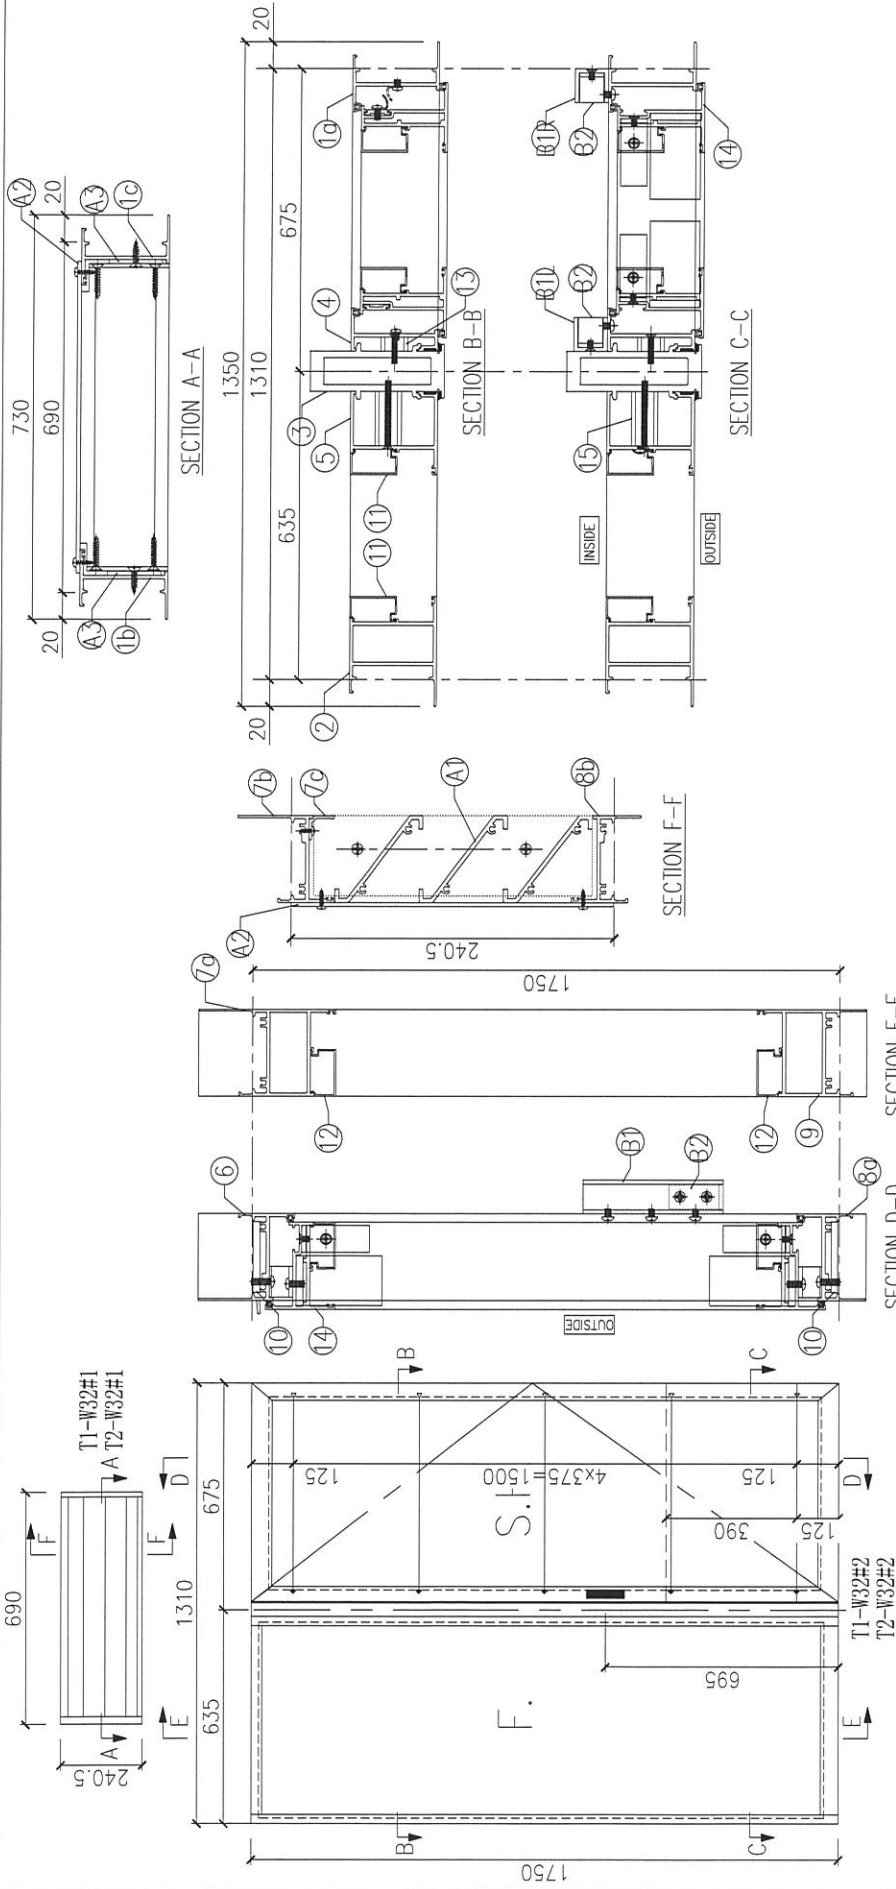

序号	加工图编号	材料名称	长度	支/幅
5	X85682-02RB	楔夹企	1810	1
4	X85683-02LB	生夹企	1810	1
3	X85684-02B	夹框通	1810	1
2	X85677-02LC	框通企	1810	1
1c	X85679-09R	生边企	300.5	1
1b	X85679-09L	生边企	300.5	1
1a	X85679-02RC	生边企	1810	1

序号	加工图编号	材料名称	长度	支/幅
9	X85688-01A	框底横	534	1
8b	X85687-06A	生底横	664	1
8a	X85687-03RB	生底横	634	1
7c	X84489-01L	百叶滴水线	650	1
7b	X85697-01L	百叶顶横	664	1
7a	X85686-01A	框顶横	534	1
6	X85685-01RB	生顶横	646	1

序号	加工图编号	材料名称	长度	支/幅
15	J851-LM10	铝垫通	40.5	7
14	J851-SH04R	铝玉小孔垫板(40x1730)	1730	1
13	J851-LM12	铝垫通	10.5	7
12	X856780	方玻璃垫圈	495.5	2
11	X856780	方玻璃垫圈	1657.5	2
10	J851-LM06	不锈钢螺母巴	25	6

序号	加工图编号	材料名称	只/幅	说明
A3	J851-LM09	铝垫块(40x40x3)	4	送佛
A2	LV-P01-14	百叶背板(661x240)	1	沙场
A1	LV-S02-11	百叶玉(657x207.5)	1	

序号	加工图编号	材料名称	长度	支/幅	说明
B2	J851-LM14	铝角	18	2	组装后
B1R	J851-LM13R	安全玻璃铝槽	401	1	送地盘
B1L	J851-LM13L	安全玻璃铝槽	401	1	

Remarks:

Project Name: 青衣190

Project No.: J851

Shop Drawing No.: PRE-CAST ALUM. WINDOW & LOUVRE

Rev: -

Checklist: KEN

Date: 25-02-2020

Drawn: W.E.X

Material: 3+3

Tolerance: ±0.5

Factory: 3+3

Delivery to Rev. Date: 3+3

Amendments:







序号	加工图编号	材料名称	长度	支/幅	说明
T1	W32#1	T1-W32(MIR)/T2-W32(MIR)			
T2	W32#2				

Assembly No.: T1-W32(MIR)/T2-W32(MIR)

Rev: -

Site: MIDAL Aluminium Fabricator Ltd.

FABRICATION DRAWING

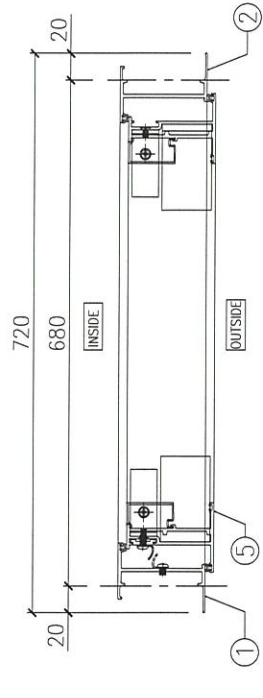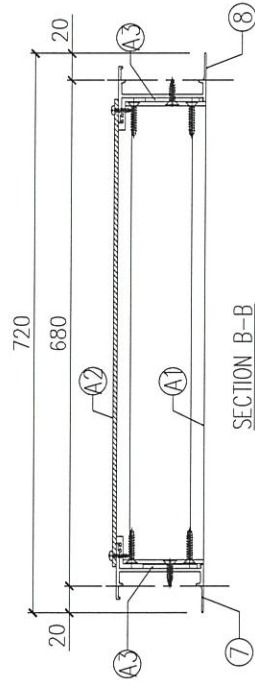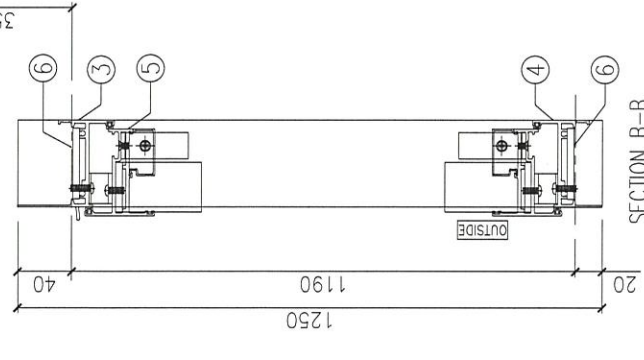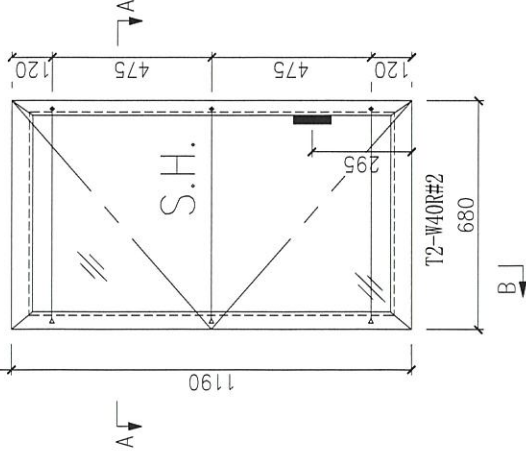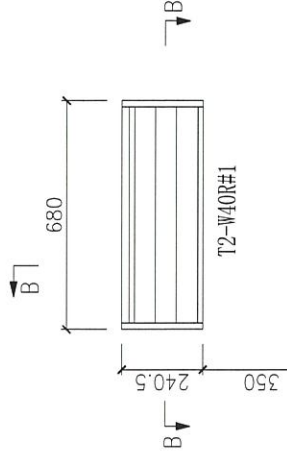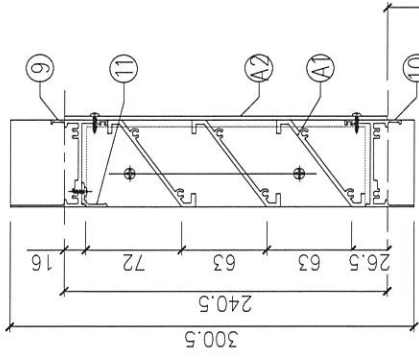

Remarks:		Description: 门窗组装图		Checklist: KEN		Date: 25-02-2020		Project No. J851	
Project Name: 青衣190		Material: UCT534193SC-3		Drawn: W.E.X		Date: 25-02-2020		Rev. -	
Shop Drawing No. PRE-CAST ALUM. WINDOW & LOUVRE		Finish: UCT534193SC-3		Tolerance: ±0.5		Factory: 2		Site: T2-W40(MIR)	
Assembly No. -		Projection: 1:1		Delivery to Rev. -		Date -		Rev. -	

序号	加工图编号	材料名称	只/幅	说明
A3	J851-LM09	铝漆块 (40x40x3)	4	送佛
A2	LV-P01-04	百叶背板651x210	1	沙场
A1	LV-S02-04	百叶玉617x207.5	1	


11	X84489-01D	百叶滴水线	640	1
10	X85687-06D	百叶底横	654	1
9	X85697-01D	百叶顶横	654	1
8	X85679-09R	生边企	300.5	1
7	X85679-09L	生边企	300.5	1

6	J851-LM06	不锈钢螺母	25	6
5	J851-SH10L	窗玉小组装660x1170	1	1
4	X85687-03LF	生底横	654	1
3	X85685-01LJ	生顶横	666	1
2	X86679-03RA	生边企	1250	1
1	X85679-02LB	生边企	1250	1

序号	加工图编号	材料名称	长度	支/幅
6	J851-LM06	不锈钢螺母	25	6
5	J851-SH10L	窗玉小组装660x1170	1	1
4	X85687-03LF	生底横	654	1
3	X85685-01LJ	生顶横	666	1
2	X86679-03RA	生边企	1250	1
1	X85679-02LB	生边企	1250	1

MIDJ Aluminium Fabricator Ltd.

FABRICATION DRAWING

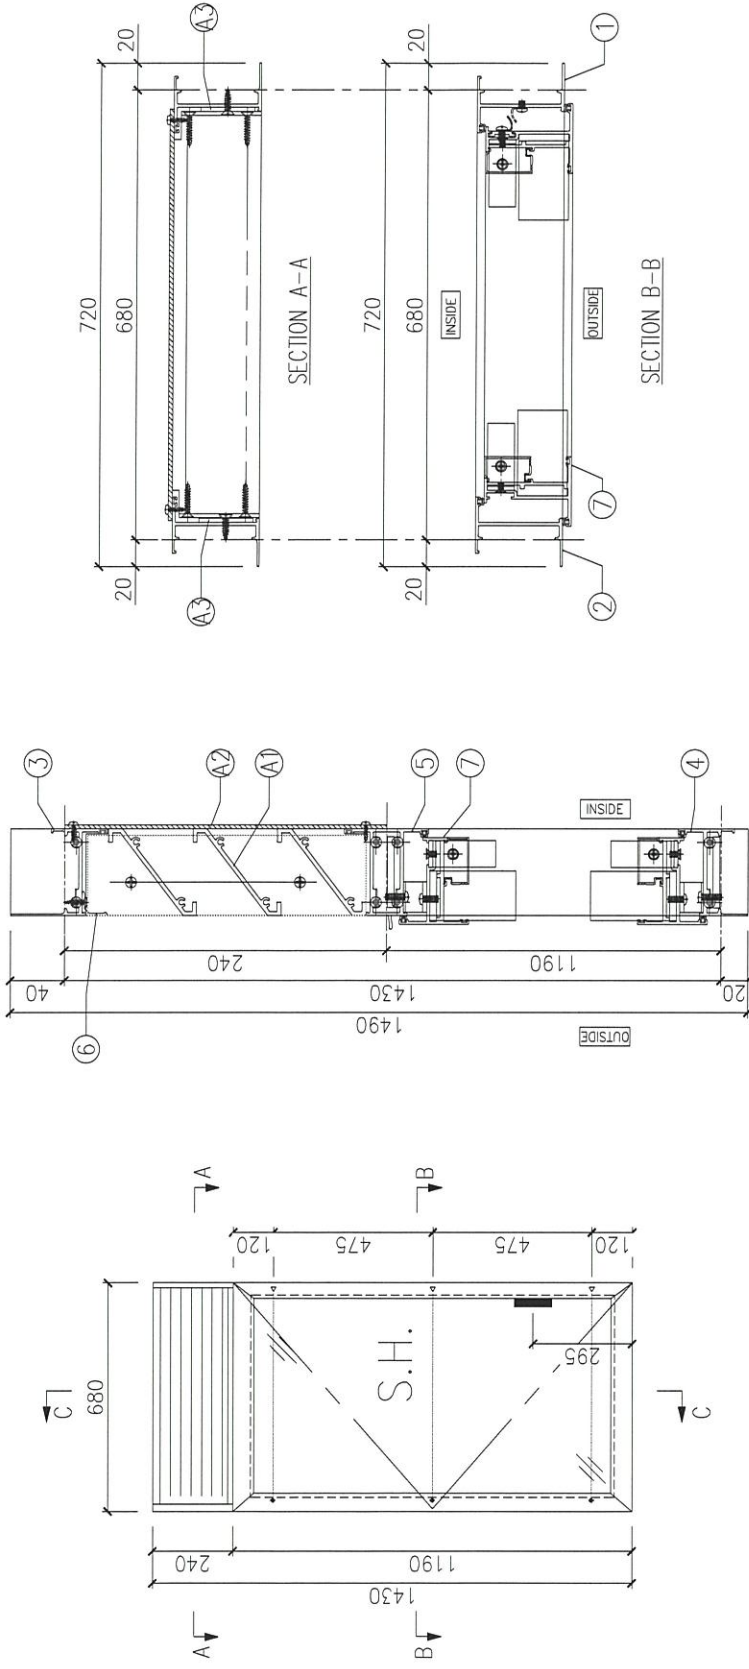

序号	加工图编号	材料名称	长度	支/幅
9	J851-LM06	不锈钢螺母	25	3
8	J851-LM05	不锈钢螺母	390	1
7	J851-SH10L	普玉小组装660x1170	640	1
6	X84489-01D	百叶滴水线	666	1
5	X85690-01LA	上生下生叶横	654	1
4	X85687-03LF	生底横	654	1
3	X85697-01D	百叶顶横	1490	1
2	X85679-04RB	生边企	1490	1
1	X85679-05LB	生边企	1490	1

序号	加工图编号	材料名称	只/幅	说明
A3	J851-LM09	铝垫块(40x40x3)	4	送佛
A2	LV-P01-04	百叶盖板(651x240)	1	沙场
A1	LV-S02-04	百叶玉(647x207.5)	1	

Remarks:

Project Name:	青衣190	Project No.:	J851	Check:	KEN
Shop Drawing No.:	PRE-CAST ALUM. WINDOW & LOUVRE	Date:	25-02-2020	Date:	25-02-2020
		Drawn:	W.E.X	Material:	
		Date:	25-02-2020	Finish:	UCT534193SC-3
		Site:		Assembly No.:	T2-W10(MIR)
		Factory:		Rev.:	-
		Delivery to:		Amendments:	
		Rev.:			


门窗组装箱图

QTY: 54
Tolerance: ±0.5
Projection:

Material: UCT534193SC-3
Finish: UCT534193SC-3

MJD-Aluminium Fabricator Ltd.

FABRICATION DRAWING

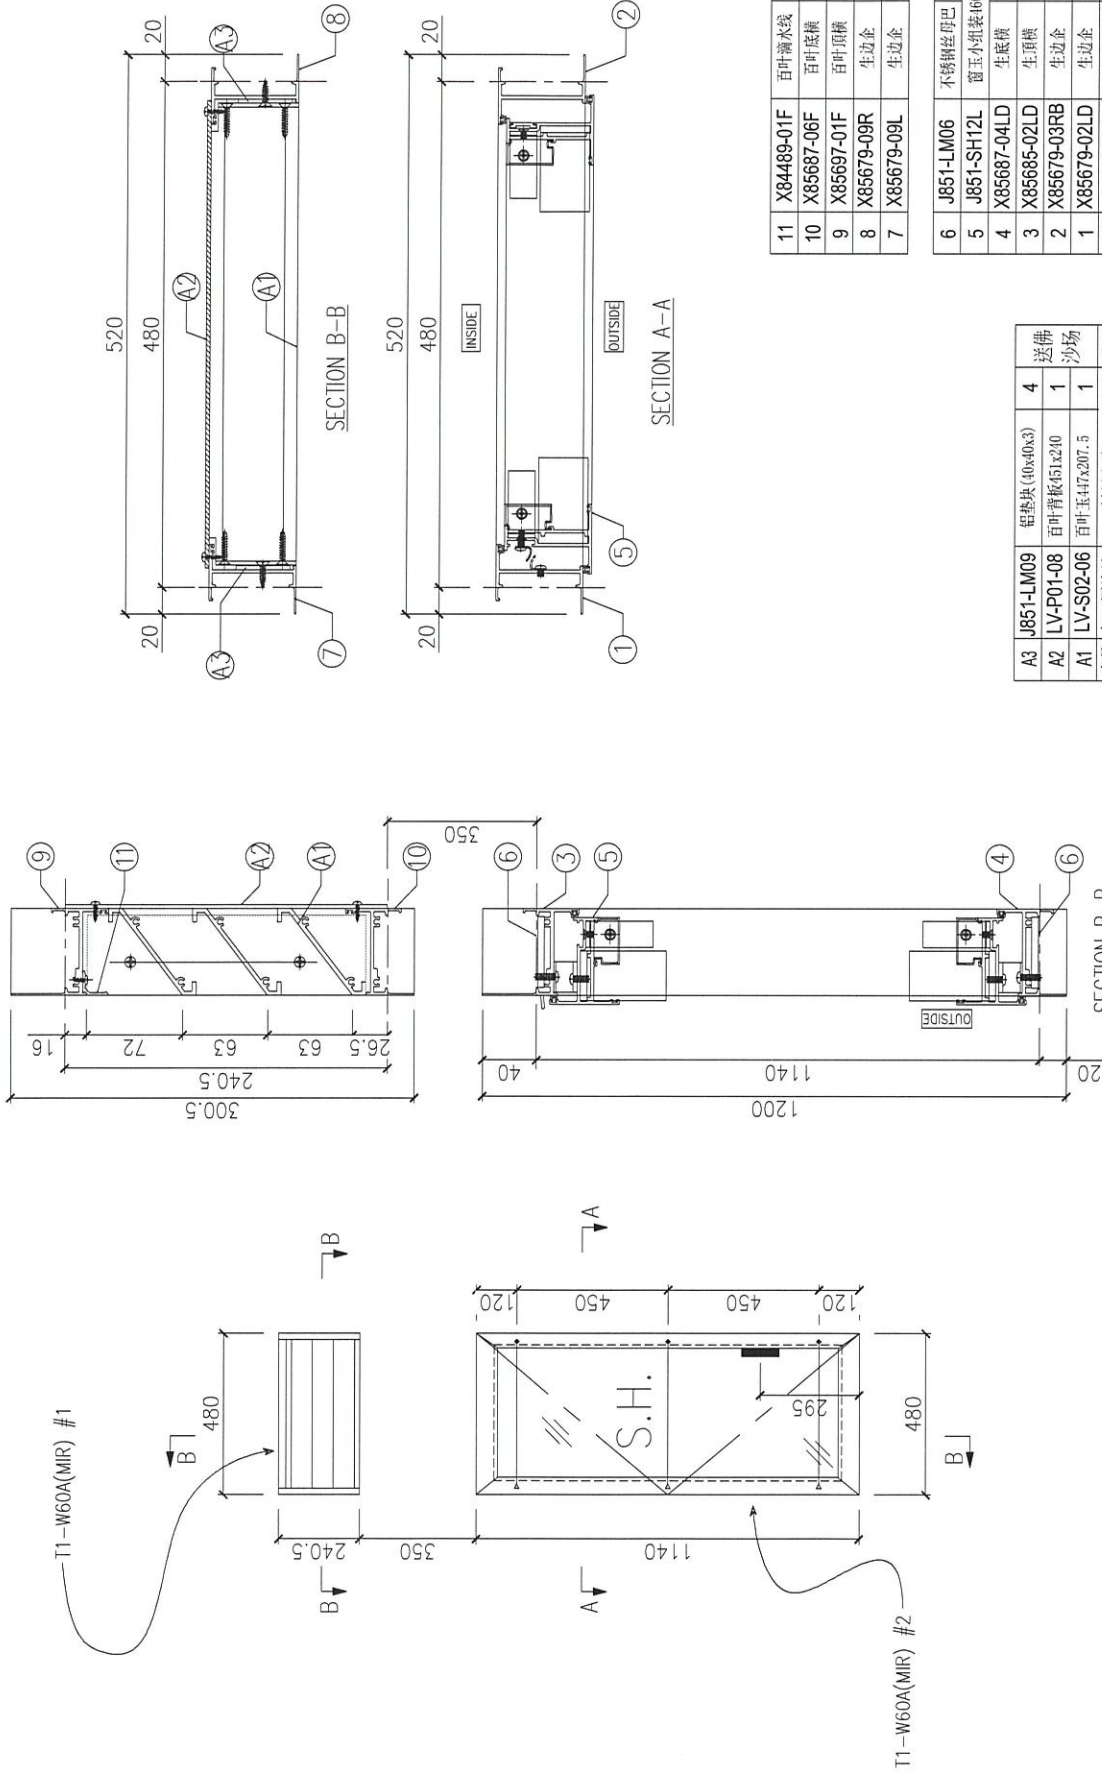

Remarks:		Description: 门窗组装图		Check: KEN		Date: 25-02-2020		Material:	
Project Name: 青衣190		Project No. J851		Drawn: W.E.X		Date: 25-02-2020		Finish: UCT534193SC-3	
Shop Drawing No. PRE-CAST ALUM. WINDOW & LOUVRE		Rev. -		Tolerance: ±0.5		Projection:		Site:	
Assembly No. T1-W60A(MIR)		Rev. -		QTY: 1		Delivery to: Factory		Amendments:	

序号	加工图编号	材料名称	只/幅	说明
A3	J851-LM09	铝垫块 (10x40x3)	4	送佛
A2	LV-P01-08	百叶背板151x210	1	沙场
A1	LV-S02-06	百叶玉447x207.5	1	


11	X84489-01F	百叶滴水线	440	1
10	X85687-06F	百叶底横	454	1
9	X85697-01F	百叶顶横	454	1
8	X85679-09R	生边企	300.5	1
7	X85679-09L	生边企	300.5	1

6	J851-LM06	不锈钢压厚巴	25	6
5	J851-SH12L	留玉小组装160x1120	1	1
4	X85687-04LD	生底横	454	1
3	X85685-02LD	生顶横	466	1
2	X85679-03RB	生边企	1200	1
1	X85679-02LD	生边企	1200	1

序号	加工图编号	材料名称	长度	支/幅
6	J851-LM06	不锈钢压厚巴	25	6
5	J851-SH12L	留玉小组装160x1120	1	1
4	X85687-04LD	生底横	454	1
3	X85685-02LD	生顶横	466	1
2	X85679-03RB	生边企	1200	1
1	X85679-02LD	生边企	1200	1




MIDI-Aluminium Fabricator Ltd.

FABRICATION DRAWING

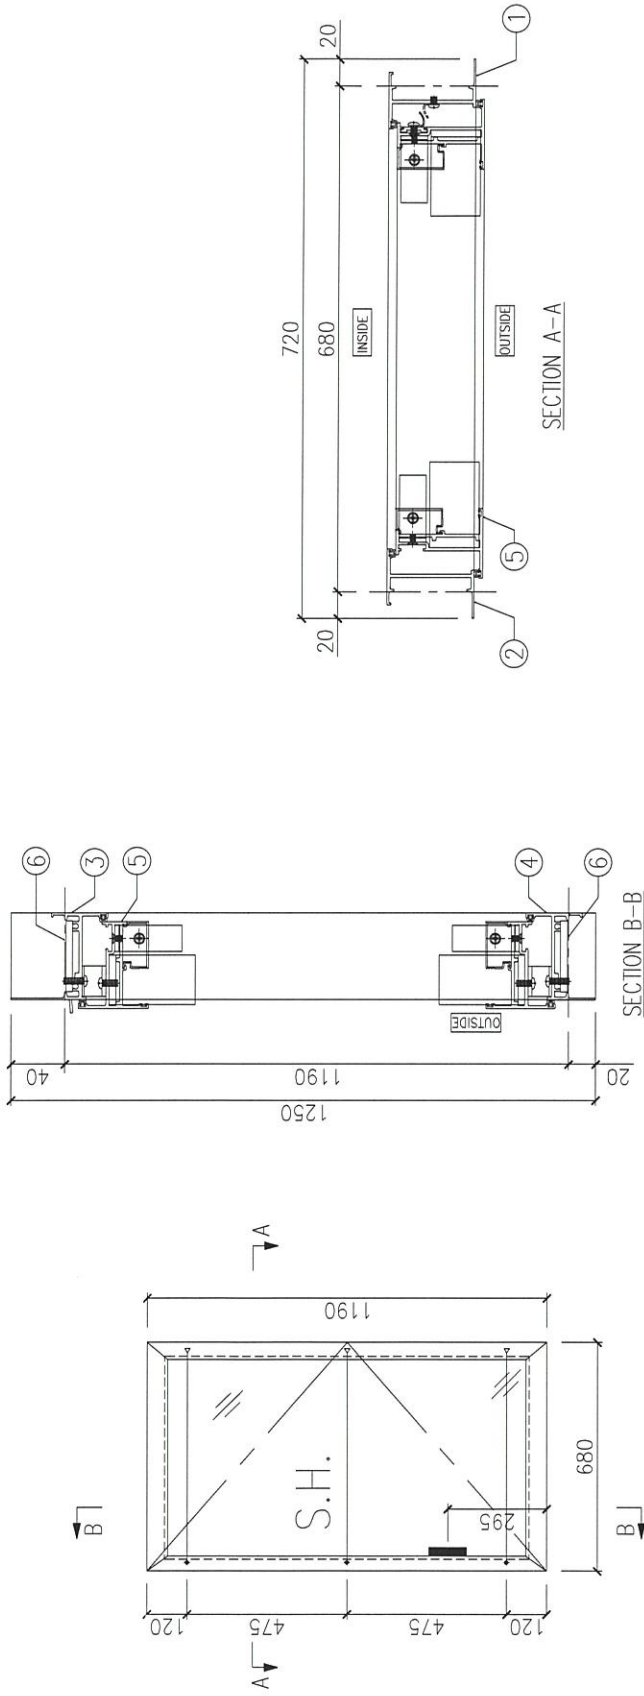

6	J851-LM06	不锈钢丝母巴	25	6
5	J851-SH10R	窗五小组装660x1170	1	1
4	X85687-03RG	生底模	654	1
3	X85685-01RJ	生顶模	666	1
2	X85679-03LA	生边企	1250	1
1	X85679-02RB	生边企	1250	1
	序号	加工图编号	材料名称	长度
			支/框	



Remarks:		Checked: KEN		Description: 门窗组装图		QTY: 27+2		Delivery to Rev.		Date	
Project Name: 青衣190		Date: 25-02-2020		Material:		Tolerance: ±0.5		Factory		Amendments	
Shop Drawing No. PRE-CAST ALUM. WINDOW & LOUVRE		Drawn: W.E.X		Finish: UCT534193SC-3		Projection:		Site		Assembly No. T2-W22(MIR)/T2-W52(MIR)	
Rev. -		Date: 25-02-2020								Rev. -	
MIDI Aluminium Fabricator Ltd.											

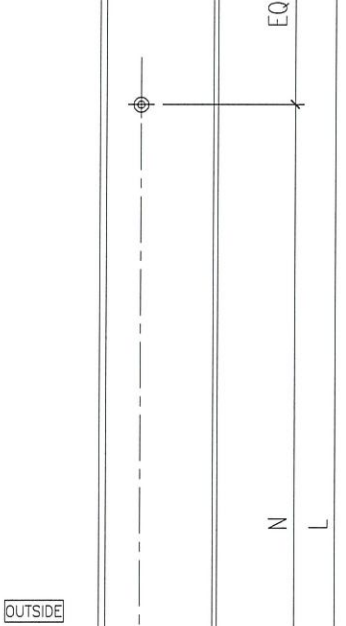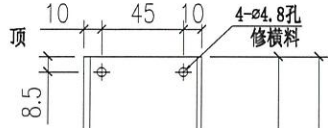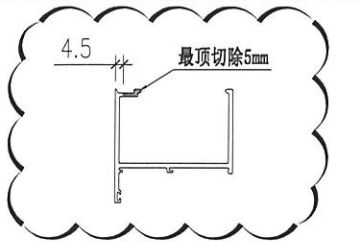




OUTSIDE



ø5.2平头孔
修夹通

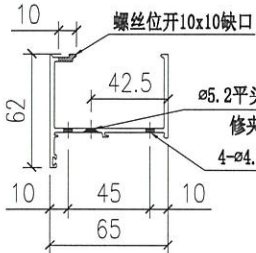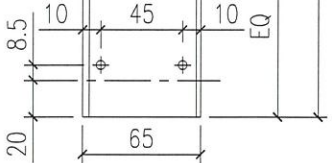



2	X85682-01LB	1655	5x300c/c
1	X85682-01LA	1755	5x300c/c
序号	部件编号	L	N

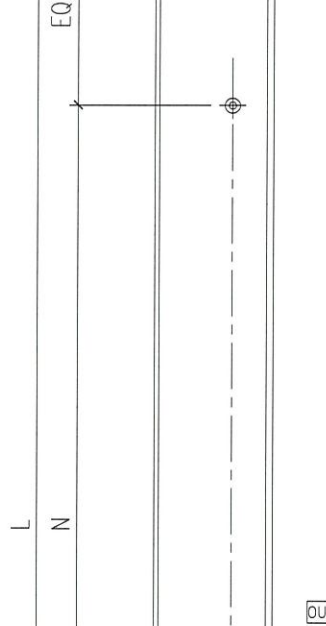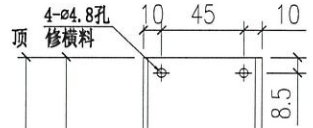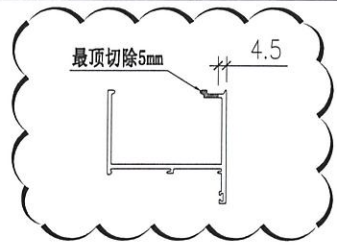

OUTSIDE







ø5.2平头孔
修夹通

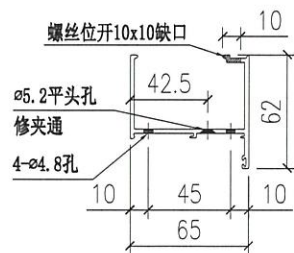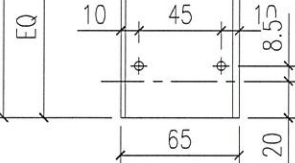

1	X85682-01RA	1755	5x300c/c
序号	部件编号	L	N

Remarks:		Checked: KEN		Description: 榭夹企, X856822		QTY: -		Delivery to: (Factory)		Date:		Amendments:	
Project Name: 青衣190		Date: 22-12-2014		Material: 6061-T6		Tolerance: ±0.5		Site: (Factory)		Rev.:			
Shop Drawing No. PRE-CAST ALUM. WINDOW & LOUVER		Project No. J851		Finish: UC1534193SC-3		Projection: (Symbol)		Assembly No. X85682-01		Rev. B			
		Date: 22-12-2014		W.E.X									

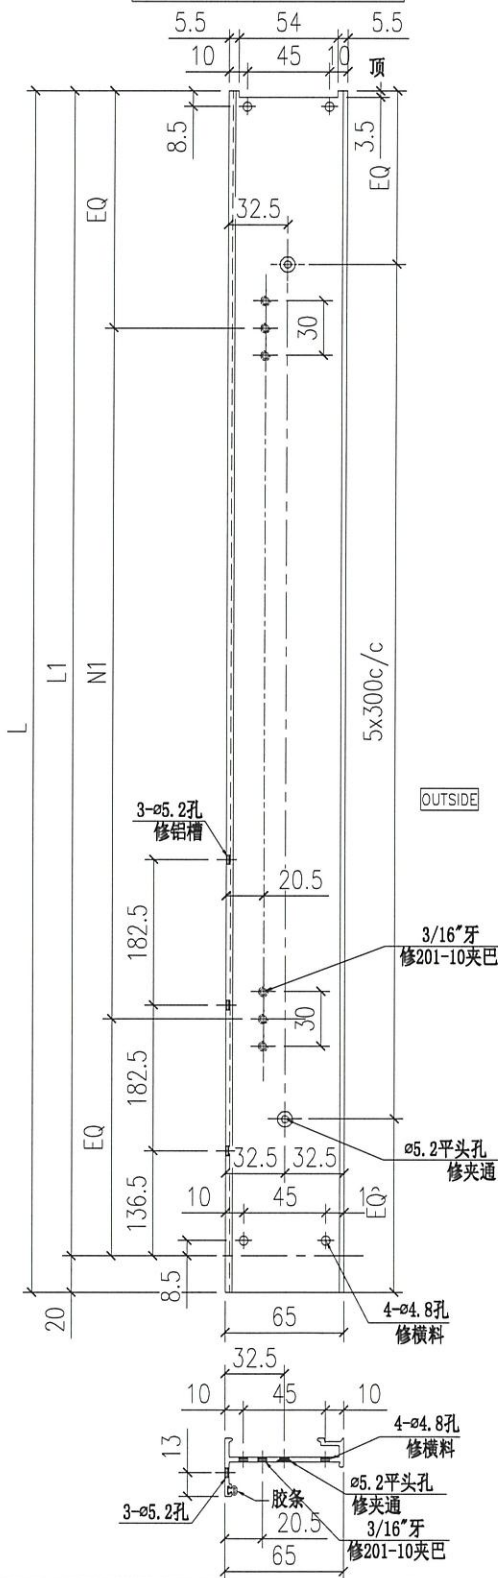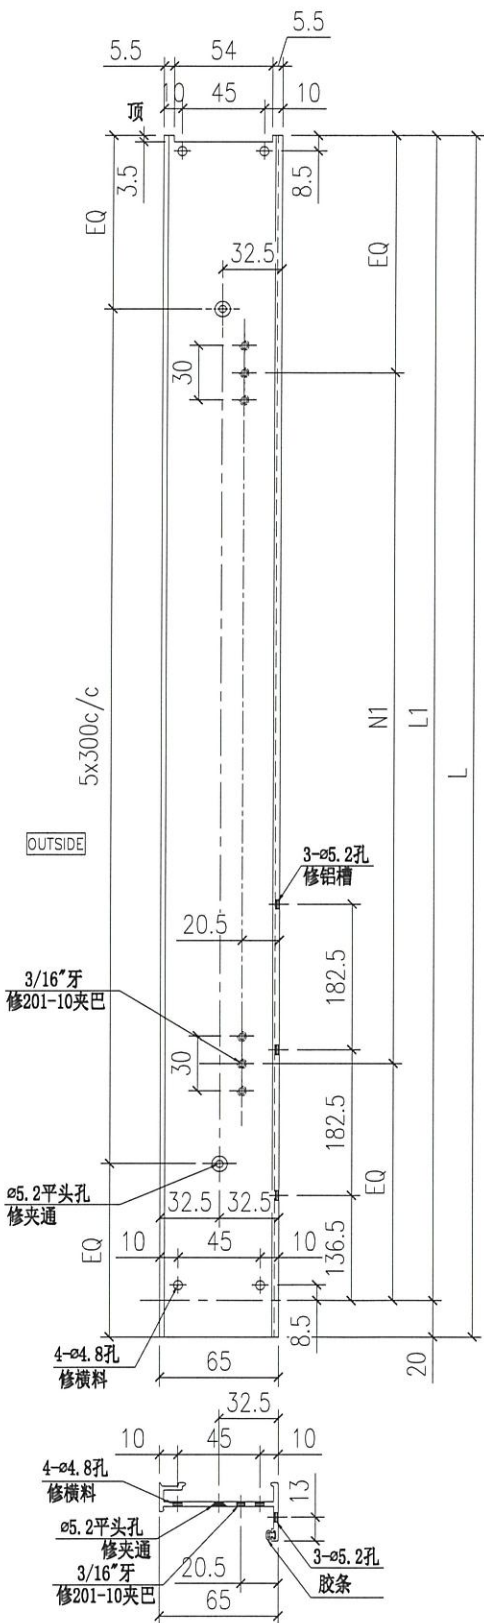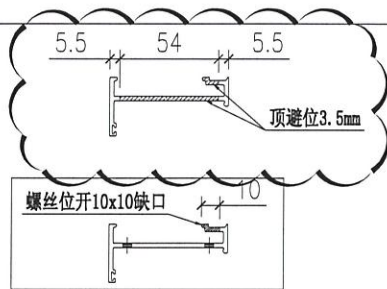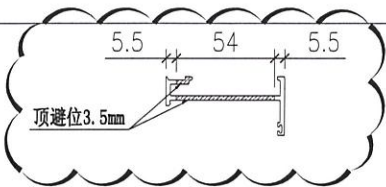

1	X85683-01LA	1755	1735	4x370c/c
序号	部件编号	L	L1	N1

2	X85683-01RB	1655	1635	3x465c/c
1	X85683-01RA	1755	1735	4x370c/c
序号	部件编号	L	L1	N1

Remarks:

Checked: KEN

Project Name: 青衣190

Project No: J851

Shop Drawing No: PRE-CAST ALUM. WINDOW & LOUVRE

Rev: A

Date: 22-12-2014

Drawn: W.F.X

Description: 生夹企, X856830

Material: 6061-T6

Finish: UC15341935C-3

QT: -

Tolerance: ±0.5

Projection:

Delivery to: Factory

Site:

Assembly No: X85683-01

Rev: A

