



美 特 鋁 質 有 限 公 司

MIDI ALUMINIUM FABRICATOR LTD.

工程指示 / 要求簡箋(E.I.)

工程指示編號：EI / 1930 / 20

修改版次：-

工程編號：J851

工程名稱：青衣明翹匯住宅

工程項目：后裝窗 CAD 電腦圖

收件人：生統

發件人：Leung Hin Wai

日期：8/6-2020

☐ 要求提供 / ☐ 確認 事項：

- | | | |
|------------------------------------|-------------------------------------|-------------------------------|
| ☐ 初步鋁料 B.M. | ☐ 加工拆圖，然後生產 | ☐ 尺寸表 |
| ☐ 正式鋁料 B.M. | ☐ 技術上資料 / 指示 | ☐ 報價 |
| ☐ 配件 B.M. | ☐ 樣辦或貨品說明書 | ☐ 分判合約 |
| ☐ 其他：_____ | | |

內容：

請查收后裝窗 CAD 電腦圖。

請在_____前完成上列要求。

附：-

以上項目為：

☐ 原合約工程包

☐ 原合約工程加 / 減賬

☐ 新工程報價

原因：-

分發東莞各部門：

- | | | | |
|---|---|---|--|
| ☐ 生產技術總監 ☐ 連附件 | ☐ 技術部 ☐ 連附件 | ☐ 生產部 ☐ 連附件 | ☐ 機械設計部 ☐ 連附件 |
| ☐ 採購部 ☐ 連附件 | ☒ 生產統籌部 ☒ 連附件 | | |
| ☒ 質檢部 ☒ 連附件 | ☐ 會計部 ☐ 連附件 | ☐ 報關組 ☐ 連附件 | ☐ 其他 _____ ☐ 連附件 |

分發香港各部門：

- | | | | |
|---|--|---|--|
| ☐ 行政部 ☐ 連附件 | ☐ 會計部 ☐ 連附件 | ☐ 統籌部 ☐ 連附件 | ☐ 工程部地盤科文 ☐ 連附件 |
| ☐ 採購部 ☐ 連附件 | ☐ QS 部 ☐ 連附件 | ☐ 維修部 ☐ 連附件 | ☐ 其他 _____ ☐ 連附件 |

傳遞編號：

HK 1070

發件人簽署：

項目經理簽署：

PROJECT :

RESIDENTIAL DEVELOPMENT AT TSING YI TOWN LOT 190 SAI SHAN ROAD

SHOP DRAWING FOR
IN- SITU ALUM. WINDOW, SLIDING DOOR,
FOLDING DOOR AND ALUM. LOUVRE
(TOWER 1 / 1A AND TOWER 2 / 2A)
DATE : 04 - MAY - 2020

 美特鋁質有限公司
MIDI ALUMINIUM FABRICATOR LTD.
Units 6-8, Sunray Industrial Centre, 1/F
610 Cha Kwo Ling Road, Kowloon
Tel:23489211-4 Fax:(852)27727666

MIDI ALUMINIUM FABRICATOR LTD.		DRAWING SUBMISSION REGISTER																														
PROJECT : RESIDENTIAL DEVELOPMENT AT TSING YI TOWN LOT 190 SAI SHAN ROAD WORK TYPE: SHOP DRAWING FOR IN- SITU ALUM. WINDOW, SLIDING DOOR, FOLDING DOOR AND ALUM. LOUVRE (TOWER 1 / 1A AND TOWER 2 / 2A)		DATE OF ISSUE										SUBMISSION STATE (FOR B.D/A.S.D)			SUBMISSION STATE (FOR CLIENT/CONSULTANT)			SUBMISSION STATE (FOR ARCHITECT)			FABRICATION/CONSTRUCTION STATE											
		COVER	01	02	03	04	05											AP - APPROVED			AP - APPROVED			AP - APPROVED			ISSUE TO CHINA OFFICE		ISSUE TO SITE		ISSUE TO SUB-CONTRACTOR	
		DAY	13	13	05	20	04											AC - APPROVED SUB. TO CONDITION			AC - APPROVED SUB. TO CONDITION			AC - APPROVED SUB. TO CONDITION								
		MONTH	12	02	03	03	05											NA - NOT APPROVED			NA - NOT APPROVED			NA - NOT APPROVED								
YEAR	19	20	20	20	20																											
DRAWING TITLE		DRG. NO.		REVISIONS										COMMENT DATE	REV.	STATE	COMMENT DATE	REV.	STATE	COMMENT DATE	REV.	STATE	REV.	DATE	REV.	DATE	REV.	DATE	REV.	DATE		
COVER PAGE		J851-IW-000		-	A	B	C	D																								
DRAWING REGISTER		J851-IW-001		-	A	B	C	D																								
DRAWING REGISTER		J851-IW-002		-	A	B	C	D																								
DRAWING REGISTER		J851-IW-003		-	A	B	C	D																								
SECTION PROPERTIES		J851-IW-004		-	A	B	B	B																								
SECTION PROPERTIES		J851-IW-005		-	A	B	C	C																								
WINDOW AND LOUVRE LOCATION PLAN OF LOWER GROUND FLOOR		J851-IW-101		-	A	A	A	A																								
WINDOW AND LOUVRE LOCATION PLAN OF UPPER GROUND FLOOR		J851-IW-102		-	A	A	A	A																								
WINDOW AND LOUVRE LOCATION PLAN OF TOWER 1/ TOWER 1A (1/F)		J851-IW-103		-	A	A	B	C																								
WINDOW AND LOUVRE LOCATION PLAN OF TOWER 1/ TOWER 1A (2/F~31/F)		J851-IW-104		-	A	B	C	D																								
WINDOW AND LOUVRE LOCATION PLAN OF TOWER 1/ TOWER 1A (32/F)		J851-IW-105		-	A	B	C	D																								
WINDOW AND LOUVRE LOCATION PLAN OF TOWER 1/ TOWER 1A (33/F)		J851-IW-106		-	A	B	C	D																								
WINDOW AND LOUVRE LOCATION PLAN OF TOWER 1/ TOWER 1A (35/F)		J851-IW-107		-	A	B	B	C																								
LOUVRE LOCATION PLAN OF TOWER 1/ TOWER 1A (ROOF)		J851-IW-108		-	A	A	A	A																								
WINDOW AND LOUVRE LOCATION PLAN OF TOWER 2/ TOWER 2A (1/F)		J851-IW-201		-	A	B	C	D																								
WINDOW AND LOUVRE LOCATION PLAN OF TOWER 2/ TOWER 2A (2/F~31/F)		J851-IW-202		-	A	B	C	D																								
WINDOW AND LOUVRE LOCATION PLAN OF TOWER 2/ TOWER 2A (32/F)		J851-IW-203		-	A	B	C	D																								
WINDOW AND LOUVRE LOCATION PLAN OF TOWER 2/ TOWER 2A (33/F)		J851-IW-204		-	A	B	C	D																								
WINDOW AND LOUVRE LOCATION PLAN OF TOWER 2/ TOWER 2A (35/F)		J851-IW-205		-	A	A	A	B																								
LOUVRE LOCATION PLAN OF TOWER 2/ TOWER 2A (ROOF)		J851-IW-206		-	A	A	A	A																								
WINDOW SCHEDULE OF TOWER 1/ TOWER 1A		J851-IW-111		-	A	B	B	C																								
WINDOW SCHEDULE OF TOWER 1/ TOWER 1A		J851-IW-112		-	A	B	B	C																								
WINDOW SCHEDULE OF TOWER 1/ TOWER 1A		J851-IW-113		-	A	B	C	D																								
WINDOW SCHEDULE OF TOWER 1/ TOWER 1A		J851-IW-114		-	A	B	B	B																								
WINDOW SCHEDULE OF TOWER 1/ TOWER 1A		J851-IW-115		-	A	B	C	D																								
WINDOW SCHEDULE OF TOWER 1/ TOWER 1A		J851-IW-116		-	A	B	B	C																								
WINDOW SCHEDULE OF TOWER 1/ TOWER 1A		J851-IW-117		-	A	B	C	D																								

IN-HOUSE DESIGN CHECKER	
DWG. NO. : J851-IW-001	REV. : D

 MIDI ALUMINIUM FABRICATOR LTD.		DRAWING SUBMISSION REGISTER																														
PROJECT : RESIDENTIAL DEVELOPMENT AT TSING YI TOWN LOT 190 SAI SHAN ROAD WORK TYPE: SHOP DRAWING FOR IN- SITU ALUM. WINDOW, SLIDING DOOR, FOLDING DOOR AND ALUM. LOUVRE (TOWER 1 / 1A AND TOWER 2 / 2A)		DATE OF ISSUE										SUBMISSION STATE (FOR B.D/A.S.D)			SUBMISSION STATE (FOR CLIENT/CONSULTANT)			SUBMISSION STATE (FOR ARCHITECT)			FABRICATION/CONSTRUCTION STATE											
		COVER	01	02	03	04	05											AP - APPROVED			AP - APPROVED			AP - APPROVED			ISSUE TO CHINA OFFICE		ISSUE TO SITE		ISSUE TO SUB-CONTRACTOR	
		DAY	13	13	05	20	04											AC - APPROVED SUB. TO CONDITION			AC - APPROVED SUB. TO CONDITION			AC - APPROVED SUB. TO CONDITION								
		MONTH	12	02	03	03	05											NA - NOT APPROVED			NA - NOT APPROVED			NA - NOT APPROVED								
		YEAR	19	20	20	20	20																									
DRAWING TITLE		DRG. NO.		REVISIONS										COMMENT DATE	REV.	STATE	COMMENT DATE	REV.	STATE	COMMENT DATE	REV.	STATE	REV.	DATE	REV.	DATE	REV.	DATE				
WINDOW SCHEDULE OF TOWER 1/ TOWER 1A		J851-IW-118		-	-	A	A	A																								
WINDOW SCHEDULE OF TOWER 1/ TOWER 1A		J851-IW-119		-	-	A	A	A																								
WINDOW SCHEDULE OF LOWER GROUND FLOOR AND UPPER GROUND FLOOR		J851-IW-120		-	-	A	A	B																								
WINDOW SCHEDULE OF TOWER 1/ TOWER 1A AND TOWER 2 / TOWER 2A		J851-IW-121		-	-	A	B	B																								
WINDOW SCHEDULE OF TOWER 2/ TOWER 2A		J851-IW-122		-	-	A	B	B																								
WINDOW SCHEDULE OF TOWER 1/ TOWER 1A		J851-IW-123				-	-	A																								
WINDOW SCHEDULE OF TOWER 1/ TOWER 1A		J851-IW-124						-																								
WINDOW SCHEDULE OF TOWER 2/ TOWER 2A		J851-IW-211		-	A	B	C	D																								
WINDOW SCHEDULE OF TOWER 2/ TOWER 2A		J851-IW-212		-	A	B	C	D																								
WINDOW SCHEDULE OF TOWER 2/ TOWER 2A		J851-IW-213		-	A	B	C	D																								
WINDOW SCHEDULE OF TOWER 2/ TOWER 2A		J851-IW-214		-	-	A	A	B																								
WINDOW SCHEDULE OF TOWER 2/ TOWER 2A		J851-IW-215		-	A	B	C	D																								
WINDOW SCHEDULE OF TOWER 2/ TOWER 2A		J851-IW-216		-	-	A	A	A																								
WINDOW SCHEDULE OF TOWER 2/ TOWER 2A		J851-IW-217		-	-	A	A	A																								
WINDOW SCHEDULE OF TOWER 2/ TOWER 2A		J851-IW-218		-	-	A	A	B																								
LOUVRE SCHEDULE OF LOWER GROUND FLOOR		J851-IW-131		-	A	A	A	A																								
LOUVRE SCHEDULE OF LOWER GROUND FLOOR		J851-IW-132		-	A	A	A	A																								
LOUVRE SCHEDULE OF LOWER GROUND FLOOR AND UPPER GROUND FLOOR		J851-IW-133		-	A	A	A	A																								
LOUVRE SCHEDULE OF UPPER GROUND FLOOR		J851-IW-134		-	A	A	A	A																								
LOUVRE SCHEDULE OF UPPER GROUND FLOOR		J851-IW-135		-	A	A	A	A																								
LOUVRE SCHEDULE OF UPPER GROUND FLOOR		J851-IW-136		-	A	A	A	A																								
LOUVRE SCHEDULE OF TOWER 1/ TOWER 1A AND TOWER 2 / TOWER 2A		J851-IW-137		-	A	A	A	A																								
LOUVRE SCHEDULE OF TOWER 1/ TOWER 1A		J851-IW-138		-	A	A	A	A																								
LOUVRE SCHEDULE OF TOWER 1/ TOWER 1A AND TOWER 2 / TOWER 2A		J851-IW-139		-	A	A	A	A																								
LOUVRE SCHEDULE OF TOWER 1/ TOWER 1A AND TOWER 2 / TOWER 2A		J851-IW-140		-	A	A	A	A																								
TYPICAL DETAIL FOR ALUM. WINDOW		J851-IW-901		-	A	B	C	C																								
TYPICAL DETAIL FOR ALUM. SLIDING DOOR		J851-IW-902		-	A	B	C	C																								
TYPICAL DETAIL FOR F.D. FOOR		J851-IW-903		-	A	B	C	C																								












IN-HOUSE DESIGN CHECKER	
DWG. NO. : J851-IW-002	REV. : D




DRAWING SUBMISSION REGISTER

[illegible][illegible]

DWG. NO. : J851-IW-003	REV. : D
---------------------------	-------------

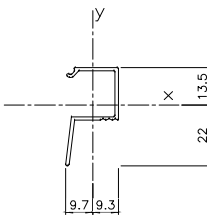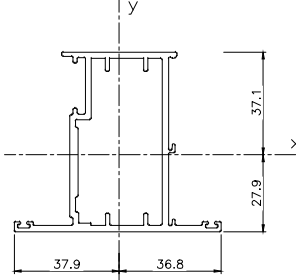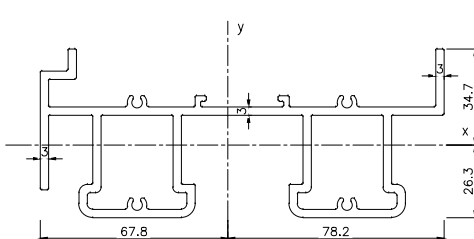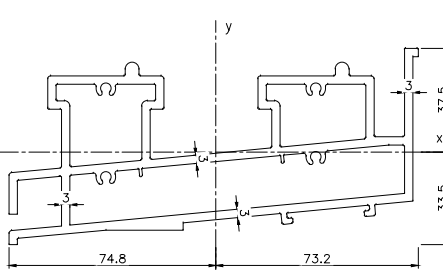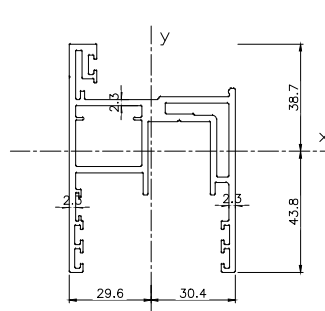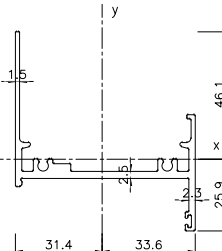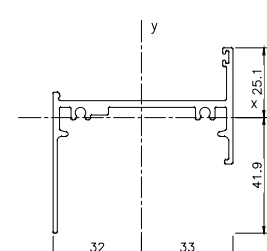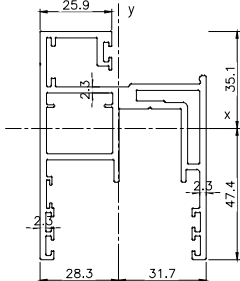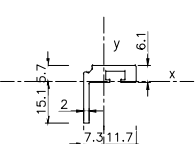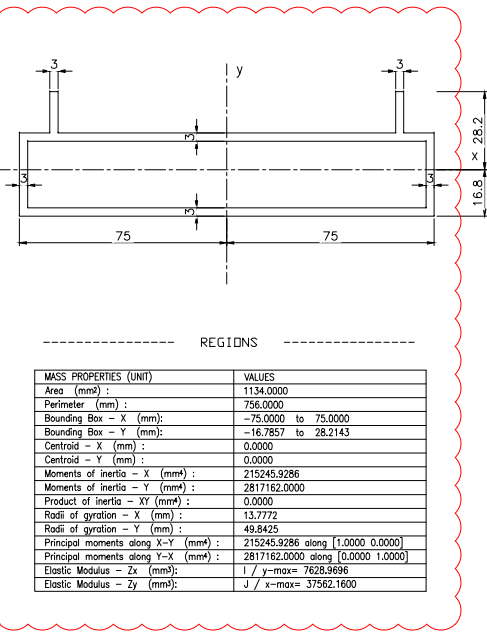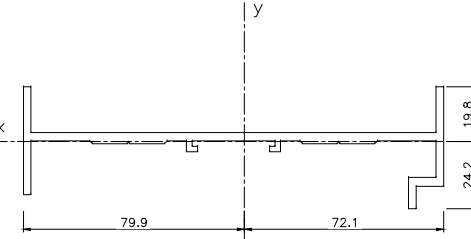PROPERTIES  REGIONS <table><tr><th>MASS PROPERTIES (UNIT)</th><th>VALUES</th></tr><tr><td>Area (mm²) :</td><td>83.1657</td></tr><tr><td>Perimeter (mm) :</td><td>142.1269</td></tr><tr><td>Bounding Box - X (mm):</td><td>-9.7443 to 9.2557</td></tr><tr><td>Bounding Box - Y (mm):</td><td>-21.9890 to 13.5110</td></tr><tr><td>Centroid - X (mm) :</td><td>0.0000</td></tr><tr><td>Centroid - Y (mm) :</td><td>0.0000</td></tr><tr><td>Moments of inertia - X (mm⁴) :</td><td>9241.4200</td></tr><tr><td>Moments of inertia - Y (mm⁴) :</td><td>4024.5592</td></tr><tr><td>Product of inertia - XY (mm⁴) :</td><td>3004.8970</td></tr><tr><td>Radii of gyration - X (mm) :</td><td>10.5414</td></tr><tr><td>Radii of gyration - Y (mm) :</td><td>6.9564</td></tr><tr><td>Principal moments along X-Y (mm⁴) :</td><td>7653.8798 along [0.4150 0.9098]</td></tr><tr><td>Principal moments along Y-X (mm⁴) :</td><td>10612.0994 along [-0.9098 0.4150]</td></tr><tr><td>Elastic Modulus - Zx (mm³):</td><td>1 / y-max= 420.2741</td></tr><tr><td>Elastic Modulus - Zy (mm³):</td><td>1 / x-max= 413.0171</td></tr></table>	MASS PROPERTIES (UNIT)	VALUES	Area (mm²) :	83.1657	Perimeter (mm) :	142.1269	Bounding Box - X (mm):	-9.7443 to 9.2557	Bounding Box - Y (mm):	-21.9890 to 13.5110	Centroid - X (mm) :	0.0000	Centroid - Y (mm) :	0.0000	Moments of inertia - X (mm⁴) :	9241.4200	Moments of inertia - Y (mm⁴) :	4024.5592	Product of inertia - XY (mm⁴) :	3004.8970	Radii of gyration - X (mm) :	10.5414	Radii of gyration - Y (mm) :	6.9564	Principal moments along X-Y (mm⁴) :	7653.8798 along [0.4150 0.9098]	Principal moments along Y-X (mm⁴) :	10612.0994 along [-0.9098 0.4150]	Elastic Modulus - Zx (mm³):	1 / y-max= 420.2741	Elastic Modulus - Zy (mm³):	1 / x-max= 413.0171	PROPERTIES  REGIONS <table><tr><th>MASS PROPERTIES (UNIT)</th><th>VALUES</th></tr><tr><td>Area (mm²) :</td><td>606.0126</td></tr><tr><td>Perimeter (mm) :</td><td>557.9480</td></tr><tr><td>Bounding Box - X (mm):</td><td>-37.9127 to 36.8472</td></tr><tr><td>Bounding Box - Y (mm):</td><td>-27.8742 to 37.0996</td></tr><tr><td>Centroid - X (mm) :</td><td>0.0000</td></tr><tr><td>Centroid - Y (mm) :</td><td>0.0000</td></tr><tr><td>Moments of inertia - X (mm⁴) :</td><td>359599.9049</td></tr><tr><td>Moments of inertia - Y (mm⁴) :</td><td>175730.1915</td></tr><tr><td>Product of inertia - XY (mm⁴) :</td><td>9839.7289</td></tr><tr><td>Radii of gyration - X (mm) :</td><td>24.3595</td></tr><tr><td>Radii of gyration - Y (mm) :</td><td>17.0287</td></tr><tr><td>Principal moments along X-Y (mm⁴) :</td><td>175205.1153 along [0.0533 0.9986]</td></tr><tr><td>Principal moments along Y-X (mm⁴) :</td><td>360122.8811 along [-0.9986 0.0533]</td></tr><tr><td>Elastic Modulus - Zx (mm³):</td><td>1 / y-max= 9692.7607</td></tr><tr><td>Elastic Modulus - Zy (mm³):</td><td>1 / x-max= 4635.1284</td></tr></table>	MASS PROPERTIES (UNIT)	VALUES	Area (mm²) :	606.0126	Perimeter (mm) :	557.9480	Bounding Box - X (mm):	-37.9127 to 36.8472	Bounding Box - Y (mm):	-27.8742 to 37.0996	Centroid - X (mm) :	0.0000	Centroid - Y (mm) :	0.0000	Moments of inertia - X (mm⁴) :	359599.9049	Moments of inertia - Y (mm⁴) :	175730.1915	Product of inertia - XY (mm⁴) :	9839.7289	Radii of gyration - X (mm) :	24.3595	Radii of gyration - Y (mm) :	17.0287	Principal moments along X-Y (mm⁴) :	175205.1153 along [0.0533 0.9986]	Principal moments along Y-X (mm⁴) :	360122.8811 along [-0.9986 0.0533]	Elastic Modulus - Zx (mm³):	1 / y-max= 9692.7607	Elastic Modulus - Zy (mm³):	1 / x-max= 4635.1284	PROPERTIES  REGIONS <table><tr><th>MASS PROPERTIES (UNIT)</th><th>VALUES</th></tr><tr><td>Area (mm²) :</td><td>1447.9581</td></tr><tr><td>Perimeter (mm) :</td><td>977.6432</td></tr><tr><td>Bounding Box - X (mm):</td><td>-67.8185 to 78.1815</td></tr><tr><td>Bounding Box - Y (mm):</td><td>-26.2697 to 34.7303</td></tr><tr><td>Centroid - X (mm) :</td><td>0.0000</td></tr><tr><td>Centroid - Y (mm) :</td><td>0.0000</td></tr><tr><td>Moments of inertia - X (mm⁴) :</td><td>405499.3896</td></tr><tr><td>Moments of inertia - Y (mm⁴) :</td><td>3120743.3913</td></tr><tr><td>Product of inertia - XY (mm⁴) :</td><td>-26025.0666</td></tr><tr><td>Radii of gyration - X (mm) :</td><td>16.7347</td></tr><tr><td>Radii of gyration - Y (mm) :</td><td>46.4249</td></tr><tr><td>Principal moments along X-Y (mm⁴) :</td><td>405249.9675 along [1.0000 -0.0096]</td></tr><tr><td>Principal moments along Y-X (mm⁴) :</td><td>3120992.8134 along [-0.0096 1.0000]</td></tr><tr><td>Elastic Modulus - Zx (mm³):</td><td>1 / y-max= 11675.6579</td></tr><tr><td>Elastic Modulus - Zy (mm³):</td><td>1 / x-max= 39916.6597</td></tr></table>	MASS PROPERTIES (UNIT)	VALUES	Area (mm²) :	1447.9581	Perimeter (mm) :	977.6432	Bounding Box - X (mm):	-67.8185 to 78.1815	Bounding Box - Y (mm):	-26.2697 to 34.7303	Centroid - X (mm) :	0.0000	Centroid - Y (mm) :	0.0000	Moments of inertia - X (mm⁴) :	405499.3896	Moments of inertia - Y (mm⁴) :	3120743.3913	Product of inertia - XY (mm⁴) :	-26025.0666	Radii of gyration - X (mm) :	16.7347	Radii of gyration - Y (mm) :	46.4249	Principal moments along X-Y (mm⁴) :	405249.9675 along [1.0000 -0.0096]	Principal moments along Y-X (mm⁴) :	3120992.8134 along [-0.0096 1.0000]	Elastic Modulus - Zx (mm³):	1 / y-max= 11675.6579	Elastic Modulus - Zy (mm³):	1 / x-max= 39916.6597	PROPERTIES  REGIONS <table><tr><th>MASS PROPERTIES (UNIT)</th><th>VALUES</th></tr><tr><td>Area (mm²) :</td><td>1895.2064</td></tr><tr><td>Perimeter (mm) :</td><td>1235.5800</td></tr><tr><td>Bounding Box - X (mm):</td><td>-74.7876 to 73.2124</td></tr><tr><td>Bounding Box - Y (mm):</td><td>-33.5279 to 37.4724</td></tr><tr><td>Centroid - X (mm) :</td><td>0.0000</td></tr><tr><td>Centroid - Y (mm) :</td><td>0.0000</td></tr><tr><td>Moments of inertia - X (mm⁴) :</td><td>686173.6728</td></tr><tr><td>Moments of inertia - Y (mm⁴) :</td><td>3923629.8335</td></tr><tr><td>Product of inertia - XY (mm⁴) :</td><td>398935.9619</td></tr><tr><td>Radii of gyration - X (mm) :</td><td>19.0278</td></tr><tr><td>Radii of gyration - Y (mm) :</td><td>45.5025</td></tr><tr><td>Principal moments along X-Y (mm⁴) :</td><td>637739.3436 along [0.9927 0.1205]</td></tr><tr><td>Principal moments along Y-X (mm⁴) :</td><td>3972064.1627 along [-0.1205 0.9927]</td></tr><tr><td>Elastic Modulus - Zx (mm³):</td><td>1 / y-max= 18311.4610</td></tr><tr><td>Elastic Modulus - Zy (mm³):</td><td>1 / x-max= 52483.6607</td></tr></table>	MASS PROPERTIES (UNIT)	VALUES	Area (mm²) :	1895.2064	Perimeter (mm) :	1235.5800	Bounding Box - X (mm):	-74.7876 to 73.2124	Bounding Box - Y (mm):	-33.5279 to 37.4724	Centroid - X (mm) :	0.0000	Centroid - Y (mm) :	0.0000	Moments of inertia - X (mm⁴) :	686173.6728	Moments of inertia - Y (mm⁴) :	3923629.8335	Product of inertia - XY (mm⁴) :	398935.9619	Radii of gyration - X (mm) :	19.0278	Radii of gyration - Y (mm) :	45.5025	Principal moments along X-Y (mm⁴) :	637739.3436 along [0.9927 0.1205]	Principal moments along Y-X (mm⁴) :	3972064.1627 along [-0.1205 0.9927]	Elastic Modulus - Zx (mm³):	1 / y-max= 18311.4610	Elastic Modulus - Zy (mm³):	1 / x-max= 52483.6607	PROPERTIES  REGIONS <table><tr><th>MASS PROPERTIES (UNIT)</th><th>VALUES</th></tr><tr><td>Area (mm²) :</td><td>847.0178</td></tr><tr><td>Perimeter (mm) :</td><td>743.7866</td></tr><tr><td>Bounding Box - X (mm):</td><td>-28.1815 to 31.8185</td></tr><tr><td>Bounding Box - Y (mm):</td><td>-45.7765 to 36.7235</td></tr><tr><td>Centroid - X (mm) :</td><td>0.0000</td></tr><tr><td>Centroid - Y (mm) :</td><td>0.0000</td></tr><tr><td>Moments of inertia - X (mm⁴) :</td><td>347816.6778</td></tr><tr><td>Moments of inertia - Y (mm⁴) :</td><td>434144.6609</td></tr><tr><td>Product of inertia - XY (mm⁴) :</td><td>-63284.4194</td></tr><tr><td>Radii of gyration - X (mm) :</td><td>20.2642</td></tr><tr><td>Radii of gyration - Y (mm) :</td><td>22.6397</td></tr><tr><td>Principal moments along X-Y (mm⁴) :</td><td>314377.4847 along [0.8842 -0.4672]</td></tr><tr><td>Principal moments along Y-X (mm⁴) :</td><td>467583.8541 along [0.4672 0.8842]</td></tr><tr><td>Elastic Modulus - Zx (mm³):</td><td>1 / y-max= 7598.1538</td></tr><tr><td>Elastic Modulus - Zy (mm³):</td><td>1 / x-max= 13644.4159</td></tr></table>	MASS PROPERTIES (UNIT)	VALUES	Area (mm²) :	847.0178	Perimeter (mm) :	743.7866	Bounding Box - X (mm):	-28.1815 to 31.8185	Bounding Box - Y (mm):	-45.7765 to 36.7235	Centroid - X (mm) :	0.0000	Centroid - Y (mm) :	0.0000	Moments of inertia - X (mm⁴) :	347816.6778	Moments of inertia - Y (mm⁴) :	434144.6609	Product of inertia - XY (mm⁴) :	-63284.4194	Radii of gyration - X (mm) :	20.2642	Radii of gyration - Y (mm) :	22.6397	Principal moments along X-Y (mm⁴) :	314377.4847 along [0.8842 -0.4672]	Principal moments along Y-X (mm⁴) :	467583.8541 along [0.4672 0.8842]	Elastic Modulus - Zx (mm³):	1 / y-max= 7598.1538	Elastic Modulus - Zy (mm³):	1 / x-max= 13644.4159	B.D. REF : F.S.D. REF : Note : 1.All dimensions are in mm. 2.All elevations are viewed from outside. 3.All dimensions to be verified on site before fabrication. GENERAL NOTES Legend : 1. F.F.L--- Finished Floor Level 2. S.F.L--- Structural Floor Level 3. (R) --- Reversed Detail X1 X001 DETAIL MARK NO. REFER SHEET NO.
MASS PROPERTIES (UNIT)	VALUES	
Area (mm²) :	83.1657	
Perimeter (mm) :	142.1269	
Bounding Box - X (mm):	-9.7443 to 9.2557	
Bounding Box - Y (mm):	-21.9890 to 13.5110	
Centroid - X (mm) :	0.0000	
Centroid - Y (mm) :	0.0000	
Moments of inertia - X (mm⁴) :	9241.4200	
Moments of inertia - Y (mm⁴) :	4024.5592	
Product of inertia - XY (mm⁴) :	3004.8970	
Radii of gyration - X (mm) :	10.5414	
Radii of gyration - Y (mm) :	6.9564	
Principal moments along X-Y (mm⁴) :	7653.8798 along [0.4150 0.9098]	
Principal moments along Y-X (mm⁴) :	10612.0994 along [-0.9098 0.4150]	
Elastic Modulus - Zx (mm³):	1 / y-max= 420.2741	
Elastic Modulus - Zy (mm³):	1 / x-max= 413.0171	
MASS PROPERTIES (UNIT)	VALUES	
Area (mm²) :	606.0126	
Perimeter (mm) :	557.9480	
Bounding Box - X (mm):	-37.9127 to 36.8472	
Bounding Box - Y (mm):	-27.8742 to 37.0996	
Centroid - X (mm) :	0.0000	
Centroid - Y (mm) :	0.0000	
Moments of inertia - X (mm⁴) :	359599.9049	
Moments of inertia - Y (mm⁴) :	175730.1915	
Product of inertia - XY (mm⁴) :	9839.7289	
Radii of gyration - X (mm) :	24.3595	
Radii of gyration - Y (mm) :	17.0287	
Principal moments along X-Y (mm⁴) :	175205.1153 along [0.0533 0.9986]	
Principal moments along Y-X (mm⁴) :	360122.8811 along [-0.9986 0.0533]	
Elastic Modulus - Zx (mm³):	1 / y-max= 9692.7607	
Elastic Modulus - Zy (mm³):	1 / x-max= 4635.1284	
MASS PROPERTIES (UNIT)	VALUES	
Area (mm²) :	1447.9581	
Perimeter (mm) :	977.6432	
Bounding Box - X (mm):	-67.8185 to 78.1815	
Bounding Box - Y (mm):	-26.2697 to 34.7303	
Centroid - X (mm) :	0.0000	
Centroid - Y (mm) :	0.0000	
Moments of inertia - X (mm⁴) :	405499.3896	
Moments of inertia - Y (mm⁴) :	3120743.3913	
Product of inertia - XY (mm⁴) :	-26025.0666	
Radii of gyration - X (mm) :	16.7347	
Radii of gyration - Y (mm) :	46.4249	
Principal moments along X-Y (mm⁴) :	405249.9675 along [1.0000 -0.0096]	
Principal moments along Y-X (mm⁴) :	3120992.8134 along [-0.0096 1.0000]	
Elastic Modulus - Zx (mm³):	1 / y-max= 11675.6579	
Elastic Modulus - Zy (mm³):	1 / x-max= 39916.6597	
MASS PROPERTIES (UNIT)	VALUES	
Area (mm²) :	1895.2064	
Perimeter (mm) :	1235.5800	
Bounding Box - X (mm):	-74.7876 to 73.2124	
Bounding Box - Y (mm):	-33.5279 to 37.4724	
Centroid - X (mm) :	0.0000	
Centroid - Y (mm) :	0.0000	
Moments of inertia - X (mm⁴) :	686173.6728	
Moments of inertia - Y (mm⁴) :	3923629.8335	
Product of inertia - XY (mm⁴) :	398935.9619	
Radii of gyration - X (mm) :	19.0278	
Radii of gyration - Y (mm) :	45.5025	
Principal moments along X-Y (mm⁴) :	637739.3436 along [0.9927 0.1205]	
Principal moments along Y-X (mm⁴) :	3972064.1627 along [-0.1205 0.9927]	
Elastic Modulus - Zx (mm³):	1 / y-max= 18311.4610	
Elastic Modulus - Zy (mm³):	1 / x-max= 52483.6607	
MASS PROPERTIES (UNIT)	VALUES	
Area (mm²) :	847.0178	
Perimeter (mm) :	743.7866	
Bounding Box - X (mm):	-28.1815 to 31.8185	
Bounding Box - Y (mm):	-45.7765 to 36.7235	
Centroid - X (mm) :	0.0000	
Centroid - Y (mm) :	0.0000	
Moments of inertia - X (mm⁴) :	347816.6778	
Moments of inertia - Y (mm⁴) :	434144.6609	
Product of inertia - XY (mm⁴) :	-63284.4194	
Radii of gyration - X (mm) :	20.2642	
Radii of gyration - Y (mm) :	22.6397	
Principal moments along X-Y (mm⁴) :	314377.4847 along [0.8842 -0.4672]	
Principal moments along Y-X (mm⁴) :	467583.8541 along [0.4672 0.8842]	
Elastic Modulus - Zx (mm³):	1 / y-max= 7598.1538	
Elastic Modulus - Zy (mm³):	1 / x-max= 13644.4159	
PROPERTIES  REGIONS <table><tr><th>MASS PROPERTIES (UNIT)</th><th>VALUES</th></tr><tr><td>Area (mm²) :</td><td>404.2980</td></tr><tr><td>Perimeter (mm) :</td><td>371.7452</td></tr><tr><td>Bounding Box - X (mm):</td><td>-31.3660 to 33.6140</td></tr><tr><td>Bounding Box - Y (mm):</td><td>-25.9498 to 46.0502</td></tr><tr><td>Centroid - X (mm) :</td><td>0.0000</td></tr><tr><td>Centroid - Y (mm) :</td><td>0.0000</td></tr><tr><td>Moments of inertia - X (mm⁴) :</td><td>71844.4546</td></tr><tr><td>Moments of inertia - Y (mm⁴) :</td><td>264516.3701</td></tr><tr><td>Product of inertia - XY (mm⁴) :</td><td>-63841.4491</td></tr><tr><td>Radii of gyration - X (mm) :</td><td>13.3305</td></tr><tr><td>Radii of gyration - Y (mm) :</td><td>25.5785</td></tr><tr><td>Principal moments along X-Y (mm⁴) :</td><td>52610.7477 along [0.9575 -0.2885]</td></tr><tr><td>Principal moments along Y-X (mm⁴) :</td><td>283750.0769 along [0.2885 0.9575]</td></tr><tr><td>Elastic Modulus - Zx (mm³):</td><td>1 / y-max= 1560.1336</td></tr><tr><td>Elastic Modulus - Zy (mm³):</td><td>1 / x-max= 7869.2343</td></tr></table>	MASS PROPERTIES (UNIT)	VALUES	Area (mm²) :	404.2980	Perimeter (mm) :	371.7452	Bounding Box - X (mm):	-31.3660 to 33.6140	Bounding Box - Y (mm):	-25.9498 to 46.0502	Centroid - X (mm) :	0.0000	Centroid - Y (mm) :	0.0000	Moments of inertia - X (mm⁴) :	71844.4546	Moments of inertia - Y (mm⁴) :	264516.3701	Product of inertia - XY (mm⁴) :	-63841.4491	Radii of gyration - X (mm) :	13.3305	Radii of gyration - Y (mm) :	25.5785	Principal moments along X-Y (mm⁴) :	52610.7477 along [0.9575 -0.2885]	Principal moments along Y-X (mm⁴) :	283750.0769 along [0.2885 0.9575]	Elastic Modulus - Zx (mm³):	1 / y-max= 1560.1336	Elastic Modulus - Zy (mm³):	1 / x-max= 7869.2343	PROPERTIES  REGIONS <table><tr><th>MASS PROPERTIES (UNIT)</th><th>VALUES</th></tr><tr><td>Area (mm²) :</td><td>396.8018</td></tr><tr><td>Perimeter (mm) :</td><td>361.7603</td></tr><tr><td>Bounding Box - X (mm):</td><td>-31.9648 to 33.0352</td></tr><tr><td>Bounding Box - Y (mm):</td><td>-41.8746 to 25.1279</td></tr><tr><td>Centroid - X (mm) :</td><td>0.0000</td></tr><tr><td>Centroid - Y (mm) :</td><td>0.0000</td></tr><tr><td>Moments of inertia - X (mm⁴) :</td><td>57372.4406</td></tr><tr><td>Moments of inertia - Y (mm⁴) :</td><td>257346.4129</td></tr><tr><td>Product of inertia - XY (mm⁴) :</td><td>53661.5072</td></tr><tr><td>Radii of gyration - X (mm) :</td><td>12.0244</td></tr><tr><td>Radii of gyration - Y (mm) :</td><td>25.4667</td></tr><tr><td>Principal moments along X-Y (mm⁴) :</td><td>348802.3883 along [0.9688 0.2438]</td></tr><tr><td>Principal moments along Y-X (mm⁴) :</td><td>270836.0973 along [-0.2438 0.9688]</td></tr><tr><td>Elastic Modulus - Zx (mm³):</td><td>1 / y-max= 1370.1000</td></tr><tr><td>Elastic Modulus - Zy (mm³):</td><td>1 / x-max= 7790.0592</td></tr></table>	MASS PROPERTIES (UNIT)	VALUES	Area (mm²) :	396.8018	Perimeter (mm) :	361.7603	Bounding Box - X (mm):	-31.9648 to 33.0352	Bounding Box - Y (mm):	-41.8746 to 25.1279	Centroid - X (mm) :	0.0000	Centroid - Y (mm) :	0.0000	Moments of inertia - X (mm⁴) :	57372.4406	Moments of inertia - Y (mm⁴) :	257346.4129	Product of inertia - XY (mm⁴) :	53661.5072	Radii of gyration - X (mm) :	12.0244	Radii of gyration - Y (mm) :	25.4667	Principal moments along X-Y (mm⁴) :	348802.3883 along [0.9688 0.2438]	Principal moments along Y-X (mm⁴) :	270836.0973 along [-0.2438 0.9688]	Elastic Modulus - Zx (mm³):	1 / y-max= 1370.1000	Elastic Modulus - Zy (mm³):	1 / x-max= 7790.0592	PROPERTIES  REGIONS <table><tr><th>MASS PROPERTIES (UNIT)</th><th>VALUES</th></tr><tr><td>Area (mm²) :</td><td>886.3474</td></tr><tr><td>Perimeter (mm) :</td><td>781.3645</td></tr><tr><td>Bounding Box - X (mm):</td><td>-28.3130 to 31.6870</td></tr><tr><td>Bounding Box - Y (mm):</td><td>-47.4181 to 35.0819</td></tr><tr><td>Centroid - X (mm) :</td><td>0.0000</td></tr><tr><td>Centroid - Y (mm) :</td><td>0.0000</td></tr><tr><td>Moments of inertia - X (mm⁴) :</td><td>396928.4326</td></tr><tr><td>Moments of inertia - Y (mm⁴) :</td><td>425262.2131</td></tr><tr><td>Product of inertia - XY (mm⁴) :</td><td>-62913.6067</td></tr><tr><td>Radii of gyration - X (mm) :</td><td>21.1380</td></tr><tr><td>Radii of gyration - Y (mm) :</td><td>21.8795</td></tr><tr><td>Principal moments along X-Y (mm⁴) :</td><td>348606.3883 along [0.7809 -0.6246]</td></tr><tr><td>Principal moments along Y-X (mm⁴) :</td><td>475584.2574 along [0.6246 0.7809]</td></tr><tr><td>Elastic Modulus - Zx (mm³):</td><td>1 / y-max= 8370.8207</td></tr><tr><td>Elastic Modulus - Zy (mm³):</td><td>1 / x-max= 13420.8953</td></tr></table>	MASS PROPERTIES (UNIT)	VALUES	Area (mm²) :	886.3474	Perimeter (mm) :	781.3645	Bounding Box - X (mm):	-28.3130 to 31.6870	Bounding Box - Y (mm):	-47.4181 to 35.0819	Centroid - X (mm) :	0.0000	Centroid - Y (mm) :	0.0000	Moments of inertia - X (mm⁴) :	396928.4326	Moments of inertia - Y (mm⁴) :	425262.2131	Product of inertia - XY (mm⁴) :	-62913.6067	Radii of gyration - X (mm) :	21.1380	Radii of gyration - Y (mm) :	21.8795	Principal moments along X-Y (mm⁴) :	348606.3883 along [0.7809 -0.6246]	Principal moments along Y-X (mm⁴) :	475584.2574 along [0.6246 0.7809]	Elastic Modulus - Zx (mm³):	1 / y-max= 8370.8207	Elastic Modulus - Zy (mm³):	1 / x-max= 13420.8953	PROPERTIES  REGIONS <table><tr><th>MASS PROPERTIES (UNIT)</th><th>VALUES</th></tr><tr><td>Area (mm²) :</td><td>112.6385</td></tr><tr><td>Perimeter (mm) :</td><td>92.4674</td></tr><tr><td>Bounding Box - X (mm):</td><td>-7.3189 to 11.6818</td></tr><tr><td>Bounding Box - Y (mm):</td><td>-15.1114 to 5.7041</td></tr><tr><td>Centroid - X (mm) :</td><td>0.0000</td></tr><tr><td>Centroid - Y (mm) :</td><td>0.0000</td></tr><tr><td>Moments of inertia - X (mm⁴) :</td><td>3208.0999</td></tr><tr><td>Moments of inertia - Y (mm⁴) :</td><td>4432.6606</td></tr><tr><td>Product of inertia - XY (mm⁴) :</td><td>2101.6576</td></tr><tr><td>Radii of gyration - X (mm) :</td><td>5.3368</td></tr><tr><td>Radii of gyration - Y (mm) :</td><td>6.2732</td></tr><tr><td>Principal moments along X-Y (mm⁴) :</td><td>1631.3503 along [0.7999 0.6001]</td></tr><tr><td>Principal moments along Y-X (mm⁴) :</td><td>6009.4101 along [-0.6001 0.7999]</td></tr><tr><td>Elastic Modulus - Zx (mm³):</td><td>1 / y-max= 212.2970</td></tr><tr><td>Elastic Modulus - Zy (mm³):</td><td>1 / x-max= 379.4487</td></tr></table>	MASS PROPERTIES (UNIT)	VALUES	Area (mm²) :	112.6385	Perimeter (mm) :	92.4674	Bounding Box - X (mm):	-7.3189 to 11.6818	Bounding Box - Y (mm):	-15.1114 to 5.7041	Centroid - X (mm) :	0.0000	Centroid - Y (mm) :	0.0000	Moments of inertia - X (mm⁴) :	3208.0999	Moments of inertia - Y (mm⁴) :	4432.6606	Product of inertia - XY (mm⁴) :	2101.6576	Radii of gyration - X (mm) :	5.3368	Radii of gyration - Y (mm) :	6.2732	Principal moments along X-Y (mm⁴) :	1631.3503 along [0.7999 0.6001]	Principal moments along Y-X (mm⁴) :	6009.4101 along [-0.6001 0.7999]	Elastic Modulus - Zx (mm³):	1 / y-max= 212.2970	Elastic Modulus - Zy (mm³):	1 / x-max= 379.4487	PROPERTIES  REGIONS <table><tr><th>MASS PROPERTIES (UNIT)</th><th>VALUES</th></tr><tr><td>Area (mm²) :</td><td>1134.0000</td></tr><tr><td>Perimeter (mm) :</td><td>756.0000</td></tr><tr><td>Bounding Box - X (mm):</td><td>-75.0000 to 75.0000</td></tr><tr><td>Bounding Box - Y (mm):</td><td>-16.7857 to 28.2143</td></tr><tr><td>Centroid - X (mm) :</td><td>0.0000</td></tr><tr><td>Centroid - Y (mm) :</td><td>0.0000</td></tr><tr><td>Moments of inertia - X (mm⁴) :</td><td>215245.9286</td></tr><tr><td>Moments of inertia - Y (mm⁴) :</td><td>2817162.0000</td></tr><tr><td>Product of inertia - XY (mm⁴) :</td><td>0.0000</td></tr><tr><td>Radii of gyration - X (mm) :</td><td>13.7772</td></tr><tr><td>Radii of gyration - Y (mm) :</td><td>49.8425</td></tr><tr><td>Principal moments along X-Y (mm⁴) :</td><td>215245.9286 along [1.0000 0.0000]</td></tr><tr><td>Principal moments along Y-X (mm⁴) :</td><td>2817162.0000 along [0.0000 1.0000]</td></tr><tr><td>Elastic Modulus - Zx (mm³):</td><td>1 / y-max= 7628.9696</td></tr><tr><td>Elastic Modulus - Zy (mm³):</td><td>1 / x-max= 37562.1600</td></tr></table>	MASS PROPERTIES (UNIT)	VALUES	Area (mm²) :	1134.0000	Perimeter (mm) :	756.0000	Bounding Box - X (mm):	-75.0000 to 75.0000	Bounding Box - Y (mm):	-16.7857 to 28.2143	Centroid - X (mm) :	0.0000	Centroid - Y (mm) :	0.0000	Moments of inertia - X (mm⁴) :	215245.9286	Moments of inertia - Y (mm⁴) :	2817162.0000	Product of inertia - XY (mm⁴) :	0.0000	Radii of gyration - X (mm) :	13.7772	Radii of gyration - Y (mm) :	49.8425	Principal moments along X-Y (mm⁴) :	215245.9286 along [1.0000 0.0000]	Principal moments along Y-X (mm⁴) :	2817162.0000 along [0.0000 1.0000]	Elastic Modulus - Zx (mm³):	1 / y-max= 7628.9696	Elastic Modulus - Zy (mm³):	1 / x-max= 37562.1600	C 20.03.2020 GENERAL REVISION B 05.03.2020 GENERAL REVISION A 13.02.2020 GENERAL REVISION NO. DATE REVISED BY CLIENT : 佳明集團控股有限公司 GRAND MING GROUP HOLDINGS LIMITED MAIN CONTRACTOR : GRAND TECH CONSTRUCTION CO. LTD. ARCHITECT : WONG TUNG & PARTNERS LIMITED ARCHITECTS & PLANNERS STRUCTURAL ENGINEER : C M WONG & ASSOCIATES LTD 美特鋁質有限公司 MIDI ALUMINIUM FABRICATOR LTD. Units 6-8, Sunray Industrial Centre, 1/F 610 Cha Kwo Ling Road, Kowloon Tel:23489211-4 Fax:(852)27727666 PROJECT : RESIDENTIAL DEVELOPMENT AT TSING YI TOWN LOT 190 SAI SHAN ROAD TITLE : SECTION PROPERTIES JOB NO. : J-851 DRAWN BY : DATE : 2-12-2019 CHKD BY : SCALE A1: A3: 1:3 DWG. NO. : J851-IW-005 REV. : C
MASS PROPERTIES (UNIT)	VALUES	
Area (mm²) :	404.2980	
Perimeter (mm) :	371.7452	
Bounding Box - X (mm):	-31.3660 to 33.6140	
Bounding Box - Y (mm):	-25.9498 to 46.0502	
Centroid - X (mm) :	0.0000	
Centroid - Y (mm) :	0.0000	
Moments of inertia - X (mm⁴) :	71844.4546	
Moments of inertia - Y (mm⁴) :	264516.3701	
Product of inertia - XY (mm⁴) :	-63841.4491	
Radii of gyration - X (mm) :	13.3305	
Radii of gyration - Y (mm) :	25.5785	
Principal moments along X-Y (mm⁴) :	52610.7477 along [0.9575 -0.2885]	
Principal moments along Y-X (mm⁴) :	283750.0769 along [0.2885 0.9575]	
Elastic Modulus - Zx (mm³):	1 / y-max= 1560.1336	
Elastic Modulus - Zy (mm³):	1 / x-max= 7869.2343	
MASS PROPERTIES (UNIT)	VALUES	
Area (mm²) :	396.8018	
Perimeter (mm) :	361.7603	
Bounding Box - X (mm):	-31.9648 to 33.0352	
Bounding Box - Y (mm):	-41.8746 to 25.1279	
Centroid - X (mm) :	0.0000	
Centroid - Y (mm) :	0.0000	
Moments of inertia - X (mm⁴) :	57372.4406	
Moments of inertia - Y (mm⁴) :	257346.4129	
Product of inertia - XY (mm⁴) :	53661.5072	
Radii of gyration - X (mm) :	12.0244	
Radii of gyration - Y (mm) :	25.4667	
Principal moments along X-Y (mm⁴) :	348802.3883 along [0.9688 0.2438]	
Principal moments along Y-X (mm⁴) :	270836.0973 along [-0.2438 0.9688]	
Elastic Modulus - Zx (mm³):	1 / y-max= 1370.1000	
Elastic Modulus - Zy (mm³):	1 / x-max= 7790.0592	
MASS PROPERTIES (UNIT)	VALUES	
Area (mm²) :	886.3474	
Perimeter (mm) :	781.3645	
Bounding Box - X (mm):	-28.3130 to 31.6870	
Bounding Box - Y (mm):	-47.4181 to 35.0819	
Centroid - X (mm) :	0.0000	
Centroid - Y (mm) :	0.0000	
Moments of inertia - X (mm⁴) :	396928.4326	
Moments of inertia - Y (mm⁴) :	425262.2131	
Product of inertia - XY (mm⁴) :	-62913.6067	
Radii of gyration - X (mm) :	21.1380	
Radii of gyration - Y (mm) :	21.8795	
Principal moments along X-Y (mm⁴) :	348606.3883 along [0.7809 -0.6246]	
Principal moments along Y-X (mm⁴) :	475584.2574 along [0.6246 0.7809]	
Elastic Modulus - Zx (mm³):	1 / y-max= 8370.8207	
Elastic Modulus - Zy (mm³):	1 / x-max= 13420.8953	
MASS PROPERTIES (UNIT)	VALUES	
Area (mm²) :	112.6385	
Perimeter (mm) :	92.4674	
Bounding Box - X (mm):	-7.3189 to 11.6818	
Bounding Box - Y (mm):	-15.1114 to 5.7041	
Centroid - X (mm) :	0.0000	
Centroid - Y (mm) :	0.0000	
Moments of inertia - X (mm⁴) :	3208.0999	
Moments of inertia - Y (mm⁴) :	4432.6606	
Product of inertia - XY (mm⁴) :	2101.6576	
Radii of gyration - X (mm) :	5.3368	
Radii of gyration - Y (mm) :	6.2732	
Principal moments along X-Y (mm⁴) :	1631.3503 along [0.7999 0.6001]	
Principal moments along Y-X (mm⁴) :	6009.4101 along [-0.6001 0.7999]	
Elastic Modulus - Zx (mm³):	1 / y-max= 212.2970	
Elastic Modulus - Zy (mm³):	1 / x-max= 379.4487	
MASS PROPERTIES (UNIT)	VALUES	
Area (mm²) :	1134.0000	
Perimeter (mm) :	756.0000	
Bounding Box - X (mm):	-75.0000 to 75.0000	
Bounding Box - Y (mm):	-16.7857 to 28.2143	
Centroid - X (mm) :	0.0000	
Centroid - Y (mm) :	0.0000	
Moments of inertia - X (mm⁴) :	215245.9286	
Moments of inertia - Y (mm⁴) :	2817162.0000	
Product of inertia - XY (mm⁴) :	0.0000	
Radii of gyration - X (mm) :	13.7772	
Radii of gyration - Y (mm) :	49.8425	
Principal moments along X-Y (mm⁴) :	215245.9286 along [1.0000 0.0000]	
Principal moments along Y-X (mm⁴) :	2817162.0000 along [0.0000 1.0000]	
Elastic Modulus - Zx (mm³):	1 / y-max= 7628.9696	
Elastic Modulus - Zy (mm³):	1 / x-max= 37562.1600	
PROPERTIES  REGIONS <table><tr><th>MASS PROPERTIES (UNIT)</th><th>VALUES</th></tr><tr><td>Area (mm²) :</td><td>777.7500</td></tr><tr><td>Perimeter (mm) :</td><td>510.4853</td></tr><tr><td>Bounding Box - X (mm):</td><td>-79.8884 to 72.1116</td></tr><tr><td>Bounding Box - Y (mm):</td><td>-24.2314 to 19.7686</td></tr><tr><td>Centroid - X (mm) :</td><td>0.0000</td></tr><tr><td>Centroid - Y (mm) :</td><td>0.0000</td></tr><tr><td>Moments of inertia - X (mm⁴) :</td><td>42530.9432</td></tr><tr><td>Moments of inertia - Y (mm⁴) :</td><td>2252772.4914</td></tr><tr><td>Product of inertia - XY (mm⁴) :</td><td>-50246.2348</td></tr><tr><td>Radii of gyration - X (mm) :</td><td>7.3949</td></tr><tr><td>Radii of gyration - Y (mm) :</td><td>53.8194</td></tr><tr><td>Principal moments along X-Y (mm⁴) :</td></tr></table>	MASS PROPERTIES (UNIT)	VALUES	Area (mm²) :	777.7500	Perimeter (mm) :	510.4853	Bounding Box - X (mm):	-79.8884 to 72.1116	Bounding Box - Y (mm):	-24.2314 to 19.7686	Centroid - X (mm) :	0.0000	Centroid - Y (mm) :	0.0000	Moments of inertia - X (mm⁴) :	42530.9432	Moments of inertia - Y (mm⁴) :	2252772.4914	Product of inertia - XY (mm⁴) :	-50246.2348	Radii of gyration - X (mm) :	7.3949	Radii of gyration - Y (mm) :	53.8194	Principal moments along X-Y (mm⁴) :	
MASS PROPERTIES (UNIT)	VALUES	
Area (mm²) :	777.7500	
Perimeter (mm) :	510.4853	
Bounding Box - X (mm):	-79.8884 to 72.1116	
Bounding Box - Y (mm):	-24.2314 to 19.7686	
Centroid - X (mm) :	0.0000	
Centroid - Y (mm) :	0.0000	
Moments of inertia - X (mm⁴) :	42530.9432	
Moments of inertia - Y (mm⁴) :	2252772.4914	
Product of inertia - XY (mm⁴) :	-50246.2348	
Radii of gyration - X (mm) :	7.3949	
Radii of gyration - Y (mm) :	53.8194	
Principal moments along X-Y (mm⁴) :	

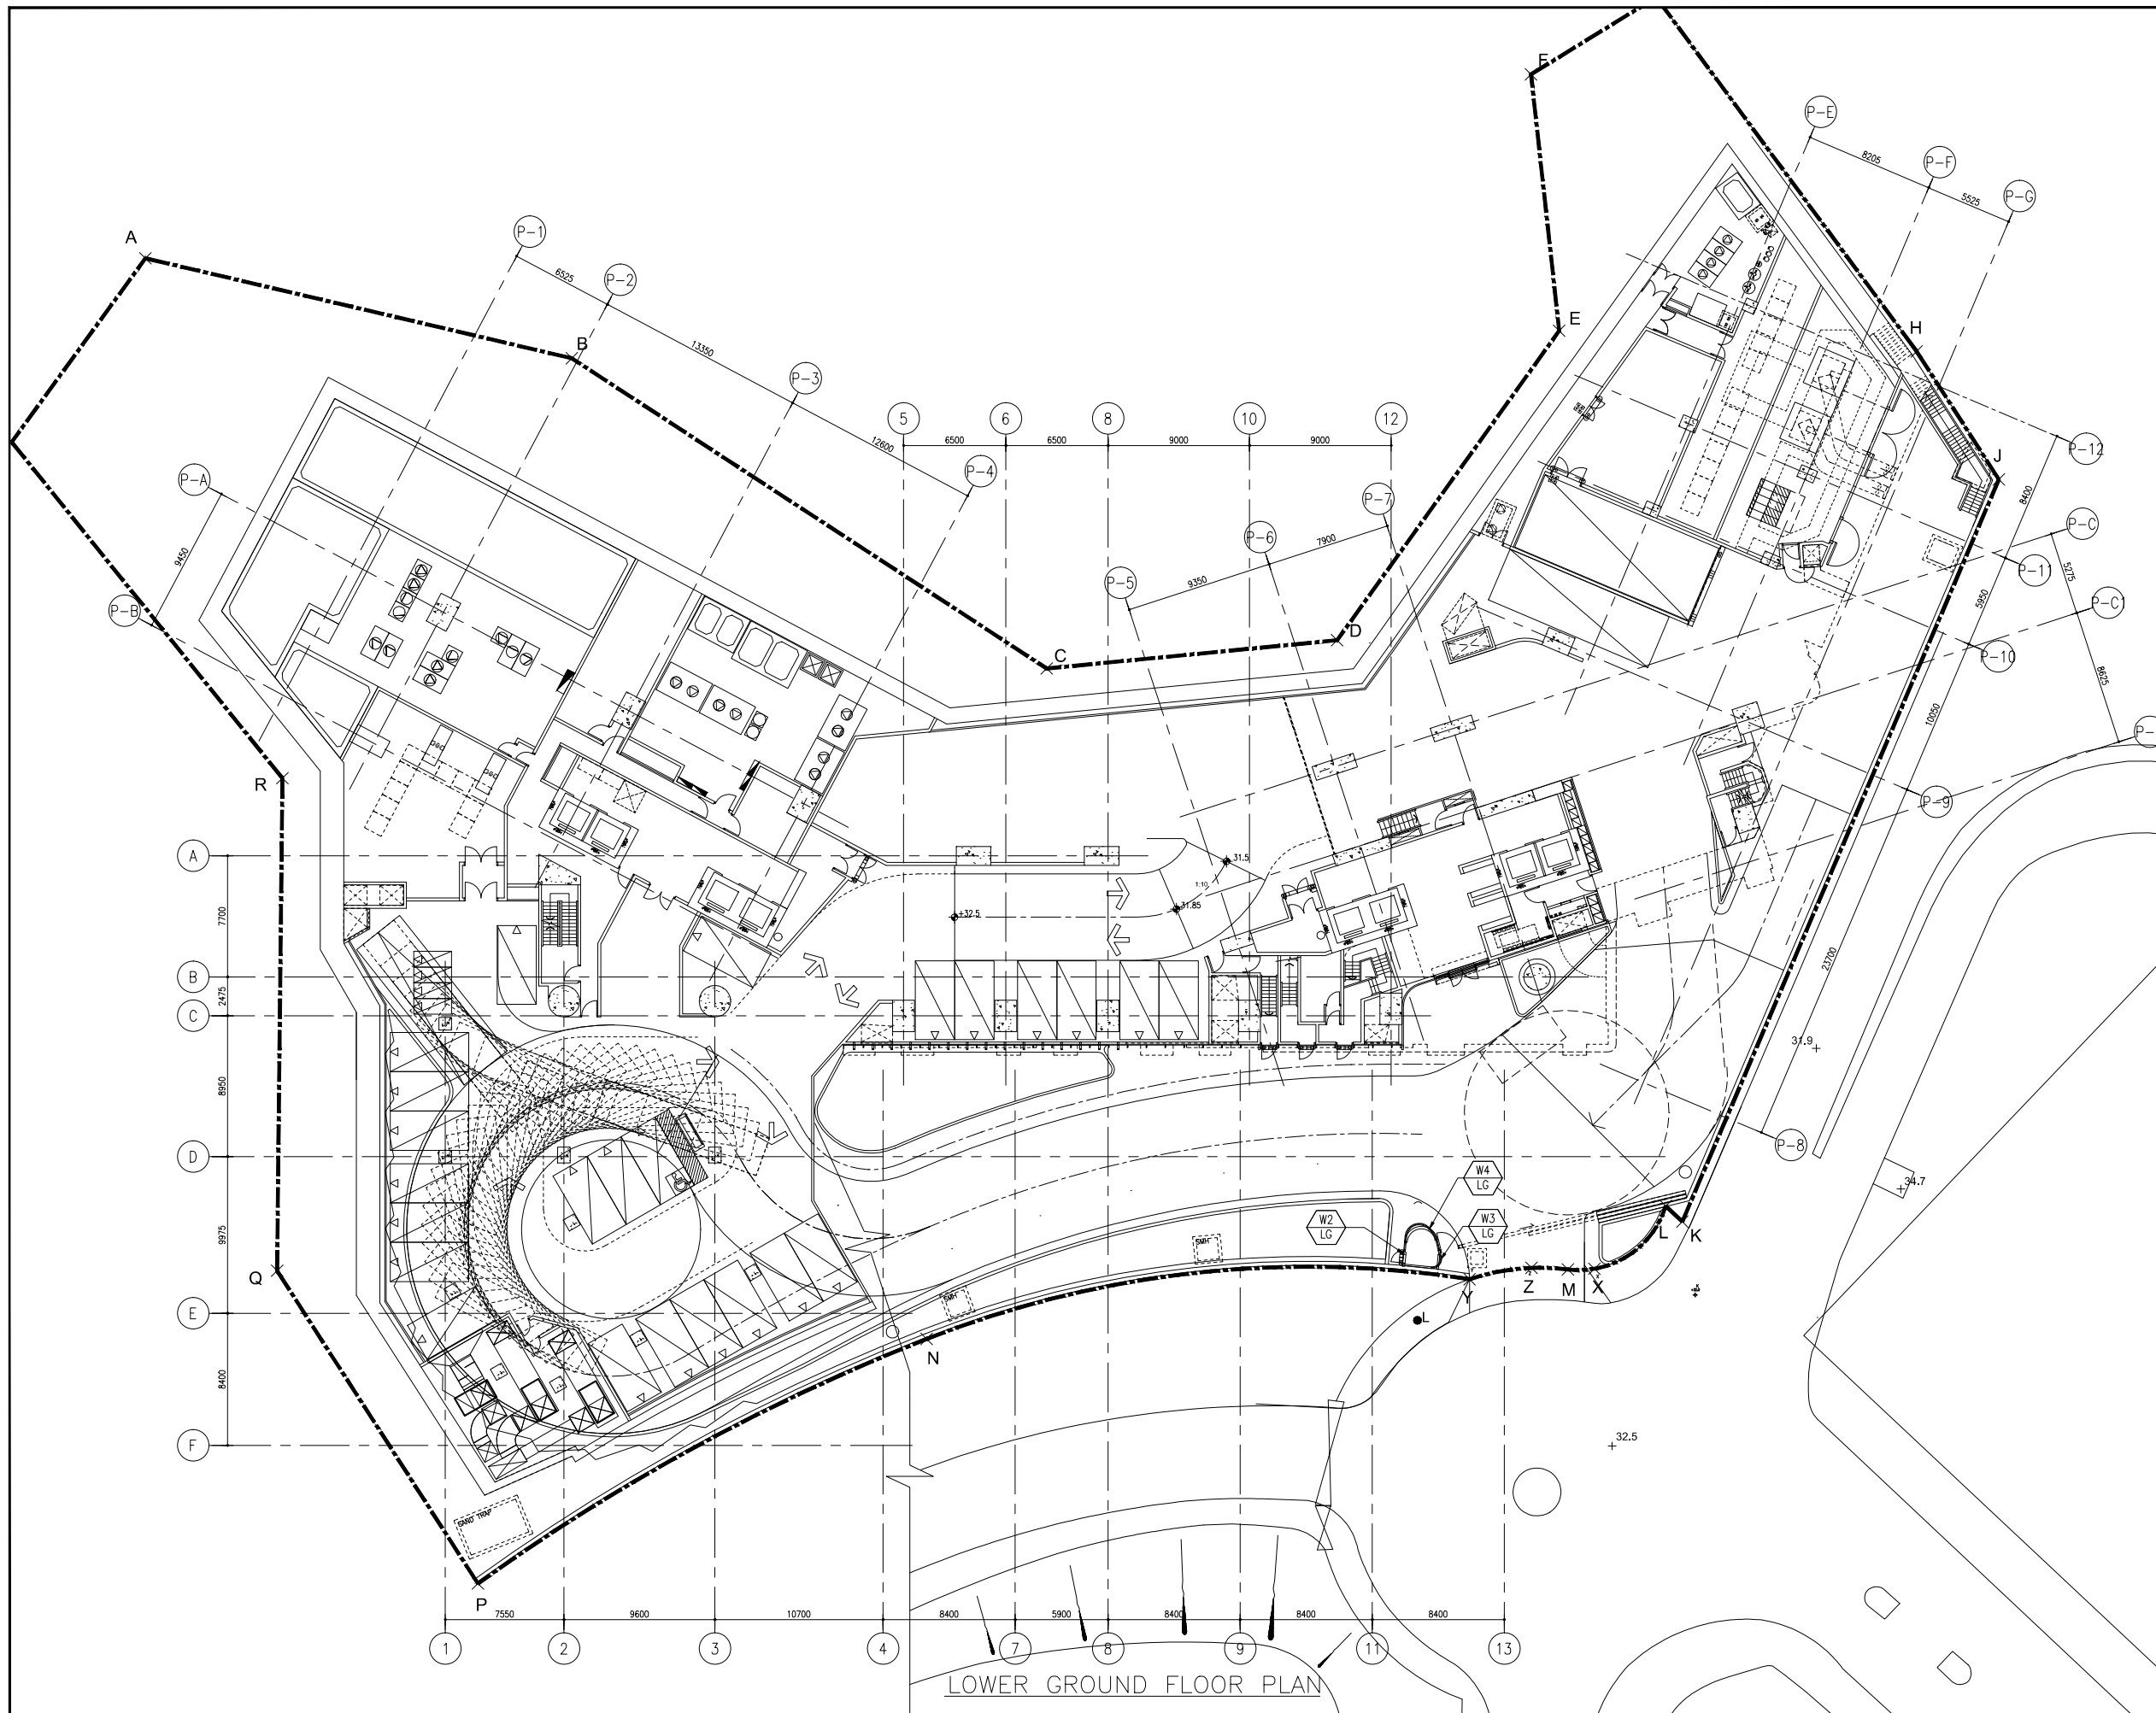

B.D. REF :

F.S.D. REF :

Note :
1.All dimensions are in mm.
2.All elevations are viewed from outside.
3.All dimensions to be verified on site before fabrication.

GENERAL NOTES

Legend :

1. F.F.L.-- Finished Floor Level
2. S.F.L.-- Structural Floor Level
3. (R) -- Reversed Detail

X1--DETAIL MARK NO.
X001--REFER SHEET NO.

NO.	DATE	GENERAL REVISION REVISED	BY
A	13.02.2020		

CLIENT :

佳明集團控股有限公司
GRAND MING GROUP HOLDINGS LIMITED

MAIN CONTRACTOR :

GRAND TECH CONSTRUCTION CO.LTD.

ARCHITECT :

WONG TUNG & PARTNERS LIMITED
ARCHITECTS & PLANNERS


STRUCTURAL ENGINEER :

 C M WONG & ASSOCIATES LTD

 美特鋁質有限公司
MIDI ALUMINIUM FABRICATOR LTD.
Units 6-8, Sunray Industrial Centre, 1/F
610 Cha Kwo Ling Road, Kowloon
Tel:23489211-4 Fax:(652)27727666

PROJECT :

RESIDENTIAL DEVELOPMENT AT
TSING YI TOWN LOT 190 SAI SHAN ROAD

TITLE :

WINDOW LOCATION PLAN
OF LOWER GROUND FLOOR


JOB NO. : J-851

DRAWN BY : DATE : 2-12-2019

CHKD BY : SCALE: A1:
A3: 1:400

DWG. NO. : J851-IW-101

REV. : A

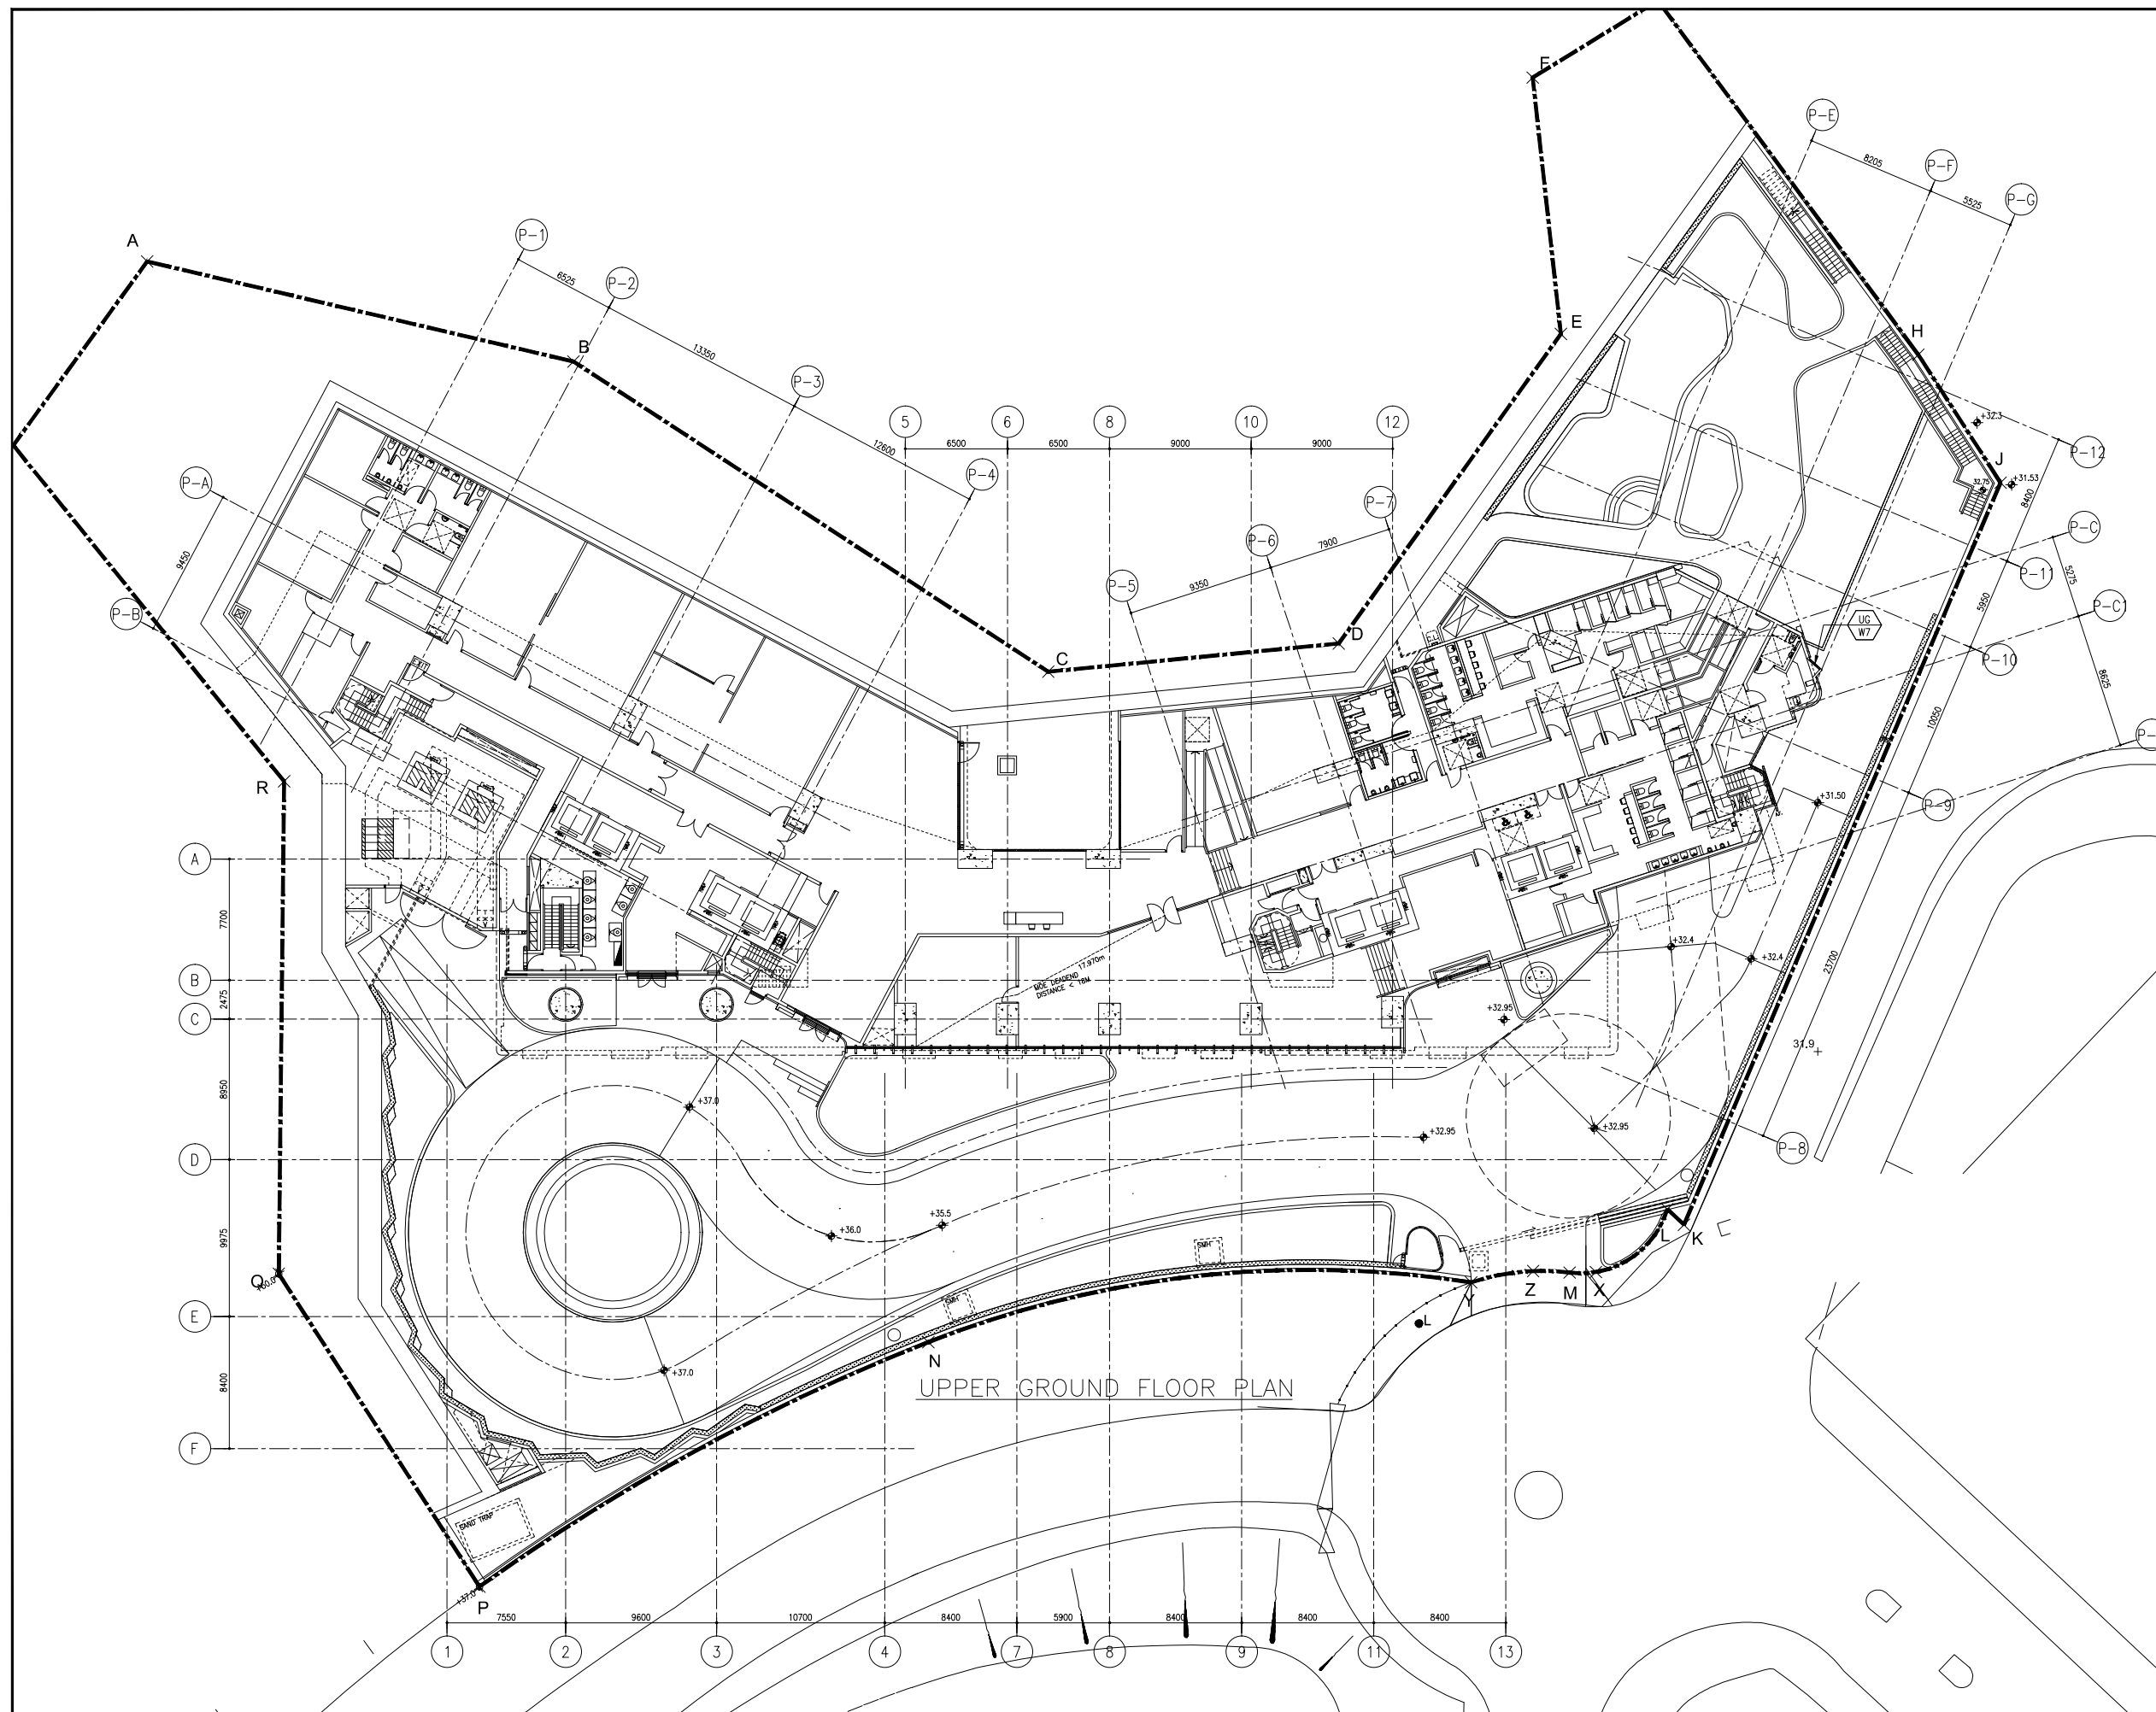

B.D. REF :	
------------	--

F.S.D. REF :

Note :

- 1.All dimensions are in mm.
- 2.All elevations are viewed from outside.
- 3.All dimensions to be verified on site before fabrication.

GENERAL NOTES

Legend :

1. F.F.L.-- Finished Floor Level
2. S.F.L.-- Structural Floor Level
3.  -- Reversed Detail


 X1 ← DETAIL MARK NO.
 X001 ← REFER SHEET NO.

D				
A	13.02.2020	GENERAL REVISION		
NO.	DATE	REVISED	BY	

CLIENT :

佳明集團控股有限公司
GRAND MING GROUP HOLDINGS LIMITED

MAIN CONTRACTOR :

GRAND TECH CONSTRUCTION CO. LTD.

ARCHITECT : **WONG TUNG & PARTNERS LIMITED**
ARCHITECTS & PLANNERS



STRUCTURAL ENGINEER :



C M WONG & ASSOCIATES LTD



美特鋁質有限公司
MIDI ALUMINIUM FABRICATOR LTD.

Units 6-8, Sunray Industrial Centre, 1/F
610 Cha Kwo Ling Road, Kowloon
Tel:23489211-4 Fax:(852)27727666

PROJECT :

RESIDENTIAL DEVELOPMENT AT
TSING YI TOWN LOT 190 SAI SHAN ROAD

TITLE :


WINDOW LOCATION PLAN
OF UPPER GROUND FLOOR

JOB NO. : J-851

DRAWN BY :	DATE : 2-12-2019
------------	---------------------

CHKD BY :	SCALE A1: A3: 1:400
-----------	------------------------

DWG. NO. : J851-IW-102	REV. : A
---------------------------	-------------

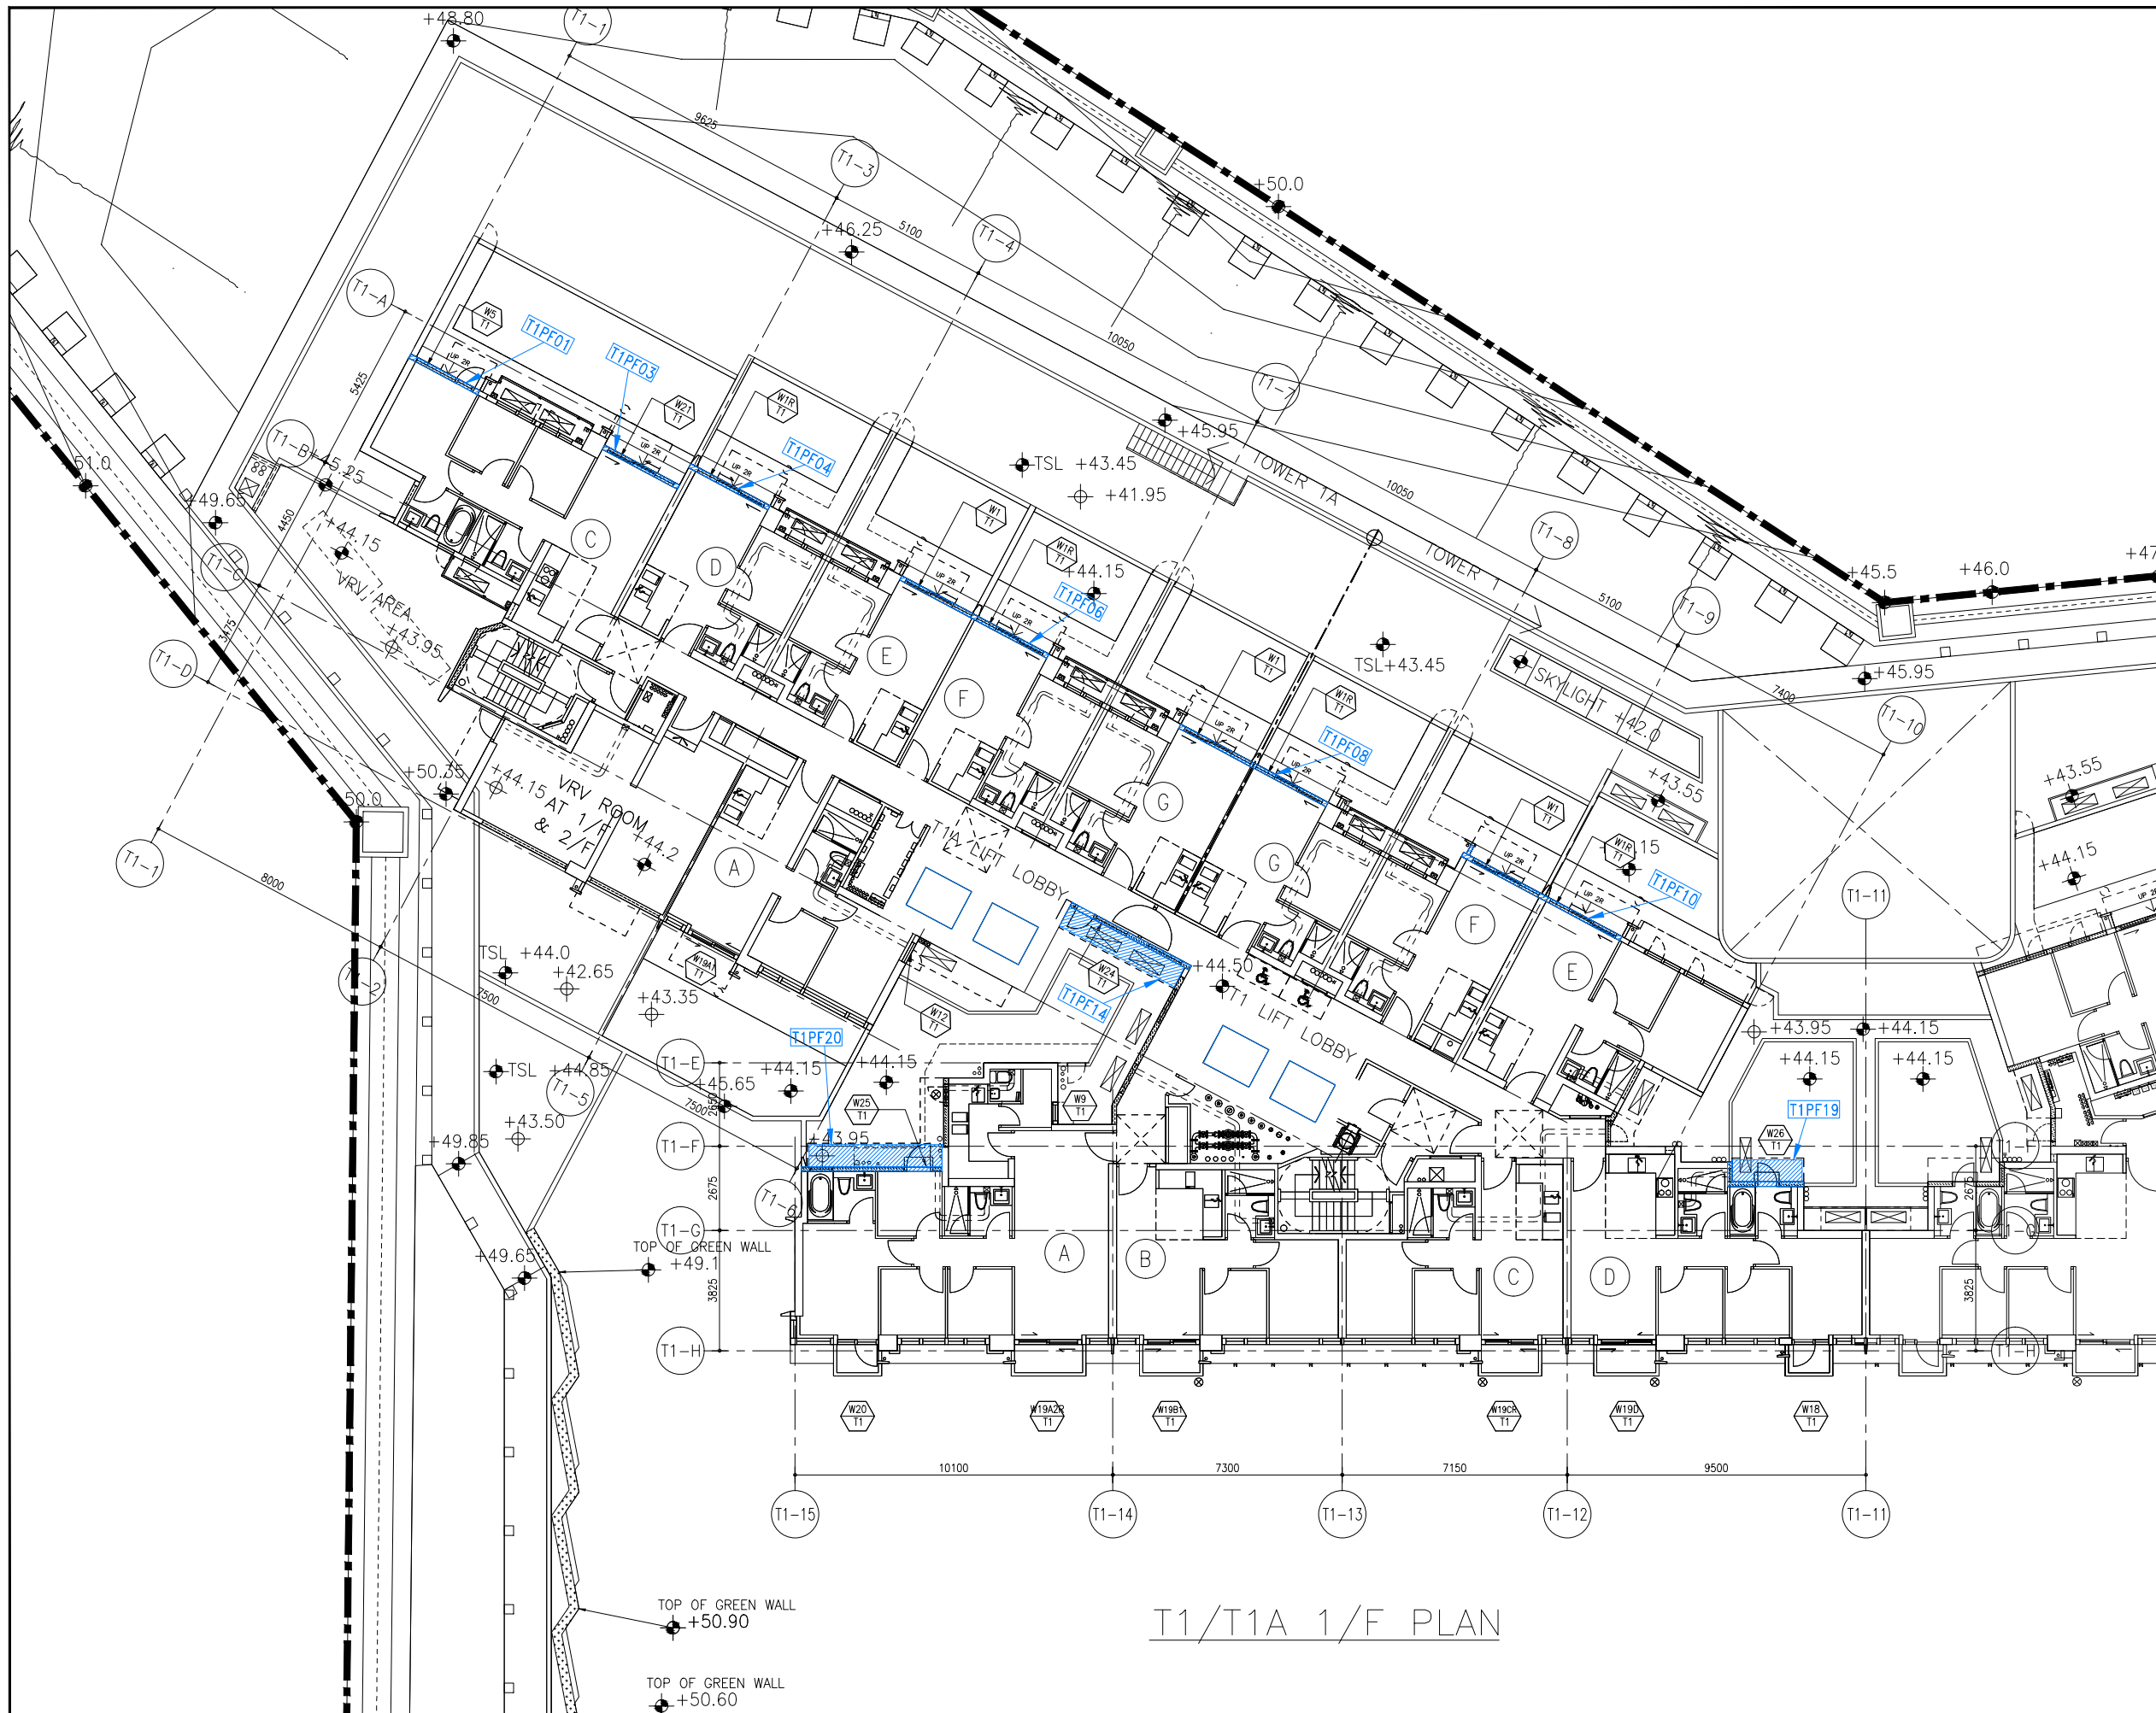

B.D. REF :
F.S.D. REF :
Note :
1.All dimensions are in mm.
2.All elevations are viewed from outside.
3.All dimensions to be verified on site before fabrication.

GENERAL NOTES

Legend :
1. F.F.L.-- Finished Floor Level
2. S.F.L.-- Structural Floor Level
3. (R) -- Reversed Detail

X1-- DETAIL MARK NO.
X001-- REFER SHEET NO.

TIPFXX -- FACADE MARK

C	04.05.2020	GENERAL REVISION		
B	20.03.2020	GENERAL REVISION		
A	13.02.2020	GENERAL REVISION		
NO.	DATE	REVISED	BY	

CLIENT :
佳明集團控股有限公司
GRAND MING GROUP HOLDINGS LIMITED

MAIN CONTRACTOR :
GRAND TECH CONSTRUCTION CO.LTD.

ARCHITECT :
WONG TUNG & PARTNERS LIMITED
ARCHITECTS & PLANNERS


STRUCTURAL ENGINEER :
 C M WONG & ASSOCIATES LTD

 美特鋁質有限公司
MIDI ALUMINIUM FABRICATOR LTD.
Units 6-8, Sunray Industrial Centre, 1/F
610 Cha Kwo Ling Road, Kowloon
Tel:23489211-4 Fax:(652)27727666

PROJECT :
RESIDENTIAL DEVELOPMENT AT
TSING YI TOWN LOT 190 SAI SHAN ROAD

TITLE :
WINDOW LOCATION PLAN
OF TOWER 1/ TOWER 1A (1/F)

JOB NO. : J-851

DRAWN BY : DATE : 2-12-2019


CHKD BY : SCALE : A1:
A3: 1:200

DWG. NO. : J851-IW-103 REV. : C



B.D. REF :

REV. :

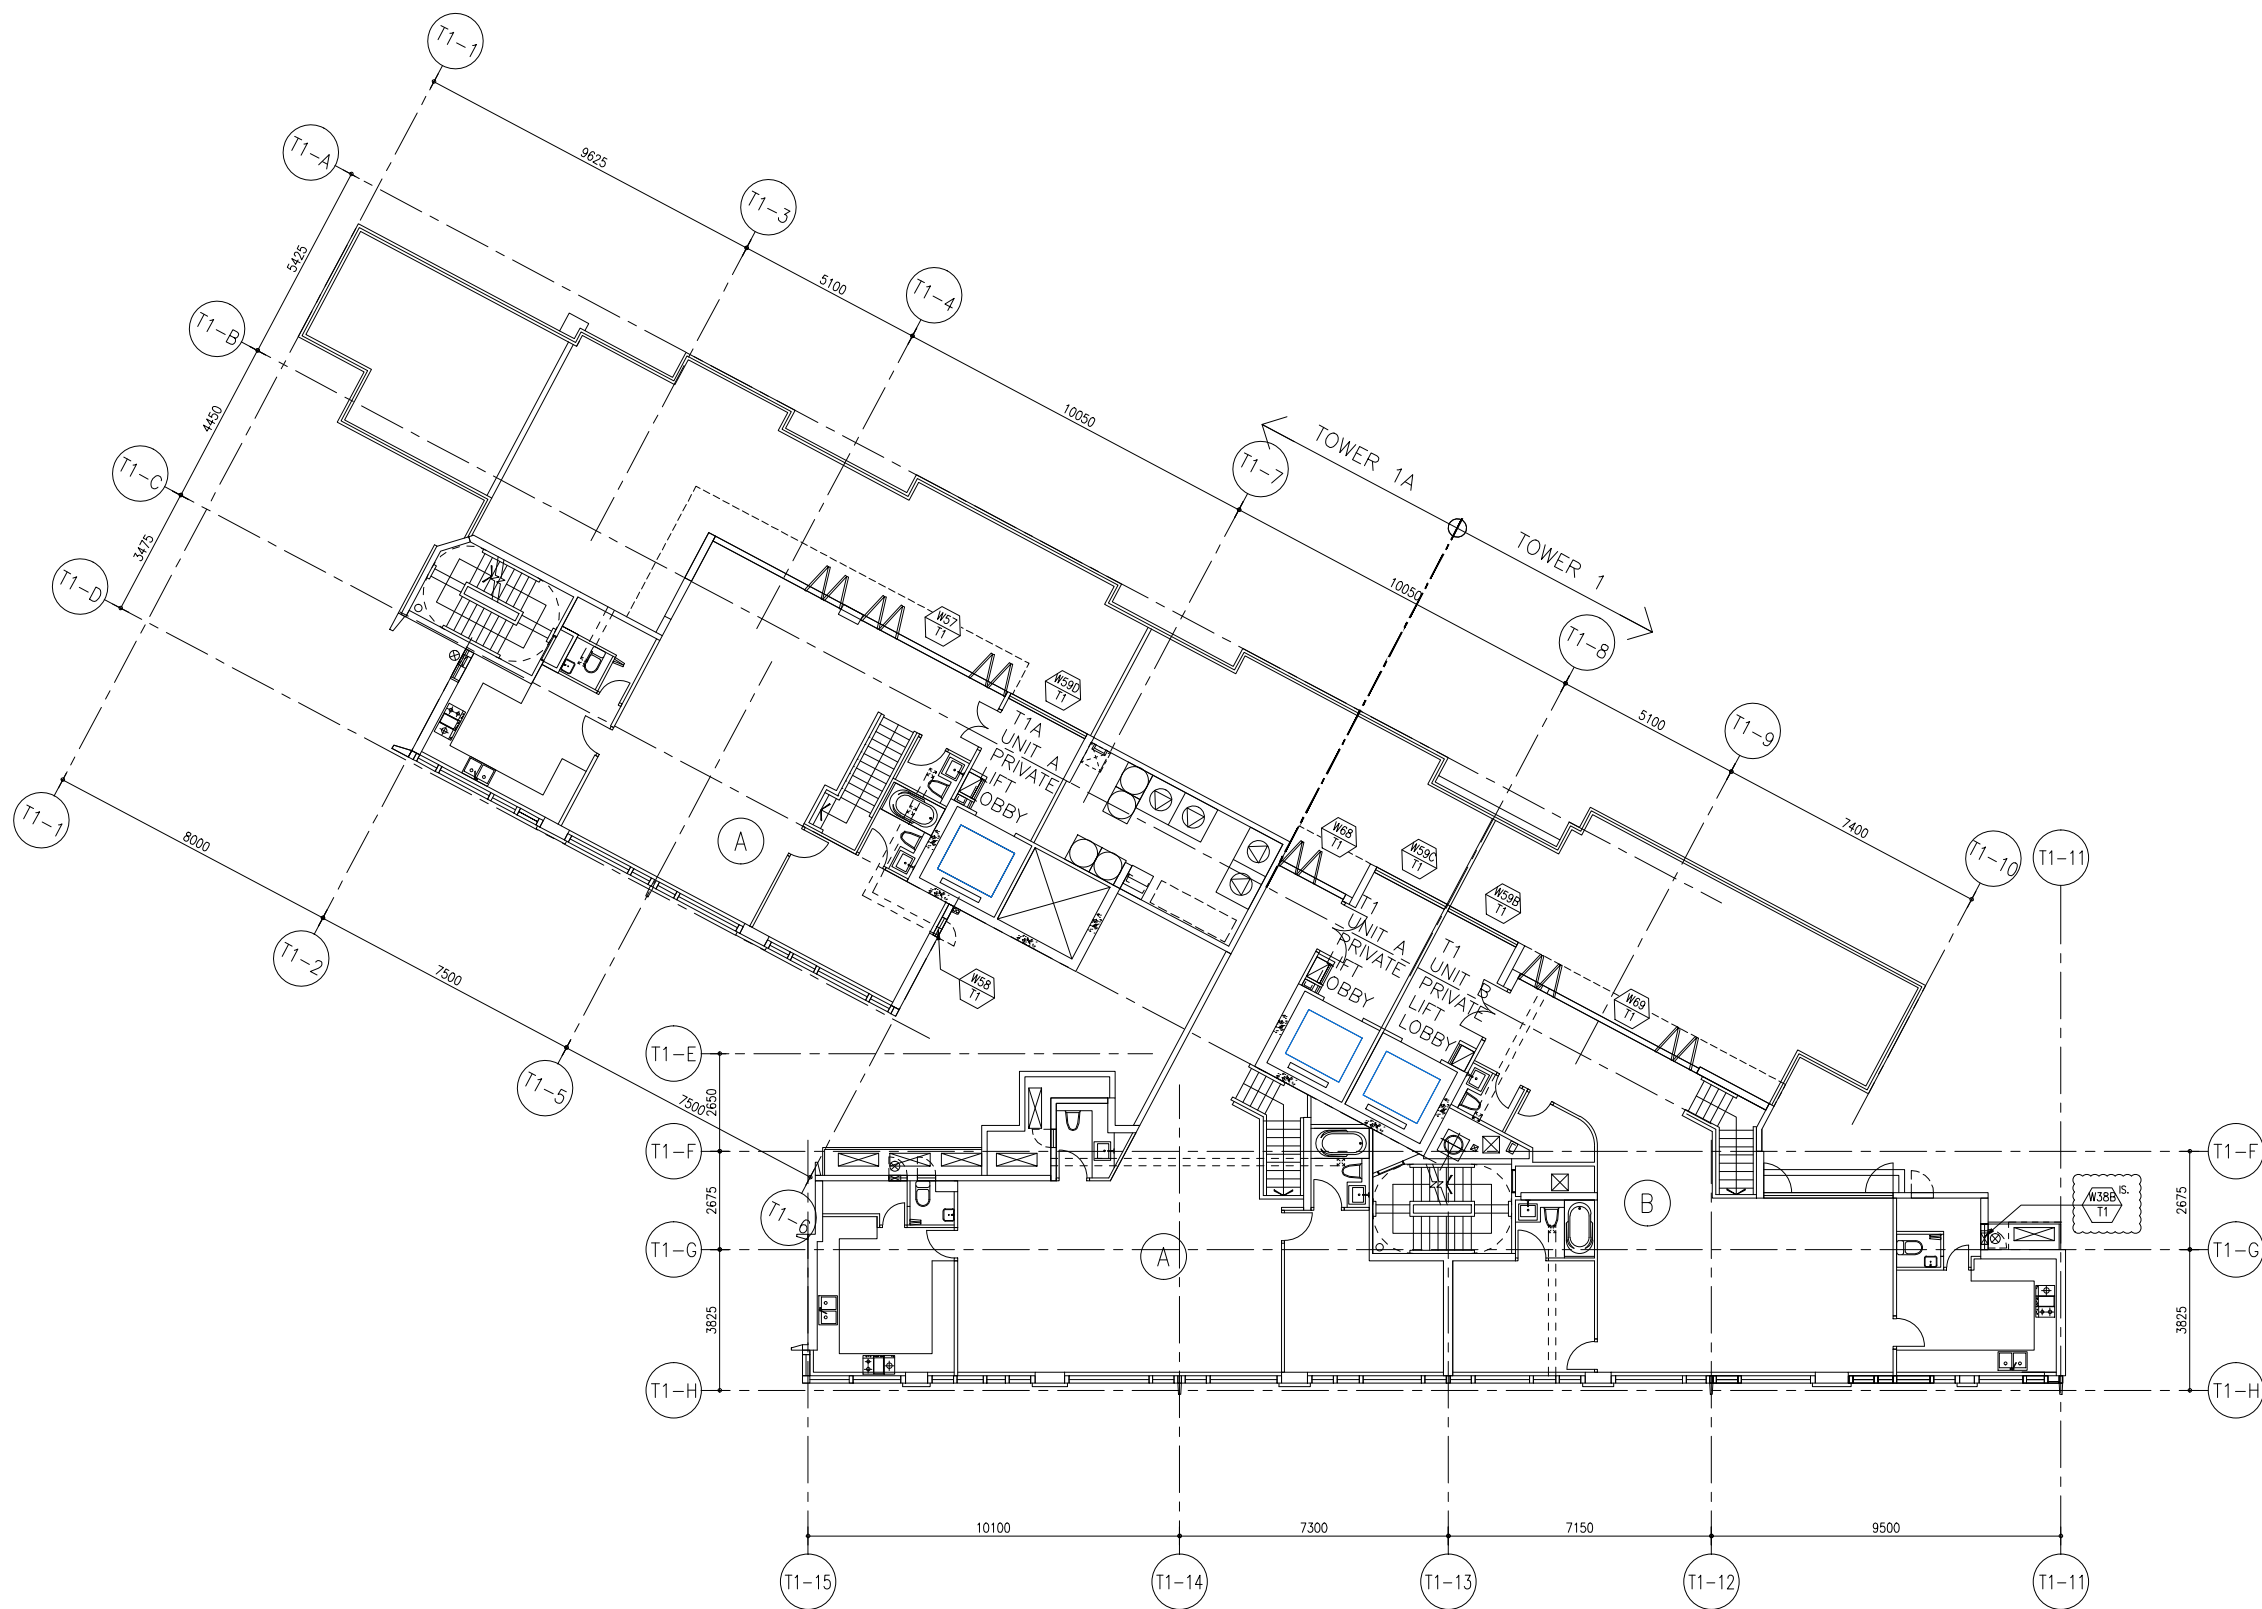

T1/T1A 35/F PLAN

B.D. REF :

F.S.D. REF :

Note :
1.All dimensions are in mm.
2.All elevations are viewed from outside.
3.All dimensions to be verified on site before fabrication.

GENERAL NOTES

Legend :

1. F.F.L.-- Finished Floor Level
2. S.F.L.-- Structural Floor Level
3. (R) -- Reversed Detail

X1--

X001--

DETAIL MARK NO.
REFER SHEET NO.

T1PFX

FACADE MARK

C	04.05.2020	GENERAL REVISION	
B	05.03.2020	GENERAL REVISION	
A	13.02.2020	GENERAL REVISION	
NO.	DATE	REVISED	BY

CLIENT :
佳明集團控股有限公司
GRAND MING GROUP HOLDINGS LIMITED

MAIN CONTRACTOR :
GRAND TECH CONSTRUCTION CO.LTD.

ARCHITECT :
WONG TUNG & PARTNERS LIMITED
ARCHITECTS & PLANNERS


STRUCTURAL ENGINEER :
 C M WONG & ASSOCIATES LTD

 美特鋁質有限公司
MIDI ALUMINIUM FABRICATOR LTD.
Units 6-8, Sunray Industrial Centre, 1/F
610 Cha Kwo Ling Road, Kowloon
Tel:23489211-4 Fax:(652)27727666

PROJECT :
RESIDENTIAL DEVELOPMENT AT
TSING YI TOWN LOT 190 SAI SHAN ROAD

TITLE :
WINDOW LOCATION PLAN
OF TOWER 1/ TOWER 1A (35/F)

JOB NO. : J-851

DRAWN BY :


DATE : 2-12-2019

CHKD BY :

SCALE: A1:
A3: 1:200

DWG. NO. : J851-IW-107

REV. : C

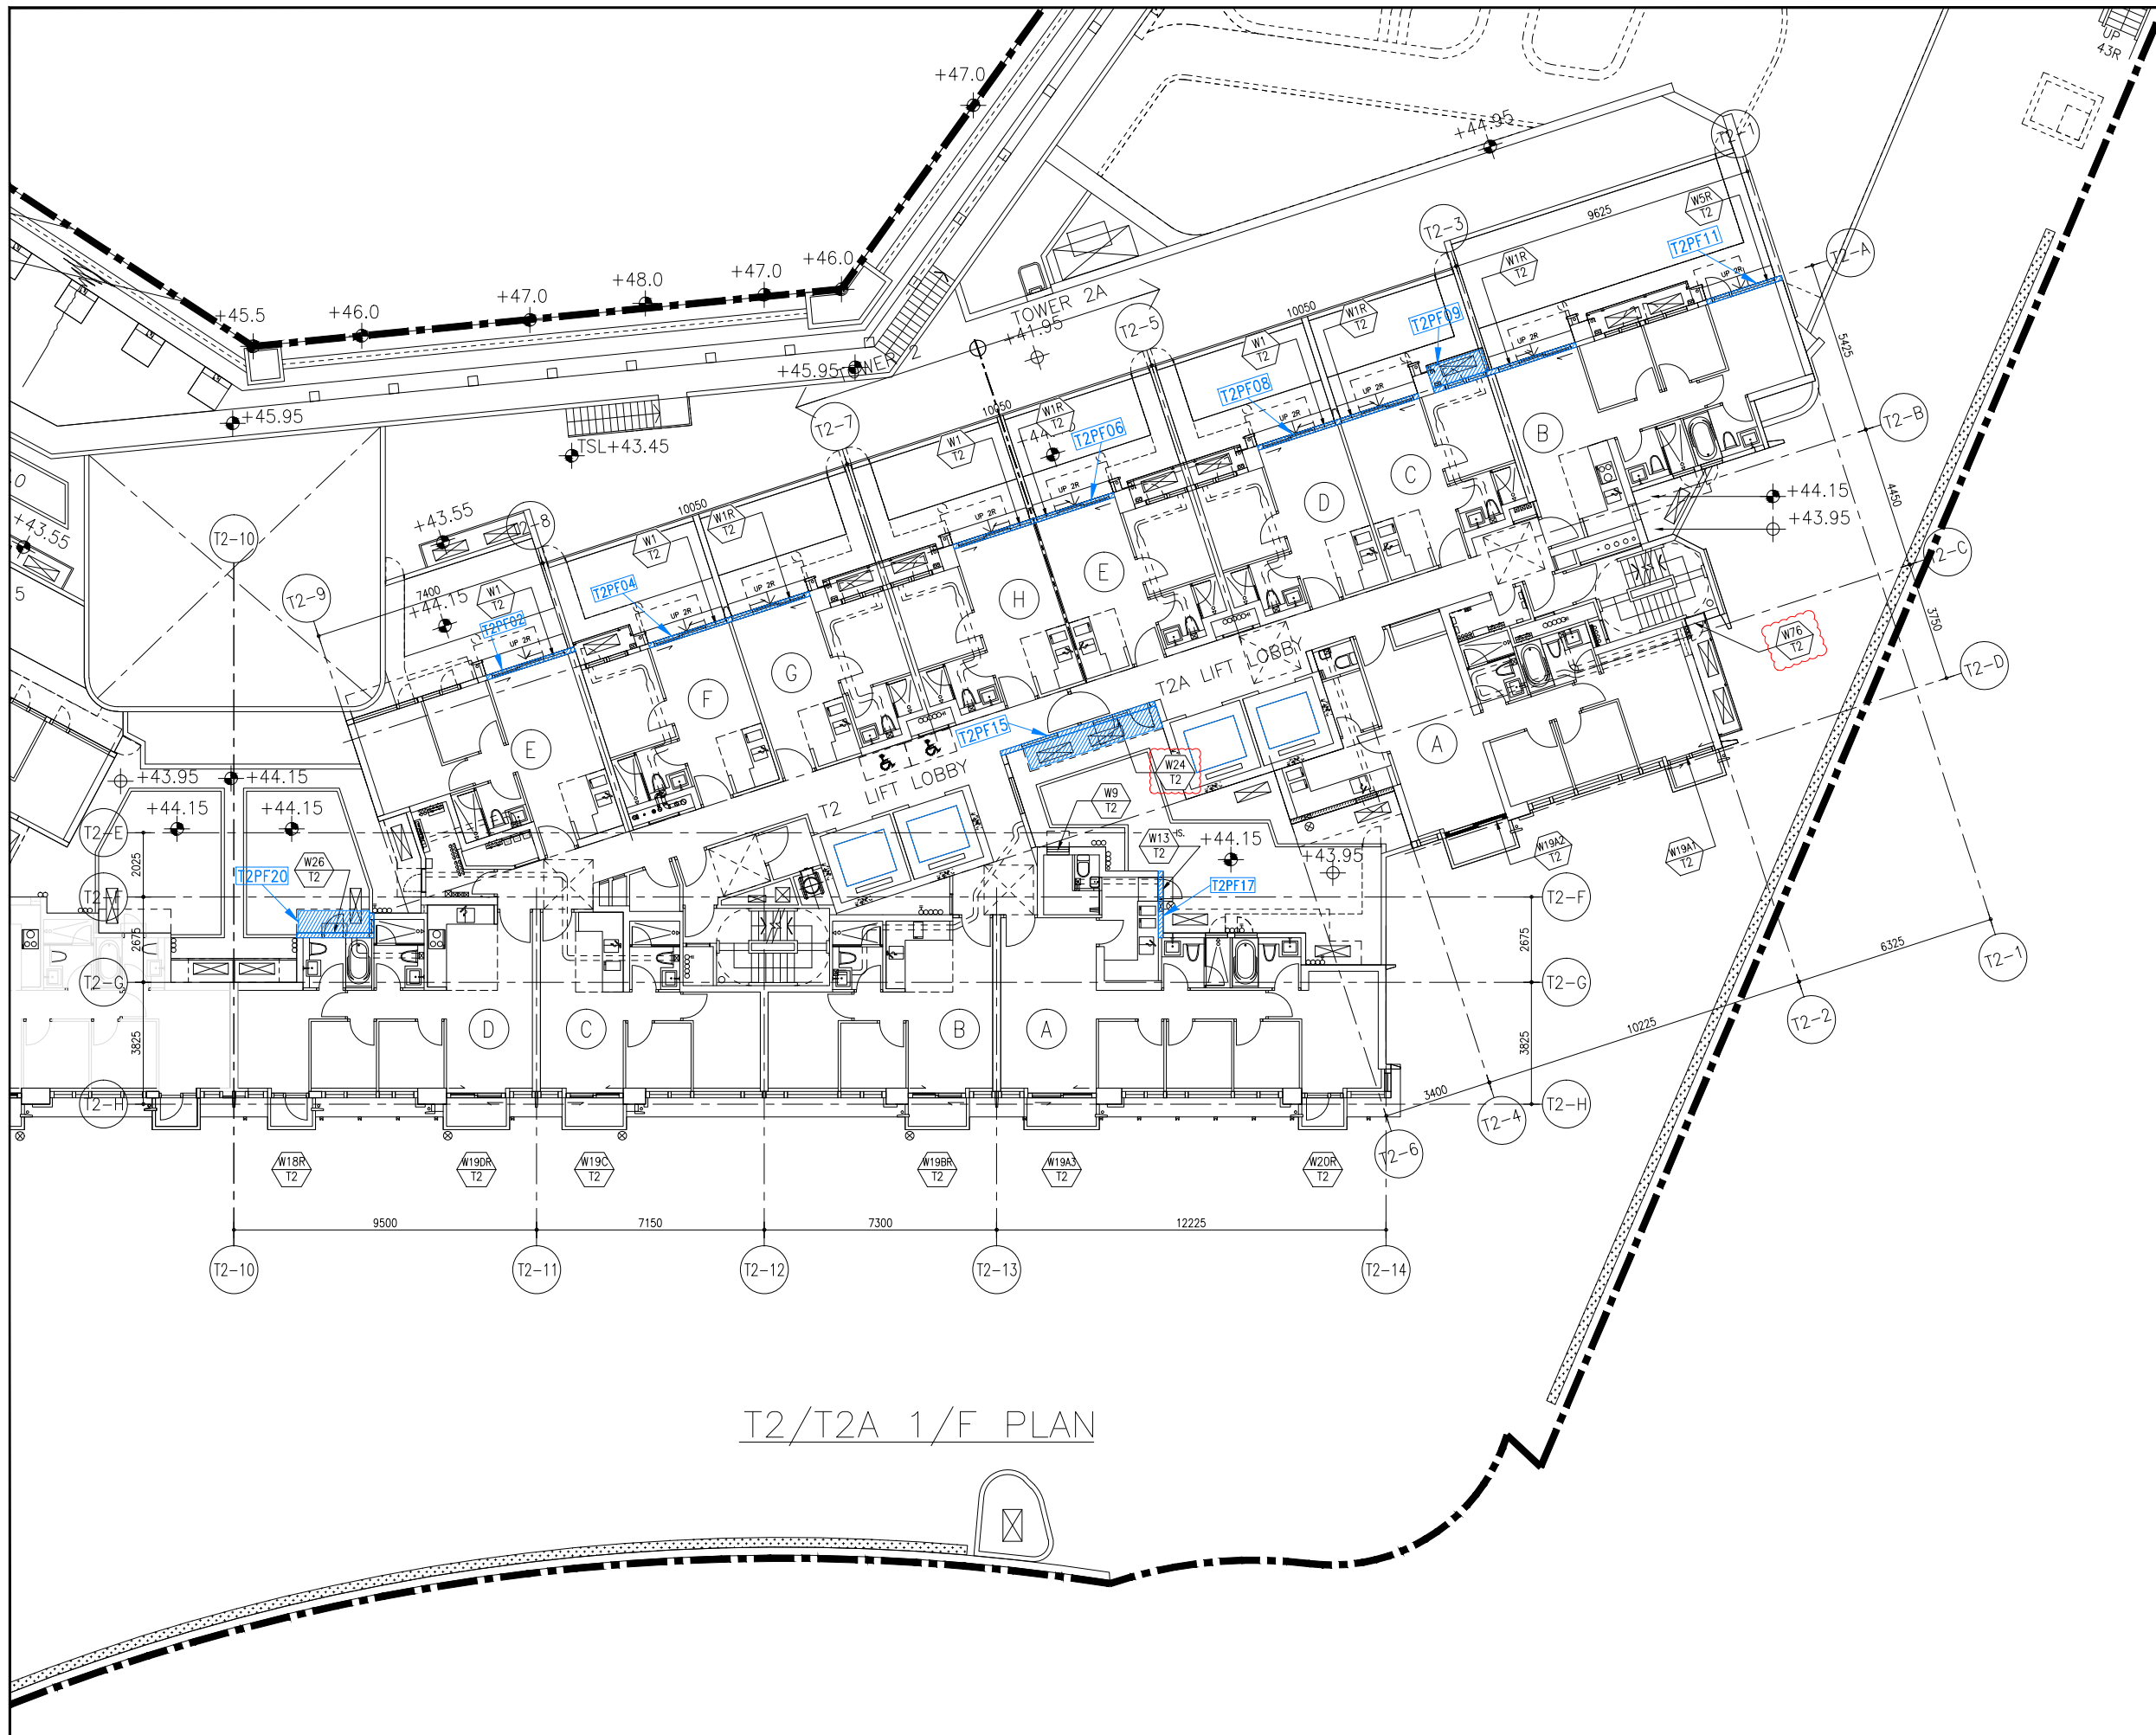

T2/T2A 1/F PLAN

B.D. REF :
F.S.D. REF :
Note :
1.All dimensions are in mm.
2.All elevations are viewed from outside.
3.All dimensions to be verified on site before fabrication.

GENERAL NOTES

Legend :
1. F.F.L.-- Finished Floor Level
2. S.F.L.-- Structural Floor Level
3. (R) -- Reversed Detail

X1-- DETAIL MARK NO.
X001-- REFER SHEET NO.

T2PFXX -- FACADE MARK

D	04.05.2020	GENERAL REVISION	
C	20.03.2020	GENERAL REVISION	
B	05.03.2020	GENERAL REVISION	
A	13.02.2020	GENERAL REVISION	
NO.	DATE	REVISED	BY

CLIENT :
佳明集團控股有限公司
GRAND MING GROUP HOLDINGS LIMITED

MAIN CONTRACTOR :
GRAND TECH CONSTRUCTION CO.LTD.

ARCHITECT :
WONG TUNG & PARTNERS LIMITED
ARCHITECTS & PLANNERS


STRUCTURAL ENGINEER :
 C M WONG & ASSOCIATES LTD

 美特鋁質有限公司
MIDI ALUMINIUM FABRICATOR LTD.
Units 6-8, Sunray Industrial Centre, 1/F
610 Cha Kwo Ling Road, Kowloon
Tel:23489211-4 Fax:(852)27727666

PROJECT :
RESIDENTIAL DEVELOPMENT AT
TSING YI TOWN LOT 190 SAI SHAN ROAD


TITLE :
WINDOW LOCATION PLAN
OF TOWER 2/ TOWER 2A (1/F)

JOB NO. : J-851


DRAWN BY :
DATE : 2-12-2019

CHKD BY :
SCALE : A1:
A3: 1:200

DWG. NO. : J851-IW-201
REV. : D

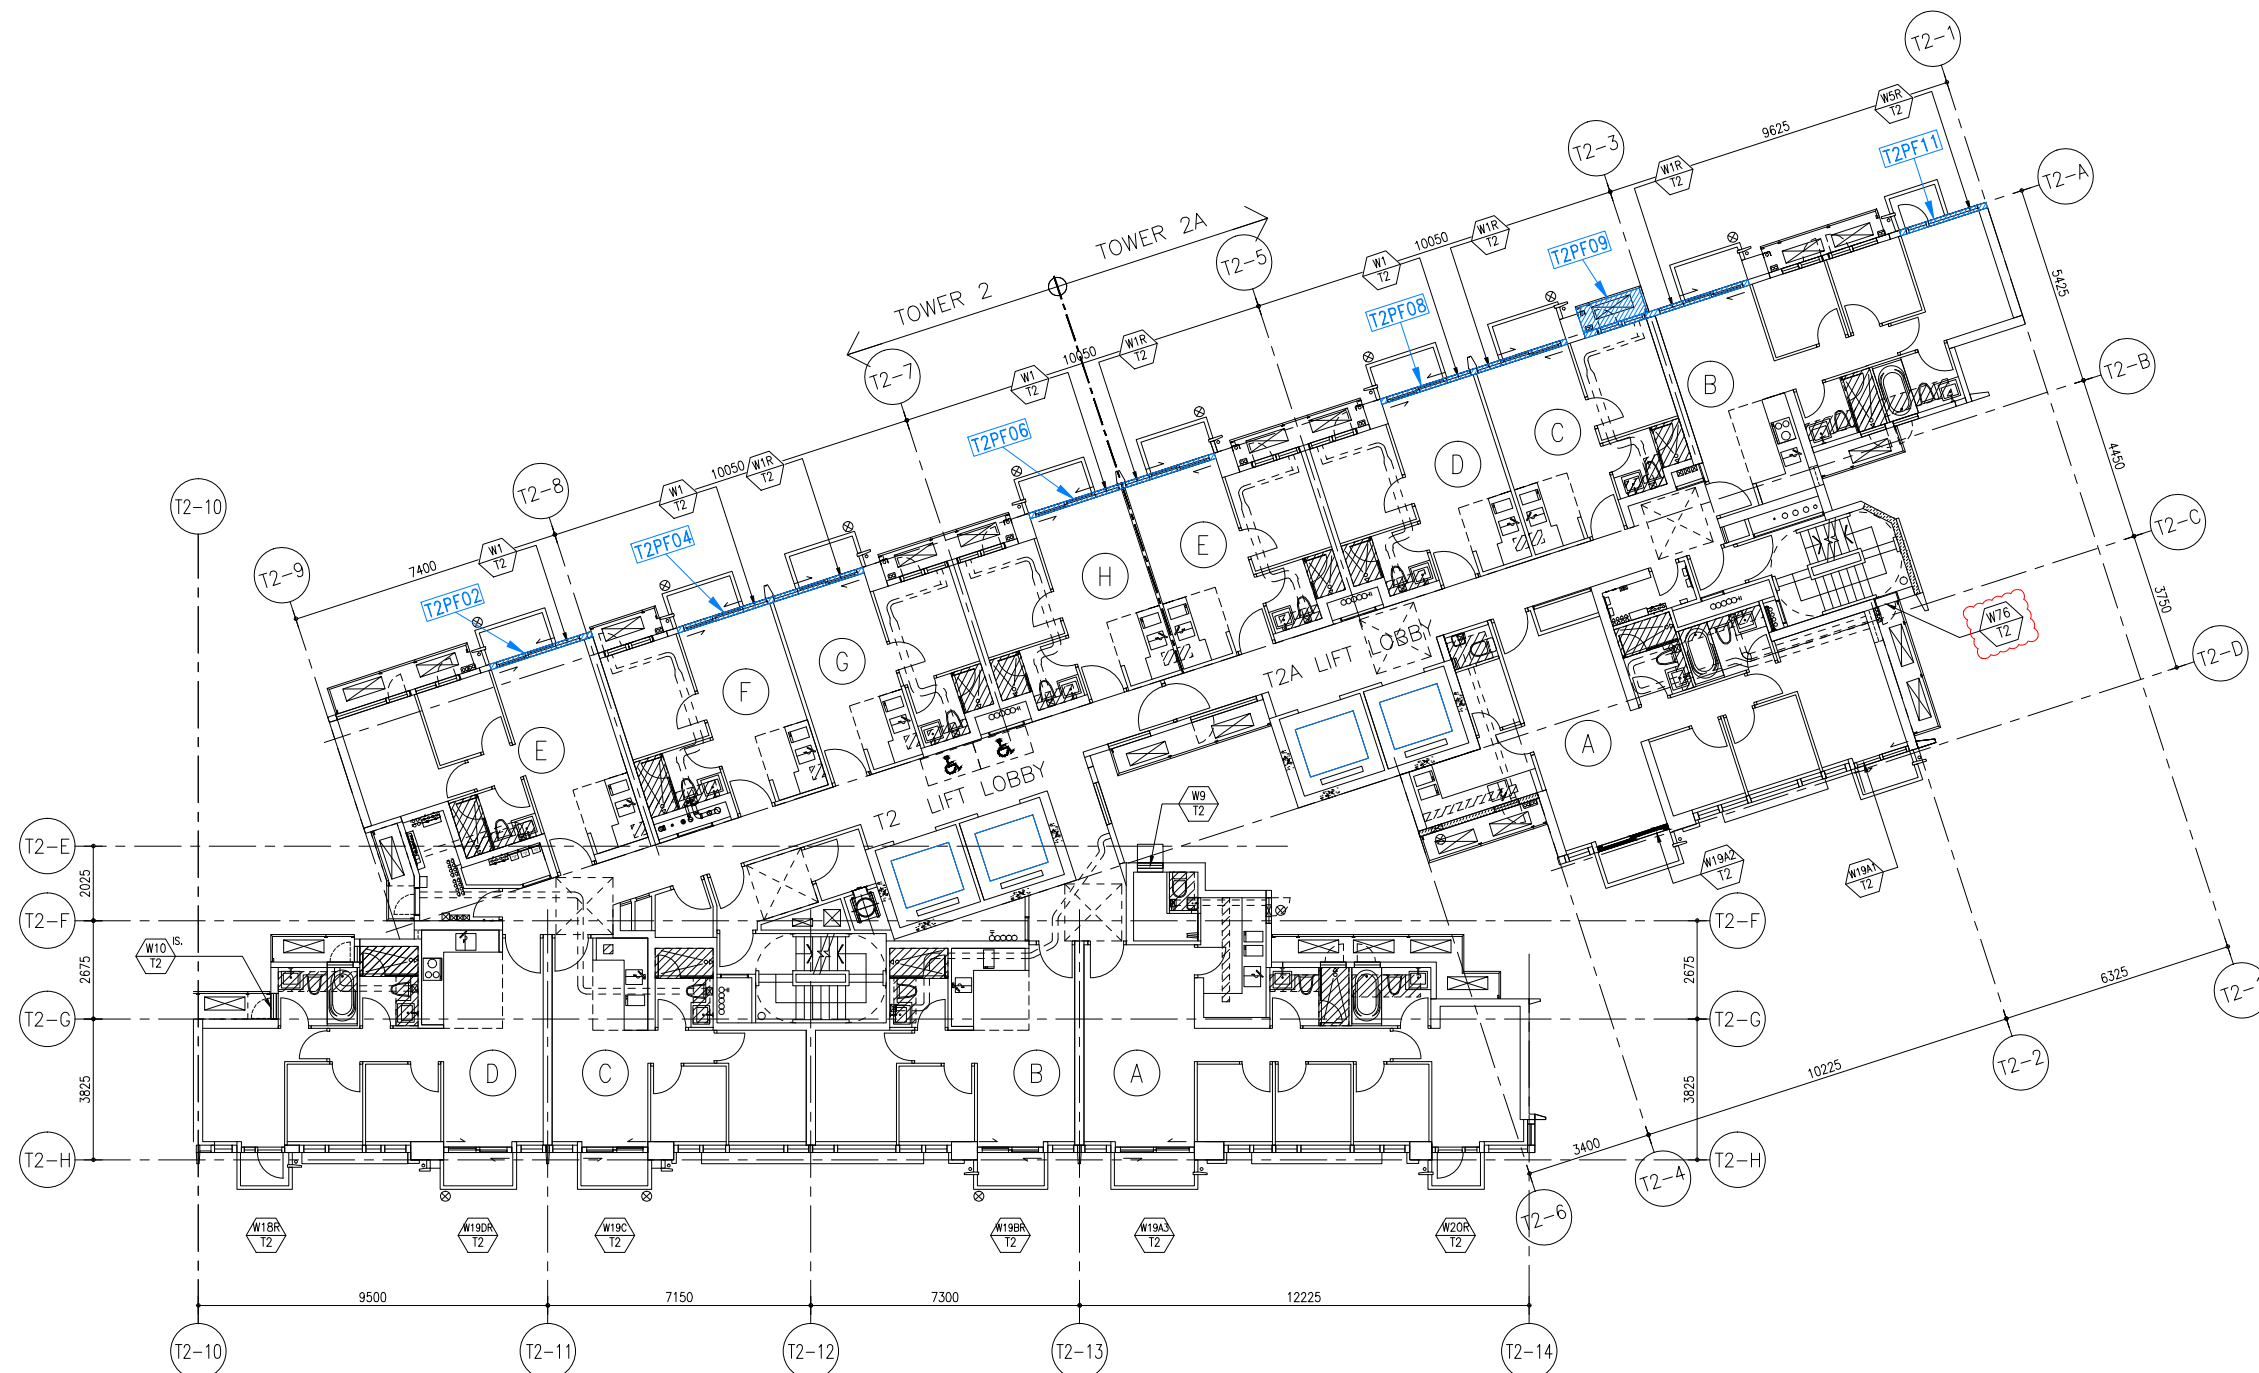

B.D. REF :	
------------	--

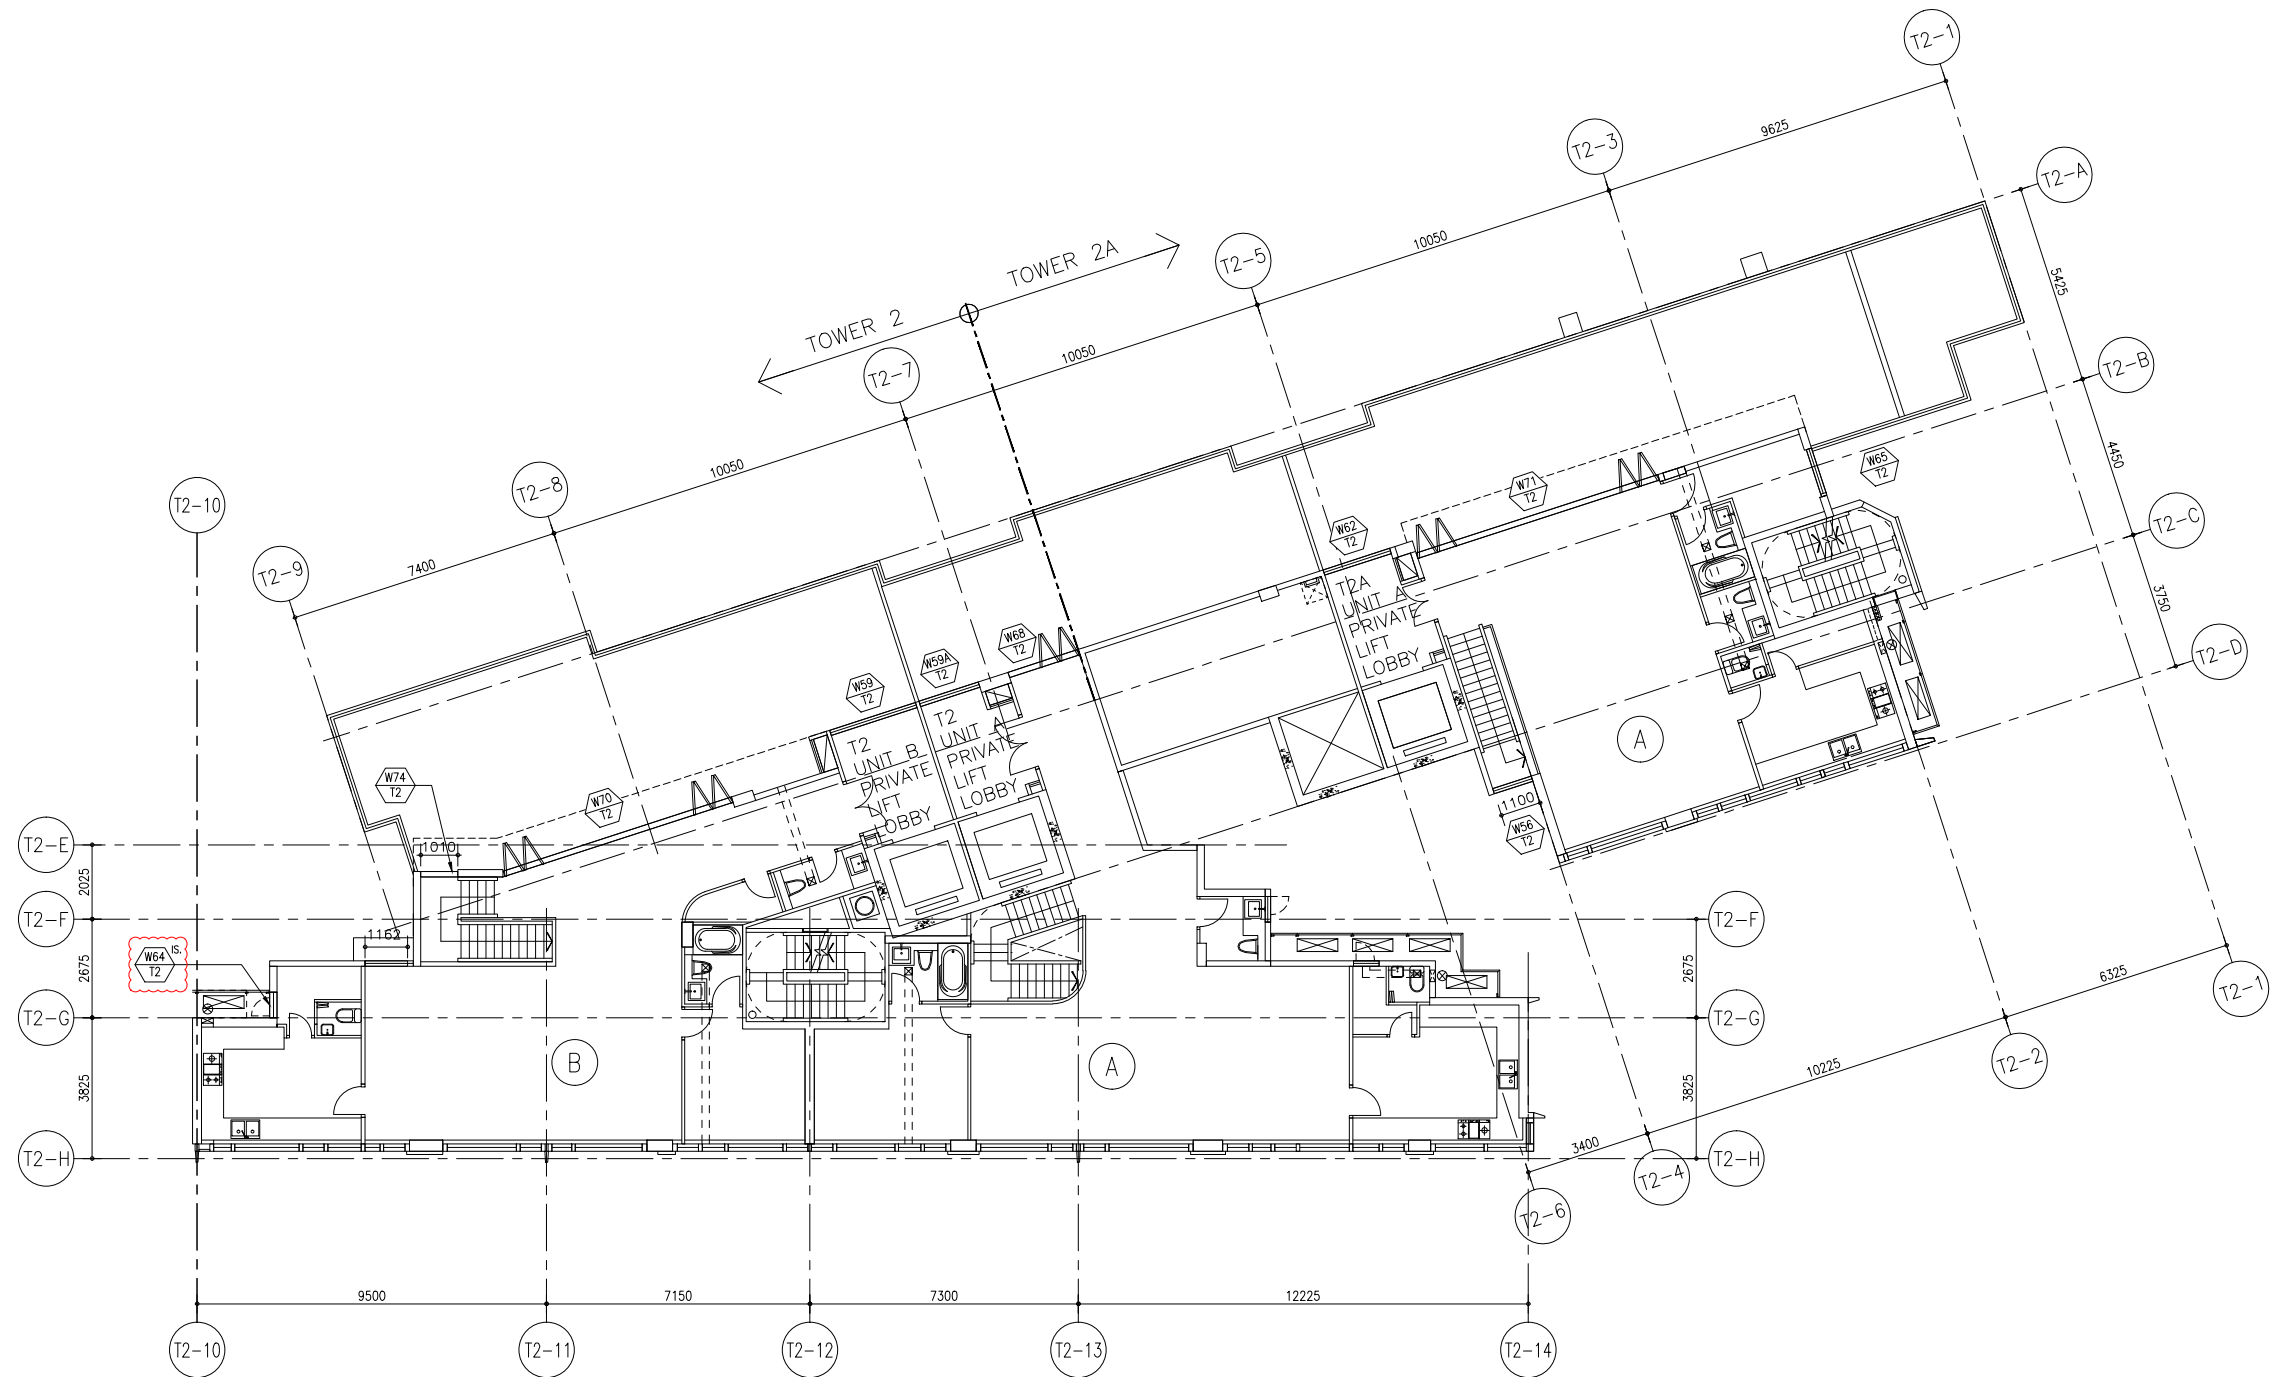

T2/T2A 35/F PLAN

B.D. REF :

F.S.D. REF :

Note :
1.All dimensions are in mm.
2.All elevations are viewed from outside.
3.All dimensions to be verified on site before fabrication.

GENERAL NOTES

Legend :
1. F.F.L.-- Finished Floor Level
2. S.F.L.-- Structural Floor Level
3. (R) -- Reversed Detail

X1--

X001--

DETAIL MARK NO.

REFER SHEET NO.

B	04.05.2020	GENERAL REVISION	
A	13.02.2020	GENERAL REVISION	
NO.	DATE	REVISED	BY

CLIENT :

佳明集團控股有限公司
GRAND MING GROUP HOLDINGS LIMITED

MAIN CONTRACTOR :

GRAND TECH CONSTRUCTION CO.LTD.

ARCHITECT :

WONG TUNG & PARTNERS LIMITED
ARCHITECTS & PLANNERS


STRUCTURAL ENGINEER :

 C M WONG & ASSOCIATES LTD

 美特鋁質有限公司
MIDI ALUMINIUM FABRICATOR LTD.
Units 6-8, Sunray Industrial Centre, 1/F
610 Cha Kwo Ling Road, Kowloon
Tel:23489211-4 Fax:(652)27727666

PROJECT :

RESIDENTIAL DEVELOPMENT AT
TSING YI TOWN LOT 190 SAI SHAN ROAD

TITLE :




WINDOW LOCATION PLAN
OF TOWER 2/ TOWER 2A (35/F)

JOB NO. : J-851

DRAWN BY : DATE : 2-12-2019

CHKD BY : SCALE A1:
A3: 1:200

DWG. NO. : J851-IW-205 REV. : B

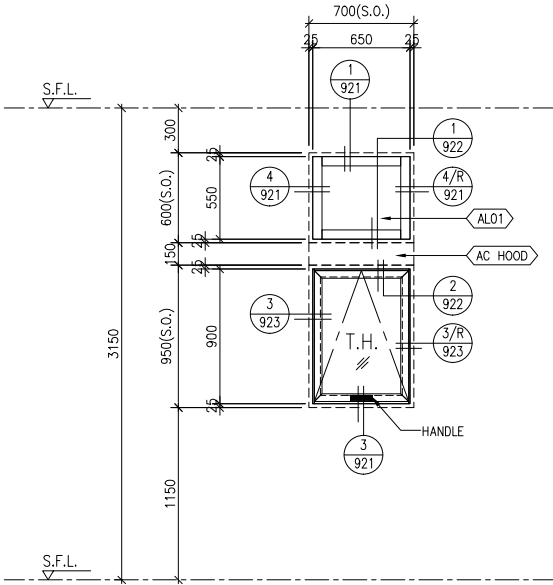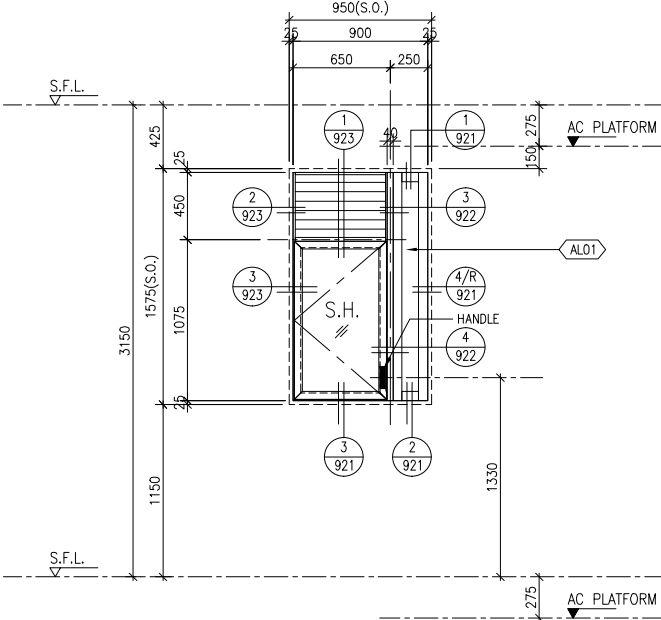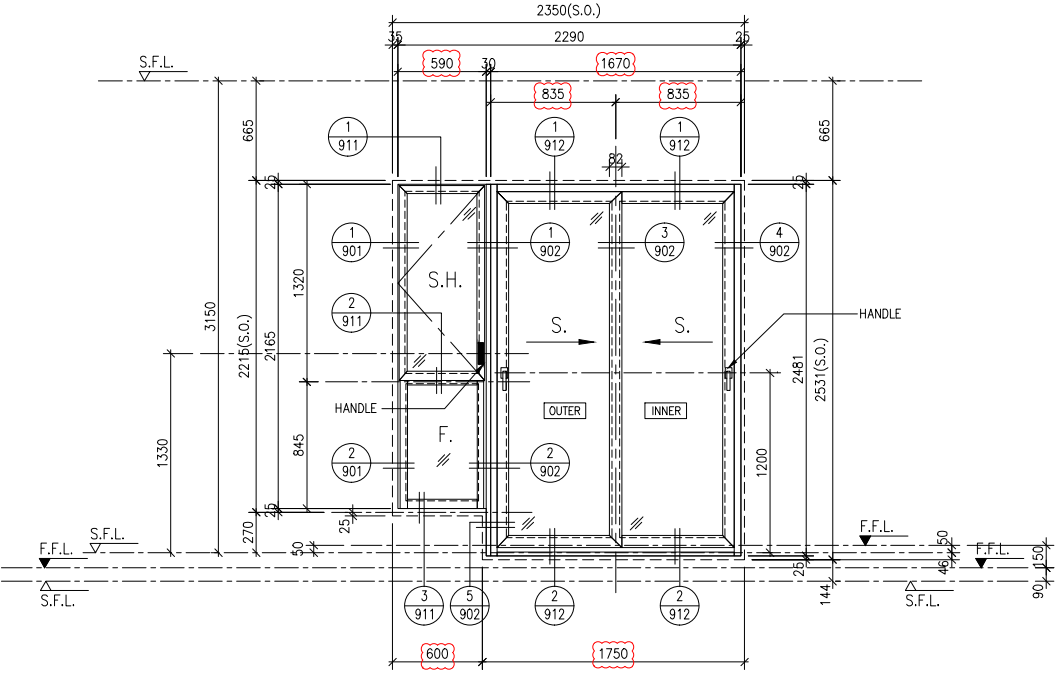OPENABLE AREA 0.49		GLAZING AREA 0.41					
WINDOW MARK	W9 T1	27 nos.	LOCATION	TOWER 1 - FLAT A UTILITY ROOM (1/F~31/F)			
GLAZING	GL06		FRAME	AL11			
REMARK	SITE IN-SITU WINDOW(4,13,14,24/F OMITTED)						
OPENABLE AREA 2.55		GLAZING AREA 2.31					
WINDOW MARK	W12 T1	27 nos.	LOCATION	TOWER 1A - FLAT A M.B.R. (1/F~31/F)			
GLAZING	GL06		FRAME	AL11			
REMARK	SITE IN-SITU WINDOW(4,13,14,24/F OMITTED)						
OPENABLE AREA 2.55		GLAZING AREA 2.31					
WINDOW MARK	W21 T1	27 nos.	LOCATION	TOWER 1A - FLAT C LIV. & DIN. (1/F~31/F)			
GLAZING	GL02		FRAME	AL11			
REMARK	PRECAST FACADE IN-SITU WINDOW(4,13,14,24/F OMITTED)						

B.D. REF :

F.S.D. REF :

Note :
1.All dimensions are in mm.
2.All elevations are viewed from outside.
3.All dimensions to be verified on site before fabrication.

GENERAL NOTES

Legend :

1. F.F.L.-- Finished Floor Level
2. S.F.L.-- Structural Floor Level
3. (R) -- Reversed Detail

X1

X001

DETAIL MARK NO.
REFER SHEET NO.

GL02 -- GREY BLUE MONOLITHIC GLASS (12mm) w/
DRAK GREY WINDOW FRAME IN PVF2 FINISH
GL06 -- GREY BLUE MONOLITHIC GLASS (12mm) w/
FROSTED TEXTURE AT INNER SURFACE
AL01 -- 3mm THK. ALUM. CLADDING

C	04.05.2020	MATCHING PRECAST FACADE TYPE T1PF03	
B	05.03.2020	GENERAL REVISION	
A	13.02.2020	GENERAL REVISION	
NO.	DATE	REVISED	BY

CLIENT :
佳明集團控股有限公司
GRAND MING GROUP HOLDINGS LIMITED

MAIN CONTRACTOR :
GRAND TECH CONSTRUCTION CO.LTD.

ARCHITECT :
WONG TUNG & PARTNERS LIMITED
ARCHITECTS & PLANNERS


STRUCTURAL ENGINEER :
 C M WONG & ASSOCIATES LTD

 美特鋁質有限公司
MIDI ALUMINIUM FABRICATOR LTD.
Units 6-8, Sunray Industrial Centre, 1/F
610 Cha Kwo Ling Road, Kowloon
Tel:23489211-4 Fax:(852)27727666

PROJECT :
RESIDENTIAL DEVELOPMENT AT
TSING YI TOWN LOT 190 SAI SHAN ROAD

TITLE :
WINDOW SCHEDULE
OF TOWER 1/ TOWER 1A


JOB NO. : J-851

DRAWN BY : DATE : 2-12-2019

CHKD BY : SCALE A1:
A3: 1:50

DWG. NO. : J851-IW-112 REV. : C

OPENABLE AREA	GLAZING AREA
0.83	1.03

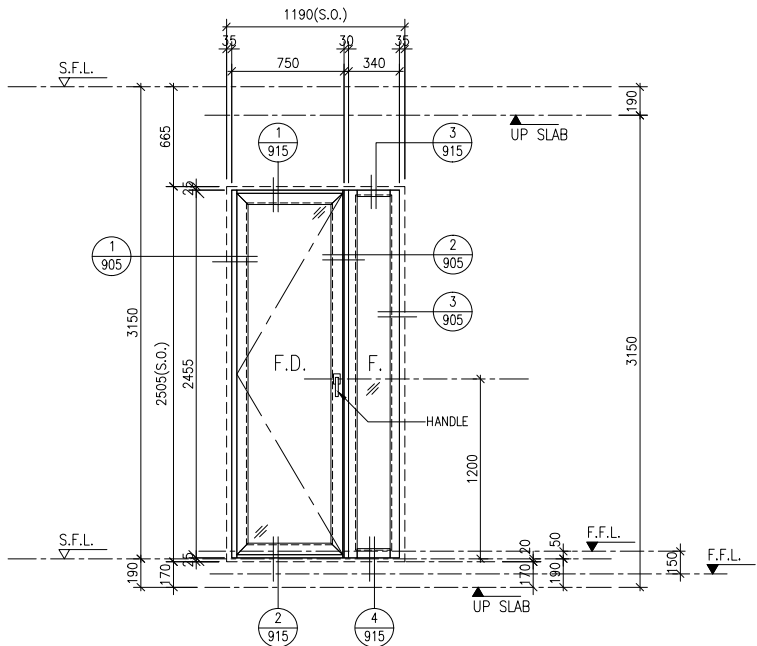

WINDOW MARK

W18
T1 27 nos.

LOCATION

TOWER 1 - FLAT D M.B.R. (1/F~31/F)

GLAZING

GL01


FRAME

AL11

REMARK

SITE IN-SITU WINDOW(4,13,14,24/F OMITTED)

OPENABLE AREA	GLAZING AREA
0.83	1.21

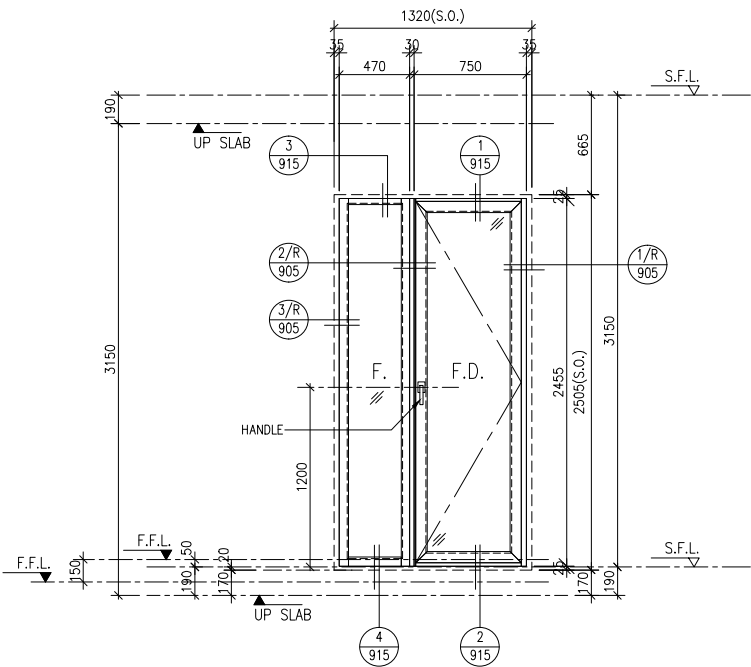

WINDOW MARK

W20
T1 27 nos.

LOCATION

TOWER 1 - FLAT A M.B.R. (1/F~31/F)

GLAZING

GL01


FRAME

AL11

REMARK

SITE IN-SITU WINDOW(4,13,14,24/F OMITTED)

WINDOW MARK	LOCATION	W(S.O.)	DOOR DIM.	NOS.	OPENABLE AREA	GLAZING AREA
T1-W19A1	TOWER 1A - FLAT A (1/F~31/F)	1785	1735	27	1.97	1.81
T1-W19B1	TOWER 1 - FLAT B (1/F~31/F)	1795	1745	27	1.98	1.82
T1-W19D	TOWER 1 - FLAT D (1/F~31/F)	1855	1805	27	2.06	1.90

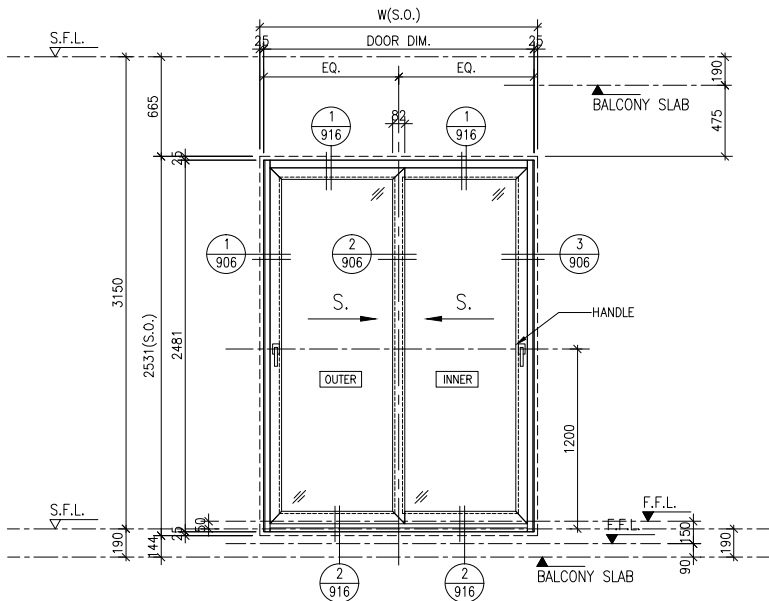

WINDOW MARK

W19A1
T1 W19B1
T1 W19D
T1

LOCATION

LIV. & DIN.

GLAZING

GL01


FRAME

AL11

REMARK

SITE IN-SITU WINDOW(4,13,14,24/F OMITTED)

WINDOW MARK	LOCATION	W(S.O.)	DOOR DIM.	NOS.	OPENABLE AREA	GLAZING AREA
T1-W19B2R	TOWER 1A - FLAT B (2/F~31/F)	1785	1735	26	1.97	1.81
T1-W19CR	TOWER 1 - FLAT C (1/F~31/F)	1795	1745	27	1.98	1.82
T1-W19A2R	TOWER 1 - FLAT A (1/F~31/F)	2145	2095	27	2.42	2.27

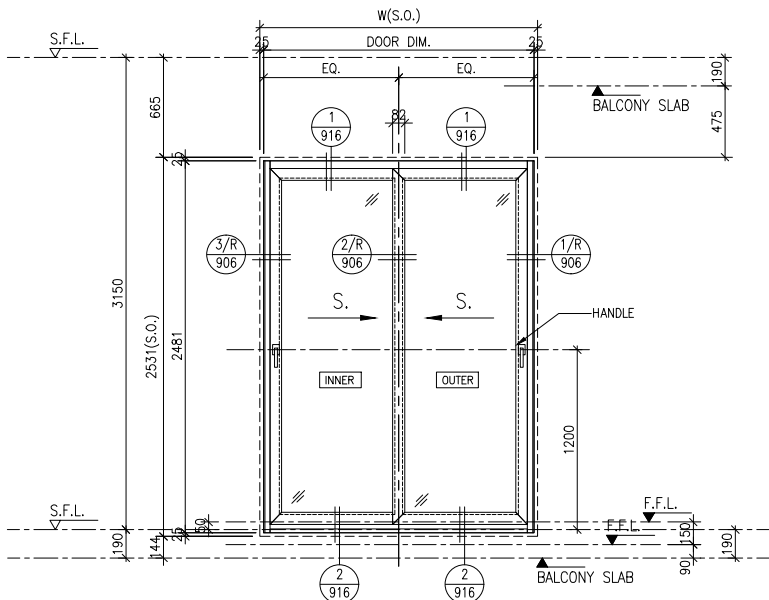

WINDOW MARK

W19B2R
T1 W19CR
T1 W19A2R
T1

LOCATION

LIV. & DIN.

GLAZING

GL01

FRAME


AL11

REMARK


SITE IN-SITU WINDOW(4,13,14,24/F OMITTED)

B.D. REF :			
F.S.D. REF :			
Note : 1.All dimensions are in mm. 2.All elevations are viewed from outside. 3.All dimensions to be verified on site before fabrication.			
GENERAL NOTES			
Legend : 1. F.F.L.-- Finished Floor Level 2. S.F.L.-- Structural Floor Level 3. (R) -- Reversed Detail			
X1 X001 DETAIL MARK NO. REFER SHEET NO.			
GL01 -- GREY BLUE IGU (6mm+12mm+8mm)			
D	04.05.2020	GENERAL REVISION	
C	20.03.2020	GENERAL REVISION	
B	05.03.2020	GENERAL REVISION	
A	13.02.2020	GENERAL REVISION	
NO.	DATE	REVISED	BY
CLIENT :			
佳明集團控股有限公司 GRAND MING GROUP HOLDINGS LIMITED			
MAIN CONTRACTOR :			
GRAND TECH CONSTRUCTION CO.LTD.			
ARCHITECT :			
WONG TUNG & PARTNERS LIMITED ARCHITECTS & PLANNERS 			
STRUCTURAL ENGINEER :			
C M WONG & ASSOCIATES LTD			
美特鋁質有限公司 MIDI ALUMINIUM FABRICATOR LTD. Units 6-8, Sunray Industrial Centre, 1/F 610 Cha Kwo Ling Road, Kowloon Tel:23489211-4 Fax:(852)27727666			
PROJECT :			
RESIDENTIAL DEVELOPMENT AT TSING YI TOWN LOT 190 SAI SHAN ROAD			
TITLE :			
WINDOW SCHEDULE OF TOWER 1/ TOWER 1A			
JOB NO. : J-851			
DRAWN BY :		DATE : 2-12-2019	
CHKD BY :		SCALE A1: A3: 1:50	
DWG. NO. : J851-IW-113			REV. : D

OPENABLE AREA	GLAZING AREA
1.09	1.32

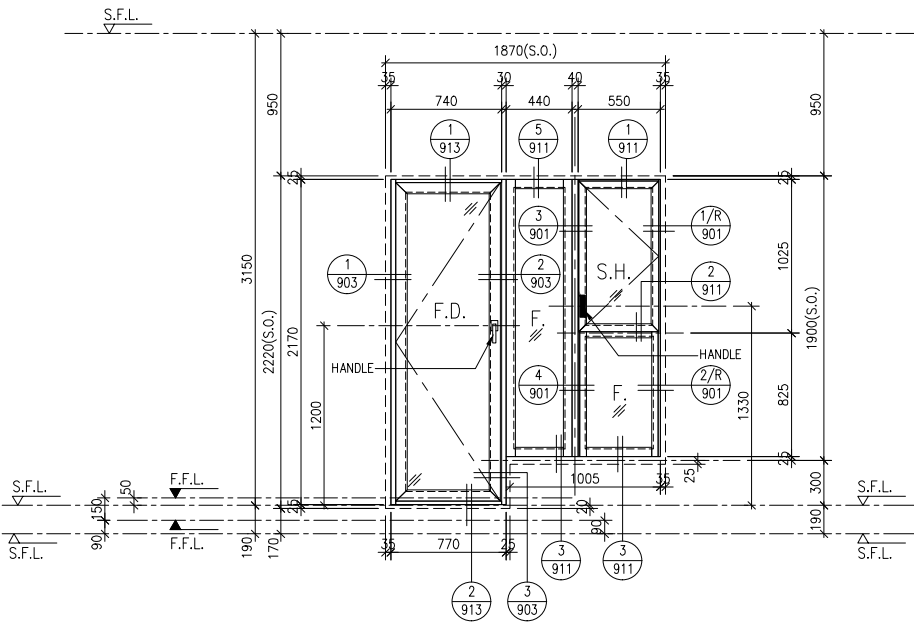

FREE AREA(%)	OPENABLE AREA	GLAZING AREA
56%	0.84	0.75

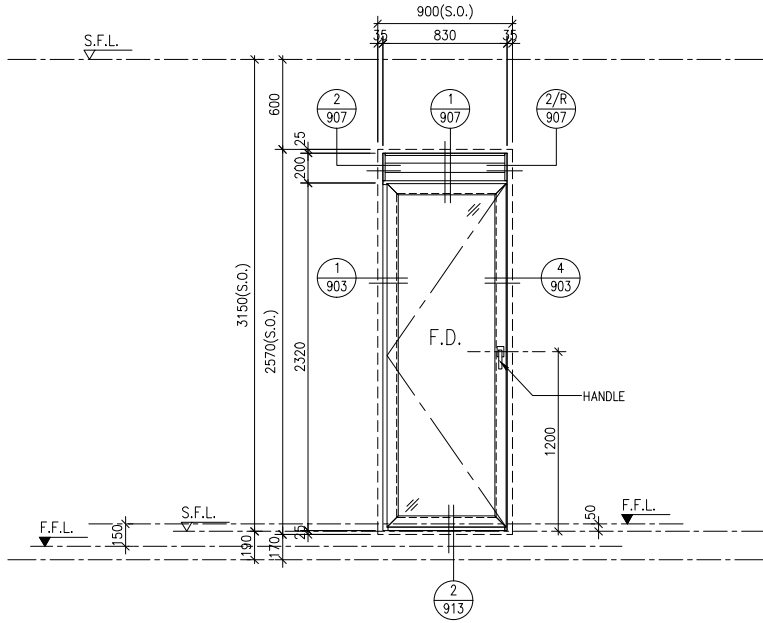

WINDOW MARK

W24
T1 1 no.

LOCATION

TOWER 1A – 1/F LIFT LOBBY CORRIDOR

GLAZING

GL08

FRAME

AL11

REMARK

PRECAST FACADE IN-SITU WINDOW

WINDOW MARK

W25
T1 1 no.

LOCATION

TOWER 1 – 1/F FLAT A STORE

GLAZING

GL02


FRAME

AL11

REMARK

PRECAST FACADE IN-SITU WINDOW

FREE AREA(%)	OPENABLE AREA	GLAZING AREA
56%	0.70	0.60

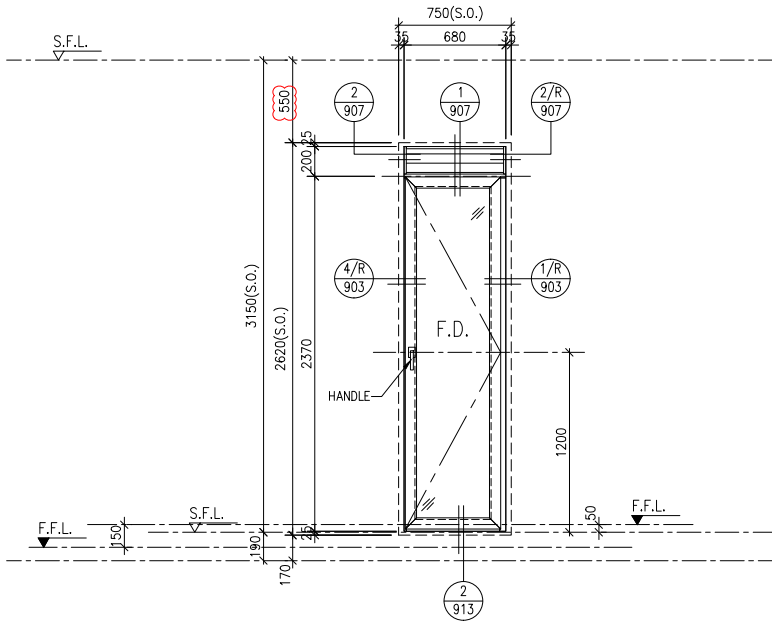

WINDOW MARK

W26
T1 1 no.

LOCATION

TOWER 1 – 1/F FLAT D M.BATH

GLAZING

GL06

FRAME

AL11

REMARK

PRECAST FACADE IN-SITU WINDOW

WINDOW MARK

LOCATION

GLAZING

FRAME

REMARK

B.D. REF :		
F.S.D. REF :		
Note : 1.All dimensions are in mm. 2.All elevations are viewed from outside. 3.All dimensions to be verified on site before fabrication.		
GENERAL NOTES		
Legend : 1. F.F.L.-- Finished Floor Level 2. S.F.L.-- Structural Floor Level 3. (R) -- Reversed Detail		
X1 DETAIL MARK NO. X001 REFER SHEET NO.		
GL02 -- GREY BLUE MONOLITHIC GLASS (12mm) w/ DRAK GREY WINDOW FRAME IN PVF2 FINISH		
GL06 -- GREY BLUE MONOLITHIC GLASS (12mm) w/ FROSTED TEXTURE AT INNER SURFACE		
GL08 -- CLEAR GLASS (12mm) w/ FROSTED TEXTURE AT INNER SURFACE		
B	05.03.2020	GENERAL REVISION
A	13.02.2020	GENERAL REVISION
NO.	DATE	REVISED
		BY
CLIENT :		
佳明集團控股有限公司 GRAND MING GROUP HOLDINGS LIMITED		
MAIN CONTRACTOR :		
GRAND TECH CONSTRUCTION CO.LTD.		
ARCHITECT : WONG TUNG & PARTNERS LIMITED ARCHITECTS & PLANNERS		
STRUCTURAL ENGINEER :		
C M WONG & ASSOCIATES LTD		
美特鋁質有限公司 MIDI ALUMINIUM FABRICATOR LTD.		
Units 6-8, Sunray Industrial Centre, 1/F 610 Cha Kwo Ling Road, Kowloon Tel:23489211-4 Fax:(852)27727666		
PROJECT :		
RESIDENTIAL DEVELOPMENT AT TSING YI TOWN LOT 190 SAI SHAN ROAD		
TITLE :		
WINDOW SCHEDULE OF TOWER 1/ TOWER 1A		
JOB NO. : J-851		
DRAWN BY :		DATE : 2-12-2019
CHKD BY :		SCALE A1: A3: 1:50
DWG. NO. : J851-IW-114		REV. : B

OPENABLE AREA		GLAZING AREA	
0.49		0.41	

WINDOW MARK	W39 T1 1 no.	LOCATION	TOWER 1 – FLAT A UTILITY ROOM (32/F)
GLAZING	GL06	FRAME	AL11
REMARK	SITE IN-SITU WINDOW		

OPENABLE AREA	GLAZING AREA
2.55	2.31


WINDOW MARK	W51 T1 2 nos.	LOCATION	TOWER 1A – FLAT C LIV. & DIN. (32/F~33/F)
GLAZING	GL02	FRAME	AL11
REMARK	PRECAST FACADE IN-SITU WINDOW		

FREE AREA(%)	OPENABLE AREA	GLAZING AREA
56%	0.78	0.66


WINDOW MARK	W42 T1 1 no.	LOCATION	TOWER 1A – FLAT A M.B.R. (32/F)
GLAZING	GL06	FRAME	AL11
REMARK	SITE IN-SITU WINDOW		

B.D. REF :	
F.S.D. REF :	
Note : 1.All dimensions are in mm. 2.All elevations are viewed from outside. 3.All dimensions to be verified on site before fabrication.	
GENERAL NOTES	
Legend : 1. F.F.L.-- Finished Floor Level 2. S.F.L.-- Structural Floor Level 3. (R) -- Reversed Detail	
X1 DETAIL MARK NO. X001 REFER SHEET NO.	
GL02 -- GREY BLUE MONOLITHIC GLASS (12mm) w/ DRAK GREY WINDOW FRAME IN PVF2 FINISH	
GL06 -- GREY BLUE MONOLITHIC GLASS (12mm) w/ FROSTED TEXTURE AT INNER SURFACE	
(AL01) -- 3mm THK. ALUM. CLADDING	
C 04.05.2020 MATCHING PRECAST FACADE TYPE T1PF03	
B 05.03.2020 GENERAL REVISION	
A 13.02.2020 GENERAL REVISION	
NO.	DATE
	REVISED
	BY
CLIENT :	
佳明集團控股有限公司 GRAND MING GROUP HOLDINGS LIMITED	
MAIN CONTRACTOR :	
GRAND TECH CONSTRUCTION CO.LTD.	
ARCHITECT :	
WONG TUNG & PARTNERS LIMITED ARCHITECTS & PLANNERS	
STRUCTURAL ENGINEER :	
C M WONG & ASSOCIATES LTD	
美特鋁質有限公司 MIDI ALUMINIUM FABRICATOR LTD.	
Units 6-8, Sunray Industrial Centre, 1/F 610 Cha Kwo Ling Road, Kowloon Tel:23489211-4 Fax:(852)27727666	
PROJECT :	
RESIDENTIAL DEVELOPMENT AT TSING YI TOWN LOT 190 SAI SHAN ROAD	
TITLE :	
WINDOW SCHEDULE OF TOWER 1/ TOWER 1A	
JOB NO. : J-851	
DRAWN BY :	DATE : 2-12-2019
CHKD BY :	SCALE A1: A3: 1:50
DWG. NO. : J851-IW-116	REV. : C

OPENABLE AREA	GLAZING AREA
0.83	1.03

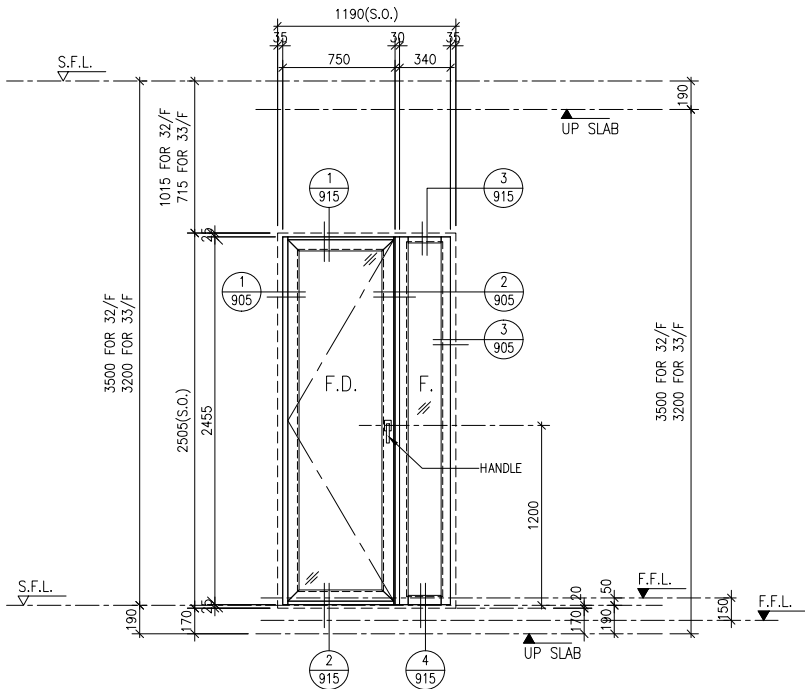

WINDOW MARK

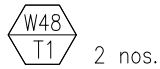

LOCATION

TOWER 1 - FLAT D M.B.R. (32/F~33/F)

GLAZING

GL01


FRAME

AL11


REMARK

SITE IN-SITU WINDOW

OPENABLE AREA	GLAZING AREA
0.83	1.21

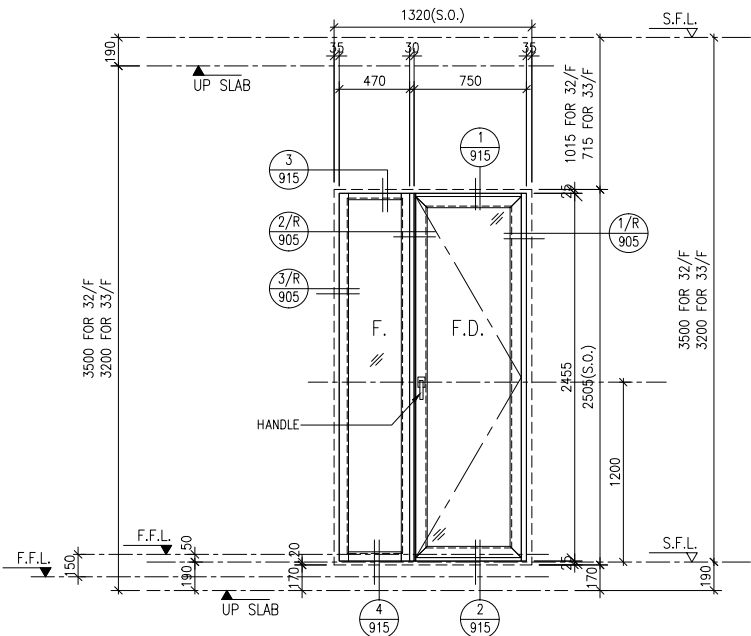

WINDOW MARK

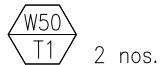

LOCATION

TOWER 1 - FLAT A M.B.R. (32/F~33/F)

GLAZING

GL01


FRAME

AL11

REMARK

SITE IN-SITU WINDOW

WINDOW MARK	LOCATION	W(S.O.)	DOOR DIM.	NOS.	OPENABLE AREA	GLAZING AREA
T1-W49A1	TOWER 1A - FLAT A (32/F~33/F)	1785	1735	2	1.97	1.81
T1-W49B1	TOWER 1 - FLAT B (32/F)	1795	1745	1	1.98	1.82
T1-W49D	TOWER 1 - FLAT D (32/F)	1855	1805	1	2.06	1.90

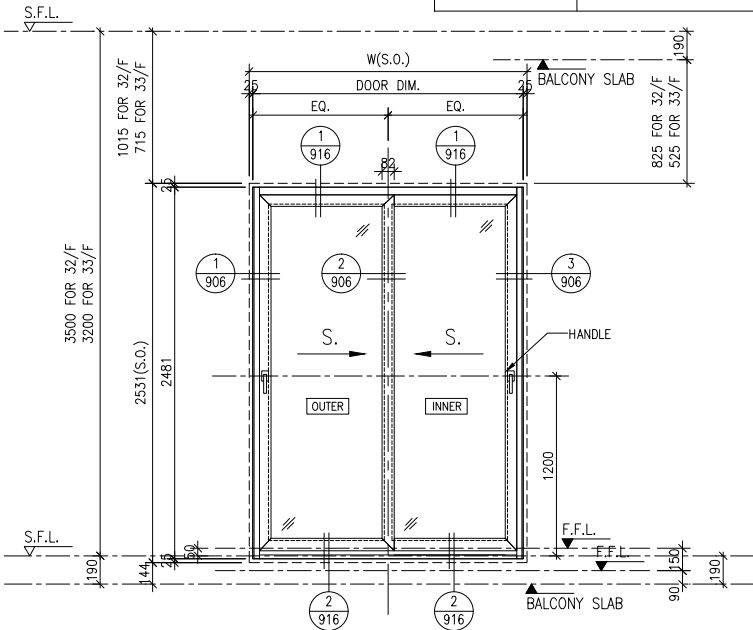

WINDOW MARK



LOCATION

LIV. & DIN.

GLAZING

GL01


FRAME

AL11

REMARK

SITE IN-SITU WINDOW

WINDOW MARK	LOCATION	W(S.O.)	DOOR DIM.	NOS.	OPENABLE AREA	GLAZING AREA
T1-W49B2R	TOWER 1A - FLAT B (32/F)	1785	1735	1	1.97	1.81
T1-W49A1R	TOWER 1A - FLAT A (33/F)	1785	1735	1	1.97	1.81
T1-W49CR	TOWER 1 - FLAT C (32/F)	1795	1745	1	1.98	1.82
T1-W49B1R	TOWER 1 - FLAT B (33/F)	1795	1745	1	1.98	1.82
T1-W49A2R	TOWER 1 - FLAT A (32/F~33/F)	2145	2095	2	2.42	2.27

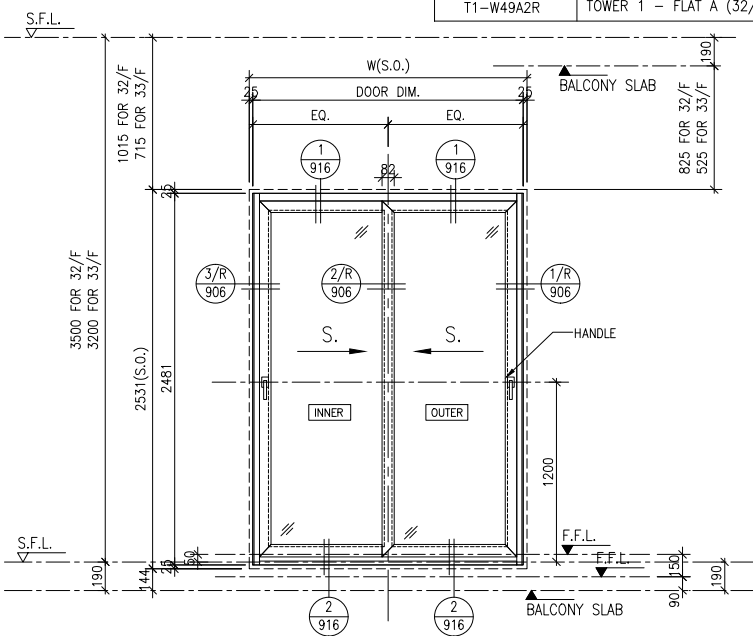

WINDOW MARK



LOCATION

LIV. & DIN.

GLAZING

GL01

FRAME

AL11

REMARK


SITE IN-SITU WINDOW

B.D. REF :
F.S.D. REF :
Note :
1.All dimensions are in mm.
2.All elevations are viewed from outside.
3.All dimensions to be verified on site before fabrication.

GENERAL NOTES

Legend :

1. F.F.L.-- Finished Floor Level
2. S.F.L.-- Structural Floor Level
3. (R) -- Reversed Detail

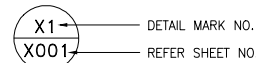

GL01 -- GREY BLUE IGU (6mm+12mm+8mm)

D	04.05.2020	GENERAL REVISION	
C	20.03.2020	GENERAL REVISION	
B	05.03.2020	GENERAL REVISION	
A	13.02.2020	GENERAL REVISION	
NO.	DATE	REVISED	BY

CLIENT :

佳明集團控股有限公司
GRAND MING GROUP HOLDINGS LIMITED

MAIN CONTRACTOR :

GRAND TECH CONSTRUCTION CO.LTD.



STRUCTURAL ENGINEER :



Units 6-8, Sunray Industrial Centre, 1/F
610 Cha Kwo Ling Road, Kowloon
Tel:23489211-4 Fax:(852)27727666

PROJECT :

RESIDENTIAL DEVELOPMENT AT
TSING YI TOWN LOT 190 SAI SHAN ROAD

TITLE :

WINDOW SCHEDULE
OF TOWER 1/ TOWER 1A

JOB NO. : J-851

DRAWN BY :

DATE :
2-12-2019


CHKD BY :

SCALE A1:
A3: 1:50


DWG. NO. : J851-IW-117

REV. : D

OPENABLE AREA	GLAZING AREA
0.67	0.56

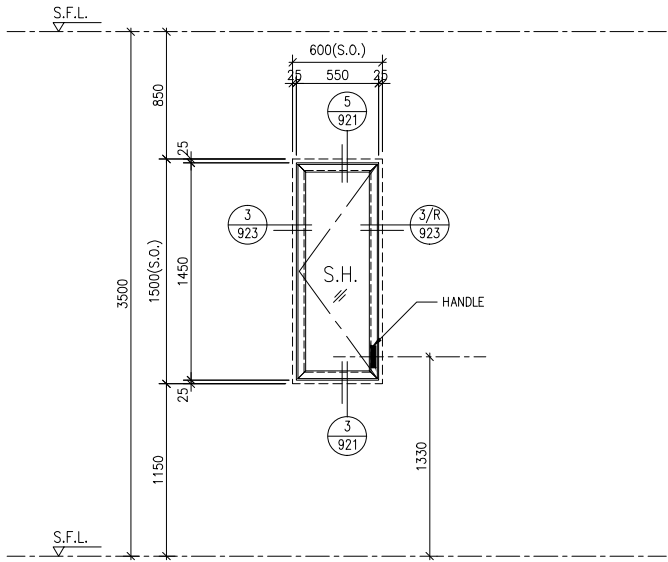


FREE AREA(%)	OPENABLE AREA	GLAZING AREA
56%	0.64	0.53

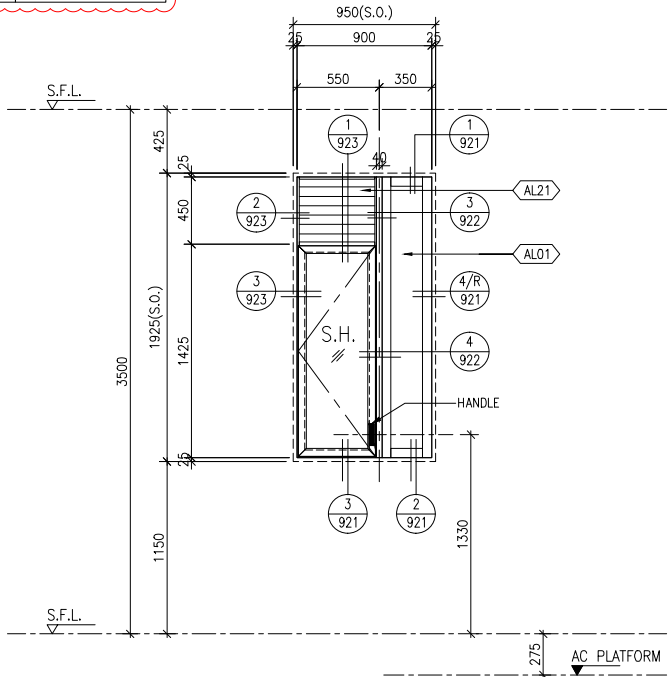

WINDOW MARK	W54 T1 2 nos.	LOCATION	TOWER 1 – FLAT A BATHROOM(33/F) TOWER 1 – FLAT B BATHROOM(33/F)
GLAZING	GL06	FRAME	AL11
REMARK	SITE IN–SITU WINDOW		

FREE AREA(%)	OPENABLE AREA	GLAZING AREA
56%	0.64	0.53

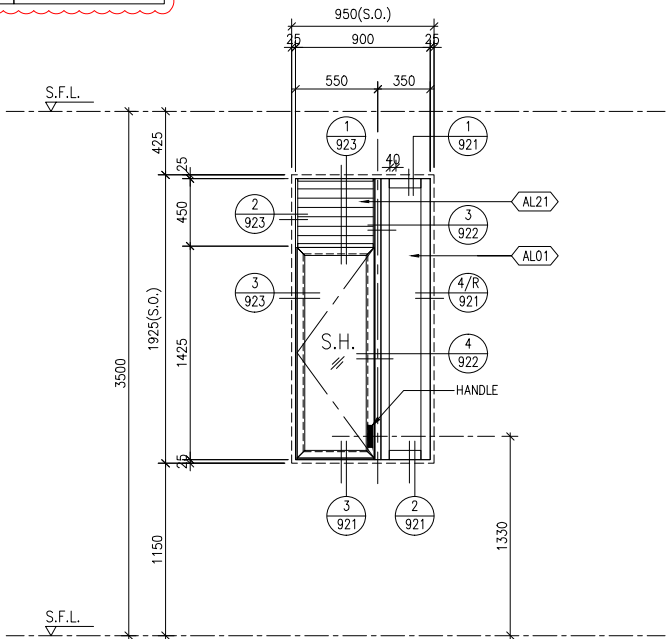


WINDOW MARK	W58 T1 1 no.	LOCATION	TOWER 1A – FLAT A B.R.4. (35/F)
GLAZING	GL06	FRAME	AL11
REMARK	SITE IN–SITU WINDOW		

WINDOW MARK	W57 T1 1 no.	LOCATION	TOWER 1A – FLAT A B.R.3. (33/F)
GLAZING	GL06	FRAME	AL11
REMARK	SITE IN–SITU WINDOW		


WINDOW MARK		LOCATION	
GLAZING		FRAME	
REMARK			

B.D. REF :			
F.S.D. REF :			
Note : 1.All dimensions are in mm. 2.All elevations are viewed from outside. 3.All dimensions to be verified on site before fabrication.			
GENERAL NOTES			
Legend : 1. F.F.L.-- Finished Floor Level 2. S.F.L.-- Structural Floor Level 3. (R) -- Reversed Detail			
X1 DETAIL MARK NO. X001 REFER SHEET NO.			
GL06 -- GREY BLUE MONOLITHIC GLASS (12mm) w/ FROSTED TEXTURE AT INNER SURFACE			
AL01 -- 3mm THK. ALUM. CLADDING			
A	05.03.2020	GENERAL REVISION	
NO.	DATE	REVISED	BY
CLIENT :			
佳明集團控股有限公司 GRAND MING GROUP HOLDINGS LIMITED			
MAIN CONTRACTOR :			
GRAND TECH CONSTRUCTION CO.LTD.			
ARCHITECT : WONG TUNG & PARTNERS LIMITED ARCHITECTS & PLANNERS			
STRUCTURAL ENGINEER :			
C M WONG & ASSOCIATES LTD			
美特鋁質有限公司 MIDI ALUMINIUM FABRICATOR LTD. Units 6–8, Sunray Industrial Centre, 1/F 610 Cha Kwo Ling Road, Kowloon Tel:23489211–4 Fax:(852)27727666			
PROJECT :			
RESIDENTIAL DEVELOPMENT AT TSING YI TOWN LOT 190 SAI SHAN ROAD			
TITLE :			
WINDOW SCHEDULE OF TOWER 1/ TOWER 1A			
JOB NO. : J–851			
DRAWN BY :		DATE : 2–12–2019	
CHKD BY :		SCALE A1: A3: 1:50	
DWG. NO. : J851-IW-118			REV. : A

GLAZING AREA
2.85

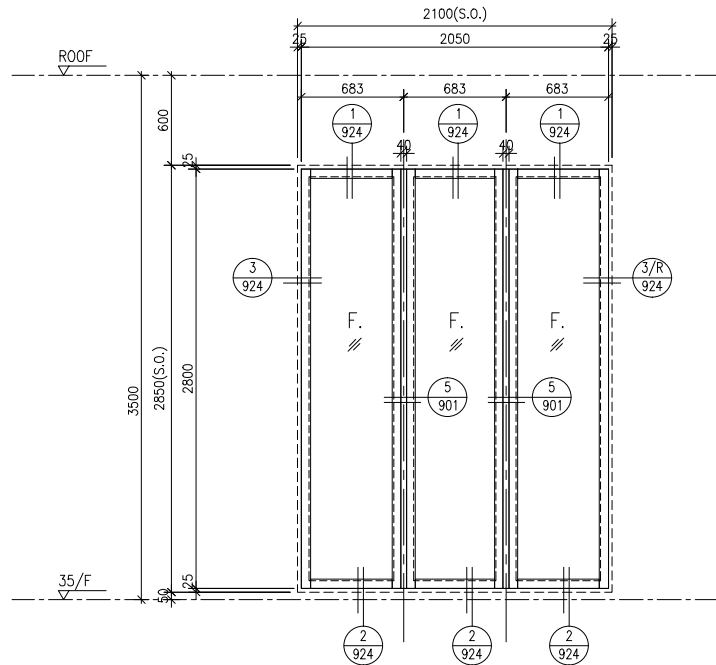

GLAZING AREA
2.94

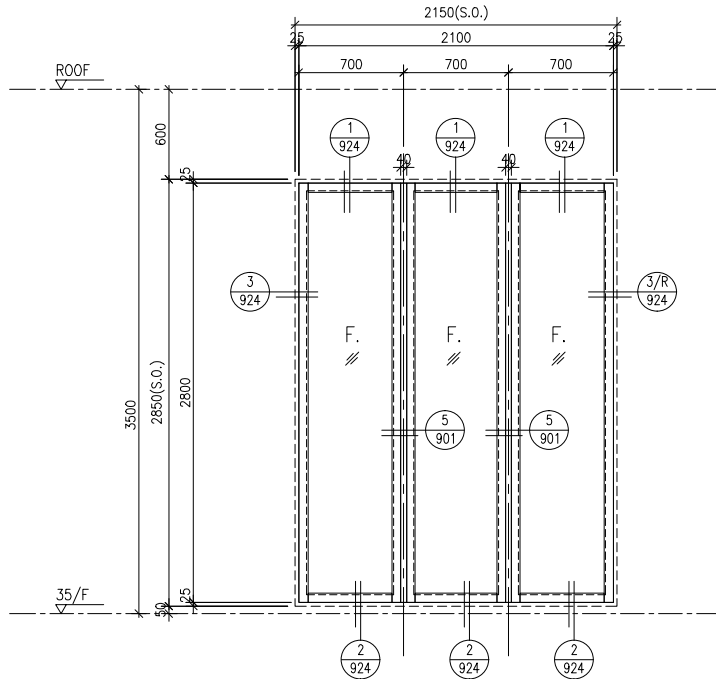

WINDOW MARK

W59B
T1 1 no.

LOCATION

TOWER 1A – UNIT B. PRIVATE LIFT LOBBY (35/F)

GLAZING

GL02


FRAME

AL11

REMARK

SITE IN–SITU WINDOW

GLAZING AREA
3.33

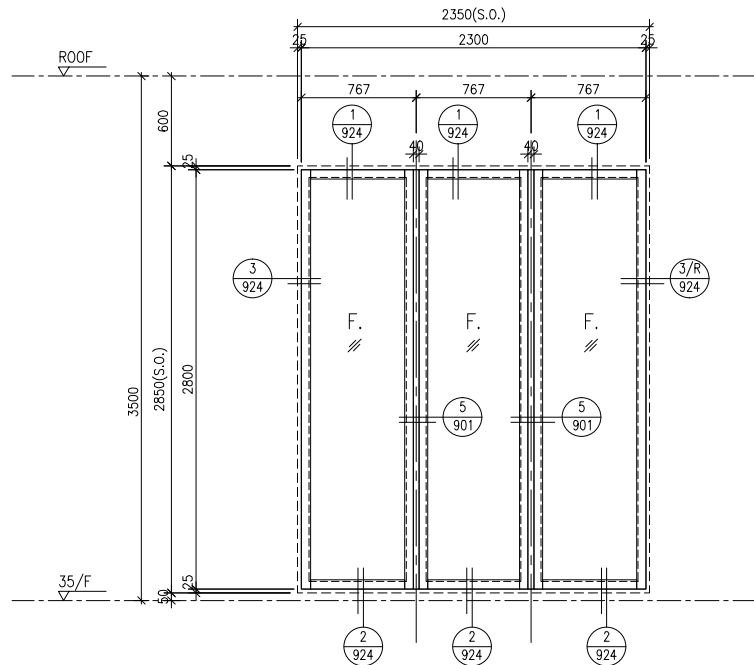

WINDOW MARK

W59D
T1 1 no.

LOCATION

TOWER 1A – UNIT A. PRIVATE LIFT LOBBY (35/F)

GLAZING

GL02

FRAME

AL11

REMARK

SITE IN–SITU WINDOW

WINDOW MARK

W59C
T1 1 no.

LOCATION

TOWER 1 – UNIT A. PRIVATE LIFT LOBBY (35/F)

GLAZING

GL02

FRAME

AL11

REMARK

SITE IN–SITU WINDOW

B.D. REF :

F.S.D. REF :

Note :

- 1.All dimensions are in mm.
- 2.All elevations are viewed from outside.
- 3.All dimensions to be verified on site before fabrication.

GENERAL NOTES

Legend :

1. F.F.L.-- Finished Floor Level
2. S.F.L.-- Structural Floor Level
3. (R) -- Reversed Detail

X1 -- DETAIL MARK NO.
X001 -- REFER SHEET NO.

GL02 -- GREY BLUE MONOLITHIC GLASS (12mm) w/
DRAK GREY WINDOW FRAME IN PwF2 FINISH

A	05.03.2020	GENERAL REVISION	
NO.	DATE	REVISED	BY

CLIENT :

佳明集團控股有限公司
GRAND MING GROUP HOLDINGS LIMITED

MAIN CONTRACTOR :

GRAND TECH CONSTRUCTION CO.LTD.

ARCHITECT :
WONG TUNG & PARTNERS LIMITED
ARCHITECTS & PLANNERS



STRUCTURAL ENGINEER :

C M WONG & ASSOCIATES LTD

美特鋁質有限公司
MIDI ALUMINIUM FABRICATOR LTD.

Units 6–8, Sunray Industrial Centre, 1/F
610 Cha Kwo Ling Road, Kowloon
Tel:23489211–4 Fax:(852)27727666

PROJECT :

RESIDENTIAL DEVELOPMENT AT
TSING YI TOWN LOT 190 SAI SHAN ROAD

TITLE :

WINDOW SCHEDULE
OF TOWER 1/ TOWER 1A

JOB NO. : J–851

DRAWN BY :

DATE :
2–12–2019

CHKD BY :

SCALE A1:
A3: 1:50

DWG. NO. :
J851-IW-119

REV. :
A

OPENABLE AREA 0.82		GLAZING AREA 0.73					
WINDOW MARK W2 LG 1 no.		LOCATION WATCHMAN'S OFFICE(LOWER GROUND FLOOR)					
GLAZING GL08		FRAME AL11					
REMARK SITE IN-SITU WINDOW							
GLAZING AREA 1.50							
WINDOW MARK W4 LG 1 no.		LOCATION WATCHMAN'S OFFICE(LOWER GROUND FLOOR)					
GLAZING GL11		FRAME AL11					
REMARK SITE IN-SITU WINDOW							
WINDOW MARK W7 UG 1 no.		LOCATION WATCHMAN QUARTER(UPPER GROUND FLOOR)					
GLAZING GL02		FRAME AL11					
REMARK SITE IN-SITU WINDOW							

B.D. REF :

F.S.D. REF :

Note :
1.All dimensions are in mm.
2.All elevations are viewed from outside.
3.All dimensions to be verified on site before fabrication.

GENERAL NOTES

Legend :
1. F.F.L--- Finished Floor Level
2. S.F.L--- Structural Floor Level
3. (R) --- Reversed Detail

X1

X001

DETAIL MARK NO.

REFER SHEET NO.

GL02

--

GREY BLUE MONOLITHIC GLASS (12mm) w/
DRAK GREY WINDOW FRAME IN PVF2 FINISH

GL08

--

CLEAR GLASS (12mm) w/ FROSTED TEXTURE
AT INNER SURFACE

GL11

--

CLEAR TEMPERED GLASS (12mm)

B	04.05.2020	GENERAL REVISION	
A	05.03.2020	GENERAL REVISION	
NO.	DATE	REVISED	BY

CLIENT :
佳明集團控股有限公司
GRAND MING GROUP HOLDINGS LIMITED

MAIN CONTRACTOR :
GRAND TECH CONSTRUCTION CO.LTD.

ARCHITECT :
WONG TUNG & PARTNERS LIMITED
ARCHITECTS & PLANNERS

STRUCTURAL ENGINEER :

C M WONG & ASSOCIATES LTD

MIDI ALUMINIUM FABRICATOR LTD.
Units 6-8, Sunray Industrial Centre, 1/F
610 Cha Kwo Ling Road, Kowloon
Tel:23489211-4 Fax:(852)27727666

PROJECT :
RESIDENTIAL DEVELOPMENT AT
TSING YI TOWN LOT 190 SAI SHAN ROAD

TITLE :
WINDOW SCHEDULE
OF LOWER GROUND FLOOR
AND UPPER GROUND FLOOR


JOB NO. : J-851

DRAWN BY : DATE : 2-12-2019

CHKD BY : SCALE A1: A3: 1:50


DWG. NO. : J851-IW-120 REV. : B

OPENABLE AREA	GLAZING AREA
11.71	8.71

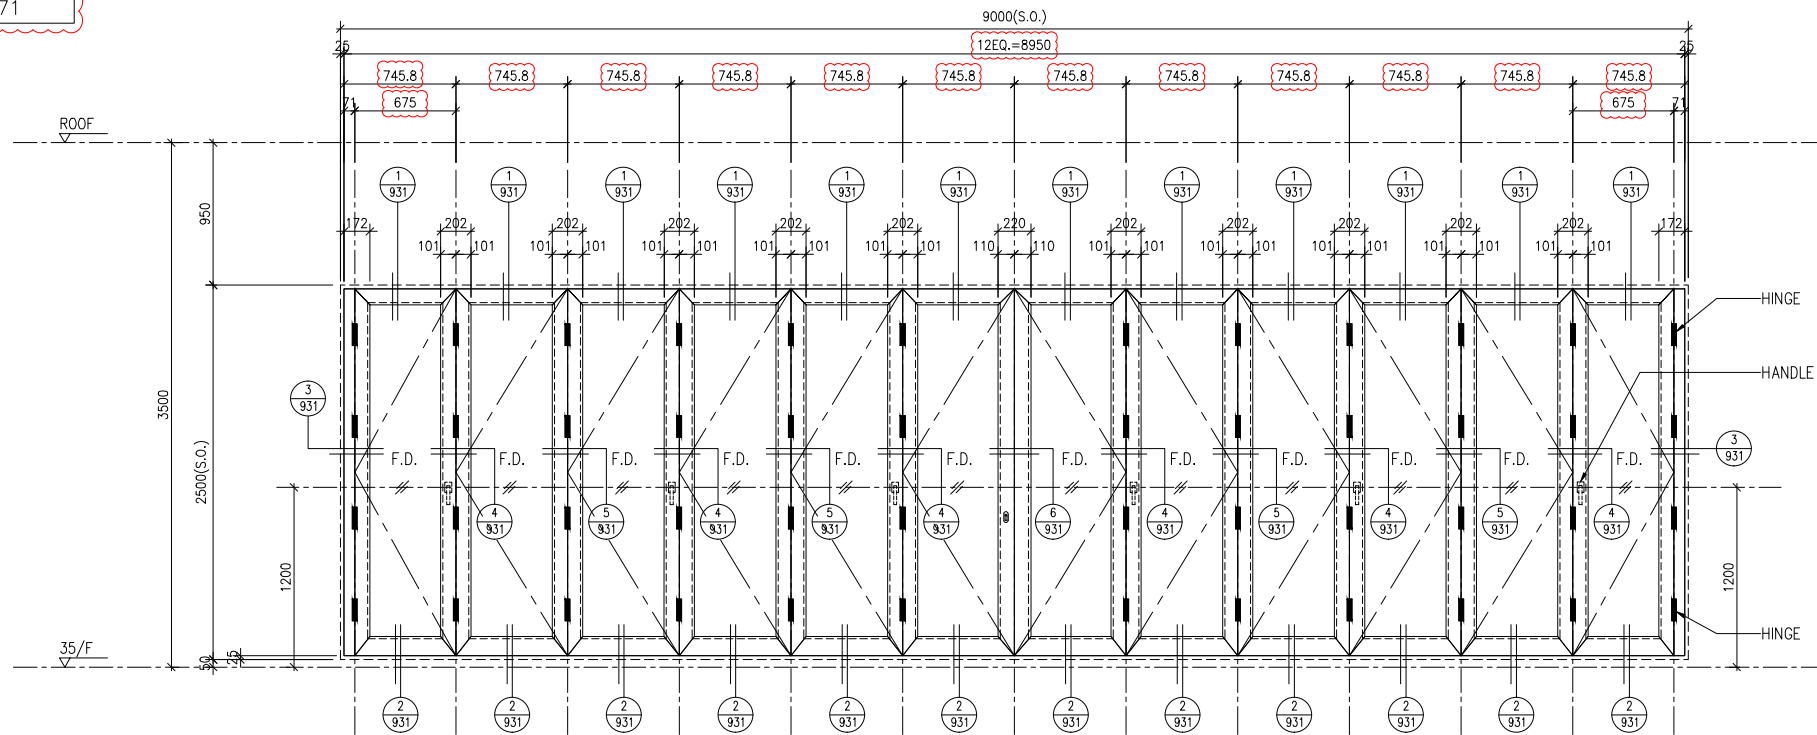

WINDOW MARK	 1 no.	LOCATION	TOWER 1A FLAT A LIV. & DIN(35/F)	WINDOW MARK		LOCATION	
GLAZING	GL02	FRAME	AL11	GLAZING		FRAME	
REMARK	SITE IN-SITU WINDOW			REMARK			

OPENABLE AREA	GLAZING AREA
2.40	1.64

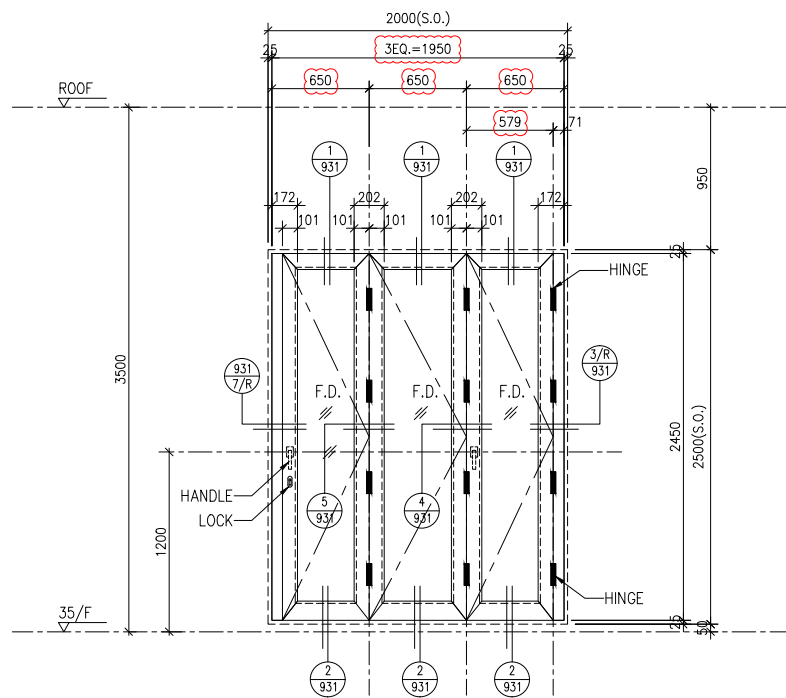


WINDOW MARK	 1 no.  1 no.	LOCATION	TOWER 1 FLAT A LIV. & DIN(35/F) TOWER 2 FLAT A LIV. & DIN(35/F)	WINDOW MARK	 1 no.	LOCATION	TOWER 1 FLAT B LIV. & DIN(35/F)
GLAZING	GL02	FRAME	AL11	GLAZING	GL02	FRAME	AL11
REMARK	SITE IN-SITU WINDOW			REMARK	SITE IN-SITU WINDOW		

WINDOW MARK	 1 no.  1 no.	LOCATION	TOWER 1 FLAT A LIV. & DIN(35/F) TOWER 2 FLAT A LIV. & DIN(35/F)	WINDOW MARK	 1 no.	LOCATION	TOWER 1 FLAT B LIV. & DIN(35/F)
GLAZING	GL02	FRAME	AL11	GLAZING	GL02	FRAME	AL11
REMARK	SITE IN-SITU WINDOW			REMARK	SITE IN-SITU WINDOW		


B.D. REF :			
F.S.D. REF :			
Note : 1.All dimensions are in mm. 2.All elevations are viewed from outside. 3.All dimensions to be verified on site before fabrication.			
GENERAL NOTES			
Legend : 1. F.F.L.-- Finished Floor Level 2. S.F.L.-- Structural Floor Level 3. (R) -- Reversed Detail			
  X1 DETAIL MARK NO.  X001 REFER SHEET NO.			
GL02 -- GREY BLUE MONOLITHIC GLASS (12mm) w/ DRAK GREY WINDOW FRAME IN PVF2 FINISH			
B	20.03.2020	GENERAL REVISION	
A	05.03.2020	GENERAL REVISION	
NO.	DATE	REVISED	BY
CLIENT :  佳明集團控股有限公司 GRAND MING GROUP HOLDINGS LIMITED			
MAIN CONTRACTOR : GRAND TECH CONSTRUCTION CO. LTD.			
ARCHITECT :  WONG TUNG & PARTNERS LIMITED ARCHITECTS & PLANNERS			
STRUCTURAL ENGINEER :  C M WONG & ASSOCIATES LTD			
 美特鋁質有限公司 MIDI ALUMINIUM FABRICATOR LTD. Units 6-8, Sunray Industrial Centre, 1/F 610 Cha Kwo Ling Road, Kowloon Tel:23489211-4 Fax:(852)27727666			
PROJECT : RESIDENTIAL DEVELOPMENT AT TSING YI TOWN LOT 190 SAI SHAN ROAD			
TITLE : WINDOW SCHEDULE OF TOWER 1/ TOWER 1A AND TOWER 2/ TOWER 2A			
JOB NO. : J-851			
DRAWN BY :		DATE : 2-12-2019	
CHKD BY :		SCALE A1: A3: 1:50	
DWG. NO. : J851-IW-121			REV. : B

OPENABLE AREA	GLAZING AREA
8.41	5.87

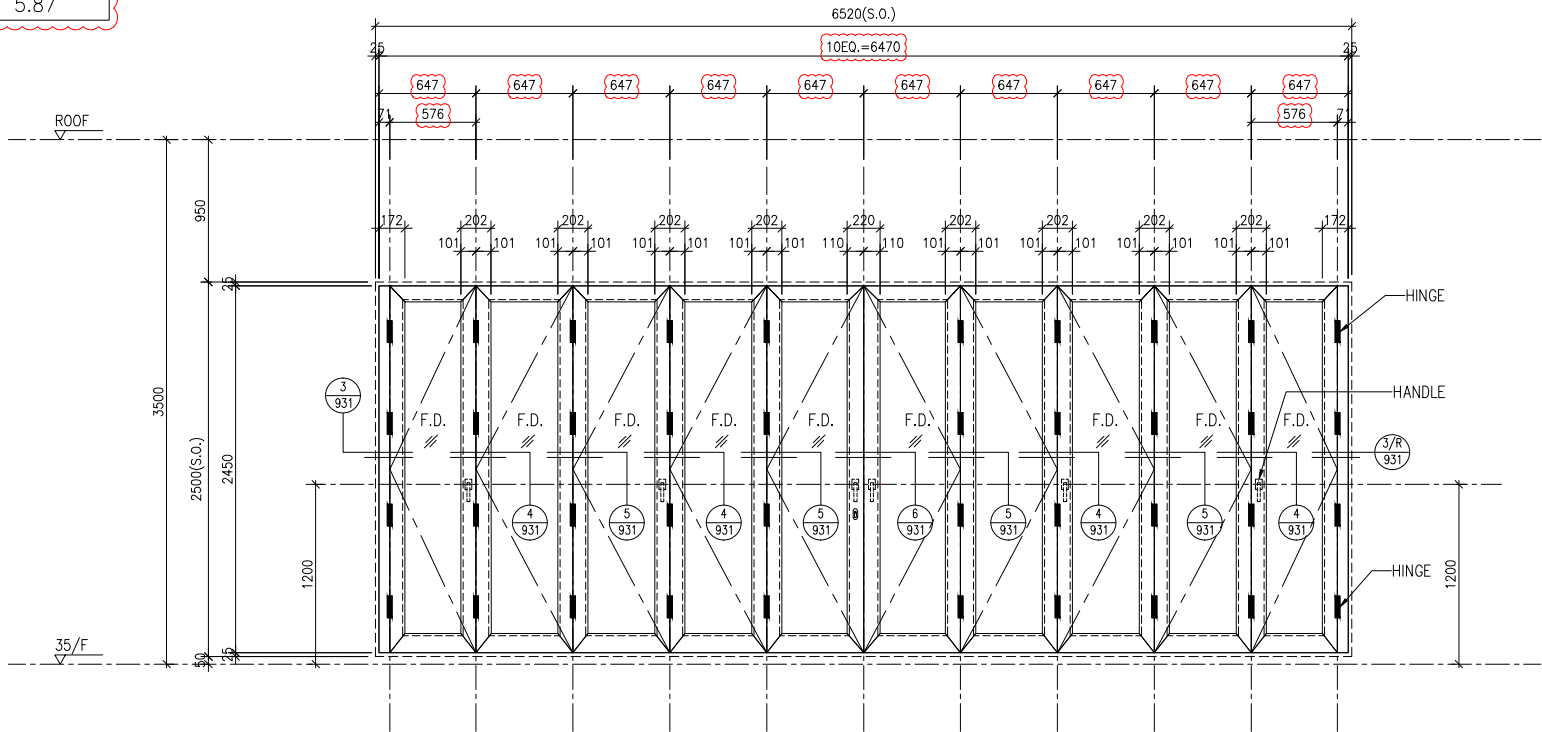





WINDOW MARK	W70 T2 1 no.	LOCATION	TOWER 2 FLAT B LIV. & DIN(35/F)	WINDOW MARK		LOCATION	
GLAZING	GL02	FRAME	AL11	GLAZING		FRAME	
REMARK	SITE IN-SITU WINDOW			REMARK			

OPENABLE AREA	GLAZING AREA
8.92	6.39

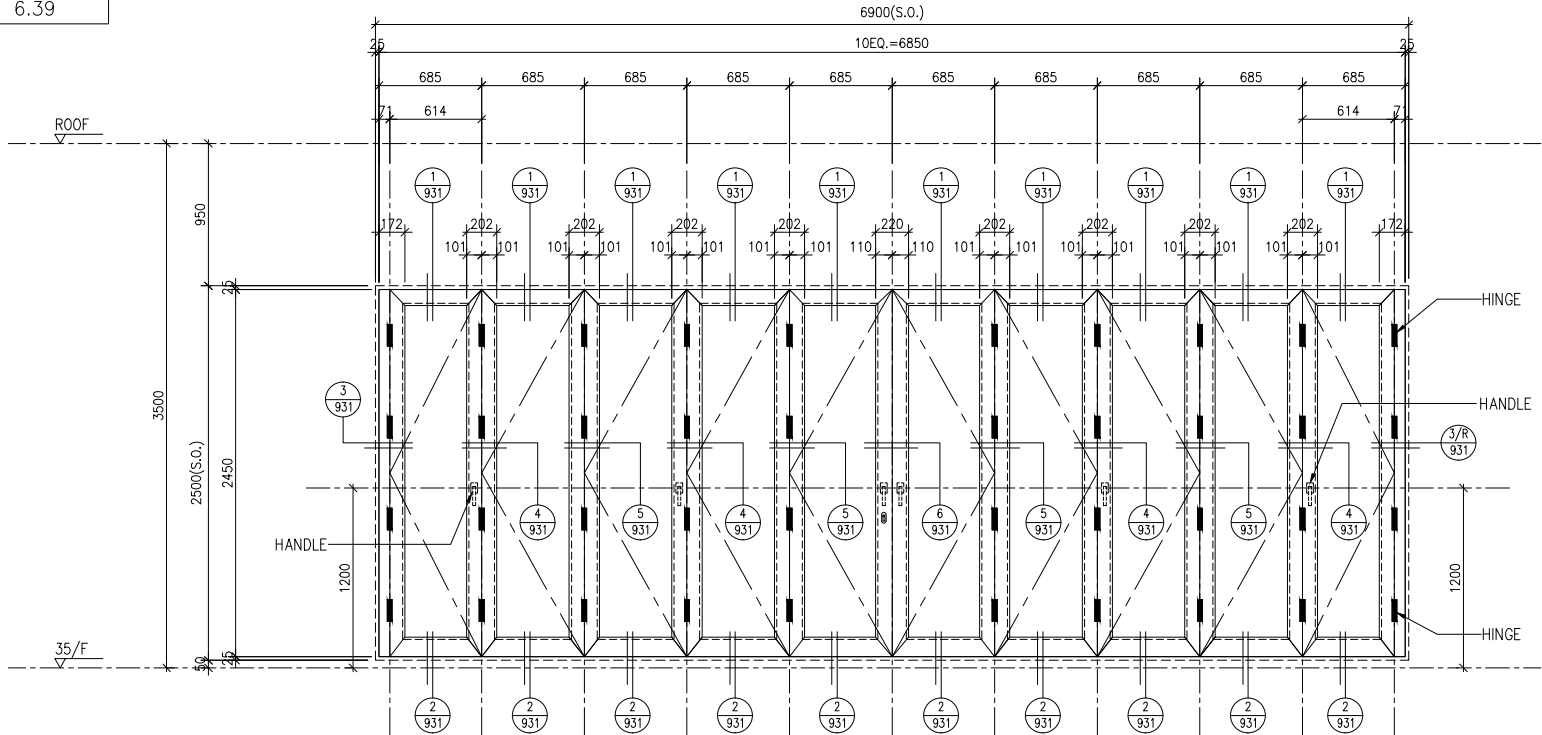


WINDOW MARK	W71 T2 1 no.	LOCATION	TOWER 2A FLAT A LIV. & DIN(35/F)	WINDOW MARK		LOCATION	
GLAZING	GL02	FRAME	AL11	GLAZING		FRAME	
REMARK	SITE IN-SITU WINDOW			REMARK			

B.D. REF :			
F.S.D. REF :			
Note : 1.All dimensions are in mm. 2.All elevations are viewed from outside. 3.All dimensions to be verified on site before fabrication.			
GENERAL NOTES			
Legend : 1. F.F.L--- Finished Floor Level 2. S.F.L--- Structural Floor Level 3. (R) --- Reversed Detail			
X1 X001 DETAIL MARK NO. REFER SHEET NO.			
GL02 --- GREY BLUE MONOLITHIC GLASS (12mm) w/ DRAK GREY WINDOW FRAME IN PVF2 FINISH			
B	20.03.2020	GENERAL REVISION	
A	05.03.2020	GENERAL REVISION	
NO.	DATE	REVISED	BY
CLIENT :			
佳明集團控股有限公司 GRAND MING GROUP HOLDINGS LIMITED			
MAIN CONTRACTOR :			
GRAND TECH CONSTRUCTION CO.LTD.			
ARCHITECT :			
WONG TUNG & PARTNERS LIMITED ARCHITECTS & PLANNERS WT			
STRUCTURAL ENGINEER :			
C M WONG & ASSOCIATES LTD			
美特鋁質有限公司 MIDI ALUMINIUM FABRICATOR LTD. Units 6-8, Sunray Industrial Centre, 1/F 610 Cha Kwo Ling Road, Kowloon Tel:23489211-4 Fax:(852)27727666			
PROJECT :			
RESIDENTIAL DEVELOPMENT AT TSING YI TOWN LOT 190 SAI SHAN ROAD			
TITLE :			
WINDOW SCHEDULE OF TOWER 2/ TOWER 2A			
JOB NO. : J-851			
DRAWN BY :		DATE : 2-12-2019	
CHKD BY :		SCALE A1: A3: 1:50	
DWG. NO. : J851-IW-122			REV. : B
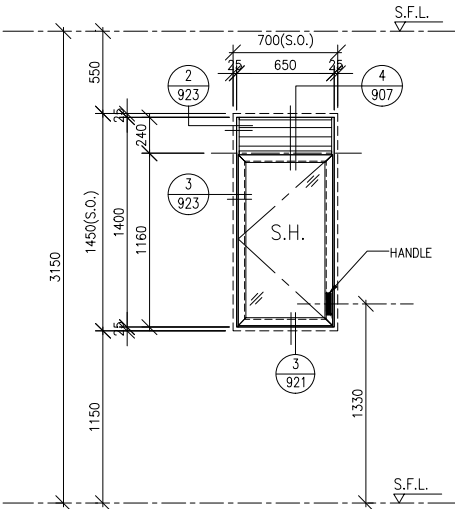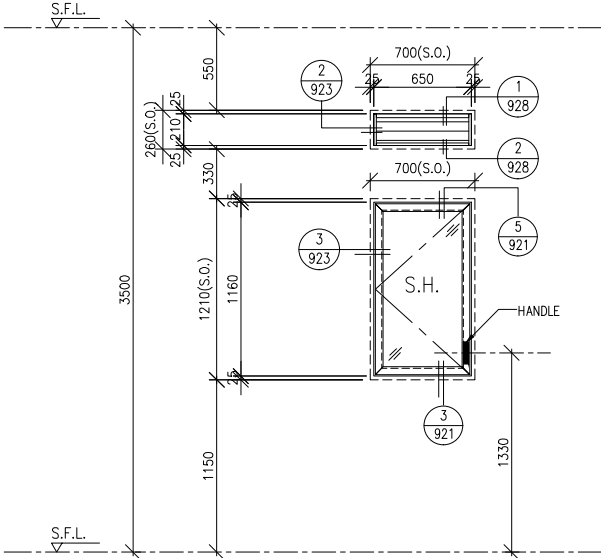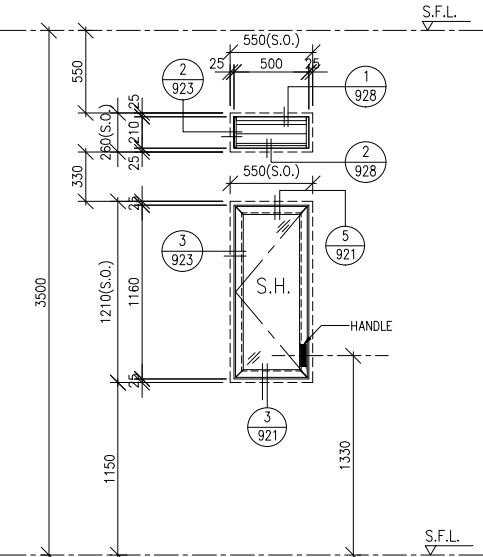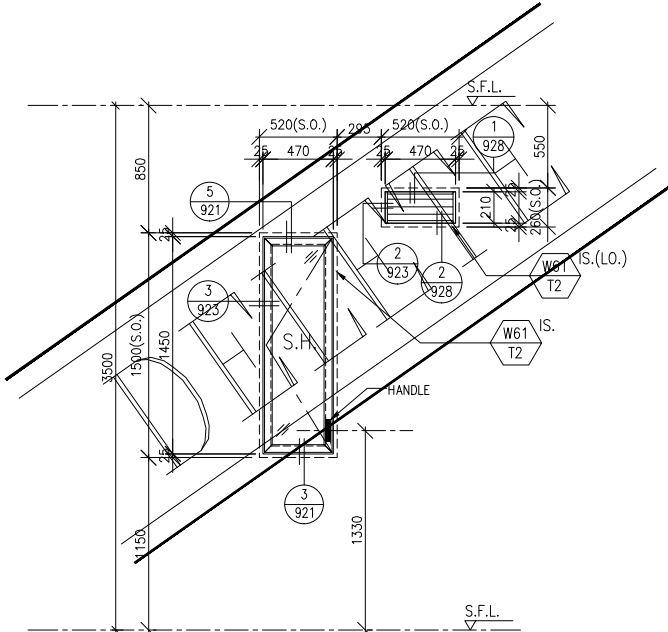
<table><tr><th>FREE AREA(%)</th><th>OPENABLE AREA</th><th>GLAZING AREA</th></tr><tr><td>57%</td><td>0.64</td><td>0.54</td></tr></table> 				FREE AREA(%)	OPENABLE AREA	GLAZING AREA	57%	0.64	0.54	<table><tr><th>FREE AREA(%)</th><th>OPENABLE AREA</th><th>GLAZING AREA</th></tr><tr><td>57%</td><td>0.64</td><td>0.54</td></tr></table> 				FREE AREA(%)	OPENABLE AREA	GLAZING AREA	57%	0.64	0.54	B.D. REF : F.S.D. REF : Note : 1.All dimensions are in mm. 2.All elevations are viewed from outside. 3.All dimensions to be verified on site before fabrication. GENERAL NOTES Legend : 1. F.F.L.-- Finished Floor Level 2. S.F.L.-- Structural Floor Level 3. (R) -- Reversed Detail X1 X001 DETAIL MARK NO. REFER SHEET NO. GL06 -- GREY BLUE MONOLITHIC GLASS (12mm) w/ FROSTED TEXTURE AT INNER SURFACE <table><tr><td></td><td></td><td></td><td></td></tr><tr><td></td><td></td><td></td><td></td></tr><tr><td></td><td></td><td></td><td></td></tr><tr><td></td><td></td><td></td><td></td></tr><tr><td>A</td><td>04.05.2020</td><td>GENERAL REVISION</td><td></td></tr><tr><td>NO.</td><td>DATE</td><td>REVISED</td><td>BY</td></tr></table> CLIENT : 佳明集團控股有限公司 GRAND MING GROUP HOLDINGS LIMITED MAIN CONTRACTOR : GRAND TECH CONSTRUCTION CO. LTD. ARCHITECT : WONG TUNG & PARTNERS LIMITED ARCHITECTS & PLANNERS  STRUCTURAL ENGINEER :  C M WONG & ASSOCIATES LTD  美特鋁質有限公司 MIDI ALUMINIUM FABRICATOR LTD. Units 6-8, Sunray Industrial Centre, 1/F 610 Cha Kwo Ling Road, Kowloon Tel:23489211-4 Fax:(852)27727666 PROJECT : RESIDENTIAL DEVELOPMENT AT TSING YI TOWN LOT 190 SAI SHAN ROAD TITLE : WINDOW SCHEDULE OF TOWER 1/ TOWER 1A JOB NO. : J-851 DRAWN BY : DATE : 2-12-2019 CHKD BY : SCALE A1: A3: 1:50 DWG. NO. : J851-IW-123 REV. : A																	A	04.05.2020	GENERAL REVISION		NO.	DATE	REVISED	BY
FREE AREA(%)	OPENABLE AREA	GLAZING AREA	
57%	0.64	0.54	
FREE AREA(%)	OPENABLE AREA	GLAZING AREA	
57%	0.64	0.54	
A	04.05.2020	GENERAL REVISION	
NO.	DATE	REVISED	BY	
<table><tr><th>FREE AREA(%)</th><th>OPENABLE AREA</th><th>GLAZING AREA</th></tr><tr><td>57%</td><td>0.48</td><td>0.39</td></tr></table> 				FREE AREA(%)	OPENABLE AREA	GLAZING AREA	57%	0.48	0.39	<table><tr><th>FREE AREA(%)</th><th>OPENABLE AREA</th><th>GLAZING AREA</th></tr><tr><td>57%</td><td>0.56</td><td>0.46</td></tr></table> 				FREE AREA(%)	OPENABLE AREA	GLAZING AREA	57%	0.56	0.46																									
FREE AREA(%)	OPENABLE AREA	GLAZING AREA	
57%	0.48	0.39	
FREE AREA(%)	OPENABLE AREA	GLAZING AREA	
57%	0.56	0.46	
WINDOW MARK	W38B T1 IS. 2 nos.	LOCATION	T1 FLAT B M.BATH. (33/F) <u>T1 FLAT B UTILITY RM (35/F)</u>	WINDOW MARK	W61 T1 IS. 1 no. W61 T1 IS.(L.O.) 1 no.	LOCATION	T1 FLAT B UTILITY RM (35/F)																																					
GLAZING	GL06	FRAME	AL11	GLAZING	GL06	FRAME	AL11																																					
REMARK	SITE IN-SITU WINDOW			REMARK	SITE IN-SITU WINDOW																																							

OPENABLE AREA	GLAZING AREA
0.83	1.03

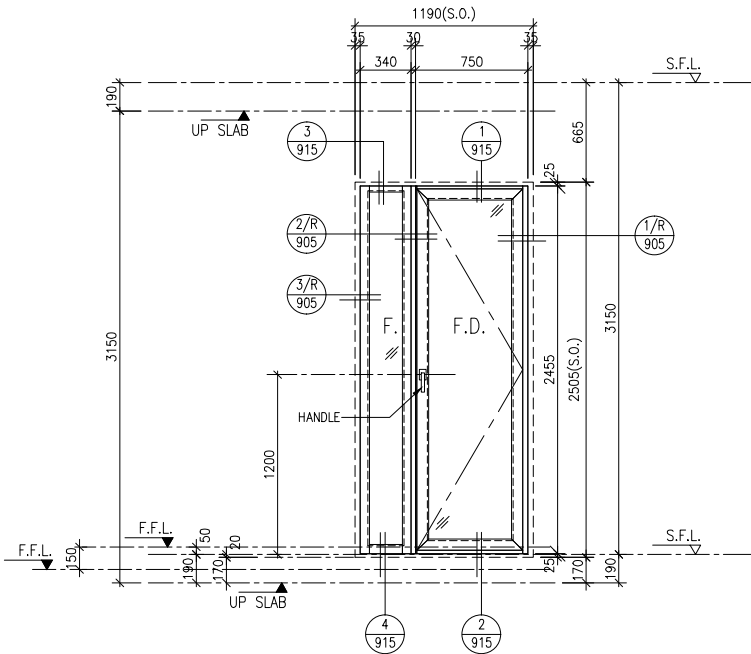

WINDOW MARK



27 nos.

LOCATION

TOWER 2 - FLAT D M.B.R. (1/F~31/F)

GLAZING

GL01


FRAME

AL11

REMARK

SITE IN-SITU WINDOW(4,13,14,24/F OMITTED)

OPENABLE AREA	GLAZING AREA
0.83	1.21

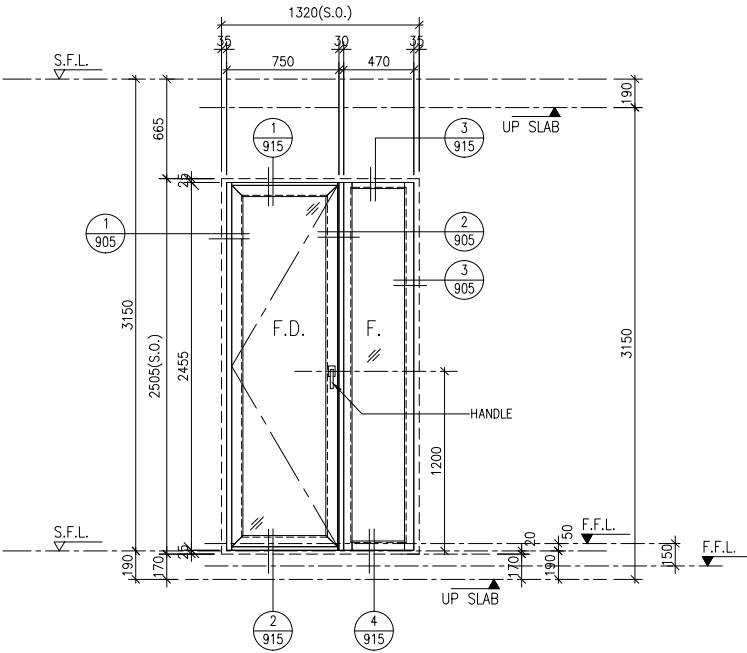

WINDOW MARK



27 nos.

LOCATION

TOWER 2 - FLAT A M.B.R. (1/F~31/F)

GLAZING

GL01


FRAME

AL11


REMARK

SITE IN-SITU WINDOW(4,13,14,24/F OMITTED)

WINDOW MARK	LOCATION	W(S.O.)	DOOR DIM.	NOS.	OPENABLE AREA	GLAZING AREA
T2-W19A1	TOWER 2A - FLAT A (1/F~31/F)	1545	1495	27	1.67	1.50
T2-W19A2	TOWER 2A - FLAT A (1/F~31/F)	2005	1955	27	2.25	2.09
T2-W19A3	TOWER 2 - FLAT A (1/F~31/F)	2145	2095	27	2.42	2.27
T2-W19C	TOWER 2 - FLAT C (1/F~31/F)	1795	1745	27	1.98	1.82

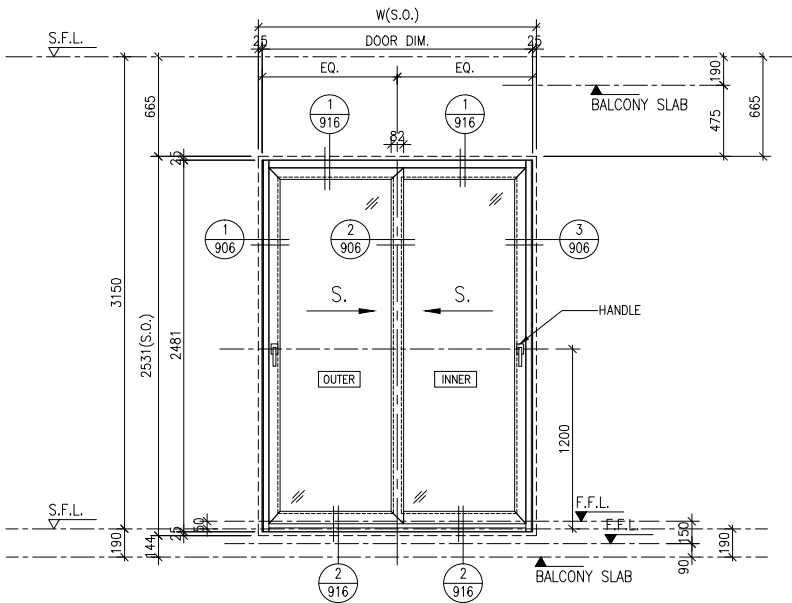

WINDOW MARK

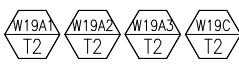

LOCATION

LIV. & DIN.

GLAZING

GL01


FRAME

AL11

REMARK

SITE IN-SITU WINDOW(4,13,14,24/F OMITTED)

WINDOW MARK	LOCATION	W(S.O.)	DOOR DIM.	NOS.	OPENABLE AREA	GLAZING AREA
T2-W19BR	TOWER 2 - FLAT B (1/F~31/F)	1795	1745	27	1.98	1.82
T2-W19DR	TOWER 2 - FLAT D (1/F~31/F)	1855	1805	27	2.06	1.90

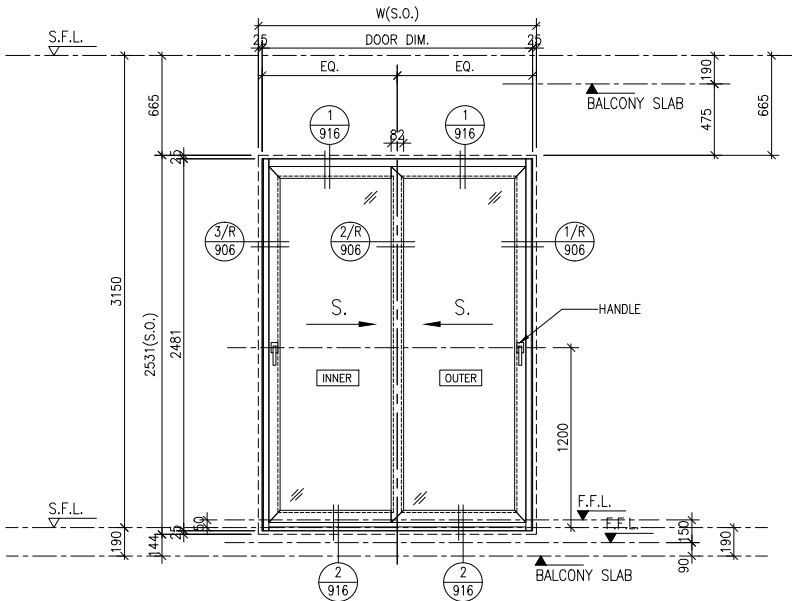

WINDOW MARK



LOCATION

LIV. & DIN.

GLAZING

GL01

FRAME

AL11

REMARK

SITE IN-SITU WINDOW(4,13,14,24/F OMITTED)

B.D. REF :
F.S.D. REF :
Note :
1.All dimensions are in mm.
2.All elevations are viewed from outside.
3.All dimensions to be verified on site before fabrication.

GENERAL NOTES

Legend :
1. F.F.L.-- Finished Floor Level
2. S.F.L.-- Structural Floor Level
3. (R) -- Reversed Detail
X1 -- DETAIL MARK NO.
X001 -- REFER SHEET NO.
GL01 -- GREY BLUE IGU (6mm+12mm+8mm)

D	04.05.2020	GENERAL REVISION	
C	20.03.2020	GENERAL REVISION	
B	05.03.2020	GENERAL REVISION	
A	13.02.2020	GENERAL REVISION	
NO.	DATE	REVISED	BY

CLIENT :
佳明集團控股有限公司
GRAND MING GROUP HOLDINGS LIMITED

MAIN CONTRACTOR :
GRAND TECH CONSTRUCTION CO.LTD.

ARCHITECT :
WONG TUNG & PARTNERS LIMITED
ARCHITECTS & PLANNERS

STRUCTURAL ENGINEER :

C M WONG & ASSOCIATES LTD


MIDI ALUMINIUM FABRICATOR LTD.
Units 6-8, Sunray Industrial Centre, 1/F
610 Cha Kwo Ling Road, Kowloon
Tel:23489211-4 Fax:(852)27727666

PROJECT :
RESIDENTIAL DEVELOPMENT AT
TSING YI TOWN LOT 190 SAI SHAN ROAD

TITLE :
WINDOW SCHEDULE
OF TOWER 2/ TOWER 2A


JOB NO. :	J-851
DRAWN BY :	DATE : 2-12-2019
CHKD BY :	SCALE A1: A3: 1:50
DWG. NO. : J851-IW-212	REV. : D

OPENABLE AREA	GLAZING AREA
0.49	0.41

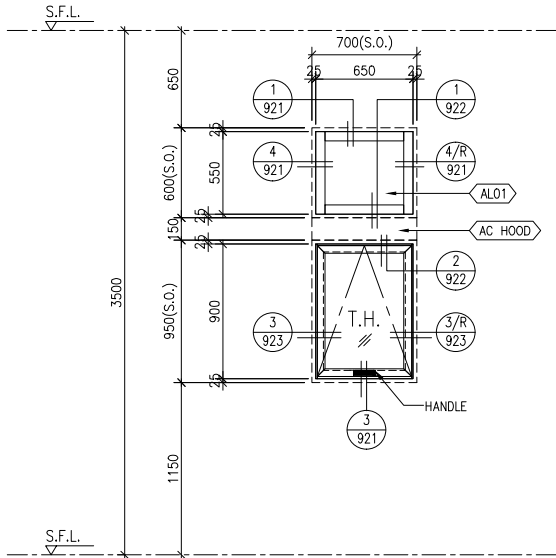


WINDOW MARK	W39 T2 1 no.	LOCATION	TOWER 2 - FLAT A UTILITY ROOM (32/F)
GLAZING	GL06	FRAME	AL11
REMARK	SITE IN-SITU WINDOW		

OPENABLE AREA	GLAZING AREA
0.50	0.42

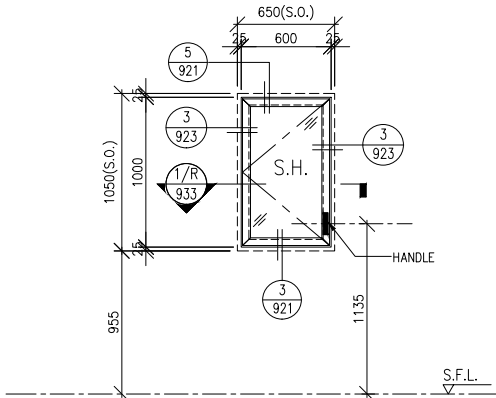


WINDOW MARK	W76 T2 26 nos.	LOCATION	T2A STAIRCASE (2-31/F)
GLAZING	CLEAR GLASS (10mm) w/ FROSTED TEXTURE AT INNER SURFACE	FRAME	AL11
REMARK	-SITE IN-SITU WINDOW -333SS SERIES HINGE		

OPENABLE AREA	GLAZING AREA
1.09	1.32

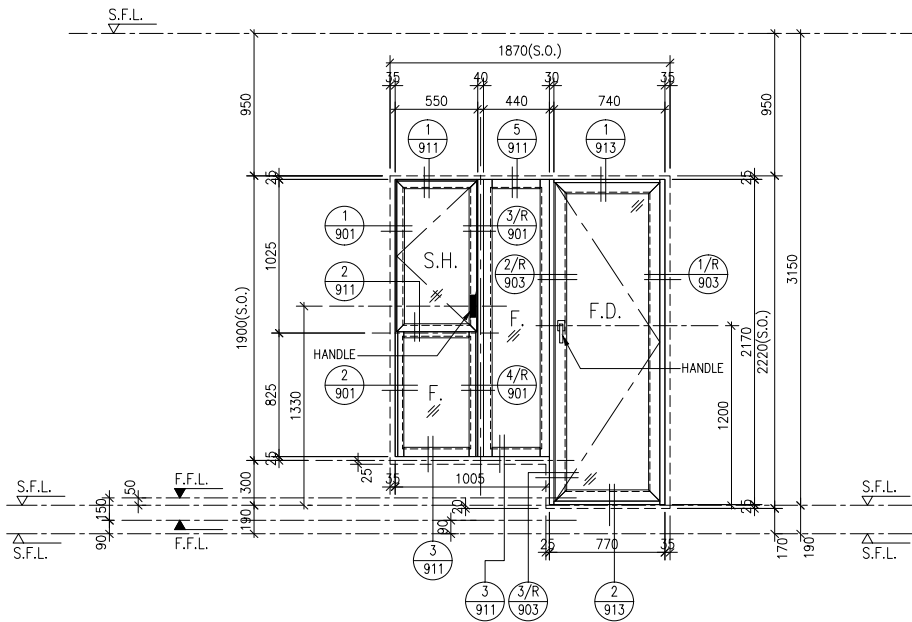

WINDOW MARK	W24 T2 1 no.	LOCATION	TOWER 2A - 1/F LIFT LOBBY CORRIDOR
GLAZING	GL08	FRAME	AL11
REMARK	PRECAST FACADE IN-SITU WINDOW		

FREE AREA(%)	OPENABLE AREA
57%	0.47
GLAZING AREA	0.38

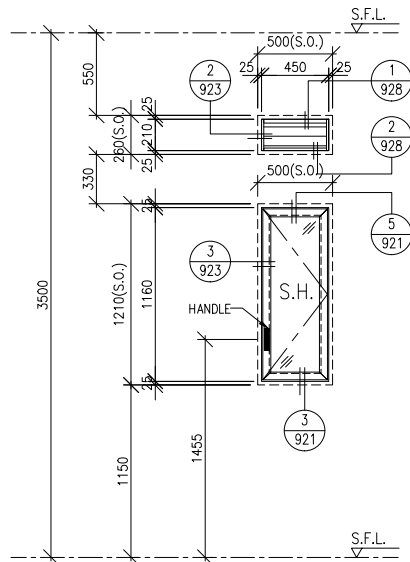

WINDOW MARK	W64 ^{IS.} T2 1 no.	LOCATION	
GLAZING	GL06	FRAME	AL11
REMARK	SITE IN-SITU WINDOW		

B.D. REF :		
F.S.D. REF :		
Note : 1.All dimensions are in mm. 2.All elevations are viewed from outside. 3.All dimensions to be verified on site before fabrication.		
GENERAL NOTES		
Legend : 1. F.F.L.-- Finished Floor Level 2. S.F.L.-- Structural Floor Level 3. (R) -- Reversed Detail		
X1 DETAIL MARK NO. X001 REFER SHEET NO.		
GL06 -- GREY BLUE MONOLITHIC GLASS (12mm) w/ FROSTED TEXTURE AT INNER SURFACE		
AL01 -- 3mm THK. ALUM. CLADDING		
B	04.05.2020	GENERAL REVISION
A	05.03.2020	GENERAL REVISION
NO.	DATE	REVISED BY
CLIENT :		
佳明集團控股有限公司 GRAND MING GROUP HOLDINGS LIMITED		
MAIN CONTRACTOR :		
GRAND TECH CONSTRUCTION CO. LTD.		
ARCHITECT :		
WONG TUNG & PARTNERS LIMITED ARCHITECTS & PLANNERS		
STRUCTURAL ENGINEER :		
C M WONG & ASSOCIATES LTD		
美特鋁質有限公司 MIDI ALUMINIUM FABRICATOR LTD.		
Units 6-8, Sunray Industrial Centre, 1/F 610 Cha Kwo Ling Road, Kowloon Tel:23489211-4 Fax:(852)27727666		
PROJECT :		
RESIDENTIAL DEVELOPMENT AT TSING YI TOWN LOT 190 SAI SHAN ROAD		
TITLE :		
WINDOW SCHEDULE OF TOWER 2/ TOWER 2A		
JOB NO. : J-851		
DRAWN BY :	DATE : 2-12-2019	
CHKD BY :	SCALE A1: A3: 1:50	
DWG. NO. : J851-IW-214	REV. : B	

OPENABLE AREA 0.83		GLAZING AREA 1.03									
WINDOW MARK	2 nos.	LOCATION	TOWER 2 – FLAT D M.B.R. (32/F~33/F)			WINDOW MARK		LOCATION	LIV. & DIN.		
GLAZING	GL01	FRAME	AL11			GLAZING	GL01	FRAME	AL11		
REMARK	SITE IN-SITU WINDOW					REMARK	SITE IN-SITU WINDOW				

WINDOW MARK	LOCATION	W(S.O.)	DOOR DIM.	NOS.	OPENABLE AREA	GLAZING AREA
T2-W49A1	TOWER 2 – FLAT A (32/F~33/F)	2145	2095	2	2.42	2.27
T2-W49A2	TOWER 2A – FLAT A (32/F~33/F)	2005	1955	2	2.25	2.09
T2-W49A3	TOWER 2A – FLAT A (32/F~33/F)	1545	1495	2	1.67	1.50
T2-W49B	TOWER 2 – FLAT B (33/F)	1795	1745	1	1.98	1.82
T2-W49C	TOWER 2 – FLAT C (32/F)	1795	1745	1	1.98	1.82

WINDOW MARK	LOCATION	W(S.O.)	DOOR DIM.	NOS.	OPENABLE AREA	GLAZING AREA
T2-W49BR	TOWER 2 – FLAT B (32/F)	1795	1745	1	1.98	1.82
T2-W49DR	TOWER 2 – FLAT D (32/F)	1855	1805	1	2.06	1.90

WINDOW MARK	LOCATION	W(S.O.)	DOOR DIM.	NOS.	OPENABLE AREA	GLAZING AREA

Legend :

1. F.F.L.-- Finished Floor Level
2. S.F.L.-- Structural Floor Level
3. -- Reversed Detail

-- DETAIL MARK NO.
 -- REFER SHEET NO.

GL01 -- GREY BLUE IGU (8mm+12mm+8mm)

D	04.05.2020	GENERAL REVISION	
C	20.03.2020	GENERAL REVISION	
B	05.03.2020	GENERAL REVISION	
A	13.02.2020	GENERAL REVISION	
NO.	DATE	REVISED	BY

CLIENT :
佳明集團控股有限公司
GRAND MING GROUP HOLDINGS LIMITED

MAIN CONTRACTOR :
GRAND TECH CONSTRUCTION CO. LTD.

ARCHITECT :
WONG TUNG & PARTNERS LIMITED
ARCHITECTS & PLANNERS

STRUCTURAL ENGINEER :
 C M WONG & ASSOCIATES LTD

美特鋁質有限公司
MIDI ALUMINIUM FABRICATOR LTD.
Units 6-8, Sunray Industrial Centre, 1/F
610 Cha Kwo Ling Road, Kowloon
Tel:23489211-4 Fax:(852)27727666

PROJECT :
RESIDENTIAL DEVELOPMENT AT
TSING YI TOWN LOT 190 SAI SHAN ROAD

TITLE :
WINDOW SCHEDULE
OF TOWER 2/ TOWER 2A


JOB NO. : J-851

DRAWN BY : DATE : 2-12-2019

CHKD BY : SCALE A1: A3: 1:50

DWG. NO. : J851-IW-215 REV. : D

GLAZING AREA
1.60

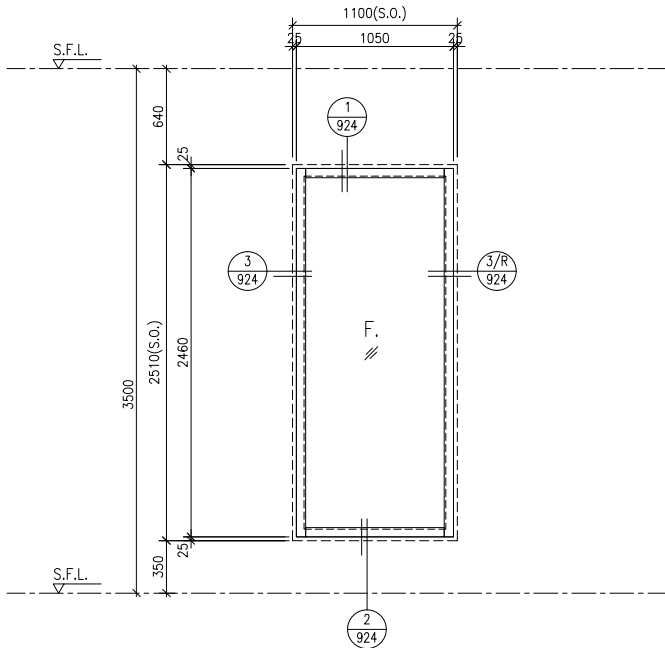

WINDOW MARK

W56
T2 1 no.

LOCATION

TOWER 2A 35/F FLAT A – INTERNAL STAIRCASE

GLAZING

GL02


FRAME

AL11

REMARK

SITE IN–SITU WINDOW

GLAZING AREA
1.94

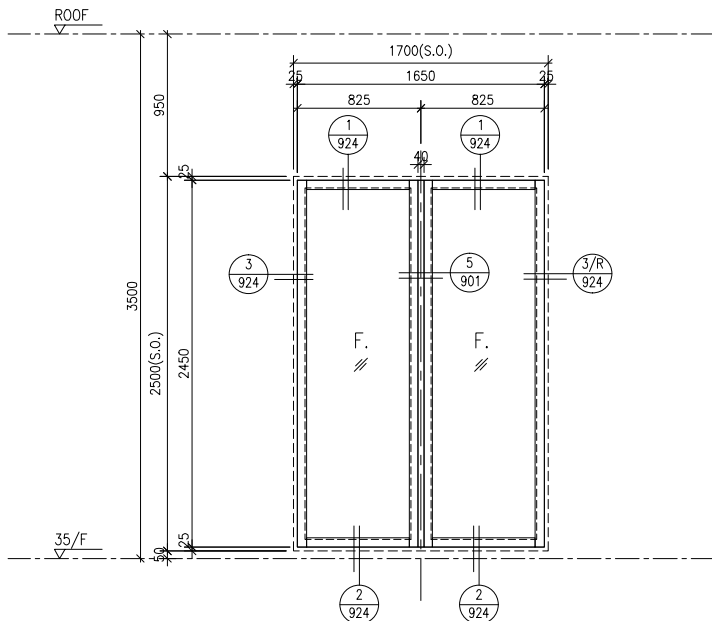

WINDOW MARK

W59A
T2 1 no.

LOCATION

TOWER 2 – UNIT A. PRIVATE LIFT LOBBY (35/F)

GLAZING

GL02


FRAME

AL11

REMARK

SITE IN–SITU WINDOW

GLAZING AREA
2.78

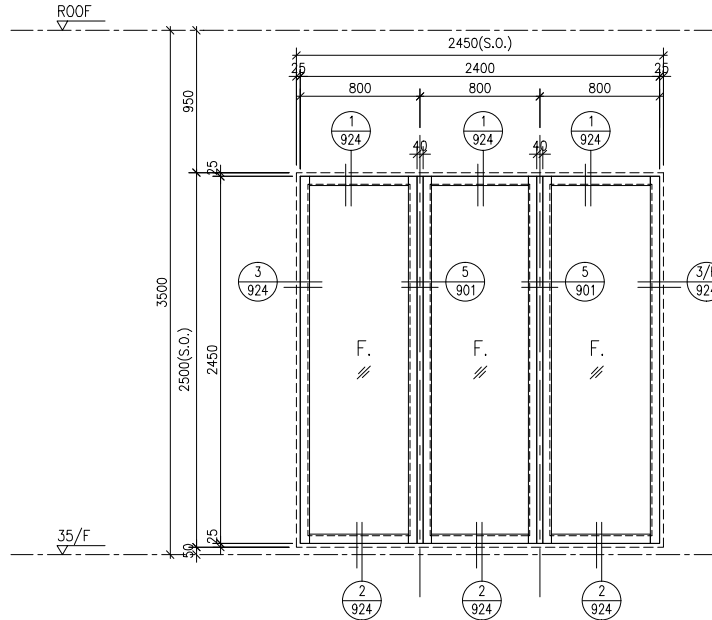

WINDOW MARK

W59
T2 1 no.

LOCATION

TOWER 2 – UNIT B. PRIVATE LIFT LOBBY (35/F)

GLAZING

GL02


FRAME

AL11

REMARK

SITE IN–SITU WINDOW

GLAZING AREA
2.00

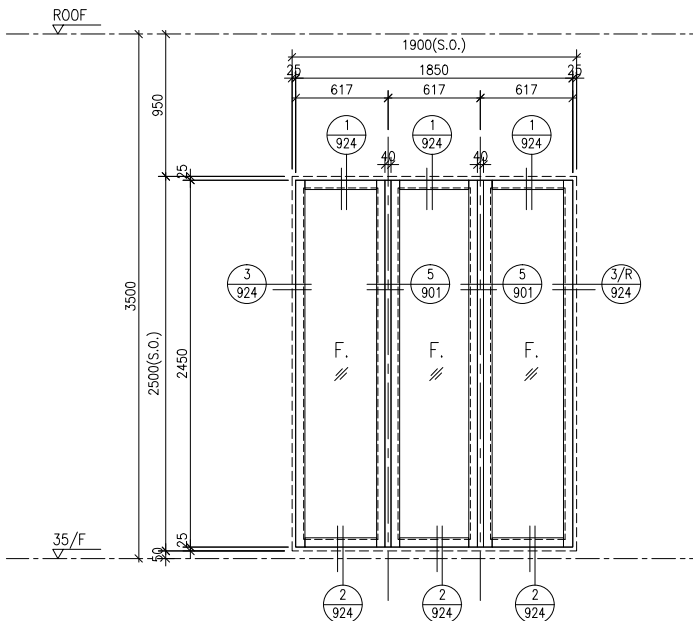

WINDOW MARK

W62
T2 1 no.

LOCATION

TOWER 2A – UNIT A. PRIVATE LIFT LOBBY (35/F)

GLAZING

GL02





FRAME

AL11

REMARK

SITE IN–SITU WINDOW

B.D. REF :		
F.S.D. REF :		
Note : 1.All dimensions are in mm. 2.All elevations are viewed from outside. 3.All dimensions to be verified on site before fabrication.		
GENERAL NOTES		
Legend : 1. F.F.L.-- Finished Floor Level 2. S.F.L.-- Structural Floor Level 3. (R) -- Reversed Detail		
X1 DETAIL MARK NO. X001 REFER SHEET NO.		
GL02 -- GREY BLUE MONOLITHIC GLASS (12mm) w/ DRAK GREY WINDOW FRAME IN PVF2 FINISH		
A	05.03.2020	GENERAL REVISION
NO.	DATE	REVISED BY
CLIENT :		
佳明集團控股有限公司 GRAND MING GROUP HOLDINGS LIMITED		
MAIN CONTRACTOR :		
GRAND TECH CONSTRUCTION CO.LTD.		
ARCHITECT : WONG TUNG & PARTNERS LIMITED ARCHITECTS & PLANNERS 		
STRUCTURAL ENGINEER :		
 C M WONG & ASSOCIATES LTD		
 美特鋁質有限公司 MIDI ALUMINIUM FABRICATOR LTD. Units 6–8, Sunray Industrial Centre, 1/F 610 Cha Kwo Ling Road, Kowloon Tel:23489211–4 Fax:(852)27727666		
PROJECT :		
RESIDENTIAL DEVELOPMENT AT TSING YI TOWN LOT 190 SAI SHAN ROAD		
TITLE :		
WINDOW SCHEDULE OF TOWER 2/ TOWER 2A		
JOB NO. : J–851		
DRAWN BY :	DATE : 2–12–2019	
CHKD BY :	SCALE A1: A3: 1:50	
DWG. NO. : J851-IW-217		REV. : A

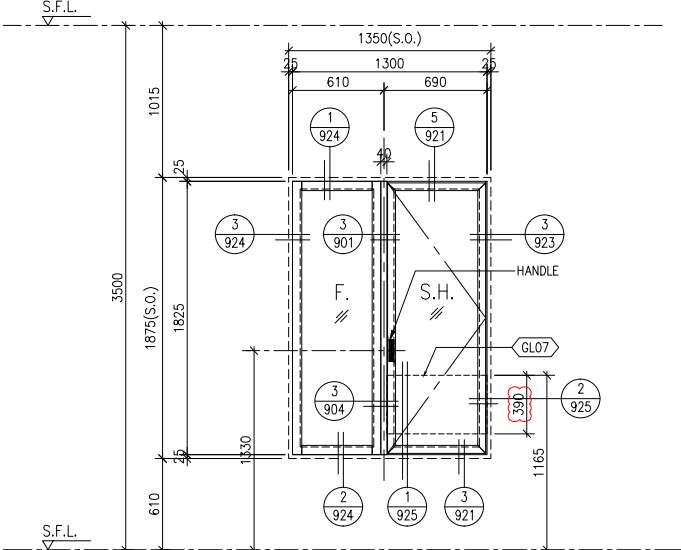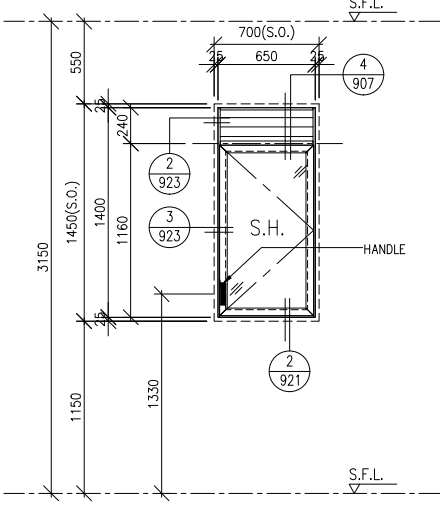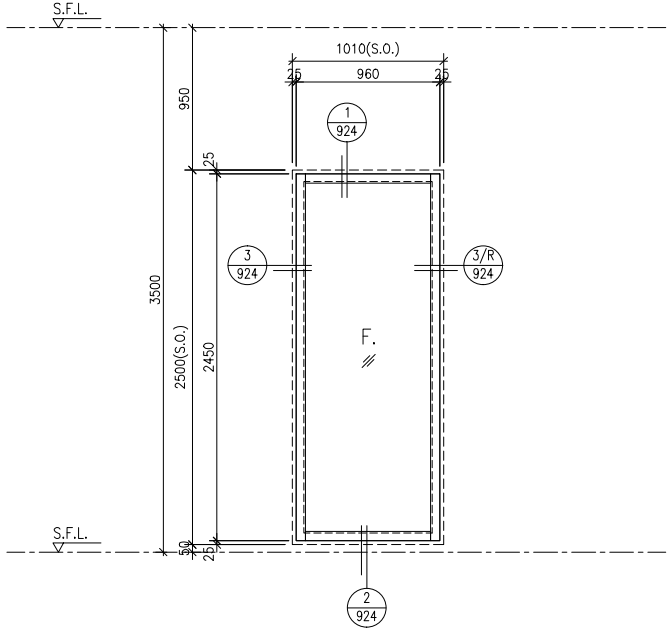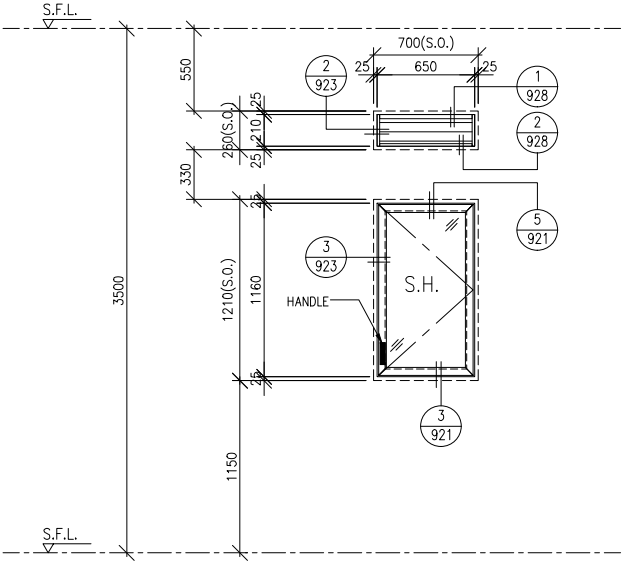OPENABLE AREA 0.78		GLAZING AREA 1.38					
WINDOW MARK W65 T2 1 no.		LOCATION TOWER 2A FLAT A – B.R.4(35/F)					
GLAZING GL02		FRAME AL11					
REMARK SITE IN–SITU WINDOW							
FREE AREA(%) 57%	OPENABLE AREA 0.64	GLAZING AREA 0.54					
							
WINDOW MARK W10 ^{IS.} T2 29 nos.		LOCATION T2 FLAT D M.BATH.(1–33/F)					
GLAZING GL06		FRAME AL11					
REMARK SITE IN–SITU WINDOW(4,13,14,24/F OMITTED)							
GLAZING AREA 1.18							
WINDOW MARK W74 T2 1 no.		LOCATION TOWER 2 – UNIT B. PRIVATE LIFT LOBBY (35/F)					
GLAZING GL02		FRAME AL11					
REMARK SITE IN–SITU WINDOW							
FREE AREA(%) 57%	OPENABLE AREA 0.64	GLAZING AREA 0.54					
							
WINDOW MARK W40A ^{IS.} T2 2 nos.		LOCATION T2 FLAT D M.BATH. (32–33/F)					
GLAZING GL06		FRAME AL11					
REMARK SITE IN–SITU WINDOW							

B.D. REF :

F.S.D. REF :

Note :
1.All dimensions are in mm.
2.All elevations are viewed from outside.
3.All dimensions to be verified on site before fabrication.

GENERAL NOTES

Legend :

1. F.F.L.-- Finished Floor Level
2. S.F.L.-- Structural Floor Level
3. (R) -- Reversed Detail

X1

DETAIL MARK NO.

X001

REFER SHEET NO.

GL02

-- GREY BLUE MONOLITHIC GLASS (12mm) w/
DRAK GREY WINDOW FRAME IN PVF2 FINISH

GL06

-- GREY BLUE MONOLITHIC GLASS (12mm) w/
FROSTED TEXTURE AT INNER SURFACE

GL07

-- CLEAR SAFETY GLASS BARRIER (12mm)

B	04.05.2020	GENERAL REVISION	
A	05.03.2020	GENERAL REVISION	
NO.	DATE	REVISED	BY

CLIENT :
佳明集團控股有限公司
GRAND MING GROUP HOLDINGS LIMITED

MAIN CONTRACTOR :
GRAND TECH CONSTRUCTION CO.LTD.

ARCHITECT :
WONG TUNG & PARTNERS LIMITED
ARCHITECTS & PLANNERS


STRUCTURAL ENGINEER :
 C M WONG & ASSOCIATES LTD

 美特鋁質有限公司
MIDI ALUMINIUM FABRICATOR LTD.
Units 6–8, Sunray Industrial Centre, 1/F
610 Cha Kwo Ling Road, Kowloon
Tel:23489211–4 Fax:(852)27727666

PROJECT :
RESIDENTIAL DEVELOPMENT AT
TSING YI TOWN LOT 190 SAI SHAN ROAD


TITLE :
WINDOW SCHEDULE
OF TOWER 2/ TOWER 2A

JOB NO. : J–851


DRAWN BY : DATE : 2–12–2019

CHKD BY : SCALE A1: A3: 1:50


DWG. NO. : J851-IW-218 REV. : B

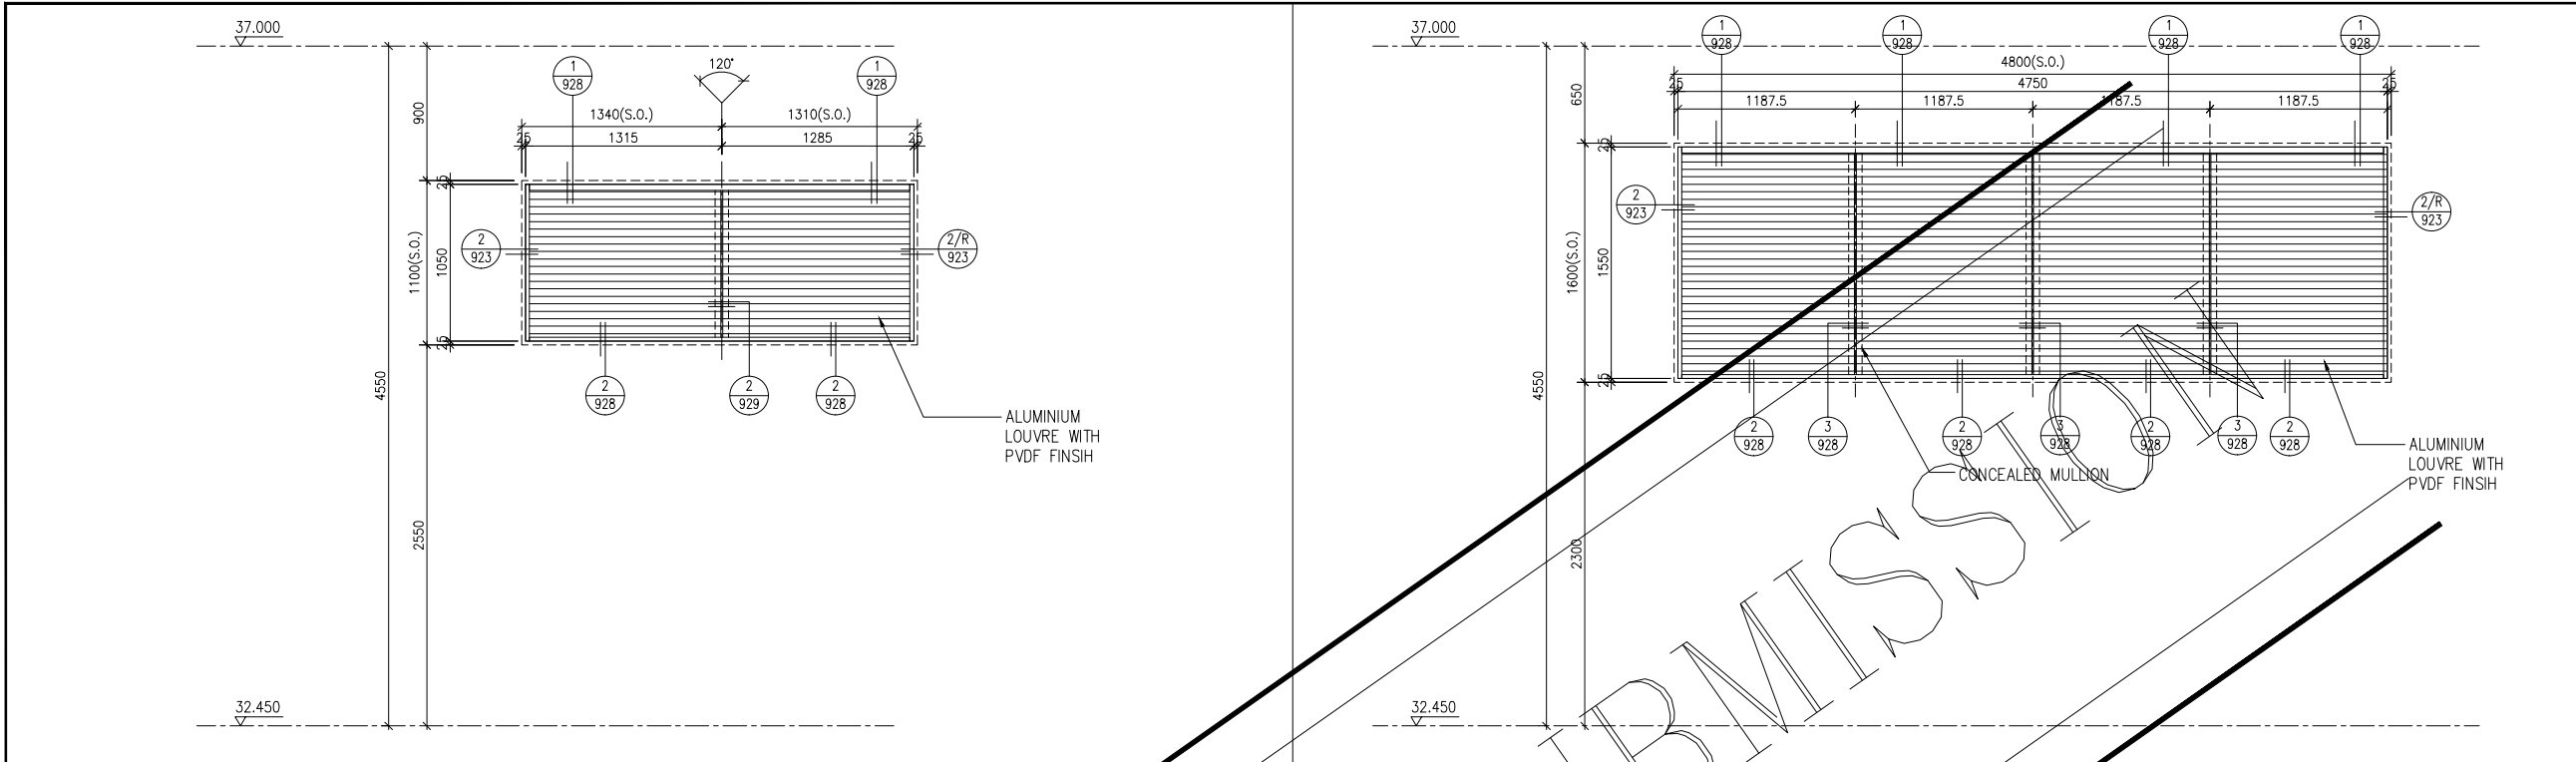


LOUVRE MARK	L1LG 1 no.	LOCATION	SMOKE VENT OUTLET AT L/GF (IN-SITU WALL)
MATERIAL	PVF2 3 COATED ALUMINIUM LOUVRES AND FRAME		
REMARK	1. ALL STEEL WORKS SHOULD BE HOP DIP GALVANIZED AND COMPLIED WITH PAINT FINISH COLOR TO BE APPROVED BY ARCHITECT		
	2. (50% FREE AREA)		
	3. LOUVRE TO BE INSTALLED ON IN-SITU WALL UNLESS OTHERWISE STATED		
	4. WITH WIRE MESH		

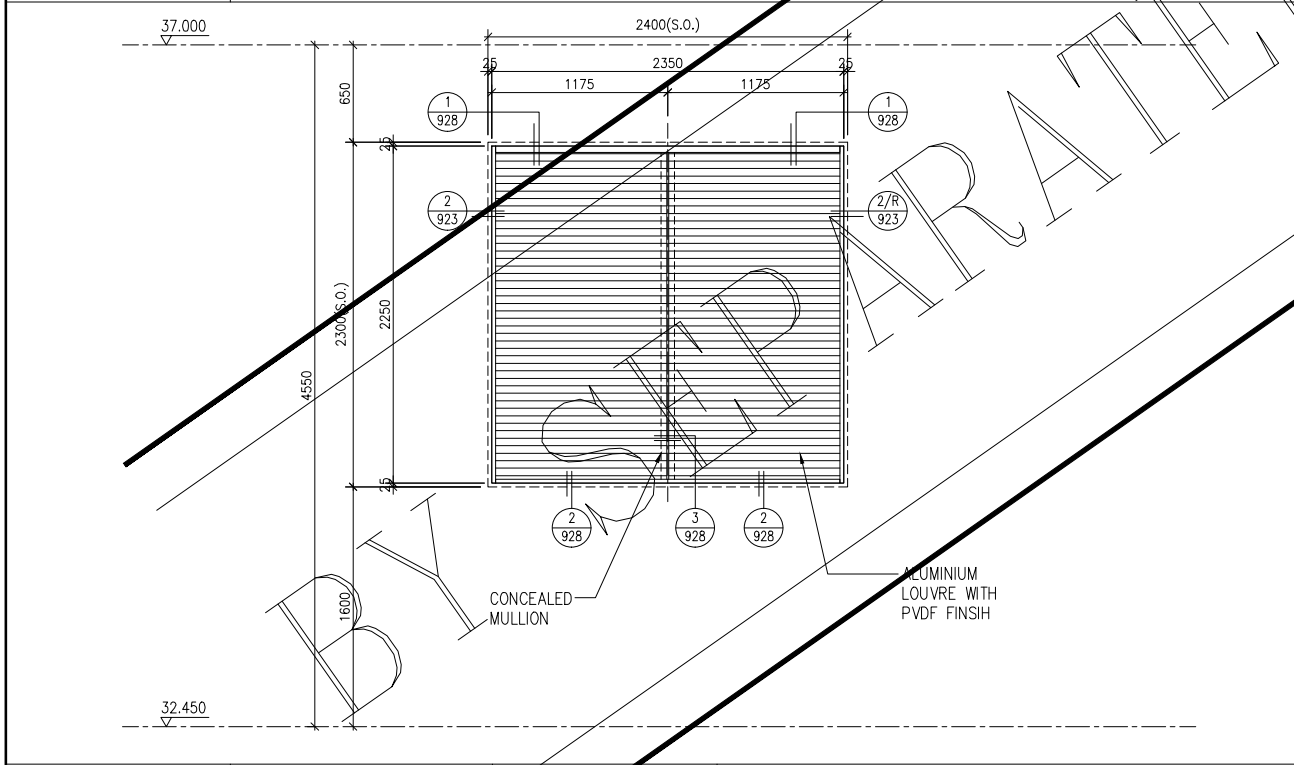

LOUVRE MARK	L3LG 1 no.	LOCATION	SMOKE VENT OUTLET AT L/GF (IN-SITU WALL)
MATERIAL	PVF2 3 COATED ALUMINIUM LOUVRES AND FRAME		
REMARK	1. ALL STEEL WORKS SHOULD BE HOP DIP GALVANIZED AND COMPLIED WITH PAINT FINISH COLOR TO BE APPROVED BY ARCHITECT		
	2. (50% FREE AREA)		
	3. LOUVRE TO BE INSTALLED ON IN-SITU WALL UNLESS OTHERWISE STATED		
	4. WITH WIRE MESH		

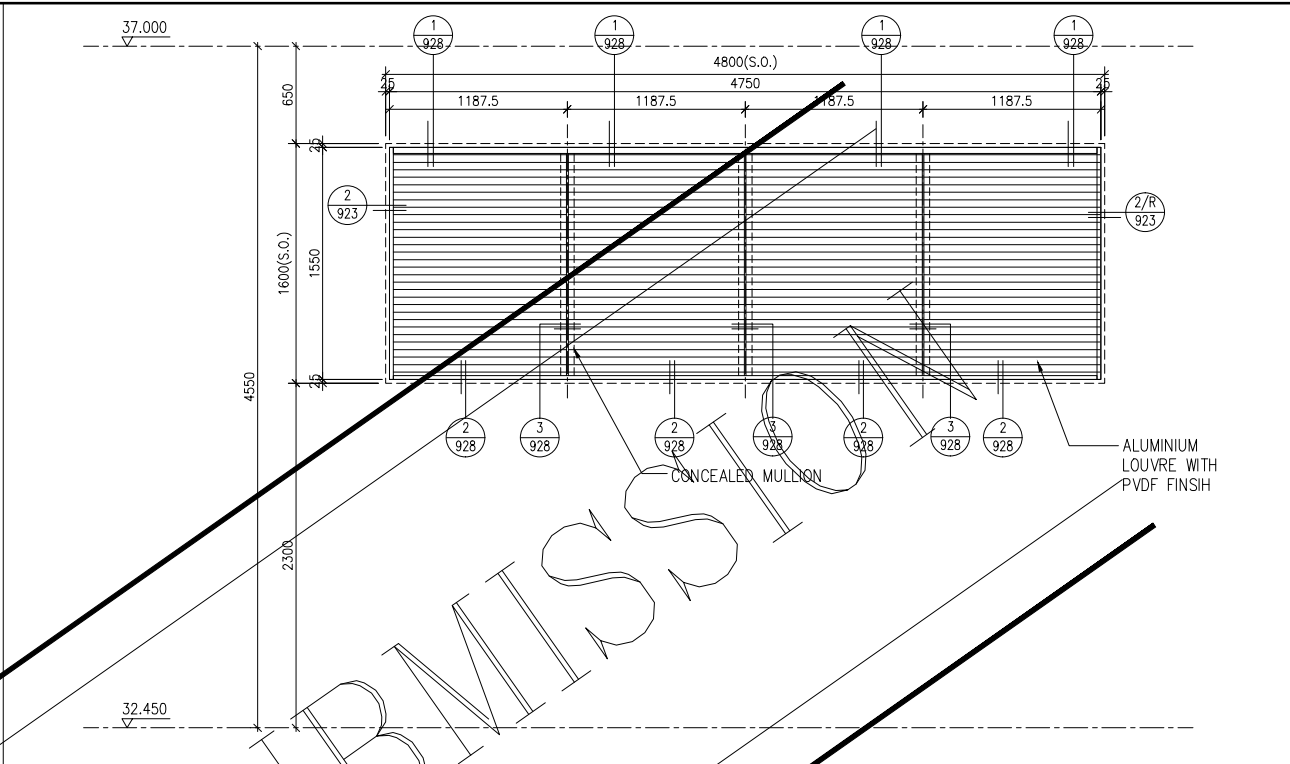

LOUVRE MARK	L2LG 1 no.	LOCATION	CARPARK SPACE AT L/GF (IN-SITU WALL)
MATERIAL	PVF2 3 COATED ALUMINIUM LOUVRES AND FRAME		
REMARK	1. ALL STEEL WORKS SHOULD BE HOP DIP GALVANIZED AND COMPLIED WITH PAINT FINISH COLOR TO BE APPROVED BY ARCHITECT		
	2. (50% FREE AREA)		
	3. LOUVRE TO BE INSTALLED ON IN-SITU WALL UNLESS OTHERWISE STATED		
	4. WITH WIRE MESH		

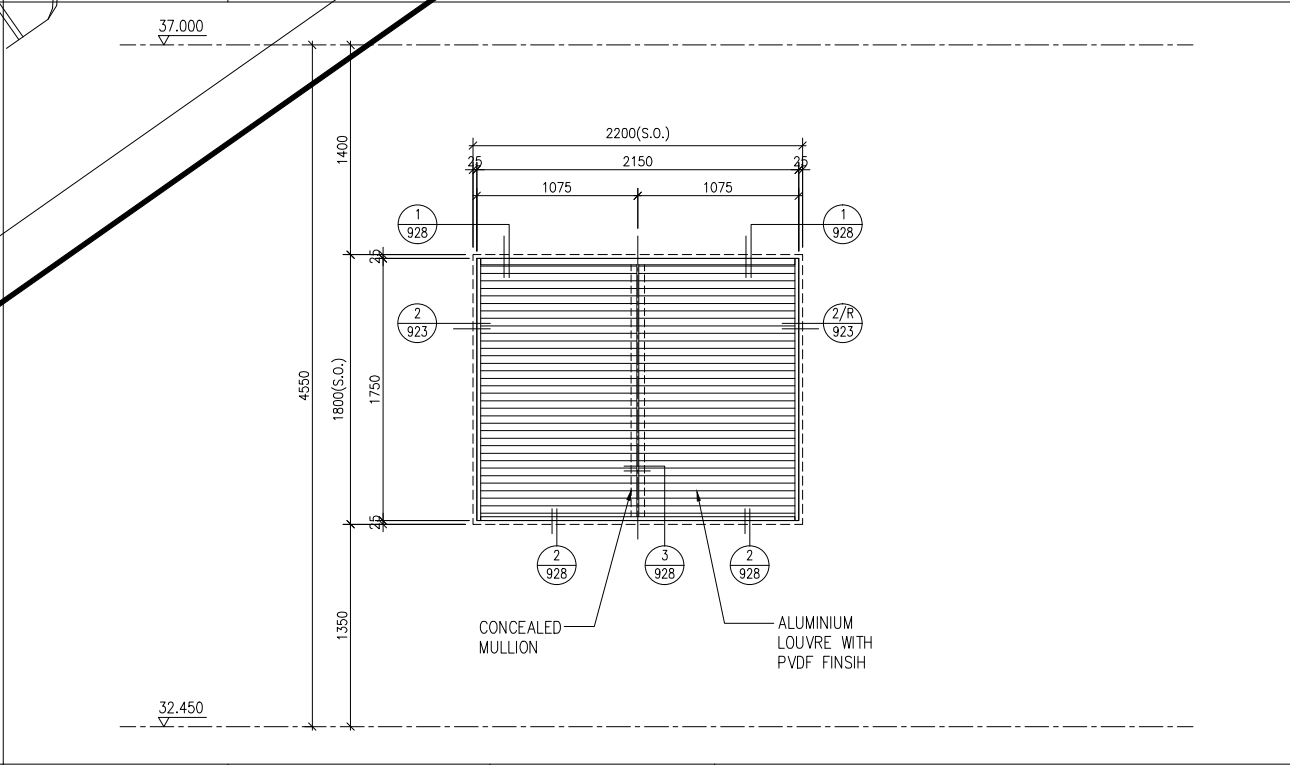

LOUVRE MARK	L4LG 1 no.	LOCATION	SMOKE VENT OUTLET AT L/GF (IN-SITU WALL)
MATERIAL	PVF2 3 COATED ALUMINIUM LOUVRES AND FRAME		
REMARK	1. ALL STEEL WORKS SHOULD BE HOP DIP GALVANIZED AND COMPLIED WITH PAINT FINISH COLOR TO BE APPROVED BY ARCHITECT		
	2. (50% FREE AREA)		
	3. LOUVRE TO BE INSTALLED ON IN-SITU WALL UNLESS OTHERWISE STATED		
	4. WITH WIRE MESH		

B.D. REF :

F.S.D. REF :

Note :
1.All dimensions are in mm.
2.All elevations are viewed from outside.
3.All dimensions to be verified on site before fabrication.

GENERAL NOTES

Legend :

1. F.F.L.-- Finished Floor Level
2. S.F.L.-- Structural Floor Level
3. (R) -- Reversed Detail

X1

DETAIL MARK NO.

X001

REFER SHEET NO.

A	13.02.2020	GENERAL REVISION	
NO.	DATE	REVISED	BY

CLIENT :
佳明集團控股有限公司
GRAND MING GROUP HOLDINGS LIMITED

MAIN CONTRACTOR :
GRAND TECH CONSTRUCTION CO. LTD.

ARCHITECT :
WONG TUNG & PARTNERS LIMITED
ARCHITECTS & PLANNERS

STRUCTURAL ENGINEER :
 C M WONG & ASSOCIATES LTD

美特鋁質有限公司
MIDI ALUMINIUM FABRICATOR LTD.
Units 6-8, Sunray Industrial Centre, 1/F
610 Cha Kwo Ling Road, Kowloon
Tel:23489211-4 Fax:(852)27727666

PROJECT :
RESIDENTIAL DEVELOPMENT AT
TSING YI TOWN LOT 190 SAI SHAN ROAD


TITLE :
LOUVRE SCHEDULE
OF LOWER GROUND FLOOR

JOB NO. : J-851

DRAWN BY : DATE : 2-12-2019

CHKD BY : SCALE A1: A3: 1:50

DWG. NO. : J851-IW-131 REV. : A

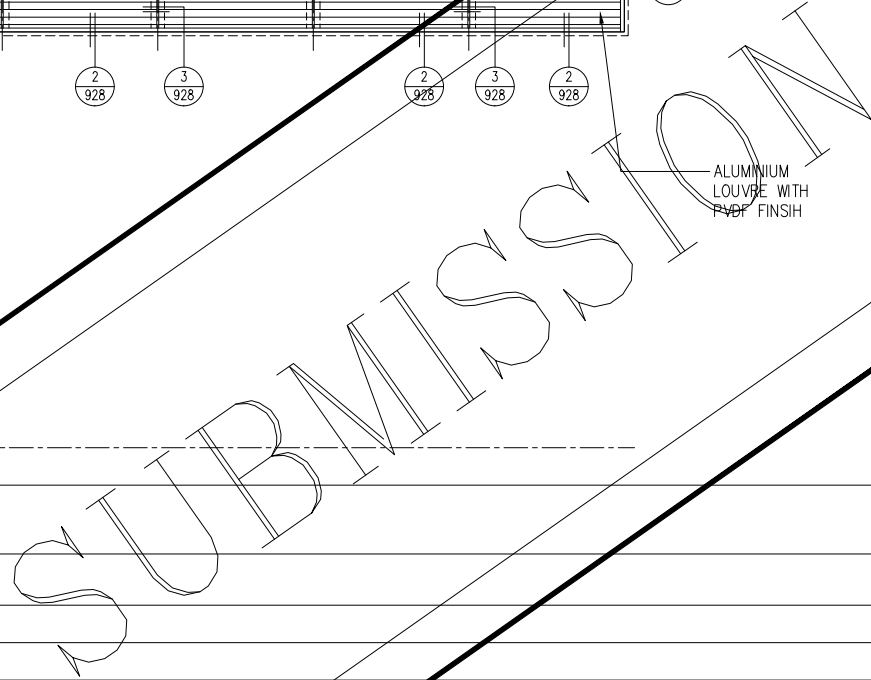

WALL UNLESS OTHERWISE STATED

050(S.O.)

1000



25

2050

2/R 923

2 928

ALUMINIUM LOUVRE WITH PVDF FINISH

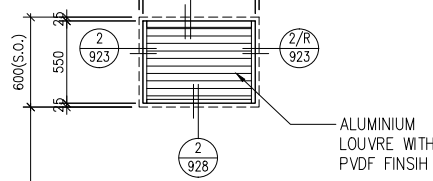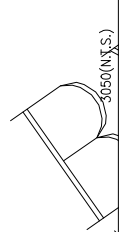

Legend :

1. F.F.L.-- Finished Floor Level
2. S.F.L.-- Structural Floor Level
3. (R) -- Reversed Detail


 X1 ← DETAIL MARK NO.
 X001 ← REFER SHEET NO.

A	13.02.2020	GENERAL REVISION	
NO.	DATE	REVISED	BY

CLIENT : 佳明集團控股有限公司
GRAND MING GROUP HOLDINGS LIMITED

MAIN CONTRACTOR :
GRAND TECH CONSTRUCTION CO.LTD.

ARCHITECT : **WONG TUNG & PARTNERS LIMITED**
ARCHITECTS & PLANNERS



STRUCTURAL ENGINEER :


 **C M WONG & ASSOCIATES LTD**

美特鋁質有限公司
MIDI ALUMINIUM FABRICATOR LTD.
Units 6-8, Sunray Industrial Centre, 1/F
610 Cha Kwo Ling Road, Kowloon
Tel: 23489211-4 Fax: (852) 27727666


PROJECT :
RESIDENTIAL DEVELOPMENT AT
TSING YI TOWN LOT 190 SAI SHAN ROAD

TITLE :
LOUVRE SCHEDULE
OF LOWER GROUND FLOOR


JOB NO. : J-851	
DRAWN BY :	DATE : 2-12-2019
CHKD BY :	SCALE A1: A3: 1:50
DWG. NO. : J851-IW-132	REV. : A

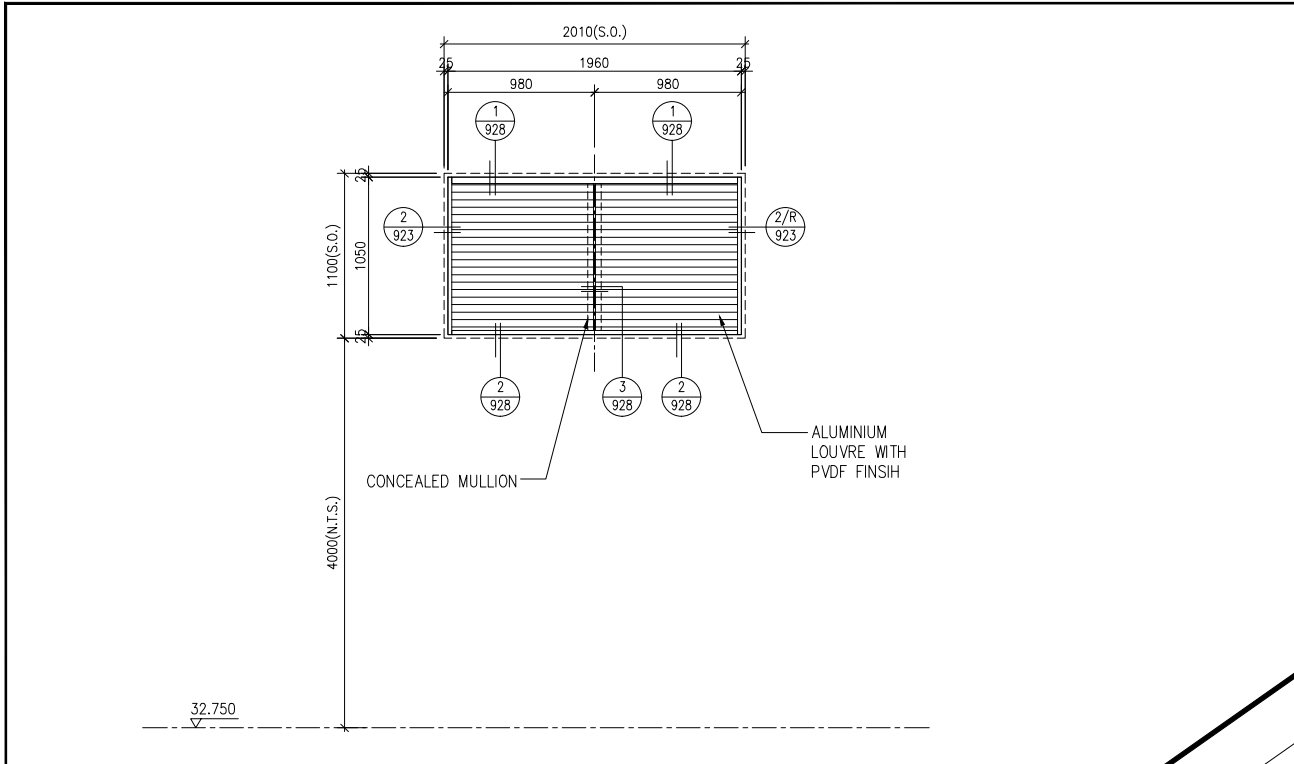


LOUVRE MARK	 1 no.	LOCATION	SMOKE VENT OUTLET AT L/GF (IN-SITU WALL)
MATERIAL	PVF2 3 COATED ALUMINIUM LOUVRES AND FRAME		
REMARK	1. ALL STEEL WORKS SHOULD BE HOP DIP GALVANIZED AND COMPLIED WITH PAINT FINISH COLOR TO BE APPROVED BY ARCHITECT 2. (50% FREE AREA) 3. LOUVRE TO BE INSTALLED ON IN-SITU WALL UNLESS OTHERWISE STATED 4. WITH WIRE MESH		

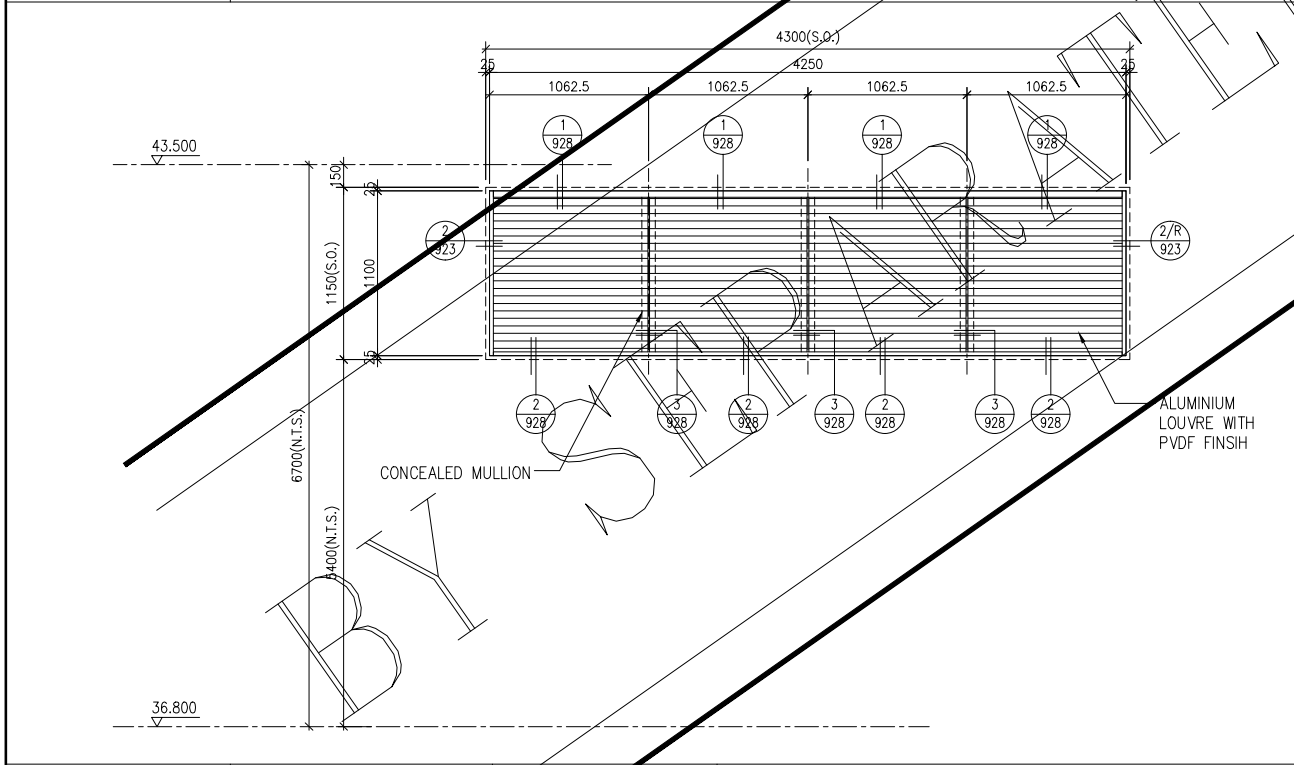

LOUVRE MARK	 1 no.	LOCATION	SMOKE VENT OUTLET AT U/GF (IN-SITU WALL)
MATERIAL	PVF2 3 COATED ALUMINIUM LOUVRES AND FRAME		
REMARK	1. ALL STEEL WORKS SHOULD BE HOP DIP GALVANIZED AND COMPLIED WITH PAINT FINISH COLOR TO BE APPROVED BY ARCHITECT 2. (50% FREE AREA) 3. LOUVRE TO BE INSTALLED ON IN-SITU WALL UNLESS OTHERWISE STATED 4. WITH WIRE MESH		



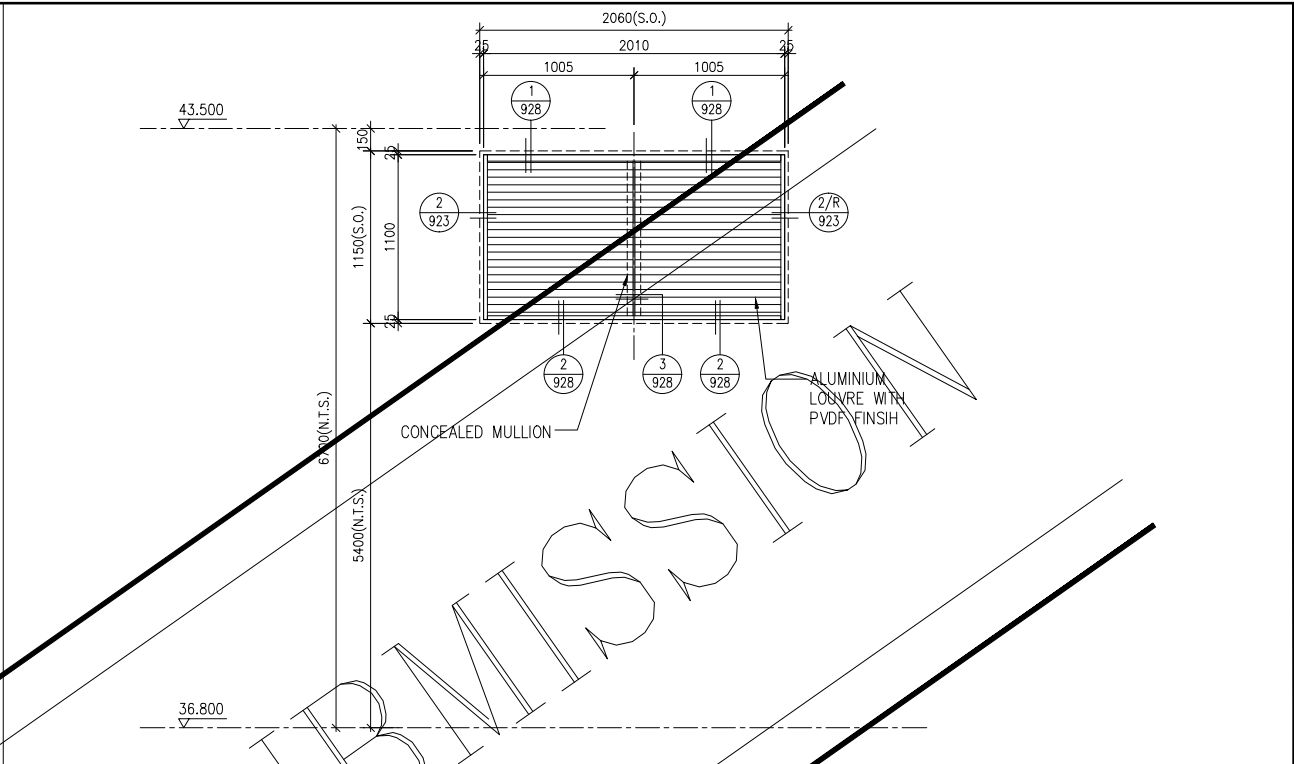




LOUVRE MARK	 1 no.	LOCATION	SMOKE VENT OUTLET AT U/GF (IN-SITU WALL)
MATERIAL	PVF2 3 COATED ALUMINIUM LOUVRES AND FRAME		
REMARK	1. ALL STEEL WORKS SHOULD BE HOP DIP GALVANIZED AND COMPLIED WITH PAINT FINISH COLOR TO BE APPROVED BY ARCHITECT 2. (50% FREE AREA) 3. LOUVRE TO BE INSTALLED ON IN-SITU WALL UNLESS OTHERWISE STATED 4. WITH WIRE MESH		

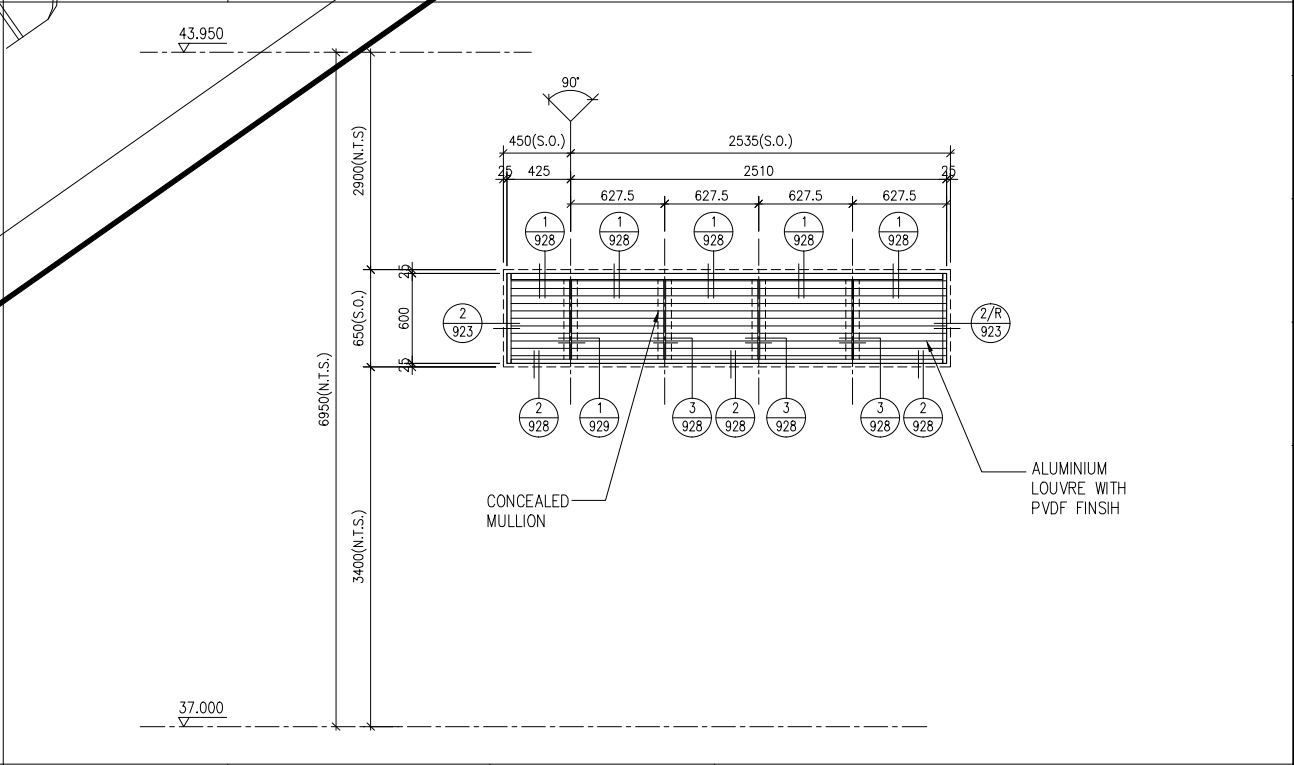

LOUVRE MARK	 1 no.	LOCATION	OUTDOOR OF LANDING/UNLOADING SPACE AT U/GF (IN-SITU WALL)
MATERIAL	PVF2 3 COATED ALUMINIUM LOUVRES AND FRAME		
REMARK	1. ALL STEEL WORKS SHOULD BE HOP DIP GALVANIZED AND COMPLIED WITH PAINT FINISH COLOR TO BE APPROVED BY ARCHITECT 2. (50% FREE AREA) 3. LOUVRE TO BE INSTALLED ON IN-SITU WALL UNLESS OTHERWISE STATED 4. WITH WIRE MESH		

B.D. REF :			
F.S.D. REF :			
Note : 1.All dimensions are in mm. 2.All elevations are viewed from outside. 3.All dimensions to be verified on site before fabrication.			
GENERAL NOTES			
Legend : 1. F.F.L.-- Finished Floor Level 2. S.F.L.-- Structural Floor Level 3. (R) -- Reversed Detail			
 -- DETAIL MARK NO.  -- REFER SHEET NO.			
CLIENT :			
佳明集團控股有限公司 GRAND MING GROUP HOLDINGS LIMITED			
MAIN CONTRACTOR :			
GRAND TECH CONSTRUCTION CO. LTD.			
ARCHITECT :			
WONG TUNG & PARTNERS LIMITED ARCHITECTS & PLANNERS 			
STRUCTURAL ENGINEER :			
 C M WONG & ASSOCIATES LTD			
PROJECT :			
RESIDENTIAL DEVELOPMENT AT TSING YI TOWN LOT 190 SAI SHAN ROAD			
TITLE :			
LOUVRE SCHEDULE OF LOWER GROUND FLOOR AND UPPER GROUND FLOOR			
JOB NO. : J-851			
DRAWN BY :		DATE : 2-12-2019	
CHKD BY :		SCALE A1: A3: 1:50	
DWG. NO. : J851-IW-133			REV. : A

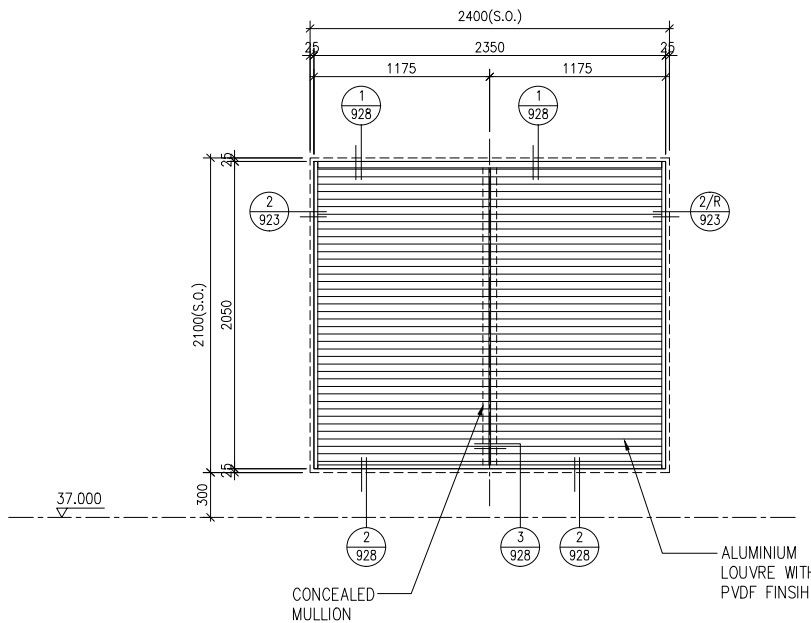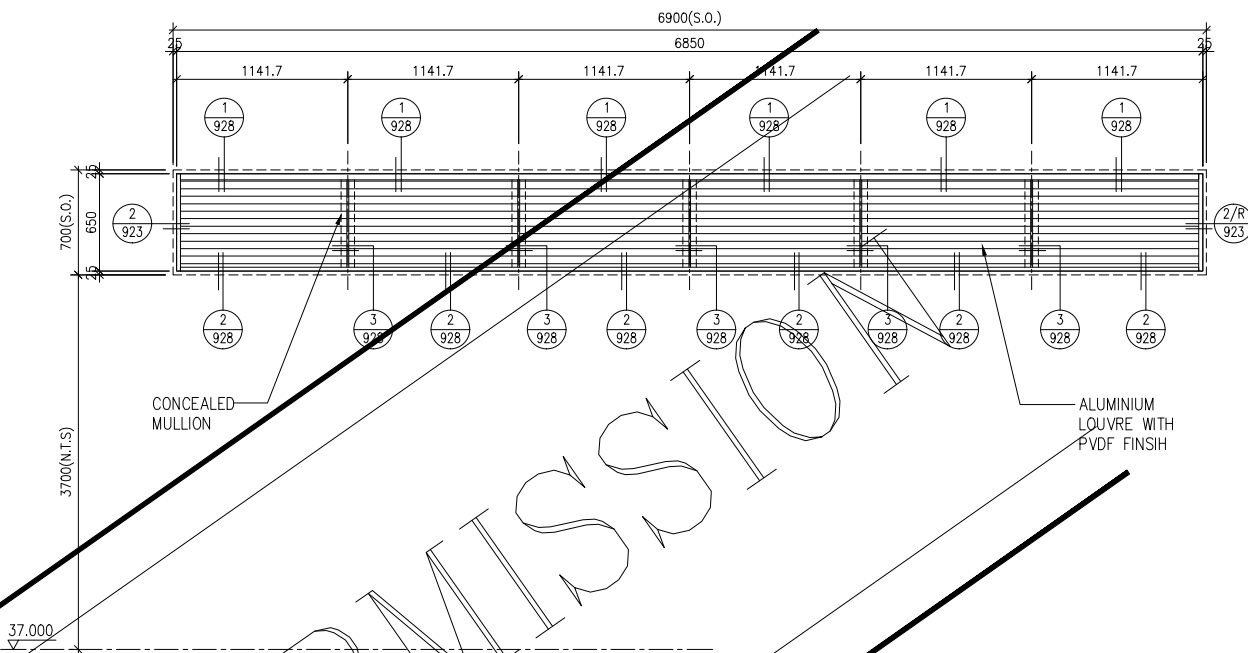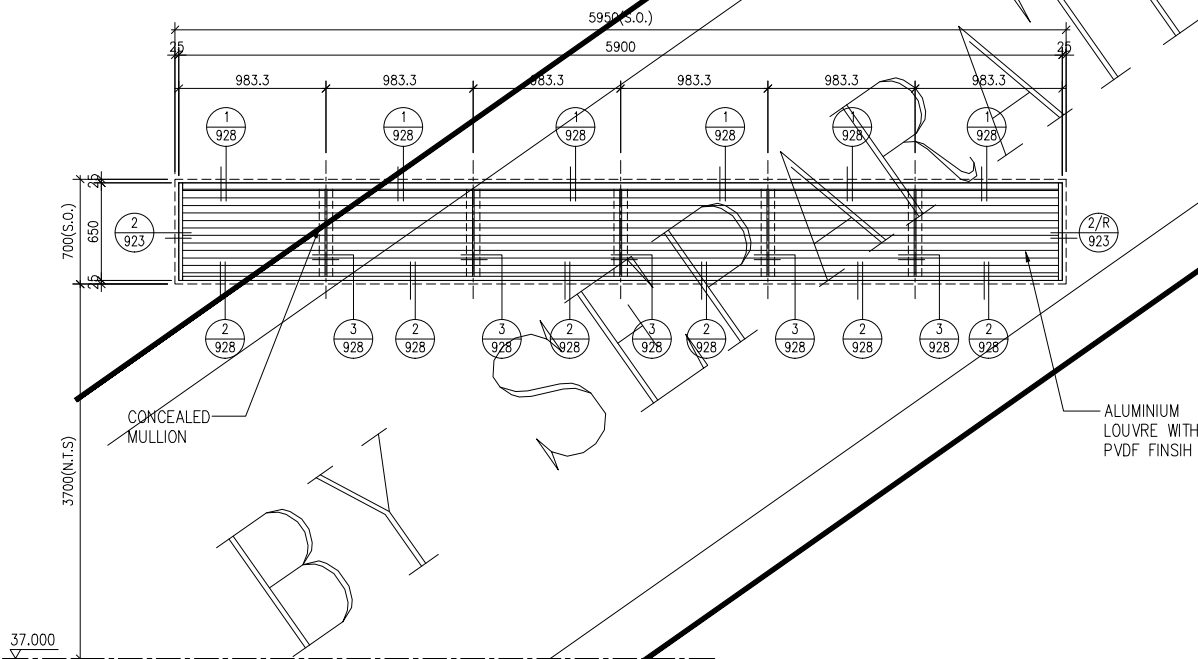								B.D. REF : F.S.D. REF : Note : 1.All dimensions are in mm. 2.All elevations are viewed from outside. 3.All dimensions to be verified on site before fabrication. GENERAL NOTES Legend : 1. F.F.L--- Finished Floor Level 2. S.F.L--- Structural Floor Level 3. (R) --- Reversed Detail X1 --- DETAIL MARK NO. X001 --- REFER SHEET NO.					
LOUVRE MARK	 1 no.	LOCATION	SMOKE VENT OUTLET AT U/GF (IN-SITU WALL)	LOUVRE MARK	 2 nos.	LOCATION	CLUBHOUSE OF SITTING AREA & ART PAINTING GALLERY AT U/GF (IN-SITU WALL)						
MATERIAL	PVF2 3 COATED ALUMINIUM LOUVRES AND FRAME			MATERIAL	PVF2 3 COATED ALUMINIUM LOUVRES AND FRAME								
REMARK	1. ALL STEEL WORKS SHOULD BE HOP DIP GALVANIZED AND COMPLIED WITH PAINT FINISH COLOR TO BE APPROVED BY ARCHITECT			REMARK	1. ALL STEEL WORKS SHOULD BE HOP DIP GALVANIZED AND COMPLIED WITH PAINT FINISH COLOR TO BE APPROVED BY ARCHITECT								
	2. (50% FREE AREA)				2. (50% FREE AREA)								
	3. LOUVRE TO BE INSTALLED ON IN-SITU WALL UNLESS OTHERWISE STATED				3. LOUVRE TO BE INSTALLED ON IN-SITU WALL UNLESS OTHERWISE STATED								
	4. WITH WIRE MESH				4. WITH WIRE MESH								
													
LOUVRE MARK	 1 no.	LOCATION	CLUBHOUSE OF SITTING AREA AT U/GF (IN-SITU WALL)	LOUVRE MARK		LOCATION				CLIENT : 佳明集團控股有限公司 GRAND MING GROUP HOLDINGS LIMITED			
MATERIAL	PVF2 3 COATED ALUMINIUM LOUVRES AND FRAME			MATERIAL				MAIN CONTRACTOR : GRAND TECH CONSTRUCTION CO.LTD.					
REMARK	1. ALL STEEL WORKS SHOULD BE HOP DIP GALVANIZED AND COMPLIED WITH PAINT FINISH COLOR TO BE APPROVED BY ARCHITECT			REMARK				ARCHITECT : WONG TUNG & PARTNERS LIMITED ARCHITECTS & PLANNERS 					
	2. (50% FREE AREA)							STRUCTURAL ENGINEER :  C M WONG & ASSOCIATES LTD					
	3. LOUVRE TO BE INSTALLED ON IN-SITU WALL UNLESS OTHERWISE STATED							 美特鋁質有限公司 MIDI ALUMINIUM FABRICATOR LTD. Units 6-8, Sunray Industrial Centre, 1/F 610 Cha Kwo Ling Road, Kowloon Tel:23489211-4 Fax:(852)27727666					
	4. WITH WIRE MESH							PROJECT : RESIDENTIAL DEVELOPMENT AT TSING YI TOWN LOT 190 SAI SHAN ROAD					
				TITLE : LOUVRE SCHEDULE OF UPPER GROUND FLOOR									
				JOB NO. : J-851									
				DRAWN BY :				DATE : 2-12-2019					
				CHKD BY :				SCALE A1: A3: 1:50					
				DWG. NO. : J851-IW-134		REV. : A							

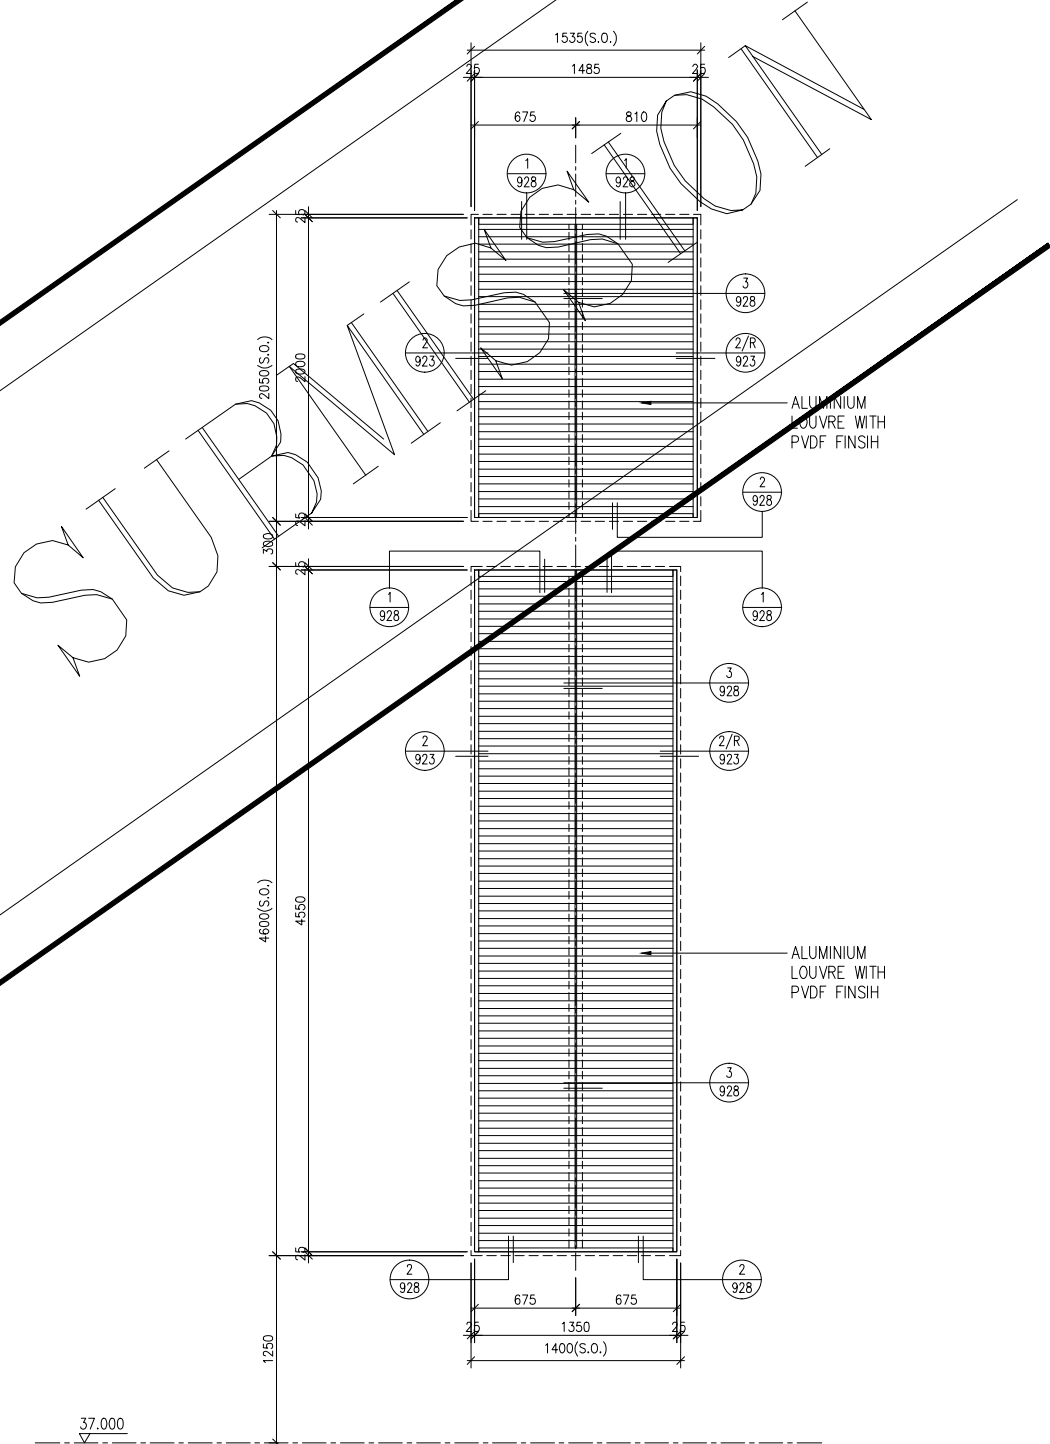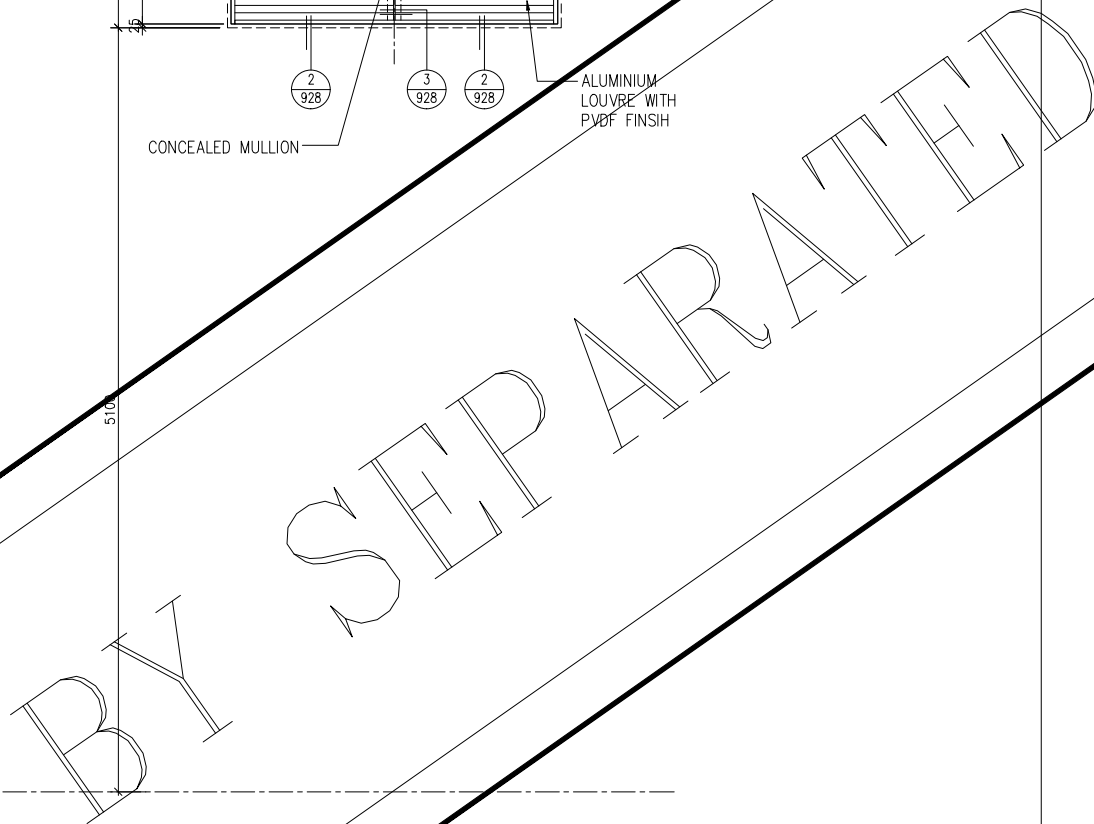

LOUVRE MARK	 1 no.	LOCATION	SMOKE VENT OUTLET AT U/GF (IN-SITU WALL)
MATERIAL	PVF2 3 COATED ALUMINIUM LOUVRES AND FRAME		
REMARK	1. ALL STEEL WORKS SHOULD BE HOP DIP GALVANIZED AND COMPLIED WITH PAINT FINISH COLOR TO BE APPROVED BY ARCHITECT		
	2. (50% FREE AREA)		
	3. LOUVRE TO BE INSTALLED ON IN-SITU WALL UNLESS OTHERWISE STATED		
	4. WITH WIRE MESH		

LOUVRE MARK	 1 no.	LOCATION	EXHAUST AIR DUCT AT U/GF (IN-SITU WALL)
MATERIAL	PVF2 3 COATED ALUMINIUM LOUVRES AND FRAME		
REMARK	1. ALL STEEL WORKS SHOULD BE HOP DIP GALVANIZED AND COMPLIED WITH PAINT FINISH COLOR TO BE APPROVED BY ARCHITECT		
	2. (50% FREE AREA)		
	3. LOUVRE TO BE INSTALLED ON IN-SITU WALL UNLESS OTHERWISE STATED		
	4. WITH WIRE MESH		

B.D. REF :
F.S.D. REF :

Note :
1.All dimensions are in mm.
2.All elevations are viewed from outside.
3.All dimensions to be verified on site before fabrication.

GENERAL NOTES


Legend :

1. F.F.L.-- Finished Floor Level
2. S.F.L.-- Structural Floor Level
3. (R) -- Reversed Detail


X1

X001


DETAIL MARK NO.
REFER SHEET NO.

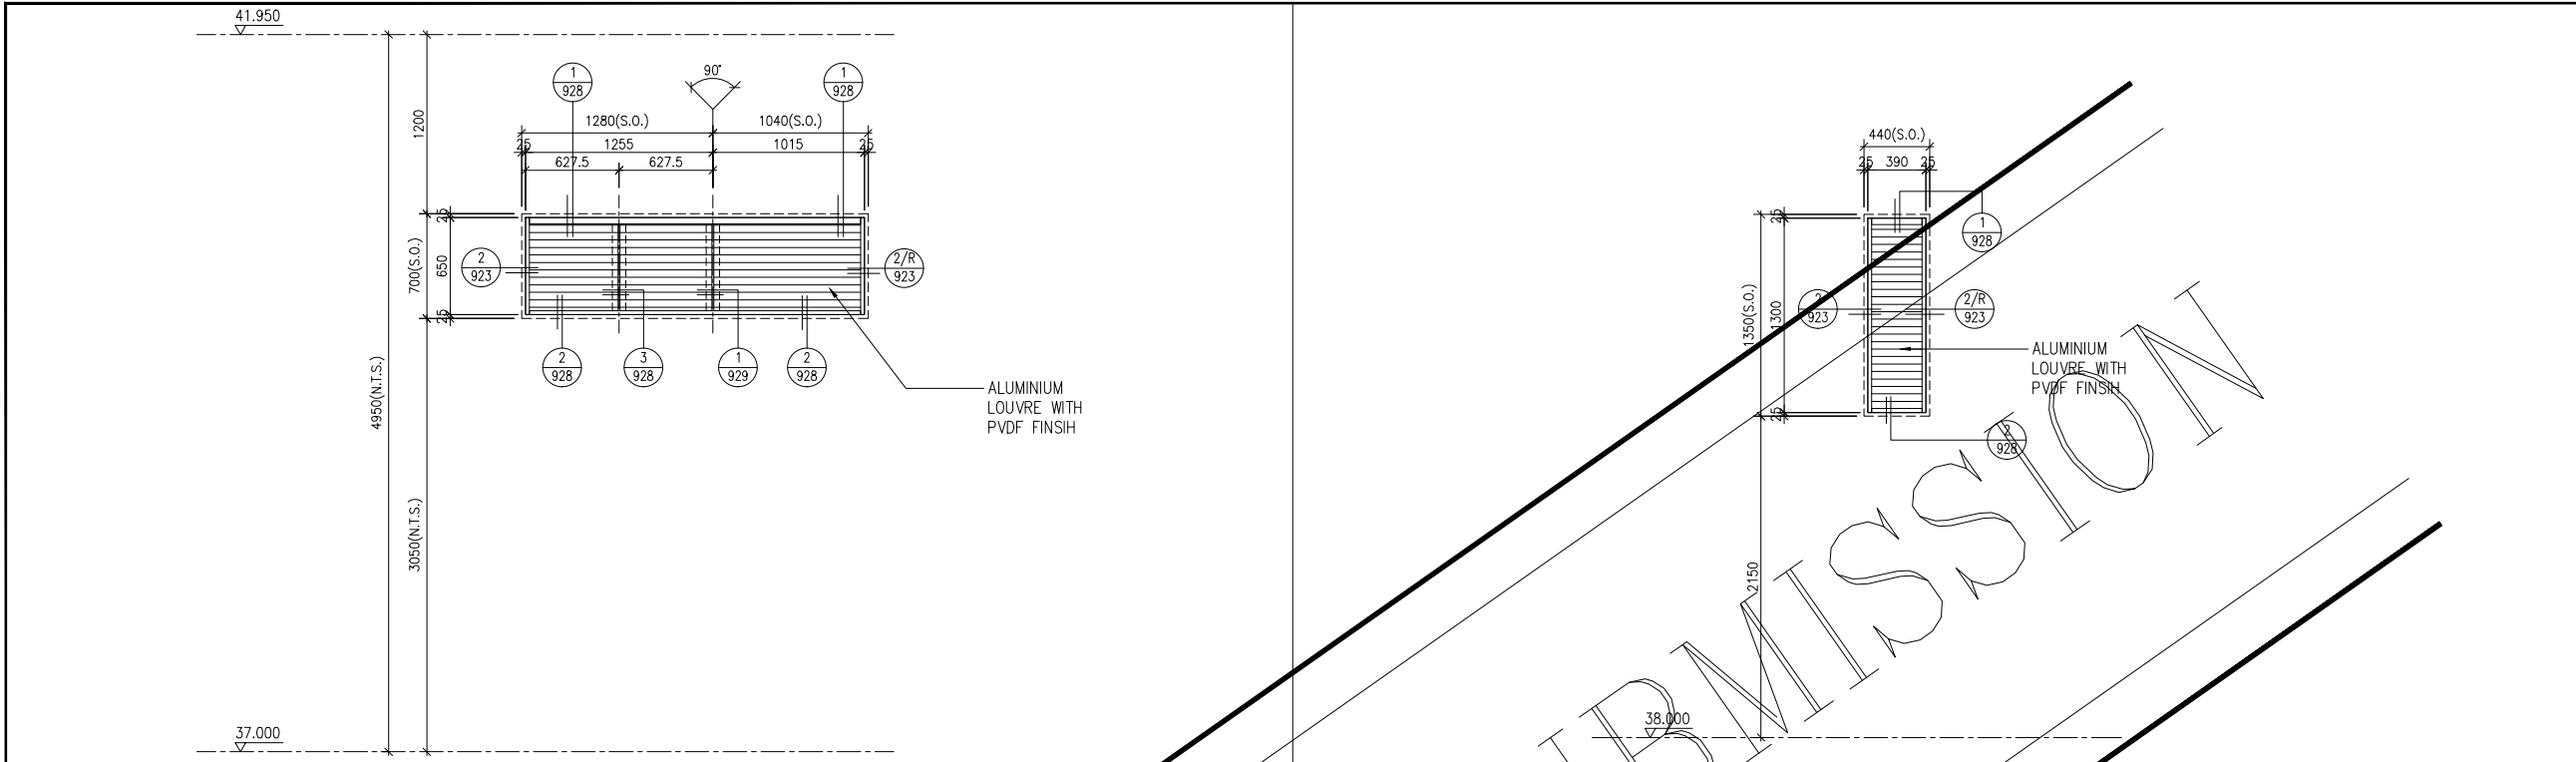


LOUVRE MARK	L17 LG 1 no.	LOCATION	OUTDOOR OF CLUBHOUSE AT L/GF (IN-SITU WALL)
MATERIAL	PVF2 3 COATED ALUMINIUM LOUVRES AND FRAME		
REMARK	1. ALL STEEL WORKS SHOULD BE HOP DIP GALVANIZED AND COMPLIED WITH PAINT FINISH COLOR TO BE APPROVED BY ARCHITECT		
	2. (50% FREE AREA)		
	3. LOUVRE TO BE INSTALLED ON IN-SITU WALL UNLESS OTHERWISE STATED		
	4. WITH WIRE MESH		

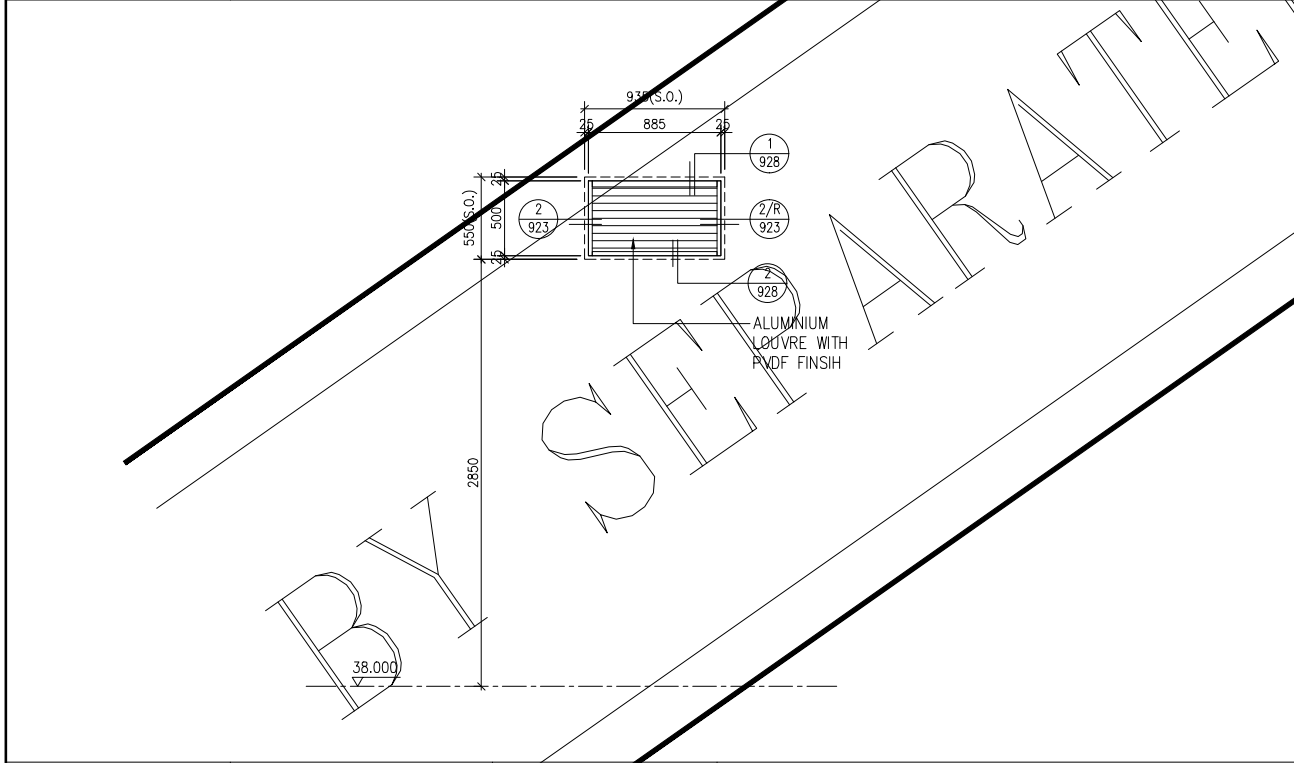

LOUVRE MARK	L19 UG 1 no.	LOCATION	WATCHMAN QUARTER AT U/GF (IN-SITU WALL)
MATERIAL	PVF2 3 COATED ALUMINIUM LOUVRES AND FRAME		
REMARK	1. ALL STEEL WORKS SHOULD BE HOP DIP GALVANIZED AND COMPLIED WITH PAINT FINISH COLOR TO BE APPROVED BY ARCHITECT		
	2. (50% FREE AREA)		
	3. LOUVRE TO BE INSTALLED ON IN-SITU WALL UNLESS OTHERWISE STATED		
	4. WITH WIRE MESH		




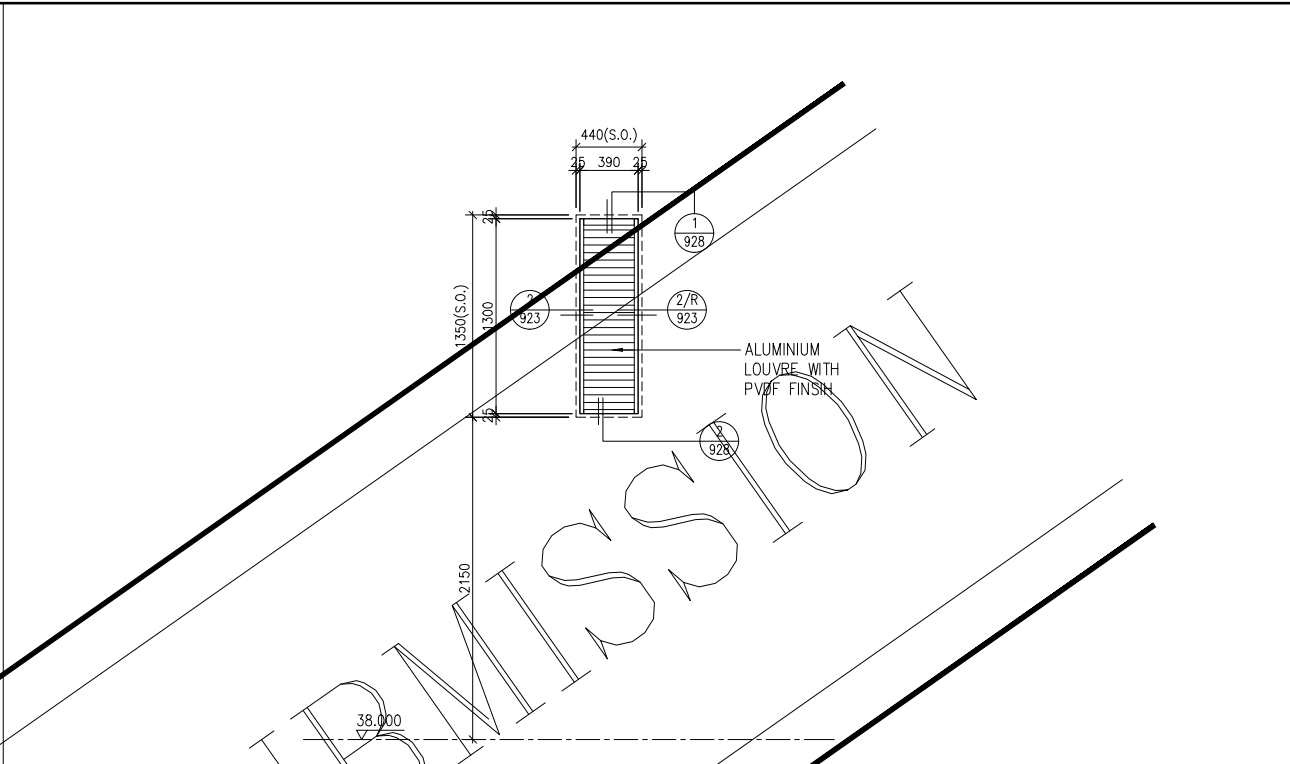




LOUVRE MARK	L18 UG 1 no.	LOCATION	WATCHMAN QUARTER AT U/GF (IN-SITU WALL)
MATERIAL	PVF2 3 COATED ALUMINIUM LOUVRES AND FRAME		
REMARK	1. ALL STEEL WORKS SHOULD BE HOP DIP GALVANIZED AND COMPLIED WITH PAINT FINISH COLOR TO BE APPROVED BY ARCHITECT		
	2. (50% FREE AREA)		
	3. LOUVRE TO BE INSTALLED ON IN-SITU WALL UNLESS OTHERWISE STATED		
	4. WITH WIRE MESH		

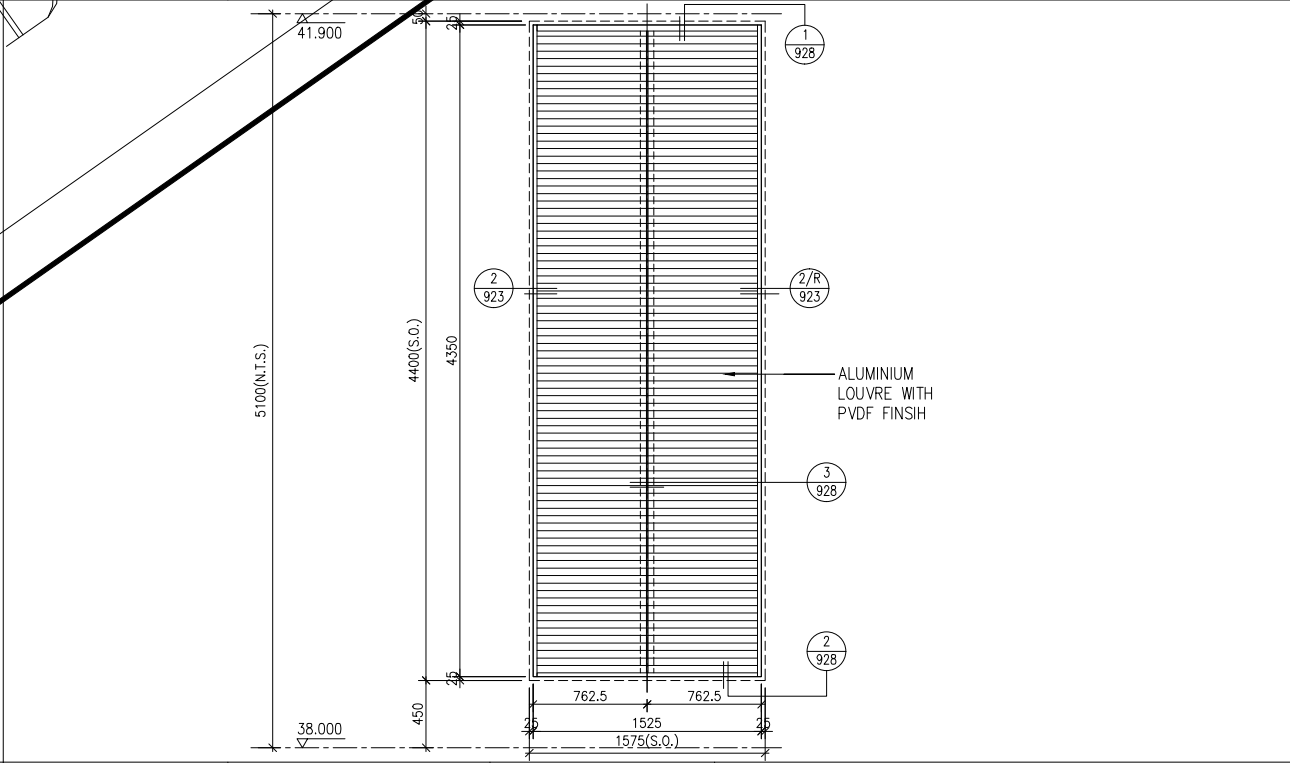

LOUVRE MARK	L20 UG 1 no.	LOCATION	EXHAUST AIR DUCT AT U/GF (IN-SITU WALL)
MATERIAL	PVF2 3 COATED ALUMINIUM LOUVRES AND FRAME		
REMARK	1. ALL STEEL WORKS SHOULD BE HOP DIP GALVANIZED AND COMPLIED WITH PAINT FINISH COLOR TO BE APPROVED BY ARCHITECT		
	2. (50% FREE AREA)		
	3. LOUVRE TO BE INSTALLED ON IN-SITU WALL UNLESS OTHERWISE STATED		
	4. WITH WIRE MESH		

B.D. REF :		
F.S.D. REF :		
Note : 1.All dimensions are in mm. 2.All elevations are viewed from outside. 3.All dimensions to be verified on site before fabrication.		
GENERAL NOTES		
Legend : 1. F.F.L--- Finished Floor Level 2. S.F.L--- Structural Floor Level 3. (R) --- Reversed Detail		
X1 X001 DETAIL MARK NO. REFER SHEET NO.		
A	13.02.2020	GENERAL REVISION
NO.	DATE	REVISED BY
CLIENT :		
佳明集團控股有限公司 GRAND MING GROUP HOLDINGS LIMITED		
MAIN CONTRACTOR :		
GRAND TECH CONSTRUCTION CO.LTD.		
ARCHITECT :		
WONG TUNG & PARTNERS LIMITED ARCHITECTS & PLANNERS WT		
STRUCTURAL ENGINEER :		
C M WONG & ASSOCIATES LTD		
美特鋁質有限公司 MIDI ALUMINIUM FABRICATOR LTD. Units 6-8, Sunray Industrial Centre, 1/F 610 Cha Kwo Ling Road, Kowloon Tel:23489211-4 Fax:(852)27727666		
PROJECT :		
RESIDENTIAL DEVELOPMENT AT TSING YI TOWN LOT 190 SAI SHAN ROAD		
TITLE :		
LOUVRE SCHEDULE OF UPPER GROUND FLOOR		
JOB NO. : J-851		
DRAWN BY :		DATE : 2-12-2019
CHKD BY :		SCALE A1: A3: 1:50
DWG. NO. : J851-IW-136		REV. : A

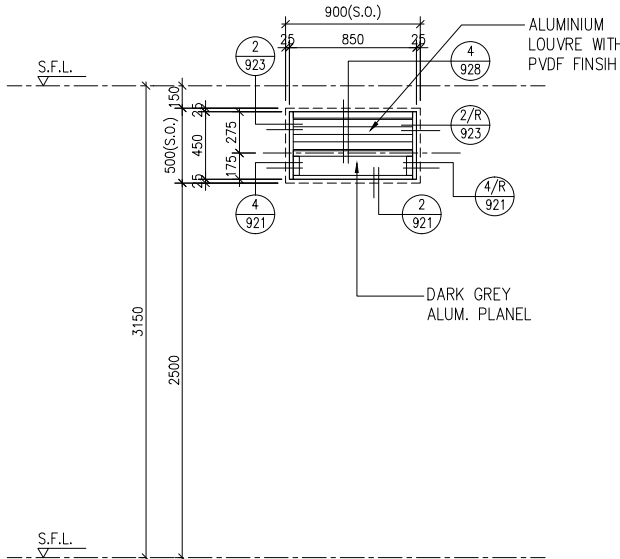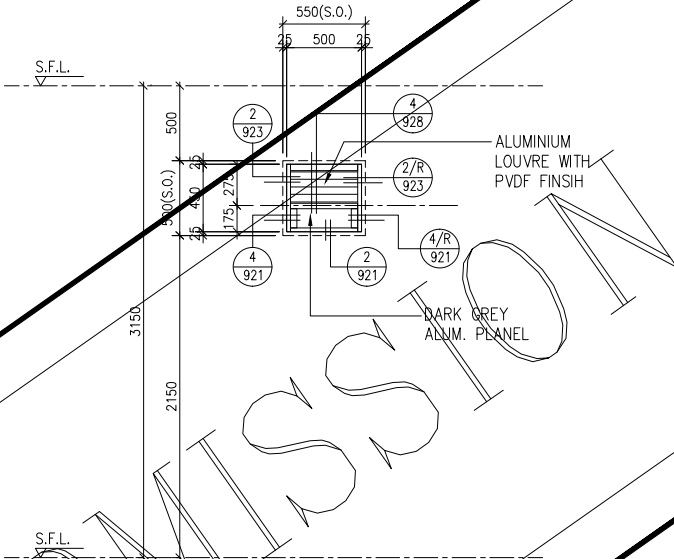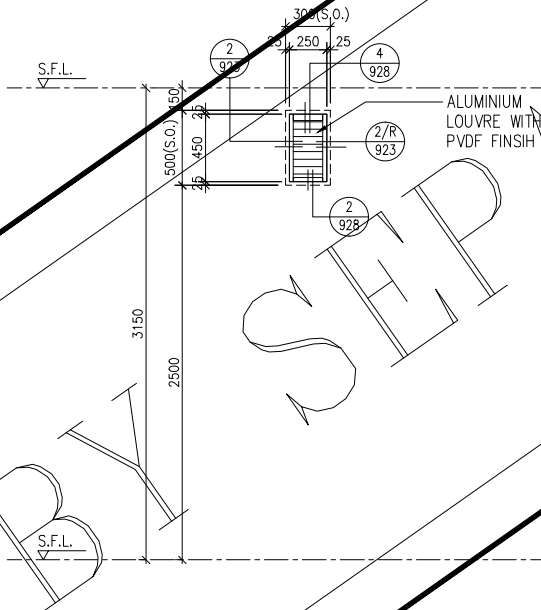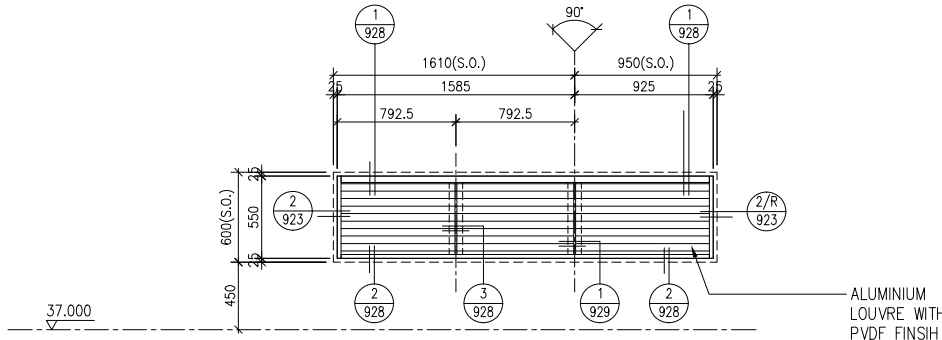																							
LOUVRE MARK		LOCATION		LOUVRE MARK		LOCATION		LOUVRE MARK		LOCATION		LOUVRE MARK		LOCATION									
MATERIAL		TOWER 1A FLAT B M.B.R. TOWER 2A FLAT A M.B.R.		MATERIAL		TOWER 1A FLAT C M.B.R. TOWER 2A FLAT B M.B.R.		MATERIAL		TOWER 1 FLAT D – OPEN KITCHEN		MATERIAL		DOG HOUSE AT 1/F									
REMARK		PVF2 3 COATED ALUMINIUM LOUVRES AND FRAME		REMARK		PVF2 3 COATED ALUMINIUM LOUVRES AND FRAME		REMARK		PVF2 3 COATED ALUMINIUM LOUVRES AND FRAME		REMARK		PVF2 3 COATED ALUMINIUM LOUVRES AND FRAME									
		1. ALL STEEL WORKS SHOULD BE HOP DIP GALVANIZED AND COMPLIED WITH PAINT FINISH COLOR TO BE APPROVED BY ARCHITECT				1. ALL STEEL WORKS SHOULD BE HOP DIP GALVANIZED AND COMPLIED WITH PAINT FINISH COLOR TO BE APPROVED BY ARCHITECT				1. ALL STEEL WORKS SHOULD BE HOP DIP GALVANIZED AND COMPLIED WITH PAINT FINISH COLOR TO BE APPROVED BY ARCHITECT				1. ALL STEEL WORKS SHOULD BE HOP DIP GALVANIZED AND COMPLIED WITH PAINT FINISH COLOR TO BE APPROVED BY ARCHITECT									
		2. (50% FREE AREA)				2. (50% FREE AREA)				2. (50% FREE AREA)				2. (50% FREE AREA)									
		3. LOUVRE TO BE INSTALLED ON IN-SITU WALL UNLESS OTHERWISE STATED				3. LOUVRE TO BE INSTALLED ON IN-SITU WALL UNLESS OTHERWISE STATED				3. LOUVRE TO BE INSTALLED ON IN-SITU WALL UNLESS OTHERWISE STATED				3. LOUVRE TO BE INSTALLED ON IN-SITU WALL UNLESS OTHERWISE STATED									
		4. WITH WIRE MESH				4. WITH WIRE MESH				4. WITH WIRE MESH				4. WITH WIRE MESH									
		5. 4/F, 13/F, 14/F AND 24/F OMITTED				5. 4/F, 13/F, 14/F AND 24/F OMITTED				5. 4/F, 13/F, 14/F AND 24/F OMITTED				5. 4/F, 13/F, 14/F AND 24/F OMITTED									

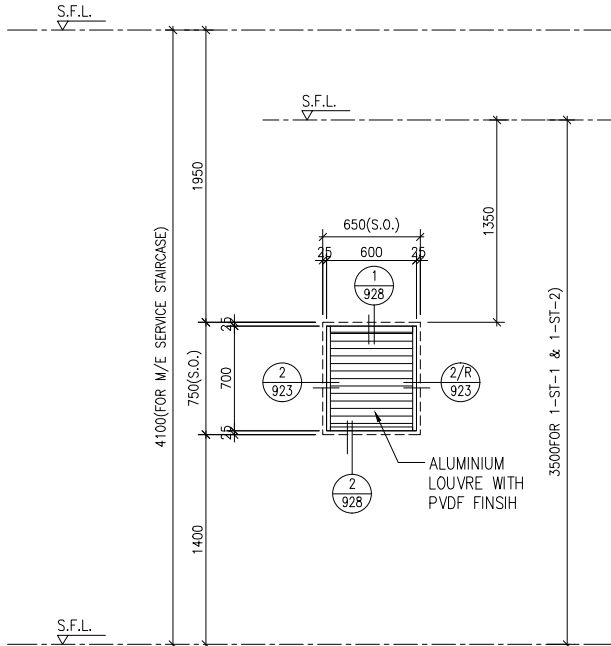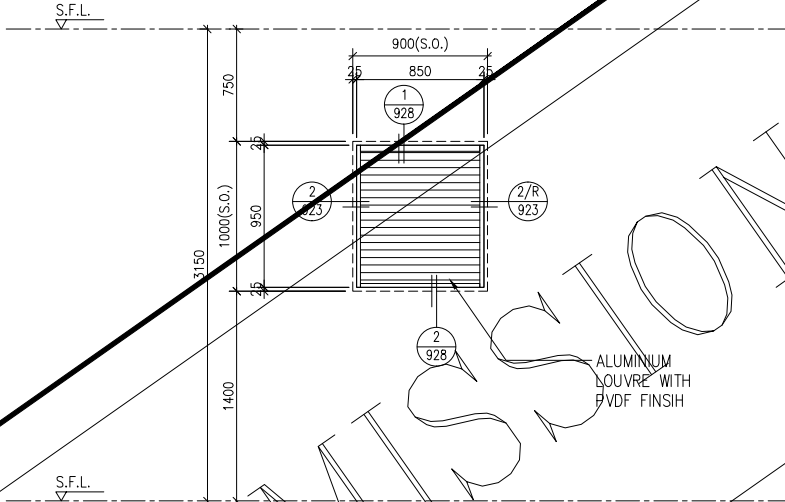							
LOUVRE MARK	 3 nos.  3 nos.	LOCATION	1-ST-1, 1-ST-2 & ME/SERVICE STAIRCASE AT ROOF PLAN	LOUVRE MARK	 2 nos.  2 nos.	LOCATION	LIFT MACHINE ROOM AT LIFT MACHINE PLAN (IN-SITU WALL)
MATERIAL	PVF2 3 COATED ALUMINIUM LOUVRES AND FRAME			MATERIAL	PVF2 3 COATED ALUMINIUM LOUVRES AND FRAME		
REMARK	1. ALL STEEL WORKS SHOULD BE HOP DIP GALVANIZED AND COMPLIED WITH PAINT FINISH COLOR TO BE APPROVED BY ARCHITECT			REMARK	1. ALL STEEL WORKS SHOULD BE HOP DIP GALVANIZED AND COMPLIED WITH PAINT FINISH COLOR TO BE APPROVED BY ARCHITECT		
	2. (50% FREE AREA)				2. (50% FREE AREA)		
	3. LOUVRE TO BE INSTALLED ON IN-SITU WALL UNLESS OTHERWISE STATED				3. LOUVRE TO BE INSTALLED ON IN-SITU WALL UNLESS OTHERWISE STATED		
	4. WITH WIRE MESH				4. WITH WIRE MESH		

A	13.02.2020	GENERAL REVISION	
NO.	DATE	REVISED	BY

CLIENT :
佳明集團控股有限公司
GRAND MING GROUP HOLDINGS LIMITED

MAIN CONTRACTOR :
GRAND TECH CONSTRUCTION CO. LTD.

ARCHITECT :
WONG TUNG & PARTNERS LIMITED
ARCHITECTS & PLANNERS


STRUCTURAL ENGINEER :
 C M WONG & ASSOCIATES LTD

 美特鋁質有限公司
MIDI ALUMINIUM FABRICATOR LTD.
Units 6-8, Sunray Industrial Centre, 1/F
610 Cha Kwo Ling Road, Kowloon
Tel:23489211-4 Fax:(852)27727666

PROJECT :
RESIDENTIAL DEVELOPMENT AT
TSING YI TOWN LOT 190 SAI SHAN ROAD



TITLE :
LOUVRE SCHEDULE
OF TOWER 1/ TOWER1A
AND TOWER 2/ TOWER2A



JOB NO. : J-851

DRAWN BY : DATE : 2-12-2019

CHKD BY : SCALE A1: A3: 1:50

DWG. NO. : J851-IW-139 REV. : A

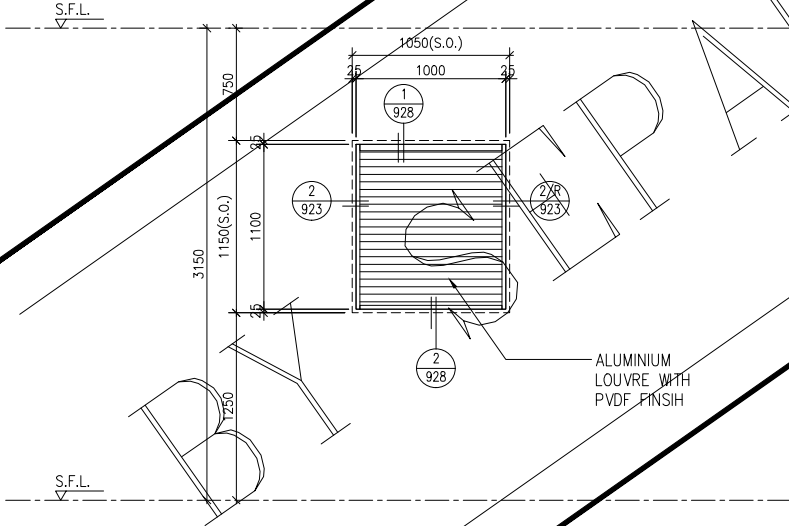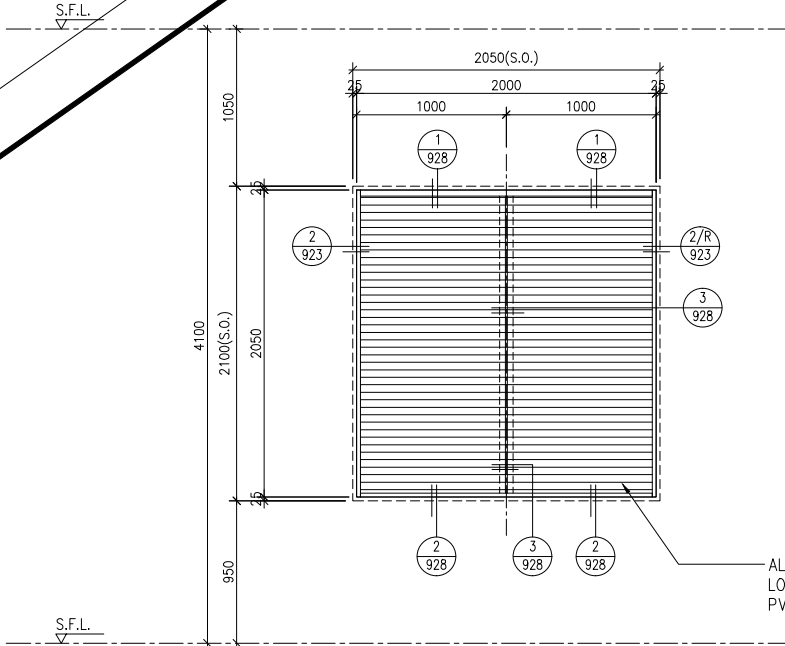							
LOUVRE MARK	 1 no.  1 no.	LOCATION	REFUSE CHUTE AT LIFT MACHINE PLAN (IN-SITU WALL)	LOUVRE MARK	 1 no.  1 no.	LOCATION	EMERGENCY GENERATOR ROOM AT PUMP ROOM PLAN (IN-SITU WALL)
MATERIAL	PVF2 3 COATED ALUMINIUM LOUVRES AND FRAME			MATERIAL	PVF2 3 COATED ALUMINIUM LOUVRES AND FRAME		
REMARK	1. ALL STEEL WORKS SHOULD BE HOP DIP GALVANIZED AND COMPLIED WITH PAINT FINISH COLOR TO BE APPROVED BY ARCHITECT			REMARK	1. ALL STEEL WORKS SHOULD BE HOP DIP GALVANIZED AND COMPLIED WITH PAINT FINISH COLOR TO BE APPROVED BY ARCHITECT		
	2. (50% FREE AREA)				2. (50% FREE AREA)		
	3. LOUVRE TO BE INSTALLED ON IN-SITU WALL UNLESS OTHERWISE STATED				3. LOUVRE TO BE INSTALLED ON IN-SITU WALL UNLESS OTHERWISE STATED		
	4. WITH WIRE MESH				4. WITH WIRE MESH		

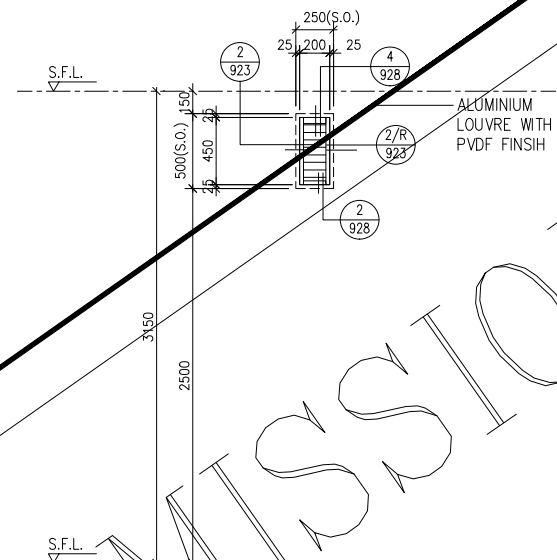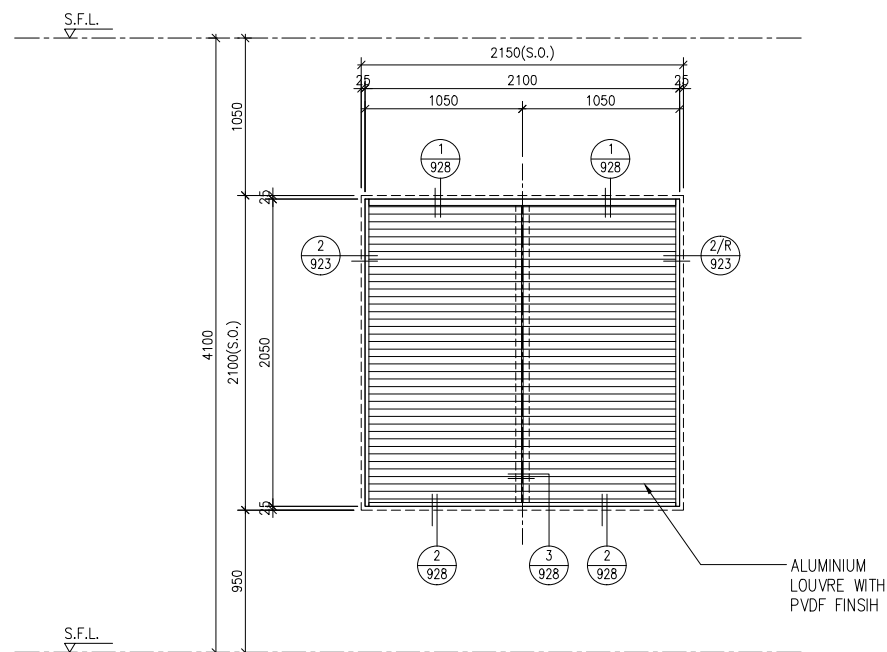





LOUVRE MARK	 1 no.  1 no.	LOCATION	EMERGENCY GENERATOR ROOM AT PUMP ROOM PLAN (IN-SITU WALL)
MATERIAL	PVF2 3 COATED ALUMINIUM LOUVRES AND FRAME		
REMARK	1. ALL STEEL WORKS SHOULD BE HOP DIP GALVANIZED AND COMPLIED WITH PAINT FINISH COLOR TO BE APPROVED BY ARCHITECT 2. (50% FREE AREA) 3. LOUVRE TO BE INSTALLED ON IN-SITU WALL UNLESS OTHERWISE STATED 4. WITH WIRE MESH		

LOUVRE MARK	 28 nos.	LOCATION	TOWER 2 FLAT D — OPEN KITCHEN
MATERIAL	PVC 3 COATED ALUMINIUM LOUVRES AND FRAME		
REMARK	1. ALL STEEL WORKS SHOULD BE HOT DIP GALVANIZED AND COMPLIED WITH PAINT FINISH COLOR TO BE APPROVED BY ARCHITECT 2. (50% FREE AREA) 3. LOUVRE TO BE INSTALLED ON IN SITU WALL UNLESS OTHERWISE STATED 4. WITH WIRE MESH		
	5. 4/F, 13/F, 14/F AND 24/F OMITTED		


LOUVRE MARK		LOCATION	
MATERIAL			
REMARK			

LOUVRE MARK		LOCATION	
MATERIAL			
REMARK			


B.D. REF :																															
F.S.D. REF :																															
<u>Note :</u> 1.All dimensions are in mm. 2.All elevations are viewed from outside. 3.All dimensions to be verified on site before fabrication.																															
GENERAL NOTES																															
<u>Legend :</u> 1. F.F.L.-- Finished Floor Level 2. S.F.L.-- Structural Floor Level 3. (R) -- Reversed Detail																															
X1 X001		DETAIL MARK NO. REFER SHEET NO.																													
<table><tr><td></td><td></td><td></td><td></td></tr><tr><td></td><td></td><td></td><td></td></tr><tr><td></td><td></td><td></td><td></td></tr><tr><td></td><td></td><td></td><td></td></tr><tr><td></td><td></td><td></td><td></td></tr><tr><td>A</td><td>13.02.2020</td><td>GENERAL REVISION</td><td></td></tr><tr><td>NO.</td><td>DATE</td><td>REVISED</td><td>BY</td></tr></table>																								A	13.02.2020	GENERAL REVISION		NO.	DATE	REVISED	BY
A	13.02.2020	GENERAL REVISION																													
NO.	DATE	REVISED	BY																												
CLIENT : 佳明集團控股有限公司 GRAND MING GROUP HOLDINGS LIMITED																															
MAIN CONTRACTOR : GRAND TECH CONSTRUCTION CO. LTD.																															
ARCHITECT : WONG TUNG & PARTNERS LIMITED ARCHITECTS & PLANNERS 																															
STRUCTURAL ENGINEER :  C M WONG & ASSOCIATES LTD																															
 美特鋁質有限公司 MIDI ALUMINIUM FABRICATOR LTD. Units 6-8, Sunray Industrial Centre, 1/F 610 Cha Kwo Ling Road, Kowloon Tel:23489211-4 Fax:(852)27727666																															
PROJECT : RESIDENTIAL DEVELOPMENT AT TSING YI TOWN LOT 190 SAI SHAN ROAD																															
TITLE : LOUVRE SCHEDULE OF TOWER 1/ TOWER1A AND TOWER 2/ TOWER2A																															
JOB NO. : J-851																															
DRAWN BY :		DATE : 2-12-2019																													
CHKD BY :		SCALE A1: A3: 1:50																													
DWG. NO. : J851-IW-140			REV. : A																												

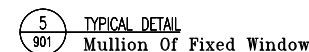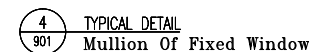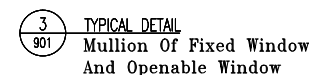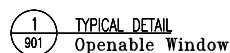


REV. :	C
--------	---

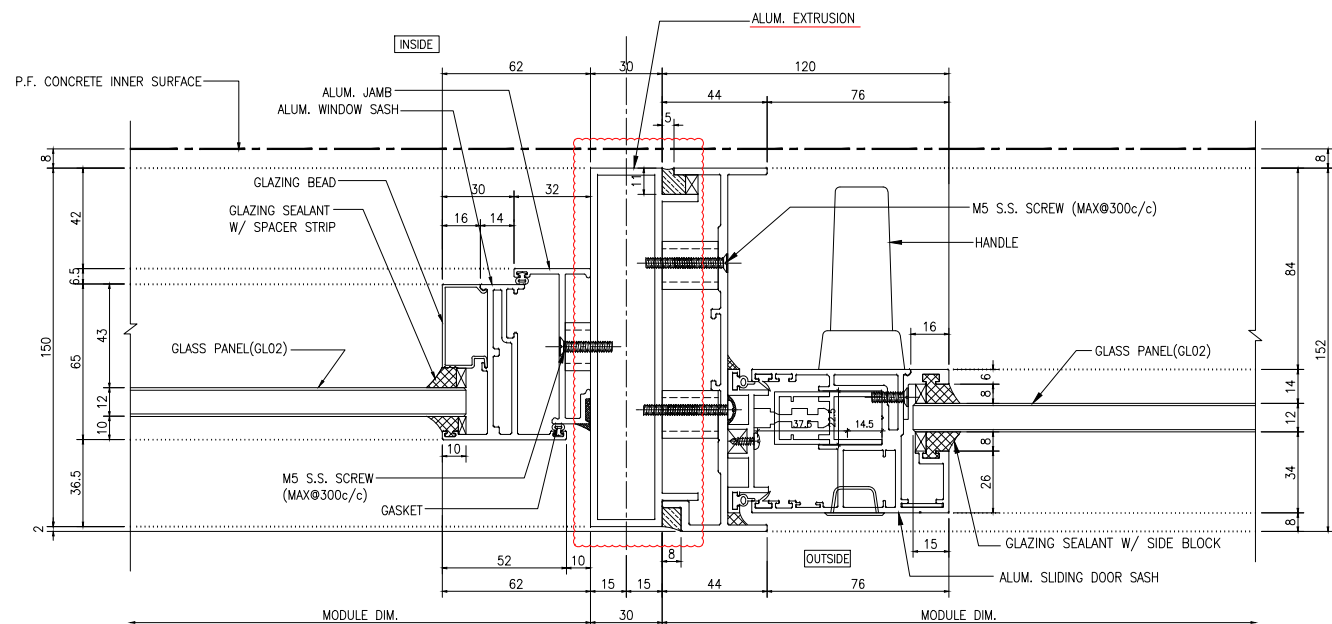


1 TYPICAL DETAIL
902 FOR ALUM. SLIDING DOOR

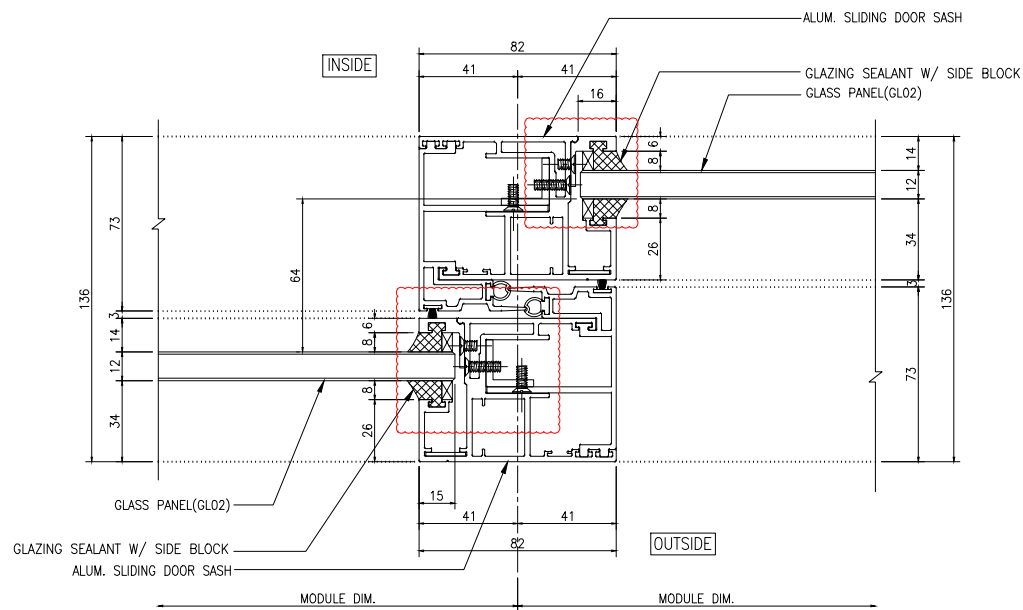


3 TYPICAL DETAIL
902 FOR ALUM. SLIDING DOOR

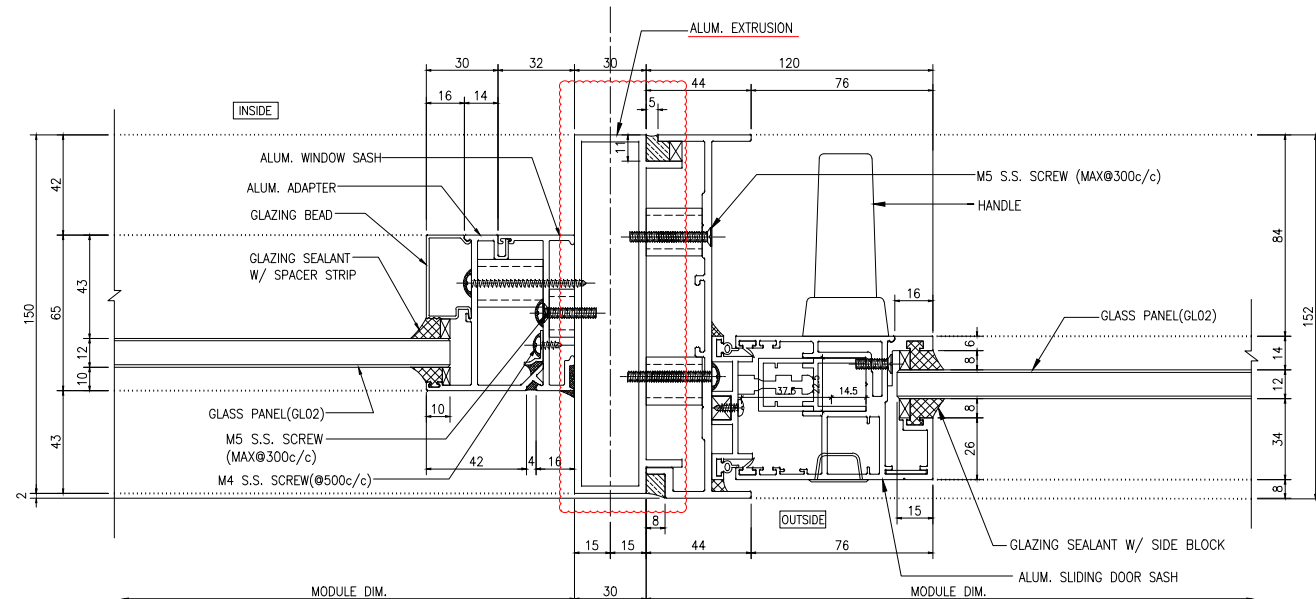

2 TYPICAL DETAIL
902 FOR ALUM. SLIDING DOOR
AND FIXED WINDOW

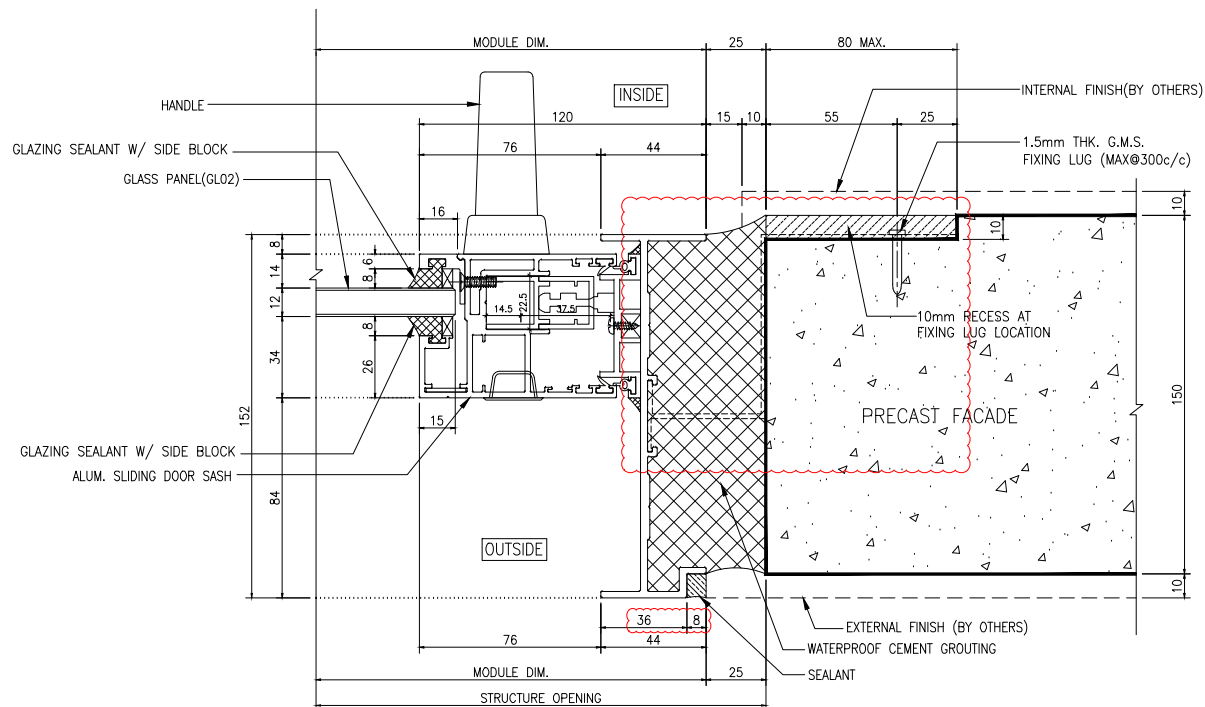


4 TYPICAL DETAIL
902 FOR ALUM. SLIDING DOOR

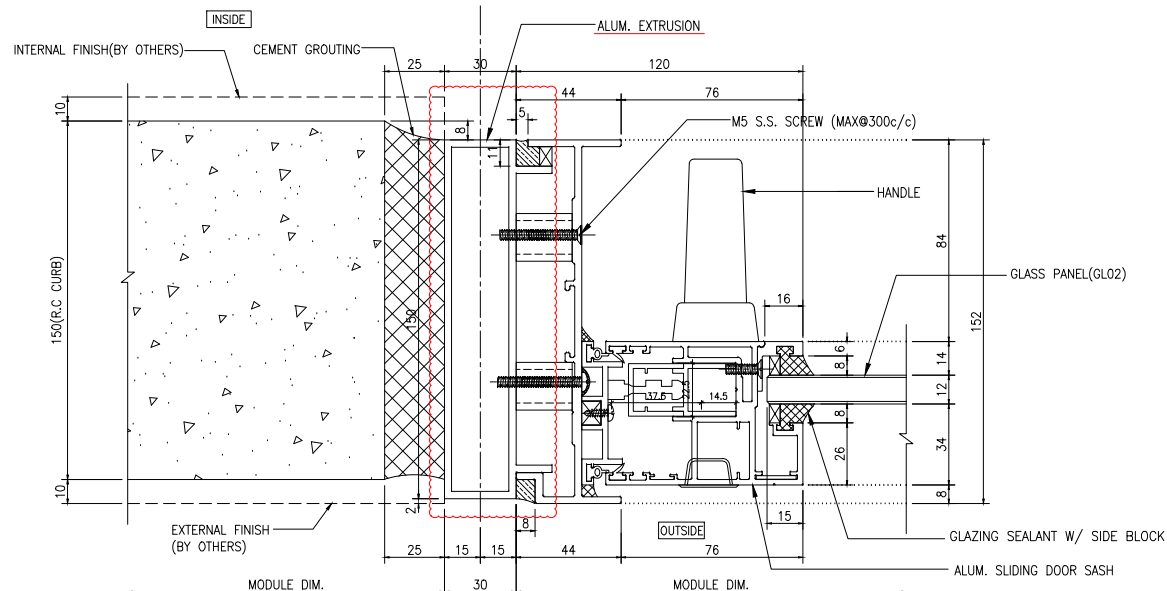


5 TYPICAL DETAIL
902 FOR ALUM. SLIDING DOOR


B.D. REF :																			
F.S.D. REF :																			
Note : 1. All dimensions are in mm. 2. All elevations are viewed from outside. 3. All dimensions to be verified on site before fabrication.																			
GENERAL NOTES																			
Legend : 1. F.F.L. --- Finished Floor Level 2. S.F.L. --- Structural Floor Level 3. (R) --- Reversed Detail																			
X1 --- DETAIL MARK NO. X001 --- REFER SHEET NO.																			
GL02 --- GREY BLUE MONOLITHIC GLASS (12mm) w/ DRAB GREY WINDOW FRAME IN PVF2 FINISH																			
<table border="1"> <thead> <tr> <th>NO.</th><th>DATE</th><th>REVISED</th><th>BY</th></tr> </thead> <tbody> <tr> <td>C</td><td>20.03.2020</td><td>GENERAL REVISION</td><td></td></tr> <tr> <td>B</td><td>05.03.2020</td><td>GENERAL REVISION</td><td></td></tr> <tr> <td>A</td><td>13.02.2020</td><td>GENERAL REVISION</td><td></td></tr> </tbody> </table>				NO.	DATE	REVISED	BY	C	20.03.2020	GENERAL REVISION		B	05.03.2020	GENERAL REVISION		A	13.02.2020	GENERAL REVISION	
NO.	DATE	REVISED	BY																
C	20.03.2020	GENERAL REVISION																	
B	05.03.2020	GENERAL REVISION																	
A	13.02.2020	GENERAL REVISION																	
CLIENT :																			
佳明集團控股有限公司 GRAND MING GROUP HOLDINGS LIMITED																			
MAIN CONTRACTOR :																			
GRAND TECH CONSTRUCTION CO. LTD.																			
ARCHITECT :																			
WONG TUNG & PARTNERS LIMITED ARCHITECTS & PLANNERS 																			
STRUCTURAL ENGINEER :																			
 C M WONG & ASSOCIATES LTD																			
美特鋁質有限公司 MIDI ALUMINIUM FABRICATOR LTD. Units 6-8, Sunray Industrial Centre, 1/F 610 Cha Kwo Ling Road, Kowloon Tel: 23489211-4 Fax: (852) 2727666																			
PROJECT :																			
RESIDENTIAL DEVELOPMENT AT TSING YI TOWN LOT 190 SAI SHAN ROAD																			
TITLE :																			
TYPICAL DETAIL FOR ALUM. SLIDING DOOR																			
JOB NO. : J-851																			
DRAWN BY :	DATE : 2-12-2019																		
CHKD BY :	SCALE A1: A3: 1:3																		
DWG. NO. : J851-IW-902	REV. : C																		

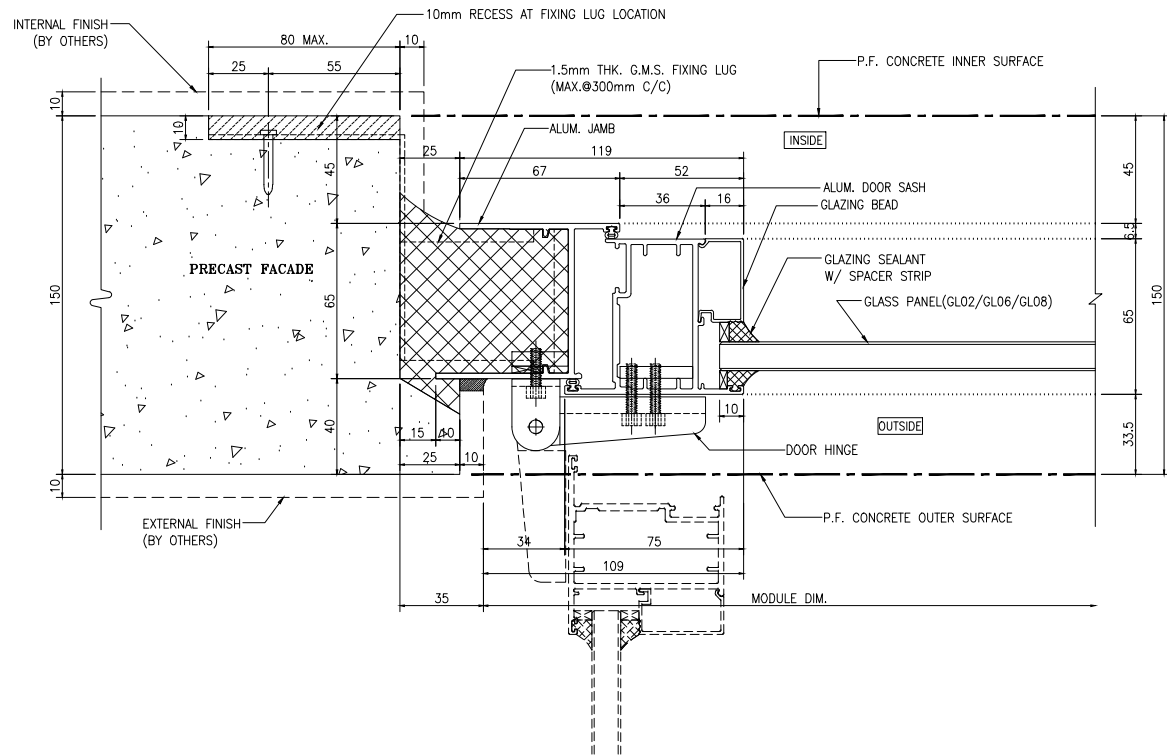


1
903 TYPICAL DETAIL FOR F.D. DOOR

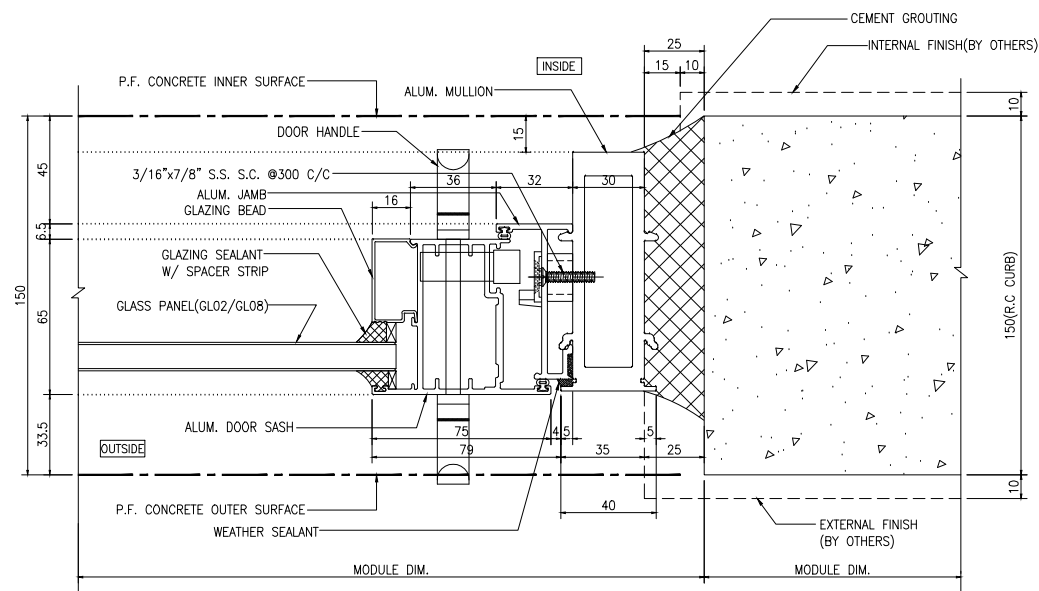

3
903 TYPICAL DETAIL FOR F.D. DOOR

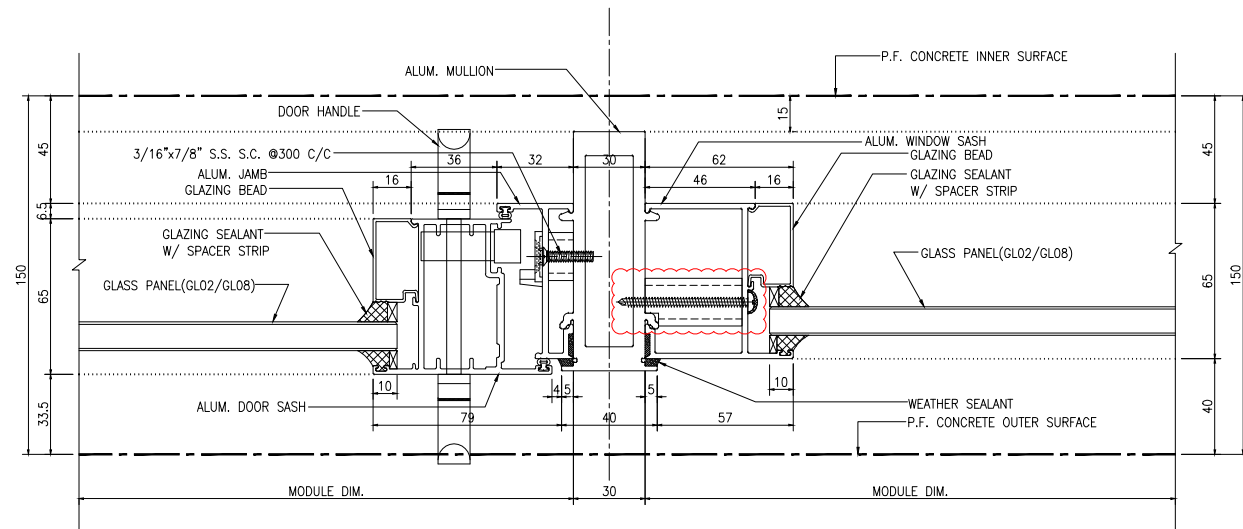


2
903 TYPICAL DETAIL FOR F.D. DOOR
Mullion Of Fixed Window
And F.D. Door

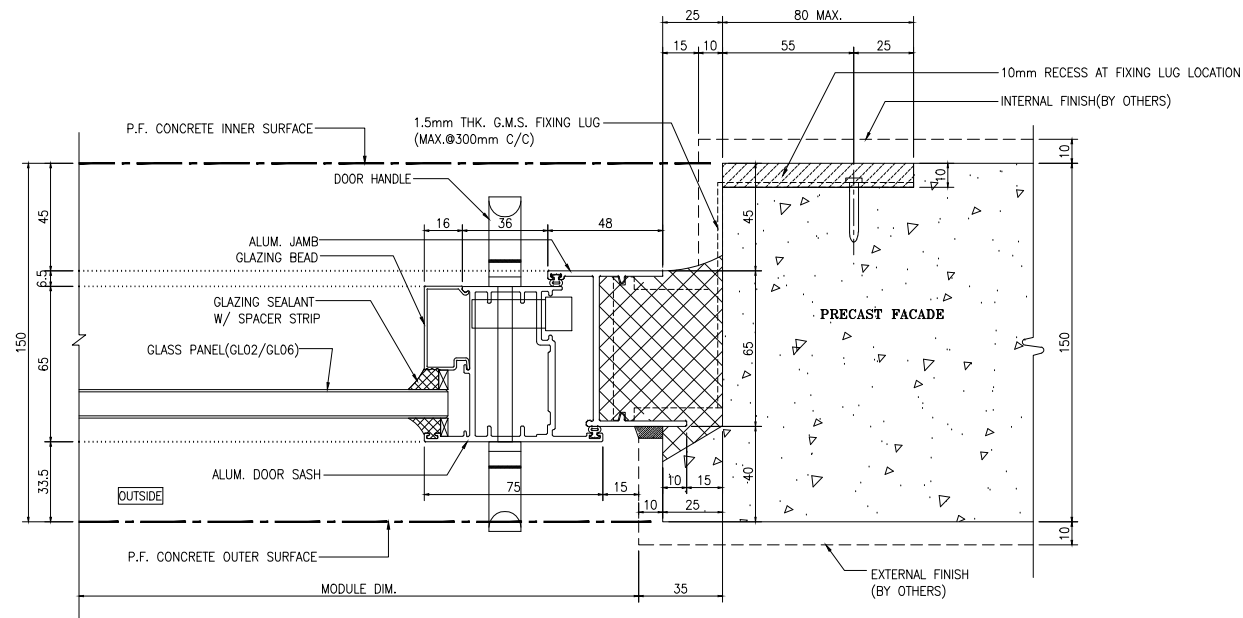


4
903 TYPICAL DETAIL FOR F.D. DOOR


B.D. REF :			
F.S.D. REF :			
Note : 1.All dimensions are in mm. 2.All elevations are viewed from outside. 3.All dimensions to be verified on site before fabrication.			
GENERAL NOTES			
Legend : 1. F.F.L.-- Finished Floor Level 2. S.F.L.-- Structural Floor Level 3. (R) --- Reversed Detail			
		DETAIL MARK NO. REFER SHEET NO.	
GL02 --- GREY BLUE MONOLITHIC GLASS (12mm) w/ DRAK GREY WINDOW FRAME IN PVF2 FINISH			
GL06 --- GREY BLUE MONOLITHIC GLASS (12mm) w/ FROSTED TEXTURE AT INNER SURFACE			
GL08 --- CLEAR GLASS (12mm) w/ FROSTED TEXTURE AT INNER SURFACE			
C	20.03.2020	GENERAL REVISION	
B	05.03.2020	GENERAL REVISION	
A	13.02.2020	GENERAL REVISION	
NO.	DATE	REVISED	BY
CLIENT :			
佳明集團控股有限公司 GRAND MING GROUP HOLDINGS LIMITED			
MAIN CONTRACTOR :			
GRAND TECH CONSTRUCTION CO.LTD.			
ARCHITECT :			
WONG TUNG & PARTNERS LIMITED ARCHITECTS & PLANNERS 			
STRUCTURAL ENGINEER :			
 C M WONG & ASSOCIATES LTD			
 美特鋁質有限公司 MIDI ALUMINIUM FABRICATOR LTD. Units 6-8, Sunray Industrial Centre, 1/F 610 Cha Kwo Ling Road, Kowloon Tel:23489211-4 Fax:(852)27727666			
PROJECT :			
RESIDENTIAL DEVELOPMENT AT TSING YI TOWN LOT 190 SAI SHAN ROAD			
TITLE :			
TYPICAL DETAIL FOR F.D. DOOR			
JOB NO. : J-851			
DRAWN BY :		DATE : 2-12-2019	
CHKD BY :		SCALE A1: A3: 1:3	
DWG. NO. : J851-IW-903			REV. : C

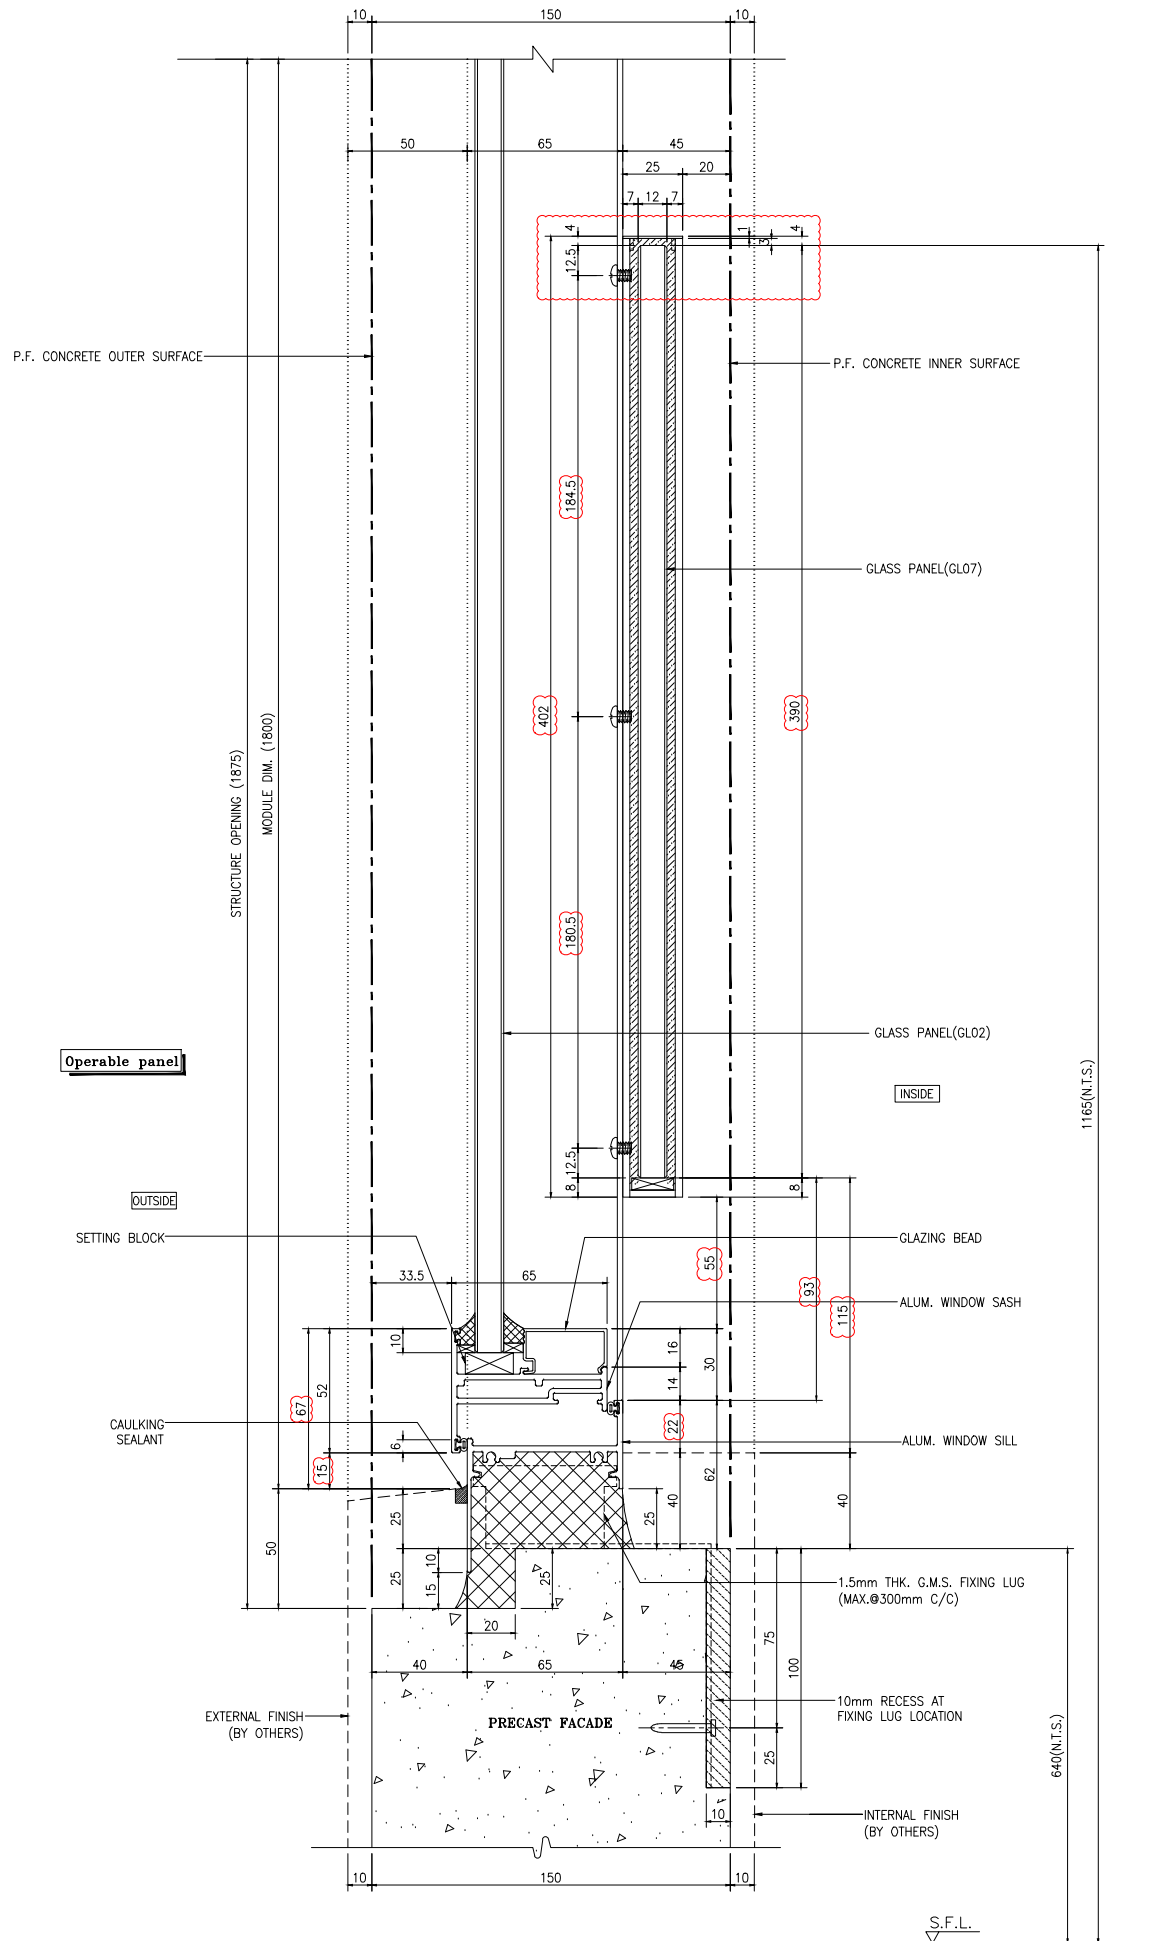

1
904 TYPICAL DETAIL
For Openable Window

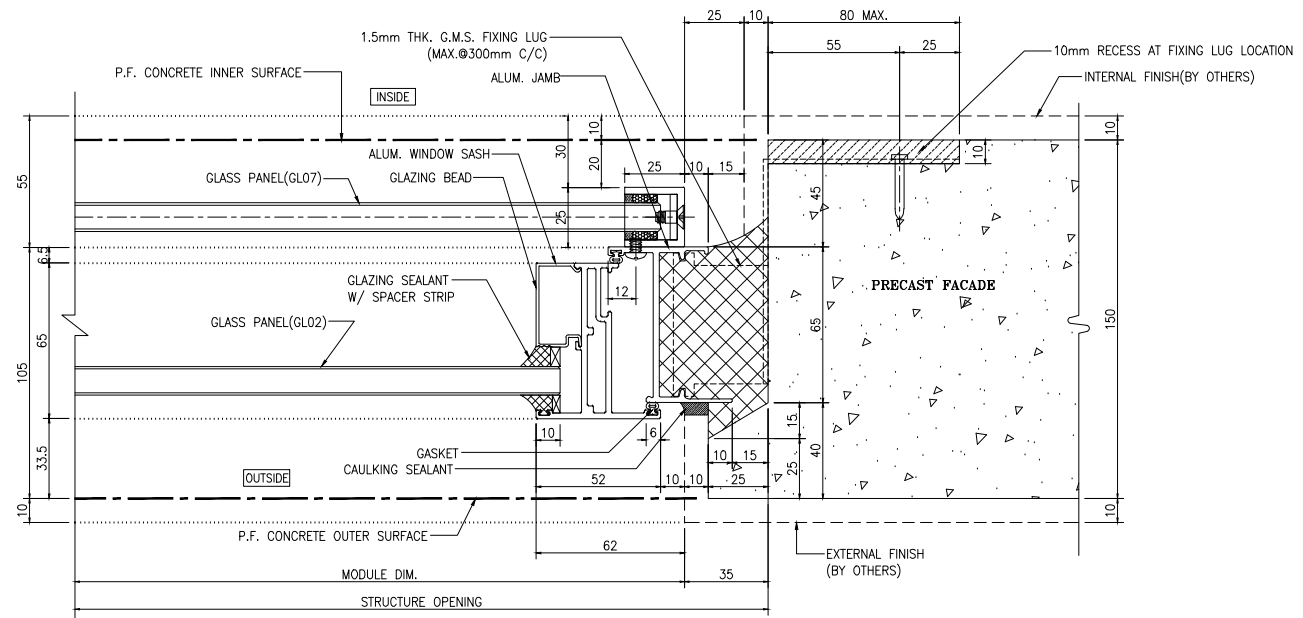


2
904 TYPICAL DETAIL
Openable Window

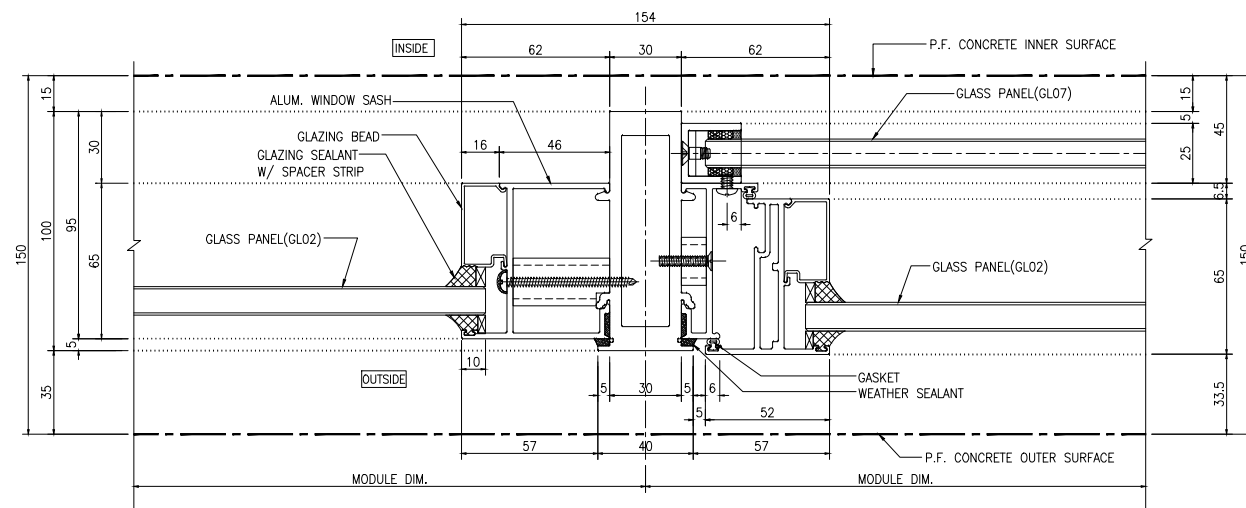


3
904 TYPICAL DETAIL
Mullion Of Openable Window
and Fixed Window


B.D. REF :			
F.S.D. REF :			
Note : 1.All dimensions are in mm. 2.All elevations are viewed from outside. 3.All dimensions to be verified on site before fabrication.			
GENERAL NOTES			
Legend : 1. F.F.L.-- Finished Floor Level 2. S.F.L.-- Structural Floor Level 3. (R) -- Reversed Detail			
X1 X001 DETAIL MARK NO. REFER SHEET NO.			
GL02 -- GREY BLUE MONOLITHIC GLASS (12mm) w/ DRAK GREY WINDOW FRAME IN PVF2 FINISH			
GL07 -- CLEAR SAFETY GLASS BARRIER (12mm)			
D	04.05.2020	GENERAL REVISION	
C	20.03.2020	GENERAL REVISION	
B	05.03.2020	GENERAL REVISION	
A	13.02.2020	GENERAL REVISION	
NO.	DATE	REVISED	BY
CLIENT : 佳明集團控股有限公司 GRAND MING GROUP HOLDINGS LIMITED			
MAIN CONTRACTOR : GRAND TECH CONSTRUCTION CO. LTD.			
ARCHITECT : WONG TUNG & PARTNERS LIMITED ARCHITECTS & PLANNERS 			
STRUCTURAL ENGINEER :  C M WONG & ASSOCIATES LTD			
 美特鋁質有限公司 MIDI ALUMINIUM FABRICATOR LTD. Units 6-8, Sunray Industrial Centre, 1/F 610 Cha Kwo Ling Road, Kowloon Tel:23489211-4 Fax:(852)27727666			
PROJECT : RESIDENTIAL DEVELOPMENT AT TSING YI TOWN LOT 190 SAI SHAN ROAD			
TITLE : TYPICAL DETAIL FOR ALUM. WINDOW			
JOB NO. : J-851			
DRAWN BY :		DATE : 2-12-2019	
CHKD BY :		SCALE A1: A3: 1:3	
DWG. NO. : J851-IW-904			REV. : D

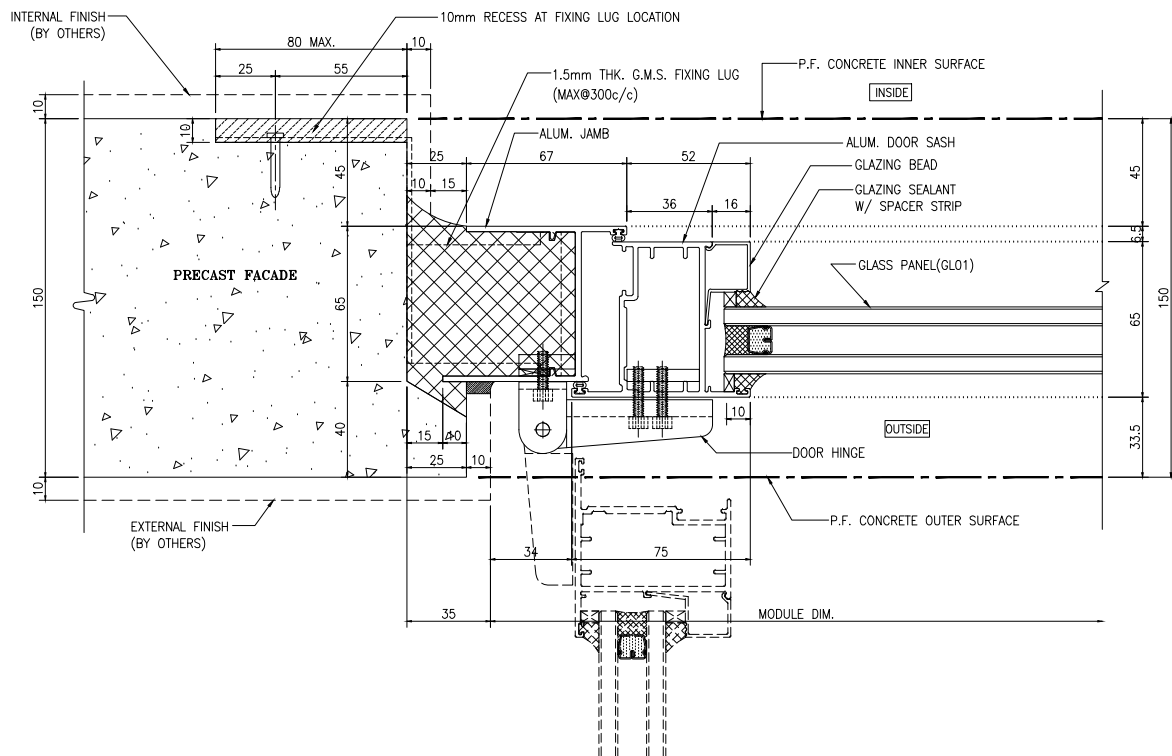

1 TYPICAL DETAIL FOR F.D. DOOR
905

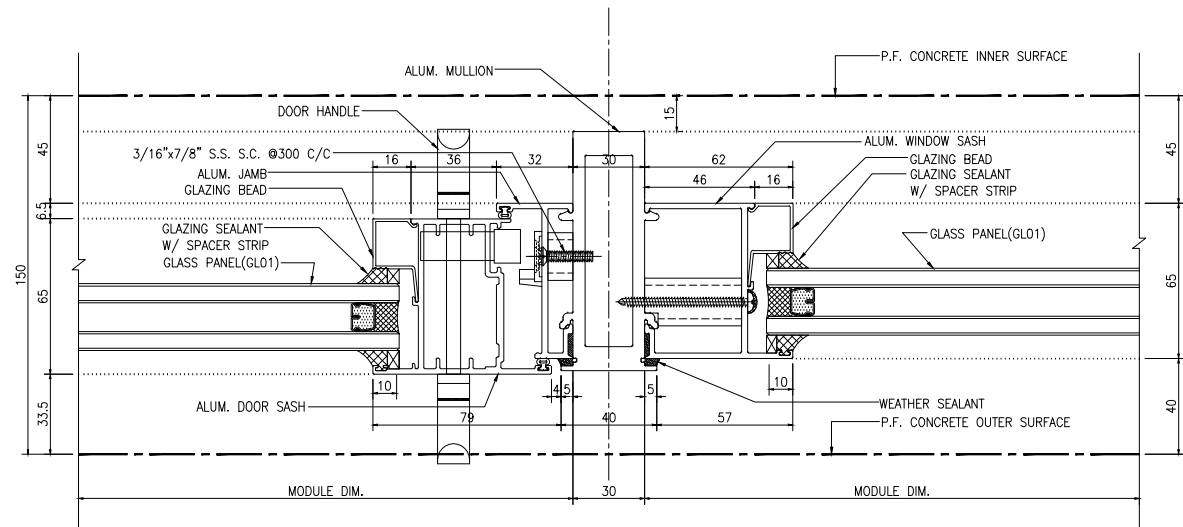

2 TYPICAL DETAIL FOR F.D. DOOR
905 Mullion Of Fixed Window And F.D. Door

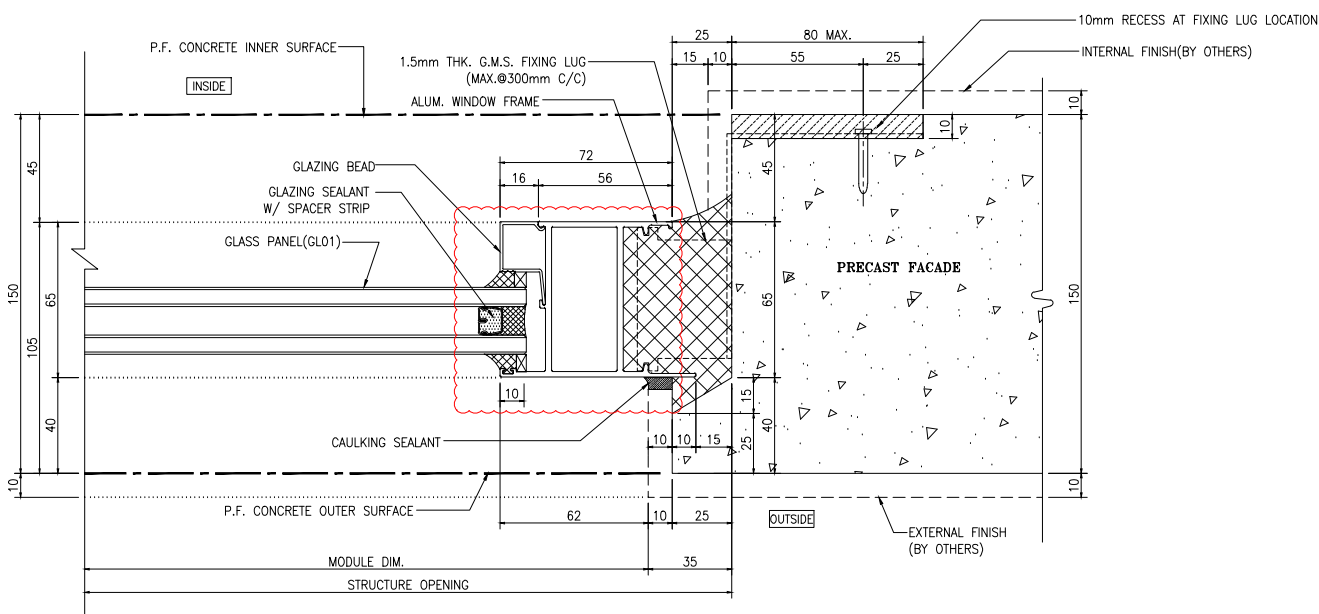

3 TYPICAL DETAIL
905 Fixed Window

B.D. REF :

F.S.D. REF :

Note :
1.All dimensions are in mm.
2.All elevations are viewed from outside.
3.All dimensions to be verified on site before fabrication.

GENERAL NOTES

Legend :
1. F.F.L.-- Finished Floor Level
2. S.F.L.-- Structural Floor Level
3. (R) -- Reversed Detail

X1 -- DETAIL MARK NO.
X001 -- REFER SHEET NO.

GL01 -- GREY BLUE IGU (8mm+12mm+8mm)

NO.	DATE	REVISED	BY
D	04.05.2020	GENERAL REVISION	
C	20.03.2020	GENERAL REVISION	
B	05.03.2020	GENERAL REVISION	
A	13.02.2020	GENERAL REVISION	

CLIENT :
佳明集團控股有限公司
GRAND MING GROUP HOLDINGS LIMITED

MAIN CONTRACTOR :
GRAND TECH CONSTRUCTION CO. LTD.

ARCHITECT :
WONG TUNG & PARTNERS LIMITED
ARCHITECTS & PLANNERS


STRUCTURAL ENGINEER :
C M WONG & ASSOCIATES LTD

美特鋁質有限公司
MIDI ALUMINIUM FABRICATOR LTD.
Units 6-8, Sunray Industrial Centre, 1/F
610 Cha Kwo Ling Road, Kowloon
Tel:23489211-4 Fax:(852)27727666


PROJECT :
RESIDENTIAL DEVELOPMENT AT
TSING YI TOWN LOT 190 SAI SHAN ROAD

TITLE :
TYPICAL DETAIL FOR
F.D. DOOR


JOB NO. : J-851
DRAWN BY : DATE : 2-12-2019
CHKD BY : SCALE A1: A3: 1:3
DWG. NO. : J851-IW-905 REV. : D

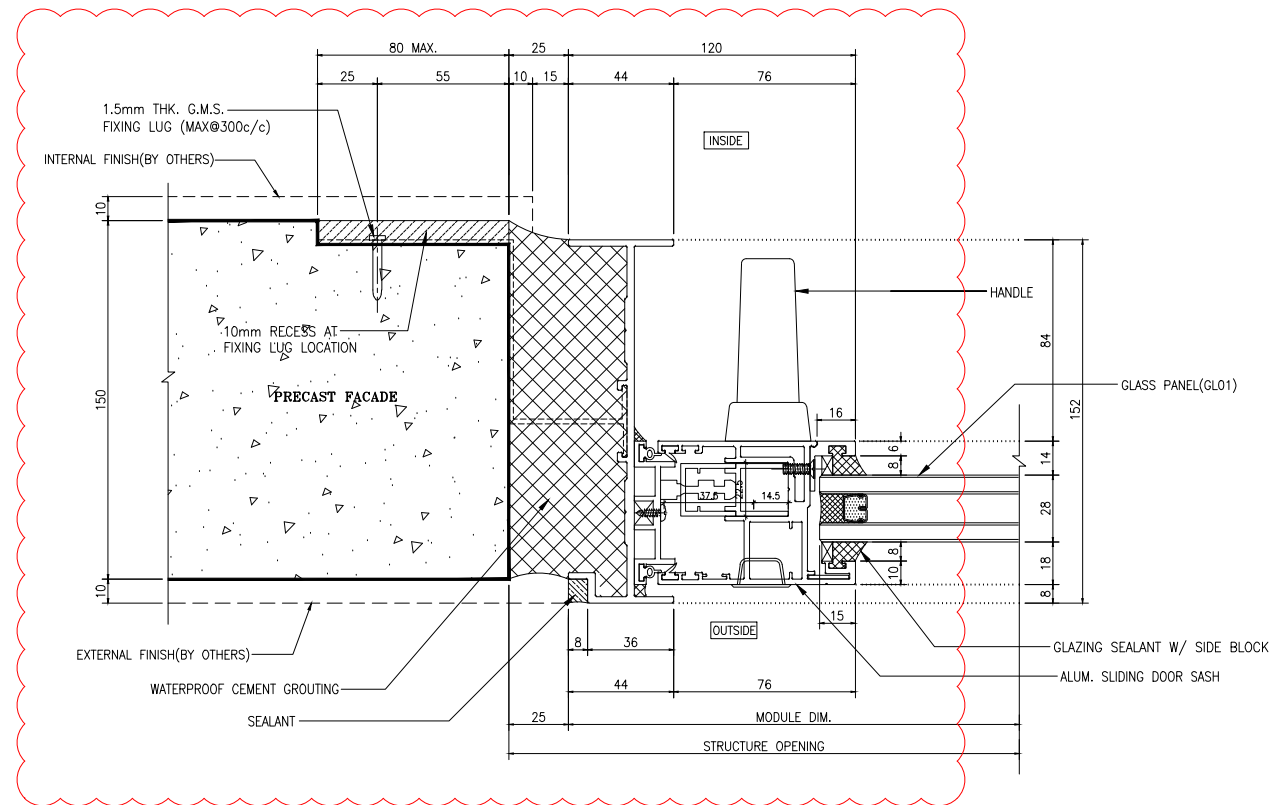

1 TYPICAL DETAIL
906 FOR ALUM. SLIDING DOOR


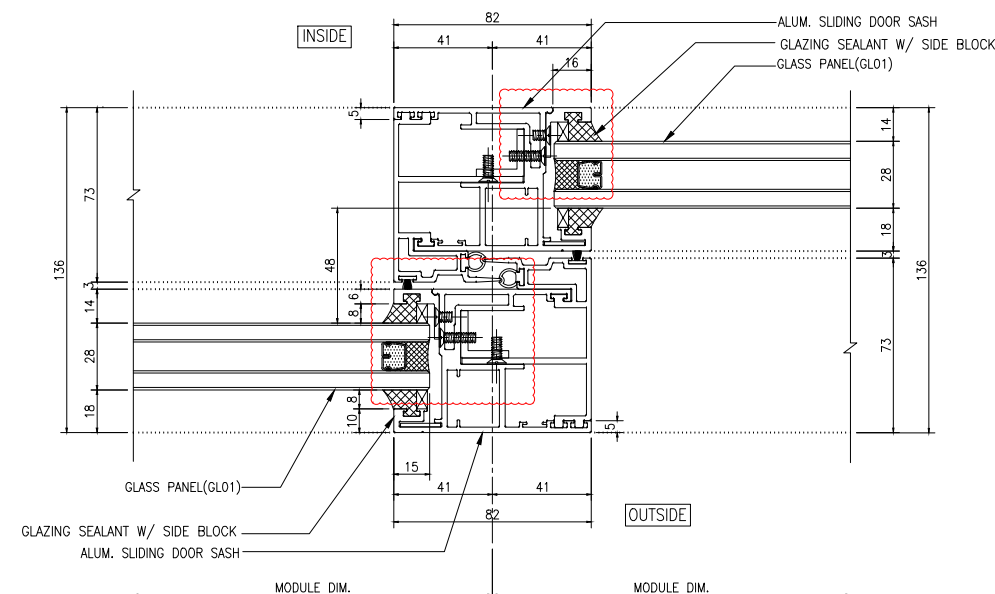


2 TYPICAL DETAIL
906 FOR ALUM. SLIDING DOOR





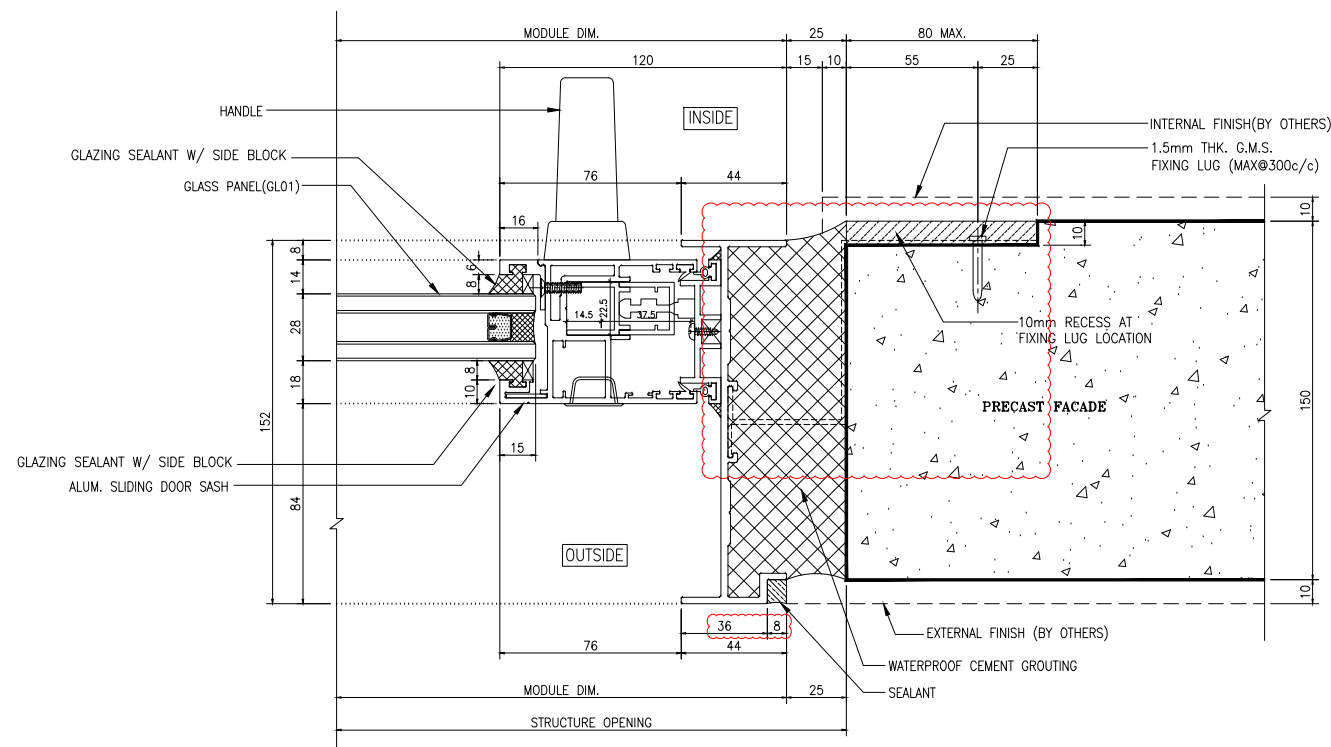


3 TYPICAL DETAIL
906 FOR ALUM. SLIDING DOOR


B.D. REF :			
F.S.D. REF :			
<u>Note :</u> 1.All dimensions are in mm. 2.All elevations are viewed from outside. 3.All dimensions to be verified on site before fabrication.			
GENERAL NOTES			
<u>Legend :</u> 1. F.F.L.-- Finished Floor Level 2. S.F.L.-- Structural Floor Level 3. (R) -- Reversed Detail			
X1 X001 DETAIL MARK NO. REFER SHEET NO.			
GL01 -- GREY BLUE IGU (8mm+12mm+8mm)			
C	20.03.2020	GENERAL REVISION	
B	05.03.2020	GENERAL REVISION	
A	13.02.2020	GENERAL REVISION	
NO.	DATE	REVISED	BY
CLIENT : 佳明集團控股有限公司 GRAND MING GROUP HOLDINGS LIMITED			
MAIN CONTRACTOR : GRAND TECH CONSTRUCTION CO. LTD.			
ARCHITECT : WONG TUNG & PARTNERS LIMITED ARCHITECTS & PLANNERS 			
STRUCTURAL ENGINEER :  C M WONG & ASSOCIATES LTD			
 美特鋁質有限公司 MIDI ALUMINIUM FABRICATOR LTD. Units 6-8, Sunray Industrial Centre, 1/F 610 Cha Kwo Ling Road, Kowloon Tel:23489211-4 Fax:(852)27727666			
PROJECT : RESIDENTIAL DEVELOPMENT AT TSING YI TOWN LOT 190 SAI SHAN ROAD			
TITLE : TYPICAL DETAIL FOR ALUM. SLIDING DOOR			
JOB NO. : J-851			
DRAWN BY :		DATE : 2-12-2019	
CHKD BY :		SCALE A1: A3: 1:3	
DWG. NO. : J851-IW-906			REV. : C

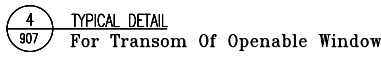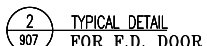



REV. : B

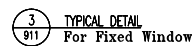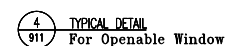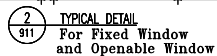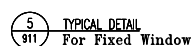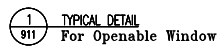



B.D. REF :			
F.S.D. REF :			
Note : 1.All dimensions are in mm. 2.All elevations are viewed from outside. 3.All dimensions to be verified on site before fabrication.			
GENERAL NOTES			
Legend : 1. F.F.L--- Finished Floor Level 2. S.F.L--- Structural Floor Level 3. (R) --- Reversed Detail			
X1 X001 DETAIL MARK NO. REFER SHEET NO.			
GL02 --- GREY BLUE MONOLITHIC GLASS (12mm) w/ DRAK GREY WINDOW FRAME IN PVF2 FINISH			
GL08 --- CLEAR GLASS (12mm) w/ FROSTED TEXTURE AT INNER SURFACE			
C	20.03.2020	GENERAL REVISION	
B	05.03.2020	GENERAL REVISION	
A	13.02.2020	GENERAL REVISION	
NO.	DATE	REVISED	BY
CLIENT : 佳明集團控股有限公司 GRAND MING GROUP HOLDINGS LIMITED			
MAIN CONTRACTOR : GRAND TECH CONSTRUCTION CO. LTD.			
ARCHITECT : WONG TUNG & PARTNERS LIMITED ARCHITECTS & PLANNERS 			
STRUCTURAL ENGINEER :  C M WONG & ASSOCIATES LTD			
 美特鋁質有限公司 MIDI ALUMINIUM FABRICATOR LTD. Units 6-8, Sunray Industrial Centre, 1/F 610 Cho Kwo Ling Road, Kowloon Tel:23489211-4 Fax:(652)27727666			
PROJECT : RESIDENTIAL DEVELOPMENT AT TSING YI TOWN LOT 190 SAI SHAN ROAD			
TITLE : TYPICAL DETAIL FOR ALUM. WINDOW			
JOB NO. : J-851			
DRAWN BY :		DATE : 2-12-2019	
CHKD BY :		SCALE A1: A3: 1:4	
DWG. NO. : J851-IW-911			REV. : C

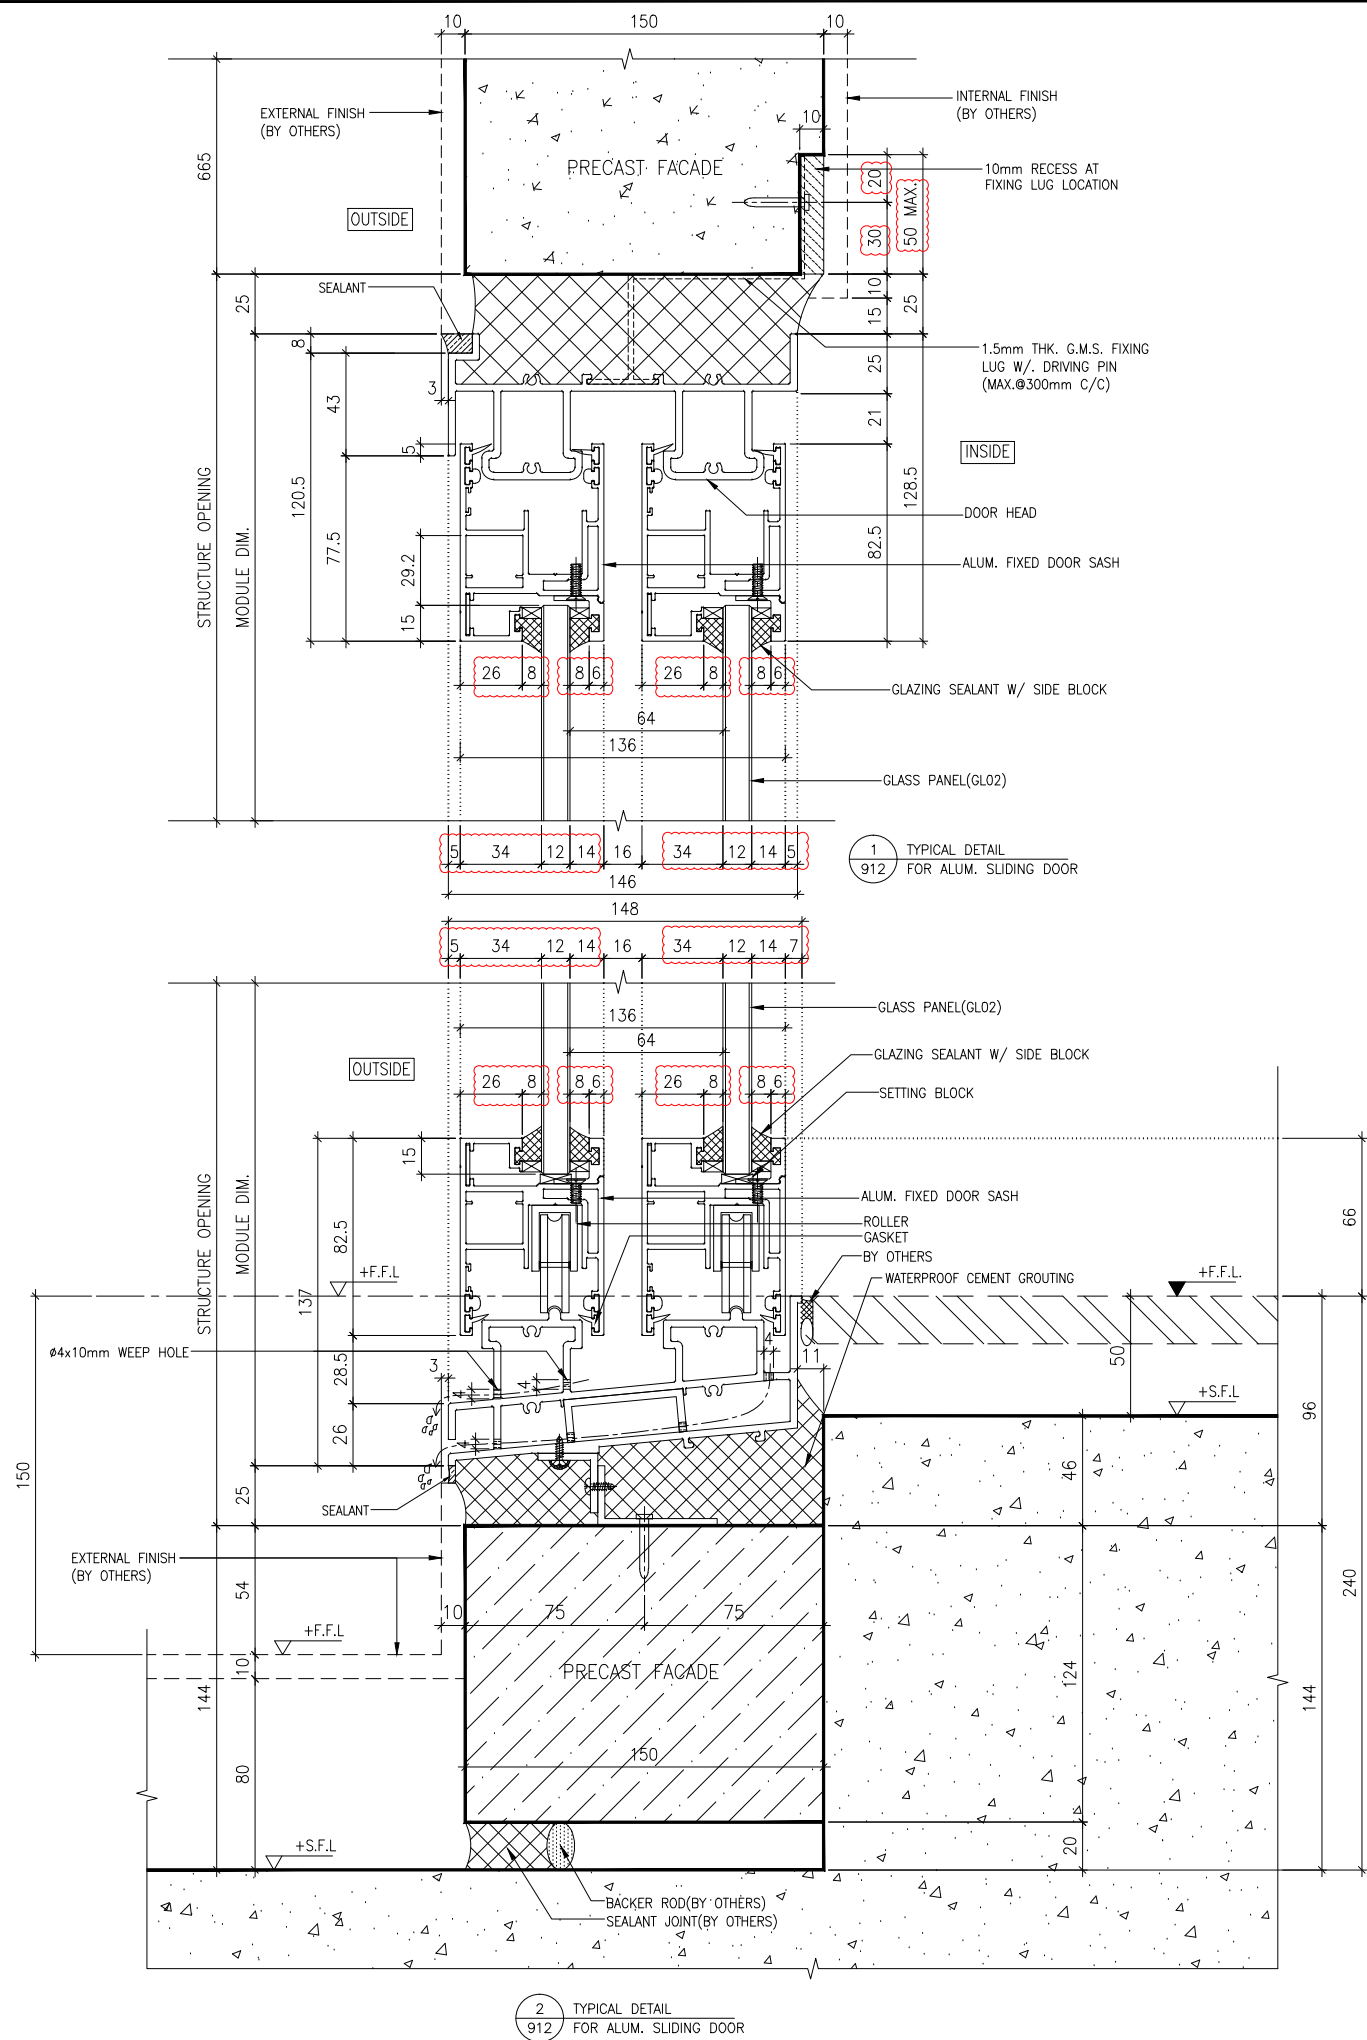


B.D. REF :			
F.S.D. REF :			
Note : 1.All dimensions are in mm. 2.All elevations are viewed from outside. 3.All dimensions to be verified on site before fabrication.			
GENERAL NOTES			
Legend : 1. F.F.L--- Finished Floor Level 2. S.F.L--- Structural Floor Level 3. (R) --- Reversed Detail			
X1 X001 DETAIL MARK NO. REFER SHEET NO.			
GL02 --- GREY BLUE MONOLITHIC GLASS (12mm) w/ DRAK GREY WINDOW FRAME IN PVF2 FINISH			
B	05.03.2020	GENERAL REVISION	
A	13.02.2020	GENERAL REVISION	
NO.	DATE	REVISED	BY
CLIENT :			
佳明集團控股有限公司 GRAND MING GROUP HOLDINGS LIMITED			
MAIN CONTRACTOR :			
GRAND TECH CONSTRUCTION CO. LTD.			
ARCHITECT :			
WONG TUNG & PARTNERS LIMITED ARCHITECTS & PLANNERS 			
STRUCTURAL ENGINEER :			
 C M WONG & ASSOCIATES LTD			
PROJECT :			
RESIDENTIAL DEVELOPMENT AT TSING YI TOWN LOT 190 SAI SHAN ROAD			
TITLE :			
TYPICAL DETAIL FOR ALUM. SLIDING DOOR			
JOB NO. : J-851			
DRAWN BY :		DATE : 2-12-2019	
CHKD BY :		SCALE A1: A3: 1:3	
DWG. NO. : J851-IW-912			REV. : B

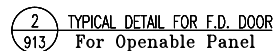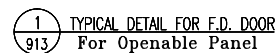

 
B.D. REF : _____			
F.S.D. REF : _____			
<u>Note :</u>			
1.All dimensions are in mm.			
2.All elevations are viewed from outside.			
3.All dimensions to be verified on site before fabrication.			
GENERAL NOTES			
<u>Legend :</u>			
1. F.F.L.-- Finished Floor Level			
2. S.F.L.-- Structural Floor Level			
3. (R) -- Reversed Detail			
 X1 ————— DETAIL MARK NO. X001 ————— REFER SHEET NO.			
GL02	--	GREY BLUE MONOLITHIC GLASS (12mm) w/ DRAK GREY WINDOW FRAME IN PVF2 FINISH	
GL06	--	GREY BLUE MONOLITHIC GLASS (12mm) w/ FROSTED TEXTURE AT INNER SURFACE	
GL08	--	CLEAR GLASS (12mm) w/ FROSTED TEXTURE AT INNER SURFACE	
C	20.03.2020	GENERAL REVISION	
B	05.03.2020	GENERAL REVISION	
A	13.02.2020	GENERAL REVISION	
NO.	DATE	REVISED	BY
CLIENT :			
佳明集團控股有限公司 GRAND MING GROUP HOLDINGS LIMITED			
MAIN CONTRACTOR :			
GRAND TECH CONSTRUCTION CO. LTD.			
ARCHITECT :			
WONG TUNG & PARTNERS LIMITED ARCHITECTS & PLANNERS 			
STRUCTURAL ENGINEER :			
 C M WONG & ASSOCIATES LTD			
 美特鋁質有限公司 MIDI ALUMINIUM FABRICATOR LTD. Units 6-8, Sunray Industrial Centre, 1/F 610 Cha Kwo Ling Road, Kowloon Tel:23489211-4 Fax:(852)27727666			
PROJECT :			
RESIDENTIAL DEVELOPMENT AT TSING YI TOWN LOT 190 SAI SHAN ROAD			
TITLE :			
TYPICAL DETAIL FOR F.D. DOOR			
JOB NO. :		J-851	
DRAWN BY :		DATE : 2-12-2019	
CHKD BY :		SCALE A1: A3: 1:3	
DWG. NO. : J851-IW-913			REV. : C

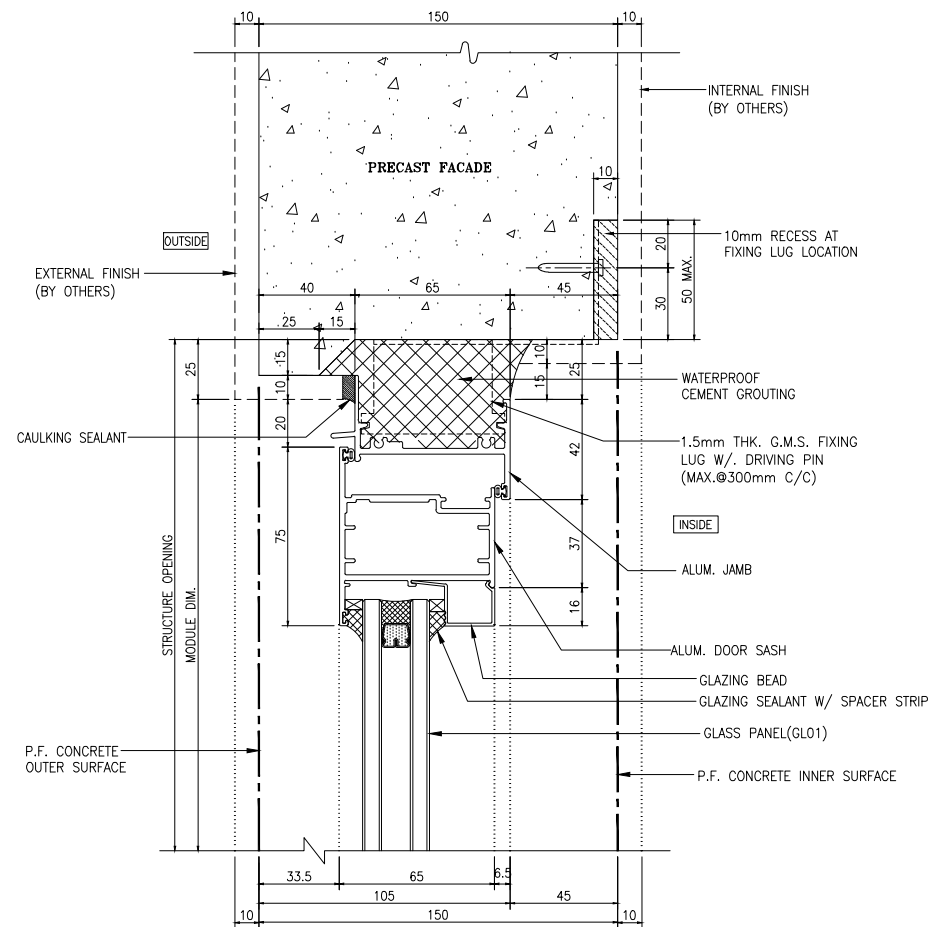


1 TYPICAL DETAIL FOR F.D. DOOR
915 For Openable Panel

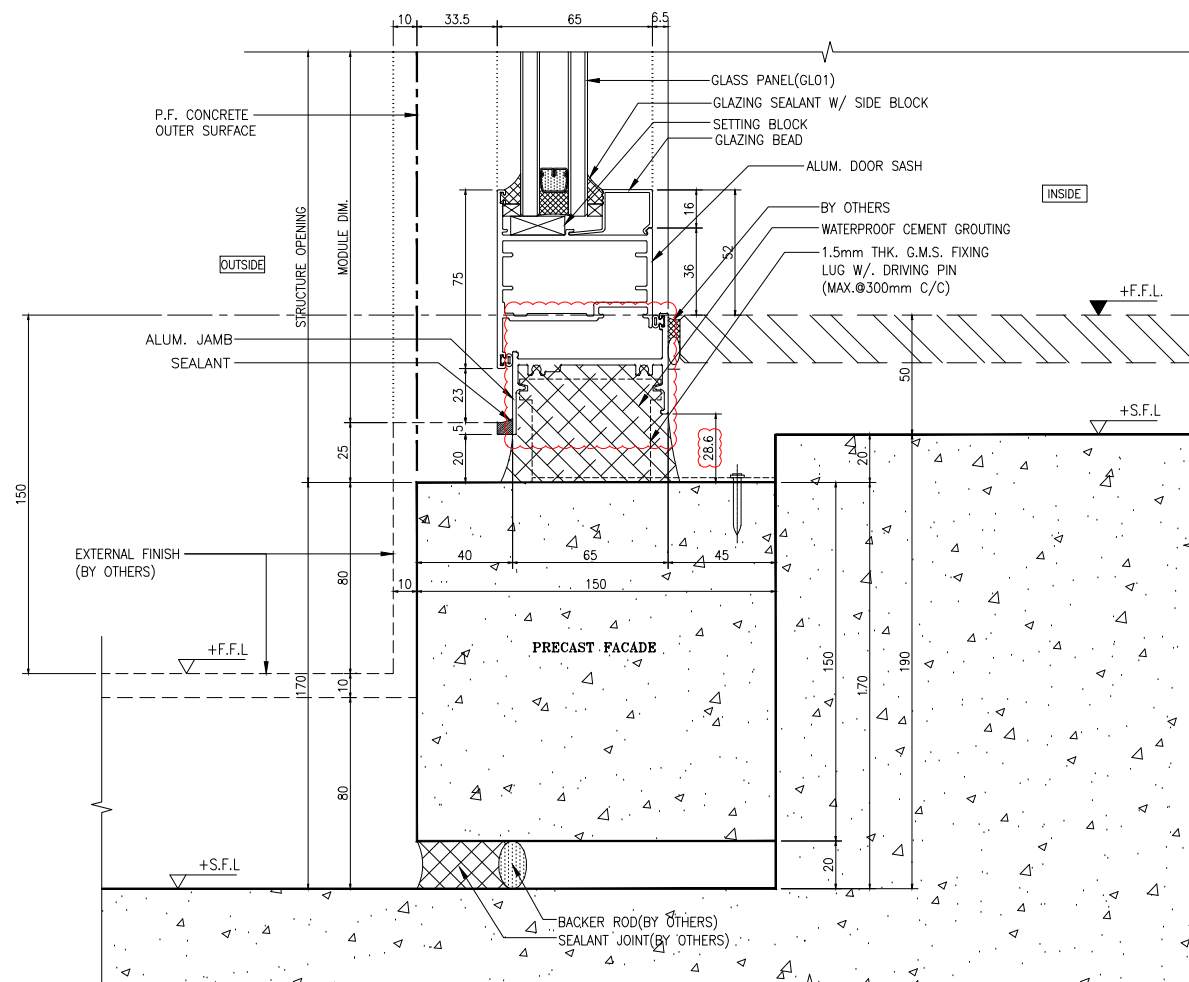

2 TYPICAL DETAIL FOR F.D. DOOR
915 For Openable Panel

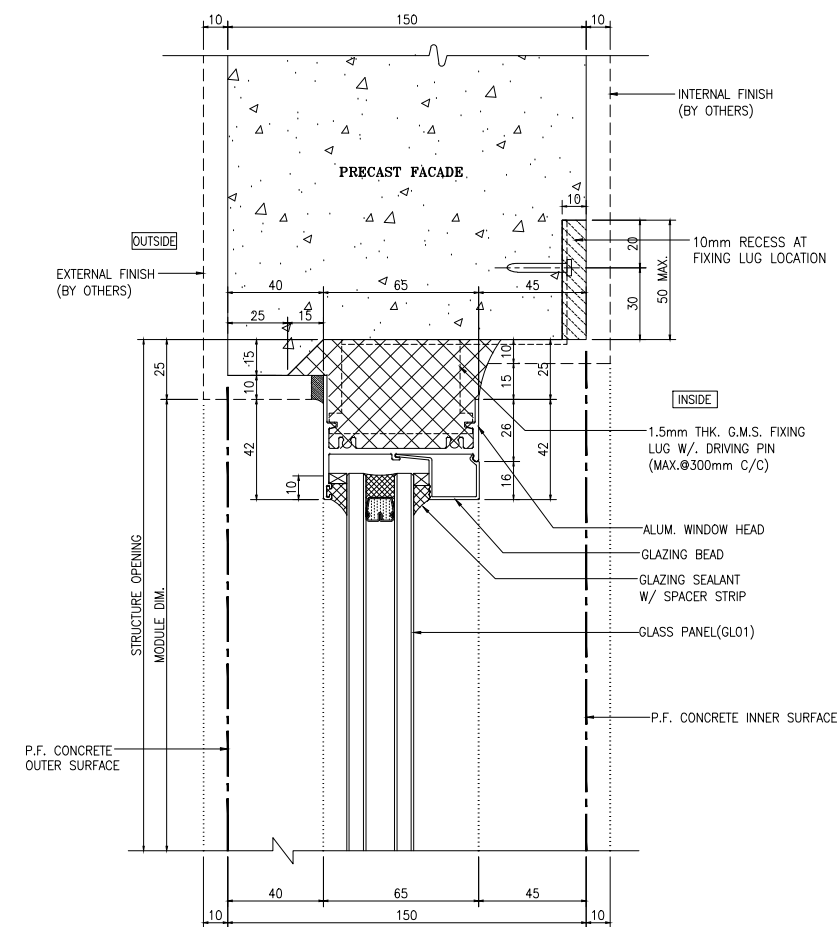


3 TYPICAL DETAIL FOR F.D. DOOR
915 For Fixed Panel





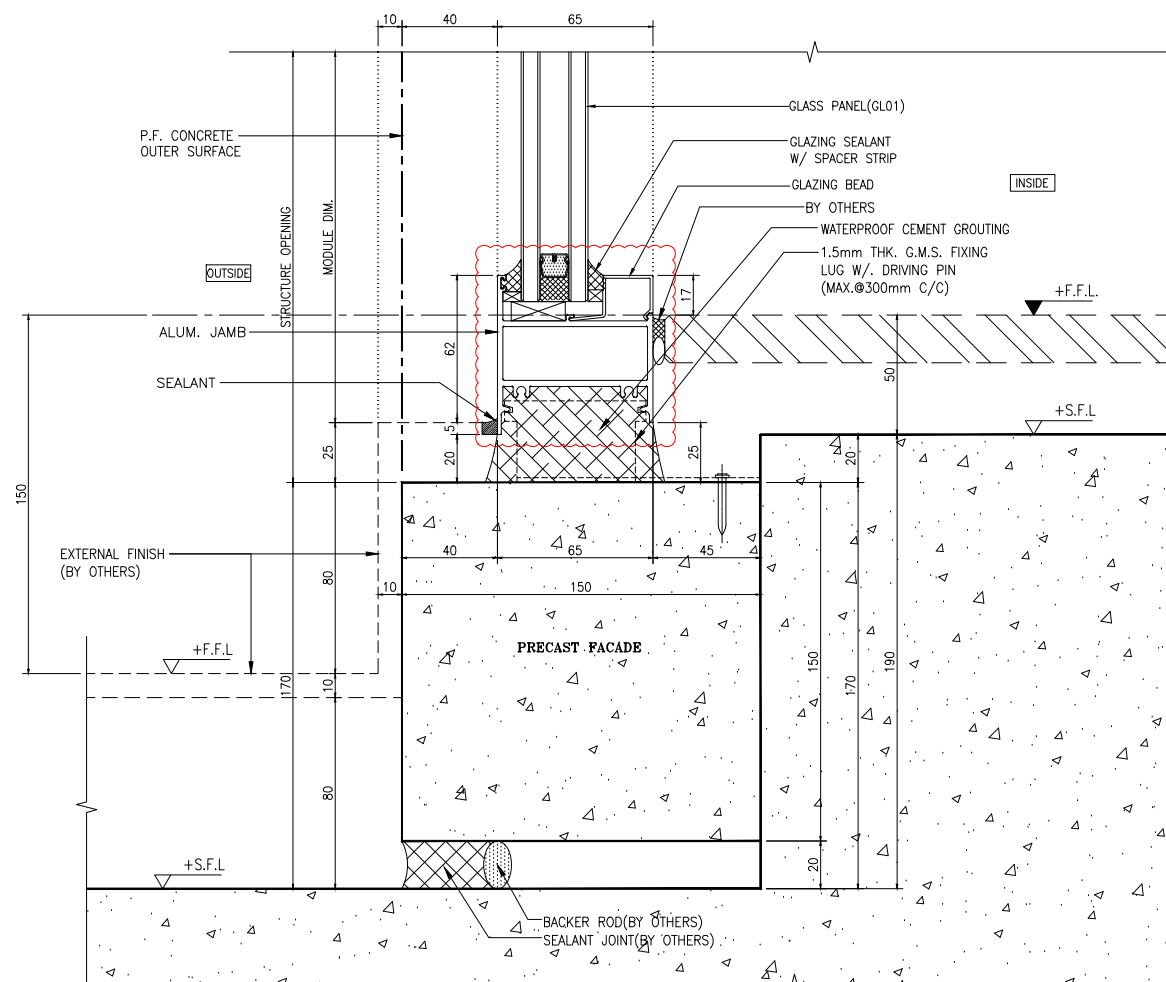


4 TYPICAL DETAIL FOR F.D. DOOR
915 For Fixed Panel


B.D. REF :			
F.S.D. REF :			
<u>Note :</u> 1.All dimensions are in mm. 2.All elevations are viewed from outside. 3.All dimensions to be verified on site before fabrication.			
GENERAL NOTES			
<u>Legend :</u> 1. F.F.L.-- Finished Floor Level 2. S.F.L.-- Structural Floor Level 3. (R) -- Reversed Detail			
X1 X001 DETAIL MARK NO. REFER SHEET NO.			
GL01 -- GREY BLUE IGU (8mm+12mm+8mm)			
C	20.03.2020	GENERAL REVISION	
B	05.03.2020	GENERAL REVISION	
A	13.02.2020	GENERAL REVISION	
NO.	DATE	REVISED	BY
CLIENT : 佳明集團控股有限公司 GRAND MING GROUP HOLDINGS LIMITED			
MAIN CONTRACTOR : GRAND TECH CONSTRUCTION CO. LTD.			
ARCHITECT : WONG TUNG & PARTNERS LIMITED ARCHITECTS & PLANNERS WT			
STRUCTURAL ENGINEER : C M WONG & ASSOCIATES LTD			
美特鋁質有限公司 MIDI ALUMINIUM FABRICATOR LTD. Units 6-8, Sunray Industrial Centre, 1/F 610 Cha Kwo Ling Road, Kowloon Tel:23489211-4 Fax:(852)27727666			
PROJECT : RESIDENTIAL DEVELOPMENT AT TSING YI TOWN LOT 190 SAI SHAN ROAD			
TITLE : TYPICAL DETAIL FOR F.D. DOOR			
JOB NO. : J-851			
DRAWN BY :		DATE : 2-12-2019	
CHKD BY :		SCALE A1: A3: 1:3	
DWG. NO. : J851-IW-915			REV. : C

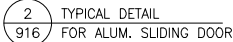


REV. : B

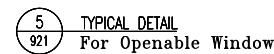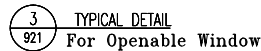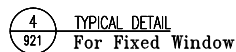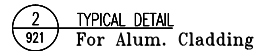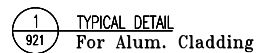


B.D. REF :			
F.S.D. REF :			
<u>Note :</u> 1.All dimensions are in mm. 2.All elevations are viewed from outside. 3.All dimensions to be verified on site before fabrication.			
GENERAL NOTES			
<u>Legend :</u> 1. F.F.L.-- Finished Floor Level 2. S.F.L.-- Structural Floor Level 3. (R) -- Reversed Detail			
X1 X001 DETAIL MARK NO. REFER SHEET NO.			
GL02 -- GREY BLUE MONOLITHIC GLASS (12mm) w/ DRAK GREY WINDOW FRAME IN PVF2 FINISH GL06 -- GREY BLUE MONOLITHIC GLASS (12mm) w/ FROSTED TEXTURE AT INNER SURFACE GL08 -- CLEAR GLASS (12mm) w/ FROSTED TEXTURE AT INNER SURFACE			
C	04.05.2020	GENERAL REVISION	
B	05.03.2020	GENERAL REVISION	
A	13.02.2020	GENERAL REVISION	
NO.	DATE	REVISED	BY
CLIENT : 佳明集團控股有限公司 GRAND MING GROUP HOLDINGS LIMITED			
MAIN CONTRACTOR : GRAND TECH CONSTRUCTION CO. LTD.			
ARCHITECT : WONG TUNG & PARTNERS LIMITED ARCHITECTS & PLANNERS WT			
STRUCTURAL ENGINEER :  C M WONG & ASSOCIATES LTD			
 美特鋁質有限公司 MIDI ALUMINUM FABRICATOR LTD. Units 6-8, Sunray Industrial Centre, 1/F 610 Cha Kwo Ling Road, Kowloon Tel:23489211-4 Fax:(852)27727666			
PROJECT : RESIDENTIAL DEVELOPMENT AT TSING YI TOWN LOT 190 SAI SHAN ROAD			
TITLE : TYPICAL DETAIL FOR IN-SITU WINDOW			
JOB NO. : J-851			
DRAWN BY :		DATE : 2-12-2019	
CHKD BY :		SCALE A1: A3: 1:3	
DWG. NO. : J851-IW-921			REV. : C

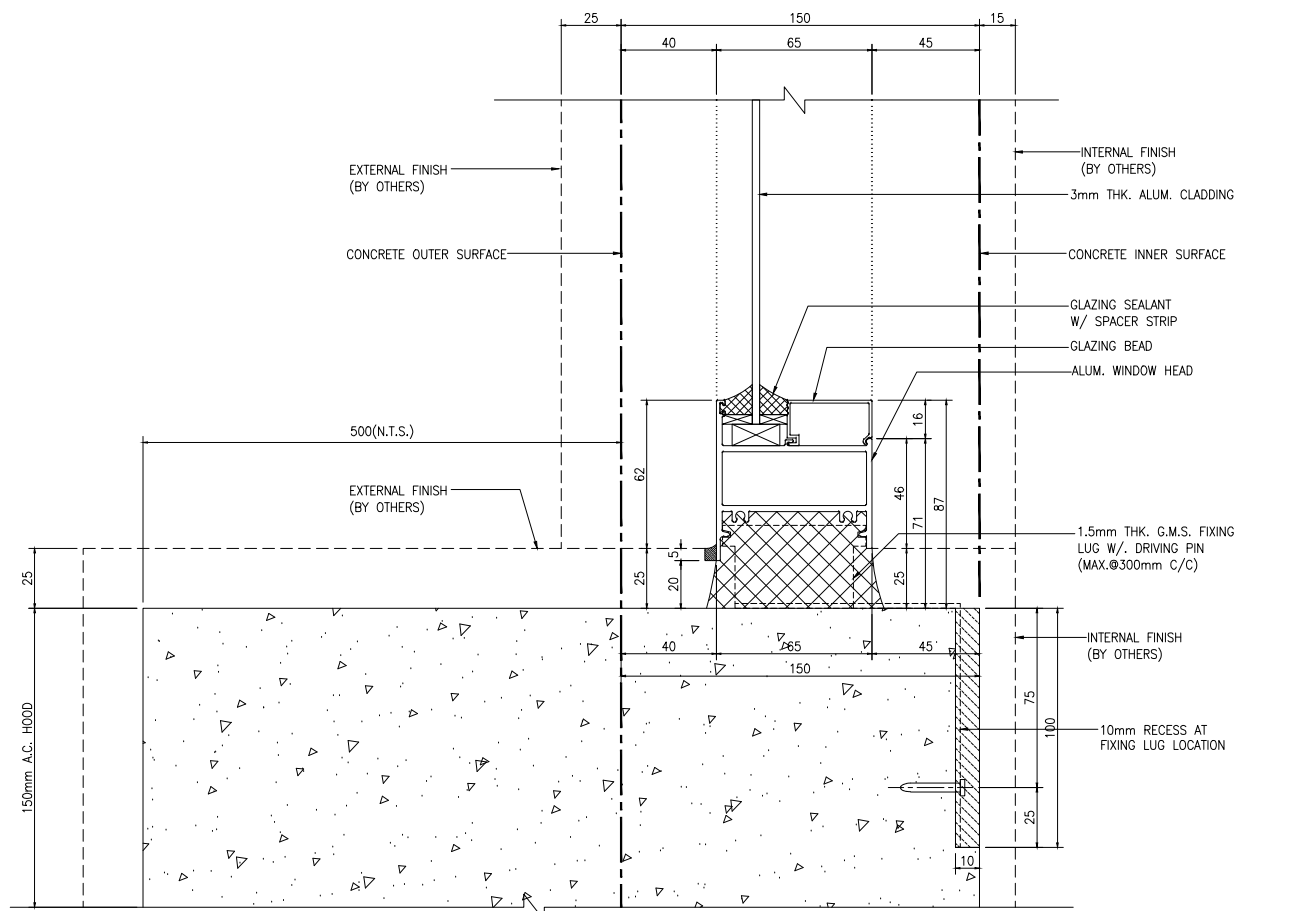


1
922 TYPICAL DETAIL
For Alum. Cladding

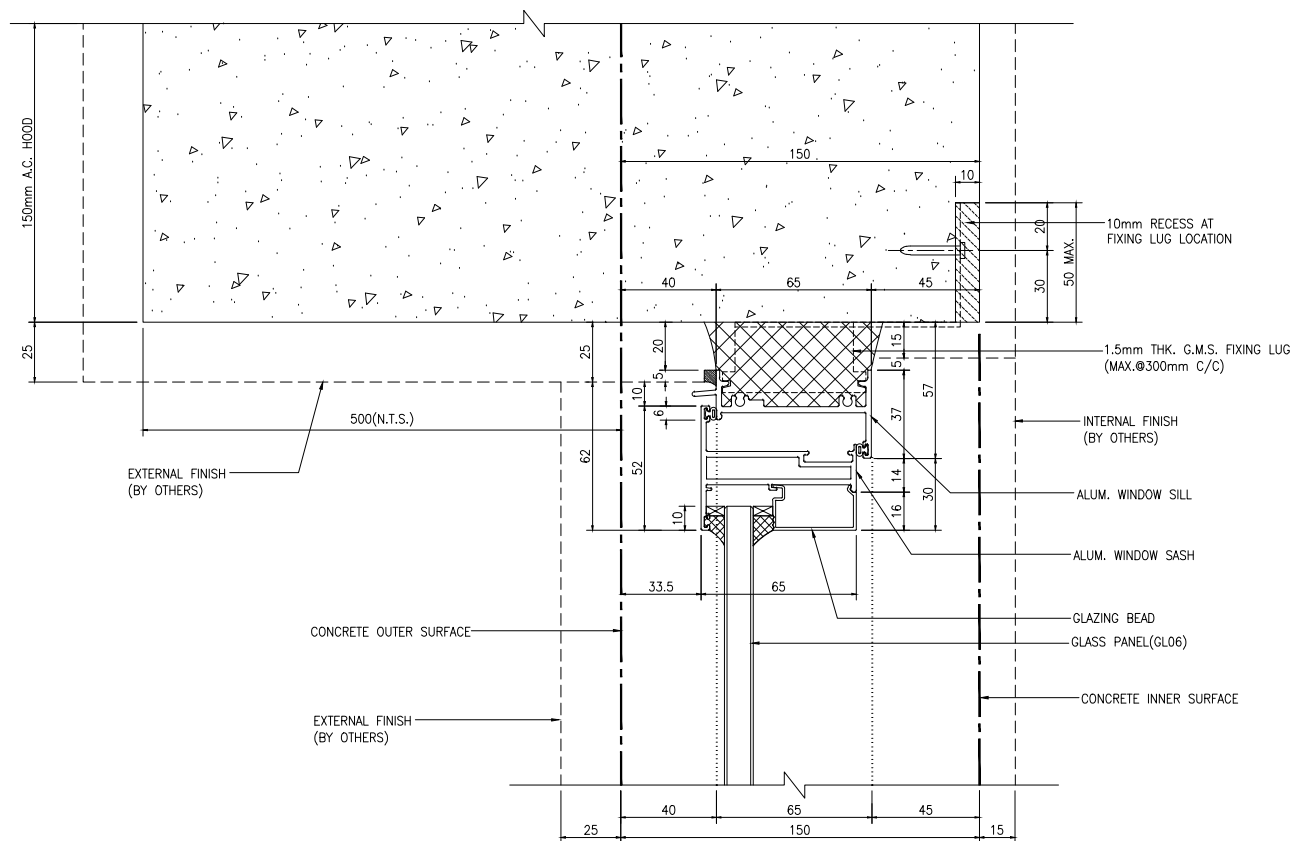

2
922 TYPICAL DETAIL
For Openable Window



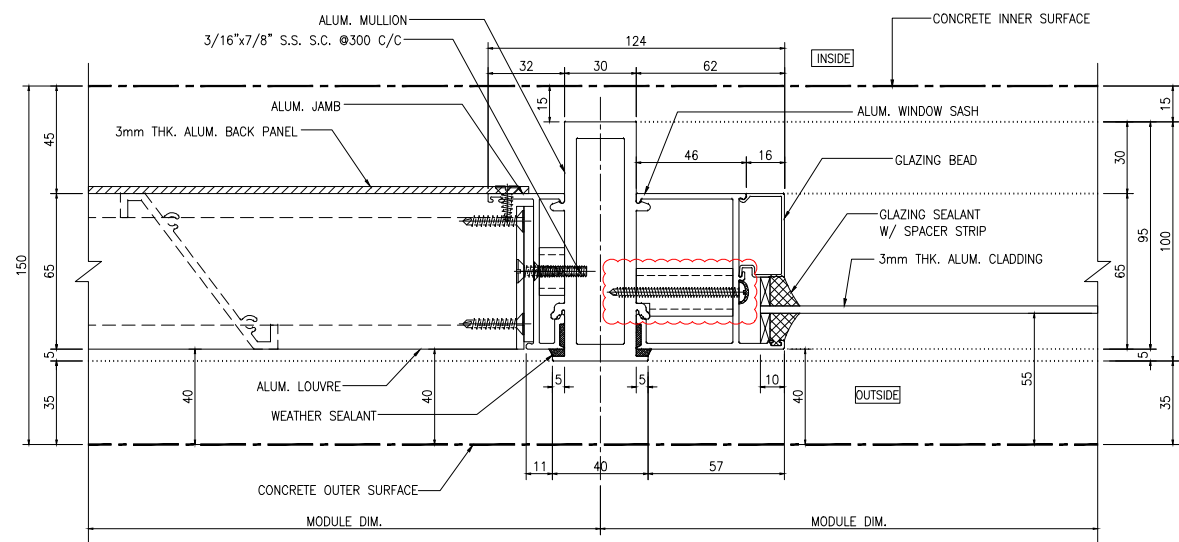


3
922 TYPICAL DETAIL
Mullion Of Alum. Louvre
And Alum. Cladding

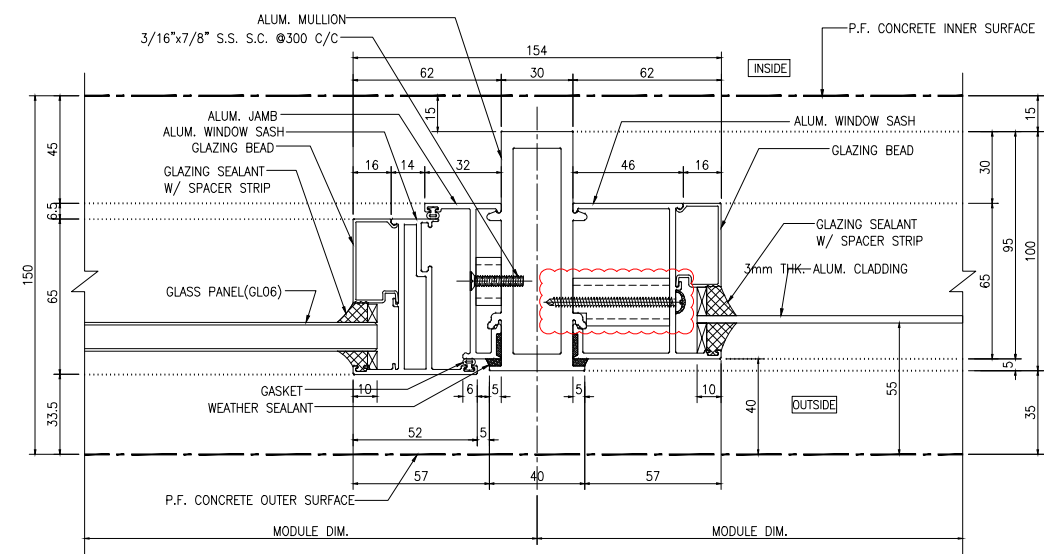


4
922 TYPICAL DETAIL
Mullion Of Openable Window
And Alum. Cladding


B.D. REF :			
F.S.D. REF :			
<u>Note :</u> 1.All dimensions are in mm. 2.All elevations are viewed from outside. 3.All dimensions to be verified on site before fabrication.			
GENERAL NOTES			
<u>Legend :</u> 1. F.F.L.-- Finished Floor Level 2. S.F.L.-- Structural Floor Level 3. (R) -- Reversed Detail			
X1 X001		DETAIL MARK NO. REFER SHEET NO.	
GL06 -- GREY BLUE MONOLITHIC GLASS (12mm) w/ FROSTED TEXTURE AT INNER SURFACE			
C	20.03.2020	GENERAL REVISION	
B	05.03.2020	GENERAL REVISION	
A	13.02.2020	GENERAL REVISION	
NO.	DATE	REVISED	BY
CLIENT :			
佳明集團控股有限公司 GRAND MING GROUP HOLDINGS LIMITED			
MAIN CONTRACTOR :			
GRAND TECH CONSTRUCTION CO. LTD.			
ARCHITECT :			
WONG TUNG & PARTNERS LIMITED ARCHITECTS & PLANNERS 			
STRUCTURAL ENGINEER :			
 C M WONG & ASSOCIATES LTD			
 美特鋁質有限公司 MIDI ALUMINIUM FABRICATOR LTD. Units 6-8, Sunray Industrial Centre, 1/F 610 Cha Kwo Ling Road, Kowloon Tel:23489211-4 Fax:(852)27727666			
PROJECT :			
RESIDENTIAL DEVELOPMENT AT TSING YI TOWN LOT 190 SAI SHAN ROAD			
TITLE :			
TYPICAL DETAIL FOR IN-SITU WINDOW			
JOB NO. : J-851			
DRAWN BY :		DATE : 2-12-2019	
CHKD BY :		SCALE A1: A3: 1:3	
DWG. NO. : J851-IW-922			REV. : C

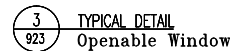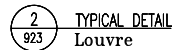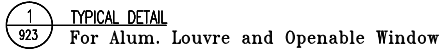


B.D. REF. :			
F.S.D. REF. :			
<u>Note :</u> 1.All dimensions are in mm. 2.All elevations are viewed from outside. 3.All dimensions to be verified on site before fabrication.			
GENERAL NOTES			
<u>Legend :</u> 1. F.F.L.-- Finished Floor Level 2. S.F.L.-- Structural Floor Level 3. (R) -- Reversed Detail			
X1 X001 DETAIL MARK NO. REFER SHEET NO.			
GL02 -- GREY BLUE MONOLITHIC GLASS (12mm) w/ DRAK GREY WINDOW FRAME IN PVF2 FINISH GL06 -- GREY BLUE MONOLITHIC GLASS (12mm) w/ FROSTED TEXTURE AT INNER SURFACE GL08 -- CLEAR GLASS (12mm) w/ FROSTED TEXTURE AT INNER SURFACE			
C	04.05.2020	GENERAL REVISION	
B	05.03.2020	GENERAL REVISION	
A	13.02.2020	GENERAL REVISION	
NO.	DATE	REVISED	BY
CLIENT : 佳明集團控股有限公司 GRAND MING GROUP HOLDINGS LIMITED			
MAIN CONTRACTOR : GRAND TECH CONSTRUCTION CO. LTD.			
ARCHITECT : WONG TUNG & PARTNERS LIMITED ARCHITECTS & PLANNERS 			
STRUCTURAL ENGINEER :  C M WONG & ASSOCIATES LTD			
 美特鋁質有限公司 MIDI ALUMINIUM FABRICATOR LTD. Units 6-8, Sunray Industrial Centre, 1/F 610 Cha Kwo Ling Road, Kowloon Tel:23489211-4 Fax:(852)27727666			
PROJECT : RESIDENTIAL DEVELOPMENT AT TSING YI TOWN LOT 190 SAI SHAN ROAD			
TITLE : TYPICAL DETAIL FOR IN-SITU WINDOW			
JOB NO. : J-851			
DRAWN BY :		DATE : 2-12-2019	
CHKD BY :		SCALE A1: A3: 1:3	
DWG. NO. : J851-JW-923			REV. : C

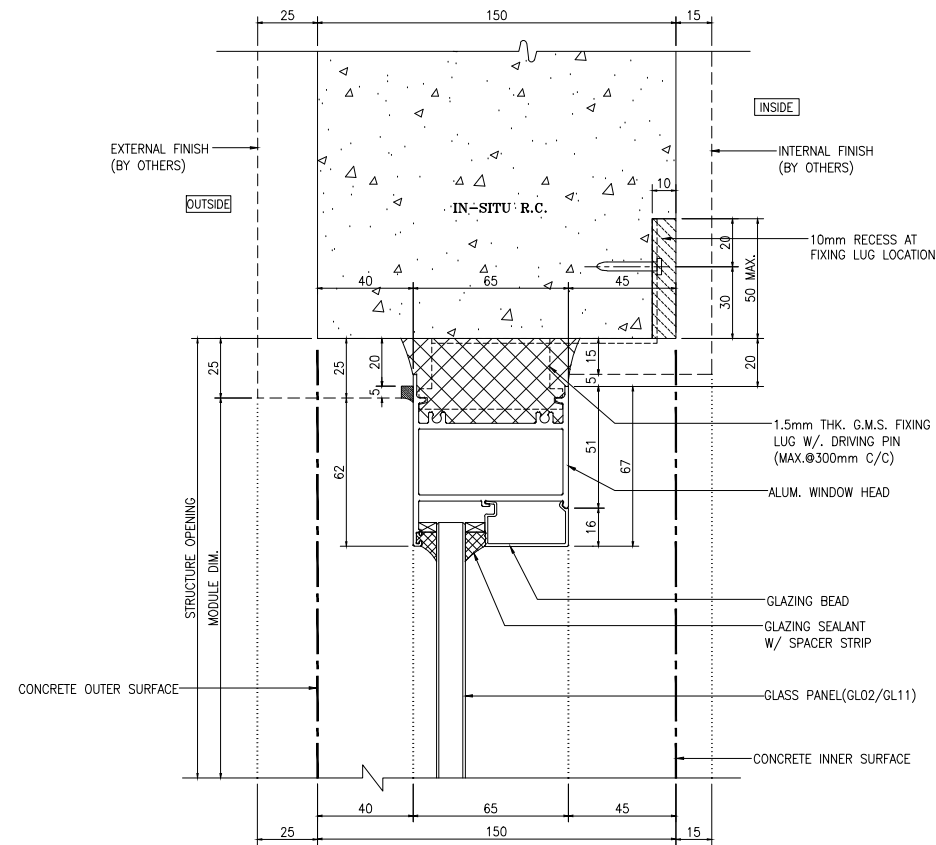

1
924 TYPICAL DETAIL
For Alum. Cladding

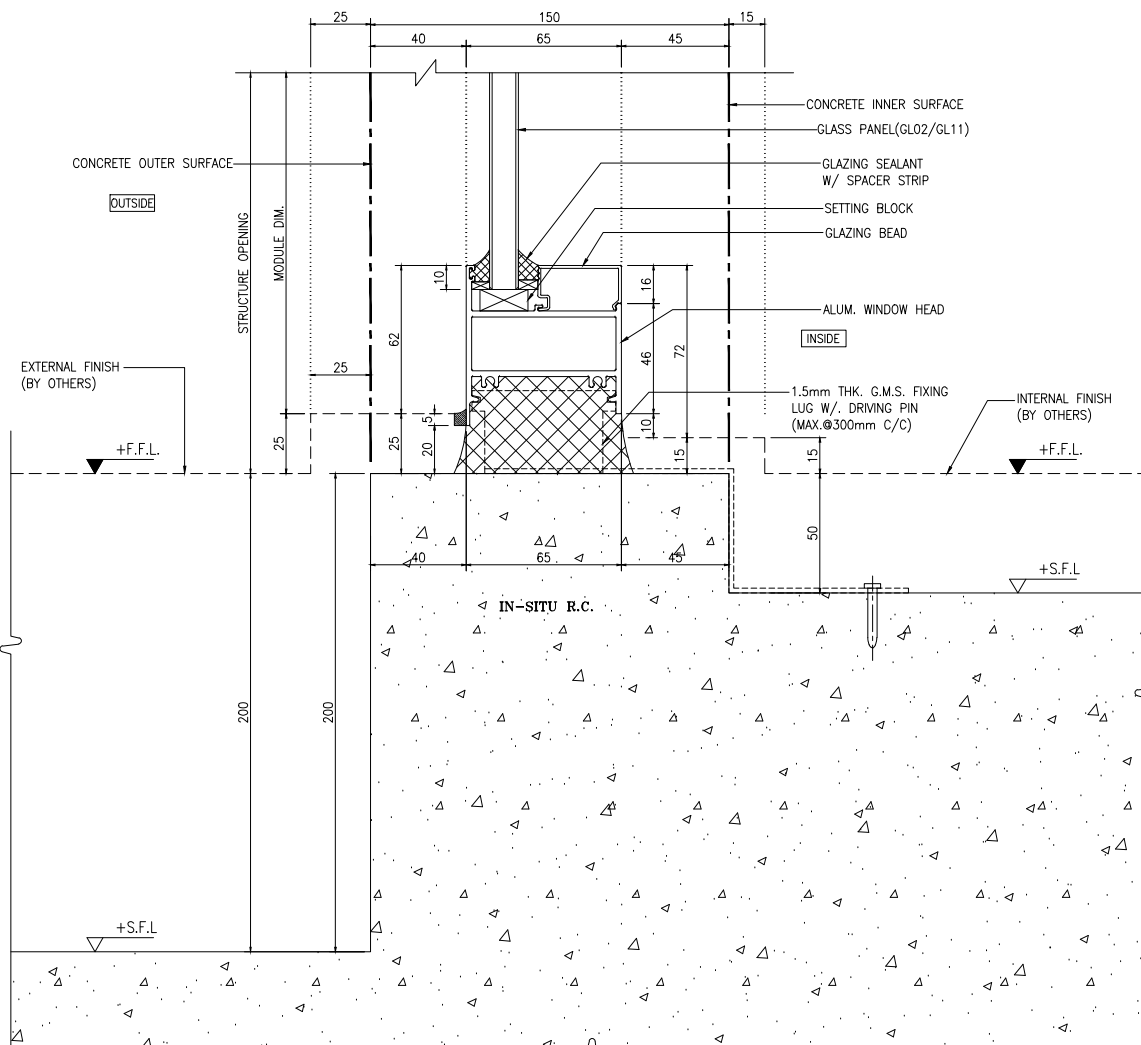


2
924 TYPICAL DETAIL
For Alum. Cladding

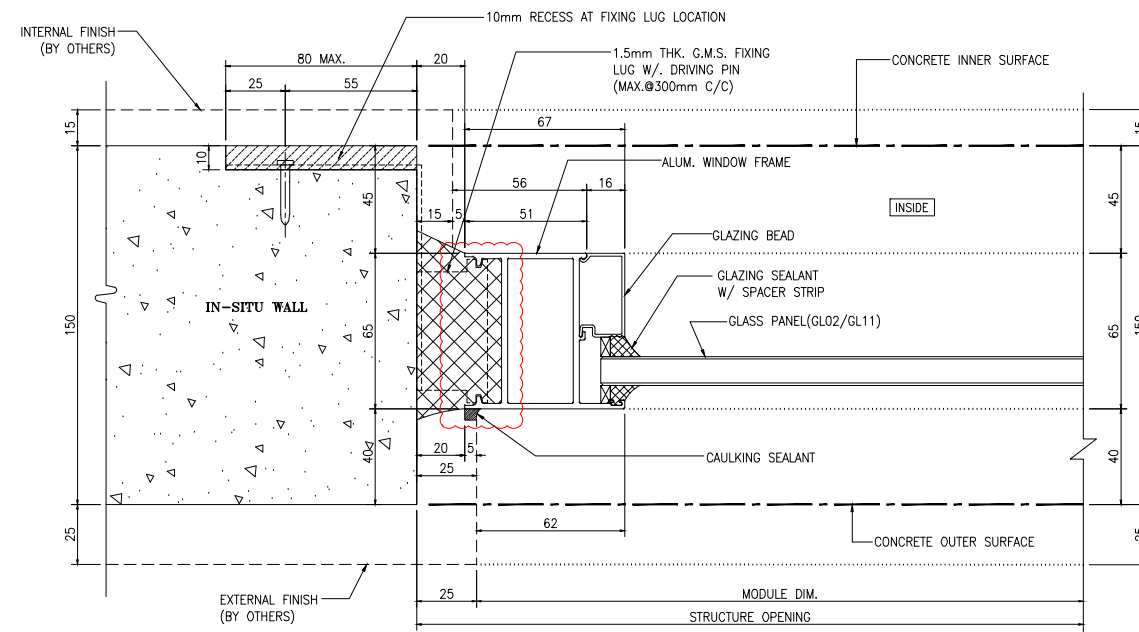


3
924 TYPICAL DETAIL
For Fixed Window

B.D. REF :			
F.S.D. REF :			
Note : 1.All dimensions are in mm. 2.All elevations are viewed from outside. 3.All dimensions to be verified on site before fabrication.			
GENERAL NOTES			
Legend : 1. F.F.L--- Finished Floor Level 2. S.F.L--- Structural Floor Level 3. (R) --- Reversed Detail			
X1 --- DETAIL MARK NO. X001 --- REFER SHEET NO.			
GL02 --- GREY BLUE MONOLITHIC GLASS (12mm) w/ DRAK GREY WINDOW FRAME IN PVF2 FINISH GL11 --- CLEAR TEMPERED GLASS (12mm)			
C	04.05.2020	GENERAL REVISION	
B	05.03.2020	GENERAL REVISION	
A	13.02.2020	GENERAL REVISION	
NO.	DATE	REVISED	BY
CLIENT :			
佳明集團控股有限公司 GRAND MING GROUP HOLDINGS LIMITED			
MAIN CONTRACTOR :			
GRAND TECH CONSTRUCTION CO. LTD.			
ARCHITECT :			
WONG TUNG & PARTNERS LIMITED ARCHITECTS & PLANNERS 			
STRUCTURAL ENGINEER :			
C M WONG & ASSOCIATES LTD			
美特鋁質有限公司 MIDI ALUMINIUM FABRICATOR LTD. Units 6-8, Sunray Industrial Centre, 1/F 610 Cha Kwo Ling Road, Kowloon Tel:23489211-4 Fax:(852)27727666			
PROJECT :			
RESIDENTIAL DEVELOPMENT AT TSING YI TOWN LOT 190 SAI SHAN ROAD			
TITLE :			
TYPICAL DETAIL FOR IN-SITU WINDOW			
JOB NO. : J-851			
DRAWN BY :		DATE : 2-12-2019	
CHKD BY :		SCALE A1: A3: 1:3	
DWG. NO. : J851-IW-924			REV. : C

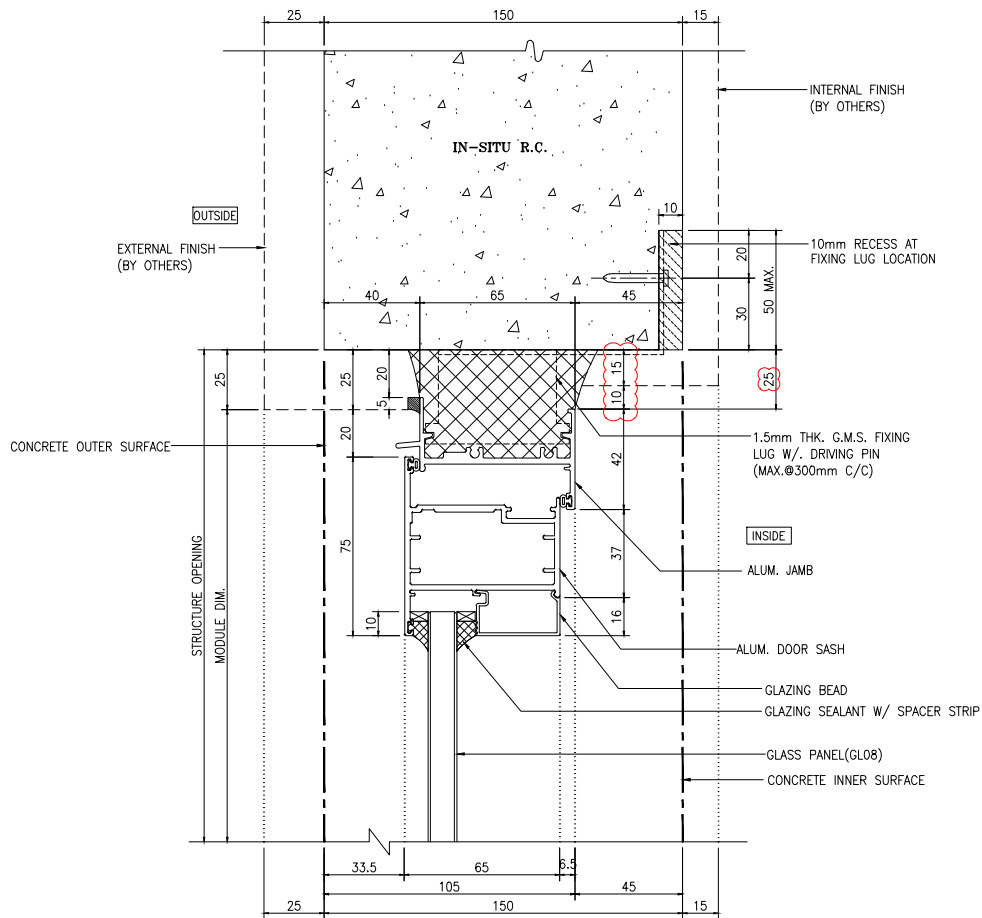

1
926 TYPICAL DETAIL
For Openable Window

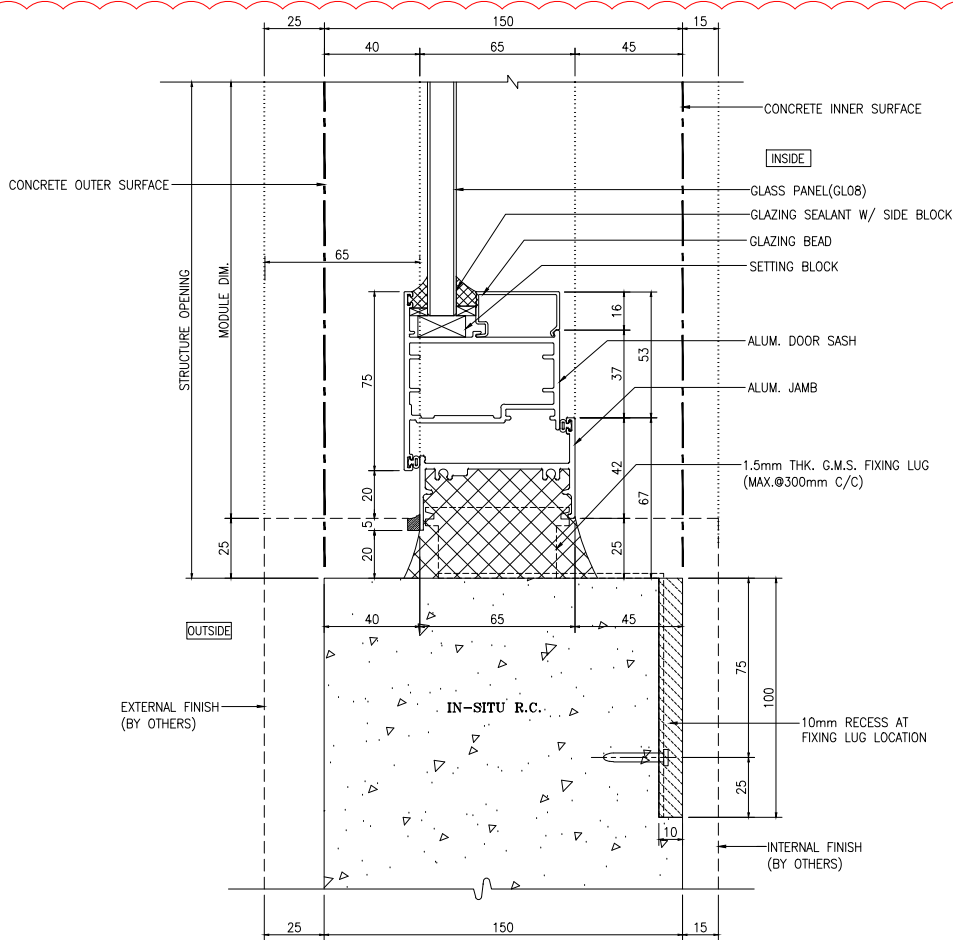

3
For Openable Window

B.D. REF :

F.S.D. REF :

Note :
1.All dimensions are in mm.
2.All elevations are viewed from outside.
3.All dimensions to be verified on site before fabrication.

GENERAL NOTES

Legend :
1. F.F.L.-- Finished Floor Level
2. S.F.L.-- Structural Floor Level
3. (R) -- Reversed Detail

X1 -- DETAIL MARK NO.
X001 -- REFER SHEET NO.

GL08 -- CLEAR GLASS (12mm) w/ FROSTED TEXTURE AT INNER SURFACE

NO.	DATE	REVISED	BY
C	04.05.2020	GENERAL REVISION	
B	05.03.2020	GENERAL REVISION	
A	13.02.2020	GENERAL REVISION	

CLIENT :
佳明集團控股有限公司
GRAND MING GROUP HOLDINGS LIMITED

MAIN CONTRACTOR :
GRAND TECH CONSTRUCTION CO. LTD.

ARCHITECT :
WONG TUNG & PARTNERS LIMITED
ARCHITECTS & PLANNERS
WT

STRUCTURAL ENGINEER :
C M WONG & ASSOCIATES LTD

美特鋁質有限公司
MIDI ALUMINIUM FABRICATOR LTD.
Units 6-8, Sunray Industrial Centre, 1/F
610 Cha Kwo Ling Road, Kowloon
Tel:23489211-4 Fax:(852)27727666

PROJECT :
RESIDENTIAL DEVELOPMENT AT
TSING YI TOWN LOT 190 SAI SHAN ROAD


TITLE :
TYPICAL DETAIL FOR
IN-SITU WINDOW

JOB NO. : J-851


DRAWN BY : DATE : 2-12-2019

CHKD BY : SCALE A1: A3: 1:3


DWG. NO. : J851-IW-926 REV. : C

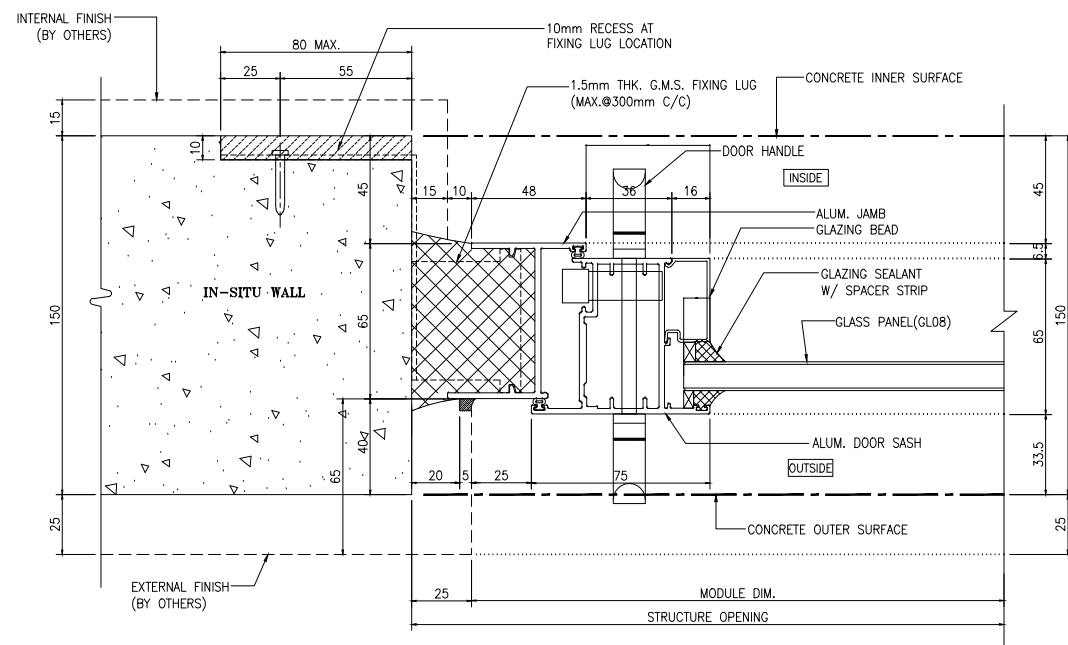

1
927 TYPICAL DETAIL
FOR F.D. DOOR

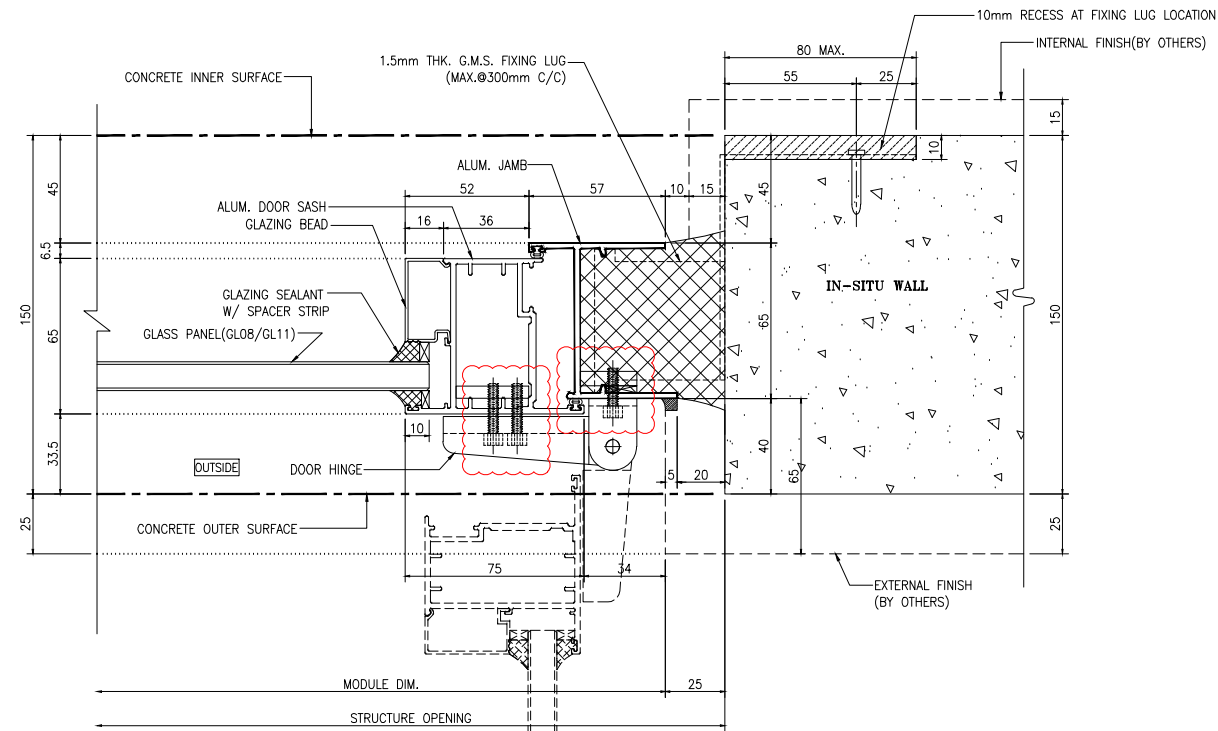

2
927 TYPICAL DETAIL
FOR F.D. DOOR

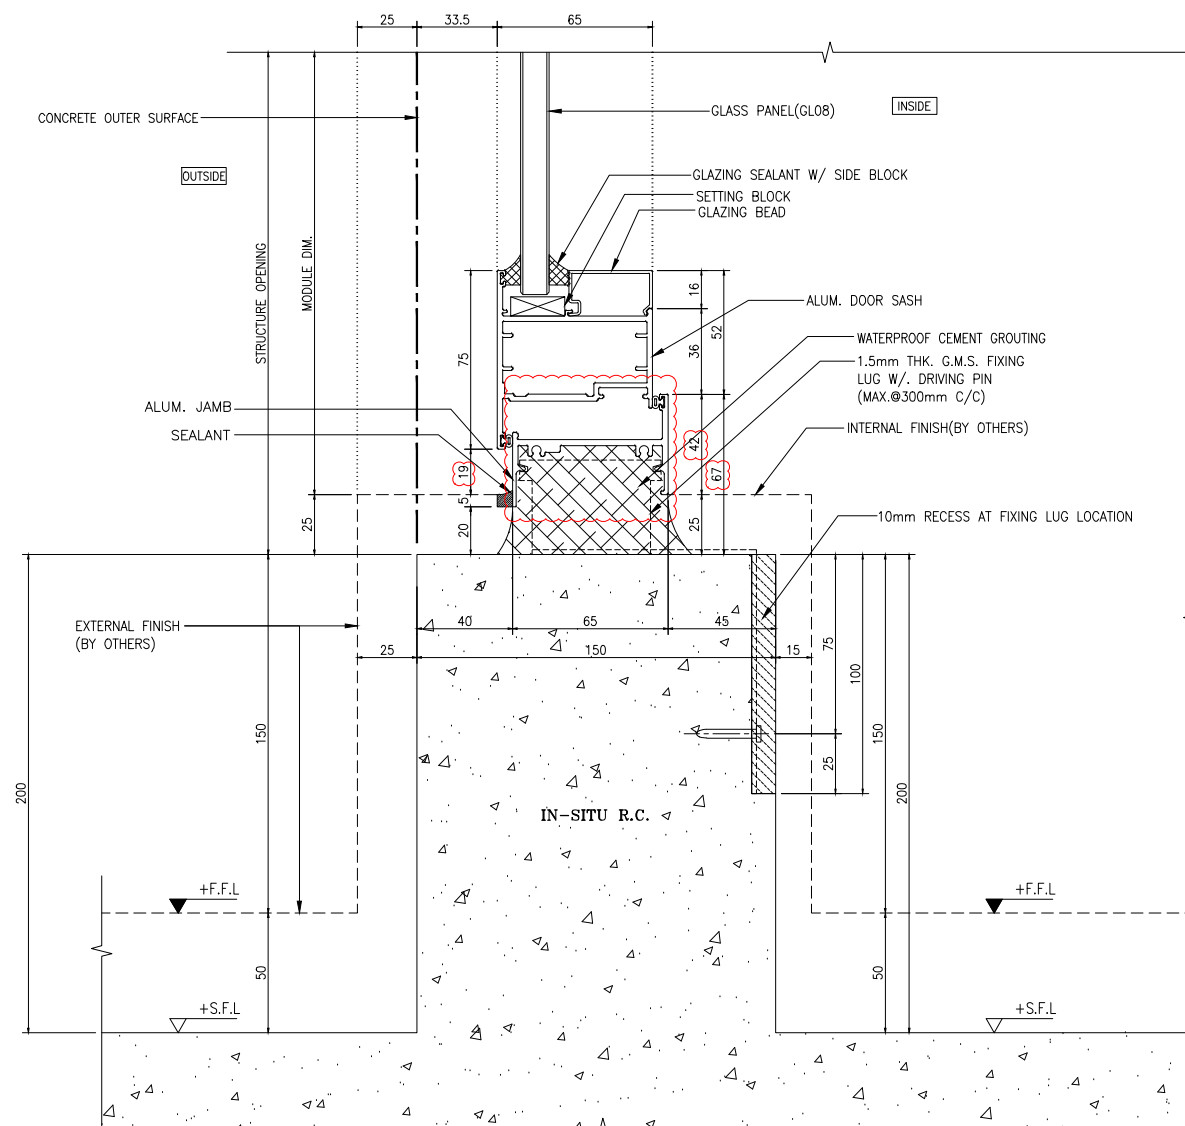

3
927 TYPICAL DETAIL FOR F.D. DOOR
For Openable Panel

B.D. REF :

F.S.D. REF :

Note :
1. All dimensions are in mm.
2. All elevations are viewed from outside.
3. All dimensions to be verified on site before fabrication.

GENERAL NOTES

Legend :
1. F.F.L. --- Finished Floor Level
2. S.F.L. --- Structural Floor Level
3. (R) --- Reversed Detail

X1 --- DETAIL MARK NO.
X001 --- REFER SHEET NO.

GL08 --- CLEAR GLASS (12mm) w/ FROSTED TEXTURE AT INNER SURFACE

GL11 --- CLEAR TEMPERED GLASS (12mm)

NO.	DATE	REVISED	BY
C	20.03.2020	GENERAL REVISION	
B	05.03.2020	GENERAL REVISION	
A	13.02.2020	GENERAL REVISION	

CLIENT :
佳明集團控股有限公司
GRAND MING GROUP HOLDINGS LIMITED

MAIN CONTRACTOR :
GRAND TECH CONSTRUCTION CO. LTD.

ARCHITECT :
WONG TUNG & PARTNERS LIMITED
ARCHITECTS & PLANNERS
WT

STRUCTURAL ENGINEER :
C M WONG & ASSOCIATES LTD

美特鋁質有限公司
MIDI ALUMINIUM FABRICATOR LTD.
Units 6-8, Sunray Industrial Centre, 1/F
610 Cha Kwo Ling Road, Kowloon
Tel: 23489211-4 Fax: (852) 27727666

PROJECT :
RESIDENTIAL DEVELOPMENT AT
TSING YI TOWN LOT 190 SAI SHAN ROAD


TITLE :
TYPICAL DETAIL FOR
IN-SITU WINDOW

JOB NO. : J-851


DRAWN BY : DATE : 2-12-2019

CHKD BY : SCALE A1: A3: 1:3


DWG. NO. : J851-IW-927 REV. : C

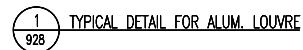


REV. : C

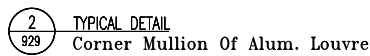


REV. :	A
--------	---

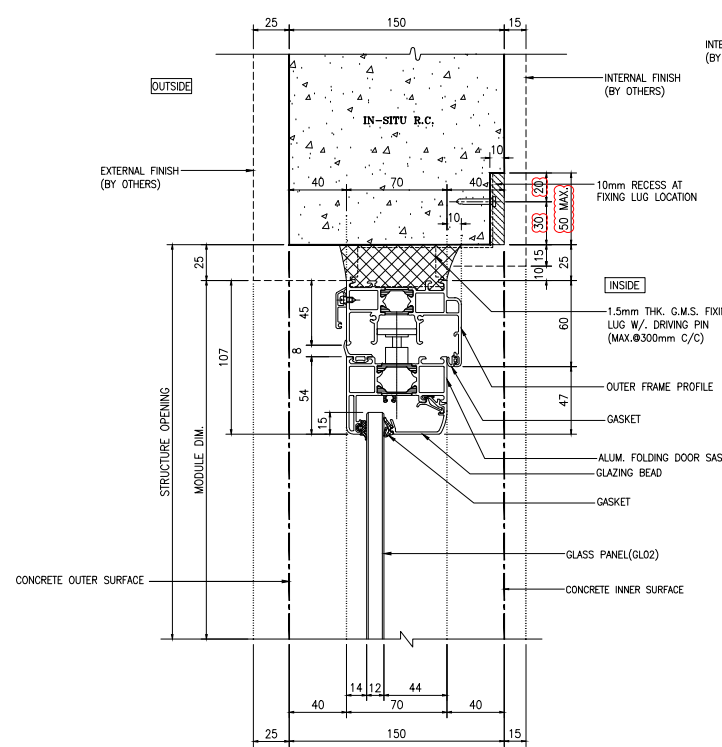


1 TYPICAL DETAIL
931 FOR FOLDING DOOR

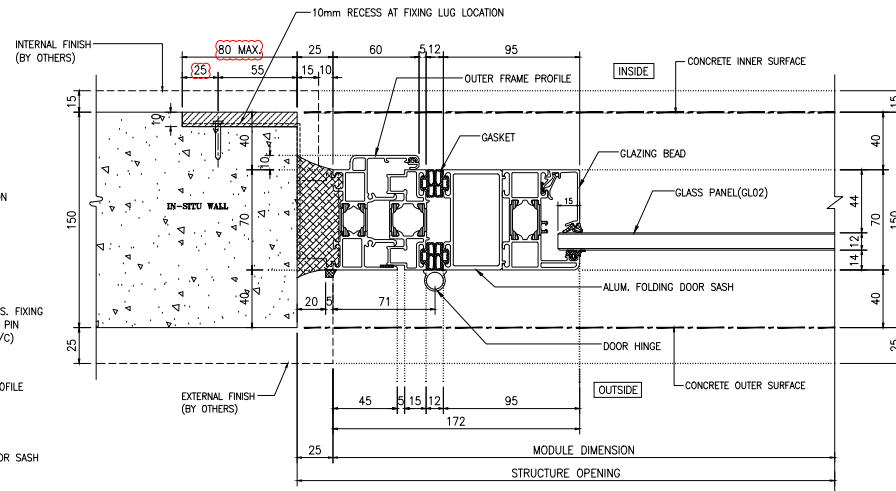


3 TYPICAL DETAIL
931 FOR FOLDING DOOR

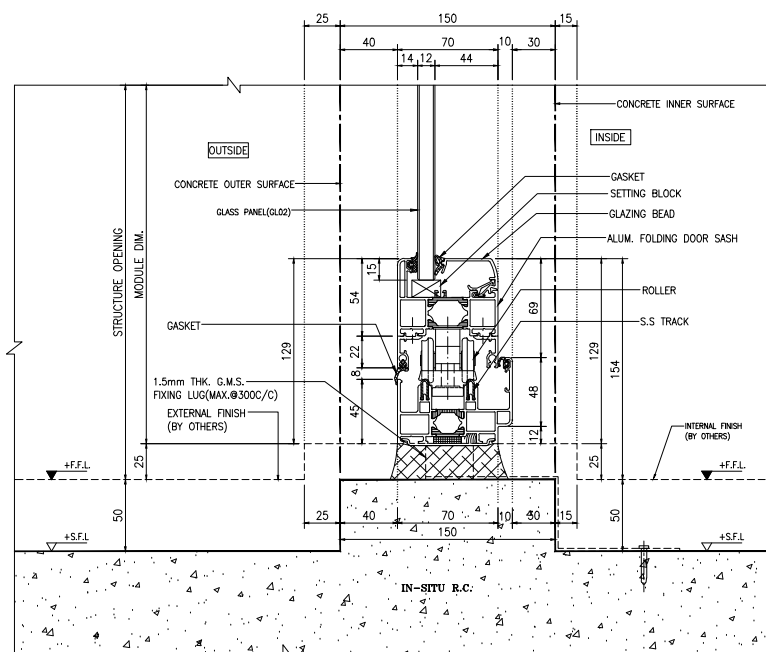


2 TYPICAL DETAIL
931 FOR FOLDING DOOR

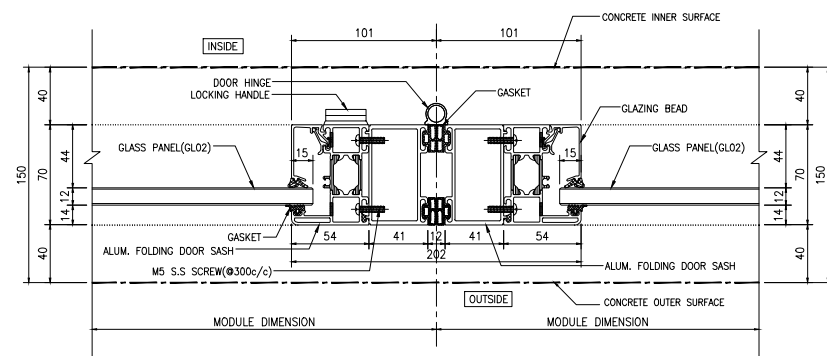


4 TYPICAL DETAIL
931 FOR FOLDING DOOR

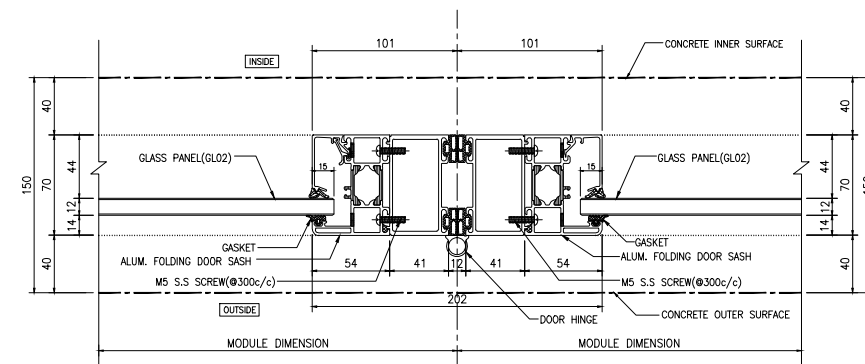

5 TYPICAL DETAIL
931 FOR FOLDING DOOR

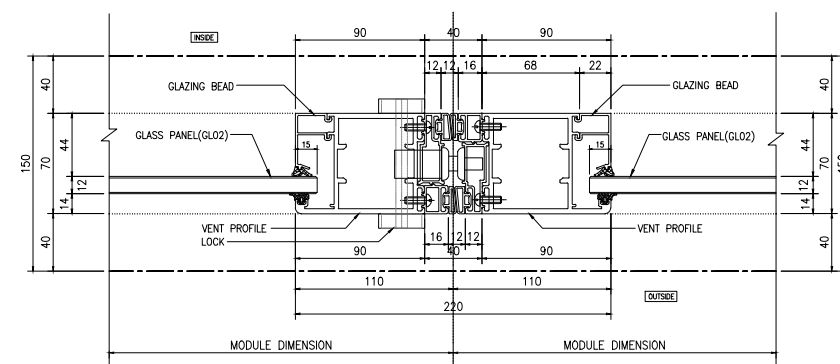


6 TYPICAL DETAIL
931 FOR FOLDING DOOR

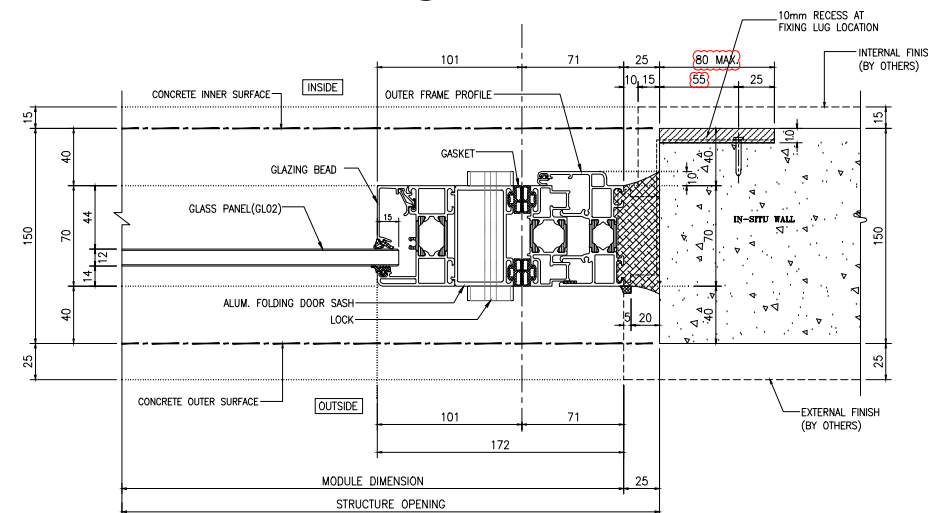

7 TYPICAL DETAIL
931 FOR FOLDING DOOR

B.D. REF :																											
F.S.D. REF :																											
Note : 1. All dimensions are in mm. 2. All elevations are viewed from outside. 3. All dimensions to be verified on site before fabrication.																											
GENERAL NOTES																											
Legend : 1. F.F.L. --- Finished Floor Level 2. S.F.L. --- Structural Floor Level 3. (R) --- Reversed Detail																											
X1 --- DETAIL MARK NO. X001 --- REFER SHEET NO.																											
GL02 --- GREY BLUE MONOLITHIC GLASS (12mm) w/ DRAB GREY WINDOW FRAME IN PVF2 FINISH																											
<table border="1"> <tr> <td></td><td></td><td></td><td></td></tr> <tr> <td></td><td></td><td></td><td></td></tr> <tr> <td></td><td></td><td></td><td></td></tr> <tr> <td>B</td><td>05.03.2020</td><td>GENERAL REVISION</td><td></td></tr> <tr> <td>A</td><td>13.02.2020</td><td>GENERAL REVISION</td><td></td></tr> <tr> <td>NO.</td><td>DATE</td><td>REVISED</td><td>BY</td></tr> </table>																B	05.03.2020	GENERAL REVISION		A	13.02.2020	GENERAL REVISION		NO.	DATE	REVISED	BY
B	05.03.2020	GENERAL REVISION																									
A	13.02.2020	GENERAL REVISION																									
NO.	DATE	REVISED	BY																								
CLIENT :																											
佳明集團控股有限公司 GRAND MING GROUP HOLDINGS LIMITED																											
MAIN CONTRACTOR :																											
GRAND TECH CONSTRUCTION CO. LTD.																											
ARCHITECT :																											
WONG TUNG & PARTNERS LIMITED ARCHITECTS & PLANNERS 																											
STRUCTURAL ENGINEER :																											
C M WONG & ASSOCIATES LTD																											
美特鋁質有限公司 MIDI ALUMINIUM FABRICATOR LTD. Units 6-8, Sunray Industrial Centre, 1/F 610 Cha Kwo Ling Road, Kowloon Tel: 23489211-4 Fax: (852) 27727666																											
PROJECT :																											
RESIDENTIAL DEVELOPMENT AT TSING YI TOWN LOT 190 SAI SHAN ROAD																											
TITLE :																											
TYPICAL DETAIL FOR FOLDING DOOR																											
JOB NO. : J-851																											
DRAWN BY :	DATE : 2-12-2019																										
CHKD BY :	SCALE A1: A3: 1:5																										
DWG. NO. : J851-IW-931	REV. : B																										

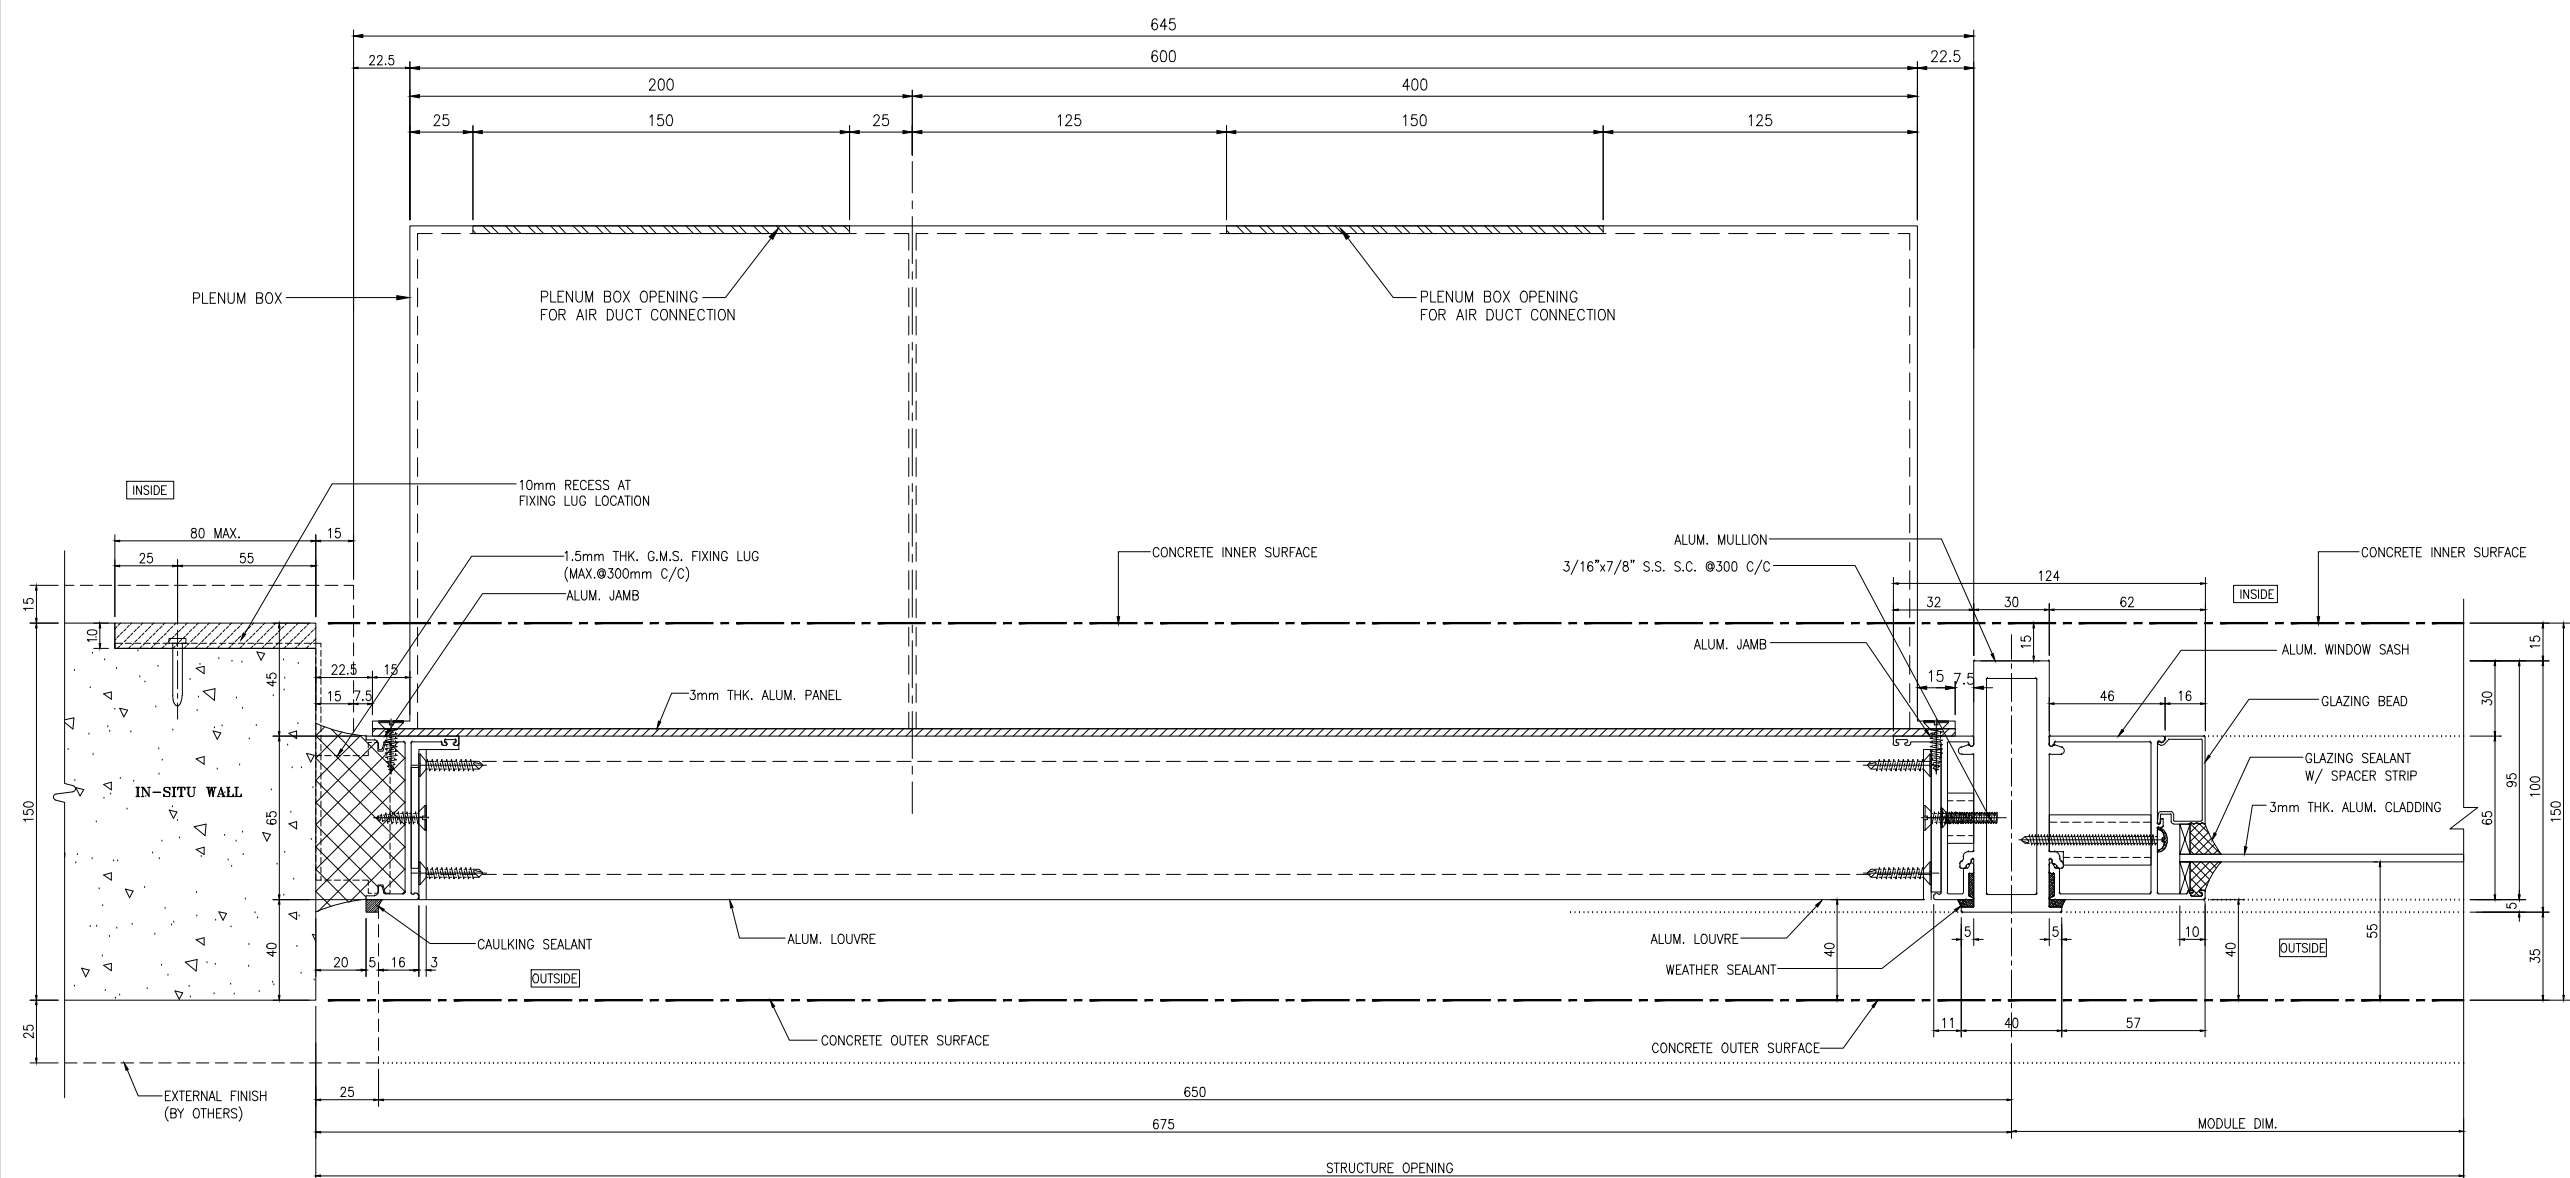

B.D. REF :

Note :

GENERAL NOTES

Legend :

A circular stamp is located in the upper right corner of the drawing. The stamp is divided horizontally. The top half contains the text 'X1' and the bottom half contains the text 'X001'. Two leader lines extend from the right side of the stamp. The top leader line points to the text 'DETAIL MARK NO.' and the bottom leader line points to the text 'REFER SHEET NO.'.

NO.	DATE	REVISED	BY

CLIENT :

MAIN CONTRACTOR :

ARCHITECT : **WONG TUNG & PARTNERS LIMITED**
ARCHITECTS & PLANNERS

STRUCTURAL ENGINEER :

 **美特鋁質有限公司**
MIDI ALUMINIUM FABRICATOR LTD.

PROJECT :


TITLE :

JOB NO. : J-851




CHKD BY :	SCALE A1:
	A3: 1:5

DWG. NO. : J851-IW-932

REV. :

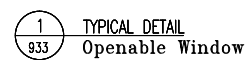

REV. :

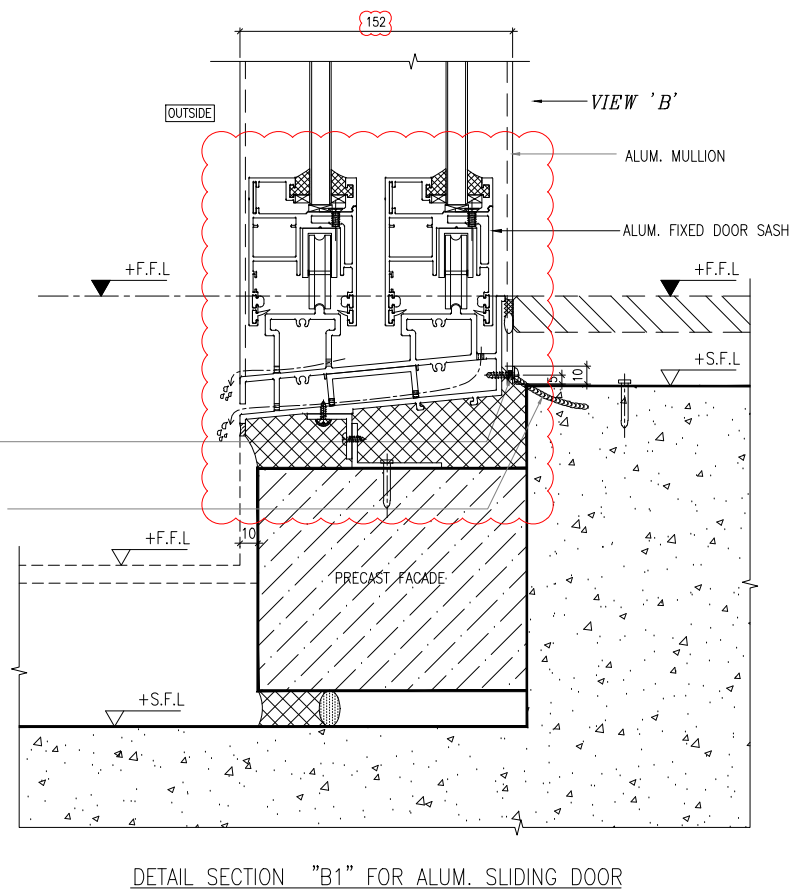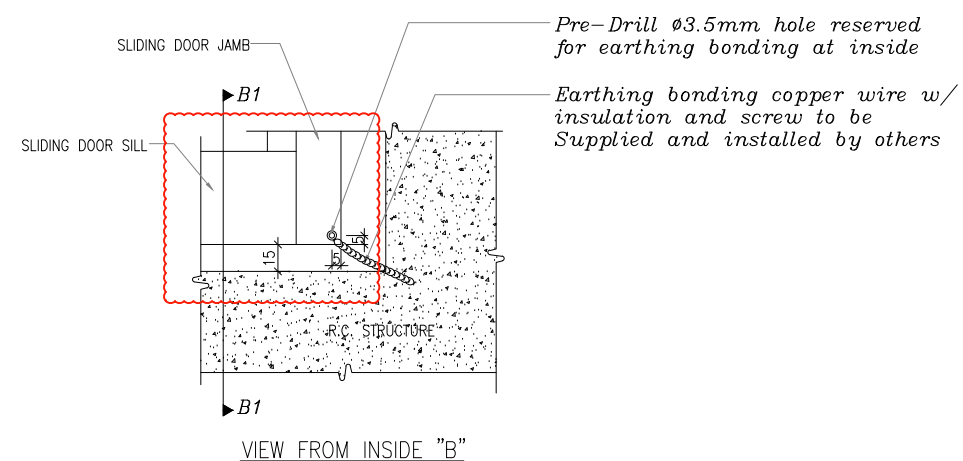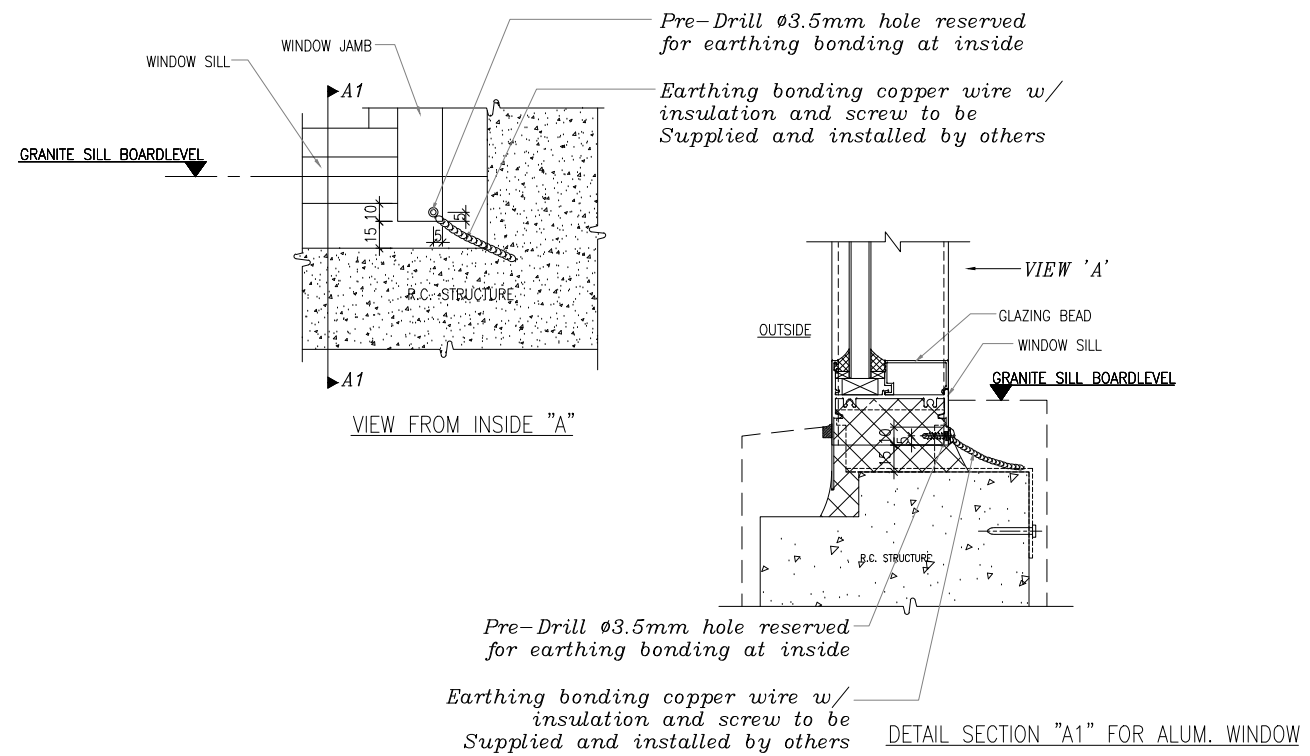ELEVATION(VIEW FROM INSIDE)

B.D. REF :			
F.S.D. REF :			
<u>Note :</u> 1.All dimensions are in mm. 2.All elevations are viewed from outside. 3.All dimensions to be verified on site before fabrication.			
GENERAL NOTES			
<u>Legend :</u> 1. F.F.L.-- Finished Floor Level 2. S.F.L.-- Structural Floor Level 3. (R) -- Reversed Detail			
 DETAIL MARK NO. REFER SHEET NO.			
A	05.03.2020	GENERAL REVISION	
NO.	DATE	REVISED	BY
CLIENT : 佳明集團控股有限公司 GRAND MING GROUP HOLDINGS LIMITED			
MAIN CONTRACTOR : GRAND TECH CONSTRUCTION CO. LTD.			
ARCHITECT : WONG TUNG & PARTNERS LIMITED ARCHITECTS & PLANNERS 			
STRUCTURAL ENGINEER : C M WONG & ASSOCIATES LTD			
美特鋁質有限公司 MIDI ALUMINIUM FABRICATOR LTD. Units 6-8, Sunray Industrial Centre, 1/F 610 Cha Kwo Ling Road, Kowloon Tel:23489211-4 Fax:(852)27727666			
PROJECT : RESIDENTIAL DEVELOPMENT AT TSING YI TOWN LOT 190 SAI SHAN ROAD			
TITLE : TYPICAL DETAIL FOR EARTH BONDING			
JOB NO. : J-851			
DRAWN BY :		DATE : 2-12-2019	
CHKD BY :		SCALE A1: A3: 1:4	
DWG. NO. : J851-IW-951			REV. : A