



工程指示 / 要求簡箋(E.I.)

工程指示編號：EI / 2650 / 20

修改版次：-

工程編號：J - 852

工程名稱：亞皆老街中電

工程項目：試水場圖紙 和地址

收件人：生統 / 林哥

發件人：Ant Yeung

日期：30/10/2020

要求提供 / 確認 事項：

- |                                    |                                     |                               |
|------------------------------------|-------------------------------------|-------------------------------|
| <input type="checkbox"/> 初步鋁料 B.M. | <input type="checkbox"/> 加工拆圖，然後生產  | <input type="checkbox"/> 尺寸表  |
| <input type="checkbox"/> 正式鋁料 B.M. | <input type="checkbox"/> 技術上資料 / 指示 | <input type="checkbox"/> 報價   |
| <input type="checkbox"/> 配件 B.M.   | <input type="checkbox"/> 樣辦或貨品說明書   | <input type="checkbox"/> 分判合約 |
| <input type="checkbox"/> 其他：_____  |                                     |                               |

內容：

附上試水箱圖紙和地址

先作預算十一月尾到料試水場 TM

謝謝

請在 2020 / 11 / 20 前完成上列要求。

附：14 頁。

以上項目為：

- 原合約工程包                       原合約工程加 / 減賬                       新工程報價

分發東莞各部門：

- 生產技術總監  連附件     技術部     連附件     生產部     連附件     機械設計部  連附件  
 採購部     連附件     生產統籌部  連附件  
 質檢部     連附件     會計部     連附件     報關組     連附件     其他 楊榮輝  連附件

分發香港各部門：

- 行政部  連附件     會計部  連附件     統籌部  連附件     工程部地盤科文  連附件 祥哥 何曾成  
 採購部  連附件     QS 部  連附件     維修部  連附件     其他 \_\_\_\_\_  連附件


傳遞編號：

HK 2491 / 20

發件人簽署：

項目經理簽署：

622650 HK 2491

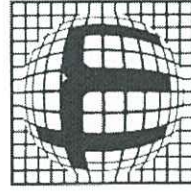

T.M. Testing Co., Ltd.  
屯門測試有限公司


DD124, Lot 612, 18 Wing On Kui  
Shek Po Road


Ping Ha Road, Tin Shui Wai, N.T.

新界天水圍屏廈路石埗路永安居 18 號

Tel (852) 2472 6380

Fax (852) 3905 6158

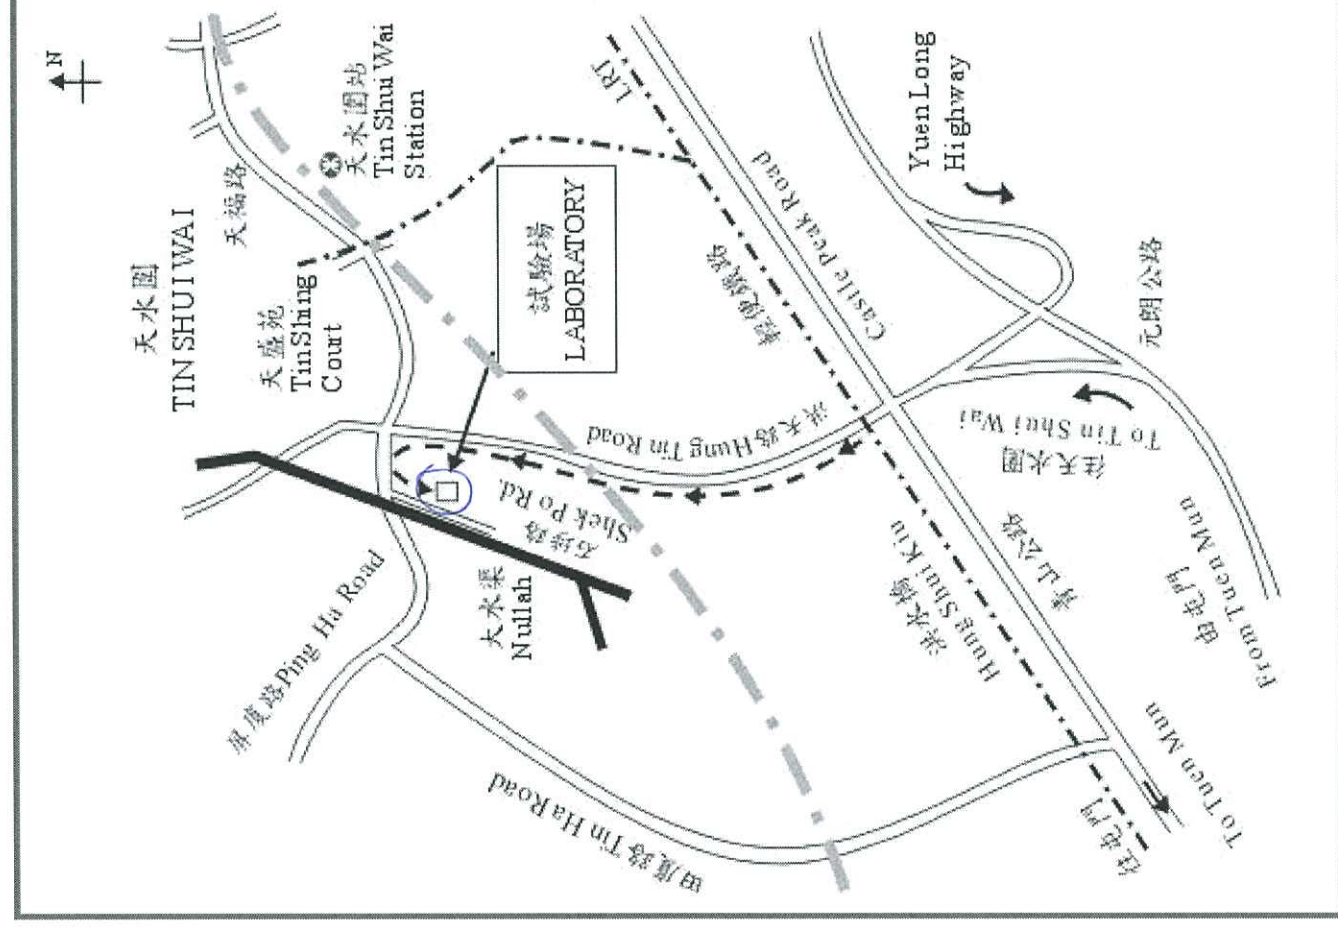

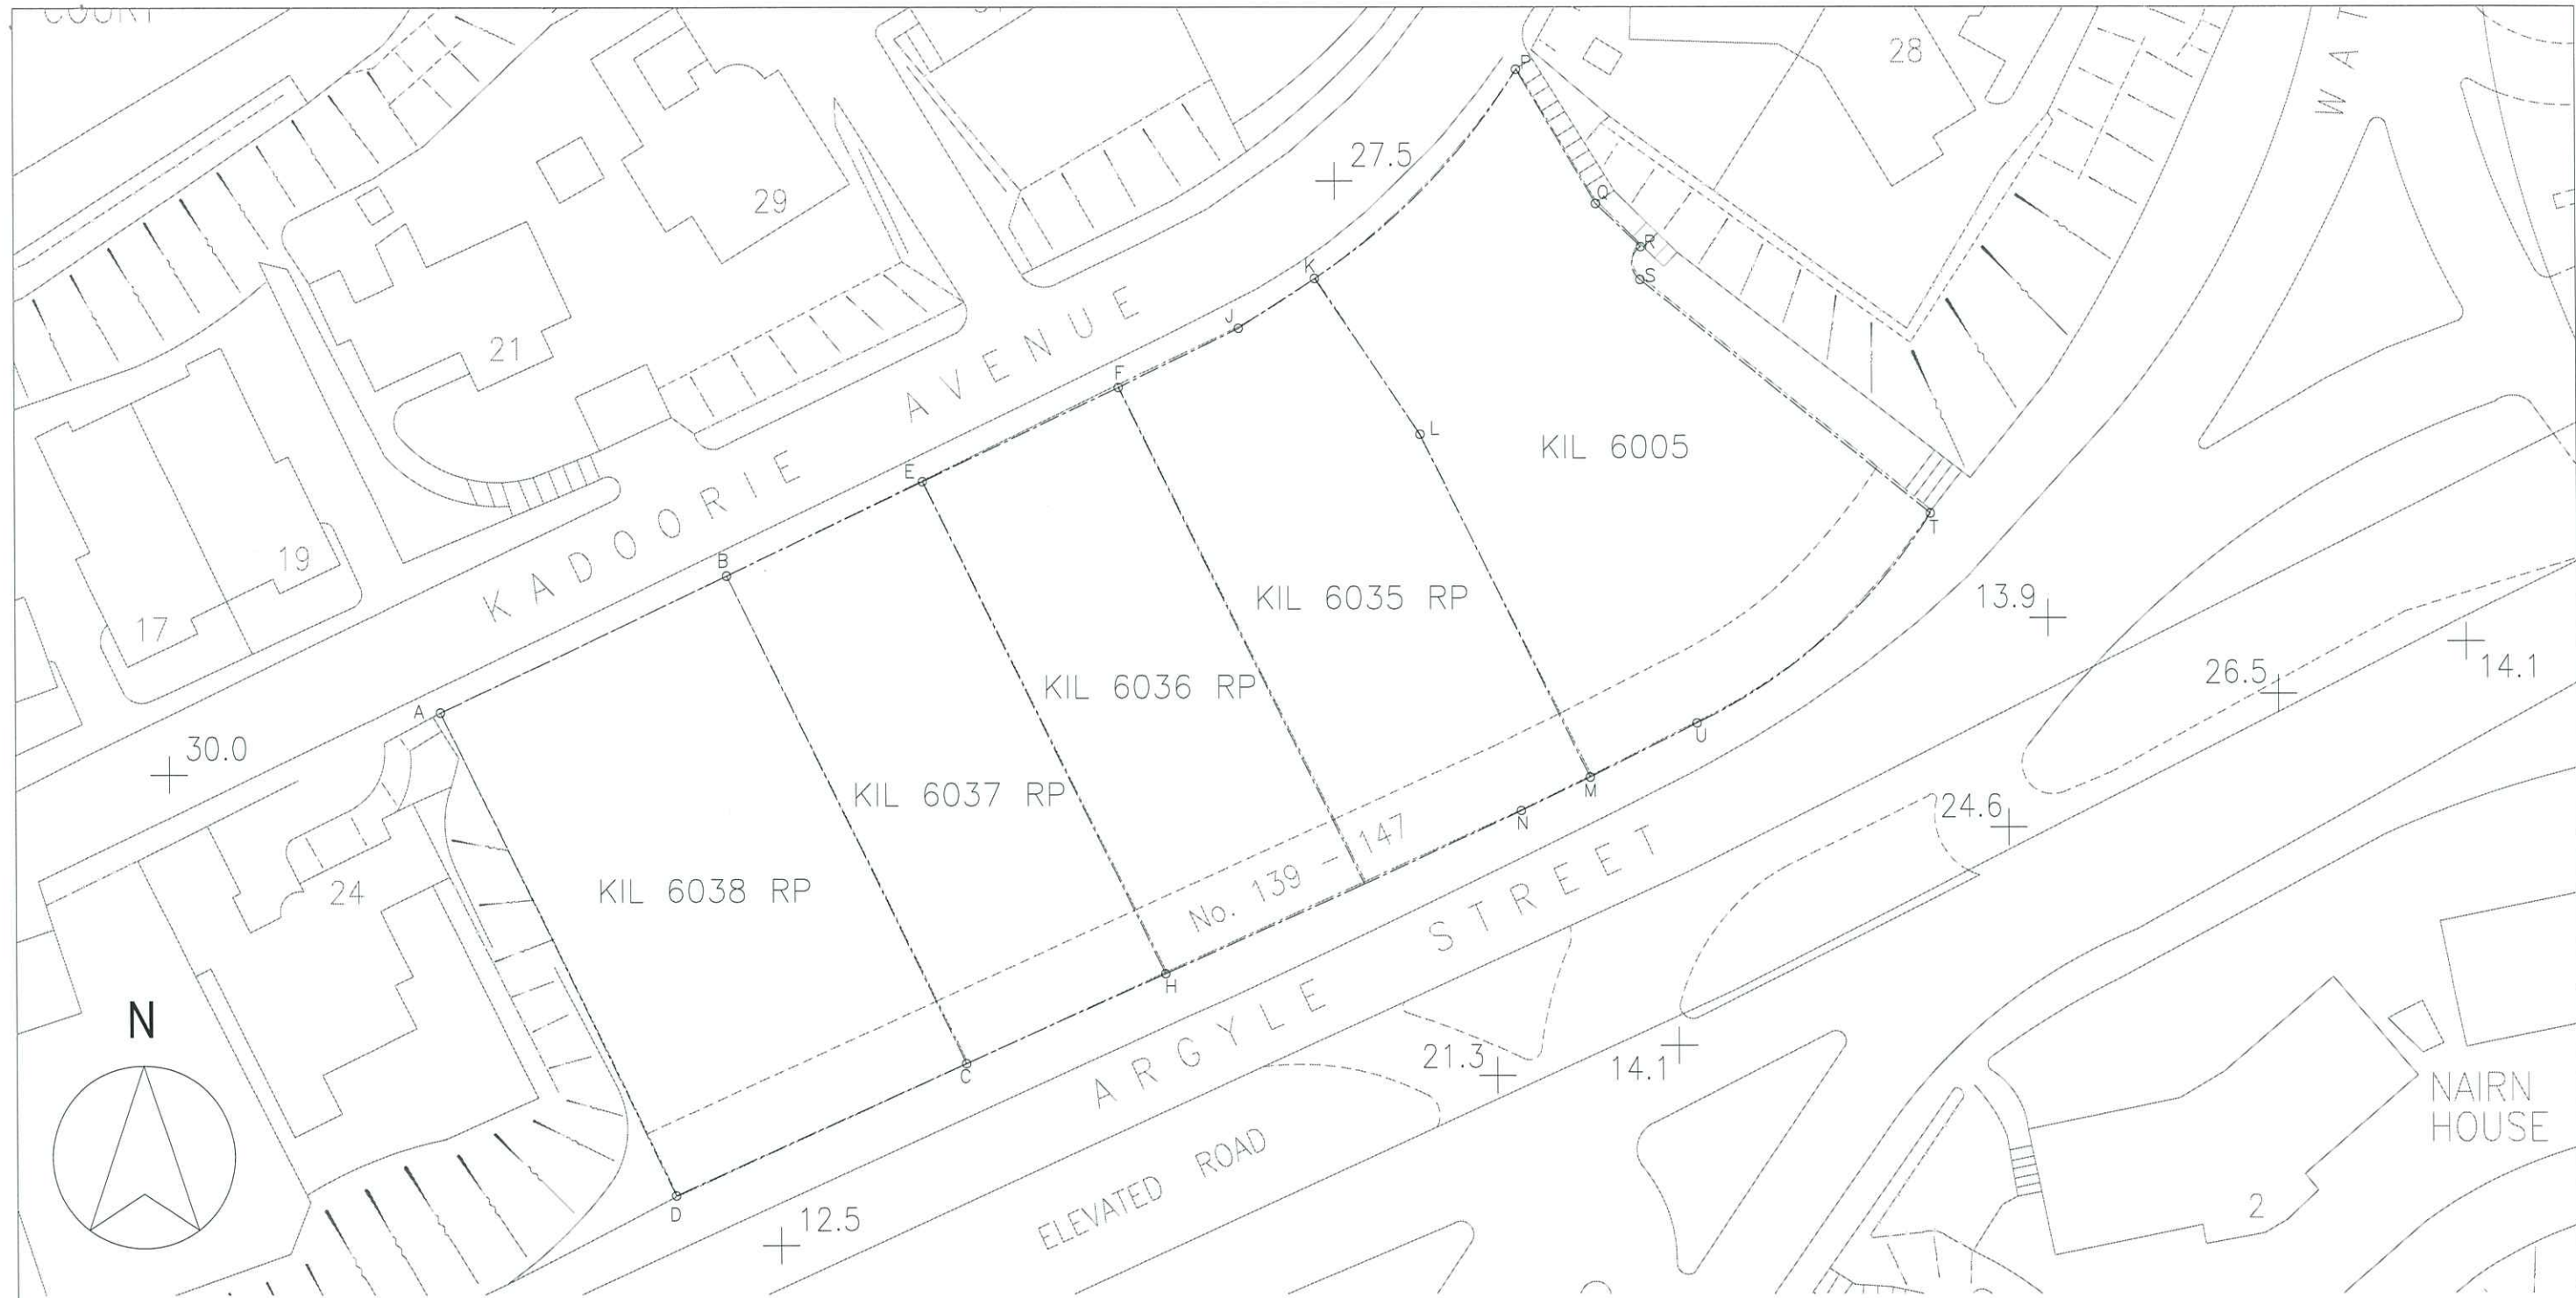



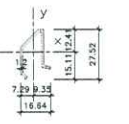
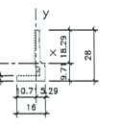
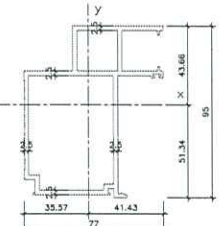
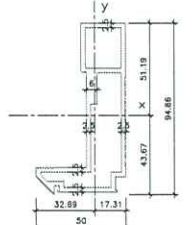
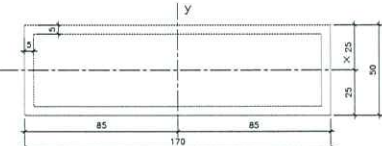
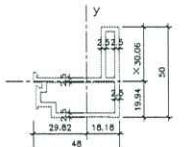
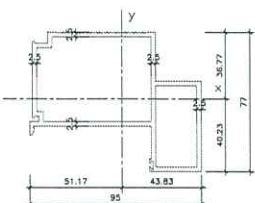
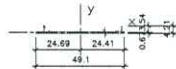
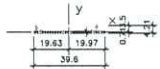
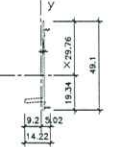
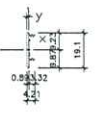
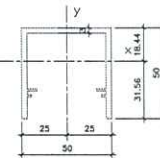
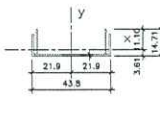
**PROJECT : PROPOSED RESIDENTIAL DEVELOPMENT AT 139 - 147 ARGYLE STREET,  
NKIL 6005, 6035 R.P., 6036 R.P., 6037 R.P. & 6038 R.P.**

**2**

**TITLE : PERFORMANCE TEST OF CURTAIN WALL  
SHOPDRAWING SUBMISSION**

**DATE: 30 - OCT - 2020**

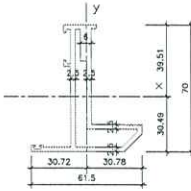

PROPERTIES	PROPERTIES	PROPERTIES	PROPERTIES
<p>MEMBER : AL-PW21 GRADE : 6063-T6 FINISH : PVF2 3-COATING</p>  <p>REGIONS</p> <pre> Area(m2): 651.573222 Perimeter(m): 487.825637 Bounding box(m): X: -30.720347 -- 30.779933 Y: -30.481102 -- 35.513898 Centroid(m): X: 0.000000 Y: 0.000000 Moments of inertia(m4): X: 381187.024841 Y: 154.865699 Product of inertia(m4): XY: -37024.772619 XZ: 187201.21 YZ: 11.891973 Principal moments and X-Y directions about centroid(m4): I: 87470.106204 along C.O. 125166 -0.992136 I: 382861.785336 along C.O. 992136 0.125166 Elastic Modulus(m3): Zx: 1 / y-max= 9647 Zy: 1 / x-max= 2994 </pre>	<p>MEMBER : AL-PW05 GRADE : 6063-T6 FINISH : PVF2 3-COATING</p>  <p>REGIONS</p> <pre> Area(m2): 29.048373 Perimeter(m): 64.812944 Bounding box(m): X: -11.150751 -- 11.149249 Y: -0.955237 -- 0.955237 Centroid(m): X: 0.000000 Y: 0.000000 Moments of inertia(m4): X: 1484.925234 Y: 29.792984 Product of inertia(m4): XY: -0.022335 XZ: 1.025974 YZ: 7.149760 Principal moments and X-Y directions about centroid(m4): I: 29.292984 along C.O. 0.000000 0.000151 I: 1484.925234 along C.O. 0.000151 0.000000 Elastic Modulus(m3): Zx: 1 / y-max= 8 Zy: 1 / x-max= 133 </pre>	<p>MEMBER : AL-PW22 GRADE : 6063-T6 FINISH : PVF2 3-COATING</p>  <p>REGIONS</p> <pre> Area(m2): 69.774414 Perimeter(m): 118.232367 Bounding box(m): X: -7.289921 -- 9.352491 Y: -15.110745 -- 12.412923 Centroid(m): X: 0.000000 Y: 0.000000 Moments of inertia(m4): X: 4068.519848 Y: 2008.876583 Product of inertia(m4): XY: 832.138225 XZ: 7.025974 YZ: 3.362572 Principal moments and X-Y directions about centroid(m4): I: 1716.690397 along C.O. 333210 0.942817 I: 4362.702104 along C.O. 942817 0.333210 Elastic Modulus(m3): Zx: 1 / y-max= 89 Zy: 1 / x-max= 215 </pre>	<p>MEMBER : AL27 GRADE : 6063-T6 FINISH : MILL</p>  <p>REGIONS</p> <pre> Area(m2): 127.267359 Perimeter(m): 94.041743 Bounding box(m): X: -10.727820 -- 8.292180 Y: -5.727653 -- 18.292353 Centroid(m): X: 0.000000 Y: 0.000000 Moments of inertia(m4): X: 9202.818171 Y: 1626.166423 Product of inertia(m4): XY: 1061.091800 XZ: 8.523268 YZ: 3.607393 Principal moments and X-Y directions about centroid(m4): I: 1529.810682 along C.O. 136636 0.990621 I: 9349.177912 along C.O. 990621 0.136636 Elastic Modulus(m3): Zx: 1 / y-max= 223 Zy: 1 / x-max= 155 </pre>
<p>MEMBER : AL01M GRADE : 6063-T6 FINISH : PVF2 3-COATING</p>  <p>REGIONS</p> <pre> Area(m2): 895.813200 Perimeter(m): 741.466387 Bounding box(m): X: -35.371854 -- 41.428146 Y: -51.328927 -- 43.660293 Centroid(m): X: 0.000000 Y: 0.000000 Moments of inertia(m4): X: 92536.802690 Y: 43239.161658 Product of inertia(m4): XY: 19863.497293 XZ: 32.145178 YZ: 22.000398 Principal moments and X-Y directions about centroid(m4): I: 325263.259119 along C.O. 332882 0.942827 I: 995592.670845 along C.O. 942827 0.332882 Elastic Modulus(m3): Zx: 1 / y-max= 1802 Zy: 1 / x-max= 10466 </pre>	<p>MEMBER : AL02M GRADE : 6063-T6 FINISH : PVF2 3-COATING</p>  <p>REGIONS</p> <pre> Area(m2): 604.014928 Perimeter(m): 604.037449 Bounding box(m): X: -32.692599 -- 17.307401 Y: -43.668865 -- 31.189714 Centroid(m): X: 0.000000 Y: 0.000000 Moments of inertia(m4): X: 764979.979776 Y: 69129.473737 Product of inertia(m4): XY: 128856.851288 XZ: 26.845931 YZ: 13.161642 Principal moments and X-Y directions about centroid(m4): I: 113783.064778 along C.O. 194112 0.980979 I: 790477.685119 along C.O. 980979 0.194112 Elastic Modulus(m3): Zx: 1 / y-max= 1484 Zy: 1 / x-max= 4260 </pre>	<p>MEMBER : AL01 GRADE : 6063-T6 FINISH : PVF2 3-COATING</p>  <p>REGIONS</p> <pre> Area(m2): 2100.103009 Perimeter(m): 828.959911 Bounding box(m): X: -85.000000 -- 85.000000 Y: -85.000000 -- 25.000000 Centroid(m): X: 0.000000 Y: 0.000000 Moments of inertia(m4): X: 917533.065479 Y: 69129.473737 Product of inertia(m4): XY: -0.000001 XZ: 908.9121 YZ: 56.978671 Principal moments and X-Y directions about centroid(m4): I: 917533.065479 along C.O. 0.000000 0.000000 I: 69129.473737 along C.O. 0.000000 1.000000 Elastic Modulus(m3): Zx: 1 / y-max= 2870 Zy: 1 / x-max= 60213 </pre>	<p>MEMBER : AL03 GRADE : 6063-T6 FINISH : PVF2 3-COATING</p>  <p>REGIONS</p> <pre> Area(m2): 484.455091 Perimeter(m): 290.825318 Bounding box(m): X: -29.825026 -- 18.179974 Y: -19.376111 -- 30.082399 Centroid(m): X: 0.000000 Y: 0.000000 Moments of inertia(m4): X: 99196.571574 Y: 127418.047018 Product of inertia(m4): XY: 44476.054584 XZ: 14.309394 YZ: 16.217231 Principal moments and X-Y directions about centroid(m4): I: 6644.340225 along C.O. 806935 0.930613 I: 19994.824287 along C.O. 930613 0.806935 Elastic Modulus(m3): Zx: 1 / y-max= 320 Zy: 1 / x-max= 473 </pre>
<p>MEMBER : AL04 GRADE : 6063-T6 FINISH : PVF2 3-COATING</p>  <p>REGIONS</p> <pre> Area(m2): 890.744328 Perimeter(m): 732.436436 Bounding box(m): X: -51.169708 -- 43.830292 Y: -43.232938 -- 36.774702 Centroid(m): X: 0.000000 Y: 0.000000 Moments of inertia(m4): X: 498024.183971 Y: 92529.611653 Product of inertia(m4): XY: -230396.408312 XZ: 32.145178 YZ: 14.782624 Principal moments and X-Y directions about centroid(m4): I: 296286.770287 along C.O. 915103 -0.403219 I: 1022033.025238 along C.O. 403219 0.915103 Elastic Modulus(m3): Zx: 1 / y-max= 1228 Zy: 1 / x-max= 17985 </pre>	<p>MEMBER : AL36 GRADE : 6063-T6 FINISH : PVF2 3-COATING</p>  <p>REGIONS</p> <pre> Area(m2): 54.246227 Perimeter(m): 114.539708 Bounding box(m): X: -24.692540 -- 24.407460 Y: -0.614620 -- 3.937158 Centroid(m): X: 0.000000 Y: 0.000000 Moments of inertia(m4): X: 24.241185 Y: 2165.161630 Product of inertia(m4): XY: 18.827730 XZ: 0.669862 YZ: 14.478225 Principal moments and X-Y directions about centroid(m4): I: 24.241185 along C.O. 999999 0.001037 I: 2165.161630 along C.O. 0.001037 0.999999 Elastic Modulus(m3): Zx: 1 / y-max= 7 Zy: 1 / x-max= 493 </pre>	<p>MEMBER : AL37 GRADE : 6063-T6 FINISH : PVF2 3-COATING</p>  <p>REGIONS</p> <pre> Area(m2): 44.746227 Perimeter(m): 95.529708 Bounding box(m): X: -19.627198 -- 19.972802 Y: -0.711198 -- 3.937158 Centroid(m): X: 0.000000 Y: 0.000000 Moments of inertia(m4): X: 23.200202 Y: 6581.721965 Product of inertia(m4): XY: -18.541739 XZ: 0.702028 YZ: 12.109485 Principal moments and X-Y directions about centroid(m4): I: 23.175995 along C.O. 999999 -0.001918 I: 6561.745962 along C.O. 0.001918 0.999999 Elastic Modulus(m3): Zx: 1 / y-max= 7 Zy: 1 / x-max= 329 </pre>	<p>MEMBER : AL38 GRADE : 6063-T6 FINISH : PVF2 3-COATING</p>  <p>REGIONS</p> <pre> Area(m2): 73.928796 Perimeter(m): 133.487449 Bounding box(m): X: -9.197427 -- 5.017778 Y: -19.338571 -- 29.761429 Centroid(m): X: 0.000000 Y: 0.000000 Moments of inertia(m4): X: 17407.141247 Y: 628.140287 Product of inertia(m4): XY: 1589.629256 XZ: 15.344238 YZ: 8.917127 Principal moments and X-Y directions about centroid(m4): I: 490.809471 along C.O. 0.999371 0.999371 I: 17543.451803 along C.O. 999371 0.000629 Elastic Modulus(m3): Zx: 1 / y-max= 58 Zy: 1 / x-max= 68 </pre>
<p>MEMBER : AL39 GRADE : 6063-T6 FINISH : PVF2 3-COATING</p>  <p>REGIONS</p> <pre> Area(m2): 24.246227 Perimeter(m): 54.239708 Bounding box(m): X: -0.889743 -- 3.321617 Y: -9.889054 -- 9.231096 Centroid(m): X: 0.000000 Y: 0.000000 Moments of inertia(m4): X: 785.844588 Y: 19.804365 Product of inertia(m4): XY: 11.161120 XZ: 5.691982 YZ: 0.903772 Principal moments and X-Y directions about centroid(m4): I: 19.441782 along C.O. 0.145711 0.999894 I: 785.707223 along C.O. 999894 0.145711 Elastic Modulus(m3): Zx: 1 / y-max= 60 Zy: 1 / x-max= 6 </pre>	<p>MEMBER : AL41 GRADE : 6063-T6 FINISH : PVF2 3-COATING</p>  <p>REGIONS</p> <pre> Area (mm2): 448.85 Perimeter (mm): 324.45 Bounding Box - X (mm): -25.00 to 25.00 Bounding Box - Y (mm): -31.56 to 18.44 Centroid - X (mm): 0.00 Centroid - Y (mm): 0.00 Moments of inertia - X (mm4): 117911.08 Moments of inertia - Y (mm4): 192510.04 Product of inertia - XY (mm4): 0.00 Radii of gyration - X (mm): 16.82 Radii of gyration - Y (mm): 20.78 Principal moments along X-Y (mm4): 117911.08 along C.O. 0.00 1.00 Principal moments along Y-X (mm4): 192510.04 along C.O. 0.00 1.00 Elastic Modulus - Zx (mm3): 1 / y-max= 3725.89 Elastic Modulus - Zy (mm3): 1 / x-max= 3746.49 </pre>	<p>MEMBER : AL42 GRADE : 6063-T6 FINISH : PVF2 3-COATING</p>  <p>REGIONS</p> <pre> Area (mm2): 82.85 Perimeter (mm): 187.81 Bounding Box - X (mm): -21.90 to 21.90 Bounding Box - Y (mm): -3.61 to 11.10 Centroid - X (mm): 0.00 Centroid - Y (mm): 0.00 Moments of inertia - X (mm4): 1412.29 Moments of inertia - Y (mm4): 23195.60 Product of inertia - XY (mm4): 0.38 Radii of gyration - X (mm): 14.12 Radii of gyration - Y (mm): 15.76 Principal moments along X-Y (mm4): 1412.29 along C.O. 0.00 1.00 Principal moments along Y-X (mm4): 23195.60 along C.O. 0.00 1.00 Elastic Modulus - Zx (mm3): 1 / y-max= 127.20 Elastic Modulus - Zy (mm3): 1 / x-max= 1059.13 </pre>	

B.D. REF :

CLIENT :

ARCHITECT :  
**AGC DESIGN LTD**

MAIN CONTRACTOR :  
**Gammon**

STRUCTURAL ENGINEER :  
**ARUP**

FAÇADE CONSULTANT :  
**MEIN-HARDT**

NOTE :  
1. ALL DIMENSIONS ARE IN mm.  
2. ALL ELEVATIONS ARE VIEWED FROM OUTSIDE.  
3. ALL DIMENSIONS TO BE VERIFIED ON SITE BEFORE FABRICATION.

LEGEND :  
X1 --- DETAIL MARK NO.  
X001 --- REFER SHEET NO.

1. F.F.L. --- FINISHED FLOOR LEVEL  
2. S.F.L. --- STRUCTURAL FLOOR LEVEL  
3. (R) --- REVERSED DETAIL

NO.	DATE	REVISED	BY

JOB NO. : J-852

PROJECT : PROPOSED RESIDENTIAL DEVELOPMENT AT 139 - 147 ARGYLE STREET, NKIL 6005, 6035 R.P., 6036 R.P., 6037 R.P. & 6038 R.P.

TITLE : SECTION PROPERTIES OF PERFORMANCE TEST FOR CURTAIN WALL (ALUM. EXTRUSIONS)

DATE : 13-Jul-20 SCALE : 1:40

DRAWN BY : LHR CHECKED BY : DW

**美特铝质有限公司**  
MIDI ALUMINIUM FABRICATOR LTD.  
Units 6-8, Sunray Industrial Centre, 1/F  
610 Cha Kwo Ling Road, Kowloon  
Tel: 23489211-4 Fax: (852) 27276666

DWG NO. : J852-SD-PT-1101 REV. : -

MEMBER : AL11  
GRADE : 6063-T6  
FINISH : MILL

REGIONS

Area(m <sup>2</sup> ):	2424.115046
Perimeter(m):	441.464125
Bounding box(m):	X: -41.091593 -- 83.908407
	Y: -22.300000 -- 22.300000
Centroid(m):	X: 0.000000
	Y: 0.000000
Moments of inertia(m <sup>4</sup> ):	X: 1459896.203098
	Y: 376896.371678
Product of inertia(m <sup>4</sup> ):	XY: 1364852.325923
Radius of gyration(m):	X: 24.320564
	Y: 39.430861
Principal moments and X-Y directions about centroid(m <sup>4</sup> ):	I: 825922.892413 along [0.907194 0.420713]
	J: 4401949.884853 along [-0.420713 0.907194]
Elastic Modulus(m <sup>3</sup> ):	Zx: 1 / y-max= 23231
	Zy: 1 / x-max= 44918

MEMBER : AL12  
GRADE : 6063-T6  
FINISH : MILL

REGIONS

Area(m <sup>2</sup> ):	264.923682
Perimeter(m):	108.079759
Bounding box(m):	X: -4.072294 -- 3.427706
	Y: -20.000000 -- 20.000000
Centroid(m):	X: 0.000000
	Y: 0.000000
Moments of inertia(m <sup>4</sup> ):	X: 39524.801336
	Y: 1009.337333
Product of inertia(m <sup>4</sup> ):	XY: 0.000000
Radius of gyration(m):	X: 11.979819
	Y: 1.945029
Principal moments and X-Y directions about centroid(m <sup>4</sup> ):	I: 1026.337333 along [0.000000 -1.000000]
	J: 39524.801336 along [1.000000 0.000000]
Elastic Modulus(m <sup>3</sup> ):	Zx: 1 / y-max= 1776
	Zy: 1 / x-max= 247

MEMBER : AL13  
GRADE : 6063-T6  
FINISH : MILL

REGIONS

Area(m <sup>2</sup> ):	1096.010000
Perimeter(m):	256.825625
Bounding box(m):	X: -4.113977 -- 5.386023
	Y: -51.000000 -- 51.000000
Centroid(m):	X: 0.000000
	Y: 0.000000
Moments of inertia(m <sup>4</sup> ):	X: 92626.772483
	Y: 12649.219787
Product of inertia(m <sup>4</sup> ):	XY: 0.000000
Radius of gyration(m):	X: 30.431000
	Y: 3.117106
Principal moments and X-Y directions about centroid(m <sup>4</sup> ):	I: 12649.219787 along [0.000000 -1.000000]
	J: 92626.772483 along [1.000000 0.000000]
Elastic Modulus(m <sup>3</sup> ):	Zx: 1 / y-max= 1840
	Zy: 1 / x-max= 1742

MEMBER : AL14  
GRADE : 6063-T6  
FINISH : MILL

REGIONS

Area (mm <sup>2</sup> ):	421.20
Perimeter (mm):	152.40
Bounding Box - X (mm):	-11.71 to 26.39
Bounding Box - Y (mm):	-11.71 to 26.39
Centroid - X (mm):	0.00
Centroid - Y (mm):	0.00
Moments of Inertia - X (mm <sup>4</sup> ):	55158.36
Moments of Inertia - Y (mm <sup>4</sup> ):	55158.36
Product of Inertia - XY (mm <sup>4</sup> ):	31902.54
Radius of gyration - X (mm):	11.44
Radius of gyration - Y (mm):	11.44
Principal moments along X-Y (mm <sup>4</sup> ):	23197.82 along [0.71 -0.71]
Principal moments along X-X (mm <sup>4</sup> ):	8718.90 along [0.71 0.71]
Elastic Modulus - Xx (mm <sup>3</sup> ):	1 / y-max= 2000.18
Elastic Modulus - Yy (mm <sup>3</sup> ):	1 / x-max= 2000.18

B.D. REF :

CLIENT :

ARCHITECT :

MAIN CONTRACTOR :

STRUCTURAL ENGINEER :

FACADE CONSULTANT:

NOTE :

- ALL DIMENSIONS ARE IN mm.
- ALL ELEVATIONS ARE VIEWED FROM OUTSIDE.
- ALL DIMENSIONS TO BE VERIFIED ON SITE BEFORE FABRICATION.

LEGEND :

X1 — DETAIL MARK NO.  
X001 — REFER SHEET NO.

- F.F.L. -- FINISHED FLOOR LEVEL
- S.F.L. -- STRUCTURAL FLOOR LEVEL
- (/R) -- REVERSED DETAIL

NO.	DATE	REVISED	BY
-----	------	---------	----

JOB NO. : J-852

PROJECT : PROPOSED RESIDENTIAL DEVELOPMENT AT 139 - 147 ARGYLE STREET, NKIL 6005, 6035 R.P., 6036 R.P., 6037 R.P. & 6038 R.P.

TITLE : SECTION PROPERTIES OF PERFORMANCE TEST FOR CURTAIN WALL (ALUM. EXTRUSIONS)

DATE : 13-JUL-20 SCALE : 1:40


DRAWN BY : LHR CHECKED BY : DW

MIDI ALUMINIUM FABRICATOR LTD.  
Units 6-8, Sunray Industrial Centre, 1/F  
610 Cha Kwo Ling Road, Kowloon  
Tel: 23489211-4 Fax: (852) 27727666

DWG NO. : J852-SD-PT-1102 REV. : -

PROPERTIES


MEMBER : 200x160x12mm THK, G.M.S. ANGLE  
 GRADE : S275J0  
 FINISH : MILL

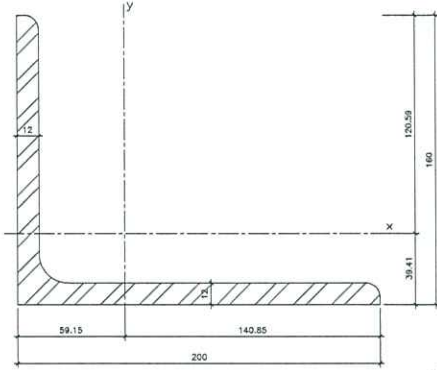

REGIONS	
Area (mm <sup>2</sup> ):	4223.47
Perimeter (mm):	708.27
Bounding Box - X (mm):	-59.15 to 142.85
Bounding Box - Y (mm):	-39.41 to 122.59
Centroid - X (mm):	0.00
Centroid - Y (mm):	0.00
Moment of inertia - X (mm <sup>4</sup> ):	1620581.74
Moment of inertia - Y (mm <sup>4</sup> ):	1842554.42
Product of inertia - XY (mm <sup>4</sup> ):	7420527.08
Radius of gyration - X (mm):	47.87
Radius of gyration - Y (mm):	63.31
Principal moments along X-Y (mm <sup>4</sup> ):	4323346.15 along [0.85 -0.53]
Principal moments along Y-X (mm <sup>4</sup> ):	21546280.01 along [0.53 0.85]
Elastic Modulus - Zx (mm <sup>3</sup> ):	1 / y-max= 79855.55
Elastic Modulus - Zy (mm <sup>3</sup> ):	1 / x-max= 11830.50

PROPERTIES


 GRADE : S275J0  
 FINISH : MILL

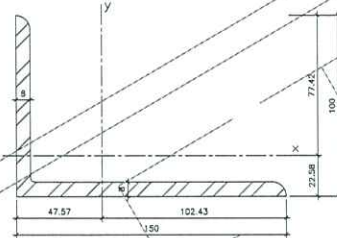

REGIONS	
Area (mm <sup>2</sup> ):	1829.39
Perimeter (mm):	492.37
Bounding Box - X (mm):	-47.57 to 102.43
Bounding Box - Y (mm):	-27.58 to 77.42
Centroid - X (mm):	0.00
Centroid - Y (mm):	0.00
Moment of inertia - X (mm <sup>4</sup> ):	1584240.52
Moment of inertia - Y (mm <sup>4</sup> ):	439230.33
Product of inertia - XY (mm <sup>4</sup> ):	1202043.19
Radius of gyration - X (mm):	28.80
Radius of gyration - Y (mm):	47.98
Principal moments along X-Y (mm <sup>4</sup> ):	864704.72 along [0.91 -0.41]
Principal moments along Y-X (mm <sup>4</sup> ):	5082172.34 along [0.41 0.91]
Elastic Modulus - Zx (mm <sup>3</sup> ):	1 / y-max= 20463.35
Elastic Modulus - Zy (mm <sup>3</sup> ):	1 / x-max= 42884.42

PROPERTIES

 GRADE : S275J0  
 FINISH : MILL



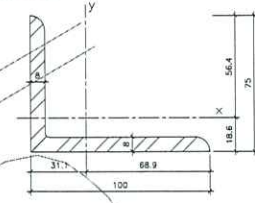


REGIONS	
Area (mm <sup>2</sup> ):	329.39
Perimeter (mm):	342.27
Bounding Box - X (mm):	-31.10 to 68.90
Bounding Box - Y (mm):	-18.60 to 56.40
Centroid - X (mm):	0.00
Centroid - Y (mm):	0.00
Moment of inertia - X (mm <sup>4</sup> ):	93252.12
Moment of inertia - Y (mm <sup>4</sup> ):	278946.79
Product of inertia - XY (mm <sup>4</sup> ):	32009.34
Radius of gyration - X (mm):	21.84
Radius of gyration - Y (mm):	31.25
Principal moments along X-Y (mm <sup>4</sup> ):	15173.05 along [0.89 -0.48]
Principal moments along Y-X (mm <sup>4</sup> ):	136511.33 along [0.48 0.89]
Elastic Modulus - Zx (mm <sup>3</sup> ):	1 / y-max= 5873.10
Elastic Modulus - Zy (mm <sup>3</sup> ):	1 / x-max= 18513.33

B.D. REF :

CLIENT :

ARCHITECT :  
**AGC DESIGN LTD**  
 181, 183, 185,3557

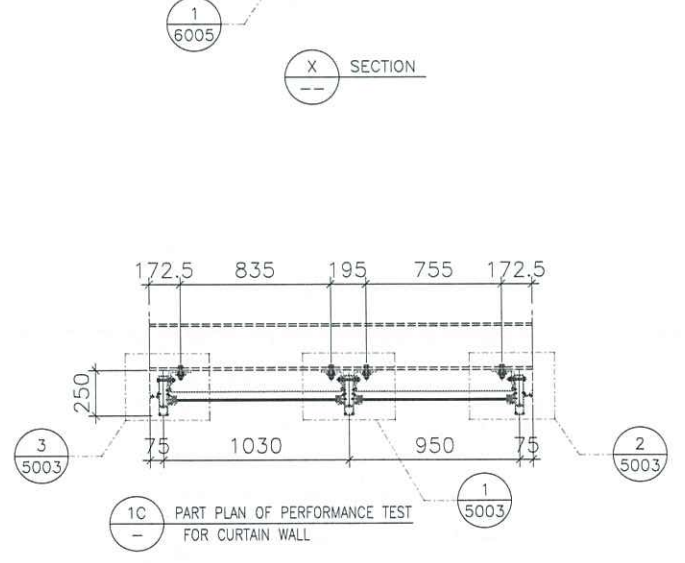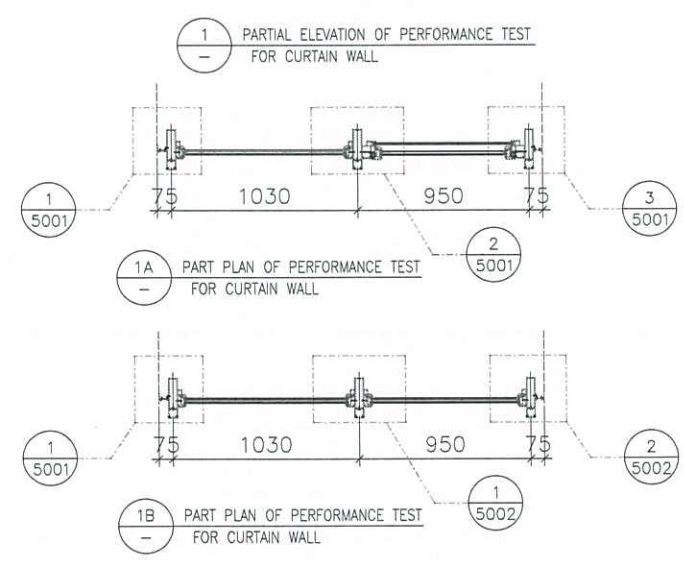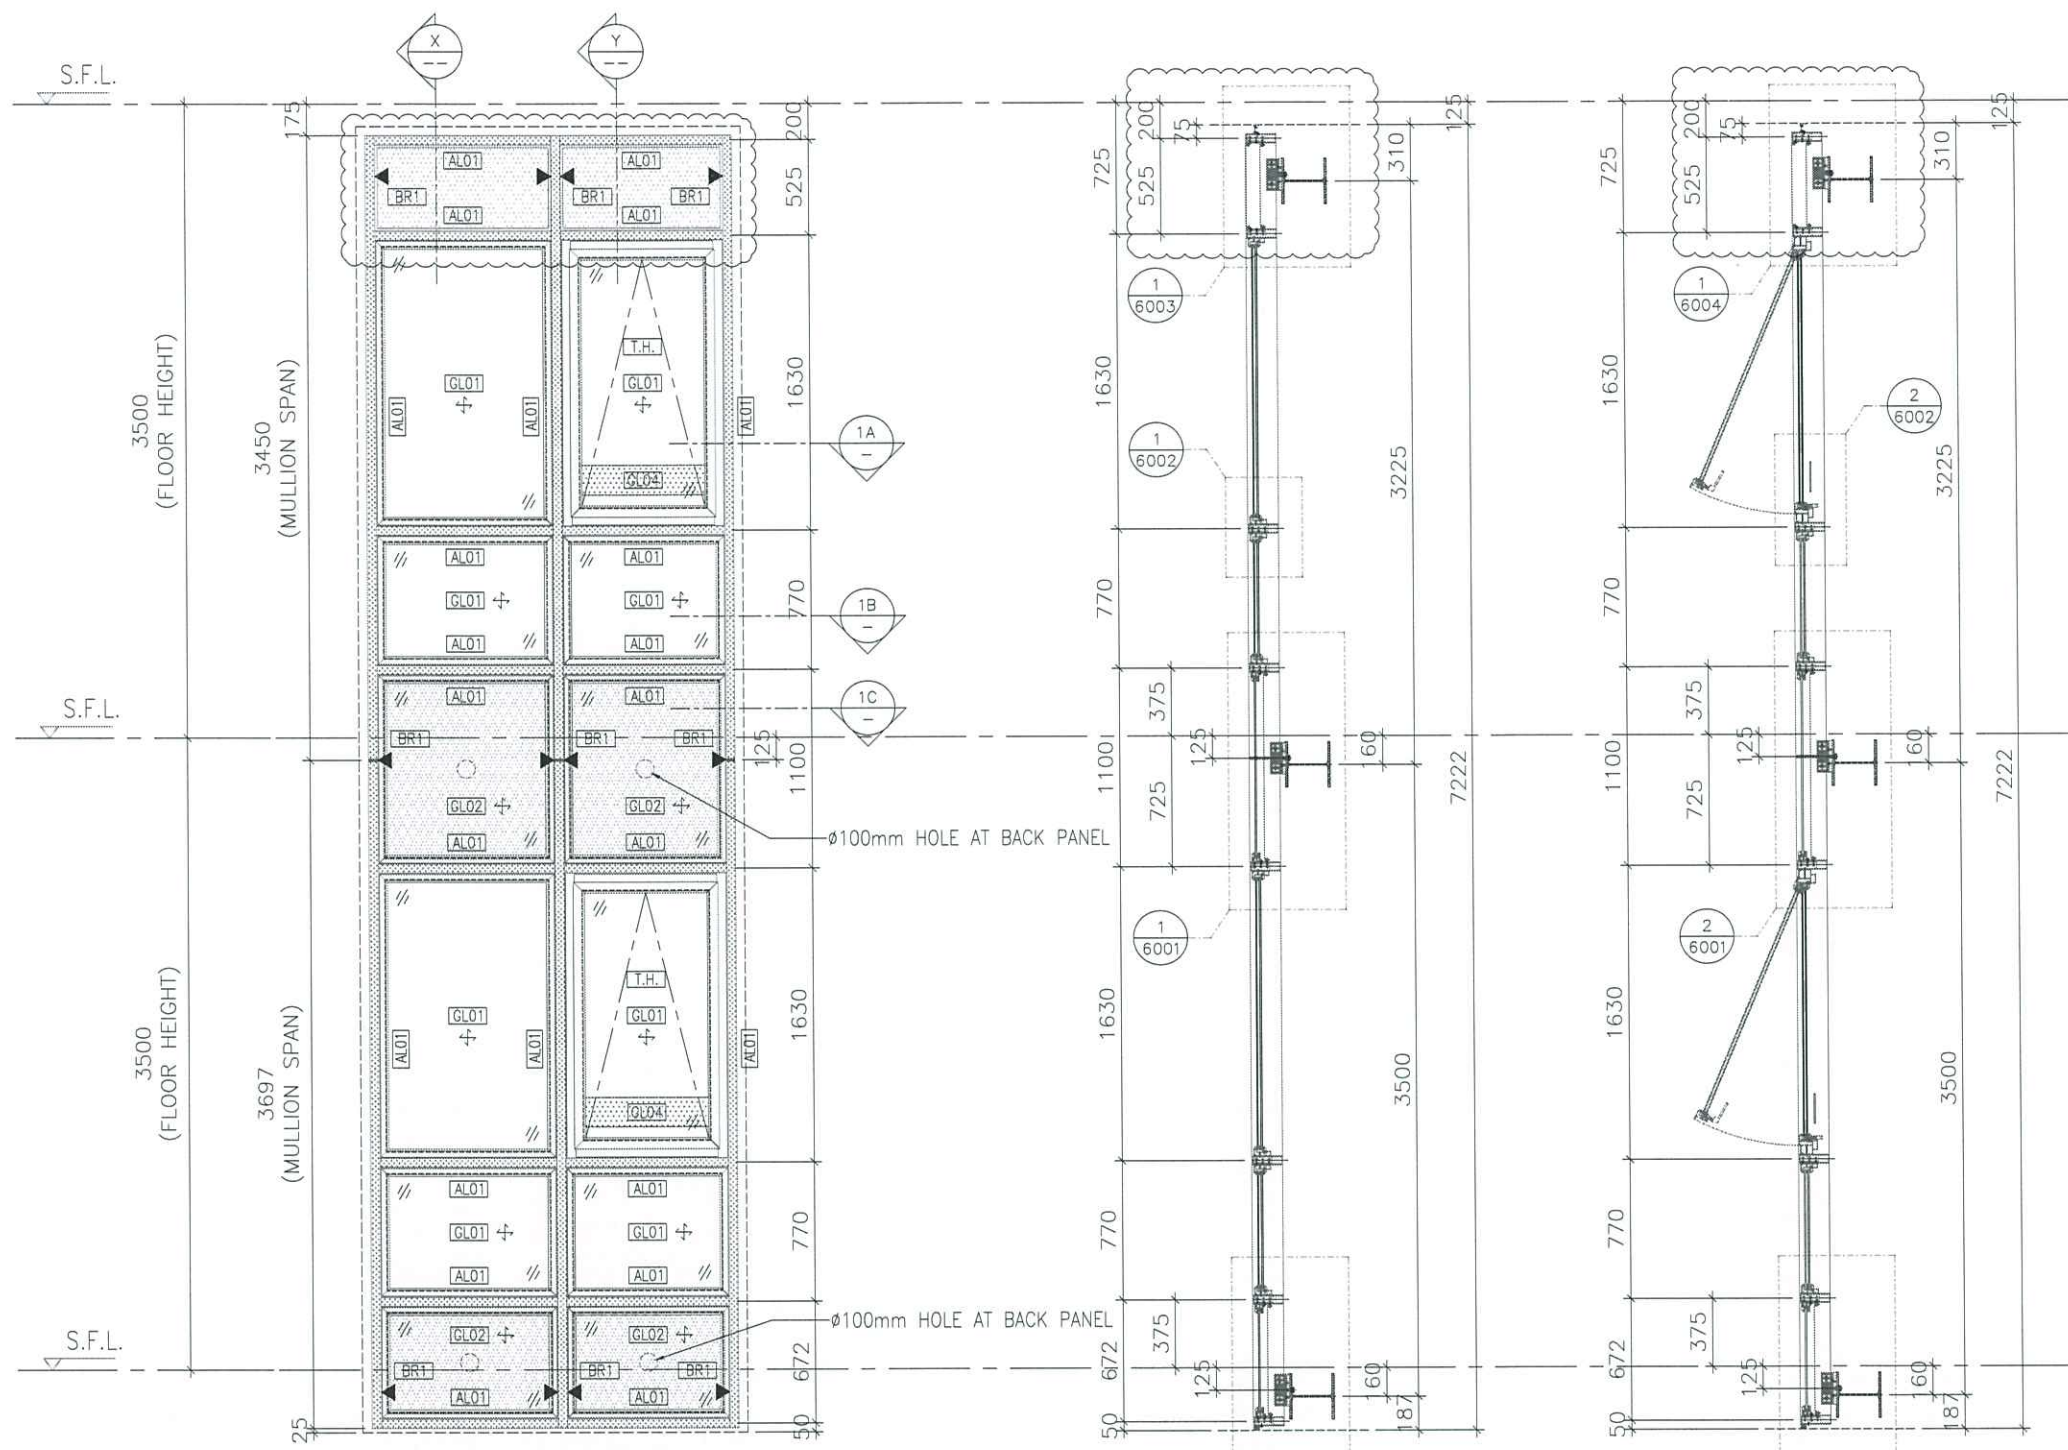

B.D. REF :

CLIENT :

ARCHITECT :  
**AGC DESIGN LTD**  

MAIN CONTRACTOR :  
**Gammon**

STRUCTURAL ENGINEER :  
**ARUP**

FAÇADE CONSULTANT:  
**MEIN-HARDT**

NOTE :  
 1. ALL DIMENSIONS ARE IN mm.  
 2. ALL ELEVATIONS ARE VIEWED FROM OUTSIDE.  
 3. ALL DIMENSIONS TO BE VERIFIED ON SITE BEFORE FABRICATION.

LEGEND :  
 X1 — DETAIL MARK NO.  
 X001 — REFER SHEET NO.

1. F.F.L. — FINISHED FLOOR LEVEL  
 2. S.F.L. — STRUCTURAL FLOOR LEVEL  
 3. (B) — REVERSED DETAIL  
 4. GLASS LEGEND  
 AL01 ALUM EXTRUSION MARK: REFER TO DRAWING: 1101&1102  
 GL01 (VISION GLASS): 8mm HEAT STRENGTHENED+12mm AIR GAP +10mm THK. CLEAR TEMPERED I.G.U.  
 GL02 (SPANDREL GLASS): 10mm THK. HEAT STRENGTHENED GLASS  
 GL04 (PROTECTIVE BARRIER): 10mm THK. TEMPERED GLASS  
 + GLASS SPAN DIRECTION  
 5. FIXING LOCATION  
 (BR1) FIXING LOCATION

A	28-10-2020	REVISION SUBJECT TO ARCH. COMMENT	MN
NO.	DATE	REVISED	BY

JOB NO. : J-852

PROJECT :  
 PROPOSED RESIDENTIAL DEVELOPMENT  
 AT 139 - 147 ARGYLE STREET,  
 NKIL 6005, 6035 R.P., 6036 R.P.,  
 6037 R.P. & 6038 R.P.


TITLE :  
 ELEVATION  
 OF PERFORMANCE TEST  
 FOR CURTAIN WALL

DATE : 13-Jul-20 SCALE : 1:40


DRAWN BY : LHR CHECKED BY : DW

**美特鋁質有限公司**  
**MIDI ALUMINIUM FABRICATOR LTD.**  
 Units 6-8, Sunny Industrial Centre, 1/F  
 610 Cha Kwo Ling Road, Kowloon  
 Tel: 23489211-4 Fax: (852)27727666


DWG NO. : JB52-SD-PT-4001 REV. : A

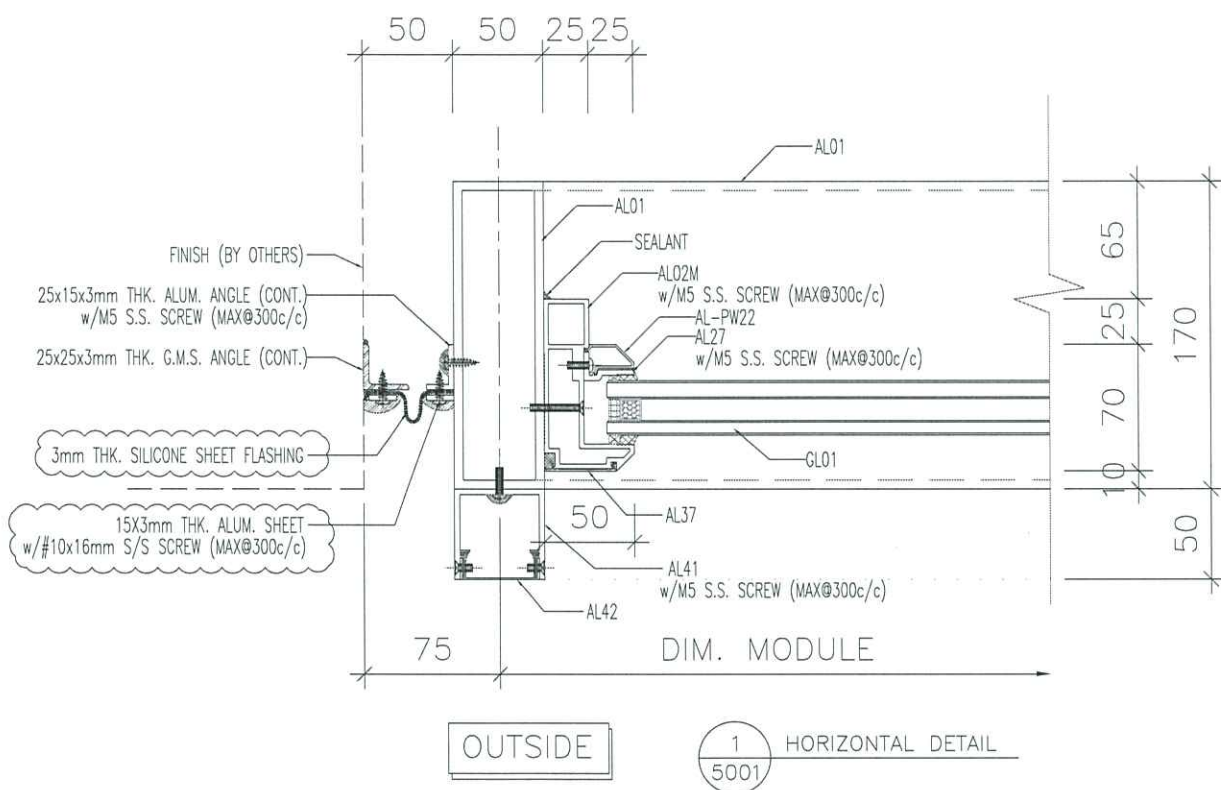

1 HORIZONTAL DETAIL  
5001

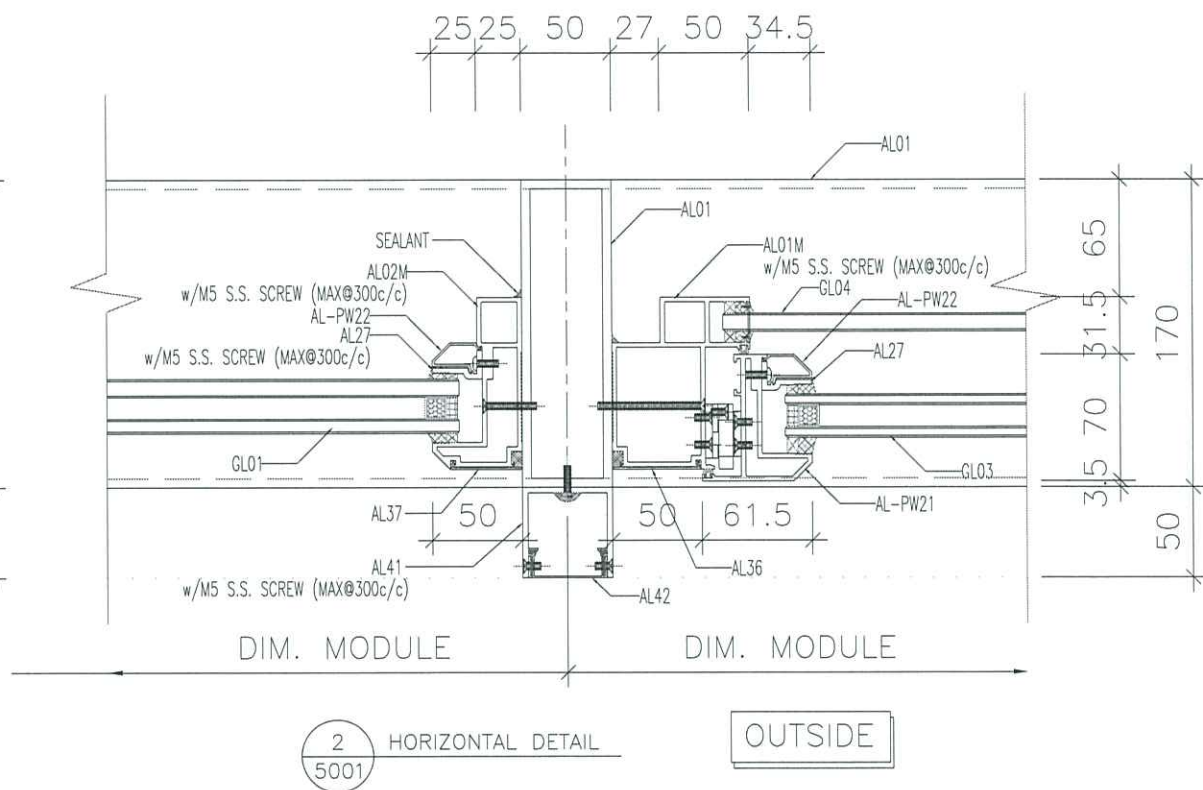

2 HORIZONTAL DETAIL  
5001

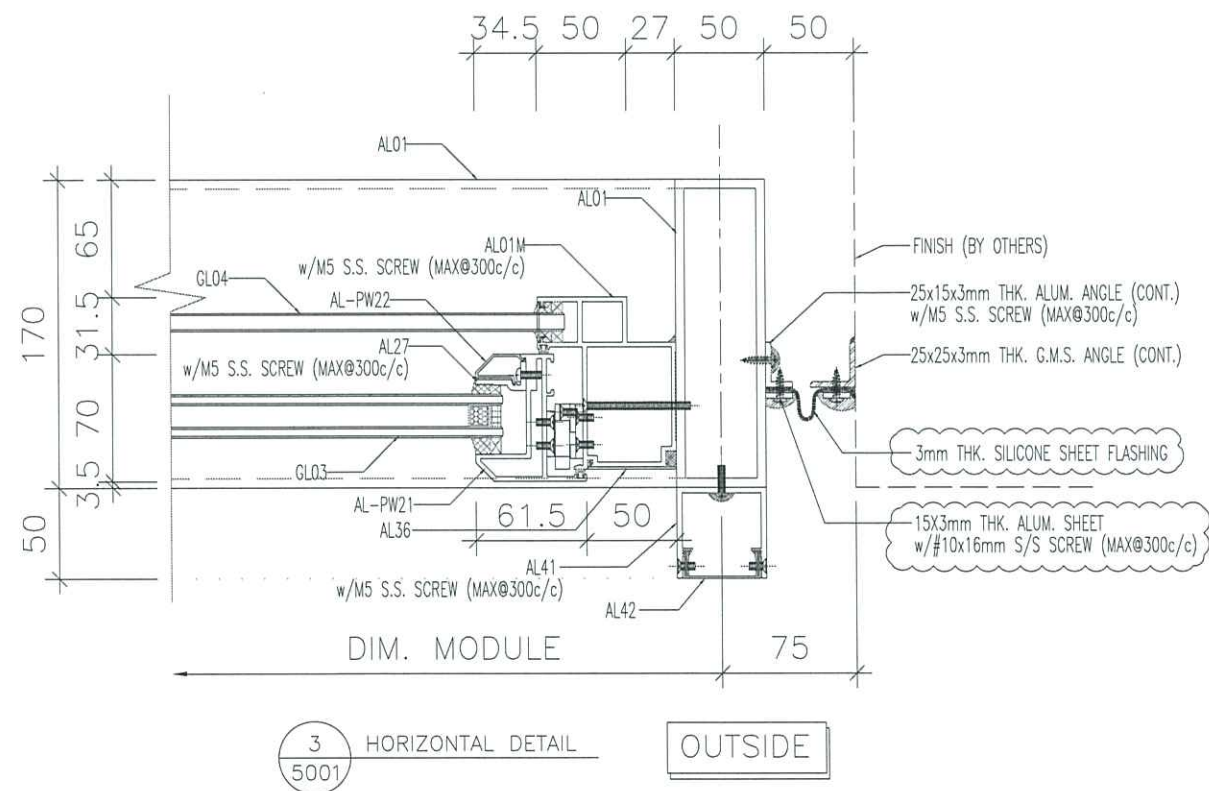

3 HORIZONTAL DETAIL  
5001

B.D. REF :  
CLIENT :

ARCHITECT :  
**AGC DESIGN LTD**

MAIN CONTRACTOR :  
**Gammon**

STRUCTURAL ENGINEER :  
**ARUP**

FACADE CONSULTANT :  
**MEIN-HARDT**

NOTE :  
1. ALL DIMENSIONS ARE IN mm.  
2. ALL ELEVATIONS ARE VIEWED FROM OUTSIDE.  
3. ALL DIMENSIONS TO BE VERIFIED ON SITE BEFORE FABRICATION.

LEGEND :  
X1 — DETAIL MARK NO.  
X001 — REFER SHEET NO.  
1. F.F.L. — FINISHED FLOOR LEVEL  
2. S.F.L. — STRUCTURAL FLOOR LEVEL  
3. (B) — REVERSED DETAIL  
4. GLASS LEGEND  
AL01 ALUM EXTRUSION MARK: REFER TO DRAWING: 1101&1102  
GLO1 (VISION GLASS): 8mm HEAT STRENGTHENED+12mm AIR GAP +10mm THK. CLEAR TEMPERED I.G.U.  
GLO2 (SPANDREL GLASS): 10mm THK. HEAT STRENGTHENED GLASS  
GLO4 (PROTECTIVE BARRIER): 10mm THK. TEMPERED GLASS  
+ GLASS SPAN DIRECTION  
5. FIXING LOCATION  
BRT FIXING LOCATION


A	28-10-2020	REVISION SUBJECT TO COMMENTS	MN
NO.	DATE	REVISION	BY

JOB NO. : J-852  
PROJECT : PROPOSED RESIDENTIAL DEVELOPMENT AT 139 - 147 ARGYLE STREET, NKIL 6005, 6035 R.P., 6036 R.P., 6037 R.P. & 6038 R.P.


TITLE : TYPICAL DETAILS FOR CURTAIN WALL

DATE : 13-Jul-20 SCALE : 1:4  
DRAWN BY : LHR CHECKED BY : DW


**美特鋁質有限公司**  
**MIDI ALUMINIUM FABRICATOR LTD.**  
Units 6-8, Sunray Industrial Centre, 1/F  
610 Cha Kwo Ling Road, Kowloon  
Tel:23489211-4 Fax:(852)2727666  
DWG NO. : J852-SD-PT-5001 REV. : A

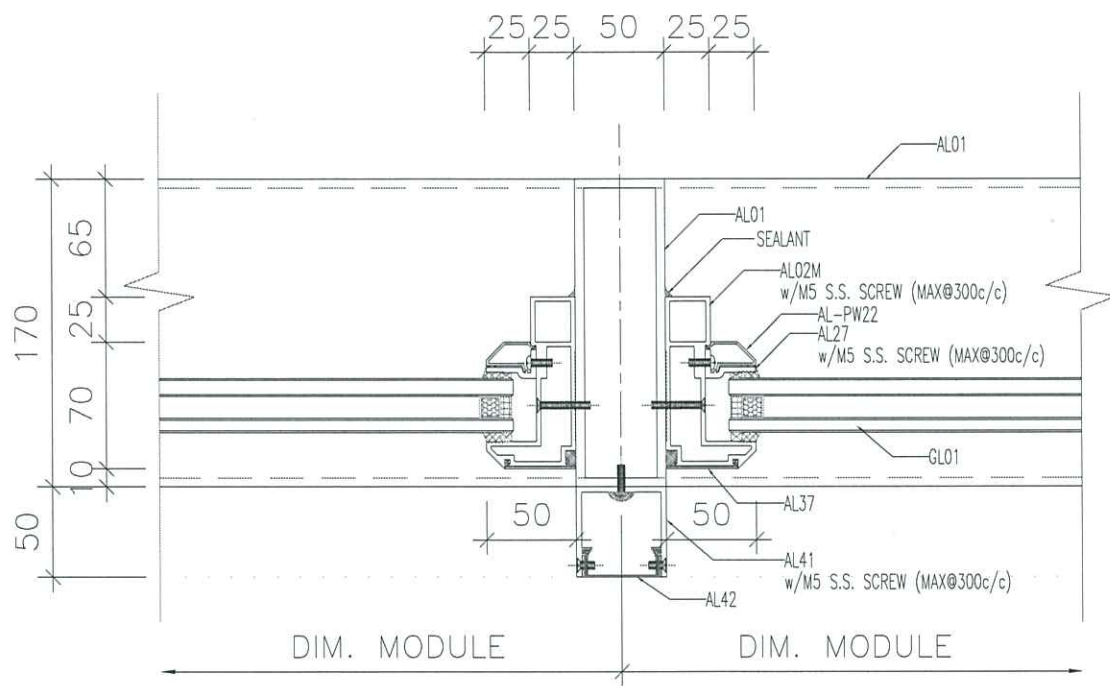

1 HORIZONTAL DETAIL OUTSIDE  
5002

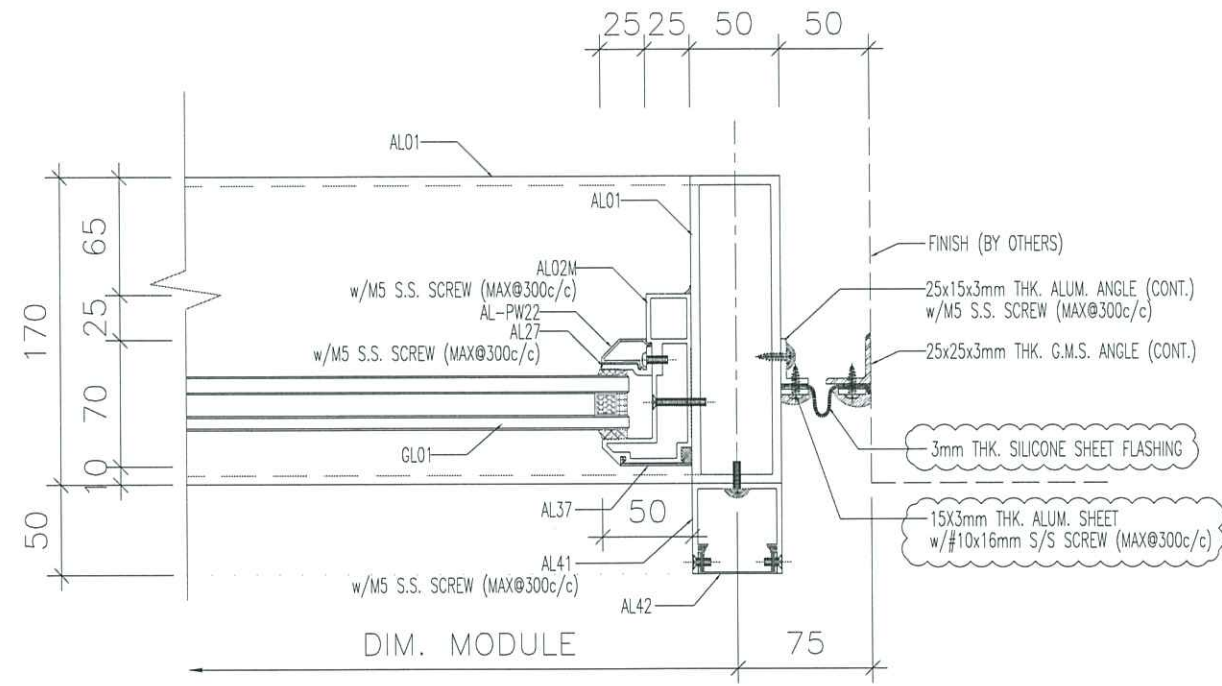

2 HORIZONTAL DETAIL OUTSIDE  
5002

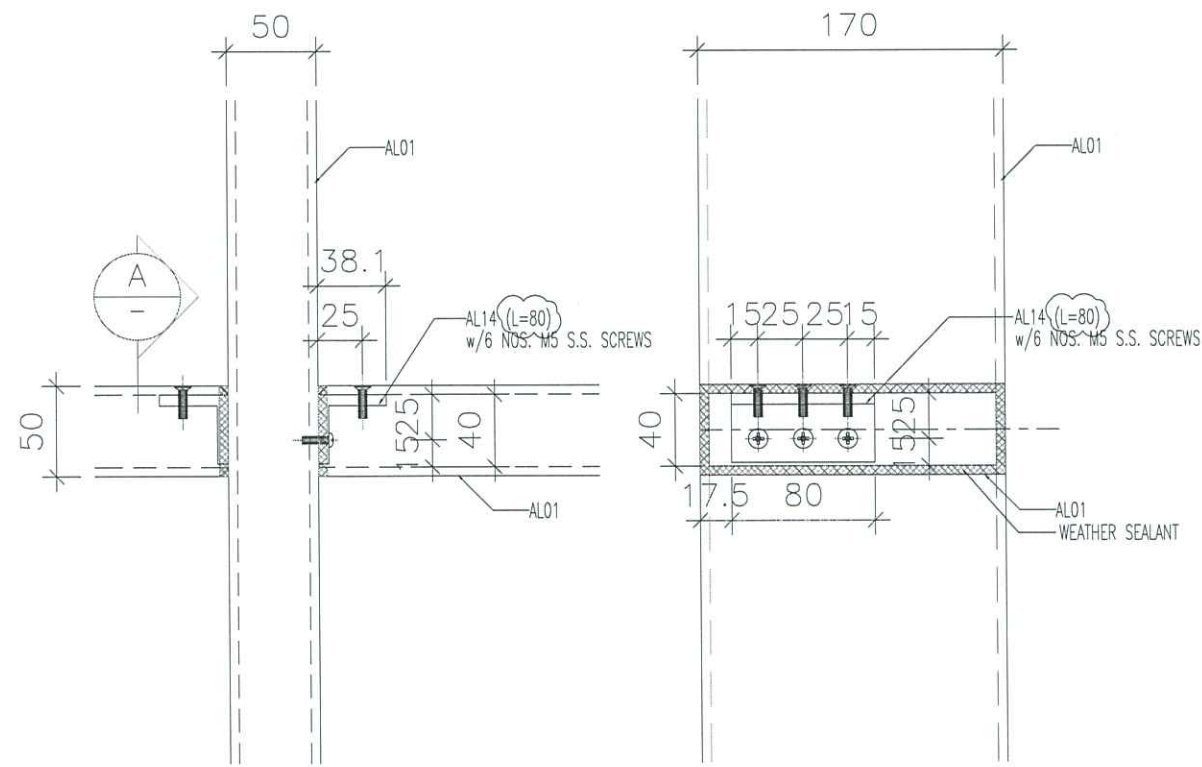

3 CONNECTION DETAIL MULLION & TRANSOM  
5002

B.D. REF :

CLIENT :

ARCHITECT :  
**AGC DESIGN LTD**

MAIN CONTRACTOR :  
**Gammon**

STRUCTURAL ENGINEER :  
**ARUP**

FACADE CONSULTANT :  
**MEINHARDT**

NOTE :  
1. ALL DIMENSIONS ARE IN mm.  
2. ALL ELEVATIONS ARE VIEWED FROM OUTSIDE.  
3. ALL DIMENSIONS TO BE VERIFIED ON SITE BEFORE FABRICATION.

LEGEND :

X1 - DETAIL MARK NO.  
X001 - REFER SHEET NO.

1. F.F.L. -- FINISHED FLOOR LEVEL  
2. S.F.L. -- STRUCTURAL FLOOR LEVEL  
3. (R) -- REVERSED DETAIL

4. GLASS LEGEND  
[AL01] ALUM EXTRUSION MARK: REFER TO DRAWING: 1101&1102  
[GLO1] GLO1 (VISION GLASS): 8mm HEAT STRENGTHENED+12mm AIR GAP +10mm THK. CLEAR TEMPERED I.G.U.  
[GLO2] GLO2 (SPANDREL GLASS): 10mm THK. HEAT STRENGTHENED GLASS  
[GLO4] GLO4 (PROTECTIVE BARRIER): 10mm THK. TEMPERED GLASS  
+ GLASS SPAN DIRECTION  
5. FIXING LOCATION  
◀ [BRT] FIXING LOCATION

NO.	DATE	REVISION SUBJECT TO COMMENTS	BY
A	28-10-2020	REVISION SUBJECT TO COMMENTS	MN
		REVISED	BY


JOB NO. : J-852  
PROJECT : PROPOSED RESIDENTIAL DEVELOPMENT AT 139 - 147 ARGYLE STREET, NKIL 6005, 6035 R.P., 6036 R.P., 6037 R.P. & 6038 R.P.

TITLE : TYPICAL DETAILS FOR CURTAIN WALL


DATE : 13-Jul-20 SCALE : 1:4  
DRAWN BY : LHR CHECKED BY : DW

**美特鋁質有限公司**  
MIDI ALUMINIUM FABRICATOR LTD.  
Units 6-8, Sunray Industrial Centre, 1/F  
610 Cha Kwo Ling Road, Kowloon  
Tel:23489211-4 Fax:(852)2727666


DWG NO. : J852-SD-PT-5002 REV. : A

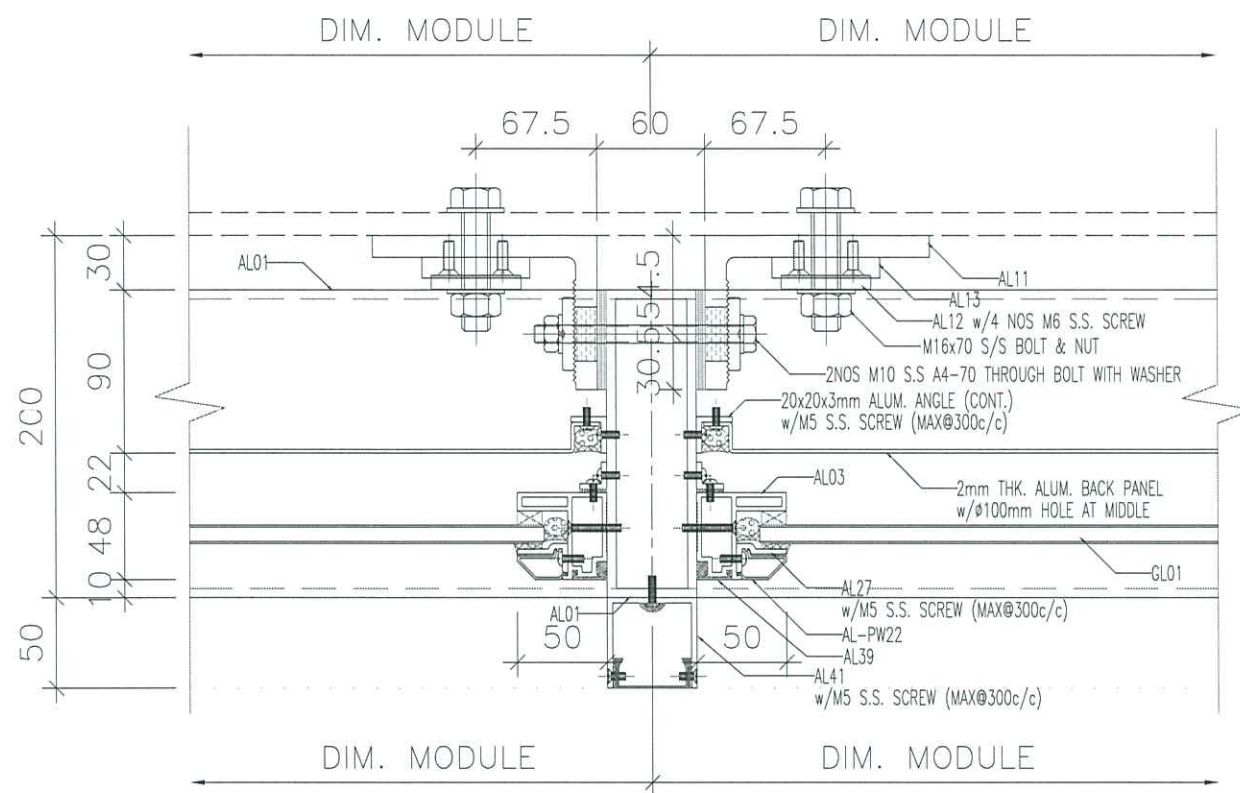

1 HORIZONTAL DETAIL  
5003 BR1 OUTSIDE

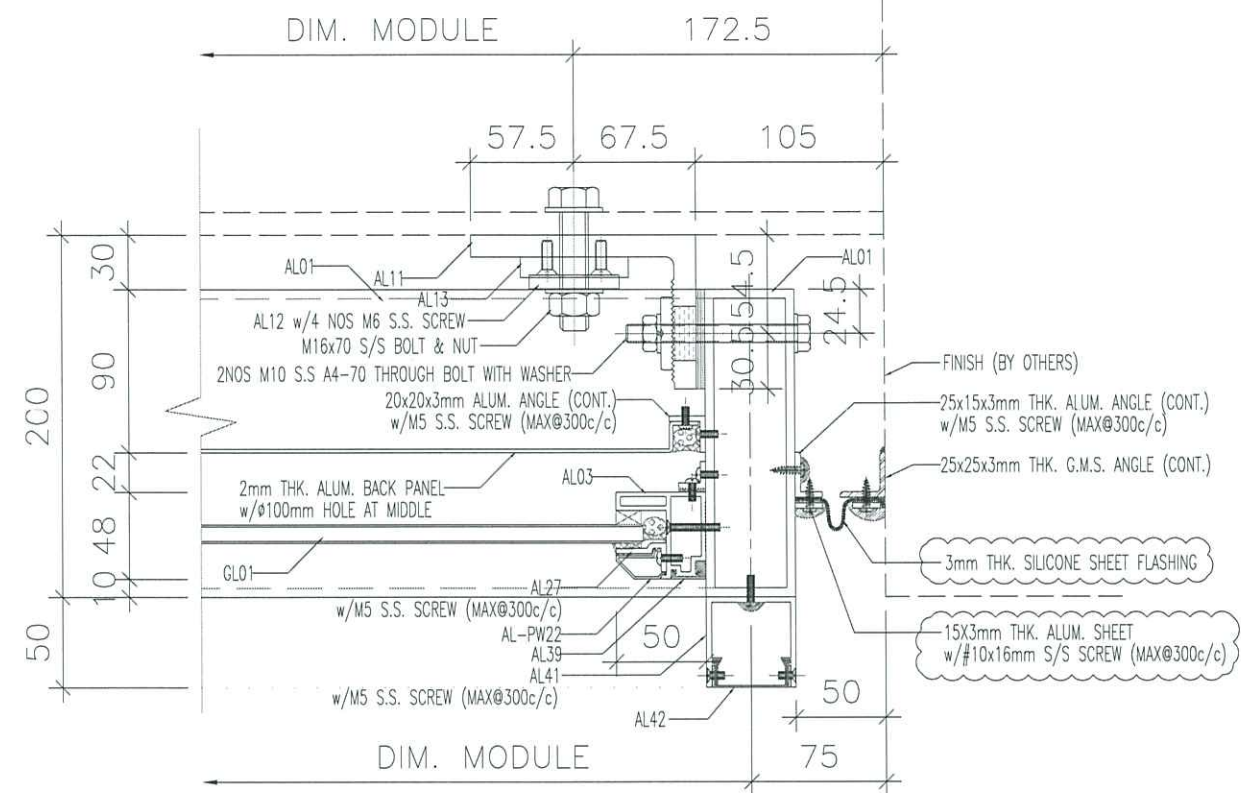

2 HORIZONTAL DETAIL  
5003 BR1 OUTSIDE

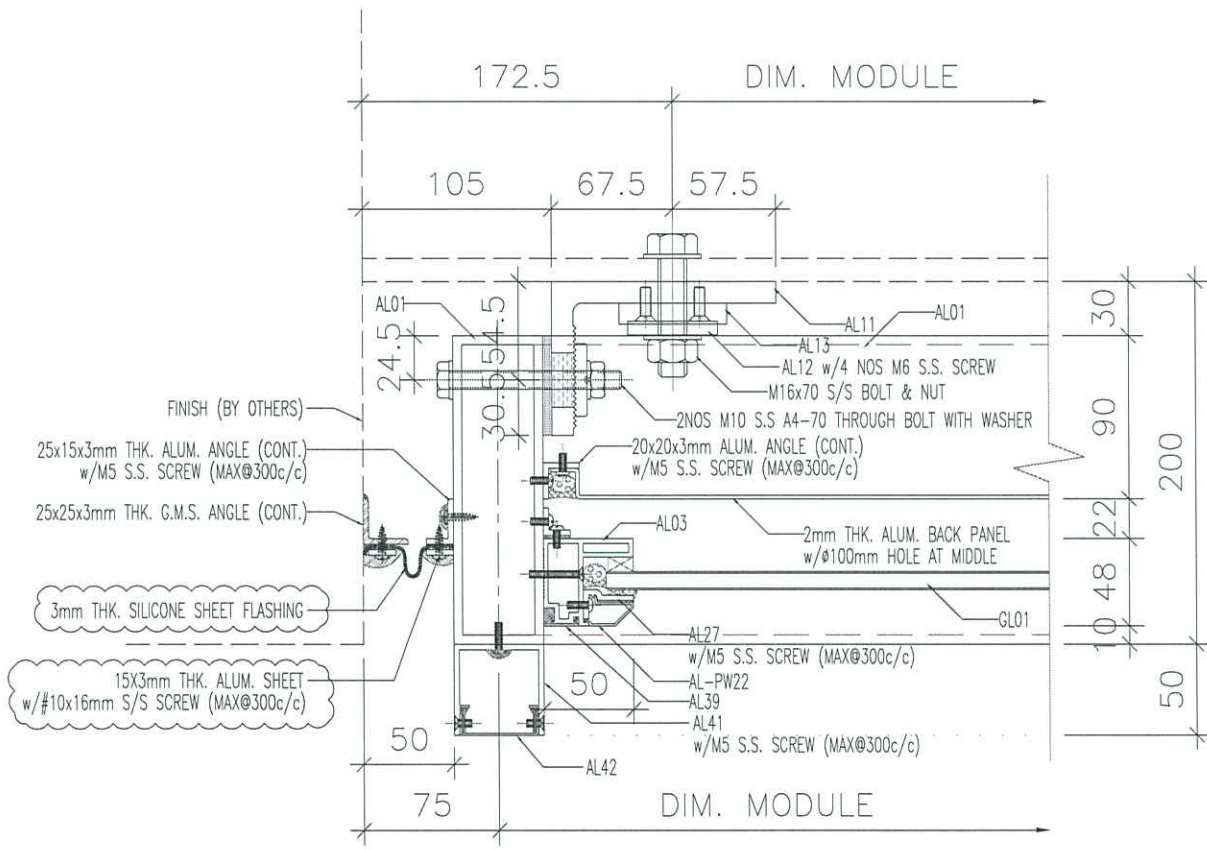

3 HORIZONTAL DETAIL  
5003 BR1 OUTSIDE

B.D. REF :

CLIENT :

ARCHITECT :  
**AGC DESIGN LTD**

MAIN CONTRACTOR :  
**Gammon**

STRUCTURAL ENGINEER :  
**ARUP**

FAÇADE CONSULTANT:  
**MEIN-HARDT**

NOTE:  
1. ALL DIMENSIONS ARE IN mm.  
2. ALL ELEVATIONS ARE VIEWED FROM OUTSIDE.  
3. ALL DIMENSIONS TO BE VERIFIED ON SITE BEFORE FABRICATION.

LEGEND:  
X1 - DETAIL MARK NO.  
X001 - REFER SHEET NO.

1. F.F.L. -- FINISHED FLOOR LEVEL  
2. S.F.L. -- STRUCTURAL FLOOR LEVEL  
3. /R -- REVERSED DETAIL  
4. GLASS LEGEND  
AL01 ALUM EXTRUSION MARK: REFER TO DRAWING: 1101&1102  
GL01 GL01 (VISION GLASS): 8mm HEAT STRENGTHENED+12mm AIR GAP +10mm THK. CLEAR TEMPERED I.G.U.  
GL02 GL02 (SPANDREL GLASS): 10mm THK. HEAT STRENGTHENED GLASS  
GL04 GL04 (PROTECTIVE BARRIER): 10mm THK. TEMPERED GLASS  
+ GLASS SPAN DIRECTION  
5. FIXING LOCATION  
BRT FIXING LOCATION



NO.	DATE	REVISION SUBJECT TO COMMENTS	BY
A	28-10-2020	REVISION SUBJECT TO COMMENTS	MN
		REVISED	BY

JOB NO. : J-852  
PROJECT : PROPOSED RESIDENTIAL DEVELOPMENT AT 139 - 147 ARGYLE STREET, NKIL 6005, 6035 R.P., 6036 R.P., 6037 R.P. & 6038 R.P.

TITLE : TYPICAL DETAILS FOR CURTAIN WALL

DATE : 13-Jul-20 SCALE : 1:4  
DRAWN BY : LHR CHECKED BY : DW

**美特鋁質有限公司**  
MIDI ALUMINUM FABRICATOR LTD.  
Units 6-8, Sunray Industrial Centre, 1/F  
610 Cha Kwo Ling Road, Kowloon  
Tel:23489211-4 Fax:(852)27727666  
DWG NO. : JB52-SD-PT-5003 REV. : A

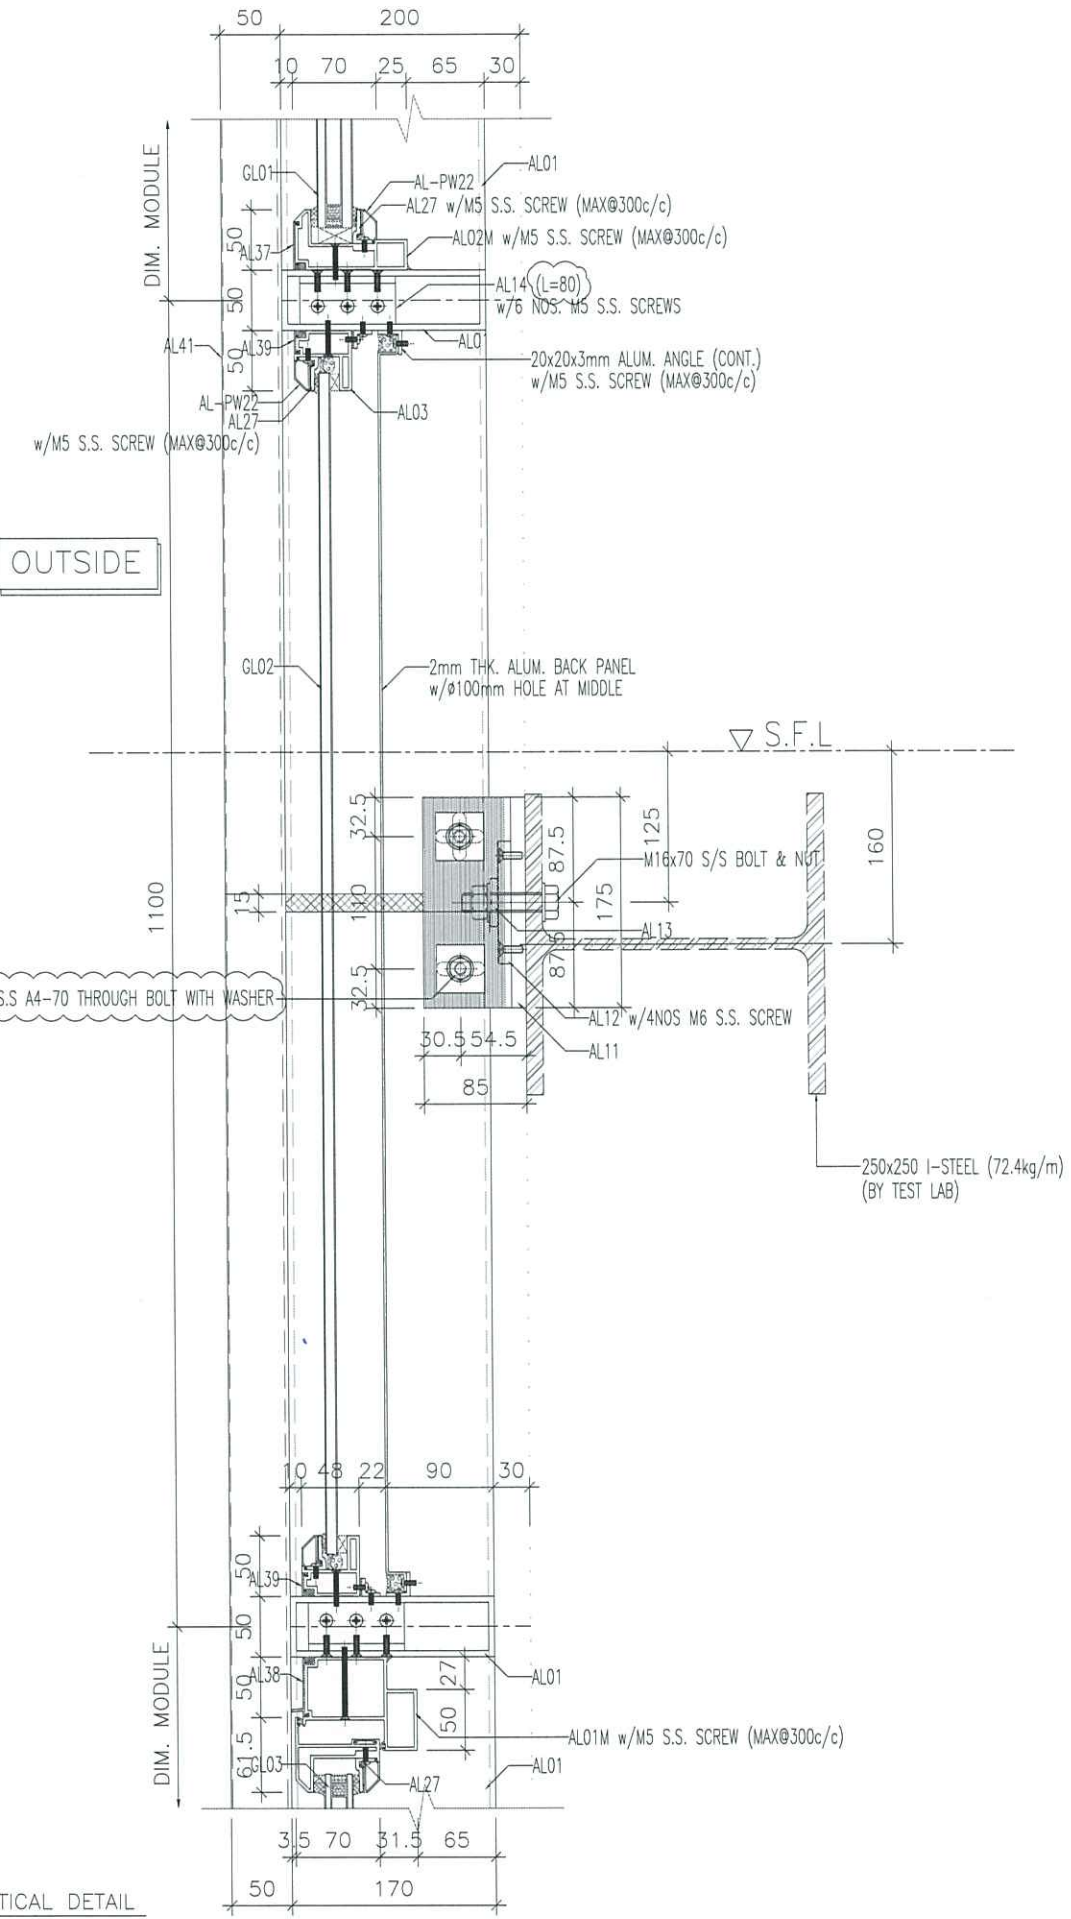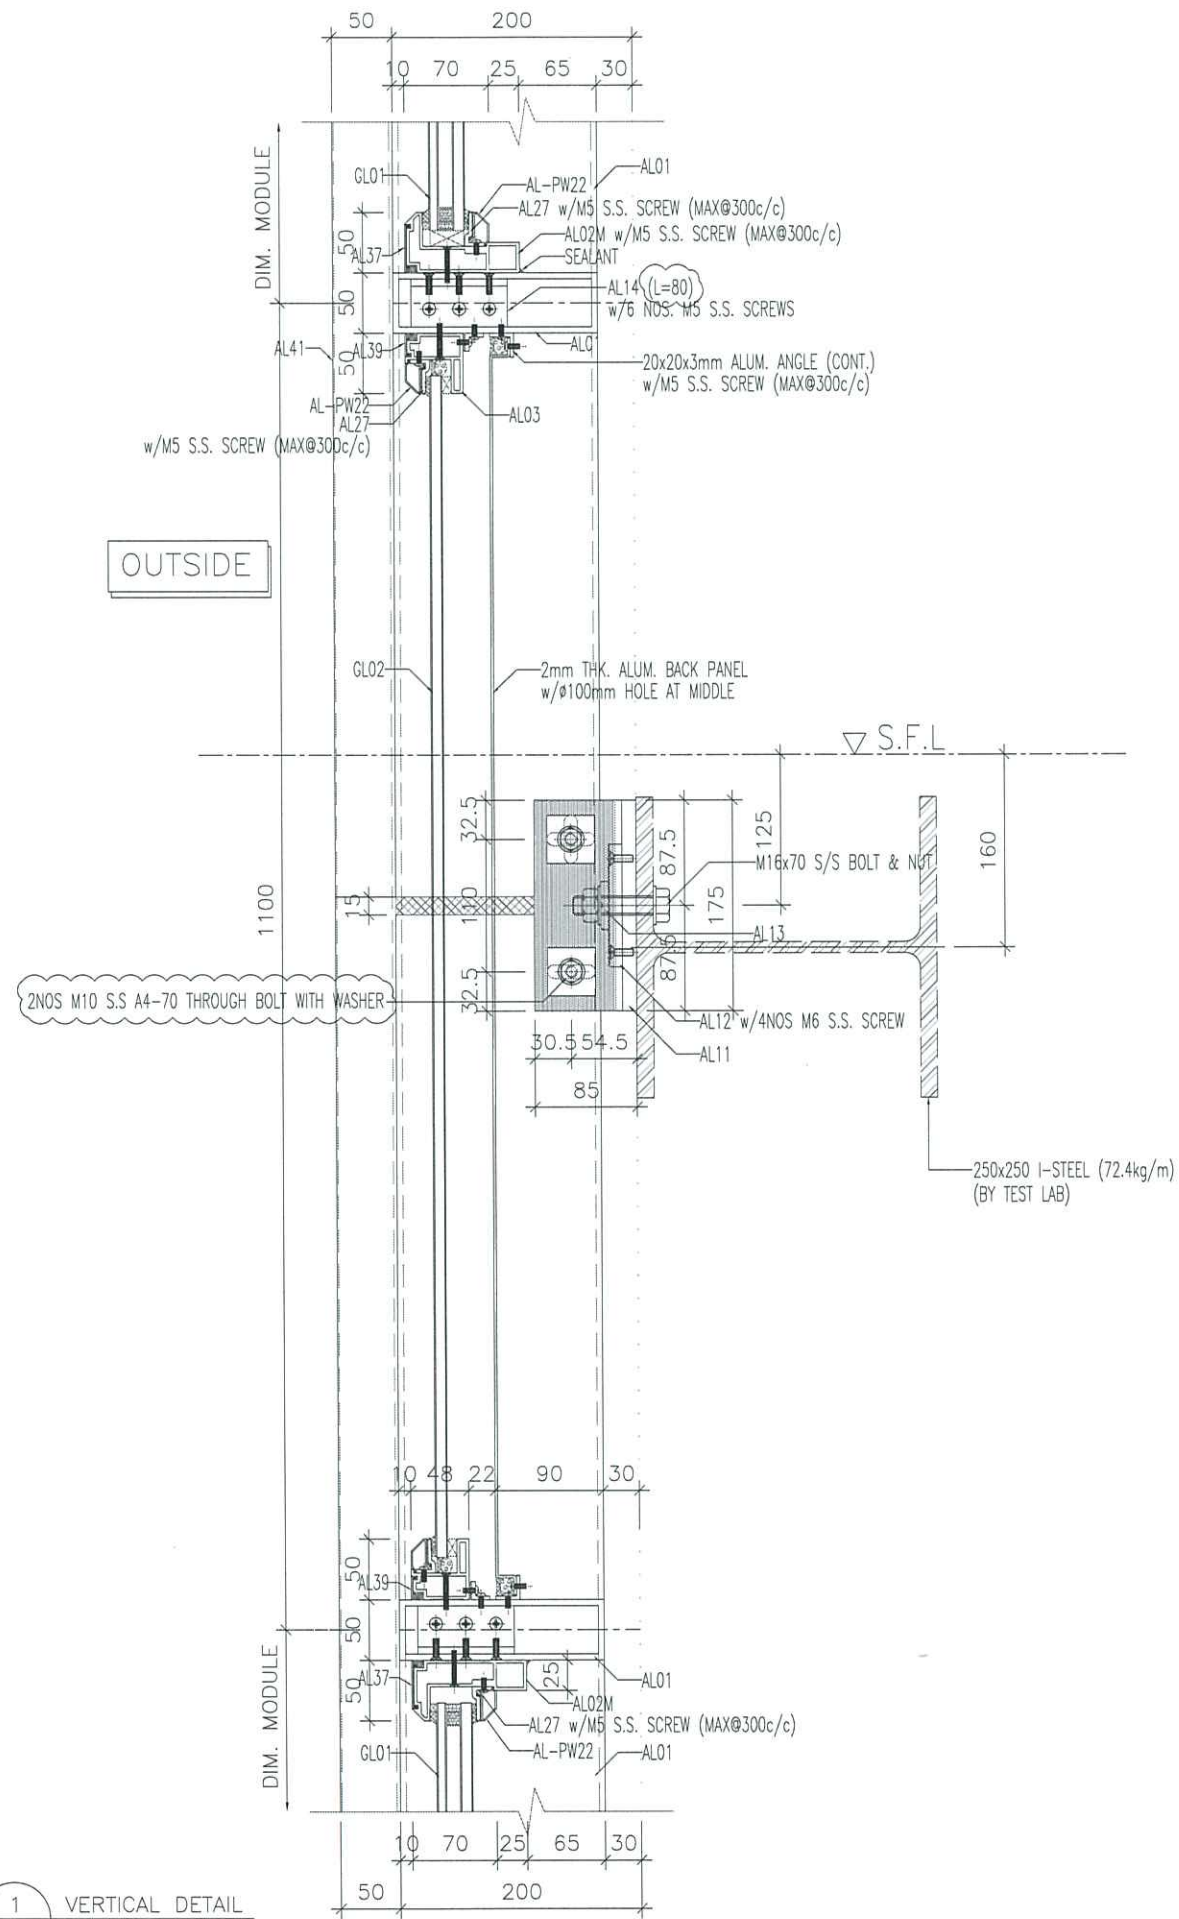

1 VERTICAL DETAIL  
6001 BR1

2 VERTICAL DETAIL  
6001 BR1

B.D. REF :

CLIENT :

ARCHITECT :



MAIN CONTRACTOR :



STRUCTURAL ENGINEER :



FACADE CONSULTANT :



NOTE :

1. ALL DIMENSIONS ARE IN mm.
2. ALL ELEVATIONS ARE VIEWED FROM OUTSIDE.
3. ALL DIMENSIONS TO BE VERIFIED ON SITE BEFORE FABRICATION.

LEGEND :

- X1 --- DETAIL MARK NO.
- X001 --- REFER SHEET NO.
- 1. F.F.L. --- FINISHED FLOOR LEVEL
- 2. S.F.L. --- STRUCTURAL FLOOR LEVEL
- 3. (R) --- REVERSED DETAIL
- 4. GLASS LEGEND
  - [AL01] ALUM EXTRUSION MARK:  
REFER TO DRAWING: 1101&1102
  - [GL01] GL01 (VISION GLASS):  
8mm HEAT STRENGTHENED+12mm AIR GAP  
+10mm THK. CLEAR TEMPERED I.G.U.
  - [GL02] GL02 (SPANDREL GLASS):  
10mm THK. HEAT STRENGTHENED GLASS
  - [GL04] GL04 (PROTECTIVE BARRIER):  
10mm THK. TEMPERED GLASS
  - ⊕ GLASS SPAN DIRECTION
- 5. FIXING LOCATION
  - ◀ [BRT] FIXING LOCATION

A	28-10-2020	REVISION SUBJECT TO COMMENTS	MN
NO.	DATE	REVISED	BY

JOB NO. : J-852  
 PROJECT : PROPOSED RESIDENTIAL DEVELOPMENT  
 AT 139 - 147 ARGYLE STREET,  
 NKIL 6005, 6035 R.P., 6036 R.P.,  
 6037 R.P. & 6038 R.P.


TITLE : TYPICAL DETAILS FOR CURTAIN WALL

DATE : 13-JUL-20 SCALE : 1:6


DRAWN BY : LHR CHECKED BY : DW

美特鋁質有限公司  
 MIDI ALUMINIUM FABRICATOR LTD.  
 Units 6-8, Sunray Industrial Centre, 1/F  
 610 Cha Kwo Ling Road, Kowloon  
 Tel:23489211-4 Fax:(852)2727666

DWG NO. : J852-SD-PT-6001 REV. : A

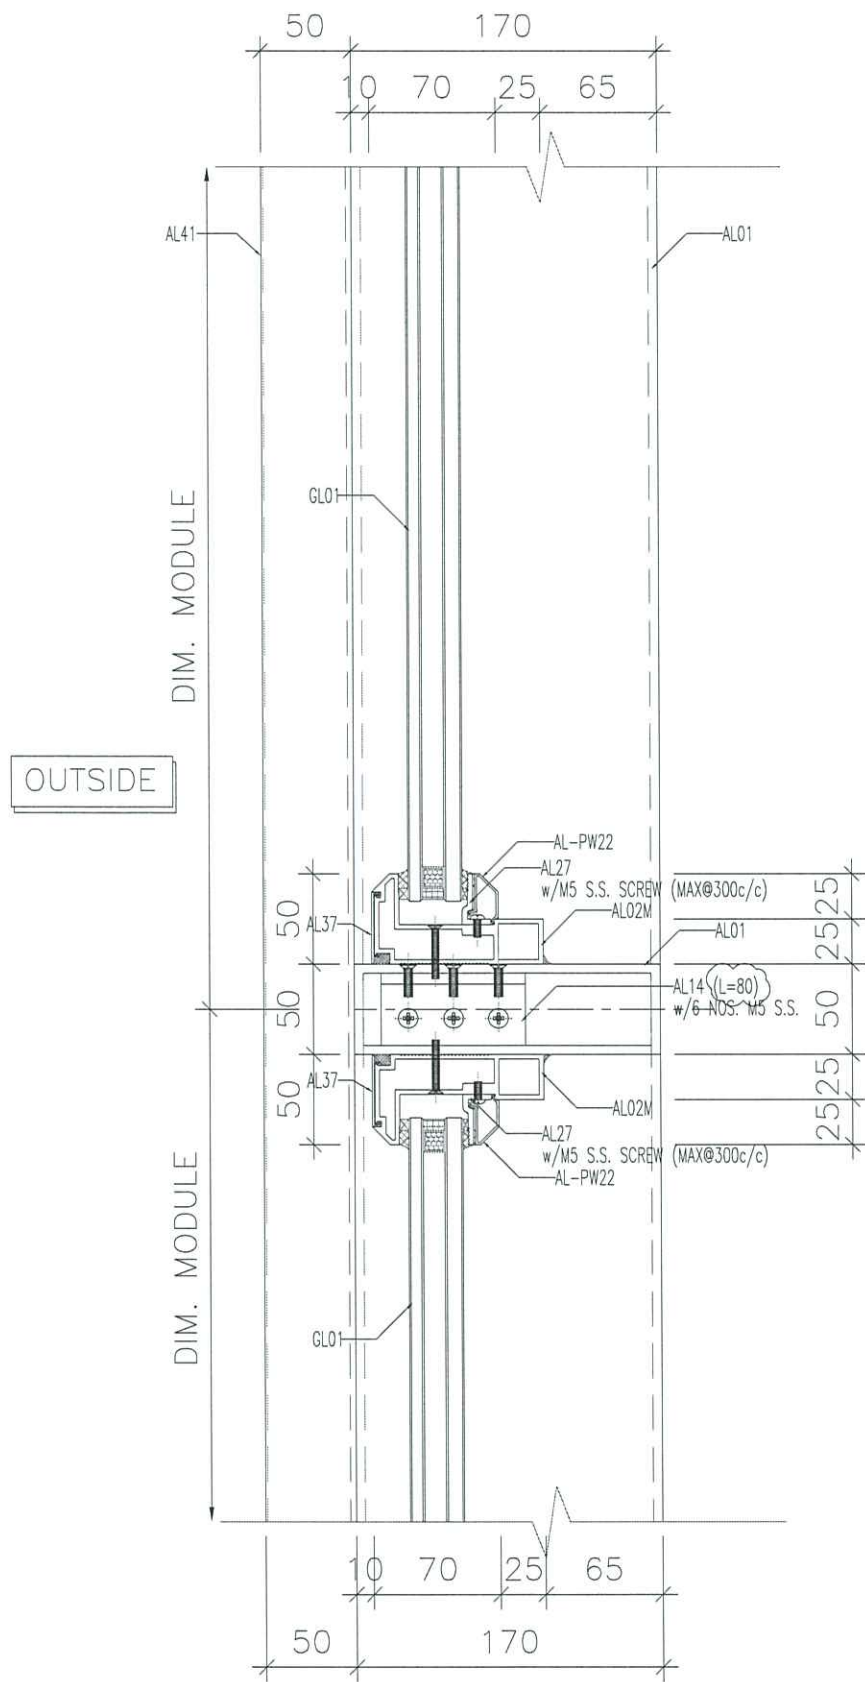

1 VERTICAL DETAIL  
6002

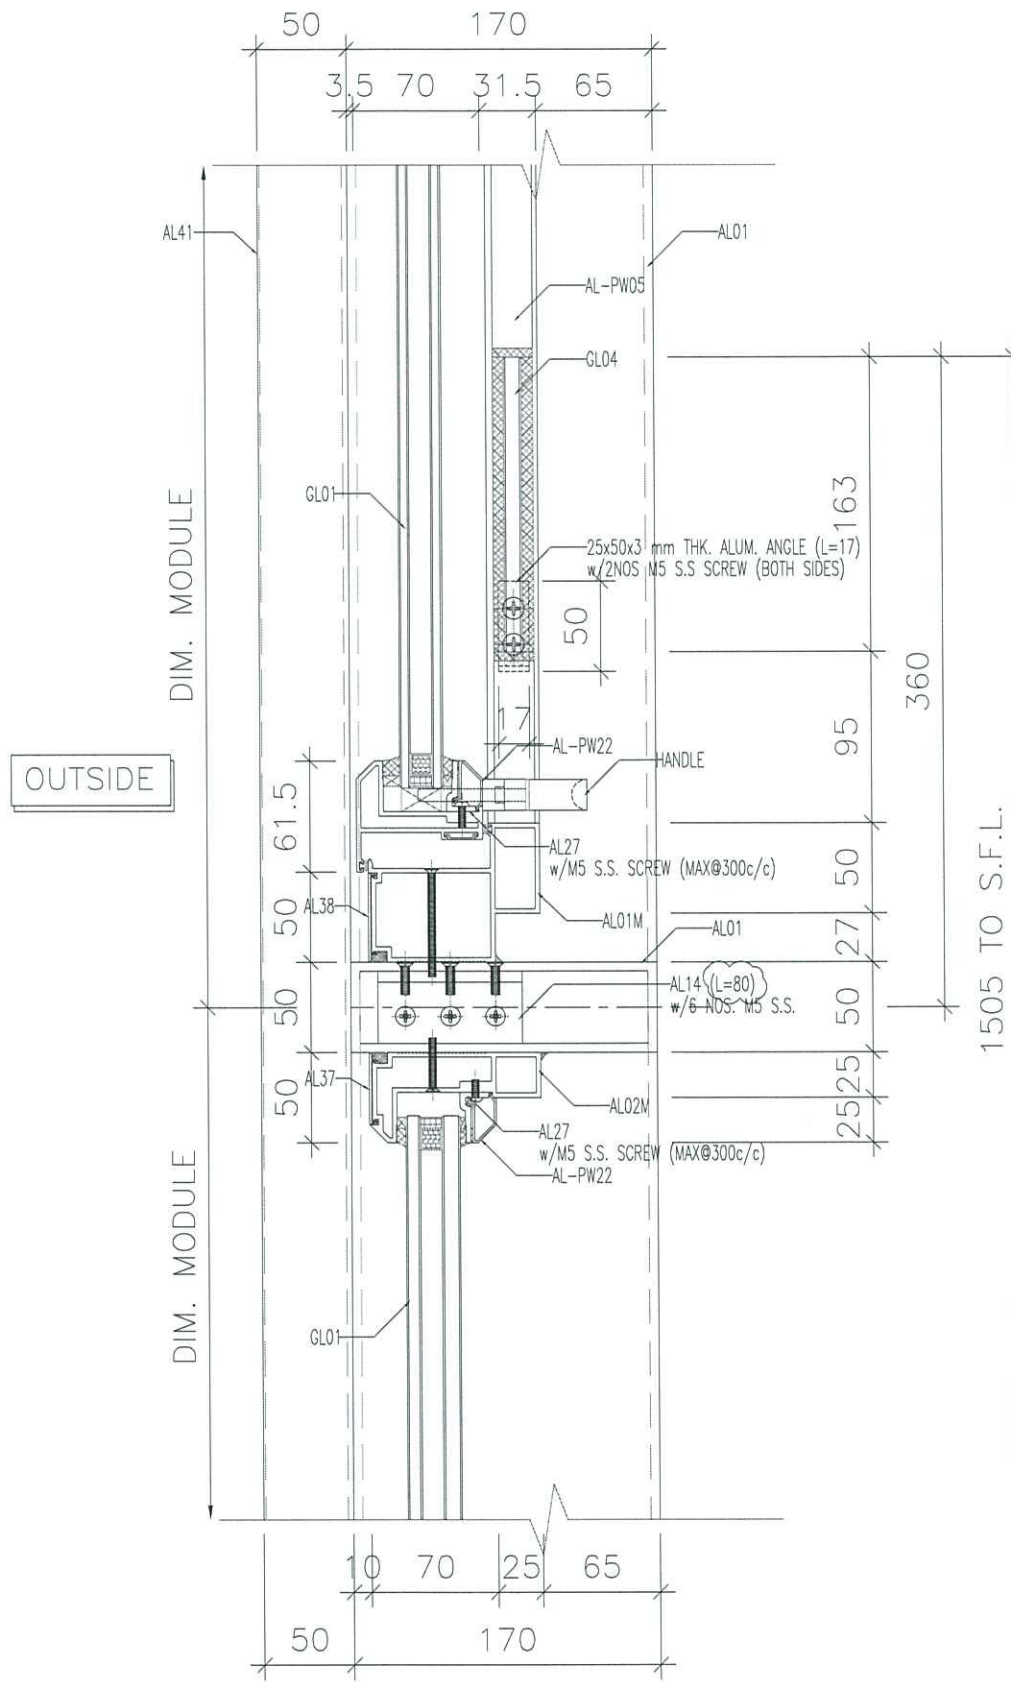

2 VERTICAL DETAIL  
6002

B.D. REF :

CLIENT :

ARCHITECT :  
**AGC DESIGN LTD**

MAIN CONTRACTOR :  
**Gammon**

STRUCTURAL ENGINEER :  
**ARUP**

FACADE CONSULTANT:  
**MEINHARDT**

NOTE:  
1. ALL DIMENSIONS ARE IN mm.  
2. ALL ELEVATIONS ARE VIEWED FROM OUTSIDE.  
3. ALL DIMENSIONS TO BE VERIFIED ON SITE BEFORE FABRICATION.

LEGEND:  
X1 --- DETAIL MARK NO.  
X001 --- REFER SHEET NO.

1. F.F.L. --- FINISHED FLOOR LEVEL  
2. S.F.L. --- STRUCTURAL FLOOR LEVEL  
3. /R --- REVERSED DETAIL  
4. GLASS LEGEND  
AL01 ALUM EXTRUSION MARK: REFER TO DRAWING: 1101&1102  
GLO1 (VISION GLASS): 8mm HEAT STRENGTHENED+12mm AIR GAP +10mm THK. CLEAR TEMPERED I.G.U.  
GLO2 (SPANDREL GLASS): 10mm THK. HEAT STRENGTHENED GLASS  
GLO4 (PROTECTIVE BARRIER): 10mm THK. TEMPERED GLASS  
+--- GLASS SPAN DIRECTION  
5. FIXING LOCATION  
BRT FIXING LOCATION

NO.	DATE	REVISION	BY
A	28-10-2020	REVISION SUBJECT TO COMMENTS	MN

JOB NO. : J-852  
PROJECT : PROPOSED RESIDENTIAL DEVELOPMENT AT 139 - 147 ARGYLE STREET, NKIL 6005, 6035 R.P., 6036 R.P., 6037 R.P. & 6038 R.P.


TITLE : TYPICAL DETAILS FOR CURTAIN WALL

DATE : 13-Jul-20 SCALE : 1:4


DRAWN BY : LHR CHECKED BY : DW

**美特鋁質有限公司**  
MIDI ALUMINIUM FABRICATOR LTD.  
Units 6-8, Sunray Industrial Centre, 1/F  
610 Cha Kwo Ling Road, Kowloon  
Tel:23489211-4 Fax:(852)27727666

DWG NO. : J852-SD-PT-6002 REV. : A

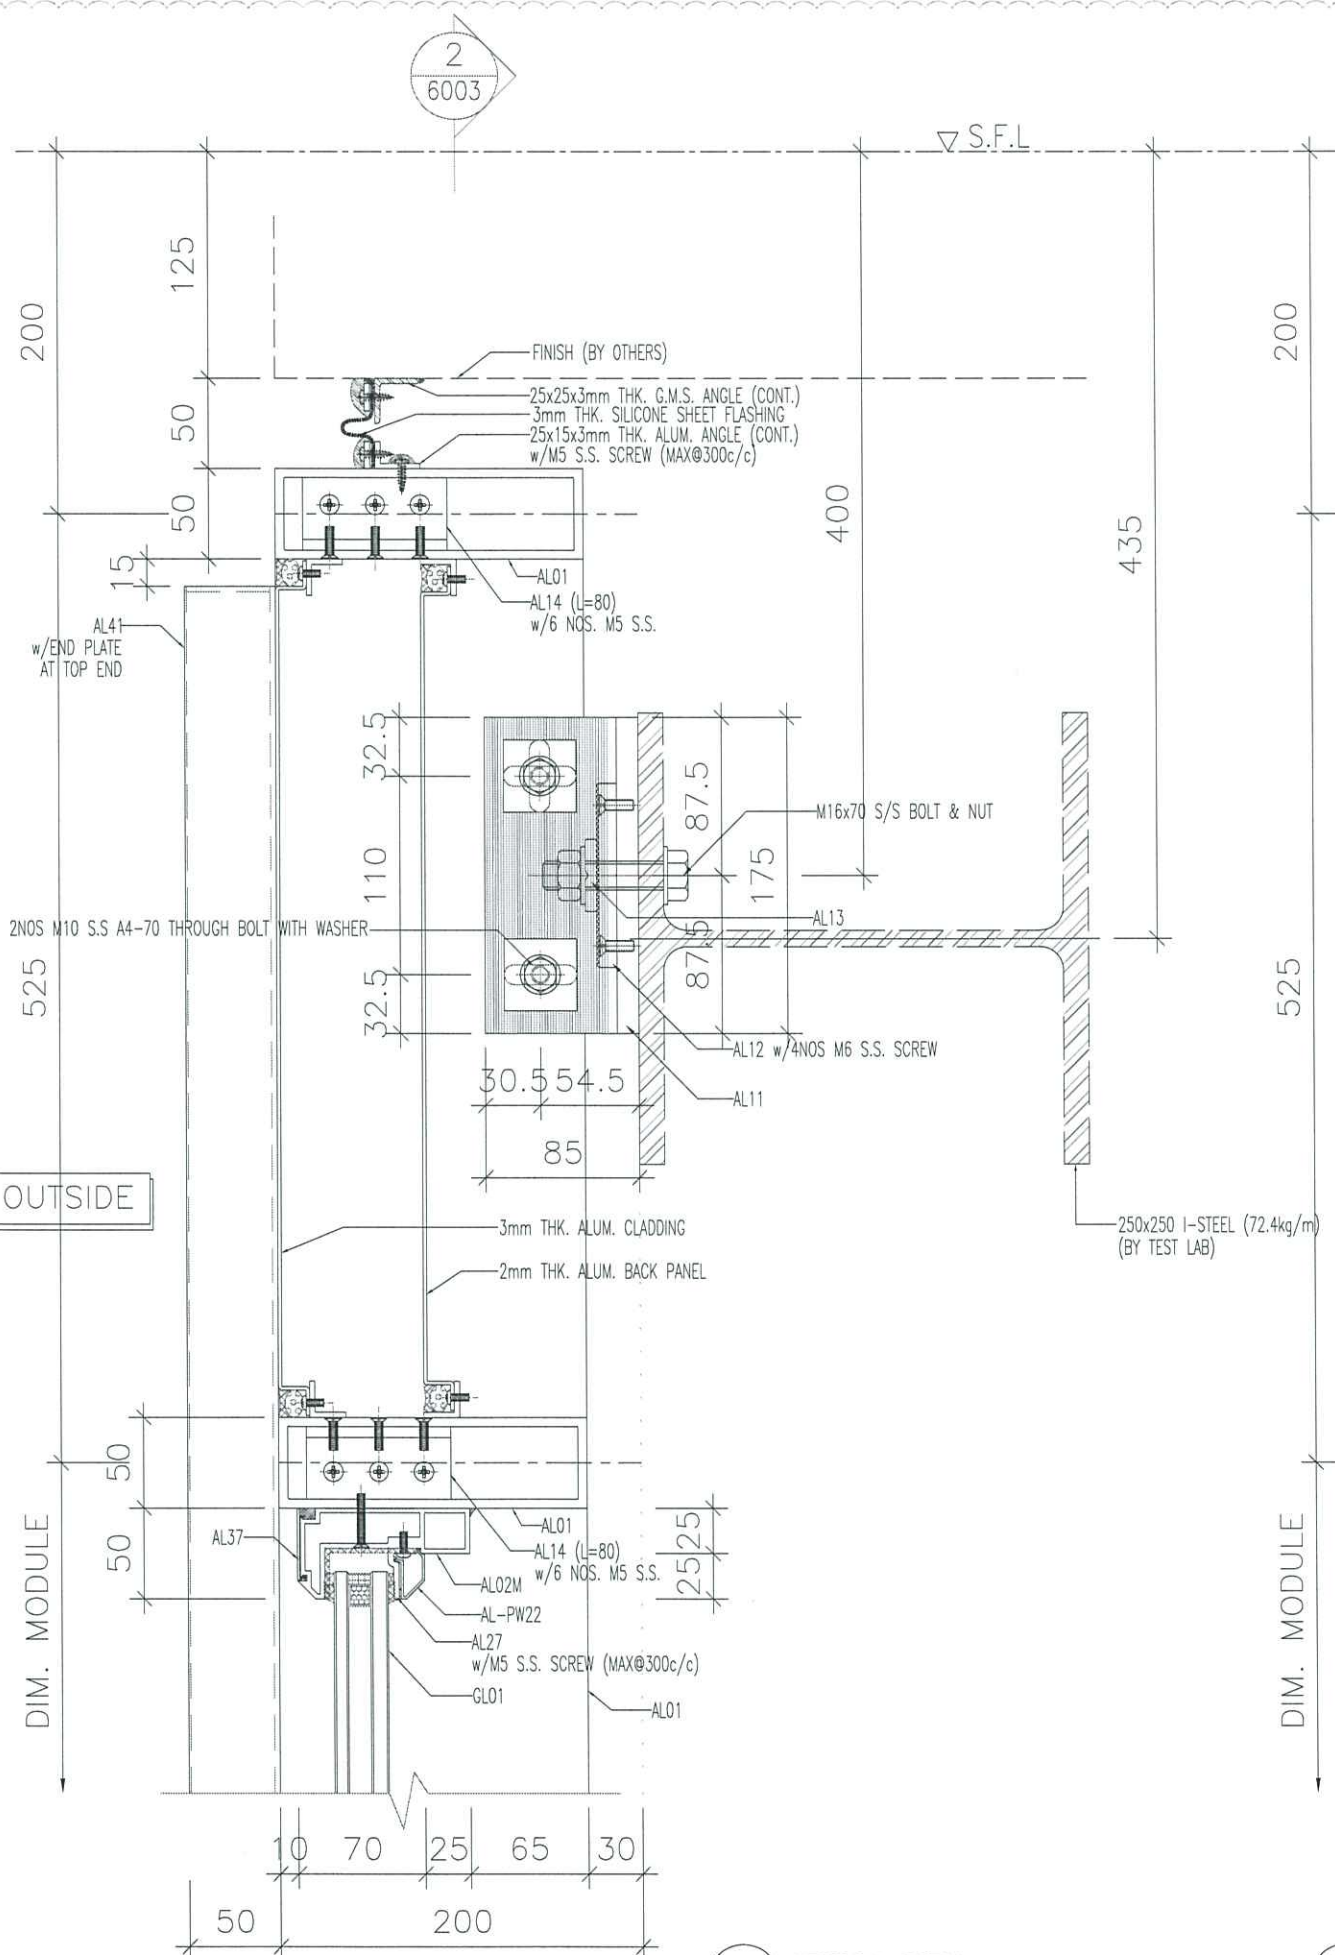

1 VERTICAL DETAIL  
6003

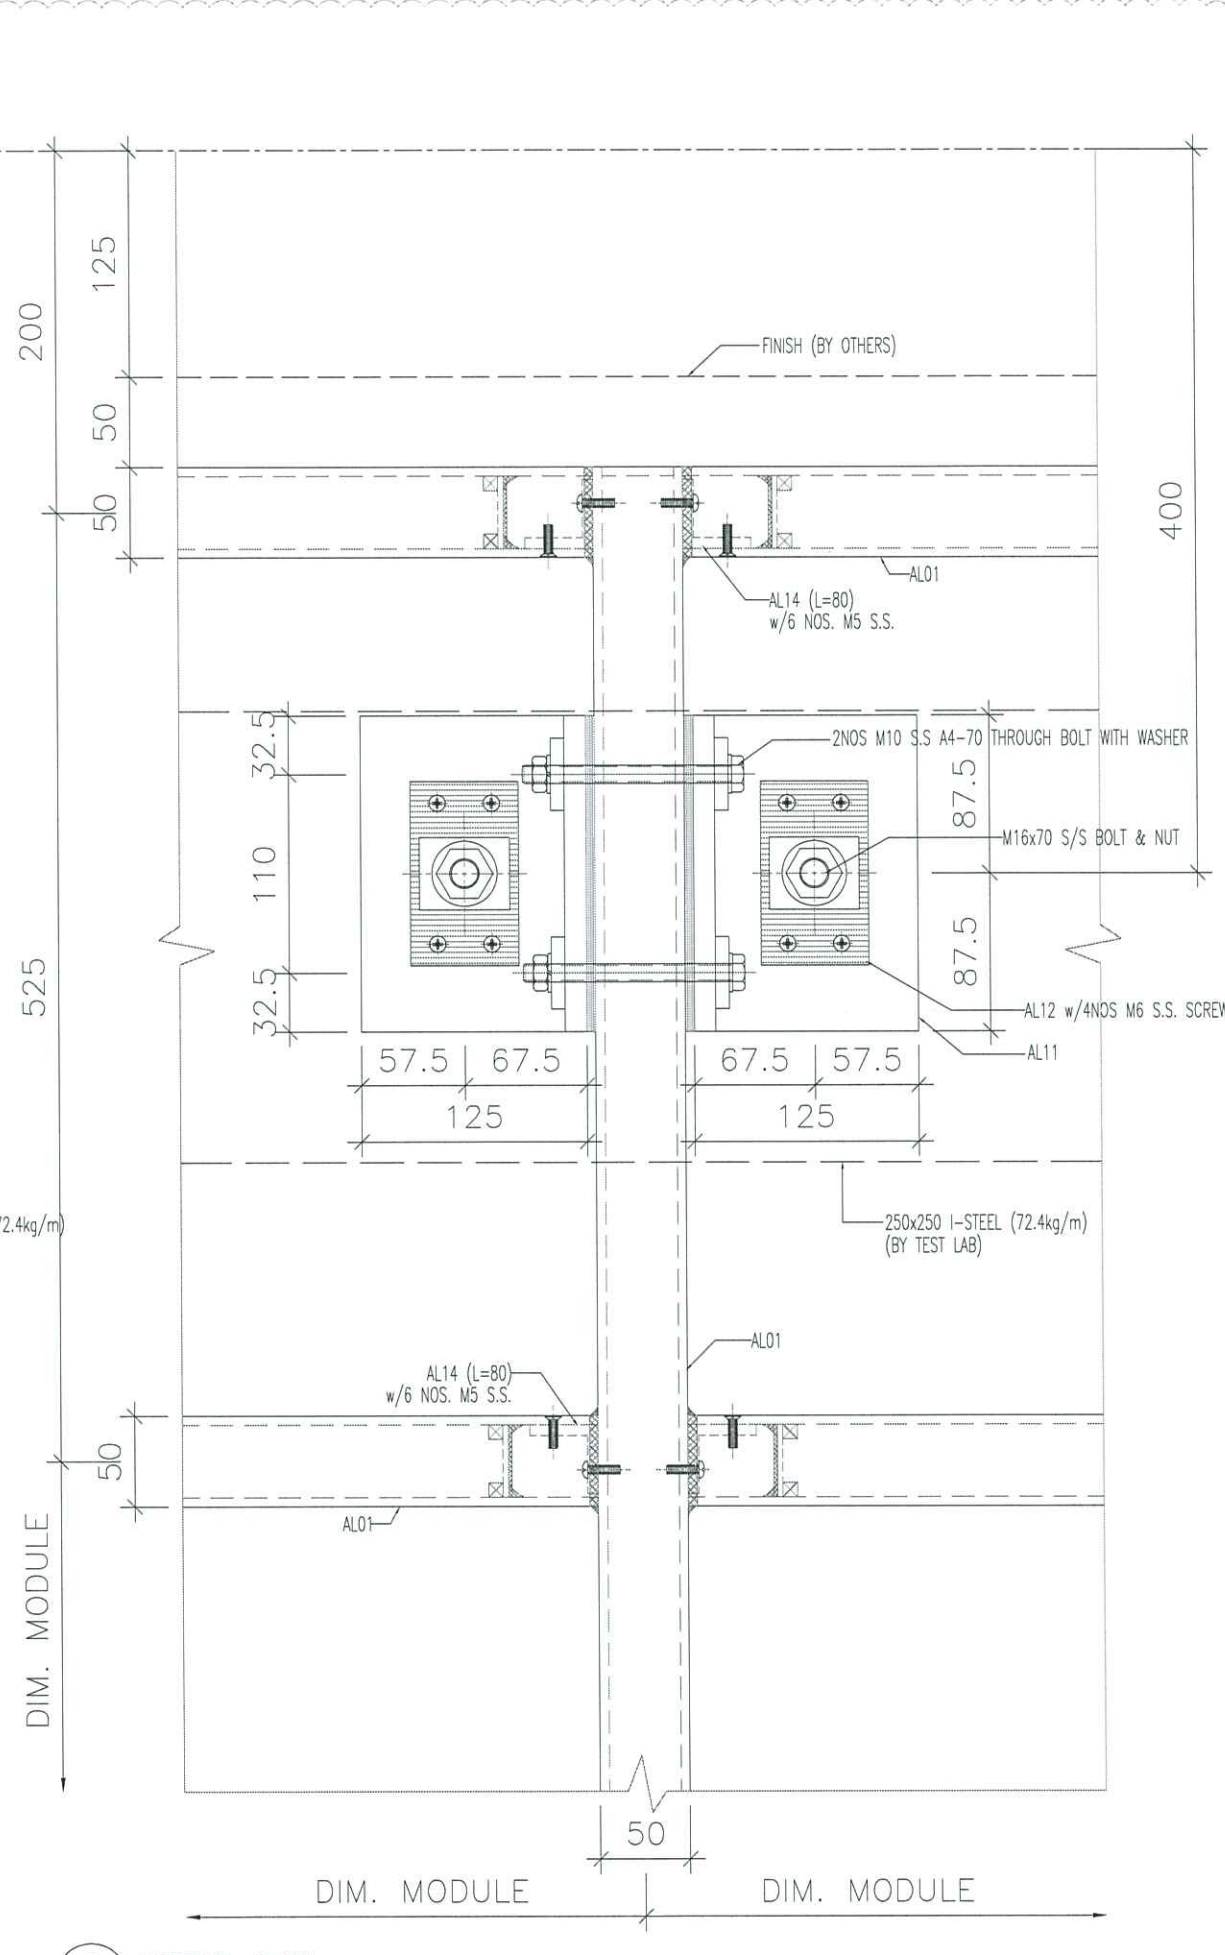

2 VERTICAL DETAIL  
6003

B.D. REF :

CLIENT :

ARCHITECT :  
**AGC DESIGN LTD**

MAIN CONTRACTOR :  
**Gammon**

STRUCTURAL ENGINEER :  
**ARUP**

FACADE CONSULTANT :  
**MEINHARDT**

NOTE :

- ALL DIMENSIONS ARE IN mm.
- ALL ELEVATIONS ARE VIEWED FROM OUTSIDE.
- ALL DIMENSIONS TO BE VERIFIED ON SITE BEFORE FABRICATION.

LEGEND :

X1 - DETAIL MARK NO.  
X001 - REFER SHEET NO.

- F.F.L. -- FINISHED FLOOR LEVEL
- S.F.L. -- STRUCTURAL FLOOR LEVEL
- ⊕ -- REVERSED DETAIL
- GLASS LEGEND
  - AL01 ALUM EXTRUSION MARK: REFER TO DRAWING: 1101&1102
  - GL01 GLO1 (VISION GLASS): 8mm HEAT STRENGTHENED+12mm AIR GAP +10mm THK. CLEAR TEMPERED I.G.U.
  - GL02 GLO2 (SPANDREL GLASS): 10mm THK. HEAT STRENGTHENED GLASS
  - GL04 GLO4 (PROTECTIVE BARRIER): 10mm THK. TEMPERED GLASS
  - ⊕ GLASS SPAN DIRECTION
- FIXING LOCATION
  - BR1 FIXING LOCATION

NO.	DATE	REVISION SUBJECT TO COMMENTS	BY
A	28-10-2020	REVISION SUBJECT TO COMMENTS	MN

JOB NO. : J-852

PROJECT : PROPOSED RESIDENTIAL DEVELOPMENT AT 139 - 147 ARGYLE STREET, NKIL 6005, 6035 R.P., 6036 R.P., 6037 R.P. & 6038 R.P.


TITLE : TYPICAL DETAILS FOR CURTAIN WALL

DATE : 13-JUL-20 SCALE : 1:4


DRAWN BY : LHR CHECKED BY : DW

**美特鋁質有限公司**  
MIDI ALUMINIUM FABRICATOR LTD.  
Units 6-8, Sunray Industrial Centre, 1/F  
610 Cha Kwo Ling Road, Kowloon  
Tel:23489211-4 Fax:(852)2727666

DWG NO. : J852-SD-PT-6003 REV. : -

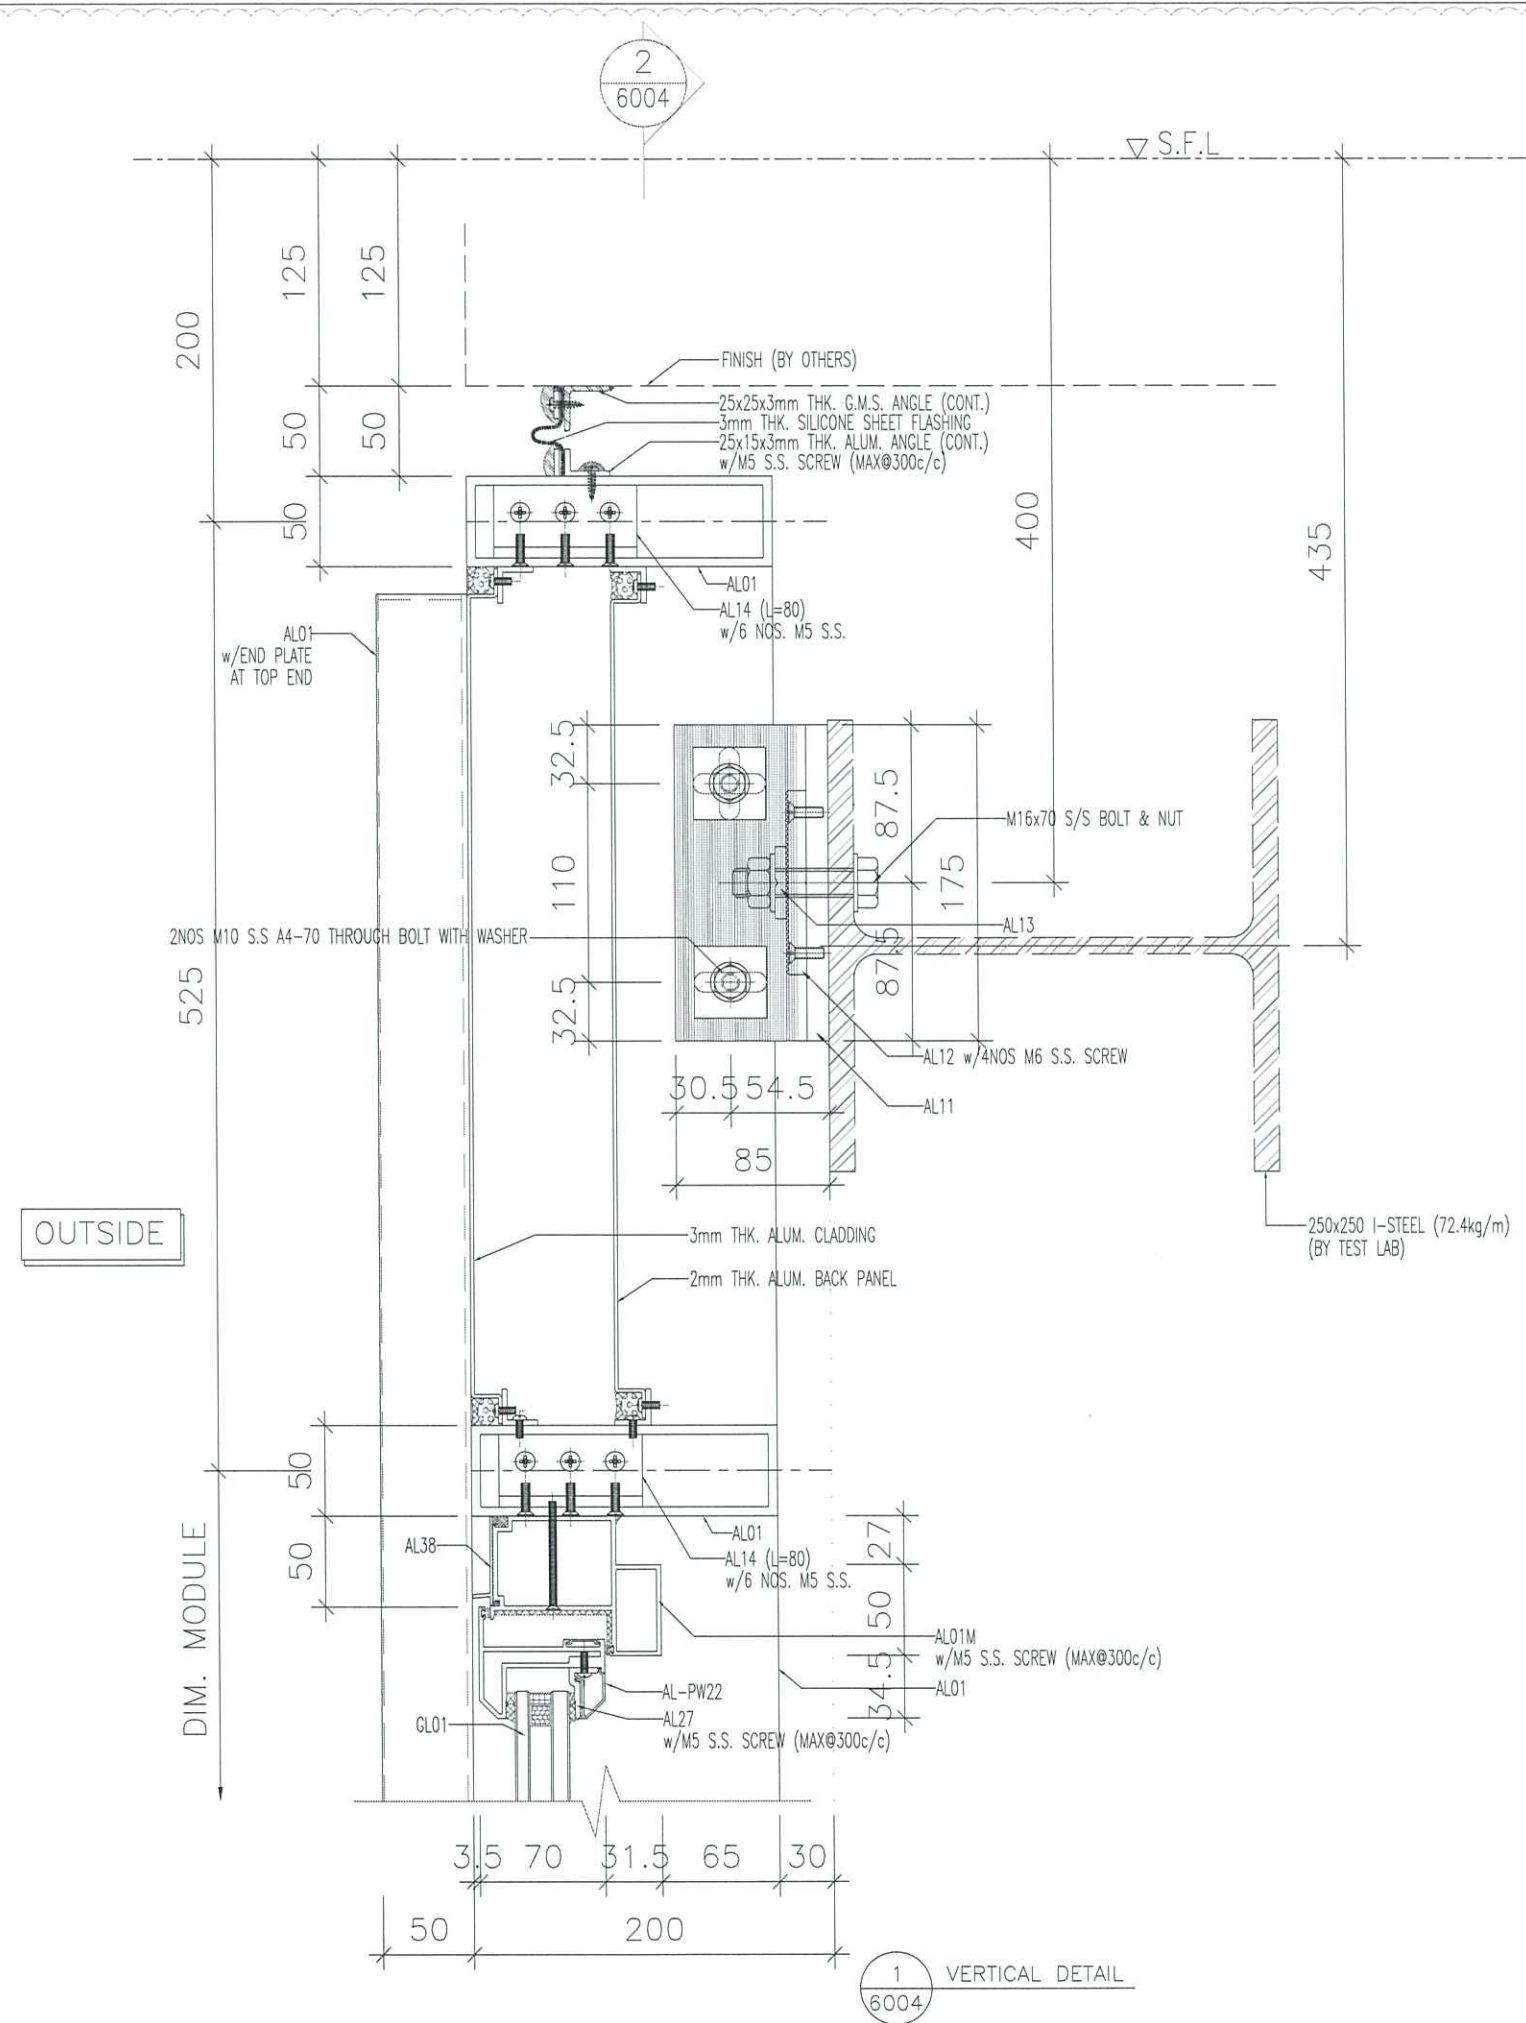

1 VERTICAL DETAIL  
6004

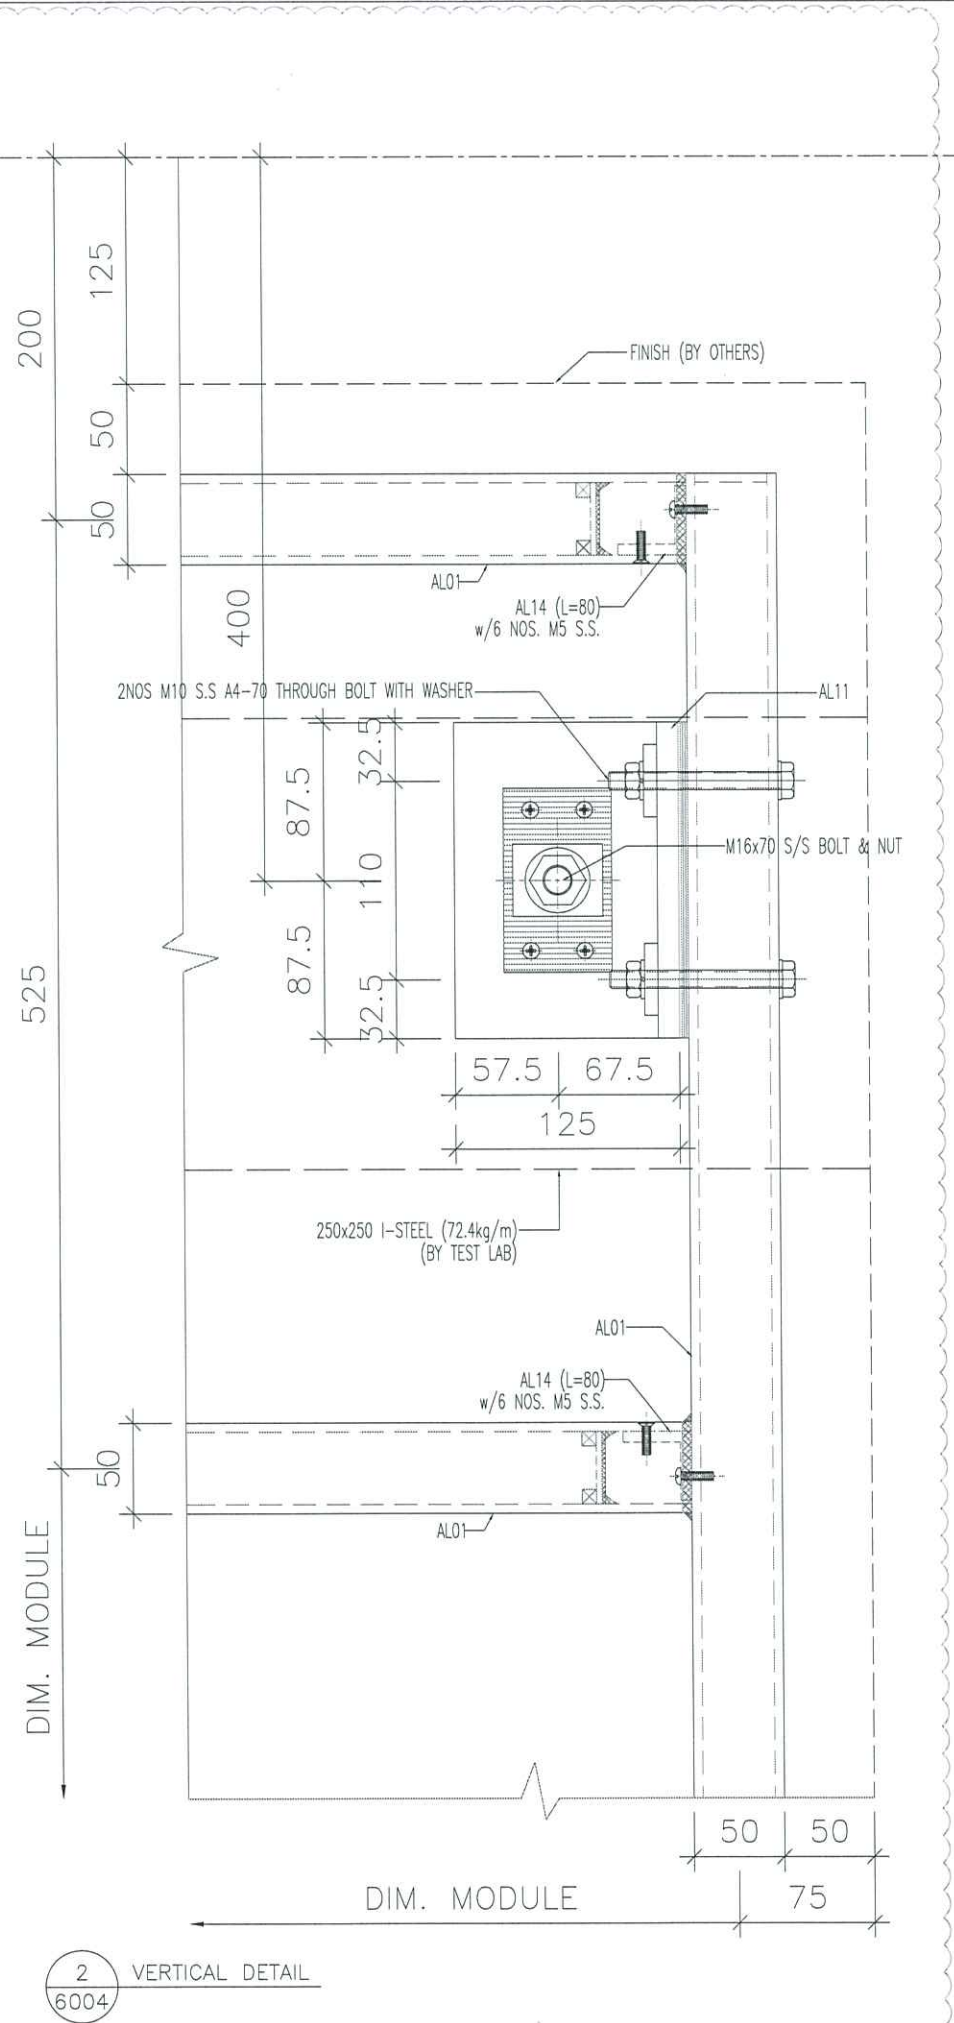

2 VERTICAL DETAIL  
6004

B.D. REF :

CLIENT :

ARCHITECT :  
**AGC DESIGN LTD**

MAIN CONTRACTOR :  
**Gammon**

STRUCTURAL ENGINEER :  
**ARUP**

FACADE CONSULTANT:  
**MEIN-HARDT**

NOTE :  
1. ALL DIMENSIONS ARE IN MM.  
2. ALL ELEVATIONS ARE VIEWED FROM OUTSIDE.  
3. ALL DIMENSIONS TO BE VERIFIED ON SITE BEFORE FABRICATION.

LEGEND :

X1 — DETAIL MARK NO.  
X001 — REFER SHEET NO.

1. F.F.L. — FINISHED FLOOR LEVEL  
2. S.F.L. — STRUCTURAL FLOOR LEVEL  
3. ⊕ — REVERSED DETAIL  
4. GLASS LEGEND

AL01 ALUM EXTRUSION MARK:  
REFER TO DRAWING: 1101&1102

GLO1 GLO1 (VISION GLASS):  
8mm HEAT STRENGTHENED+12mm AIR GAP  
+10mm THK. CLEAR TEMPERED I.G.U.

GLO2 GLO2 (SPANDREL GLASS):  
10mm THK. HEAT STRENGTHENED GLASS

GLO4 GLO4 (PROTECTIVE BARRIER):  
10mm THK. TEMPERED GLASS

⊕ GLASS SPAN DIRECTION

5. FIXING LOCATION  
▶ BRT FIXING LOCATION

A	28-10-2020	REVISION SUBJECT TO COMMENTS	MN
NO.	DATE	REVISION	BY

JOB NO. : J-852

PROJECT : PROPOSED RESIDENTIAL DEVELOPMENT AT 139 - 147 ARGYLE STREET, NKIL 6005, 6035 R.P., 6036 R.P., 6037 R.P. & 6038 R.P.


TITLE : TYPICAL DETAILS FOR CURTAIN WALL

DATE : 13-Jul-20 SCALE : 1:4

DRAWN BY : LHR CHECKED BY : DW

**美特鋁質有限公司**  
MIDI ALUMINIUM FABRICATOR LTD.  
Units 6-8, Sunray Industrial Centre, 1/F  
610 Cha Kwo Ling Road, Kowloon  
Tel:23489211-4 Fax:(852)2727666


DWG NO. : J852-SD-PT-6004 REV. : A

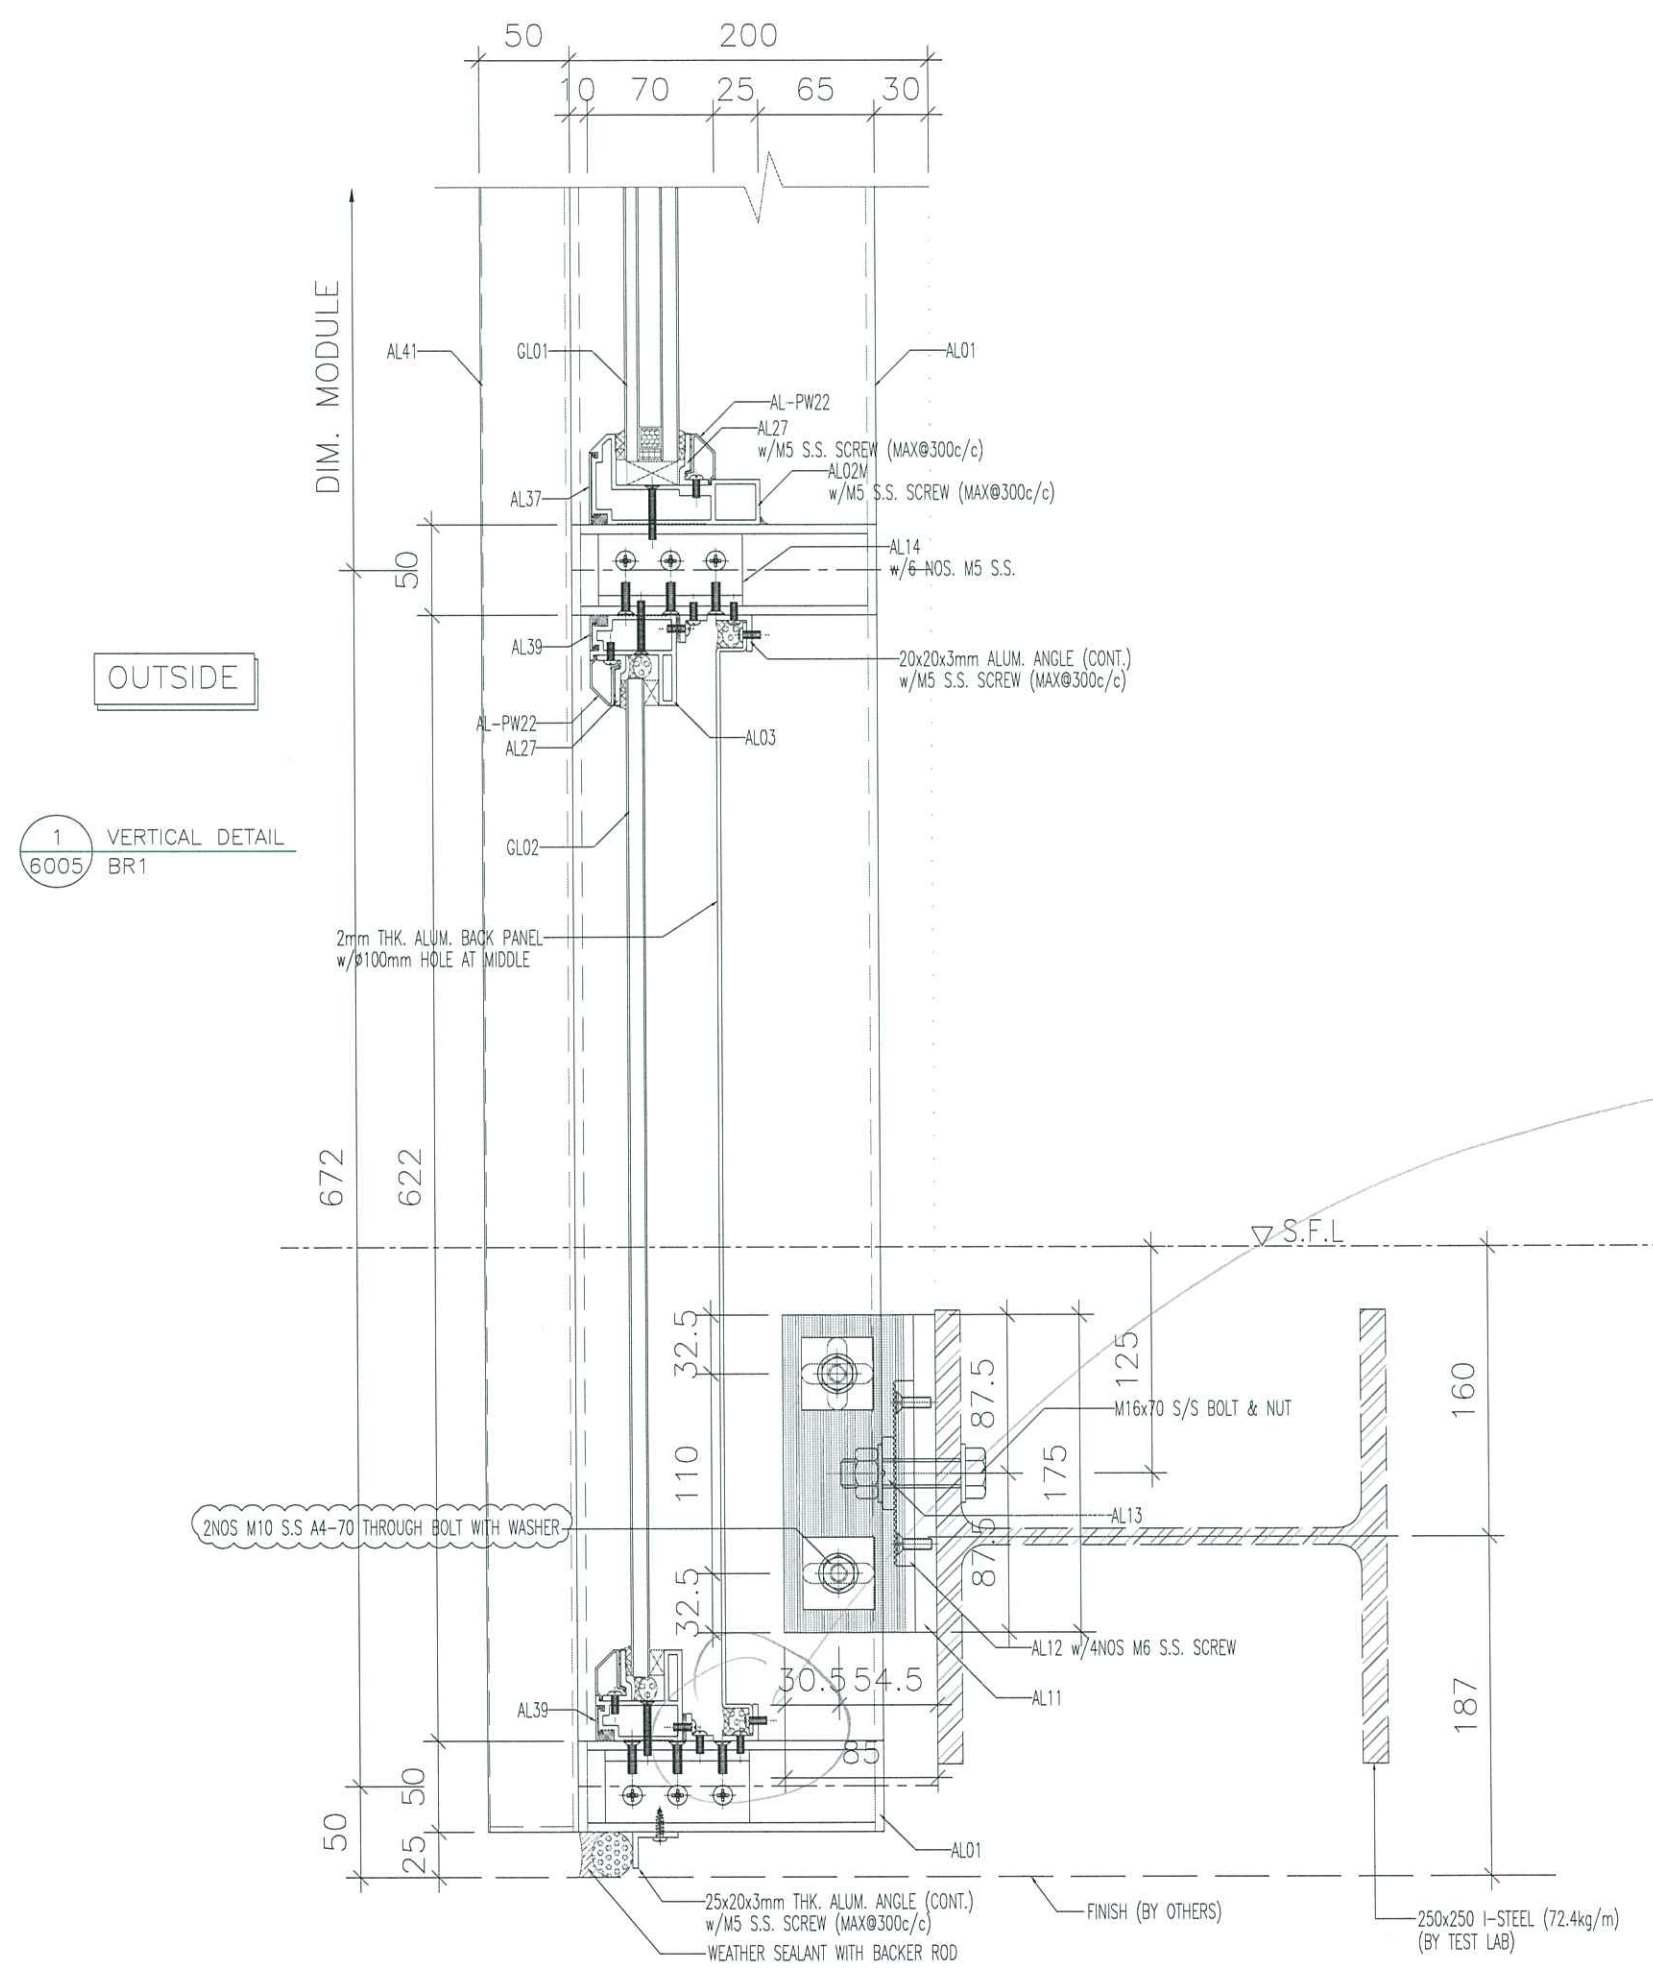

OUTSIDE

1 VERTICAL DETAIL  
6005 BR1

注意:

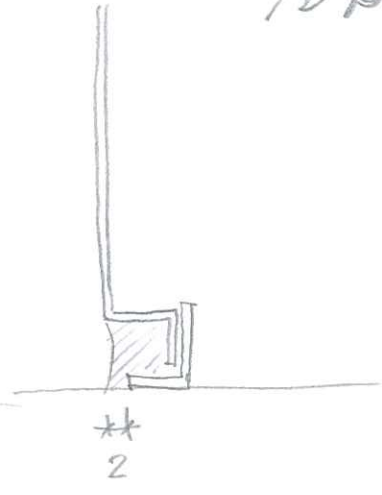

B.D. REF :

CLIENT :

ARCHITECT :  
**AGC DESIGN LTD**  
 110, 112, 114,1000

MAIN CONTRACTOR :  
**Gammon**

STRUCTURAL ENGINEER :  
**ARUP**

FACADE CONSULTANT :  
**MEINHARDT**

NOTE :  
 1. ALL DIMENSIONS ARE IN mm.  
 2. ALL ELEVATIONS ARE VIEWED FROM OUTSIDE.  
 3. ALL DIMENSIONS TO BE VERIFIED ON SITE BEFORE FABRICATION.

LEGEND :  
 X1 — DETAIL MARK NO.  
 X001 — REFER SHEET NO.

1. F.F.L. — FINISHED FLOOR LEVEL  
 2. S.F.L. — STRUCTURAL FLOOR LEVEL  
 3. (B) — REVERSED DETAIL  
 4. GLASS LEGEND  
 AL01 ALUM EXTRUSION MARK: REFER TO DRAWING: 1101&1102  
 GL01 GL01 (VISION GLASS): 8mm HEAT STRENGTHENED+12mm AIR GAP +10mm THK. CLEAR TEMPERED I.G.U.  
 GL02 GL02 (SPANDREL GLASS): 10mm THK. HEAT STRENGTHENED GLASS  
 GL04 GL04 (PROTECTIVE BARRIER): 10mm THK. TEMPERED GLASS  
 + GLASS SPAN DIRECTION  
 5. FIXING LOCATION  
 (BR1) FIXING LOCATION

A	28-10-2020	REVISION SUBJECT TO COMMENTS	MN
NO.	DATE	REVISED	BY

JOB NO. : J-852

PROJECT :  
 PROPOSED RESIDENTIAL DEVELOPMENT  
 AT 139 - 147 ARGYLE STREET,  
 NKIL 6005, 6035 R.P., 6036 R.P.,  
 6037 R.P. & 6038 R.P.

TITLE :  
 TYPICAL DETAILS FOR  
 CURTAIN WALL

DATE : 13-Jul-20 SCALE : 1:4

DRAWN BY : LHR CHECKED BY : DW

**美特铝质有限公司**  
 MIDI ALUMINIUM FABRICATOR LTD.  
 Units 6-8, Sunray Industrial Centre, 1/F  
 610 Cha Kwo Ling Road, Kowloon  
 Tel:23489211-4 Fax:(852)27727666

DWG NO. : J852-SD-PT-6005 REV. : A